


PLOT PLAN

DESCRIPTION: As Provided By: CLIENT

Lot 10, MONTICELLO 1ST PLAT - LOTS 1-32 & TRACTS A-C, a subdivision in Lees Summit, Jackson County, Missouri.

ADDRESS 1336 NE BRANDYWINE ROAD
GARAGE FLOOR=920.5
TOP FOUNDATION=921.2
BASEMENT FLOOR=912.5
WALKOUT=912.5
WALKOUT LAG=912.4
MBOE PER ASBUILT=907

RELEASE FOR CONSTRUCTION
AS NOTED FOR PLAN REVIEW
ENCLOSURE SERVICE
LEE'S SUMMIT, MISSOURI
06/13/2025

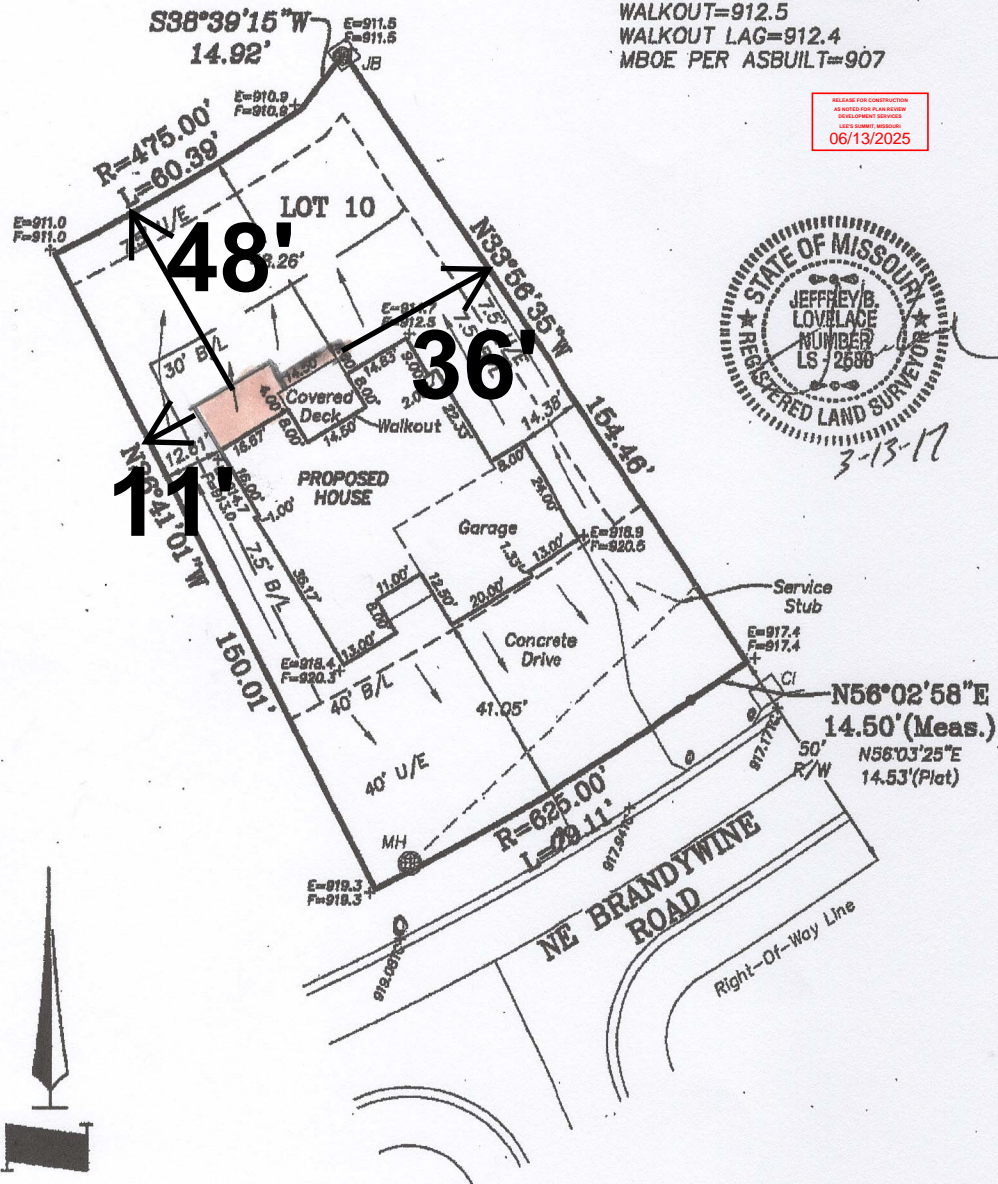

NOTES:

1. LEGAL DESCRIPTION OF PROPERTY PROVIDED BY CONTRACTOR. THIS PLOT PLAN DOES NOT CONSTITUTE OR REPRESENT A BOUNDARY SURVEY. THE CONTRACTOR AND/OR OWNER SHALL BE RESPONSIBLE FOR VERIFICATION OF PROPERTY BOUNDARY, PROPERTY CORNERS, DEED DESCRIPTIONS AND LOCATIONS OF PROPOSED HOUSE WITH RESPECT TO PROPERTY LINES.
2. EASEMENTS, BUILDING LINES AND SET-BACKS TAKEN FROM RECORDED PLAT ONLY.
3. CONTRACTOR TO VERIFY LOCATION AND DEPTH OF SANITARY SEWER SERVICE PRIOR TO CONSTRUCTION.
4. CONTRACTOR TO VERIFY ALL DIMENSIONS, ELEVATIONS AND LOCATIONS PRIOR TO CONSTRUCTION.
5. CONTRACTOR TO VERIFY CONDITION OF ALL FILL PRIOR TO CONSTRUCTION.
6. GRADES ARE PROPOSED GRADES ONLY. FINAL GRADING AND ELEVATIONS SHALL BE CONTRACTORS RESPONSIBILITY.
7. THIS IS A REPRESENTATION OF THE STRUCTURE AS STAKED BY THIS COMPANY.

Ordered By:
D&D Building, Inc.
PO Box 7014
Lees Summit, MO. 64064

LOVELACE & ASSOCIATES, LLC
LAND SURVEYING AND PLANNING SERVICES
929 SE 3RD ST / P.O. BOX 68
Lee's Summit, MO. 64063/816-347-9997

Drawn by: J. Smith, Jr.
Checked by: J. Lovelace

SCALE: 1" = 30'

DATE: 03/13/2017

JOB NO. 17072