## CONSTRUCTION STAKE PLOT PLAN

Ordered by: McGraw Homes Inc.


Description: Lot 385, Park Ridge 8th Plat, in Lee's Summit, MO


Address: 1500 NE Park Springs Terr.

Lot Area 10067 sf

RELEASE FOR CONSTRUCTION
AS NOTED FOR PLAN REVIEW
DEVELOPMENT SERVICES
LEE'S SUMMIT, MISSOURI

06/30/2025

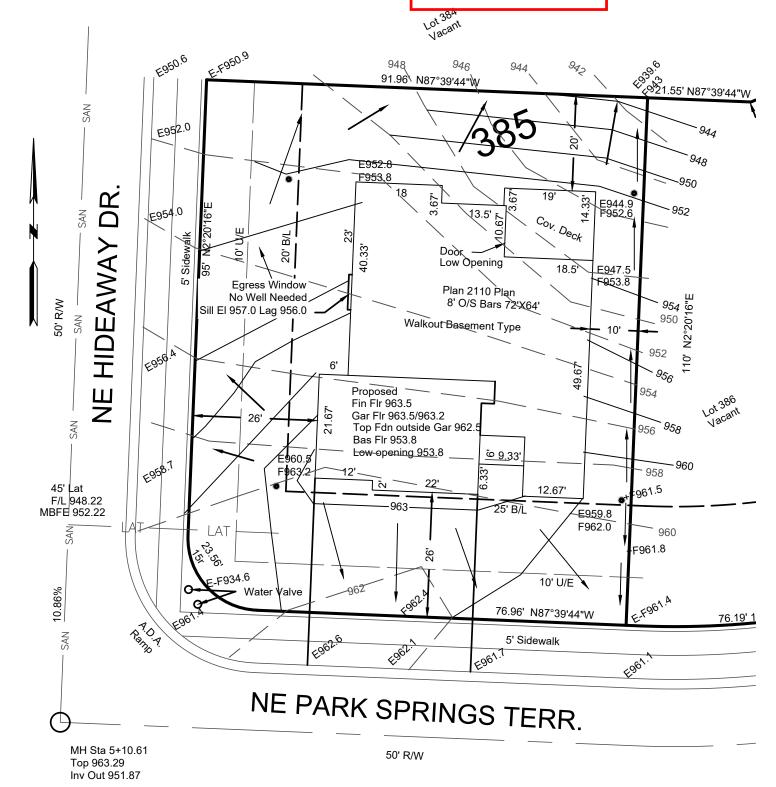

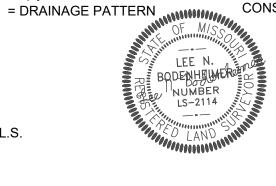

16810-C East 40 Highway

Independence, MO 64055 (816)478-2323 lee@engineeringkc.com SCALE: 1" = 20'

SCALE: 1" = 20' DATE: 06-18-2025 JOB NO: 19480