SCALE 1/4"=1'-0"

THIS HATCH INDICATES NO SPRINKLER

WORK IN THESE AREAS.

1st FLOOR PARTIAL SPRINKLER PLAN

NFPA 13 - OBSTRUCTION CODES: Table 8.6.5.2.2 Suspended or Floor-Mounted Obstructions in Light Hazard Occupancies Only (SSU/SSP) Ceiling or roof **Minimum Vertical Distance** Below Deflector (B) **Horizontal Distance** (A) [in. (mm)] 6 in. (150 mm) or less 3(75)More than 6 in. (150 mm) to 4 (100) 9 in. (225 mm) 6 (150) More than 9 in. (225 mm) to 12 in. (300 mm) More than 12 in. (300 mm) to 8 (200) 15 in. (375 mm) More than 15 in. (375 mm) to 9½ (240) 18 in. (400 mm) More than 18 in. (400 mm) to $12\frac{1}{2}$ (315) FIGURE 8.6.5.2.2 Suspended or Floor-Mounted Obstruction 24 in. (600 mm)

in Light Hazard Occupancies Only (SSU/SSP).

Obstruction

15½ (395)

18 (450)

Ceiling or roof

More than 24 in. (600 mm) to

Note: For *A* and *B*, refer to Figure 8.6.5.2.2.

lo maximum

FIGURE 8.6.5.1.2(c) Obstructions Against Walls (SSU/SSP).

More than 30 in. (750 mm)

Obstruction

24 in. (600 mm)

THREADED LIGHTWALL

THREADED LIGHTWALL

STEEL PIPE

COPPER TUBE

No additional

protection is required

For SI units, 1 in. = 25.4 mm.

30 in. (750 mm)

8.6.6 Clearance to Storage (Standard Pendent and Upright Spray Sprinklers). **8.6.6.1** The clearance between the deflector and the top of storage shall be 18 in. (450 mm) or greater.

8.6.6.2 The 18 in. (450 mm) dimension shall not limit the height of shelving on a wall or shelving against a wall in accordance with 8.6.6, 8.7.6, 8.8.6, and Section 8.9. **8.6.6.2.1** Where shelving is installed on a wall and is not directly below sprinklers, the shelves, including storage thereon, shall be permitted to extend above the level of a plane located 18 in. (450 mm) below ceiling sprinkler deflectors. **8.6.6.2.2** Shelving, and any storage thereon, directly below the sprinklers shall not extend above a plane located 18 in. (450 mm) below the ceiling sprinkler deflectors.

8.6.6.3 Where other standards specify greater clearance to storage minimums, they shall be followed.

> Ceiling Open web steel or wood truss

Elevation View of Truss (Obstruction in horizontal orientation) $A \ge 3C \text{ or } 3D$ $A \le 24 \text{ in. (600 mm)}$ (Use dimension C or D, whichever is greater) FIGURE 8.6.5.1.2(b) Obstruction Against Wall (SSU/SSP).

FIGURE 8.6.5.2.1.3(b) Minimum Distance from an Obstruction in the Horizontal Orientation (SSU/SSP).

RELEASED FOR CONSTRUCTION

Lee's Summit, Missouri

As Noted on Plan Review

Lee's Summit Fire Department 07/17/2025

ER AREA:

CODE SUMMARY

PROJECT CONSTRUCTION PURPOSE: Renovating existing offices into 3 new exam rooms for the ED.

OWNER: Saint Luke's East Hospital 120 NE Saint Luke's Blvd Lee's Summit, MO 64063

> 1710 WYANDOTTE ST. KANSAS CITY, MO 64108 PHONE: (816) 763-9600

<u>LOCAL AUTHORITY:</u>
RESPONDING FIRE SERVICE: CITY OF LEE'S SUMMIT MO

LOCAL BUILDING INSPECTION: CITY OF LEE'S SUMMIT MO

CODE INFORMATION: 2018 INTERNATIONAL BUILDING CODE 2018 INTERNATIONAL PLUMBING CODE 2018 INTERNATIONAL MECHANICAL CODE 2017 NATIONAL ELECTRICAL CODE (NFPA 70) 2018 INTERNATIONAL FIRE CODE

2012 LIFE SAFETY CODE (NFPA 101 CHAPTER 20) 2009 ICC/ANSI A117.1 AS AMENDED AND ADOPTED BY THE CITY OF LEE'S SUMMIT 2010 ADA STANDARDS FOR ACCESSIBLE DESIGN / AMERICANS WITH DISABILITIES ACT OF 1990 STATE OF MISSOURI DEPT. OF HEALTH & ENVIRONMENT REFERENCES THE FOLLOWING

2012 NFPA 101 LIFE SAFETY CODE (LSC) 2018 FGI GUIDELINES FOR DESIGN & CONSTRUCTION OF HOSPITALS & OUTPATIENT FACILITIES NOTE: IF CODE REQUIREMENTS OVERLAP, THE MOST STRINGENT SHALL APPLY

TYPE OF CONSTRUCTION TYPE 1-A -SECTION 602.2 (TYPE 1 - 332 SPRINKLERED - SECTION 18.1.6.1) I-2 -SECTION 308.3 (HEALTHCARE - SECTION 6.1.5) **OCCUPANCY GROUP**:

OCCUPANT LOAD:
TOTAL SQUARE FOOTAGE: SF / = TOTAL NUMBER OF OCCUPANTS = DEAD END CORRIDOR LENGTH LIMIT: EXIT ACCESS TRAVEL DISTANCE: 785+/- SF **AREA OF CONSTRUCTION:**

REQUIRED FIRE RESISTANCE RATINGS (IN HOURS) PER NFPA 101 A.8.2.1.2:

INTERIOR BEARING WALLS PRIMARY STRUCTURAL FRAME 3 HR FLOOR CONSTRUCTION 1 1/2 HR ROOF CONSTRUCTION INTERIOR NON-BEARING WALLS 0 HR

PLUMBING FIXTURE CALCULATIONS: EXISTING TO REMAIN NO CHANGE IN OCCUPANCY

<u>ACTIVE FIRE SAFETY FEATURES:</u>
- FIRE ALARM SYSTEM - THE FIRE ALARM SYSTEM IS SPECIFIED AS AN ADDRESSABLE TYPE SYSTEM. THE DEVICE TYPE AND LOCATIONS ARE PER THE APPLICABLE CODES AS WELL AS ADA REQUIREMENTS.

SMOKE CONTROL SYSTEM - ALL DUCTWORK PENETRATING SMOKE RATED WALLS WILL HAVE A SMOKE OR COMBINATION FIRE/SMOKE DAMPER AS INDICATED ON CONSTRUCTION DOCUMENTS. THESE DAMPERS WILL CLOSE UPON DETECTION OF SMOKE BY THE AREA SMOKE DETECTORS OR DUCT SMOKE DETECTORS IN THE AIR HANDLING UNITS.

FIRE SPRINKLER SYSTEM - SPECIFIED TO BE PER NFPA 13. THE SPRINKLER HEADS ARE SPECIFIED TO BE QUICK RESPONSE TYPE.

EMERGENCY LIGHTING AND POWER - EMERGENCY LIGHTING, LIFE SAFETY AND CRITICAL LOADS WILL RECEIVE POWER FROM A BACKUP GENERATOR LOCATED OUTSIDE THE MAIN

- ILLUMINATED EXIT SIGNS

ELECTRICAL ROOM.

PASSIVE FIRE SAFETY FEATURES:

SMOKE COMPARTMENTS NO GREATER THAN 22,500 SF

GENERAL NOTES:

ALL FITTINGS CONFORM TO SECTION 2-4 OF NFPA PAMPHLET 13.

VALVES ON CONNECTIONS TO WATER SUPPLIES, SECTIONAL CONTROL VALVES AND OTHER VALVES IN SUPPLY PIPES TO SPRINKLERS SHALL BE SUPERVISED OPEN BY AN APPROVED METHOD.

IT IS THE OWNERS RESPONSIBILITY TO PROVIDE ADEQUATE HEAT TO KEEP THE SPRINKLER SYSTEM FROM FREEZING.

ALL ELECTRICAL WIRING OF ALARM BELLS. FLOW SWITCHES AND TAMPER SWITCHES (IF REQUIRED) TO BE DONE BY OTHERS.

THE SPRINKLER SYSTEM TO BE INSTALLED IN ACCORDANCE WITH NFPA 13.

HANGERS TO BE SPACED TO MEET NFPA REQUIREMENTS

PER NFPA 13, SECTION 8.6.3.2.4, WITHIN SMALL ROOMS AS DEFINED IN SECTION 3.3.20, SPRINKLERS SHALL BE PERMITTED TO BE LOCATED NOT MORE THAN 9 FT. FROM ANY SINGLE WALL, AND SPRINKLER SPACING LIMITATIONS OF SECTION 8.6.3 AND AREA LIMITATIONS OF TABLE 8.6.2.2.1(a) SHALL NOT BE EXCEEDED. JFS MAY MODIFY HEADS SHOWN ON THIS DRAWING TO COMPLY WITH THIS RULE.

- € = CENTER LINE OF PIPE BELOW TOP OF STEEL
- EL = CENTER LINE OF PIPE ABOVE FINISHED FLOOR

CONSTRUCTION: CONCRETE SLAB, CONCRETE BEAMS AND TEES

PLAN NOTES:

- 1. ALL CEILING HEIGHTS ARE TO BE 9'-0" UNLESS NOTED OTHERWISE
- 2. SPRINKLERS WILL BE CENTERED IN CEILING TILES WHERE POSSIBLE YET NEVER ANY CLOSER THAN 6" FROM GRID.
- 3. ALL THREADED PIPING IS TO BE ALLIED "SCHEDULE 40" WITH THREADED CAST IRON FITTINGS.
- 4. ALL GROOVED PIPING IS TO BE SCH. 10 PIPE, ASTM A-795 WITH ROLLED GROOVED ENDS. ALL FITTINGS TO BE IRON GROOVED OR WELDED STEEL OUTLETS.

8.6.5.2.2.1 IN LIGHT HAZARD OCCUPANCIES, PRIVACY CURTAINS SHALL NOT BE CONSIDERED OBSTRUCTIONS WHERE ALL OF THE FOLLOWING AREA MET: (1) THE CURTAINS ARE SUPPORTED BY FABRIC MESH ON CEILING TRACK (2) OPENINGS IN THE MESH ARE EQUAL TO 70 PERCENT OR GREATER. (3) THE MESH EXTENDS A MINIMUM OF 22 INCHES DOWN FROM CEILING.

DESIGN CRITERIA:

BUILDING CODE: SEE CODE SUMMARY

OCCUPANCY: SEE CODE SUMMARY


TYPE OF CONSTRUCTION: SEE CODE SUMMARY

AREA OF CONSTRUCTION: SEE CODE SUMMARY

PER NFPA 13, 2016 EDITION:

SYSTEM TYPE: WET (EXISTING)

CORRIDOR, EXAM ROOMS, OFFICES, ETC... LIGHT HAZARD MAXIMUM 225 S.F. SPRINKLER SPACING (STANDARD SPRINKLER) 100 GPM HOSE ALLOWANCE

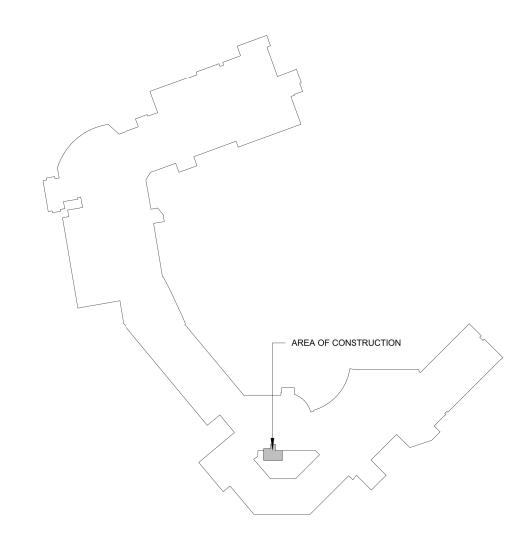



MISSOURI PE COA #201602567 Engineering, LLC

1624 N Glen Ellyn
Independence, MO 64056




SSUE DATE: 09/13/2024 PLOT DATE: 09/13/2024 FIRE PROTECTION SPRINKLER RELOCATION

 $A \ge (D - 8 \text{ in.}) + B$ [$A \ge (D - 200 \text{ mm}) + B$]

where: $D \le 30$ in. (750 mm)

Elevation View

HANGER SPACING TABLE " 1¼" 1½" 2" 2½" 3" 3½" 4" 5" 6" 8" NOMINAL PIPE SIZE | ¾" | | 5-6 | 6-0 | 6-6 | 7-0 | 8-0 | 9-0 | 10-0 | N/A | N/A | N/A | N/A | N/A

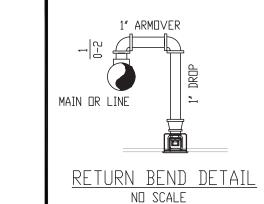

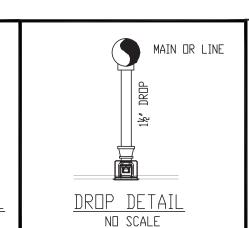


Table 8.6.5.1.2 Positioning of Sprinklers to Avoid

Maximum Allowable

Distance of Deflector Above

Bottom of Obstruction (B)

[in. (mm)]

0(0)

 $2\frac{1}{2}$ (65)

3½ (90)

5½ (140)

 $7\frac{1}{2}$ (190)

9½ (240)

12 (300)

14 (350)

16½ (420)

18 (450)

20 (510)

24 (600)

30 (750)

35 (875)

Obstructions to Discharge [Standard Spray

Upright/Standard Spray Pendent (SSU/SSP)]

Distance from Sprinklers to

Side of Obstruction (A)

1 ft (300 mm) to less than 1 ft

1 ft 6 in. (450 mm) to less than

2 ft (600 mm) to less than 2 ft

2 ft 6 (750 mm) in. to less than

3 ft (900 mm) to less than 3 ft

3 ft 6 in. (1.1 m) to less than

4 ft (1.2 m) to less than 4 ft

4 ft 6 in. (1.4 m) to less than

5 ft (1.5 m) to less than 5 ft

5 ft 6 in. (1.7 m) to less than

6 ft (1.8 m) to less than 6 ft

6 ft 6 in. (2.0 m) to less than

7 ft (2.1 m) to less than 7 ft

For SI units, 1 in. = 25.4 mm; 1 ft = 0.3048 m. Note: For A and B, refer to Figure 8.6.5.1.2(a).

Ceiling

Elevation View

FIGURE 8.6.5.1.2(a) Positioning of Sprinkler to Avoid Ob-

struction to Discharge (SSU/SSP).

Less than 1 ft (300 mm)

6 in. (450 mm)

2 ft (600 mm)

6 in. (750 mm)

3 ft (900 mm)

6 in. (1.1 m)

4 ft (1.2 m)

6 in. (1.4 m)

5 ft (1.5 m)


6 in. (1.7 m)


6 ft (1.8 m)


6 in. (2.0 m)

7 ft (2.1 m)

6 in. (2.3 m)

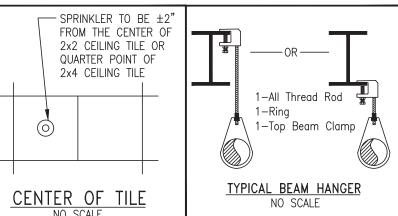

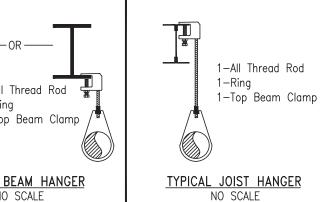

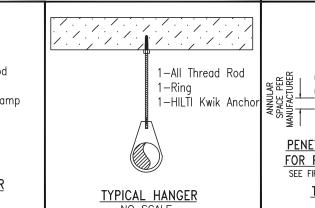

TYPICAL HANGER
NO SCALE

COMPATIBLE.** FIRE STOP CAULK BEAD FIRE STOP PENETRATION FIRESTOP DETAIL FOR RATED CONSTRUCTION ONLY TYP. FIRESTOP DETAIL

**SEALANTS USED FOR CPVC MATERIALS SHALL BE FBC SYSTEM SEE FIRE STOP SUPPLEMENT SHEETS FOR INFO PIPE END CAP

**ALL SPRINKLER PIPING PASSING

THROUGH FIRE RATED ASSEMBLIES

FIRE STOPPING MATERIAL SHALL BE

SUITABLE FOR THE PIPE MATERIAL

IN USE AND THE ASSEMBLY

PENETRATED.**

LEGEND DESCRIPTION SYMBOL ETR EXISTING SPRINKLER TO REMAIN SYMBOL R EXISTING SPRINKLER TO BE RELOCATED/REPLACED EXISTING SPRINKLER TO BE ADDED NEW SPRINKLER TO BE INSTALLAED SEMI-RECESSED PENDENT TO BE CHANGED TO CONCEALED FIRE SPRINKLER STANDPIPE NEW SPRINKLER LINE — EXISTING SPRINKLER LINE HANGER LOCATION

SHALL BE FIRESTOPPED BY OTHERS. | OF THE SPRINKLER HEADS AND SHOW THE INTENT

THE DRAWING INDICATES A "SCHEMATIC LAYOUT"

OF THE DESIGN. EXACT LOCATIONS SHALL BE

COORDINATED WITH OTHER TRADES, FIELD

VERIFIED, AND INSTALLED TO MEET NFPA 13 COVERAGE REQUIREMENTS FOR THE SPACE. 816-516-9540 SPRINKLER LEGEND SIN # FINISH TEMP. ORIFICE K-FACTOR VK462 WHITE VIKING MIRAGE Q.R. CONCEALED PENDENT

G

umm

9-16-2024 CHRISTOPHER T. GROSS

CHECKED BY: SB

FLOOR PLAN

1 OF 1