
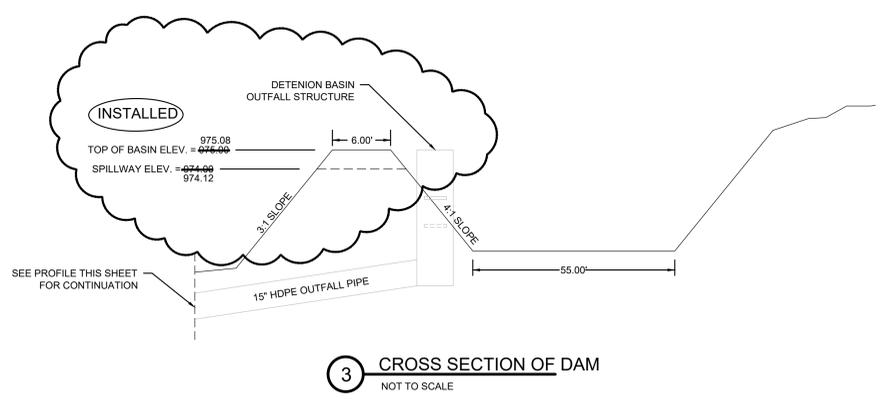
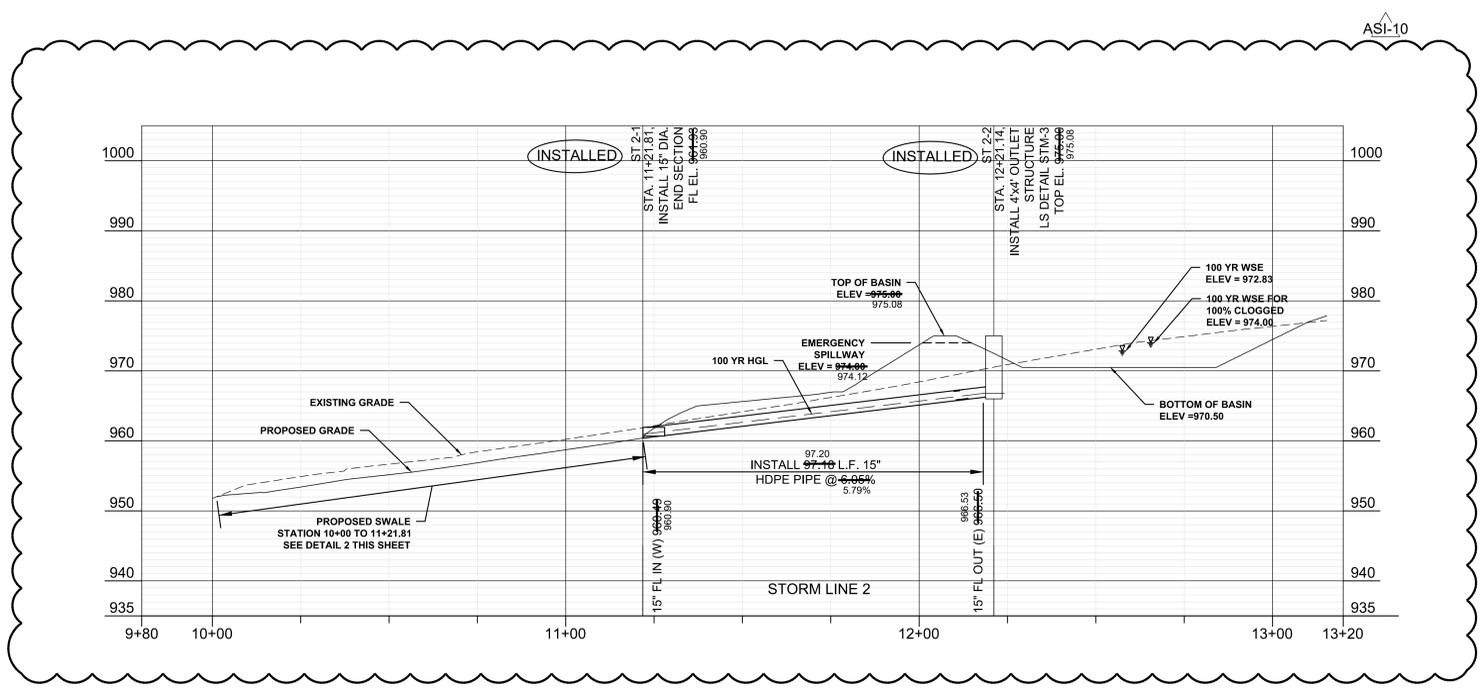
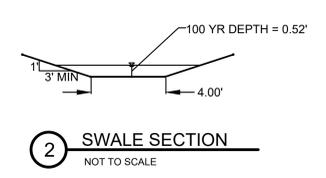


NOTE: DETENTION BASIN TO BE CONSTRUCTED ALONG WITH EROSION AND SEDIMENT CONTROL DEVICES AND PRIOR TO BUILDING AND PARKING LOT. AN AS-BUILT DRAWING SHALL BE SUBMITTED TO THE CITY FOR REVIEW AND ACCEPTANCE PRIOR TO ISSUANCE OF ANY CERTIFICATE OF OCCUPANCY

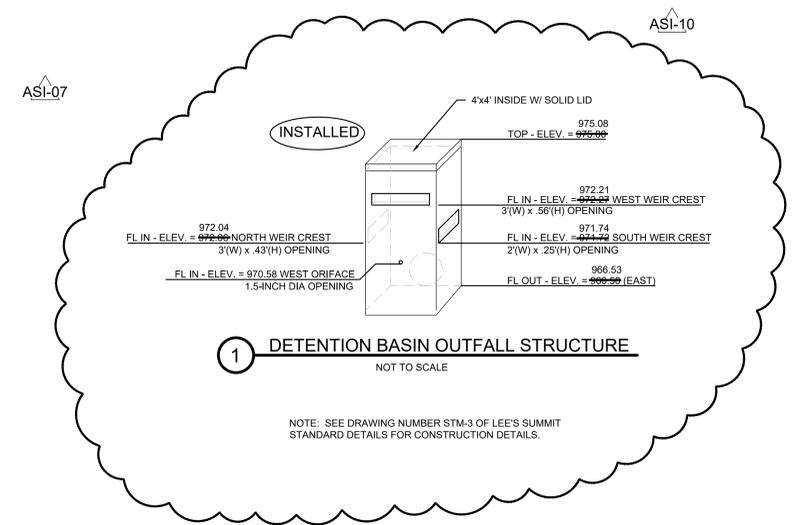


"AS-BUILT DRAWING"

DATE: AUGUST 25, 2025

NOTE: THE BOLD TYPE ON THIS SHEET INDICATES "AS-BUILT" INFORMATION THAT HAS BEEN ADDED TO THE SHEET AFTER CONSTRUCTION WAS COMPLETED.

ASI-03

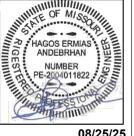

ARCHITECT
DLR GROUP
7290 W 133RD ST.
OVERLAND PARK, KS 66213
P: (913) 897-7811 F: (402) 330-2740

STRUCTURAL ENGINEER
DLR GROUP
7290 W 133RD ST.
OVERLAND PARK, KS 66213
P: (913) 897-7811 F: (402) 330-2740

MEP ENGINEERS
DLR GROUP
7290 W 133RD ST.
OVERLAND PARK, KS 66213
P: (913) 897-7811 F: (402) 330-2740

CIVIL ENGINEER
TALAMERICO & BROWNE
1020 E. 8TH ST.
KANSAS CITY, MO 64106
P: (816) 263-3456

AVIATELECOM/ACOUSTICS/
SECURITY DESIGNER
BRANCH/PATTERSON
1588 GRAND BOULEVARD
KANSAS CITY, MO 64108
P: (816) 531-2121

100%
CONSTRUCTION
DOCUMENTS
04.30.24

REVISIONS

ASI-03	07.17.24
ASI-07	12.18.24
ASI-10	08.25.25

13-23128-00
STORMWATER
DETENTION
DETAILS