

LEE'S SUMMIT HYUNDAI PREMIER AUTO OUTLET
1231 NW WARD ROAD
LEES SUMMIT, MISSOURI 64086

DRAWINGS NOT FOR CONSTRUCTION UNLESS PROFESSIONAL STAMP, SIGNATURE & DATE IS PROVIDED



DRAWN BY: [Signature]
CHECKED BY: [Signature]

FALK ARCHITECTS
© 2023 Falk Architects Inc.


C104A
Civil Addendum #4
12/18/2025

PLAN SHEET
ASI #7 - 12/18/25

FALK ARCHITECTS INC




4501 NW Oakley Ave, Suite 232 | Topeka, KS 66618
Phone: 785.806.2806 | www.unitedeng.com

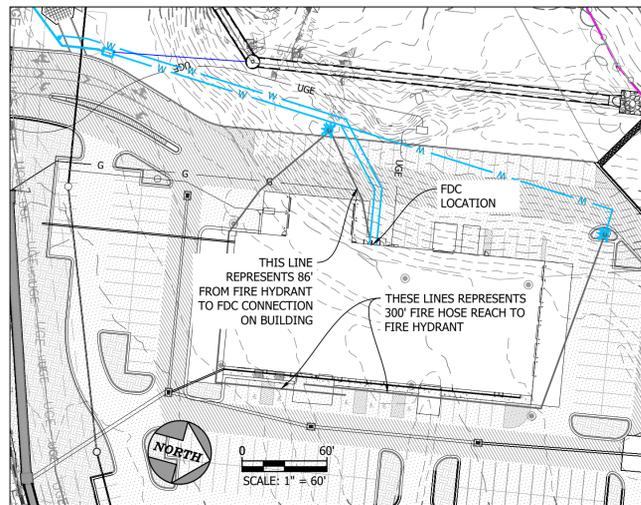

RELEASED FOR CONSTRUCTION
As Noted on Plan Review
Development Services Department
Lee's Summit, Missouri
12/18/2025

- NOTES**
- CONTRACTOR IS REQUIRED TO NOTIFY CITY OF LEE'S SUMMIT A MINIMUM OF 48 HOURS PRIOR TO ANY TRAFFIC DISRUPTIONS, SUBMIT TRAFFIC CONTROL PLAN IF REQUIRED, ERECT TRAFFIC CONTROL, AND MAINTAIN TRAFFIC CONTROL FOR THE DURATION OF THE TRAFFIC DISRUPTIONS.
 - CONTRACTOR TO MAKE APPLICATION TO THE CITY OF LEE'S SUMMIT FOR WATER LINE CONNECTION AND METER PERMIT. CONTRACTOR SHALL PAY FEES ASSOCIATED WITH WATER LINE CONNECTION AND METER.

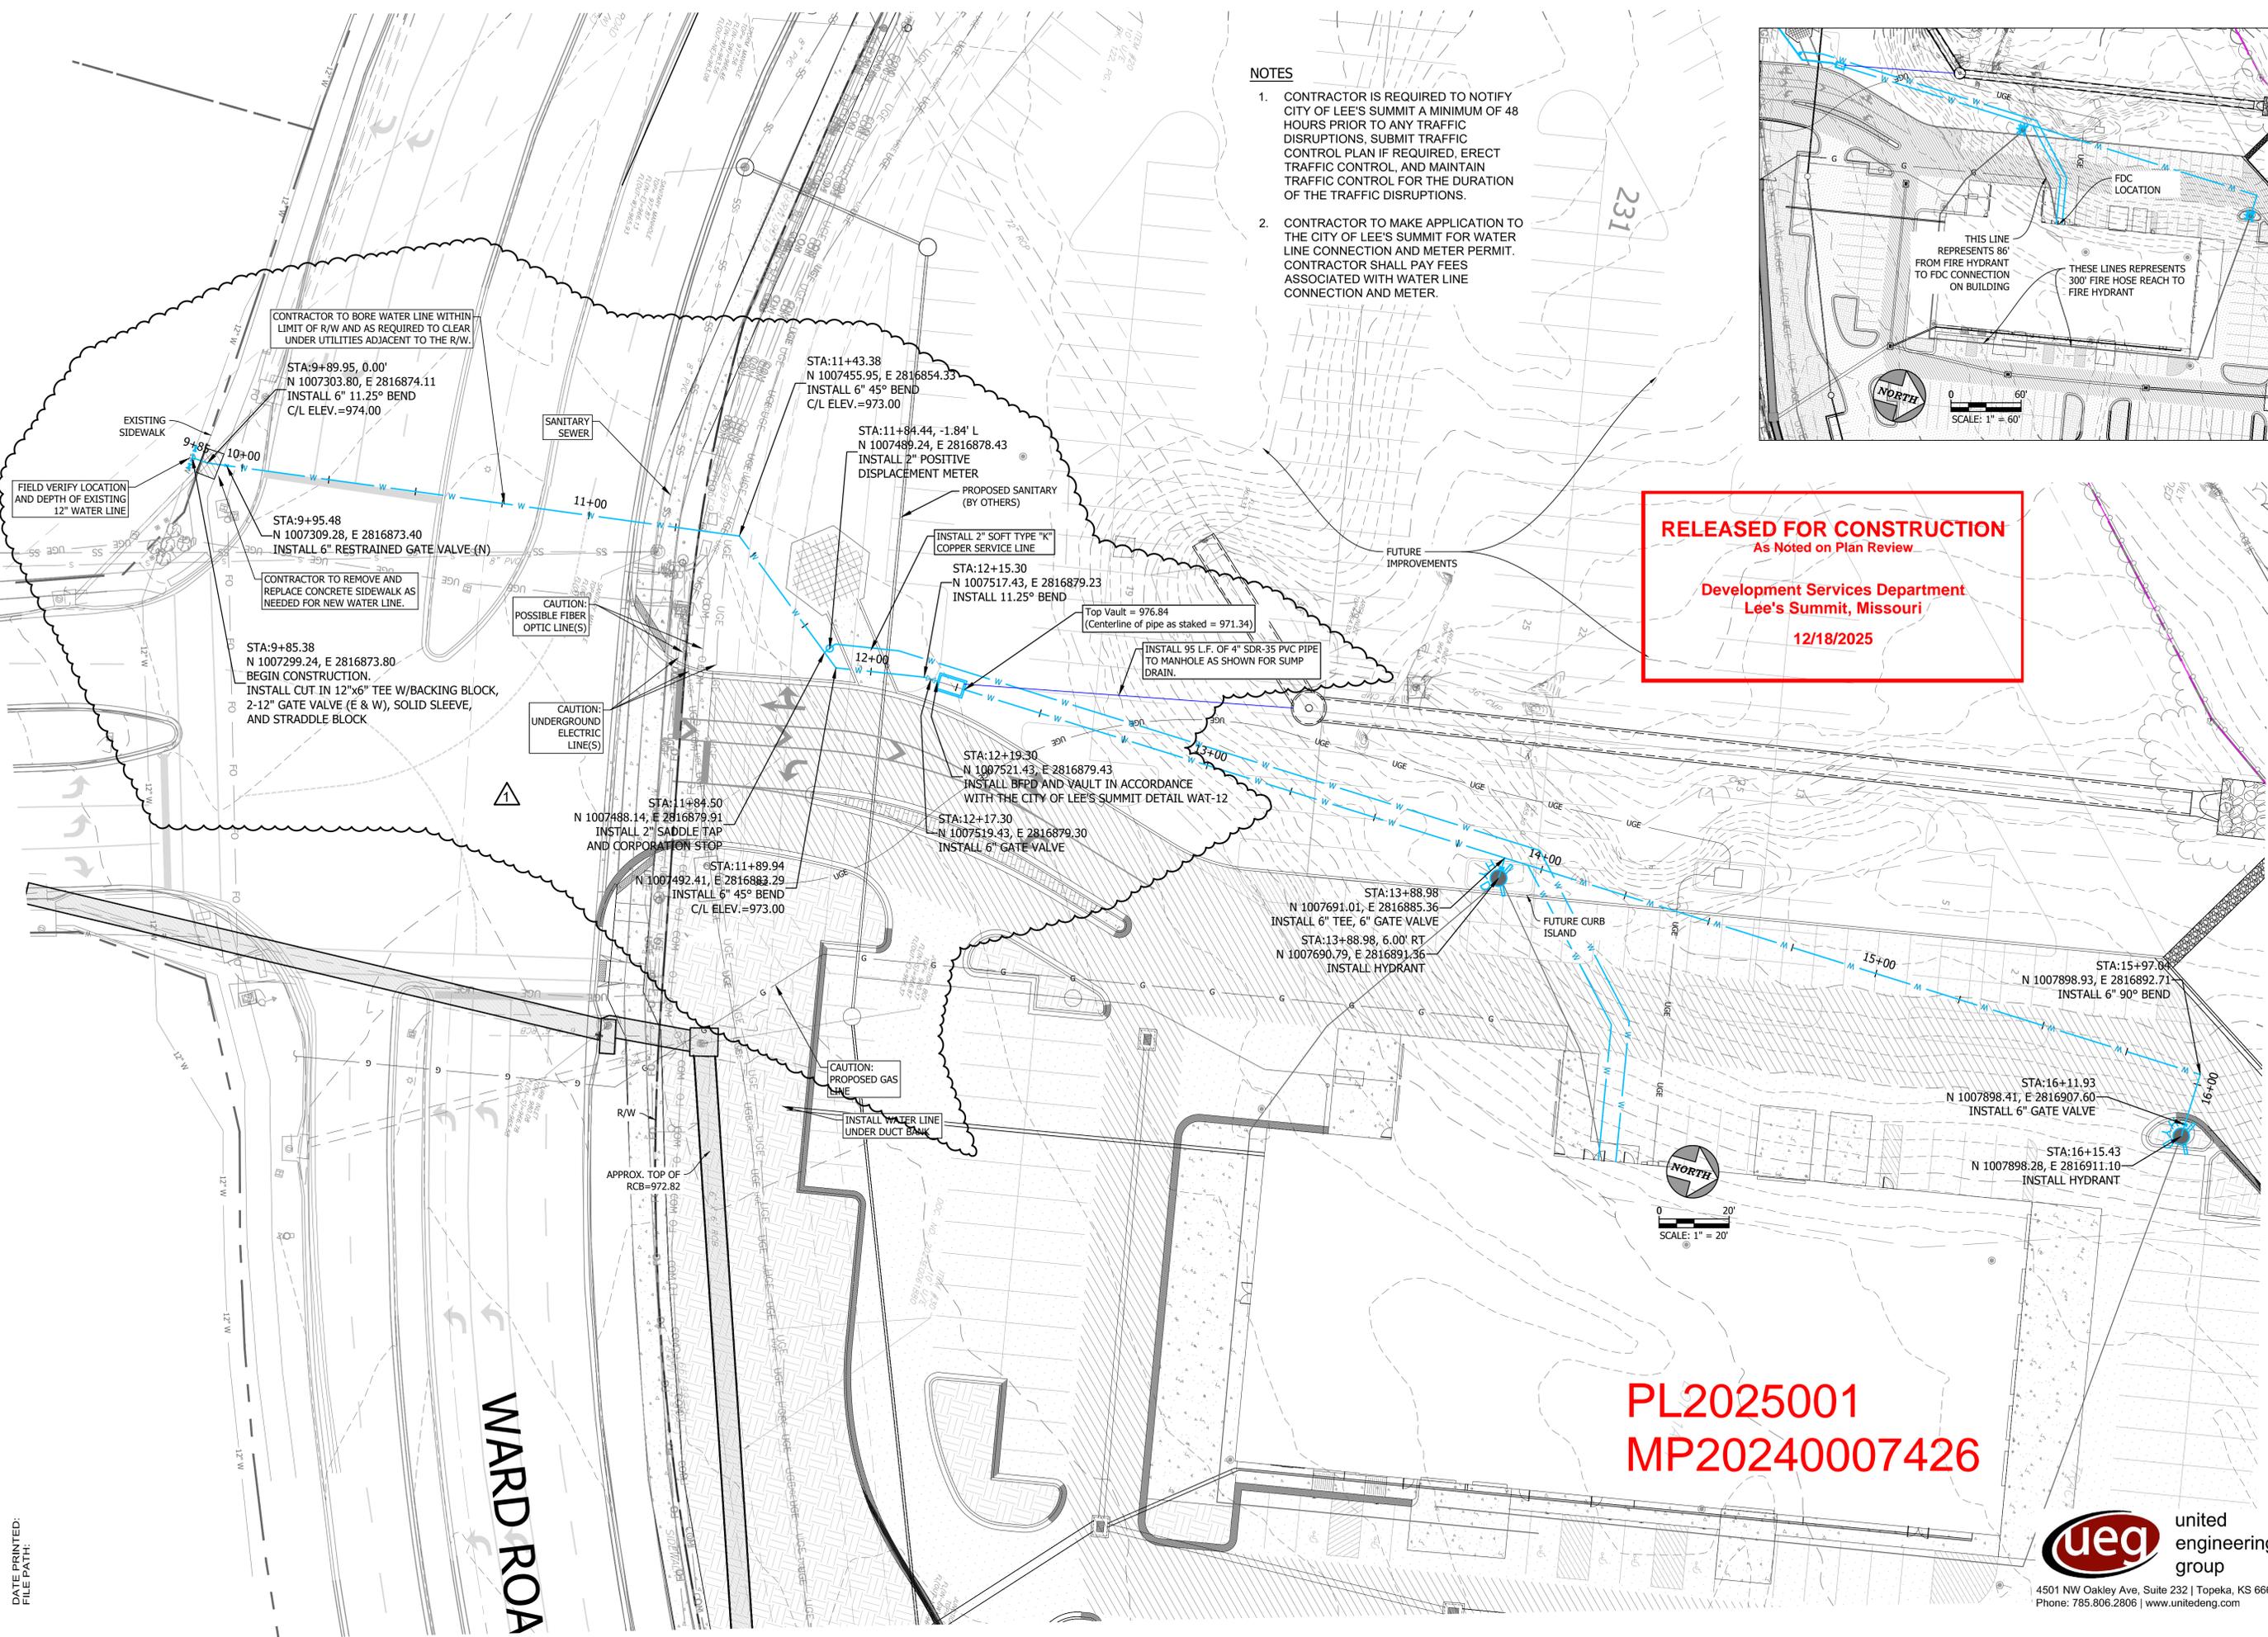

PL2025001
MP20240007426

DATE PRINTED:
FILE PATH:

WARD ROAD