

DEDICATION:
THE UNDERSIGNED OWNERS OF THE TRACT OF LAND DESCRIBED HEREIN HAS CAUSED THE SAME TO BE SUBDIVIDED IN THE MANNER SHOWN ON THE ACCOMPANYING PLAT. SAID SUBDIVISION AND PLAT SHALL HEREAFTER BE KNOW AS

THE RESERVE AT STONEY CREEK 3rd PLAT - LOTS 60 - 110 & TRACT L thru N

EASEMENTS:

AN EASEMENT OR LICENSE IS HEREBY GRANTED TO CITY OF LEE'S SUMMIT, MISSOURI TO LOCATE, CONSTRUCT, AND MAINTAIN, OR TO AUTHORIZE THE LOCATION, CONSTRUCTION AND MAINTENANCE OF POLES, WIRES, ANCHORS, CONDUITS, AND/OR STRUCTURES FOR WATER, GAS, SANITARY SEWER, STORM SEWER, SURFACE DRAINAGE CHANNEL, ELECTRICITY, TELEPHONE, CABLE TELEVISION, OR ANY OTHER NECESSARY PUBLIC UTILITY OR SERVICES, ANY OR ALL OF THEM, UPON, OVER, OR UNDER THOSE AREAS OUTLINED OR DESIGNATED UPON THIS PLAT AS "UTILITY EASEMENTS" (U/E) OR WITHIN ANY STREET OR THOROUGHFARE DEDICATED TO PUBLIC USE ON THIS PLAT. GRANTOR, ON BEHALF OF HIMSELF, HIS HEIRS, HIS ASSIGNS AND SUCCESSORS IN INTEREST, HEREBY WAIVES, TO THE FULLEST EXTENT ALLOWED BY LAW, INCLUDING, WITHOUT LIMITATION, SECTION 527.1888 RSMo. (2006), ANY RIGHT TO REQUEST RESTORATION OF RIGHTS PREVIOUSLY TRANSFERRED AND VACATION OF THE EASEMENT HEREIN GRANTED.

BUILDING LINES:

BUILDING LINES OR SETBACK LINES ARE HEREBY ESTABLISHED AS SHOWN ON THE ACCOMPANYING PLAT AND NO BUILDING OR PORTION THEREOF SHALL BE CONSTRUCTED BETWEEN THIS LINE AND THE STREET RIGHT OF WAY LINE.

STREETS:

THE STREETS AND/OR THOROUGHFARES SHOWN ON THIS PLAT AND NOT HERETOFORE DEDICATED TO PUBLIC USE ARE HEREBY SO DEDICATED.

MASTER DRAINAGE PLAN

INDIVIDUAL LOT OWNER(S) SHALL NOT CHANGE OR OBSTRUCT THE DRAINAGE FLOW PATHS ON THE LOTS AS SHOWN ON THE MASTER DRAINAGE PLAN, UNLESS SPECIFIC APPLICATION IS MADE AND APPROVED BY THE CITY ENGINEER.

SIDEWALKS

SIDEWALKS ALONG THE SOUTH SIDES OF OF TRACT M AND N SHALL BE CONSTRUCTED BY THE DEVELOPER

COMMON AREA

TRACT L, M AND N IS COMMON AREA TO BE OWNED AND MAINTAINED BY STONEY CREEK ESTATES HOME OWNERS ASSOCIATION, INC. AREA L IS TO BE USED FOR DETENTION AND BMP FACILITIES AND M AND N ARE TO BE USED FOR LANDSCAPING.

IN TESTIMONY WHEREOF:

CMH PARKS, INC., A TENNESSEE CORPORATION, HAS CAUSED THESE PRESENTS TO BE SIGNED BY ITS MEMBER THIS _____ DAY OF _____, 2016.

CMH PARKS, INC., A TENNESSEE CORPORATION.

FREDERICK J. DELIBERO, MEMBER

NOTARY CERTIFICATION:

STATE OF _____

COUNTY OF _____

ON THIS _____ DAY OF _____, 2017, BEFORE ME, THE UNDERSIGNED NOTARY PUBLIC, PERSONALLY APPEARED **FREDERICK J. DELIBERO**, TO ME PERSONALLY KNOWN AND WHO BEING BY ME DULY SWORN BY ME DID SAY THAT HE IS A MEMBER OF CMH PARKS, INC., A TENNESSEE CORPORATION, AND THAT SAID INSTRUMENT WAS SIGNED ON BEHALF OF SAID COMPANY AND AS THE FREE ACT AND DEED OF SAID COMPANY.

IN WITNESS THEREOF:

I HAVE HEREUNTO SET MY HAND AND AFFIXED MY SEAL THE DATE LAST WRITTEN ABOVE.

NOTARY PUBLIC

MY COMMISSION EXPIRES: _____

THE RESERVE AT STONEY CREEK -3RD PLAT BOUNDARY DESCRIPTION

ALL THAT PART OF THE SOUTHWEST ¼ OF SECTION 36, TOWNSHIP 47 NORTH, RANGE 32 WEST, IN LEE'S SUMMIT, JACKSON COUNTY, MISSOURI AND BEING MORE PARTICULARLY DESCRIBED AS FOLLOWS:

BEGINNING AT THE NORTHWEST CORNER OF LOT 17, MANOR AT STONEY CREEK 1ST PLAT, A SUBDIVISION AS RECORDED IN THE OFFICE OF THE RECORDER, JACKSON COUNTY, MISSOURI; THENCE SOUTH 87° 46' 58" EAST, ALONG THE NORTH LINE OF SAID LOT 17, A DISTANCE OF 179.47 FEET; THENCE SOUTH 02° 13' 02" WEST, A DISTANCE OF 11.37 FEET; THENCE SOUTH 87° 58' 58" EAST, A DISTANCE OF 617.78 FEET; THENCE SOUTH 87° 26' 13" EAST, A DISTANCE OF 60.60 FEET; THENCE SOUTH 88° 00' 07" EAST, A DISTANCE OF 493.72 FEET; THENCE NORTH 01° 59' 53" EAST, A DISTANCE OF 82.86 FEET; THENCE NORTH 02° 39' 59" WEST, A DISTANCE OF 83.99 FEET; THENCE NORTH 14° 04' 47" WEST, A DISTANCE OF 50.00 FEET; THENCE NORTH 75° 55' 13" EAST, A DISTANCE OF 14.21 FEET; THENCE NORTH 14° 04' 47" WEST, A DISTANCE OF 111.57 FEET; THENCE SOUTH 75° 55' 13" WEST, A DISTANCE OF 136.76 FEET; THENCE NORTH 88° 00' 07" WEST, A DISTANCE OF 281.41 FEET; THENCE NORTH 02° 01' 02" EAST, A DISTANCE OF 30.15 FEET; THENCE NORTH 75° 58' 58" WEST, A DISTANCE OF 60.00 FEET; THENCE NORTH 87° 03' 53" WEST, A DISTANCE OF 331.36 FEET; THENCE NORTH 68° 05' 42" WEST, A DISTANCE OF 494.84 FEET; THENCE NORTH 02° 13' 02" EAST, A DISTANCE OF 156.77 FEET; THENCE NORTH 87° 58' 42" WEST, A DISTANCE OF 329.41 FEET; THENCE SOUTH 02° 12' 45" WEST, A DISTANCE OF 103.27 FEET; THENCE NORTH 87° 54' 29" WEST, A DISTANCE OF 583.98 FEET; THENCE SOUTH 02° 05' 39" WEST, A DISTANCE OF 120.00 FEET; THENCE SOUTH 01° 15' 28" EAST, A DISTANCE OF 50.09 FEET; THENCE SOUTH 02° 05' 39" WEST, A DISTANCE OF 135.00 FEET; THENCE NORTH 87° 54' 21" WEST, A DISTANCE OF 59.77 FEET; THENCE SOUTH 02° 04' 35" WEST, A DISTANCE OF 50.00 FEET; THENCE SOUTH 87° 54' 21" EAST, A DISTANCE OF **129.90** FEET; THENCE ALONG A CURVE TO THE RIGHT TANGENT TO THE PRECEDING COURSE HAVING A RADIUS OF **15.01 FEET**, AN ARC DISTANCE OF **23.57**; THENCE SOUTH 87° 54' 16" EAST, A DISTANCE OF 50.00 FEET; THENCE ALONG A CURVE TO THE RIGHT, HAVING AN INITIAL TANGENT BEARING NORTH 02° 11' 20" EAST, A RADIUS OF 15.00 FEET, AN ARC DISTANCE OF 23.56 FEET; THENCE SOUTH 87° 54' 21" EAST, A DISTANCE OF **259.57** FEET; THENCE ALONG A CURVE TO THE RIGHT, HAVING A RADIUS OF 15.00 FEET, AN ARC DISTANCE OF 23.56 FEET; THENCE SOUTH 87° 54' 16" EAST, A DISTANCE OF 50.00 FEET; THENCE ALONG A CURVE TO THE RIGHT, HAVING AN INITIAL TANGENT BEARING NORTH 02° 05' 30" EAST, A RADIUS OF 15.00 FEET, AN ARC DISTANCE 23.56 FEET; THENCE SOUTH 87° 54' 21" EAST, A DISTANCE OF **85.43** FEET; THENCE ALONG A CURVE TO THE RIGHT, HAVING A RADIUS OF **474.91 FEET**, A DISTANCE OF **159.04 FEET**; THENCE ALONG A CURVE TO THE RIGHT, A RADIUS **15.39 FEET**, A DISTANCE OF **23.77 FEET**; THENCE SOUTH 68° 44' 14" EAST, A DISTANCE OF **52.40 FEET**; THENCE ALONG A CURVE TO THE RIGHT, HAVING AN INITIAL TANGENT BEARING NORTH 21° 17' 41" EAST, A RADIUS OF **15.02 FEET**, AN ARC DISTANCE OF **22.58** FEET; THENCE ALONG A REVERSE CURVE, HAVING A RADIUS OF 525.00 FEET, AN ARC DISTANCE OF 102.84 FEET; THENCE **SOUTH 02° 12' 45" WEST**, A DISTANCE OF 109.22 FEET TO THE POINT OF BEGINNING

THE ABOVE DESCRIBED TRACT CONTAINS 833,910.93 SQUARE FEET (19.14 ACRES) MORE OR LESS AND IS SUBJECT TO ALL EASEMENTS, RESTRICTIONS, RESERVATIONS, COVENANTS, CONDITIONS AND RIGHT OF WAYS, RECORDED OR UNRECORDED IF ANY.

SURVEY AND PLAT NOTES:

- THE FOLLOWING STANDARD MONUMENTS WILL BE SET:
 - SEMI-PERMANENT MONUMENTS:
SET 1/2" IRON BAR WITH PLASTIC CAP MARKED "ENGR 8319" AT ALL REAR LOT CORNERS AND CURBS ARE NOTCHED AT THE PROJECTION OF SIDE LOT LINES.
 - PERMANENT MONUMENTS:
SET 5/8" IRON BAR WITH ALUMINUM CAP MARKED "ENGR 8319" AT PLAT BOUNDARY CORNERS.
- THIS PROPERTY IS CLASSIFIED SUBURBAN PROPERTY (4 CSR 30-17.0020)
- BEARINGS AND COORDINATES ARE BASED ON KANSAS CITY METRO MONUMENT CA-08 OF THE MISSOURI STATE COORDINATE SYSTEM OF 1983 MISSOURI WEST ZONE, 2003 ADJUSTMENT USING A GRID FACTOR OF 0.9998997. COORDINATES IMPACTED BY GPS METHODS.
- NO OIL OR GAS WELLS ARE KNOWN TO EXIST ON THIS PROPERTY, PER THE "ENVIRONMENTAL IMPACT STUDY OF ABANDONED OIL AND GAS WELLS IN LEE'S SUMMIT, MISSOURI". BY EDWARD ALTON, JR., P.E., 1995.
- THE SUBJECT PROPERTY SURVEYED LIES WITHIN A FLOOD ZONE DESIGNATED ZONE (X), AREAS LOCATED OUTSIDE THE 100 YEAR FLOOD PLAIN, PER F.E.M.A. MAP, PANEL NO. 406 OF 480, COMMUNITY PANEL NO. 29095C0406 F EFFECTIVE DATE: SEPTEMBER 29, 2006.
- ALL STORM WATER CONVEYANCE, RETENTION, DETENTION OR WATER QUALITY(BMP) FACILITIES TO BE LOCATED ON COMMON PROPERTY SHALL BE OWNED AND MAINTAINED BY THE PROPERTY OWNERS' ASSOCIATION IN ACCORDANCE WITH THE STANDARDS SET FORTH IN THE "COVENANTS, CONDITIONS AND RESTRICTIONS." REFER TO THE "COVENANTS, CONDITIONS AND RESTRICTIONS ASSOCIATED WITH THIS DEVELOPMENT FOR REQUIREMENTS
- INDIVIDUAL LOT OWNER(S) SHALL NOT CHANGE OR OBSTRUCT THE DRAINAGE FLOW PATHS ON THE LOTS AS SHOWN ON THE MASTER DRAINAGE PLAN, UNLESS SPECIFIC APPLICATION IS MADE AND APPROVED BY THE CITY ENGINEER.

FINAL PLAT
The Reserve at Stoney Creek - 3rd Plat
Lots 60 Thru 110 & Tracts L thru N
Lee's Summit, Jackson County, Missouri

CITY OF LEE'S SUMMIT:

MAYOR AND CITY COUNCIL CERTIFICATION:

THIS IS TO CERTIFY THAT THE ACCOMPANYING PLAT OF THE MANOR AT STONEY CREEK 3RD PLAT, LOTS 82 - 108 WAS SUBMITTED TO AND DULY APPROVED BY THE MAYOR AND CITY COUNCIL OF THE CITY OF LEE'S SUMMIT, MISSOURI THIS _____ DAY OF _____, 20____, BY ORDINANCE NO. _____

RANDALL L. RHOADS, MAYOR DATE

DENISE R. CHISUM, MMC CITY CLERK DATE

**APPROVED:
PUBLIC WORKS / ENGINEERING**

GEORGE M BINGER, III P.E., CITY ENGINEER DATE

PLANNING & CODES ADMINISTRATION

ROBERT G. MCKAY, AICP, DIRECTOR OF PLANNING AND SPECIAL PROJECTS DATE



PLANNING COMMISSION

DANA ARTH, SECRETARY DATE

JACKSON COUNTY:

APPROVED: ASSESSOR'S OFFICE

JACKSON COUNTY ASSESSOR DATE

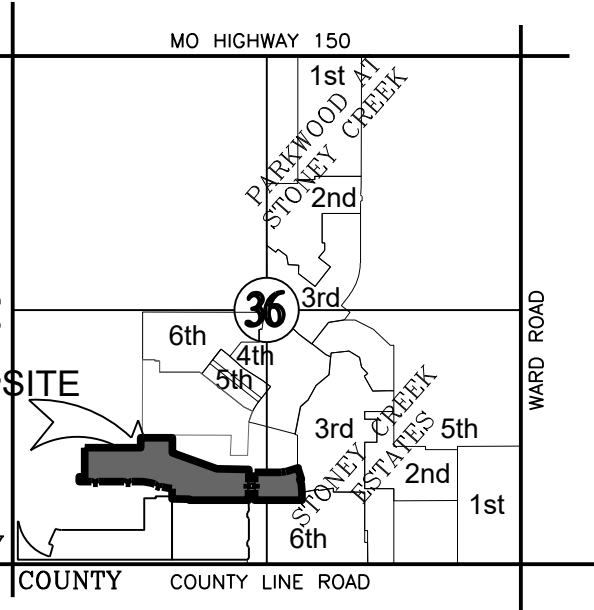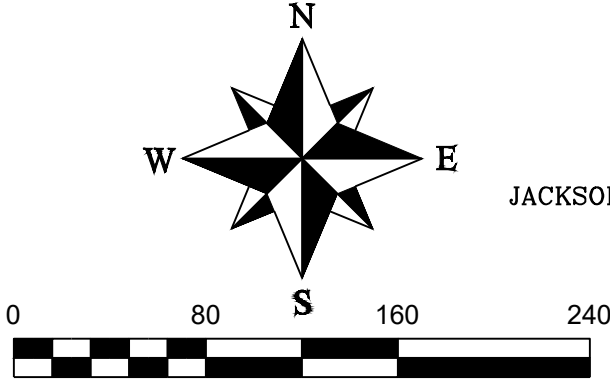

LOCATION MAP
SECTION 36-T47N-R32W

Missouri State Plane Coordinate System
1983, Missouri West Zone
(2003 Adjustment)
Reference Monument: CA-08
Combined Scale Factor: 0.9998997


POINT	NORTHING	EASTING
1	296806.340	857636.916
2	296788.054	858048.625
3	296690.362	858040.643
4	296691.007	857901.672
5	297004.439	857544.099
6	296972.986	857542.884
7	296979.491	857365.004
8	296871.985	857343.740
CA08	295023.772	857606.886
CA08AZ	295008.486	857868.230

Coordinates Shown in Meters

SURVEYOR'S CERTIFICATION:

I HEREBY CERTIFY THAT I HAVE MADE A SURVEY OF THE PREMISES DESCRIBED HEREIN WHICH MEETS OR EXCEEDS THE CURRENT "MISSOURI MINIMUM STANDARDS FOR PROPERTY BOUNDARY SURVEYS" AS JOINTLY ESTABLISHED BY THE MISSOURI BOARD FOR ARCHITECTS, PROFESSIONAL ENGINEERS, PROFESSIONAL LAND SURVEYORS, AND LANDSCAPE ARCHITECTS AND THE MISSOURI DEPARTMENT OF NATURAL RESOURCES DIVISION OF GEOLOGICAL SURVEY AND RESOURCE ASSESSMENT AND THAT THE RESULTS OF SAID SURVEY ARE REPRESENTED ON THIS PLAT TO THE BEST OF MY PROFESSIONAL KNOWLEDGE AND BELIEF.

MATTHEW J. SCHLICHT, MOPLS 2012000102
ENGINEERING SOLUTIONS, LLC, MO CORP LS 2005008319-D

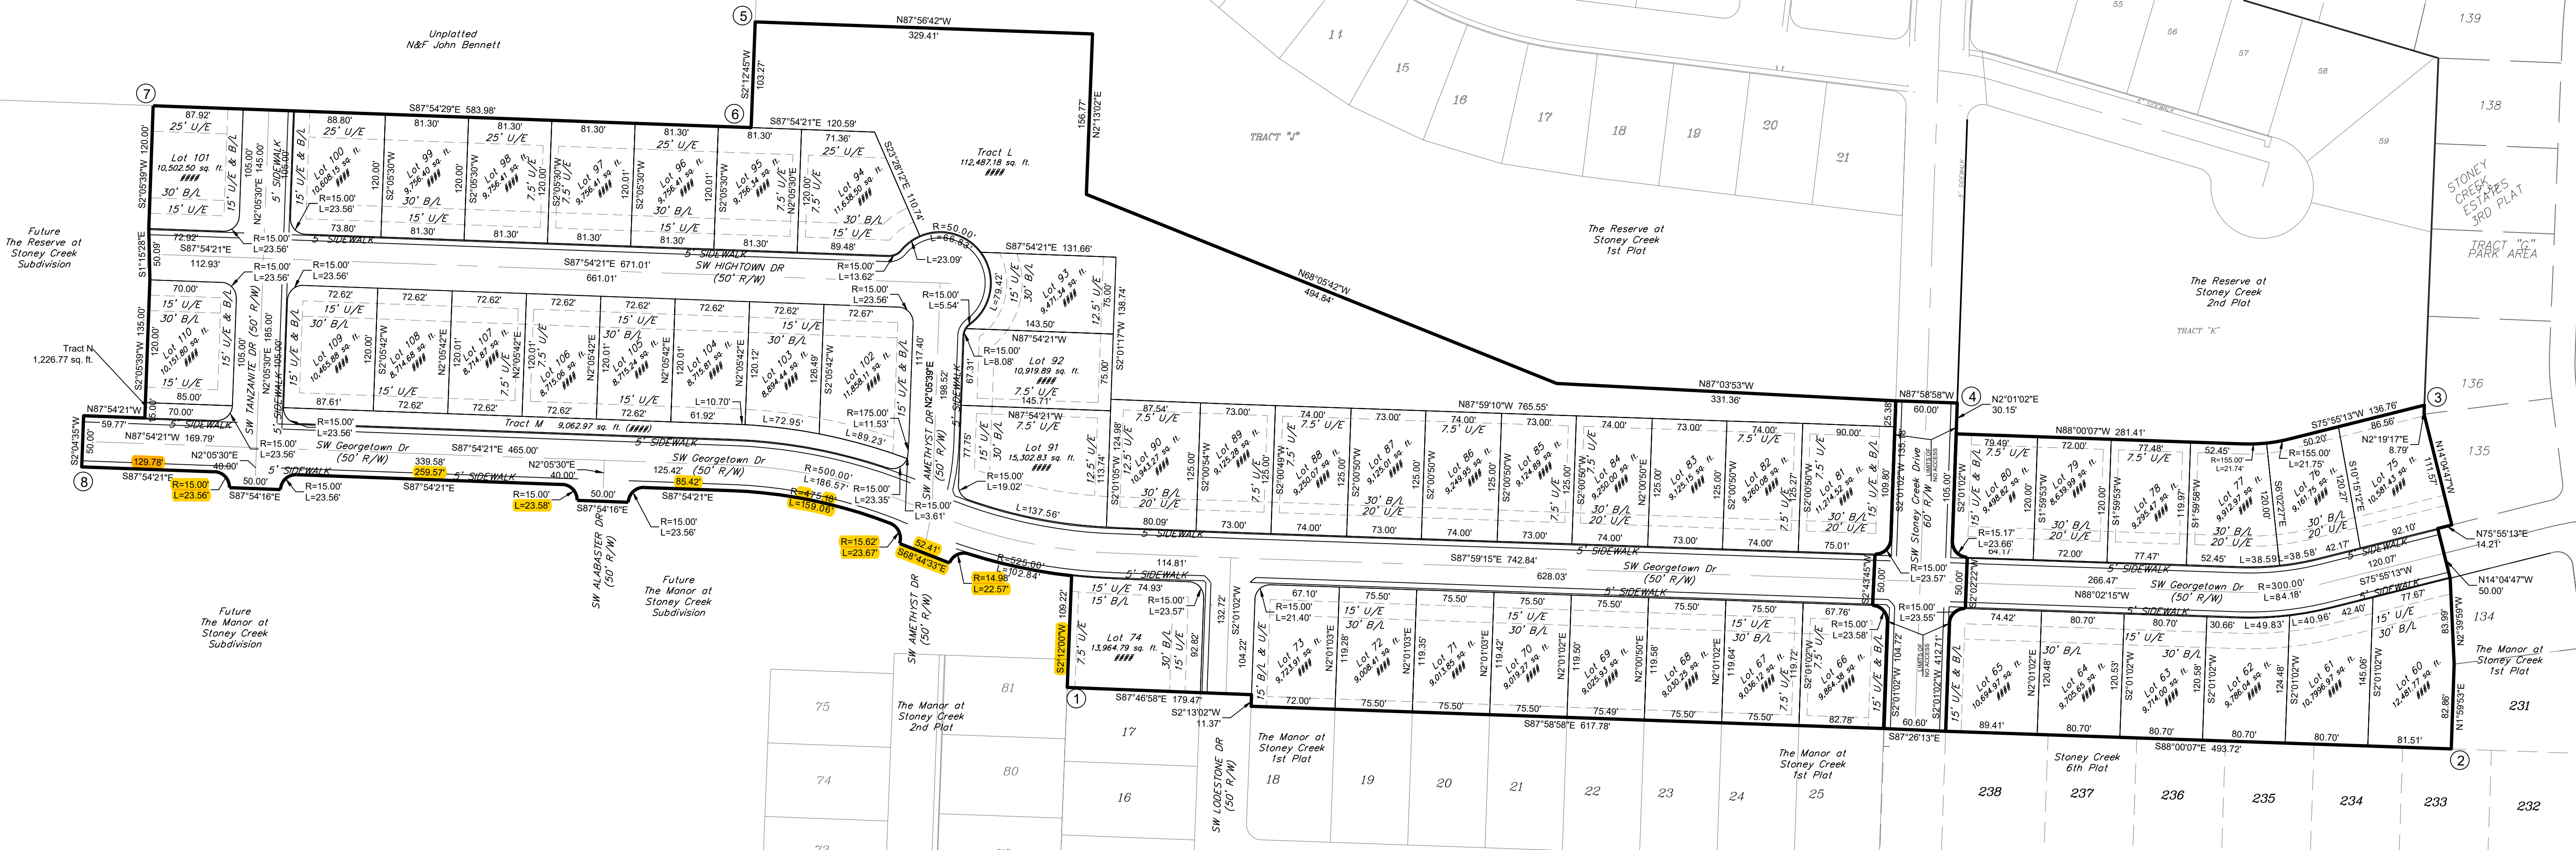

REVISIONS	DATE	DESCRIPTION

Final Plat
The Reserve at Stoney Creek 3rd Plat
Section 36, Township 47 N, Range 32 West
Lee's Summit, Jackson County, Missouri

Final Plat

SHEET	SECTION	TOWNSHIP	RANGE	COUNTY	JOB NO.
1	36	47N	32W	Jackson	Monor 3rd
DRAWN BY	DATE OF PREPARATION	SCALE	1"=80'		
M. Schlicht, PLS., PE	September 1, 2017				

PROFESSIONAL SEAL

ENGINEERING & SURVEYING SOLUTIONS
50 SE WITH STREET
LEE'S SUMMIT, MO 64082
P: (616) 623-9888 F: (616) 623-9849