

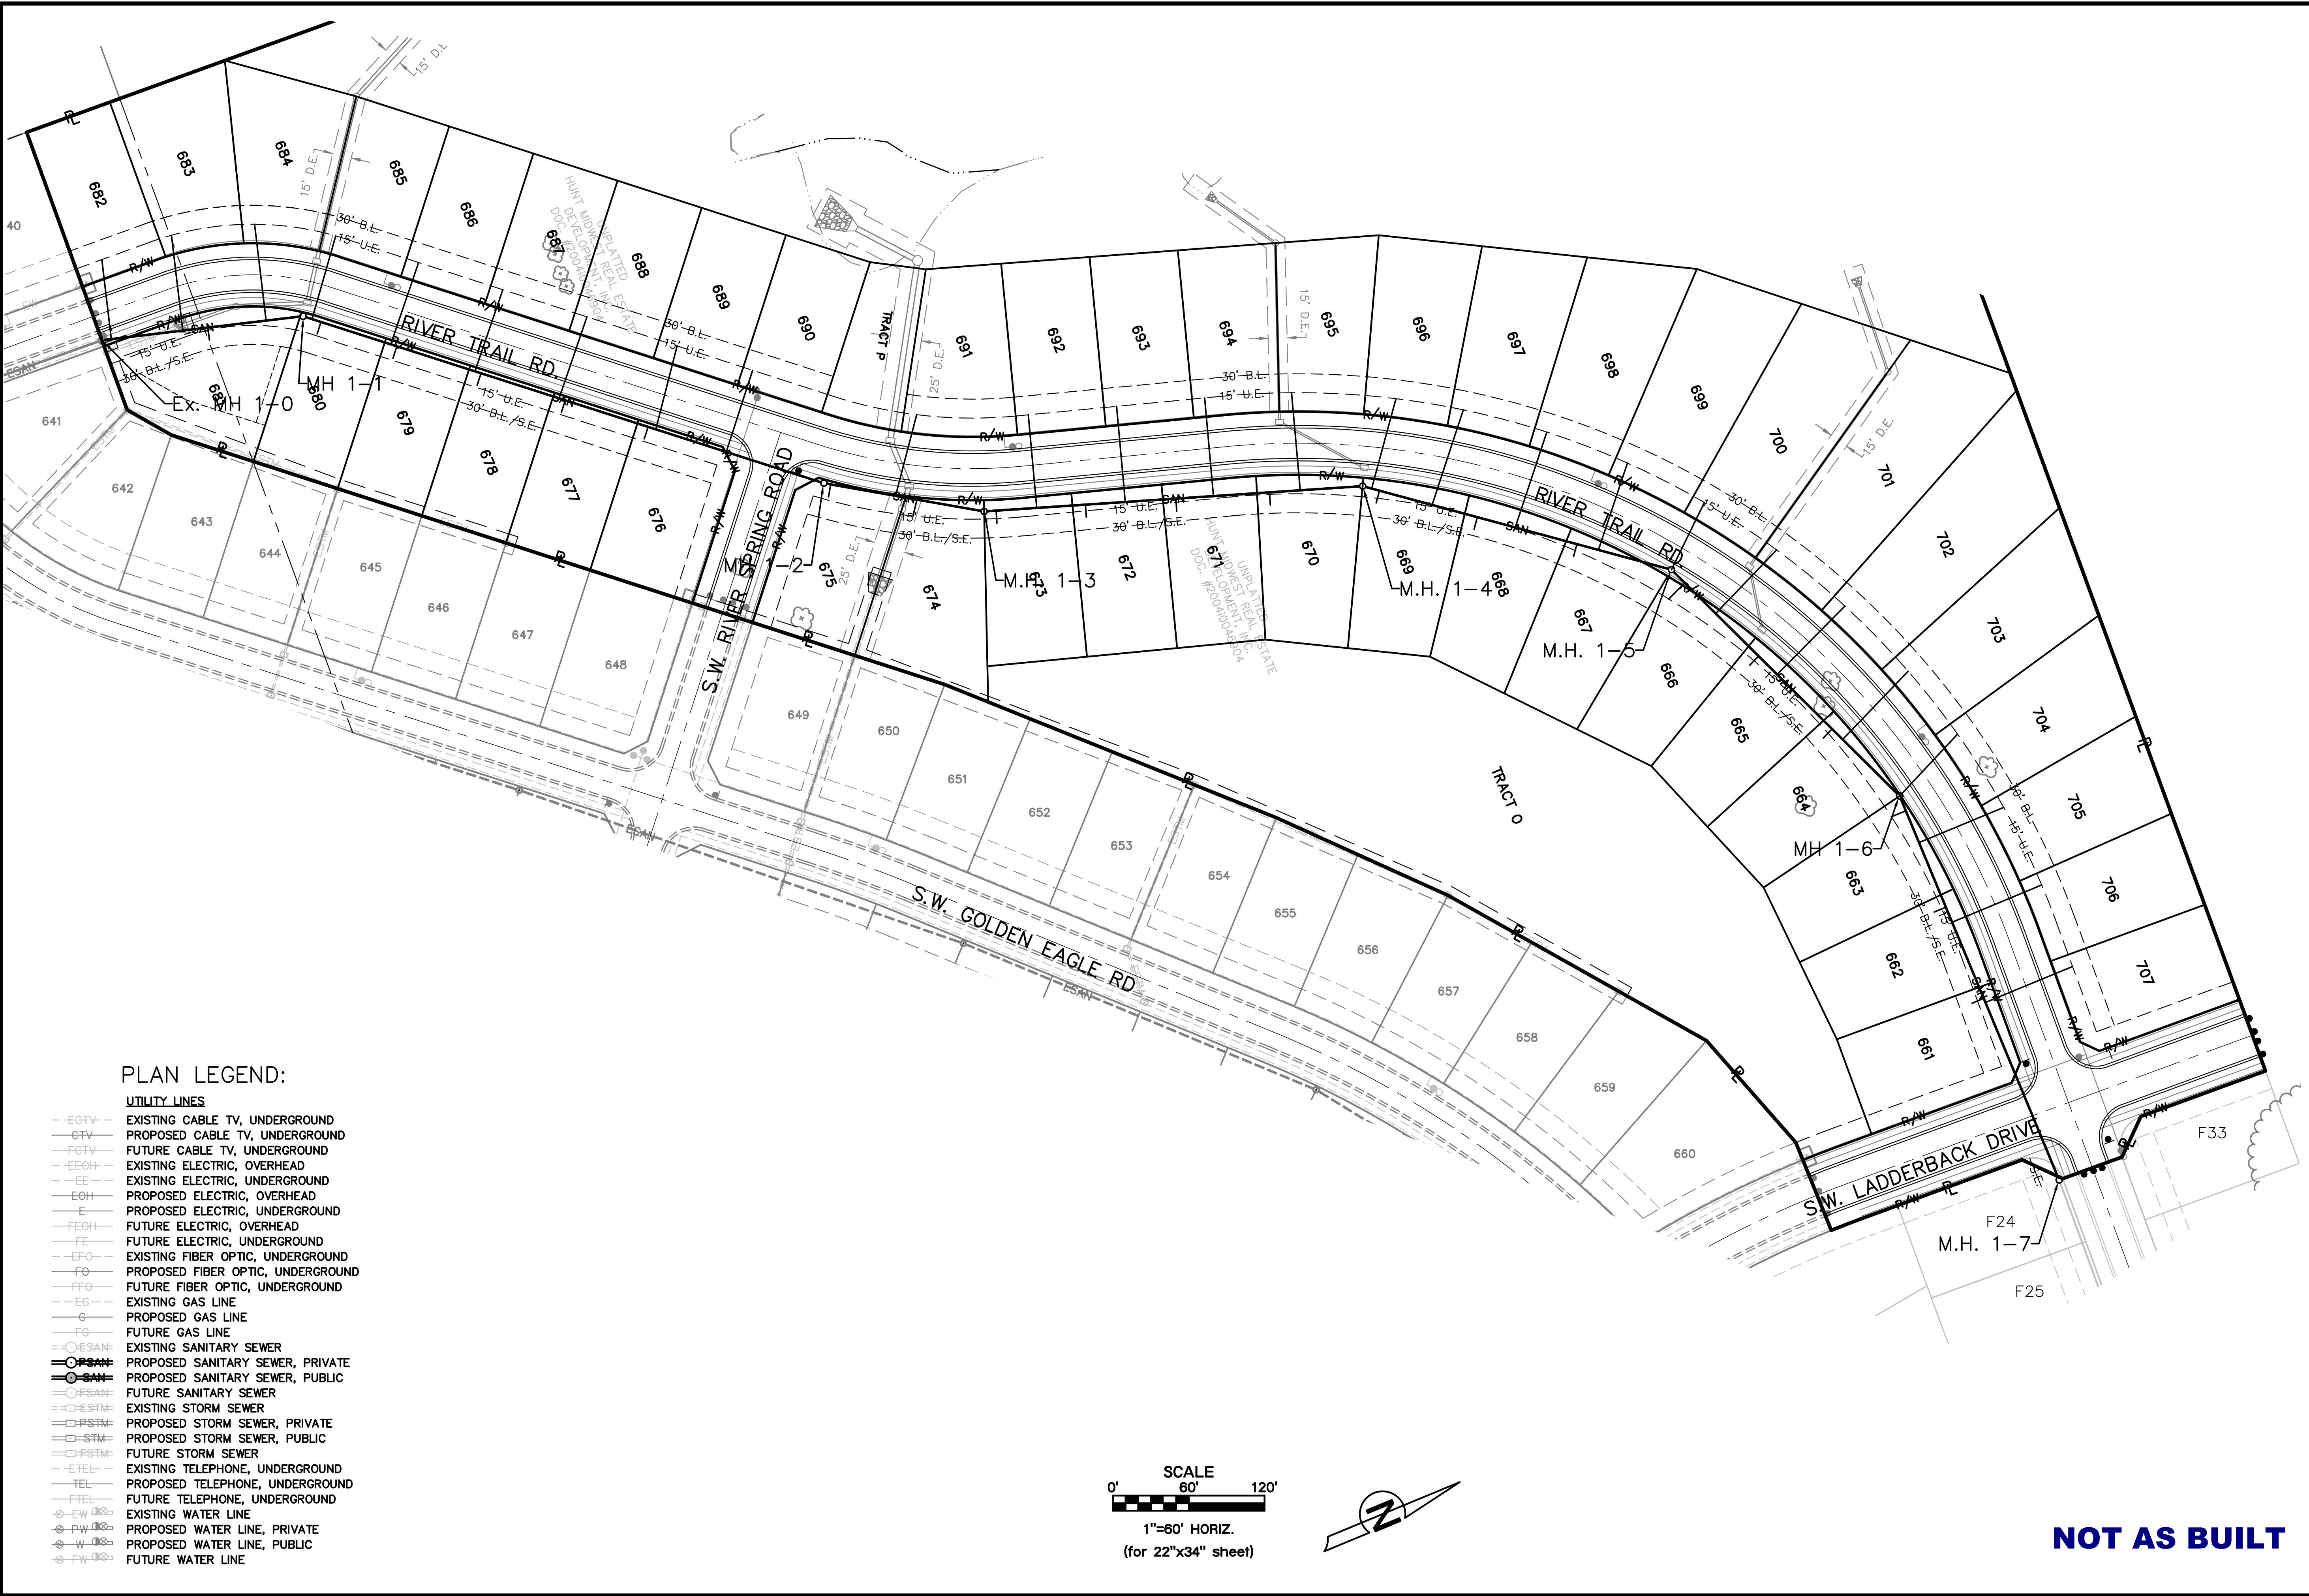


DWG: F:\2016\3001-3500\016-3432\Lutjen\Plans\Construction Documents\Sanitary 34x22\CSA-016-3432.dwg
DATE: Feb 23, 2017 6:11pm
USER: dherandez

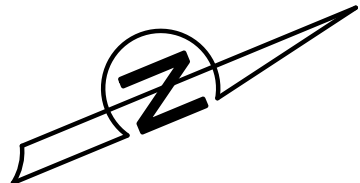

PLAN LEGEND:

- UTILITY LINES**
- EOTV--- EXISTING CABLE TV, UNDERGROUND
 - OTV--- PROPOSED CABLE TV, UNDERGROUND
 - FOTV--- FUTURE CABLE TV, UNDERGROUND
 - EEOH--- EXISTING ELECTRIC, OVERHEAD
 - EE--- EXISTING ELECTRIC, UNDERGROUND
 - EOH--- PROPOSED ELECTRIC, OVERHEAD
 - E--- PROPOSED ELECTRIC, UNDERGROUND
 - FEOH--- FUTURE ELECTRIC, OVERHEAD
 - FE--- FUTURE ELECTRIC, UNDERGROUND
 - EFO--- EXISTING FIBER OPTIC, UNDERGROUND
 - FO--- PROPOSED FIBER OPTIC, UNDERGROUND
 - FFO--- FUTURE FIBER OPTIC, UNDERGROUND
 - EG--- EXISTING GAS LINE
 - G--- PROPOSED GAS LINE
 - FG--- FUTURE GAS LINE
 - OESAN--- EXISTING SANITARY SEWER
 - PSAN--- PROPOSED SANITARY SEWER, PRIVATE
 - SAN--- PROPOSED SANITARY SEWER, PUBLIC
 - FSAN--- FUTURE SANITARY SEWER
 - OESTM--- EXISTING STORM SEWER
 - PSTM--- PROPOSED STORM SEWER, PRIVATE
 - STM--- PROPOSED STORM SEWER, PUBLIC
 - FSTM--- FUTURE STORM SEWER
 - ETEL--- EXISTING TELEPHONE, UNDERGROUND
 - TEL--- PROPOSED TELEPHONE, UNDERGROUND
 - FTEL--- FUTURE TELEPHONE, UNDERGROUND
 - EW--- EXISTING WATER LINE
 - PW--- PROPOSED WATER LINE, PRIVATE
 - W--- PROPOSED WATER LINE, PUBLIC
 - FW--- FUTURE WATER LINE

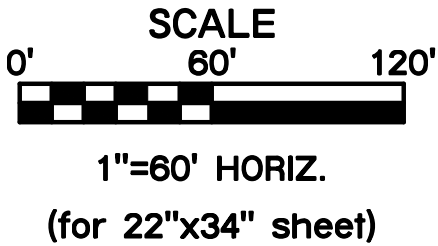

NOT AS BUILT



OLSSON ASSOCIATES
Olsson Associates - Civil Engineering
Missouri Certificate of Authority # 207022824
1301 Burlington, Suite 100 TEL: 816.587.4320
North Kansas City, MO 64116 FAX: 816.587.1393
www.olssonassociates.com

STATE OF MISSOURI
MELISSA G. DECONIA
NUMBER
PE-2011000892
3-5-18
PROFESSIONAL ENGINEER

NO.	REV.	DATE	REVISIONS DESCRIPTION	BY
		01.17.2017	Prepared for city Submittal	
		11.14.2017	As-built Submittal	

SANITARY GENERAL LAYOUT		2016
EAGLE CREEK 15TH PLAT		
LEE'S SUMMIT, MISSOURI		

drawn by: D.A.H.O.
design by: P.M.D.
approved by: M.G.D.
QA/QC by: M.G.D.
project no.: 016-3432
date: 2016/12/09

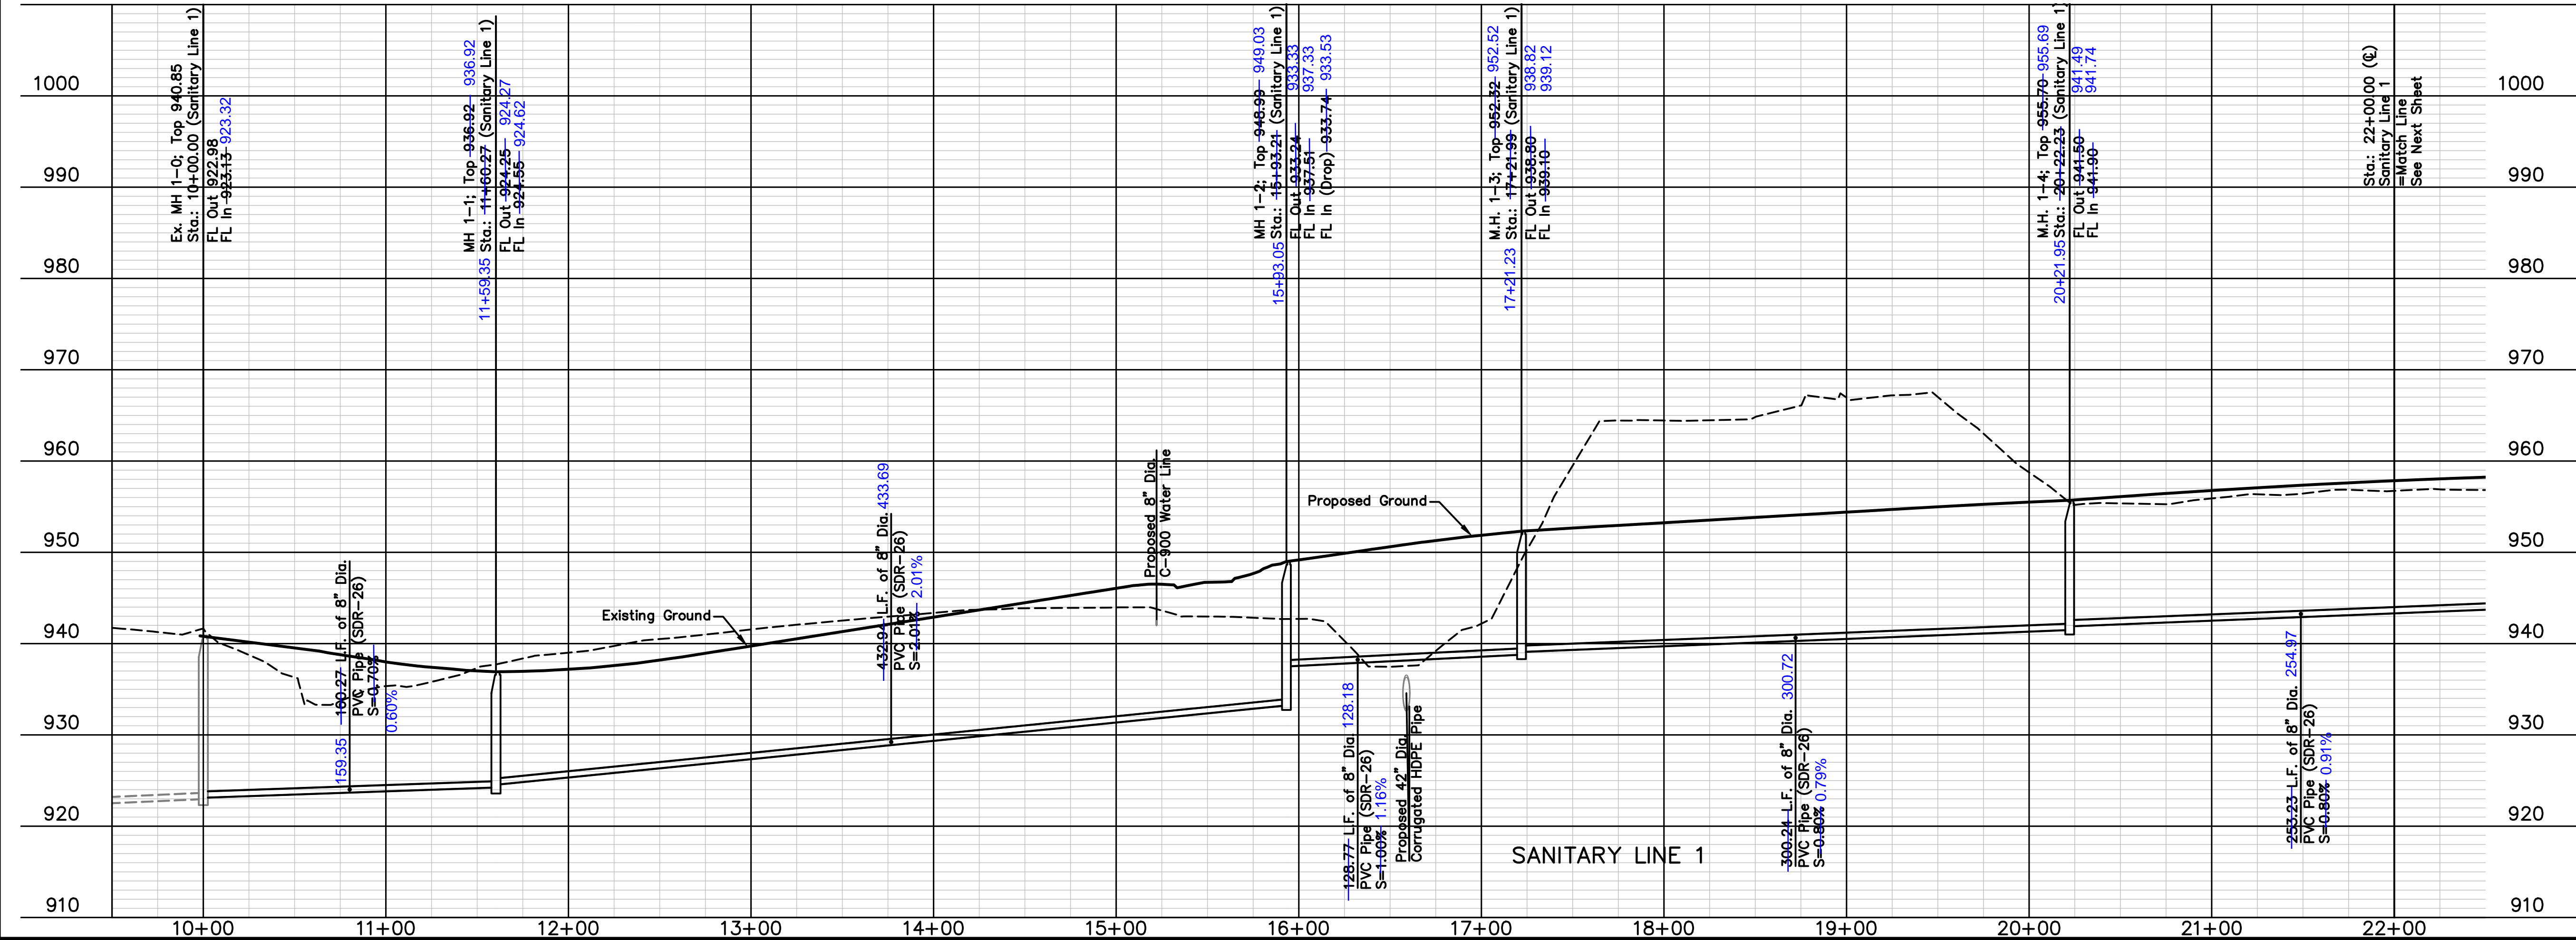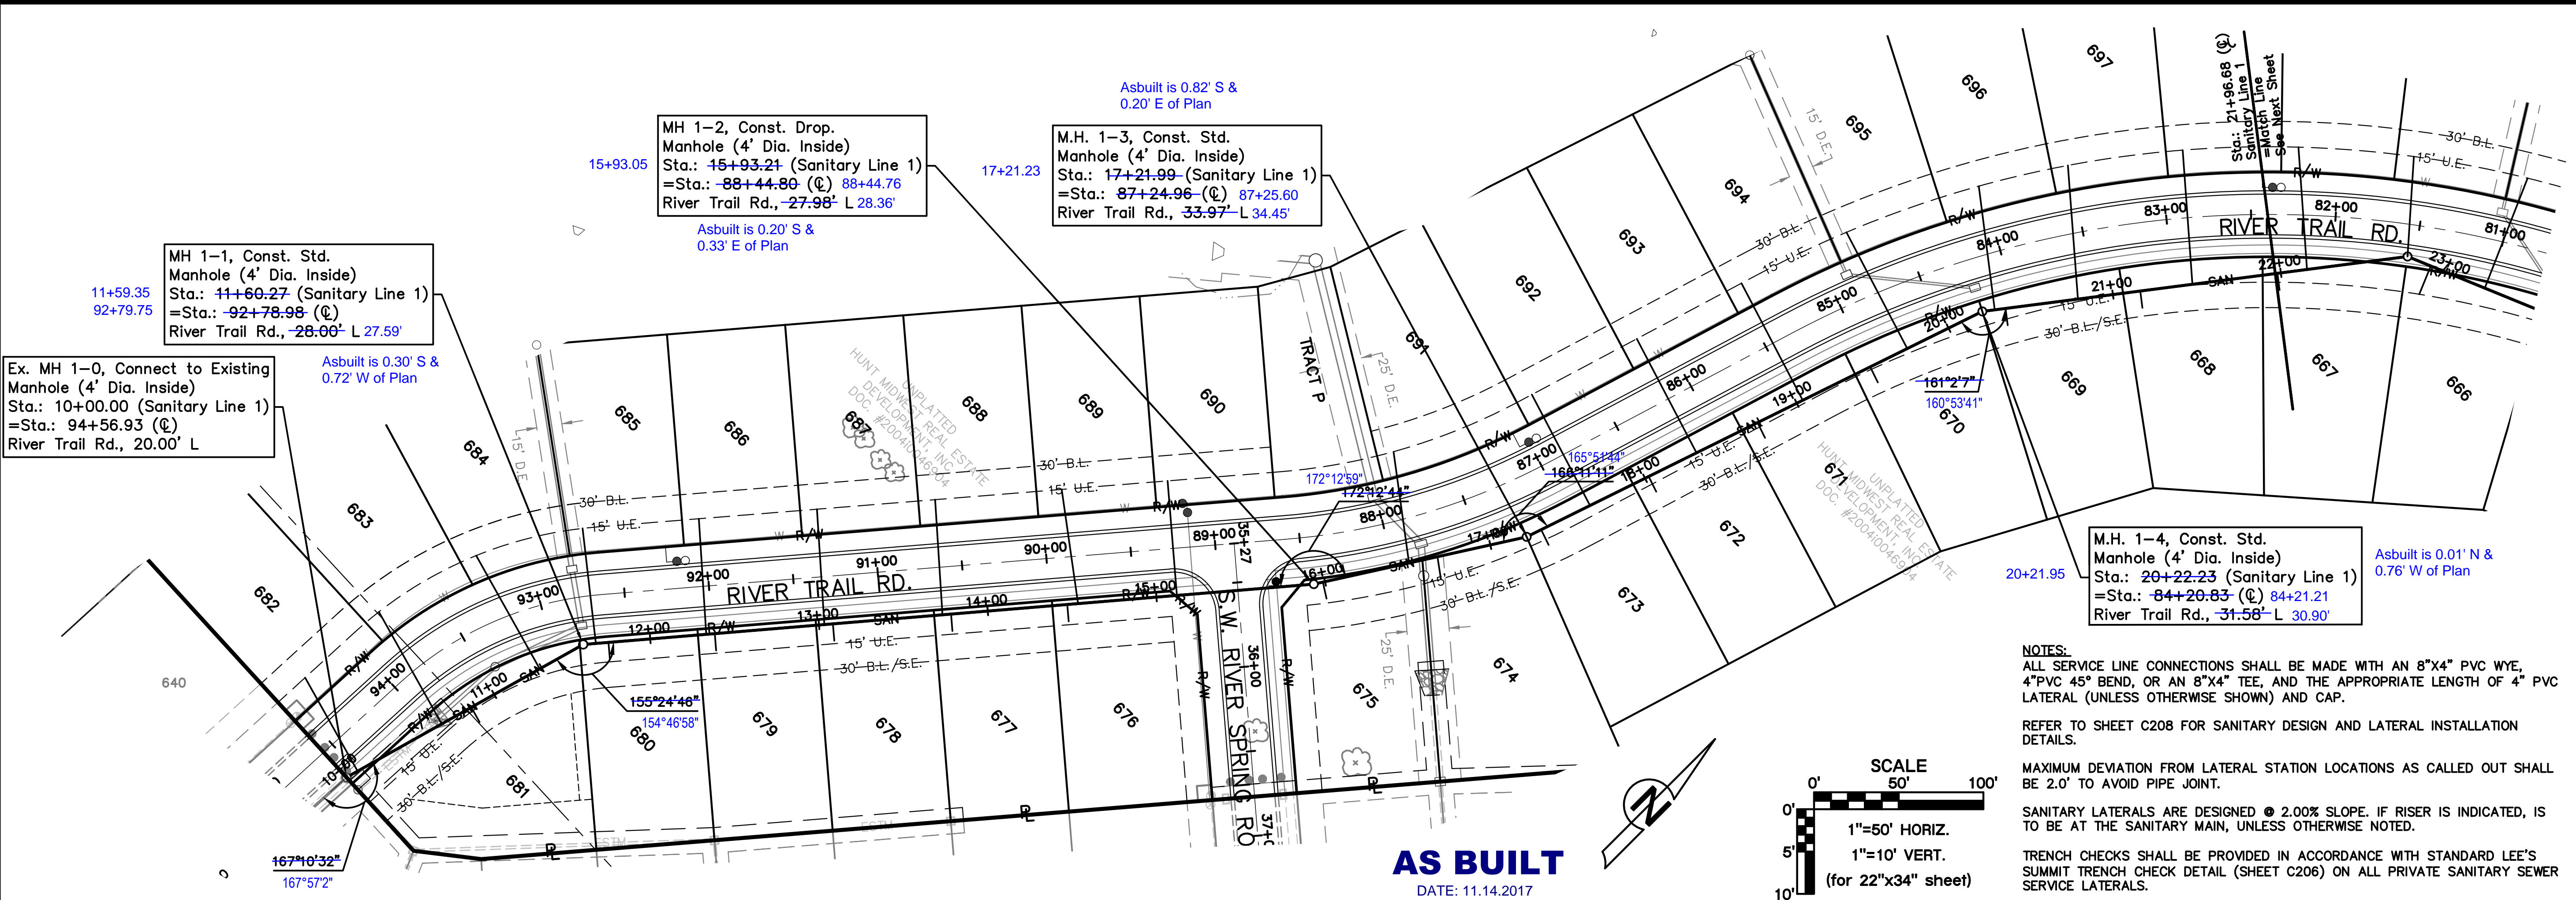

NOTES:
ALL SERVICE LINE CONNECTIONS SHALL BE MADE WITH AN 8"X4" PVC WYE, 4"PVC 45° BEND, OR AN 8"X4" TEE, AND THE APPROPRIATE LENGTH OF 4" PVC LATERAL (UNLESS OTHERWISE SHOWN) AND CAP.
REFER TO SHEET C208 FOR SANITARY DESIGN AND LATERAL INSTALLATION DETAILS.
MAXIMUM DEVIATION FROM LATERAL STATION LOCATIONS AS CALLED OUT SHALL BE 2.0' TO AVOID PIPE JOINT.
SANITARY LATERALS ARE DESIGNED @ 2.00% SLOPE. IF RISER IS INDICATED, IS TO BE AT THE SANITARY MAIN, UNLESS OTHERWISE NOTED.
TRENCH CHECKS SHALL BE PROVIDED IN ACCORDANCE WITH STANDARD LEE'S SUMMIT TRENCH CHECK DETAIL (SHEET C206) ON ALL PRIVATE SANITARY SEWER SERVICE LATERALS.

OLSSON[®]

ASSOCIATES

Olsson Associates, Civil Engineering
Missouri Certificate of Authority # 2007022924
1301 Burlington, Suite 100
North Kansas City, MO 64116
TEL 816.587.4320
FAX 816.587.1393
www.olssonassociates.com

STATE OF MISSOURI
MELISSA G. DECONIA
NUMBER
PE-2011000892
3-5-18
PROFESSIONAL ENGINEER

BY

REVISIONS DESCRIPTION

NO. REV.

DATE

1

01.12.2017

Sanitary notes added

11.14.2017

As-built Submittal

2016


SANITARY PLAN & PROFILE

EAGLE CREEK
15TH PLAT

LEE'S SUMMIT, MISSOURI

drawn by: D.A.H.O.
design by: P.M.D.
approved by: M.G.D.
QA/QC by: M.G.D.
project no: 016-3432
date: 2016/12/09

SHEET
C204

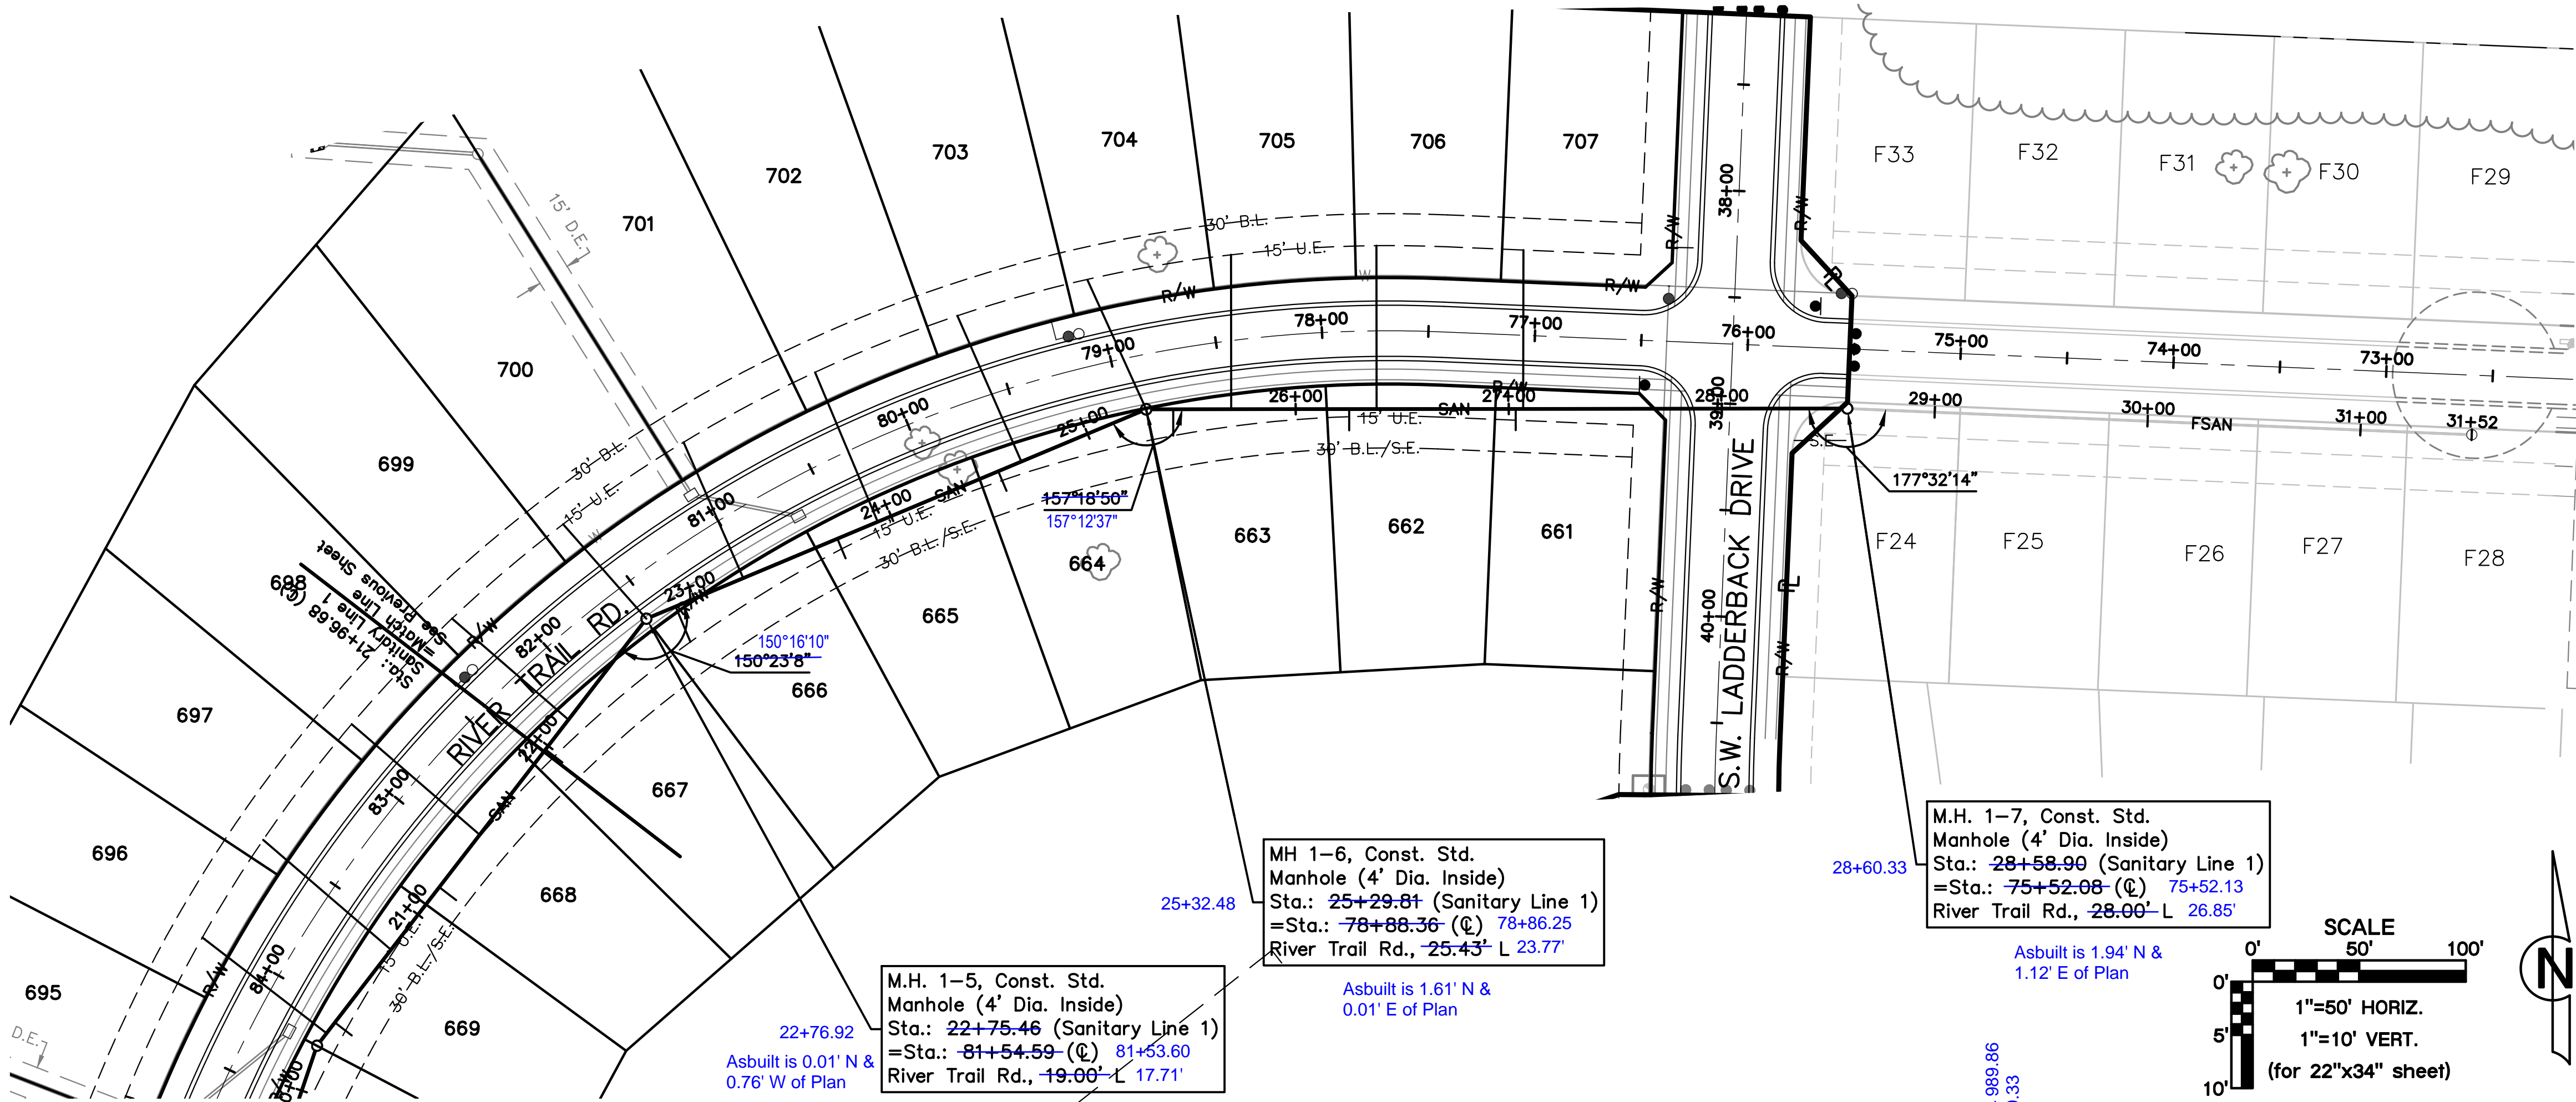


NOTES:
ALL SERVICE LINE CONNECTIONS SHALL BE MADE WITH AN 8"x4" PVC WYE, 4" PVC 45° BEND, OR AN 8"x4" TEE, AND THE APPROPRIATE LENGTH OF 4" PVC LATERAL (UNLESS OTHERWISE SHOWN) AND CAP.

REFER TO SHEET C208 FOR SANITARY DESIGN AND LATERAL INSTALLATION DETAILS.

MAXIMUM DEVIATION FROM LATERAL STATION LOCATIONS AS CALLED OUT SHALL BE 2.0' TO AVOID PIPE JOINT.

SANITARY LATERALS ARE DESIGNED @ 2.00% SLOPE. IF RISER IS INDICATED, IS TO BE AT THE SANITARY MAIN, UNLESS OTHERWISE NOTED.

TRENCH CHECKS SHALL BE PROVIDED IN ACCORDANCE WITH STANDARD LEE'S SUMMIT TRENCH CHECK DETAIL (SHEET C206) ON ALL PRIVATE SANITARY SEWER SERVICE LATERALS.

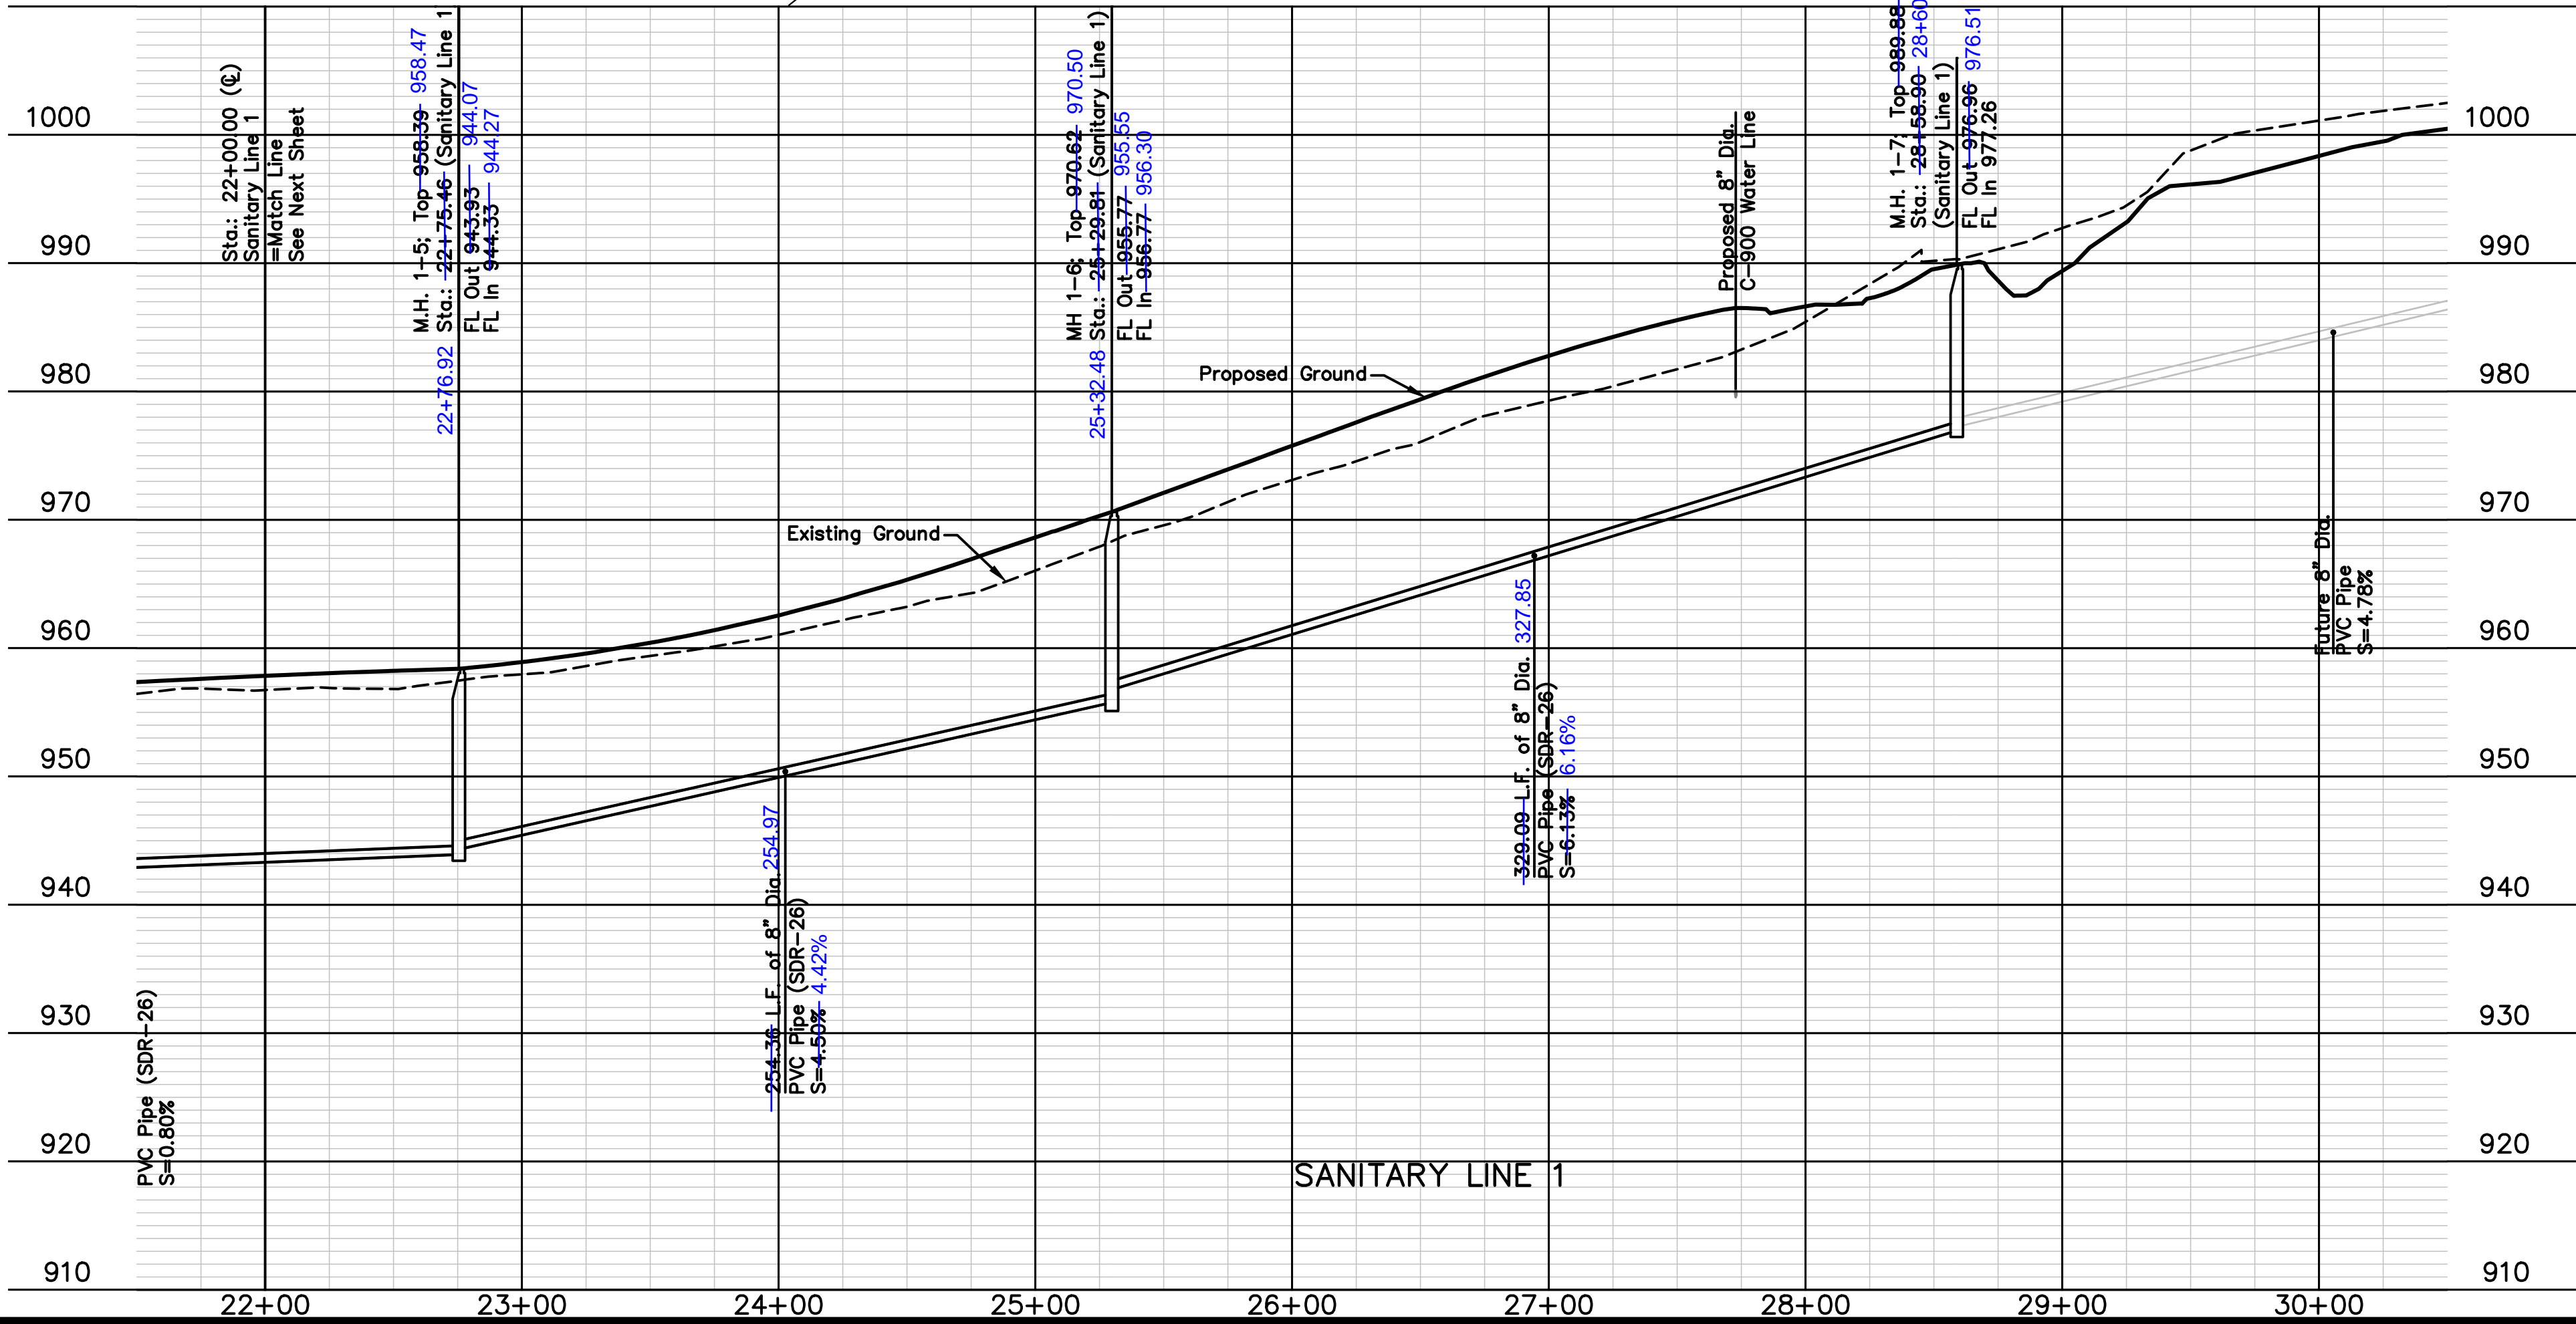

AS BUILT
DATE: 11.14.2017


SANITARY PLAN & PROFILE
EAGLE CREEK
15TH PLAT

LEE'S SUMMIT, MISSOURI

2016

drawn by: D.A.H.O.
design by: P.M.D.
approved by: M.G.D.
QA/QC by: M.G.D.
project no.: 016-3432
date: 2016/12/05

SHEET
C205



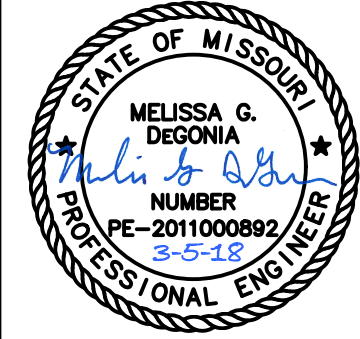


NO.	REV.	DATE	REVISIONS DESCRIPTION	BY
1		01.12.2017	Prepared for City Summit	JES
		01.12.2017	Sanitary notes added	
		11.14.2017	As-builts Submitted	

REVISIONS

OLSSON ASSOCIATES

Olsson Associates, Civil Engineering
Missouri Certificate of Authority # 2007022824
1301 Burlington, Suite 100
North Kansas City, MO 64116
TEL: 816.587.4320
FAX: 816.587.1393
www.olssonassociates.com

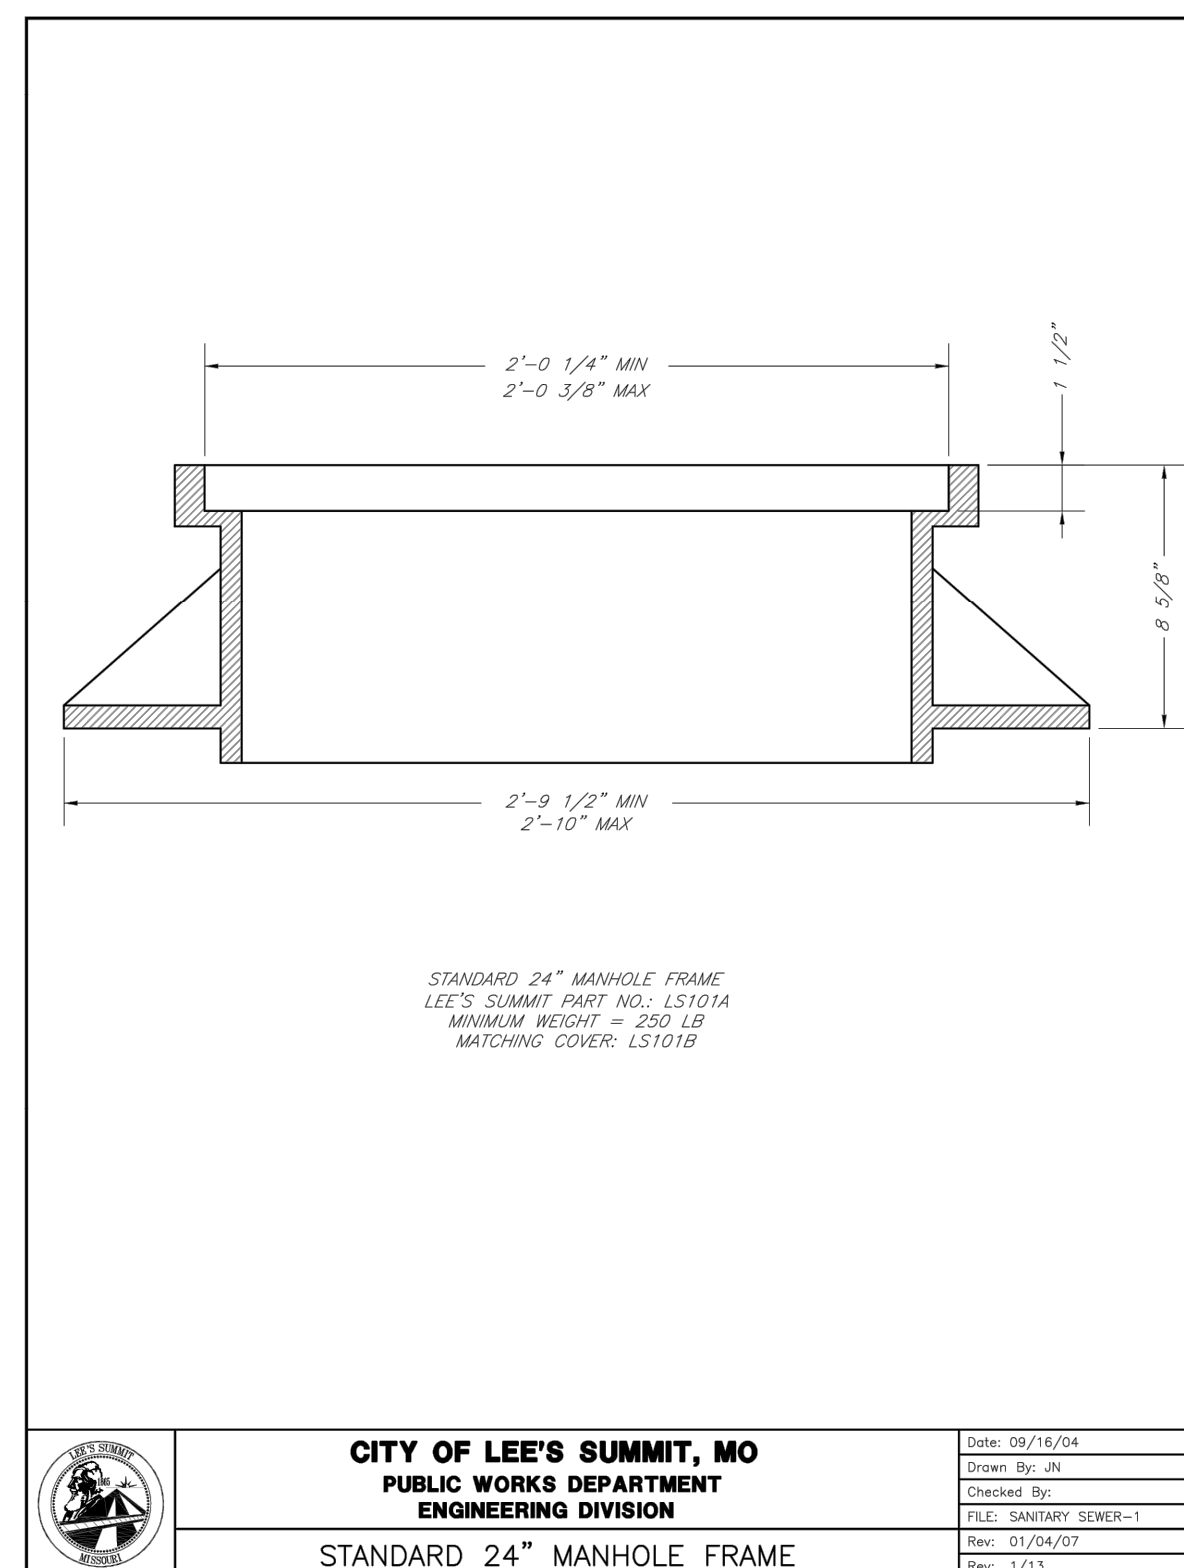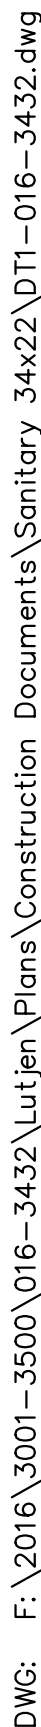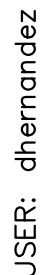

Sanitary Sewer Laterals					
Lot Number	Lateral Station	Lateral Length	Riser	Flowline at End of Lateral	Minimum Servicable Floor Elevation
		(ft)	(ft)	(ft)	(ft)
661	27+03.28	10.00	4.0	972.5	975.33
662	26+25.11	10.00	4.0	967.7	970.54
663	25+42.51	12.39	4.0	962.7	965.52
664	24+54.54	10.00	2.0	955.5	958.34
665	23+72.66	10.00	1.0	950.9	953.68
666	22+90.30	18.01	1.0	947.3	950.14
667	21+97.96	10.00	2.0	946.5	949.27
668	21+16.28	10.00	2.0	945.8	948.61
669	20+36.05	10.00	1.0	944.2	946.99
670	19+48.36	10.17	1.0	943.1	945.89
671	18+74.11	10.00	1.0	942.5	945.30
672	18+02.41	10.00	1.0	941.9	944.73
673	17+31.54	10.00	1.0	941.4	944.16
674	16+67.70	13.35	1.0	940.5	943.31
675	15+98.71	10.00	0.0	938.8	941.57
676	14+47.14	10.00	2.0	933.5	936.27
677	13+78.27	10.00	1.0	931.1	933.91
678	13+08.26	10.00	0.0	928.7	931.52
679	12+38.26	10.00	0.0	927.3	930.12
680	11+75.27	10.00	0.0	926.1	928.85
681	10+84.50	10.00	1.0	925.9	928.70
682	10+07.50	63.34	3.0	928.4	931.19
683	10+64.50	75.87	0.0	926.1	928.90
684	11+30.87	76.73	0.0	926.5	929.29
685	11+66.67	68.54	0.0	927.0	929.85
686	12+33.56	68.40	0.0	928.4	931.19
687	13+03.59	68.27	0.0	929.8	932.59
688	13+73.90	68.14	0.0	931.2	934.00
689	14+51.22	68.13	1.0	933.7	936.54
690	15+12.16	67.88	2.0	935.9	938.73
691	16+53.61	66.24	0.0	940.4	943.24
692	17+62.04	73.98	0.0	941.9	944.70
693	18+32.28	76.00	0.0	942.5	945.30
694	19+02.35	78.02	0.0	943.1	945.90
695	19+71.24	77.51	0.0	943.6	946.44
696	20+29.65	73.64	0.0	944.0	946.83
697	20+81.63	79.15	0.0	945.0	947.76
698	21+50.10	79.45	0.0	945.5	948.31
699	22+17.08	72.44	1.0	946.9	949.69
700	22+75.46	59.12	2.0	947.7	950.47
701	23+24.29	69.68	0.0	948.9	951.72
702	23+93.19	76.12	0.0	952.1	954.95
703	24+65.62	74.79	0.0	955.4	958.18
704	25+28.81	66.94	2.0	960.3	963.07
705	25+69.72	72.51	3.0	964.6	967.41
706	26+37.99	76.72	3.0	968.9	971.68
707	27+06.88	74.60	3.0	973.1	975.87

Sanitary Sewer Design Information											
Upstream Manhole	Downstream Pipe Slope	Downstream Pipe Diameter	Proposed Cumulative Area	Future Cumulative Area	Peak Base Flow	Peak Infiltration	Peak Inflow	Total Peak Flow	Downstream Pipe Mannings N	Downstream Pipe Capacity	Downstream Pipe Full Flow Velocity
	(%)	(in)	(Ac.)	(Ac.)	(gpd)	(gpd)	(cfs)	(cfs)		(cfs)	(fps)
Ex. MH 1-0	0.85%	8	13.42	2.55	23955.00	7985.00	0.44	0.49	0.013	1.11	3.19
MH 1-1	0.70%	8	12.22	2.55	22155.00	7385.00	0.41	0.45	0.013	1.01	2.89
MH 1-2	2.01%	8	9.54	2.55	18135.00	6045.00	0.34	0.38	0.013	1.71	4.91
MH 1-3	1.00%	8	8.59	2.55	16710.00	5570.00	0.32	0.35	0.013	1.21	3.47
MH 1-4	0.80%	8	6.25	2.55	13200.00	4400.00	0.26	0.28	0.013	1.08	3.09
MH 1-5	0.80%	8	3.96	2.55	9765.00	3255.00	0.20	0.22	0.013	1.08	3.10
MH 1-6	4.50%	8	1.66	2.55	6315.00	2105.00	0.14	0.15	0.013	2.56	7.34
MH 1-7	6.14%	8	0.00	2.55	3825.00	1275.00	0.09	0.10	0.013	2.99	8.57

NOT AS BUILT

NOTES:
ALL SERVICE LINE CONNECTIONS SHALL BE MADE WITH AN 8"x4" PVC WYE, 4" PVC 45° BEND, OR AN 8"x4" TEE, AND THE APPROPRIATE LENGTH OF 4" PVC LATERAL (UNLESS OTHERWISE SHOWN) AND CAP.
MAXIMUM DEVIATION FROM LATERAL STATION LOCATIONS AS CALLED OUT SHALL BE 2.0' TO AVOID PIPE JOINT.
SANITARY LATERALS ARE DESIGNED @ 2.00% SLOPE. IF RISER IS INDICATED, IS TO BE AT THE SANITARY MAIN, UNLESS OTHERWISE NOTED.
TRENCH CHECKS SHALL BE PROVIDED IN ACCORDANCE WITH STANDARD LEE'S SUMMIT TRENCH CHECK DETAIL (SHEET C206) ON ALL PRIVATE SANITARY SEWER SERVICE LATERALS.

<div style="float: right; width: 100px;"> OLSSON[®] A S S O C I A T E S </div> <div style="clear: both;"></div> <p style="font-size: small; margin-top: 10px;">Olsson Associates - Civil Engineering 1301 Burlington Suite 100 North Kansas City, MO 64116 TEL 816.587.4320 FAX 816.587.1393 www.olssonassociates.com</p>					
SANITARY TABLES		NO. REV.	DATE	REVISIONS DESCRIPTION	BY
EAGLE CREEK 15TH PLAT		1	01.17.2017	Prepared for city Submittal	JES
			02.23.2017	Sanitary notes added. Tables revised per plan changes	
			11.14.2017	As-built Submittal	
LEE'S SUMMIT, MISSOURI					
2016					
drawn by: _____ DA.HO P.M.D design by: _____ M.G.D approved by: _____ M.G.D QA/QC by: _____ M.G.D project no.: _____ date: _____ 2016/12/05					
SHEET C208					