# copyright: The following documents are the sole property of davidson architecture & engineering, Ilc for the specific purpose of construction of said building. These documents are considered confidential and subject to davidson architecture & engineering llc's copyright protection. Neither receipt nor possession transfers any rights to reproduce these documents or any part thereof. Any re-use of these documents without the express written permission of davidson architecture & engineering, llc is strictly prohibited and shall confer no liability to davidson architecture & engineering, llc. disclaimer: These documents are accurate to the best of davidson architecture & engineering, Ilc's professional knowledge. In the event a discrepancy in the documents is encountered, it is the responsibility of that party to notify davidson architecture & engineering in a timely manner, for corrections and/or explanation of the documents. project description: Building additions to an existing car dealership.

# const. schedule

construction: summer 2019 occupancy: fall 2019

schedule indications are estimated and shall be the responsibility of the contractor.

# code review:

governing municipality: Lee's Summit, Missouri
governing code: 2018 IBC, 2018 IMC, 2018 IPC,
2018 IFGC, 2018 IFC, 2017 NEC,
ADA.ANSI 117.1

CP-2 zoning: 63,595 sq. ft. Lot 1 (no work): 130,530 sq. ft. (±2.99 acres) Lot 2: existing building area: 18,298 sq. ft. 7,198 sq. ft. building addition area: 25,496 sq. ft. total building area: floor area ratio: business description: construction type: occupancy type:

floor area ratio:

business description:

construction type:

occupancy type:

stories:

building height:

fire suppression:

tabular area:

sprinkler increase:

19.5%

automobile dealership

IIB

B (Business, S-1 (Auto Shop)

1 story with parts mezzanine

31'-0" (Icon Tower)

yes

17,500 sq. ft. (S-1)

300% = 52,500 sq. ft.

70,000 sq. ft.

total building area: 25,496 sq. ft. occupant load: B 10,360

B 10,360 sq. ft. / 100 = 104 occ. S-1 15,136 sq. ft. / 300 = 50 occ. Total 154 occupants

plumbing fixtures required:

B 4 water closets
3 lavatories
2 drinking fountains
1 mop sink

S-1 1 water closet
1 lavatory
1 drinking fountain

1 drinking fountain
1 mop sink
req'd plumbing fixtures: 5 water closets, 1 w.c. can be substituted

for a urinal
4 lavatories
3 drinking fountains
1 mop sink

exist. plumbing fixtures: men 2 water closets

men 2 urinals (can be 50% of req'd w.c.)
men 2 lavatories

women 2 water closets
women 2 lavatories
4 drinking fountains
1 mop sink

Existing plumbing fixtures accommodate the total building occupancy.

# sheet index:

cover sheet

Civil

C1.0 civil cover sheet
C1.1 notes
C1.2 site plan
C1.3 demolition plan
C1.4 utility plan

C1.4 utility plan
C2.1 grading/erosion control plan
C2.2 spot elevation plan
C4.1 details
C4.2 details
C4.3 details

Architecture

L1.1 landscape plan and details
A1.1 site plan

A2.1 floor plan
A3.1 exterior elevations
A4.3 wall sections





July 08, 2019

civil engineer:

4301 Indian Creek Parkway

Overland Park, Kansas 66207

p: 913.451.9390 f: 913.451.9391

client:

McBob, LLC

architect:

Justin Bridges, AIA

3200 NW South Outer Rd.

Blue Springs, Missouri 64015

Paul A. Miller, P.E.
Davidson Architecture & Engineering
4301 Indian Creek Parkway
Overland Park, Kansas 66207
p: 913.451.9390 f: 913.451.9391

**Davidson Architecture & Engineering** 

# structural engineer:

Tim Bengfort, P.E. Needham DBS 15950 College Boulevard Lenexa, Kansas 66219 p: 913.385.5300

# design/build mechanical:

Ty Johnson BCI Mechanical, Inc. 341 S. Poplar Street Gardner, Kansas 66030 p: 913.856.6747

# design/build plumbing:

Gordon Taylor Taylor Mechanical, Inc. P.O. Box 2064 Lee's Summit, Missouri 64063 816.743.9900

# design/build electrical:

Ernie Cota Kasa Electric, LLC 1206 NW Valley Ridge Drive Grain Valley, MO 64029 p. 816.228.4886

# general contractor

Jeff Vanderpool Rothwell Construction, Inc. 1500 North 7 Hwy., Suite 100 Blue Springs, Missouri 64014 p: 816.228.8808 f: 816.228.8843 building addition for

AO.O cover sheet

Sheet Index

C2.1 — Grading Plan/Erosion Control Plan C2.2 — Spot Elevation Plan C4.1 — Details

Davidson Architecture & Engineering, LLC

C1.0 - Cover C1.1 - Notes C1.2 - Site Plan C1.3 - Demo Plan C1.4 – Utility Plan

C4.2 — Details C4.3 — Details

Civil Engineer:

Mr. Paul A. Miller. P.E. 4301 Indian Creek Pkwy. Overland Park, KS 66207 Phone: (913) 451-9390 Email: Paul@davidsonae.com

Owner Information

3200 South Outer Road Blue Springs, Missouri 64015

• Boundary information, existing utilities and topographic features shown are based on

include all utility lines present. The contractor shall be responsible to make One Call and coordinate field location of all existing underground utilities prior to beginning

• The contractor shall be responsible for any damage to any utilities or their structures

development fees, taxes, etc. for all main connections and/or extensions with and from the city and/or respective utility unless otherwise coordinated with the Owner. All

utility services for this project shall be coordinated with respective utility company by

manhole covers, valve box covers, etc. to finish grade, whether specifically indicated

• Utilities shown on the plan with specific elevations and/or structure locations are SUE quality level "B", ie: storm sewer, sanitary sewer, water hydrants & valves, utility

poles, etc. All other existing utility information shown is SUE quality level "D",

Lot 2 of Summit Plaza, Lee's Summit, Jackson County, Missouri

• The existing utility locations shown on these plans are approximate and may not

• The contractor shall coordinate and be responsible for connection fees, system

• The contractor shall be responsible for adjusting all at-grade utilities such as

McBob. LLC

information supplied by owner, surveyor, and others.

primarily retracement of one—call and city records.

excavation/construction activities.

in these plans or not.

Legal description

during excavation/construction activities.

<u>Utility Notes</u>

ddition


 $\boldsymbol{\omega}$ 

building

drawing type permit project number

# A building addition for Lee Summit Subaru

Section 29, Township 48 North, Range 31 West City of Lee Summit, Jackson County, Missouri

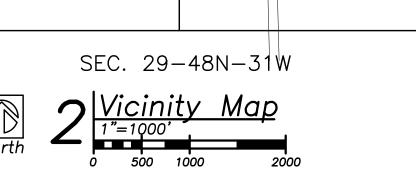

## <u>Local Benchmarks:</u>

<u>BM-1:</u> Center front edge of Curb Inlet. Elevation: 999.63'

N: 1013173.04 E: 2827639.71

BM-2: Cut plus on Northeast bolt on hydrant. Elevation: 1005.29

N: 1013295.66 E: 2827399.19

#### Floodplain Note:

The site lies entirely outside of the 100-year floodplain (zone x) as depicted on the FEMA Flood Insurance Rate Map (FIRM) community panel no. 0305F (City of Lee's Summit). Map no. 29095C0305F Date: September 29, 2006.

NW 1/4

SW 1/4

COLBERN ROAD

According to the MDNR Record Database and Field Survey, there is no evidence suggesting presence of any active, inactive or capped oil and/or gas wells on the property

## 

 right of	way
 property	lines
 easemen	ts

<u>Grading Legend</u>

<u>Property Legend</u>

existing minor contour — — — — existing major contour ------ proposed minor contour

<del>----</del> proposed major contour

underground cable/phone/data service

fence-chainlink

fence-barbed wire

fence-wood

## <u>Utility Legend</u>

<u>Linetypes</u>	
sanm	sanitary main sanitary service storm sewer (existing) storm sewer (solid wall, proposed) storm sewer (solid wall, proposed) storm sewer (perforated, proposed) water main water service (fire) water service (domestic) water service (irrigation)
gasm	natural gas main natural gas service schematic
elpu ————————————————————————————————————	underground primary electric underground secondary electric overhead electric
datu	underground cable/phone/data

## **Utility Contacts**

-SITE LOCATION

2.99 ACRES±

NE 1/4

SE 1/4

Sanitary sewers - City of Lee's Summit, phone (816) 969-1900 Water — City of Lee's Summit, phone (816) 969—1900 Electric - KCP&L, phone (888) 471-5275

Gas - Spire, phone (816) 969-2266

Telephone - At&T, phone (800) 464-7928

Cable - Time Warner, phone (816) 358-8833

Storm sewer - City of Lee's Summit, phone (816) 969-1800

\*\*\*call before you dig - one call system (800) 344-7483



<u>(S)</u>	sanitary manhole
oco	service cleanout
⊗ <sup>fmv</sup>	force main release valve
	rectangular structure
	circular structure
Q	fire hydrant
$\otimes^{WV}$	water valve
M	water meter
BFP	backflow preventer
$\boxtimes^{\mathcal{G}}$	natural gas meter
T	service transformer (pad mount)
S	primary switch gear
<del> </del>	light pole
C	cable/phone/data junction box
O — —	street light

pedestrian street light

electric pole


guy wire



## <u>General Notes</u>

- All work within the road right—of—way shall conform to the technical specifications and design criteria for public improvement projects
- Erosion Control shall be per the Erosion and Sediment Control Program Manual of the City of Lee Summit, Missouri.
- All work and materials shall be subject to inspection and approval by the owner or the owner's representative. Any change or deviation from these plans must be authorized by the owner or the owner's representative.

- The contractor shall be responsible for obtaining all required permits, paying all fees, and otherwise complying with all applicable
- The contractor shall protect from damage or injury all property including survey monuments, property markers, benchmarks, etc.
- The contractor shall be responsible for the restoration of the right-of-way and for damaged improvements such as curbs, sidewalks, street light and traffic signal junction boxes, traffic signal loop lead—ins, signal poles, etc. Damaged improvements shall be repaired
- The contractor shall sod all disturbed areas within the public street right-of-way.
- Paving shall conform to the soils report, and these drawings, any identified discrepancies shall be brought to the attention of the
- Contractor shall provide 48—hour notification to the city engineering division to schedule all required inspections.
- Board (KCMMB). Structural concrete shall be 5,000 psi and nonstructural concrete shall be 4,000 psi.
- A right—of—way work permit and/or street excavations permit shall be obtained by the contractor to complete all utility work within the public street right-of-way.

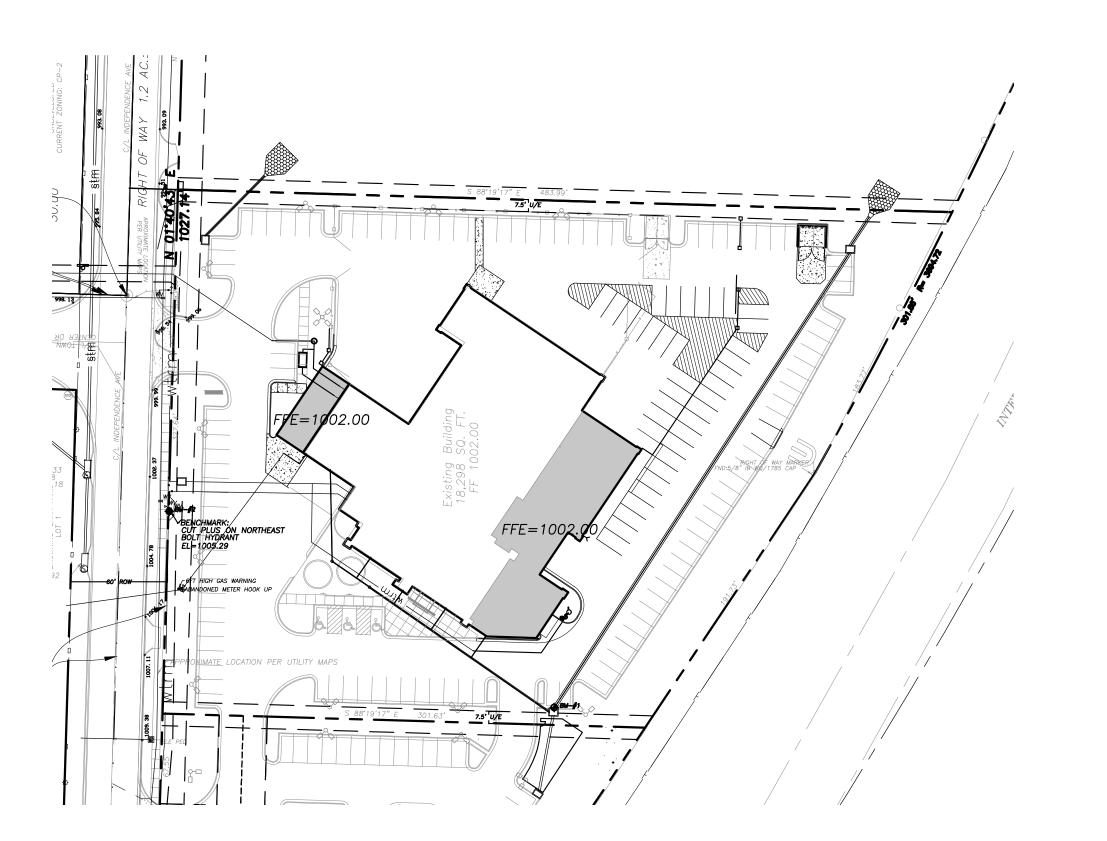

- of the city of Lee Summit, Missouri
- All traffic control in connection with construction in the right-of-way shall be in conformance with the Manual of Uniform Traffic
- The contractor shall be required to provide a stabilized construction entrance to prevent mud from being deposited onto adjacent
- regulations governing the project.
- Items damaged shall be reset by a professional land surveyor licensed in the state of Missouri, at the contractor's expense.
- in conformance with the latest city standards and to the city's satisfaction.

- All concrete for public improvements shall comply with the Standards and Specifications of the Kansas City Metropolitan Materials

- The Contractor shall be responsible for obtaining all required permits, paying all fees, and otherwise complying with all applicable regulations governing the project.
- All materials, workmanship, and construction shall meet or exceed the city standards. Where there is conflict between these plans and standards, the higher quality standard as determined by the engineer shall apply. All work shall be inspected and approved by contractor.
- All work and materials shall be subject to inspection and approval by the owner or the owner's representative. Any change or deviation from these plans must be authorized in writing by the owner or the owner's representative prior to work being completed.
- The work associated with and based on these plans, shall be subject to the requirements of, and conform to, the Municipal Code of Lee Summit, Missouri, and the standards and specifications in current use. The standards, specifications, details, and procedures sub-referenced therein are hereby incorporated by reference.
- Lineal foot measurements shown on the plans are horizontal measurements, not slope measurements. All payments shall be made on horizontal measurements.
- No geological information is shown in these plans.
- Prior to commencement of work, the contractor shall notify all utility companies which have facilities in the near vicinity of the construction to be performed.
- All waste material resulting from the project shall be disposed of off—site in an approved landfill. All excavation shall be unclassified. No separate payment will be made for rock excavation. Contractor is responsible for all haul off
- The Contractor shall be required to provide a stabilized construction entrance to prevent mud from being deposited onto adiacent roads.
- All mud, dirt, and debris tracked onto the parking lot or any roadway shall be removed immediately by the contractor.
- The Contractor shall be responsible for keeping the public streets in the vicinity of the job site clean and free of rocks, soil and debris. Streets and/or parking areas will be scraped and swept on a daily basis by the general contractor.
- The Contractor shall protect from damage all survey monuments, property markers, benchmarks, etc. Items damaged shall be reset by a professional land surveyor licensed in the state of Missouri, at the contractor's expense
- Paving shall conform to the geotechnical report and these drawings, any identified discrepancies shall be brought to the attention of the engineer immediately. If no geotech. report is provided for the project, the contractor shall use the minimum design standards as required by the city.
- The Contractor shall provide 48—hour notification to the city engineering division or proper city staff to schedule all
- All concrete for public improvements shall comply with the city standards and specifications. If no city standards and specifications are provided, then the contractor shall comply with the standards and specifications of the Kansas City Metropolitan Materials Board (KCMMB) unless otherwise noted. Structural concrete shall be 5,000 psi and nonstructural concrete shall be 4,000 psi.
- The contractor shall be responsible for the restoration of the right-of-way and for damaged improvements such as curbs, sidewalks, street light and traffic signal junction boxes, traffic signal loop lead—ins, signal poles, etc (offsite and onsite). Damaged improvements shall be repaired in conformance with the latest city standards and to the city's satisfaction.
- All work within the road right-of-way shall conform to the technical specifications and design criteria for public improvement projects of the city of Lee Summit, Missouri or the transportation department of Missouri. A right-of-way work permit and/or street excavations permit shall be obtained by the contractor if required to complete all work within the public right-of-way.
- All traffic control in connection with construction in the right—of—way shall be in conformance with the Manual of Uniform Traffic Control Devices and/or the jurisdictional authority. It is the contractor's responsibility to obtain a traffic control permit if required.
- All waste materials, trash and construction debris shall be collected and stored in dumpsters. No construction waste shall be buried on site. All hazardous waste materials will be disposed of in the manner specified by local, state and federal regulations. Site personnel shall be instructed in these practices, and the construction manager shall be responsible for seeing that these practices are followed.
- Recommendations made by the geotechnical engineer, to be retained by the owner, and contained in the geotechnical report shall govern project conditions unless noted otherwise. Paving shall conform to the geotechnical report. Any discrepancies shall be brought to the attention of the engineer.
- The Contractor shall grade areas to provide positive drainage.
- The contractor shall be responsible for the coordination of work between suppliers and subcontractors involved in the project, including staging of construction details.
- All disturbed areas shall be maintained for dust control. Sprinkling tank trucks shall be available at all times & used on on-site disturbed areas, and other areas where dust becomes a problem as a result of construction activity.
- Nothing indicated on these drawings shall relieve the contractor from complying with appropriate safety regulations.

## <u> Utility Notes</u>:

- Boundary information, existing utilities and topographic features shown are based on information supplied by owner, surveyor, and others.
- The existing utility locations shown on these plans are approximate and may not include all utility lines present. The contractor shall be responsible to contract "One Call" and coordinate field location of all existing underground utilities prior to beginning excavation/construction activities.
- The contractor shall be responsible for any damage to any utilities or their structures during excavation/construction activities. Utilities include but are not limited to a service such as electricity, communication, water, public transportation (including traffic signals), storm systems, and items provided by a public utility.
- The contractor shall coordinate and be responsible for connection fees, system development fees, taxes, etc. for all main connections and/or extensions with and from the city and/or respective utility unless otherwise coordinated with the Owner. All utility services for this project shall be coordinated with respective utility company by contractor.
- The contractor shall be responsible for adjusting all at-grade utilities such as manhole covers, valve box covers, etc. to finish grade, whether specifically indicated in these plans or not.
- Utilities shown on the plan with specific elevations and/or structure locations are SUE quality level "B", ie: storm sewer, sanitary sewer, water hydrants & valves, utility poles, etc. All other existing utility information shown is SUE auality level "D", primarily retracement of one—call and city records.
- Refer to mechanical, electrical, and plumbing (MEP) plans for utility service sizes and exact locations. Refer to site electric plans for electric construction details.
- Provide temporary support for existing utility lines that are encountered during construction until backfilling is complete.
- Backfill all utility trenches according to the most recent edition of the jurisdictional standards.
- All utilities shall be brought within 5' of the building to connect to plumbing contractors work unless otherwise
- The Contractor shall adjust all utility fixtures, manholes and inlets to finished grade as required.
- The Contractor shall maintain 18" minimum vertical clearance between storm sewer and sanitary sewer pipes and 18" minimum vertical clearance between sanitary sewer and water main unless otherwise specified.
- Contractor shall prevent entry of mud, dirt, debris, and other material into new and existing storm sewer systems. Should any contamination occur during construction, the contractor shall clean at contractor's expense. Upon completition of all storm sewer improvements, all new and existing pipe and structures shall be cleaned out.
- Electrical, lighting, and data conduit layout shown is for graphical purposes only. See MEP plans for more detail.
- The Contractor shall provide all temporary power, process, and utility service bypasses and connections as required.

#### Erosion Control Notes:

- The installation of the silt fencing, the maintenance of the drainage swales, and the construction of the stabilized entrance shall be completed prior to any clearing and grading of any portions of the site. Disturbed portions of the site where construction activities have permanently ceased shall be stabilized with permanent seeding no later than 14 days after the last construction activity, refer to SWPPP. Roadway swales shall be stabilized with Erosion Control Devices. Once construction activity ceases permanently in an area, that area shall be stabilized with permanent seed and mulch. Only after the entire site has been stabilized, the silt fencing shall be removed.
- The general contractor, or designated Erosion Control Contractor, shall be responsible for construction and maintenance of erosion control devices and practices. The contractor shall be responsible for implementation of, and ensuring compliance of, the project Storm Water Pollution Prevention Plan (SWPPP), a copy of which shall be obtained from the Design Engineer. The SWPPP shall be maintained on site per NPDES requirements and shall be available for review at any time, by any authorized Federal, State, or local review official, as well as the Design Engineer. The general contractor, or designated Erosion Control Contractor, shall also be responsible for ensuring compliance with, and paying any fees associated with, the State of Missouri General Permit for Stormwater Runoff associated with construction activities, a copy of which shall be maintained in the aforementioned SWPPP.
- This project shall be constructed in compliance with the soil erosion and sedimentation control permit, and conform to the standards and specifications of the city of Lee Summit, Missouri, prior to any land disturbance
- Erosion and any sedimentation from work on this site shall be contained on the site and not allowed to collect on any offsite areas or in waterways. Waterways include both natural and man—made open ditches, streams, storm drains, lakes and ponds. Refer to erosion control plans for more information.
- The contractor shall be responsible to control downstream erosion and siltation during all phases of construction. Erosion Control work and procedures shall be in place prior to beginning excavation/construction activities. To ensure progressive stabilization of disturbed earth, Erosion control devices shall be staged, installed and maintained throughout land disturbance activities as directed in the drawings, project manual and in accordance with all federal, state and local standards until the site is stabilized.
- The contractor shall implement and maintain Erosion Control Devices as shown in the drawings and project manual before, and at all times during the construction of this project. Any modifications to the devices due to construction or changed conditions shall be complied with as required or as directed by the city of Lee Summit,
- The contractor shall be responsible for installation and maintenance of all Erosion Control Devices. This includes providing berms, silt fence, or other means to prevent erosion from reaching the right of way and offsite boundaries. In the event the prevention measures are not effective, the contractor shall remove any debris and erosion, restoring the right of way to original or better condition.
- Contractor is to provide erosion protection for all storm sewer inlets
- If any of the Erosion Control Devices on the site are deemed inadequate or ineffective, the city of Lee Summit, Missouri has the right to require additional Erosion Control measures at the expense of the general contractor.
- If any pump—driven dewatering is needed, it shall be discharged though a filter bag over a well—vegetated area. The pump must discharge at a non—erosive velocity. If necessary, an approved energy dissipater may be used.
- Permanent BMP's for any disturbed land area shall be completed by the general contractor within 5 calendar days after final grading or the final earth change has been completed. When it is not possible to permanently stabilize a disturbed area after land disturbance activity ceases, temporary Erosion control devices shall be implemented immediately. All temporary Erosion Control Devices shall be maintained until permanent BMP devices are implemented. All permanent BMP's will be implemented and established before a certificate of compliance is issued.
- Strip topsoil only from those areas that will be disturbed by excavation, filling, road building, or compaction by equipment. Refer to the geotechnical report for depths of stripping. Put sediment basins, diversions, and other controls into place before stripping.
- When topsoiling, maintain needed erosion control practices such as diversions, grade stabilization structures, berm, dikes, level spreaders, waterways and sediment basins.
- Grades on the areas to be topsoiled which have been previously established shall be maintained.
- Bonding Immediately prior to dumping and spreading of topsoil, loosen the subgrade by discing or scarifying to a depth of at least 4", to permit bonding of the topsoil and subsoil.
- The general contractor shall inspect the Erosion Control Devices once every 14 days under any circumstances, within 24 hours of rainfall, and daily during a prolonged rain event unless otherwise noted in the SWPPP or by the jurisdictional authority. A log of inspection report shall be maintained and accessible in accordance with National Pollution Discharge Elimination System (NPDES) requirements. Any required maintenance shall be provided within 72 hours.
- Install silt fence, inlet filters, and other Erosion Control Devices as indicated in the drawings, per APWA and authority regulations, and at additional affected areas as necessary. Build—up of sediment shall be removed promptly per authorities regulations. If silt fence decomposes or becomes ineffective prior to the end of expected usable life and the barrier is still required, the silt fence shall be replaced promptly. Sediment shall be removed from sediment traps or basins when design capacity has been reduced to 50%. Contractor shall flare the ends of the silt fence uphill in order to temporarily impound runoff.
- Earthen berms shall be regularly inspected, and inspected after each rainfall event. Repairs to earthen berms shall be made immediately. If the earthen berm shows signs of erosion, and it is determined that material must be added to fix the berm, the material shall be properly placed, compacted and reseeded. The berm shall be reseeded and stabilized, as needed, to maintain its soundness whether or not there has been any rainfall.
- Drainage swales shall be inspected regularly and after every rainfall event. Repairs to drainage swales shall be made immediately. If the flow channel and/or outlets show signs of deficiency, the damaged area(s) shall be restabilized and reseeded, as needed, to prevent further damage. If additional measures are needed to eliminate issues, contractor shall notify the engineer for possible modifications.
- Refer to the jurisdictional authority for temporary gravel construction entrance details. If not specified, refer to APWA standards. The entrance and exit areas of the project shall be cleared of all vegetation, roots, and other objectionable material. The gravel shall be placed to the proper dimensions and graded to a smooth and even slope. Construction entrance drainage shall be provided to carry water to a sediment trap or other suitable outlet.

### Stockpiling Notes:

- Select stockpile location to avoid slopes and natural drainageways, avoiding traffic routes. On large sites, re-spreading is easier and more economical where topsoil is stockpiled in small piles located near areas where they will be used.
- Sediment Barriers Use sediment fences or other barriers where necessary to retain sediment.
- Temporary Seeding Protect topsoil stockpiles by temporarily seeding as soon as possible, not to exceed 14 days, weather permitting, after the formation of the stockpile.
- Permanent Vegetation If stockpiles will not be used within 12 months, they must be stabilized with permanent vegetation to control erosion and weed growth.
- All stockpiled soils shall be maintained in such a way as to prevent erosion from leaving the site. Silt fence must be installed around the perimeter of the stockpile.

#### <u>Seeding Notes:</u>

or oats at 100lbs. per acre.

seeding. Apply the mixture at 2lbs. per 1000ft

re—seedings within the same season, if possible.

• Seeding shall be as follows unless otherwise stated in the landscape plans.

more than 1" deep, and grasses and legumes no more than  $\frac{1}{2}$ ".



• Annual rye grass, wheat, or oats should be used for temporary seeding. Apply rye grass at 120lbs. per acre, wheat

phone: 913.451.9390 fex: 913.451.9391 www.davidsonae.com

Davidson Architecture

BAUL A. Paul A. Miller

Demolition Notes:

for proper installation.

operations.

• At the site, the Contractor shall maintain the required documents for immediate review, included but not limited to: Site Safety Plan, Demolition Permits, Street Closure Permits, Contract Documents, Demolition Plans, Salvage Verification Forms, SWPPP Etc.

• A mixture of 65% kentucky bluegrass and 35% chewing fescue or creeping red fescue should be used for permanent

complete grading according to the approved plan. Lime and fertilizer needs should be determined by soil test. Apply

seasons when satisfactory arowing conditions exist. The planting operations shall not be performed during times of

• Seed should be labeled in accordance with U.S. Department of Agriculture rules and regulations under the federal seed act and comply with the requirements of the Missouri seed law. Labels contain important information on seed purity,

• Apply seed uniformly with a cyclone seeder, drill, cultipacker seeder, or hydroseeder. Small grains should be planted no

• Generally, a permanent stand of vegetation cannot be determined to be fully established until soil cover has been

• The Contractor shall seed all disturbed areas unless otherwise noted by landscape plans. Immediately after seeding,

• The Contractor shall sod all disturbed areas within the public street right—of—way. Refer to city and state standards

mulch all seeded areas with unweathered small grain straw, spread uniformly at the rate of 1-2 tons per acre or

100lbs (2-3) bales) per 1000ft<sup>2</sup>. The mulch should be anchored with disc type mulch anchoring tool or other means

maintained for one full year from planting. Inspect seeded areas for failure and make necessary repairs and

approved by owner's representative. The contractor assumes full and complete responsibility for all such plantings and

extreme drought, when ground is frozen or during times of other unfavorable climatic conditions unless otherwise

Seedbed preparation—Install necessary mechanical erosion and sedimentation control practices before seeding, and

the lime and fertilizer evenly and incorporate into the top 4"-6" of soil by discing or other suitable means.

germination, and presence of weeds. Weed seed should not exceed 1.0% by weight of the mixture.

as approved by the jurisdictional authority. Mulch matting may be used in lieu of loose mulch.

All seeding shall be performed during favorable weather conditions and only during normal and accepted planting

- The Contractor shall notify all utility companies for field verification and disconnection of utilities prior to any work. Coordination is required for both temporary and permanent utility services that serve the site including, but not limited to: water lines, power, telephone, cable, storm sewer, sanitary sewer with the city and/or respective utility.
- The Contractor is specifically cautioned that the locations and/or elevation of existing utilities as shown on these plans are based on records of the various utility companies, and where possible, measurements taken in the field. The information is not to be relied on as being exact or complete. Contractor shall contact One Call utility information service for utility locates. The Contractor must call the appropriate utility companies at least 72 hours before any excavation to request exact field location of utilities. The Contractor shall also coordinate and allow access for utility companies to perform any disconnection or relocation activities. It shall be the responsibility of the Contractor to relocate all existing utilities which conflict with the proposed improvements shown on the plans.
- Remaining building structures and remaining utility services shall be protected from damage. Damage to any existing features to remain will be replaced at the Contractor's expense.
- Areas disturbed during demolition shall be thoroughly evaluated by the geotechnical engineer responsible for site preparation prior to placement of structural fill. All disturbed soils shall be undercut prior to placement of structural fill, per the geotechnical recommendations. Contractor shall notify the geotechnical engineer at least 72 hours prior to placement of structural fill.
- Excavations created by the removal of any existing utility lines that extend below design grades shall be cut wide enough to allow use of heavy construction equipment to compact the fill. Base of the excavations shall be thoroughly evaluated by the geotechnical engineer prior to placement of fill. If existing utilities are to be left in-place, existing trench backfill shall be evaluated in accordance with the recommendations of evaluation of existina fill.
- The Contractor shall be responsible for obtaining all Federal, State, and local permits, obtaining all inspections, and shall conform to all governing codes and regulations required to perform necessary abatement during demolition, should hazardous materials be encountered.
- Contractor is responsible for legally disposing of all materials and associated cost of interim storage facilities.
- For tree & stump removal, the Contractor shall remove all root systems from the site not designated to be saved. Materials disturbed during removal of stumps shall be undercut and replaced with structural fill. A zone of desiccated soils may exist in the vicinity of the trees. The desiccated soils have a higher swell potential and shall be undercut and replaced with structural fill.
- No construction waste shall be buried on site. All hazardous waste materials will be disposed of in the manner specified by local, state and federal regulations.

### Retaining Wall Notes:

- Site retaining wall improvements shall be designed by a licensed professional engineer retained by the contractor. The wall engineer and contractor shall satisfy themselves of the conditions of the surrounding site features and any interactions with the proposed improvements.
- Retaining wall design drawings and specifications shall be provided to the owner and owner's representative for review and approval. All retaining wall designs shall be signed and sealed by a registered Professional Engineer licensed in the state of Missouri. Design services shall be included in retaining wall pricing.
- Refer to Retaining Wall drawings for wall information. Civil plan set shall only be used for general location and spot elevations. • The Contractor is responsible for coordinating all inspections, certifications, permits, fees and close out of the
- wall unless otherwise determined. Contractor shall notify wall design engineer for final inspection. Contractor shall include in construction cost for all of the above items related to the installation of the retaining wall.
- Any wall shown is a schematic representation of the proposed walls. The spot elevations denoting retaining walls are provided on the site grading plan.

• If the wall is greater than 30" and is in an accessible area, guard rails are required per code.

## Americans with Disabilities Act (ADA) Notes:

• The running and cross slopes for all sidewalks, accessible paths, ramps, designated parking stalls, etc., shall be in compliance with latest Federal ADA guidelines, in addition to any accessibility standards adopted by the governing municipality. Prior to installation/construction, if any discrepancies are found within the plans, the Engineer shall be notified.

4301 Indian Creek Parkway Overland Park, KS 66207

& Engineering, LLC License # 2010029713

License # E-28140

a

1

(1)

addition

building

 $\boldsymbol{\omega}$ 

date

SML

PAM

05.17.2019

checked by

drawn by


revisions

7

**O**\_0

drawing type permit project number

sheet number

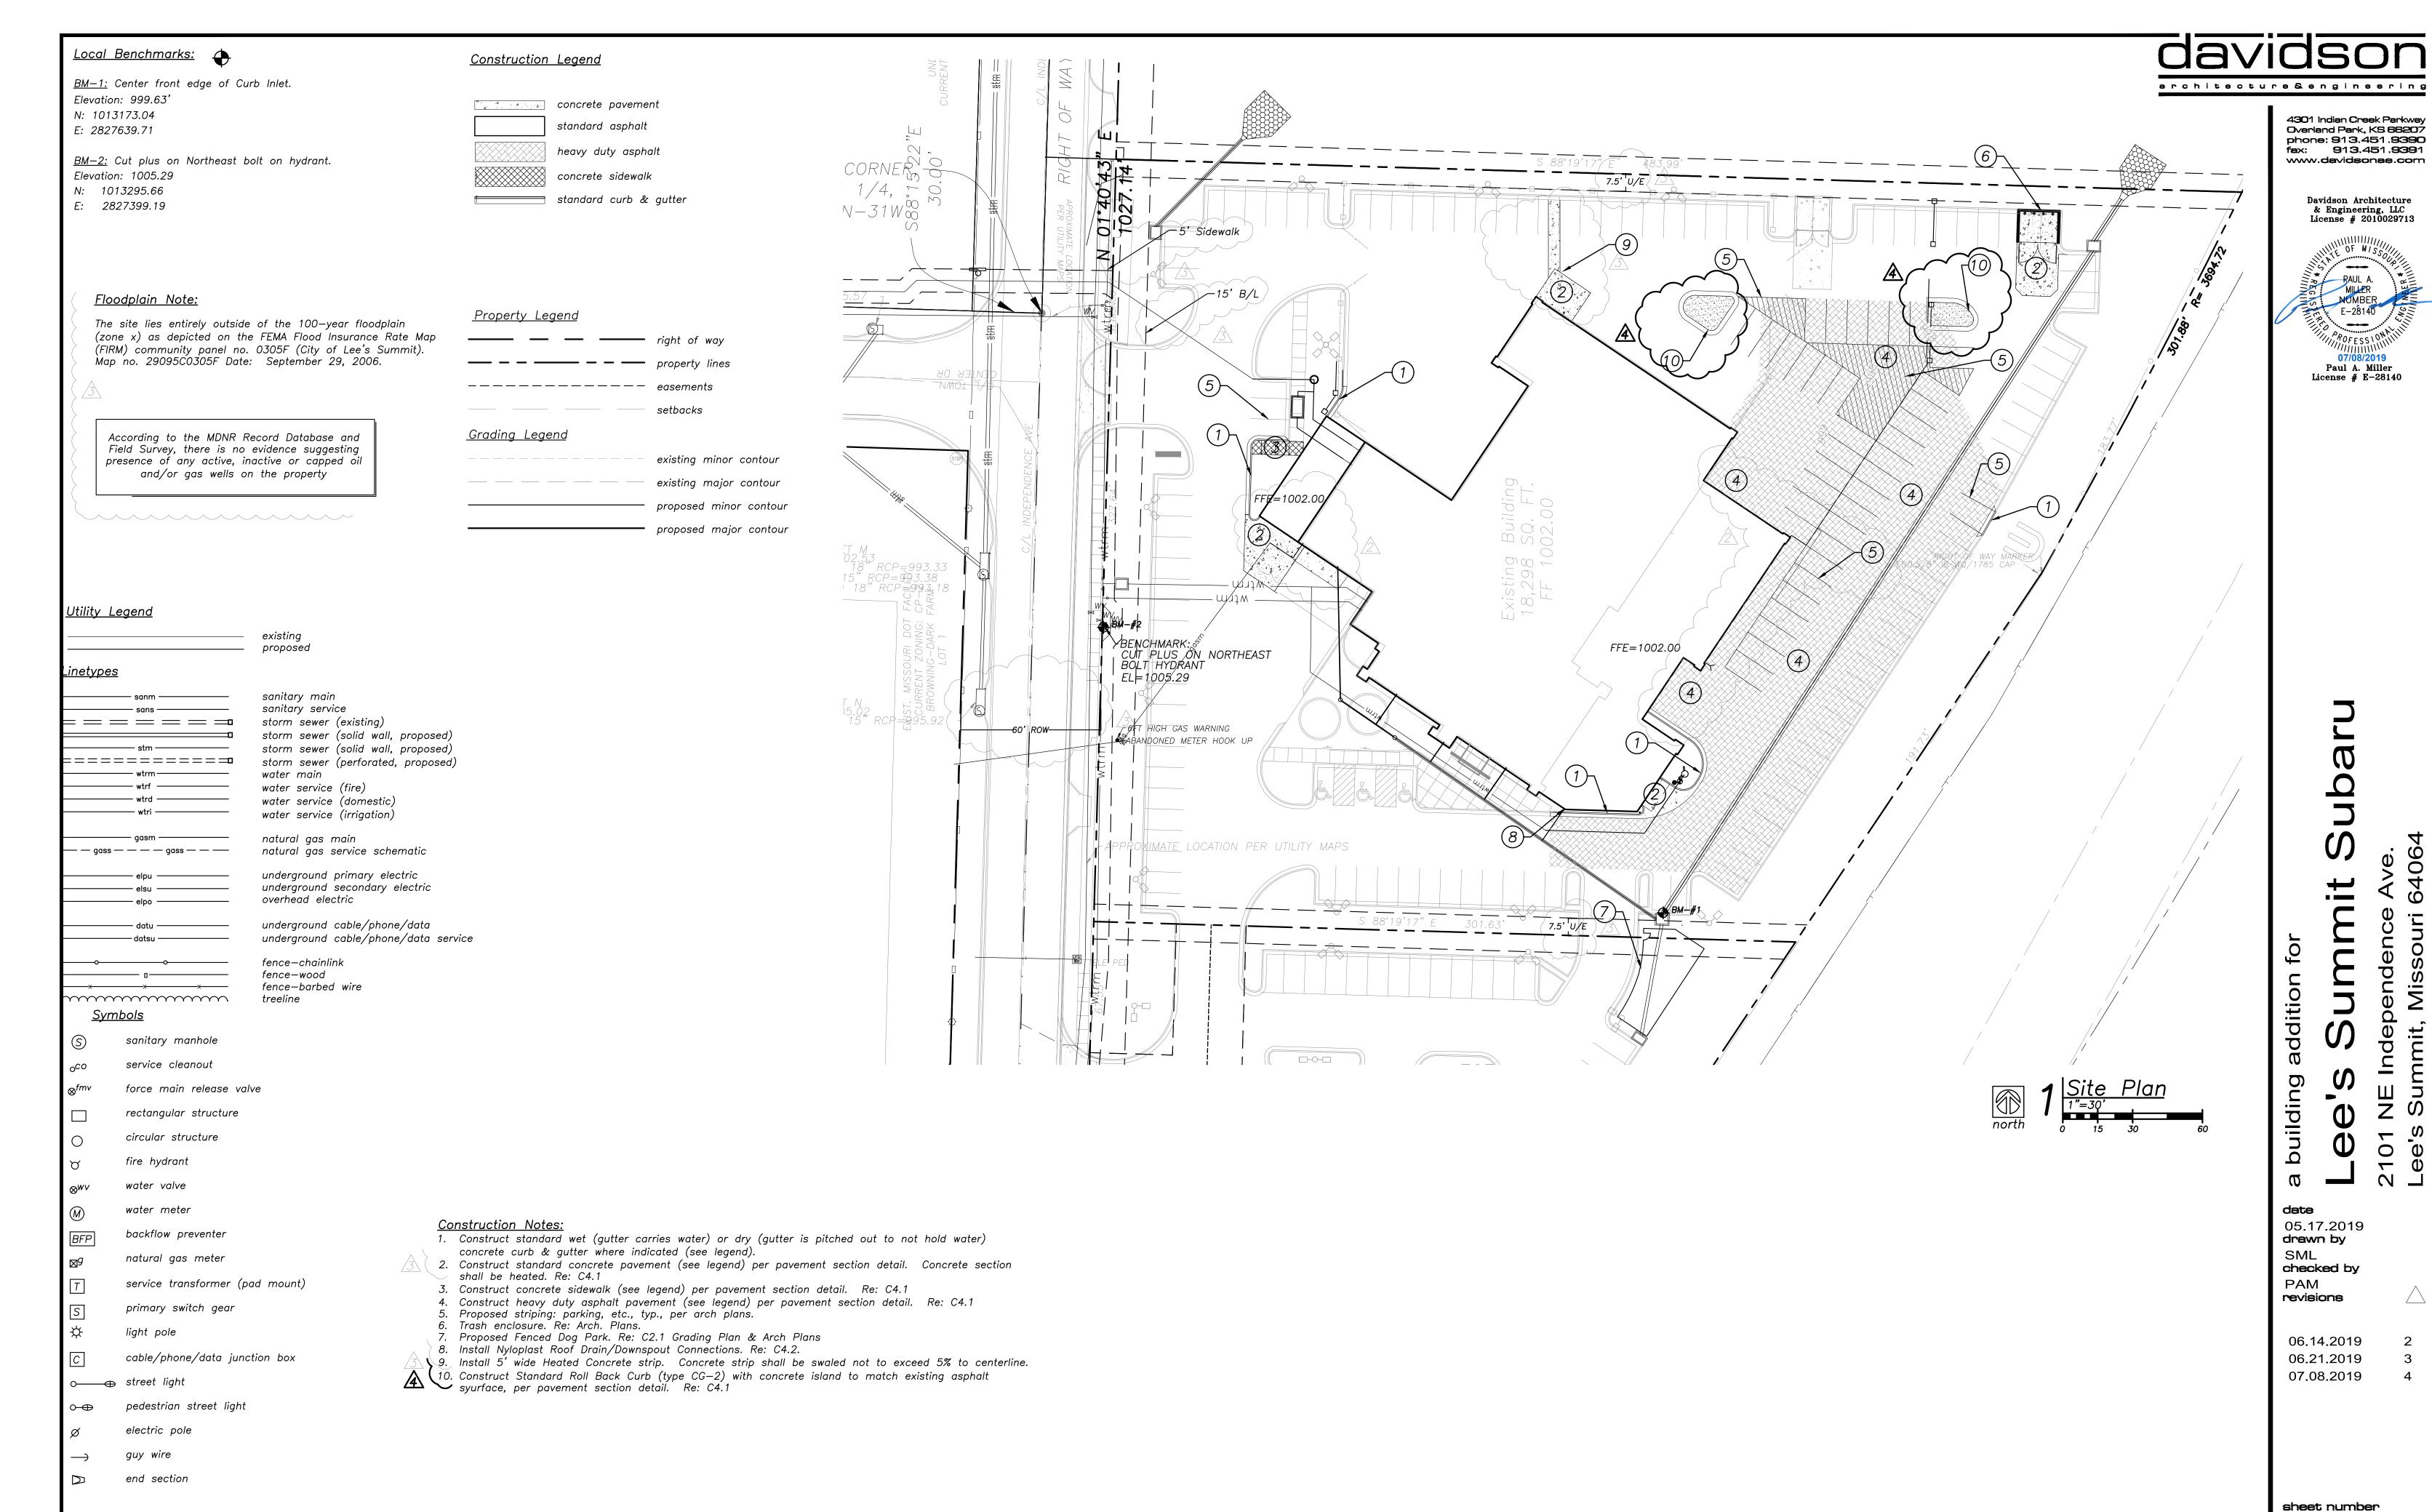


drawing type

permit

project number

18087

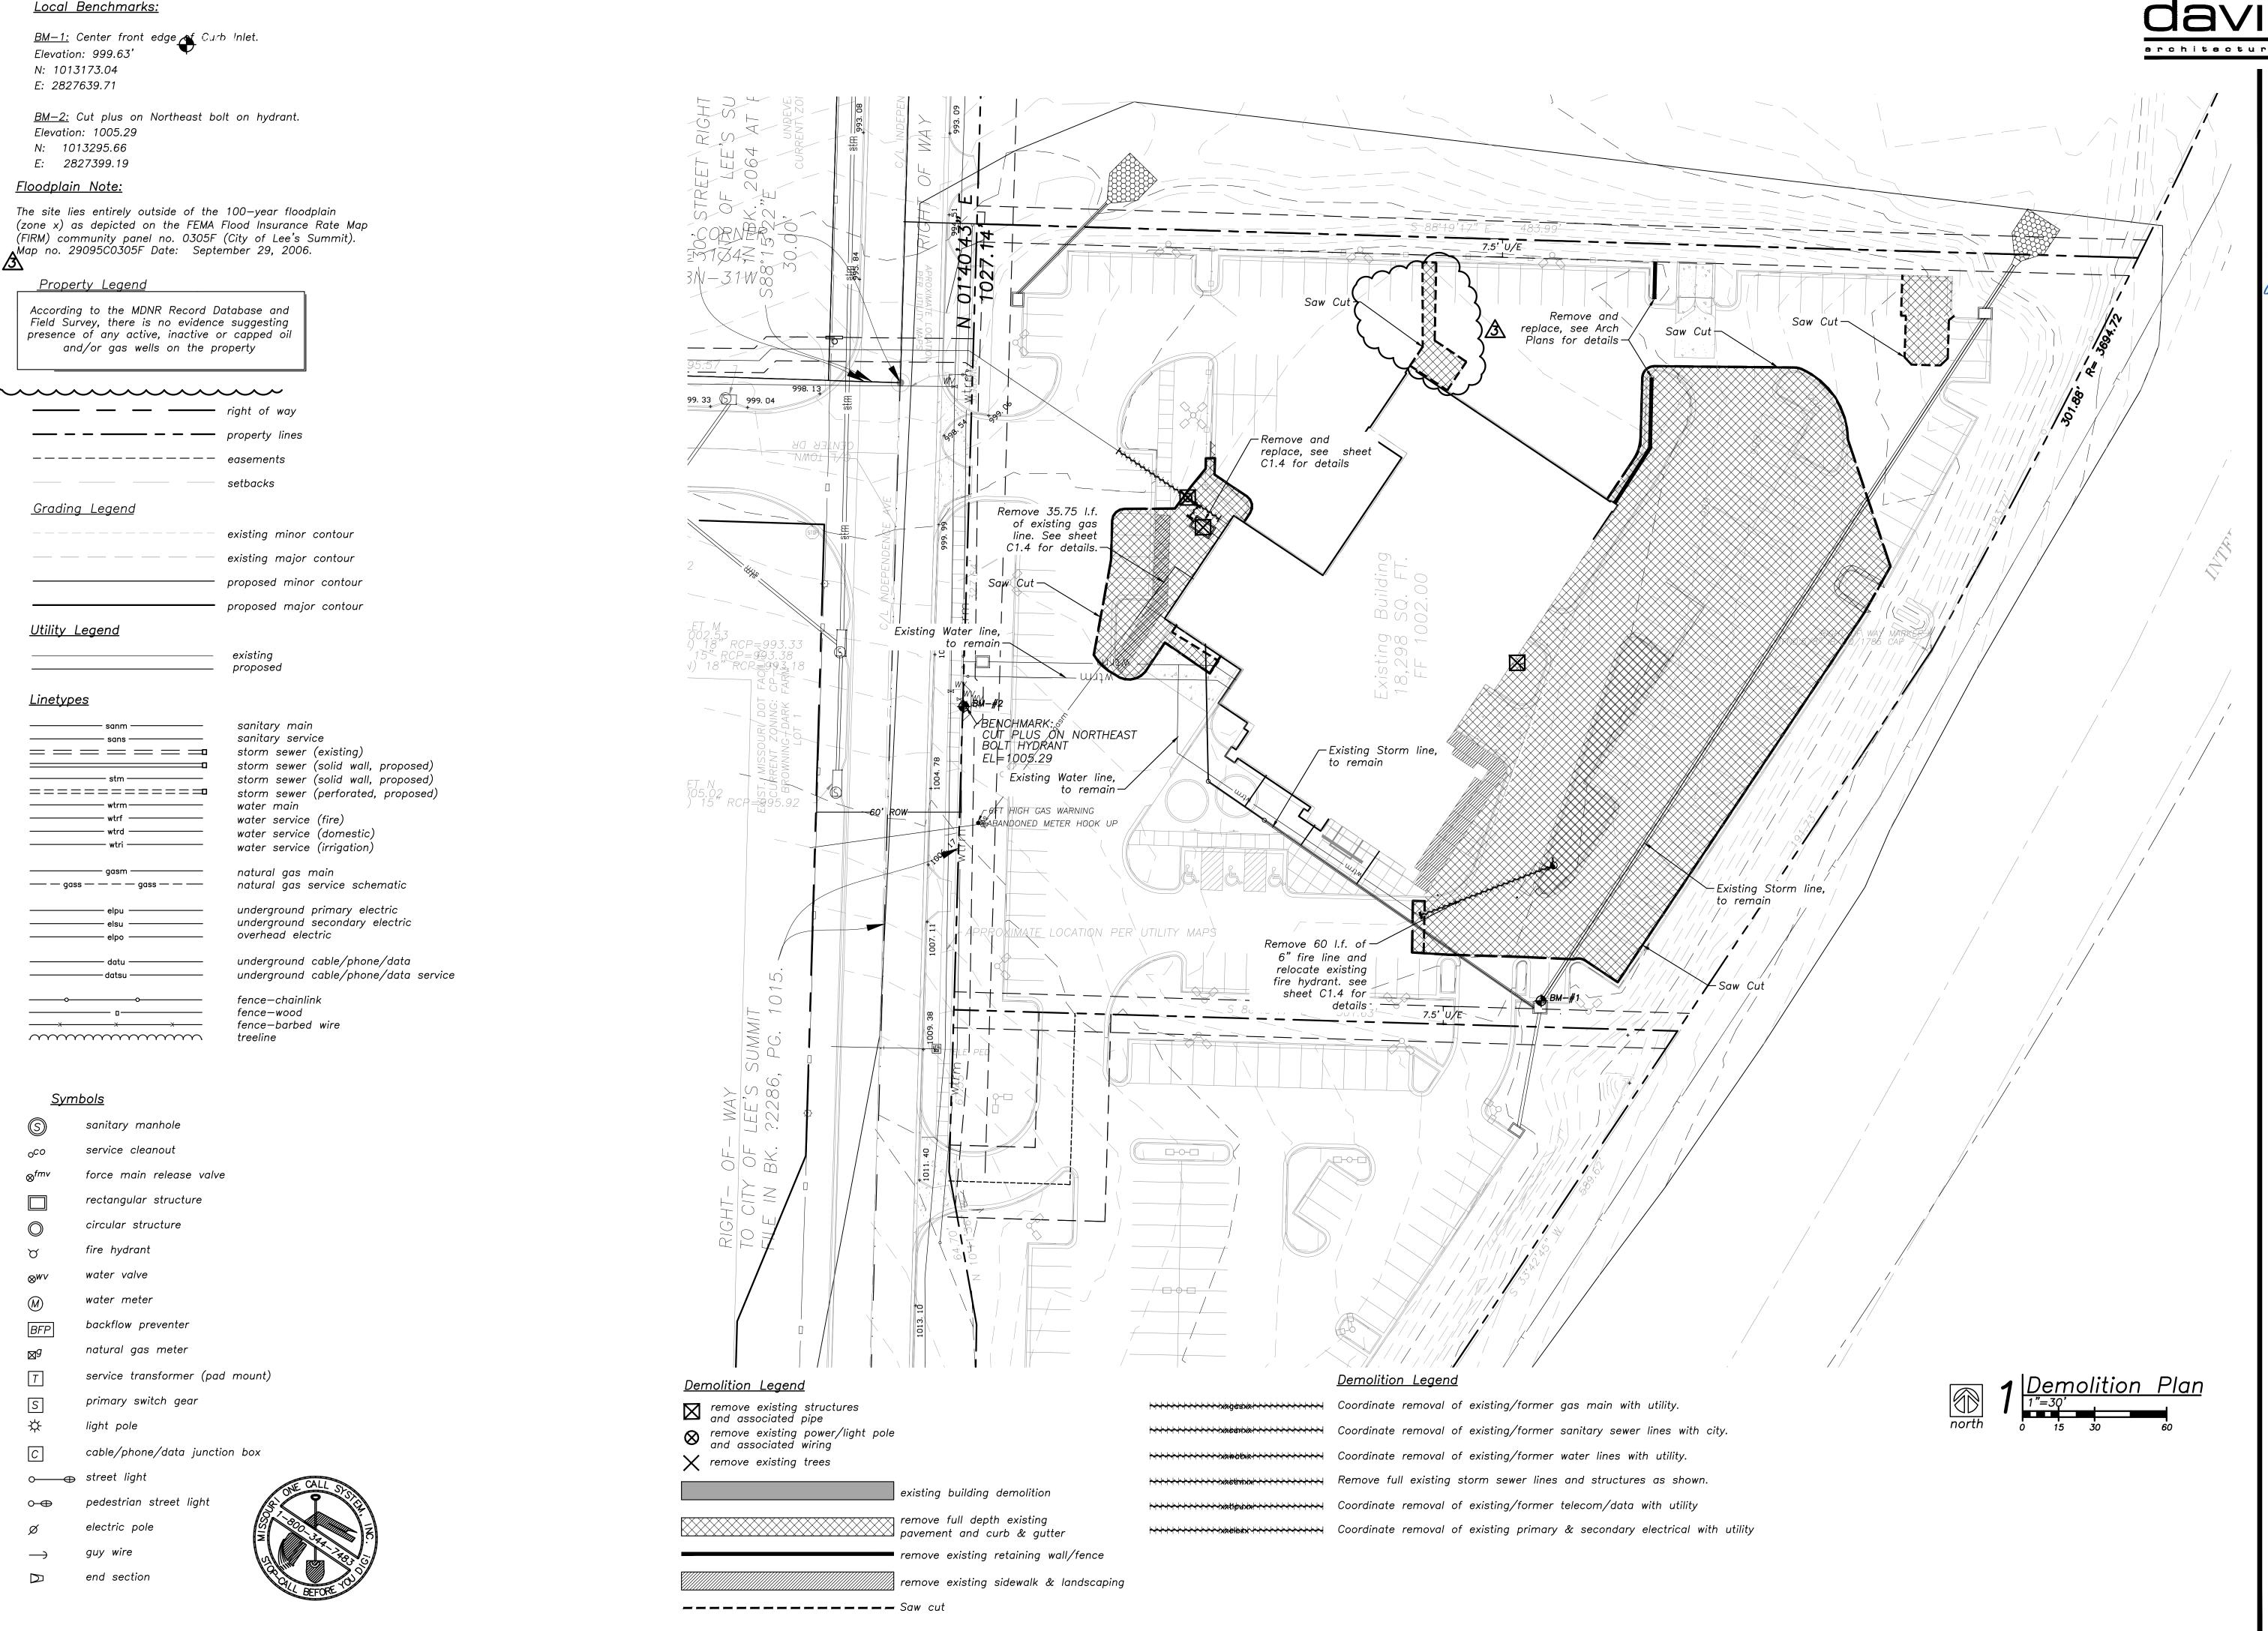

erchitecture&engineering

4301 Indian Creek Parkway Overland Park, KS 66207 phone: 913.451.9390 fex: 913.451.9391 www.davidsonae.com

Davidson Architecture & Engineering, LLC License # 2010029713

Paul A. Miller License # E-28140

addition

building date 05.17.2019 drawn by SML checked by PAM

revisions

06.14.2019

06.21.2019

sheet number

**Utility Contacts** 

Sanitary sewers — City of Lee's Summit, phone (816) 969—1900

Water — City of Lee's Summit, phone (816) 969—1900

Electric - KCP&L, phone (888) 471-5275

Gas - Spire, phone (816) 969-2266

Storm sewer - City of Lee's Summit, phone (816) 969-1800

(zone x) as depicted on the FEMA Flood Insurance Rate Map (FIRM) community panel no. 0305F (City of Lee's Summit). Map no. 29095C0305F Date: September 29, 2006.

Field Survey, there is no evidence suggesting

	existing proposed
<u>Linetypes</u>	
sanm	sanitary main sanitary service storm sewer (existing) storm sewer (solid wall, proposed) storm sewer (solid wall, proposed) storm sewer (perforated, proposed) water main water service (fire) water service (domestic) water service (irrigation)
gasm gass gass	natural gas main natural gas service schematic
elpu ————————————————————————————————————	underground primary electric underground secondary electric overhead electric
datu datsu	underground cable/phone/data underground cable/phone/data servi
	fence—chainlink fence—wood fence—barbed wire treeline

<u>Sym</u>	n <u>bols</u>	Property Legend		
S	sanitary manhole		right of way	
oco	service cleanout		property lines	
$\bigcirc^{fmv}$	force main release valve		easements	
	rectangular structure		setbacks	
$\circ$	circular structure	<u>Grading Legend</u>		
Q	fire hydrant		existing minor contour	
$\otimes^{WV}$	water valve		existing major contour	
M	water meter		proposed minor contou	
BFP	backflow preventer		proposed major contou	
<u></u>	natural gas meter			
T	service transformer (pad mount)			




o——⊕ street light

cable/phone/data junction box

pedestrian street light

electric pole


guy wire

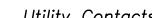

Telephone — At&T, phone (800) 464—7928

Cable – Time Warner, phone (816) 358–8833

\*\*\*call before you dig — one call system (800) 344—7483

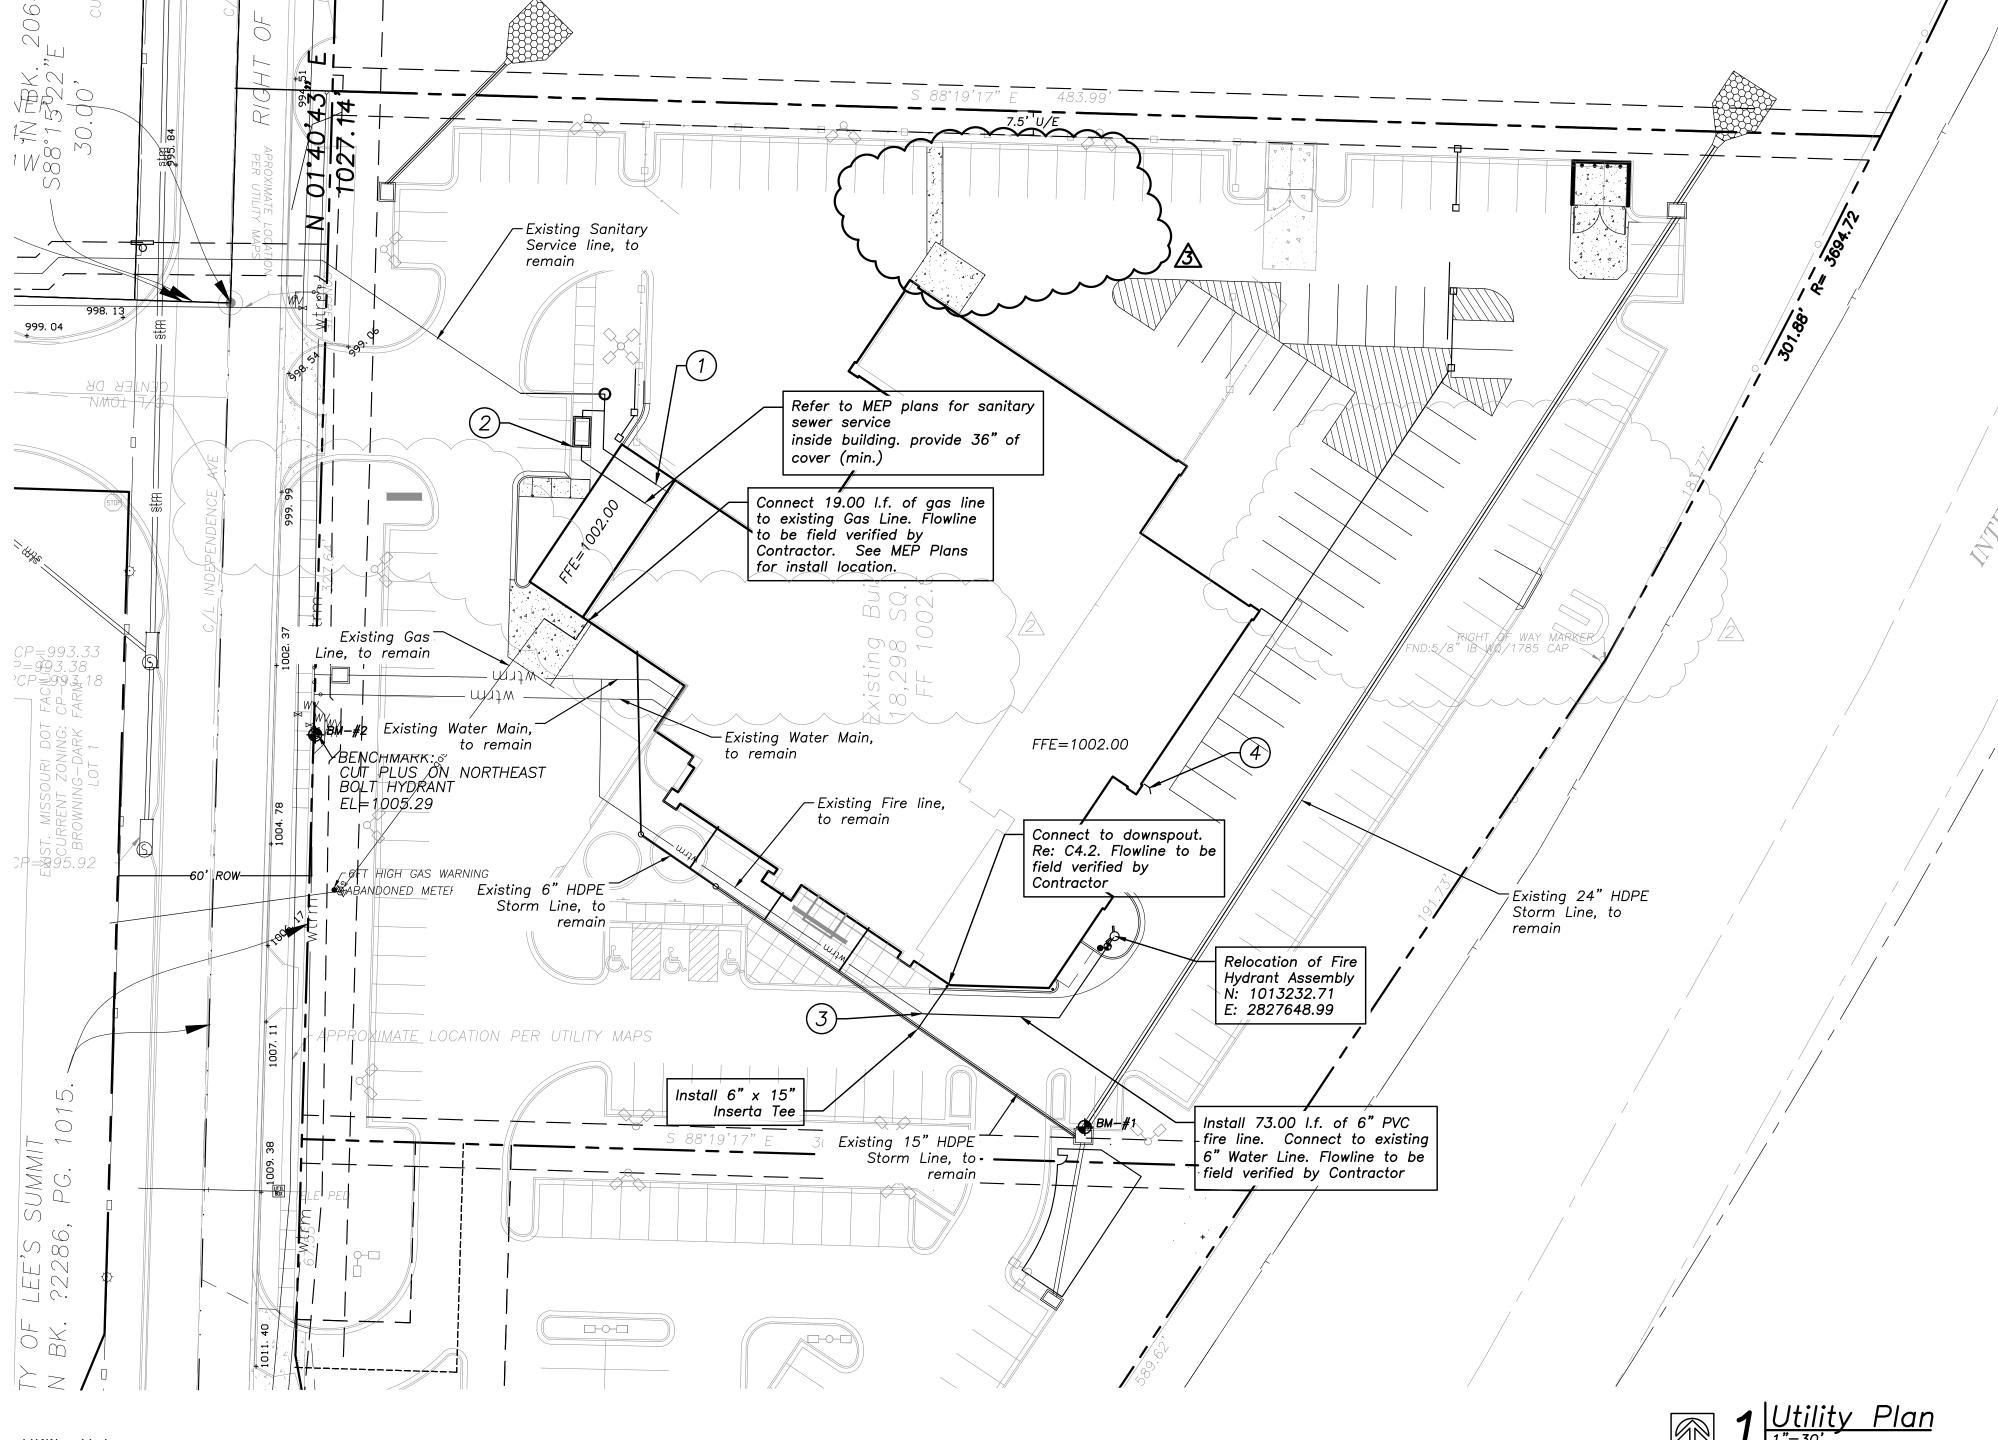

<u>Utility Notes</u>

1. Proposed sanitary sewer service, connected to existing service force main. Install approx. 63.40 L.F. 6" PVC SDR—26 sanitary sewer service pipe at 2.0% minimum slope, with (4) 45° horiz. elbows (2x 90° bends), WYE (for grease line junction), and sampling cleanout, from building to existing main in utility easement.

F/L at Bldg = 999.00

F/L at service connection = unknown, to be field verified by Contractor.

2. Proposed grease/oil interceptor. Install 1,000 gallon precast grease interceptor that meets the requirements set by the City of Lee's Summit Public Works Department. Install approx. 5 L.F. 4" PVC SDR—26 at 2.0% min., from building to grease interceptor. From interceptor, install approx. 1 L.F. 4" PVC SDR—26 at 2.0% min. to WYE on primary waste service line. Install 2" PVC vent pipe from sampling cleanout back to building, see MEP plans for continuation.

F/L at BIdg = 999.00

F/L at GI(In) = 998.90F/L at GI (Out) = 998.70


3. Install 73.00 l.f. of 6" PVC fire line, connected to the existing fire line. Existing flowline connection to be field verified by Contractor.

4. FDC Connection

4301 Indian Creek Parkway Overland Park, KS 66207 phone: 913.451.9390 fex: 913.451.9391 www.davidsonae.com

architecture&engineering

Davidson Architecture & Engineering, LLC License # 2010029713

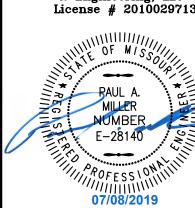

Paul A. Miller License # E-28140

addition building

 $\boldsymbol{\omega}$ date 05.17.2019 drawn by SML checked by PAM revisions

06.14.2019

06.21.2019

sheet number

----- setbacks

architecture&engineering

4301 Indian Creek Parkway Overland Park, KS 66207 phone: 913.451.9390 fax: 913.451.9391 www.davidsonae.com

Davidson Architecture & Engineering, LLC License # 2010029713




Paul A. Miller License # E-28140

date 05.17.2019 drawn by SML checked by PAMrevisions


06.21.2019 07.08.2019

sheet number

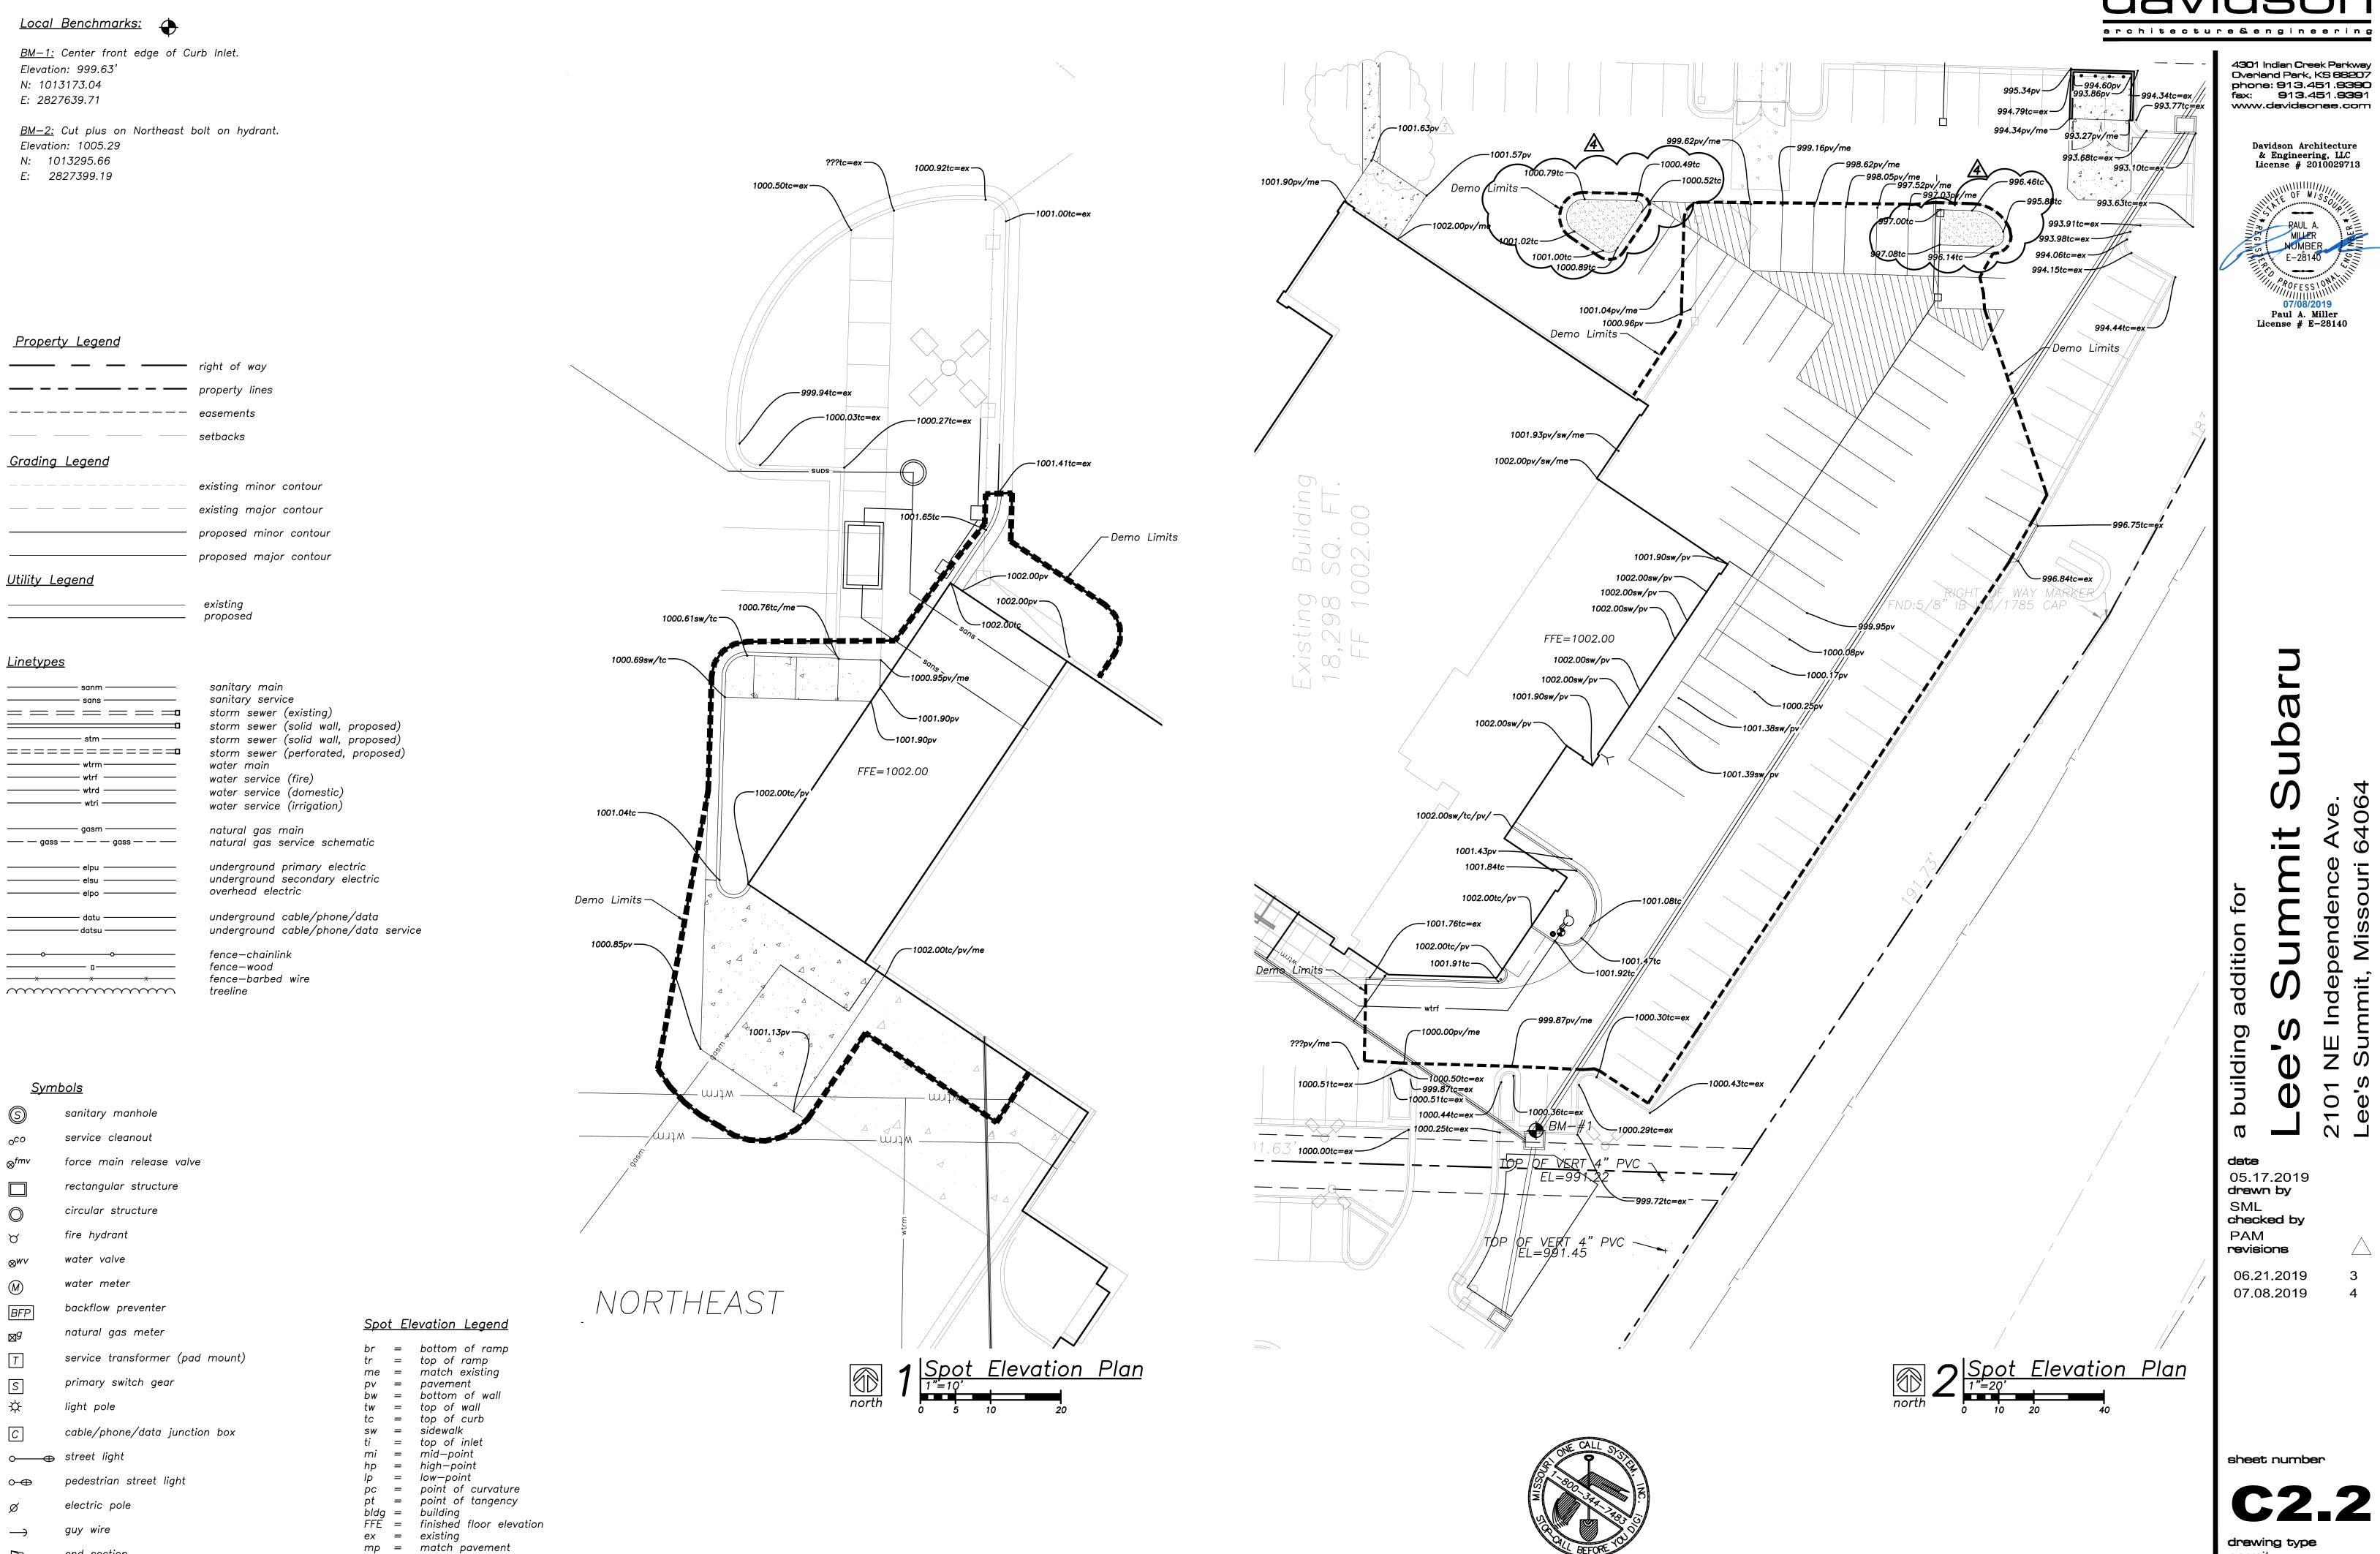

 $\square$ 

end section

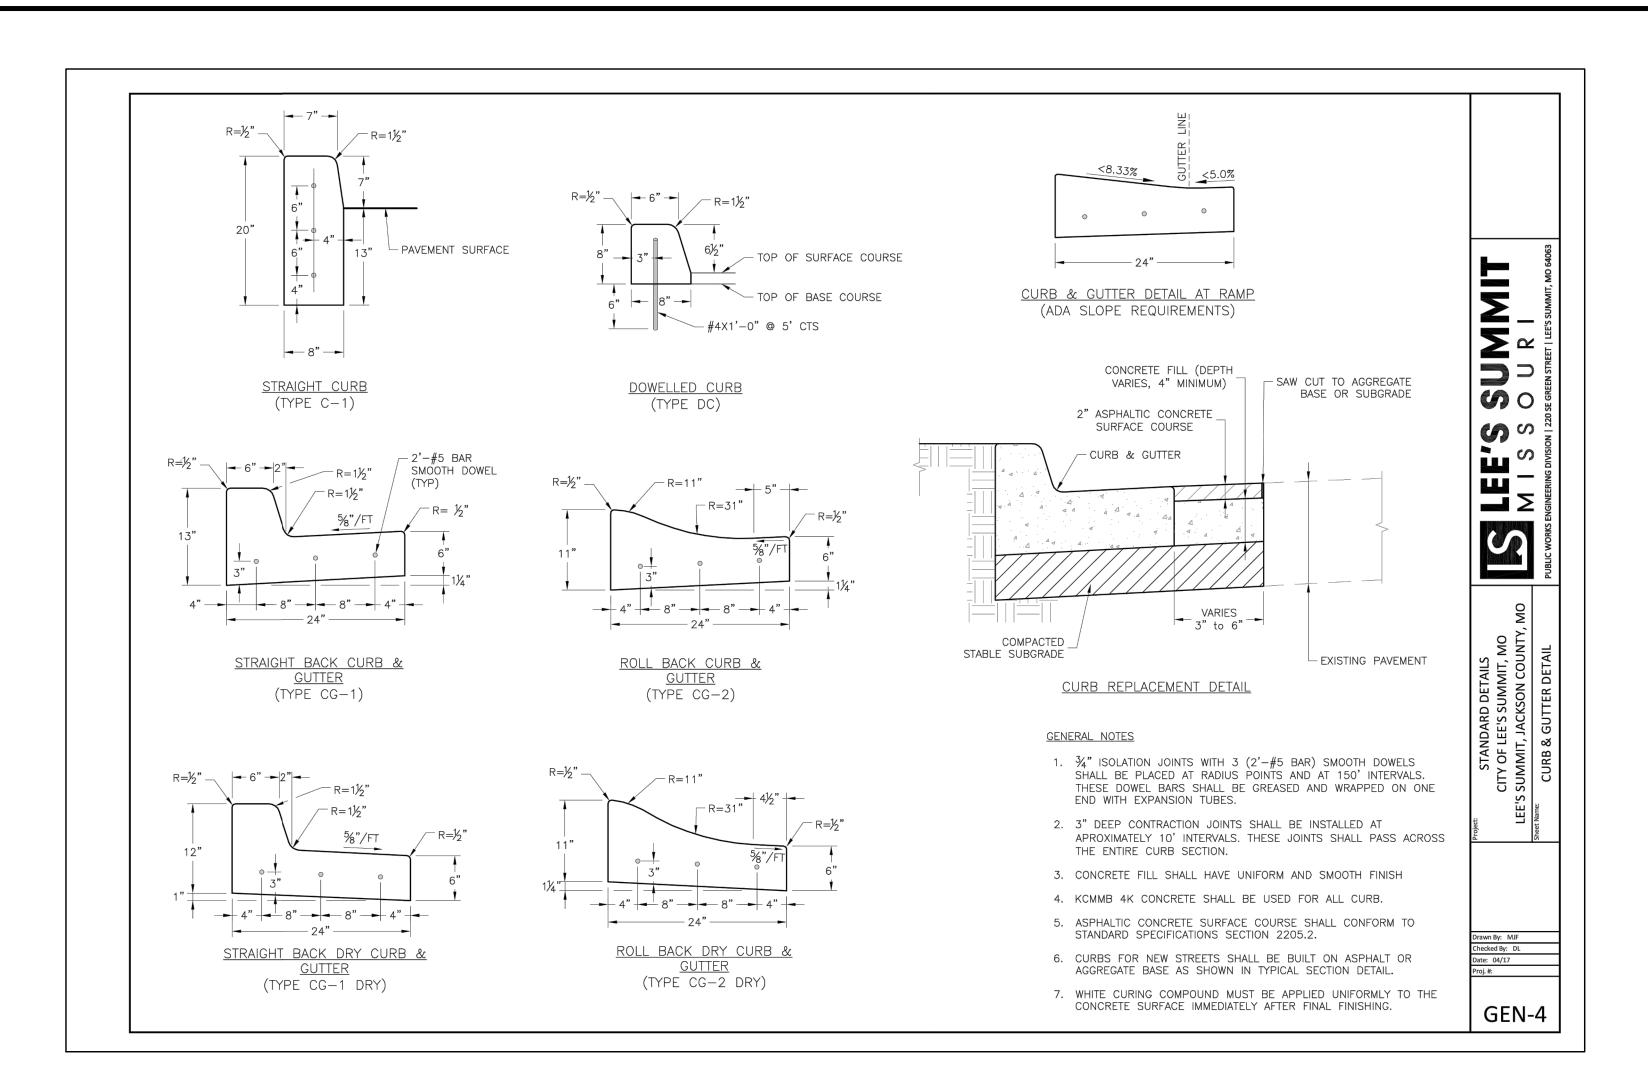




4301 Indian Creek Parkway Overland Park, KS 66207 phone: 913.451.9390

fex: 913.451.9391

www.davidsonae.com

Davidson Architecture & Engineering, LLC License # 2010029713

Paul A. Miller License # E-28140

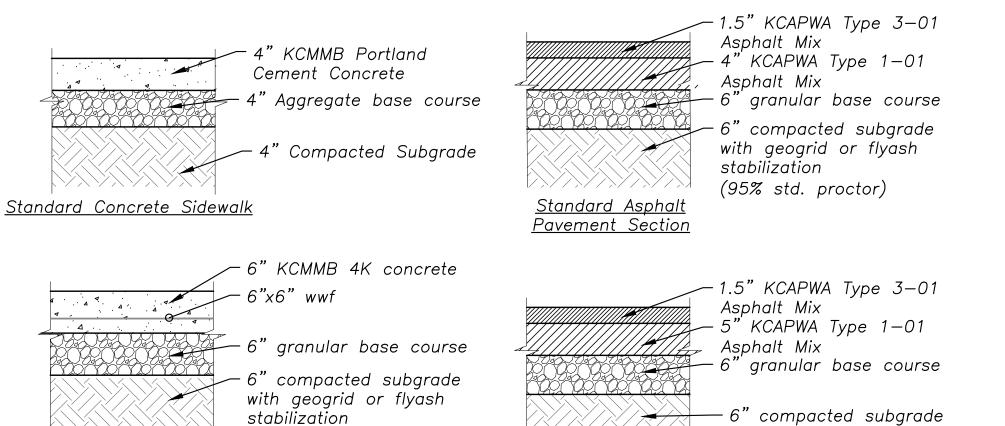

- 8" KCMMB 4K concrete -6" granular base course 'compacted subgrade

Pavement Section

<u>Display Concrete</u>

<u>Pavement Section</u>

<u>Heavy—Duty Asphalt</u>

<u>Pavement Section</u>

with geogrid or flyash stabilization (95% std. proctor)

(95% std. proctor)

1. All pavements shall conform to Lee's Summit City Standard. 2. Refer to the geotech for site recommendations.


Where city pavement standards and geotech recommendations differ, contractor shall use the more stringent of the two.


with geogrid or flyash

(95% std. proctor)

stabilization

4. Any discrepancies shall be brought to the attention of the engineer.

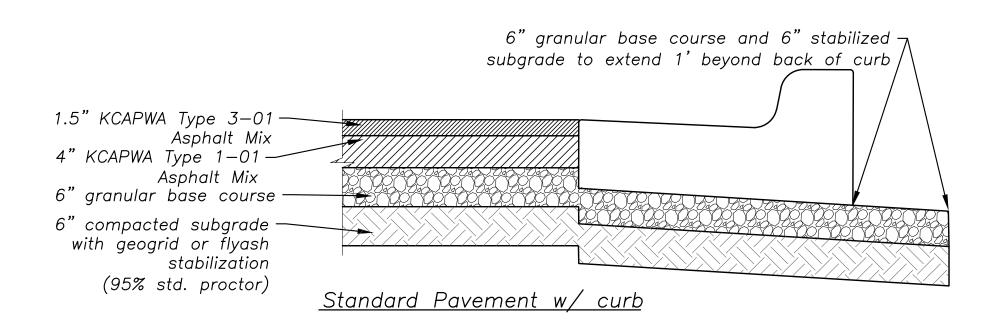

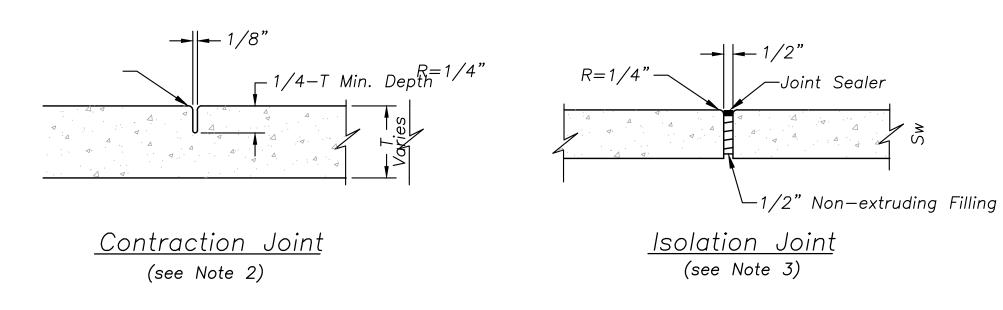

# <u>Joint Details</u>

## <u>Notes</u>

- 1. Concrete shall be KCMMB-4K unless otherwise
- 2. Key all construction joints or use tie bars #4 Epoxy coated @ 12" o.c.
- 3. Longitudinal joint spacing to match width of
- 4. Isolation joints shall be placed where walk abuts driveways and similar structures, and 250' centers max.
- 5. Install 18" tie bars #4 Epoxy coated @ 18" o.c.

Pavement Details

Not To Scale

 $\boldsymbol{\sigma}$ date 05.17.2019 drawn by SML checked by PAM revisions

addition for

building

06.21.2019


sheet number

drawing type project number





Davidson Architecture & Engineering, LLC License # 2010029713

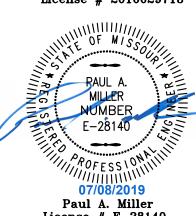


07/08/2019 Paul A. Miller License # E-28140


s addition for Subal Subal Independence Ave.

date
05.17.2019
drawn by
SML
checked by
PAM
revisions

sheet number


drawing type
permit
project number

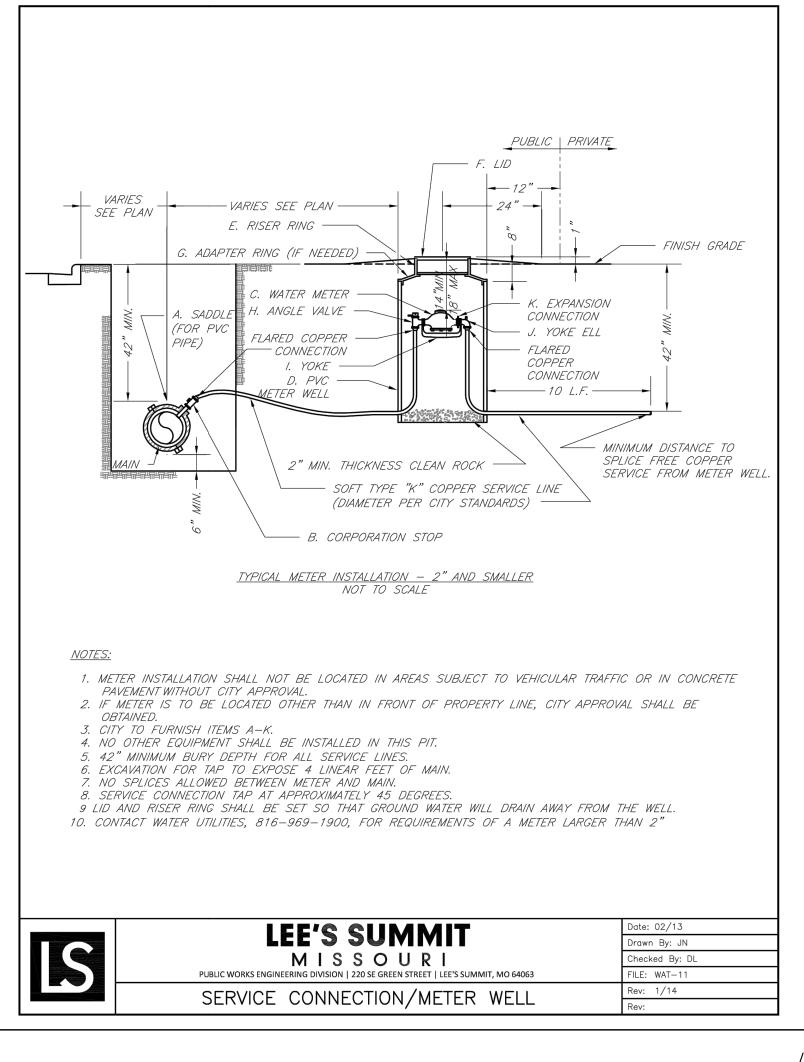

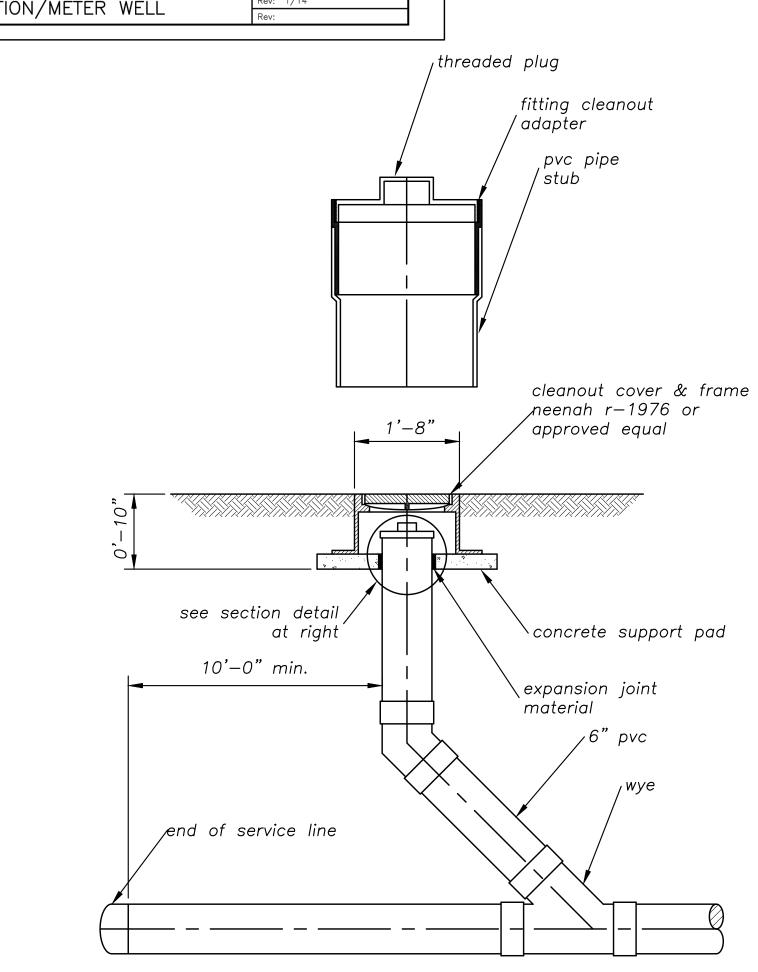



in bownspour connections betan

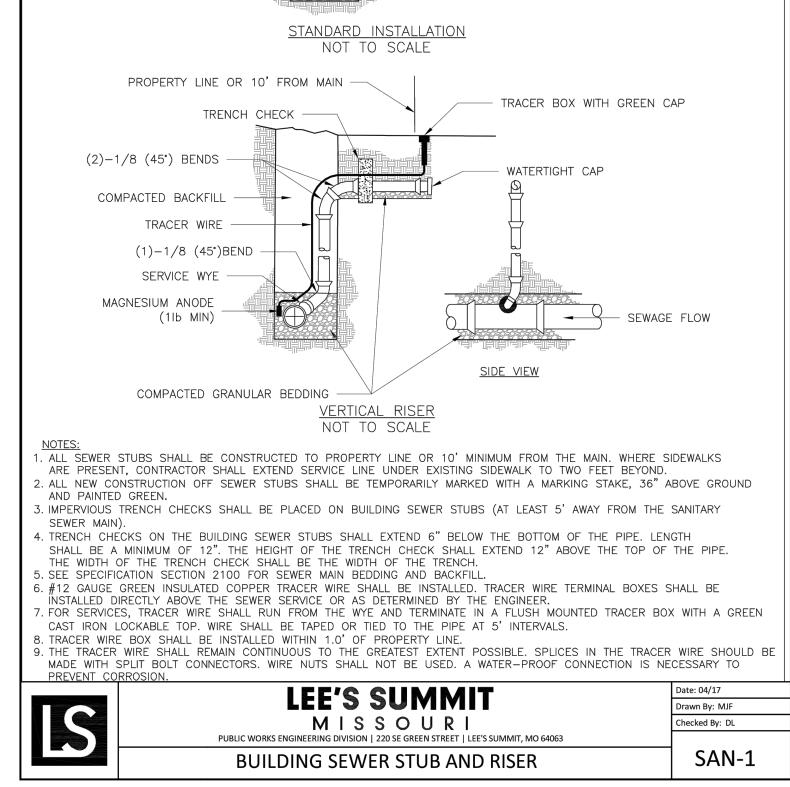

TRENCH CHECK

1-1/8 (45°) BEND —

TRACER WIRE -

SERVICE WYE

COMPACTED BACKFILL

MAGNESIUM ANODE

(11b MIN)

6" DOWNSPOUT (22 LOCATIONS TYPICAL SEE ARCHITECTURAL PLANS FOR LOCATIONS) INLINE DRAIN-- 8" HDPE DRAINS (22 LOCATIONS TYPICAL) 18" HDPE STORM SEWER MAIN INSTALL "INSERTA TEE" WATERTIGHT ADAPTER IT SHALL BE CONNECTED TO STORM SEWER - MAIN AT OR ABOVE THE RECEIVING PIPE CENTER LINE. CONCRETE POUR RING -① 8" DUCTILE IRON INLET RING CONCRETE PAVEMENT PER CIVIL PLANS INLET & OUTLET ADAPTER 8" FOR CORRUGATED HDPE INVERT ACCORDING TO ② WATERTIGHT JOINT (CORRUGATED HDPE) THE BACKFILL MATERIAL SHALL BE CRUSHED STONE OR OTHER

PROPERTY LINE OR

WATERTIGHT CAP

TRACER BOX

WITH GREEN CAP

10' FROM MAIN


- COMPACTED GRANULAR BEDDING


GRANULAR MATERIAL SHALL BE CRUSHED STONE OR OTHER
GRANULAR MATERIAL MEETING THE REQUIREMENTS OF CLASS II
MATERIAL AS DEFINED IN ASTM D2321. BEDDING & BACKFILL FOR
SURFACE DRAINAGE INLETS SHALL BE PLACED & COMPACTED
UNIFORMLY IN ACCORDANCE WITH ASTM D2321.

①- INLET RING SHALL BE DUCTILE IRON PER ASTM A536 GRADE 70-50-05
②- DRAINAGE CONNECTION STUB JOINT TIGHTNESS SHALL CONFORM TO ASTM D3212
FOR CORRUGATED HDPE (ADS & HANCOR DUAL WALL) & SDR 35 PVC

Roof Drain/Downspout Connections Detail

Not To Scale

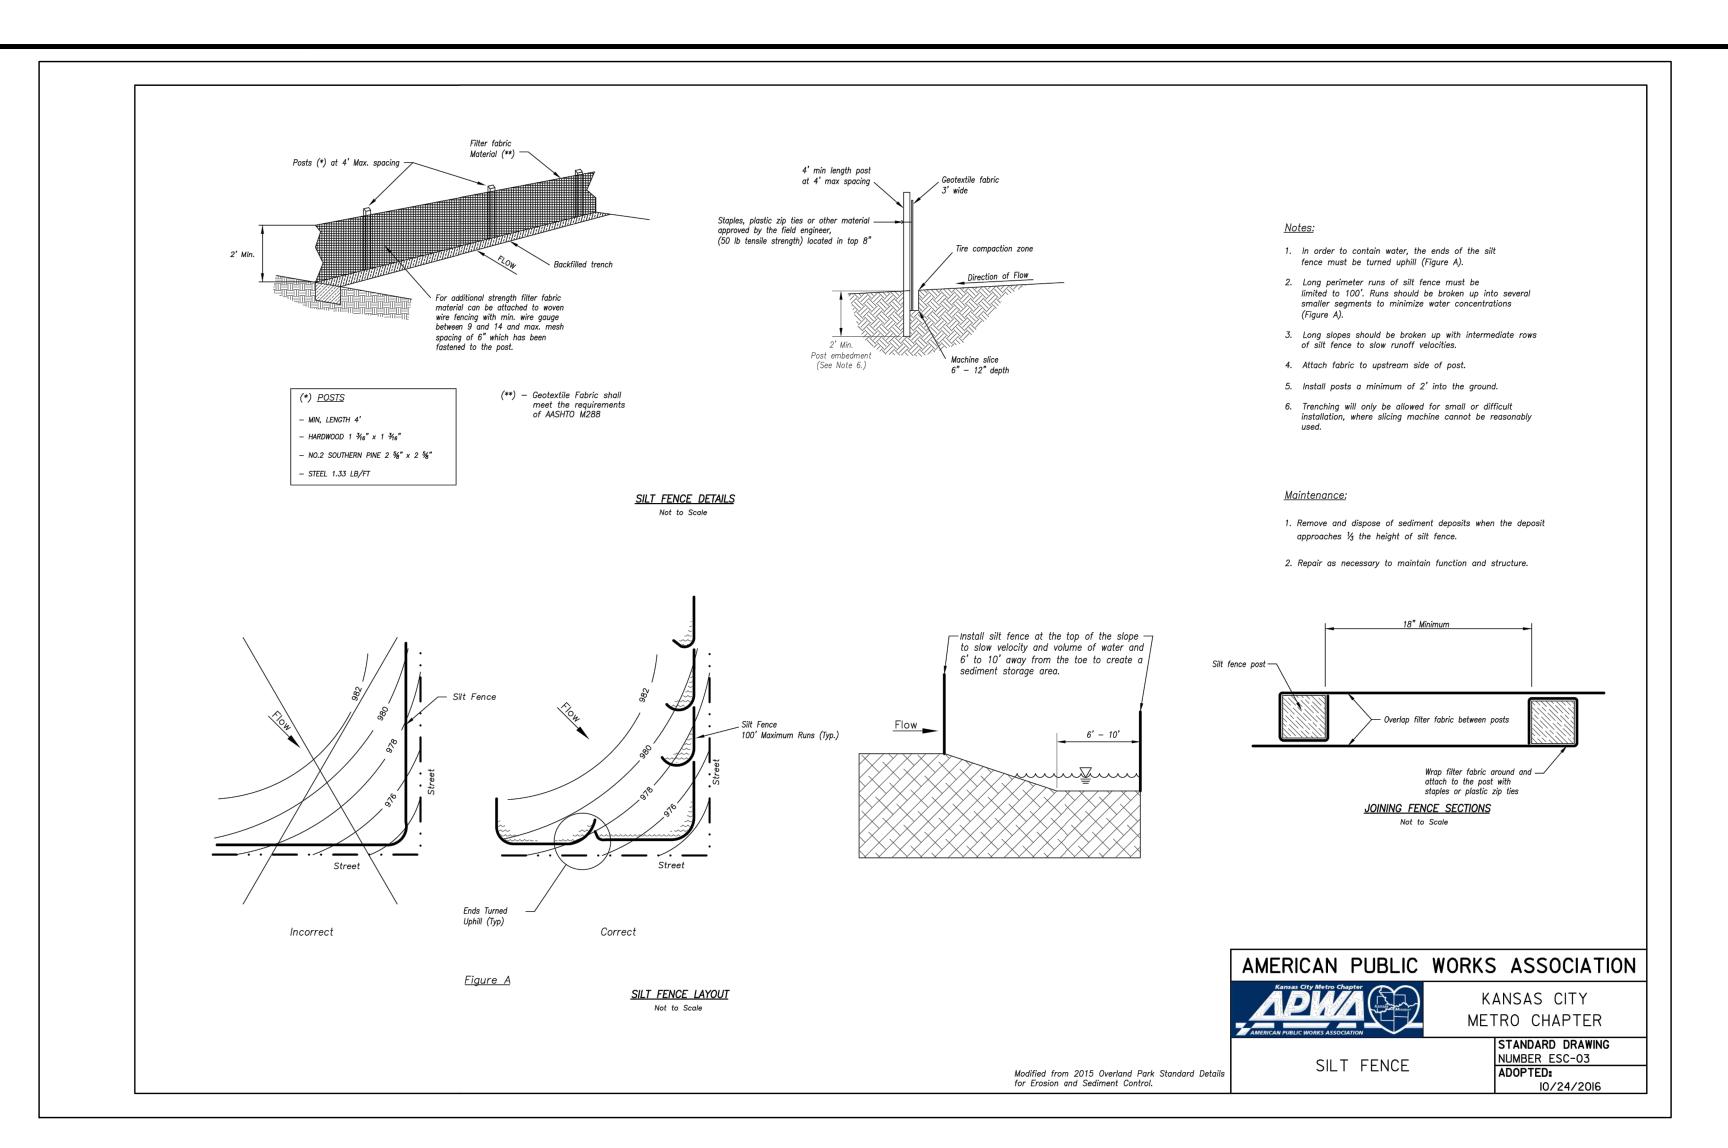


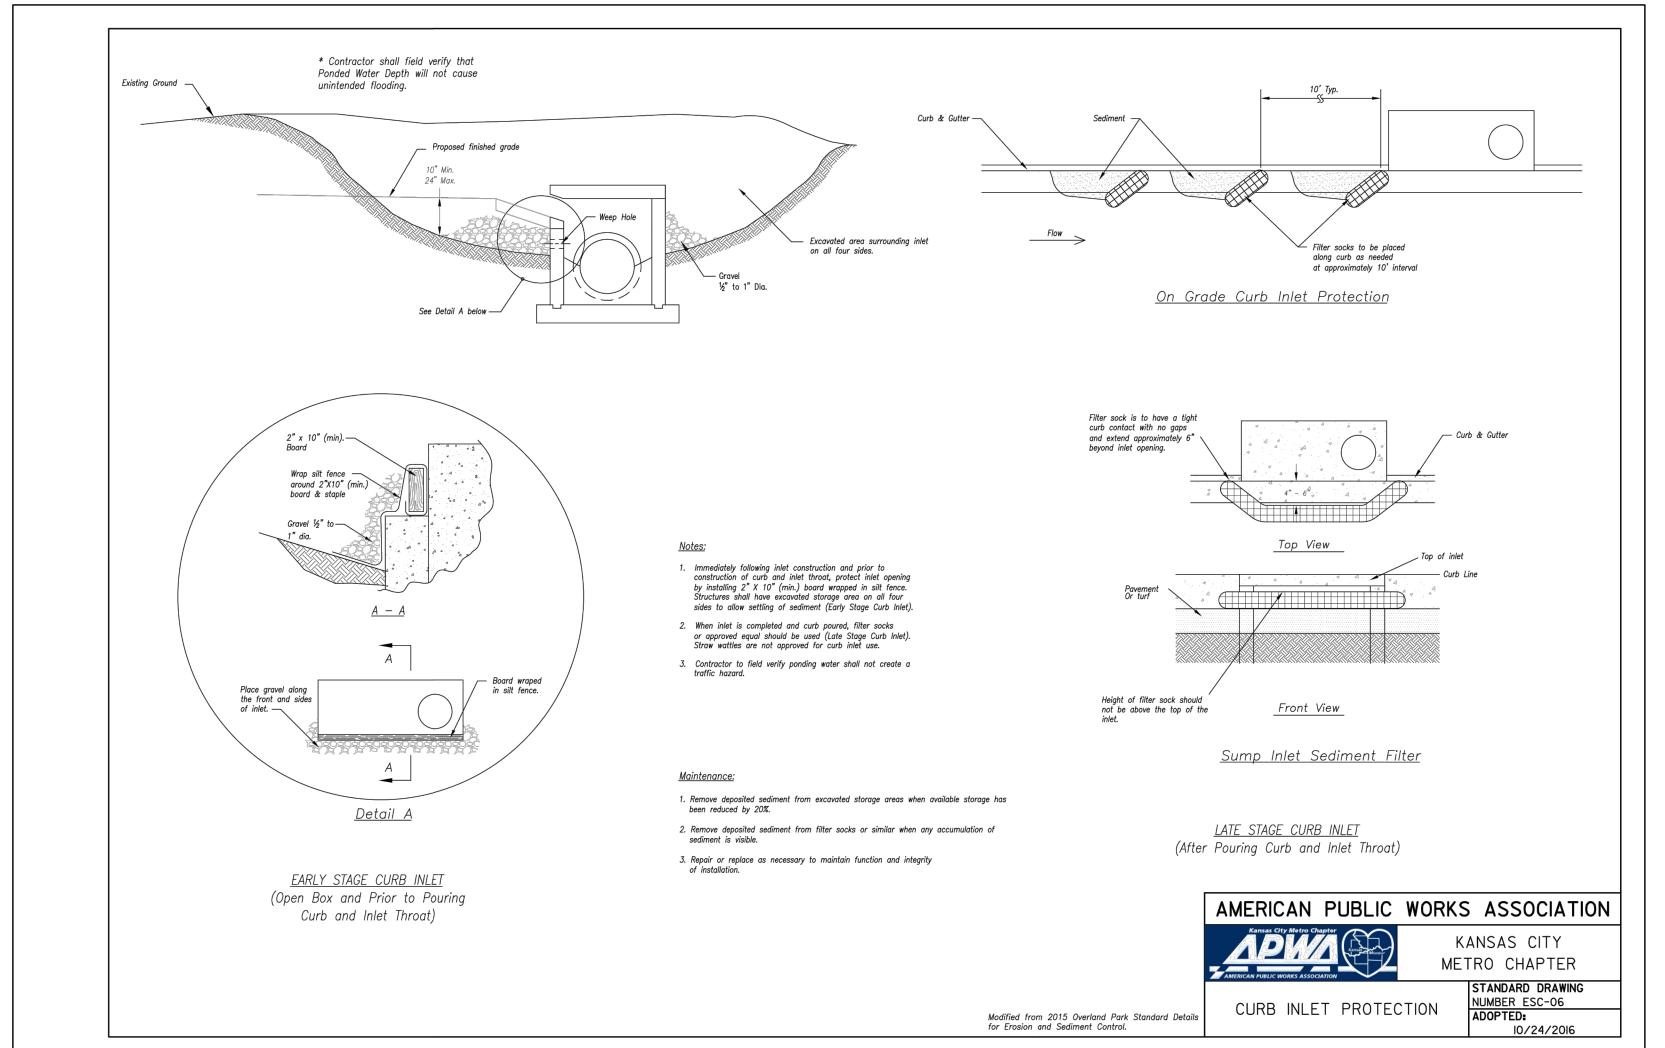



4301 Indian Creek Parkway Overland Park, KS 66207 phone: 913.451.9390 fax: 913.451.9391 www.davidsonae.com

> Davidson Architecture & Engineering, LLC License # 2010029713

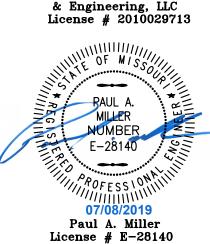

date

SML

PAM

05.17.2019

checked by

drawn by

revisions

sheet number

C4.3

		ITEM	QTY.	COMMON NAME	BOTANICAL NAME	SIZE & CONDITION
Ω Ω		А	12	AUTUMN PURPLE ASH	FRAXINUS AMERICANA 'AUTUMN PURPLE'	3" CAL.
חר הלו		В	17	OCTOBER GLORY MAPLE	ACER RUBRUM 'OCTOBER GLORY'	3" CAL.
SHADE TREES	$\odot$	С	10	SUPERFORM NORWAY MAPLE	ACER PLATANOIDES	3" CAL.
9  -	Manner of Manner	E	8	WHITE PINE	PINUS STROBUS	8'-0" HIGH
2 2 2		F	7	DWARF ALBERTA SPRUCE	PICEA GLAUCA 'CONICA'	4'-0" HIGH
200	$\odot$	G	23	CRIMSON PYGMY BARBERRY	BERBERIS 'ATROPURPUREA NANA'	5 GALLON, 24-30 INCHES
ID. VHRUBS		Н	58	DWARF BURNING BUSH	EUONYMUS ALATA 'COMPACTA'	5 GALLON, 24-30 INCHES
DECID.		I	29	GOLDENFLAME SPIREA	SPIRAEA X BUMALDA	5 GALLON, 24-30 INCHES
EG. SHRUBS	*	J	71	SEA GREEN JUNIPER	JUNIPERUS CHINENSIS 'SEA GREEN'	5 GALLON, 24-30 INCHES
	{ + }	К	45	BEARBERRY COTONEASTER	COTONEASTER DAMMERI	5 GALLON, 24-30 INCHES

	plant schedule (existing relocated)			
	ITEM	QTY.	COMMON NAME	BOTANICAL NAME
	А	1	AUTUMN PURPLE ASH	FRAXINUS AMERICANA 'AUTUMN PURPLE'
	В	1	OCTOBER GLORY MAPLE	ACER RUBRUM 'OCTOBER GLORY'
$\bigcirc$	С	2	SUPERFORM NORWAY MAPLE	ACER PLATANOIDES
S S	E	4	WHITE PINE	PINUS STROBUS
$\overline{}$	G	14	CRIMSON PYGMY BARBERRY	BERBERIS 'ATROPURPUREA NANA'

#### landscape notes:

226 TOTAL SHRUBS

- Landscaping shall be coordinated with the location of utilities, driveways and traffic clearance zones.
- The contractor doing excavation on public right-of-way shall give 48 hours advance notice to and obtain information from utility companies. Prior to commencement of work, the contractor shall notify all those companies which have facilities in the near vicinity of the construction to be performed.
- Existing underground, overhead, utilities and drainage structures have been plotted from available information and therefore, their locations must be considered approximate only. It is the
- responsibility of the individual contractors to notify the utility companies to locate their utilities before actual construction. Contractor shall verify location of and protect all utilities and structures. Damage to utilities and structures shall be repaired by the contractor to the satisfaction of the owner at no additional expense.
- Entire site to be irrigated by underground system, including right of way as req'd. (limits of sod including all other disturbed area's and all planting beds)
- Irrigation system shall include an automatic rain sensor. All landscape materials shall be installed in accordance with the current planting procedures established by the most recent addition of the American Standard for Nursery Stock.
- 9. Trees planted per this plan shall be installed during the spring (march 15 through june 15) or fall (september 15 through december 1). Written city approval will be required for planting during other times of the year.
- 10. Stake and guy all trees per planting details.
- 11. Install all shrubs and groundcover per planting details.
- 12. Elevation of top of mulch shall be 1/2" below any adjacent pavement/turf areas. 13. Root stimulator shall be applied to the soil backfill of each plant during installation.
- 14. Contractor shall verify all landscape material quantities and shall report any discrepancies immediately to the Architect.
- 15. Contractor shall stake plant locations in the field and have approval by the Architect before proceeding with installation.
- 16. Contractor shall guarantee all plant material for a period of one (1) year from date of initial acceptance. Contractor is responsible for maintaining plant material until acceptance is received. Maintenance shall include watering, maintaining plants in vertical position and shrub bed weed control.
- 17. All plant material shall meet or exceed minimum requirements defined by the "American Standard for Nursery Stock" ANSI Z60.1. 18. No plant material shall be substituted without written approval of the Architect per specifications.
- 19. Trees and seasonal color areas shall be mulched with three (3) inches minimum shredded hardwood mulch. Planting beds as delineated shall be separated from pavement/turf areas with metal edging and mulched with three (3) inches minimum shredded hardwood mulch over weed barrier fabric, except where otherwise specified.
- 20. All existing plant material to be retained shall be wrapped with orange, or bright, colored plastic snow fence around base of trees and around all shrubs. Stake to hold in place during construction. 21. All shrubs used as parking buffer to be min. 18" tall at planting and maintained 3'-0" max. height. Install plants not to encroach upon cars parked, when at full growth.
- 22. All trees with above a 2" caliper shall be double staked, while smaller trees shall be single staked. 23. Ground mechanical and electrical equipment shall be wholly screened from street right-of-way and residential developments.
- 24. Maximum slope shall be not greater than 3 : 1.
- 25. All portions of site not covered by paving, mulch, plantings, etc. are to be sodded. Sod shall extend to all disturbed areas and shall include portions of right of way if necessary.

## LANDSCAPE REQUIREMENTS

SITE AREA = 130,530 S.F. / 2.99 ACRES

IMPERVIOUS AREA = 98,665 S.F. = 76% < 80%

GREEN SPACE = 31,865 = 24% > 20%

112,232 S.F. / 5,000 S.F. = 22.4 REQ'D AND 23 TREES PROVIDED 112,232 S.F. / 5,000 S.F. x 2 = 44.9 REQ'D AND 45 SHRUBS PROVIDED

STREET FRONTAGE @ WEST

20'-0" LANDSCAPE STRIP PROVIDED 328 L.F. / 30'-0" = 10.9 REQ'D AND 11 TREES PROVIDED

1 SHRUB PER 20'-0" = 16.4 REQ'D AND 65 SHRUBS PROVIDED


STREET FRONTAGE @ I-470 20'-0" LANDSCAPE STRIP PROVIDED 380 L.F. / 30'-0" = 12.7 REQ'D AND 13 TREES PROVIDED

1 SHRUB PER 20'-0" = 19 REQ'D AND 89 SHRUBS PROVIDED


PARKING AND LOADING AREA


5% OF PARKING = 3,982 S.F. REQ'D., 6,209 S.F. PROVIDED 100% SCREENING ALONG STREET FRONTAGE

47 TOTAL TREES REQUIRED, 47 + 7 ORNAMENTAL EVERGREENS PROVIDED 81 TOTAL SHRUBS REQUIRED, 226 PROVIDED

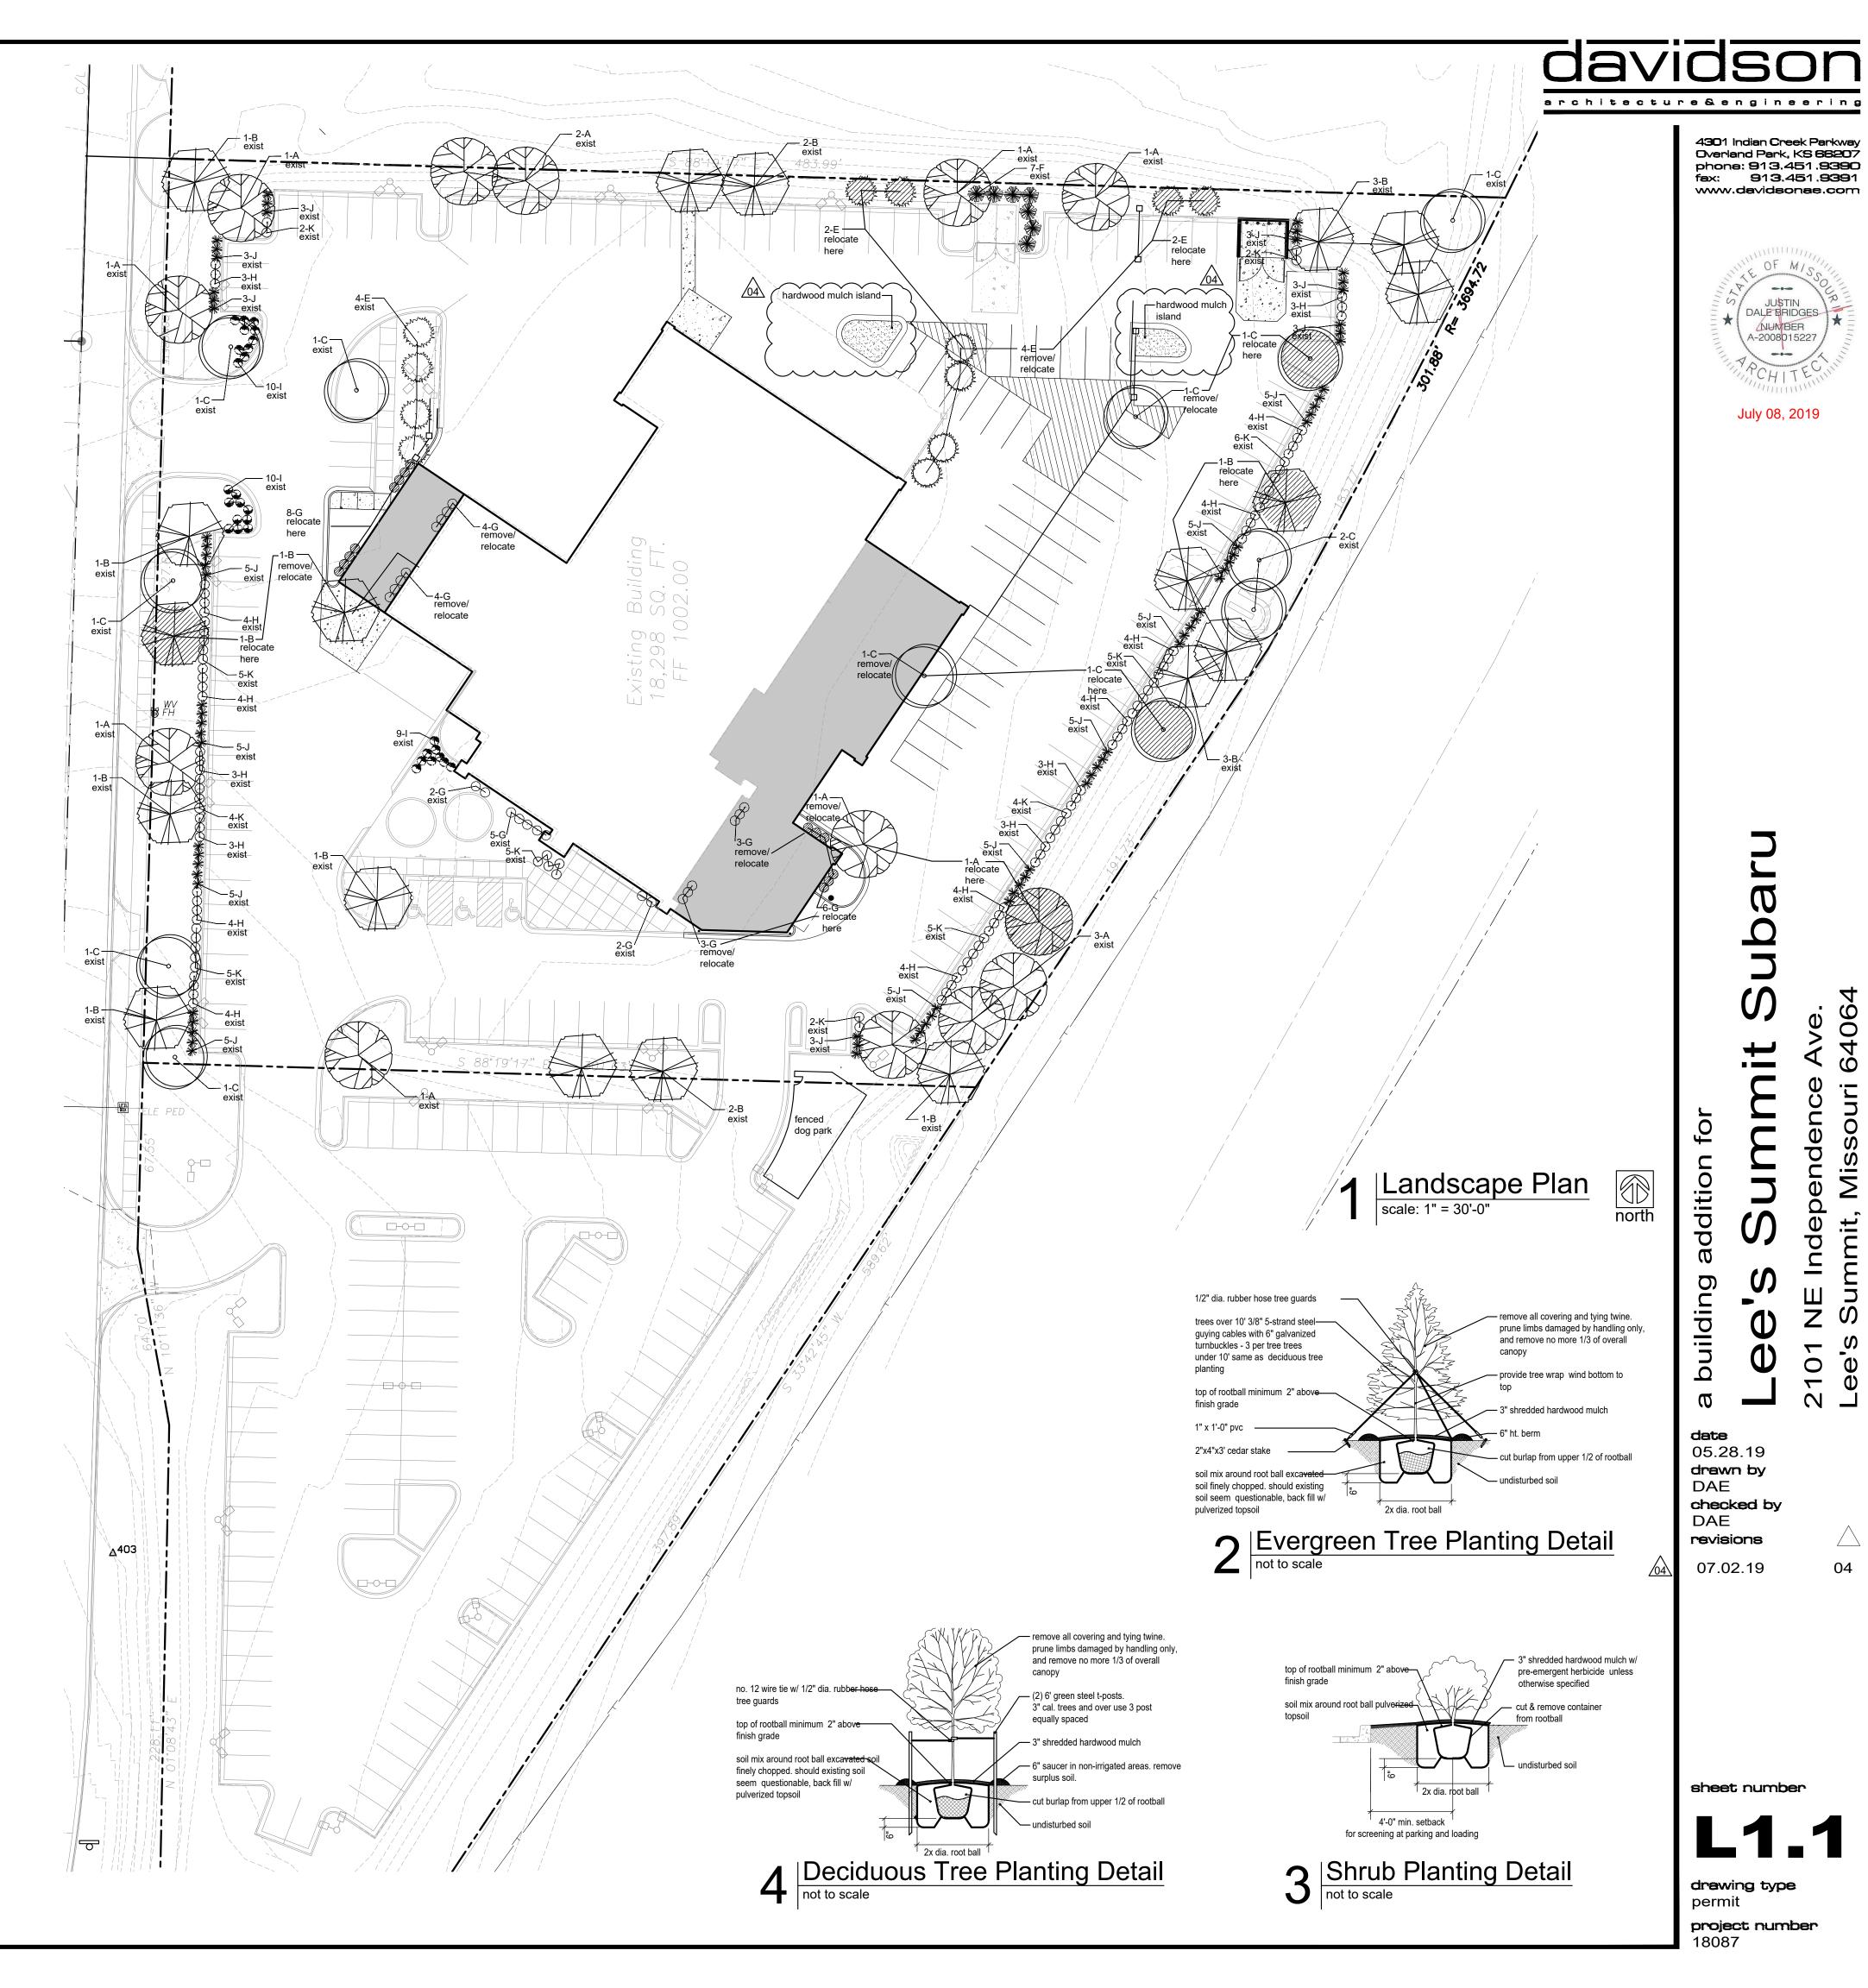

July 08, 2019

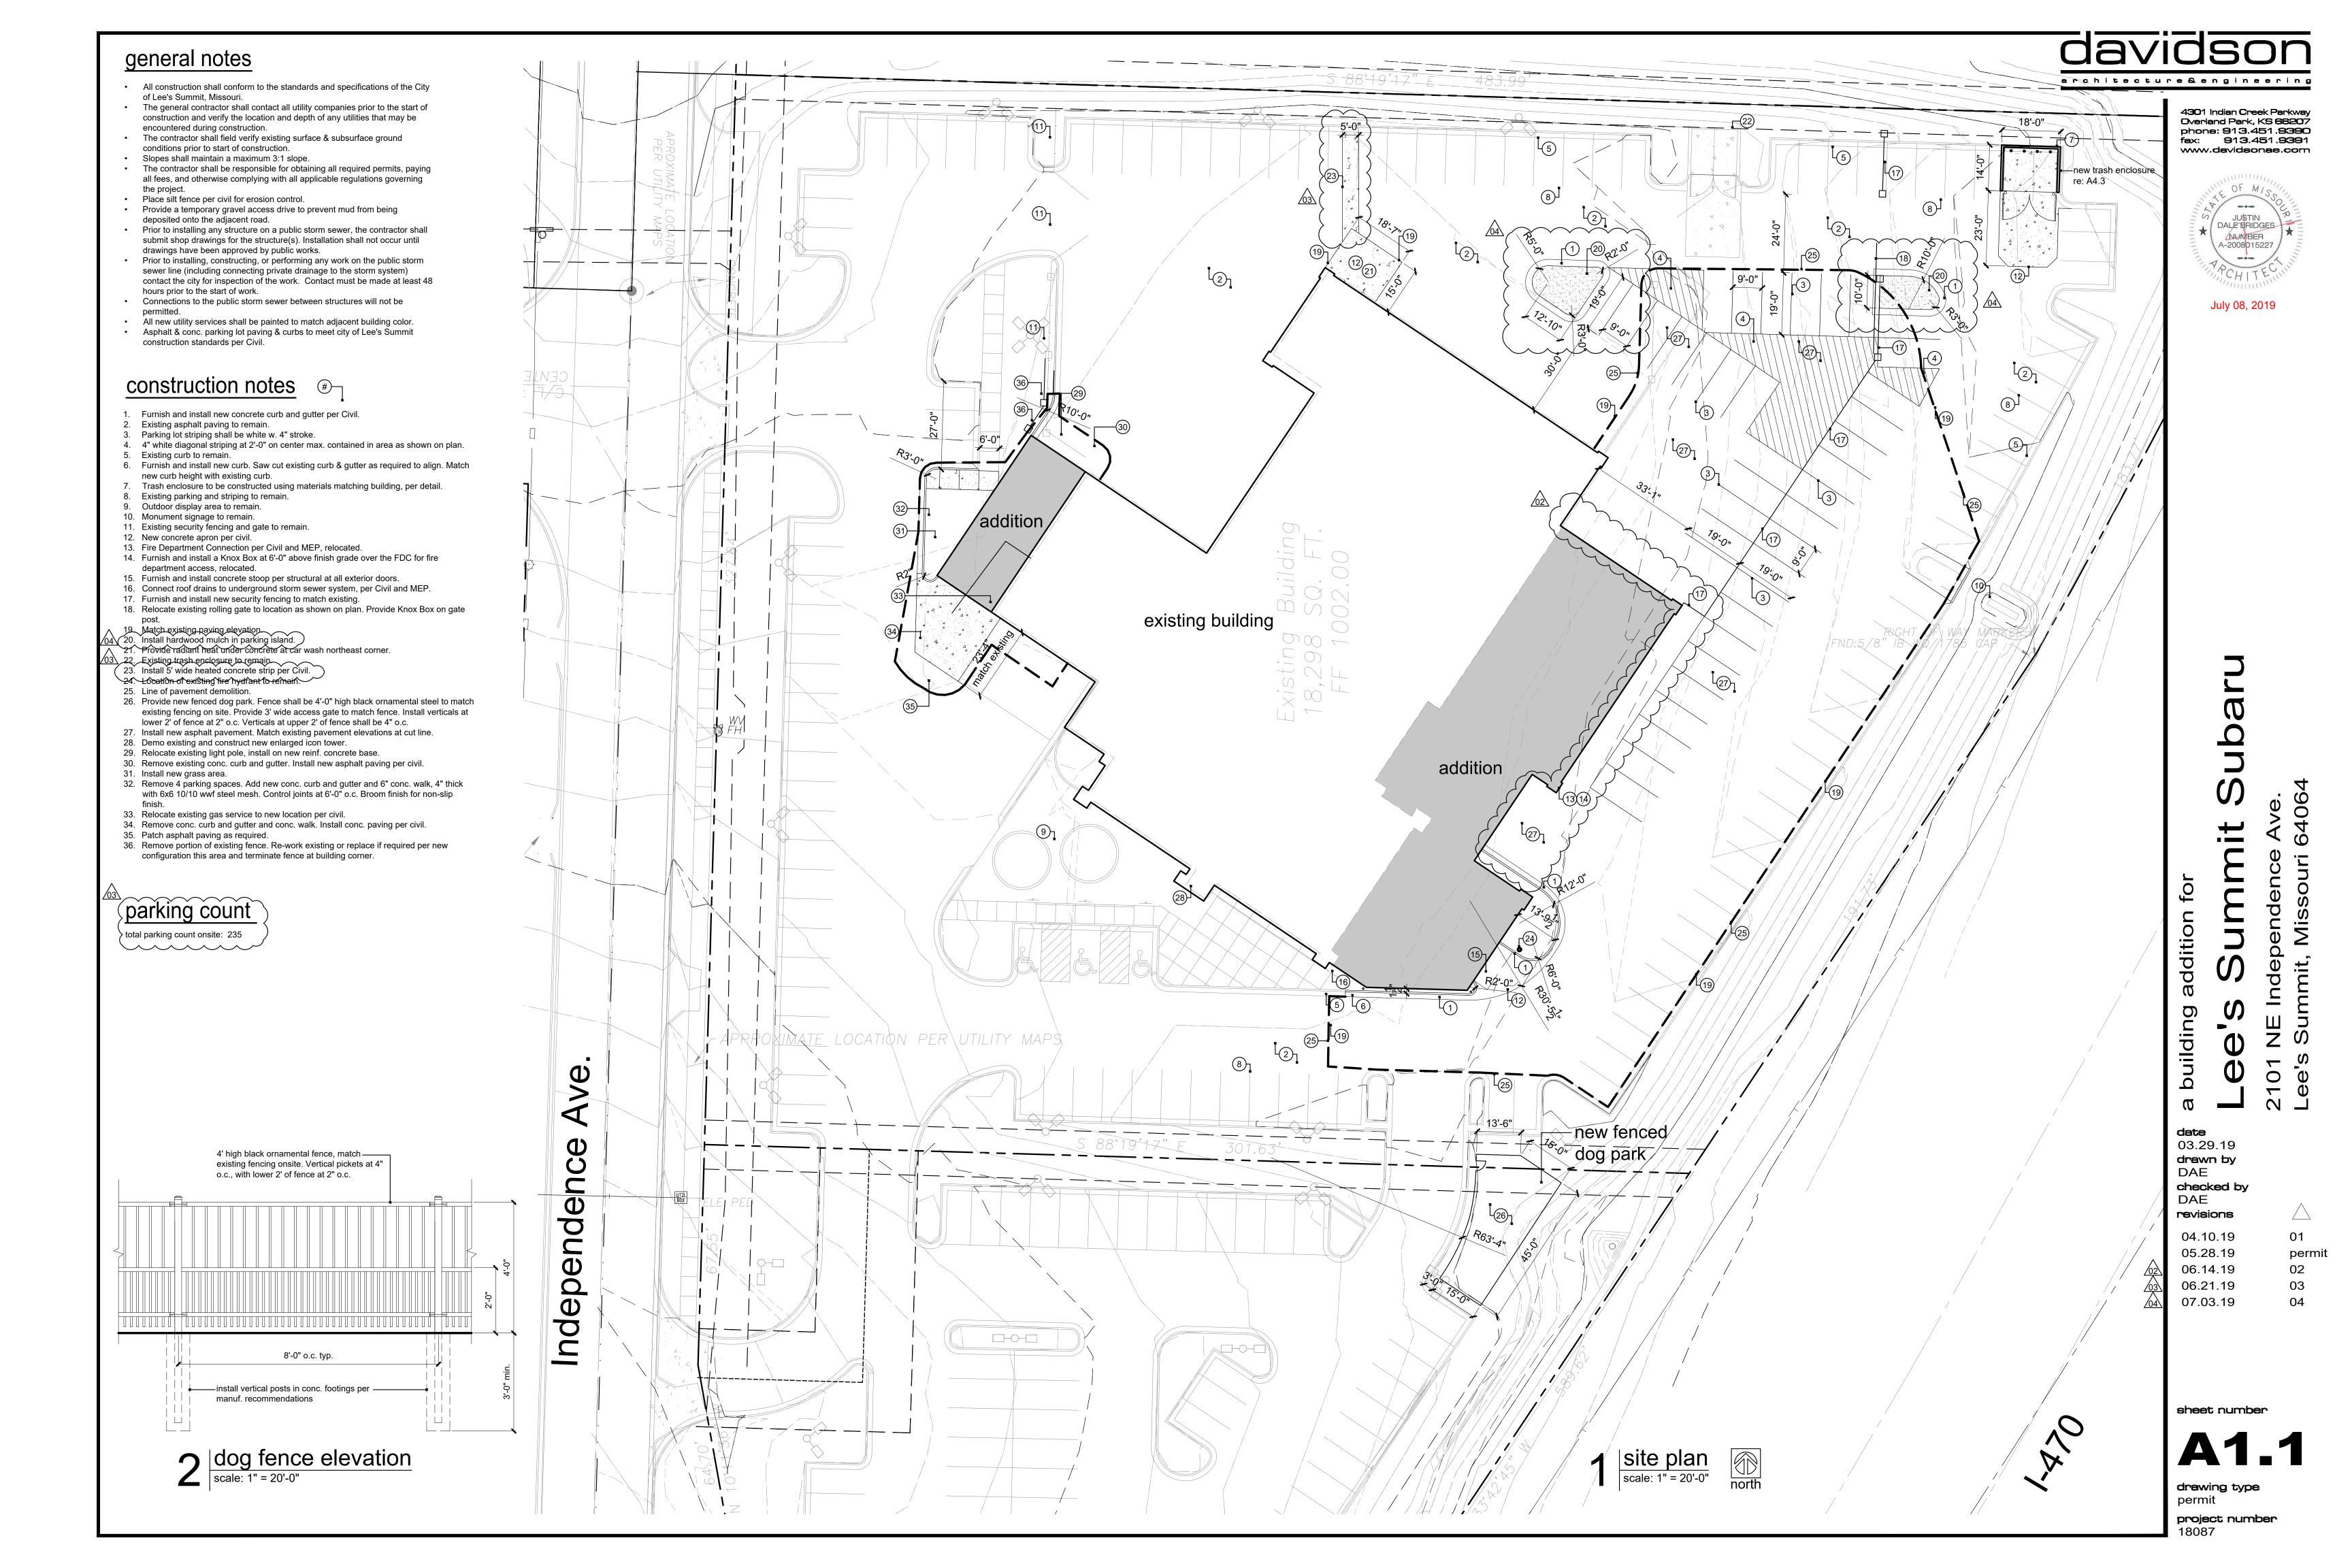

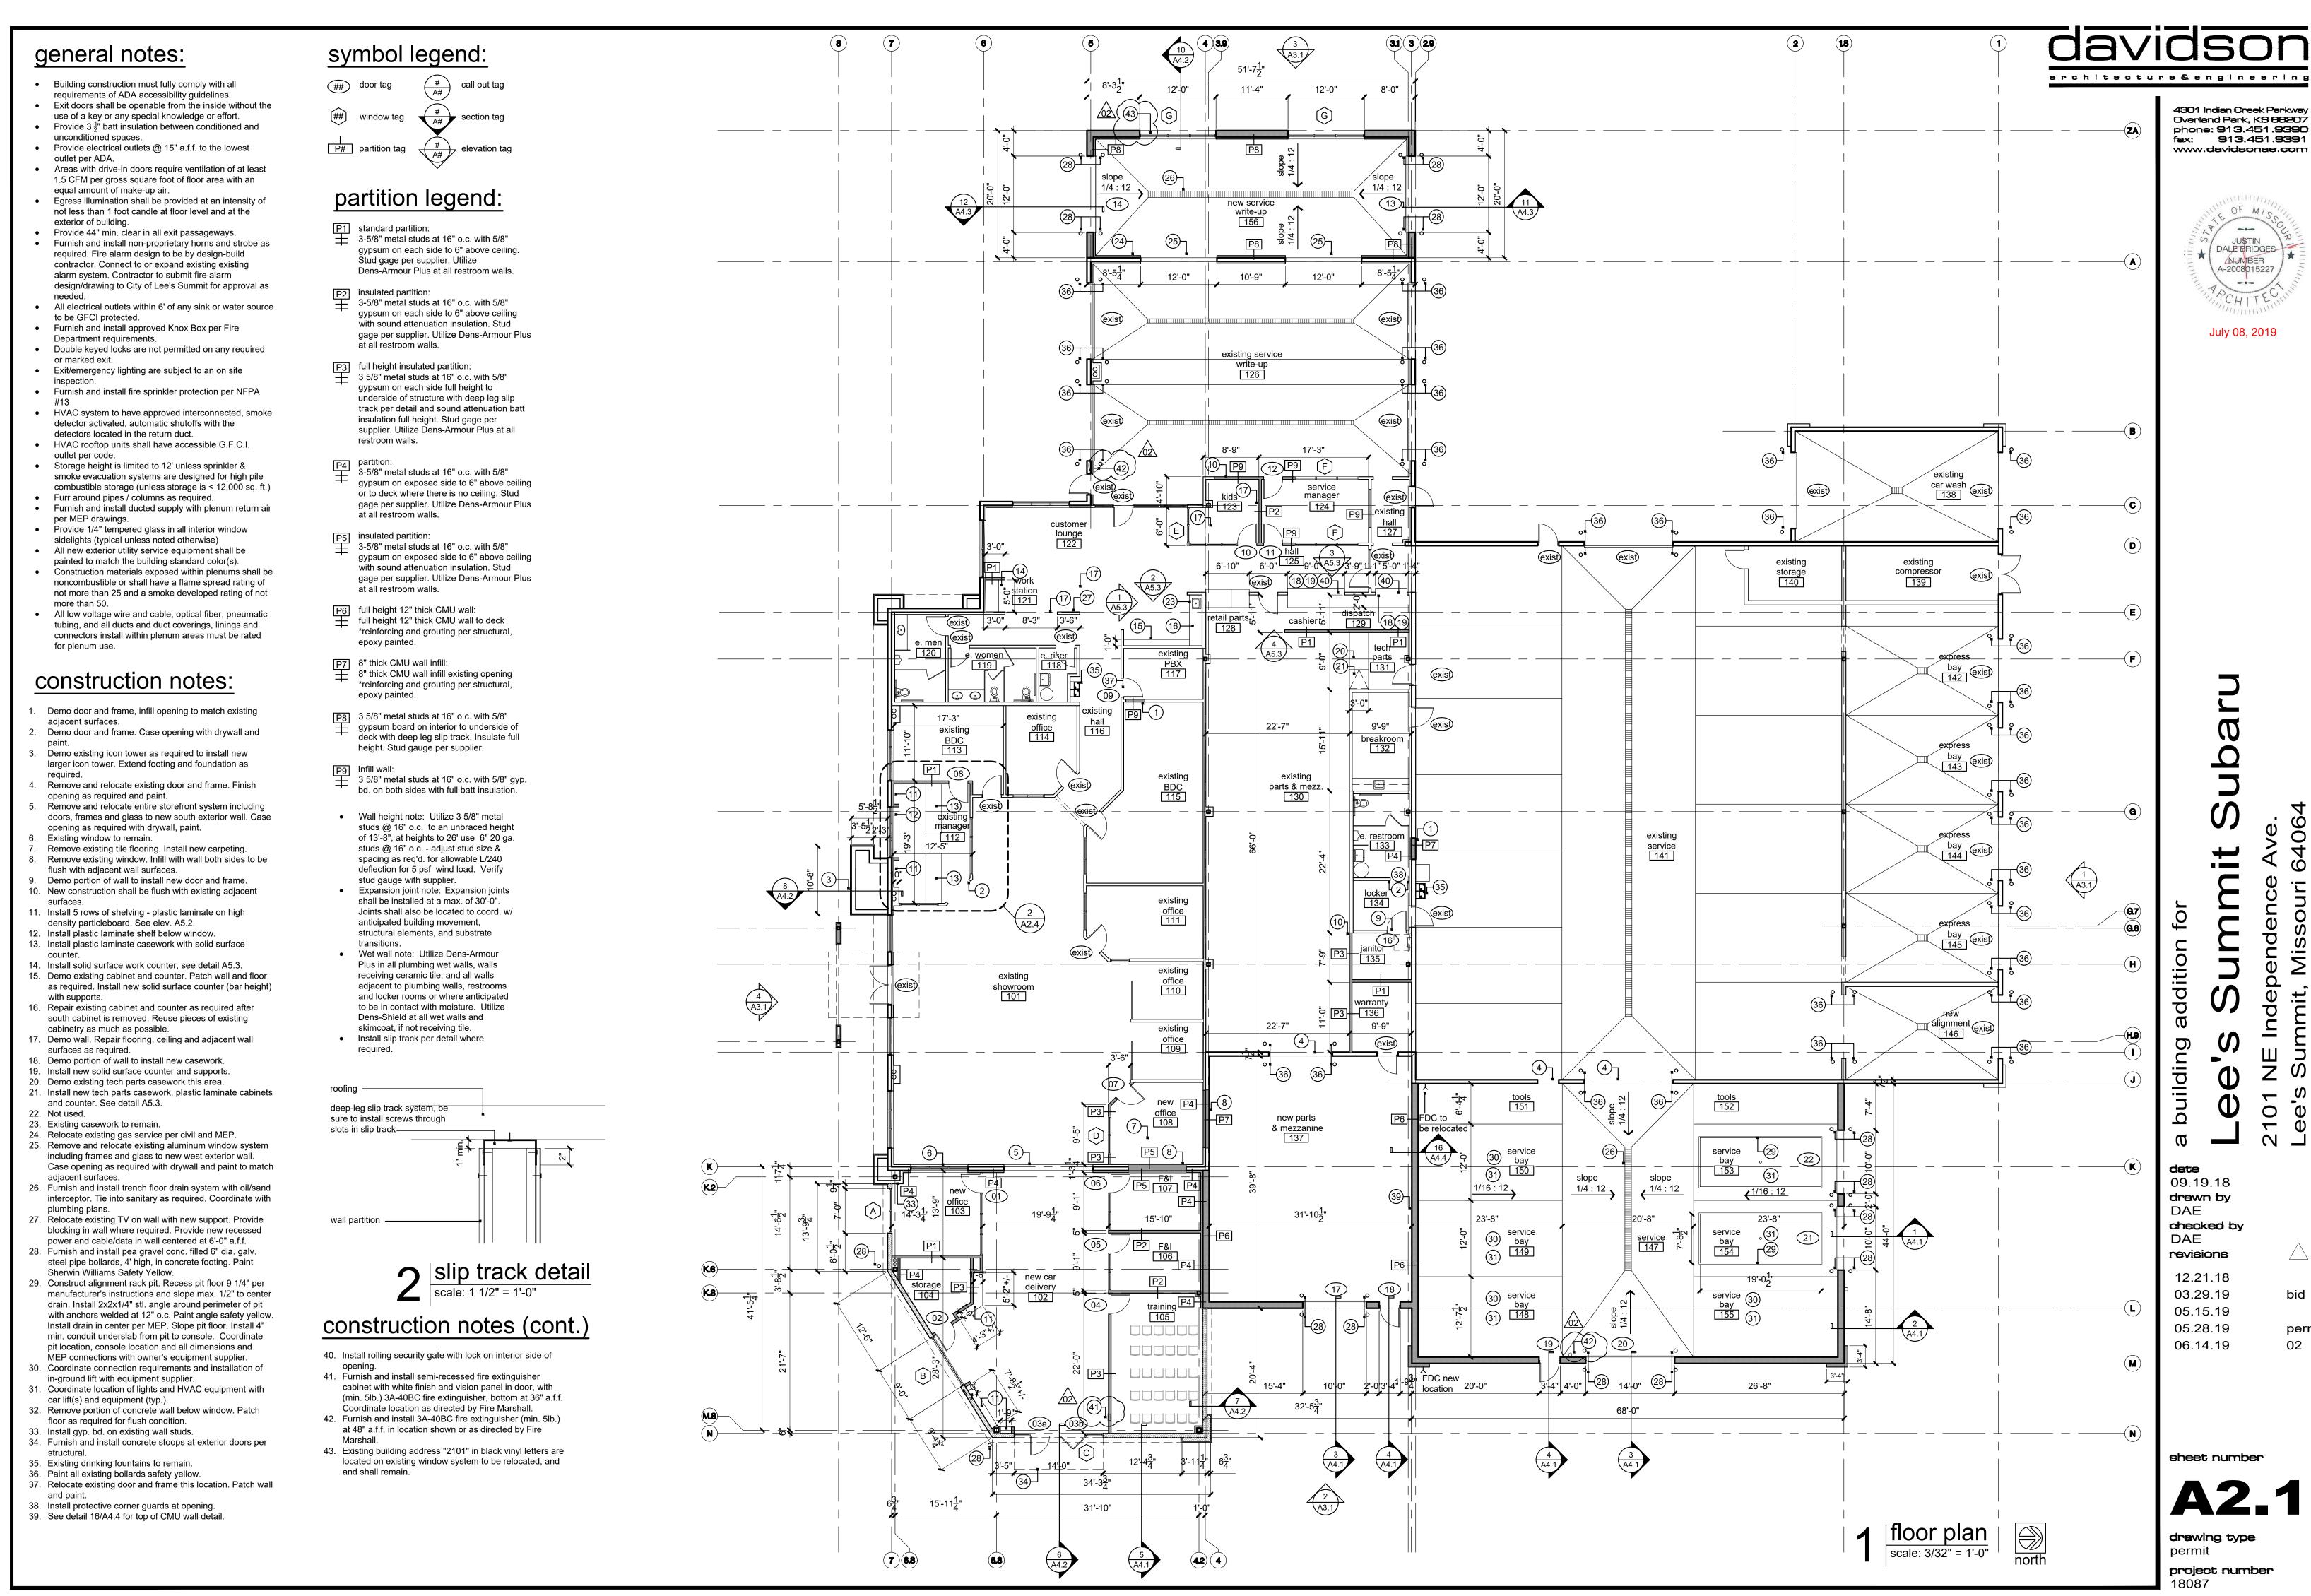

4301 Indian Creek Parkway Overland Park, KS 66207 phone: 913.451.9390 fex: 913.451.9391



July 08, 2019


09.19.18 drawn by checked by DAE

revisions 12.21.18 03.29.19 05.15.19 05.28.19

bid

permit

sheet number

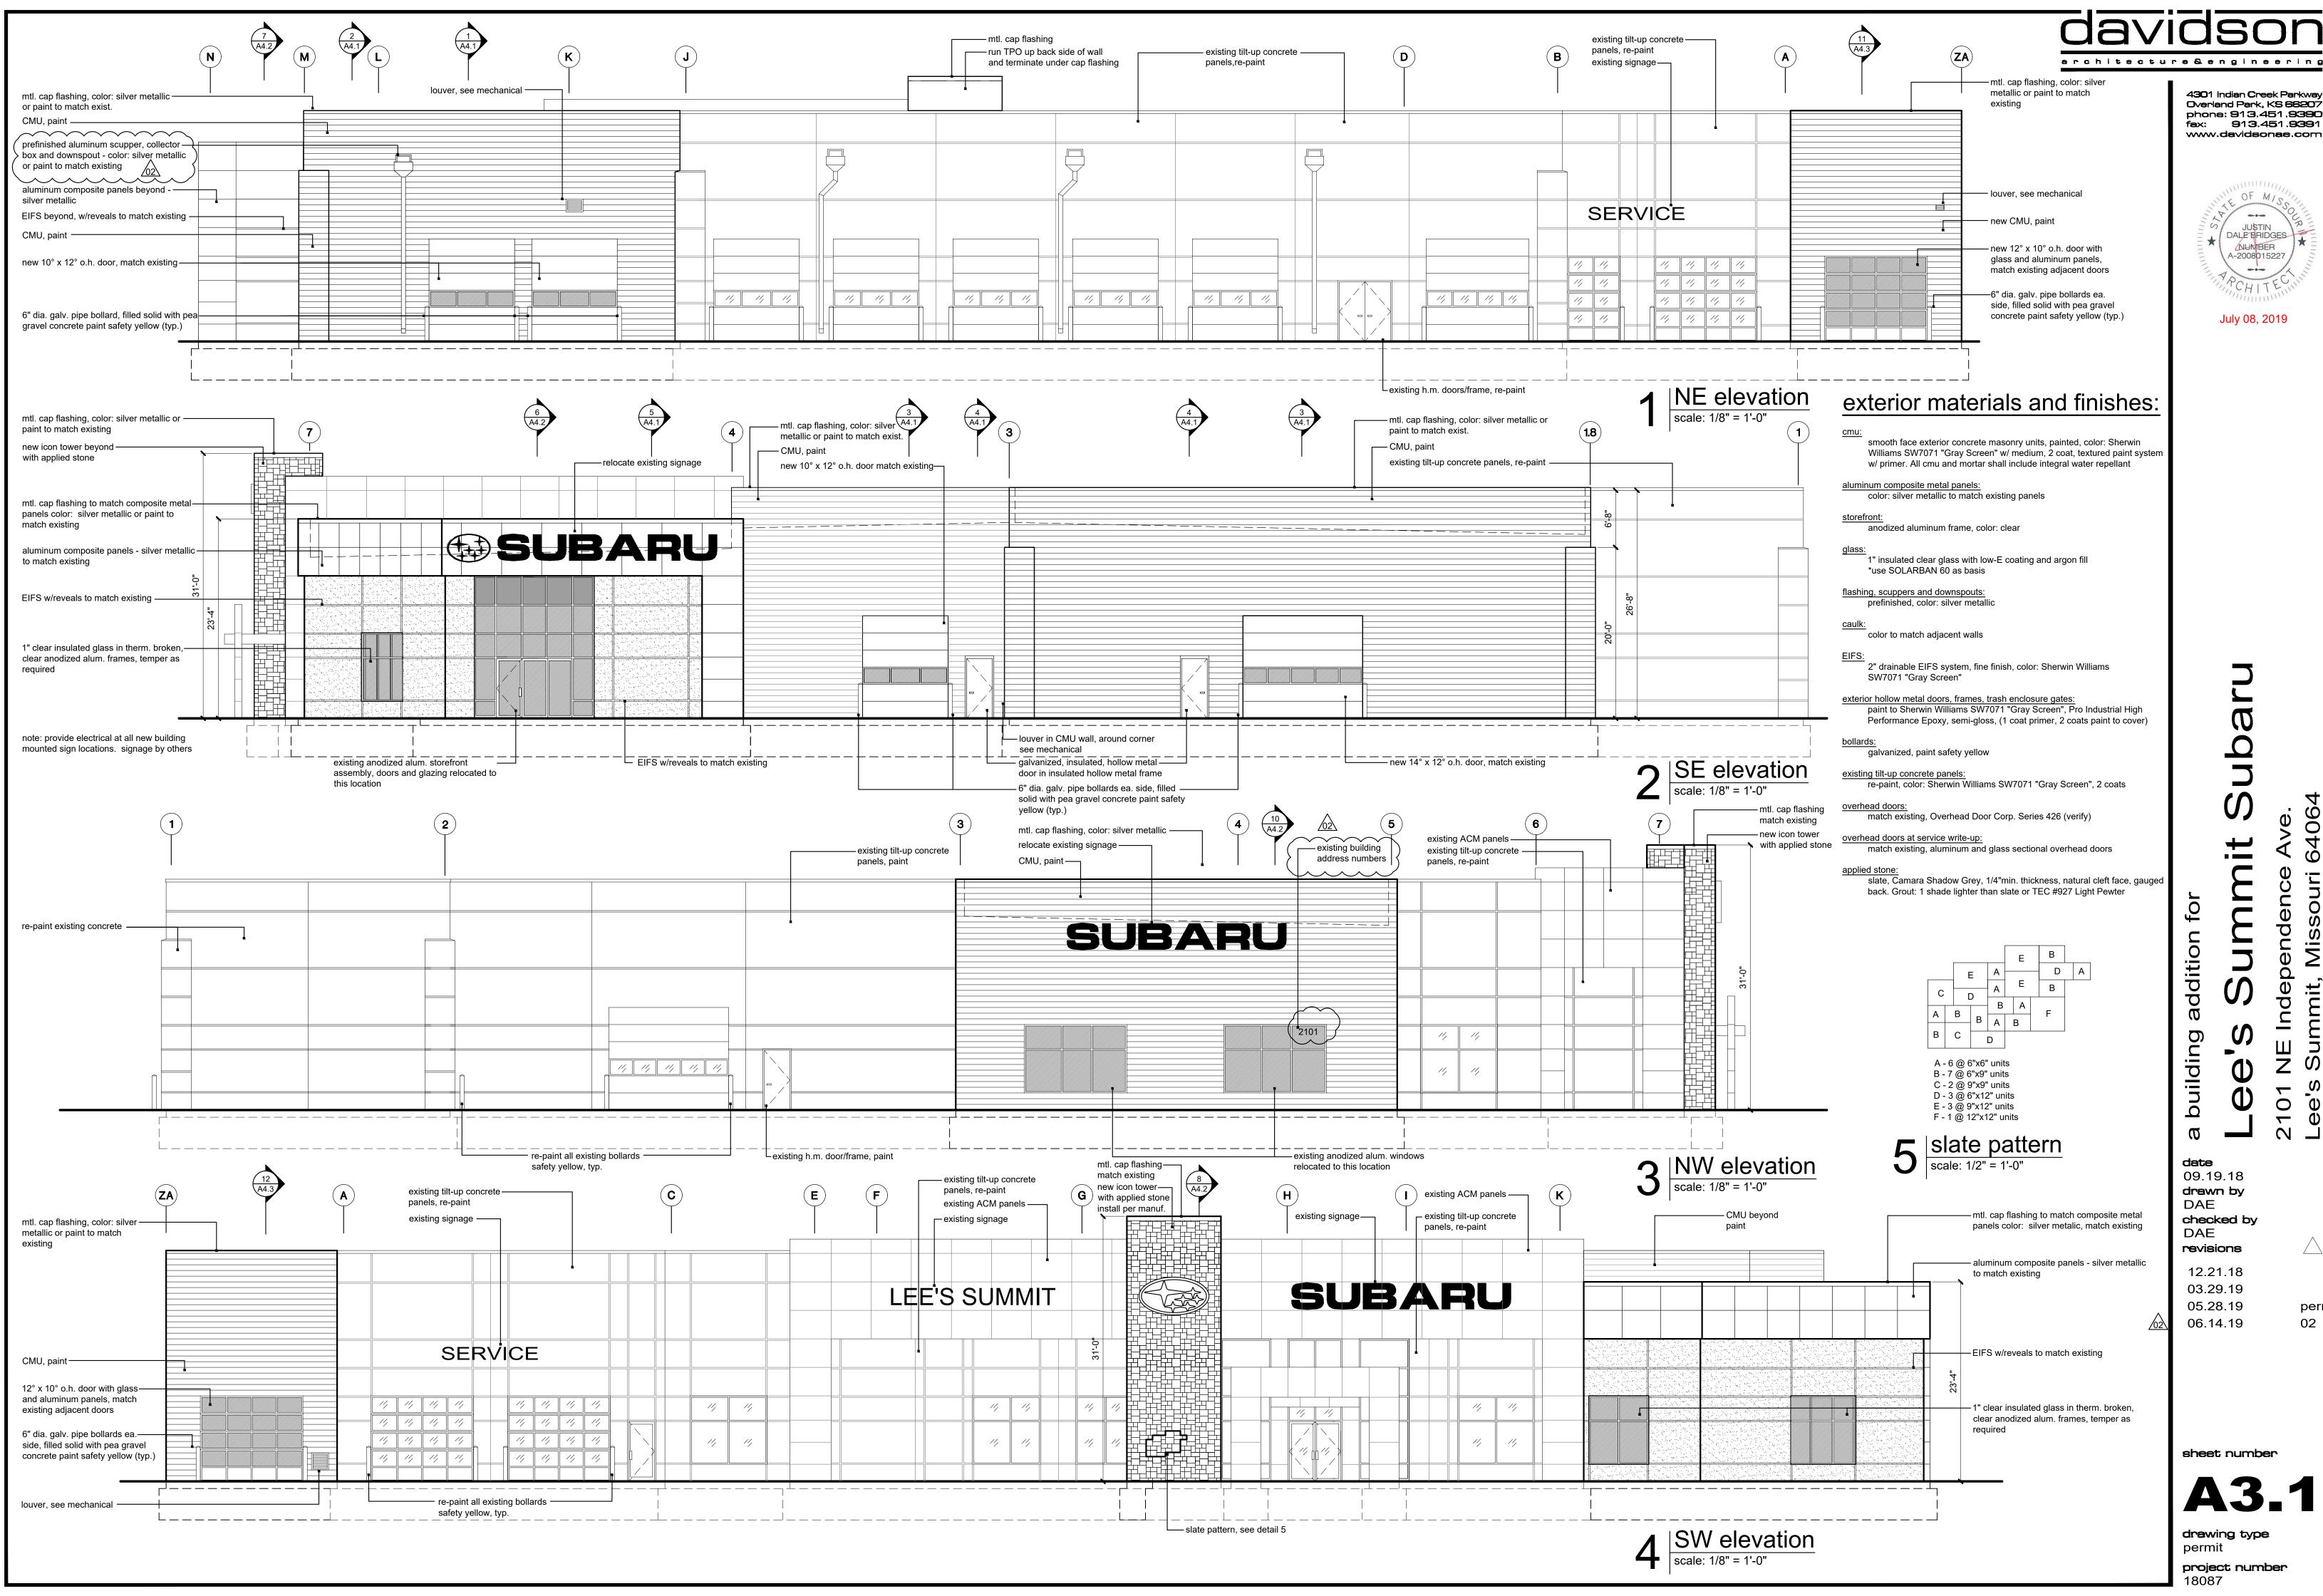


4301 Indian Creek Parkway Overland Park, KS 66207 phone: 913.451.9390 fax: 913.451.9391



permit 02

**A3.1** 

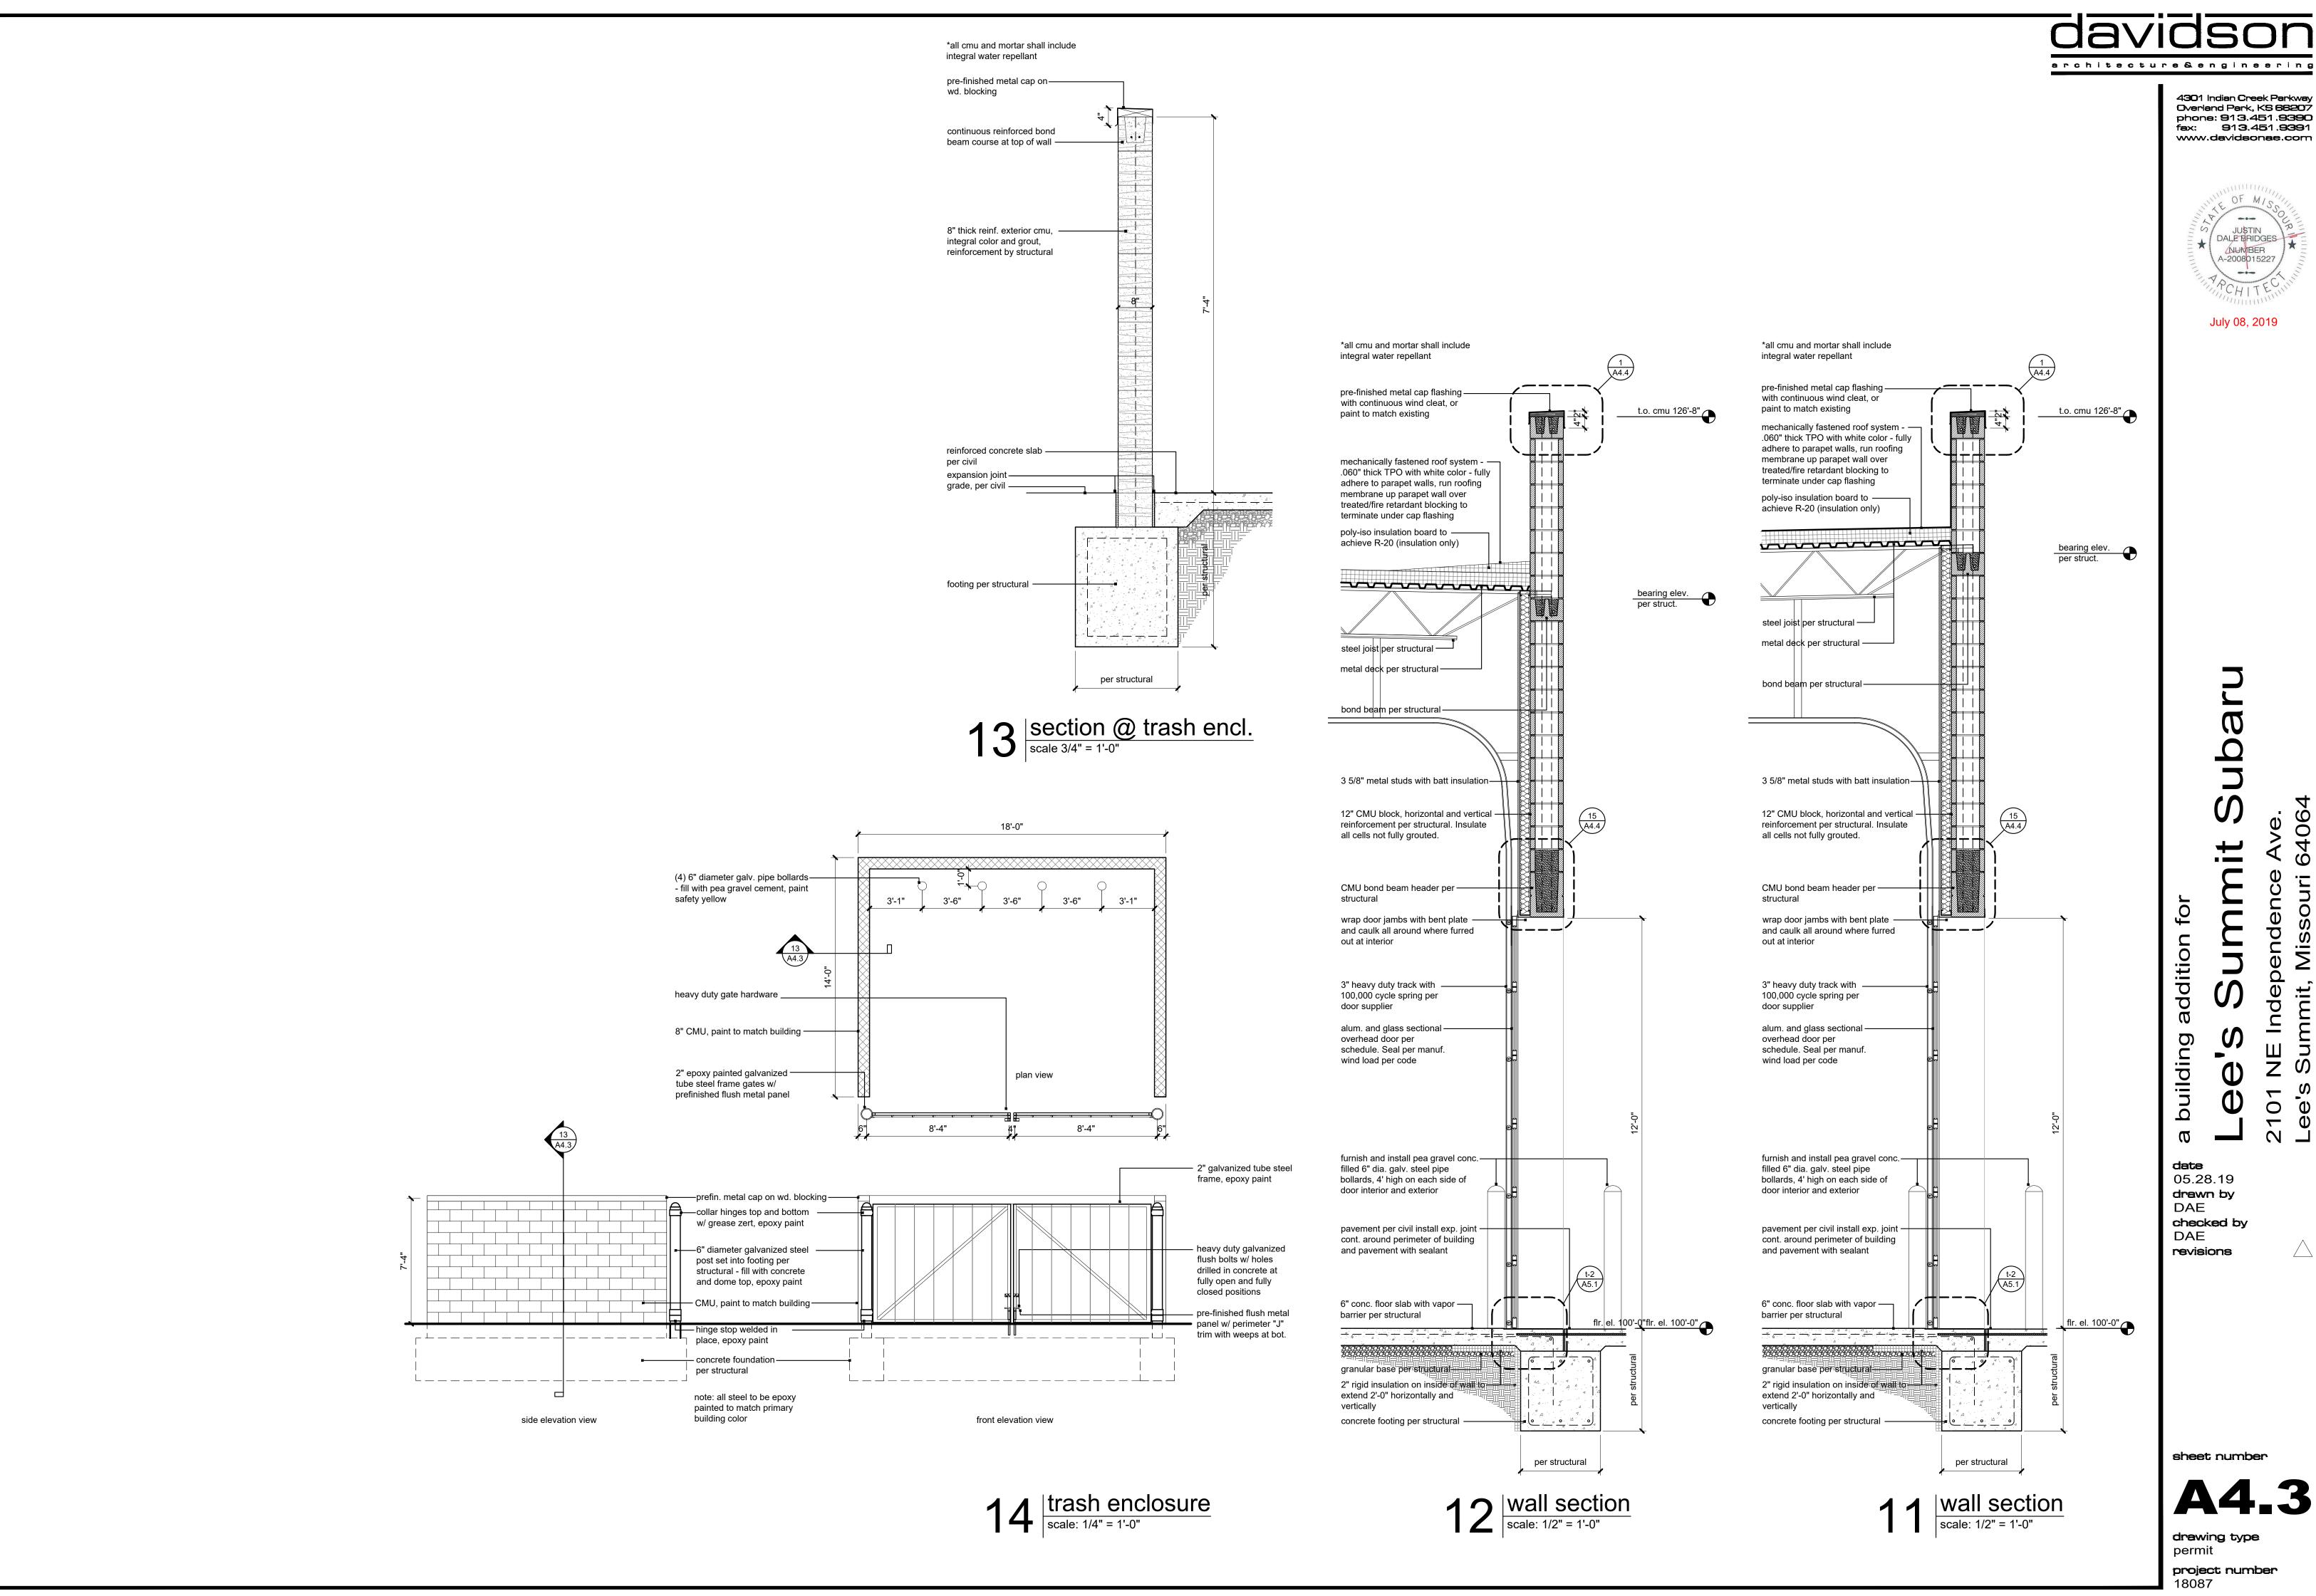

architecture&engineering 4301 Indian Creek Parkway Overland Park, KS 66207



July 08, 2019

05.28.19 drawn by checked by

sheet number