


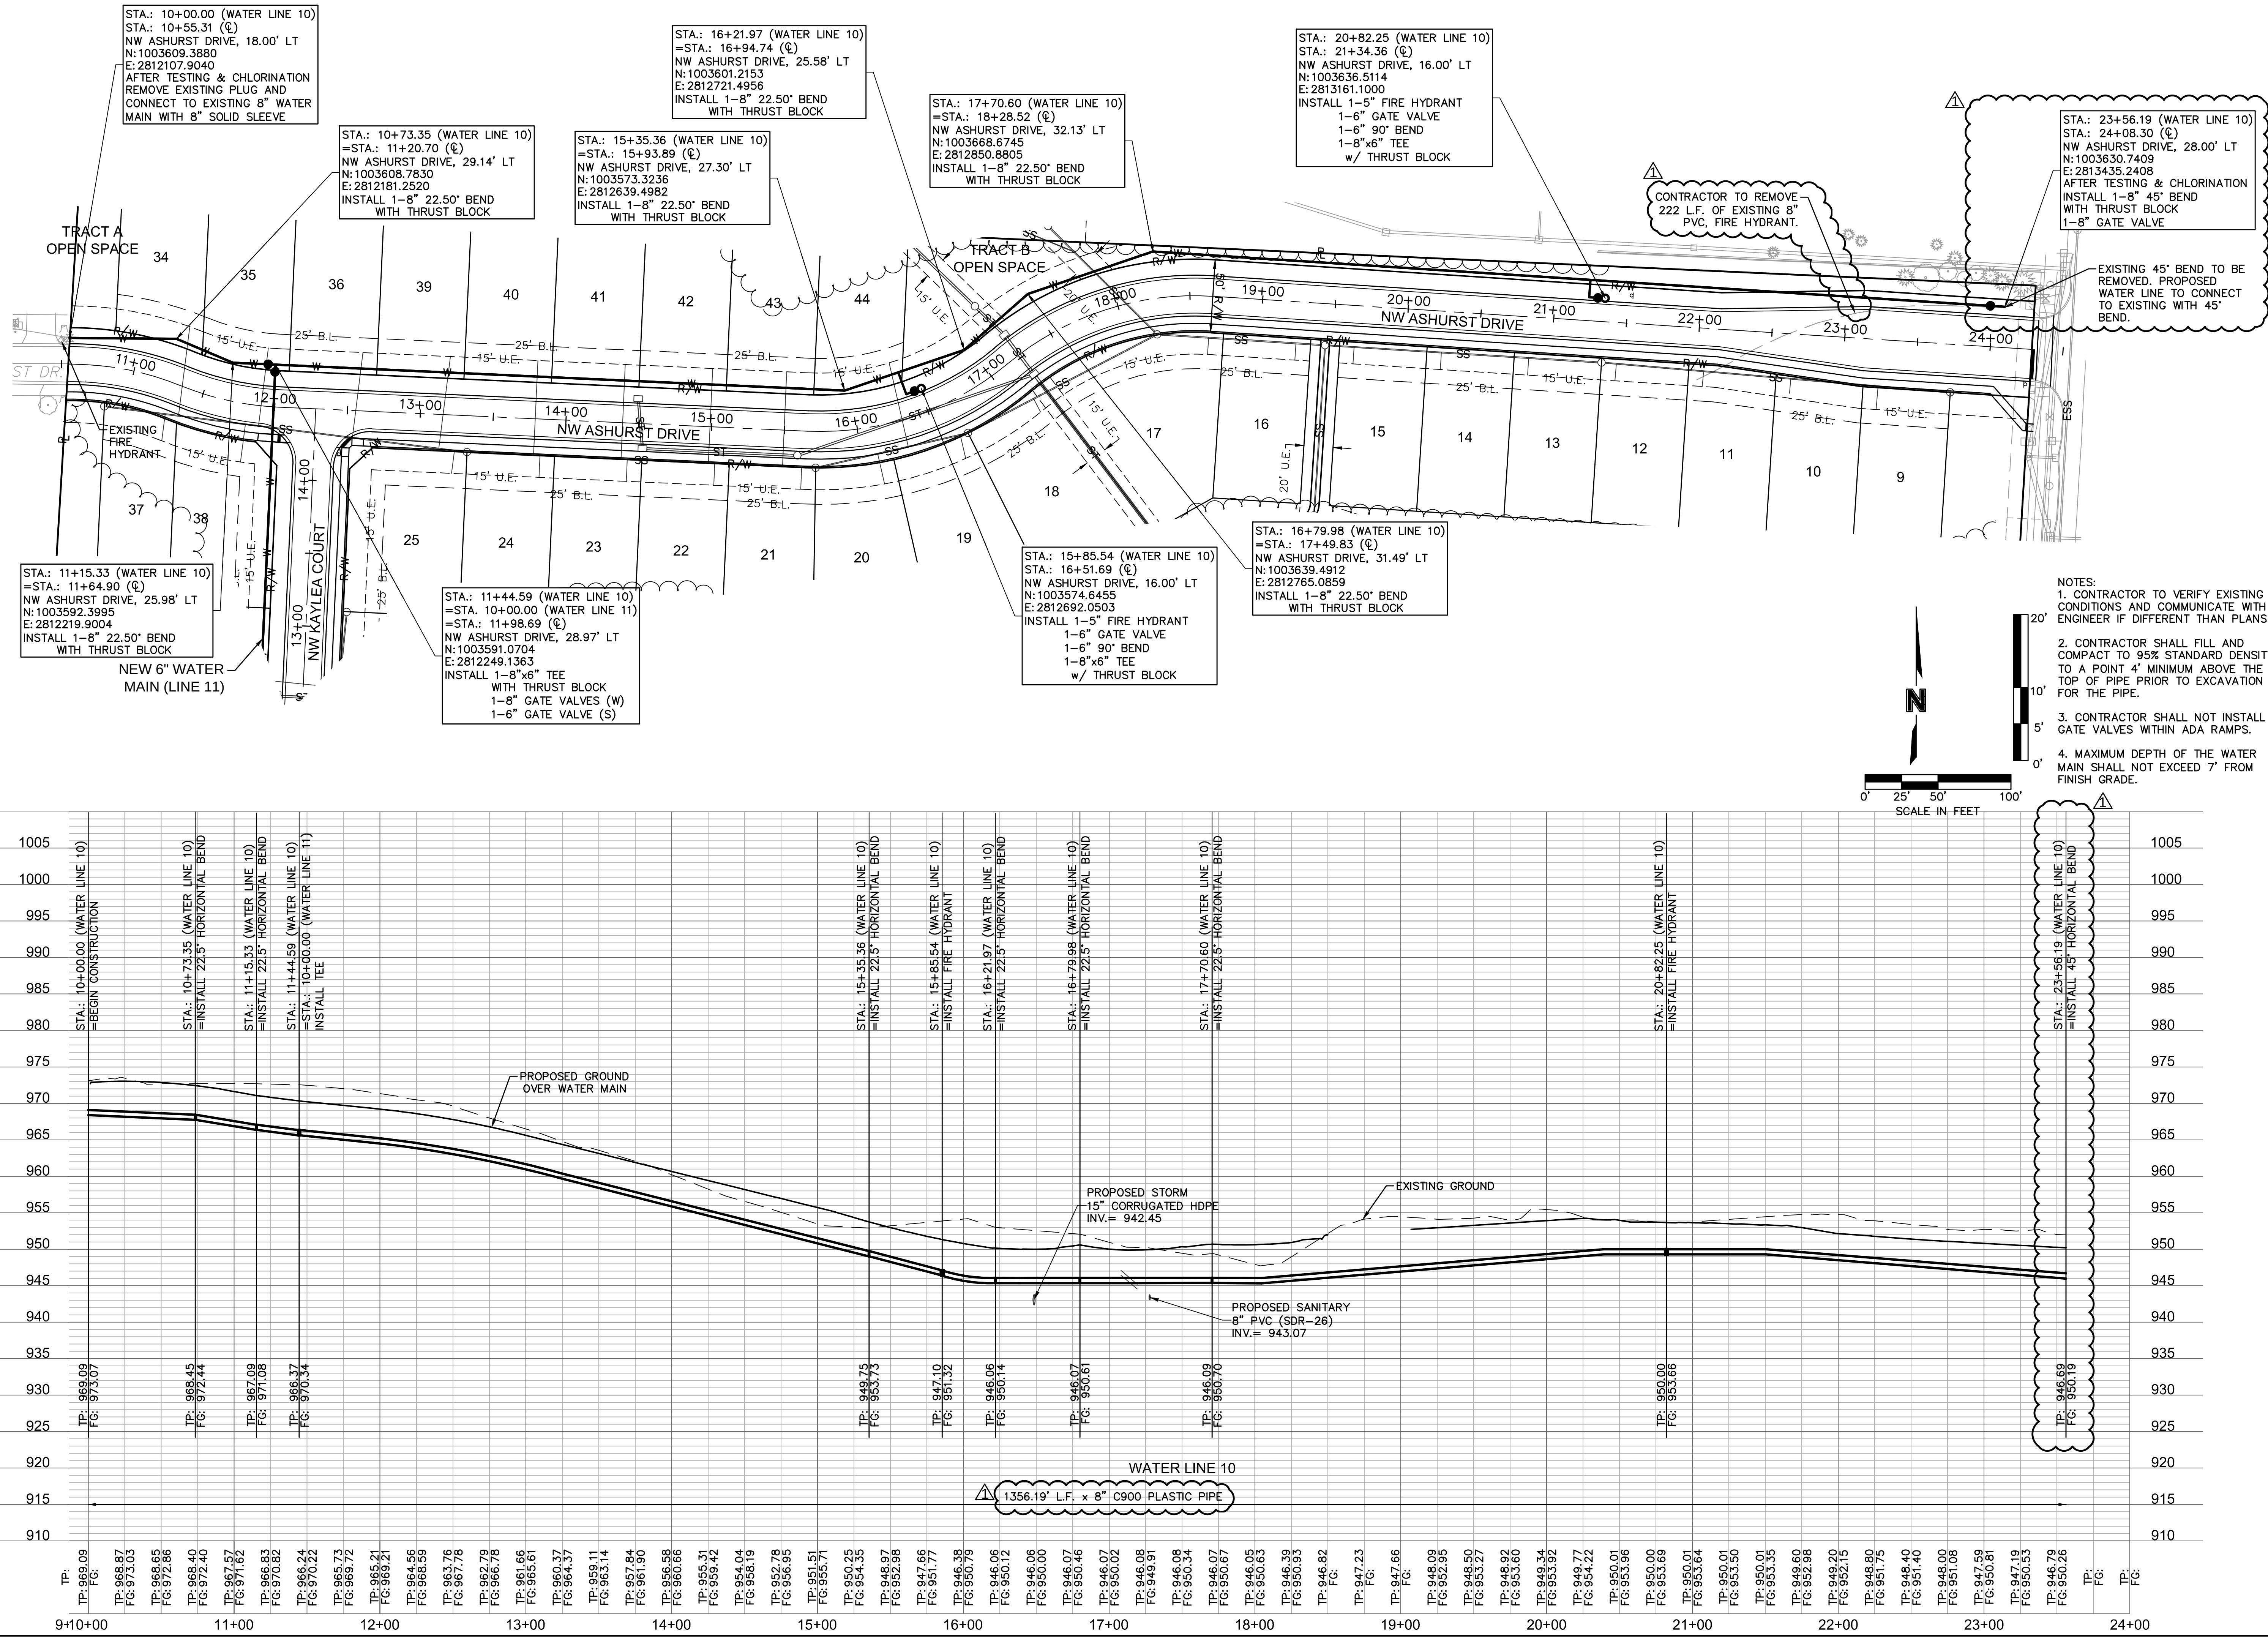

drawn by: _____ D.A.H.Q.			2019	LEE'S SUMMIT, MO	REVISIONS
checked by: _____ J.E.S.					
designed by: _____ S.M.S.					
QA/QC by: _____ M.S.B.					
project no.: _____ 618-1140					
date: _____ 2019.03.12					
SHEET C314					
WATER MAIN PLAN & PROFILE WATER MAIN EXTENSION					
WOODSIDE RIDGE FIRST PLAT					
NO.	REV.	DATE	REVISIONS DESCRIPTION		
1		8/7/2019	REVISED PER ASBUILT		
	</				

drawn by: D.A.H.O.
checked by: J.E.S.
designed by: S.M.S.
QA/QC by: M.G.D.
project no.: A18-1140
date: 2019.03.12