


DWG: F:\2018\0001-0500\018-0330-B\40-Design\AutoCAD\Final Plans\Sheets\GNCV\WORK PACKAGE 4\LEES SUMMIT\C_DETERT_80330.dwg USER: tparsons
DATE: Jan 16, 2020 9:15am XREFS: C_4LS.TBLK_80330 C_PBASE_80330 C_PSURF_80330 C_XBASE_80330 V_XBOU_80330 L_PBASE_61023

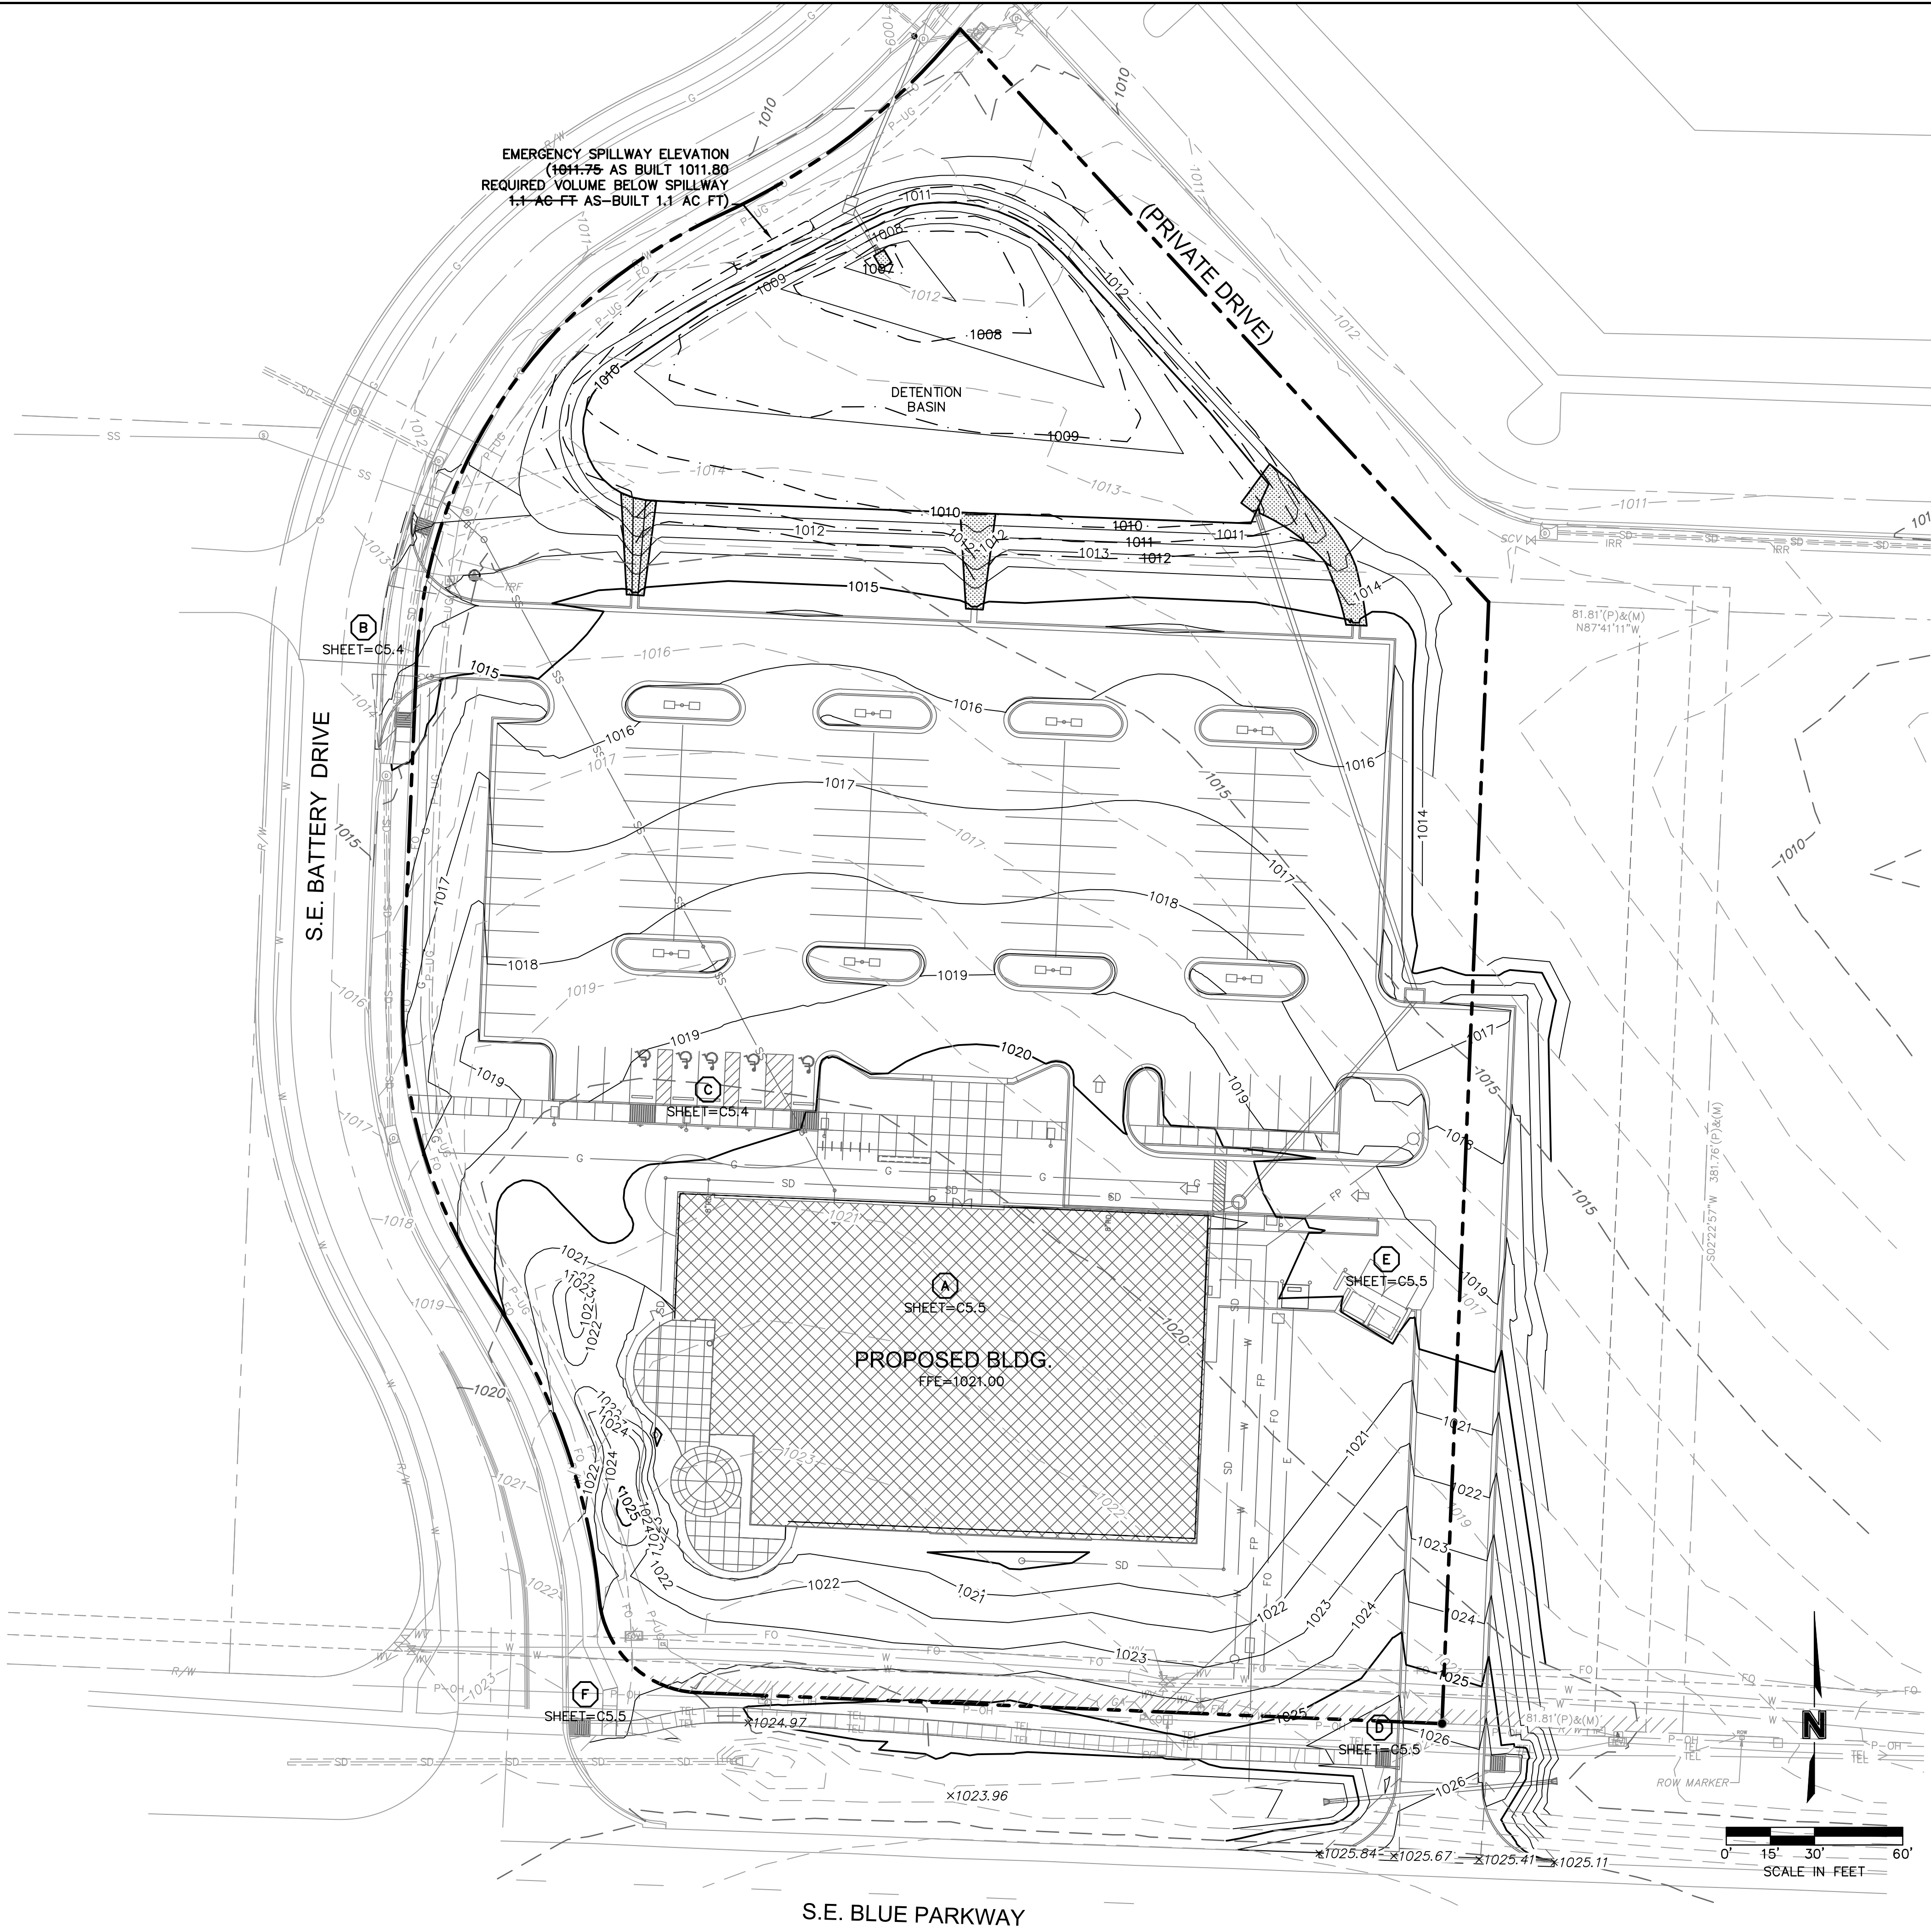


LEGEND	
	PROPERTY LINE
	EXISTING MAJOR CONTOUR
	EXISTING MINOR CONTOUR
	PROPOSED MAJOR CONTOUR
	PROPOSED MINOR CONTOUR
	AS-BUILT CONTOURS PROVIDED BY HEARTLAND HEAVY CONSTRUCTION
	RAMP
	CONCRETE CURB & GUTTER TYPE "CG-1"
	CONCRETE CURB & GUTTER TYPE "CG-1 DRY"
	CONCRETE CURB TYPE "C-1" MODIFIED
	GRADING DETAIL DESIGNATION RE: SHEET C5.1 THRU C5.5

- NOTES:
- CONTRACTOR TO REMOVE AND REPLACE ALL SIDEWALK NECESSARY FOR CONNECTION TO EXISTING.
 - ALL ADA ACCESSIBLE SIDEWALK CROSS SLOPES SHALL HAVE A MAXIMUM CROSS SLOPE OF 2.00% AND MAXIMUM LONGITUDINAL SLOPE OF 5.00%.
 - ALL ADA ACCESSIBLE PARKING AREAS SHALL NOT EXCEED 2.00% IN ANY DIRECTION.

SPOT ELEVATION LEGEND
ALL SPOT ELEVATIONS ARE TOP OF PAVEMENT ELEVATION UNLESS NOTED OTHERWISE. RE: PLAN VIEW, LEGEND AND DETAILS FOR CURB TYPE AND TO CALCULATE TOP OF CURB ELEVATION.

TC= TOP OF CURB
FG= FINISHED GRADE WITHIN GREENSPACE
TS= TOP OF STRUCTURE
TP=TC= CURB DEPRESSED TO BE FLUSH WITH ADJACENT PAVEMENT
HP= HIGH POINT
LP= LOW POINT
MATCH EX.= MATCH EXISTING
FFE= FINISH FLOOR ELEVATION AT TOP OF SLAB

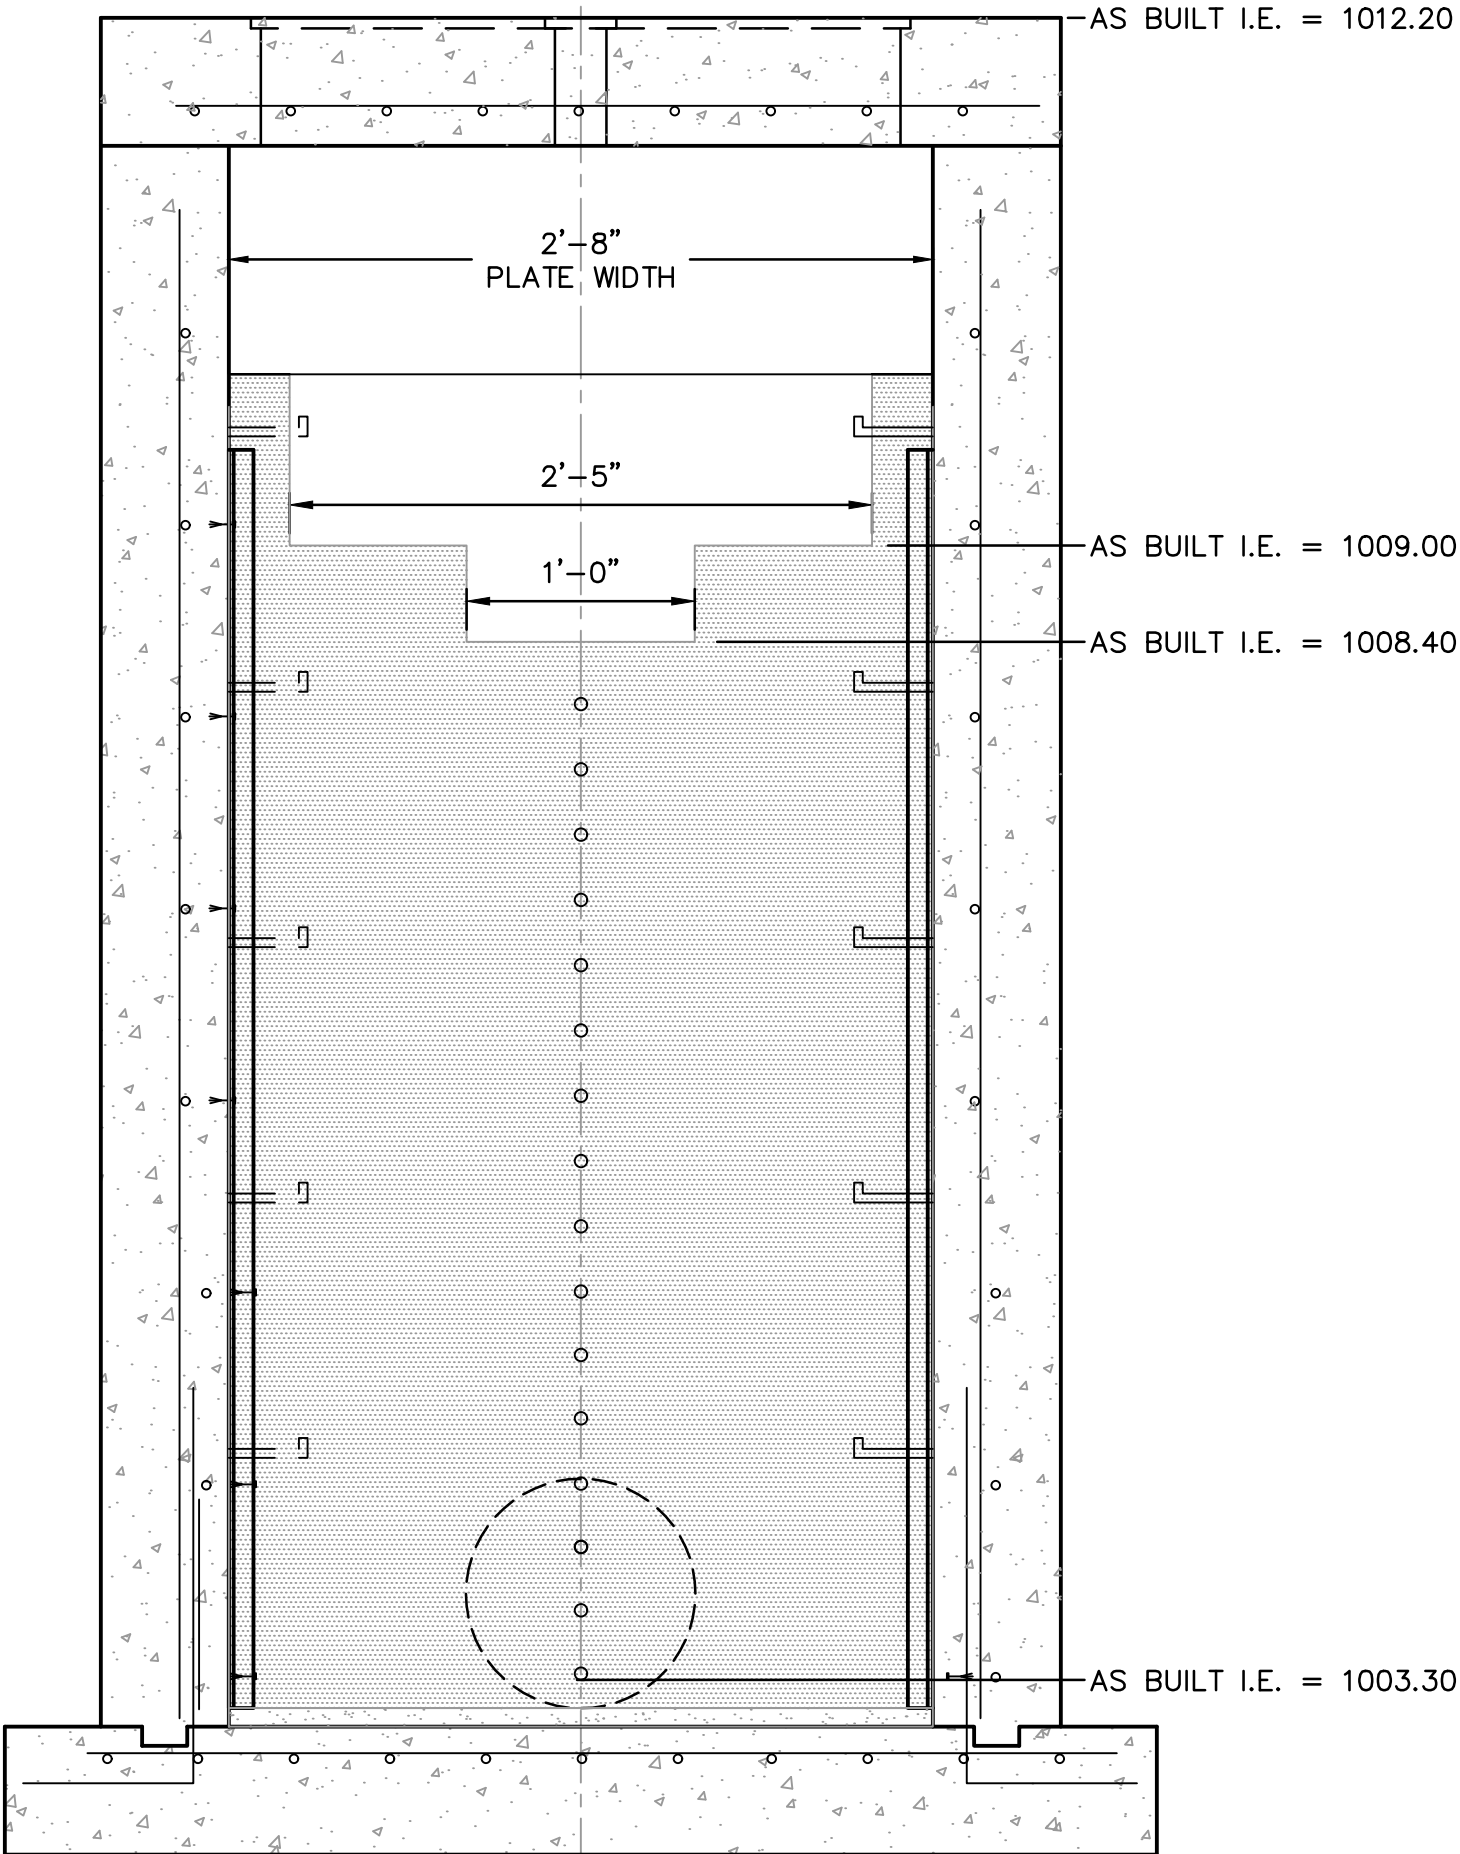

CONTROL STRUCTURE AS-BUILT
AS-BUILT CONTOURS PROVIDED BY HEARTLAND HEAVY CONSTRUCTION

**SAPP
DESIGN
ARCHITECTS**

3750 S. Fremont Ave.
Springfield, MO 65804 417.877.9600

Sapp Design Associates Architects, P.C.
Missouri State Certificate of Authority #000607

helix.

1629 Walnut
Kansas City, MO 64108 816.300.0300


SPECIAL NOTICES

In the event the client consents to, allows, authorizes or approves of changes to any plans, specifications or other construction documents, and these changes are not approved in writing by the design professional, the client recognizes that such changes and the results thereof are not the responsibility of the design professional. Therefore, the client agrees to release the design professional from any liability arising from the construction, use or result of such changes. In addition, the client agrees to the fullest extent permitted by law, to indemnify and hold the design professional harmless from any damage, liability or cost (including reasonable attorney's fees and costs of defense) arising from such changes.

The personal seal of the registered Architect or Engineer shall be the legal equivalent of his signature wherever & whenever used, and the owner of the seal shall authenticate this sheet and the specification sections pertaining to this sheet. Responsibility shall be disclaimed for all other plans, specifications, estimates, reports or other documents or instruments relating to or intended to be used for any part or parts of the architectural project.

Mid-Continent Public Library
CONSTRUCTION DOCUMENT PLANS FOR
EAST LEE'S SUMMIT BRANCH
2240 SE BLUE PARKWAY
LEE'S SUMMIT, MO 64063
JACKSON COUNTY

PACKAGE
04

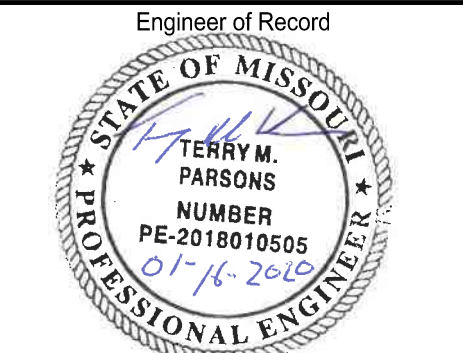

Terry M Parsons, Engineer MO PE-2018010505

olsson

7301 West 133rd Street, Suite 200
Overland Park, KS 66213
TEL 913.381.1170
FAX 913.381.1174
www.olsson.com

Olsson
Missouri State Certificate of Authority #001592

Revision No.	Description	Date
0	CONFORM TO CONSTRUCTION	01-16-2020

Project No.	Date	Drawn
B18-0330	12.07.18	RLK

Drawing No. **DC1.0**

**DETENTION
CERTIFICATION**

© Copyright 2018 - Sapp Design Associates, Architects, P.C.