


SCALE: 1" = 10'

1	12/9/20	RECHECK OF GRADE AREA	
NO.	DATE	DESCRIPTION	BY

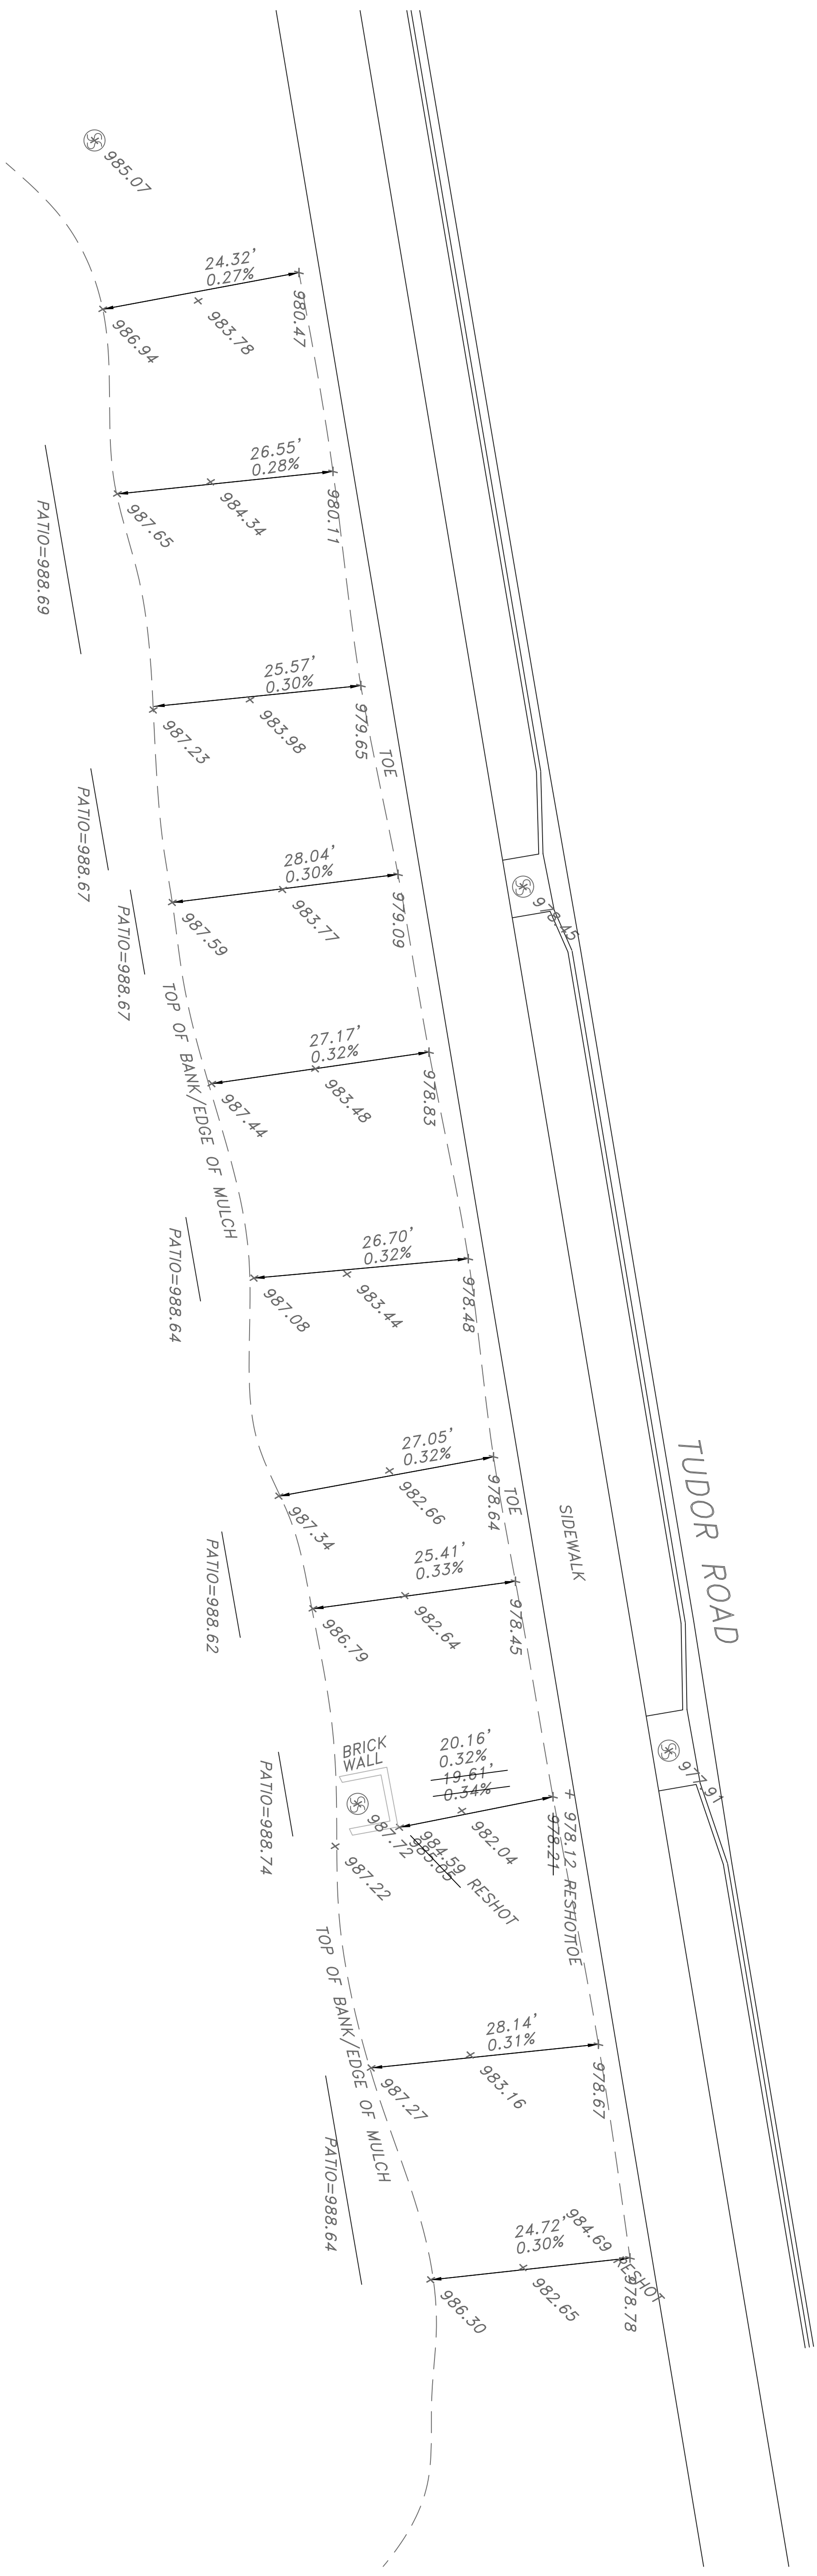

LAND SURVEYING SERVICES

SUMMIT SQUARE II
TUDOR & WARD ROAD

AS-BUILT

DATE: 12-02-2020	DRAWN BY: EKD	DRAWING
FIELD BOOK:	JOB NUMBER: 2020-146	NUMBER: 1 OF 1

JOB NUMBER: 2020-146

NUMBER: | OF |