



DWG: F:\2019\2001-2500\019-2339-A140-Design\AutoCAD\Final Plans - Asbuilts\Sheets\CONV\SANITARY\C_TTL01_A192339.dwg
DATE: Mar 10, 2021 3:42pm
USER: bworthley
XREFS: C_PBDY_A192339 C_PBLK_A192339

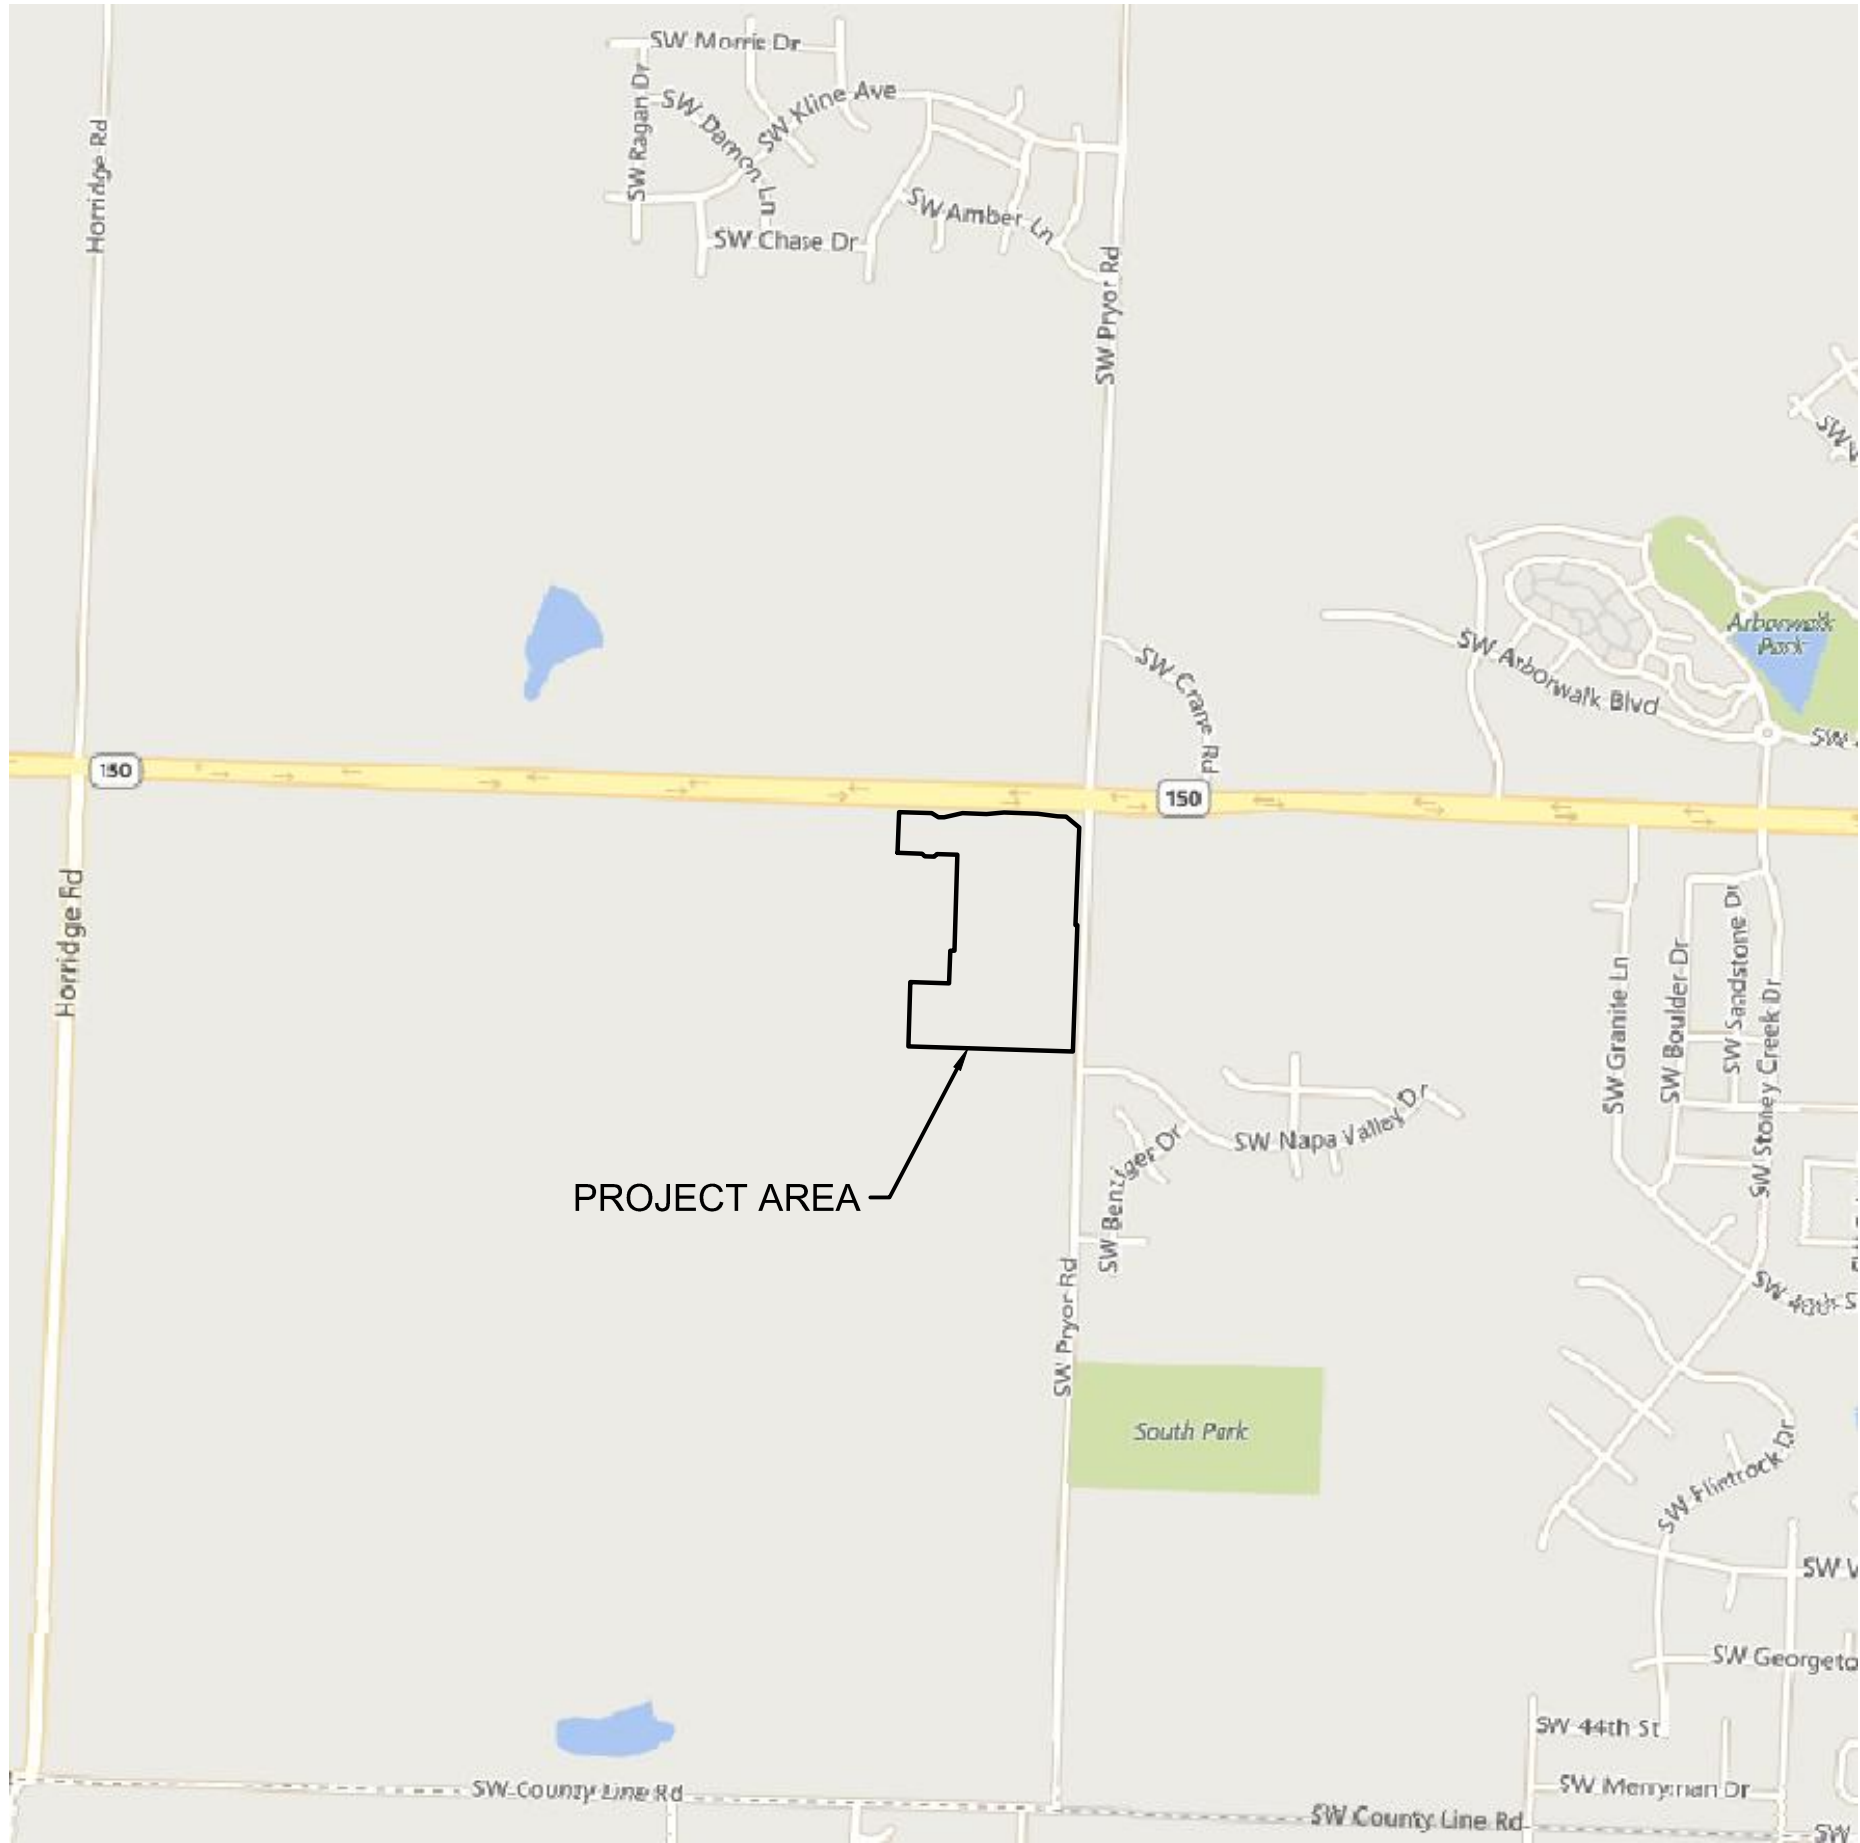

- ☐ NOT FOR CONSTRUCTION
- ☒ REVIEWED FOR CONSTRUCTION

PROJECT TEAM & UTILITY CONTACT LIST	
OWNER / DEVELOPER CLAYTON PROPERTIES GROUP, INC. D.B.A. SUMMIT HOMES 120 SE 30TH STREET CONTACT: VINCENT WALKER LEE'S SUMMIT, MO 64082 PHONE: 816.246.6700 EMAIL: VINCENT@SUMMITHOMESKC.COM	UTILITY SERVICE NUMBERS NAME: LEE'S SUMMIT PUBLIC WORKS PHONE: 816-969-1800 NAME: LEE'S SUMMIT WATER & SERVICES DEPARTMENT PHONE: 816-969-1940
ENGINEER OLSSON 1301 BURLINGTON ST. SUITE 100 NORTH KANSAS CITY, MO 64116 CONTACT: BROCK WORTHLEY PHONE: 816.361.1177 EMAIL: BWORTHLEY@OLSSON.COM	NAME: SPIRE (MGE) PHONE: 314-342-0500 NAME: AT&T PHONE: 800-286-8313 NAME: EVERGY PHONE: 816-471-5275
SURVEYOR OLSSON 1301 BURLINGTON ST. SUITE 100 NORTH KANSAS CITY, MO 64116 CONTACT: JASON ROUBEUSH PHONE: 816.361.1177 EMAIL: JROUBEUSH@OLSSON.COM	NAME: SPECTRUM (TWC) PHONE: 877-772-2253 NAME: GOOGLE FIBER PHONE: 877-454-6959

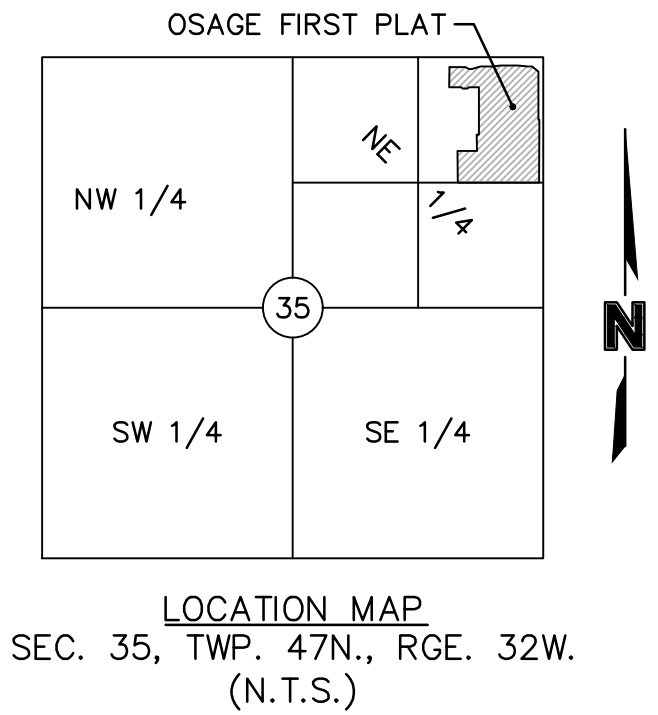

GENERAL NOTES

1. THE CONTRACTOR SHALL BE RESPONSIBLE FOR ENSURING THAT THE PLANS IN THEIR POSSESSION ARE THE MOST CURRENT VERSION ISSUED, ARE FULLY COORDINATED WITH ALL SUBCONTRACTORS, AND PRESENT ON SITE AT ALL TIMES. CURRENT PLANS PREPARED BY OLSSON MAY BE OBTAINED AT THE DIRECTION OF OLSSON'S CLIENT. DIRECT REQUESTS TO OLSSON MAY REQUIRE ADDITIONAL AUTHORIZATIONS, AGREEMENTS, AND/OR FEES. PLEASE CONTACT THE ENGINEER FOR INFORMATION.
2. THE CONTRACTOR SHALL BE RESPONSIBLE FOR ANY DEVIATIONS FROM THESE PLANS UNLESS WRITTEN APPROVAL FROM ENGINEER, OWNER, AND DEVELOPER.
3. ALL WORK AND MATERIALS SHALL BE SUBJECT TO INSPECTION AND APPROVAL BY THE OWNER OR THE OWNER'S REPRESENTATIVE.
4. ALL ESTIMATES OF QUANTITIES ARE FOR INFORMATIONAL PURPOSES ONLY. THE CONTRACTOR SHALL BE RESPONSIBLE FOR DETERMINING QUANTITIES AND ITEMS OF WORK.
5. THE CONTRACTOR SHALL BE RESPONSIBLE FOR PROVIDING ALL LABOR, MATERIALS, AND EQUIPMENT REQUIRED TO COMPLETE THE WORK SHOWN IN THE PLANS.
6. THE CONTRACTOR SHALL BE RESPONSIBLE FOR OBTAINING ALL REQUIRED PERMITS, PAYING ALL FEES, AND FOR OTHERWISE COMPLYING WITH ALL APPLICABLE REGULATIONS GOVERNING THE WORK.
7. THE CONTRACTOR SHALL NOT ENGAGE IN ACTIVITIES THAT MAY ENCROACH ON WATERS OF THE U.S., INCLUDING WETLANDS, UNTIL ANY NECESSARY PERMITS MAY BE OBTAINED. THE CONTRACTOR SHALL REVIEW AND COMPLY WITH ALL CONDITIONS DESCRIBED IN THE PERMIT.
8. THE CONTRACTOR SHALL BE SOLELY RESPONSIBLE FOR CONDITIONS OF THE JOB SITE, THE SAFETY OF ALL PERSONS INCLUDING VISITORS AND THE GENERAL PUBLIC, AND PROPERTY DURING PERFORMANCE OF THE WORK. THIS REQUIREMENT WILL APPLY CONTINUOUSLY THROUGHOUT THE PROJECT AND NOT BE LIMITED BY WORKING HOURS. ANY CONSTRUCTION OBSERVATION BY THE ENGINEER OF THE CONTRACTOR'S PERFORMANCE IS NOT INTENDED TO INCLUDE REVIEW OF THE ADEQUACY OF THE CONTRACTOR'S SAFETY MEASURES.
9. PRIOR TO COMMENCEMENT OF WORK THE CONTRACTOR SHALL NOTIFY AND COORDINATE WITH ALL UTILITY COMPANIES AND OBTAIN ANY RELEVANT INFORMATION. NOTIFY ENGINEER OF ANY DISCREPANCIES.
10. THE CONTRACTOR IS RESPONSIBLE FOR THE PROTECTION OF ALL BOUNDARY CORNERS AND SECTION CORNERS. ANY BOUNDARY CORNER AND/OR SECTION CORNER DISTURBED OR DAMAGED BY CONSTRUCTION ACTIVITIES SHALL BE RESET BY A LAND SURVEYOR LICENSED IN THE STATE OF MISSOURI, AT THE CONTRACTOR'S EXPENSE.
11. THE CONTRACTOR IS RESPONSIBLE FOR THE PROTECTION OF ADJACENT PROPERTIES AND SHALL TAKE ALL PRECAUTIONS NECESSARY TO PREVENT DAMAGE DURING CONSTRUCTION. THE CONTRACTOR IS ALSO RESPONSIBLE FOR REPAIRING ANY DAMAGE RESULTING FROM CONSTRUCTION ACTIVITIES.
12. PRIOR TO MOVING OFF THE JOB THE CONTRACTOR SHALL NOTIFY THE OWNER AND ENGINEER TO PERFORM A FINAL WALK-THROUGH OF THE CONSTRUCTION SITE.

REFERENCES

1. UNLESS EXPLICITLY DESCRIBED OTHERWISE WITHIN THESE PLANS THE FOLLOWING SHALL APPLY;
 - A. ALL CONSTRUCTION, INCLUDING THOSE LISTED BELOW, SHALL CONFORM TO THE LATEST CODES AND ORDINANCES OF LEE'S SUMMIT, MISSOURI.
 - B. ALL CONSTRUCTION IN MODOT RIGHT-OF-WAY SHALL CONFORM TO THE LATEST SPECIFICATIONS ADOPTED BY U.S. DEPARTMENT OF TRANSPORTATION AND MODOT.
 - C. ALL TRAFFIC CONTROL SIGNAGE SHALL CONFORM WITH THE CURRENT EDITION OF THE MANUAL FOR UNIFORM TRAFFIC CONTROL DEVICES (MUTCD).
 - D. ALL UTILITY EXTENSIONS AND CONSTRUCTION SHALL CONFORM TO THE STANDARDS AND SPECIFICATIONS OF THE UTILITY COMPANIES.
 - E. ALL EXTERIOR PAVEMENT (PCC, ASPHALT, ETC.) SHALL BE IN CONFORMANCE WITH THE SPECIFICATIONS OF LEE'S SUMMIT, MISSOURI.
4. THE CONTRACTOR IS RESPONSIBLE FOR CONTACTING THE DELIVERY MANAGER AND COORDINATING ANY MAILBOXES THAT MAY BE DISTURBED. FAILURE TO DO SO MAY SUBJECT THE CONTRACTOR TO PROSECUTION BY THE FEDERAL GOVERNMENT.

EXISTING CONDITIONS

1. THE CONTRACTOR SHALL VISIT THE SITE AND BECOME FAMILIAR WITH THE EXISTING CONDITIONS OF THE PROJECT AREA.
2. THE CONTRACTOR SHALL BE RESPONSIBLE FOR PERFORMING THEIR OWN INVESTIGATIONS AND MAKING THEIR OWN ASSUMPTIONS REGARDING SITE SURFACE AND SUBSURFACE CONDITIONS. THIS INCLUDES THE LOCATION AND CONSISTENCY OF ANY EXISTING ROCK LAYERS UNDERLYING THE PROJECT SITE. CONTACT THE ENGINEER REGARDING ANY DISCREPANCIES THAT MAY AFFECT THE ABILITY TO CONSTRUCT FROM THESE PLANS AS DESIGNED.
3. EXISTING CONDITIONS WERE DETERMINED THROUGH A VARIETY OF METHODS THAT MAY INCLUDE SURVEY, AERIAL IMAGERY, AVAILABLE RECORDS, GIS DATA, ETC. SUBSURFACE CONDITIONS ARE APPROXIMATE AND MAY NOT INCLUDE ALL UTILITIES AND OTHER SITE IMPROVEMENTS PRESENT ON SITE. THE CONTRACTOR SHALL MAKE EXPLORATION EXCAVATIONS AND LOCATE EXISTING UNDERGROUND UTILITIES SUFFICIENTLY AHEAD OF CONSTRUCTION TO PERMIT REVISIONS TO PLANS WHEN CONFLICTS AND DISCREPANCIES ARE FOUND.

CONSTRUCTION

1. THE CONTRACTOR SHALL INSTALL TRAFFIC CONTROL WHILE WORKING IN THE PUBLIC RIGHT-OF-WAY AS SHOWN IN THESE PLANS. IF PLANS ARE NOT PROVIDED, CONTRACTOR SHALL COORDINATE AND PROVIDE TRAFFIC CONTROLS TO THE SATISFACTION OF THE RIGHT-OF-WAY OWNER.
2. THE CONTRACTOR SHALL PROTECT ALL TREES OVER 3" CALIPER FROM DAMAGE. NO TREE SHALL BE REMOVED WITHOUT PERMISSION OF THE OWNER, UNLESS SHOWN OTHERWISE ON THESE PLANS.
3. THE CONTRACTOR SHALL DISPOSE ALL WASTE MATERIAL RESULTING

FROM THE PROJECT OFF-SITE AND IN STRICT CONFORMANCE WITH ALL
LOCAL CODES AND ORDINANCES.

4. ALL MANHOLES, CATCH BASINS, UTILITY VALVES AND METER PITS ARE TO BE ADJUSTED OR REBUILT TO GRADE AS REQUIRED. NOT ALL ADJUSTMENTS ARE INDICATED IN THE PLANS.
5. THE CONTRACTOR SHALL STREET SWEEP OR OTHERWISE CLEAN ALL ACCESS ROUTES TO THE SITE AT CONCLUSION OF THE PROJECT.

SHOP DRAWINGS

1. THE CONTRACTOR SHALL SUBMIT SHOP DRAWING A MINIMUM OF 7 DAYS PRIOR TO THE REQUESTED DATE OF APPROVAL. ENGINEER SHALL REVIEW SHOP DRAWINGS OR SAMPLES CONFORMANCE WITH THE DESIGN FOR THIS PROJECT AS DESCRIBED IN THE PLANS. THE CONTRACTOR SHALL BE RESPONSIBLE FOR ERRORS OR OMISSIONS IN SHOP DRAWINGS. THE ENGINEER'S REVIEW SHALL NOT EXTEND TO MEANS OR METHODS OF CONSTRUCTION. CONTRACTOR SHALL BE RESPONSIBLE FOR ANY VARIATION FROM THE REQUIREMENTS OF THE CONTRACT DOCUMENTS. UNLESS CONTRACTOR IS NOTIFIED BY ENGINEER OF EACH SUCH VARIATION AT THE TIME OF SUBMISSION, AND OBTAINED ENGINEER'S WRITTEN APPROVAL OF EACH SUCH VARIATION. PRIOR TO SUBMITTING EACH SHOP DRAWING OR SAMPLE, CONTRACTOR SHALL HAVE REVIEWED AND VERIFIED:
 - A. ALL FIELD MEASUREMENTS, QUANTITIES, DIMENSIONS, SPECIFIED PERFORMANCE CRITERIA, INSTALLATION REQUIREMENTS, MATERIALS, CATALOG NUMBERS AND SIMILAR INFORMATION WITH RESPECT THERETO;
 - B. ALL MATERIALS WITH RESPECT TO INTENDED USE, FABRICATION, SHIPPING, HANDLING, STORAGE, ASSEMBLY AND INSTALLATION PERTAINING TO THE PERFORMANCE OF THE WORK;
 - C. ALL INFORMATION RELATIVE TO MEANS, METHODS, TECHNIQUES, SEQUENCES AND PROCEDURES OF CONSTRUCTION AND SAFETY PRECAUTIONS AND PROGRAMS INCIDENT THERETO;
 - D. CONTRACTOR SHALL ALSO HAVE REVIEWED AND COORDINATED EACH SHOP DRAWING OR SAMPLE WITH OTHER SHOP DRAWINGS AND SAMPLES, AND WITH THE REQUIREMENTS OF THE WORK AND THE CONTRACT DOCUMENTS.
 - E. ALL SUBMITTED SHOP DRAWINGS SHALL BEAR A STAMP OR SPECIFIC WRITTEN INDICATION AND SIGNATURE THAT CONTRACTOR HAS FULLY COMPLETED THE ABOVE TASKS.
2. SHOP DRAWINGS AS DESCRIBED ABOVE ARE REQUIRED FOR, BUT NOT LIMITED TO, THE FOLLOWING:
 - A. ALL SANITARY SEWER STRUCTURES TO BE INSTALLED WITH THIS PROJECT.
 - B. ANY ITEMS IN THESE PLANS THAT ALLOW FOR AN "APPROVED EQUIVALENT" ALTERNATIVE.

SANITARY SEWER GENERAL NOTES

3. PRIOR TO COMMENCEMENT OF WORK THE CONTRACTOR SHALL NOTIFY AND COORDINATE CONSTRUCTION WITH CITY OF LEE'S SUMMIT, MISSOURI.
2. ALL PIPE LENGTHS ARE CALCULATED LINEARLY FROM CENTER OF STRUCTURE TO CENTER OF STRUCTURE.
4. ALL STRUCTURE DIMENSIONS ARE TO INSIDE FACE OF STRUCTURE.
5. COORDINATES ARE PROVIDED AT THE CENTER OF STRUCTURE. ADDITIONAL COORDINATES PROVIDED ARE PER LOCAL CODES AND ORDINANCES OR AS AN AID WHEN ORIENTING THE LID DURING INSTALLATION.
6. THE CONTRACTOR SHALL EXPOSE EXISTING UTILITIES AT LOCATIONS OF POSSIBLE CONFLICT AND POINTS OF CONNECTION PRIOR TO ANY CONSTRUCTION OF SANITARY SEWER.
7. SANITARY SEWER TRENCHES SHALL BE CONSTRUCTED SUCH THAT UNDISTURBED EXISTING SOIL OR FILL COMPACTED TO 95% PROCTOR DENSITY IS AT A DEPTH THAT IS 18" ABOVE TOP OF PROPOSED PIPE.
8. MANHOLE INVERT CHANNELS SHALL BE SMOOTH, CIRCULAR, AND CONFORMING TO 1/2 THE ADJACENT PIPE SECTION (INVERT TO CENTER). CHANGES IN DIRECTION OF FLOW SHALL BE MADE WITH A SMOOTH CURVE AND MAINTAIN SHAPE THROUGHOUT. CHANGES IN GRADE OF ADJACENT PIPES SHALL BE TRANSITIONED SMOOTHLY AND EVENLY THROUGH THE MANHOLE.
9. PIPE PENETRATIONS SHALL BE USE GASKETS TO ENSURE WATERTIGHT SEALS.
10. TRACING TAPE SHALL BE INSTALLED ALONG ALL NON-METALLIC SURFACES OR AS DIRECTED BY LOCAL CODES AND ORDINANCES.
11. SEWER LINE INSPECTIONS AND TESTING MUST BE SCHEDULED A MINIMUM OF TWO FULL BUSINESS DAYS IN ADVANCE. CONTRACTOR SHALL FURNISH ALL TESTING EQUIPMENT. TESTING SHALL INCLUDE
 - A. MANDREL TEST OF ALL GRAVITY SEWERS. IF THE MANDREL TEST FAILS ON ANY SECTION OF PIPE, THAT SECTION SHALL BE UNCOVERED AND REPLACED.
 - B. AIR PRESSURE TEST OF ALL GRAVITY SEWERS.
 - C. VACUUM TEST OF ALL MANHOLES.
12. REFER TO SHEET C215 FOR SANITARY DESIGN & SEWER LATERAL INFORMATION.
13. ALL SERVICE LINE CONNECTIONS SHALL BE MADE WITH AN 8"x4" PVC WYE, 4"PVC 45° BEND, AND THE APPROPRIATE LENGTH OF 4" PVC LATERAL (UNLESS OTHERWISE SHOWN) AND CAP. SEE DETAIL SHEET C216.
14. MSFE— INDICATES LOWEST FLOOR SERVICEABLE BY PROPOSED SANITARY SEWER.
15. MAXIMUM DEVIATION FROM LATERAL STATION LOCATIONS AS CALLED OUT SHALL BE 2.0' TO AVOID PIPE JOINT.
16. SANITARY LATERALS ARE DESIGNED @ 2.00% SLOPE. IF RISER IS INDICATED, IT IS TO BE AT THE SANITARY MAIN, UNLESS OTHERWISE NOTED.
17. REFER TO CURRENT CITY SPECIFICATIONS FOR MINIMUM PIPE SLOPES.
18. CONTRACTOR MAY BE REQUIRED TO RECONSTRUCT PIPE AND STRUCTURE IF MINIMUM INVERT DROP OR PIPE SLOPE REQUIREMENTS ARE NOT MET.
19. SANITARY STRUCTURES SHALL BE PER CURRENT CITY DETAILS. IF CITY DOES NOT HAVE PUBLISHED DETAILS STRUCTURES SHALL BE PER CURRENT APWA SPECIFICATIONS.
20. GRAVITY SANITARY SEWER AND WATER LINES SHALL BE SEPARATED BY A MINIMUM OF 10' HORIZONTALLY WHEN PARALLEL AND 2' VERTICALLY WHEN CROSSING. WATER LINES SHALL CROSS ABOVE SANITARY SEWERS.

CONTROL POINT TABLE				
POINT NUMBER	NORTHING	EASTING	POINT ELEVATION	DESCRIPTION
11	978424.224	2811650.442	1030.85	3" IB/CAP SET IN THE CENTER MEDIAN OF ROUTE 150. IT IS DUE NORTH OF THE CENTER LINE OF THE DRIVEWAY TO PROPERTY ADDRESS 2025 ROUTE 150. IT IS 12.15 FT WEST OF A LIGHT POLE, 8.5 FT SOUTH OF THE BACK OF CURB, AND 8.1 FT NORTH OF THE BACK OF CURB.
12	978340.573	2812332.280	1036.11	3" IB/CAP SET ON THE EAST SIDE OF SW PRYOR RD AT THE SOUTHEAST CORNER OF THE INTERSECTION OF ROUTE 150 AND SW PRYOR RD. IT IS 2.15 FT EAST OF THE BACK OF CURB, 19 FT WEST OF THE TRAFFIC SIGNAL POLE, AND 9.6 FT WEST OF A VAULT.
13	977064.448	2812265.992	1012.10	3" IB/CAP SET ON THE NORTHEAST CORNER OF THE INTERSECTION OF SW PRYOR RD AND SW NAPA VALLEY DR. IT IS 6 FT EAST OF THE BACK OF CURB, 10.2 FT NORTH OF THE CORNER OF THE SIDEWALK, AND 7.25 FT WEST OF ROCK LANDSCAPE BORDER.
14	977092.478	2810924.856	1040.93	3" IB/CAP SET IN THE NORTHWEST CORNER OF THE SOUTH ADJOINING PROPERTY. IT IS 7.5 FT EAST OF THE FENCE LINE, AND 45 FT SOUTH OF OF THE TREE LINE.
18	978446.811	2810956.695	1050.47	3" IB/CAP SET IN THE CENTER MEDIAN OF ROUTE 150. THE POINT IS DIRECTLY SOUTH OF A WHITE MAILBOX ON AN ORANGE POST FOR HOUSE ADDRESS 2144 ROUTE 150. IT IS 6.6 FT SOUTH OF THE BACK OF CURB, 5.8 FT NORTH OF THE BACK OF CURB, AND 31 FT EAST OF A LIGHT POLE.
BENCHMARK				
BMK1	977045.350	2812211.924	1014.83	CHISELED PLUS ON THE EAST FLANGED BOLT OF THE FIRE HYDRANT ON THE WEST SIDE OF SW PRYOR ROAD ON ADJOINING PROPERTY SOUTH OF THE SOUTHWEST CORNER OF SUBJECT PROPERTY.
BMK2	978357.416	2811627.737	1031.31	RAILROAD SPIKE IN THE NORTH FACE OF POWER POLE LOCATED ON THE SOUTH SIDE MISSOURI STATE HIGHWAY 150 AT THE WEST SIDE OF THE DRIVEWAY TO 2025 MISSOURI STATE HIGHWAY 150, LEE'S SUMMIT, MO.

AS-BUILT

3/10/2021

ESTIMATE OF QUANTITIES				
ITEM NO.	DESCRIPTION	UNIT	QUANTITY	AS-BUILT
STREET				
1	8" SANITARY PVC (SDR-26)	L.F.	4175.11	4,185.40
2	12" SANITARY PVC (SDR-26)	L.F.	858.49	857.78
3	MANHOLES, STD. 4' DIA.	EA.	21	21
4	CONNECTION TO EXISTING STUB	EA.	1	1
5	TRACER WIRE	L.F.	3349.81	3349.81*
6	TRACER WIRE BOX	EA.	101	101*
7	SERVICE WYE	EA.	101	101*
8	4" LATERAL PIPE	L.F.	3349.81	3349.81*

AS PROVIDED BY CONTRACTOR*

SUMMARY OF QUANTITIES AS INDICATED ABOVE AND ANY QUANTITIES AS SHOWN WITHIN THE PLANS HAVE BEEN PROVIDED FOR PERMITTING PURPOSES ONLY AND ARE NOT INTENDED FOR USE IN PREPARATION OF CONTRACT DOCUMENTS. QUANTITIES INTENDED FOR, BUT NOT LIMITED TO, THE PREPARATION OF PROPOSALS AND BID DOCUMENTS SHALL BE INDEPENDENTLY EVALUATED BY THE ESTIMATING PARTY BASED UPON THE CONTENTS OF THESE PLANS.



Olsson - Civil Engineering
Missouri Certificate of Authority #: 001592
1301 Burlington Street
North Kansas City, MO 64116

GENERAL NOTES

OSAGE
FIRST PLAT

LEE'S SUMMIT, MISSOURI

2020


DEVIATIONS

[illegible]

drawn by: AA
checked by: SS
designed by: AA
QA/QC by: JES
project no.: A19-2339
drawing no.: C TTL01 A192339
date: 3/17/2020


SHEET
C202

DWG: F:\2019\2001-2500\019-2339-A\40-Design\AutoCAD\Final Plans - Asbuilts\Sheets\GEN01\SANITARY\C_GEN01_A192339.dwg
DATE: Mar 10, 2021 3:43pm
XREFS: C_XBASE_A192339 C_FBASE_A192339 C_PBASE_A192339 C_PENDY_A192339 C_PTBLK_A192339 C_PUTIL_A192339
USER: bwerthley
T_PBASE_A192339

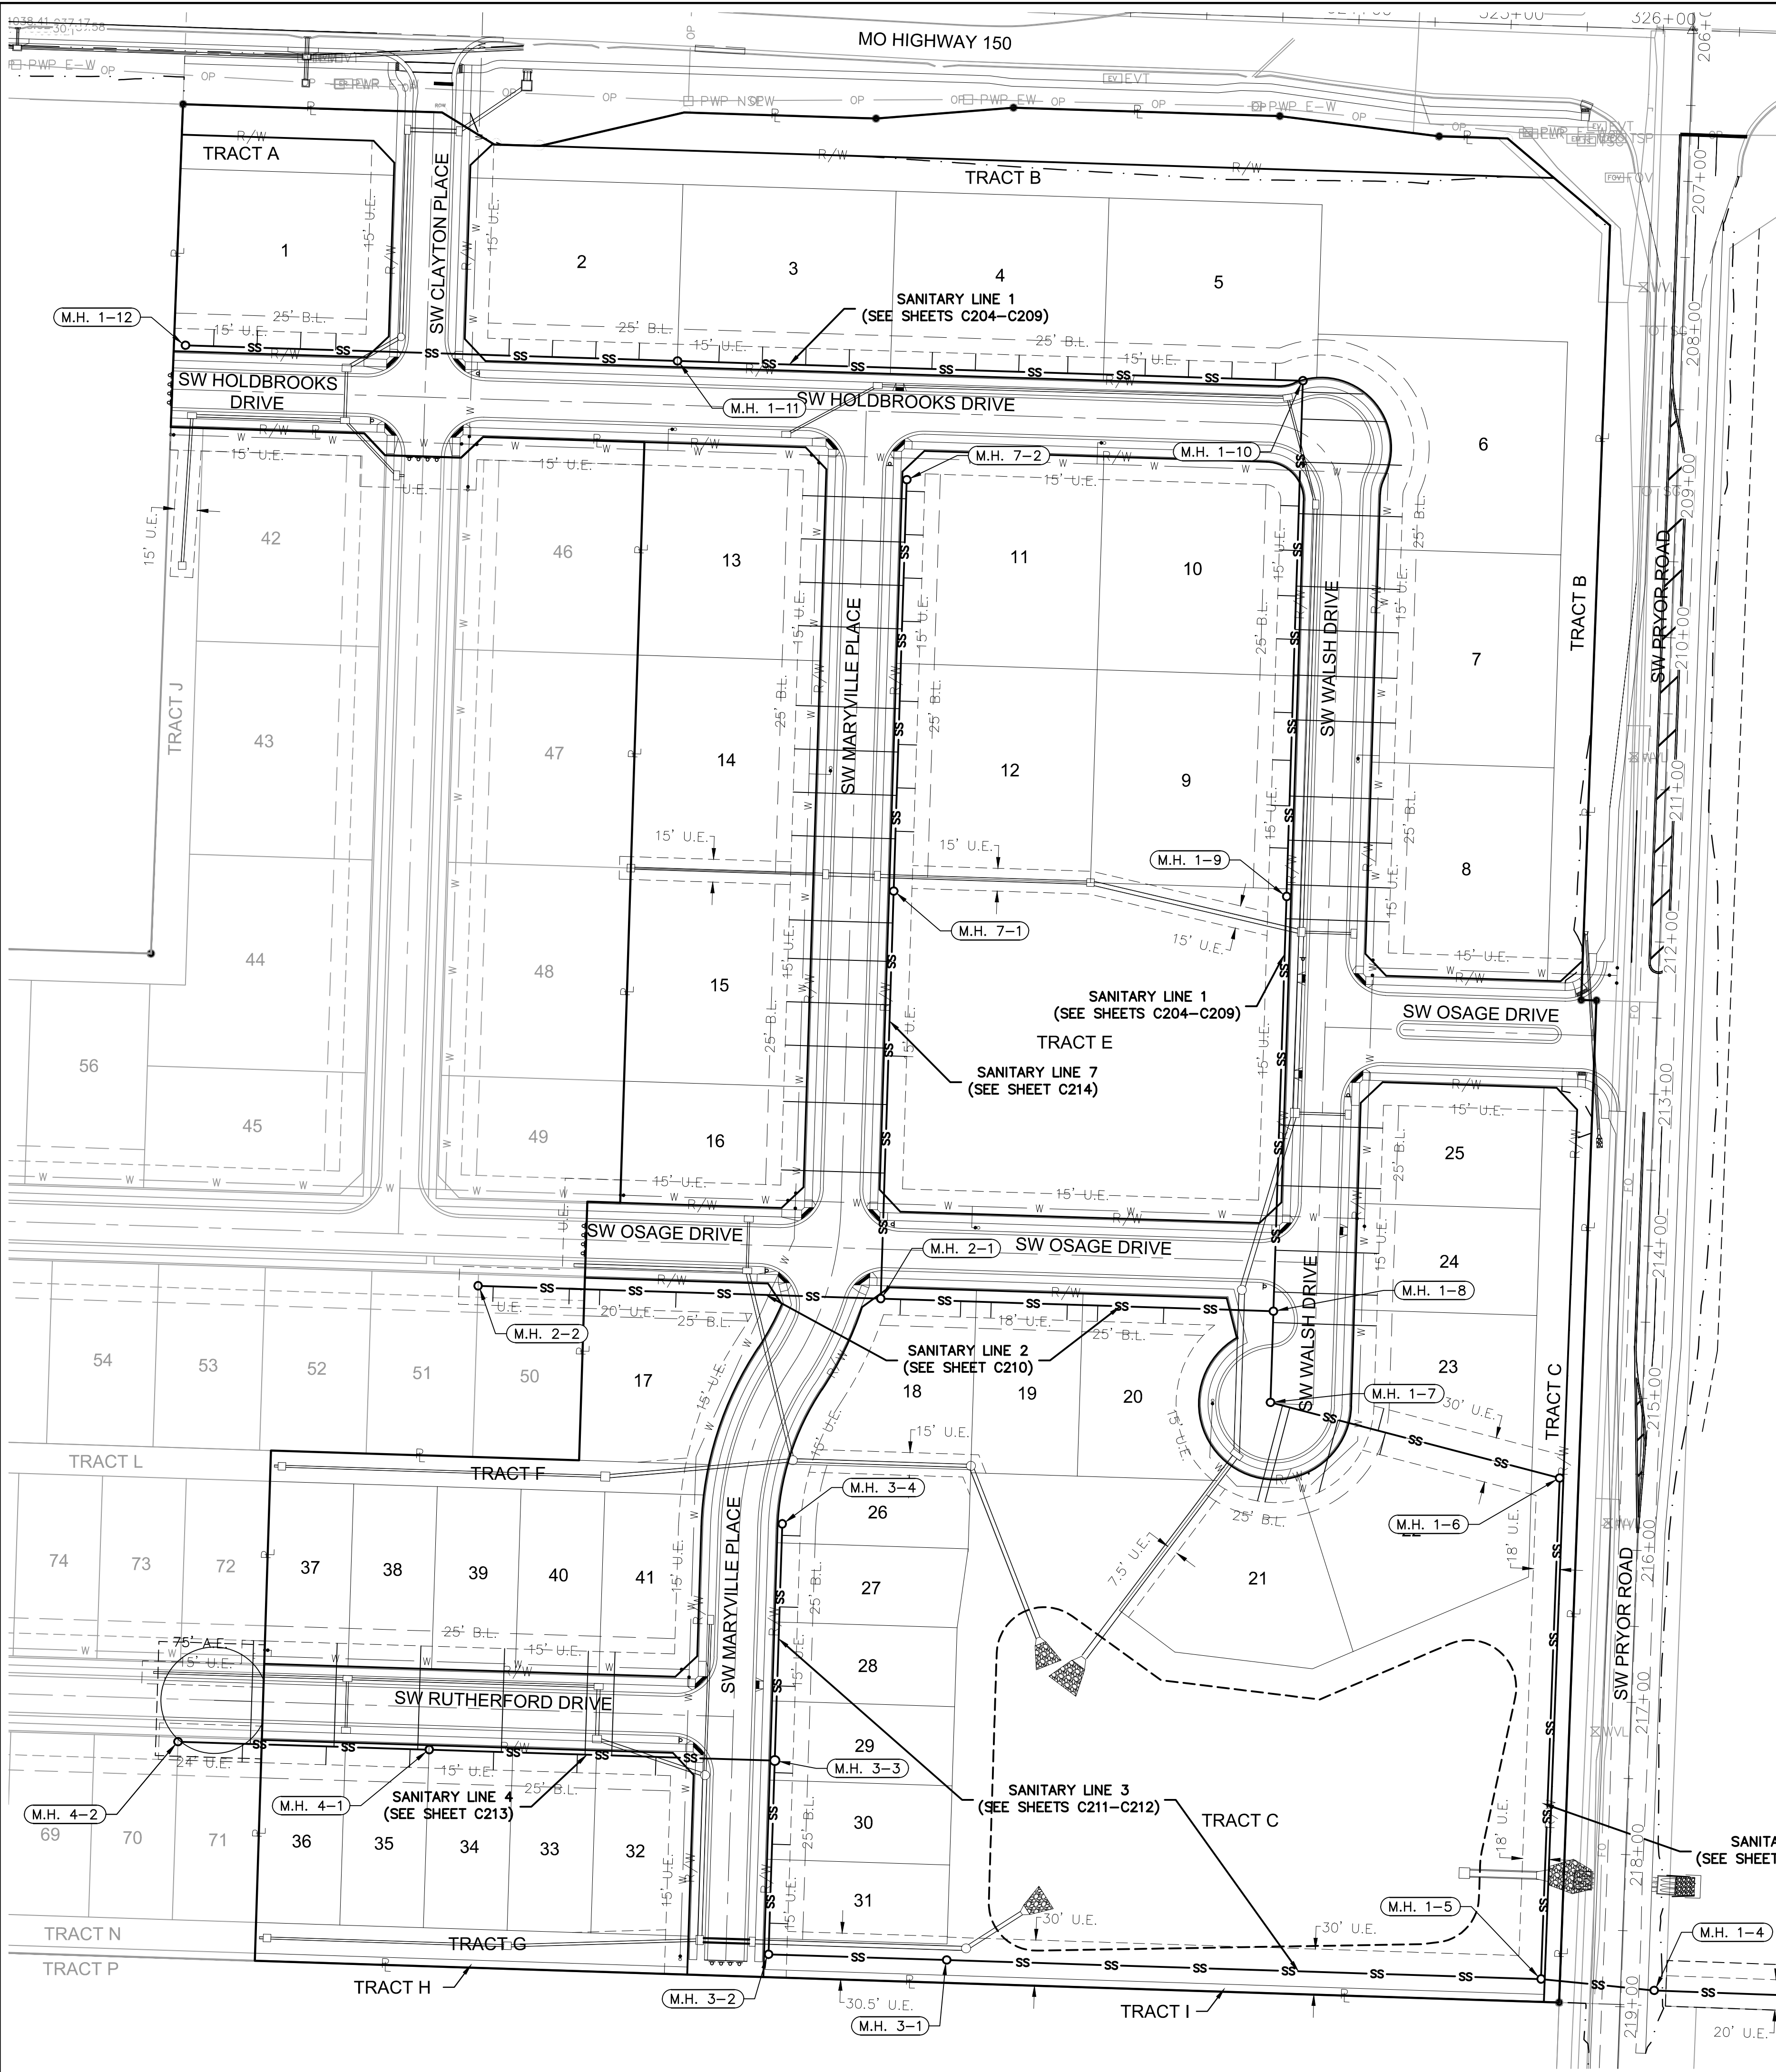

STRUCTURES		
STRUCTURE ID	NORTHING	EASTING
EX M.H. 1-1	977050.6180	2813007.8630
M.H. 1-2	977088.6386	2813007.5150
M.H. 1-3	977102.6786	2812623.6045
M.H. 1-4	977115.8940	2812262.2375
M.H. 1-5	977123.3798	2812187.9232
M.H. 1-6	977452.5727	2812200.1858
M.H. 1-7	977502.2385	2812010.2904
M.H. 1-8	977562.1899	2812012.1899
M.H. 1-9	977834.6532	2812020.8230
M.H. 1-10	978173.4941	2812031.5592
M.H. 1-11	978186.5102	2811620.7654
M.H. 1-12	978196.7501	2811297.5874
M.H. 2-1	977570.4687	2811754.3228
M.H. 2-2	977578.8528	2811489.8379
M.H. 3-1	977135.9030	2811797.5849
M.H. 3-2	977139.6553	2811680.6423
M.H. 3-3	977266.8932	2811684.6738
M.H. 3-4	977422.4460	2811689.6326
M.H. 4-1	977274.0858	2811457.6700
M.H. 4-2	977279.3112	2811292.7528
M.H. 7-1	977838.1830	2811762.8054
M.H. 7-2	978108.4677	2811771.3694

NOT AS-BUILT

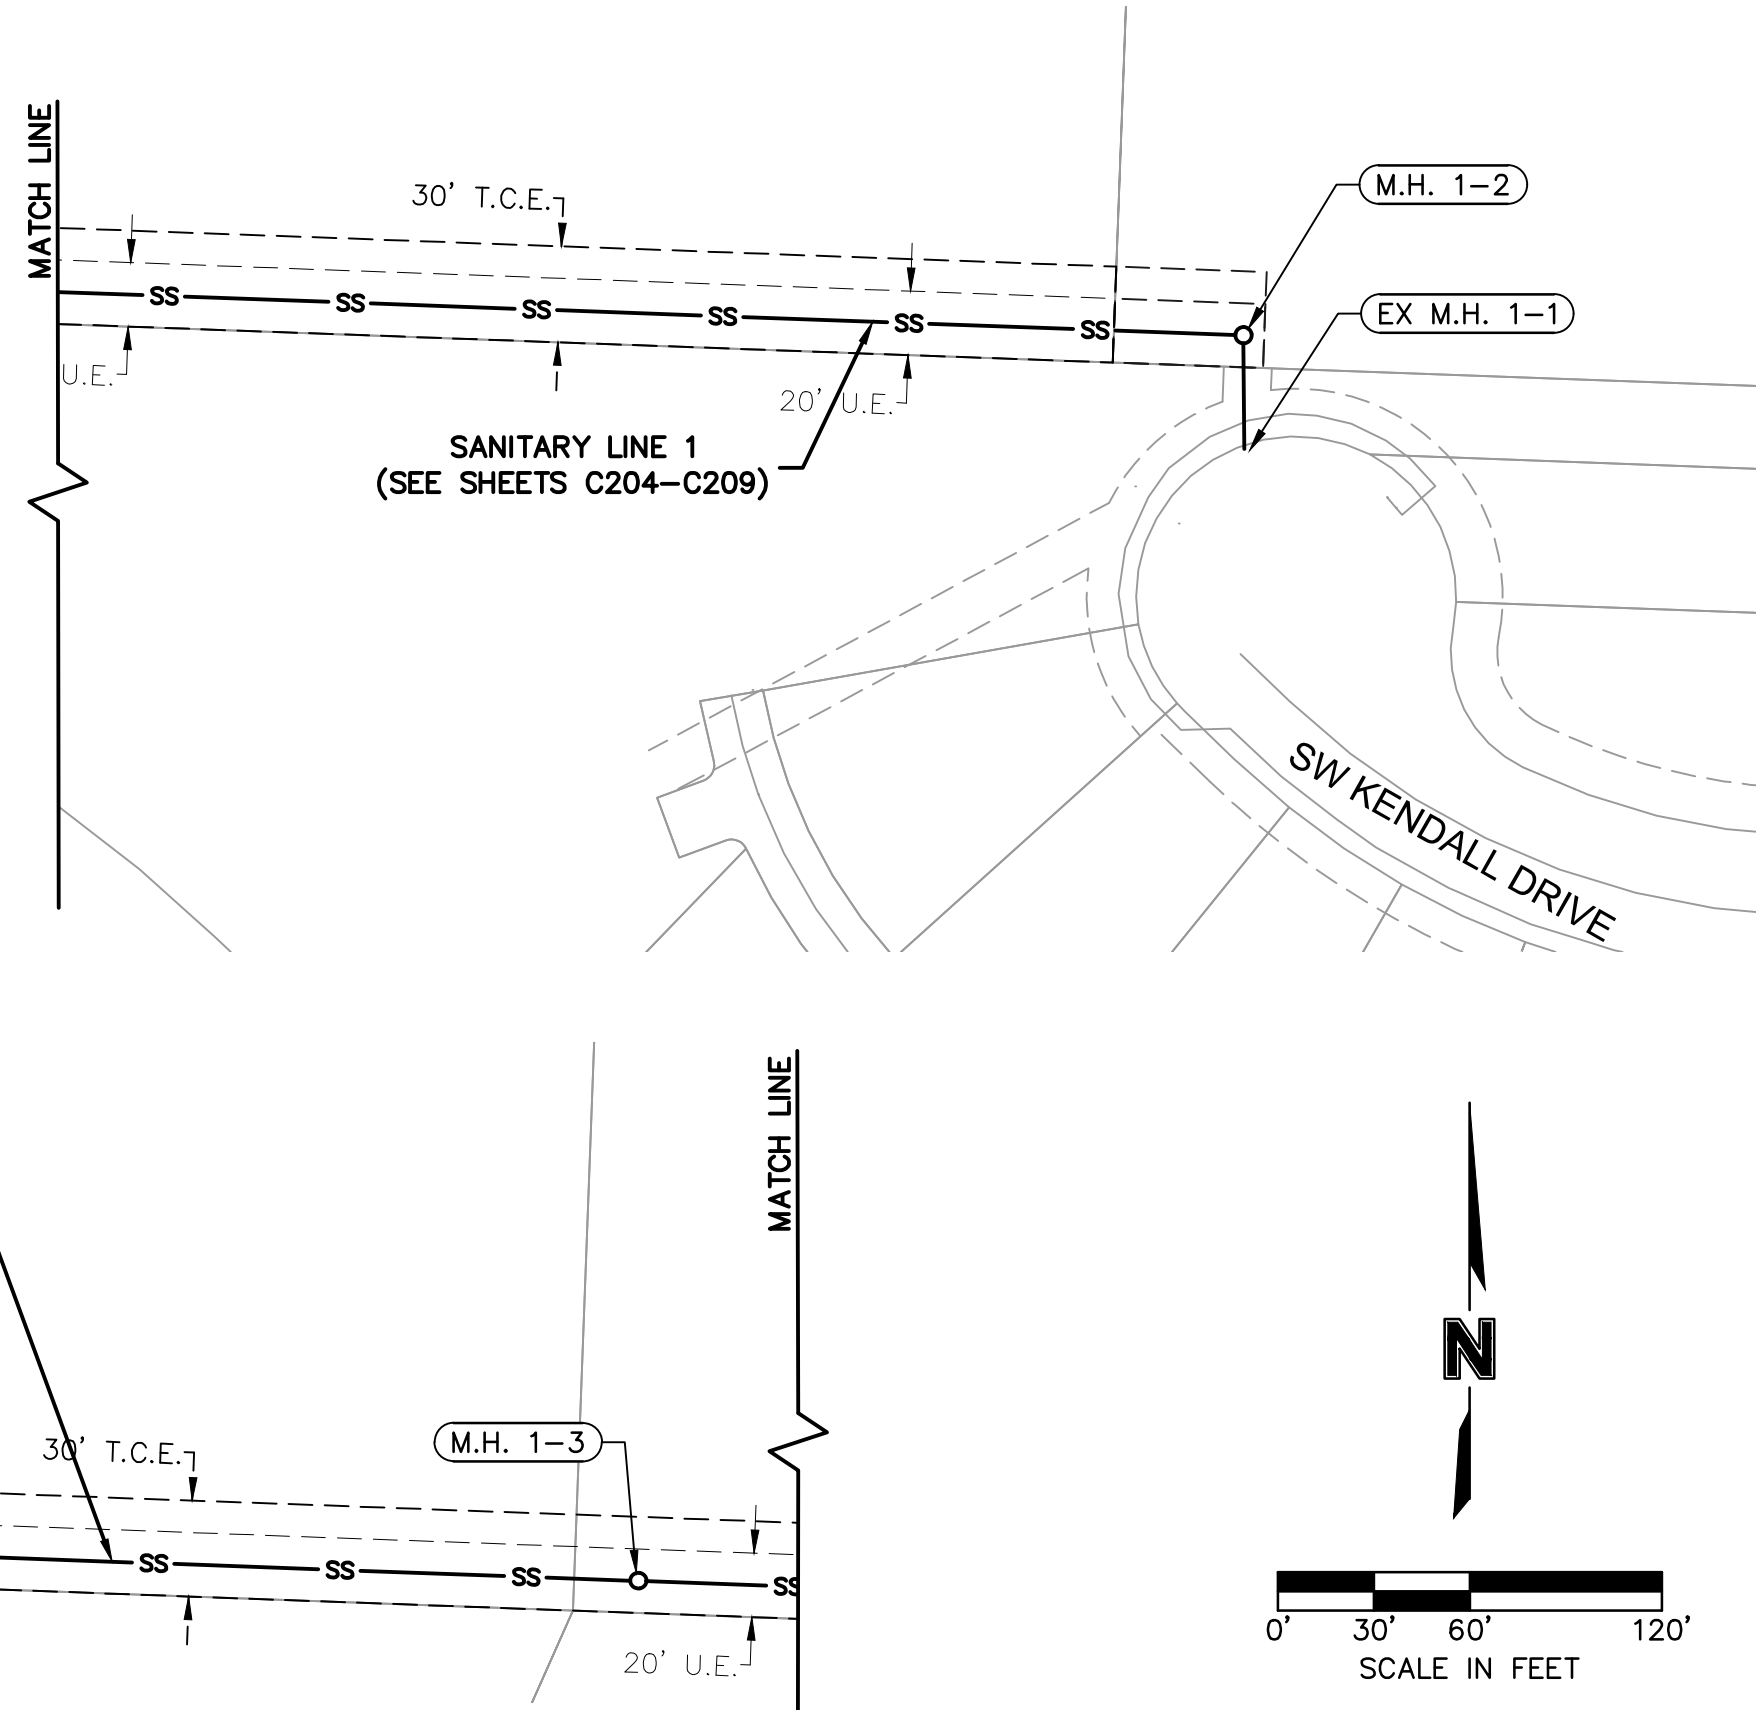

olsson

Olsson - Civil Engineering
Missouri Certificate of Authority # 001592
1301 Burlington Street
North Kansas City, MO 64116
TEL 816.361.1177
www.olsson.com

STATE OF MISSOURI
BROCK M. WORTHLEY
LICENSED PROFESSIONAL ENGINEER
PE-2019000237
3/10/2021

BY

REVISIONS DESCRIPTION

DATE

REV. NO.

GENERAL LAYOUT
SANITARY SEWER PLANS



OSAGE
FIRST PLAT

LEE'S SUMMIT, MISSOURI

2020

SHEET
C203

DWG: F:\2019\2001-2500\019-2339-A\40-Design\AutoCAD\Final Plans - Asbuilts\Sheets\CONV\SANITARY\C_SSWR01_A192339.dwg
DATE: Mar 10, 2021 3:43pm XREFS: C_XBASE_A192339 C_FBASE_A192339 C_PBASE_A192339 C_PNDY_A192339 C_PUIL_A192339 C_PTBLK_A192339 USER: bworthley

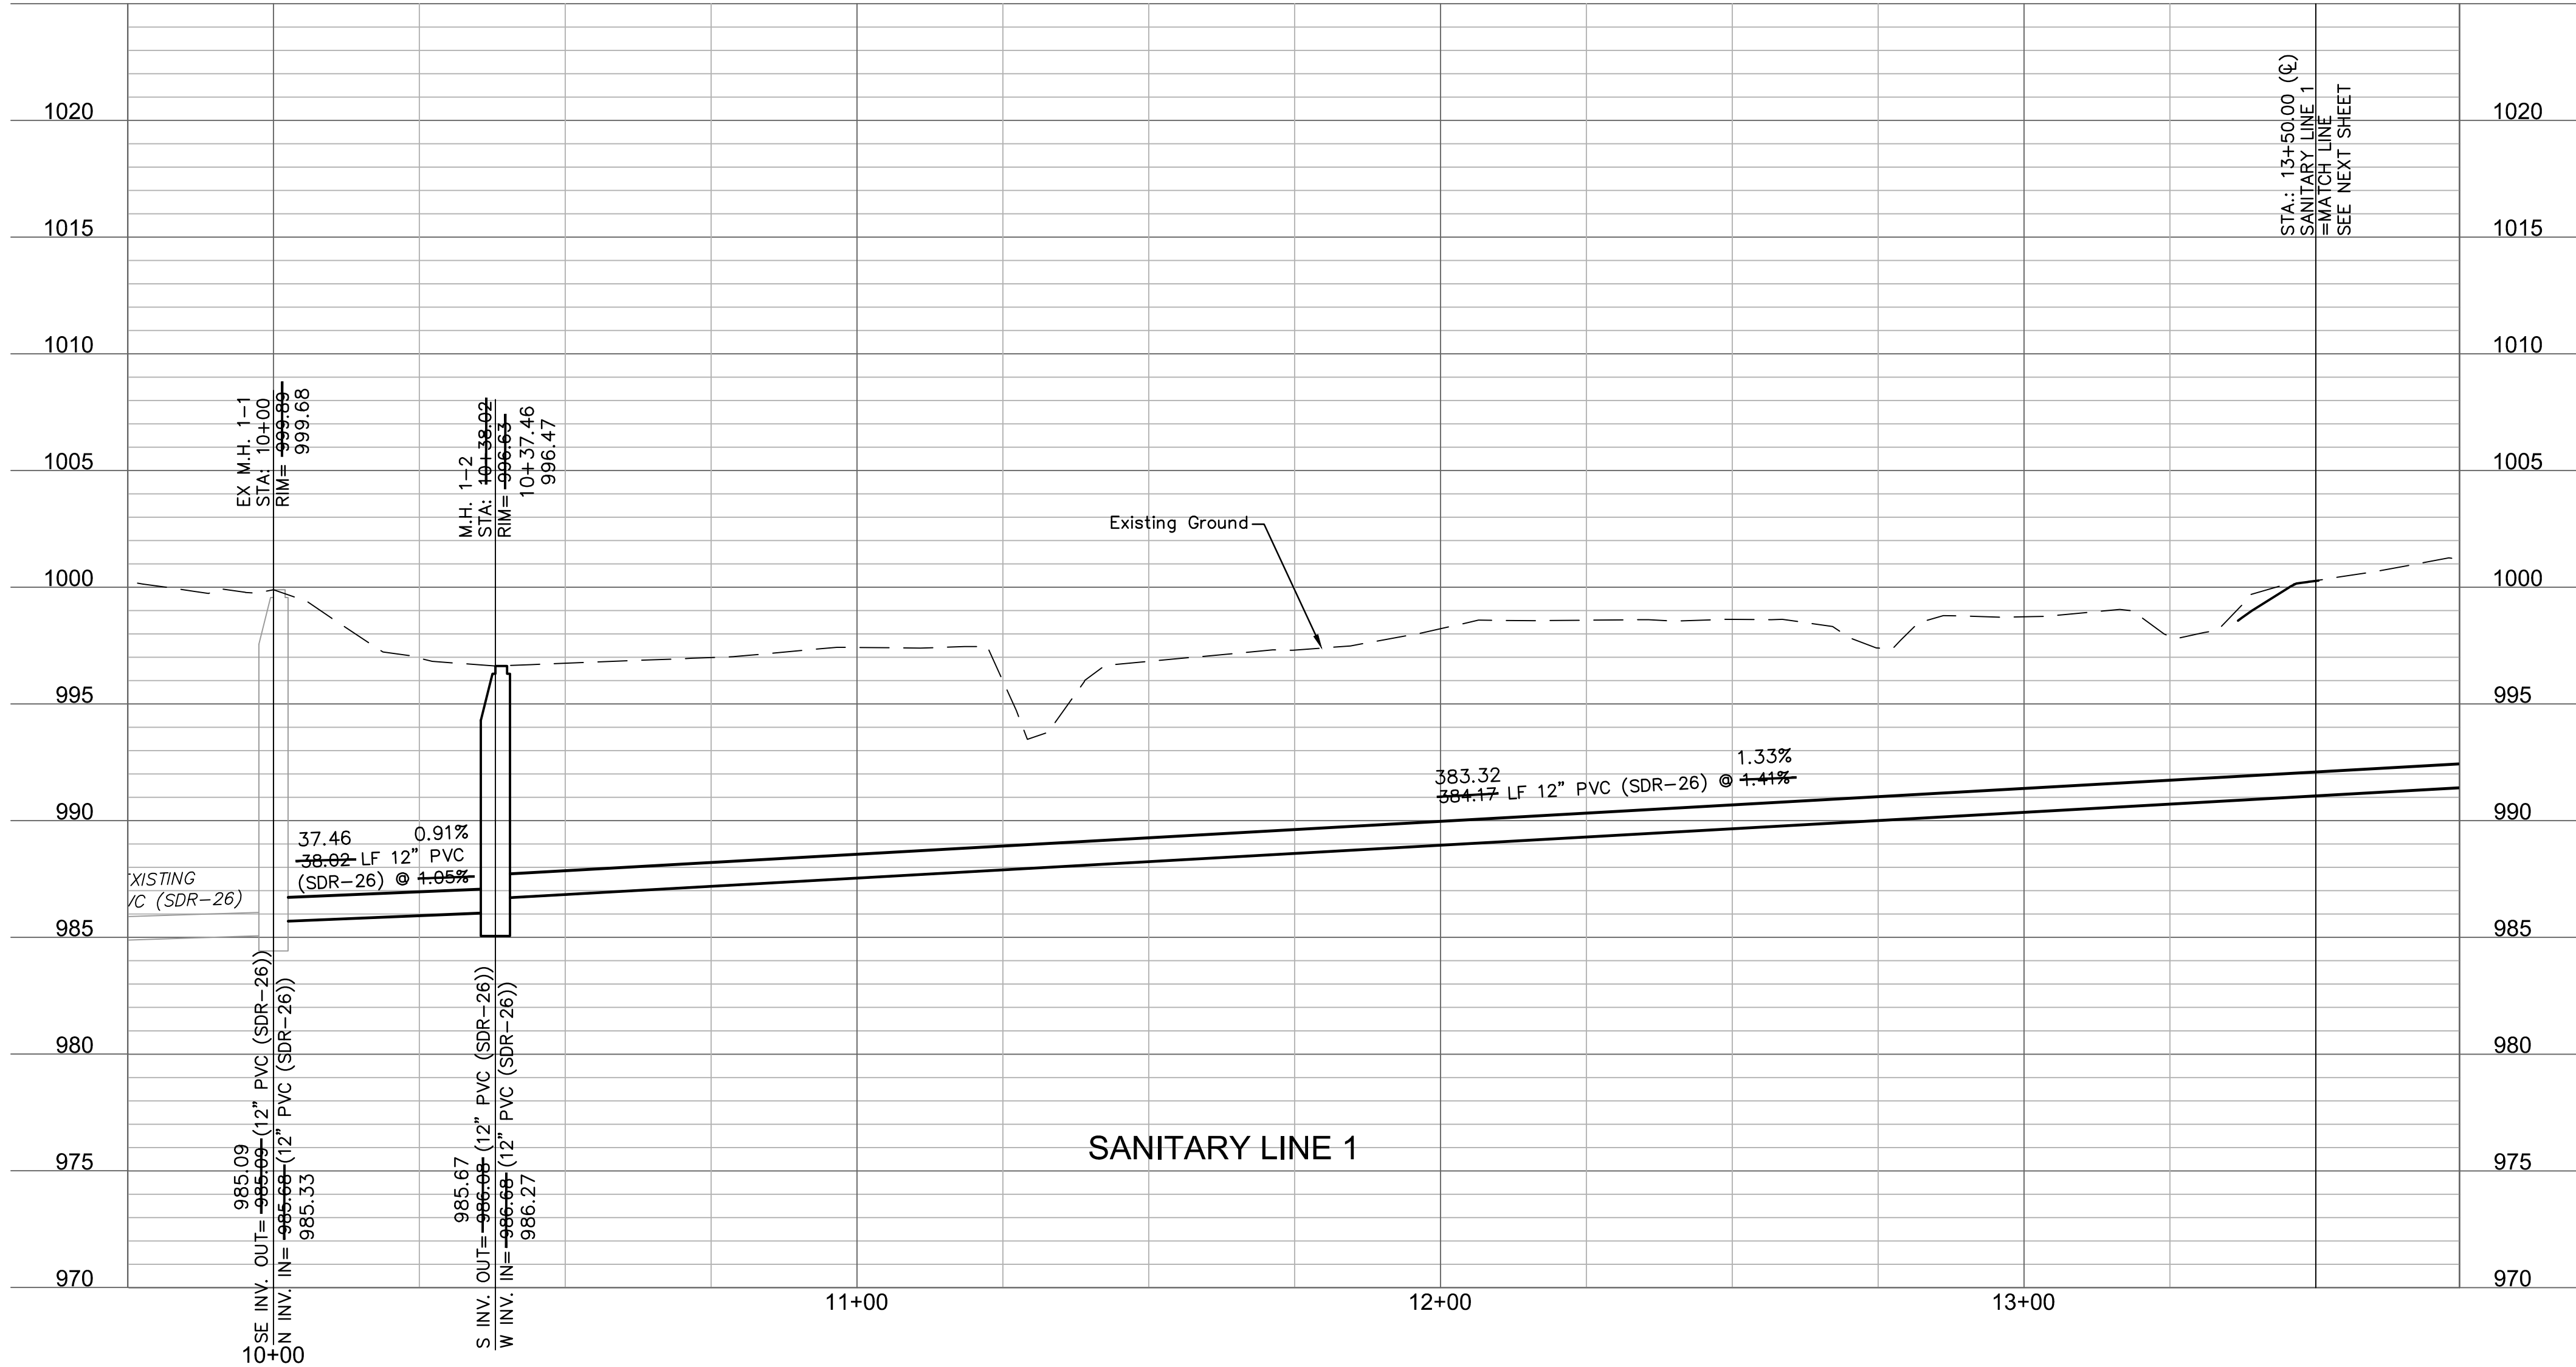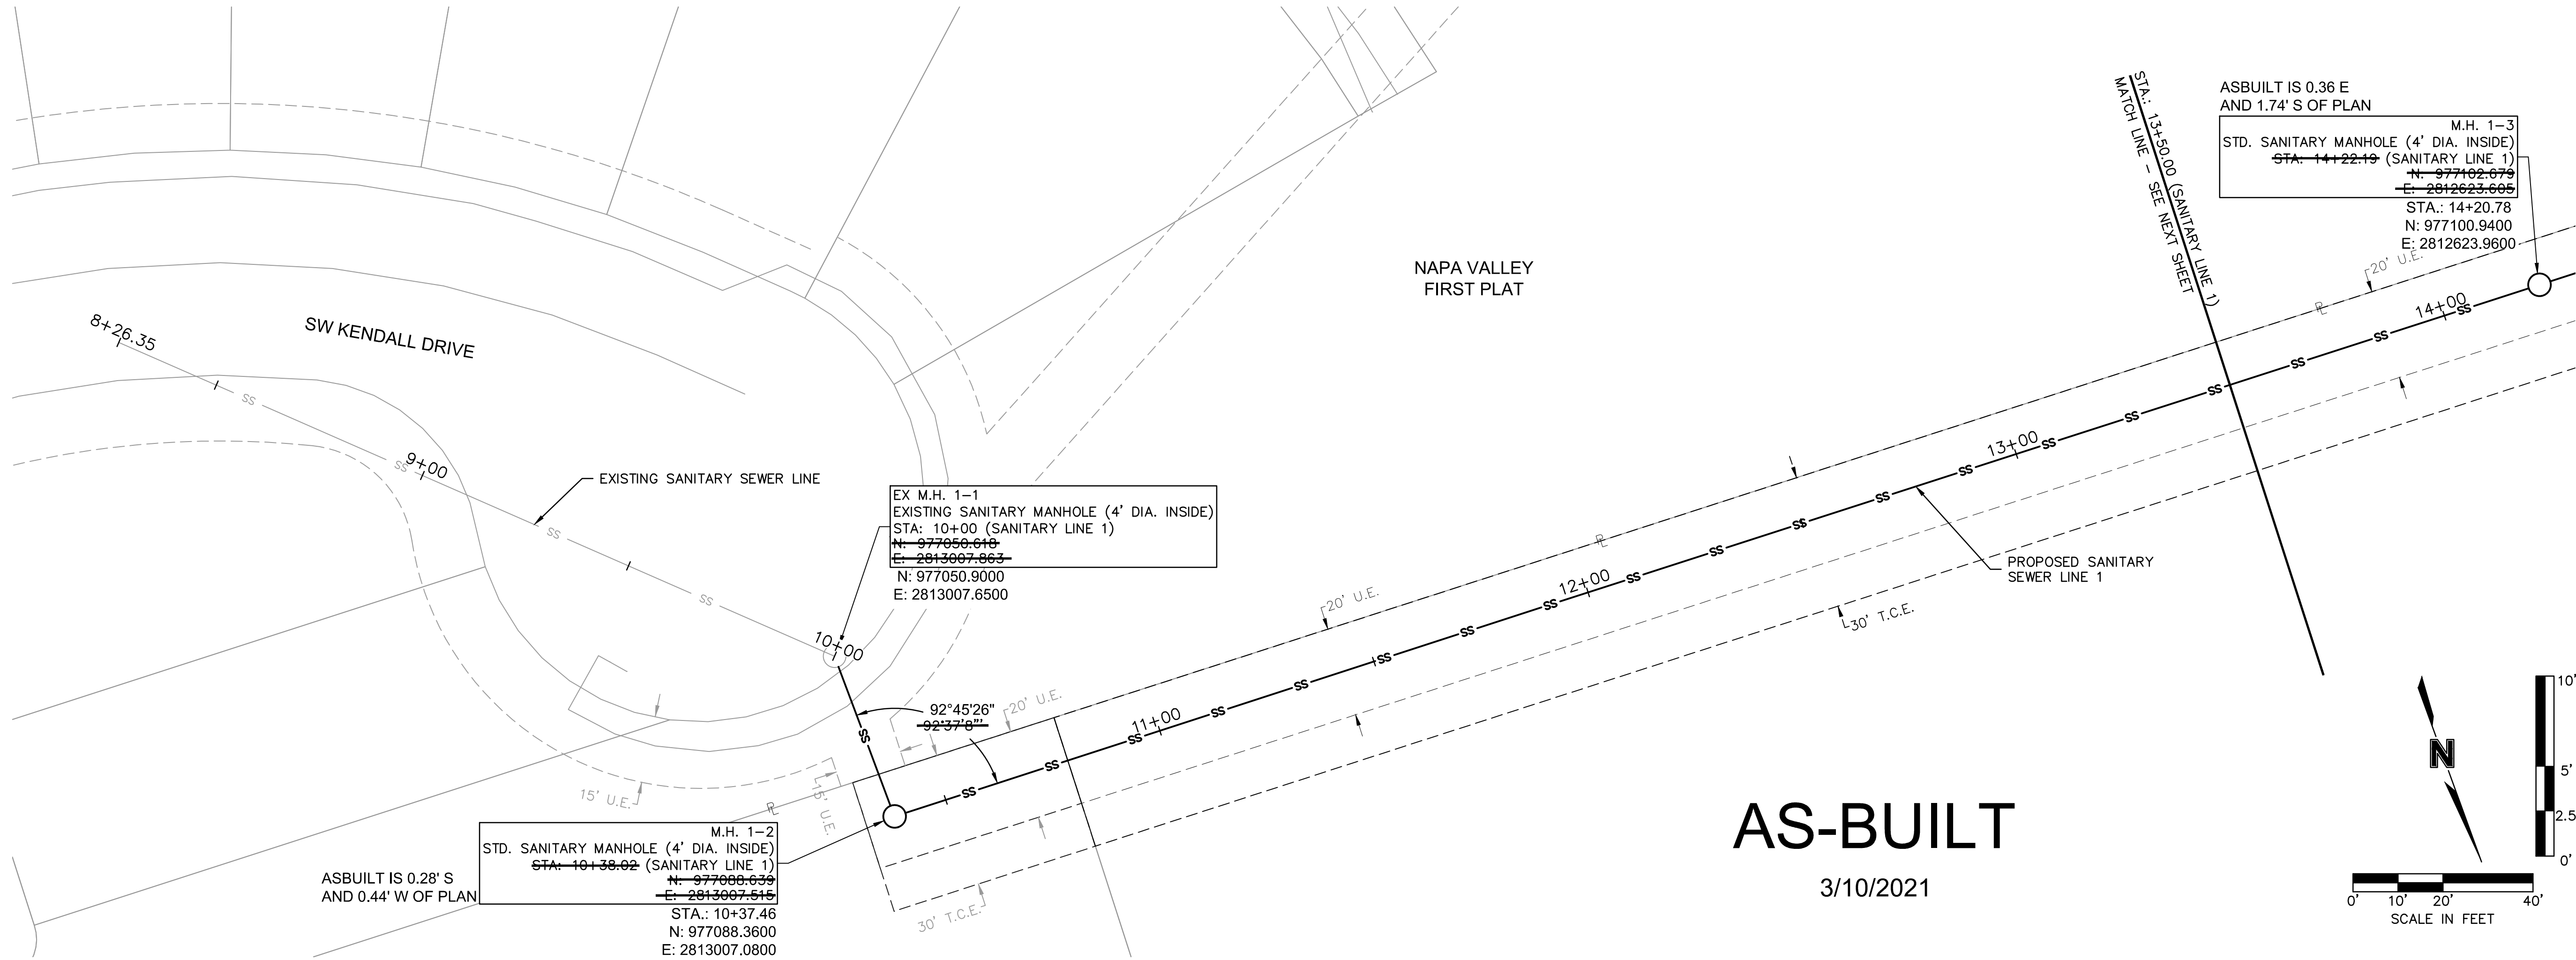

olsson

Olsson - Civil Engineering
Missouri Certificate of Authority # 001592
1301 Burlington Street
North Kansas City, MO 64116
TEL 816.361.1177
www.olsosn.com

STATE OF MISSOURI
BROCK M. WORTHLEY
LICENSED PROFESSIONAL ENGINEER
PE-3019400237
3/10/2021

REV.	NO.	DATE	REVISIONS DESCRIPTION	BY
2		7/24/2020	MH 1-2 AND CONNECTED PIPES ADJUSTED BASED ON FINDINGS ON SITE	

SANITARY PLAN & PROFILE (LINE 1)
SANITARY SEWER PLANS

OSAGE
FIRST PLAT



LEE'S SUMMIT, MISSOURI

2020

drawn by: AA
checked by: SS
designed by: AA
QA/QC by: JES
project no.: A19-2339
drawing no.: C_SSWR01_A192339
date: 3/17/2020

SHEET
C204

DWG: F:\2019\2001-2500\019-2339-A140-Design\AutoCAD\Final Plans - Asbuilts\Sheets\CONV\SANITARY\C_SSWR01_A192339.dwg
DATE: Mar 10, 2021 3:44pm XREFS: C_XBASE_A192339 C_FBASE_A192339 C_PBASE_A192339 C_PBDY_A192339 C_PTBLK_A192339 C_PUTIL_A192339
USER: bworhtley

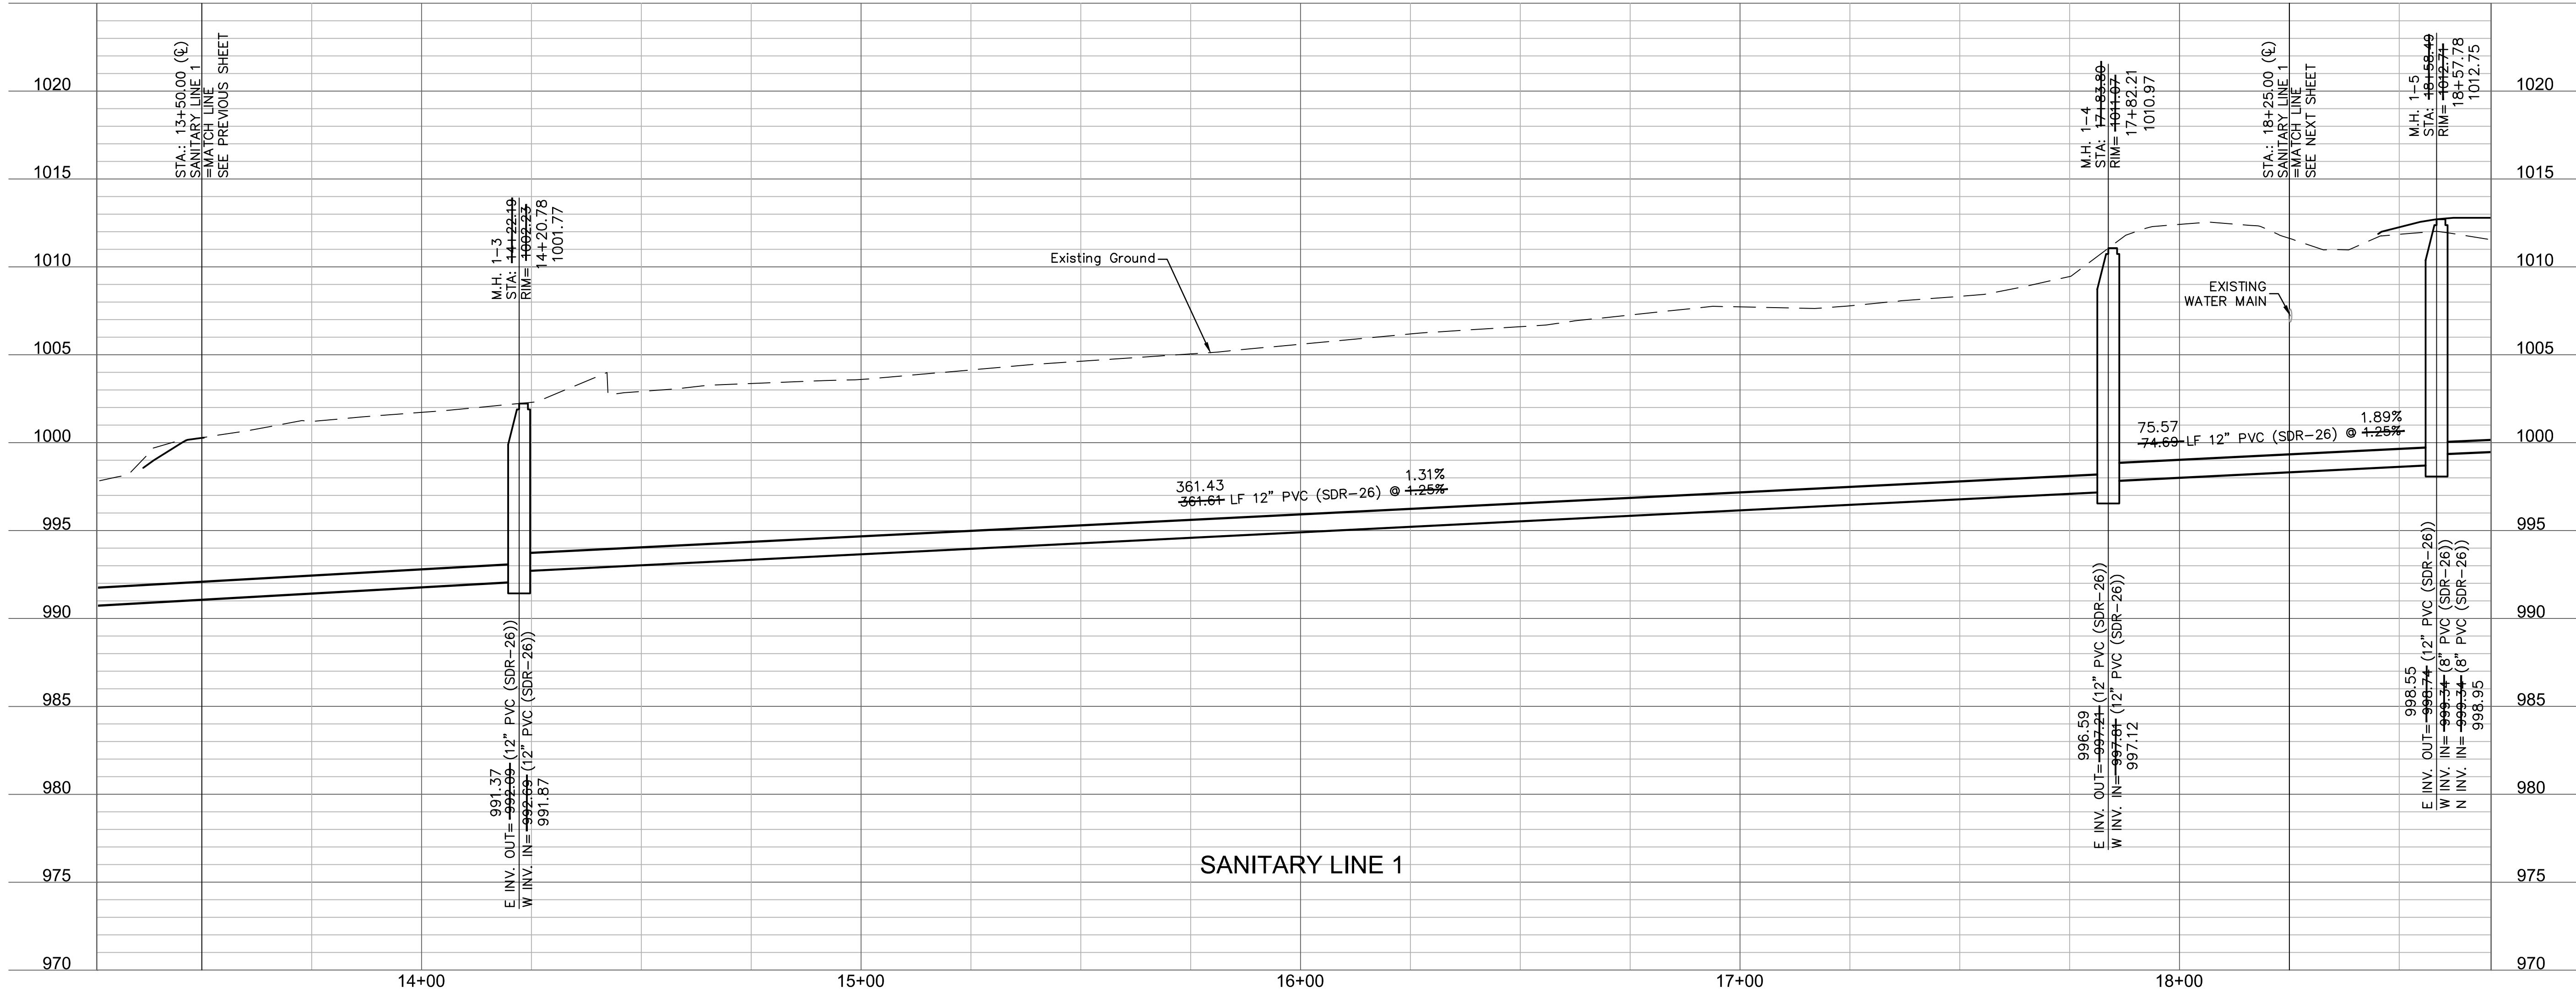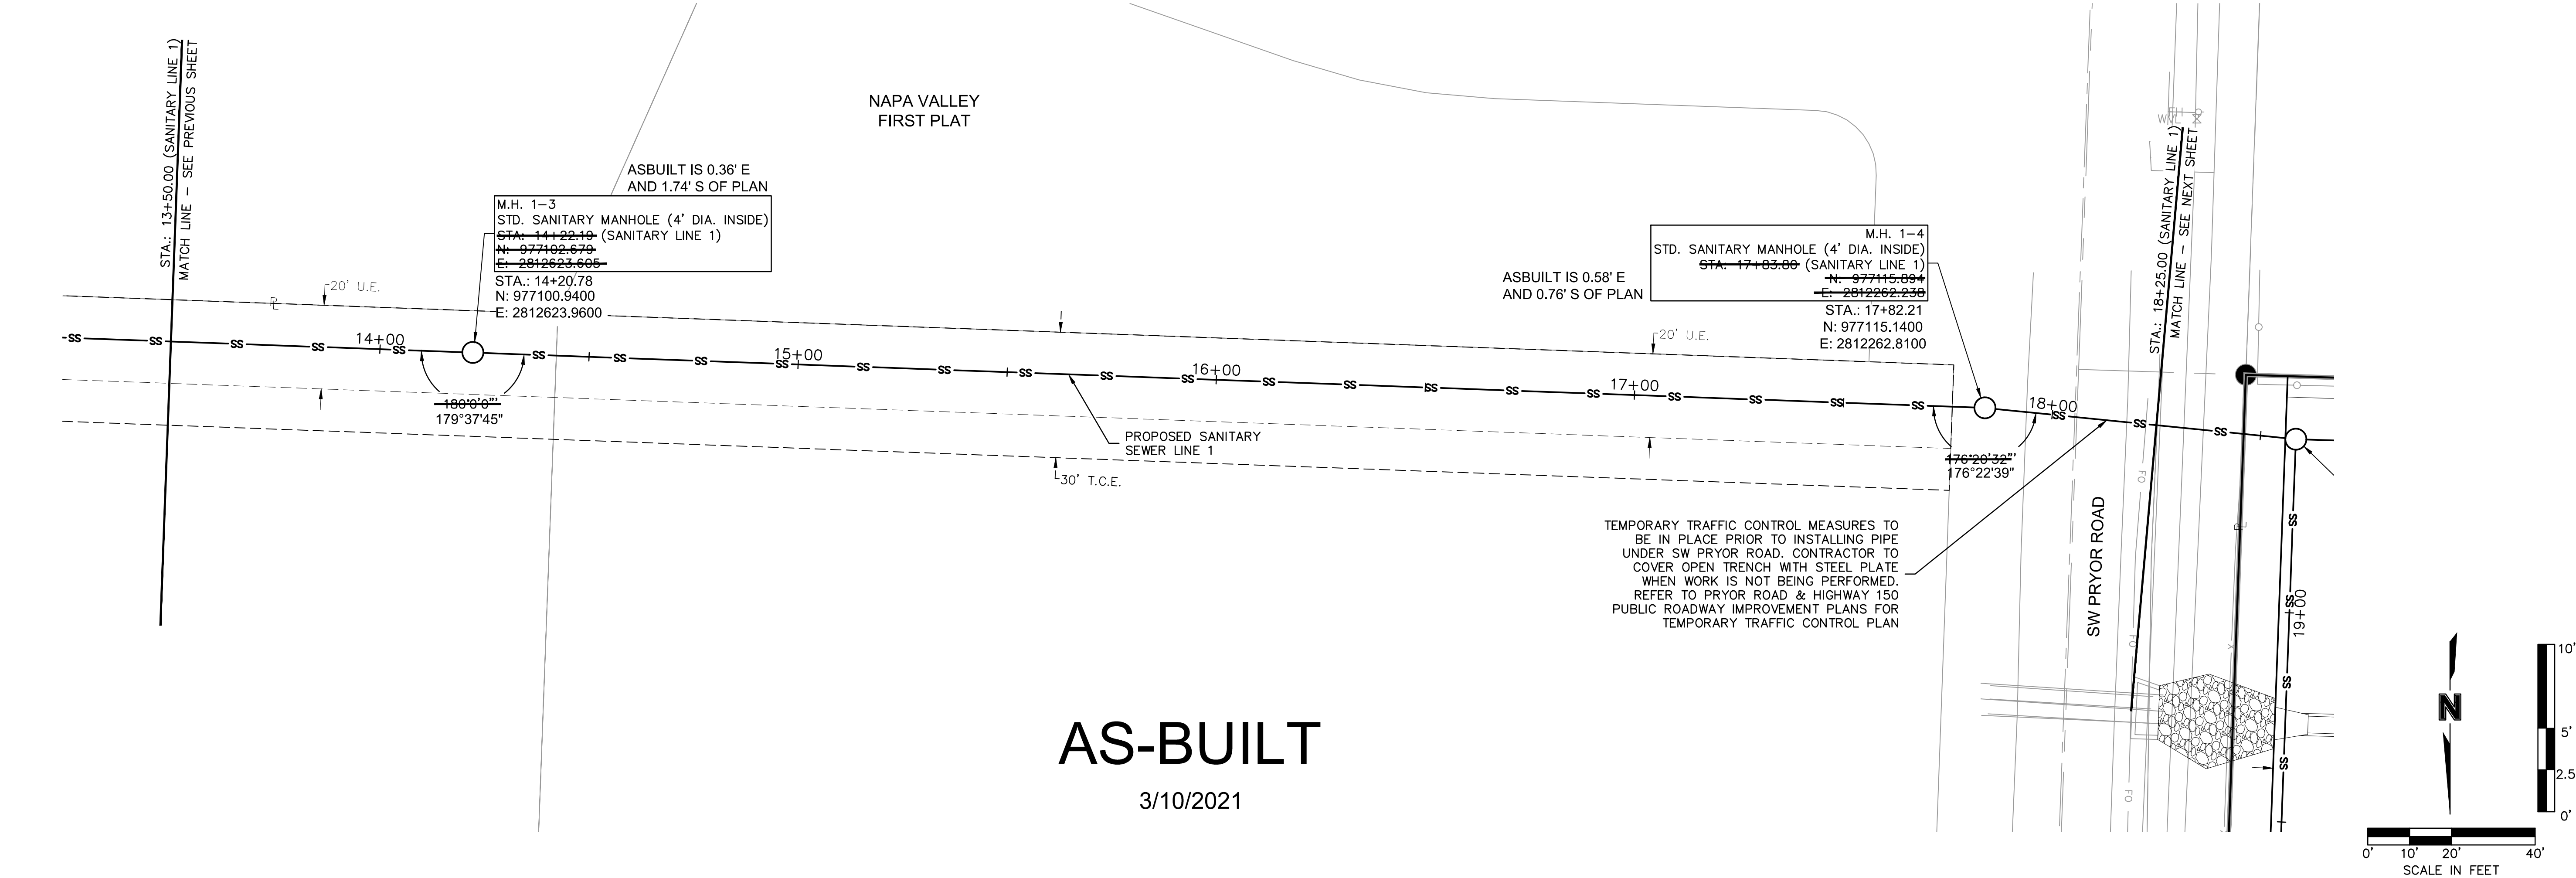

olsson

Olsson - Civil Engineering
Missouri Certificate of Authority # 001592
1301 Burlington Street
North Kansas City, MO 64116
TEL 816.361.1177
www.olsson.com

STATE OF MISSOURI
BROCK M. WORTHLEY
LICENSED PROFESSIONAL ENGINEER
PE-2019000237
3/10/2021

REV. NO.	DATE	REVISIONS DESCRIPTION	BY
1	4/24/2020	TEMPORARY TRAFFIC CONTROL NOTE ADDED	

SANITARY PLAN & PROFILE (LINE 1 CONT'D)
SANITARY SEWER PLANS



OSAGE
FIRST PLAT

2020

drawn by: AA
checked by: SS
designed by: AA
QA/QC by: JES
project no.: A19-2339
drawing no.: C_SSWR01_A192339
date: 3/17/2020

SHEET
C205

DWG: F:\2019\2001-2500\019-2339-A\40-Design\AutoCAD\Final Plans - Asbuilts\Sheets\CONV\SANITARY\C_SSWR01_A192339.dwg
DATE: Mar 10, 2021 3:44pm XREFS: C_XBASE_A192339 C_FBASE_A192339 C_PBASE_A192339 C_PBDY_A192339 C_PTBLK_A192339 C_PUTIL_A192339 USER: bworthley

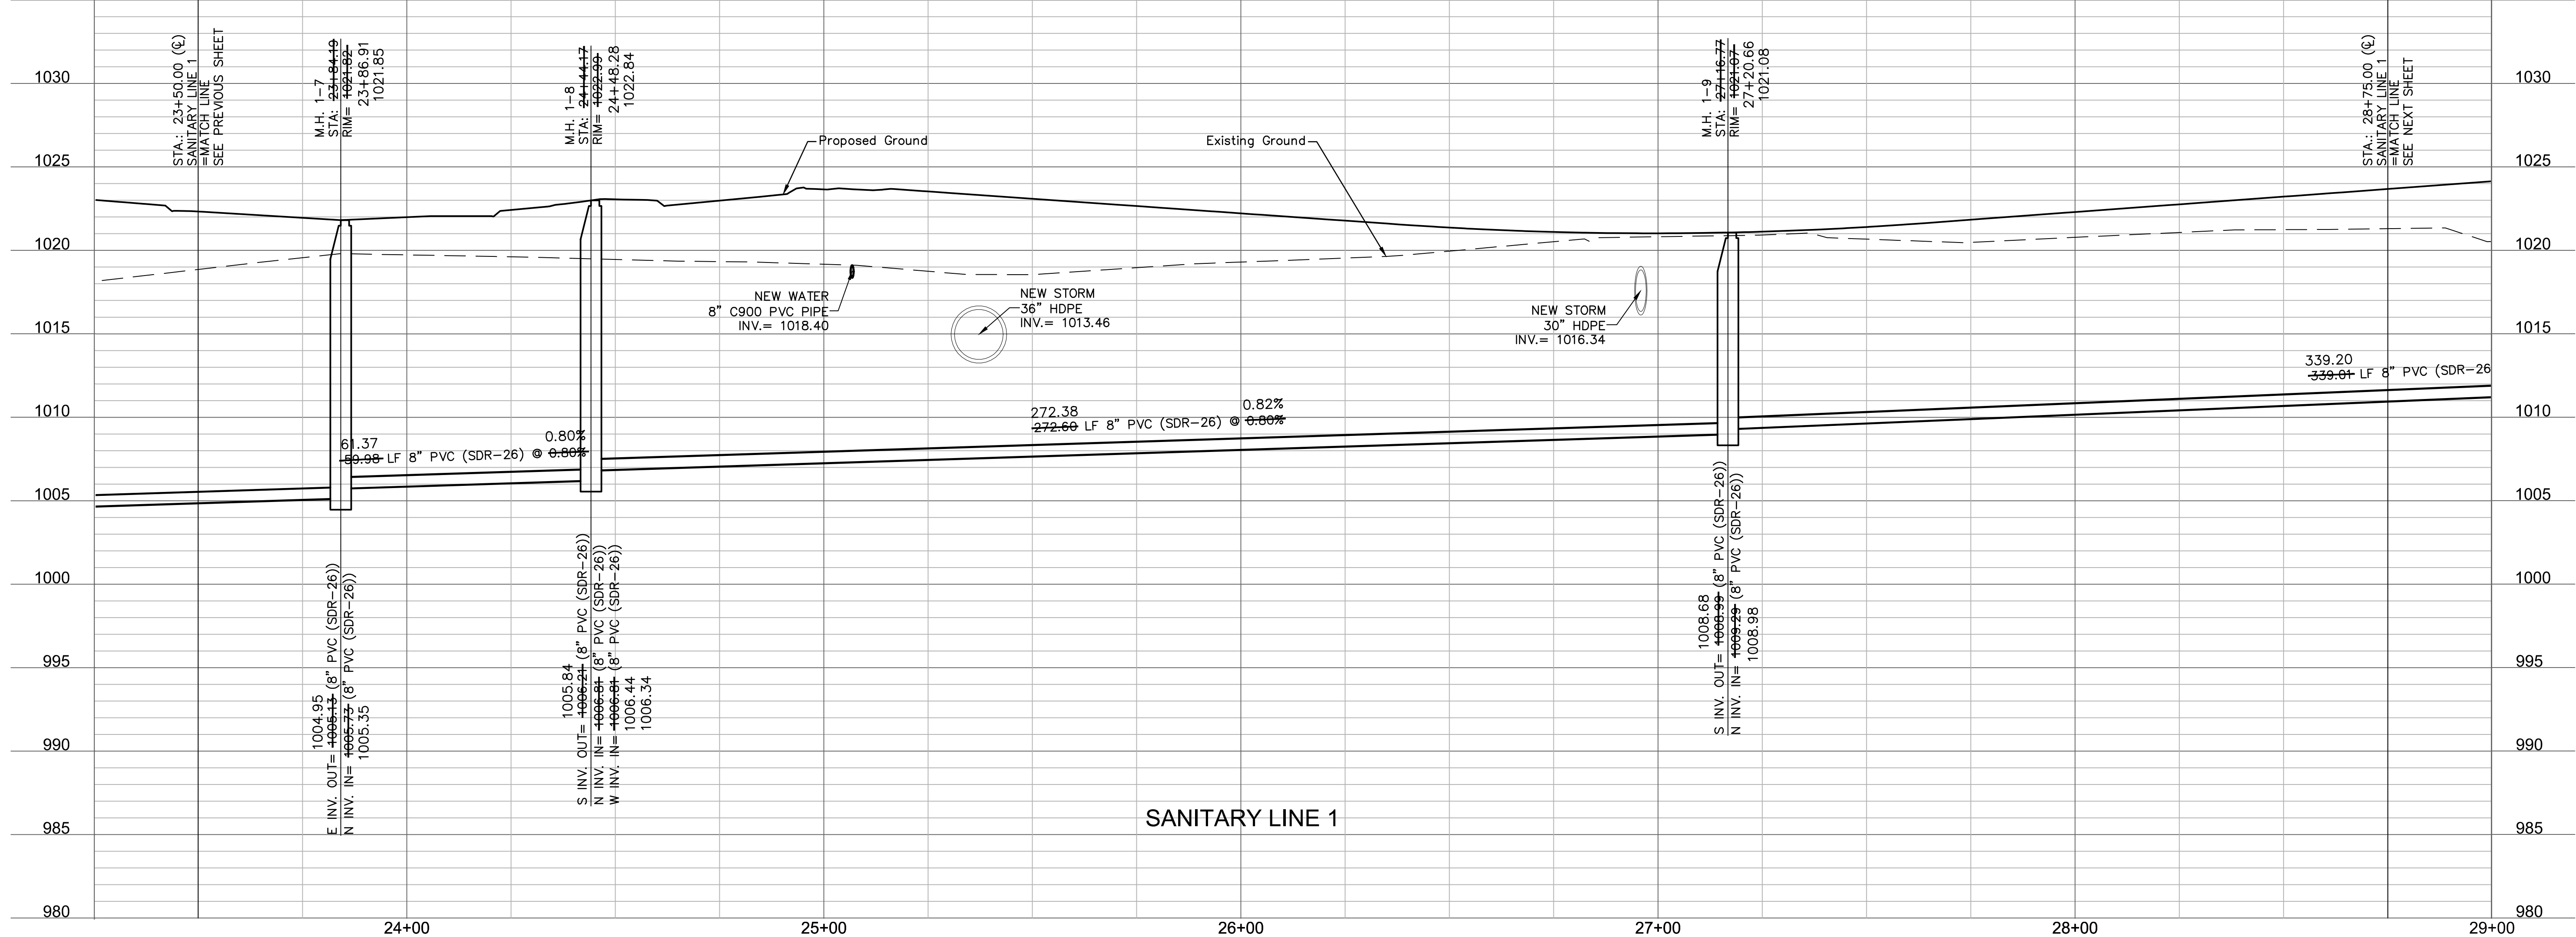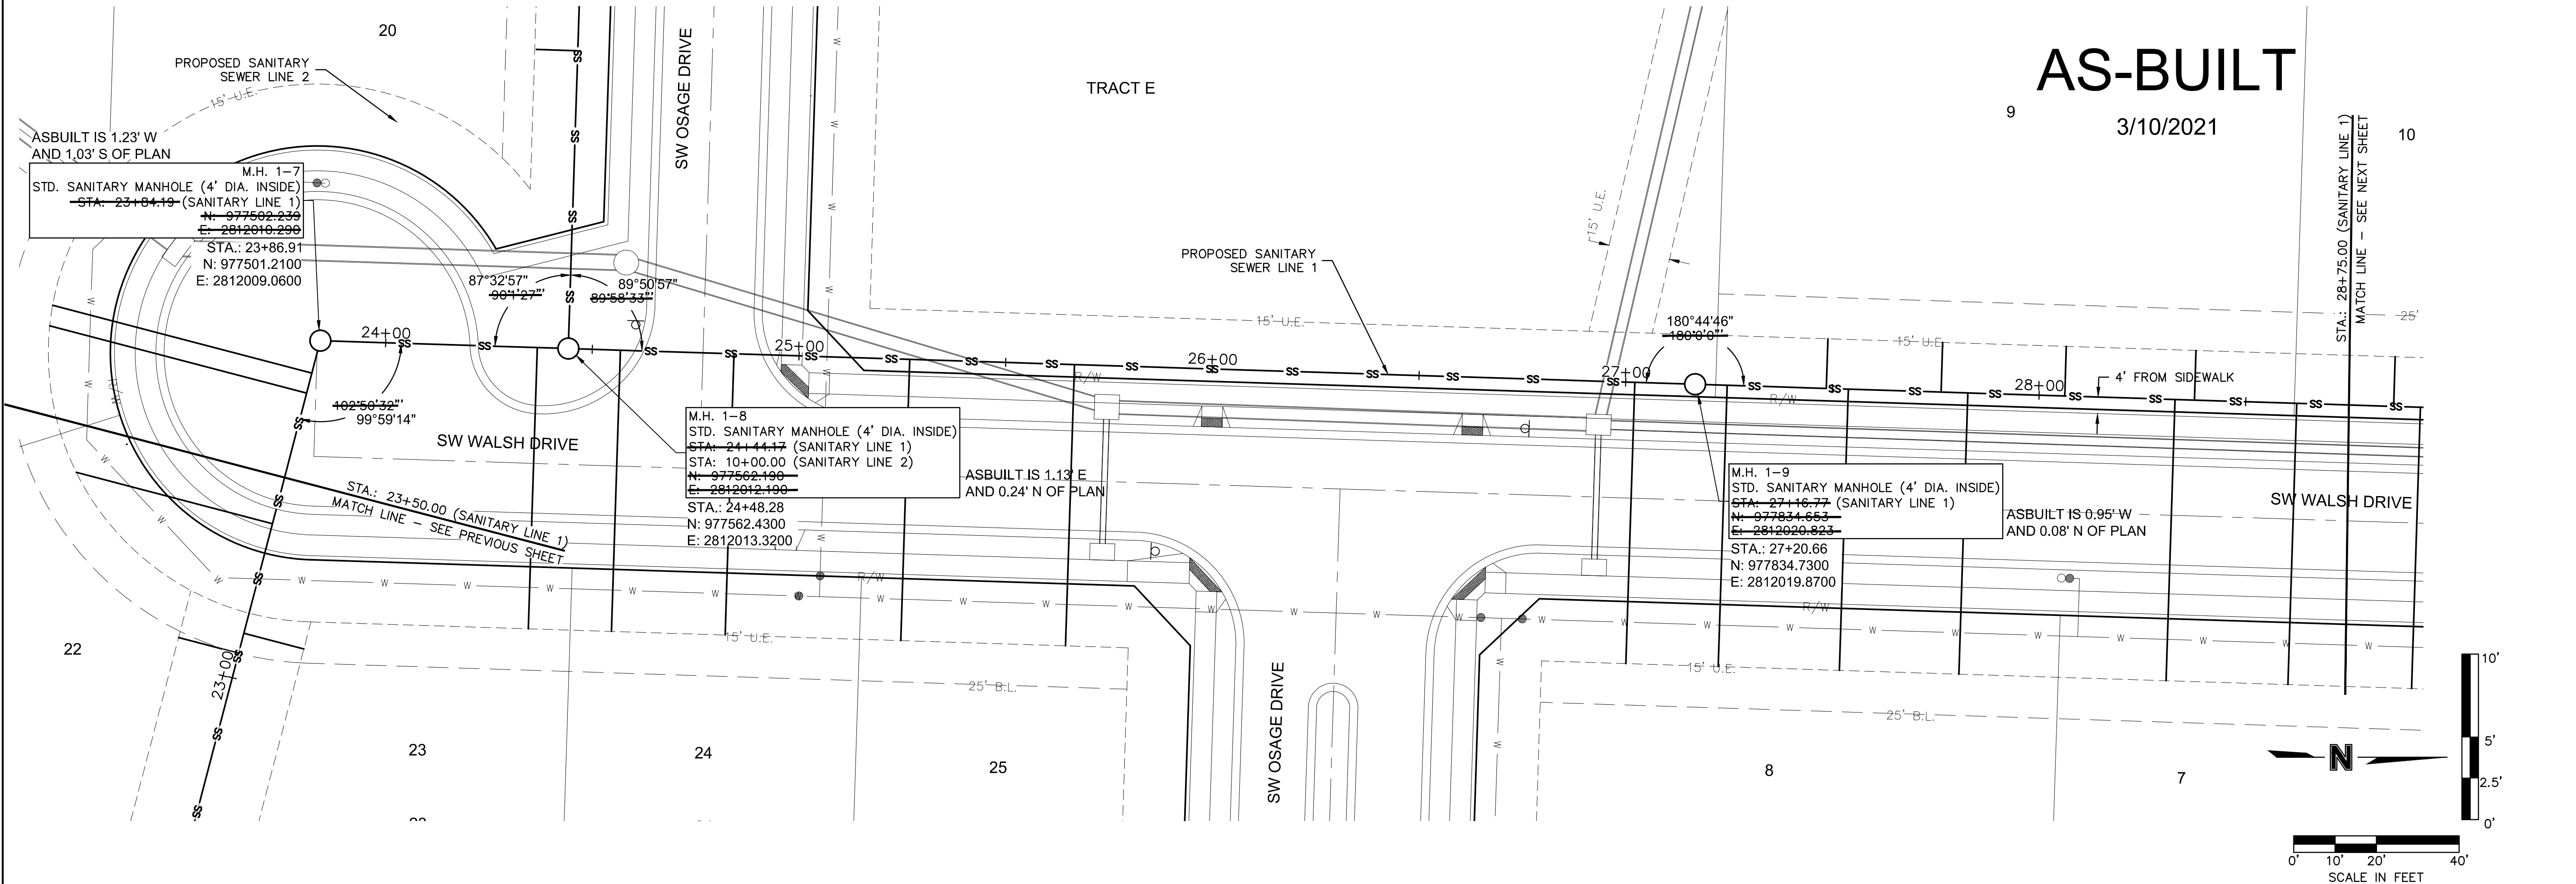

olsson

Olsson - Civil Engineering
Missouri Certificate of Authority # 001592
1301 Burlington Street
North Kansas City, MO 64116
TEL 816.361.1177
www.olsson.com

STATE OF MISSOURI
BROCK M. WORTHLEY
Professional Engineer
No. PE-3019900237
3/10/2021




BY
REV. NO.
DATE
REVISIONS DESCRIPTION

SANITARY PLAN & PROFILE (LINE 1 CONT'D)
SANITARY SEWER PLANS
OSAGE
FIRST PLAT
LEE'S SUMMIT, MISSOURI
2020

drawn by: AA
checked by: SS
designed by: AA
QA/QC by: JES
project no.: A19-2339
drawing no.: C_SSWR01_A192339
date: 3/17/2020

SHEET
C207

DWG: F:\2019\2001-2500\019-2339-A\40-Design\AutoCAD\Final Plans - Asbuilts\Sheets\CONV\SANITARY\C_SSWR02_A192339.dwg
DATE: Mar 10, 2021 3:46pm XREFS: C_XBASE_A192339 C_PBASE_A192339 C_PENDY_A192339 C_PTBLK_A192339 C_PUTIL_A192339 USER: bworthley

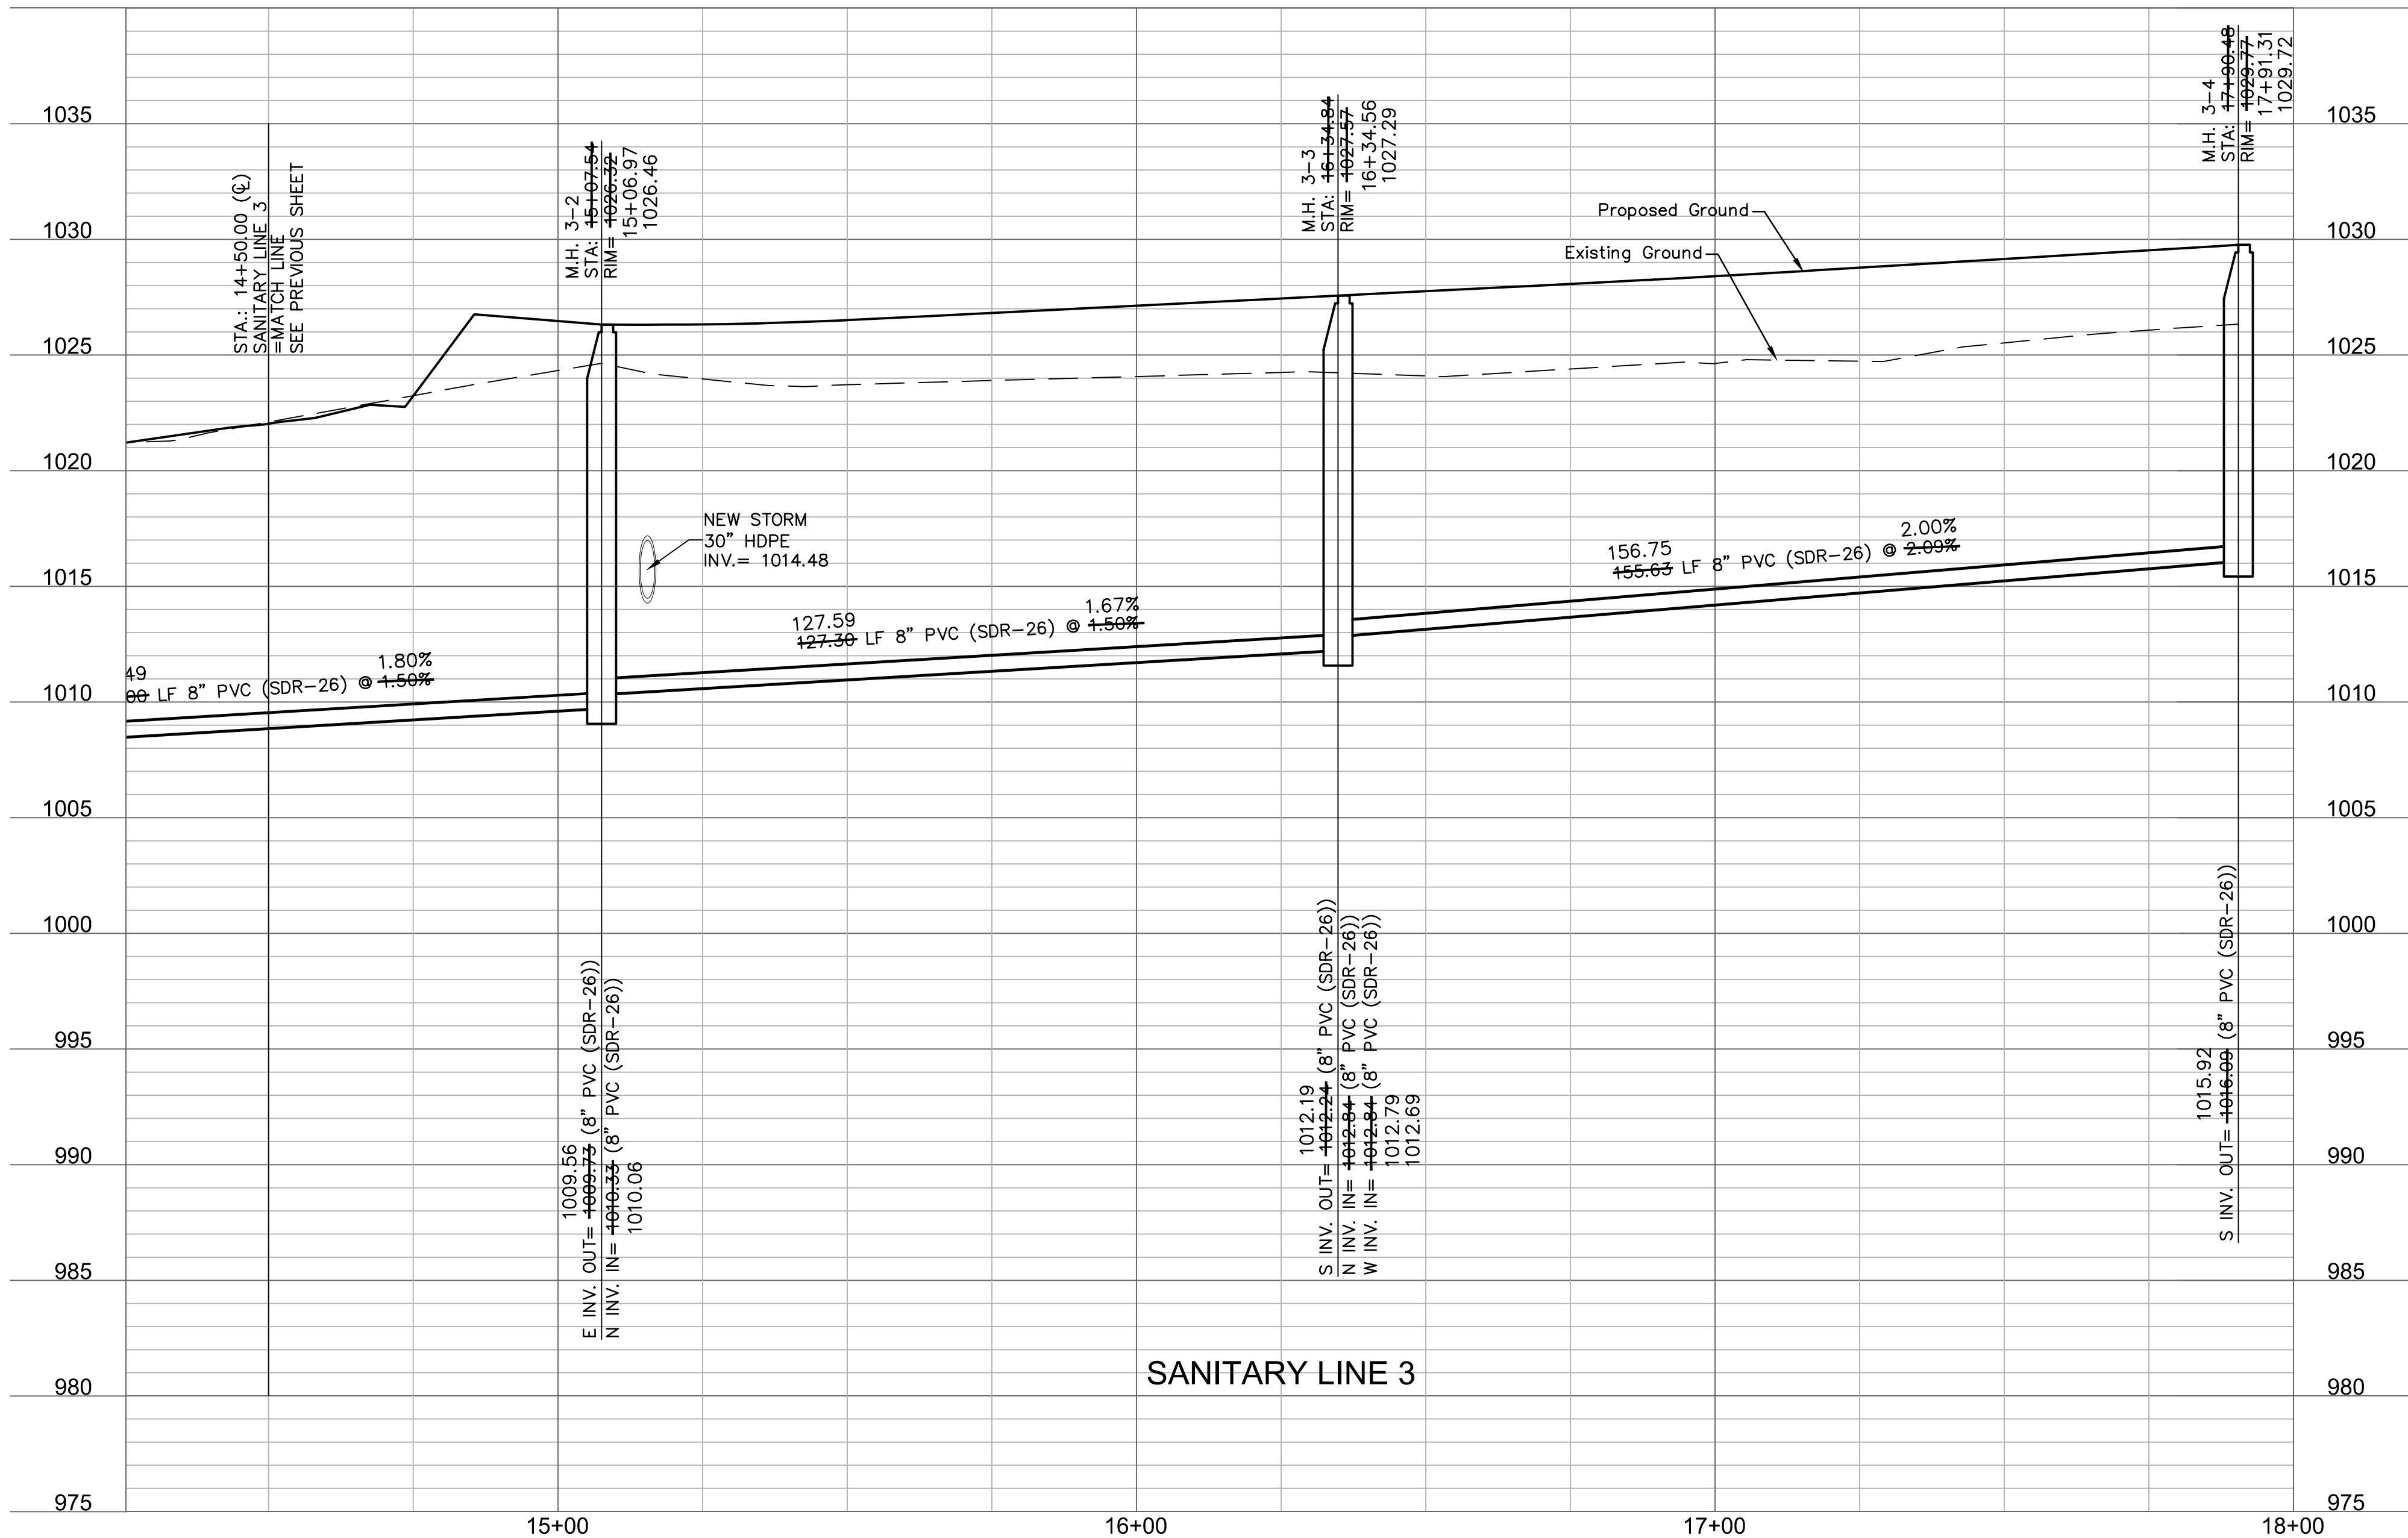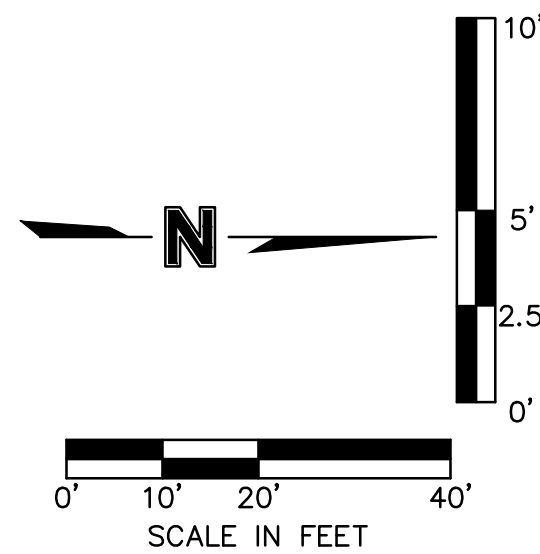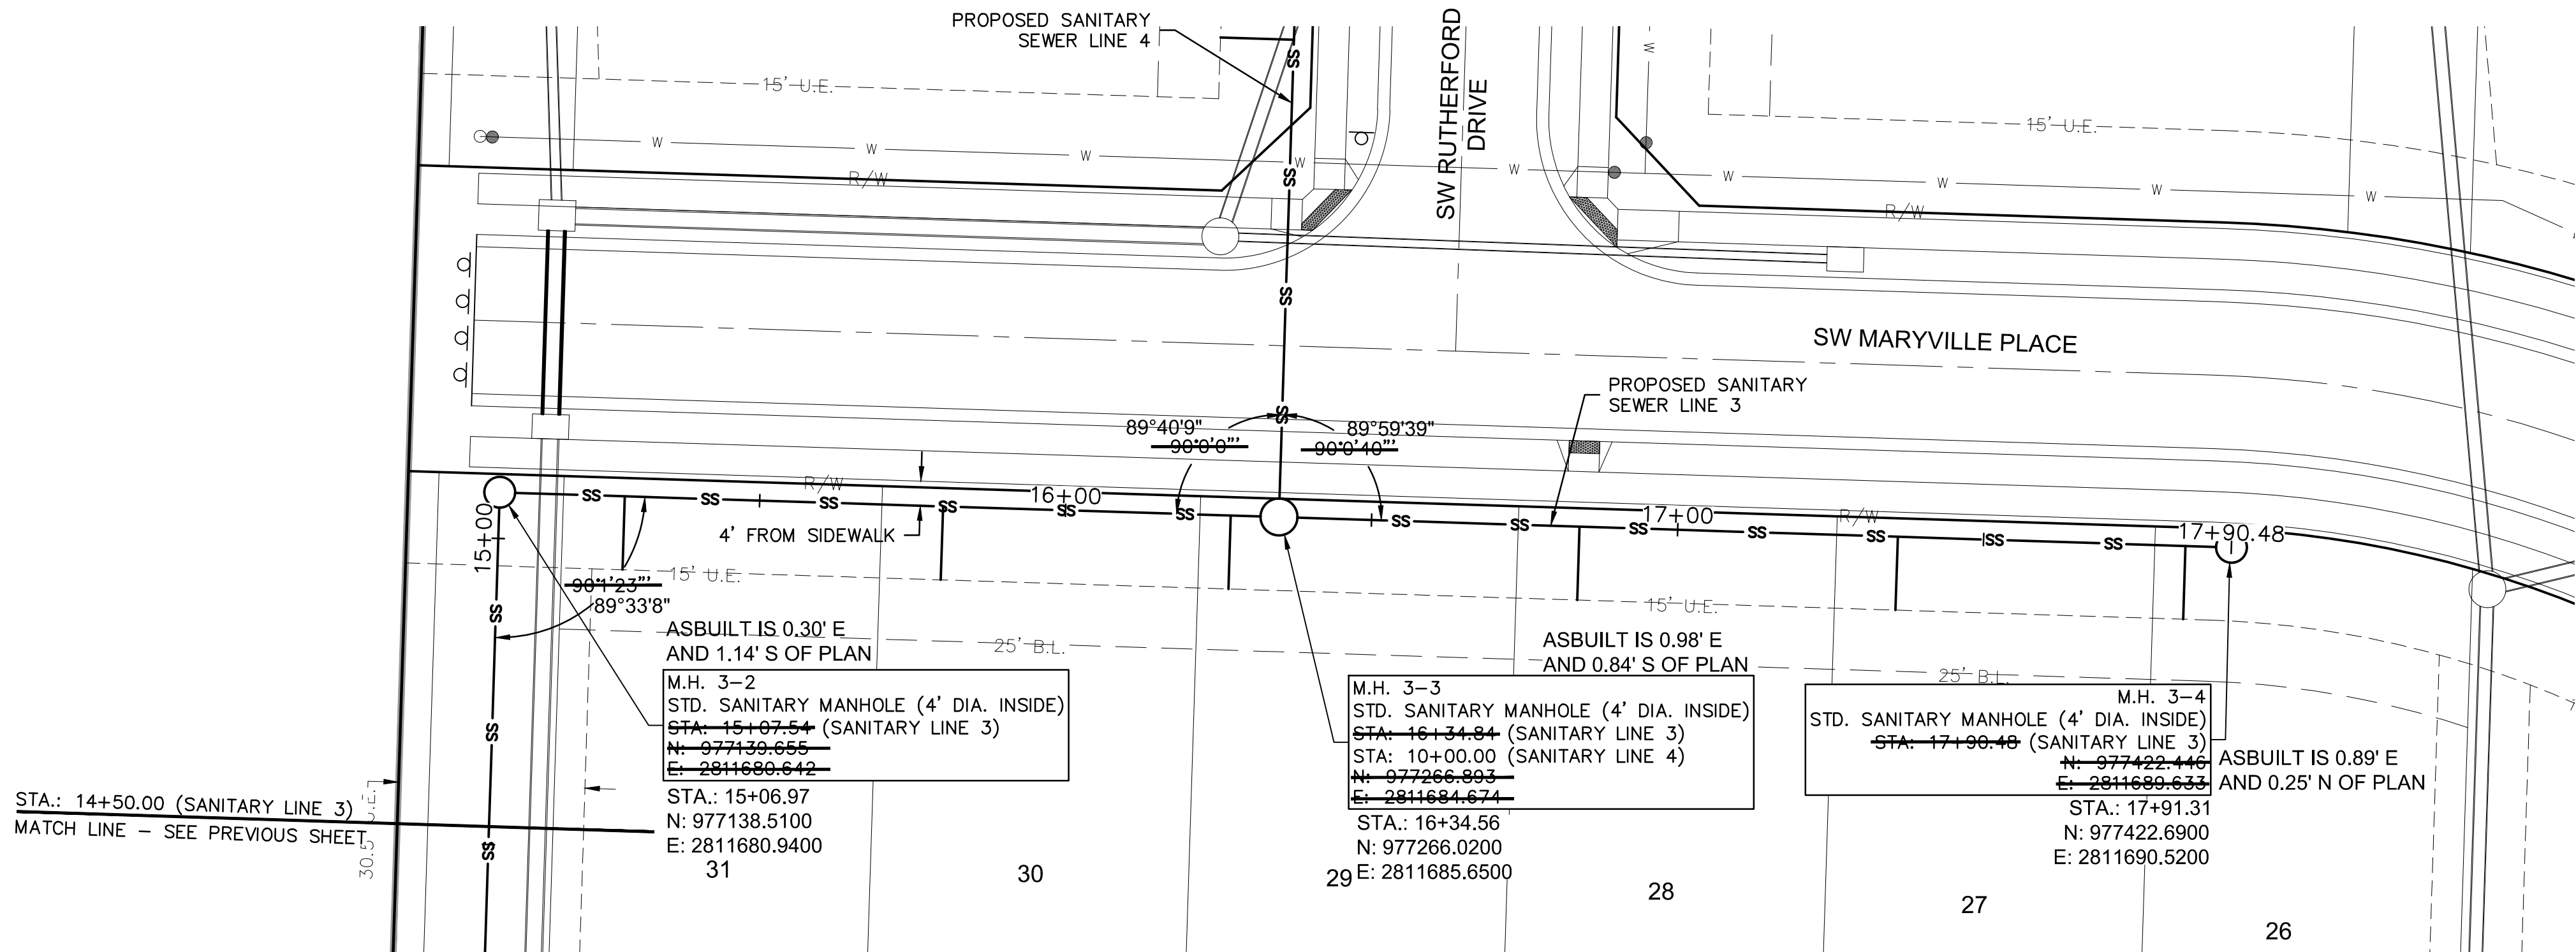

AS-BUILT

3/10/2021

SANITARY PLAN & PROFILE (LINE 3 CONT'D)
SANITARY SEWER PLANS

OSAGE
FIRST PLAT

LEE'S SUMMIT, MISSOURI

2020

REVISIONS

REV. NO.	DATE	REVISIONS DESCRIPTION	BY



olsson

Olsson - Civil Engineering
Missouri Certificate of Authority # 001592
1301 Burlington Street
North Kansas City, MO 64116
TEL 816.361.1177
www.olson.com

drawn by: AA
checked by: SS
designed by: AA
QA/QC by: JES
project no.: A19-2339
drawing no.: C_SSWR02_A192339
date: 3/17/2020

SHEET
C212

Sanitary Sewer Laterals						
Lot Number	Lateral Station	Lateral Length	Riser	Flowline at Main	Flowline at End of Lateral	Minimum Serviceable Floor Elevation
		(ft)	(ft)	(ft)	(ft)	(ft)
1A	37+71.53	11.00	0.0	1023.5	1024.7	1027.49
1B	37+43.03	11.00	0.0	1023.0	1024.3	1027.06
1C	37+14.53	11.00	0.0	1022.6	1023.8	1026.63
1D	36+91.36	11.00	0.0	1022.3	1023.5	1026.29
2A	35+77.53	11.00	0.0	1020.6	1021.8	1024.58
2B	35+49.03	11.00	0.0	1020.1	1021.4	1024.15
2C	35+20.53	11.00	0.0	1019.7	1020.9	1023.72
2D	34+92.03	11.00	0.0	1019.3	1020.5	1023.30
3A	34+39.53	11.00	1.0	1018.3	1020.5	1023.26
3B	34+11.03	11.00	1.0	1017.9	1020.1	1022.90
3C	33+82.53	11.00	1.0	1017.5	1019.7	1022.54
3D	33+54.03	11.00	1.0	1017.2	1019.4	1022.19
4A	32+99.53	11.00	1.0	1016.5	1018.7	1021.51
4B	32+71.03	11.00	1.0	1016.2	1018.4	1021.15
4C	32+42.53	11.00	1.0	1015.8	1018.0	1020.79
4D	32+10.46	11.00	1.0	1015.4	1017.6	1020.39
5A	31+59.53	11.00	0.0	1014.8	1016.0	1018.78
5B	31+31.03	11.00	0.0	1014.4	1015.6	1018.42
5C	31+02.53	11.00	1.0	1014.0	1016.2	1019.04
5D	30+74.03	11.00	1.0	1013.7	1015.9	1018.69
6A	30+48.33	39.74	0.0	1012.8	1014.6	1017.38
6B	30+30.62	55.38	0.0	1012.6	1014.7	1017.50
6C	30+02.33	66.65	0.0	1012.3	1014.6	1017.43
6D	29+68.45	68.00	0.0	1011.9	1014.3	1017.10
7A	29+20.77	68.00	0.0	1011.4	1013.8	1016.60
7B	28+92.27	68.00	0.0	1011.1	1013.5	1016.30
7C	28+62.35	68.00	0.0	1010.8	1013.2	1015.99
7D	28+32.90	68.00	0.0	1010.5	1012.9	1015.68
8A	27+82.77	68.00	0.0	1010.0	1012.4	1015.15
8B	27+53.84	68.00	0.0	1009.7	1012.1	1014.85
8C	27+24.53	68.00	0.0	1009.4	1011.7	1014.54
8D	27+02.19	68.00	0.0	1008.9	1011.2	1014.04
9A	28+37.58	12.00	0.0	1010.6	1011.8	1014.61
9B	28+06.22	12.00	0.0	1010.2	1011.5	1014.28
9C	27+76.30	12.00	0.0	1009.9	1011.2	1013.97
9D	27+48.53	12.00	0.0	1009.6	1010.9	1013.67
10A	29+73.45	12.00	0.0	1012.0	1013.2	1016.04
10B	29+44.21	12.00	0.0	1011.7	1012.9	1015.73
10C	29+14.29	12.00	0.0	1011.4	1012.6	1015.41
10D	28+85.79	12.00	0.0	1011.1	1012.3	1015.12
11A	15+30.75	12.00	0.0	1018.6	1019.9	1022.66
11B	15+02.25	12.00	0.0	1018.3	1019.6	1022.39
11C	14+73.75	12.00	0.0	1018.1	1019.3	1022.12
11D	14+45.25	12.00	0.0	1017.8	1019.0	1021.85
12A	13+92.75	12.00	0.0	1017.3	1018.5	1021.35
12B	13+64.25	12.00	0.0	1017.0	1018.3	1021.08
12C	13+35.75	12.00	0.0	1016.8	1018.0	1020.81
12D	13+07.25	12.00	0.0	1016.5	1017.7	1020.54
13A	15+25.75	68.00	0.0	1018.6	1020.9	1023.73
13B	14+97.25	68.00	0.0	1018.3	1020.7	1023.46
13C	14+68.75	68.00	0.0	1018.0	1020.4	1023.19
13D	14+40.25	68.00	0.0	1017.8	1020.1	1022.92
14A	13+87.75	68.00	0.0	1017.3	1019.6	1022.42
14B	13+59.25	68.00	0.0	1017.0	1019.4	1022.15
14C	13+30.75	68.00	0.0	1016.7	1019.1	1021.88
14D	13+02.25	68.00	0.0	1016.4	1018.8	1021.61
15A	12+46.86	68.00	0.0	1015.7	1018.0	1020.81
15B	12+21.55	68.00	0.0	1015.5	1017.8	1020.61
15C	11+93.05	68.00	0.0	1015.2	1017.6	1020.38
15D	11+64.55	68.00	0.0	1015.0	1017.4	1020.16
16A	11+27.50	68.00	3.0	1014.7	1020.0	1022.80
16B	10+82.50	68.00	3.0	1014.3	1019.6	1022.44
17A	14+42.62	10.00	2.0	1020.1	1023.3	1026.10
17B	13+92.52	10.00	3.0	1018.4	1022.5	1025.33
18A	12+44.97	10.00	6.0	1012.8	1019.8	1022.64
18B	12+05.37	10.00	7.0	1011.8	1019.9	1022.68
19A	11+85.37	10.00	5.0	1011.3	1017.4	1020.21
19B	11+35.37	10.00	6.0	1010.1	1017.2	1019.98
20A	11+15.37	10.00	4.0	1009.6	1014.7	1017.53
20B	10+72.00	10.00	5.0	1008.6	1014.7	1017.46
21A	23+76.10	64.81	3.0	1005.1	1010.3	1013.11
21B	23+71.10	64.22	3.0	1005.0	1010.3	1013.06
22A	23+38.47	49.06	4.0	1004.8	1010.7	1013.48
22B	23+06.12	15.00	5.0	1004.5	1010.7	1013.52
23A	24+36.67	68.00	3.0	1006.2	1011.5	1014.26
23B	23+11.12	15.00	6.0	1004.6	1011.7	1014.54
24A	24+84.28	68.00	3.0	1007.1	1012.4	1015.24
24B	24+56.78	68.00	3.0	1006.9	1012.2	1015.02
25A	25+66.64	68.00	1.0	1007.8	1011.1	1013.94
25B	25+26.78	68.00	2.0	1007.5	1011.8	1014.60
26	17+82.98	11.97	1.0	1015.9	1018.2	1020.97
27	17+35.98	11.98	1.0	1015.0	1017.2	1019.98
28	16+83.98	11.99	2.0	1013.9	1017.1	1019.88
29	16+26.98	12.00	3.0	1012.1	1016.3	1019.11
30	15+79.98	12.00	3.0	1011.4	1015.6	1018.41
31	15+27.98	12.00	3.0	1010.6	1014.8	1017.63
32	10+78.00	12.00	0.0	1013.6	1014.9	1017.66
33	11+29.62	12.00	0.0	1014.1	1015.4	1018.18
34	11+84.62	12.00	1.0	1014.7	1016.9	1019.71
35	12+39.62	12.00	2.0	1016.1	1019.3	1022.10
36	12+94.62	12.00	2.0	1019.1	1022.3	1025.12
37	12+89.62	68.00	1.0	1018.8	1022.2	1024.99
38	12+34.62	68.00	1.0	1015.8	1019.2	1021.98
39	11+79.62	68.00	0.0	1014.6	1017.0	1019.80
40	11+24.62	68.00	0.0	1014.1	1016.4	1019.25
41	11+07.12	68.00	0.0	1013.9	1016.3	1019.07
50A	15+12.62	10.00	0.0	1022.6	1023.8	1026.59
50B	14+62.62	10.00	2.0	1020.8	1024.0	1026.80
71	13+49.62	12.00	2.0	1022.1	1025.3	1028.15
72	13+44.62	68.00	1.0	1021.9	1025.2	1028.01
Tract E	11+59.55	12.00	3.0	1015.0	1019.1	1021.94

Note: Lots are labeled assuming A is the farthest North of West Unit and B-D is farthest South or East Unit

Sanitary Sewer Design Information											
Upstream Manhole	Downstream Pipe Slope	Downstream Pipe Diameter	Proposed Cumulative Area	Future Cumulative Area	Peak Base Flow	Peak Infiltration Flow	Peak Inflow	Total Peak Flow	Downstream Pipe Mannings N	Downstream Pipe Capacity	Downstream Pipe Full Flow Velocity
	(%)	(in)	(Ac.)	(Ac.)	(gpd)	(gpd)	(cfs)	(cfs)		(cfs)	(fps)
EX MH 1-1	0.80%	12	15.66	48.95	96915.00	32305.000	1.416	1.616	0.013	3.19	4.06
MH 1-2	0.50%	12	14.32	48.95	94905.00	31635.000	1.393	1.589	0.013	2.52	3.21
MH 1-3	1.50%	12	14.32	38.66	79470.00	26490.000	1.208	1.372	0.013	4.36	5.56
MH 1-4	1.25%	12	14.32	29.19	65265.00	21755.000	1.029	1.164	0.013	3.98	5.07
MH 1-5	1.25%	12	14.32	29.19	65265.00	21755.000	1.029	1.164	0.013	3.98	5.07
MH 1-6	1.10%	8	11.21	18.68	44835.00	14945.000	0.752	0.844	0.013	1.27	3.63
MH 1-7	0.80%	8	11.21	18.68	44835.00	14945.000	0.752	0.844	0.013	1.08	3.10
MH 1-8	0.80%	8	10.34	18.68	43530.00	14510.000	0.733	0.823	0.013	1.08	3.10
MH 1-9	0.80%	8	5.76	9.41	22755.00	7585.000	0.417	0.464	0.013	1.08	3.10
MH 1-10	1.05%	8	4.88	9.41	21435.00	7145.000	0.396	0.440	0.013	1.24	3.55
MH 1-11	1.25%	8	2.50	9.41	17865.00	5955.000	0.337	0.374	0.013	1.35	3.87
MH 1-12	1.50%	8	1.10	9.41	15765.00	5255.000	0.301	0.334	0.013	1.48	4.24
MH 2-1	2.43%	8	4.44	9.27	20565.00	6855.000	0.382	0.424	0.013	1.88	5.40
MH 2-2	3.50%	8	0.46	8.17	12945.00	4315.000	0.252	0.279	0.013	2.26	6.48
MH 3-1	2.06%	8	3.11	10.51	20430.00	6810.000	0.379	0.422	0.013	1.73	4.97
MH 3-2	1.50%	8	3.11	10.51	20430.00	6810.000	0.379	0.422	0.013	1.48	4.24
MH 3-3	1.50%	8	3.11	10.51	20430.00	6810.000	0.379	0.422	0.013	1.48	4.24
MH 3-4	2.09%	8	0.53	0.00	795.00	265.000	0.018	0.020	0.013	1.75	5.00
MH 4-1	1.00%	8	2.06	10.51	18855.00	6285.000	0.353	0.392	0.013	1.21	3.46
MH 4-2	5.50%	8	0.73	10.51	16860.00	5620.000	0.320	0.354	0.013	2.83	8.12
MH 7-1	0.80%	8	2.93	1.10	6045.00	2015.000	0.125	0.138	0.013	1.08	3.10
MH 7-2	0.95%	8	2.11	0.00	3165.00	1055.000	0.069	0.075	0.013	1.18	3.37

NOT AS-BUILT

SANITARY SEWER DESIGN TABLES

SANITARY SEWER PLANS

OSAGE

FIRST PLAT

LEE'S SUMMIT, MISSOURI

2020

drawn by: AA

checked by: SS

designed by: AA

QA/QC by: JES

project no.: A19-2339

drawing no.: C_TAB01_A192339

date: 3/17/2020

SHEET

C215

olsson

Olsson - Civil Engineering

Missouri Certificate of Authority # 001592

1301 Burlington Street

North Kansas City, MO 64116

TEL 816.361.1177

www.olsson.com

STATE OF MISSOURI

BROCK M. WORTHLEY

REGISTERED PROFESSIONAL ENGINEER

PE-2019000237

3/10/2020


BY

REVISIONS DESCRIPTION

DATE

REV. NO.

REVISIONS

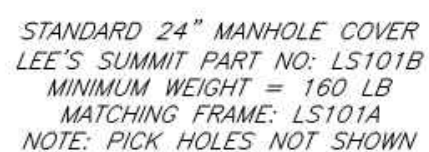


STANDARD 24" MANHOLE COVER

Date: 09/16/04
Drawn By: JN
Checked By: .
FILE: SANITARY SEWER-2
Rev: 04/05/07
Rev: 12/12



STANDARD 24" MANHOLE FRAME

Date: 09/16/04
Drawn By: JN
Checked By:
FILE: SANITARY SEWER-1
Rev: 01/04/07
Rev: 1/13

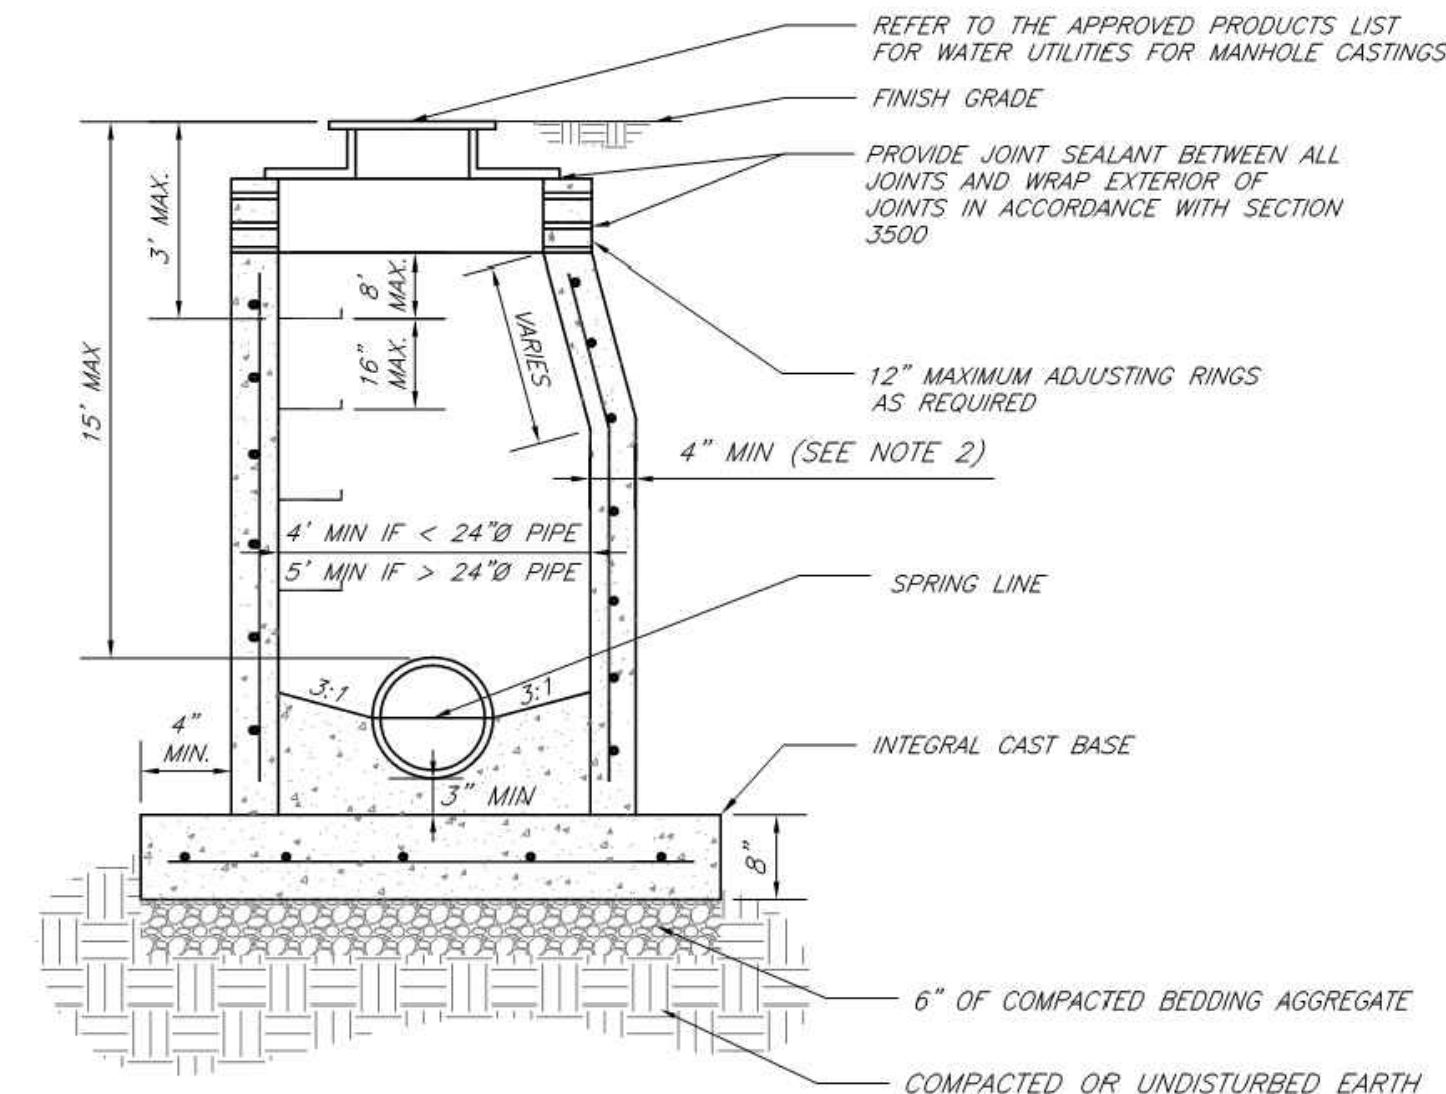

NOTES:


1. PRECAST CONCRETE MANHOLES SHALL CONFORM TO ASTM C478 EXCEPT AS MODIFIED BY THE SPECIFICATIONS.
2. A WALL THICKNESS NOT LESS THAN ONE-TWENTYTH (1/20) OF THE INSIDE DIAMETER OR 4", WHICHEVER IS GREATER, SHALL BE USED WHEN THE MANHOLE DEPTH IS LESS THAN 15 FEET.
3. WATERPROOFING SHALL BE REQUIRED ON THE OUTSIDE OF MANHOLES. THE WATERPROOFING SHALL CONSIST OF A TOTAL DRY FILM THICKNESS OF NOT LESS THAN 14 MILS OF BITUMINOUS COATING.
4. MANHOLE ENTRIES SHALL BE PROVIDED WITH AN ANTI-SIPHON VALVE BY THE CITY ENGINEER.
5. THE FILL CONCRETE FLOW CHANNEL FOR SIDE BRANCHES SHALL BE PLACED TO PROVIDE A SMOOTH TRANSITION INTO THE FLOW LINE.
6. THE APPROVED PRODUCTS LIST FOR WATER UTILITIES FOR APPROVED MANHOLE GASKET MODELS.
7. REFER TO THE APPROVED PRODUCTS LIST FOR APPROVED STEPS.




PUBLIC WORKS ENGINEERING DIVISION | 220 SE GREEN STREET | LEE'S SUMMIT, MO 6406

STANDARD PRECAST MANHOLE – SANITARY SEWER

Date: 02/13/2014
Drawn By: JH
Checked By:
FILE: SAN-2
Rev: 1/14
Rev:

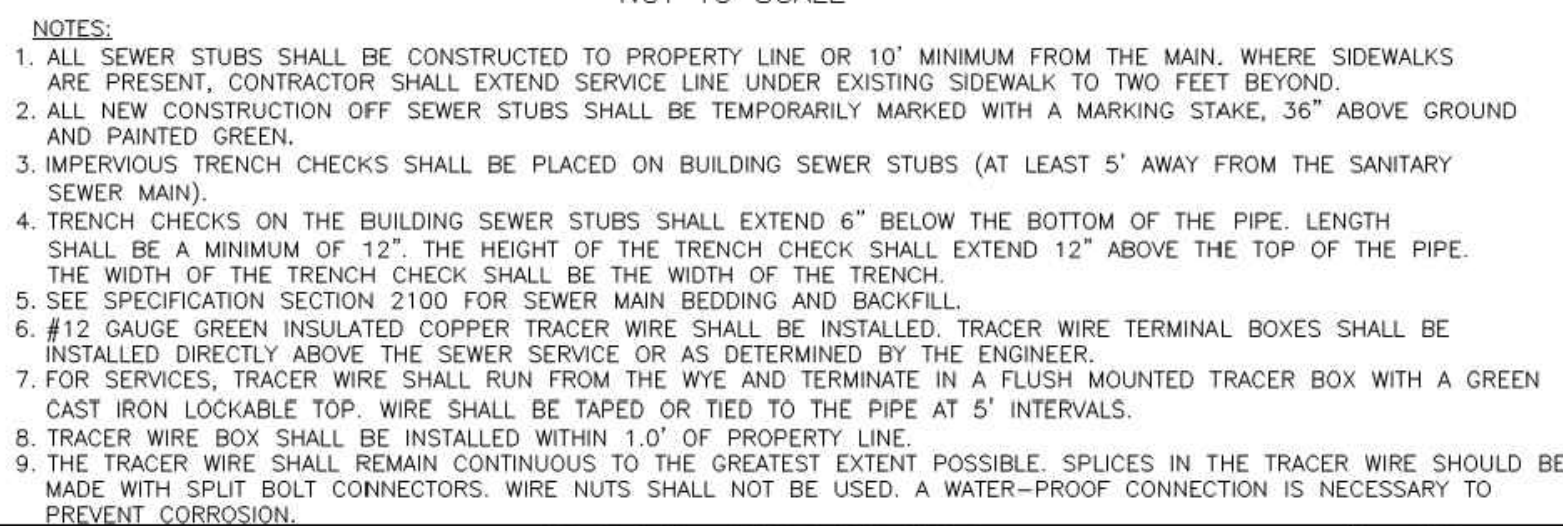


Date: 04/17
Drawn By: MJF
Checked By: DL
SAN-1

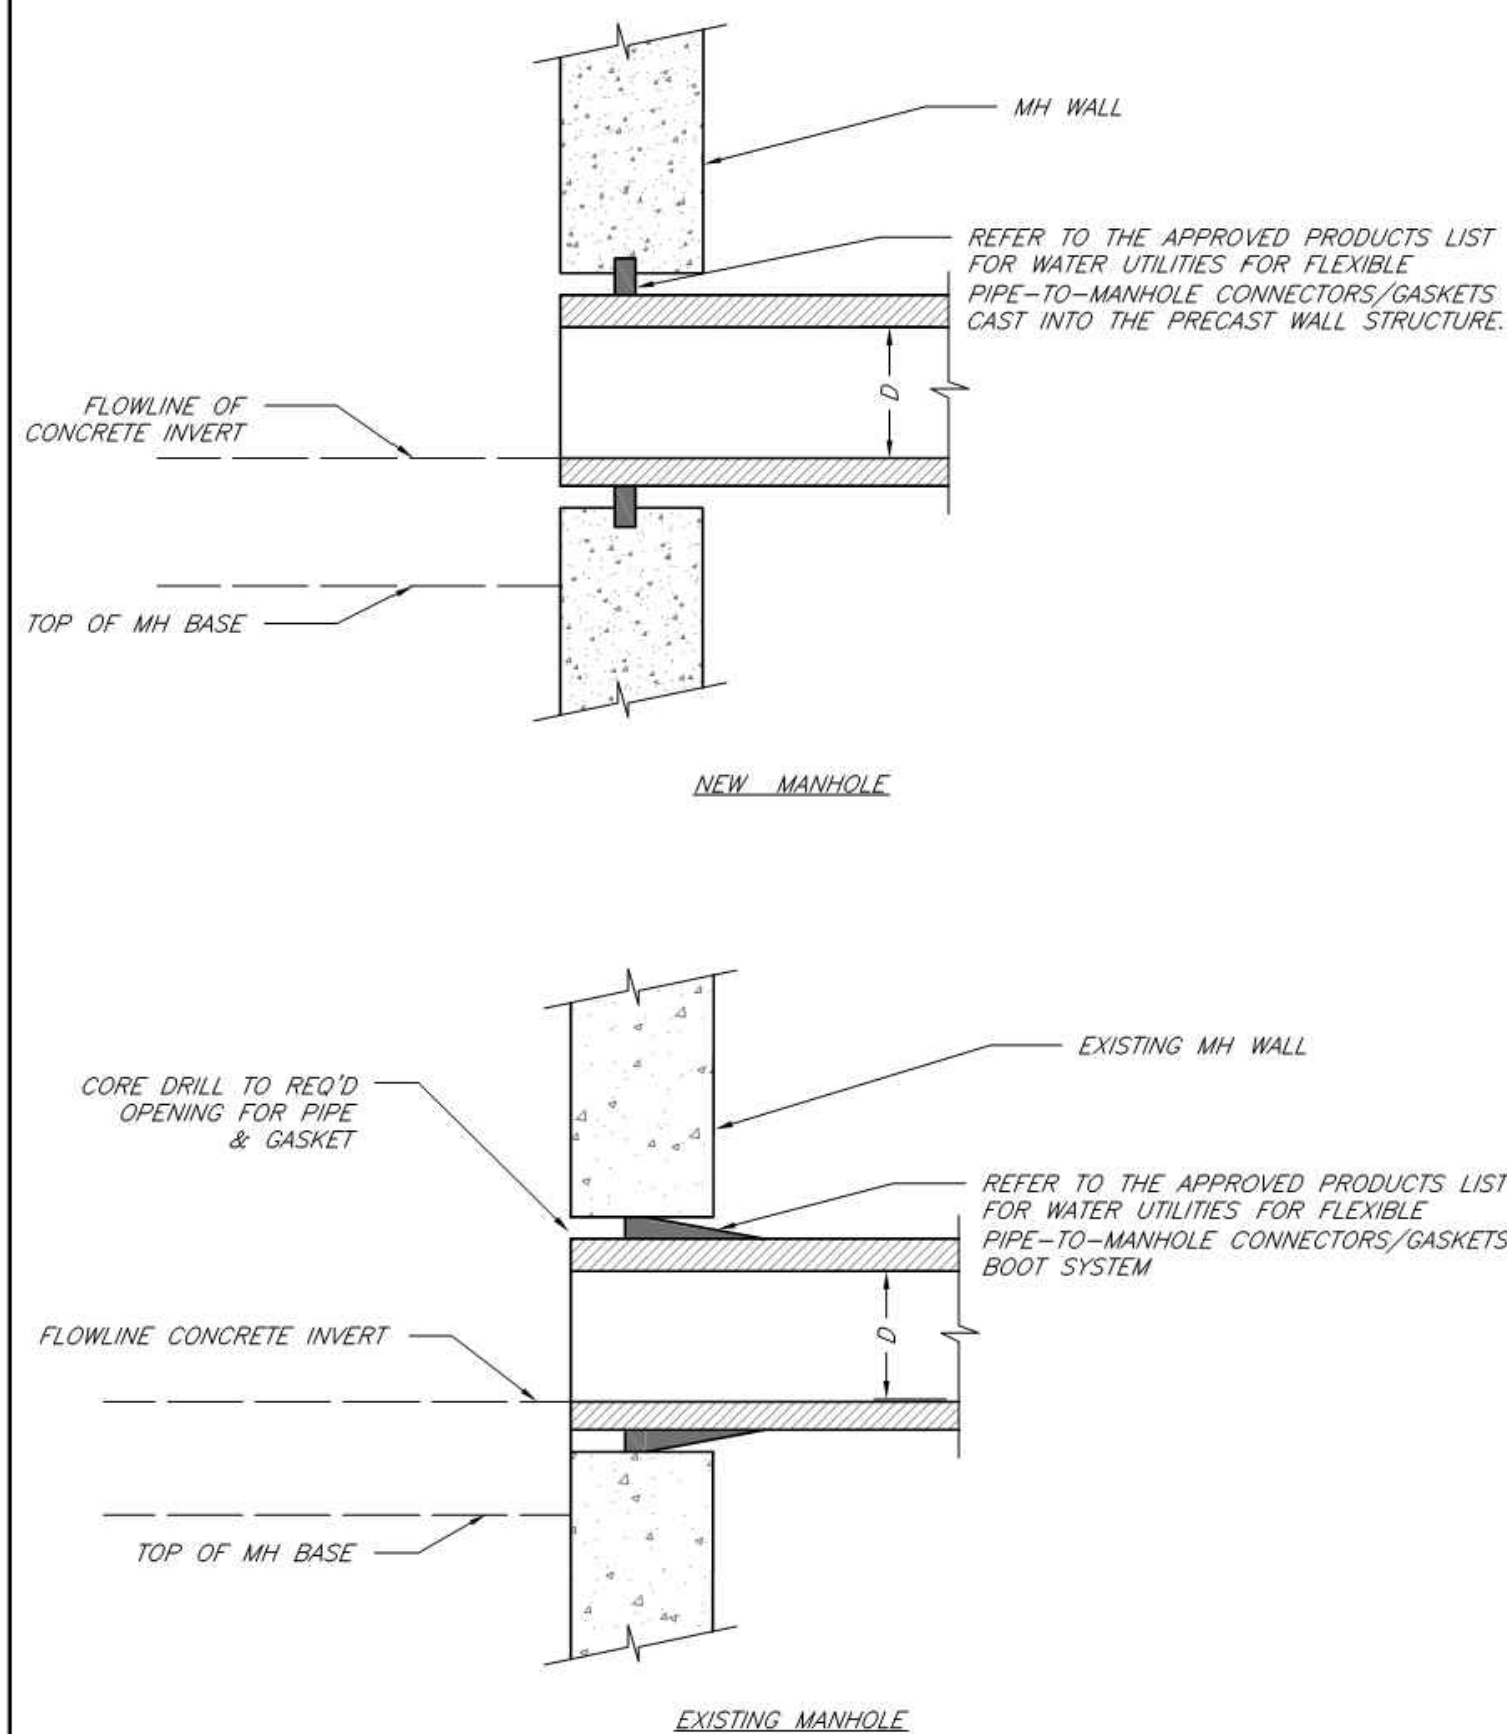

MANHOLE WALL CONNECTIONS

Date: 02/13
Drawn By: JN
Checked By: DL
FILE: SAN-5
Rev: 1/14
Rev:

NOT AS-BUILT

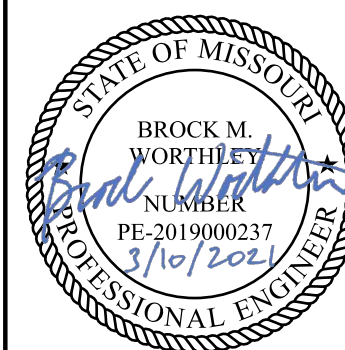[illegible]

DEVISIONS

2020



LEE'S SUMMIT, MISSOURI

DETAIL SHEET
SANITARY SEWER PLANS

OSAGE
FIRST PLAT

drawn by: AA
checked by: SS
designed by: AA
QA/QC by: JES
project no.: A19-2339
drawing no.: C DET01 A192339
date: 3/17/2020

SHEET
C216

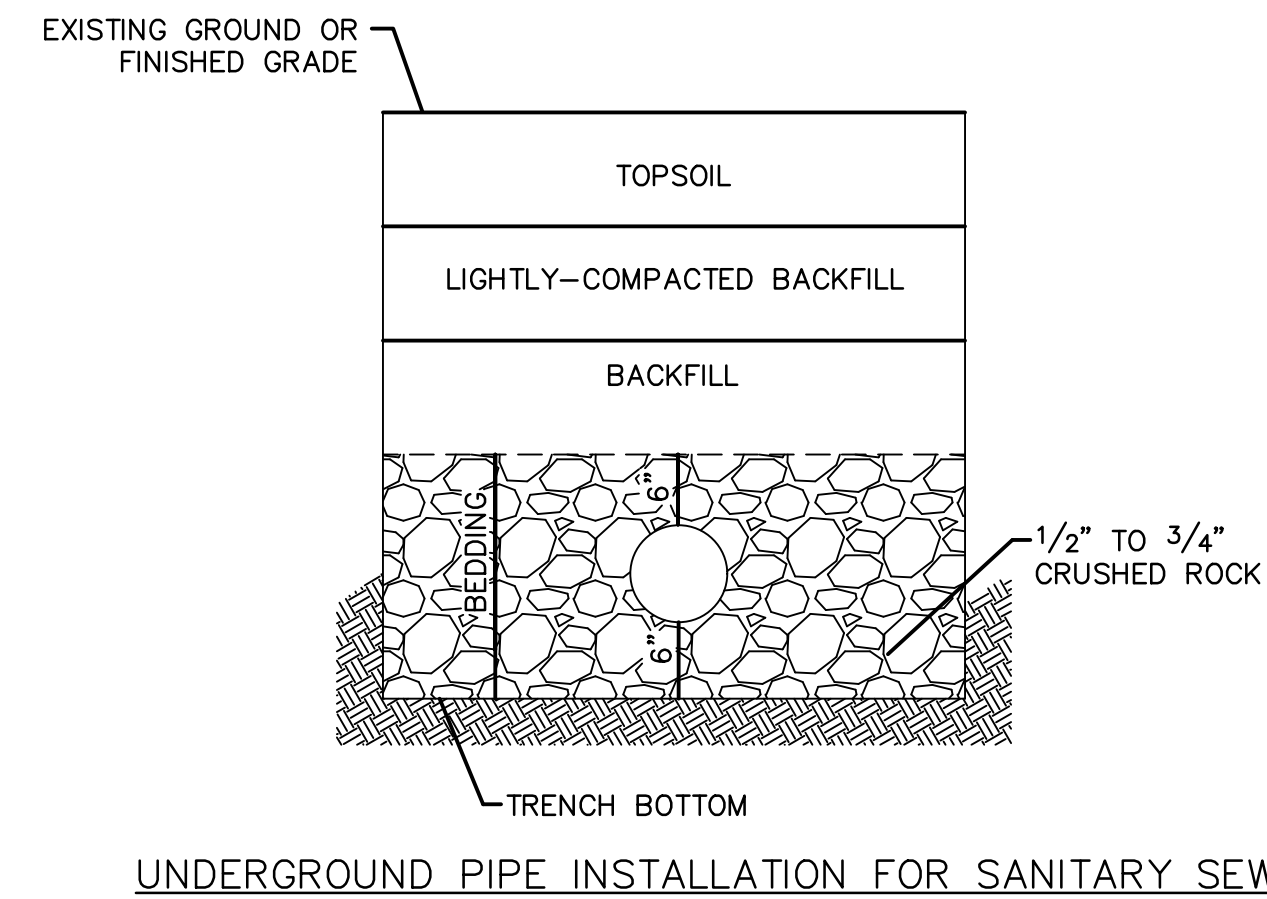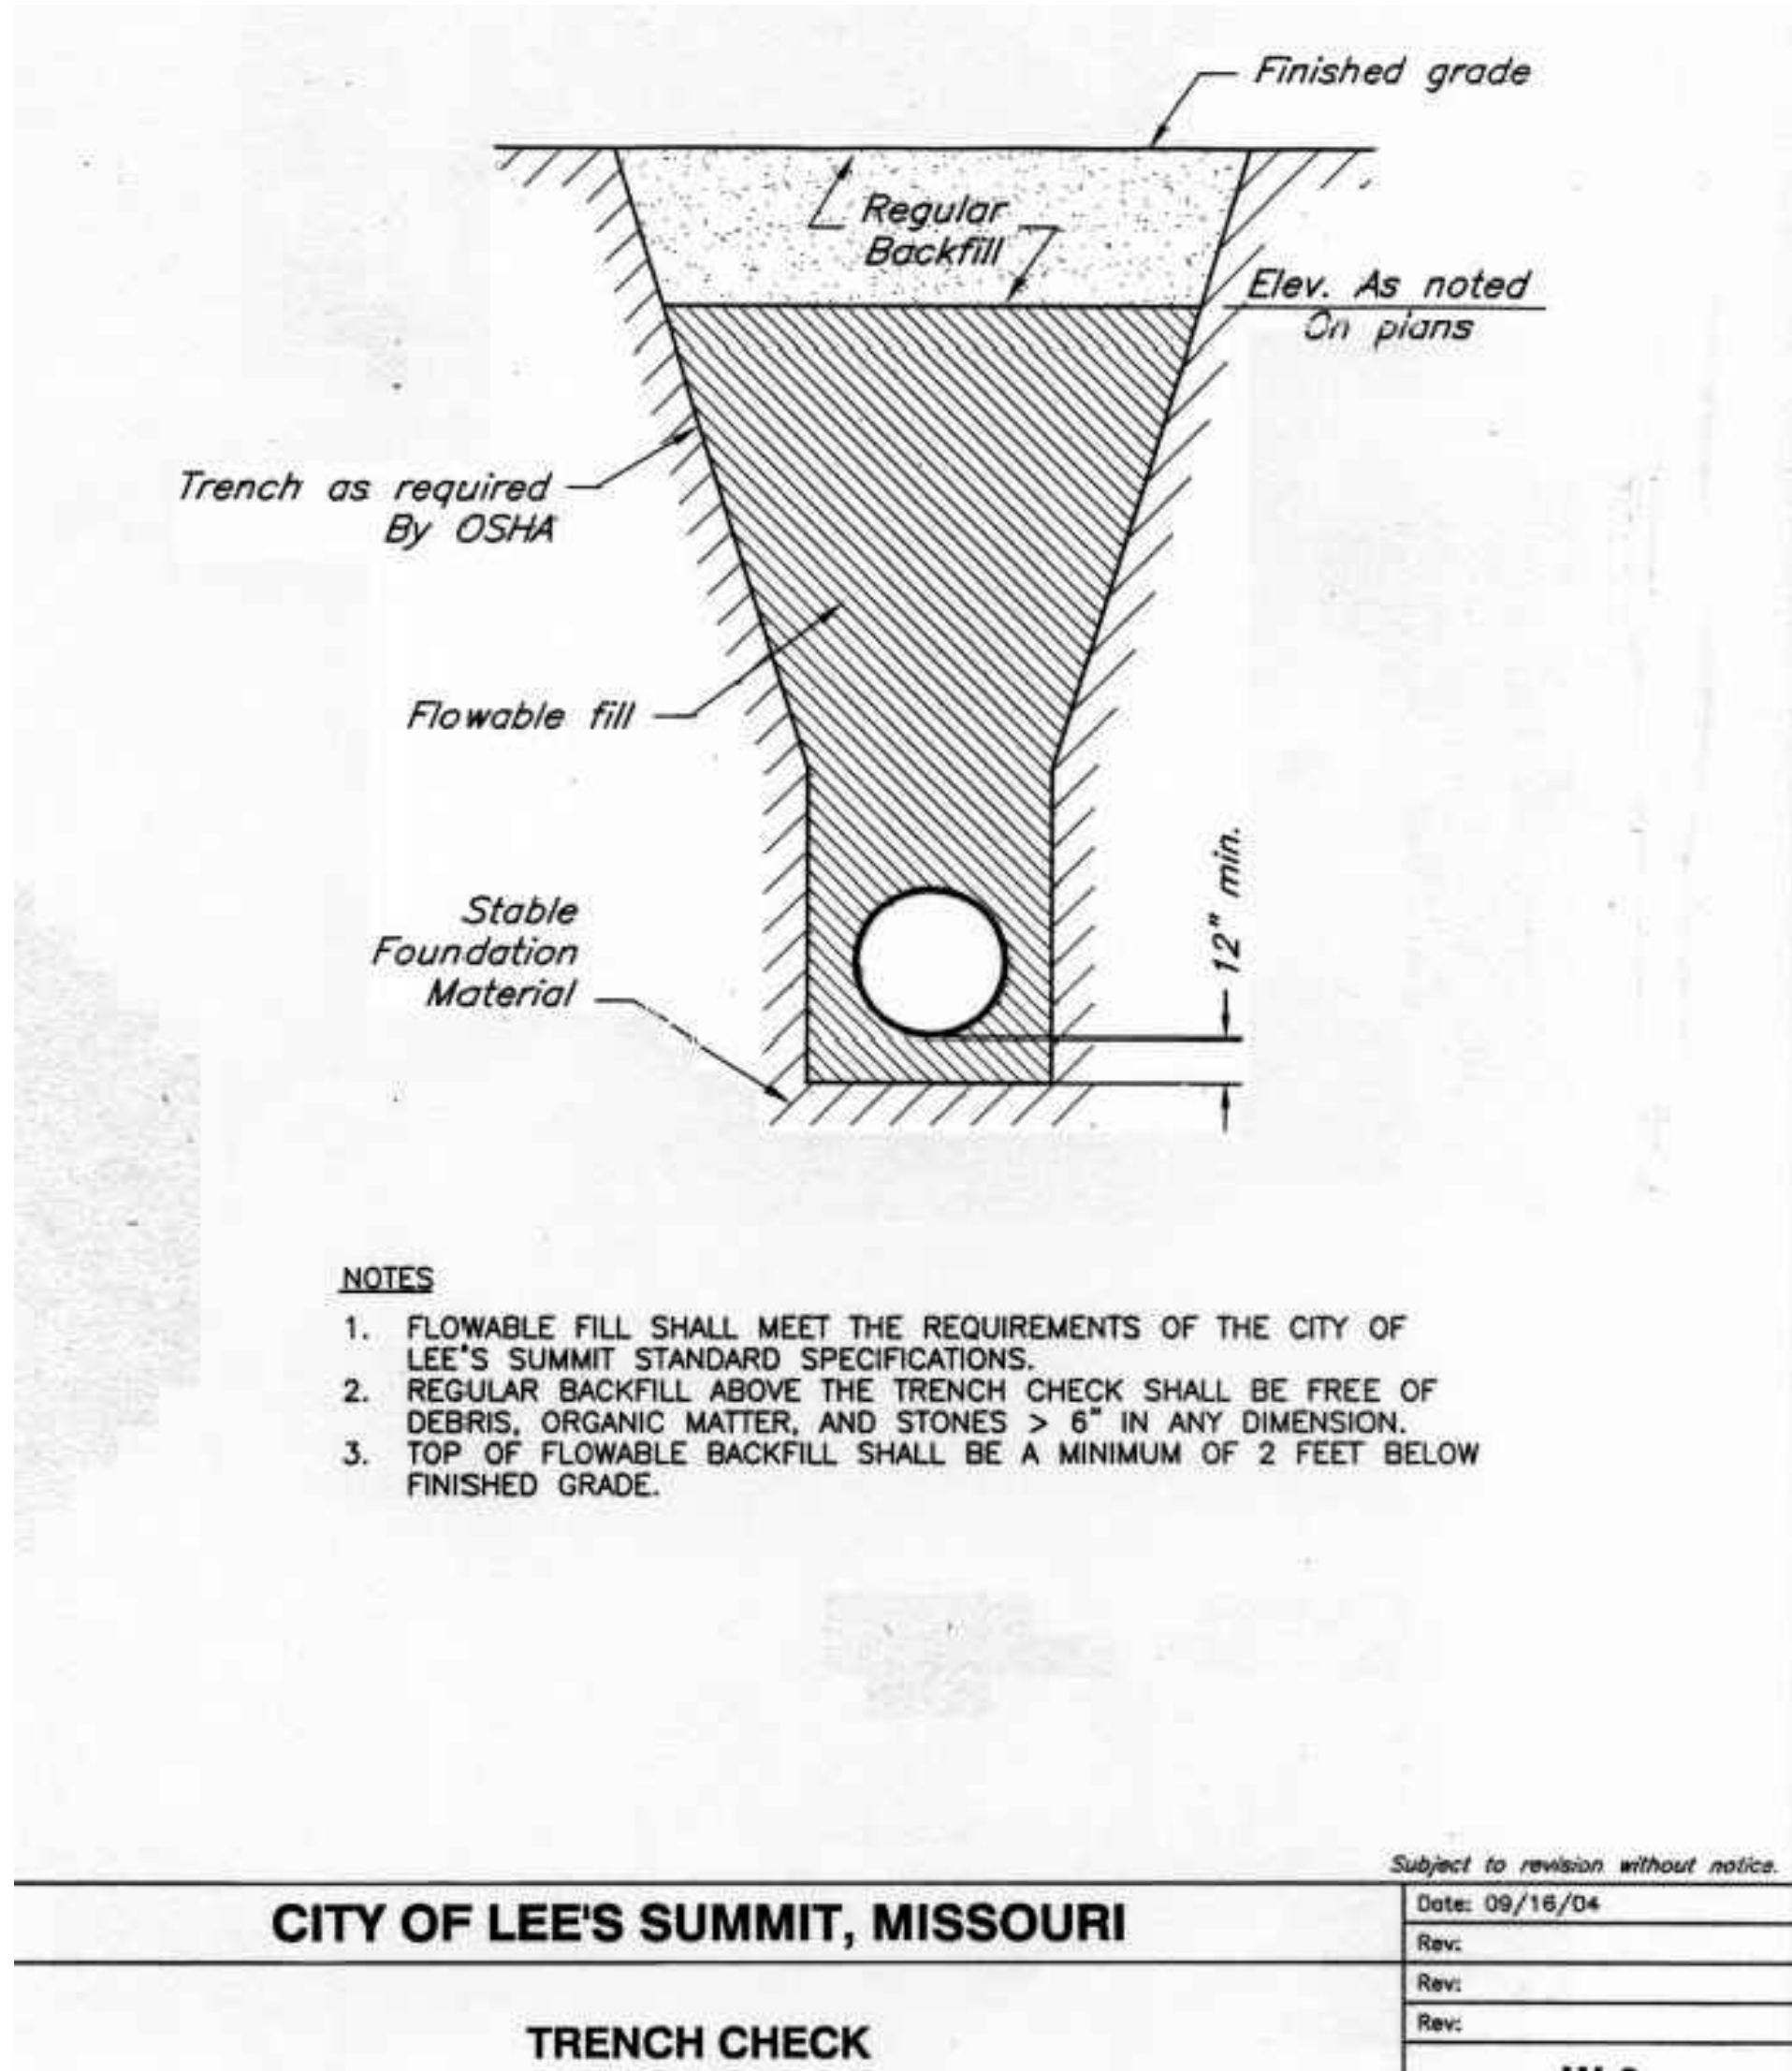

- NOTES:**
1. A MINIMUM OF 36 INCHES OF COVER SHALL BE OVER THE TOP OF THE PIPE. THIS MINIMUM OF COVER SHALL BE FROM THE TOP OF PIPE TO THE FINISHED GRADE.
 2. BEDDING AGGREGATE SHALL BE PLACED FROM A LEVEL 6 INCHES BELOW THE BOTTOM OF THE PIPE TO A LEVEL 6 INCHES ABOVE THE TOP OF THE PIPE.
 3. TRENCH BACKFILL IN PAVED AREAS WITHIN STREET OR ALLEY RIGHT OF WAYS
 - a. NARROW TRENCH: SUITABLE BACKFILL MATERIAL FOR TRENCHES 24 INCHES OR LESS IN WIDTH AND SHALL BE TYPE A FLOWABLE FILL.
 - b. STANDARD TRENCH: SUITABLE BACKFILL MATERIAL FOR TRENCHES BETWEEN 24 TO 48 INCHES WIDE SHALL BE EITHER TYPE C FLOWABLE FILL OR DENSE, WELL GRADED AGGREGATE BASE MATERIAL. AGGREGATE BASE MATERIAL SHALL MEET THE REQUIREMENTS FOR KDOT AB-3; MODT TYPES 1 OR 5; OR APWA 2202.2.
 - c. WIDE TRENCH: SUITABLE BACKFILL MATERIAL FOR TRENCHES GREATER THAN 48 INCHES WIDE SHALL BE SUITABLE MATERIAL AS SPECIFIED FOR EARTH EMBANKMENT IN APWA STANDARD SPECIFICATIONS, SECTION 2102.2.C.
 4. SUITABLE BACKFILL MATERIAL OUTSIDE OF PAVED AREAS WITHIN RIGHT OF WAY, AND ALL AREAS OUTSIDE RIGHT OF WAY, MAY BE SUITABLE MATERIAL AS SPECIFIED FOR EARTH EMBANKMENT IN APWA STANDARD SPECIFICATIONS, SECTION 2102.2.C. SUITABLE BACKFILL MATERIAL MAY ALSO BE OTHER TRENCH BACKFILL MATERIAL (FLOWABLE FILL OR AGGREGATE BASE) DEPENDING ON SITE CONDITIONS, TRENCH WIDTHS OR AT THE DIRECTION OF THE CITY'S ON SITE INSPECTOR.

NOT AS-BUILT