


Notes

1. Contractor is responsible for verifying all existing utility locations prior to excavation.
2. There are no known natural or artificial water storage detention areas, or wetlands in the area designated for construction.
3. No part of the project lies within the 100 year flood plain.
4. All erosion and sediment control measures need to be implemented prior to construction.
5. Additional erosion control may be required by the City Engineer, Design Engineer or Owner, at any time problematic areas are noted in the field or existing measures are found to be ineffective.
6. Soil Stabilization of disturbed areas shall be completed within 14 days of construction inactivity.
7. Contractor responsible for all density testing of roadway subgrade and granular base.

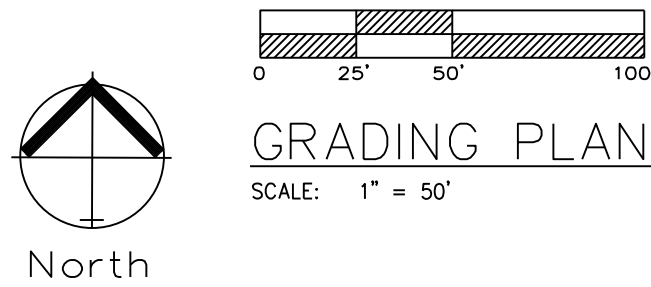

"AS-BUILT"

900.10
~~900.00~~ Indicates data replaced with "As-Built" information. All other data is as designed and has not been field verified.



Professional Registration
Missouri
Engineering 2005002186-D
Surveying 2005008319-D
Kansas
Engineering E-1685
Surveying LS-218
Oklahoma
Engineering 6254
Nebraska
Engineering CA2821

Napa Valley 4th Plat
Lee's Summit, Jackson County, Missouri


Project:
NAPA VALLEY LSUMO
Issue Date:
July 13, 2018

Master Drainage Plan 1 of 3:
Grading Plan
Street, Stormwater, Master Drainage Plan,
and Erosion and Sediment Control Plans
for:
Napa Valley 4th Plat
Lee's Summit, Jackson County, Missouri




Matthew J. Schlicht
MO PE 2006019708
KS PE 19071
OK PE 25226
NE PE E-14335

REVISIONS
1/11/2021 As-Built

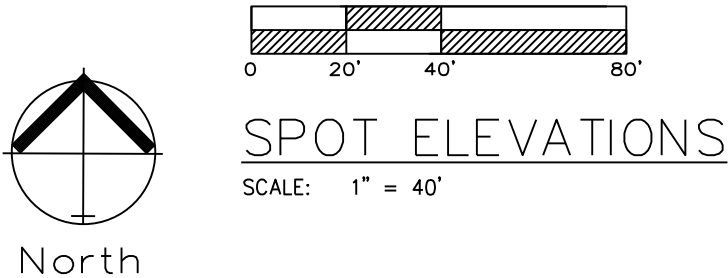

Lot Number	Basement Type	MBOE
147	Daylight	1012.9
148	Daylight	1013.9
149	Walkout	1013.9
150	Walkout	1014.9
151	Walkout	1015.9
152	Walkout	1015.9
153	Daylight	1017.9
154	Full	1018.4
155R	Full	1019.21
155L	Full	1019.21
156R	Full	1019.21
156L	Full	1020.3
157R	Full	1020.3
157L	Full	1019.16
158R	Full	1019.16
158L	Full	1020.3
159R	Full	1020.3
159L	Full	1019.3
160R	Daylight	1019.3
160L	Daylight	1020.7
161R	Daylight	1020.7
161L	Daylight	1020.76
162R	Daylight	1020.76
162L	Daylight	1019.65
163R	Daylight	1019.65
163L	Daylight	1020.7
164R	Full	1020.7
164L	Full	1019.16
165R	Full	1019.16
165L	Full	1017.15

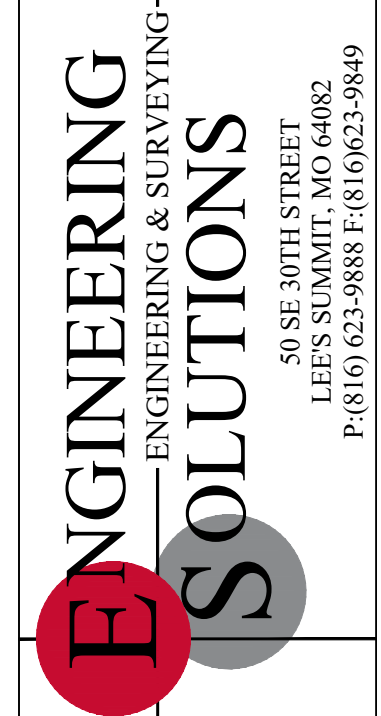


Professional Registration
Missouri
Engineering 2005002186-D
Surveying 2005008319-D
Kansas
Engineering E-1685
Surveying LS-218
Oklahoma
Engineering 6254
Nebraska
Engineering CA2821

Project: NAPA VALLEY, LSMO
Issue Date: July 13, 2018
Master Drainage Plan 2 of 3:
Spot Elevations
Street, Stormwater, Master Drainage Plan,
and Erosion and Sediment Control Plans
for:
Napa Valley 4th Plat
Lee's Summit, Jackson County, Missouri

Project: NAPA VALLEY, LSMO
Issue Date: July 13, 2018

Master Drainage Plan 2 of 3:
Spot Elevations
Street, Stormwater, Master Drainage Plan,
and Erosion and Sediment Control Plans
for:
Napa Valley 4th Plat
Lee's Summit, Jackson County, Missouri

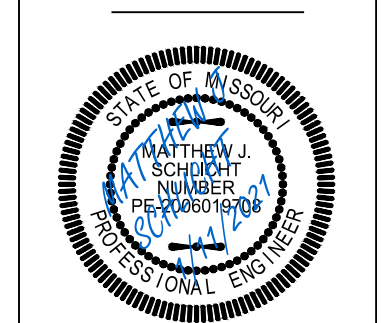

Matthew J. Schlicht
MO PE 2006019708
KS PE 19071
OK PE 25226
NE PE E-14335

REVISIONS
1/11/2021 As-Built

"AS-BUILT"
900.10
900.00 Indicates data replaced with "As-Built"
information. All other data is as designed
and has not been field verified.