



5/21/2021
16_059-StormPlanProf03-Line02-01.dgn

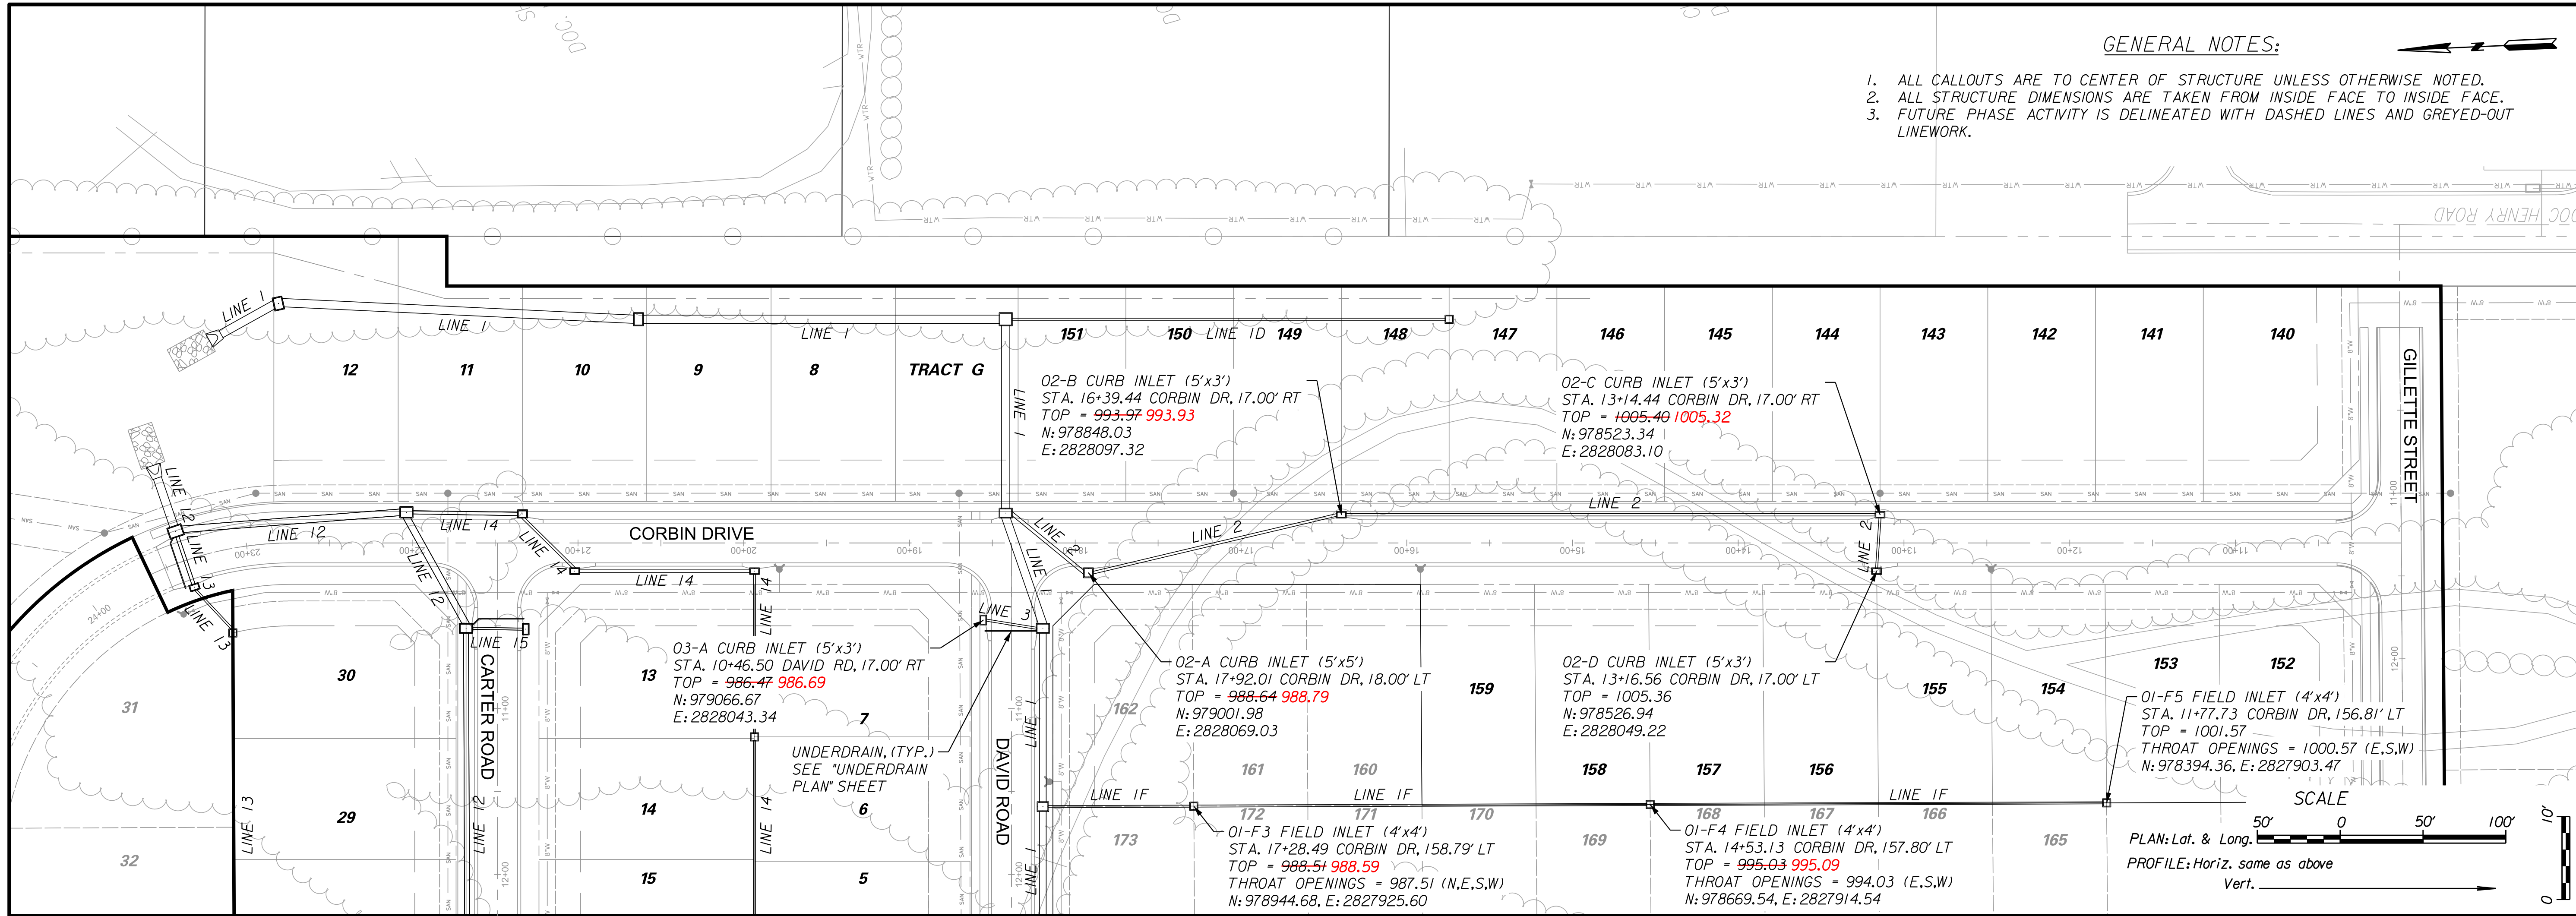

- GENERAL NOTES:
1. ALL CALLOUTS ARE TO CENTER OF STRUCTURE UNLESS OTHERWISE NOTED.
 2. ALL STRUCTURE DIMENSIONS ARE TAKEN FROM INSIDE FACE TO INSIDE FACE.
 3. FUTURE PHASE ACTIVITY IS DELINEATED WITH DASHED LINES AND GREYED-OUT LINEWORK.

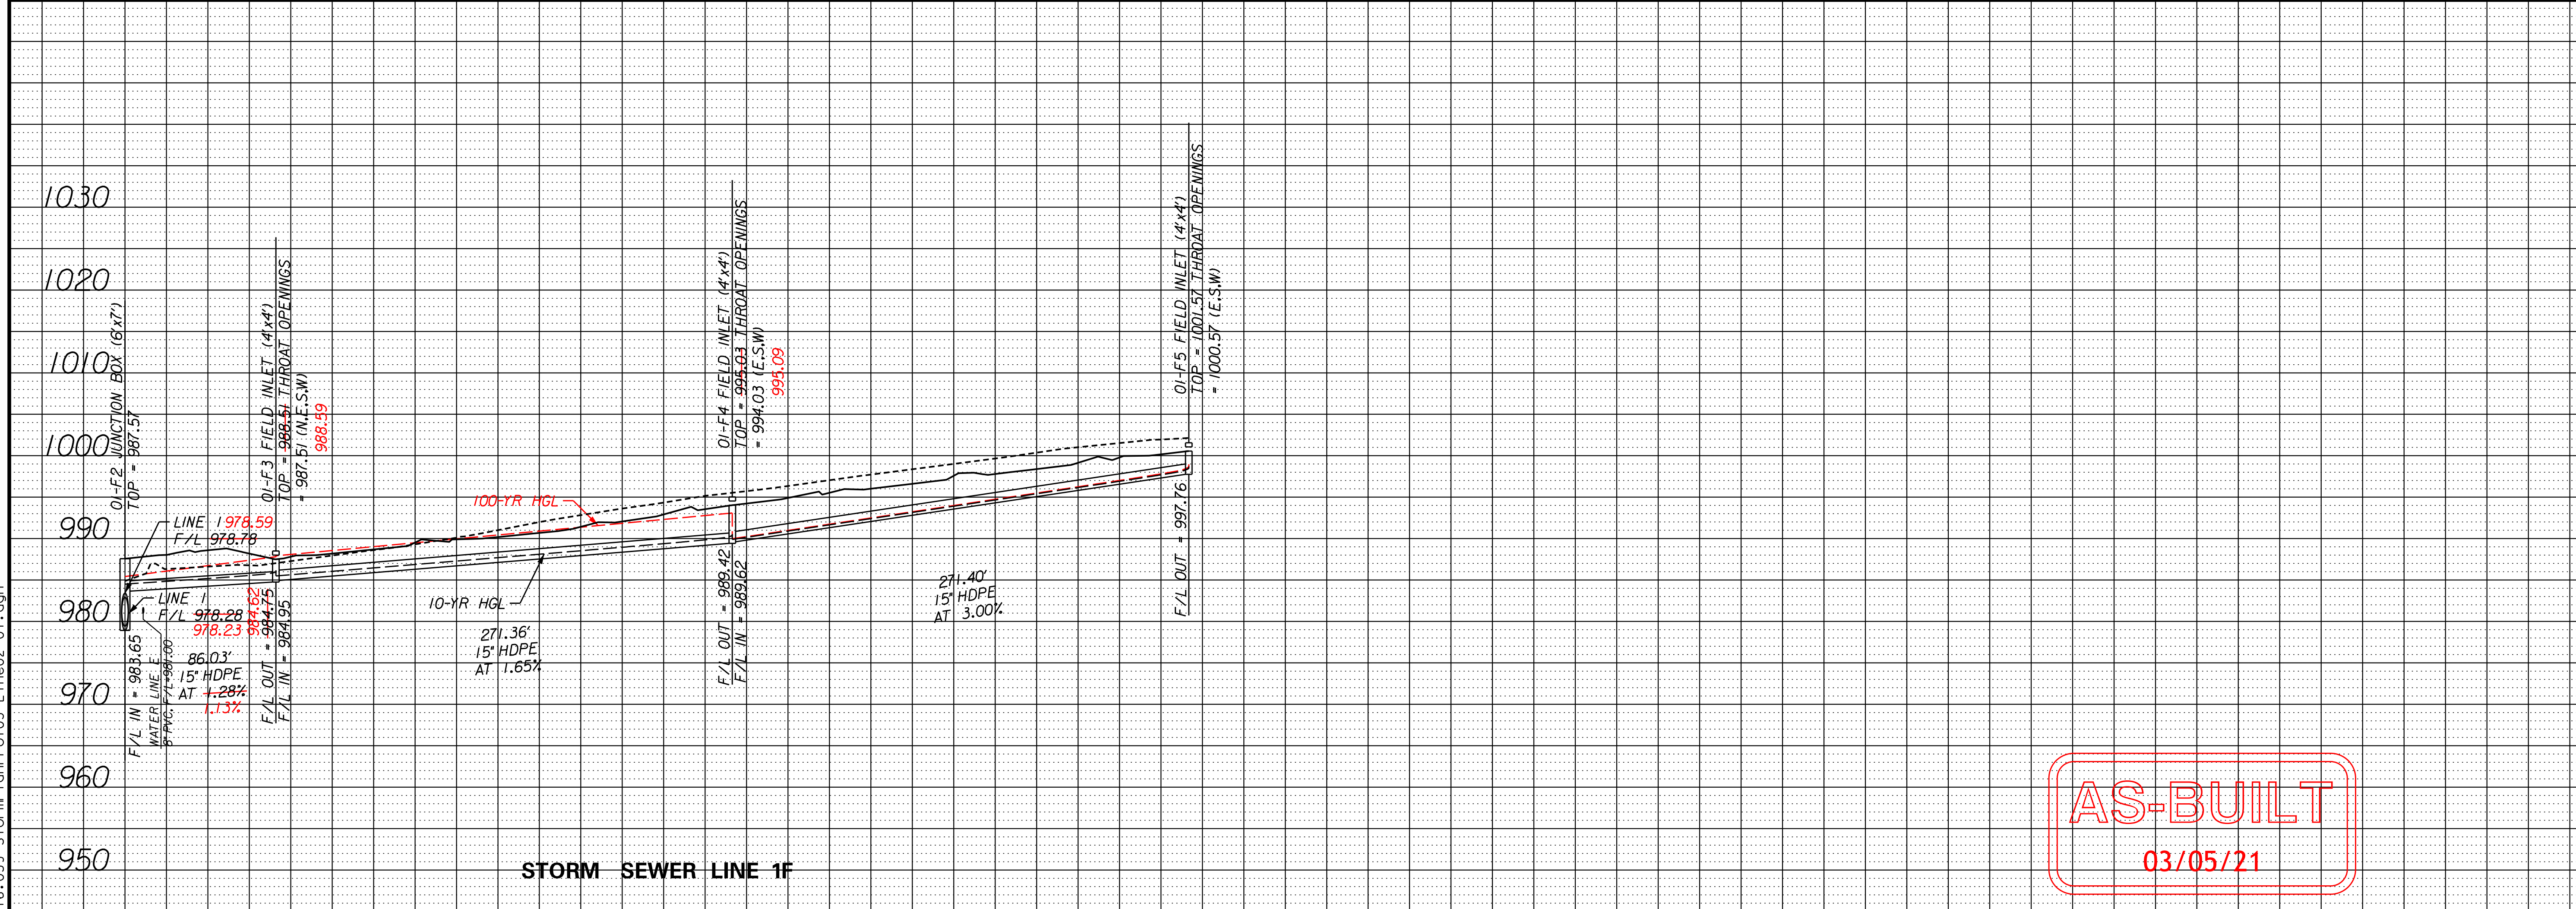

AS-BUILT
03/05/21

NO.	BY	CHK/APP
1	RAM	RNS
2	RAM	RNS
3	RAM	RNS
4	RAM	RNS

03/05/21 AS-BUILT
CHANGES TO STORM LINE 12
03/02/20
ADDRESS CITY COMMENTS DATED 3/20/19
3/27/19
ADDRESS CITY COMMENTS DATED 12/18/18
3/8/19
SUBMITTAL TO CITY OF LEE'S SUMMIT
11/22/18

F THIS IS NOT A BLUE INK SEAL AND THE SIGNATURE IS NOT IN BLUE INK, THE PLAN IS A COPY AND MAY CONTAIN UNAUTHORIZED ALTERATIONS. THE CERTIFICATION CONTAINED ON THIS DOCUMENT SHALL NOT APPLY TO ANY COPIES.

R. KEVIN STERRETT, MO E-26440

03/02/20

Consult Inc engineers planners

11010 Haskell St. Ste. 210 Kansas City, KS 66109 816-755-2285 CORPORATE LICENSE NO. E2010005873

STORM SEWER LINES 1F, 2 AND 3

COBEY CREEK

CITY OF LEE'S SUMMIT, JACKSON COUNTY, MISSOURI

X-REF. NO. XXX
DRAWING NO. XXX
DATE March 27, 2019
JOB NO. 16_059_01

12 SHEET OF 53