
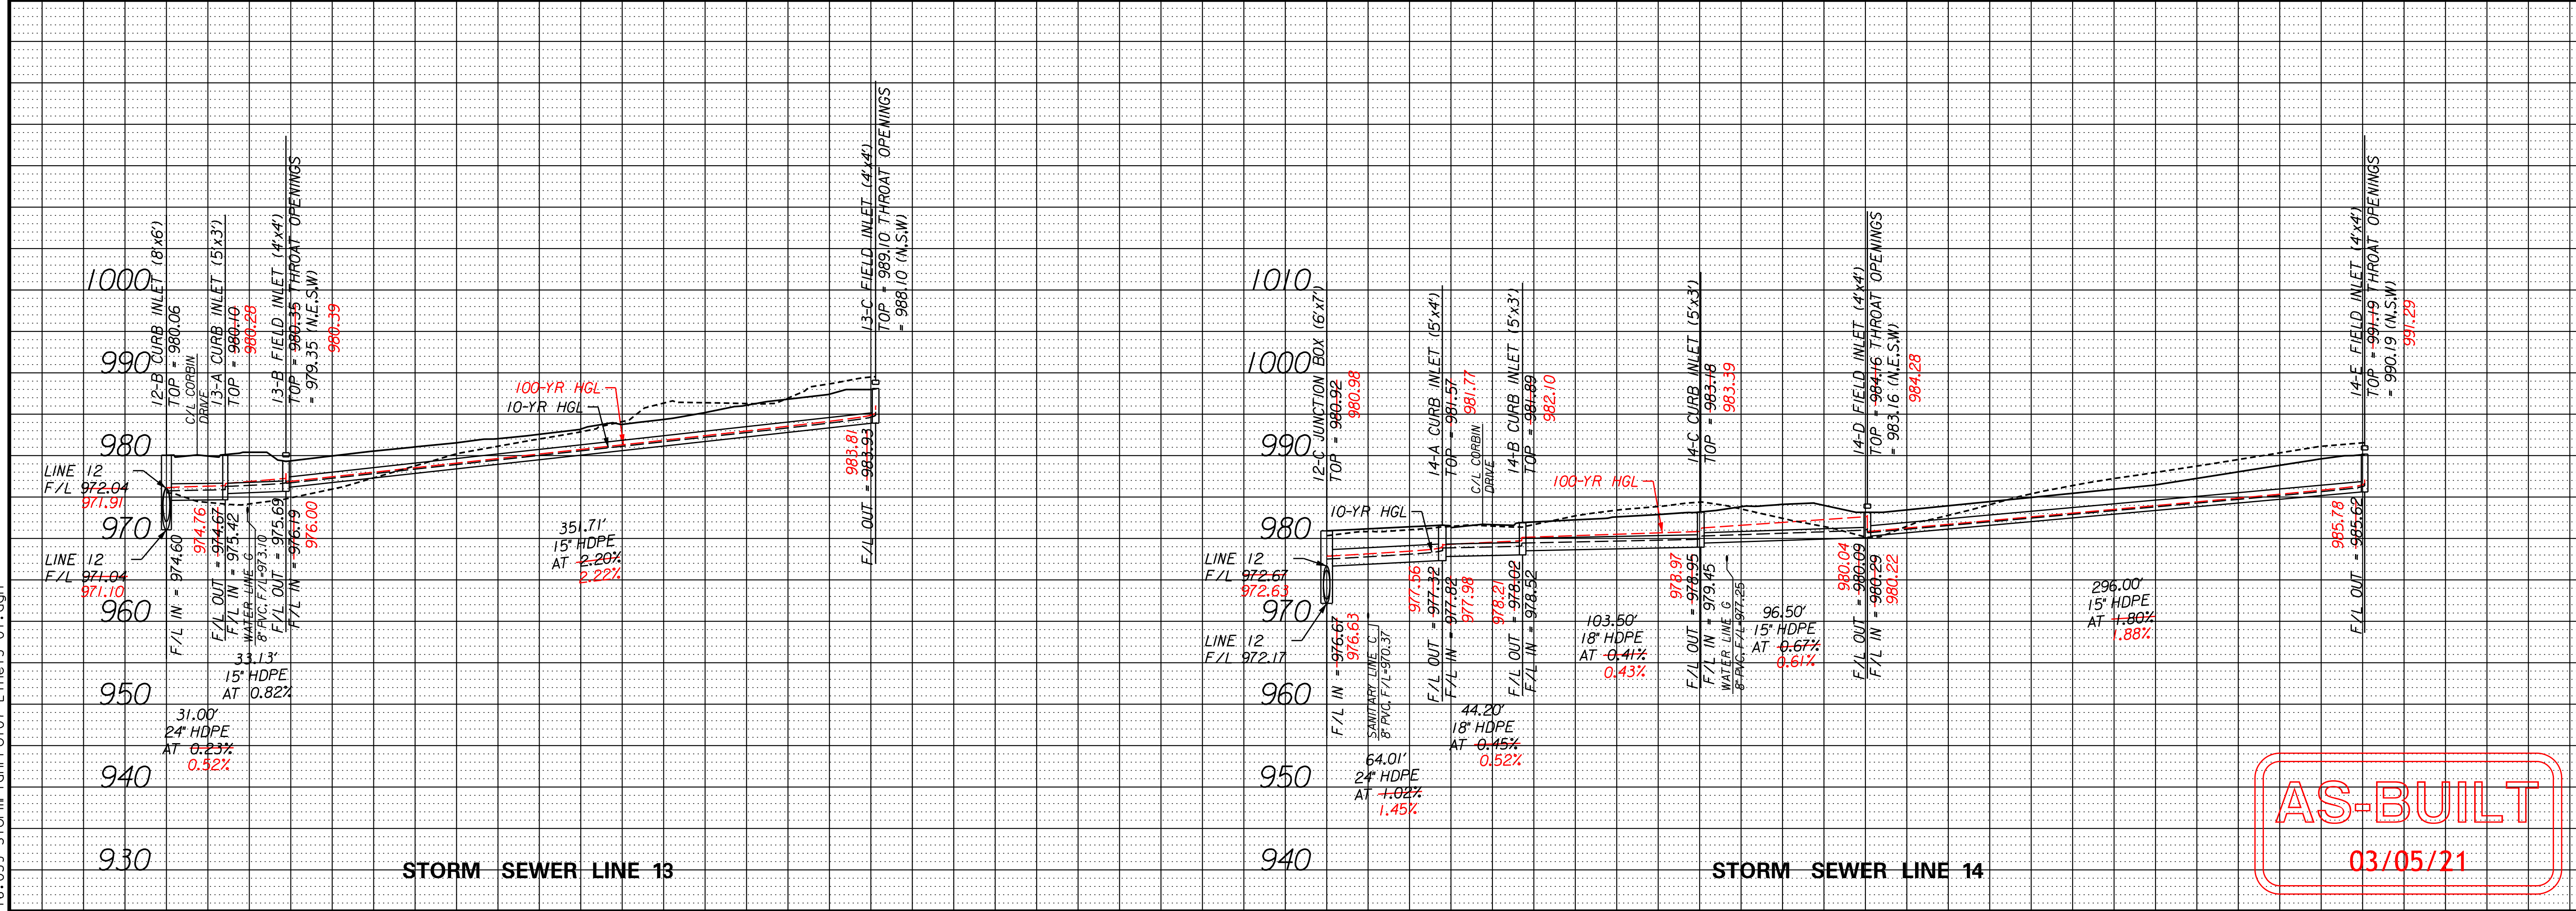


5/21/2021
16_059-StormPlanProf07-Line13-01.dgn

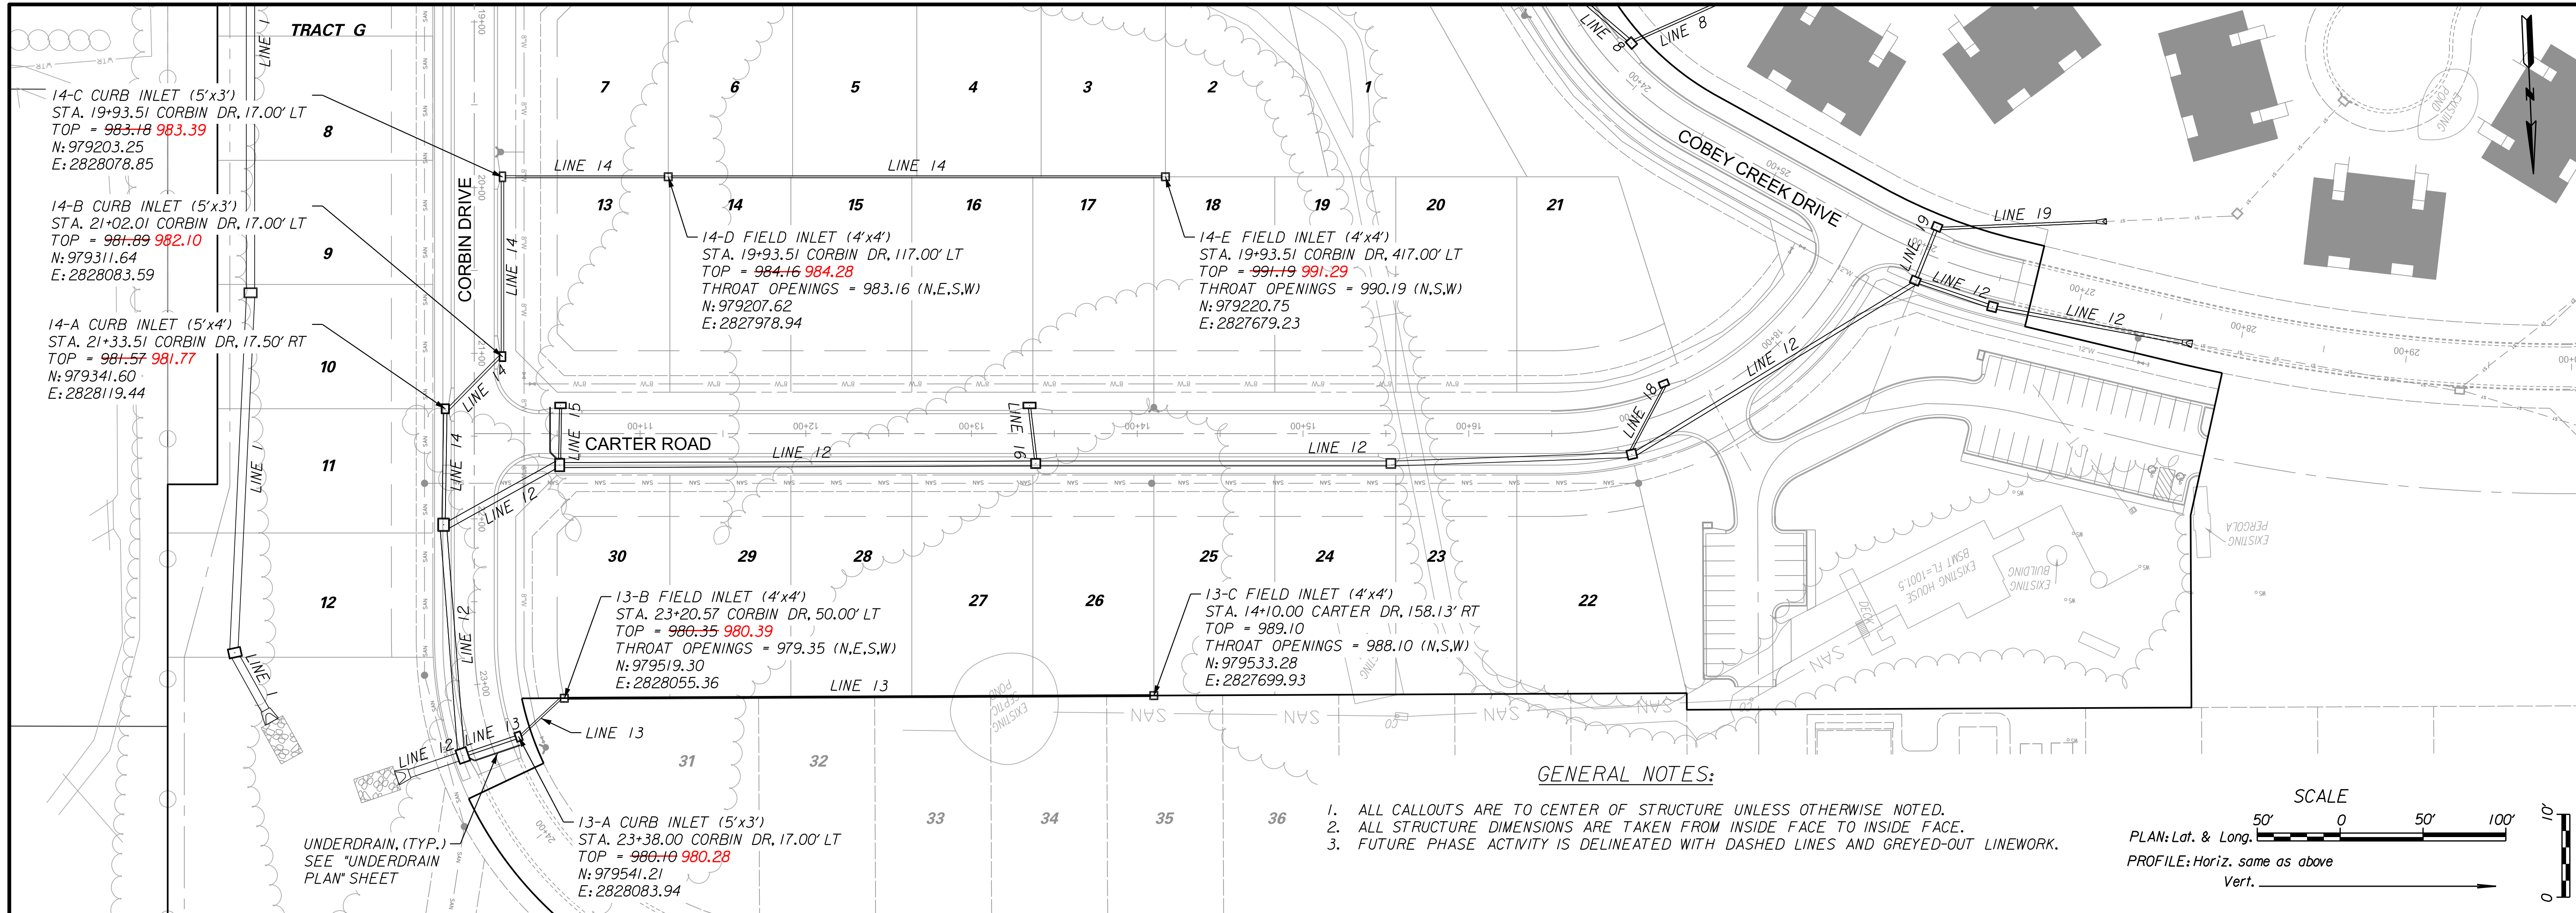

NO.	BY	DATE	REVISION
1	RAM	03/05/21	AS-BUILT
2	RAM	03/02/20	CHANGES TO STORM LINE 12
3	RAM	3/27/19	ADDRESS CITY COMMENTS DATED 3/20/19
4	RAM	3/8/19	ADDRESS CITY COMMENTS DATED 12/18/18
5	RAM	11/22/18	SUBMITTAL TO CITY OF LEE'S SUMMIT

11010 Haskell St. Ste. 210 Kansas City, KS 66109 816-755-2285
CORPORATE LICENSE NO. E2010005873
R. KEVIN STERRETT, MO E-26440

Consult Inc engineers planners

STORM SEWER LINES 13 AND 14

COBEY CREEK

CITY OF LEE'S SUMMIT, JACKSON COUNTY, MISSOURI

X-REF. NO. XXX
DRAWING NO. XXX
DATE March 27, 2019
JOB NO. 16_059_01
SHEET 53 OF 16