

Channel Report


HydroFlow Express Extension for Autodesk® AutoCAD® Civil 3D® by Autodesk, Inc.
Thursday, May 6 2021

LOT 151 / OPEN SPACE STA. 4+16.81

Trapezoidal		Highlighted	
Bottom Width (ft)	= 6.00	Depth (ft)	= 0.60
Side Slopes (z:1)	= 6.00, 3.00	Q (cfs)	= 26.12
Total Depth (ft)	= 3.00	Area (sqft)	= 5.22
Invert Elev (ft)	= 100.00	Velocity (ft/s)	= 5.00
Slope (%)	= 3.04	Wetted Perim (ft)	= 11.55
N-Value	= 0.030	Crit Depth, Yc (ft)	= 0.70
		Top Width (ft)	= 11.40
		EGL (ft)	= 0.99

Calculations
Compute by:
Known Q (cfs)

Known Q
= 26.12

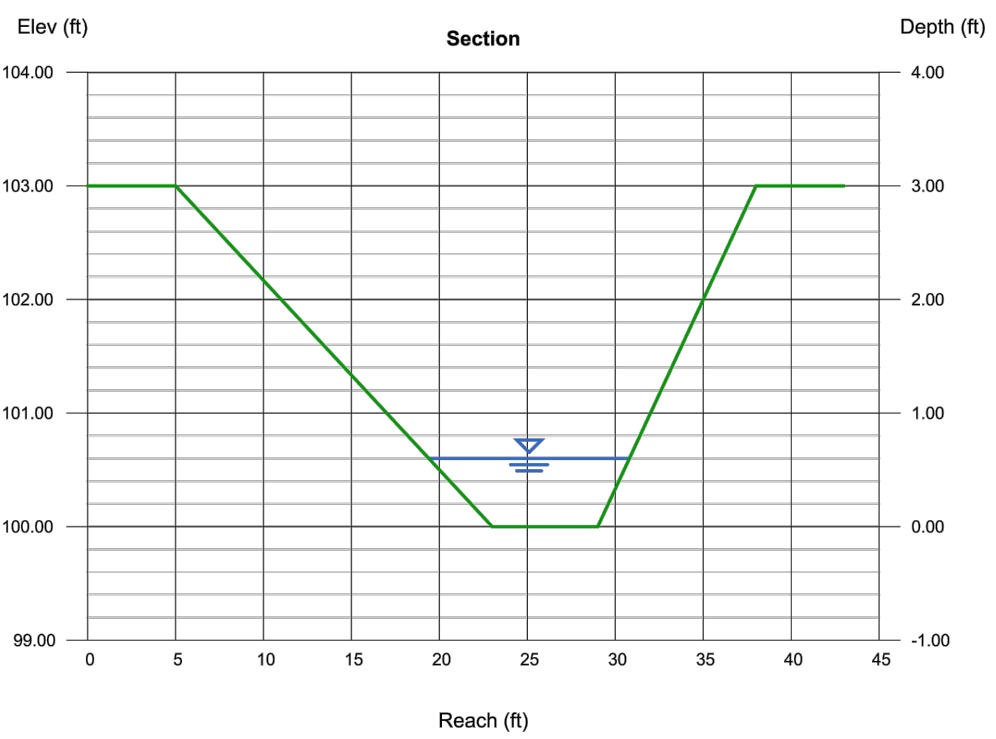

OFFSITE FLOW DIVERSION SWALE WATER SURFACE CALCS
(CALCS @ STA. 4+16.81, WATER SURFACE VARIES FROM STA. 0+00 TO 10+00)

Channel Report


HydroFlow Express Extension for Autodesk® AutoCAD® Civil 3D® by Autodesk, Inc.
Thursday, May 6 2021

LOTS 10 / 11 STA. 7+15.59

Trapezoidal		Highlighted	
Bottom Width (ft)	= 10.00	Depth (ft)	= 0.86
Side Slopes (z:1)	= 6.00, 3.00	Q (cfs)	= 53.82
Total Depth (ft)	= 3.00	Area (sqft)	= 11.93
Invert Elev (ft)	= 100.00	Velocity (ft/s)	= 4.51
Slope (%)	= 1.47	Wetted Perim (ft)	= 17.95
N-Value	= 0.030	Crit Depth, Yc (ft)	= 0.85
		Top Width (ft)	= 17.74
		EGL (ft)	= 1.18

Calculations
Compute by:
Known Q (cfs)

Known Q
= 53.82

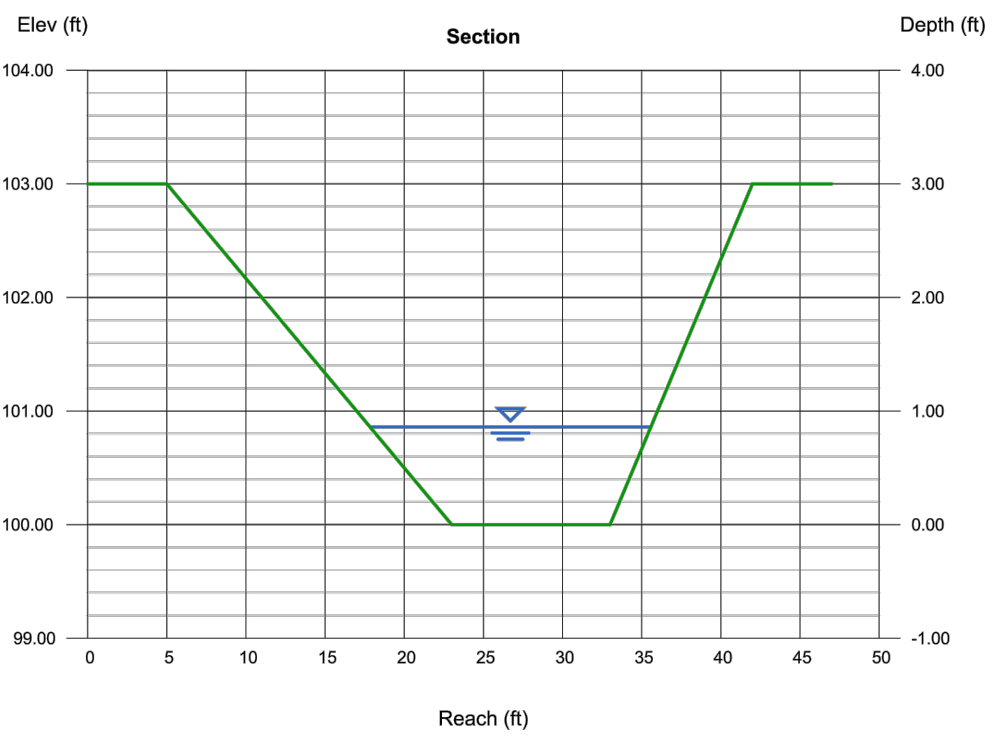

OFFSITE FLOW DIVERSION SWALE WATER SURFACE CALCS
(CALCS @ STA. 7+15.59, WATER SURFACE VARIES FROM STA. 0+00 TO 10+00)

Channel Report


HydroFlow Express Extension for Autodesk® AutoCAD® Civil 3D® by Autodesk, Inc.
Thursday, May 6 2021

LOTS 12 / DETENTION TRACT STA. 8+65.80


Trapezoidal		Highlighted	
Bottom Width (ft)	= 12.00	Depth (ft)	= 0.88
Side Slopes (z:1)	= 6.00, 3.00	Q (cfs)	= 76.84
Total Depth (ft)	= 3.00	Area (sqft)	= 14.04
Invert Elev (ft)	= 100.00	Velocity (ft/s)	= 5.47
Slope (%)	= 2.05	Wetted Perim (ft)	= 20.14
N-Value	= 0.030	Crit Depth, Yc (ft)	= 0.96
		Top Width (ft)	= 19.92
		EGL (ft)	= 1.35

Calculations
Compute by:
Known Q (cfs)

Known Q
= 76.84


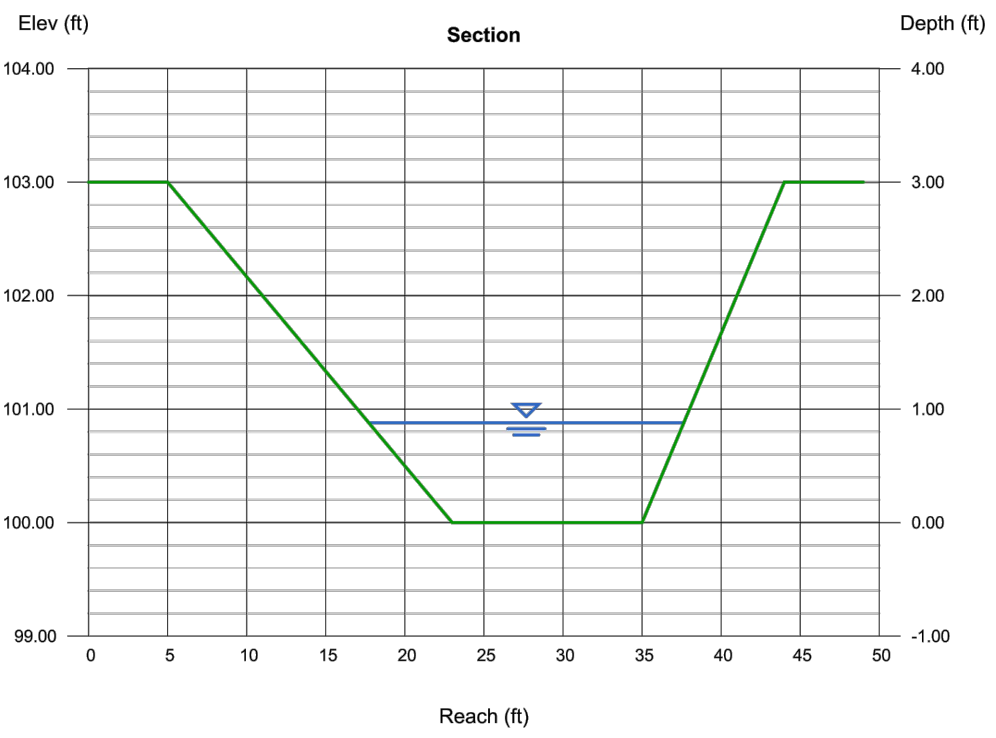


OFFSITE FLOW DIVERSION SWALE WATER SURFACE CALCS
(CALCS @ STA. 8+65.80, WATER SURFACE VARIES FROM STA. 0+00 TO 10+00)

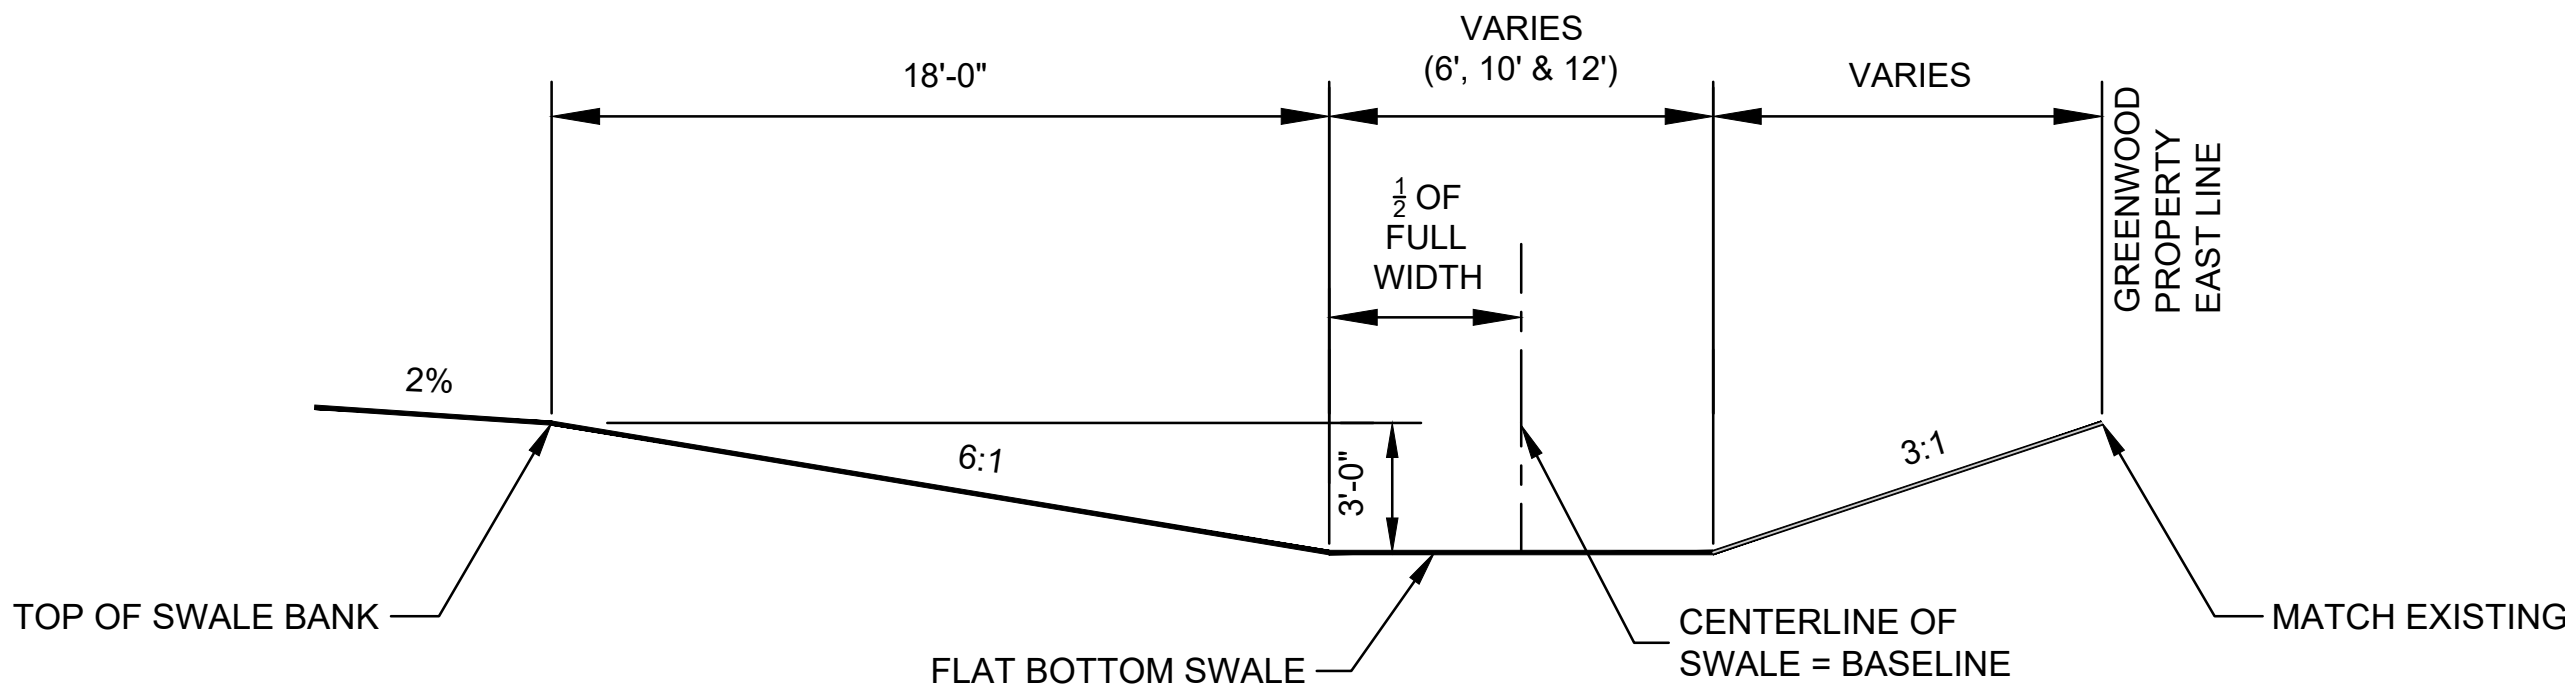


OFFSITE FLOW DIVERSION SWALE

NOT TO SCALE
6' WIDE FROM STA. 0+00 TO 4+00
10' WIDE FROM STA. 4+50 TO 7+50
12' WIDE FROM STA. 8+00 TO 10+00

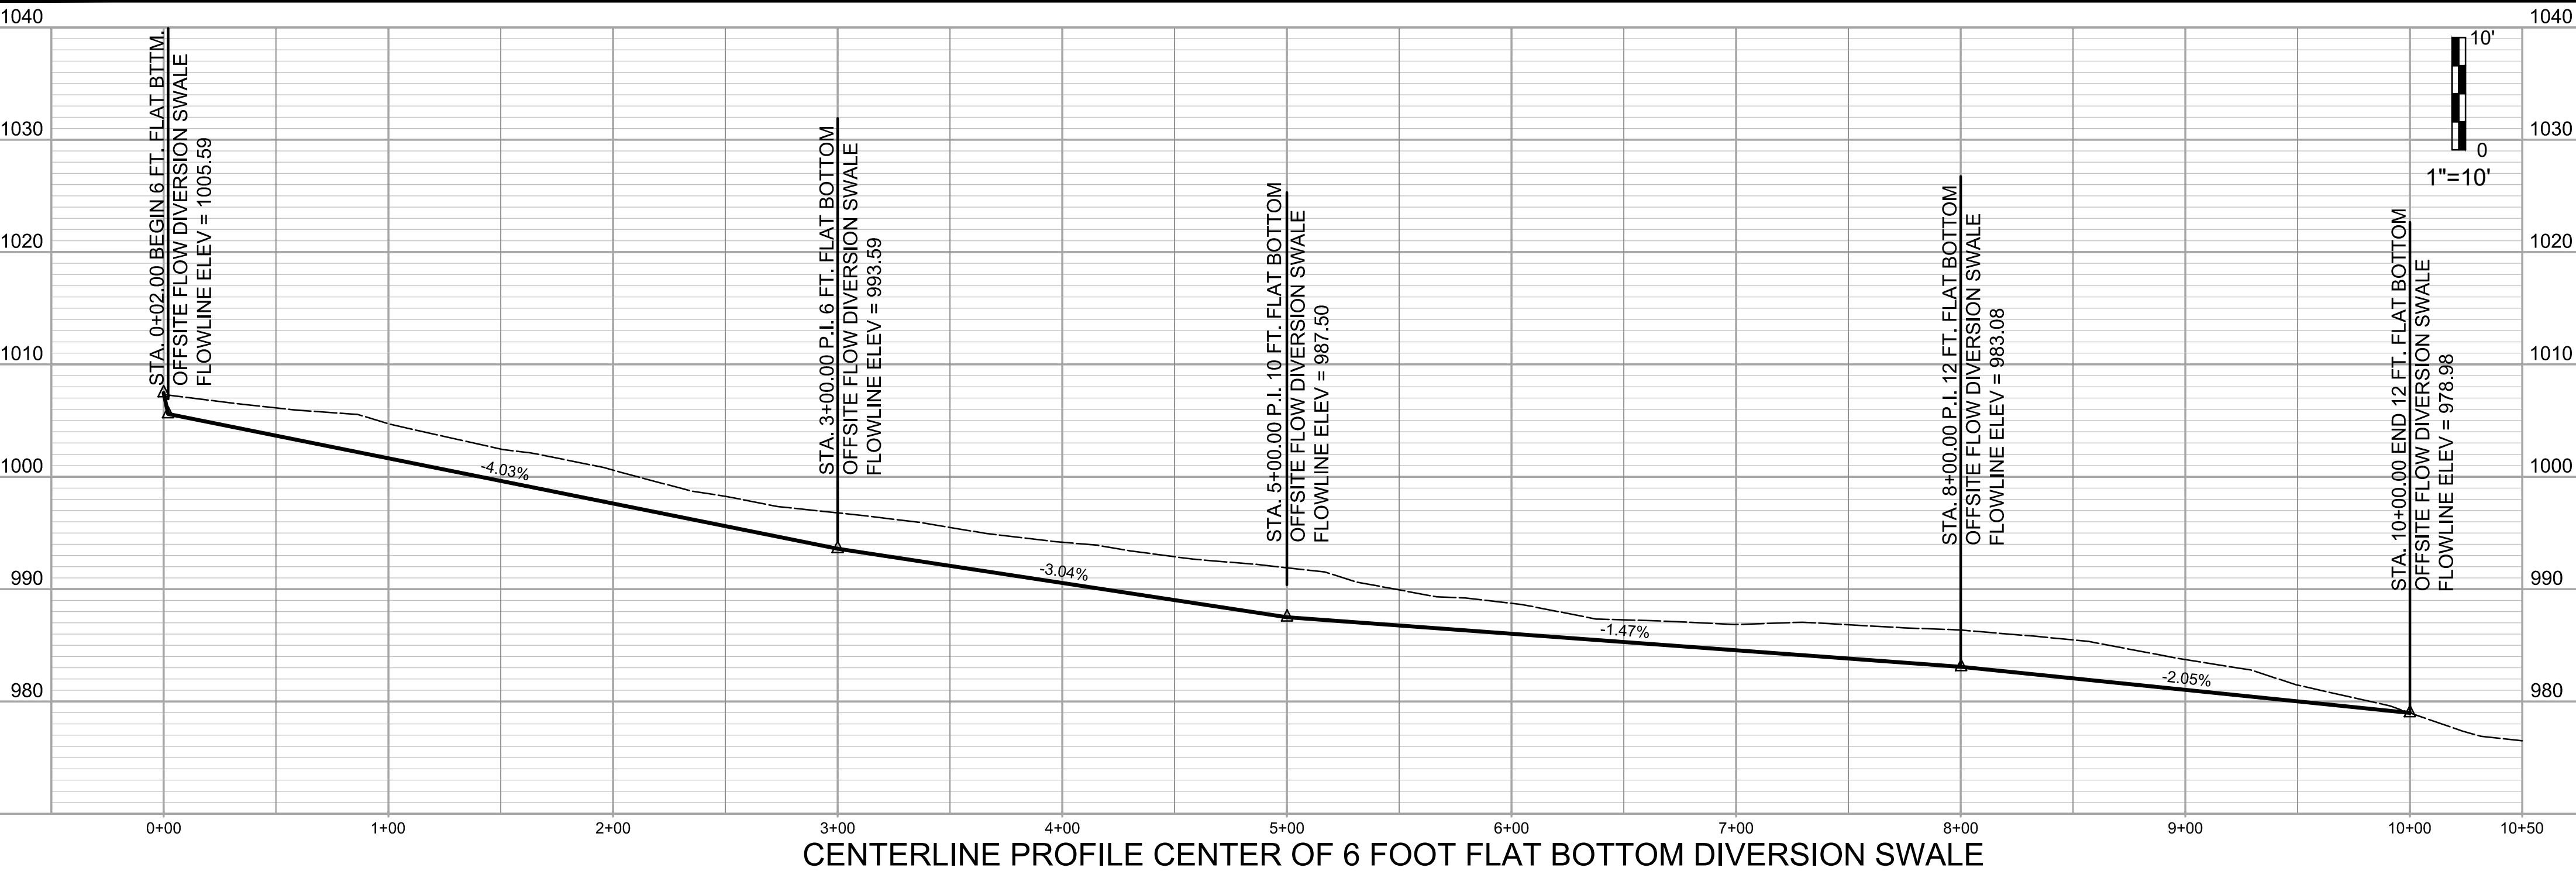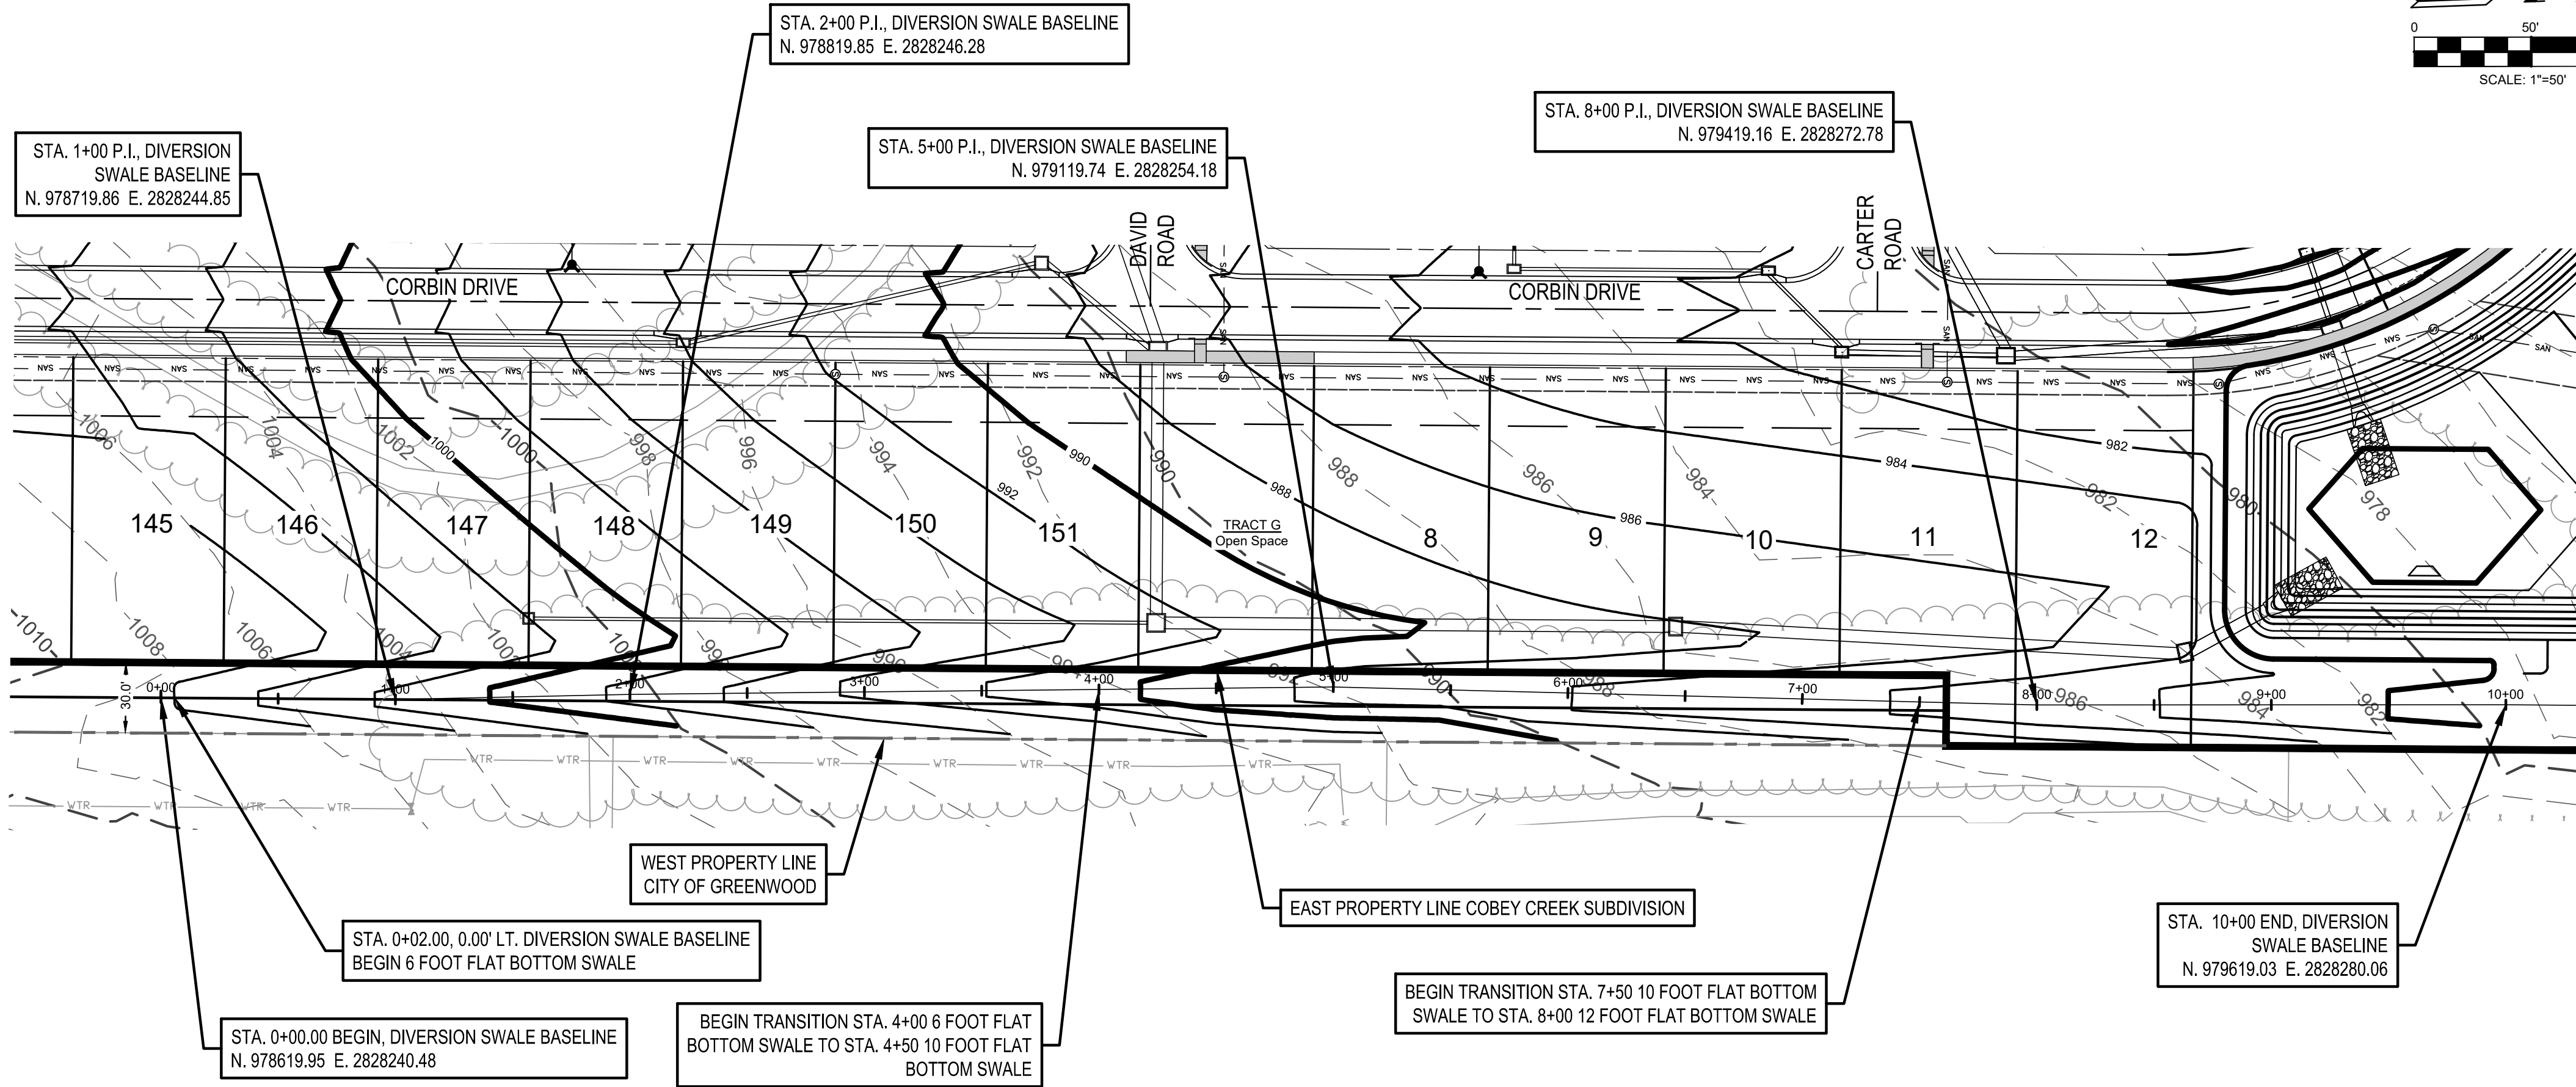



NO.	BY	DATE	REVISION
1	SPW	05/07/21	PER ACQUIRED DRAINAGE EASEMENT FROM CITY OF GREENWOOD
2	SPW	12/16/20	SUBMITAL TO CITY OF LEES SUMMIT

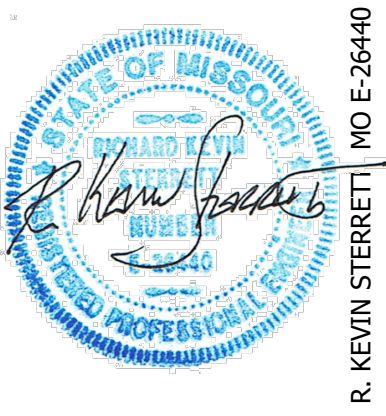

g consultants
Inc
engineers
planners
11010 Haskell Street, Suite 210, Kansas City, Kansas 66109
CORPORATE LICENSE NO. E201000373 (MO.) / E-1736 (KS.)

STREET AND STORM SEWER PLANS
DIVERSION SWALE
COBEY CREEK FIRST PLAT
PHASE I
CITY OF LEES SUMMIT, JACKSON COUNTY, MISSOURI

X-REF NO. 16-059 Base Phase I
DRAWING NO. 16-059 Phase I Street Plans
DATE December 18, 2020
JOB NO. 16-059

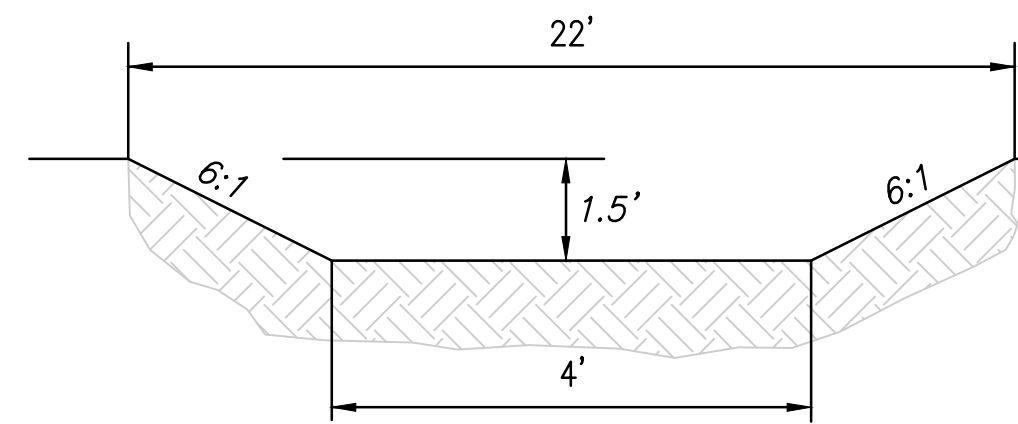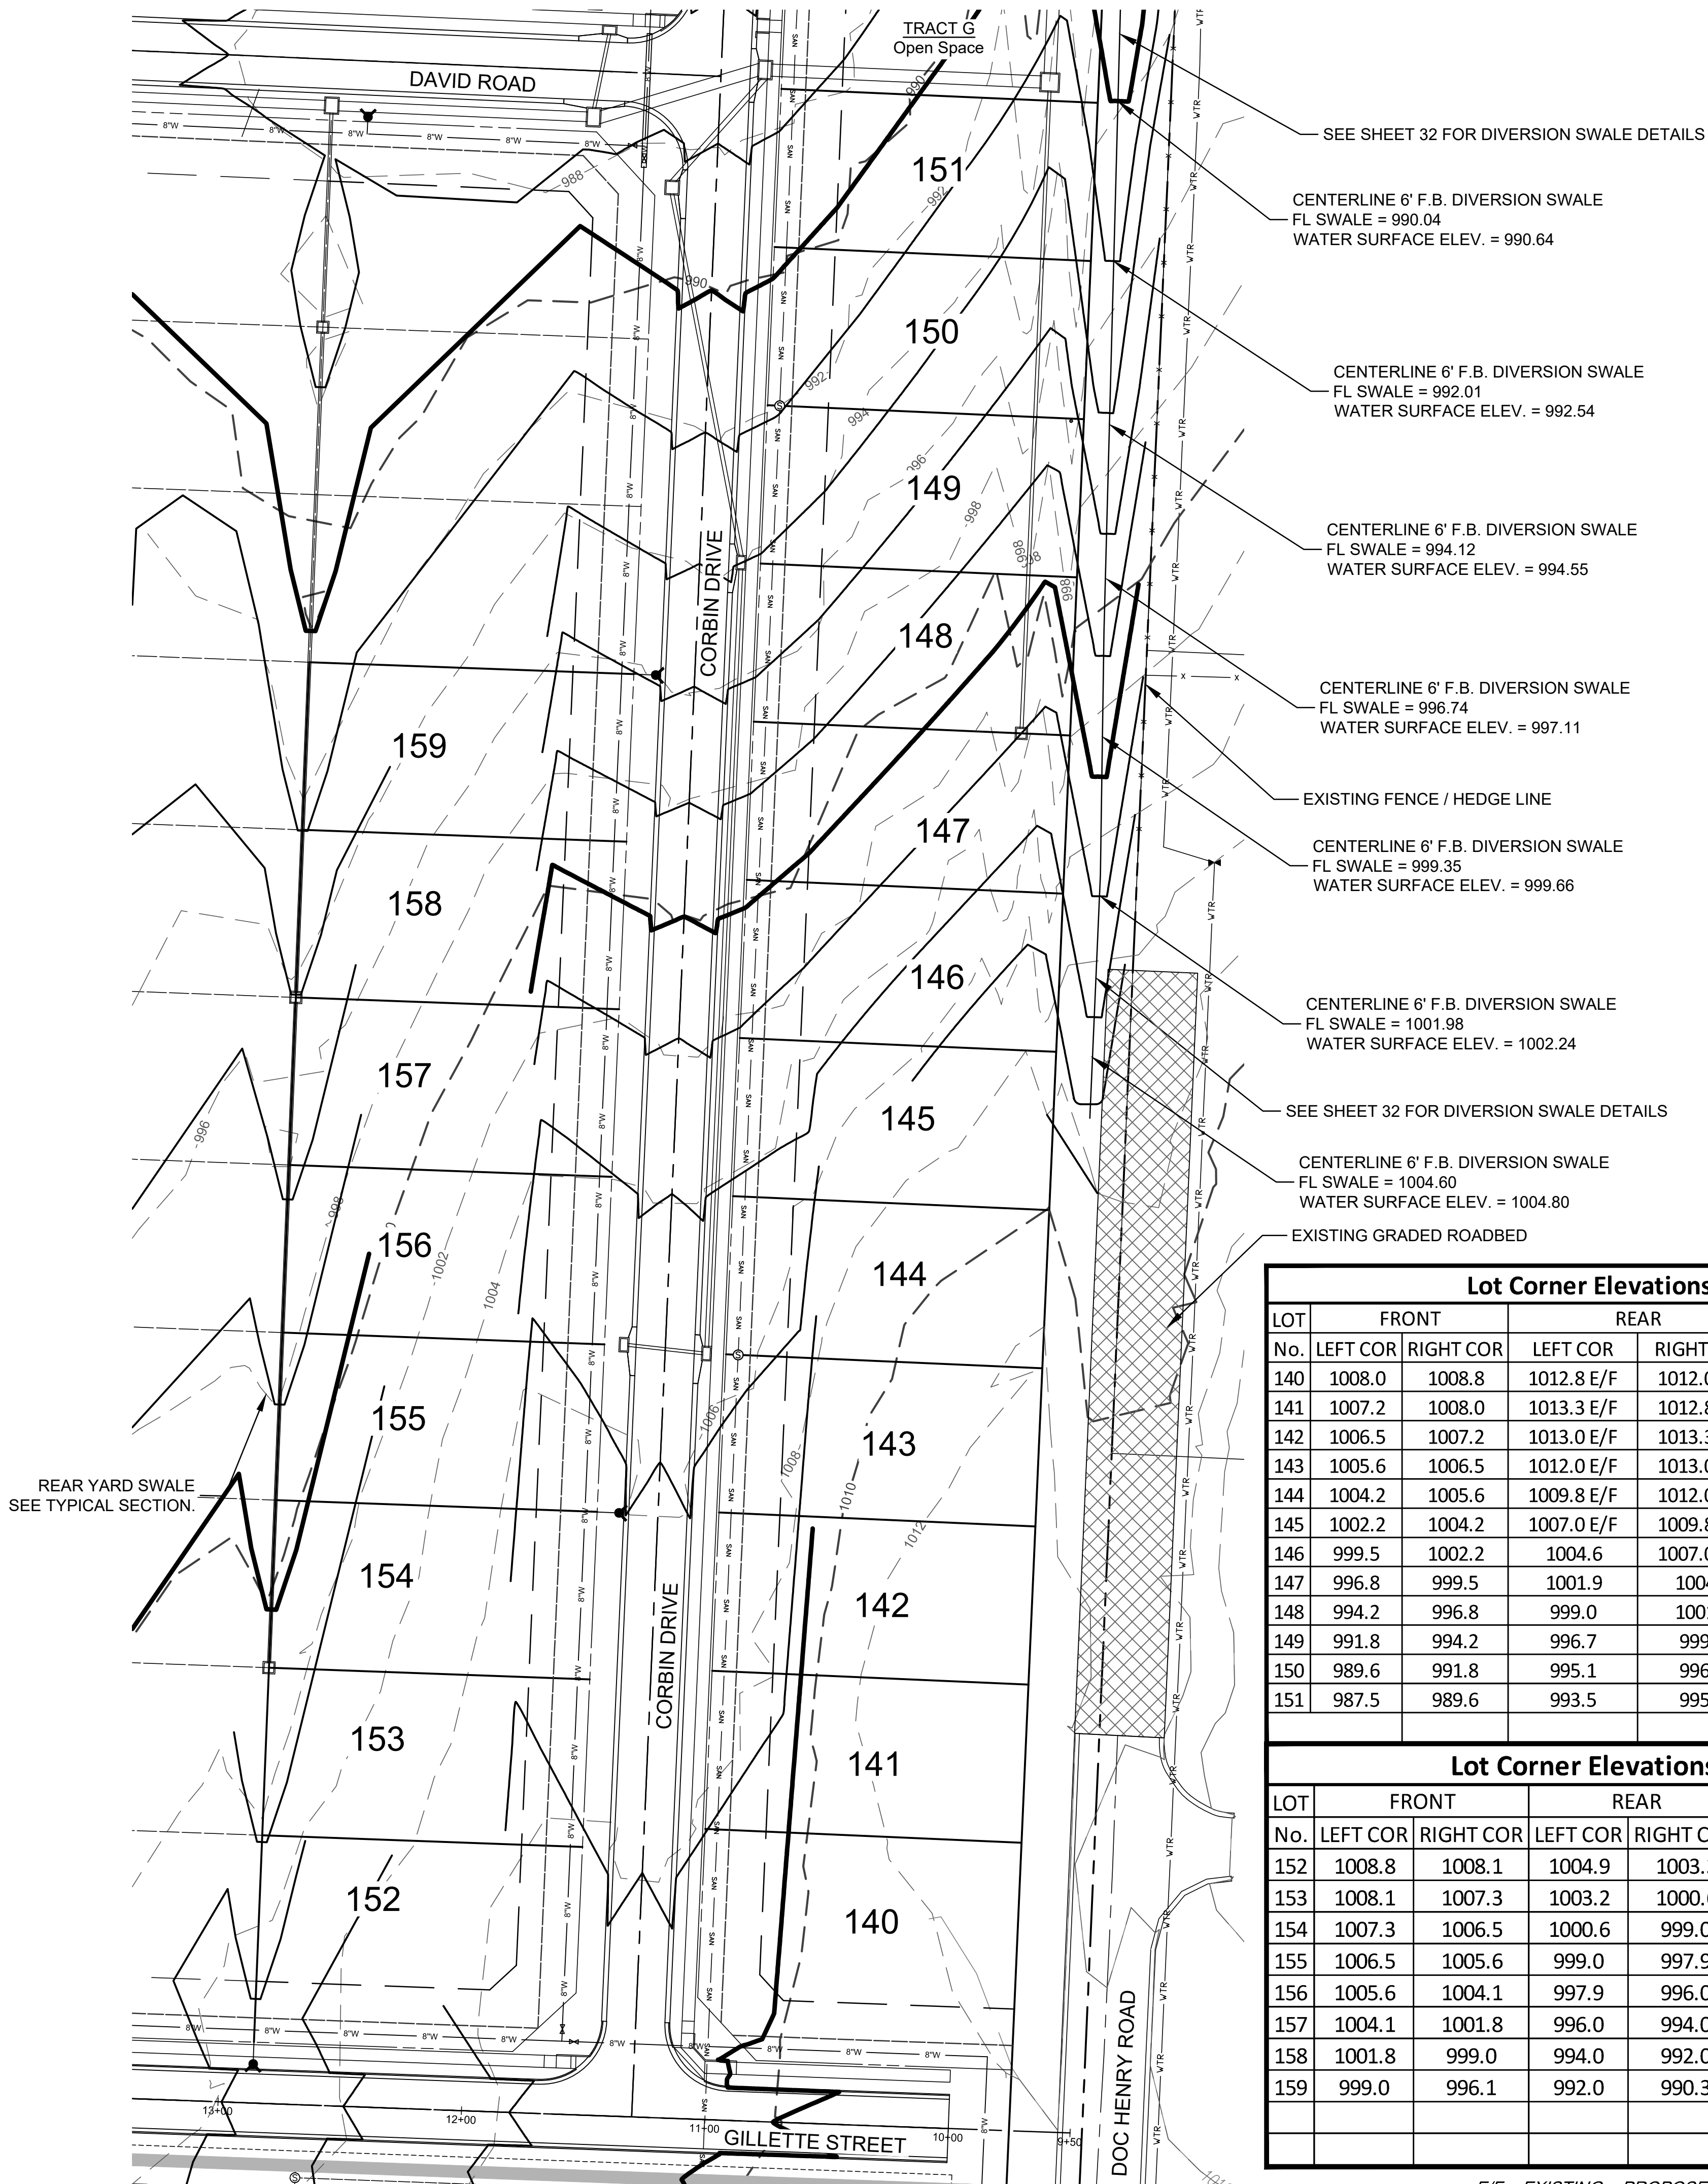

TYPICAL REAR YARD SWALE DETAIL
(NO SCALE)
SWALE CAPACITY AT 2.0% SLOPE = 125 CFS

100 YEAR WATER DEPTH IN SWALE


LOTS: 1, 2, 18, 19, 20 & 21 DEPTH = 0.28'	LOTS: 22, 23, 24, 25, 152 & 153 DEPTH = 0.24'
LOTS: 3, 4, 5, 6, 7, 13, 14, 15, 16, 17, 154, 155, 156 & 157 DEPTH = 0.31'	LOTS: 26, 27, 28, 29, 30, 158 & 159 DEPTH = 0.34'

NOTES:

- 1) Corner descriptions are oriented as if standing on the street facing the lot.
- 2) Conventional basement type indicates windows only above finished basement elevation.
- 3) Walkout basement type was determined by subtracting the 70' lot elevation from the 25' B/L elevation. If the resulting elevation difference was greater than 6 feet it was determined that the buider could make the house a walkout by raising the top of foundation as needed. The intent of the designer was not to force these lots to be walkouts, only to suggest it was possible by raising the top of foundation.
- 4) Daylight basement type was determined by top of foundation being 2 feet above, and the back lot corner of the lot being 3 feet below the front right-of-way elevation on the high side of the lot.
- 5) Corner of house elevations based on top of foundation to be 1 foot above the high side front right-of-way elevation.
- 6) As-graded plot plans shall be required for the following lots: 1-30 and 140-159.
- 7) All proposed swales shall be established during Phase I construction and grading.
- 8) MBOEs are allowed to be interpolated from adjoining lot MBOEs where appropriate.

Lot Corner Elevations and MBOEs							ASBUILT Lot Corner Elevations and MBOEs						
LOT	FRONT		REAR		M.B.O.E.	BASEMENT TYPE	LOT	FRONT		REAR		M.B.O.E.	BASEMENT TYPE
No.	LEFT COR	RIGHT COR	LEFT COR	RIGHT COR			No.	LEFT COR	RIGHT COR	LEFT COR	RIGHT COR		
140	1008.0	1008.8	1012.8 E/F	1012.0 E/F	1014.8	CONVENTIONAL	140	1008.1	1008.8	1012.8 E/F	1012.1 E/F	*	CONVENTIONAL
141	1007.2	1008.0	1013.3 E/F	1012.8 E/F	1015.3	CONVENTIONAL	141	1007.3	1008.1	1013.4 E/F	1012.8 E/F	*	CONVENTIONAL
142	1006.5	1007.2	1013.0 E/F	1013.3 E/F	1015.3	CONVENTIONAL	142	1006.4	1007.3	1013.1 E/F	1013.4 E/F	*	CONVENTIONAL
143	1005.6	1006.5	1012.0 E/F	1013.0 E/F	1015.0	DAYLIGHT	143	1005.6	1006.4	1012.1 E/F	1013.1 E/F	*	DAYLIGHT
144	1004.2	1005.6	1009.8 E/F	1012.0 E/F	1014.0	DAYLIGHT	144	1004.1	1005.6	1009.9 E/F	1012.1 E/F	*	DAYLIGHT
145	1002.2	1004.2	1007.0 E/F	1009.8 E/F	1011.8	DAYLIGHT	145	1002.3	1004.1	1007.0 E/F	1009.9 E/F	*	DAYLIGHT
146	999.5	1002.2	1004.6	1007.0 E/F	1009.0	DAYLIGHT	146	999.6	1002.3	1004.6	1006.9	*	DAYLIGHT
147	996.8	999.5	1001.9	1004.6	1006.6	DAYLIGHT*	147	996.8	999.6	1002.0	1004.6	*	DAYLIGHT
148	994.2	996.8	999.0	1001.9	1003.9	DAYLIGHT*	148	994.2	996.8	999.0	1002.0	*	DAYLIGHT
149	991.8	994.2	996.7	999.0	1001.0	DAYLIGHT	149	991.9	994.2	996.7	1000.4	*	DAYLIGHT
150	989.6	991.8	995.1	996.7	998.7	DAYLIGHT	150	989.6	991.9	995.2	996.7	*	DAYLIGHT
151	987.5	989.6	993.5	995.1	997.1	DAYLIGHT	151	987.5	989.6	993.6	995.2	*	DAYLIGHT
							* = NO MBOE REQUIRED FOR LOT						
Lot Corner Elevations and MBOEs							ASBUILT Minimum Building Opening Elevations						
LOT	FRONT		REAR		M.B.O.E.	BASEMENT TYPE	LOT	FRONT		REAR		M.B.O.E.	BASEMENT TYPE
No.	LEFT COR	RIGHT COR	LEFT COR	RIGHT COR			No.	LEFT COR	RIGHT COR	LEFT COR	RIGHT COR		
152	1008.8	1008.1	1004.9	1003.3	1010.8	DAYLIGHT	152	1008.8	1008.1	1005.0	1003.2	*	DAYLIGHT
153	1008.1	1007.3	1003.2	1000.6	1010.1	DAYLIGHT	153	1008.1	1007.4	1003.2	1000.6	*	DAYLIGHT
154	1007.3	1006.5	1000.6	999.0	1009.3	DAYLIGHT	154	1007.4	1006.6	1000.6	999.0	*	DAYLIGHT
155	1006.5	1005.6	999.0	997.9	1008.5	DAYLIGHT	155	1006.6	1005.6	999.0	997.8	*	DAYLIGHT
156	1005.6	1004.1	997.9	996.0	1007.6	DAYLIGHT	156	1005.6	1004.0	997.8	996.0	*	DAYLIGHT
157	1004.1	1001.8	996.0	994.0	1006.1	DAYLIGHT	157	1004.0	1001.9	996.0	994.1	*	DAYLIGHT
158	1001.8	999.0	994.0	992.0	1003.8	DAYLIGHT	158	1001.9	999.0	994.1	992.0	994.1	DAYLIGHT
159	999.0	996.1	992.0	990.3	1001.0	DAYLIGHT	159	999.0	996.2	992.0	990.4	992.4	DAYLIGHT
							* = NO MBOE REQUIRED FOR LOT						

E/F = EXISTING = PROPOSED DAYLIGHT* = MBOE FOR WALKOUT WITH A WALKUP

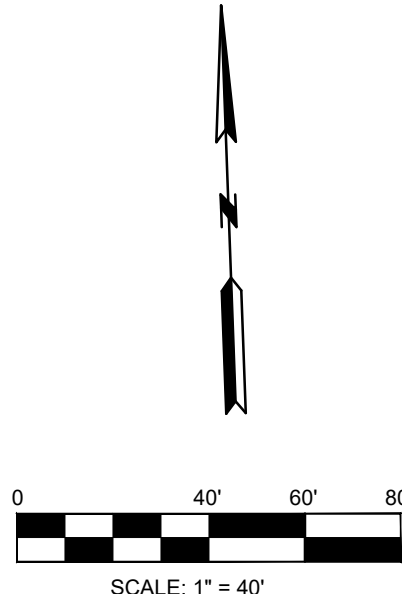

STREET AND STORM SEWER PLANS
MASTER DRAINAGE PLAN
LOT AND FOUNDATION DATA - VILLA LOTS
COBEY CREEK FIRST PLAT
PHASE I
CITY OF LEES SUMMIT, JACKSON COUNTY, MISSOURI

16-059 Base Phase I
DRAWING NO.
16-059 Master Drainage
DATE
March 27, 2019
JOB NO.
16-059

33 SHEET OF 53

STATE OF MISSOURI
Professional Engineer
R. Kevin Sterrett
No. E-26440
May 7, 2021

gconsult
Inc
engineers
planners
11010 Haskell Street, Suite 210, Kansas City, Kansas 66109
CORPORATE LICENSE NO. E201000373 (MO.) / E-1736 (KS.)

Lot Corner Elevations and MBOEs							ASBUILT Lot Corner Elevations and MBOEs						
LOT	FRONT		REAR		M.B.O.E.	BASEMENT TYPE	LOT	FRONT		REAR		M.B.O.E.	BASEMENT TYPE
No.	LEFT COR	RIGHT COR	LEFT COR	RIGHT COR			No.	LEFT COR	RIGHT COR	LEFT COR	RIGHT COR		
1	995.8	994.1	997.2	992.2	999.5	WALKOUT	1	995.9	994.2	997.2	992.2	*	WALKOUT
2	994.1	992.4	992.2	990.2	996.4	WALKOUT	2	994.2	992.5	992.2	990.2	*	WALKOUT
3	992.4	990.5	990.2	988.1	994.4	WALKOUT	3	992.5	990.6	990.2	988.1	*	WALKOUT
4	990.5	989.2	988.1	986.0	992.5	WALKOUT	4	990.6	989.2	988.1	986.1	*	WALKOUT
5	989.2	988.1	986.0	984.5	991.2	WALKOUT	5	989.2	988.1	986.1	984.5	*	WALKOUT
6	988.1	987.3	984.5	983.2	990.1	WALKOUT	6	988.1	987.4	984.5	983.2	*	WALKOUT
7	987.3	986.7	988.2	983.4	989.3	WALKOUT	7	987.4	986.7	983.2	983.5	*	WALKOUT
8	983.6	985.2	989.7	991.7	993.3	DAYLIGHT*	8	983.5	985.3	989.7	991.8	*	DAYLIGHT*
9	982.5	983.6	988.3	989.7	991.5	DAYLIGHT*	9	982.7	983.5	988.2	989.7	*	DAYLIGHT*
10	981.8	982.5	986.8	988.3	990.3	DAYLIGHT*	10	981.6	982.7	986.8	988.2	*	DAYLIGHT*
11	981.0	981.8	987.3	986.8	988.6	DAYLIGHT	11	981.2	981.6	988.5	986.8	*	DAYLIGHT
12	980.3	981.0	985.8	987.3	987.3	DAYLIGHT*	12	980.3	981.2	985.7	988.5	*	DAYLIGHT*
							* = NO MBOE REQUIRED FOR LOT						
Lot Corner Elevations and MBOEs							ASBUILT Lot Corner Elevations and MBOEs						
LOT	FRONT		REAR		M.B.O.E.	BASEMENT TYPE	LOT	FRONT		REAR		M.B.O.E.	BASEMENT TYPE
No.	LEFT COR	RIGHT COR	LEFT COR	RIGHT COR			No.	LEFT COR	RIGHT COR	LEFT COR	RIGHT COR		
13	981.1	981.8	983.4	983.2	985.7	DAYLIGHT	13	981.1	981.9	983.4	983.3	*	DAYLIGHT
14	981.8	982.7	983.2	984.5	986.8	DAYLIGHT	14	981.9	982.8	983.3	984.5	*	DAYLIGHT
15	982.7	983.6	984.5	985.9	988.2	DAYLIGHT	15	982.8	983.7	984.5	986.0	*	DAYLIGHT
16	983.6	984.5	985.9	987.9	990.2	DAYLIGHT	16	983.7	984.6	986.0	988.0	*	DAYLIGHT
17	984.5	986.4	987.9	990.0	992.3	DAYLIGHT	17	984.6	986.5	988.0	990.0	*	DAYLIGHT
18	986.4	989.1	990.0	991.6	993.9	DAYLIGHT	18	986.5	989.2	990.0	991.7	*	DAYLIGHT
19	989.1	992.3	991.6	993.7	996.0	CONVENTIONAL	19	989.2	992.3	991.7	993.8	*	CONVENTIONAL
20	992.3	994.6	993.7	996.6	998.9	CONVENTIONAL	20	992.3	994.6	993.8	996.5	*	CONVENTIONAL
21	994.6	996.8	996.6	999.1	1001.4	CONVENTIONAL	21	994.6	996.8	996.5	999.1	*	CONVENTIONAL
												* = NO MBOE REQUIRED FOR LOT	
Lot Corner Elevations and MBOEs							ASBUILT Lot Corner Elevations and MBOEs						
LOT	FRONT		REAR		M.B.O.E.	BASEMENT TYPE	LOT	FRONT		REAR		M.B.O.E.	BASEMENT TYPE
No.	LEFT COR	RIGHT COR	LEFT COR	RIGHT COR			No.	LEFT COR	RIGHT COR	LEFT COR	RIGHT COR		
22	995.9	994.6	1000.3	996.7	1002.6	CONVENTIONAL	22	996.6	994.7	1000.4	996.7	*	CONVENTIONAL
23	994.6	992.3	996.7	994.0	999.0	CONVENTIONAL	23	994.7	992.3	996.7	993.9	*	CONVENTIONAL
24	992.3	989.1	994.0	990.8	996.3	WALKOUT	24	992.3	989.0	993.9	990.9	*	WALKOUT
25	989.1	986.4	990.8	988.1	993.1	WALKOUT	25	989.0	986.5	990.9	988.1	*	WALKOUT
26	986.4	984.5	988.1	986.3	990.5	WALKOUT	26	986.5	984.5	988.1	986.2	*	WALKOUT
27	984.5	983.6	986.3	983.9	988.7	WALKOUT	27	984.5	983.7	986.2	984.0	*	WALKOUT
28	983.6	982.7	983.9	982.3	986.3	WALKOUT	28	983.7	982.8	984.0	982.3	*	WALKOUT
29	982.7	981.8	982.3	980.8	984.7	DAYLIGHT*	29	982.8	981.8	982.3	980.7	*	DAYLIGHT*
30	981.8	981.0	980.8	980.3	983.8	DAYLIGHT*	30	981.8	980.9	980.7	980.3	*	DAYLIGHT*
												* = NO MBOE REQUIRED FOR LOT	

E/F = EXISTING = PROPOSED DAYLIGHT = MBOE FOR WALKOUT WITH A WALKUP*

DATE	REVISION	NO.	BY	CK/APP
06/07/21	PER AGREED EXEMPTION FROM CITY OF GREENWOOD	3	SPW	RNS
06/27/19	PER CITY COMMENTS	2	SPW	RNS
06/08/19	PER CITY COMMENTS	1	SPW	RNS
11/27/19	SUBMITAL TO CITY OF LEES SUMMIT		SPW	RNS

IF THIS IS NOT A BLUE INK SEAL AND THE SIGNATURE IN BLUE INK, THE PLAN IS A COPY AND ANY CONTAINED UNAUTHORIZED ALTERATIONS. THE CERTIFICATION CONTAINED ON THIS DOCUMENT SHALL NOT APPLY TO ANY COPIES



R. KEVIN STERRETT | MO E-26440
May 7, 2021

g Consult
Inc engineers planners
111010 Haskell Street, Suite 210, Kansas City, Kansas 66109
CORPORATE LICENSE NO. E201000373 (MO.) / E-1736 (KS.)

STREET AND STORM SEWER PLANS
MASTER DRAINAGE PLAN
LOT AND FOUNDATION DATA - R-1 LOTS
COBEY CREEK FIRST PLAT
PHASE I
CITY OF LEES SUMMIT, JACKSON COUNTY, MISSOURI