



1. Contractor is responsible for verifying all existing utility locations prior to excavation
2. There are no known natural or artificial water storage detention areas, or wetlands in the area designated for construction
3. No part of the project lies within the 100 year flood plain
4. All erosion and sediment control measures need to be implemented prior to construction
5. Additional erosion control may be required by the City Engineer, Design Engineer or Owner at any time problematic areas are noted in the field or existing measures are found to be ineffective
6. Soil Stabilization of disturbed areas shall be completed within 14 days of construction completion
7. Contractor responsible for all density testing of roadway subgrade and granular base.



NOTE: Swale should be lined with "Straw with Net" turf reinforcement (Curlex Blanket or Eqv.) .
Per Table 5607-1 in APWA Manual



900.10
~~900.00~~ Indicates data replaced with "As-Built"
information. All other data is as designed
and has not been field verified.

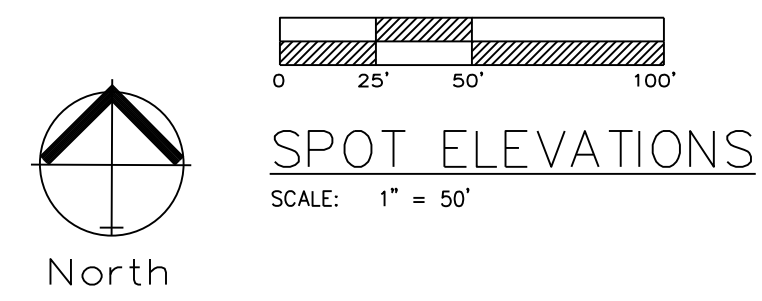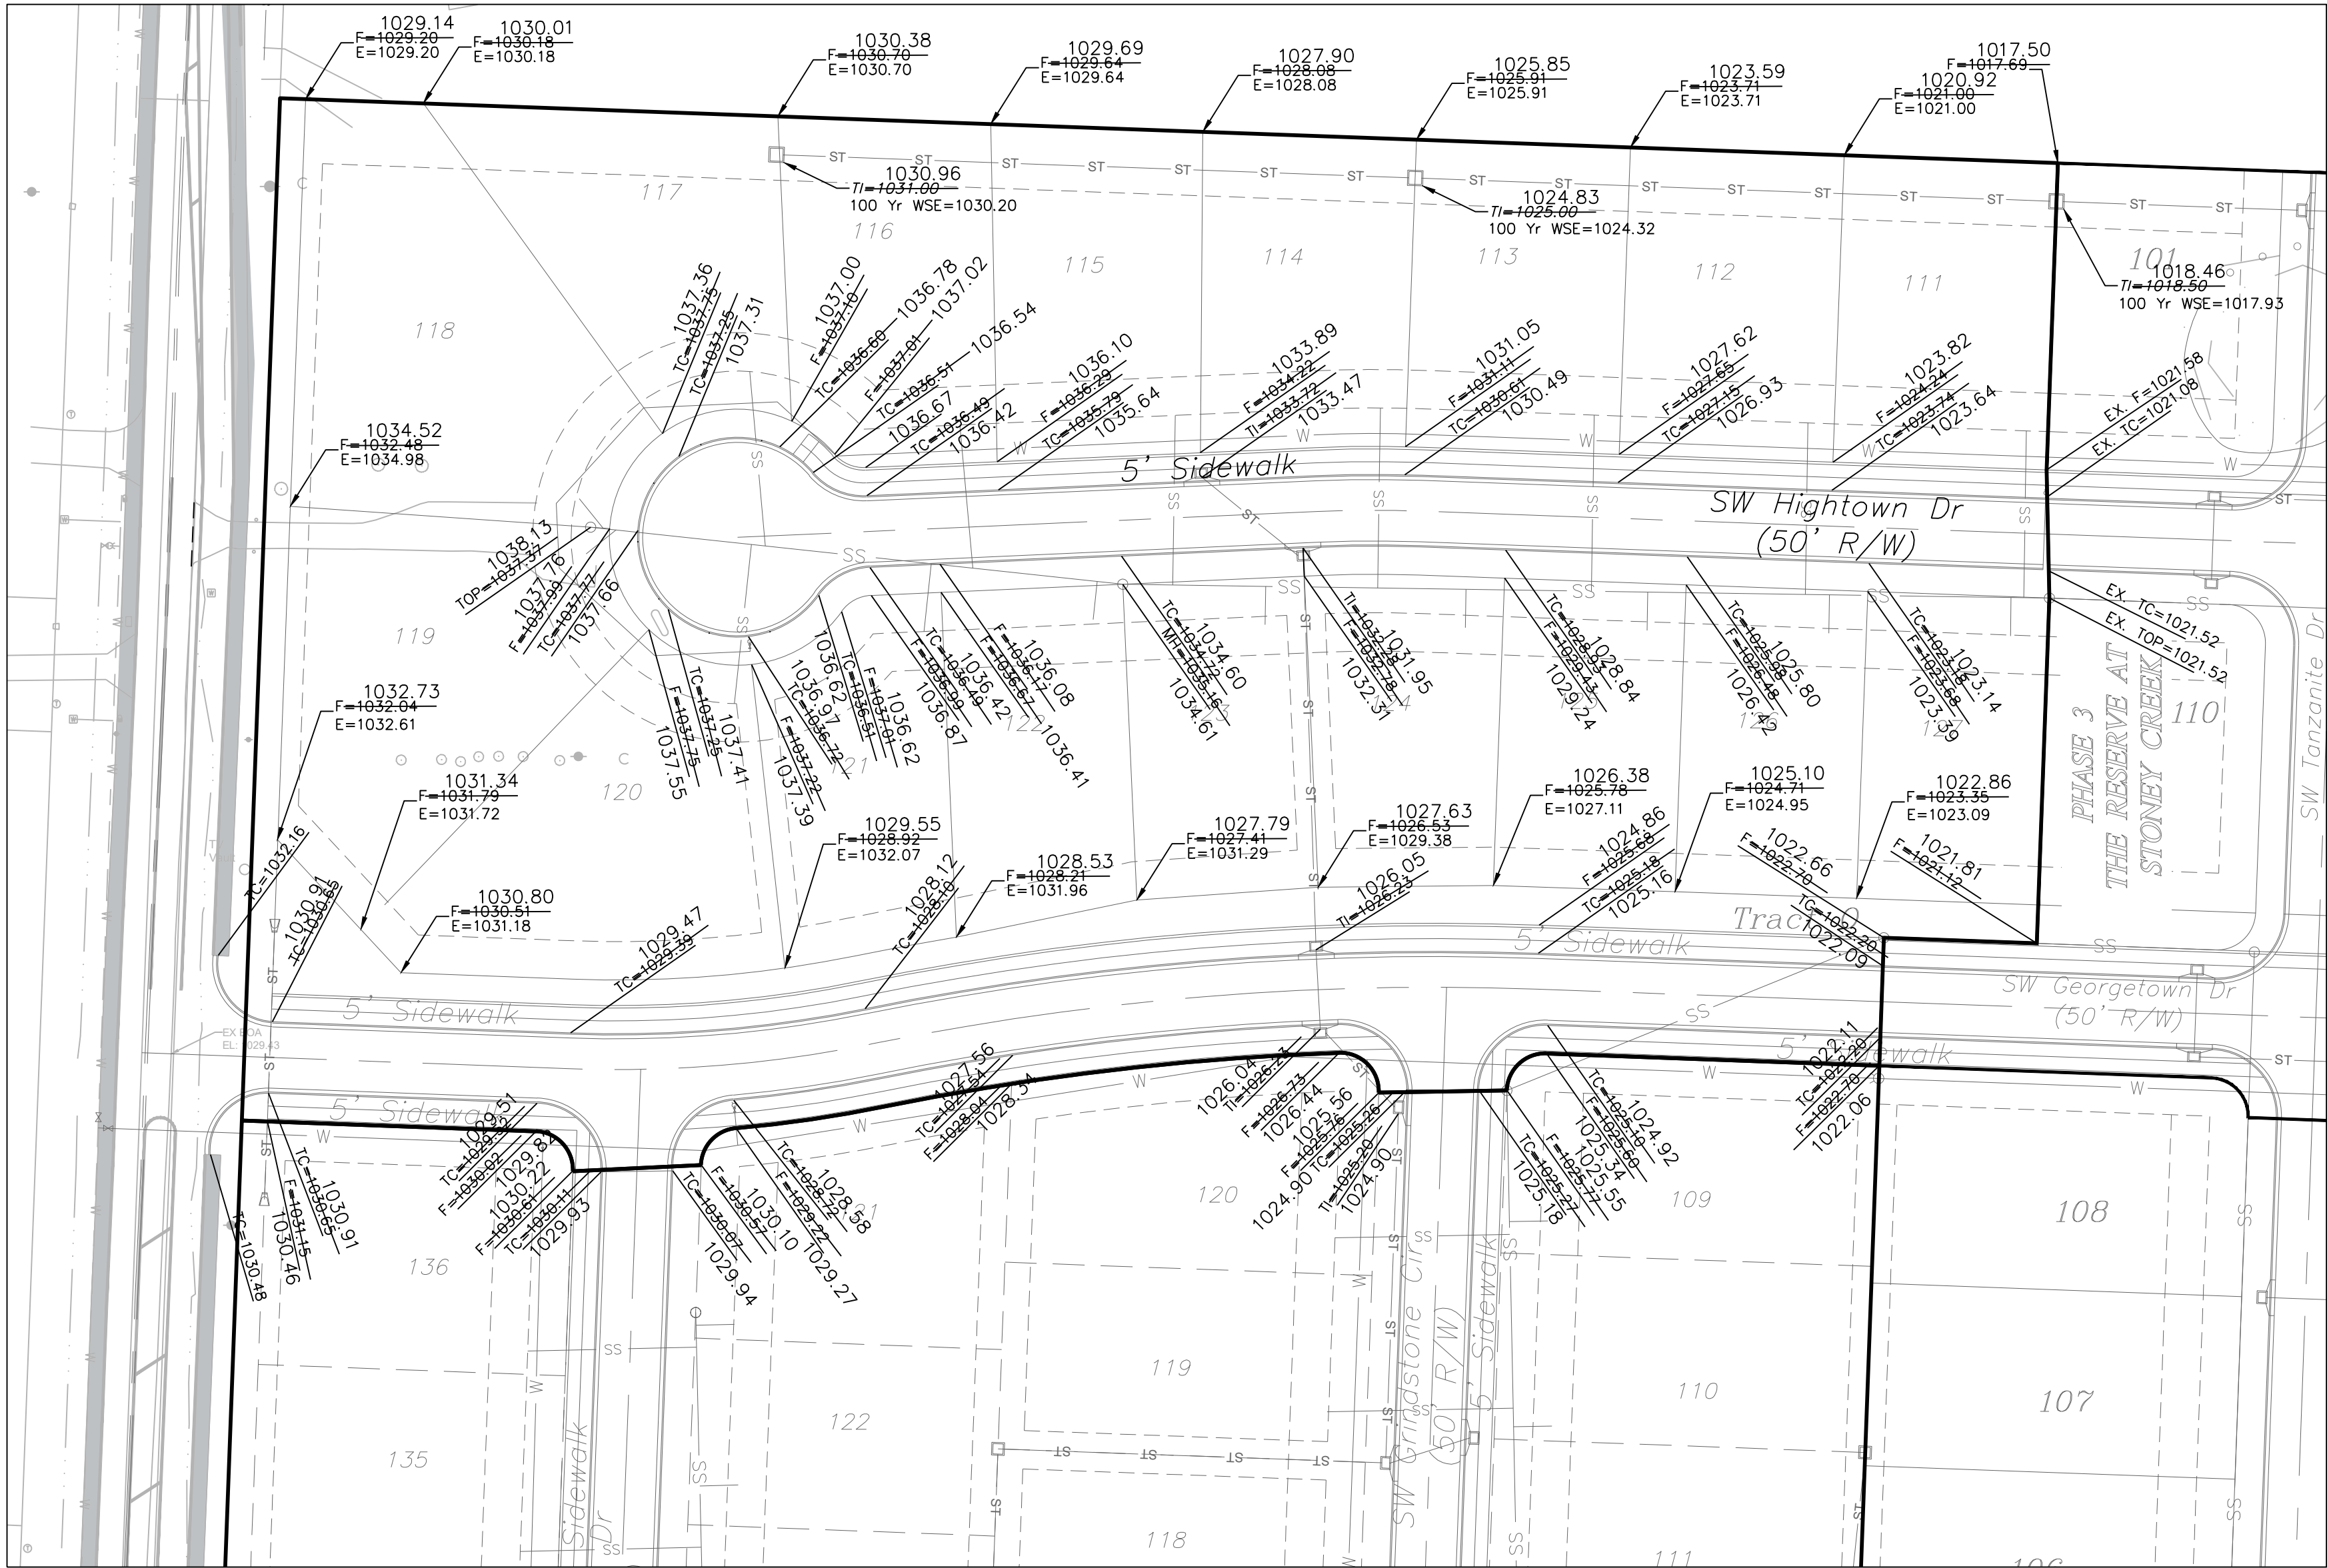

Lot Number	Basement Type	MBOE (Left Rear)	MBOE (Right Rear)
111	Full/Daylight	1022.04	1019.93
112	Daylight/Walkout	1024.21	1022.04
113	Walkout	1026.32	1024.21
114	Walkout	1028.26	1026.32
115	Walkout	1030.26	1028.26
116	Walkout	1032.20	1030.26
117	Walkout	1031.18	1032.20
118	Daylight/Walkout	1034.31	1031.18
119	Daylight/Walkout	1033.60	1034.31
120	Walkout	1034.40	1033.60
121	Walkout	1033.36	1034.40
122	Walkout	1031.52	1033.36
123	Daylight	1029.81	1031.52
124	Daylight	1028.15	1029.81
125	Daylight	1026.32	1028.15
126	Full	1024.44	1026.32
127	Full	1022.58	1024.44

ENGINEERING SOLUTIONS

ENGINEERING & SURVEYING

50 SE 30TH STREET
LEES SUMMIT, MO 64082
P: (816) 623-9888 F: (816) 623-9849

Professional Registration

Missouri
Engineering 2005002188-D
Surveying 200500319-D

Kansas
Engineering E-1895
Surveying LS-218

Oklahoma
Engineering 6254

Nebraska
Engineering CA2821

The Reserve at Stoney Creek - 4th Plat
Lee's Summit, Jackson County, Missouri

Project: RESERVE AT STONEY CREEK, 4TH PLAT
August 1, 2018

Master Drainage Plan 2 of 3:
Spot Elevations
Construction Plans for:
The Reserve at Stoney Creek - 4th Plat
Lee's Summit, Jackson County, Missouri



Matthew J. Schlicht
MO PE 2006019708
KS PE 19071
OK PE 25226

REVISIONS

5/21/2021 As-Built

"AS-BUILT"

900.10
~~900.00~~ Indicates data replaced with "As-Built" information. All other data is as designed and has not been field verified.

C. 201

