



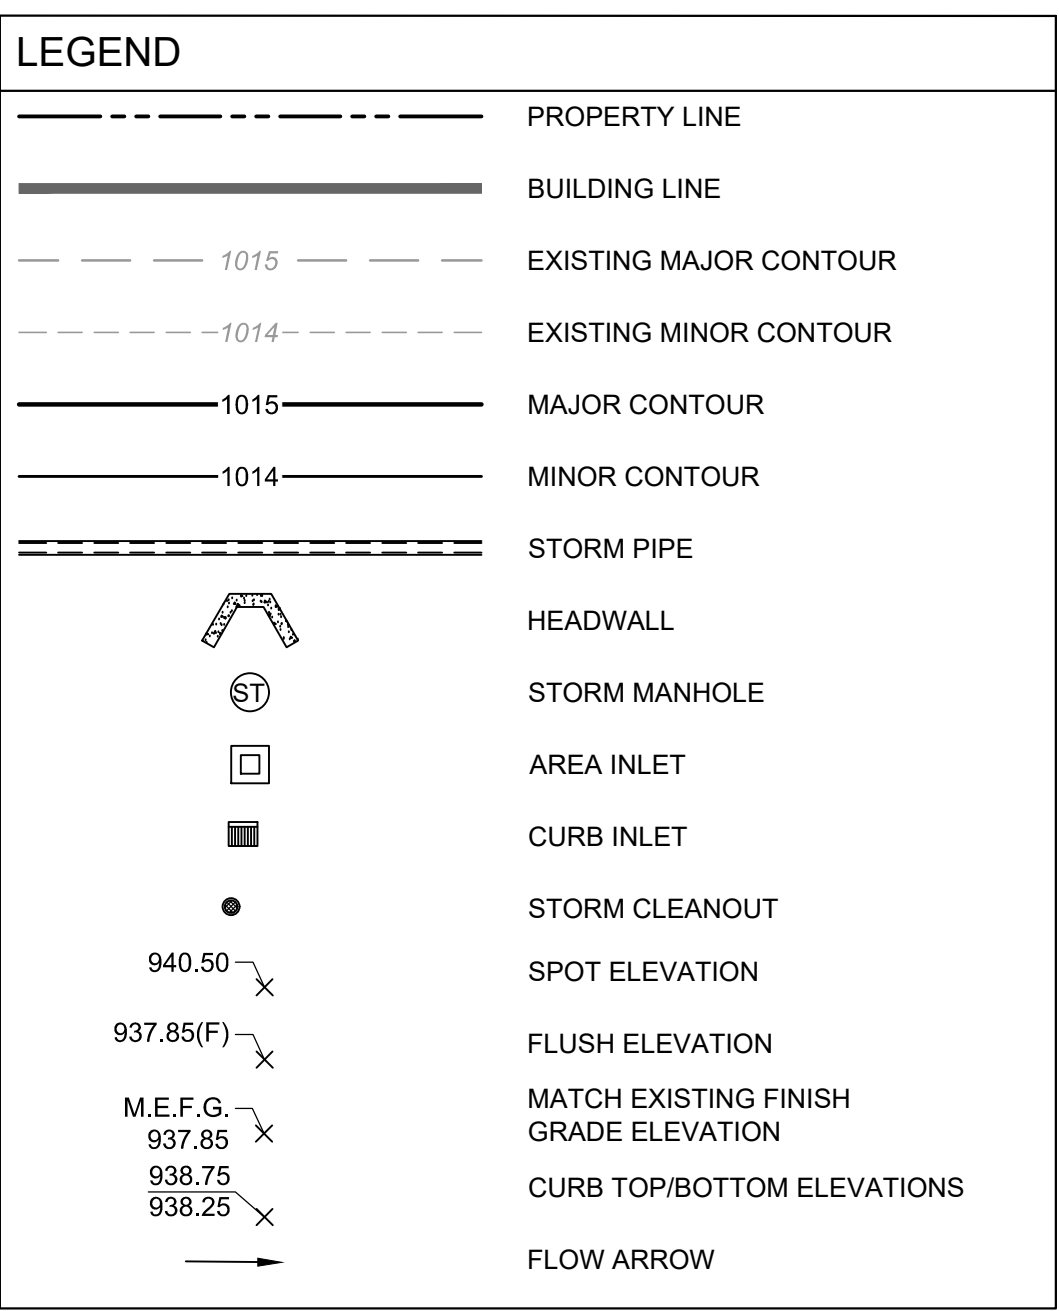

<u>STORM STRUCTURE ABBREVIATIONS</u>		
(SCI)	SINGLE CURB INLET	DETAIL 06, SHEET C901
(JB)	JUNCTION BOX	DETAIL 09, SHEET C902
(HW)	HEADWALL	DETAIL 07, SHEET C901
(OS)	OUTLET STRUCTURE	DETAIL 08, SHEET C901

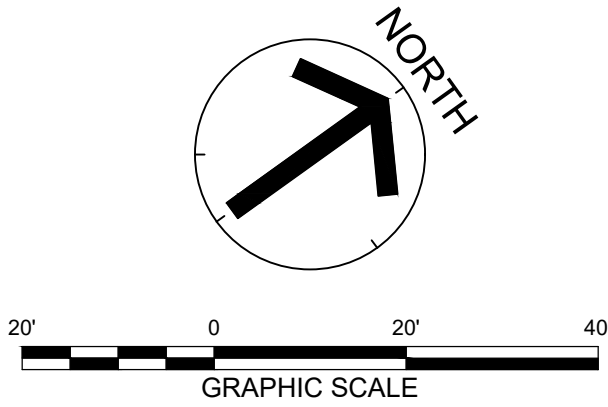

NOTES:

1. FOR SITE PREPARATION AND GEOTECHNICAL RECOMMENDATIONS, REFER TO INTERTEK PSI GEOTECHNICAL REPORT 03381947, DATED 7/24/2019.
ITEMS IN RED AND CLOUDED IN RED INDICATE AS BUILT CONDITIONS.
3. **ITEMS IN BLUE AND CLOUDED IN BLUE INDICATE AS BUILT FIX. ONCE FIX IS COMPLETED, PROVIDE TOPO SURVEY OF THE ENTIRE SITE INCLUDING PARKING, BUILDING FFE, AREA INLET TOP OF CASTING, POND, POND STRUCTURE INVERTS AND DIMENSIONS.**



GreshamSmith.com

222 Second Avenue South
Suite 1400
Nashville, TN 37201


615.770.8100



Firestone
COMPLETE AUTO CARE™

3561 SW MARKET STREET
LEE'S SUMMIT, MISSOURI 64082

THIS DRAWING IS THE PROPERTY OF BRIDGESTONE RETAIL OPERATIONS, LLC AND IS LOANED ON THE EXPRESS CONDITION THAT IT IS NOT TO BE USED IN ANY WAY DELETERIOUS TO THE INTERESTS OF BRIDGESTONE RETAIL OPERATIONS, LLC. THE ACCEPTANCE OF THIS DRAWING WILL BE CONSTRUED AS AN ACCEPTANCE OF THE FOREGOING CONDITION AND AS ADMISSION TO THE EXCLUSIVE OWNERSHIP IN AND TO THE DRAWING BY BRIDGESTONE RETAIL OPERATIONS, LLC.

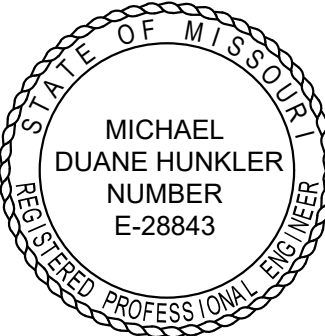[illegible]

STORM PLAN AND PROFILE

C301

40831.45
JANUARY 8, 2020