

Summit Point Apartments, Phase-II
504 NE Chipman Road
Lee's Summit, Missouri 64063
CFS Project No. 21-5065/19-5293

SW ¼, Section 32 Township 48 North, Range 31 West
Jackson County, Missouri
Tributary P3 to Prairie Lee Lake Watershed

HEC-RAS Analysis of Tributary P3 To Prairie Lee Lake

Prepared for:
Canyon View Properties
David Smith
331 Soquel Avenue
Santa Cruz, California 95052
(831) 480-6336

Prepared by:
Cook, Flatt and Strobel Engineers, P.A.
1421 E 104th Street, Suite 100
Kansas City, Missouri 64131

April 21, 2021



HEC-RAS Analysis of Tributary P3 To Prairie Lee Lake
Adjacent to the Proposed Summit Point Apartments, Phase-II
504 NE Chipman Road
City of Lee's Summit, Jackson County, Missouri 64063
CFS Project #21-5065 / #19-5293
April 21, 2021

General: The owners of the proposed Summit Point Apartments at 504 NE Chipman Road have proposed to develop the Phase-II of the site. The Phase-II addition would be constructed directly to the north of the existing Phase-I apartments located at 504 NE Chipman Road in Lee's Summit, Missouri. Phase I included five multi-unit apartment buildings plus a swimming pool on a 6.49 acre site constructed in 1980. The proposed Phase-II addition would cover 7.21 acres and include six new multi-apartment buildings along with parking lots and service drives.




Vicinity Map of the Summit Point Apartments at 504 NE Chipman Road in Lee's Summit

The site slopes downwards to the north where an existing creek (Tributary P3 to Prairie Lee Lake) flows eastwards along the site's northern boundary. The existing creek has flowline elevations ranging between approximately 994' to 1000' along the northern side of the Summit Point Apartments, Phase II. NE Swann Circle is located directly to the east of Summit Point and NE Independence Avenue is located approximately 800 ft downstream. The creek crossing at NE Swann Circle has triple 48" HDPE culverts have upstream flowline elevations of approximately 986.91' and the top of the roadway

has an overflow elevation of approximately 994'. The creek bed upstream of NE Swann Circle serves as a stormwater detention basin for the Maple Tree Manor subdivision.

NE Independence Avenue is located approximately 1000 ft downstream from NE Swann Circle downstream and has a single 48" RCP culvert with an upstream flowline elevation of approximately 979.25' and an overflow elevation across the top of NE Independence Avenue of approximately 985.41'. The creek bed upstream of NE Independence Avenue serves as a stormwater detention basin for the Maple Tree Manor subdivision.

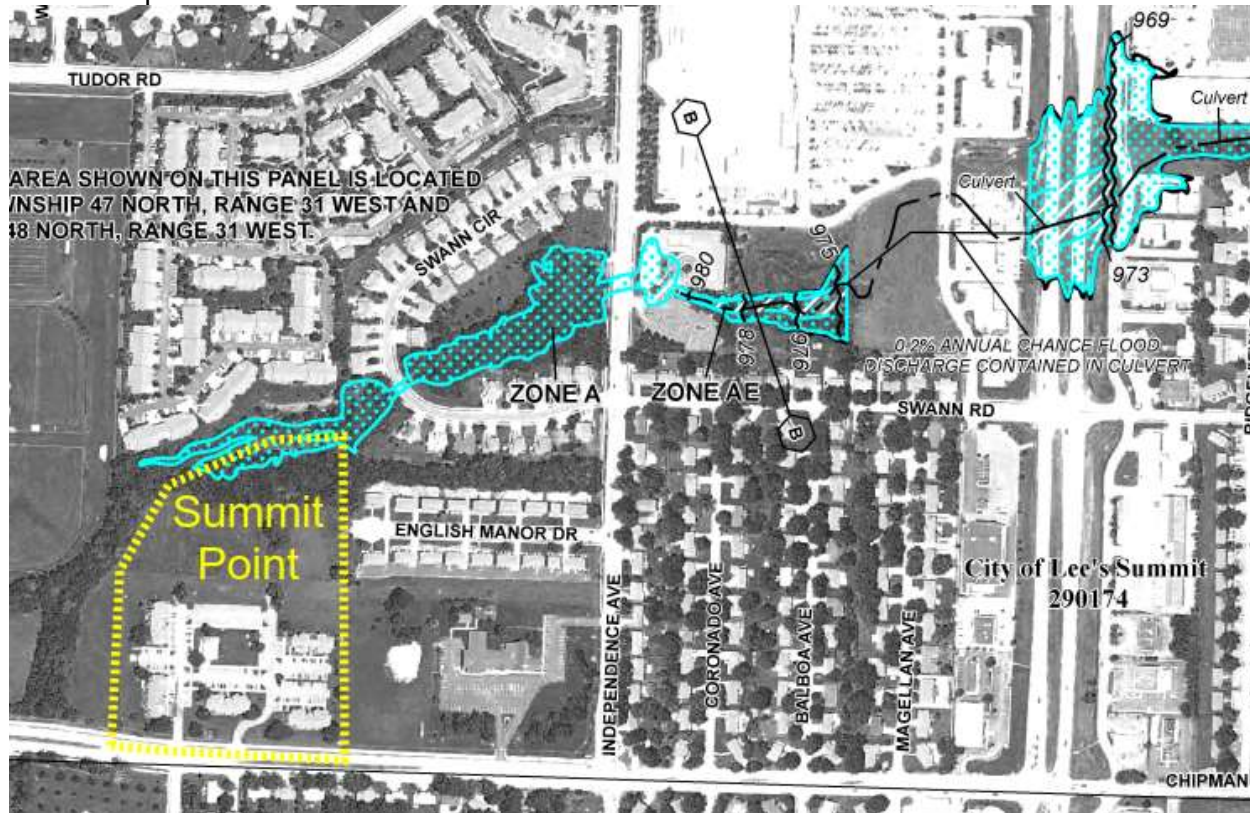

FEMA FIRM Flood Map 29095C0436G, Showing the Existing Tributary P3 to Prairie Lee Lake Flowing along the Northern Border of the Summit Point Apartments


The FEMA flood map shows the defined 1% (100-year) flood elevations to the east along the creek stop short of Independence Avenue. A portion of the northern side of the site is within the FEMA 1% (100-year) floodplain, with the remaining ground above the flood limits.

HEC-RAS Analysis: CFS Engineers created a HEC-RAS model to evaluate the water surface elevations of stormwater in the Tributary P3 to Prairie Lee Lake creek channel along the north side of the proposed Summit Point Apartments, Phase II site. Stream flows were calculated at four locations along the northern property line and where the creek crosses NE Swann Circle and NE Independence Avenue.

Drainage areas were estimated using the City GIS mapping. Channel cross-sections for the HEC-RAS models were cut across the surveyed ground surface, based on a recent topographic field survey of the site performed by CFS Engineers. The FEMA FIRM Flood Map of the region (FEMA FIRM Flood Map 29095C0436G, Panel 436 of 625, January 20, 2017), shows the Tributary P3 to Prairie Lee Lake directly to the north of the site as Zone A, defined as a Special Flood Hazard Area subject to inundation

by the 1% annual chance flood where no base flood elevations have been determined. The time of concentration for each drainage basin was determined using TR-55 methodology for overland flow, shallow concentrated flow and channelized flow segments. Estimates of flow path length and slope were estimated using Jackson County GIS topography and the USGS Quadrangle maps of the vicinity. The USGS StreamStats web-based hydrologic analysis program was used to check the contributing drainage areas to the points of interest along the creek. The StreamStat flows appeared to be overly conservative when checked against the flows calculated using the conventional TR-55 methodologies. Calculations have been included in the appendix.

The existing triple 48" HDPE culverts at NE Swann Circle and the existing 48" RCP culvert at NE Independence Avenue were also included in the HEC-RAS model to evaluate the potential back-up of flood water in the creek from the culvert crossings. Channel cross-sections were cut along the Summit Point Apartments, Phase-II site, and additional cross-sections were cut downstream to model the NE Swann Circle and NE Independence Avenue culverts. CFS surveyors measured the invert elevations of all three 48" HDPE culverts along with the top of road elevation at NE Swann Circle. Available storm sewer as-built plans were used to model the existing 48" RCP culvert at NE Independence Avenue.

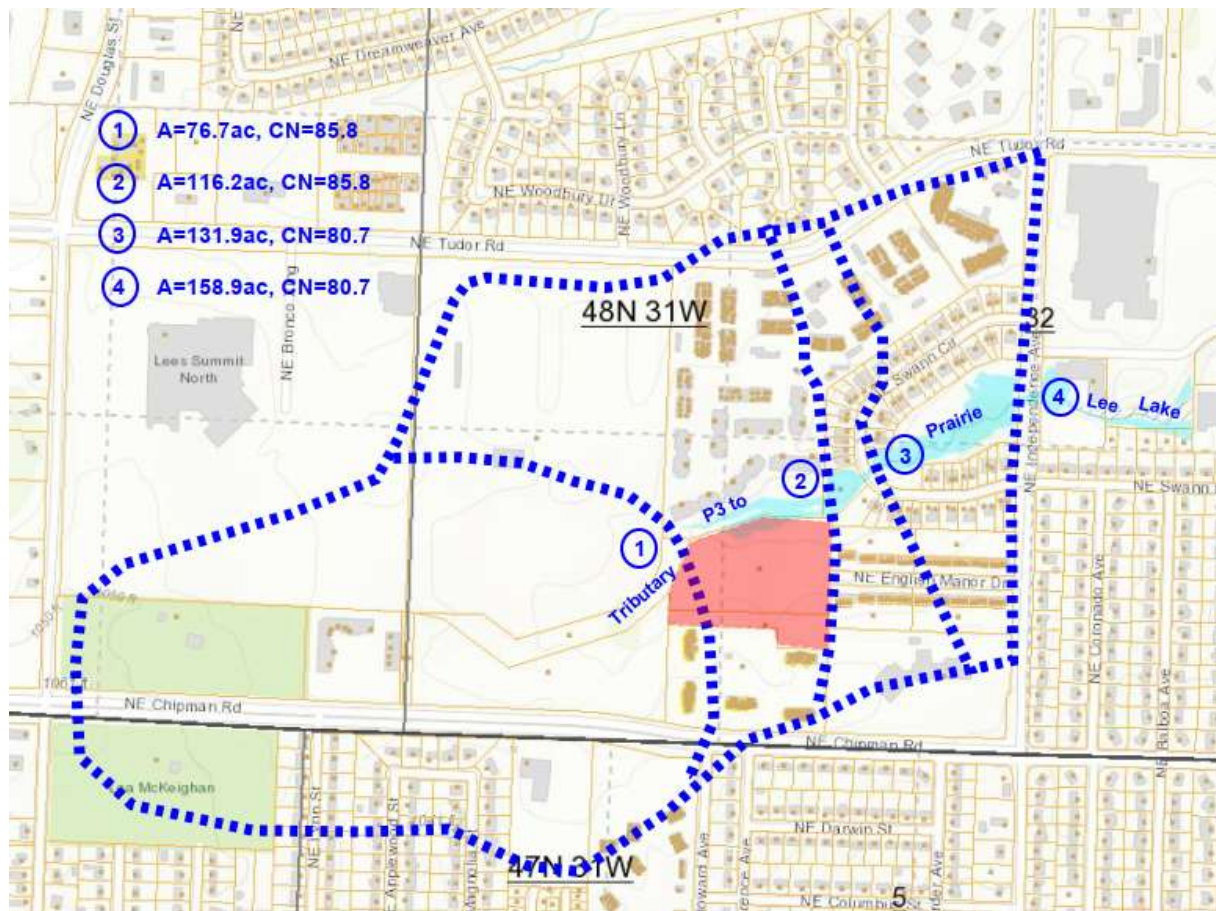

Schematic Off-Site Drainage Area Map for Tributary P3 to Prairie Lee Lake

The CFS survey topography was used to cut cross-sections for the HEC-RAS models. Jackson County GIS topography was also used to supplement the cross-section data outside of the limits of the CFS survey. Manning's roughness factors for the main channel and overbank areas were assumed based on photos and field observations of the creek. A roughness factor of $n=0.030$ was used for the main channel that was generally clean, straight and full with no rifts or deep pools. A roughness factor of

$n=0.060$ was used for the left and right overbanks that generally consisted of light brush and trees under summer conditions.

Cross-sections were cut across the digital contours to set the station-elevations. The cross-sections in the river channel were stationed based on an assumed 10000 ft at the point where the centerline of NE Swann Circle crossed the Tributary P3 to Prairie Lee Lake creek. The left and right stream bank locations were set based on the apparent break in slope locations along the sides of the main creek channel. The main channel lengths were based on the digital alignment of the creek's flowline and the left and right overbank lengths were estimated based on the general curvature of the creek alignment.

Current Effective Model: There was no readily available HEC-RAS model of Tributary P3 to Prairie Lee Lake. The FEMA FIRM flood map showed the creek within the limits of Zone AE on the eastern/downstream side of NE Independence Avenue, located approximately 900 ft downstream from the Summit Point site. The flood map showed that the creek along the northern side of Summit Point, was set inside Zone A where the defined base flood elevations were not determined. This indicates that the detailed HEC-RAS model of the Tributary P3 to Prairie Lee Lake stopped short of NE Independence Avenue and did not extend upstream to cover the Summit Point site.



Duplicate Effective Model: CFS Engineers created a HEC-RAS model using the recent topographic survey and the Jackson County GIS data. The cross-sections cut along the northern side of the Summit Point site and other cross-sections cut further downstream to model the NE Swann Circle roadway crossing and the NE Independence Avenue roadway crossing. The methods for setting the left and right bank stations and overbank lengths were described above. RS 8693.92 was the furthest downstream located approximately 530 ft downstream from the centerline of NE Independence Avenue. RS 11275.44 was the furthest upstream located on the western side of the Summit Point site. The stream flows for the 2 year storm ranged from 144 cfs at the lower end of the creek by NE Independence Avenue, to 77 cfs at the upstream end. Likewise, the 10-year stream flows ranged from 273 cfs to 146 cfs, and the 100-year stream flows ranged from 485 cfs to 264 cfs. The channel slope averaged approximately 1.1%. 100-year flow depths along the Summit Point site ranged from 2.58 ft to 4.42 ft, with corresponding flow velocities ranging from 3.52 fps to 6.78 fps.

Alternate Scenario Model for Clogged Independence Avenue Culvert: Using the Duplicate Effective Model, CFS modified the model to change the 48" diameter RCP culvert at Independence Avenue to a 6" diameter pipe for the purpose of simulating a clogged culvert condition. With the dramatically reduced culvert size, the heavier stream flows would overtop the roadway and increase the backwater depth at the Swann Circle culvert crossing. The reason for performing the scenario was two-fold.

The first reason was that the available record construction plans for Independence Avenue showed a 48" RCP culvert under the roadway connecting into a 54" RCP before discharging into the open creek, and the City's current digital stormwater utility data showing that two 24" diameter pipes were installed downstream from the existing 48" RCP and 54" RCP. While the configuration of installing two 24" pipes downstream from a 54" makes little hydraulic sense, it could have been done purposely to constrict the channel flow and store runoff in the channel upstream of Independence Avenue. Since the Independence Avenue channel crossing was over 1000' downstream from the Summit Point site, CFS Engineers did not survey the area.

The second reason for performing the clogged Independence Avenue culvert scenario was to model the worst-case conditions where the stream flow would be forced to overtop the roadway and possibly cause an increased tailwater backup at the Swann Circle culvert and higher WSEL's along the Summit Point site. After running the clogged Independence Avenue culvert scenario, it was found that the increased downstream tailwater depth had negligible impact on the WSEL's, and that the base flood elevations were unaffected along the Summit Point site.

PRELIMINARY PLAN
SUMMIT POINT 2nd PLAT
LEE'S SUMMIT, MISSOURI

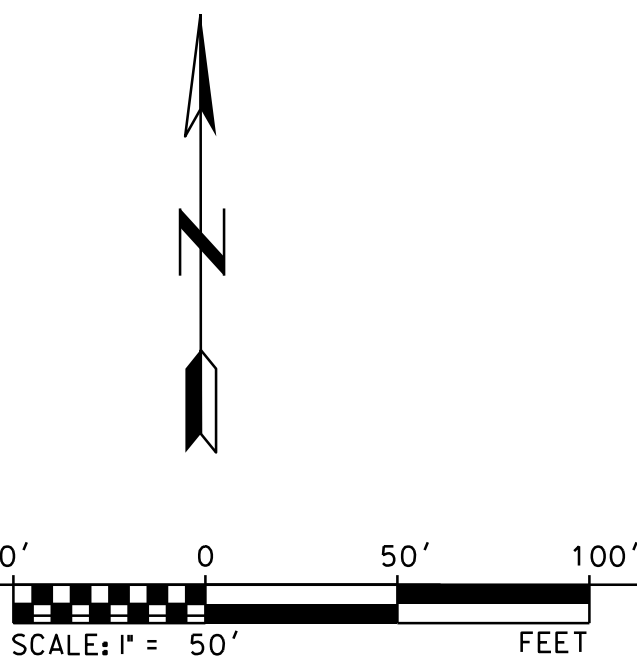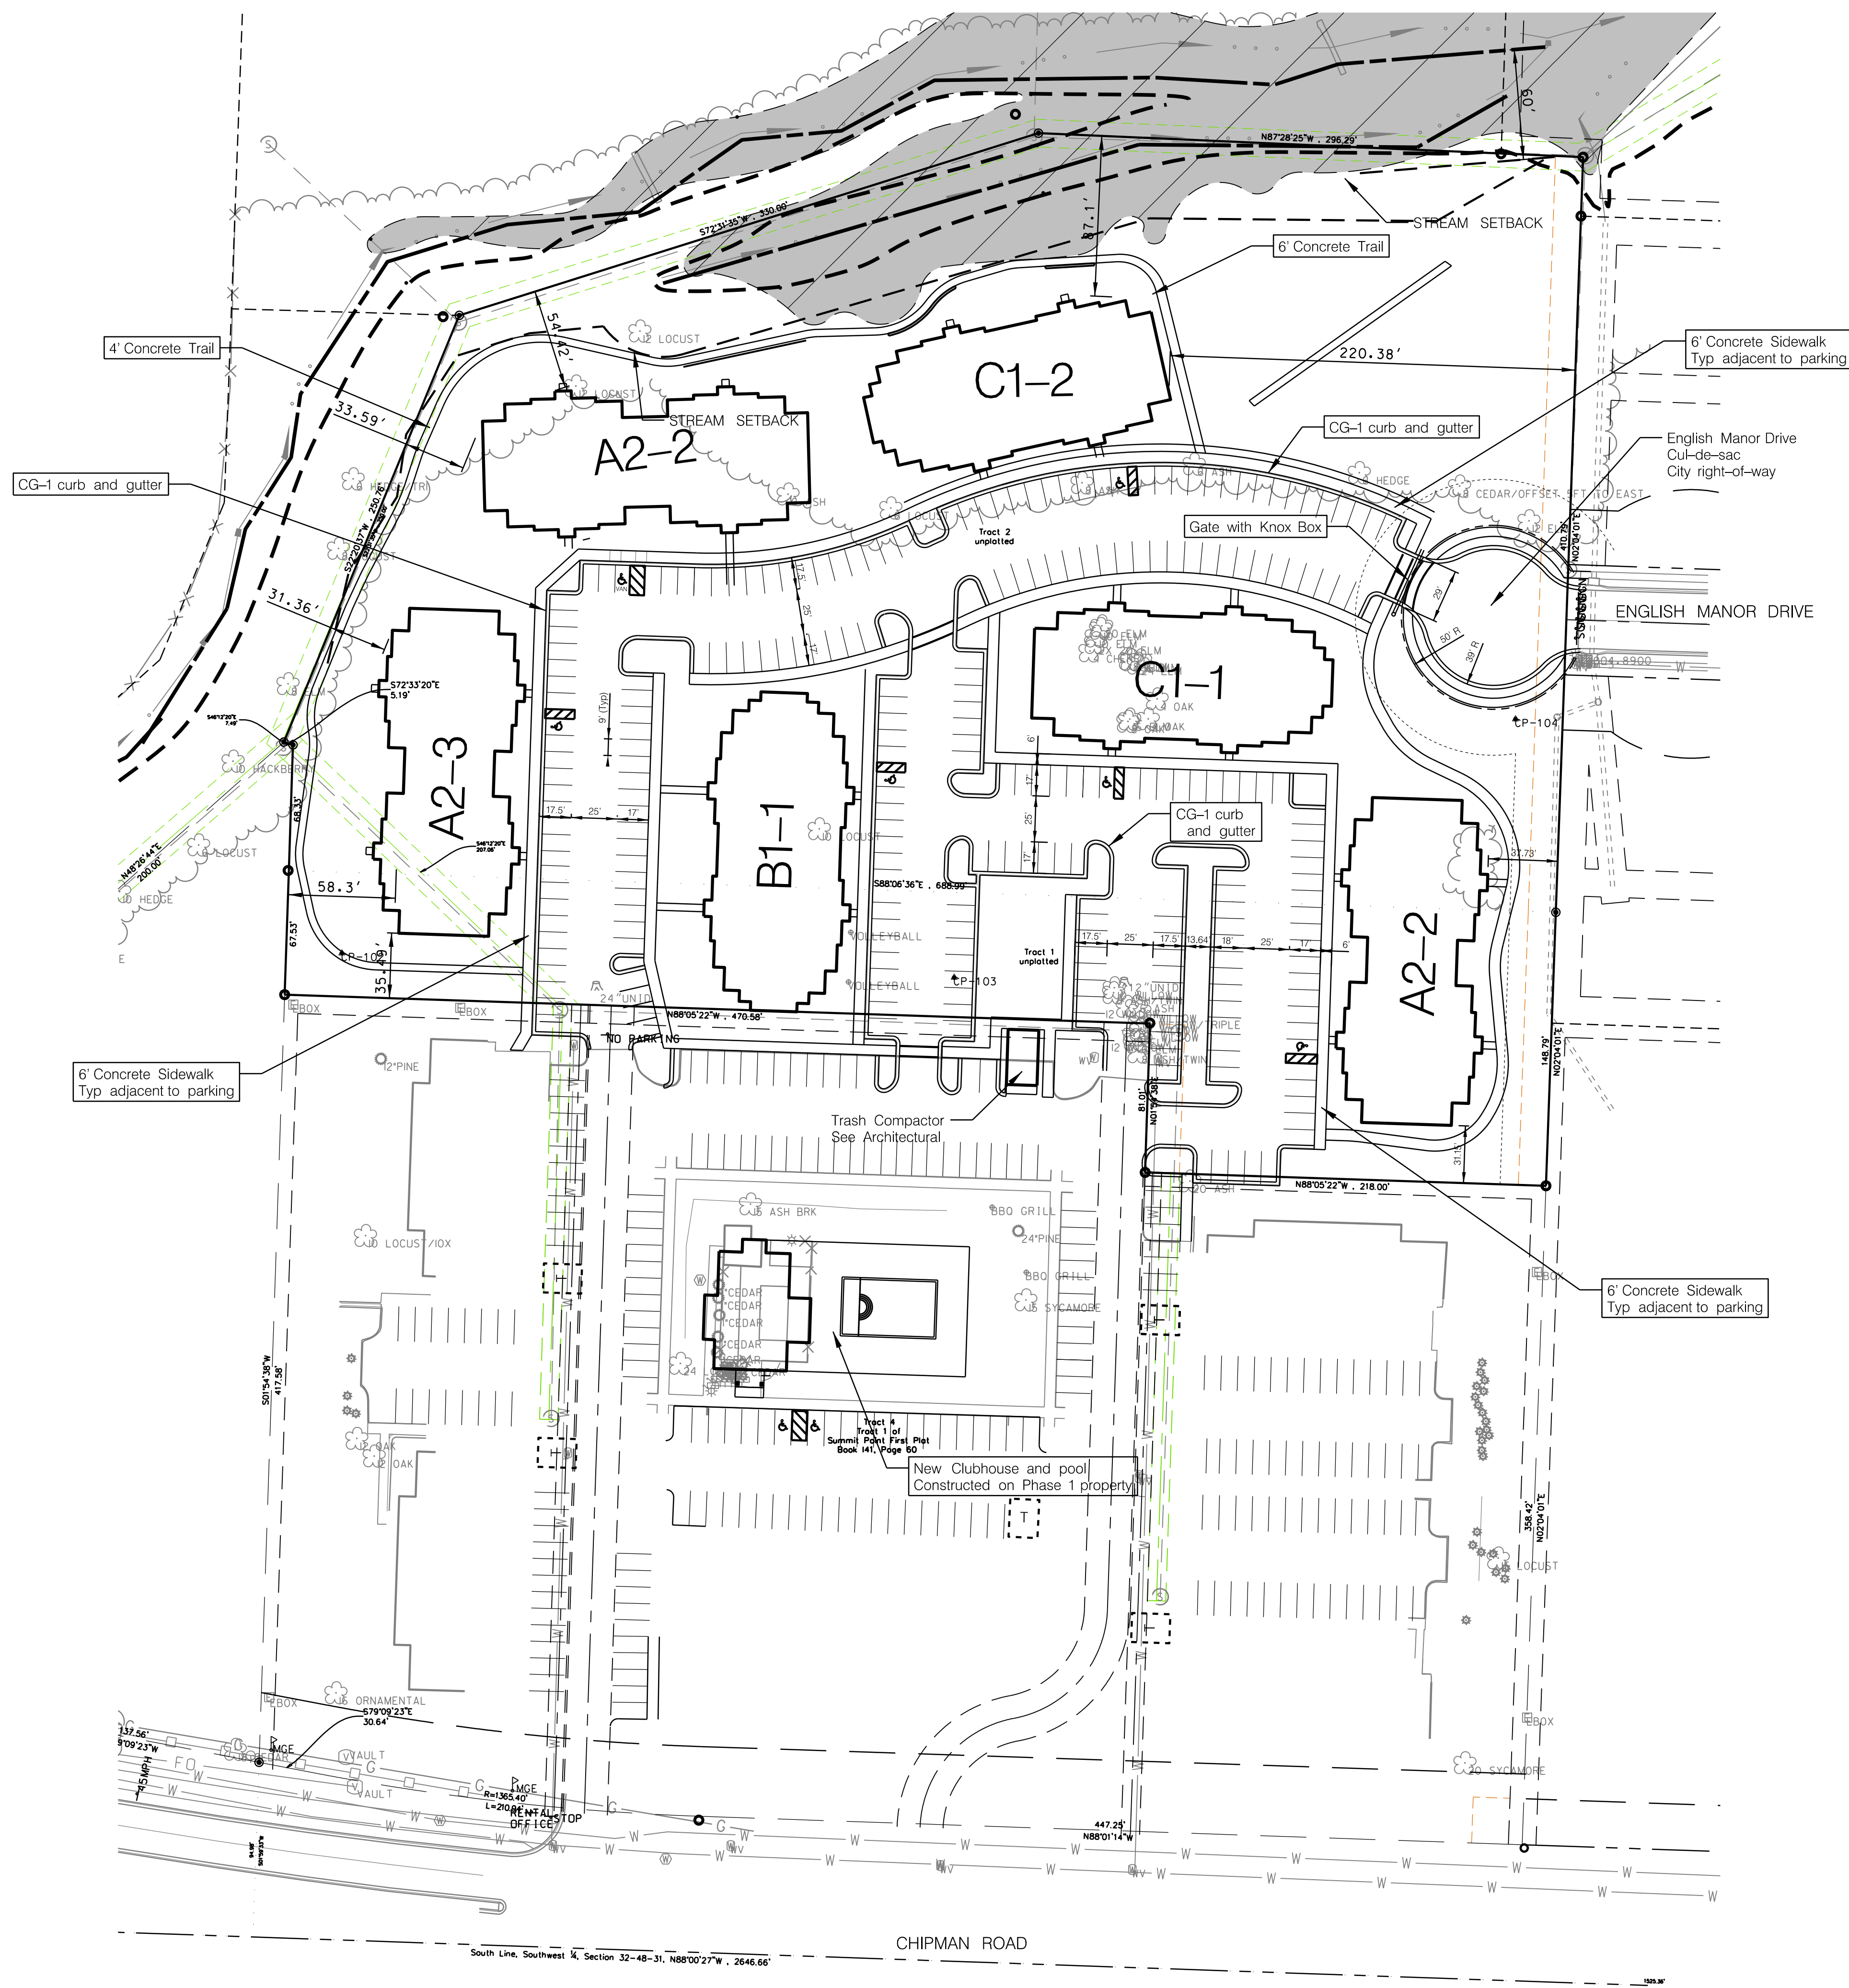

CFS ENGINEERS
cfe.com
1421 E. 10th Street, Suite 100, KC MO 64131
816-333-4477 F 816-333-6668

STATE OF MISSOURI
LAND SURVEYOR
JAMES W. SCOTT
No. 0000000000
Exp. 12/31/2025

Rev.	Date	By	Description	Appr.
1	04/15/21	REVISOR PER COMMENTS		
2	03/22/21	REVISOR PER COMMENTS		
3	03/15/21	CITY SUBMITTAL		



SUMMIT POINT
504 NE Chipman Road
Lee's Summit, Missouri

Preliminary Development Plan

SITE PLAN

Sheet reference number:
C3

PRELIMINARY PLAN
SUMMIT POINT 2nd PLAT
LEE'S SUMMIT, MISSOURI

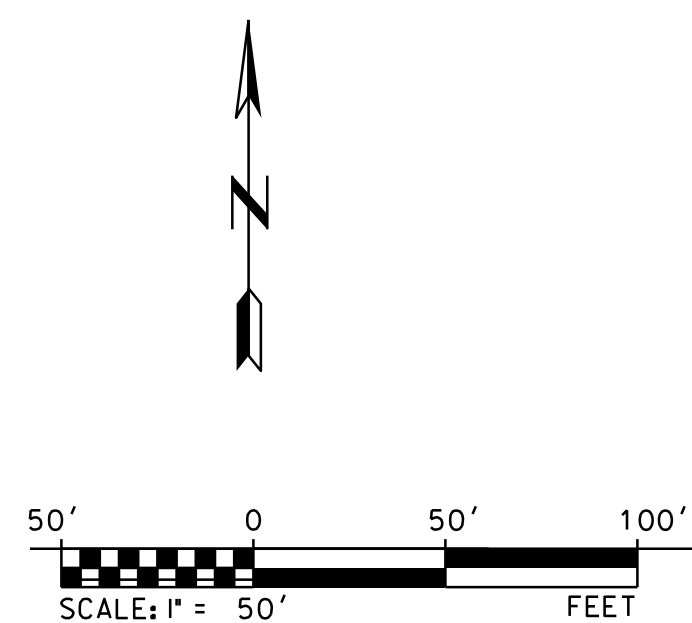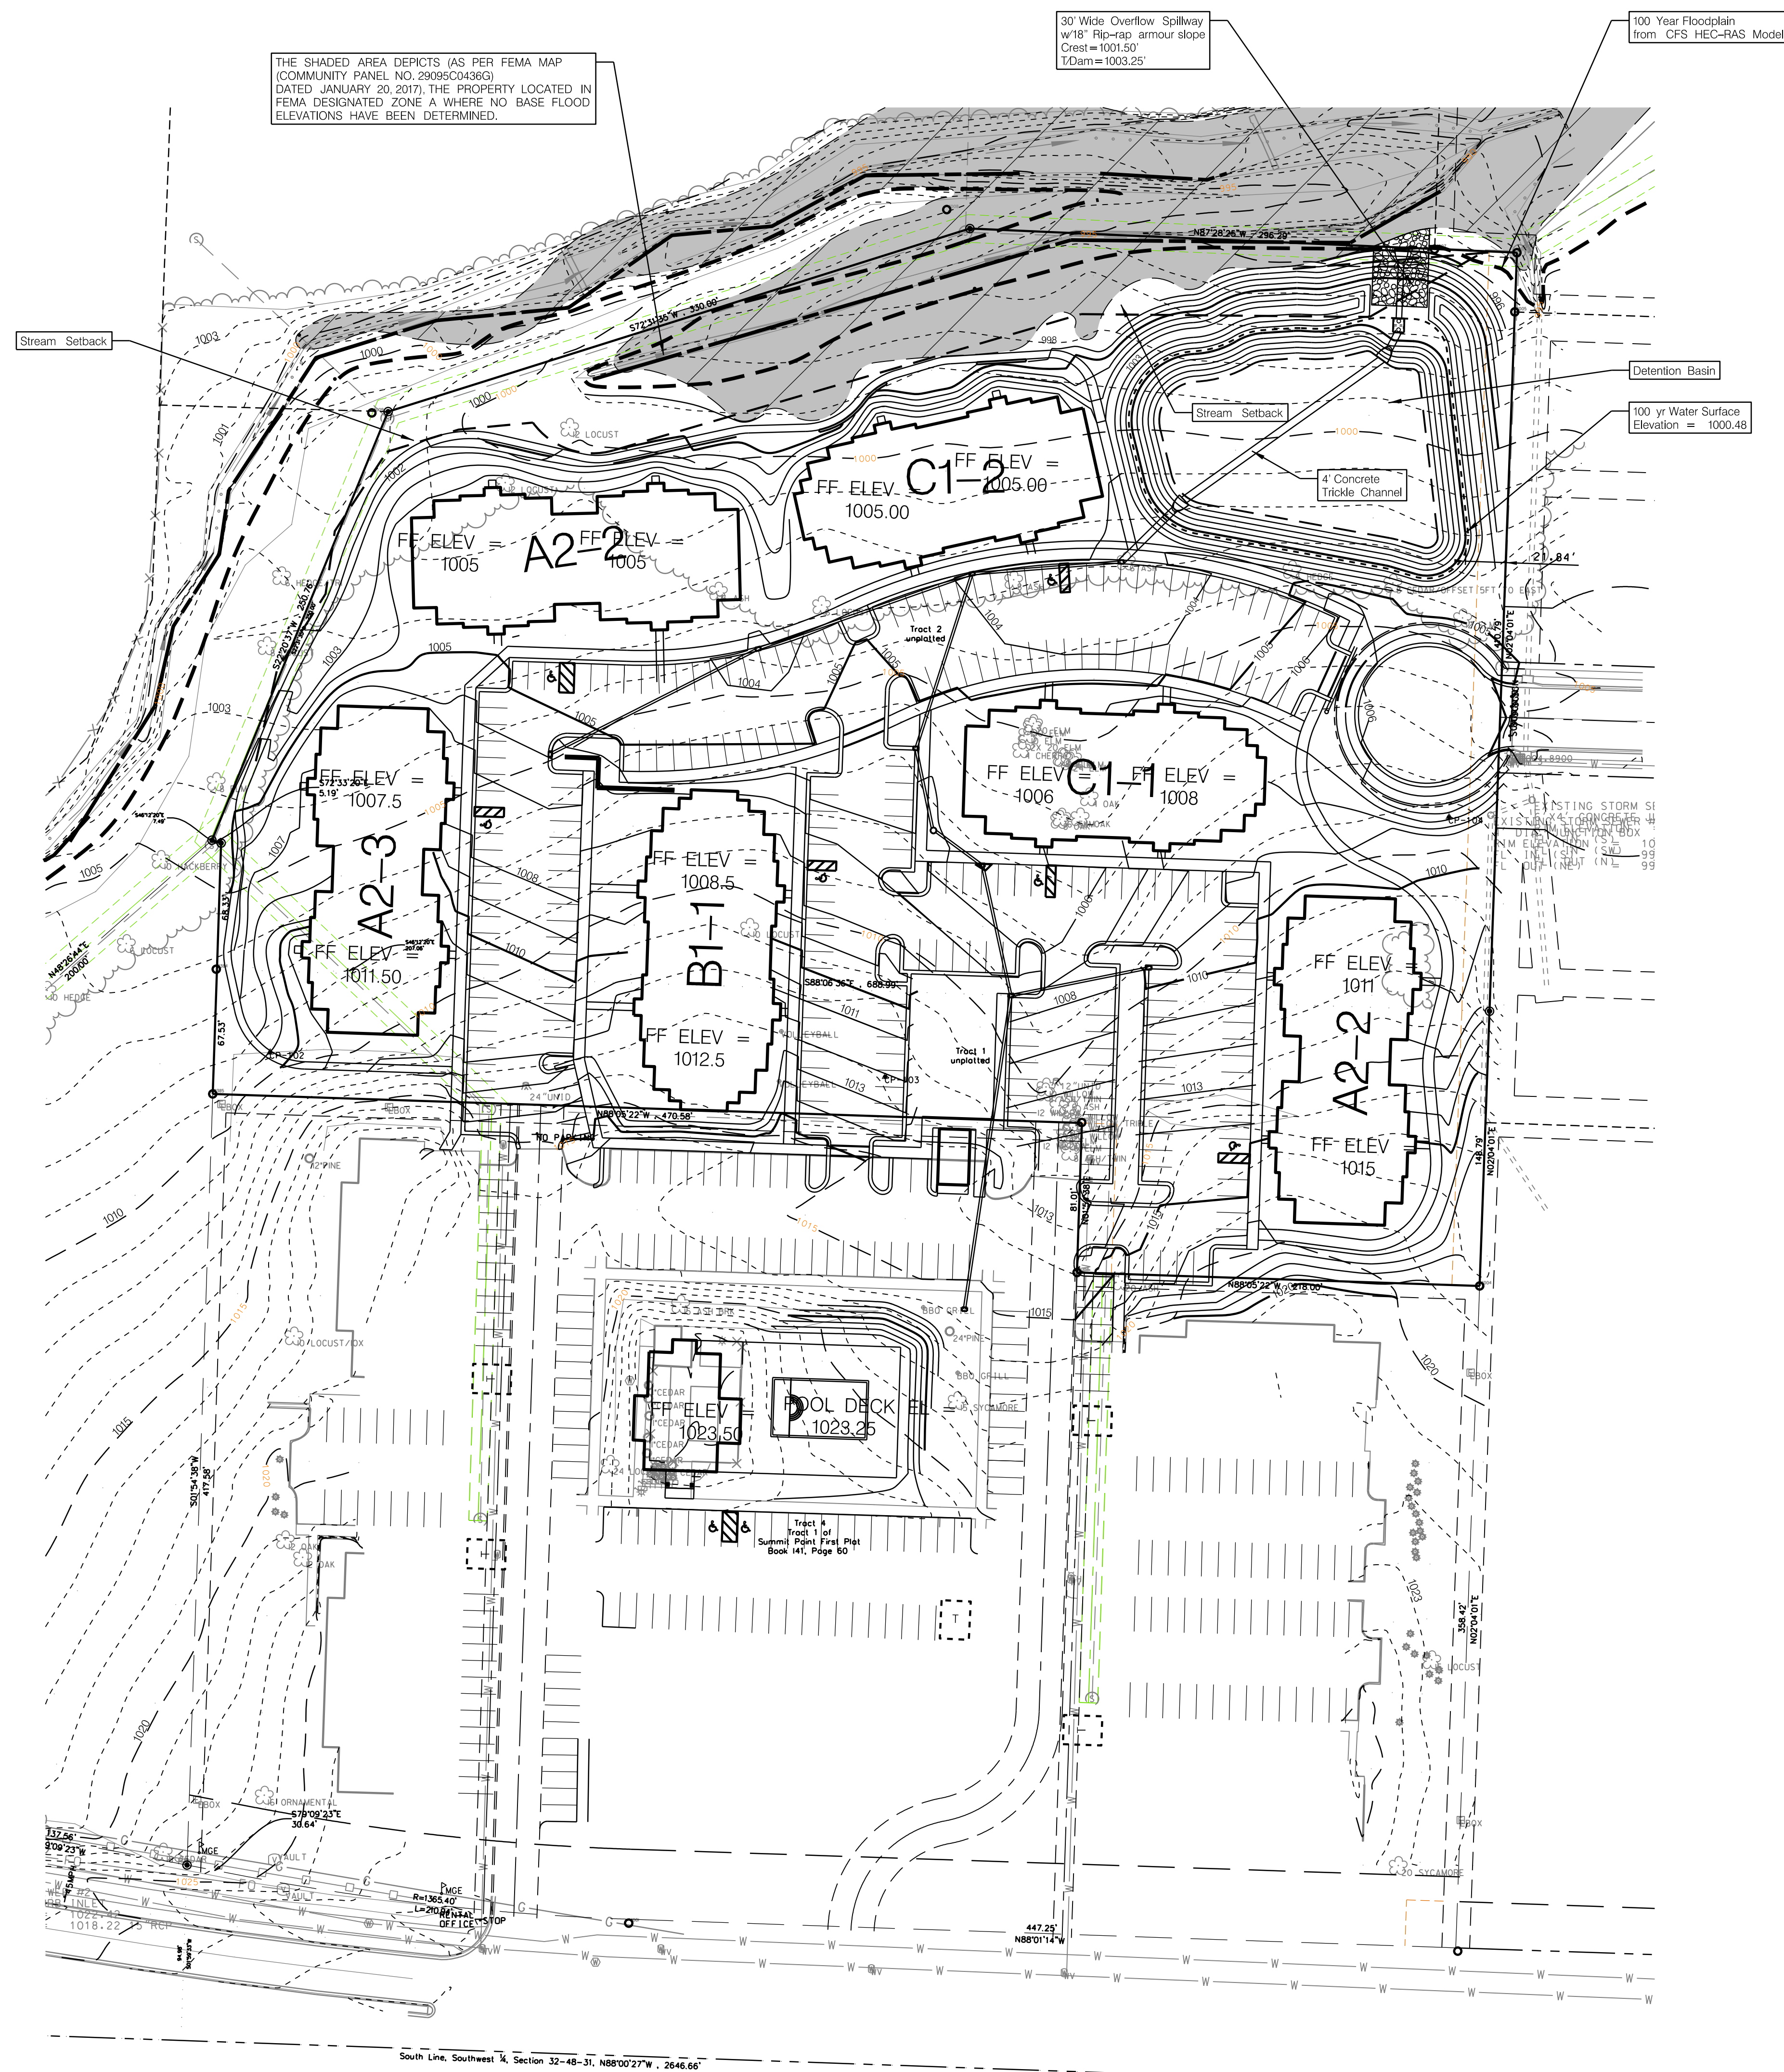

South Line, Southwest ¼, Section 32-48-31, N88°00'27"W . 2646.66

G:\Shared drives\215065\CADD\215065-ST-SH-GradingPlan.dgn



[illegible]

RP	Own by:	Ckd by:	Reviewed by:
RP	LWS	---	---
Submitted by:		Plot scale:	
---		1:50	


File name: 215065-ST-SH-GradingPlan.dgn
 Date: 2021/04/14 14:29:21
 User: 23143 DM

SUMMIT POINT
504 NE Chipman Road
Lee's Summit, Missouri

PRELIMINARY PLAN
SUMMIT POINT 2nd PLAT
LEE'S SUMMIT, MISSOURI

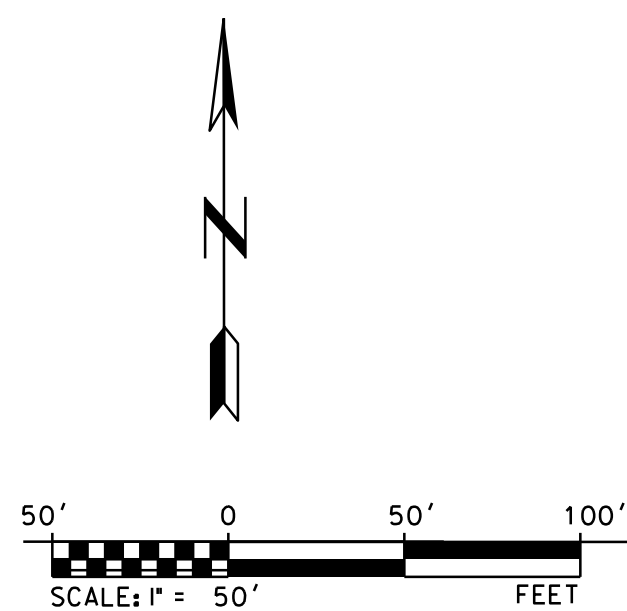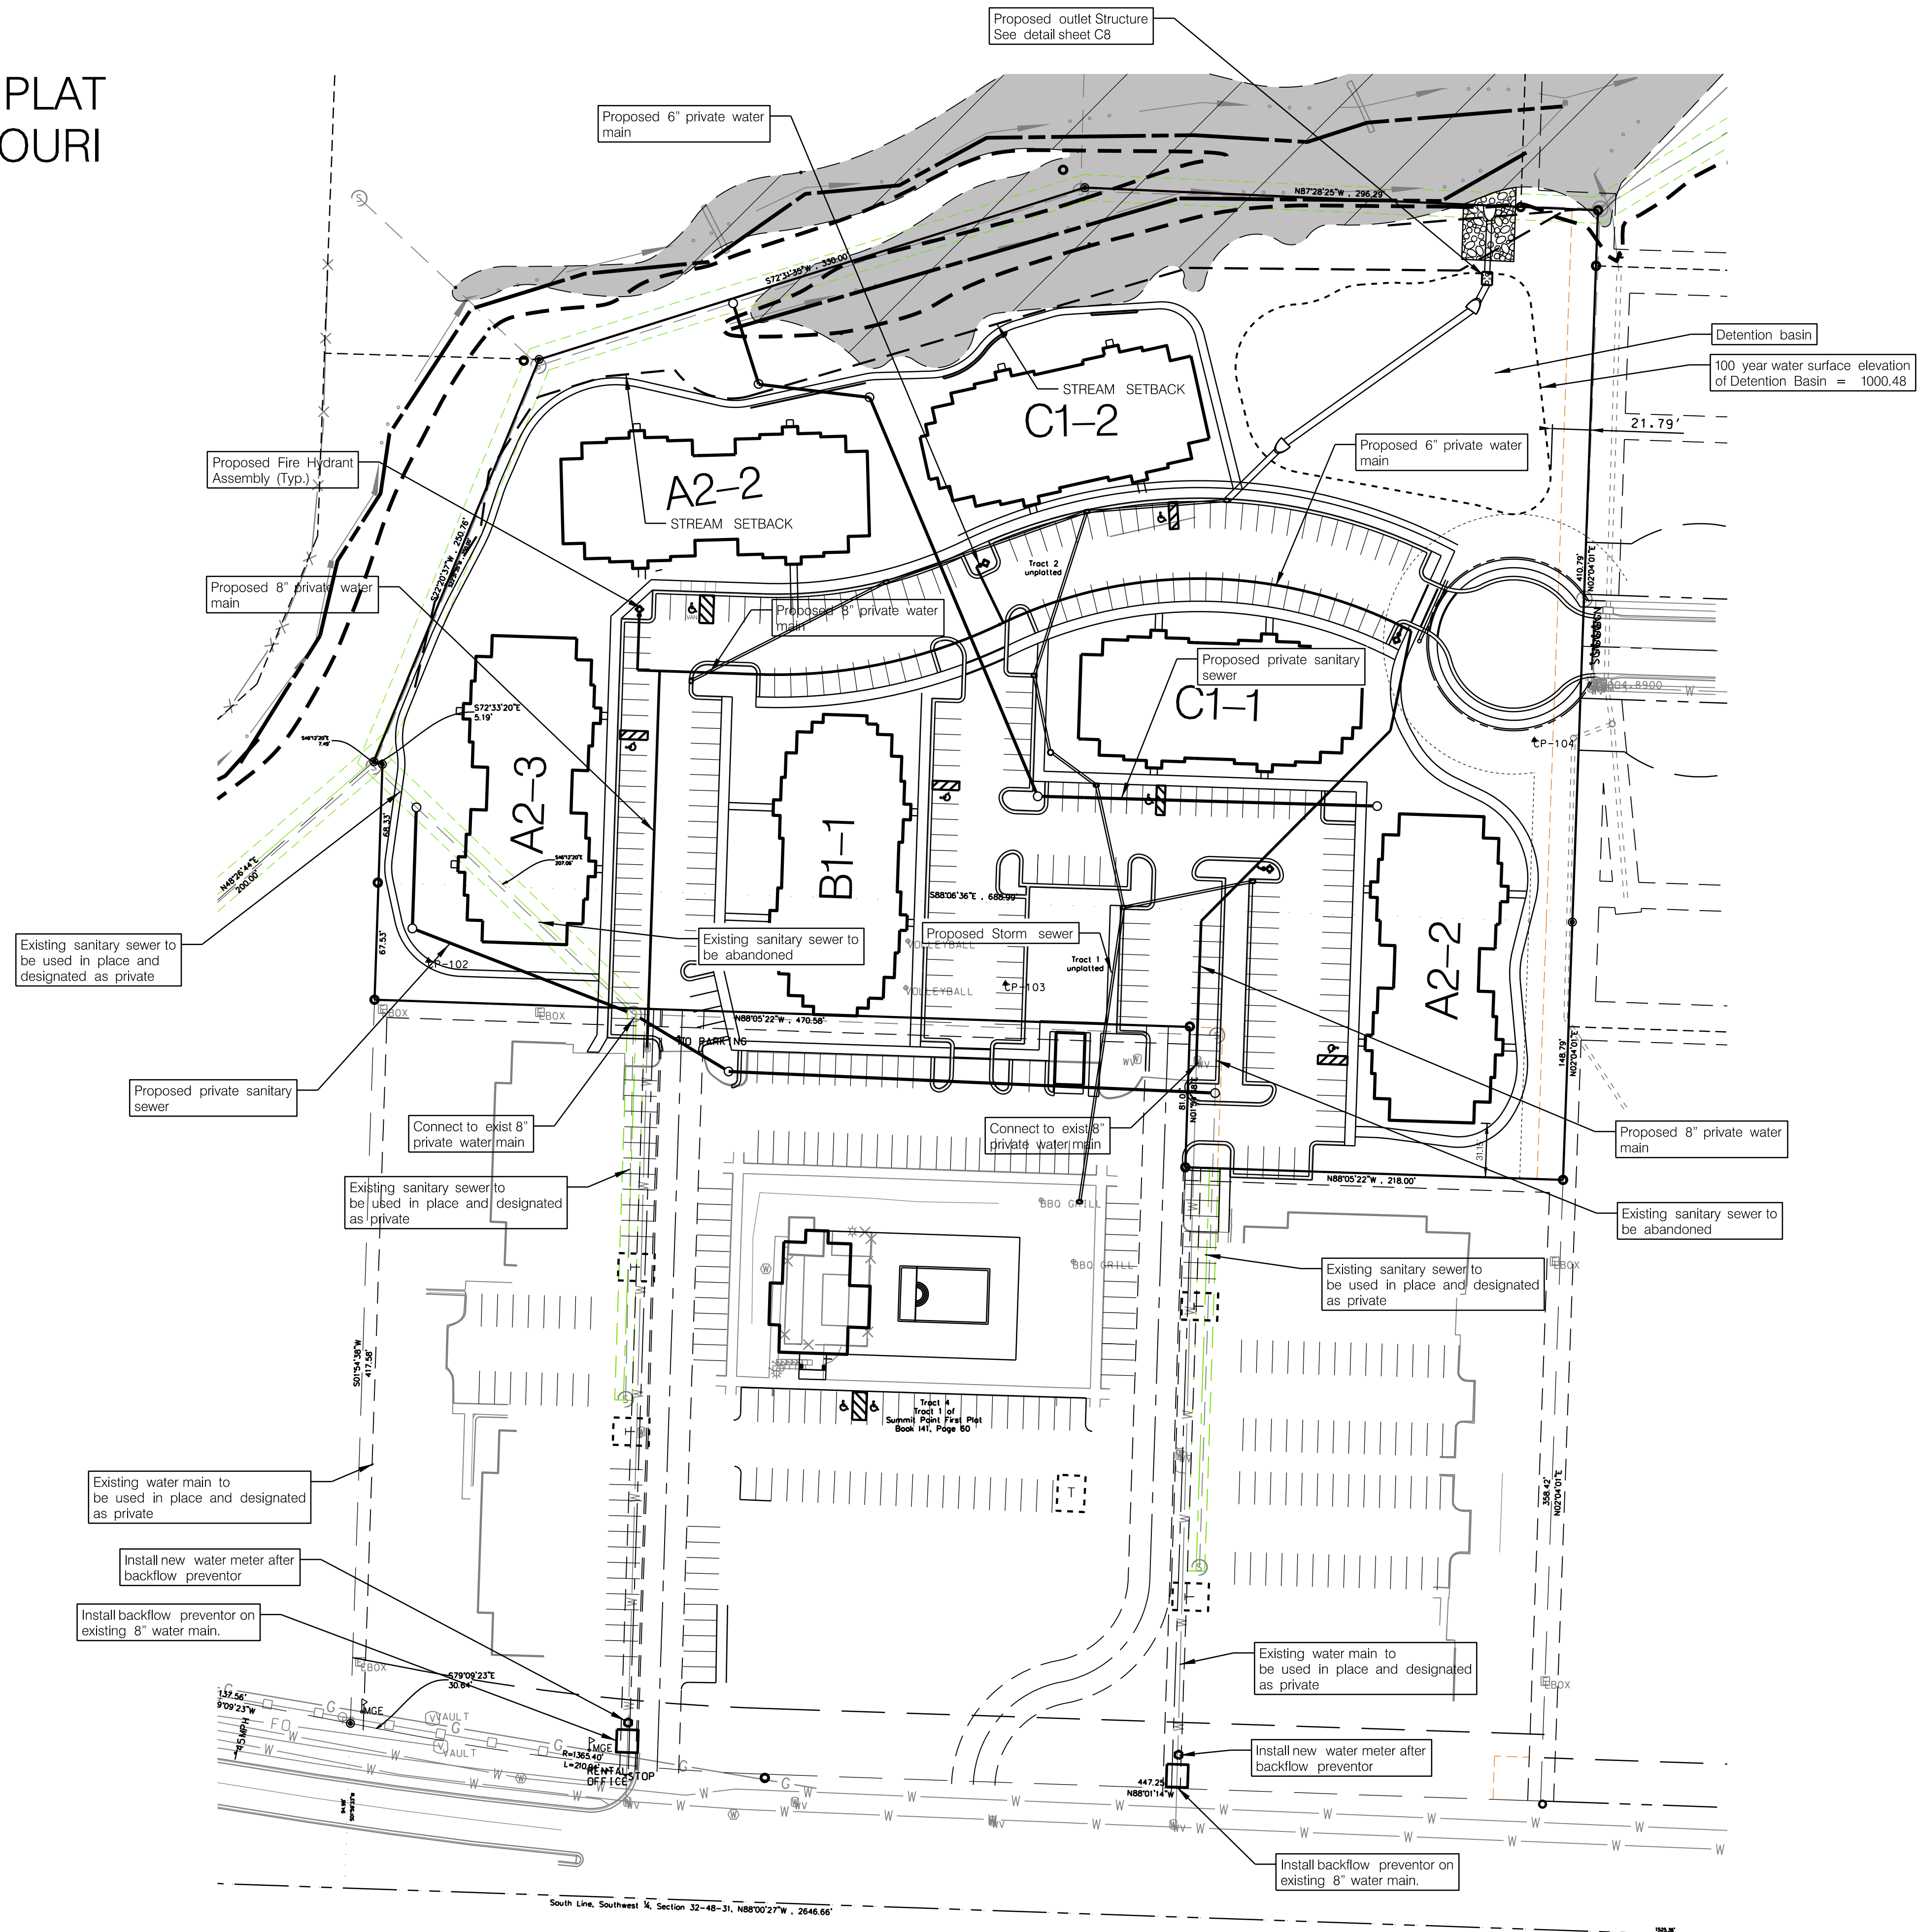

CFS ENGINEERS
cfsengineers.com
1421 E. 104th Street, Suite 100, KC, MO 64131
P: 816-333-4477 F: 816-333-4888

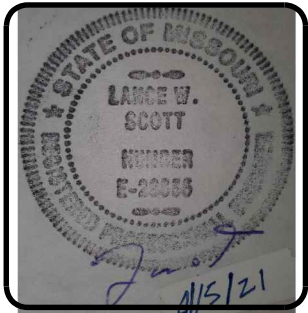

Mark	Description	Date	Appr.
	REVISED PER COMMENTS	04/15/21	
	REVISED PER COMMENTS	07/22/21	
	CITY SUBMITTAL	07/18/21	


Designed by: RP	Drawn by: LWS	Reviewed by: ---	Date: 03-25-2015	Rev. -
Submitted by: ---	Submitted by: ---	Plot scales: US/54545	File name: 25065-S1-SH-UtilityPlan.dgn	Plot date: 04/14/2021
SUMMIT POINT 504 NE Chipman Road Lee's Summit, Missouri Preliminary Development Plan				

UTILITY PLAN



Sheet
reference
number:

C5

PRELIMINARY PLAN
SUMMIT POINT 2nd PLAT
LEE'S SUMMIT, MISSOURI

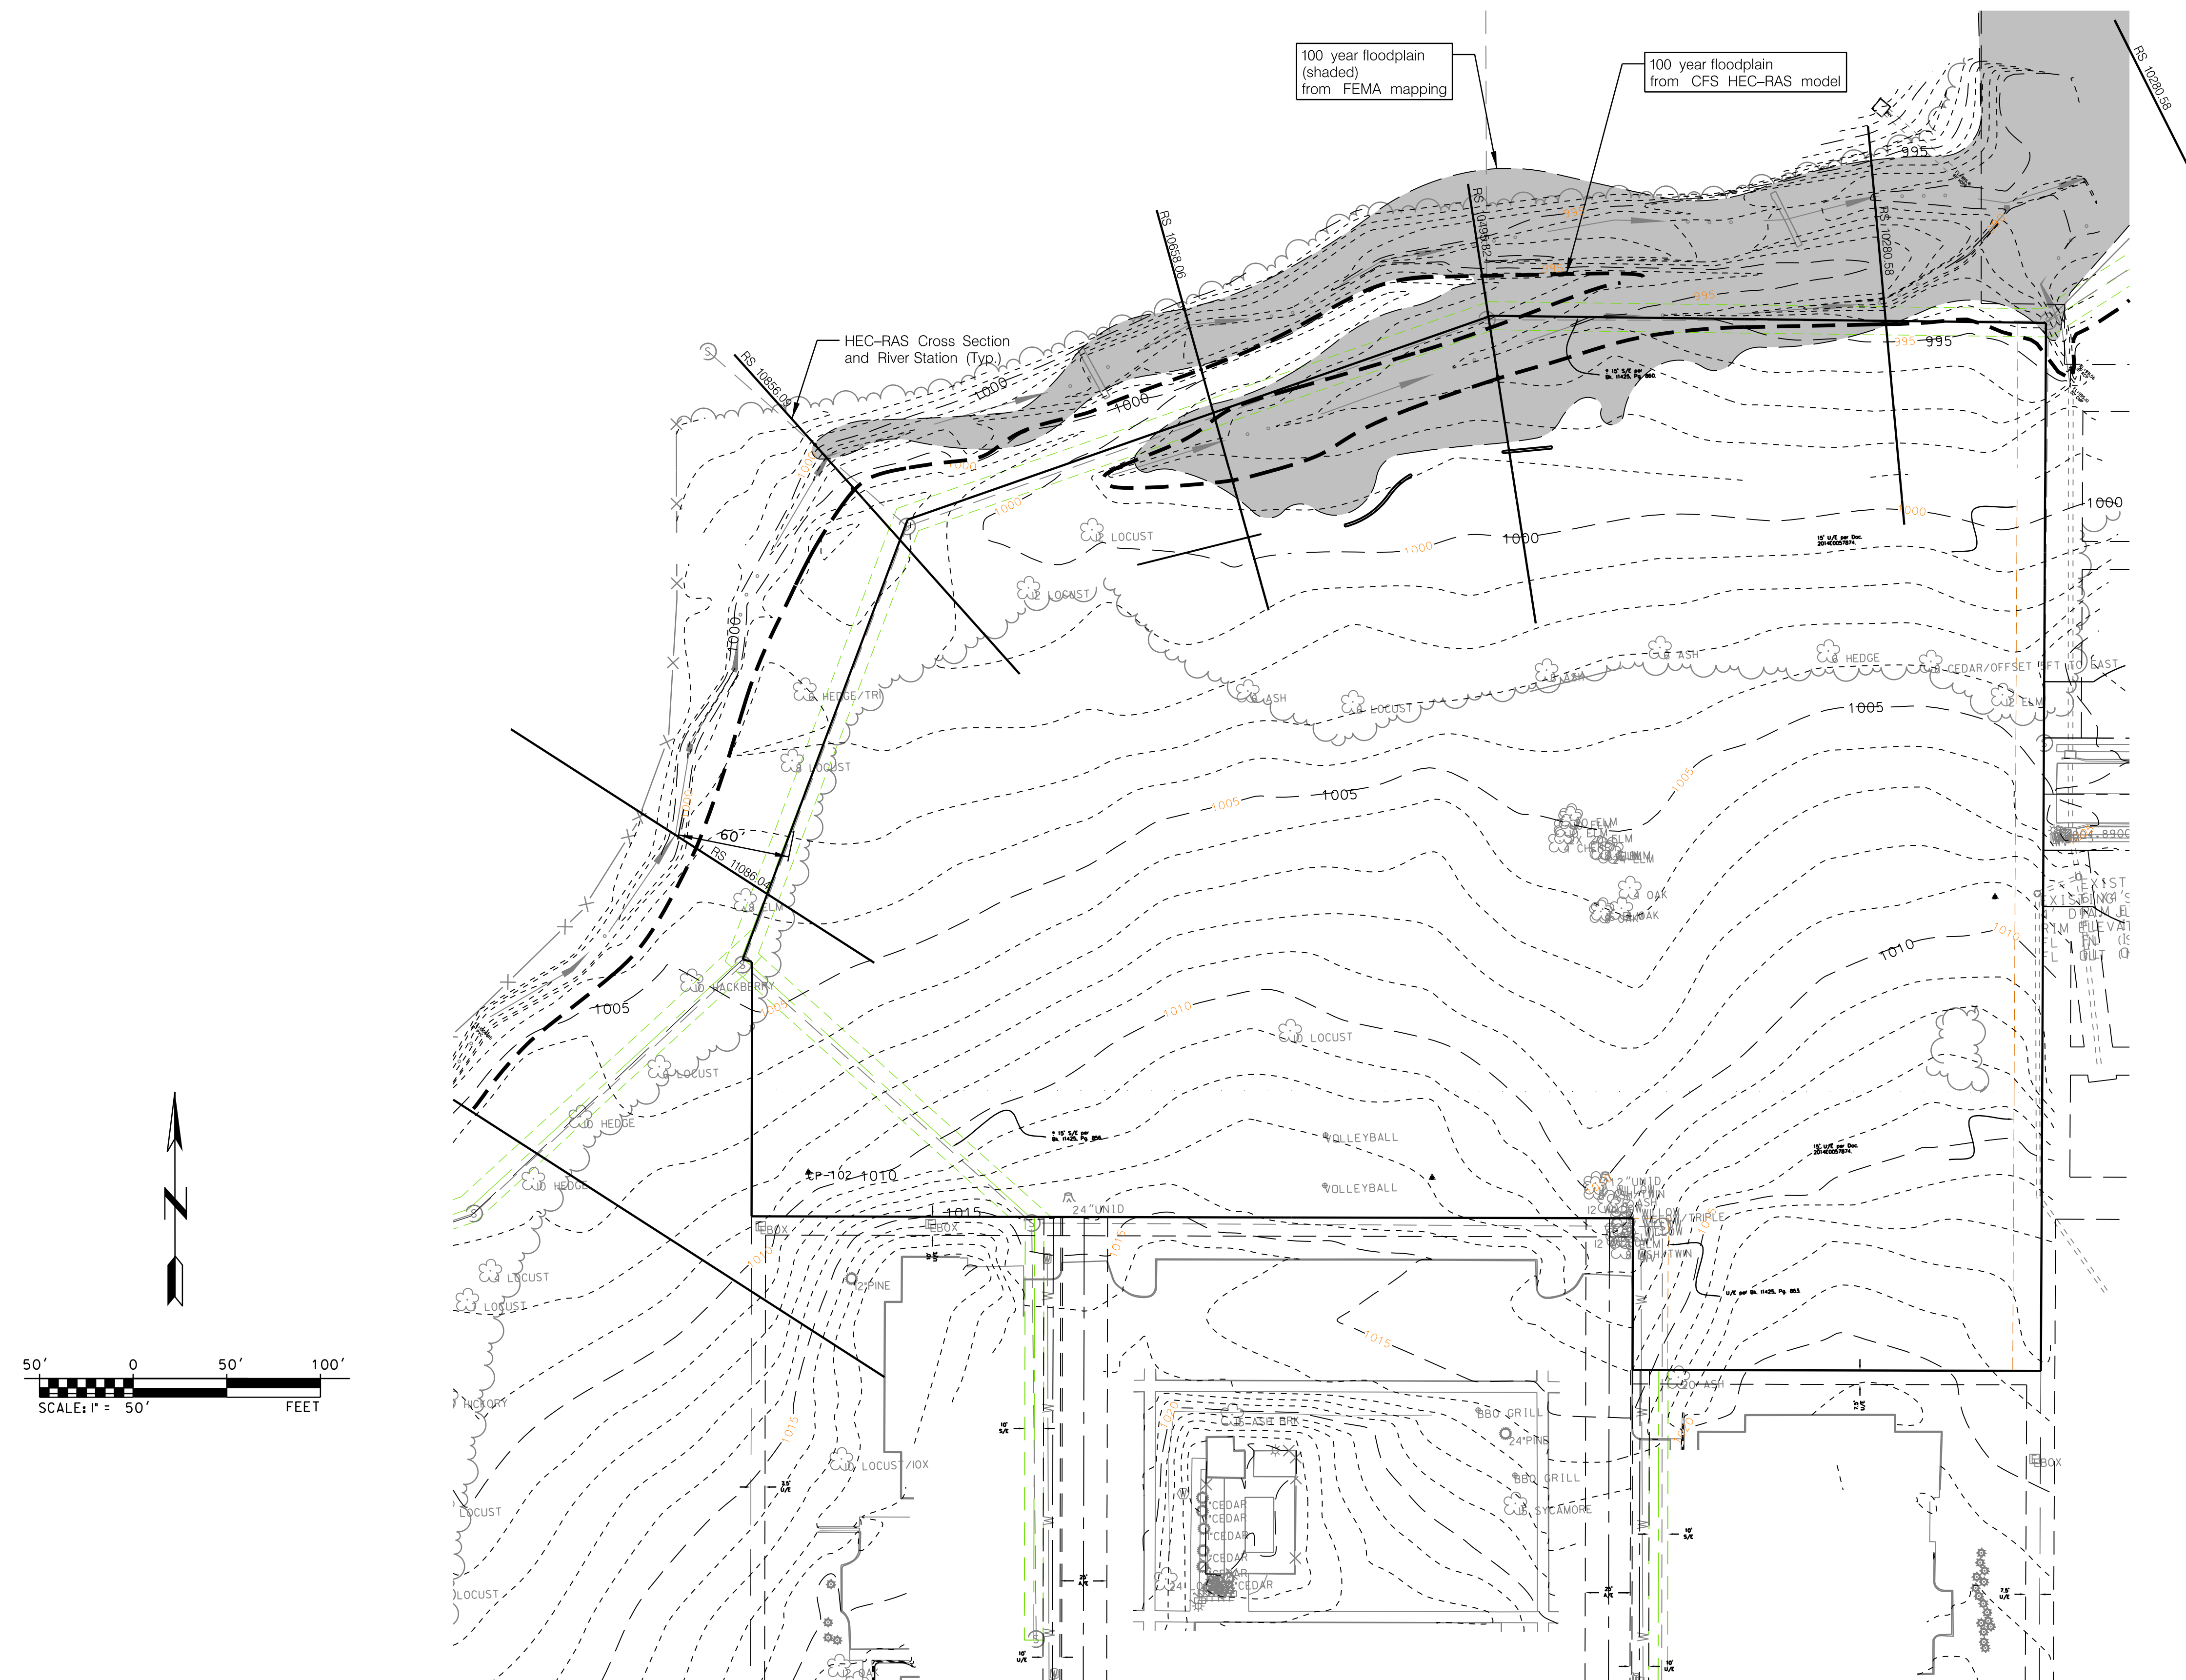

PRELIMINARY PLAN
SUMMIT POINT 2nd PLAT
LEE'S SUMMIT, MISSOURI

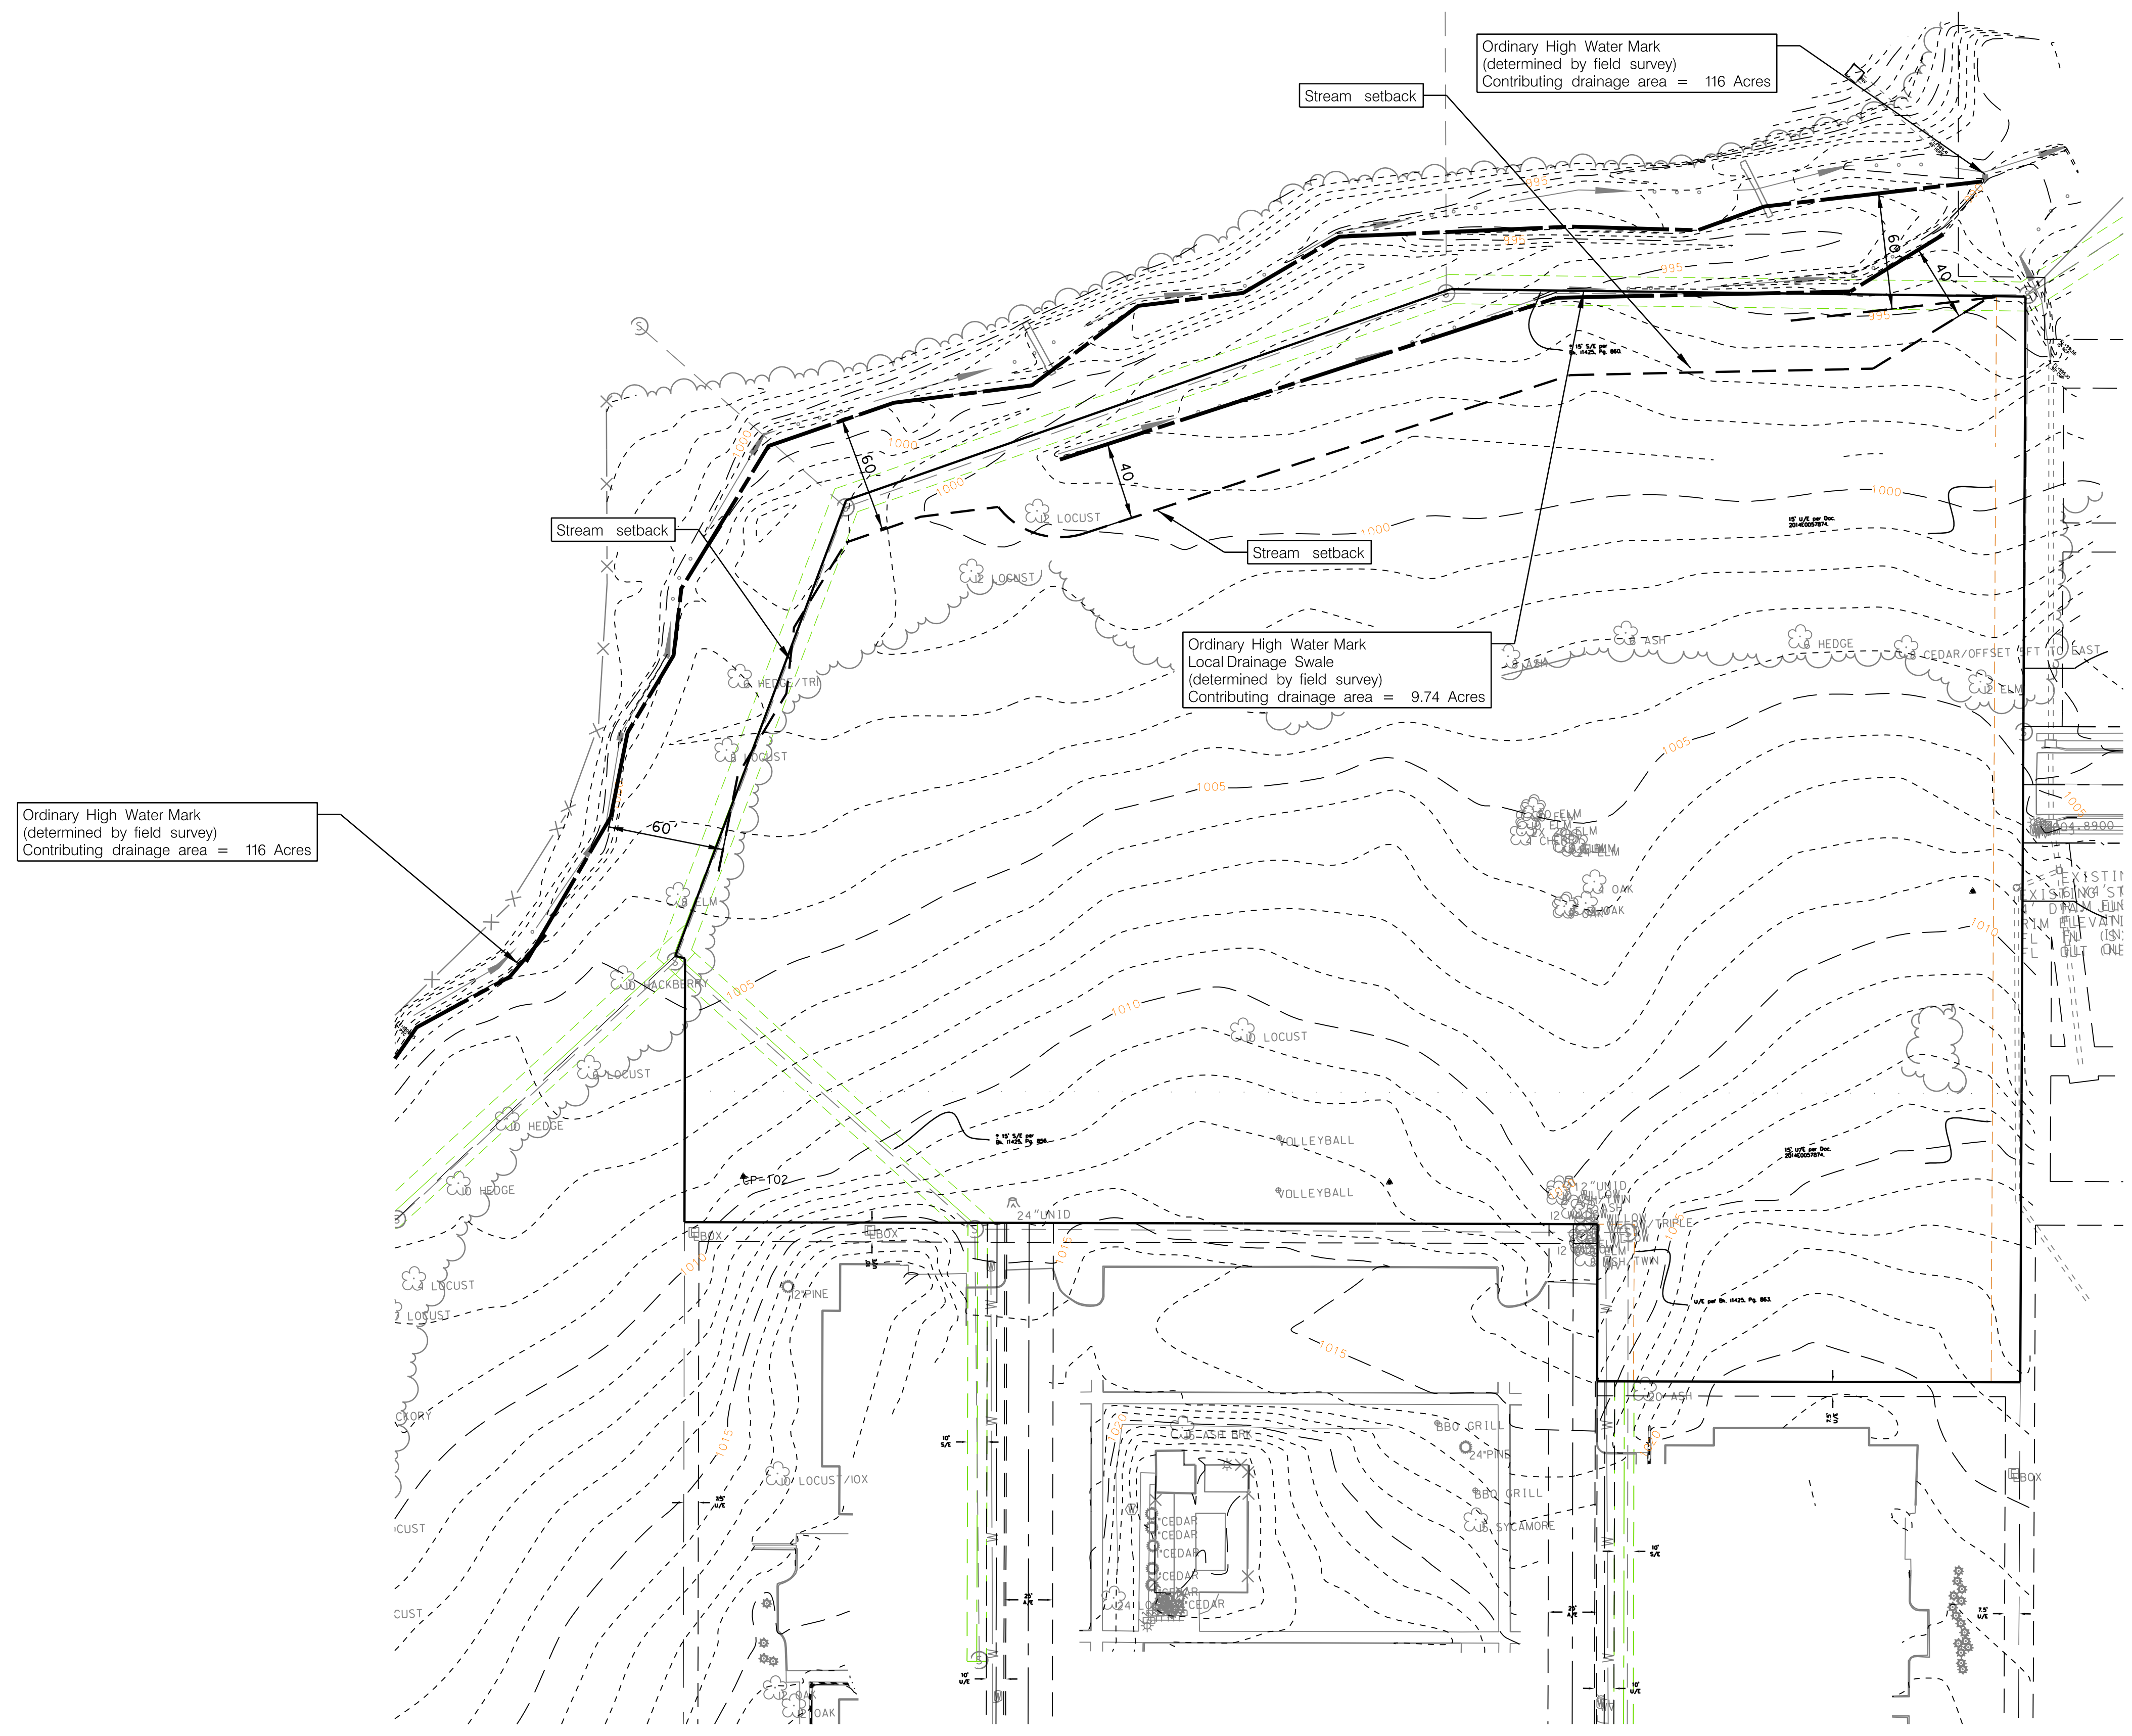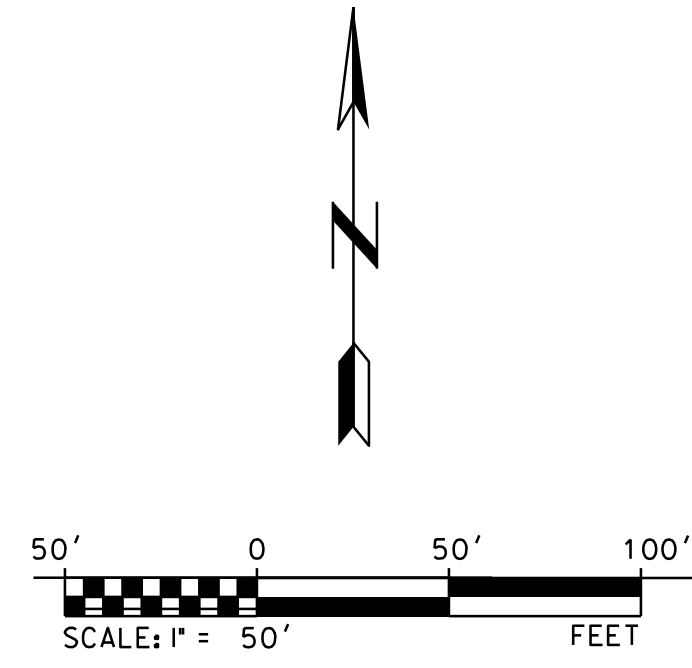

CFS ENGINEERS

cfe.com

1421 E. 10th Street, Ste. 100 KC MO 64131
P 816-333-4477 F 816-333-6666

STATE OF MISSOURI
LAND SURVEYOR
JAMES W. SCOTT
EXPIRES 08-2023

James W. Scott
4/15/21

Work	Description	Date	Appr.
	REVISED PER COMMENTS	04/15/21	
	REVISED PER COMMENTS	03/22/21	
	CITY SUBMITTAL	03/16/21	

Designed by:	Drawn by:	Checked by:	Reviewed by:	Date:	Rev.
RP	RP	LWS	---	03-25-2015	-
Submitted by:	Plot scale:				
File name: Summit Point Stream Setback exhibit.dgn	1/50				
Plot date: 04/15/21	2:22:25 PM				

SUMMIT POINT
504 NE Chipman Road
Lee's Summit, Missouri

Preliminary Development Plan

STREAM SETBACK EXHIBIT

Sheet reference number:
C7


G:\Shared drives\215065\CADD\Summit Point Stream Setback exhibit.dgn

Summit Point Apartments, Phase-II
HEC-RAS Analysis of Tributary P3
to Prairie Lee Lake, Lee's Summit, MO
April 21, 2021, CFS Proj. #21-5065

HEC-RAS Plan: SummitPIEExist River: SummitPointOpenC Reach: SummitPoint


Reach	River Sta	Profile	Q Total (cfs)	Min Ch El (ft)	W.S. Elev (ft)	Crit W.S. (ft)	E.G. Elev (ft)	E.G. Slope (ft/ft)	Vel Chnl (ft/s)	Flow Area (sq ft)	Top Width (ft)	Froude # Chl
SummitPoint	8693.92	2yr	144.00	970.00	973.53	973.53	974.45	0.014489	7.71	18.67	10.37	1.01
SummitPoint	8693.92	10yr	273.00	970.00	974.71	974.71	975.74	0.009351	8.22	38.70	29.73	0.87
SummitPoint	8693.92	100yr	485.00	970.00	975.88	975.88	976.86	0.006529	8.70	90.64	59.22	0.77
SummitPoint	8833.36	2yr	144.00	972.75	976.52	976.52	977.28	0.014109	6.96	20.69	13.84	1.00
SummitPoint	8833.36	10yr	273.00	972.75	977.39	977.39	978.34	0.013094	7.82	34.93	19.03	1.02
SummitPoint	8833.36	100yr	485.00	972.75	978.43	978.43	979.51	0.009582	8.36	62.28	44.48	0.92
SummitPoint	8962.51	2yr	144.00	974.61	977.98		978.40	0.005623	5.18	27.80	15.44	0.68
SummitPoint	8962.51	10yr	273.00	974.61	978.88		979.50	0.006207	6.29	43.38	19.33	0.74
SummitPoint	8962.51	100yr	485.00	974.61	979.64	979.40	980.68	0.008505	8.17	59.38	22.65	0.89
SummitPoint	9223.75		Culvert	NE Independence Avenue								
SummitPoint	9303.52	2yr	135.00	978.20	985.77	981.27	985.77	0.000024	0.71	492.77	253.18	0.05
SummitPoint	9303.52	10yr	255.00	978.20	986.32	982.13	986.33	0.000046	1.06	642.04	279.15	0.07
SummitPoint	9303.52	100yr	454.00	978.20	986.73	983.26	986.75	0.000095	1.59	758.03	289.67	0.11
SummitPoint	9566.40	2yr	135.00	979.30	985.77		985.79	0.000092	1.21	178.61	113.93	0.10
SummitPoint	9566.40	10yr	255.00	979.30	986.32		986.36	0.000186	1.85	248.99	140.74	0.15
SummitPoint	9566.40	100yr	454.00	979.30	986.72		986.82	0.000397	2.85	309.10	159.28	0.22
SummitPoint	9759.91	2yr	135.00	984.00	986.89	986.89	987.60	0.013004	6.76	19.98	14.11	1.00
SummitPoint	9759.91	10yr	255.00	984.00	987.71	987.71	988.62	0.011931	7.65	33.35	18.39	1.00
SummitPoint	9759.91	100yr	454.00	984.00	988.82	988.82	989.72	0.007060	7.81	75.44	69.51	0.83
SummitPoint	9890.22	2yr	135.00	986.00	988.41		988.56	0.003910	3.11	43.37	42.75	0.54
SummitPoint	9890.22	10yr	255.00	986.00	989.22		989.34	0.002472	2.87	88.85	70.27	0.45
SummitPoint	9890.22	100yr	454.00	986.00	990.09		990.21	0.001629	2.78	163.09	98.81	0.38
SummitPoint	10032.93		Culvert	NE Swann Circle								
SummitPoint	10097.67	2yr	135.00	987.00	990.29	988.69	990.31	0.000459	1.29	104.30	76.68	0.20
SummitPoint	10097.67	10yr	255.00	987.00	991.82	989.18	991.83	0.000152	0.97	263.01	130.59	0.12
SummitPoint	10097.67	100yr	454.00	987.00	994.41	989.80	994.41	0.000031	0.71	642.18	171.80	0.06
SummitPoint	10280.58	2yr	135.00	989.90	992.02	992.02	992.48	0.013677	5.62	27.60	37.67	1.00
SummitPoint	10280.58	10yr	255.00	989.90	992.55	992.55	993.11	0.011626	6.37	50.82	49.92	0.97
SummitPoint	10280.58	100yr	454.00	989.90	994.32		994.47	0.001927	3.52	185.39	110.41	0.43
SummitPoint	10495.32	2yr	117.00	993.40	995.57	995.57	996.04	0.014575	5.53	21.16	23.12	1.02
SummitPoint	10495.32	10yr	222.00	993.40	996.11	996.11	996.71	0.012564	6.22	36.70	36.99	0.99
SummitPoint	10495.32	100yr	398.00	993.40	996.76	996.76	997.45	0.009804	6.78	68.44	60.34	0.92
SummitPoint	10658.06	2yr	117.00	995.90	997.52		997.81	0.008351	4.38	27.00	30.65	0.79
SummitPoint	10658.06	10yr	222.00	995.90	997.96	997.84	998.43	0.008961	5.52	42.59	39.52	0.85
SummitPoint	10658.06	100yr	398.00	995.90	998.48	998.48	999.15	0.009555	6.73	70.53	69.06	0.92
SummitPoint	10856.09	2yr	77.00	997.50	999.40	999.39	999.87	0.014120	5.49	14.03	15.05	1.00
SummitPoint	10856.09	10yr	146.00	997.50	999.95	999.94	1000.52	0.013421	6.09	23.97	21.29	1.01
SummitPoint	10856.09	100yr	264.00	997.50	1000.59	1000.58	1001.24	0.012356	6.48	40.72	31.13	1.00
SummitPoint	11086.04	2yr	77.00	999.60	1001.65		1001.92	0.006053	4.13	18.63	15.65	0.67
SummitPoint	11086.04	10yr	146.00	999.60	1002.32		1002.66	0.006662	4.63	31.57	24.53	0.72
SummitPoint	11086.04	100yr	264.00	999.60	1002.98		1003.39	0.007107	5.13	51.47	36.47	0.76
SummitPoint	11275.44	2yr	77.00	1000.70	1003.12	1003.12	1003.89	0.015788	7.05	10.92	7.18	1.01
SummitPoint	11275.44	10yr	146.00	1000.70	1004.36	1004.36	1004.97	0.014598	6.26	23.31	19.08	1.00
SummitPoint	11275.44	100yr	264.00	1000.70	1005.09	1005.09	1005.62	0.014199	5.87	44.98	42.61	1.01

Summit Point Apartments, Phase-II
 HEC-RAS Analysis of Tributary P3
 to Prairie Lee Lake, Lee's Summit, MO
 April 21, 2021, CFS Proj. #21-5065

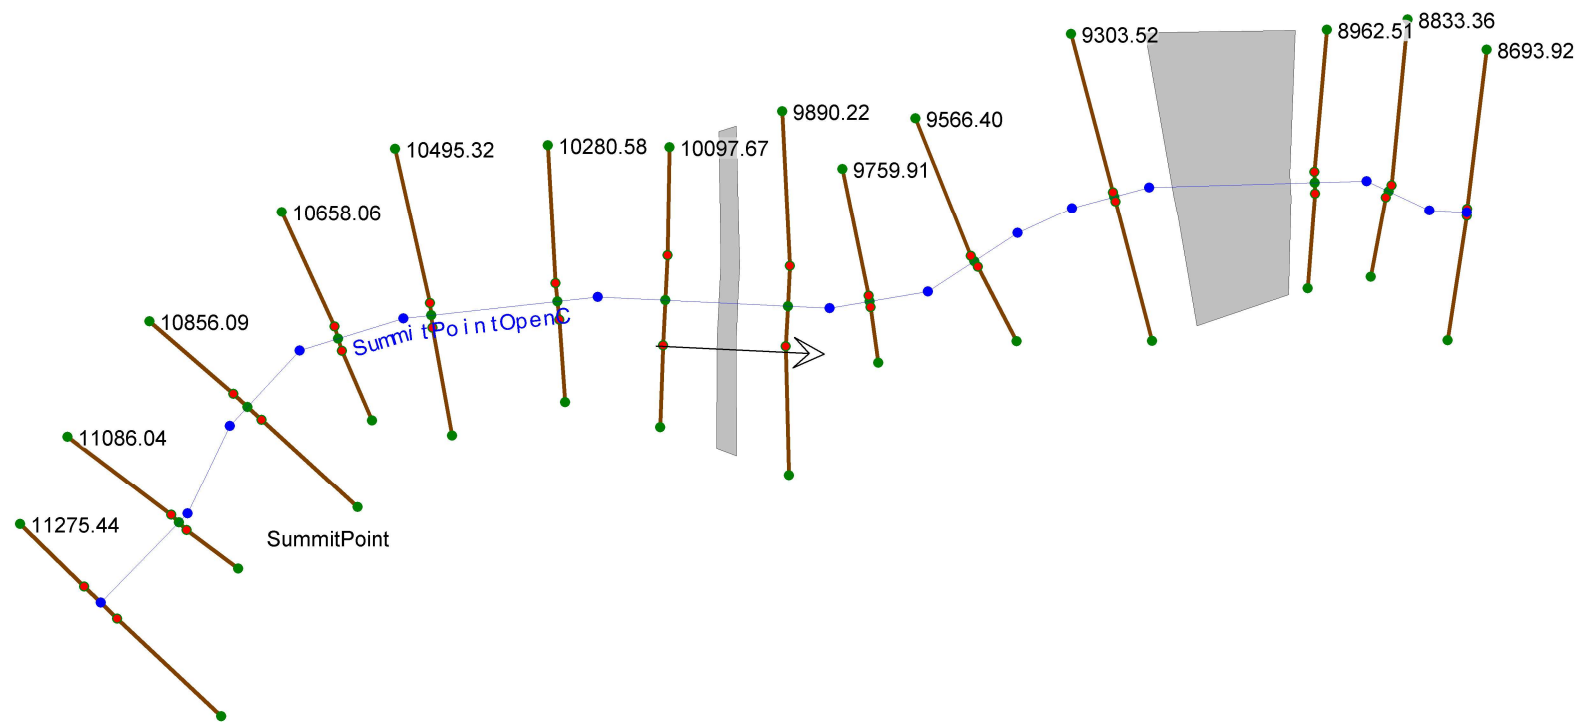


None of the XS's are Geo-Referenced (- Geo-Ref user entered XS - Geo-Ref interpolated XS - Non Geo-Ref user entered XS - Non Geo-Ref interpolated XS)


Summit Point Apartments, Phase-II
 HEC-RAS Analysis of Tributary P3
 to Prairie Lee Lake, Lee's Summit, MO
 April 21, 2021, CFS Proj. #21-5065

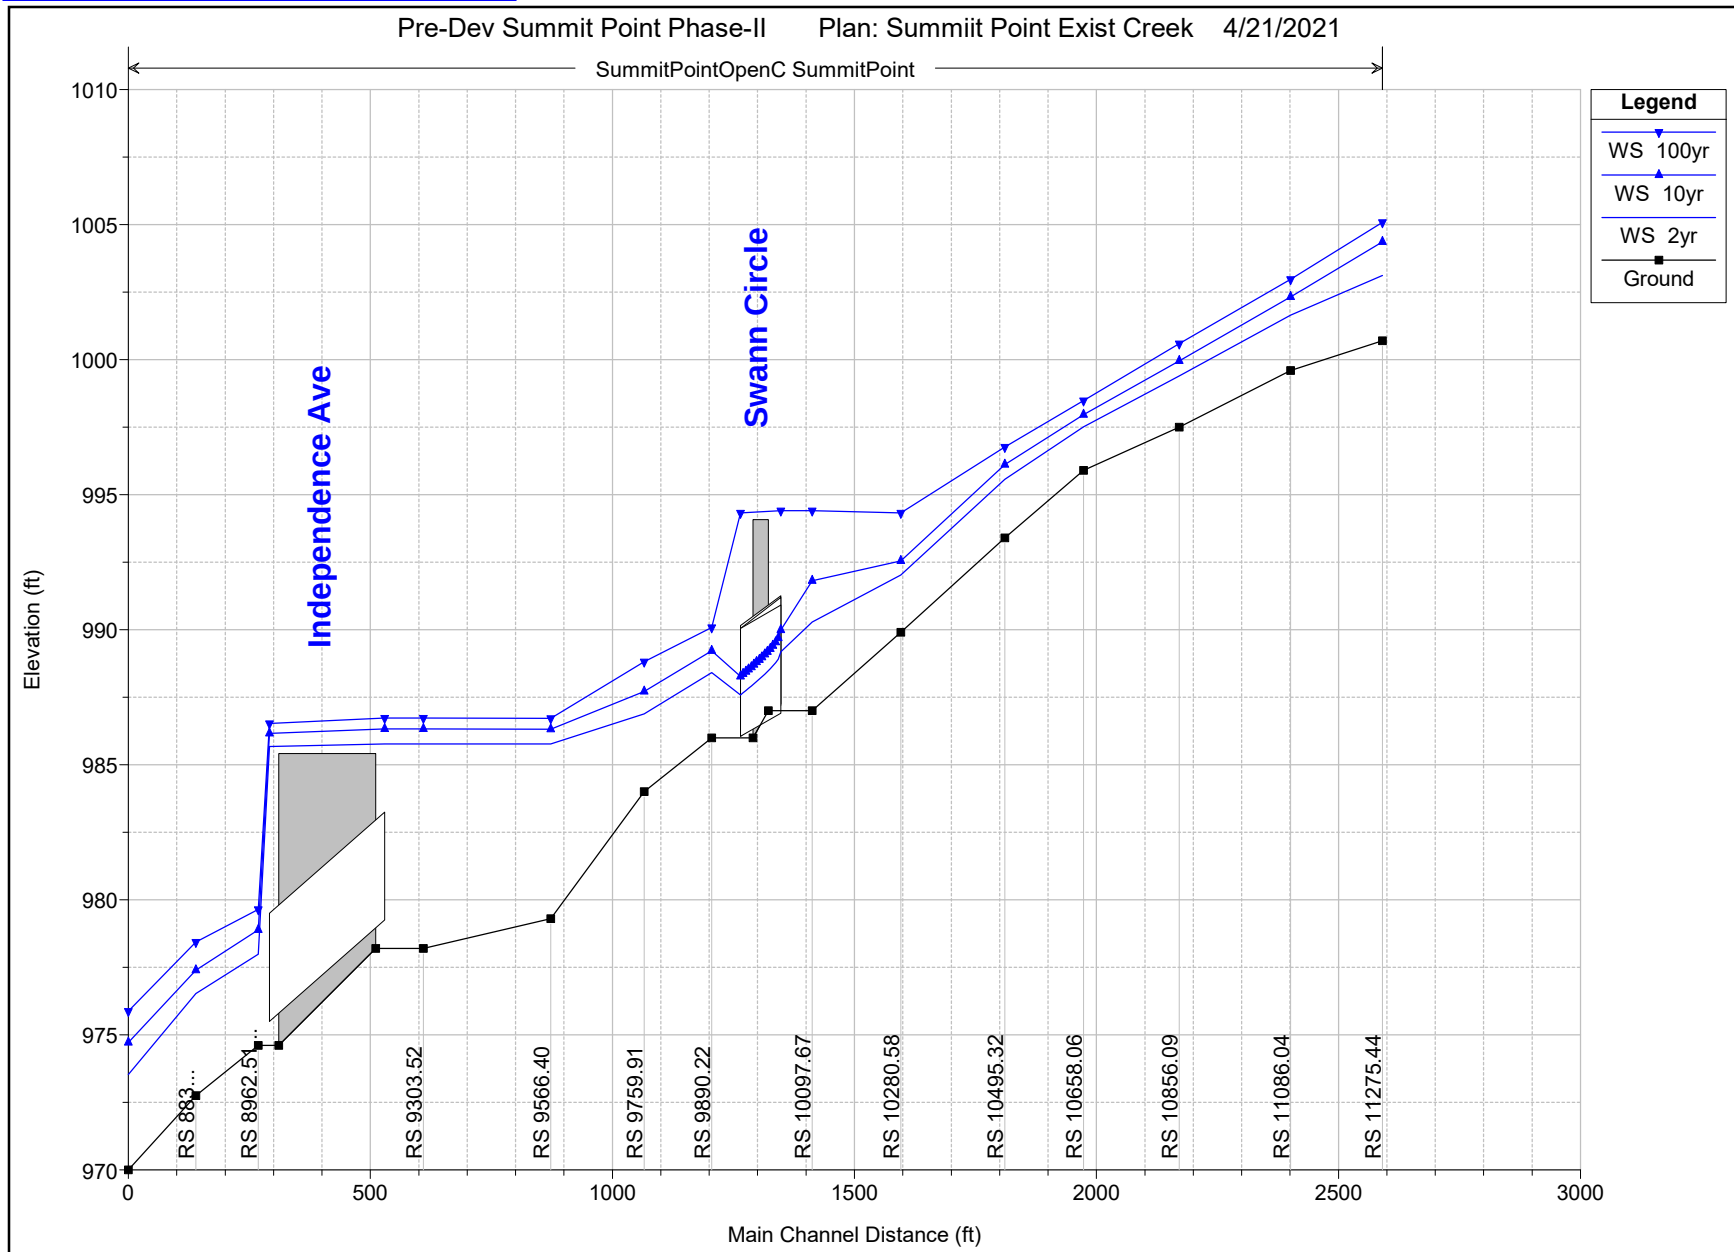


Summit Point Apartments, Phase-II
HEC-RAS Analysis of Tributary P3
to Prairie Lee Lake, Lee's Summit, MO
April 21, 2021, CFS Proj. #21-5065

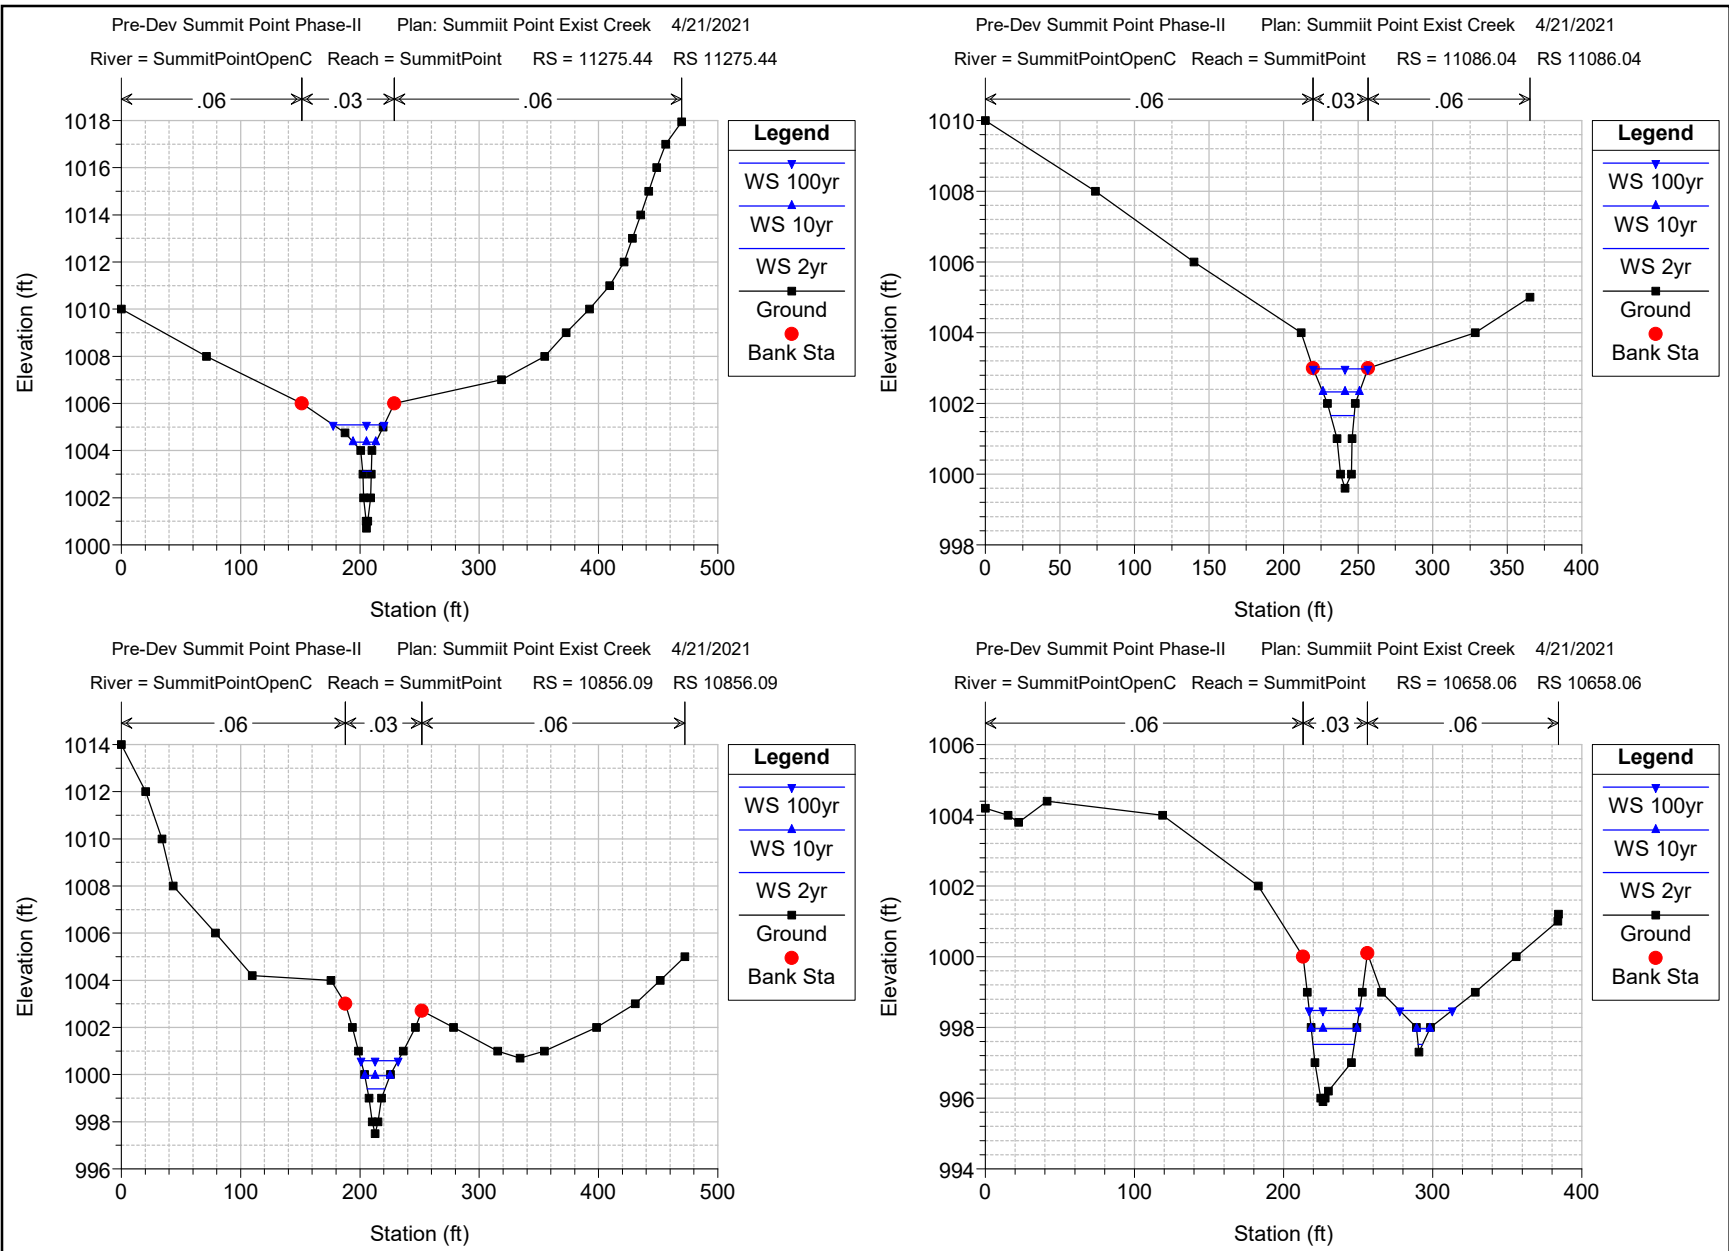


Summit Point Apartments, Phase-II
HEC-RAS Analysis of Tributary P3
to Prairie Lee Lake, Lee's Summit, MO
April 21, 2021, CFS Proj. #21-5065

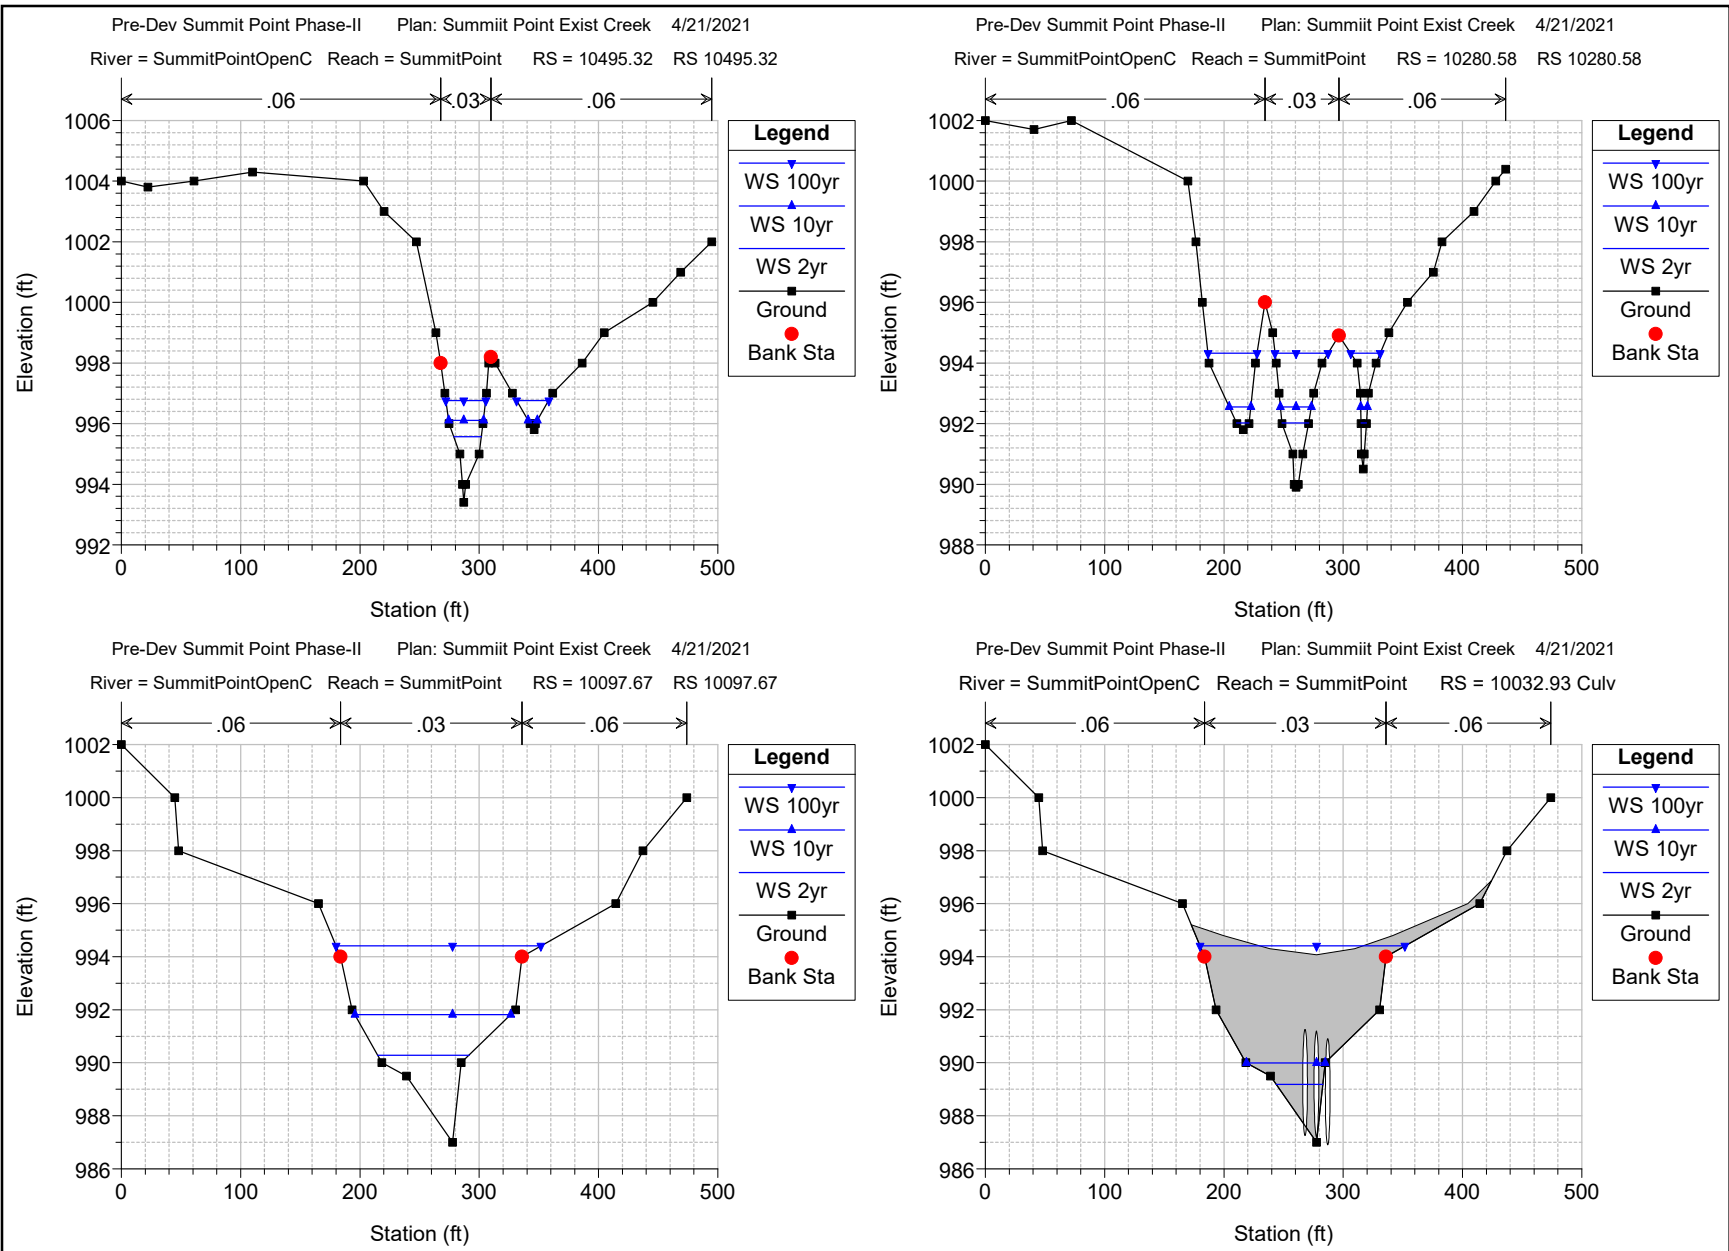

**Summit Point Apartments, Phase-II
HEC-RAS Analysis of Tributary P3
to Prairie Lee Lake, Lee's Summit, MO
April 21, 2021, CFS Proj. #21-5065**

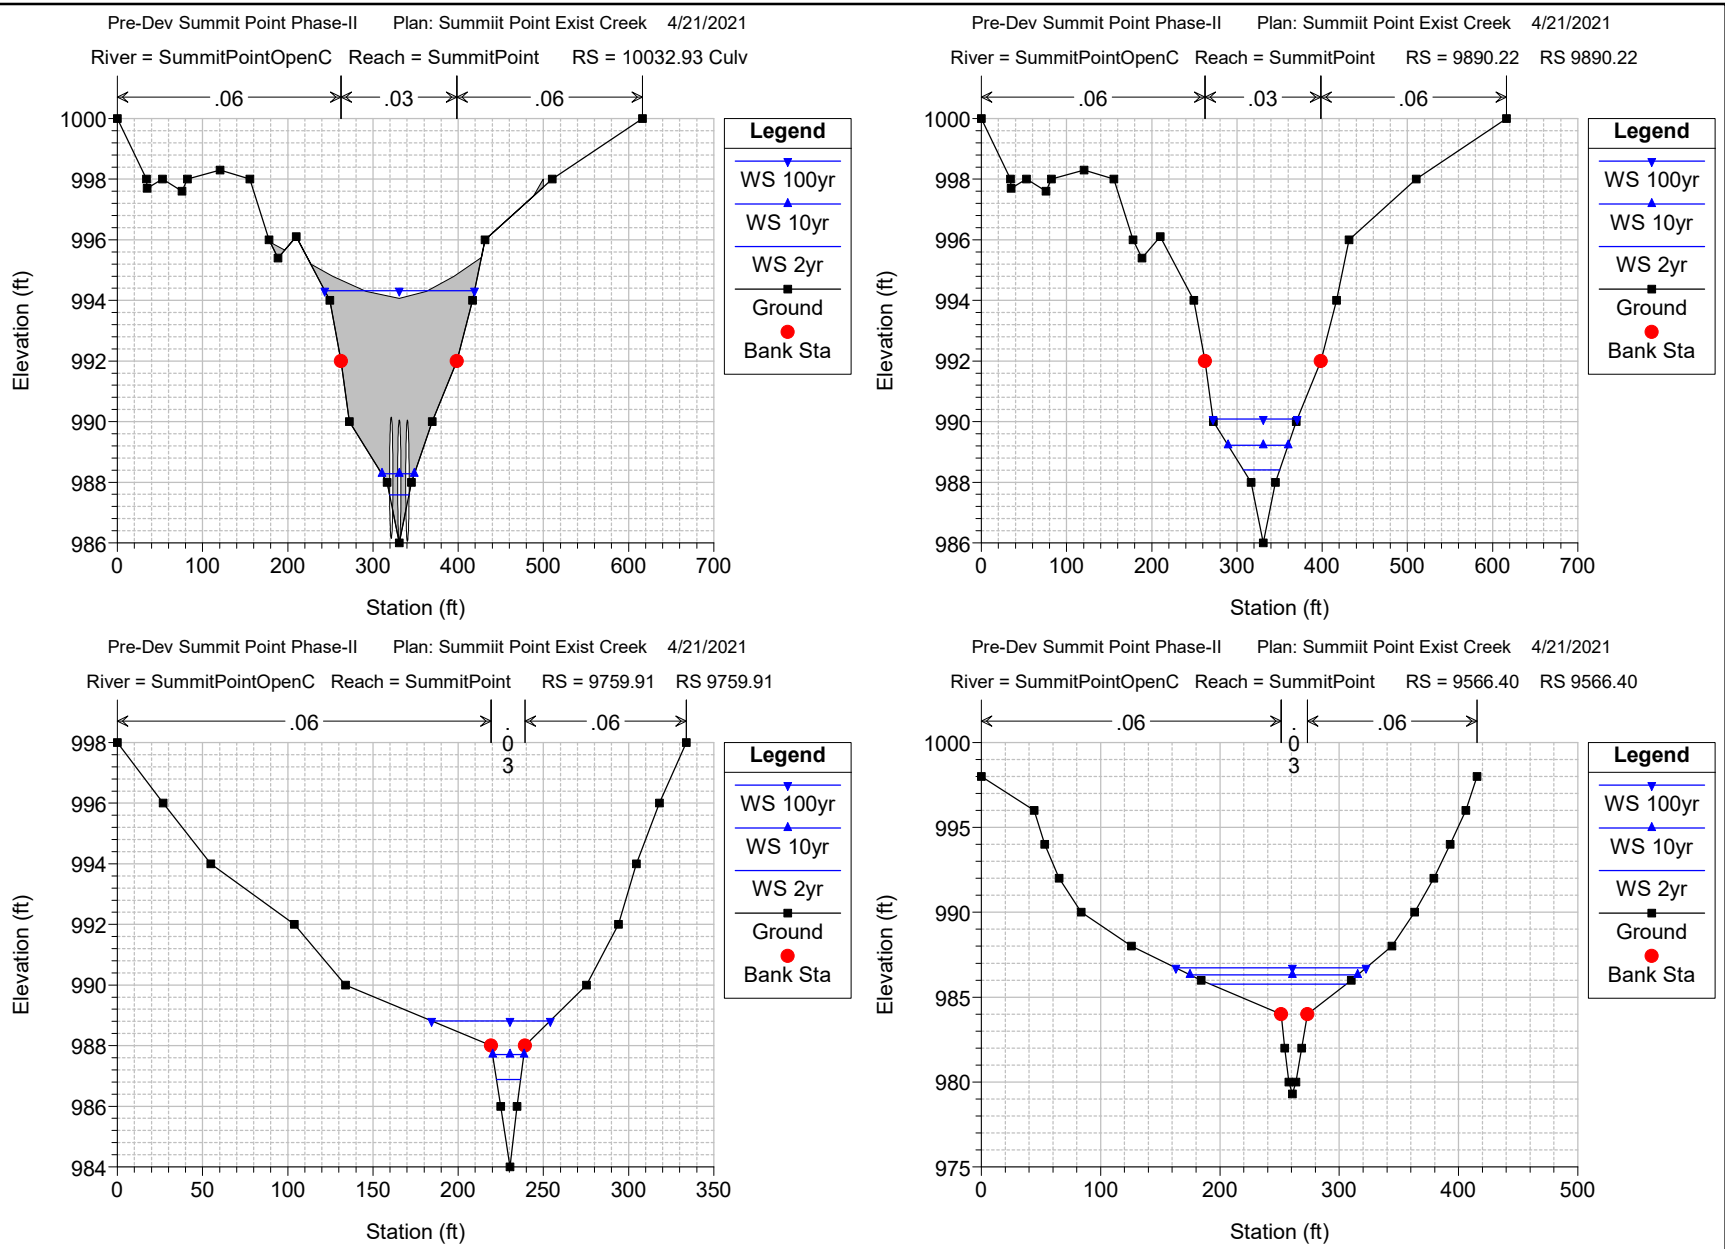

Summit Point Apartments, Phase-II
HEC-RAS Analysis of Tributary P3
to Prairie Lee Lake, Lee's Summit, MO
April 21, 2021, CFS Proj. #21-5065

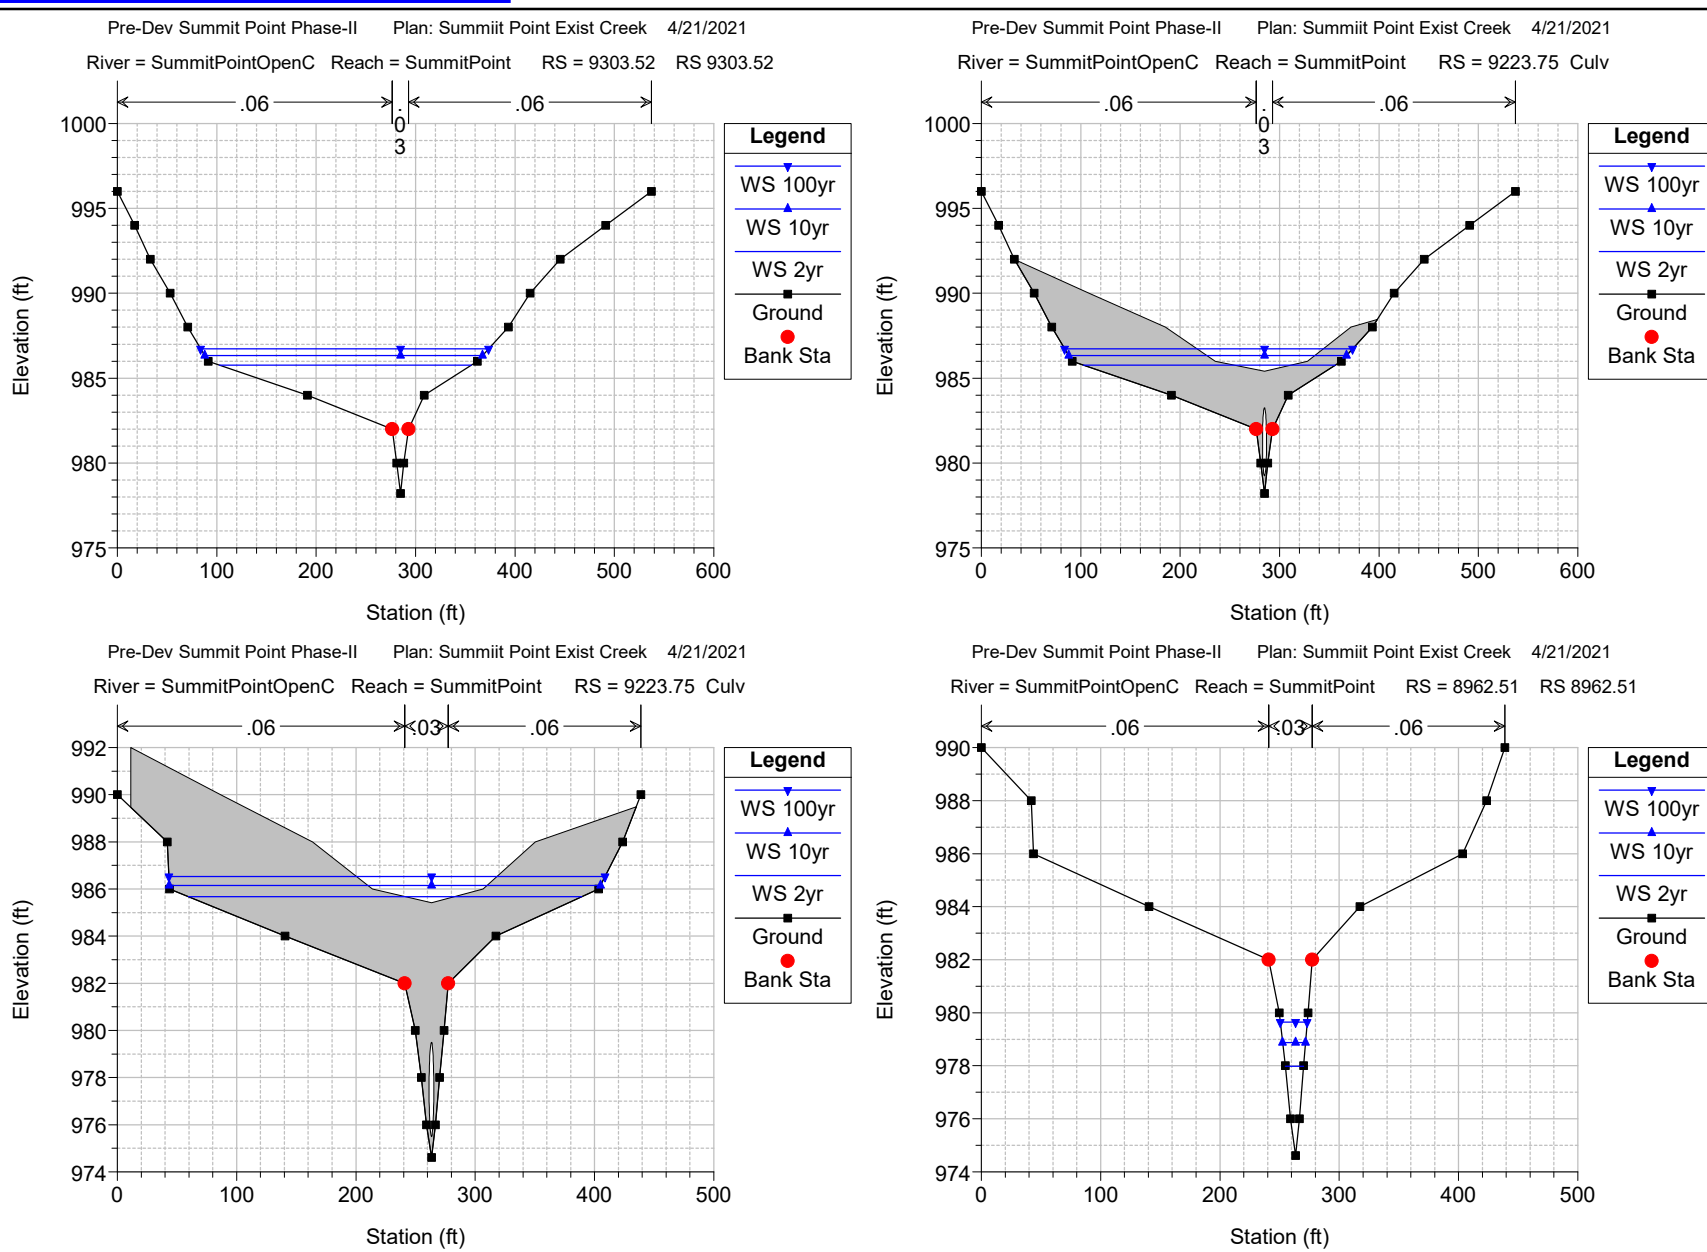


**Summit Point Apartments, Phase-II
HEC-RAS Analysis of Tributary P3
to Prairie Lee Lake, Lee's Summit, MO
April 21, 2021, CFS Proj. #21-5065**

Clogged Independence Ave Culvert Conditions

HEC-RAS Plan: ClogIndependence River: SummitPointOpenC Reach: SummitPoint

Reach	River Sta	Profile	Q Total (cfs)	Min Ch El (ft)	W.S. Elev (ft)	Crit W.S. (ft)	E.G. Elev (ft)	E.G. Slope (ft/ft)	Vel Chnl (ft/s)	Flow Area (sq ft)	Top Width (ft)	Froude # Chl
SummitPoint	8693.92	2yr	144.00	970.00	973.53	973.53	974.45	0.014489	7.71	18.67	10.37	1.01
SummitPoint	8693.92	10yr	273.00	970.00	974.71	974.71	975.74	0.009351	8.22	38.70	29.73	0.87
SummitPoint	8693.92	100yr	485.00	970.00	975.88	975.88	976.86	0.006529	8.70	90.64	59.22	0.77
SummitPoint	8833.36	2yr	144.00	972.75	976.52	976.52	977.28	0.014109	6.96	20.69	13.84	1.00
SummitPoint	8833.36	10yr	273.00	972.75	977.39	977.39	978.34	0.013094	7.82	34.93	19.03	1.02
SummitPoint	8833.36	100yr	485.00	972.75	978.43	978.43	979.51	0.009582	8.36	62.28	44.48	0.92
SummitPoint	8962.51	2yr	144.00	974.61	977.98		978.40	0.005623	5.18	27.80	15.44	0.68
SummitPoint	8962.51	10yr	273.00	974.61	978.88		979.50	0.006207	6.29	43.38	19.33	0.74
SummitPoint	8962.51	100yr	485.00	974.61	979.64	979.40	980.68	0.008505	8.17	59.38	22.65	0.89
SummitPoint	9223.75		Culvert									
SummitPoint	9303.52	2yr	135.00	978.20	986.37	981.27	986.37	0.000012	0.55	654.00	280.25	0.04
SummitPoint	9303.52	10yr	255.00	978.20	986.69	982.13	986.69	0.000031	0.91	745.66	288.57	0.06
SummitPoint	9303.52	100yr	454.00	978.20	987.09	983.26	987.10	0.000068	1.39	863.81	298.94	0.09
SummitPoint	9566.40	2yr	135.00	979.30	986.37		986.38	0.000050	0.97	255.31	142.81	0.08
SummitPoint	9566.40	10yr	255.00	979.30	986.69		986.72	0.000130	1.62	303.41	157.62	0.12
SummitPoint	9566.40	100yr	454.00	979.30	987.08		987.15	0.000283	2.51	369.60	175.97	0.18
SummitPoint	9759.91	2yr	135.00	984.00	986.89	986.89	987.60	0.013004	6.76	19.98	14.11	1.00
SummitPoint	9759.91	10yr	255.00	984.00	987.71	987.71	988.62	0.011960	7.65	33.32	18.38	1.00
SummitPoint	9759.91	100yr	454.00	984.00	988.82	988.82	989.72	0.007067	7.81	75.39	69.47	0.83
SummitPoint	9890.22	2yr	135.00	986.00	988.41		988.56	0.003910	3.11	43.37	42.75	0.54
SummitPoint	9890.22	10yr	255.00	986.00	989.22		989.34	0.002470	2.87	88.88	70.29	0.45
SummitPoint	9890.22	100yr	454.00	986.00	990.09		990.21	0.001628	2.78	163.09	98.81	0.38
SummitPoint	10032.93		Culvert									
SummitPoint	10097.67	2yr	135.00	987.00	990.29	988.69	990.31	0.000459	1.29	104.30	76.68	0.20
SummitPoint	10097.67	10yr	255.00	987.00	991.82	989.18	991.83	0.000152	0.97	263.02	130.59	0.12
SummitPoint	10097.67	100yr	454.00	987.00	994.41	989.80	994.41	0.000031	0.71	642.18	171.80	0.06
SummitPoint	10280.58	2yr	135.00	989.90	992.02	992.02	992.48	0.013677	5.62	27.60	37.67	1.00
SummitPoint	10280.58	10yr	255.00	989.90	992.55	992.55	993.11	0.011624	6.36	50.83	49.92	0.97
SummitPoint	10280.58	100yr	454.00	989.90	994.32		994.47	0.001927	3.52	185.39	110.41	0.43
SummitPoint	10495.32	2yr	117.00	993.40	995.57	995.57	996.04	0.014575	5.53	21.16	23.12	1.02
SummitPoint	10495.32	10yr	222.00	993.40	996.11	996.11	996.71	0.012556	6.22	36.71	37.00	0.99
SummitPoint	10495.32	100yr	398.00	993.40	996.76	996.76	997.45	0.009804	6.78	68.44	60.34	0.92
SummitPoint	10658.06	2yr	117.00	995.90	997.52		997.81	0.008351	4.38	27.00	30.65	0.79
SummitPoint	10658.06	10yr	222.00	995.90	997.96	997.84	998.43	0.008968	5.52	42.58	39.51	0.85
SummitPoint	10658.06	100yr	398.00	995.90	998.48	998.48	999.15	0.009555	6.73	70.53	69.06	0.92
SummitPoint	10856.09	2yr	77.00	997.50	999.40	999.39	999.87	0.014120	5.49	14.03	15.05	1.00
SummitPoint	10856.09	10yr	146.00	997.50	999.95	999.94	1000.52	0.013406	6.09	23.98	21.30	1.01
SummitPoint	10856.09	100yr	264.00	997.50	1000.59	1000.58	1001.24	0.012356	6.48	40.72	31.13	1.00
SummitPoint	11086.04	2yr	77.00	999.60	1001.65		1001.92	0.006053	4.13	18.63	15.65	0.67
SummitPoint	11086.04	10yr	146.00	999.60	1002.32		1002.66	0.006667	4.63	31.56	24.52	0.72
SummitPoint	11086.04	100yr	264.00	999.60	1002.98		1003.39	0.007107	5.13	51.47	36.47	0.76
SummitPoint	11275.44	2yr	77.00	1000.70	1003.12	1003.12	1003.89	0.015788	7.05	10.92	7.18	1.01
SummitPoint	11275.44	10yr	146.00	1000.70	1004.36	1004.36	1004.97	0.014598	6.26	23.31	19.08	1.00
SummitPoint	11275.44	100yr	264.00	1000.70	1005.09	1005.09	1005.62	0.014199	5.87	44.98	42.61	1.01

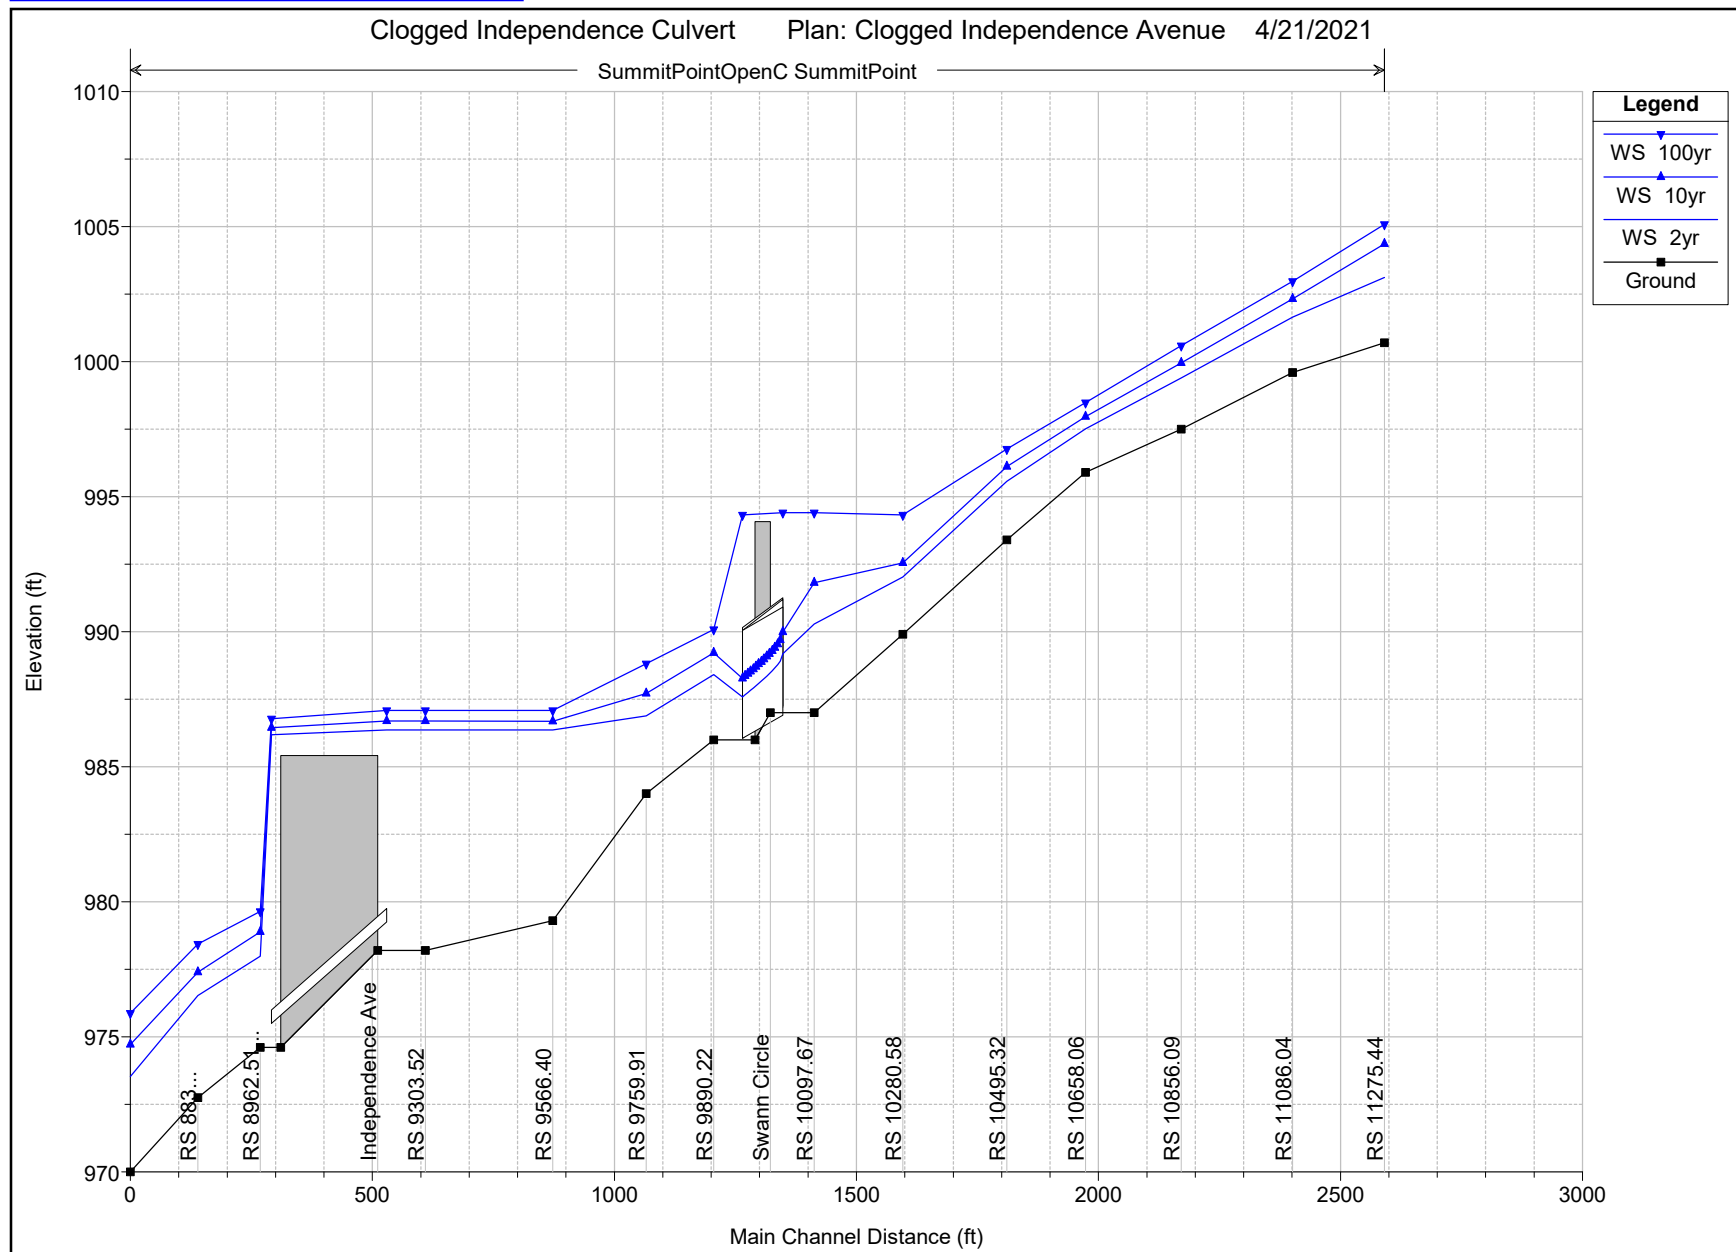

INSTALL 25' WIDE x 25' LONG GROUTED ROCK RIP-RAP EROSION CONTROL BLANKET AT 1.00% (SEE DETAIL - ALTERNATE 4" THICK REINFORCED CONCRETE CHANNEL). CARRY LINING UP SLOPE TO R/W LINE.

INSTALL 35' WIDE x 35' LONG RIP RAP

REGRADE EXISTING CHANNEL AT MINIMUM 1.0%

STA. 0+00
CONCRETE FLARED END SECTIONS WITH STANDARD TOE WALLS
F/L = 987.33

APPROXIMATE LOCATION 100-YEAR FLOOD BOUNDARY AFTER CONSTRUCTION

STA. 0+28.50
CATCH BASIN NO. 1-B
TOP = 992.55
SUMP CONDITION
F/L = 987.05
SIZE = 3' WIDE x 5' THROAT OPENING
(STA. 7+54.74 STREET, 16.5' LEFT)

STA. 0+61.50
CATCH BASIN NO. 1-C
TOP = 992.55
SUMP CONDITION
F/L = 986.39
SIZE = 3' WIDE x 5' THROAT OPENING
(STA. 7+54.74 STREET, 16.5' RIGHT)

STA. 1+00
CONCRETE FLARED END SECTIONS WITH STANDARD TOE WALLS
F/L = 986.39

INSTALL 30' WIDE FLAT BOTTOM x 60' LONG GROUTED ROCK RIP-RAP EROSION CONTROL BLANKET AT 0.40% (SEE DETAIL - ALTERNATE 4" THICK REINFORCED CONCRETE CHANNEL). CARRY LINING UP SLOPE TO 1' ABOVE TOP OF PIPES, BOTH STORM SEWERS


INSTALL 40' WIDE x 60' LONG RIP RAP

DISCHARGE AT DOWNSTREAM END OF PLAT (AT INDEPENDENCE AVENUE)


EXISTING 48" RCP
F/L = 979.0, R/W = 983.0
AT HW/D = 1.5, Q = ±125 CFS

EXISTING STORM SEWER IS OF INADEQUATE CAPACITY TO CARRY RUNOFF FROM A FULLY DEVELOPED WATERSHED.

DISCHARGE FROM OUTLET EROSION CONTROL BLANKET

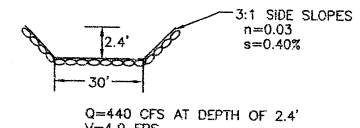

- NOTES:
- CONTRACTOR TO VERIFY EXACT LOCATION AND DEPTH OF EXISTING SANITARY SEWER MAIN PRIOR TO CONSTRUCTION.
 - ALL DISTANCES ARE CENTER OF STRUCTURE TO CENTER OF STRUCTURE.

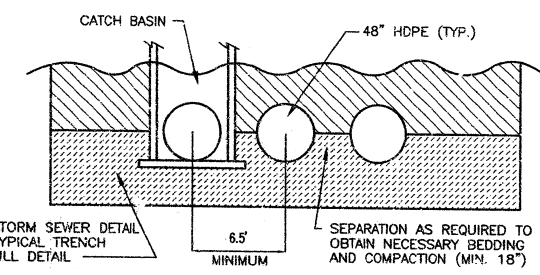

TYPICAL INSTALLATION
3 x 48" HDPE

STORM RUNOFF, NE SWANN ROAD

DRAINAGE AREA = 130 ACRES
T(C) = 15 MINUTES MAXIMUM
i(10) = 5.2, i(100) = 7.4
ASSUMED FULLY DEVELOPED WATERSHED, COMBINATION COMMERCIAL AND RESIDENTIAL.
C = 0.65
Q(10) = 440 CFS, Q(100) = 625 CFS

CAPACITY OF STREET CROSSING (10 YEAR STORM)

STORM PIPE = 48" HDPE
N = 0.012
CONVEYANCE FACTOR = 1555.3
SLOPE = 1.0%

Q = KS 1/2 = 155 CFS

CROSSING = 3 x 155 = 465 CFS

V AT DISCHARGE = 12.3 FPS (FROM PIPES)

DETENTION VOLUME CALCULATIONS

DRAINAGE AREA (MAPLE TREE MANOR) = 16.7 ACRES

C(B) = 0.2
C(A) = 5 AC. @ 0.2 AND 11.7 AC. @ 0.4 (ARTICLE IV-A-3) = 0.34

T(CB) = 15 MINUTES MAXIMUM, i(25) = 6.0, Q(B) = 20.0 CFS
T(CA) = 10.4 MINUTES, i(25) = 7.0, Q(A) = 39.7 CFS

V = 30 (Q(A) - Q(B)) K T(C) = 30 (39.7 - 20.0) (1.20) (10.4) = 7375 CUBIC FEET

DETENTION PROVIDED AT CROSSING

ELEVATION	STORAGE	RELEASE RATE
987.5	0	0
988	3,150 cf	±15 cfs
990	33,750 cf	240 cfs
992	76,950 cf	420 cfs



REQUIRED STORAGE = 7,375 CUBIC FEET AT ELEV. 988.2
AT R/W ELEVATION OF 993, ±105,000 CUBIC FEET OF STORAGE IS UTILIZED, BEFORE "OVER TOPPING" OF BERM.
RELEASE RATE FROM POND CONTROLLED BY HEADWATER DEPTH.

100-YEAR STORM

Q(100) = 625 CFS
Q(CAPACITY) OF STORM CROSSING = 465 CFS
ADDITIONAL RUNOFF = (625-465) = 160 CFS
ADDITIONAL RUNOFF FROM 100-YEAR STORM WILL "OVER TOP" R/W BERM AND FLOW ACROSS STREET. DEPTH OF RUNOFF CROSSING ROAD = ±0.25'.
MINIMUM LOW OPENING, LOTS 7, 8, 24 AND 25 TO BE 995.0.

100-YEAR STORM

BASED ON FEMA MAP, ESTIMATED 100-YEAR STORM ELEVATION AT STREET CROSSING = 992-994. HIGH WATER ELEVATION AFTER CONSTRUCTION = 993.25

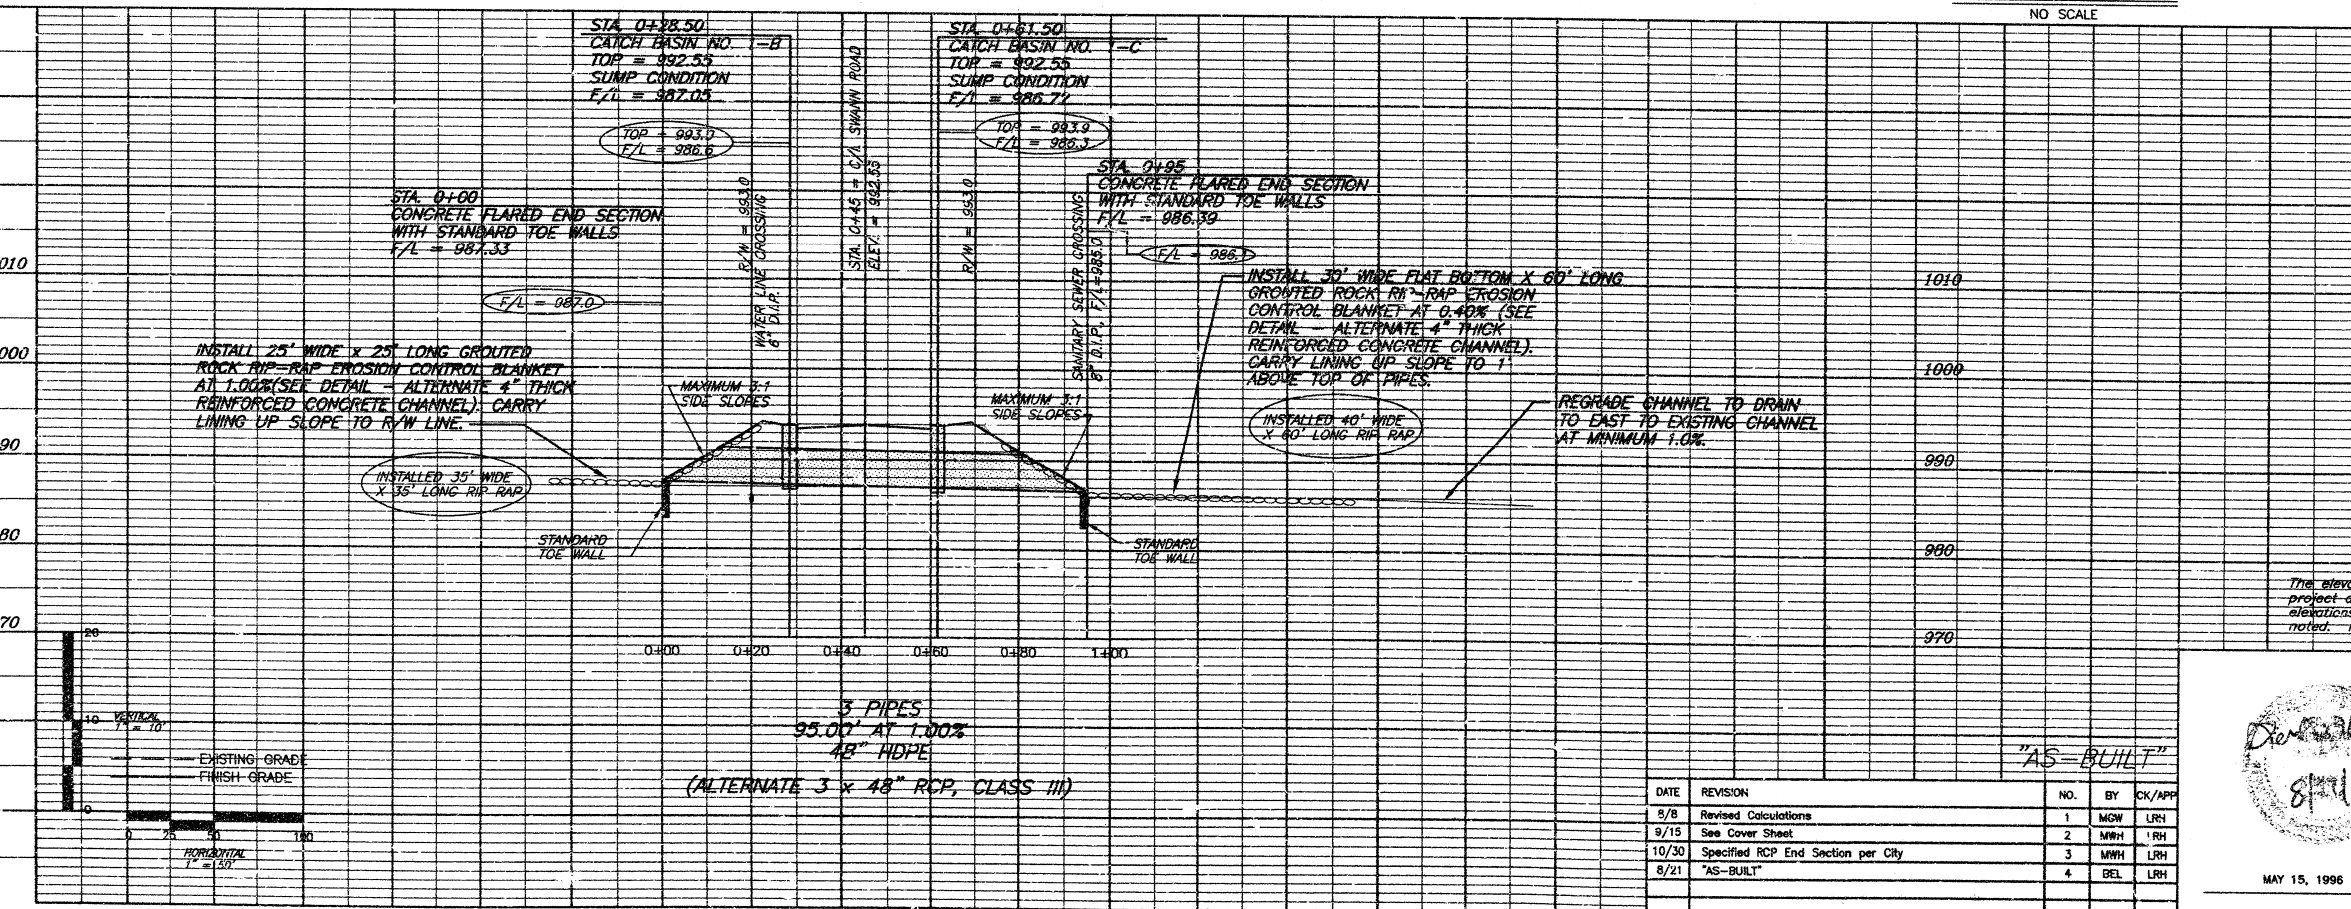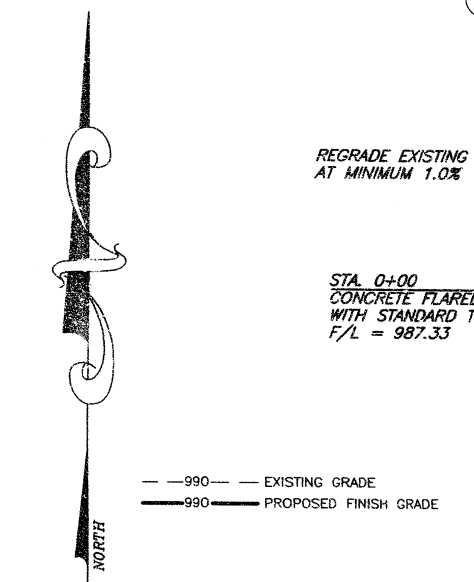

The elevations shown as "○" represent the elevations for this storm sewer on this project as determined this date. Grades shown as "●" were calculated from old elevations. Horizontal alignment is in substantial conformity with this drawing unless noted. Pipe gage used, depth of cover and clearances provided by contractor and City.

PLAN AND PROFILE
STORM SEWER NO. 1

MAPLE TREE MANOR
LOTS 1 THRU 37

LEE'S SUMMIT JACKSON COUNTY MISSOURI
E.J. WERNER & ASSOCIATES
CONSULTING ENGINEERS LAND SURVEYORS


DESIGNED LRH
CHECKED LRH
DETAILED MWH
APPROVED MWH
SCALE NOTED
DATE MAY 15, 1996

9 SHEET OF 20


DATE	REVISION	NO.	BY	CK/APP
5/8	Revised Calculations	1	MGW	LRH
9/15	See Cover Sheet	2	MWH	LRH
10/30	Specified RCP End Section per City	3	MWH	LRH
8/21	"AS-BUILT"	4	DEL	LRH

Stamp: *DeWitt*
8/1/17


MAY 15, 1996

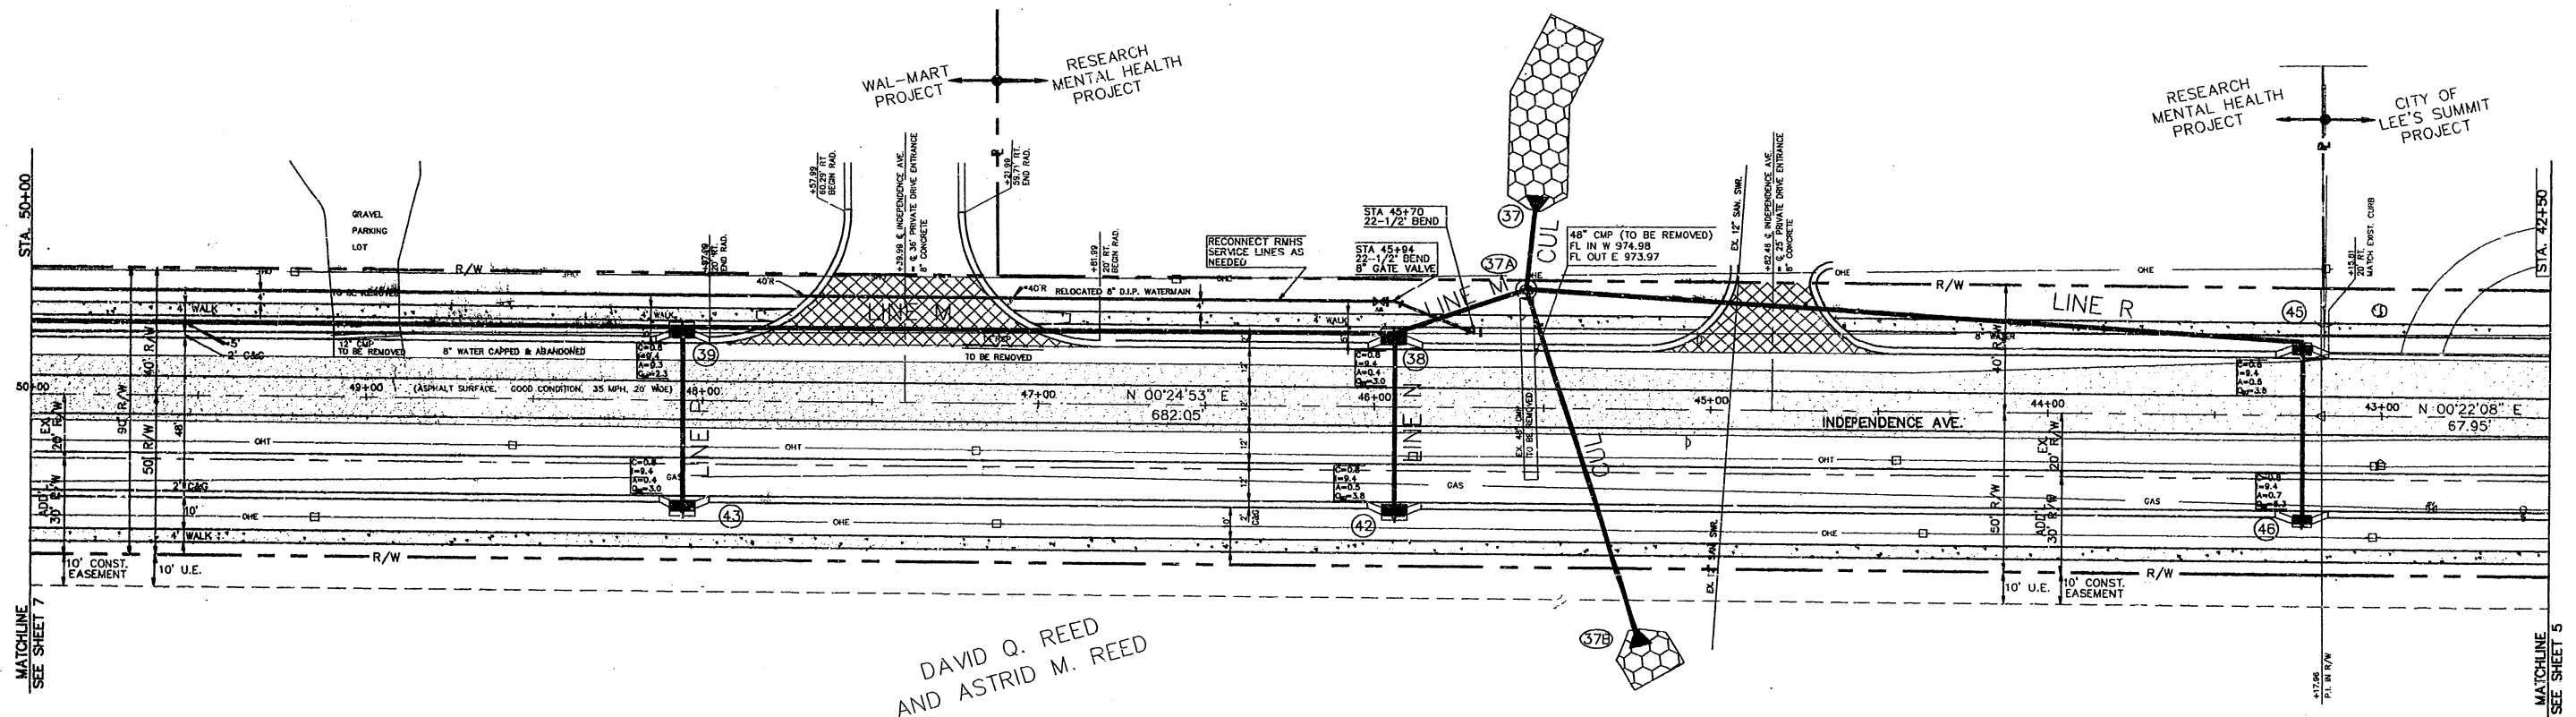

DAVID Q. REED
AND ASTRID M. REED

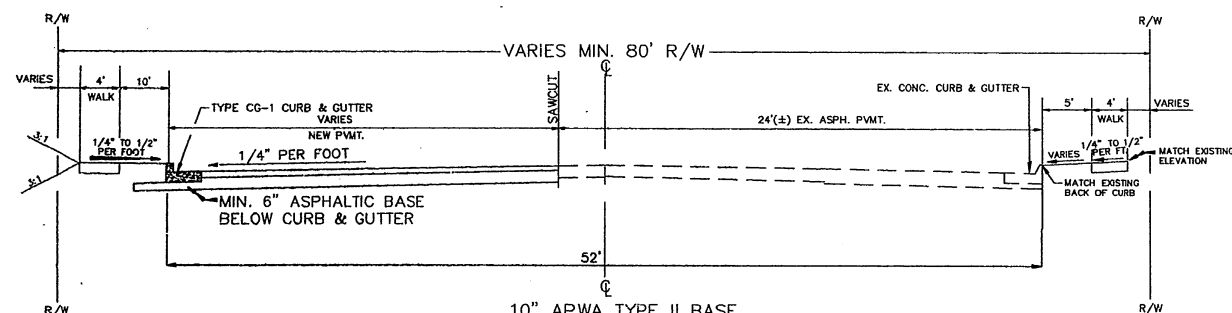

10" APWA TYPE II BASE
2" APWA TYPE III SURFACE
OR 9" CONCRETE
EITHER OPTION INSTALLED ON 6"-95%
COMPACTED SUBGRADE (STD PROCTOR DENSITY)
TYPICAL SECTION - INDEPENDENCE AVE.
STA. 41+85(±) TO 43+15.81
NOT TO SCALE

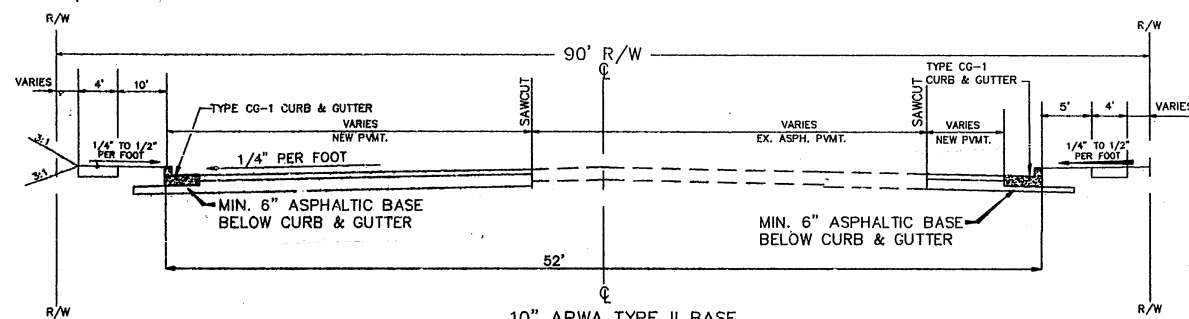

10" APWA TYPE II BASE
2" APWA TYPE III SURFACE
OR 9" CONCRETE
EITHER OPTION INSTALLED ON 6"-95%
COMPACTED SUBGRADE (STD PROCTOR DENSITY)
TYPICAL SECTION - INDEPENDENCE AVE.
STA. 43+15.81 TO STA. 55+84.26
NOT TO SCALE

CULVERT STORM SEWER LINE

- ③⑦ STA. 45+52.53 @ INDEP. AVE.
56.48' RT. CONST.
29.48 LF-54" RCP @ 1.00%
W/FES & TOEWALL AND 55 LF
OF RIPRAP
FL(out)= 977.99-976.79
- ③⑧ STA. 45+55.42 @ INDEP. AVE.
37.16' RT.
CONST. 4'-7" 6-CUL1
116.78 LF-48" RCP
@ 1.00% (CULVERT)
41.08 LF-24" RCP
@ 1.00% (LINE M)
232.04 LF-15" RCP
@ 2.25% (LINE R)
TOP = 985.60-49
FL(in-CUL)= 977.79-976.08
FL(in-M)= 978.68-33
FL(in-R)= 986.88-979.68
FL(out)= 977.20-08
- ③⑨ STA. 45+20.57 @ INDEP. AVE.
74.30' LT.
CONST. 48" FES & TOEWALL
W/ 10 LF OF RIPRAP
END OF CULVERT
FL(in)=978.96-979.25

STORM SEWER LINE M

- ③⑩ STA. 45+93.99 @ INDEP. AVE.
35.00' LT.
CONST. 4'-5" CIS-M1
212.81 LF-18" RCP
@ 2.50% (LINE M)
58.00 LF-15" RCP
@ 0.50% (LINE N)
TOP = 985.60-11
FL(in-M)= 979.56-51
FL(in-N)= 980.81-61
FL(out)= 979.99-978.91
- ③⑪ STA. 48+05.99 @ INDEP. AVE.
23.00' RT.
CONST. 3'-5" CIS-M2
311.36 LF-15" RCP
@ 2.72% (LINE M)
58.00 LF-15" RCP
@ 0.50% (LINE P)
TOP = 986.91-989.48
FL(in-M)= 986.41-984.98
FL(in-P)= 984.31-68
FL(out)= 983.89-984.48
- ③⑫ STA. 45+93.99 @ INDEP. AVE.
35.00' LT.
CONST. 3'-5" CIS-N1
END OF LINE N
TOP = 985.20-28
FL(out)= 981.20-980.88

STORM SEWER LINE P


- ③⑬ STA. 48+05.99 @ INDEP. AVE.
23.00' RT.
CONST. 3'-5" CIS-P1
END OF LINE P
TOP = 986.79-989.11
FL(out)= 984.60-985.11

STORM SEWER LINE R

- ③⑭ STA. 43+23.81 @ INDEP. AVE.
23.00' RT.
CONST. 3'-5" CI-R1
38.00 LF-15" RCP
@ 1.00%
TOP = 982.50
FL(in)= 986.87-00
FL(out)= 986.10-984.60
- ③⑮ STA. 43+23.81 @ INDEP. AVE.
35.00' LT.
CONST. 3'-5" CI-R2
TOP = 982.55-01
FL(out)= 987.85-04

LEGEND

- PROPOSED CONC.
WALK
- EXST. PAVEMENT
- PROPOSED CONC.
DRIVEWAY

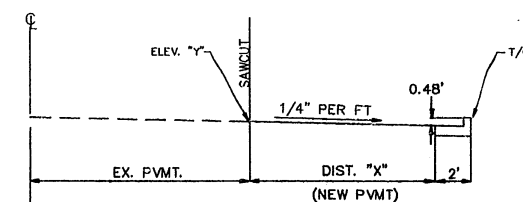


STAKING FORMULA (TYP. ABOUT C):
ELEV. "Y" - (DIST. "X" x 1/4" PER FT.) + 0.48' = T/C
(ELEV. "Y" AND DIST. "X" VERIFIED AT EACH STA.)

AS-BUILT




NO.	DATE	REVISIONS	SHE.
2	2/3/93	MISC. REVISIONS	SHE.
1	12/14/92	CITY RESUBMITTAL	SHE.
INDEPENDENCE AVE. - STA. 42+50 TO 50+00			
P.O. BOX 1304 25TH NORTH JACOBI JACKSON CITY, KANSAS 64401 TEL 783-1000 FAX 783-7744		KAW VALLEY ENGINEERING 128 N.W. PARKWAY ATYPOKA, OKLAHOMA 74509 (918) 937-2929 C.F.A. STINGOS	
PROJ. NO. 10-831 DATE 10-28-92 CAD BY WJS CHECKED BY C.F.A. STINGOS SCALE 8" = 1'			


8154

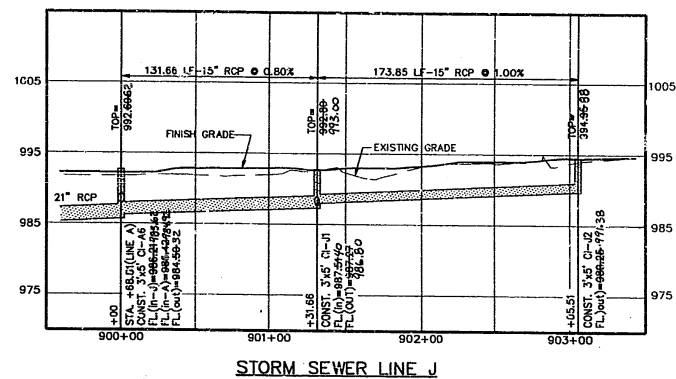


STORM SEWER LINE J

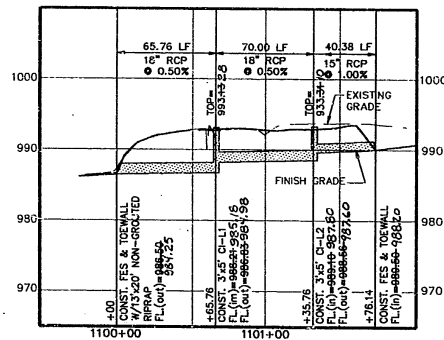


STORM SEWER LINE L

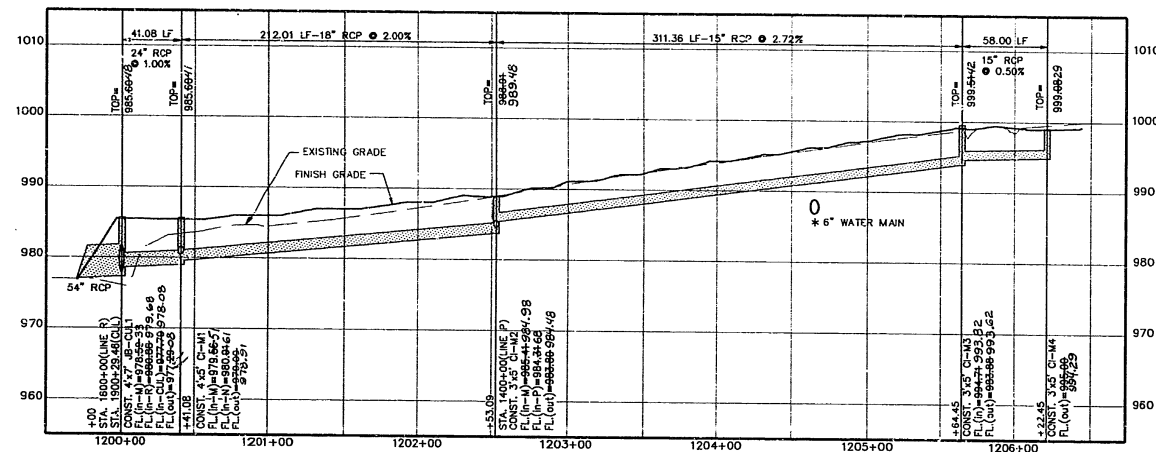


STORM SEWER LINE M

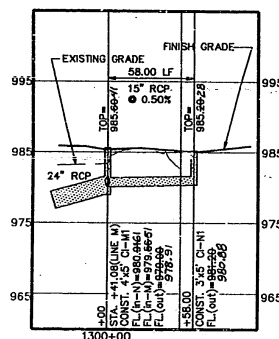


STORM SEWER LINE N

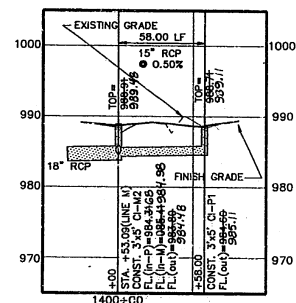


STORM SEWER LINE P

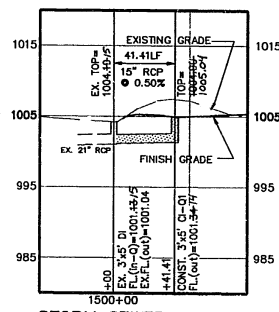


STORM SEWER LINE Q

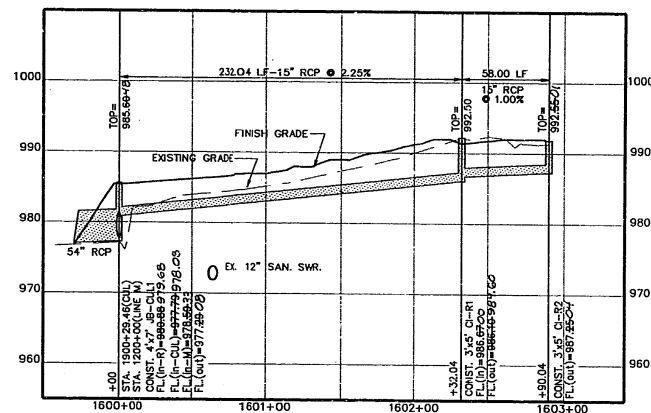


STORM SEWER LINE R

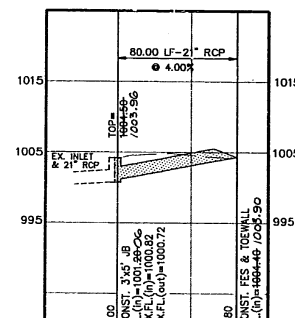

STORM SEWER LINE S

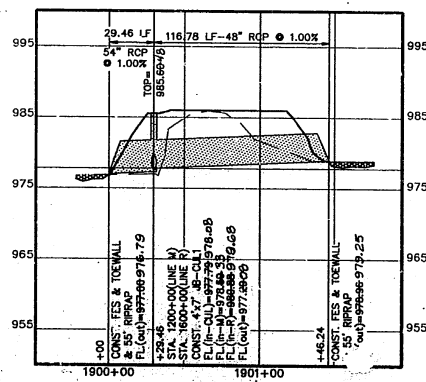

CULVERT

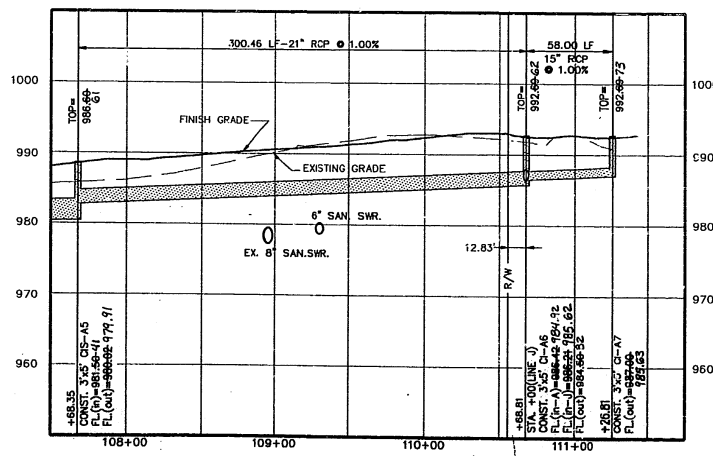

STORM SEWER LINE A

AS-BUILT



* NOTE:

1. DEFLECT WATER MAIN UNDER STORM SEWER AS SHOWN, PER AWWA STANDARDS AND SPECIFICATIONS

2	2/3/93	MISC. REVISIONS	SHE
1	12/14/92	QTY RESUBMITAL	SHE
STORM SEWER PROFILES			
P.O. BOX 1504 338 NORTH JACKSON JUNCTION CITY, KANSAS 66501 TEL: 913-752-2245 FAX: 913-752-1744		123 N.W. PARKWAY P.O. BOX 1504 JUNCTION CITY, KANSAS 66501 TEL: 913-752-2245 FAX: 913-752-1744	
KAW VALLEY ENGINEERING		PROJ. NO. 10,821 DATE 11/20/92 CAD BY: OTD CHECKED BY: C.F.N. SHEET 8 OF 14	

8157

NOTES TO USERS

This map is for use in administering the National Flood Insurance Program. It does not necessarily identify all areas subject to flooding, particularly from local drainage sources or small streams. The community map repository should be consulted for possible updated or additional flood hazard information.

To obtain more detailed information in areas where Base Flood Elevations (BFEs) and/or floodways have been determined, users are encouraged to consult the Flood Profiles and Floodway Data and/or Summary of Stillwater Elevations tables contained within the Flood Insurance Study (FIS) Report that accompanies this FIRM. Users should be aware that BFEs shown on the FIRM represent rounded whole-foot elevations. These BFEs are intended for flood insurance rating purposes only and should not be used as the sole source of flood elevation information. Accordingly, flood elevation data presented in the FIS Report should be utilized in conjunction with the FIRM for purposes of construction and/or floodplain management.

Boundaries of the floodways were computed at cross sections and interpolated between cross sections. The floodways were based on hydraulic considerations with regard to requirements of the National Flood Insurance Program. Floodway widths and other pertinent floodway data are provided in the Flood Insurance Study Report for this jurisdiction.

Certain areas not in Special Flood Hazard Areas may be protected by flood control structures. Refer to Section 2.4 "Flood Protection Measures" of the Flood Insurance Study Report for information on flood control structures for this jurisdiction.

The projection used in the preparation of this map was Missouri State Plane West Zone (FIPS zone 2403). The horizontal datum was NAD 83, GRS 1980 spheroid. Differences in datum, spheroid, projection or UTM zones used in the production of FIRMs for adjacent jurisdictions may result in slight positional differences in map features across jurisdiction boundaries. These differences do not affect the accuracy of this FIRM.

Flood elevations on this map are referenced to the North American Vertical Datum of 1988. These flood elevations must be compared to structure and ground elevations referenced to the same vertical datum. For information regarding conversion between the National Geodetic Vertical Datum of 1929 and the North American Vertical Datum of 1988, visit the National Geodetic Survey website at <http://www.ngs.noaa.gov> or contact the National Geodetic Survey at the following address:

NGS Information Services
NOAA, NINGS12
National Geodetic Survey
SSMC-3, #9202
1315 East-West Highway
Silver Spring, Maryland 20910-3282
(301) 713-3242

To obtain current elevation, description, and/or location information for bench marks shown on this map, please contact the Information Services Branch of the National Geodetic Survey at (301) 713-3242, or visit its website at <http://www.ngs.noaa.gov>.

Base map information shown on this FIRM was derived from the U.S.D.A Farm Service National Agriculture Imagery Program (NAIP) dated 2014. Produced at scale of 1:24,000.


The profile baselines depicted on this map represent the hydraulic modeling baselines that match the flood profiles in the FIS report. As a result of improved topographic data, the profile baseline, in some cases, may deviate significantly from the channel centerline or appear outside the SFHA.

Based on updated topographic information, this map reflects more detailed and up-to-date stream channel configurations and floodplain delineations than those shown on the previous FIRM for this jurisdiction. As a result, the Flood Profiles and Floodway Data tables for multiple streams in the Flood Insurance Study Report (which contains authoritative hydraulic data) may reflect stream channel distances that differ from what is shown on the map. Also, the road to floodplain relationships for unreviewed streams may differ from what is shown on previous maps.

Corporate limits shown on this map are based on the best data available at the time of publication. Because changes due to annexations or de-annexations may have occurred after this map was published, map users should contact appropriate community officials to verify current corporate limit locations.

Please refer to the separately printed Map Index for an overview map of the county showing the layout of map panels, community map repository addresses, and a Listing of Communities table containing National Flood Insurance Program dates for each community as well as a listing of the panels on which each community is located.

For information on available products associated with this FIRM visit the Map Service Center (MSC) website at <http://msc.fema.gov>. Available products may include previously issued Letters of Map Change, a Flood Insurance Study Report, and/or digital versions of this map. Many of these products can be ordered or obtained directly from the MSC website.

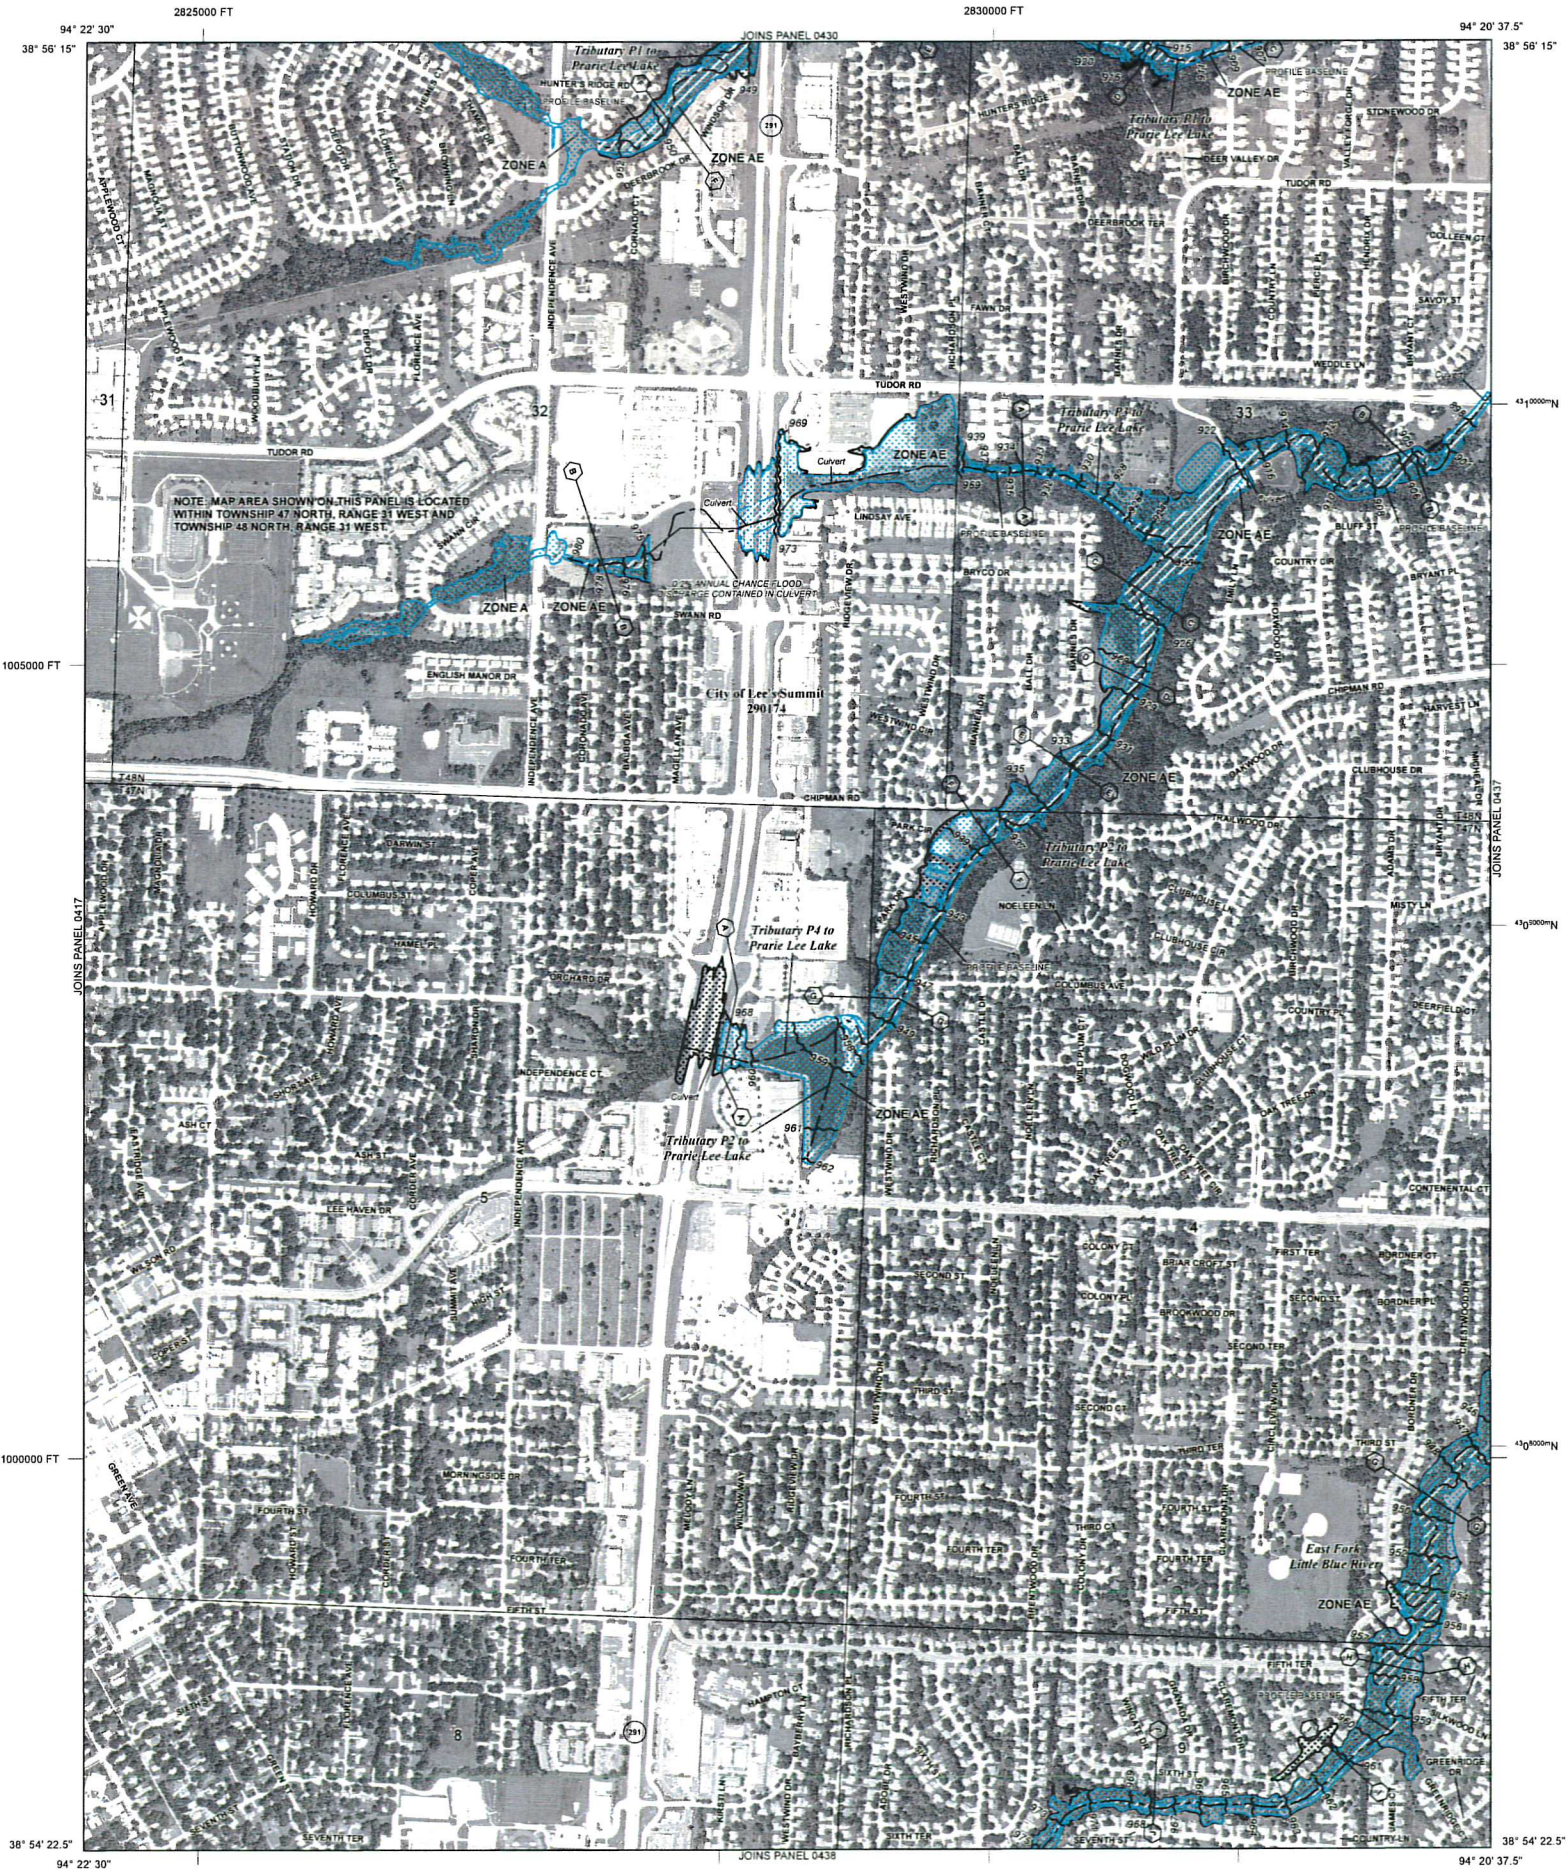

LEGEND

- SPECIAL FLOOD HAZARD AREAS (SFHAs) SUBJECT TO INUNDATION BY THE 1% ANNUAL CHANCE FLOOD**
The 1% annual chance flood (100 year flood), also known as the "base flood," is the flood that has a 1% chance of being equalled or exceeded in any given year. The Special Flood Hazard Area is the area subject to flooding by the 1% annual chance flood. Areas of Special Flood Hazard include Zones A, AE, AH, AO, AR, A99, V, and VE. The Base Flood Elevation is the water-surface elevation of the 1% annual chance flood.
- ZONE A**
No base Flood Elevations determined.
- ZONE AE**
Base Flood Elevations determined.
- ZONE AH**
Flood depths of 1 to 3 feet (usually areas of ponding); Base Flood Elevations determined.
- ZONE AO**
Flood depths of 1 to 3 feet (usually sheet flow on sloping terrain); average depths determined. For areas of alluvial fan flooding, velocities also determined.
- ZONE AR**
Special Flood Hazard Areas formerly protected from the 1% annual chance flood by a flood control system that was subsequently decertified. Zone AR indicates that the former flood control system is being restored to provide protection from the 1% annual chance or greater flood.
- ZONE A99**
Area to be protected from 1% annual chance flood by a Federal flood protection system under construction; no Base Flood Elevations determined.
- ZONE V**
Coastal flood zone with velocity hazard (wave action); no Base Flood Elevations determined.
- ZONE VE**
Coastal flood zone with velocity hazard (wave action); Base Flood Elevations determined.
- FLOODWAY AREAS IN ZONE AE**
The floodway is the channel of a stream plus any adjacent floodplain areas that must be kept free of encroachment so that the 1% annual chance flood can be carried without substantial increases in flood heights.
- OTHER FLOOD AREAS**
- ZONE X**
Areas of 0.2% annual chance flood; areas of 1% annual chance flood with average depths of less than 1 foot or with drainage areas less than 1 square mile; and areas protected by levees from 1% annual chance flood.
- OTHER AREAS**
- ZONE X**
Areas determined to be outside the 0.2% annual chance floodplain.
- ZONE D**
Areas in which flood hazards are undetermined, but possible.
- COASTAL BARRIER RESOURCES SYSTEM (CBRS) AREAS**
- OTHERWISE PROTECTED AREAS (OPAs)**
CBRS areas and OPAs are normally located within or adjacent to Special Flood Hazard Areas.
- 1% Annual Chance Floodplain Boundary
0.2% Annual Chance Floodplain Boundary
Floodway boundary
Zone D boundary
CBRS and OPA boundary
Boundary dividing Special Flood Hazard Area Zones and boundary dividing Special Flood Hazard Areas of different Base Flood Elevations, flood depths, or flood velocities.
Base Flood Elevation line and value; elevation in feet
Base Flood Elevation value where uniform within zone; elevation in feet
- *Referenced to the North American Vertical Datum of 1988
- Cross section line**
Transsect line
Culvert
Bridge
Geographic coordinates referenced to the North American Datum of 1983 (NAD 83) Western Hemisphere
5000-foot ticks: Missouri State Plane West Zone (FIPS Zone 2403), Transverse Mercator projection
Bench mark (see explanation in Notes to Users section of this FIRM panel)
M 15
River Mile
- MAP REPOSITORIES**
Refer to Map Repositories list on Map Index.
EFFECTIVE DATE OF COUNTYWIDE FLOOD INSURANCE RATE MAP
September 29, 2008
EFFECTIVE DATE(S) OF REVISION(S) TO THIS PANEL
January 20, 2017 - to change Special Flood Hazard Areas
- For community map revision history prior to countywide mapping, refer to the Community Map History table located in the Flood Insurance Study report for this jurisdiction.
To determine if flood insurance is available in this community, contact your insurance agent or call the National Flood Insurance Program at 1-800-638-6620.
- MAP SCALE 1" = 500'**
250 0 500 1000
150 0 150 300
FEET
METERS

NATIONAL FLOOD INSURANCE PROGRAM

PANEL 0436G

FIRM

FLOOD INSURANCE RATE MAP
JACKSON COUNTY,
MISSOURI
AND INCORPORATED AREAS

PANEL 436 OF 625
(SEE MAP INDEX FOR FIRM PANEL LAYOUT)

CONTAINS:

COMMUNITY	NUMBER	PANEL	SUFFIX
LEE'S SUMMIT CITY OF	290174	0436	G

Notice to User: The Map Number shown below should be used when placing map orders; the Community Number shown above should be used on insurance applications for the subject community.



MAP NUMBER
29095C0436G
MAP REVISED
JANUARY 20, 2017
Federal Emergency Management Agency