


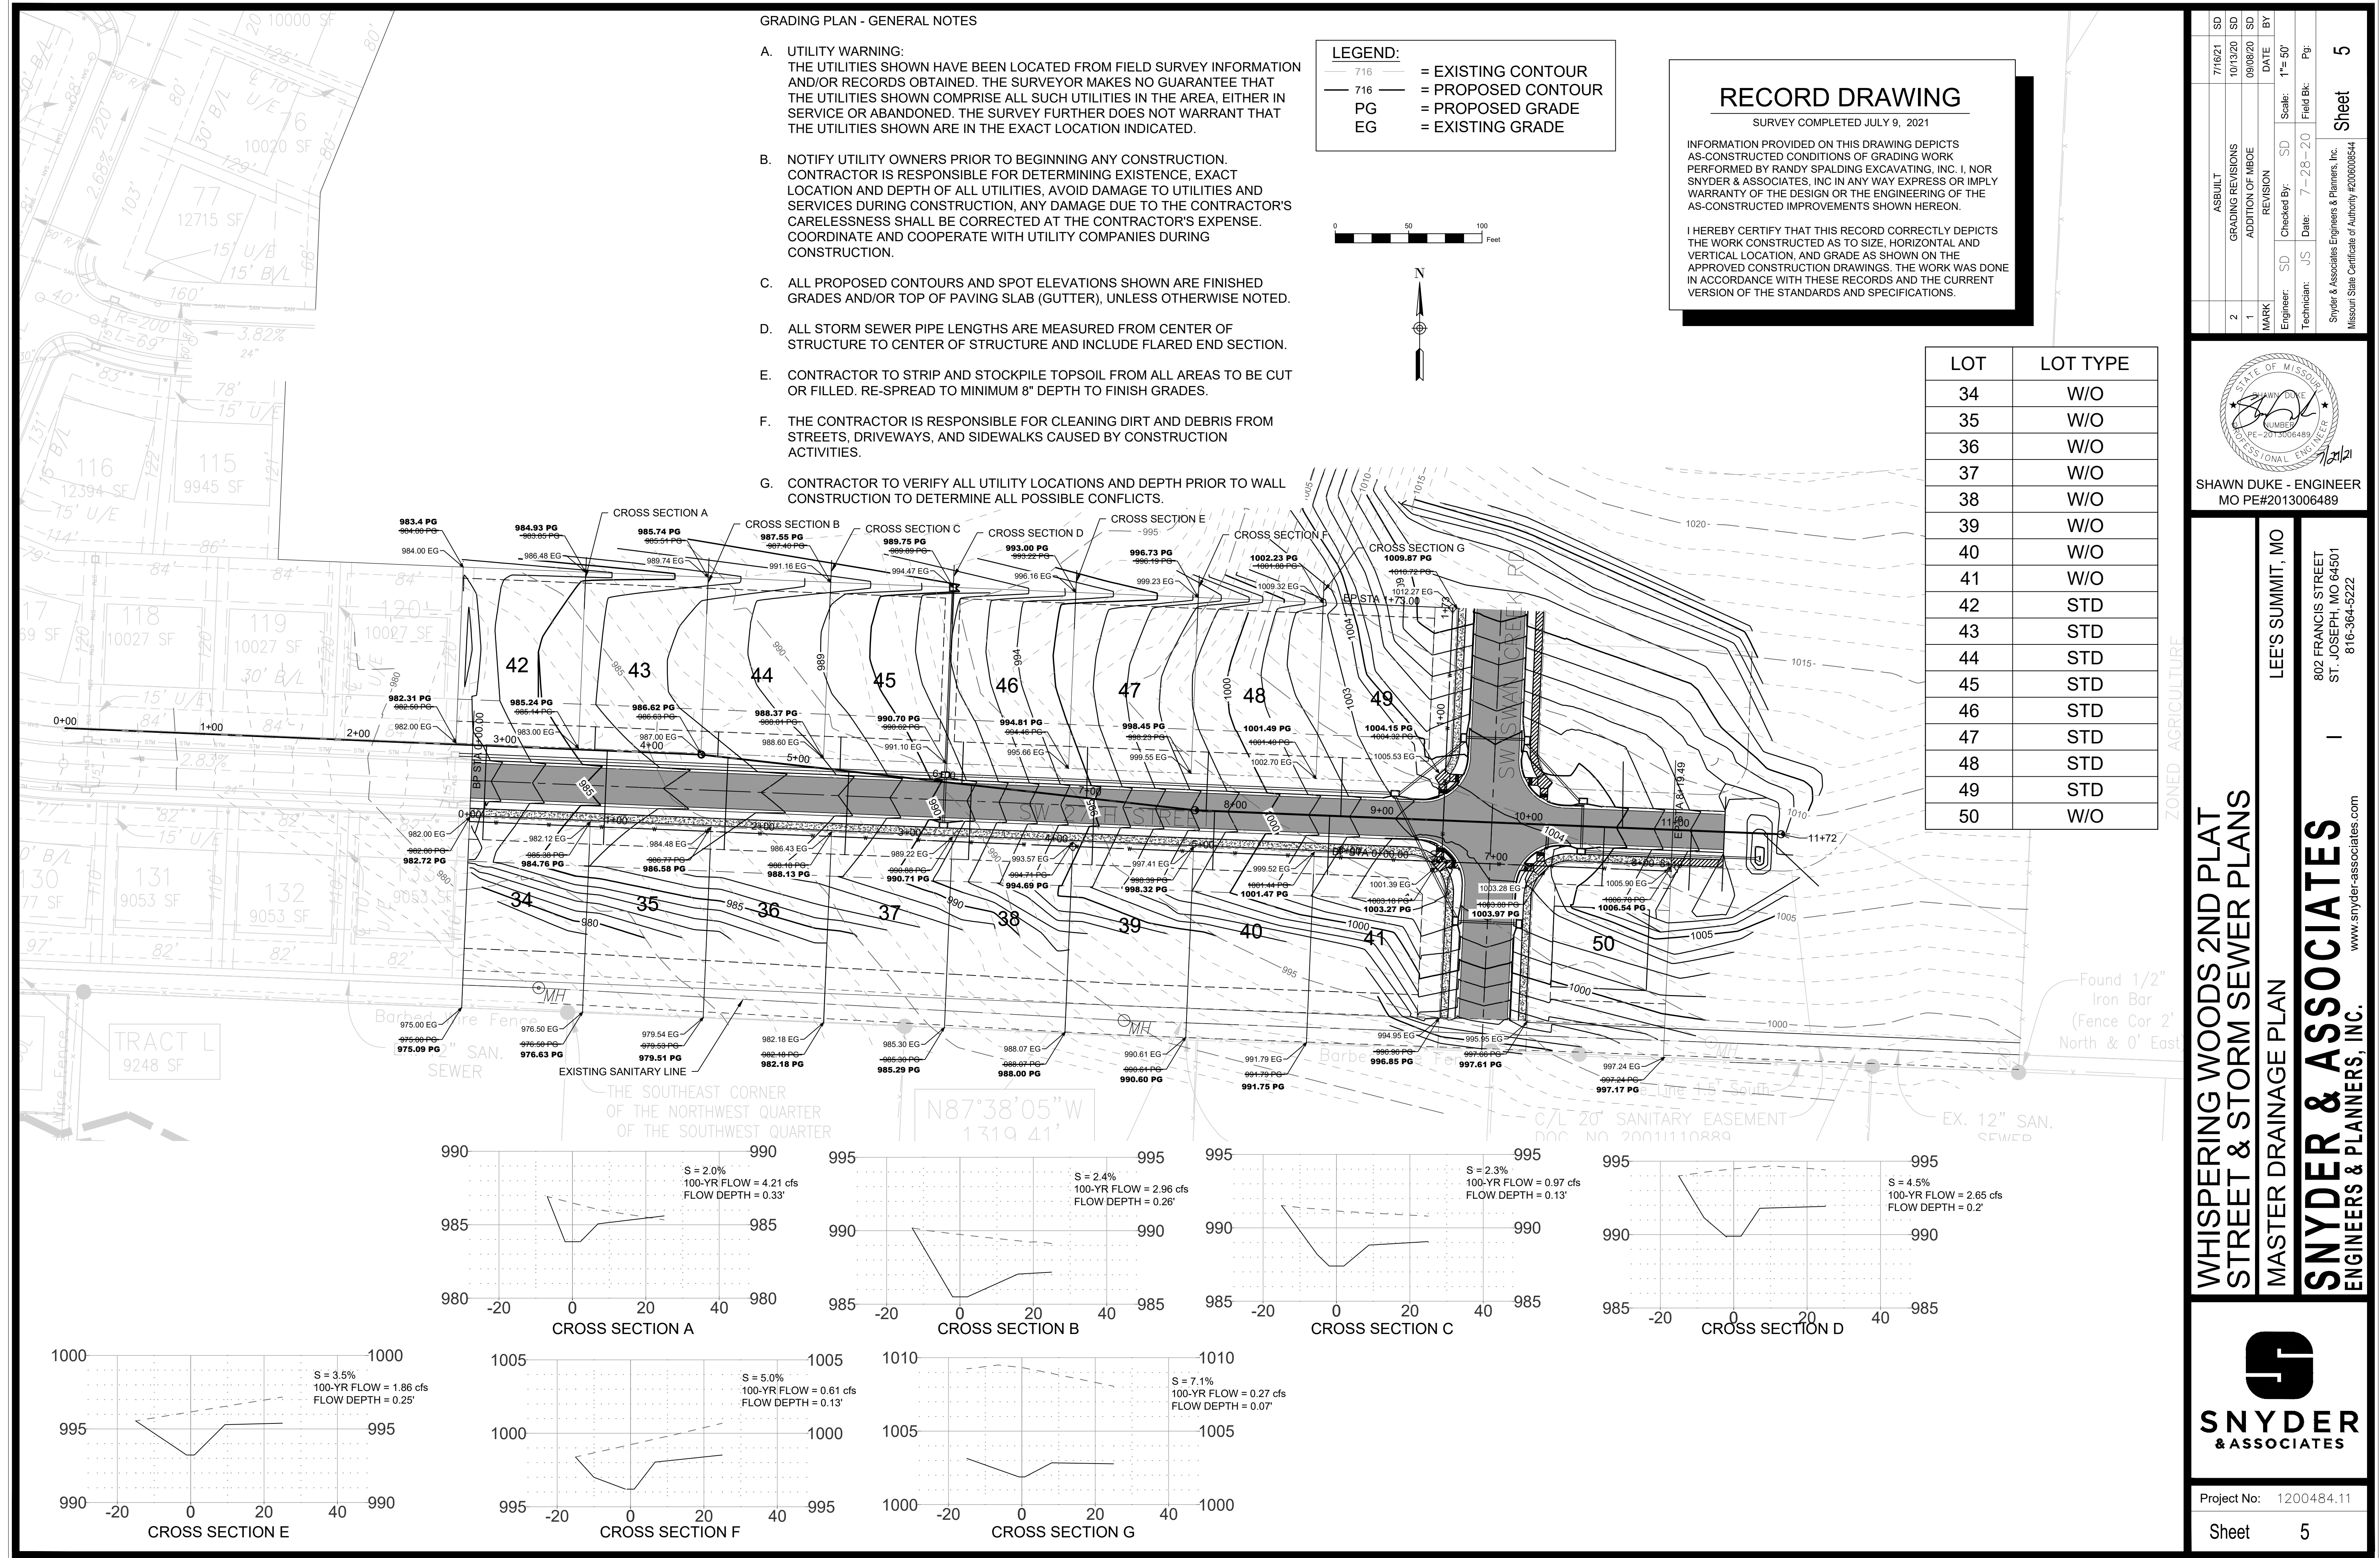

SD	7/16/21	ASBUILT	SD	10/13/20	GRADING REVISIONS	SD	09/08/20	ADDITION OF MBOE	BY	DATE	1"= 60'	Scale	Field Bk.	5	Sheet
2			1			MARK			Engineer:	SD	Checked By:	SD	Date:	7-28-20	Field Bk.
						Technician:	JS								

SHAWN DUKE - ENGINEER
MO PE#2013006489

LEE'S SUMMIT, MO

802 FRANCIS STREET
ST. JOSEPH, MO 64501
816-364-5222

SNYDER & ASSOCIATES
ENGINEERS & PLANNERS, INC.
www.snyder-associates.com

Project No: 1200484.11

Sheet 5