


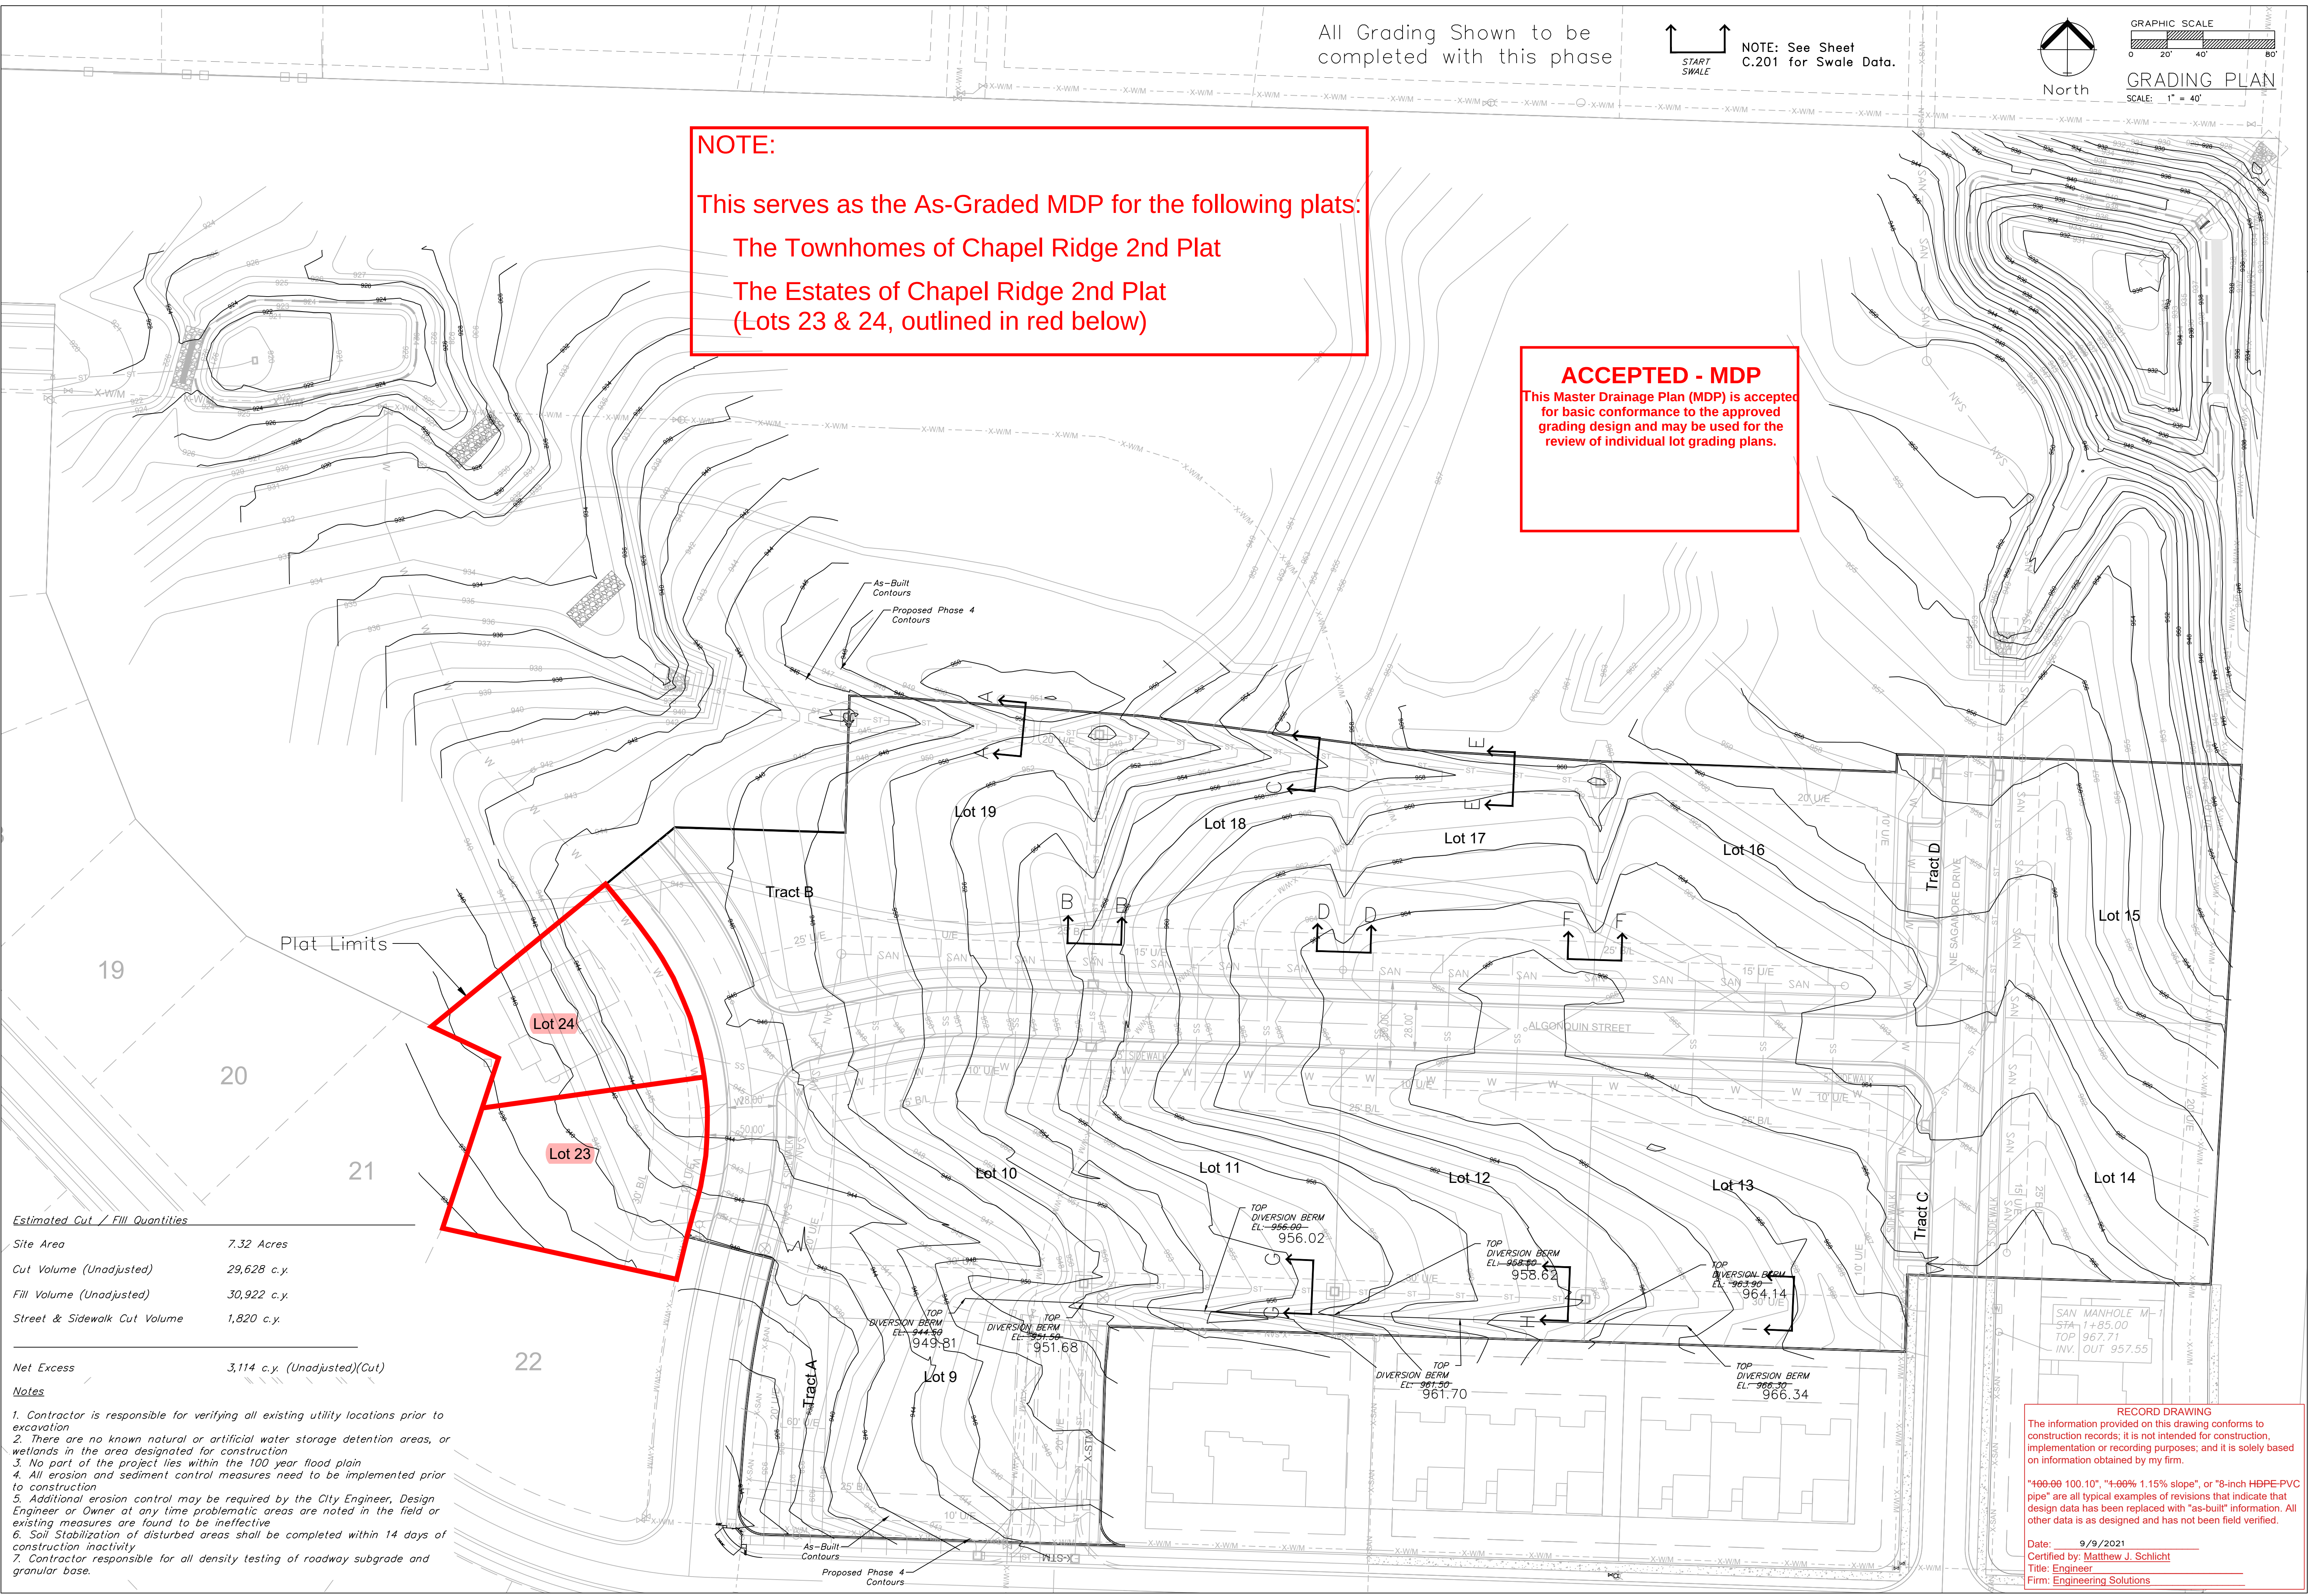

**ENGINEERING SOLUTIONS**  
ENGINEERING & SURVEYING  
50 SE 30TH STREET  
LEE'S SUMMIT, MO 64082  
P: (816) 623-9888 F: (816) 623-9849

Professional Registration  
Missouri  
Engineering 2005002186-D  
Surveying 2005008319-D  
Kansas  
Engineering E-1695  
Surveying LS-218  
Oklahoma  
Engineering 6254  
Nebraska  
Engineering CA2821

Project: VILLAS OF CHAPEL RIDGE L3MO  
Issue Date: April 10, 2020

Master Drainage Plan 1 of 3:  
Grading Plan  
Construction Plans for:  
THE TOWNHOMES OF CHAPEL RIDGE 2ND PLAT  
LOTS 9-19 & TRACTS A-D  
Lee's Summit, Jackson County, Missouri


THE TOWNHOMES OF CHAPEL RIDGE 2ND PLAT  
LOTS 9-19 & TRACTS A-D  
Lee's Summit, Jackson County, Missouri

Matthew J. Schlicht  
MO PE 2006019708  
KS PE 19071  
OK PE 25226  
NE PE E-14335


REVISIONS

|           |          |
|-----------|----------|
| 6/25/2021 | As-Built |
| 8/18/2021 | As-Built |
| 8/31/2021 | As-Built |
| 9/9/2021  | As-Built |

C. 200

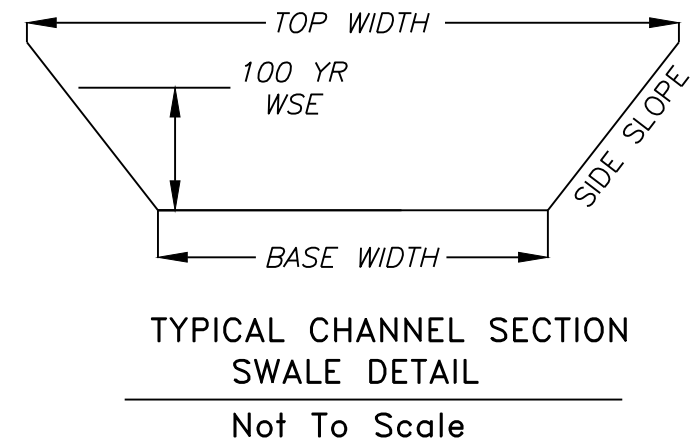

NOTE: Swale sections extend the entire length between upstream and downstream structures with the exception of a transition at each structure.

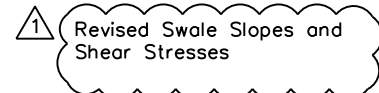


100 YEAR OVERFLOW SWALE SECTIONS

| Section | 100 Yr. Runoff (c.f.s.) | Bed Slope (%) | As-Built Slope | Base Width (ft) | Side Slope (1:V) | 100 Yr WSE (ft) | Sectional Area | Velocity 100Yr. (f.p.s.) | Hydraulic Radius (ft) | Shear Stress (p.s.f.) | As-Built Shear Stress |
|---------|-------------------------|---------------|----------------|-----------------|------------------|-----------------|----------------|--------------------------|-----------------------|-----------------------|-----------------------|
| A-A     | 1.35                    | 6.67          | 6.67           | 4               | 5                | 0.11            | 0.50           | 2.70                     | 0.10                  | 0.42                  | 0.42                  |
| B-B     | 2.37                    | 6.67          | 6.77           | 6               | 5                | 0.13            | 0.86           | 2.74                     | 0.12                  | 0.49                  | 0.50                  |
| C-C     | 3.60                    | 6.67          | 6.70           | 4               | 5                | 0.20            | 1.00           | 3.60                     | 0.17                  | 0.69                  | 0.69                  |
| D-D     | 2.50                    | 6.67          | 7.07           | 6               | 5                | 0.13            | 0.86           | 2.89                     | 0.12                  | 0.49                  | 0.52                  |
| E-E     | 3.60                    | 2.72          | 2.79           | 6               | 5                | 0.21            | 1.48           | 2.43                     | 0.18                  | 0.34                  | 0.32                  |
| F-F     | 1.03                    | 6.67          | 7.56           | 6               | 5                | 0.08            | 0.51           | 2.01                     | 0.08                  | 0.34                  | 0.35                  |
| G-G     | 3.00                    | 6.00          | 5.56           | 5               | 3                | 0.18            | 1.00           | 3.01                     | 0.16                  | 0.51                  | 0.56                  |
| H-H     | 3.73                    | 4.16          | 5.57           | 5               | 3                | 0.21            | 1.27           | 2.94                     | 0.18                  | 0.46                  | 0.41                  |
| I-I     | 3.37                    | 4.00          | 4.69           | 5               | 3                | 0.20            | 1.12           | 3.01                     | 0.18                  | 0.45                  | 0.52                  |

NOTE: Swale should be lined with "Straw with Net" turf reinforcement (Curlex Blanket or Eqv.) . Per Table 5607-1 in APWA Manual

| Townhomes | Basement Type | MBOE Lt. | MBOE Rt. |
|-----------|---------------|----------|----------|
| 9         | Full          | 940.8    | 951.0    |
| 10        | Daylight      | 951.2    | 940.8    |
| 11        | Daylight      | 958.1    | 951.2    |
| 12        | Daylight      | 963.9    | 958.1    |
| 13        | Full          | 966.0    | 963.9    |
| 14        | Daylight      | 957.4    | 964.9    |
| 15        | Walkout       | 946.5    | 957.4    |
| 16        | Walkout       | 960.3    | 960.0    |
| 17        | Walkout       | 959.1    | 960.3    |
| 18        | Walkout       | 950.2    | 959.1    |
| 19        | Daylight      | 946.2    | 950.2    |

| Estates | Basement Type | MBOE Lt. | MBOE Rt. |
|---------|---------------|----------|----------|
| 23      | Walkout       | 935.0    | 939.3    |
| 24      | Walkout       | 939.3    | 939.2    |

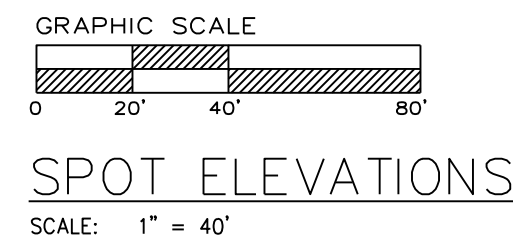


ACCEPTED - MDP

This Master Drainage Plan (MDP) is accepted for basic conformance to the approved grading design and may be used for the review of individual lot grading plans.

Note:


AS GRADED PLOT PLAN REQUIRED FOR EACH LOT.

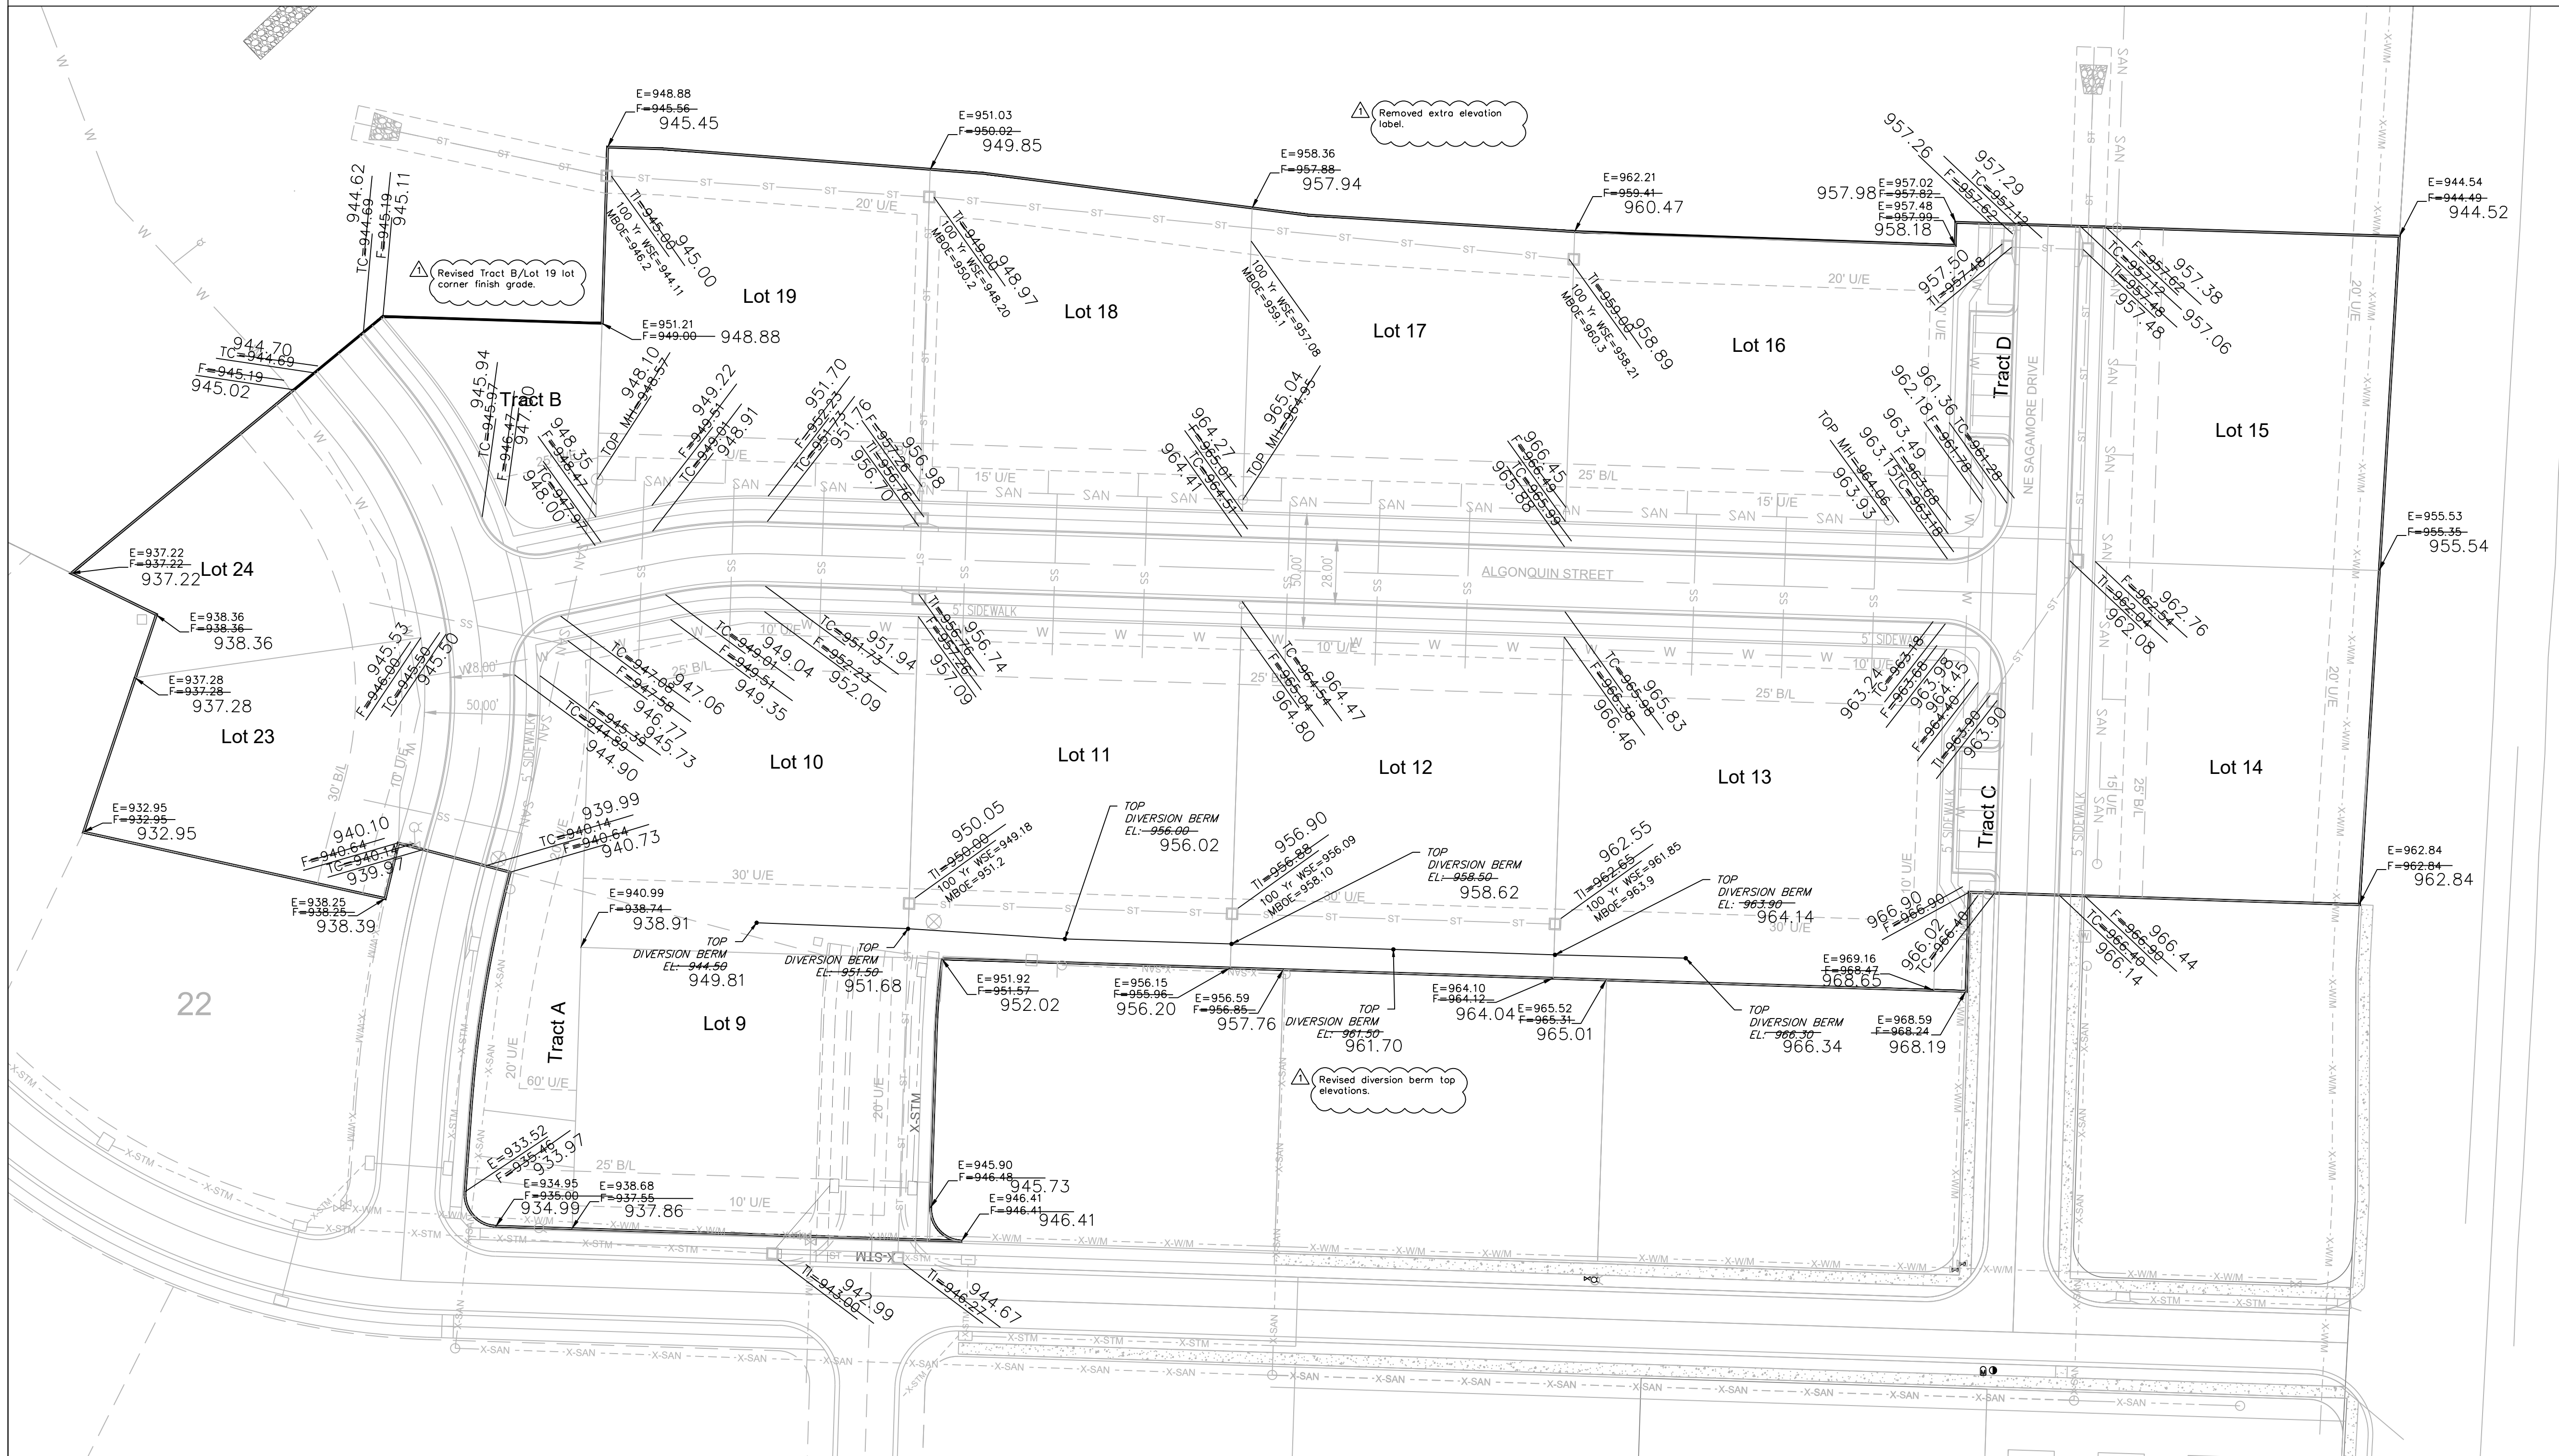

Professional Registration  
Missouri  
Engineering 2005002186-D  
Surveying 2005008319-D  
Kansas  
Engineering E-1695  
Surveying LS-218  
Oklahoma  
Engineering 6254  
Nebraska  
Engineering CA2821

Project: THE TOWNHOMES OF CHAPEL RIDGE-2ND PLAT LOTS 9-19 & TRACTS A-D  
Issue Date: April 10, 2020  
Lee's Summit, Jackson County, Missouri

Master Drainage Plan 2 of 3:  
Spot Elevations Construction Plans for THE TOWNHOMES OF CHAPEL RIDGE-2ND PLAT LOTS 9-19 & TRACTS A-D  
Lee's Summit, Jackson County, Missouri

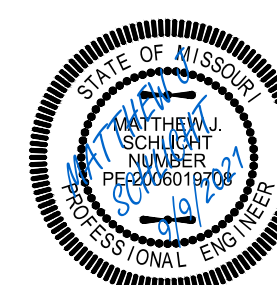



Matthew J. Schlicht  
MO PE 2006019708  
KS PE 19071  
OK PE 25226  
NE PE E-14335

REVISIONS  
6/25/2021 As-Built  
8/18/2021 As-Built  
8/31/2021 As-Built  
9/9/2021 As-Built

RECORD DRAWING  
The information provided on this drawing conforms to construction records; it is not intended for construction, implementation or recording purposes; and it is solely based on information obtained by my firm.

"100-00 100.10", "4-00% 1.15% slope", or "8-inch HDPE-PVC pipe" are all typical examples of revisions that indicate that design data has been replaced with "as-built" information. All other data is as designed and has not been field verified.

Date: 9/9/2021  
Certified by: Matthew J. Schlicht  
Title: Engineer  
Firm: Engineering Solutions

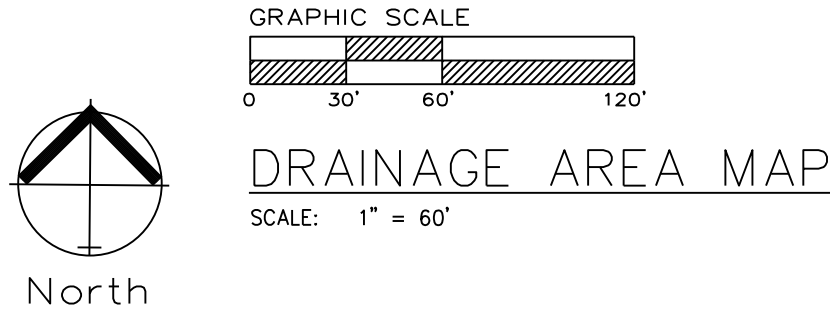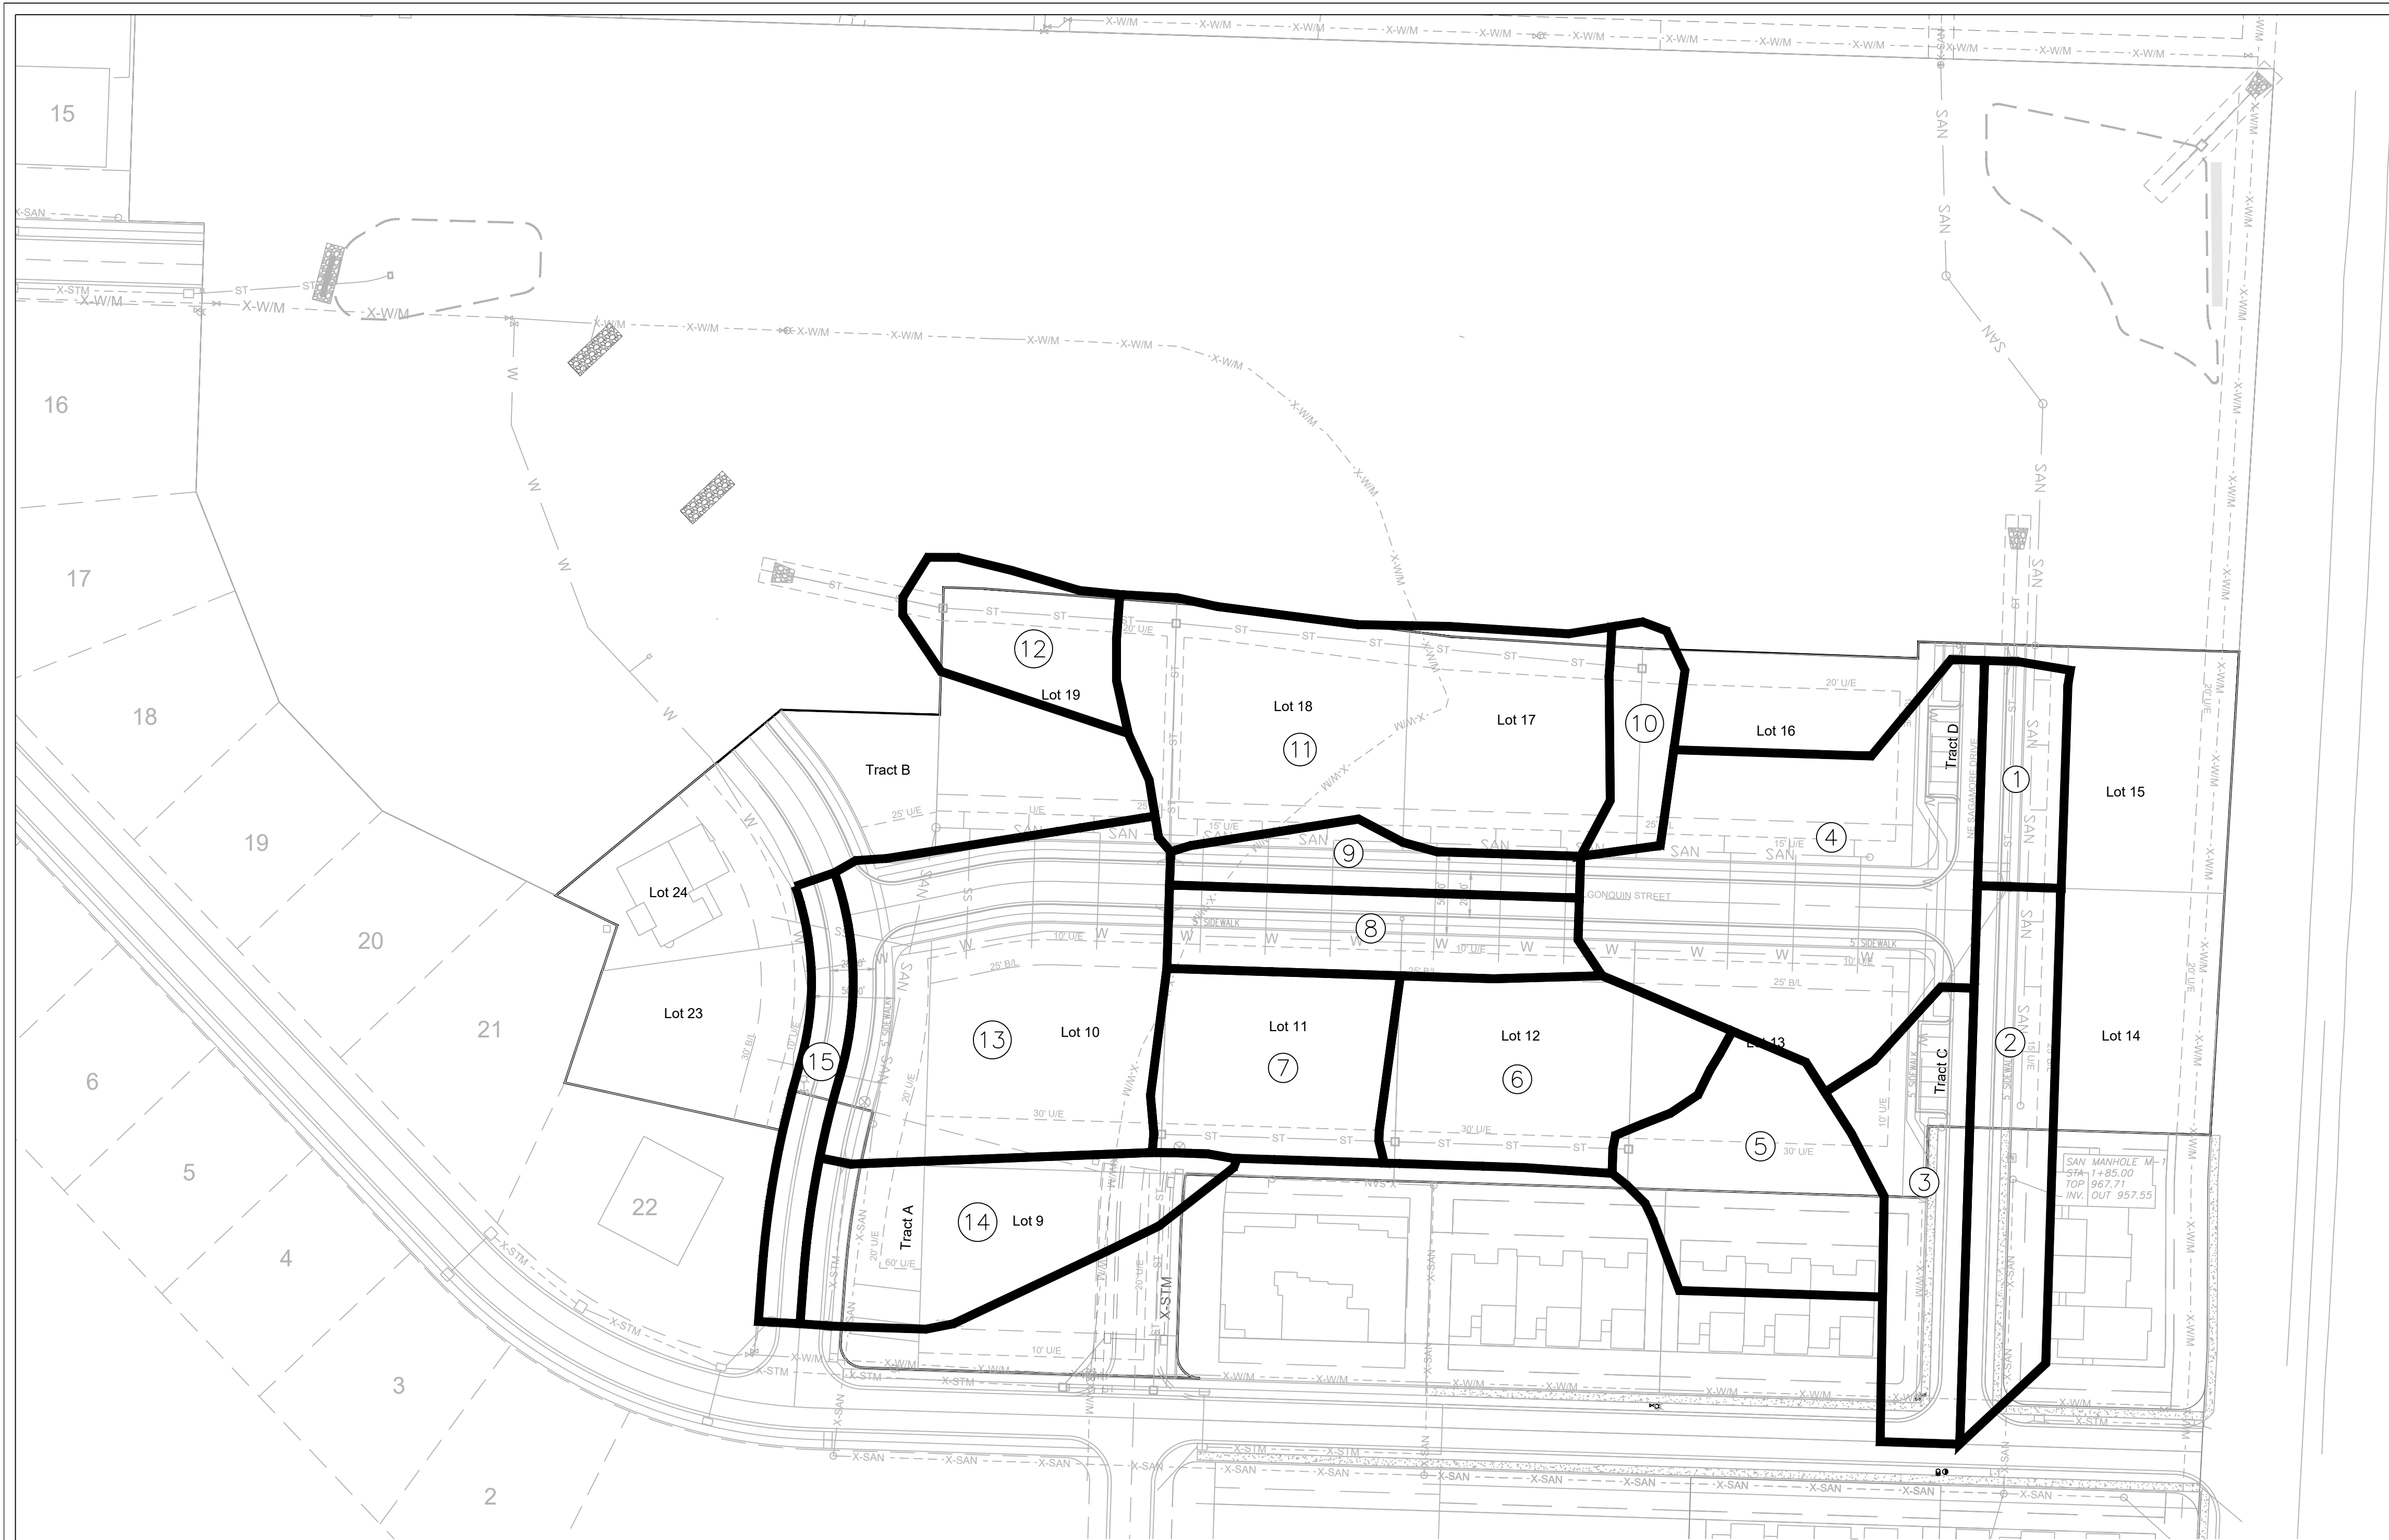

**ACCEPTED - MDP**  
This Master Drainage Plan (MDP) is accepted for basic conformance to the approved grading design and may be used for the review of individual lot grading plans.

| APWA STORM DRAINAGE "TC" COMPUTATIONS FOR : VILLAS OF CHAPEL RIDGE 2ND PLAT | |
|---|
| yellow areas are self computing<br>overwrite if necessary                   |              |             |               | Surface types:                                  | |
|                                                                             |              |             |               | SURFACE CODES                                   | |
|                                                                             |              |             |               | "C" Values                                      | |
|                                                                             |              |             |               | Overwrite Length - DnElev or Slope if necessary | |
| TOTAL WATERSHED                                                             |              |             |               | SURFACE CODE                                    |    |      |              |           |              |    |    |      |         | P=Power/overwrite Slope or Elevations<br>U=Unpaved if necessary |                |    |    |      |         |               |  |  |  | TC COMPUTATION        | |
|                                                                             |              |             |               | OVERLAND FLOW - 100' MAX                        |    |      |              |           |              |    |    |      |         | P or U                                                          |                |    |    |      |         |               |  |  |  | Cal Overland Flow (T) |  |  | Used Min 5 Max 15 (T) |  |  | Cal Channel One (T) |  |  | Cal Channel Two (T) |  |  | Total |  |  | AREA ID | |
| AREA ID                                                                     | TOTAL SQ.FT. | TOTAL ACRES | WTRSHD LENGTH | UP                                              | DN | ELEV | SURFACE CODE | "C" VALUE | OVRLG LENGTH | UP | DN | ELEV | SLOPE % |                                                                 | CHANNEL LENGTH | UP | DN | ELEV | SLOPE % | VELOCITY F/VS | |