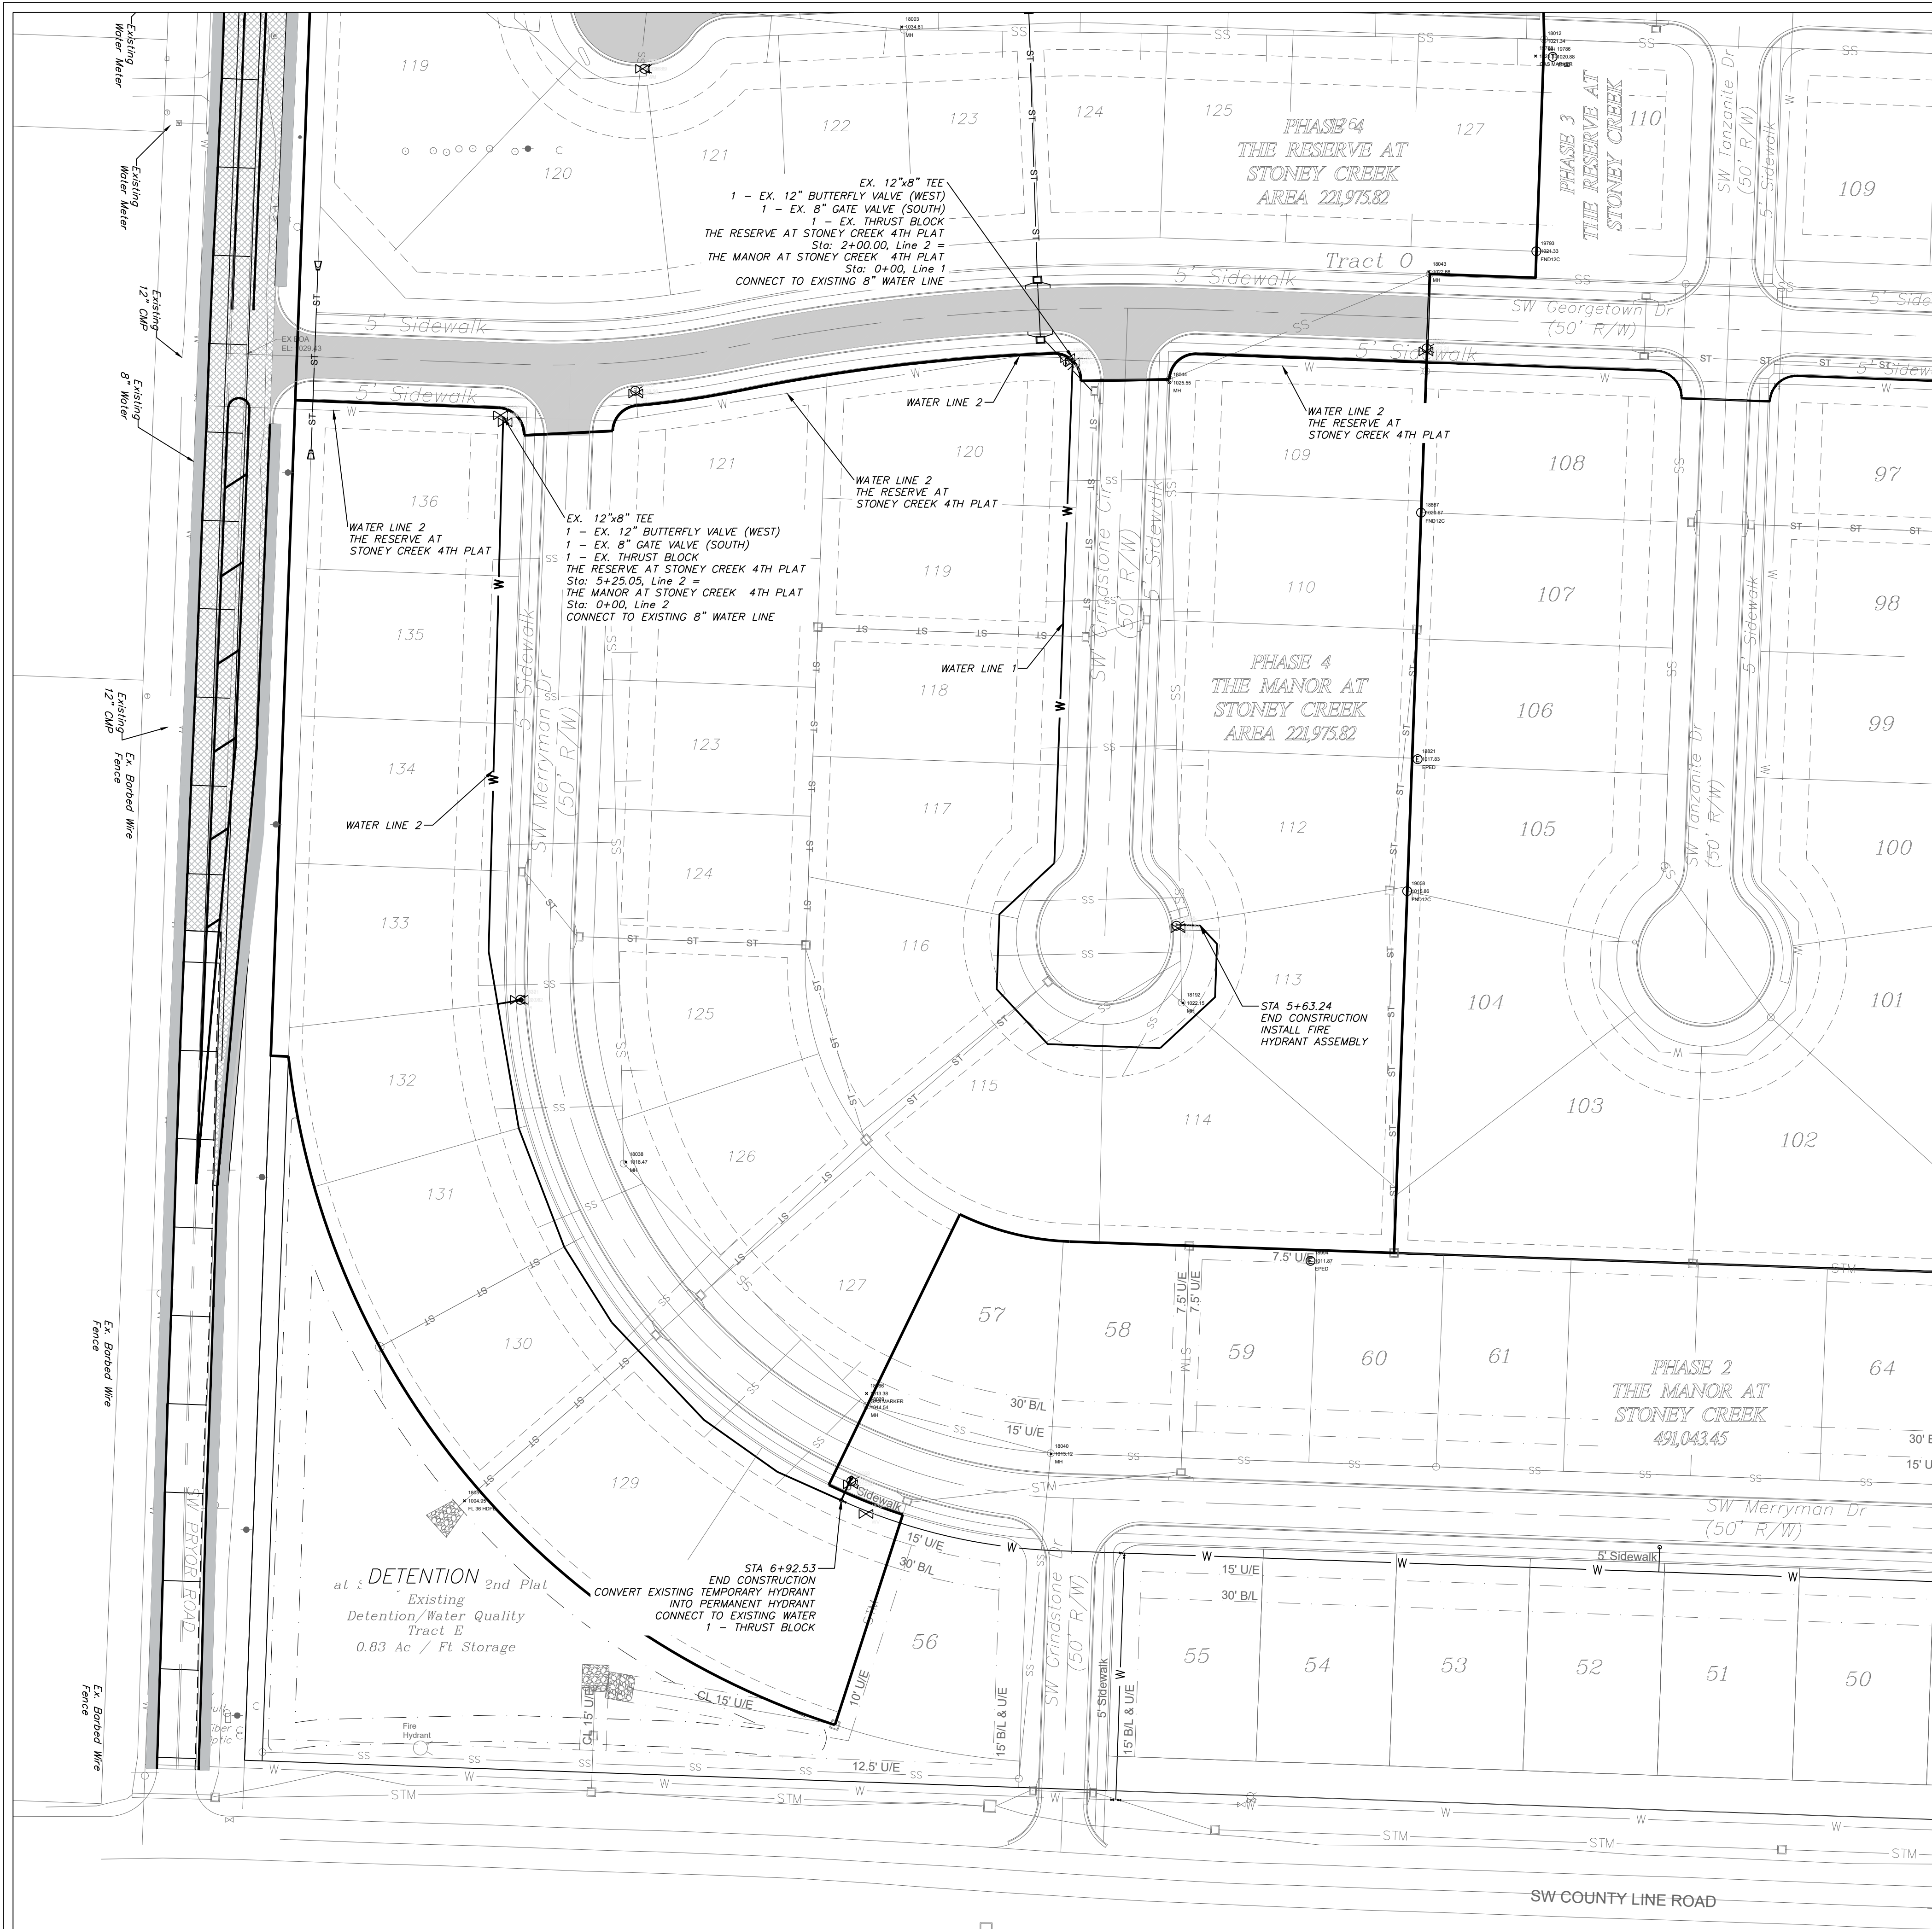


WATER LINE GENERAL LAYOUT

SCALE: 1" = 80'

ENGINEERING SOLUTIONS

ENGINEERING & SURVEYING

50 SE 30TH STREET
LEES SUMMIT, MO 64082
P:(816) 623-9888 F:(816) 623-9849

Professional Registration

Missouri
Engineering 2005002188-D
Surveying 200500519-D

Kansas
Engineering E-1695
Surveying LS-218

Oklahoma
Engineering 6254

Nebraska
Engineering CA2821

The Manor at Stoney Creek - 4th Plat

Lee's Summit, Jackson County, Missouri

Project: MANOR AT STONEY CREEK 4TH PLAT

Issue Date: August 29, 2018

Water Line General Layout

Construction Plans for:

The Manor at Stoney Creek - 4th Plat

Lee's Summit, Jackson County, Missouri

Matthew J. Schlicht
MO PE 2006019708
KS PE 19071
OK PE 25526


REVISIONS

11/16/2020	As-Built



"AS-BUILT"

900.10
~~900.00~~ Indicates data replaced with "As-Built" information. All other data is as designed and has not been field verified.


C.501

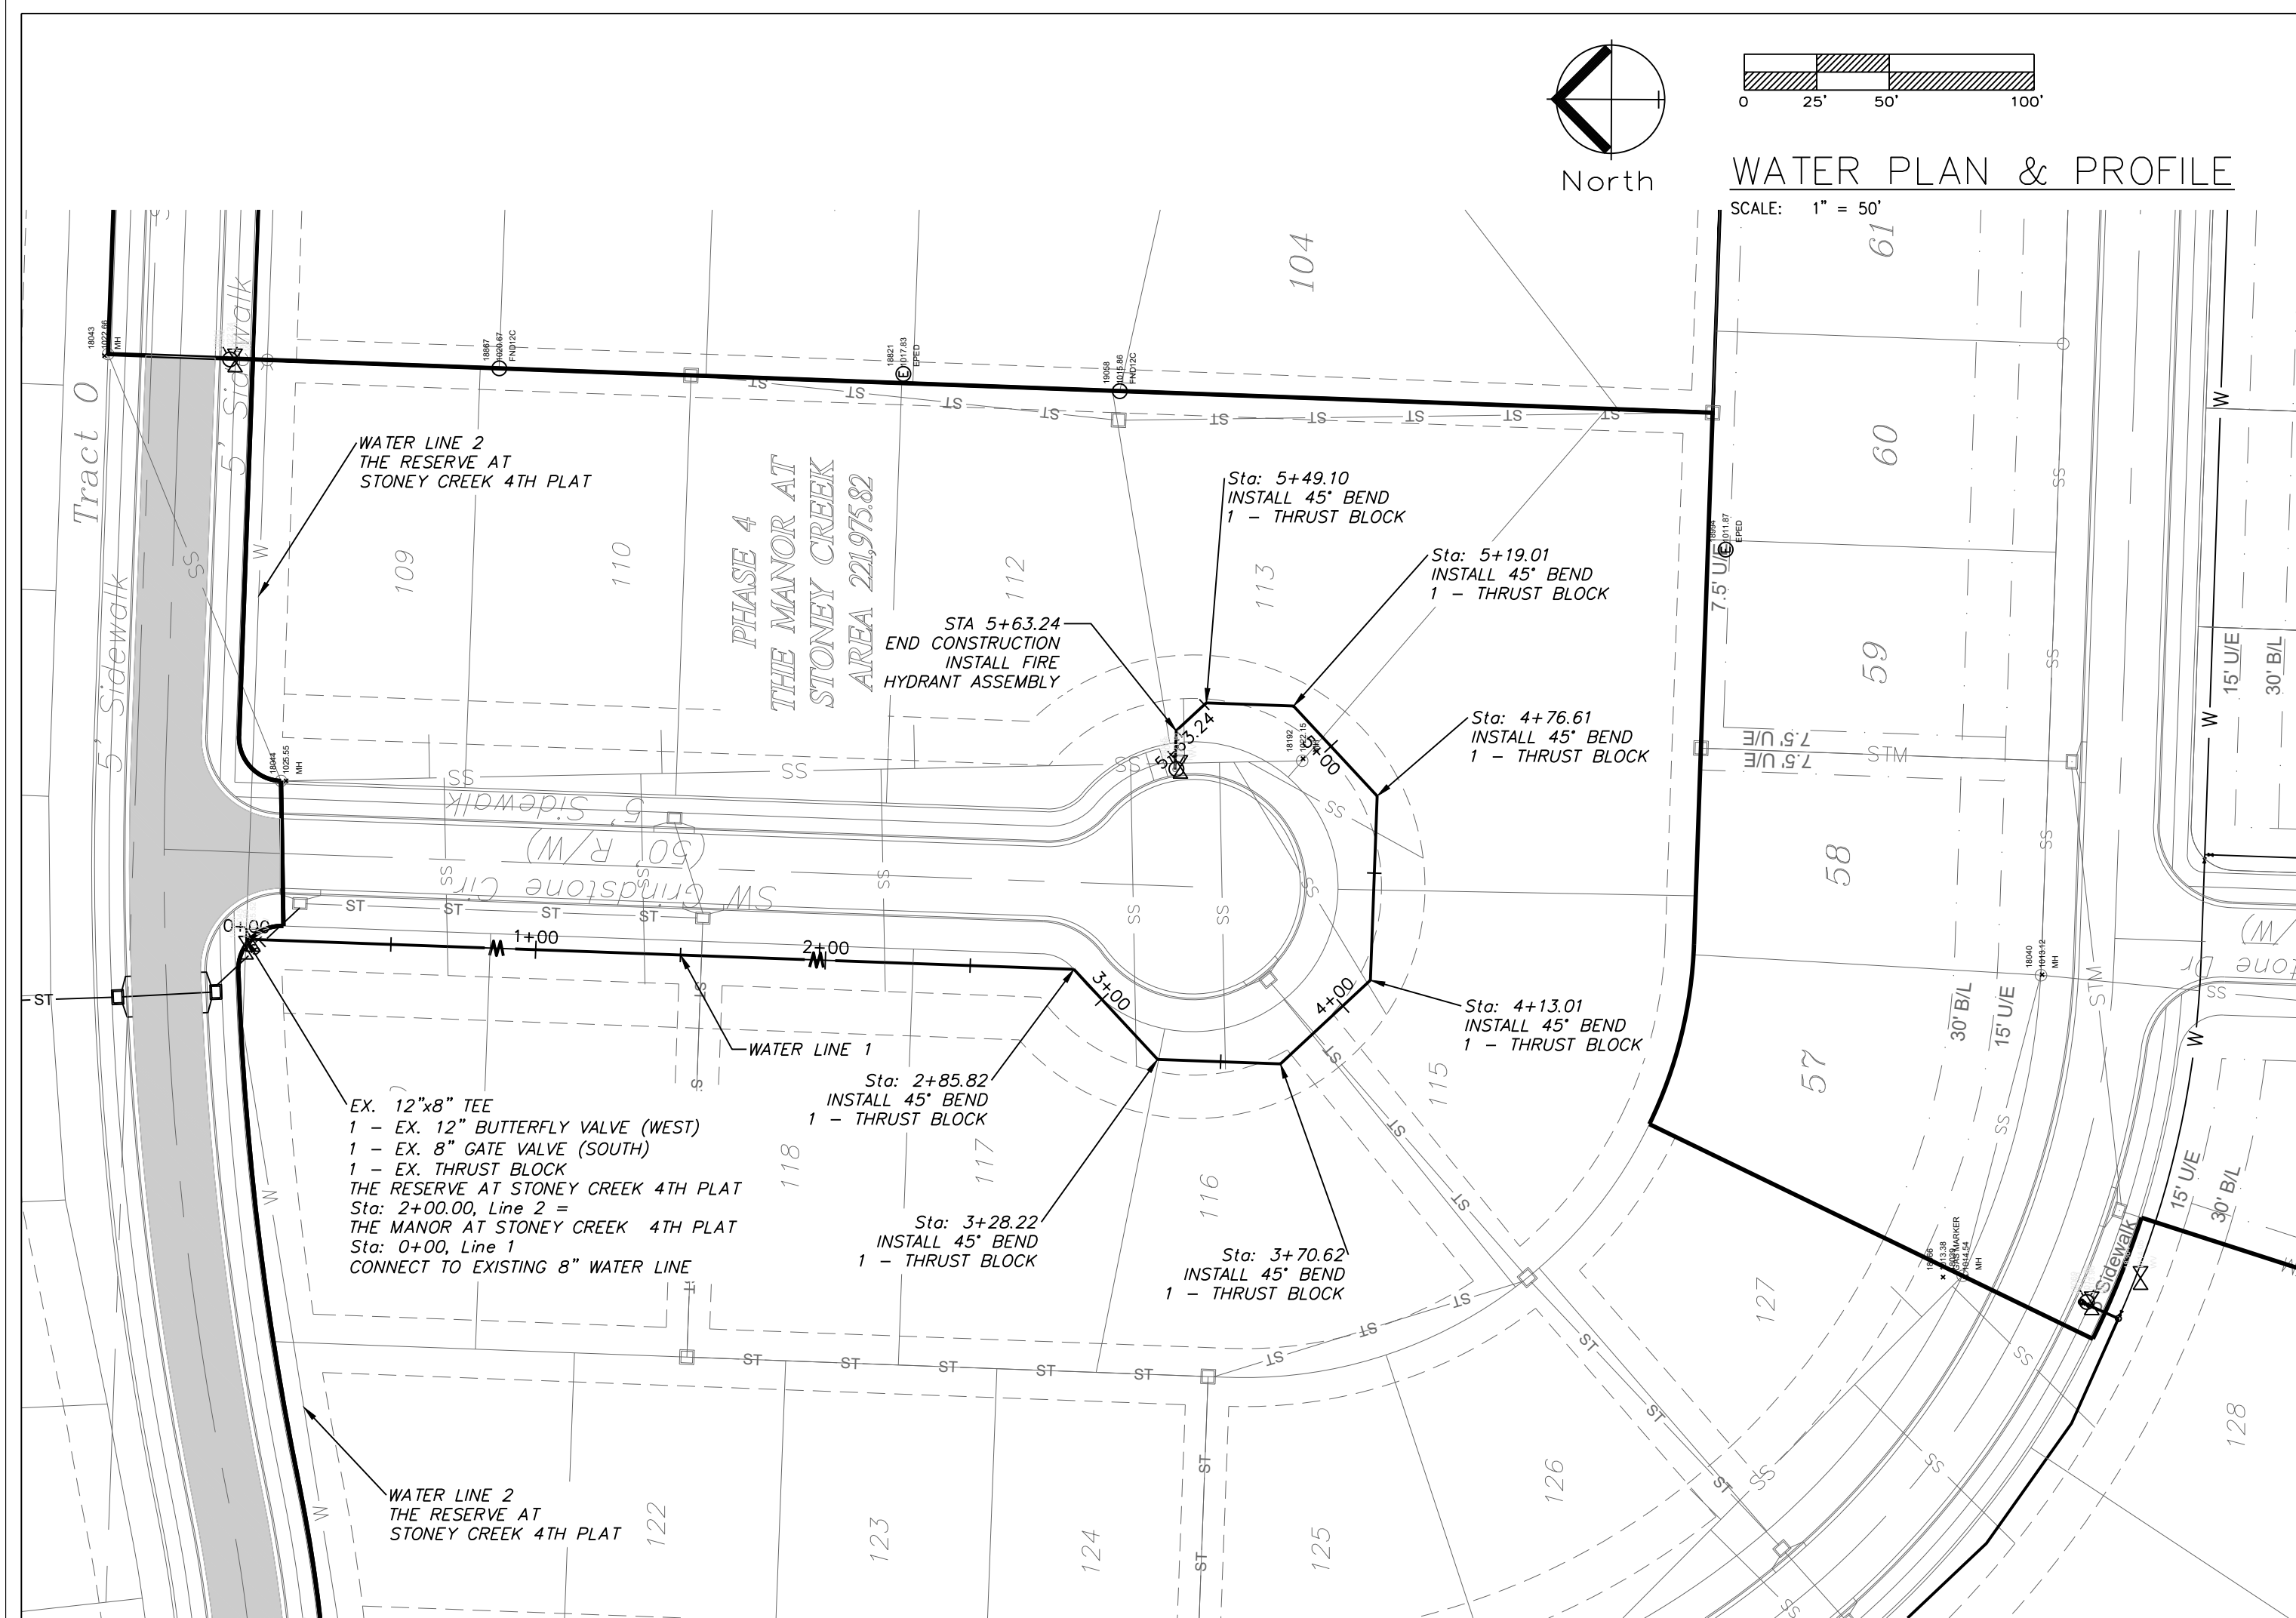

WATER LINE 1

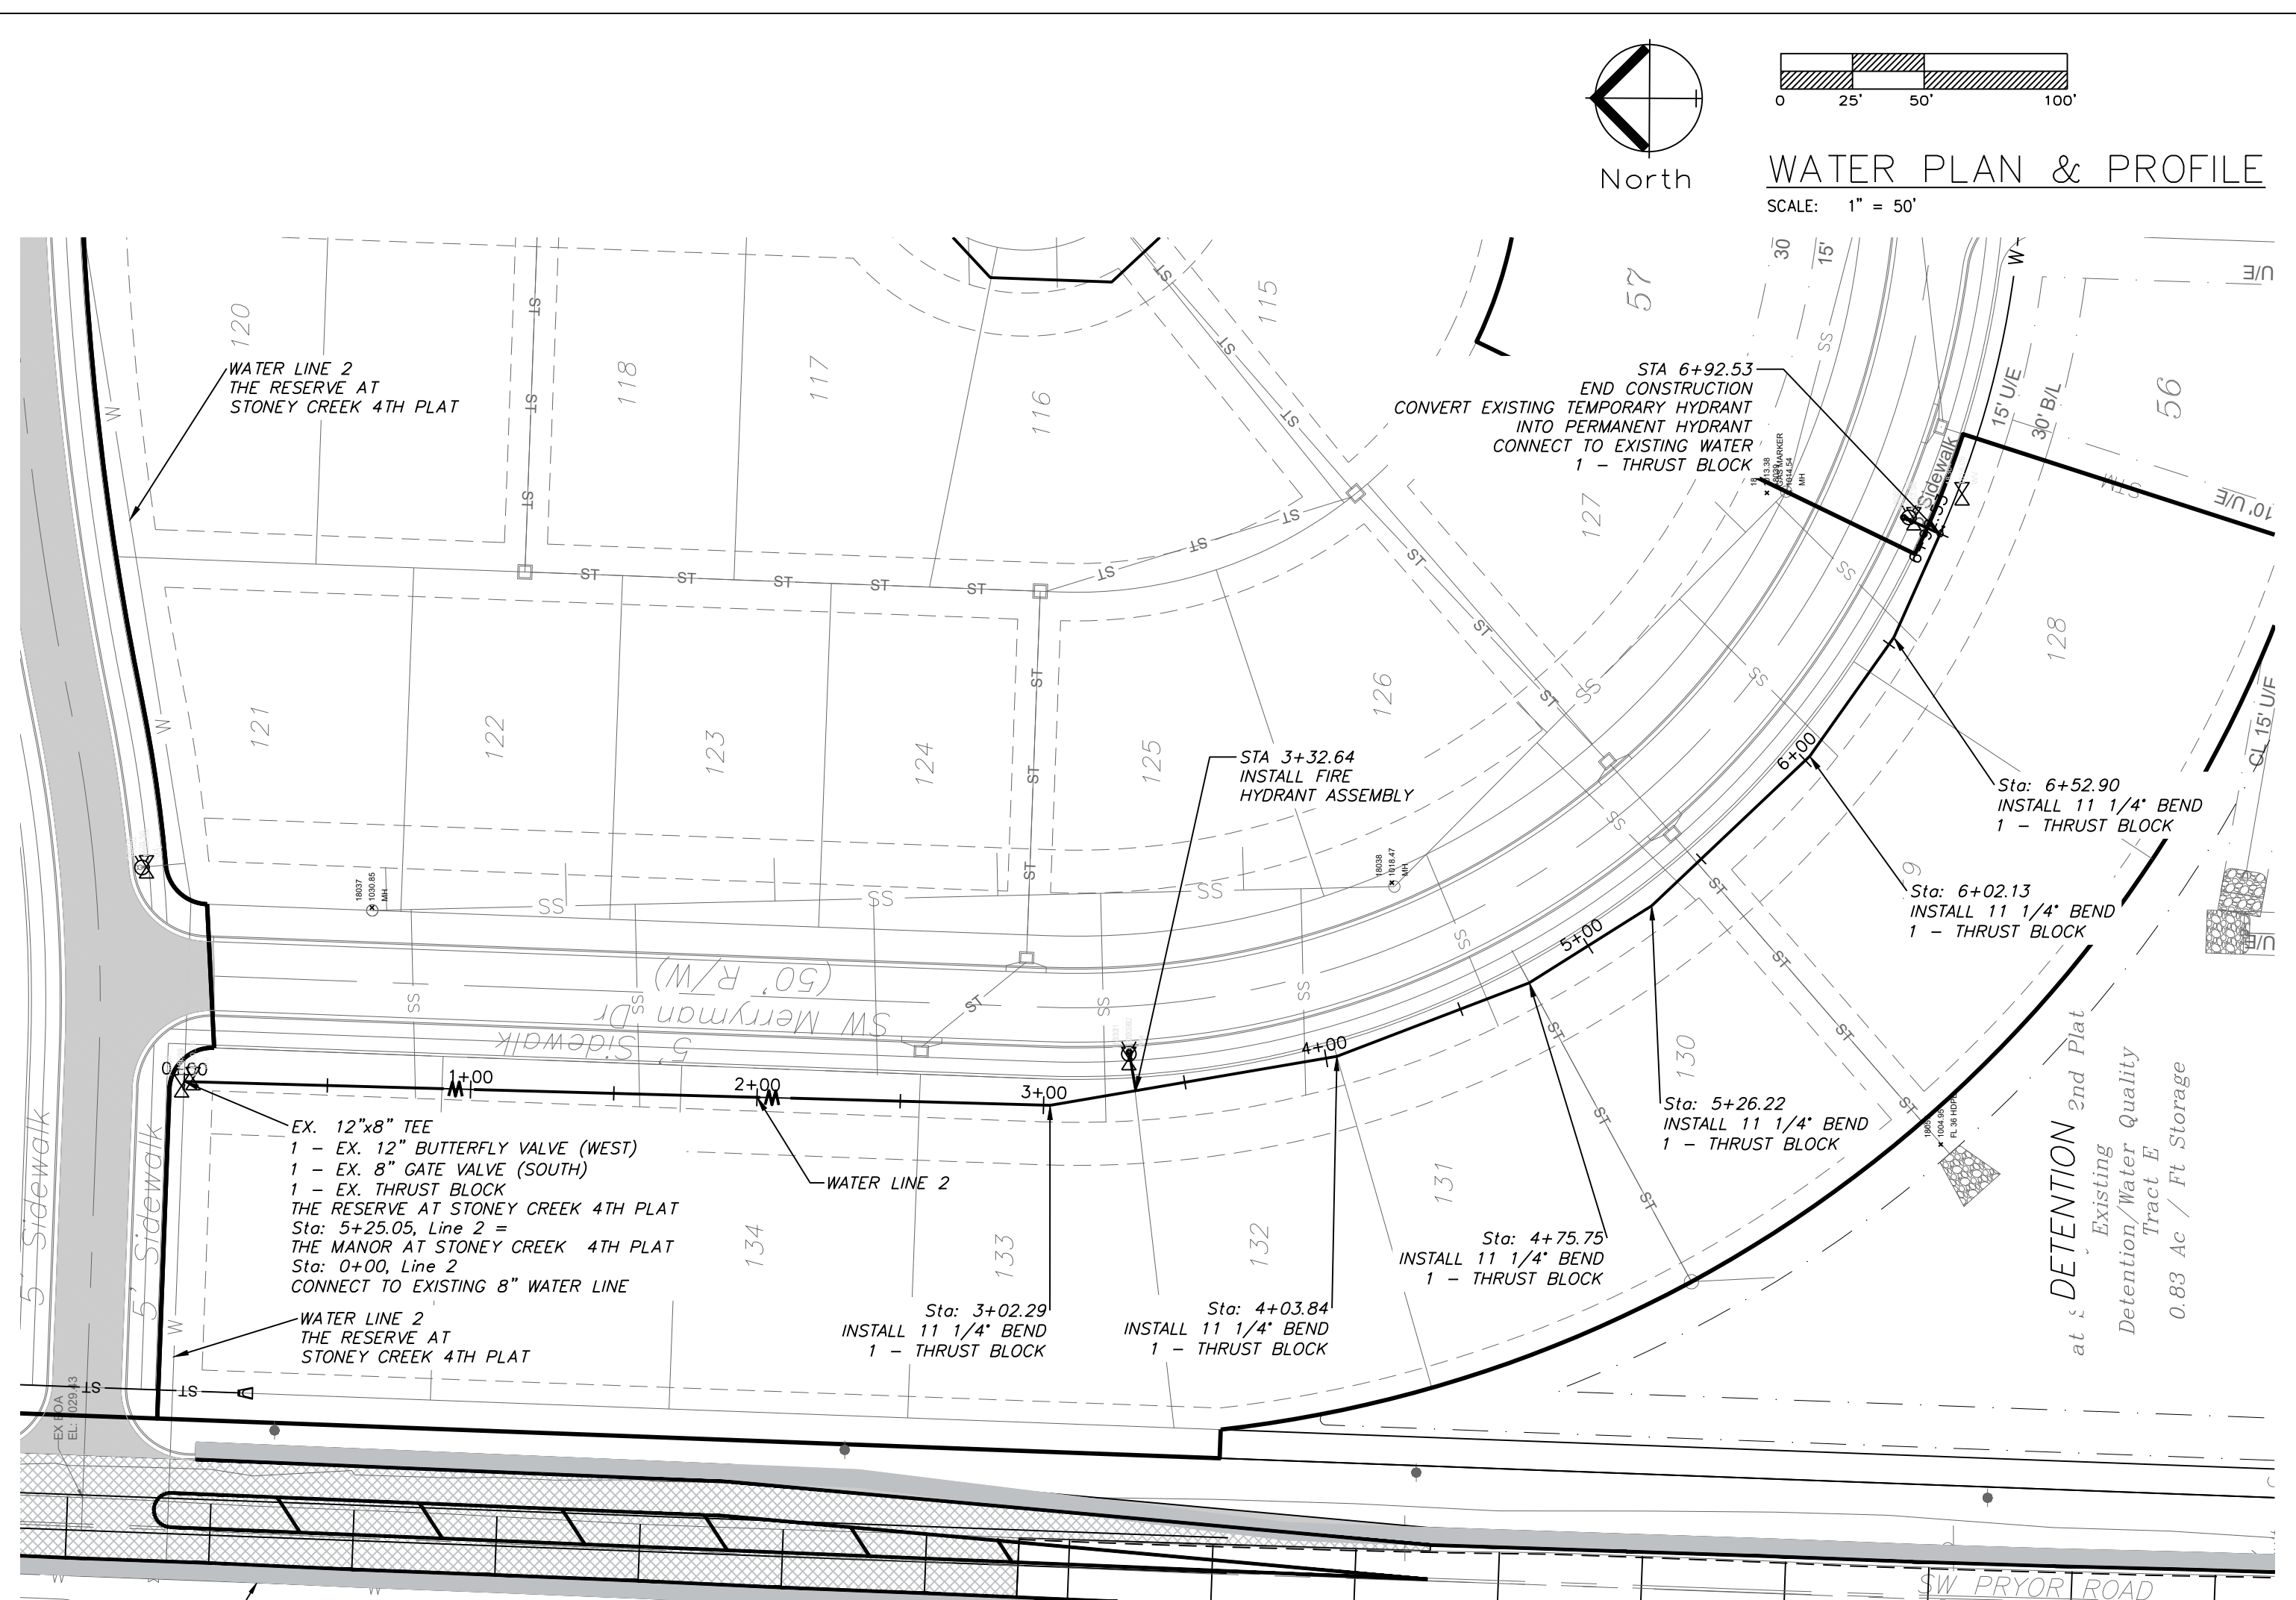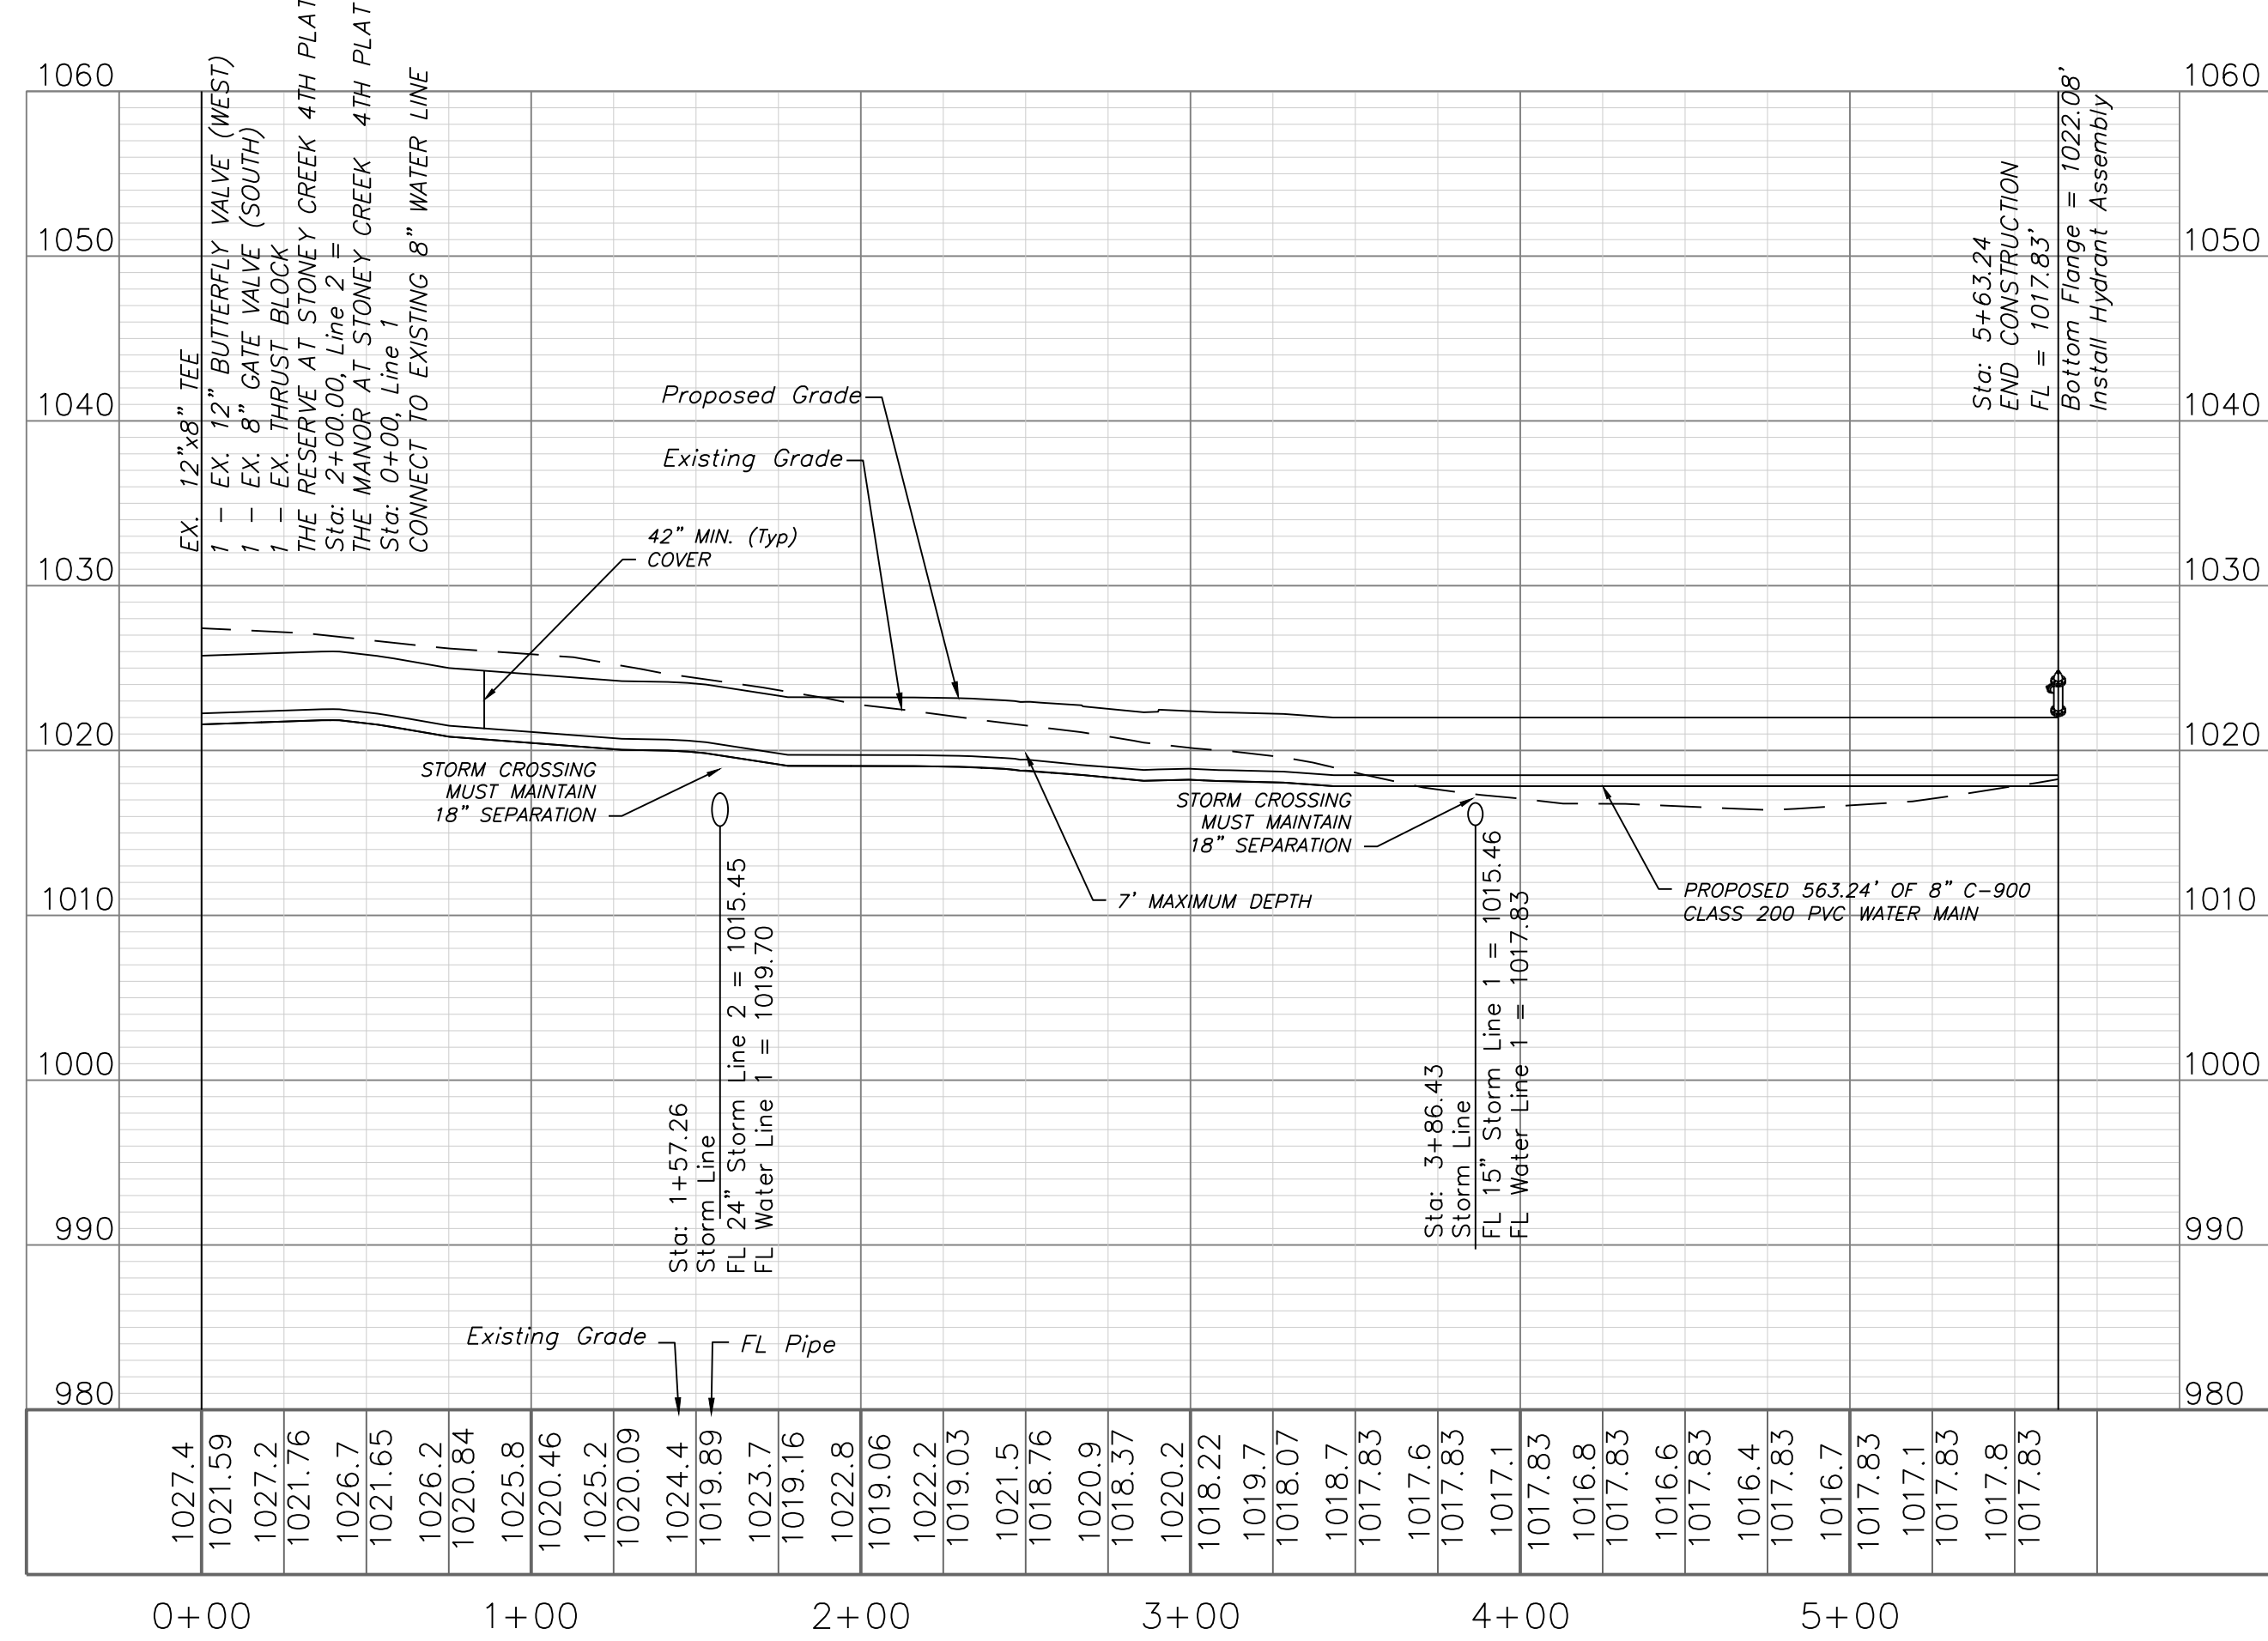

WATER LINE 2

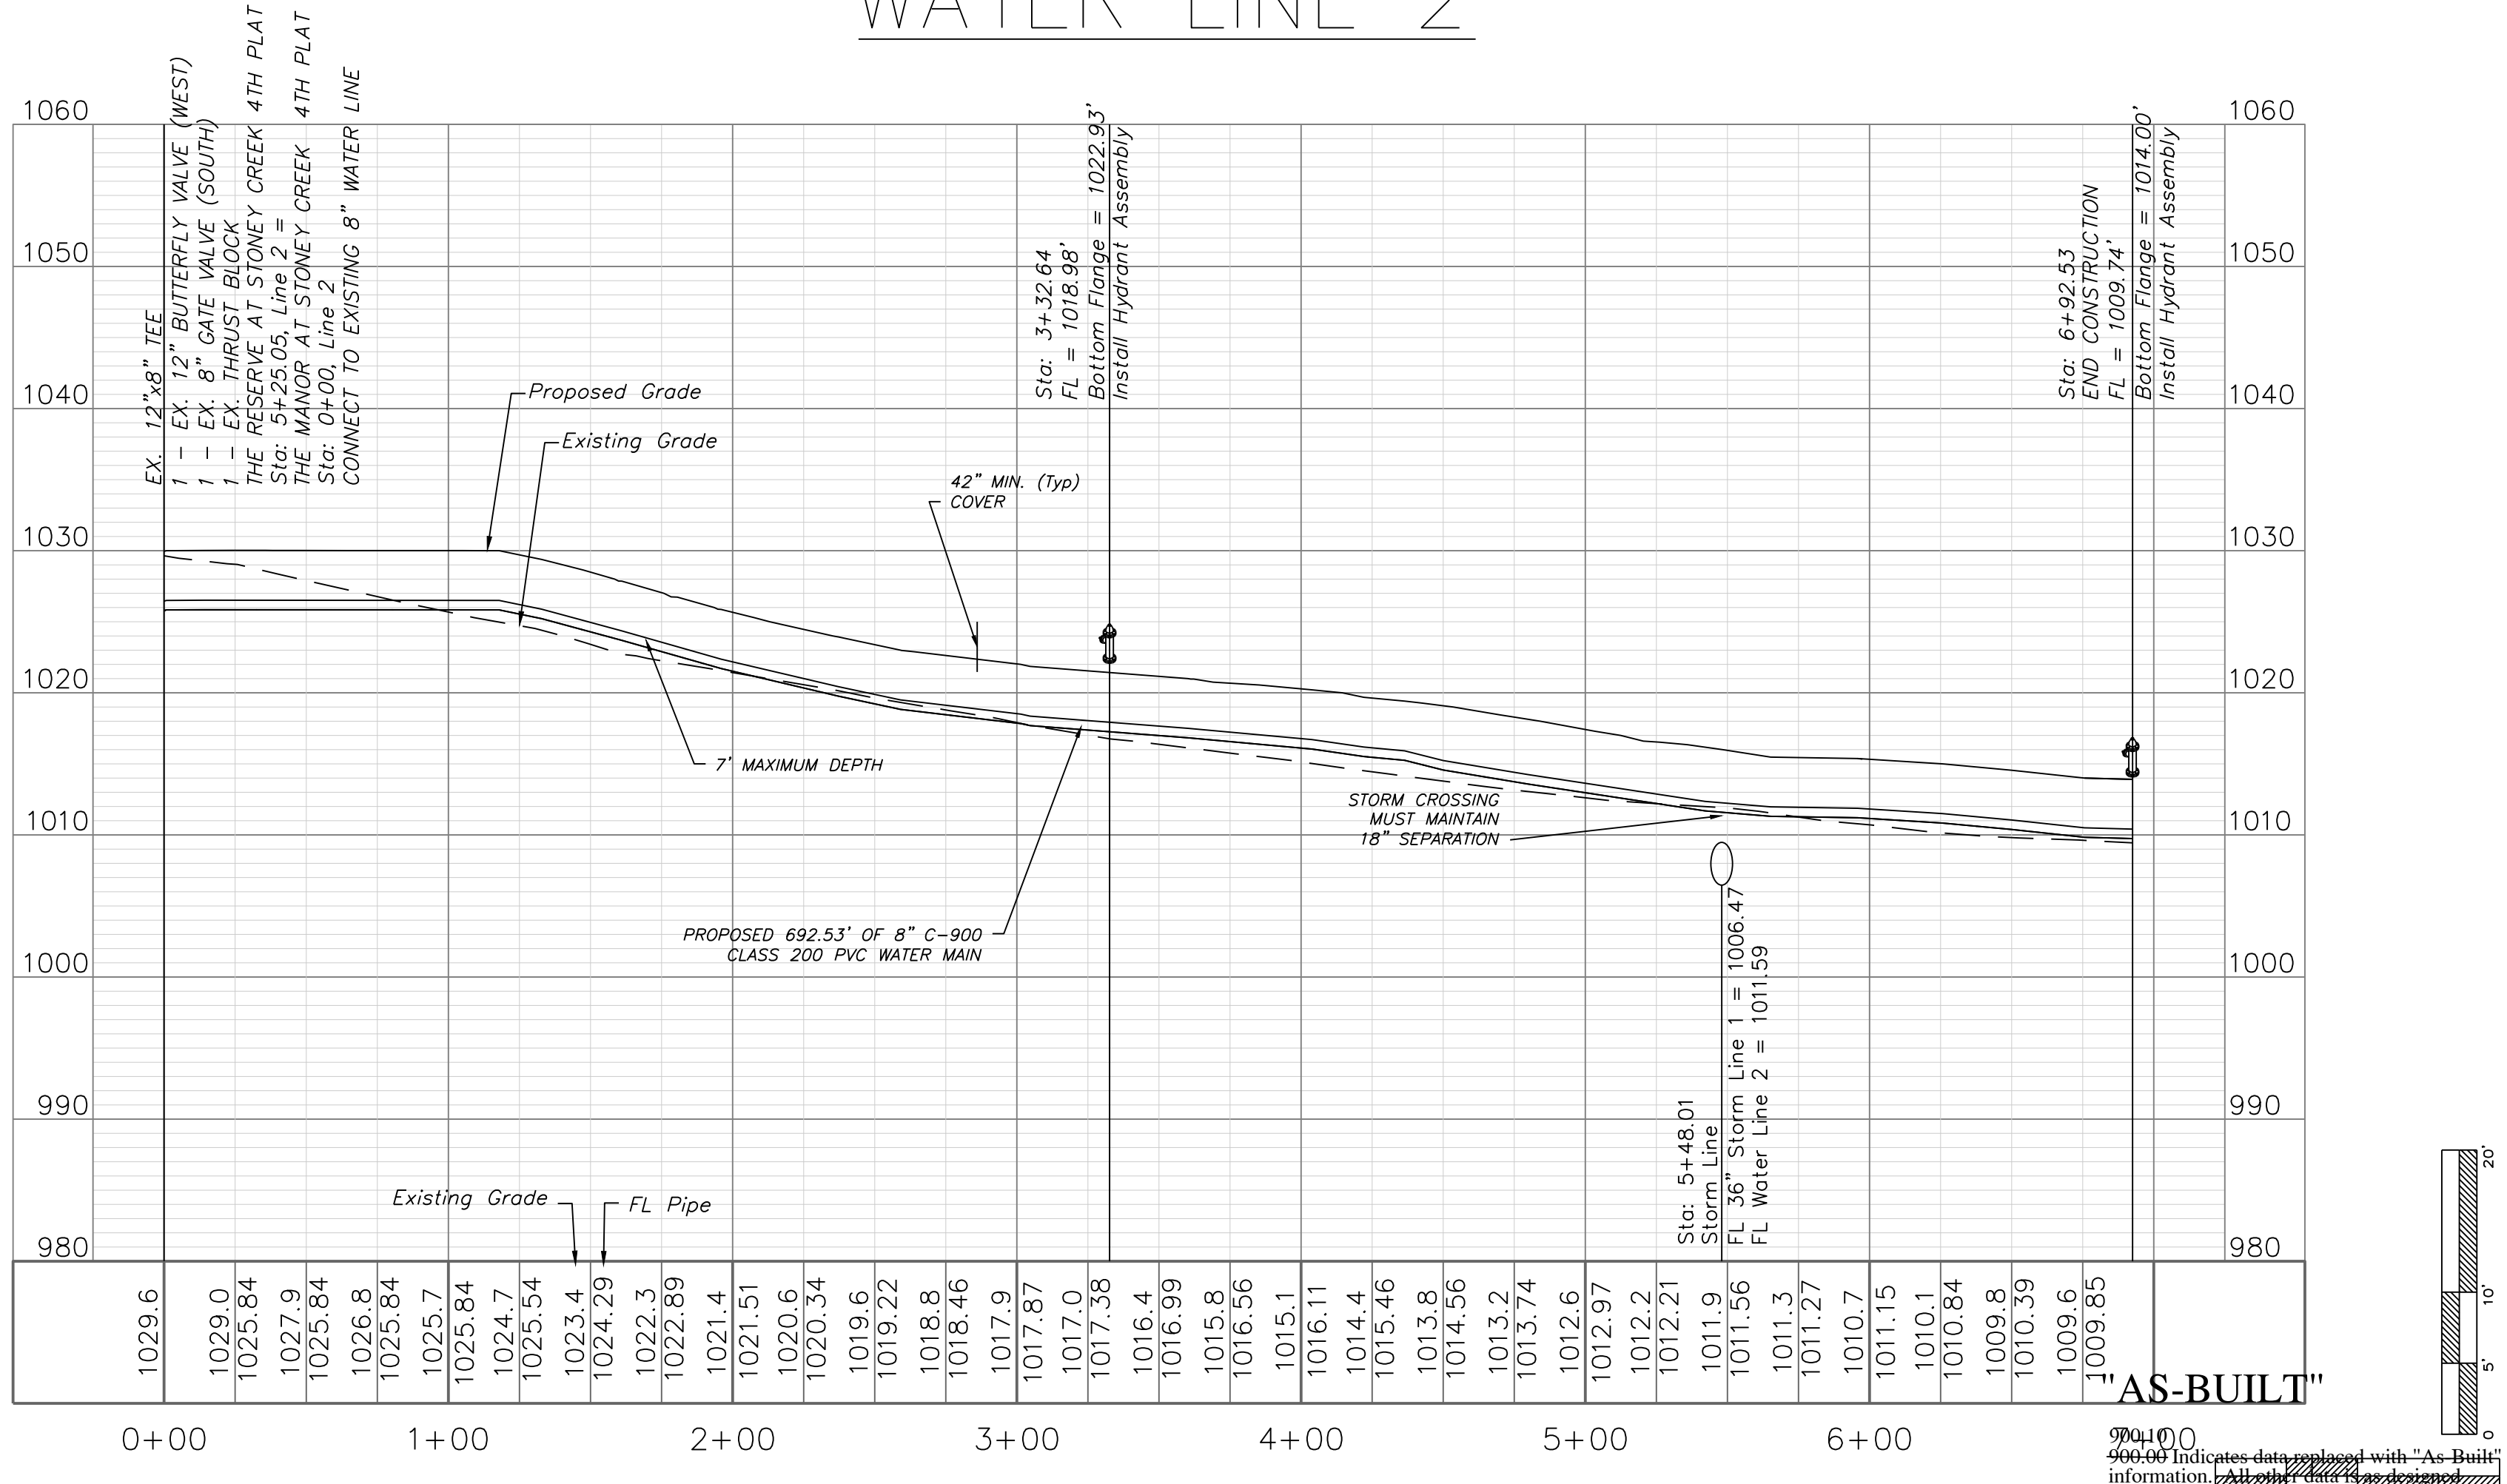

AS-BUILT

ENGINEERING SOLUTIONS

ENGINEERING & SURVEYING

50 SE 30TH STREET
LEES SUMMIT, MO 64082
P: (816) 623-9888 F: (816) 623-9849

Professional Registration

Missouri
Engineering 2005002188-D
Surveying 200500519-D

Kansas
Engineering E-1695
Surveying LS-218

Oklahoma
Engineering 6254

Nebraska
Engineering CA2821

Project: MANOR AT STONEY CREEK 4TH PLAT

Issue Date: August 29, 2018

Water Main Plan and Profile, Line 2

Construction Plans for:

The Manor at Stoney Creek - 4th Plat

Lee's Summit, Jackson County, Missouri

Matthew J. Schlicht
MO PE 2006019708
KS PE 19071
OK PE 25326

REVISIONS

11/16/2020 As-Built

C.502

