


SUMMIT VIEW FARMS 3RD PLAT
LOTS 51-74 AND TRACT C

MASS GRADING, EROSION CONTROL,
PAVING, STORM AND SANITARY PLANS
LEE’S SUMMIT, JACKSON COUNTY, MISSOURI
SECTION 26, TOWNSHIP 47 N, RANGE 32 W
LRA NO. 0318050.01

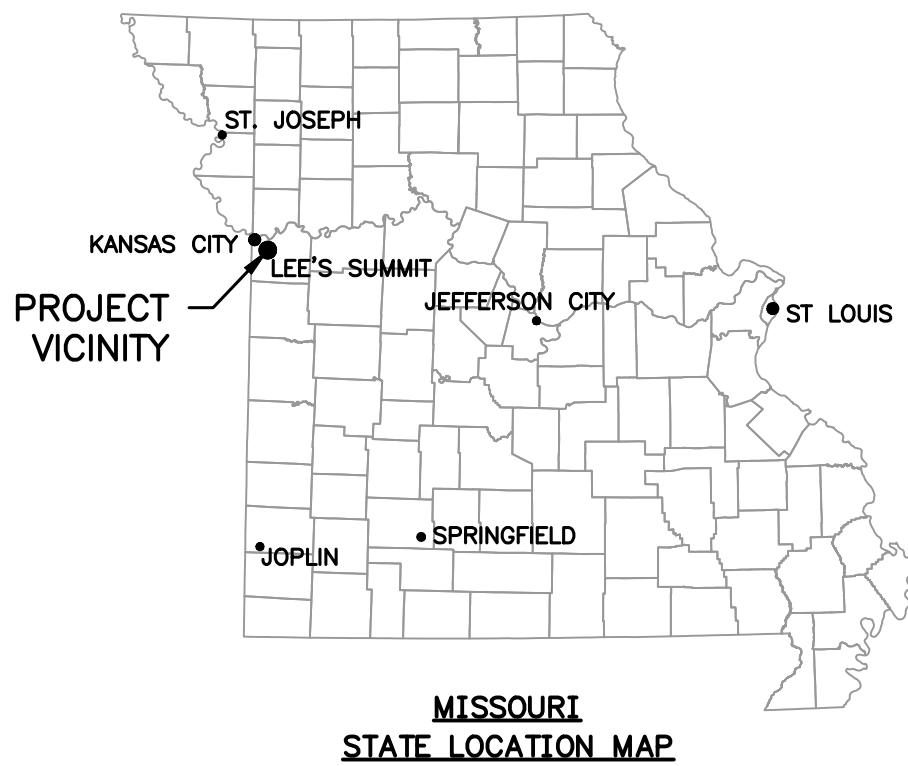


OWNER CONTACT
BILL KENNEY
SUMMIT VIEW FARMS DEVELOPMENT GROUP, LLC
P.O. BOX 291
LEE’S SUMMIT, MO 64063
billkenney9@gmail.com
(816) 838-0552

CONSULTANT CONTACT
DAN MCGHEE
LARKIN LAMP RYNEARSON
9001 STATE LINE ROAD, SUITE 200
KANSAS CITY, MO 64114
Dan.McGhee@LRA-inc.com
(816) 361-0440

INDEX OF SHEETS

- 01 COVER SHEET
- 02 GENERAL LAYOUT PLAN SHEET
- 03 EXISTING CONDITIONS PLAN SHEET
- 04 MASS GRADING PLAN SHEET
- 05 PRE CLEARING EROSION AND SEDIMENT CONTROL PLAN SHEET
- 06 TEMPORARY SEDIMENT TRAP EROSION AND SEDIMENT CONTROL PLAN SHEET
- 07 INACTIVE AREA EROSION AND SEDIMENT CONTROL PLAN SHEET
- 08 FINAL RESTORATION EROSION AND SEDIMENT CONTROL PLAN SHEET
- 09-12 EROSION CONTROL DETAIL SHEETS
- 13 MASTER DRAINAGE PLAN SHEET
- 14 TYPICAL STREET SECTION AND DETAIL SHEET
- 15 SW MONARCH DRIVE STREET PLAN/PROFILE SHEET
- 16 SW BLUE RIBBON STREET STREET PLAN/PROFILE SHEET
- 17 SW KLINE AVENUE AND SW CHASE CIRCLE STREET PLAN/PROFILE SHEET
- 18-19 INTERSECTION LAYOUT PLAN SHEETS
- 20-21 ADA SIDEWALK RAMP ELEVATIONS SHEETS
- 22 DRAINAGE AREA MAP SHEET
- 23 DRAINAGE CALCULATION SHEET
- 24 STORM SEWER PLAN AND PROFILE LINES 3-10, 3-11 AND 3-30 SHEET
- 25 STORM SEWER PLAN AND PROFILE LINES 3-20 AND 3-21 SHEET
- 25A STORM SEWER PLAN AND PROFILE LINE 3-40 SHEET
- 26 SANITARY SEWER PLAN AND PROFILE LINE 3-A SHEET
- 27 SANITARY SEWER PLAN AND PROFILE LINE 3-B SHEET
- 28-31 DETAIL SHEETS

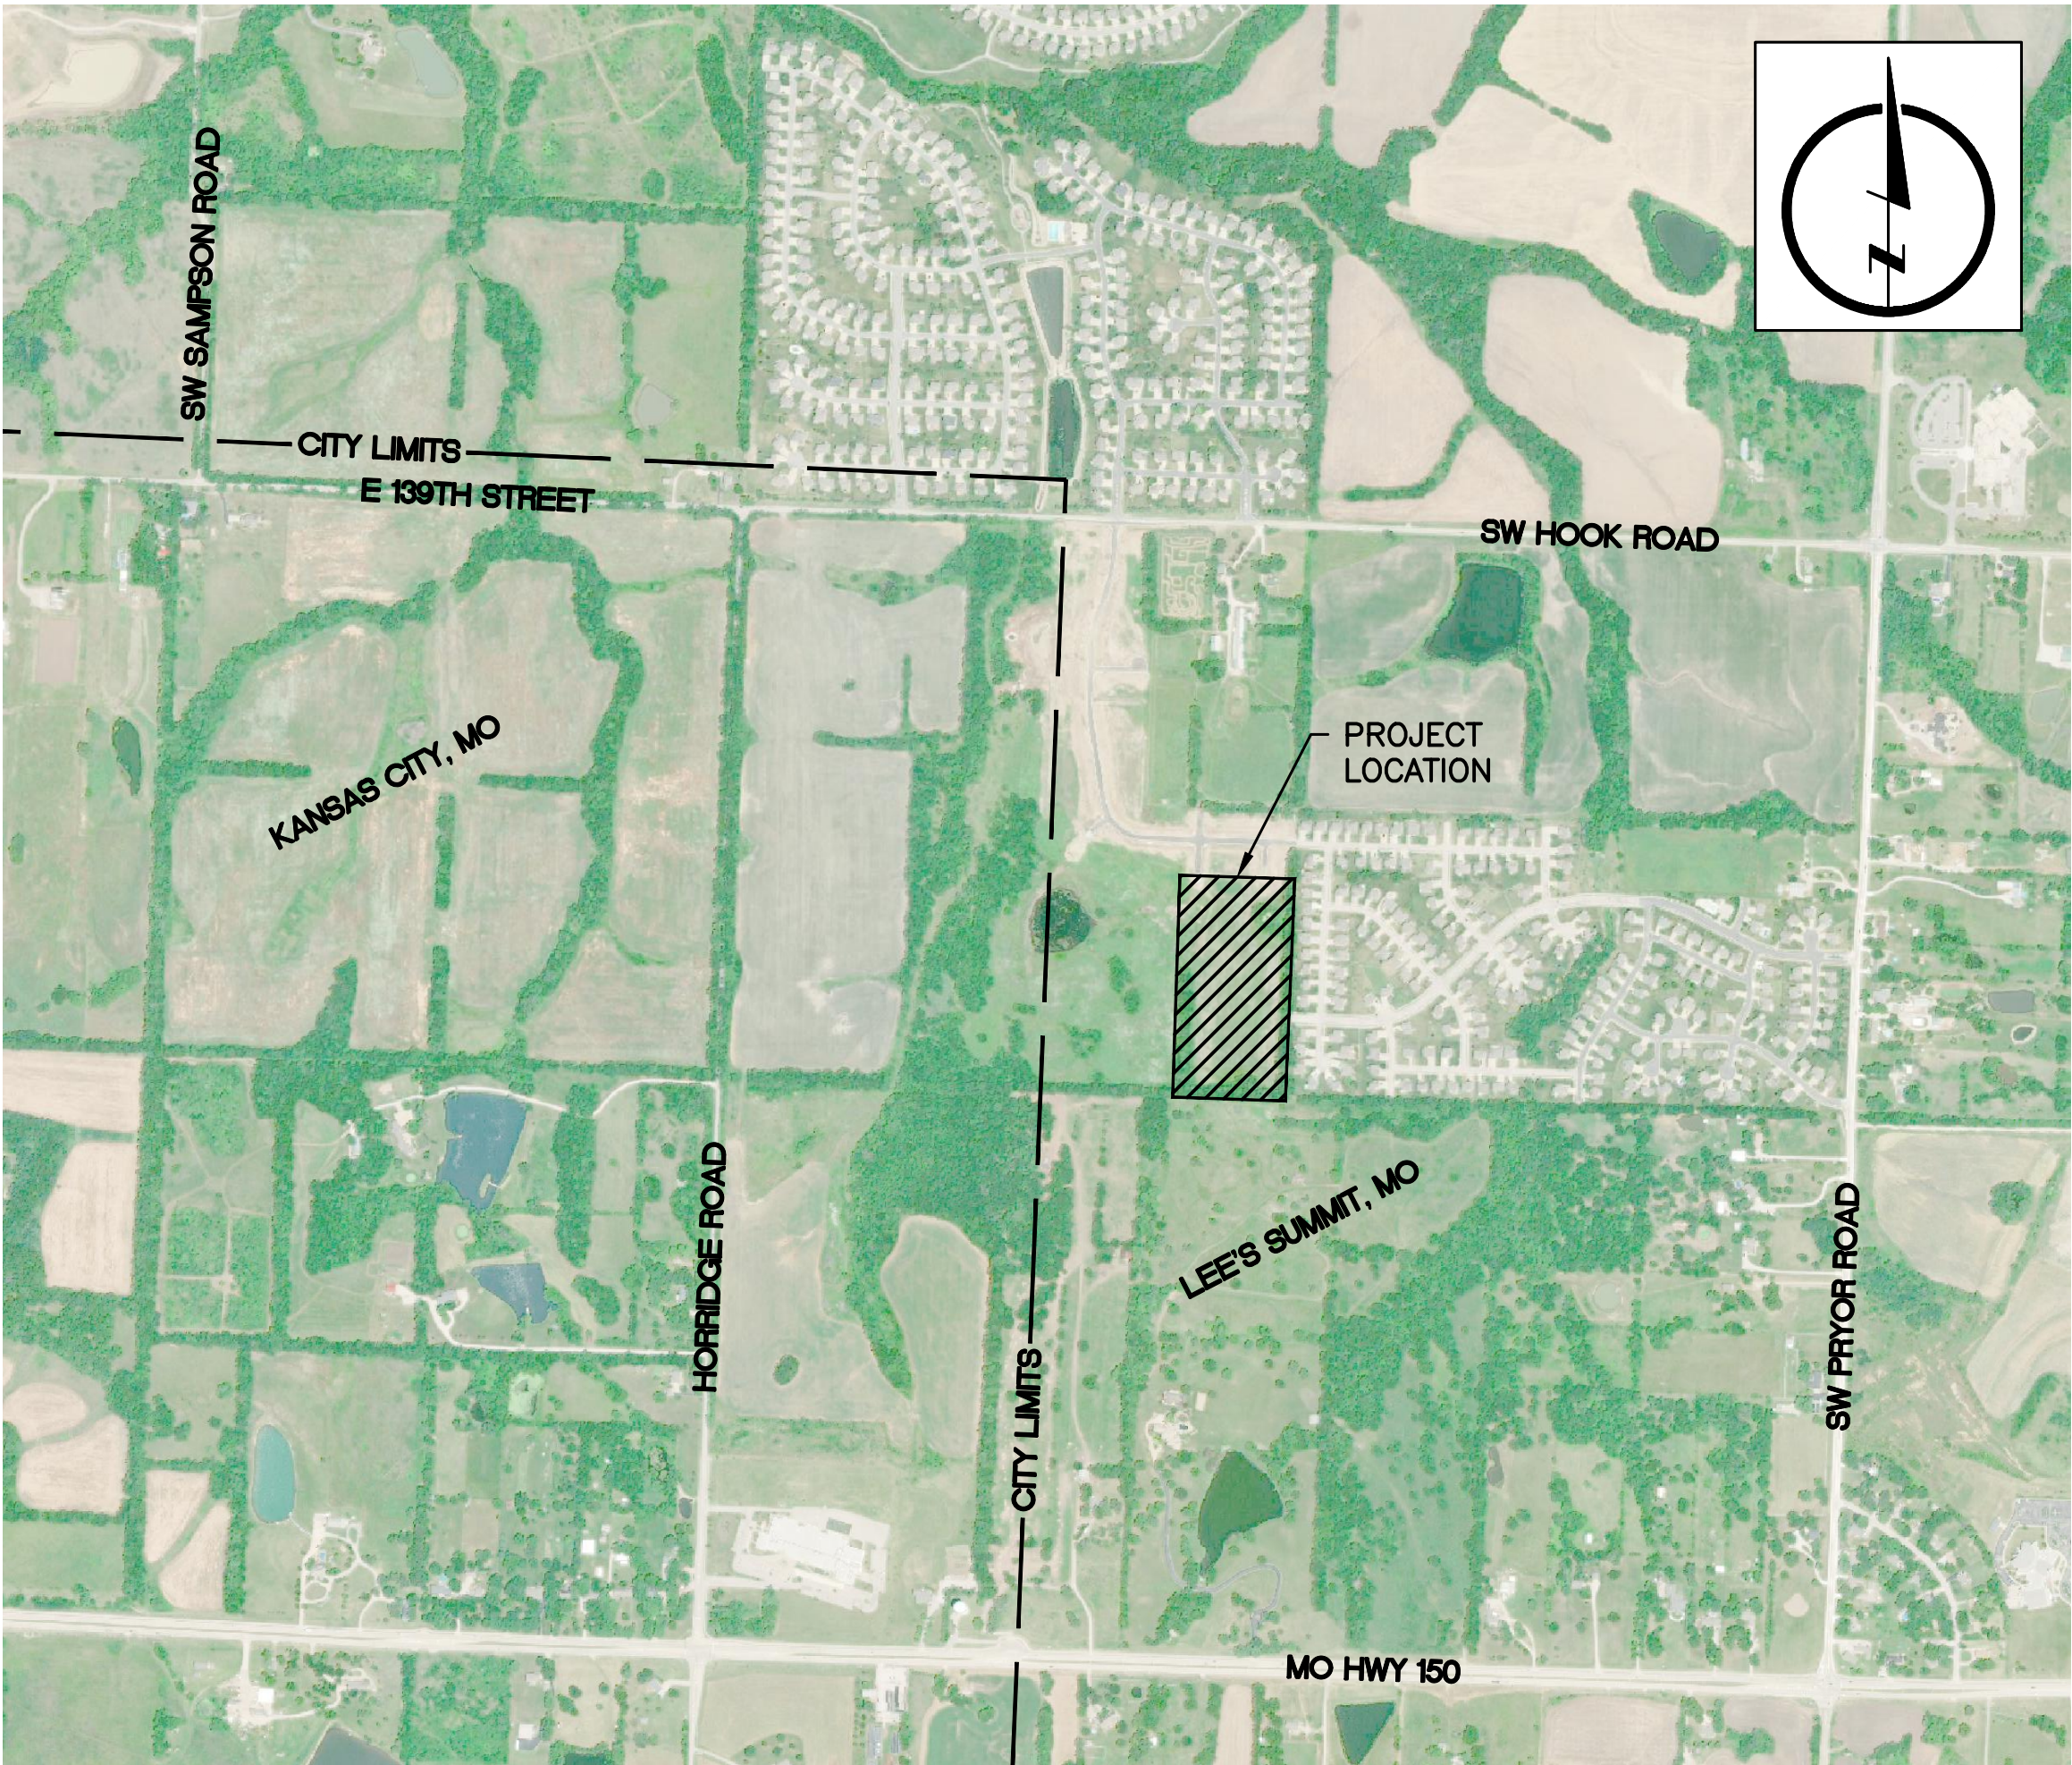

LOCATION MAP



ALL UTILITIES ARE SHOWN BASED ON THE INFORMATION AVAILABLE TO THE ENGINEER. THERE IS NO GUARANTEE ALL FACILITIES ARE SHOWN OR THAT THE LOCATION, DEPTH, AND SIZE OF EACH FACILITY IS CORRECT. THE CONTRACTOR IS RESPONSIBLE FOR LOCATING ALL UTILITIES AND SERVICE LINES PRIOR TO CONSTRUCTION. COORDINATE NECESSARY RELOCATIONS WITH UTILITY COMPANIES.

UTILITIES		
ELECTRIC:	EVERGY	(816) 471-5275
GAS:	SPIRE ENERGY	(816) 756-5252
TELEPHONE:	AT&T	(816) 325-5607
CABLE:	SPECTRUM	(816) 358-8833
WATER:	LEE'S SUMMIT WATER UTILITIES	(816) 969-1900
SEWER:	LEE'S SUMMIT WATER UTILITIES	(816) 969-1900

Sue Pyles
I have reviewed this document
2021.11.29
08:31:26-06'00"

Accepted
Record Drawings
These plans have been reviewed for accuracy and are accepted for basic conformance to the approved construction drawings.

RECORD DRAWING
THIS RECORD DRAWING IS A FINAL RECORD OF THE INSTRUCTIONS PROVIDED FOR CONSTRUCTION AND MAY NOT ACCURATELY REFLECT ALL ACTUAL WORK IN PLACE. REVISIONS HAVE BEEN PREPARED BASED ON INFORMATION FURNISHED BY OTHERS. THOSE RELYING ON THIS RECORD DRAWING ARE ADVISED TO VERIFY ALL INFORMATION.



APPROVED: MARK DANIEL MCGHEE JR., PE


DATE: 02-04-2020



9001 State Line Rd., Suite 200
Kansas City , Missouri 64114
www.LRA-Inc.com
816.361.0440 | P
816.361.0045 | F

GENERAL NOTES:

- ALL CONSTRUCTION TO FOLLOW THE CITY OF LEE'S SUMMIT DESIGN AND CONSTRUCTION MANUAL AS ADOPTED BY ORDINANCE 5813.
- ALL WORKMANSHIP AND MATERIALS SHALL BE SUBJECT TO THE INSPECTION AND APPROVAL OF THE ENGINEERING DEPARTMENT OF THE CITY OF LEE'S SUMMIT, MISSOURI.
- LINEAL FOOT MEASUREMENTS SHOWN ON THE PLANS ARE HORIZONTAL MEASUREMENTS, NOT SLOPE MEASUREMENTS.
- NO GEOLOGICAL INVESTIGATION THIS BEEN PERFORMED ON THIS PLAT.
- THE UTILITY LOCATIONS SHOWN ON THESE PLANS ARE TAKEN FROM UTILITY COMPANY RECORDS AND APPARENT FIELD LOCATIONS. THE CONTRACTOR SHALL VERIFY THE LOCATION AND DEPTH OF ALL UTILITIES PRIOR TO CONSTRUCTION.
- THE CONTRACTOR SHALL ADHERE TO THE PROVISIONS OF THE SENATE BILL NUMBER 583, 78TH GENERAL ASSEMBLY OF THE STAT OF MISSOURI. THE BILL REQUIRES THAT ANY PERSON OR FIRM DOING EXCAVATION ON PUBLIC RIGHT-OF-WAY DO SO ONLY AFTER GIVING NOTICE TO, AND OBTAINING INFORMATION FROM, UTILITY COMPANIES. STATE LAW REQUIRES 72 HOURS ADVANCE NOTICE. THE CONTRACTOR MAY ALSO UTILIZE THE FOLLOWING TOLL FREE PHONE NUMBER PROVIDED BY "MISSOURI ONE CALL SYSTEM, INC.": 1-(800)-DIG-RITE OR 811. THIS PHONE NUMBER IS APPLICABLE ANYWHERE WITHIN THE STATE OF MISSOURI PRIOR TO COMMENCEMENT OF WORK, THE CONTRACTOR SHALL NOTIFY ALL THOSE COMPANIES WHICH ARE FACILITIES IN THE NEAR VICINITY OF THE CONSTRUCTION TO BE PERFORMED.
- PRIOR TO ORDERING PRECAST STRUCTURES, SHOP DRAWINGS SHALL BE SUBMITTED TO THE DESIGN ENGINEER FOR APPROVAL.
- THE CONTRACTOR SHALL PROTECT ALL MAJOR TREES FROM DAMAGE. NO TREE SHALL BE REMOVED WITHOUT PERMISSION OF THE OWNER, UNLESS SHOWN OTHERWISE.
- CLEARING AND GRUBBING OPERATIONS AND DISPOSAL OF ALL DEBRIS THEREFROM SHALL BE PERFORMED BY THE CONTRACTOR IN STRICT ACCORDANCE WITH ALL LOCAL CODES AND ORDINANCES.
- ALL WASTE MATERIAL RESULTING FROM THE PROJECT SHALL BE DISPOSED OF OFF-SITE BY THE CONTRACTOR, OR AS DIRECTED BY THE OWNER.
- ALL EXCAVATION SHALL BE UNCLASSIFIED.
- THE CONTRACTOR SHALL CONTROL THE EROSION AND SILTATION DURING ALL PHASES OF CONSTRUCTION, AND SHALL KEEP THE STREETS CLEAN OF MUD AND DEBRIS.
- ALL MANHOLES, CATCH BASINS, UTILITY VALVES AND METER PITS TO BE ADJUSTED OR REBUILT TO GRADE AS REQUIRED. ALL EXISTING UTILITIES SHALL BE ADJUSTED AS REQUIRED.
- SUBGRADE SOIL FOR ALL CONCRETE STRUCTURES, REGARDLESS OF THE TYPE OR LOCATION, SHALL BE FIRM, DENSE AND THOROUGHLY COMPACTED AND CONSOLIDATED; SHALL BE FREE FROM MUCK AND MUD; AND SHALL BE SUFFICIENTLY STABLE TO REMAIN FIRM AND INTACT UNDER THE FEET OF THE WORKMEN OR MACHINERY ENGAGED IN SUBGRADE SURFACING, LAYING REINFORCING STEEL, AND DEPOSITING CONCRETE THEREON. IN ALL CASES WHERE SUBSOIL IS MUCKY OR WORKS INTO MUD OR MUCK DURING SUCH OPERATION, A SEAL COURSE OF EITHER CONCRETE OR ROCK SHALL BE PLACED BELOW SUGRADE TO PROVIDE A FIRM BASE FOR WORKING AND STRUCTURE CONSTRUCTION.
- THE CONTRACTOR SHALL CONTACT PUBLIC WORKS INSPECTIONS AT 816-969-1800 TO OBTAIN A PUBLIC WORKS CONSTRUCTION PERMIT. PERMITS ARE ISSUED BY THE DEVELOPMENT ENGINEERING DIVISION AFTER PLANS ARE APPROVED FOR PERMITTING AND FEES ARE PAID.
- THE CONTRACTOR SHALL CONTACT THE CITY'S DEVELOPMENT ENGINEERING FIELD ENGINEERING INSPECTORS AT 816-969-1200 PRIOR TO ANY LAND DISTURBANCE.
- THE CONTRACTOR SHALL CONTACT THE CITY'S RIGHT-OF-WAY INSPECTOR AT 816-969-1800 PRIOR TO ANY LAND DISTURBANCE ACTIVITIES WITHIN THE RIGHT-OF-WAY. THESE ACTIVITIES MAY REQUIRE A PERMIT.
- THE CONTRACTOR SHALL PROVIDE AND MAINTAIN ALL TRAFFIC HANDLING MEASURES NECESSARY TO ENSURE THAT THE GENERAL PUBLIC IS PROTECTED AT ALL TIMES. TRAFFIC CONTROL SHALL CONFORM TO THE MANUAL ON UNIFORM TRAFFIC CONTROL DEVICES (MUTCD - LATEST EDITION).

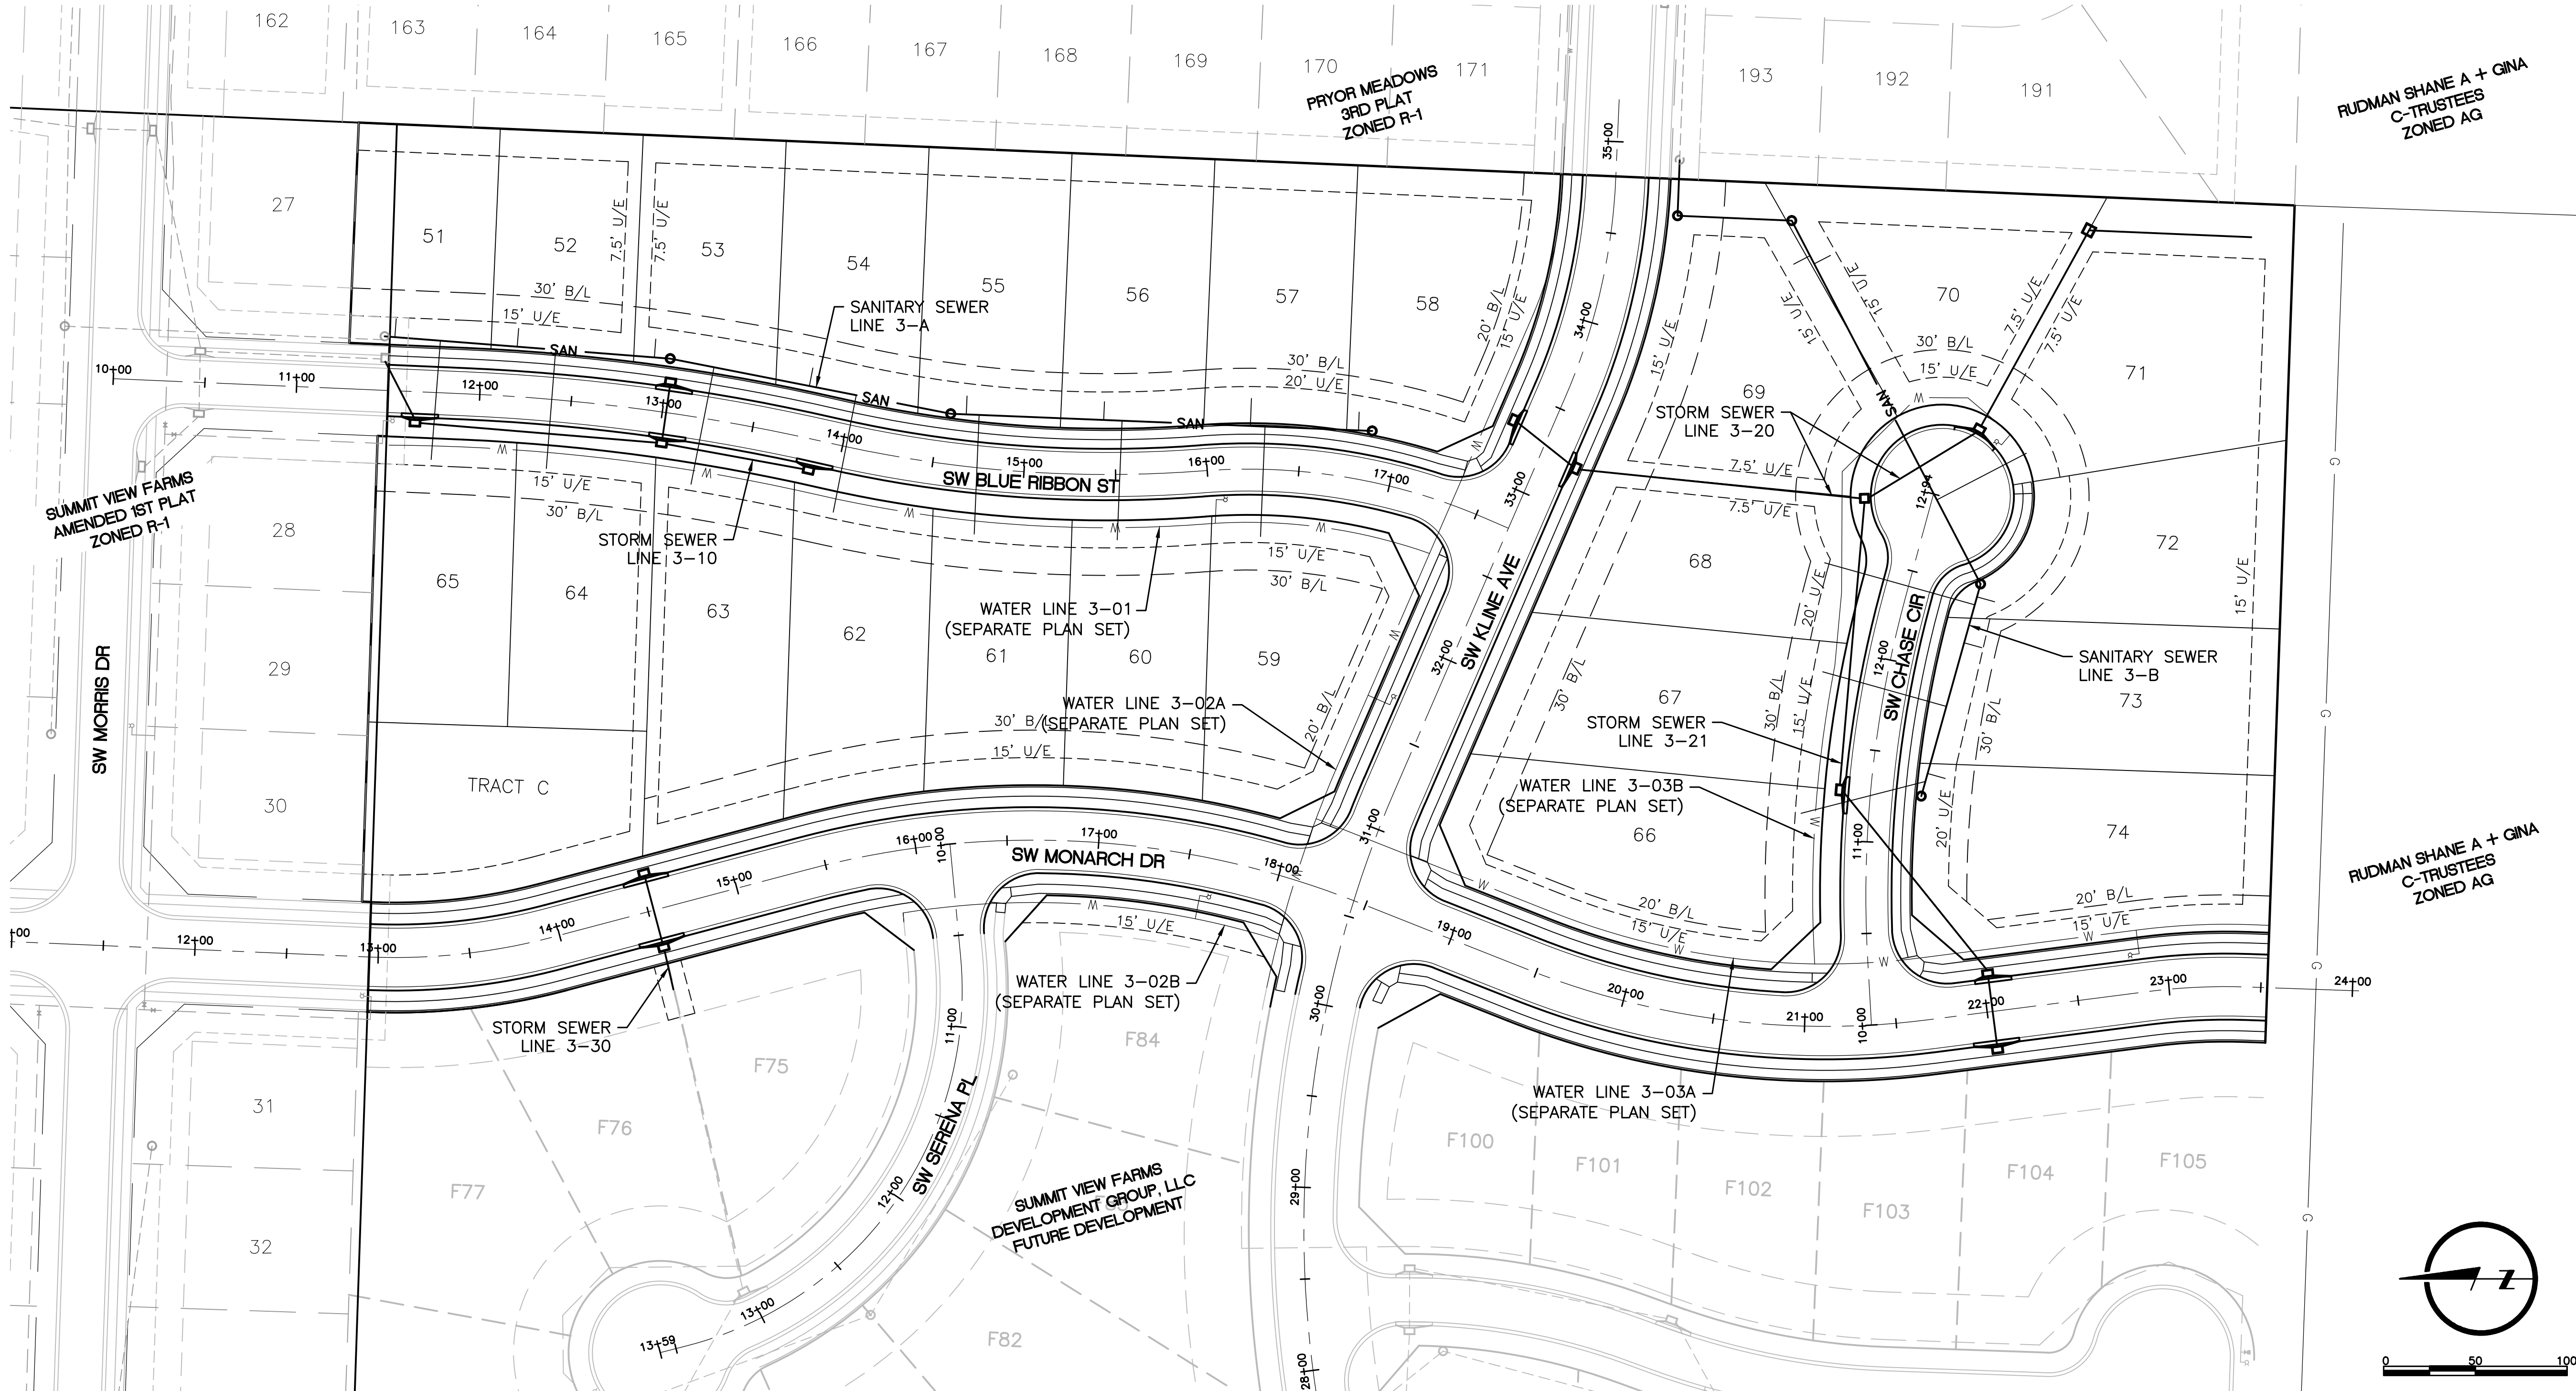


DRAWN BY AJM	DESIGNED BY MDM	DATE 09-19-2018	JOB NUMBER-TASKS 0316050.01	BOOK AND PAGE
REVISIONS 08/19/18 - RESUBMITAL PER ADJUSTED LAYOUT 09/19/18 - RESUBMITAL PER CITY COMMENTS				
9001 State Line Rd., Suite 200, 816.361.0040 P Kansas City, Missouri 64114 816.361.0045 F www.LRA-inc.com				
LARKIN/RYNEARSON LAMP RYNEARSON				
SUMMIT VIEW FARMS 3RD PLAT LEE'S SUMMIT, MISSOURI				
MASS GRADING, EROSION CONTROL, PAVING, STORM AND SANITARY PLANS				
GENERAL LAYOUT PLAN SHEET				
LARKIN LAMP RYNEARSON - ENGINEERS MEO Certificate of Authority No. 2013011903				
STATE OF MISSOURI MARK DANIEL MCGHEE JR. PE-2008019568 09-19-2018				
MARK DANIEL MCGHEE JR. PE - 2008019568				
SHEET				
02 OF 31				

L:\Engineering\0318050 SVFC Summit View Farms 3rd Plat\DRAWINGS\CONSTRUCTION DRAWINGS\GRD-ERC-PLANS\0318050-MG-EX-COND.dwg, 9/19/2018 7:57:18 AM, JAMIE MONMURRY, LAMP RYNEARSON & ASSOCIATES

UTILITY STATEMENT:

THE UNDERGROUND UTILITIES SHOWN HEREON ARE FROM FIELD SURVEY INFORMATION OF ONE-CALL LOCATED UTILITIES, FIELD SURVEY INFORMATION OF ABOVE GROUND OBSERVABLE EVIDENCE, AND/OR THE SCALING AND PLOTTING OF EXISTING UTILITY MAPS AND DRAWINGS AVAILABLE TO THE SURVEYOR AT THE TIME OF SURVEY. THE SURVEYOR MAKES NO GUARANTEE THAT THE UNDERGROUND UTILITIES SHOWN COMPRISE ALL SUCH UTILITIES IN THE AREA, EITHER IN SERVICE OR ABANDONED. FURTHERMORE, THE SURVEYOR DOES NOT WARRANT THAT THE UNDERGROUND UTILITIES SHOWN ARE IN THE EXACT LOCATION INDICATED ALTHOUGH HE DOES CERTIFY THAT THEY ARE LOCATED AS ACCURATELY AS POSSIBLE FROM INFORMATION AVAILABLE. THE SURVEYOR HAS NOT PHYSICALLY LOCATED THE UNDERGROUND UTILITIES BY EXCAVATION UNLESS OTHERWISE NOTED ON THIS SURVEY.
MISSOURI ONE CALL TICKET #181713504, #181713505, #181713506, #181713507 AND #181713508

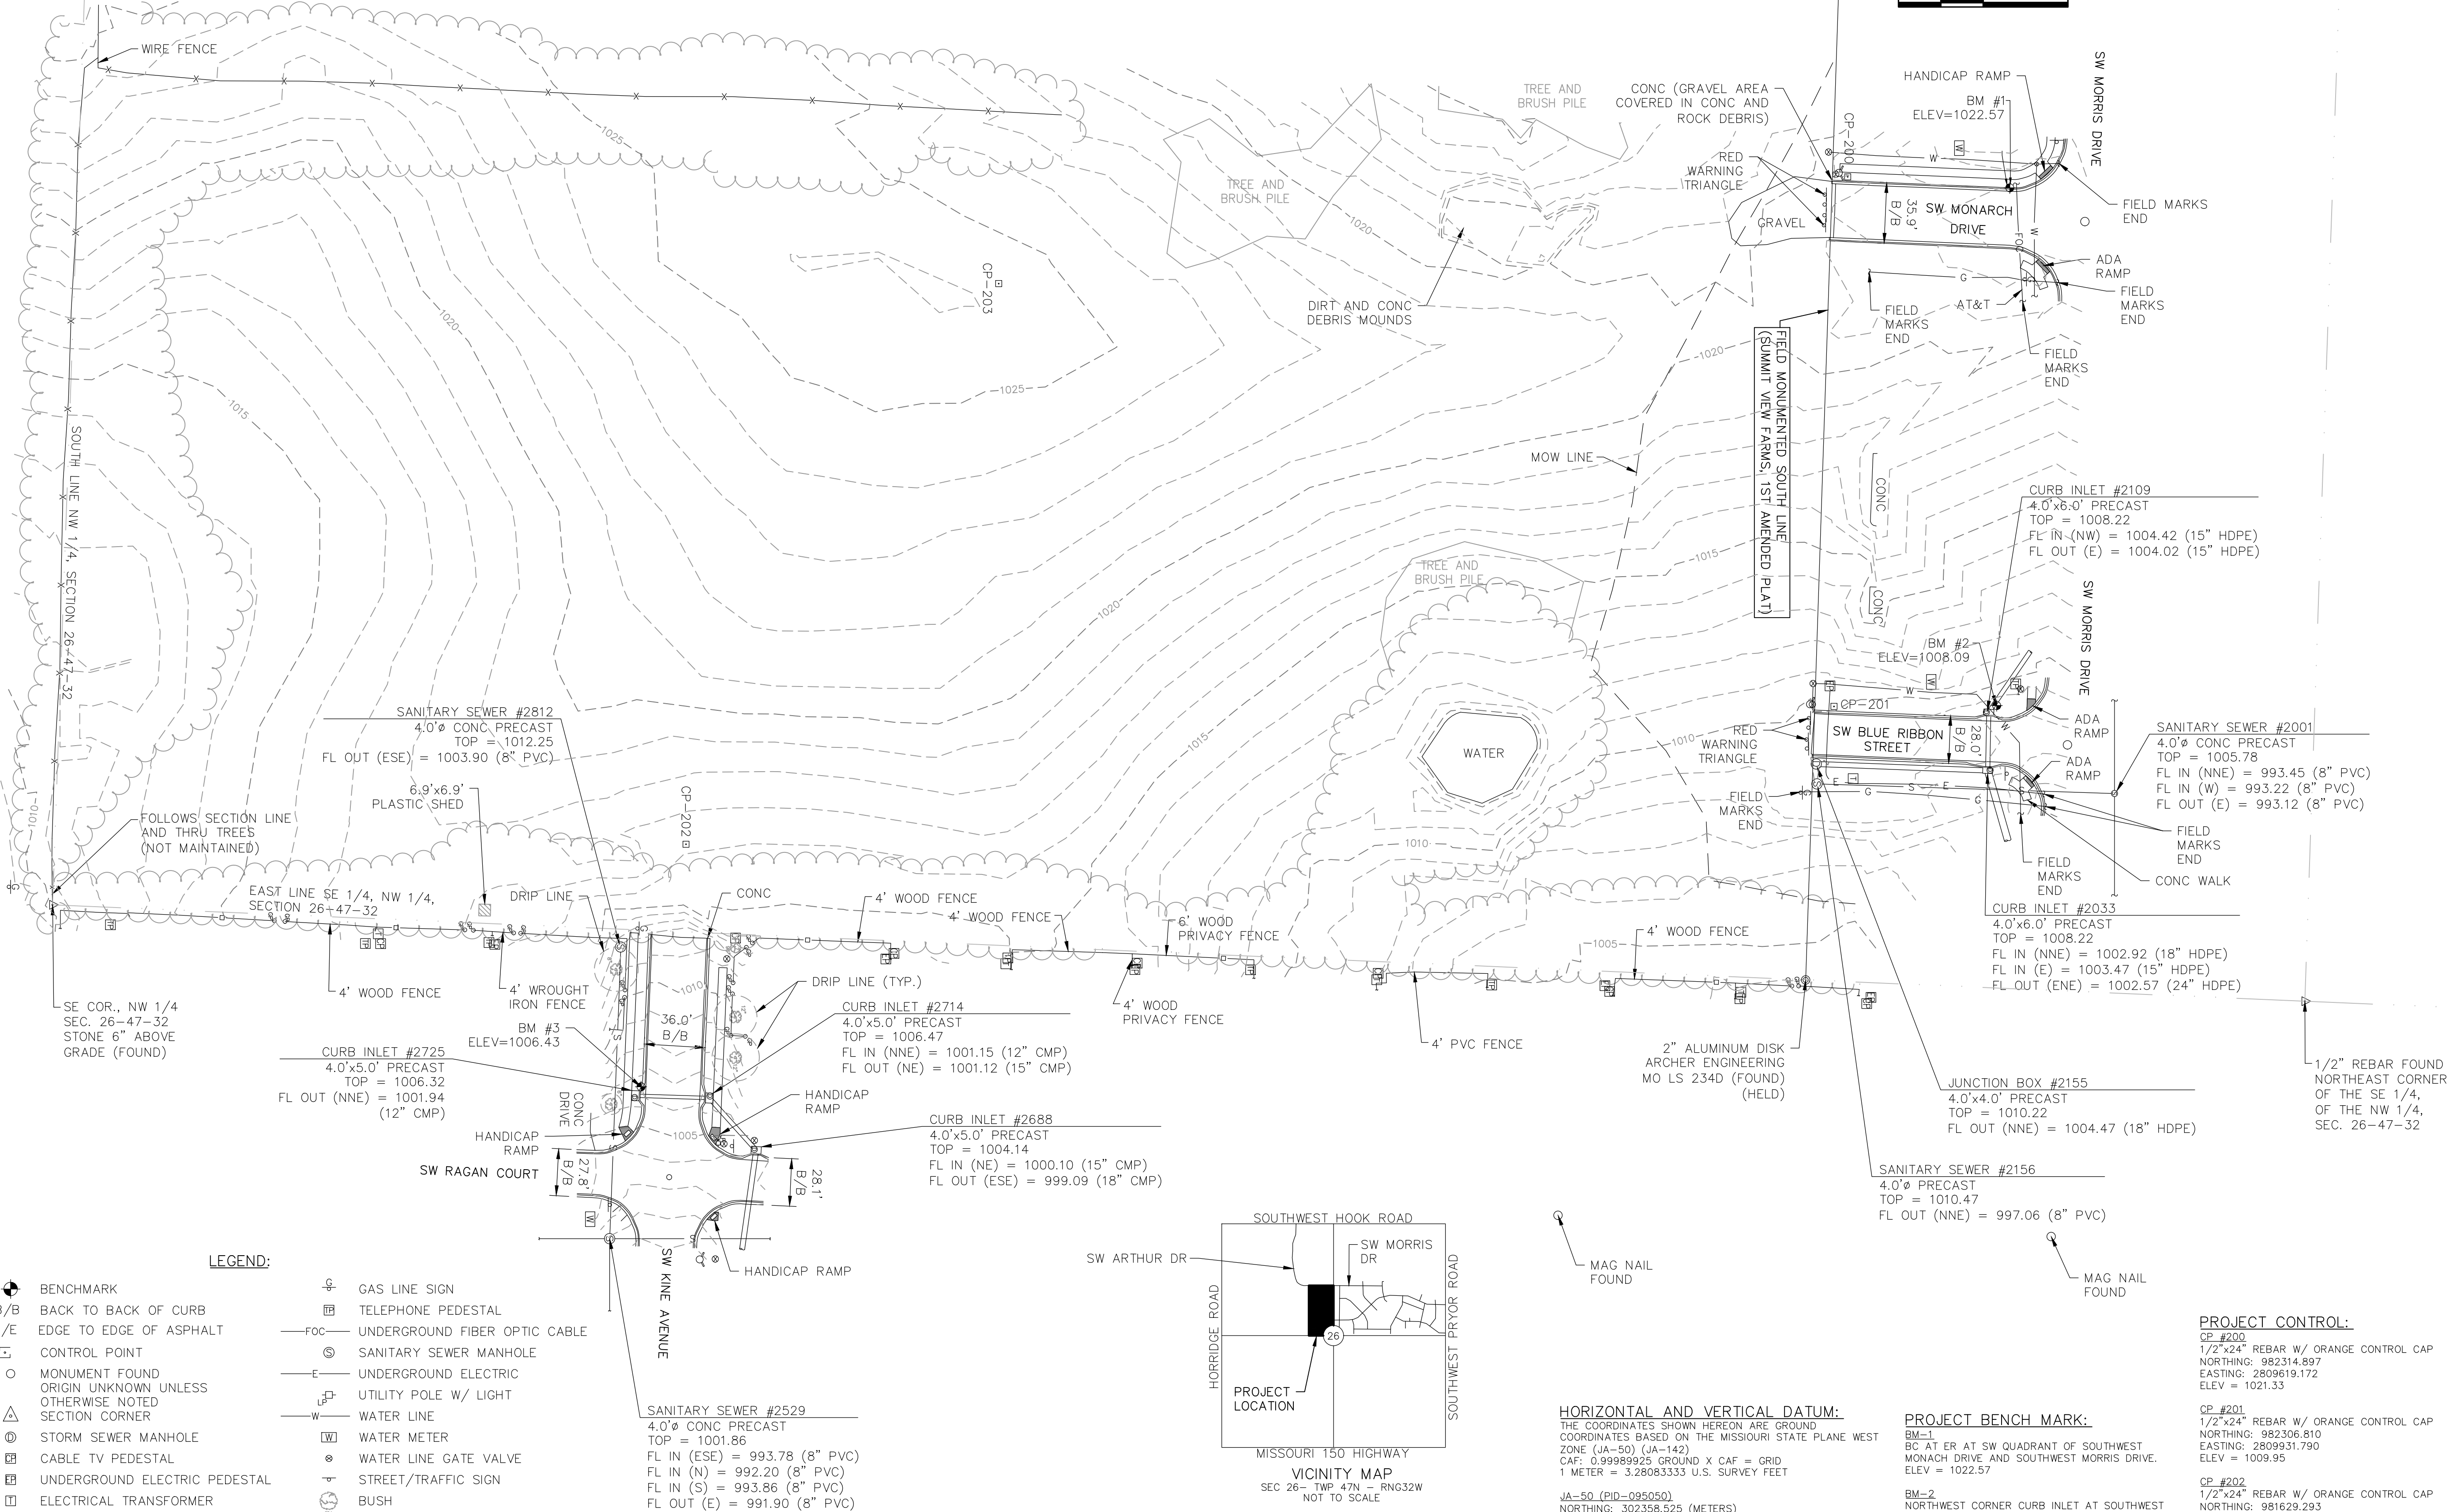

LEGEND:

- | | |
|--|-------------------------------------|
| ● BENCHMARK | —G— GAS LINE SIGN |
| B/B BACK TO BACK OF CURB | —T— TELEPHONE PEDESTAL |
| E/E EDGE TO EDGE OF ASPHALT | —FOC— UNDERGROUND FIBER OPTIC CABLE |
| □ CONTROL POINT | ⊙ SANITARY SEWER MANHOLE |
| ○ MONUMENT FOUND ORIGIN UNKNOWN UNLESS OTHERWISE NOTED | —E— UNDERGROUND ELECTRIC |
| △ SECTION CORNER | —W— WATER LINE |
| ⊙ STORM SEWER MANHOLE | —W— WATER METER |
| □ CABLE TV PEDESTAL | ⊙ WATER LINE GATE VALVE |
| ⊙ UNDERGROUND ELECTRIC PEDESTAL | —T— STREET/TRAFFIC SIGN |
| ⊙ ELECTRICAL TRANSFORMER | ⊙ BUSH |
| ⊙ FIRE HYDRANT | ⊙ DECIDUOUS TREE |
| —X— BARBED WIRE FENCE | —ELEV— EXISTING GRADE 1' CONTOUR |
| —W— WOOD FENCE | —ELEV— EXISTING GRADE 5' CONTOUR |
| ⊙ GATE POST | |
| —G— UNDERGROUND GAS | |

REFERENCE SURVEY

- TOPOGRAPHIC SURVEY, PREPARED BY: HDR ENGINEERING INC. PROJECT #: 239662 AND DATED: JANUARY 6, 2015.
- TOPOGRAPHIC SURVEY, PREPARED BY: PHOENIX ENGINEERING & SURVEYING, LLC, PROJECT #: 02067A AND DATED: OCTOBER 22, 2003.

HORIZONTAL AND VERTICAL DATUM:

THE COORDINATES SHOWN HEREON ARE GROUND COORDINATES BASED ON THE MISSOURI STATE PLANE WEST ZONE (JA-50) (JA-142)
CAF: 0.99989925 GROUND X CAF = GRID
1 METER = 3.28083333 U.S. SURVEY FEET

JA-50 (PID-095050)
NORTHING: 302358.525 (METERS)
EASTING: 854683.866 (METERS)
ELEV = 289.8 (METERS)

JA-142 (PID-095142)
NORTHING: 302106.953 (METERS)
EASTING: 858960.056 (METERS)
ELEV = 318.0 (METERS)

PROJECT BENCH MARK:

- BM-1
1/2"x24" REBAR W/ ORANGE CONTROL CAP
NORTHING: 982314.897
EASTING: 2809619.172
ELEV = 1021.33
- BM-2
NORTHWEST CORNER CURB INLET AT SOUTHWEST QUADRANT OF SOUTHWEST MORRIS AND BLUE RIBBON.
ELEV = 1008.09
- BM-3
NORTHWEST CORNER CURB INLET AT SOUTHWEST QUADRANT OF REGAN AND KLINE.
ELEV = 1006.43

NOTE:

TOPOGRAPHIC AND BOUNDARY SURVEY WAS PERFORMED BY KAW VALLEY ENGINEERING, INC.

MASS GRADING, EROSION CONTROL,
PAVING, STORM AND SANITARY PLANS

EXISTING CONDITIONS PLAN

SUMMIT VIEW FARMS 3RD PLAT
LEE'S SUMMIT, MISSOURI

LARKIN/
LAMP RYNEARSON

9001 State Line Rd., Suite 200
Kansas City, Missouri 64114
www.LRA-inc.com

DRAWN BY	AM
DESIGNED BY	MDM
DATE	09-19-2018
JOB NUMBER-TASKS	0318050.01
BOOK AND PAGE	

LARKIN LAMP RYNEARSON - ENGINEERS
TMO Certificate of Authority No. 2013011903



MARK DANIEL MCGHEE JR.

PE - 2008019568

SHEET

03 OF 31


L:\Engineering\031850 SVFDG Summit View Farms 3rd Plat\DRAWINGS\CONSTRUCTION DRAWINGS\GRD-ERC-PLANS\031850-MG-PLN.dwg, 3/7/2019 8:21:13 AM, DAN MCGHEE, LAMP RYNEARSON & ASSOCIATES

GENERAL NOTES:

1. SLOPES SHALL BE GRADED AS SHOWN ON THE PLANS WITH A MAXIMUM SLOPE OF 3:1 UNLESS NOTED OTHERWISE.
2. CONTOURS SHOWN ARE AT 1-FOOT INTERVALS.
3. DISTURBED AREAS SHALL HAVE SURFACES ROUGHENED PER KCAPWA SPECIFICATIONS.
4. ALL PROPOSED GRADES SHOWN ARE TO FINISH GRADE. THE CONTRACTOR IS RESPONSIBLE FOR ADJUSTMENTS TO ACCOUNT FOR PAVEMENT SECTION, SUBBASE, AND TOPSOIL REMOVAL AND REPLACEMENT.
5. EMBANKMENTS SHALL BE CONSTRUCTED TO 90% OF MAXIMUM DRY DENSITY OUTSIDE RIGHT-OF-WAY AND TO 95% WITHIN RIGHT-OF-WAY IN 8-INCH MAXIMUM LIFTS IN ACCORDANCE WITH APWA SECTION 2102.6 REQUIREMENTS.

LEGEND

- PROPOSED MAJOR CONTOUR
- PROPOSED MINOR CONTOUR
- EXISTING MAJOR CONTOUR
- EXISTING MINOR CONTOUR

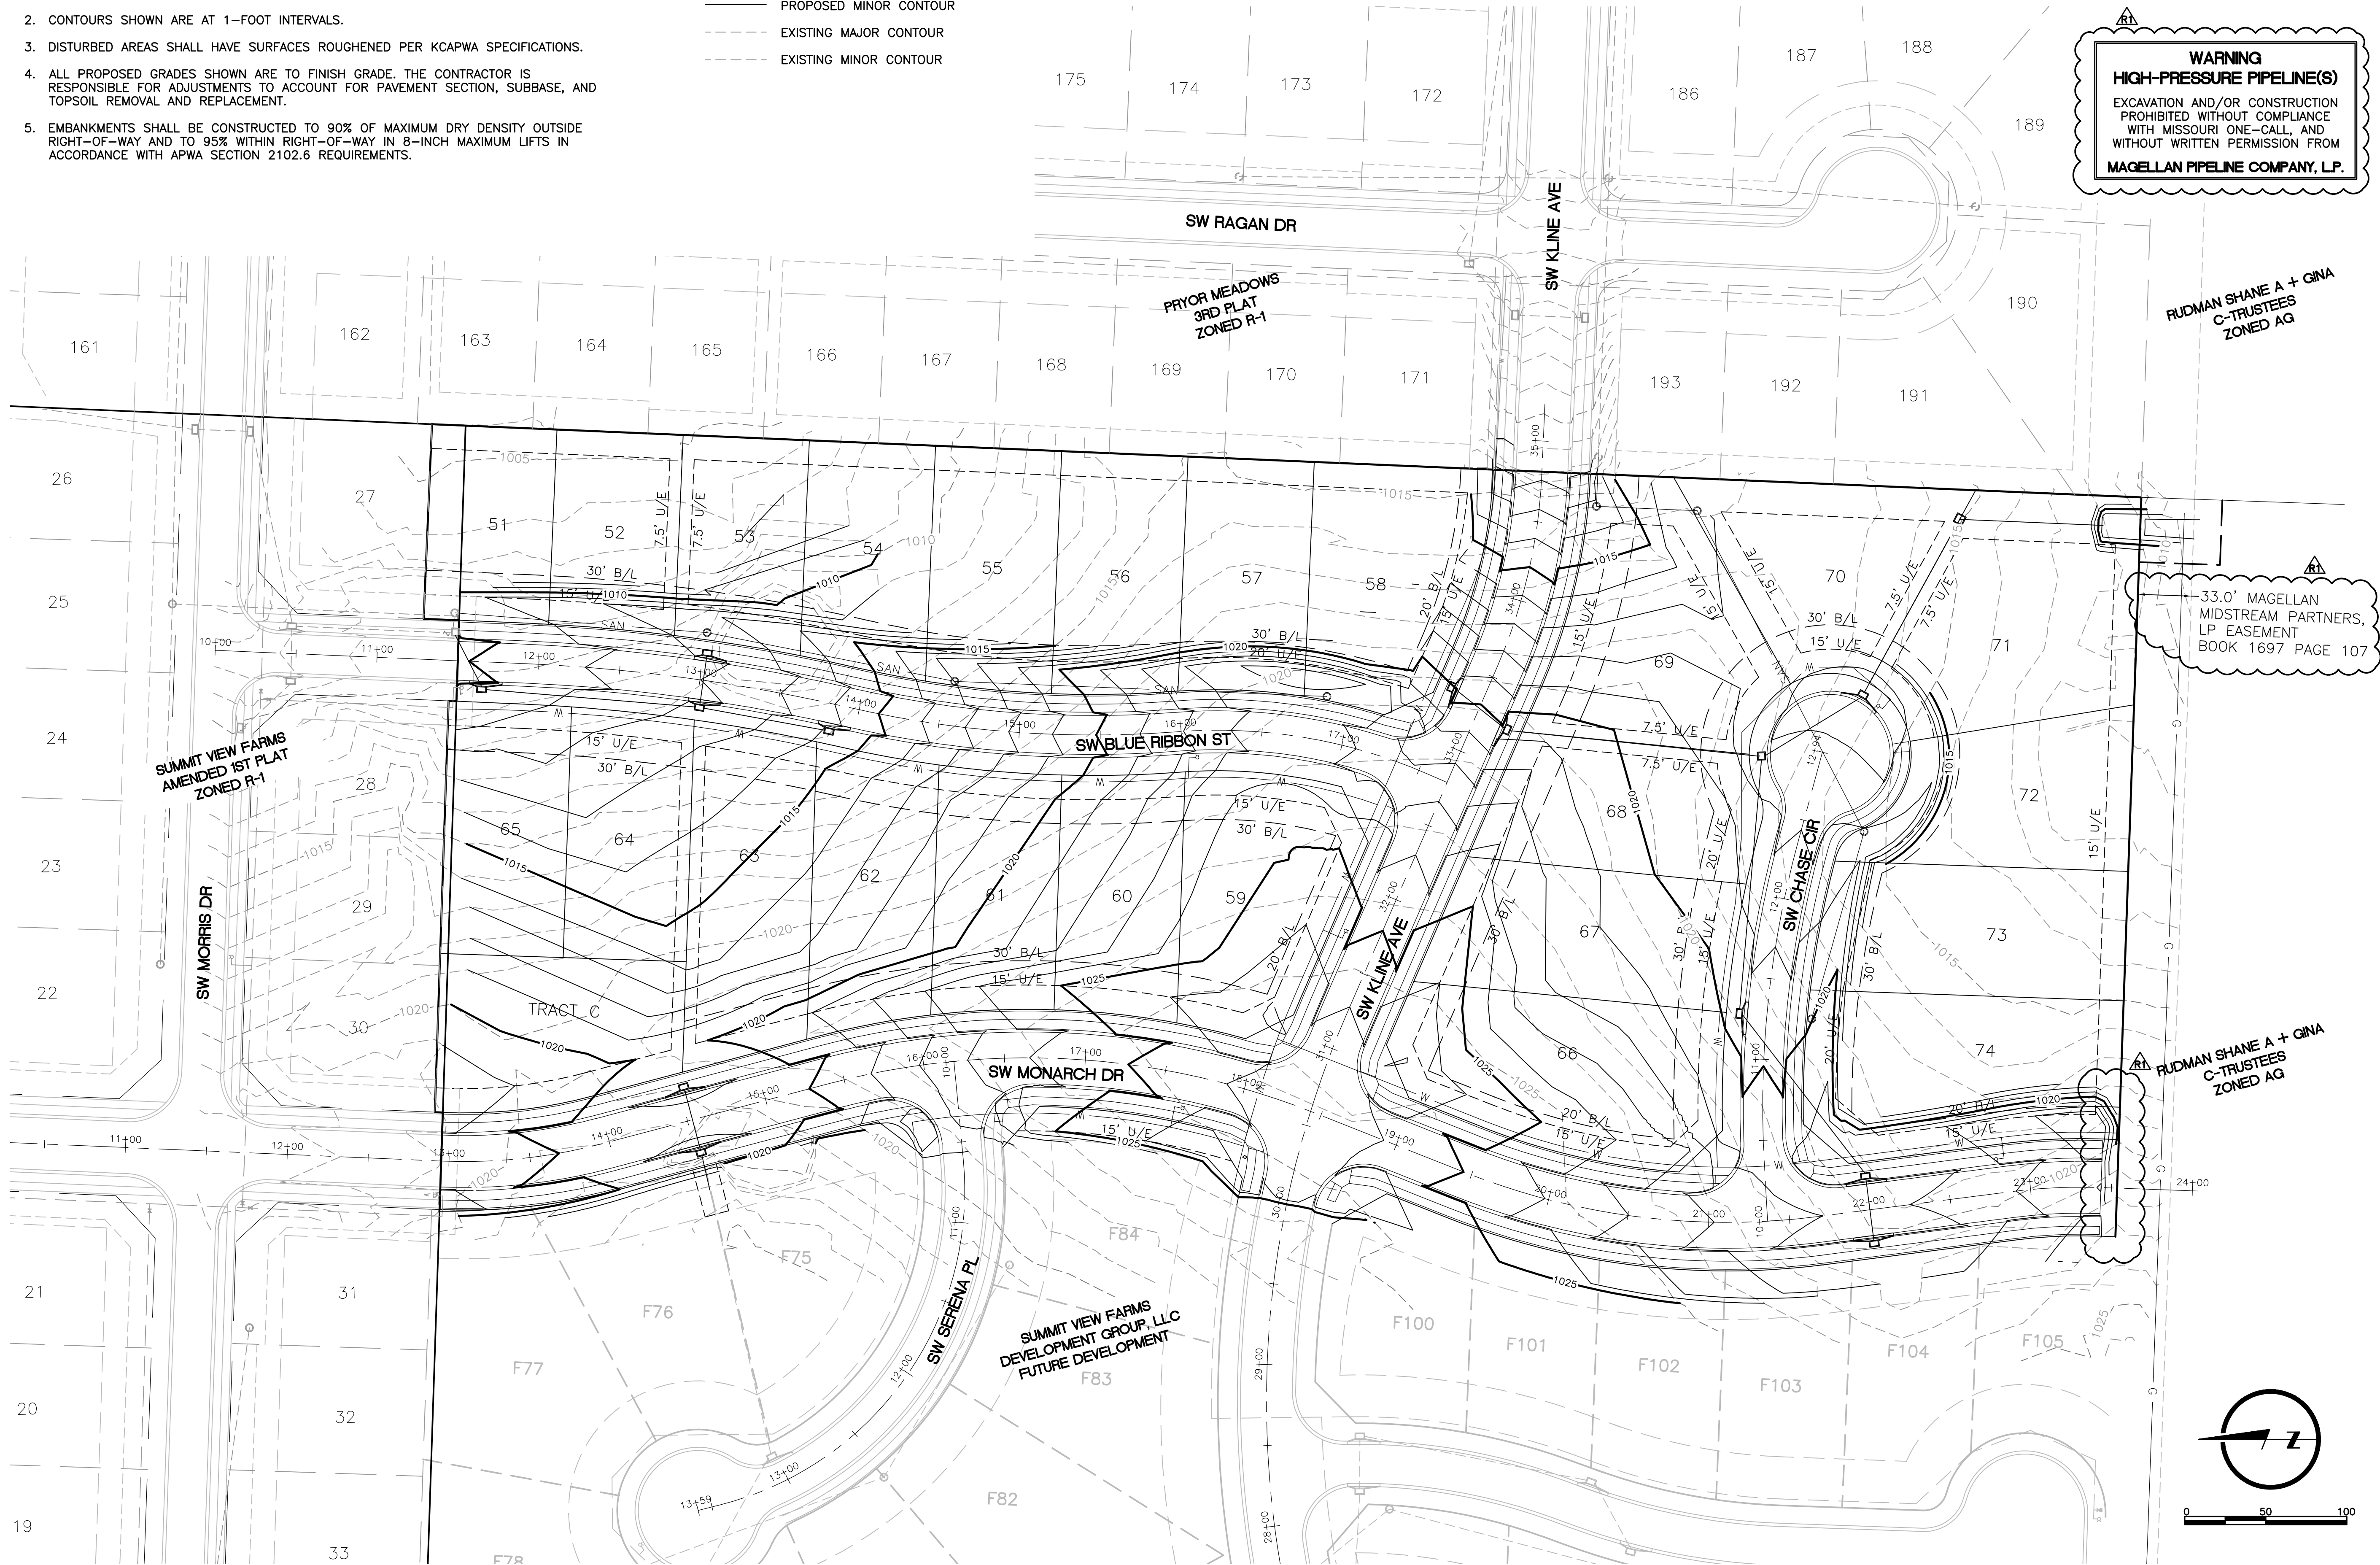

WARNING
HIGH-PRESSURE PIPELINE(S)
EXCAVATION AND/OR CONSTRUCTION
PROHIBITED WITHOUT COMPLIANCE
WITH MISSOURI ONE-CALL, AND
WITHOUT WRITTEN PERMISSION FROM
MAGELLAN PIPELINE COMPANY, LP.

33.0' MAGELLAN
MIDSTREAM PARTNERS,
LP EASEMENT
BOOK 1697 PAGE 107



DRAWN BY AJM	DESIGNED BY NDM	DATE 10-05-2018	JOB NUMBER-TASKS 031850.01	BOOK AND PAGE
REVISIONS				
09/10/18 - RESUBMITAL PER ADJUSTED LAYOUT				
09/19/18 - RESUBMITAL PER CITY COMMENTS				
03/01/19 - REVISION 1				
9001 State Line Rd., Suite 200 Kansas City, Missouri 64114 www.LRA-inc.com				
LARKIN/ LAMP RYNEARSON				
SUMMIT VIEW FARMS 3RD PLAT LEE'S SUMMIT, MISSOURI				
MASS GRADING, EROSION CONTROL, PAVING, STORM AND SANITARY PLANS				
MASS GRADING PLAN				
LARKIN LAMP RYNEARSON - ENGINEERS NO Certificate of Authority No. 2013011903				
MARK DANIEL MCGHEE JR. PE - 2008019568				
SHEET				
04 OF 31				

GENERAL NOTES:

1. CONTRACTOR IS RESPONSIBLE FOR KEEPING ALL PUBLIC ROADWAYS ADJACENT TO THE CONSTRUCTION SITE FREE OF DIRT AND DEBRIS RESULTING FROM ACTIVITIES RELATED TO THE CONSTRUCTION OF THIS PROJECT.
2. CONTRACTOR SHALL UTILIZE TEMPORARY CONSTRUCTION ENTRANCE FOR ACCESS TO SITE.
3. MULCH BERMS SHALL BE AT LEAST 18-INCH TALL AND 2-FEET WIDE AT TOP OF BERM.
4. CONTRACTOR SHALL NOT STRIP ENTIRE PROPERTY. LOCATE STOCKPILE/STORAGE AREAS ON WEST SIDE OF THE SITE ON RIDGE. ADDITIONAL EROSION AND SEDIMENT CONTROL DEVICES SHALL BE PROVIDED AS REQUIRED SHOULD DISTURBED AREAS EXTEND BEYOND PLAN DEPICTED CONTROL MEASURES.


PRE-CLEARING EROSION AND SEDIMENT CONTROL SEQUENCING:

5. IMPLEMENT PRE-CLEARING PLAN: ALL STRUCTURAL BMPs SHOWN ON THE PRE-CLEARING PLAN MUST BE IN PLACE BEFORE GENERAL CLEARING OPERATIONS. CLEARING NECESSARY TO PLACE STRUCTURAL BMPs SHALL BE THE MINIMUM REQUIRED FOR INSTALLATION. COORDINATE CLEARING NECESSARY TO PLACE STRUCTURAL BMPs WITH LOCAL WEATHER FORECAST SO THAT CLEARING AND PLACEMENT MAY BE COMPLETED WITHIN A FORECAST DRY PERIOD. STABILIZE ALL DIVERSION DIKES, SEDIMENT BASINS, AND SEDIMENT TRAPS WITHIN 5 DAYS AFTER INSTALLATION.
6. EARLY WORK: CLEAR MINIMUM WORK ZONE AND CONSTRUCT ANY EARLY WORK ITEMS OF PERMANENT CONSTRUCTION THAT ARE SHOWN ON THE PRE-CLEARING PLAN. SANITARY SEWER MAY BE CONSTRUCTED BEFORE MASS GRADING OCCURS.

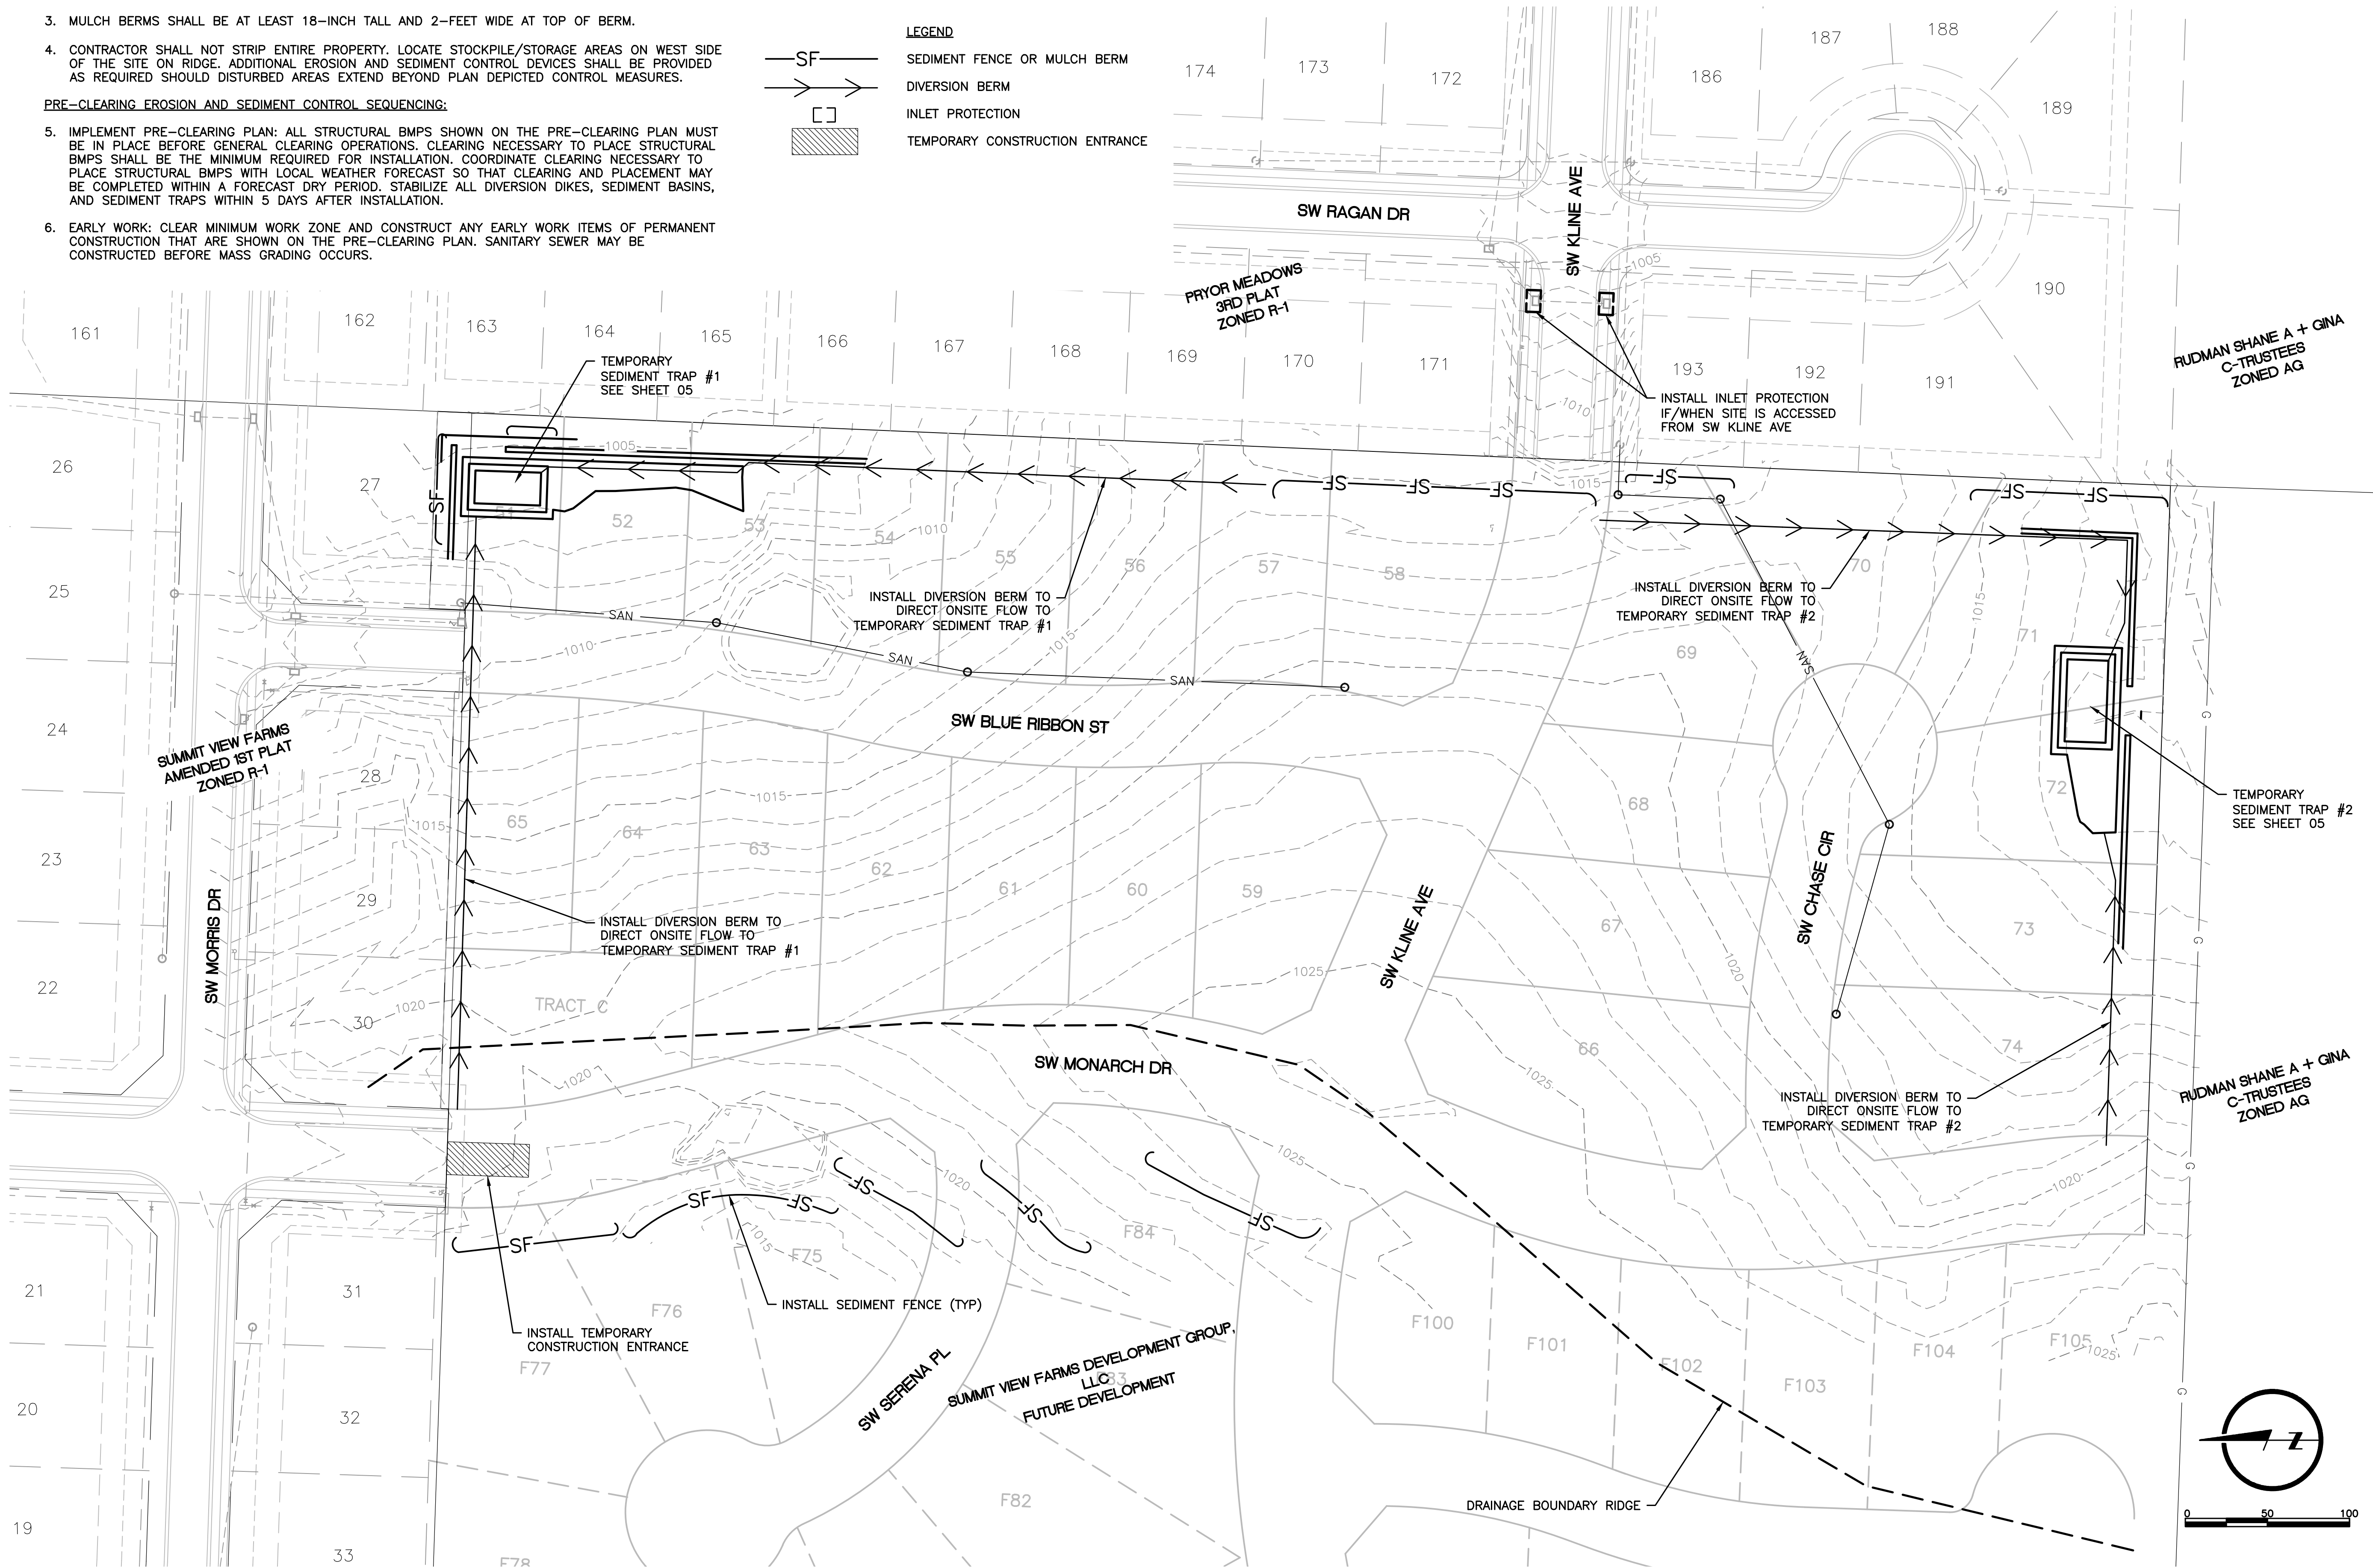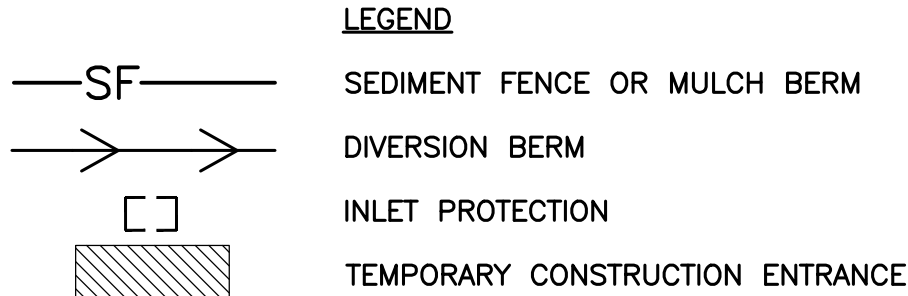


DRAWN BY JAM	DESIGNED BY MDM	DATE 09-19-2018	JOB NUMBER-TASKS 0316050.01	BOOK AND PAGE
REVISIONS				
08/19/18 - RESUBMITAL PER ADJUSTED LAYOUT				
09/19/18 - RESUBMITAL PER CITY COMMENTS				
9001 State Line Rd., Suite 200 816.361.0440 P Kansas City, Missouri 64114 816.361.0045 F www.LRA-Inc.com				
LARKIN/ LAMP RYNEARSON				
SUMMIT VIEW FARMS 3RD PLAT LEE'S SUMMIT, MISSOURI				
MASS GRADING, EROSION CONTROL, PAVING, STORM AND SANITARY PLANS PRE CLEARING EROSION AND SEDIMENT CONTROL PLAN				
LARKIN LAMP RYNEARSON - ENGINEERS TMO Certificate of Authority No. 2013011903				
MARK DANIEL MCGHEE JR. PE - 2008019568				
SHEET				
05 OF 31				

L:\Engineering\0316050 SVFDG Summit View Forms 3rd Plat\Drawings\CONSTRUCTION DRAWINGS\GRD-ERC-PLANS\0316050-MG-TMP-TRP.dwg, 9/19/2018 8:07:50 AM, JAMIE MCNURRY, LAMP RYNEARSON & ASSOCIATES

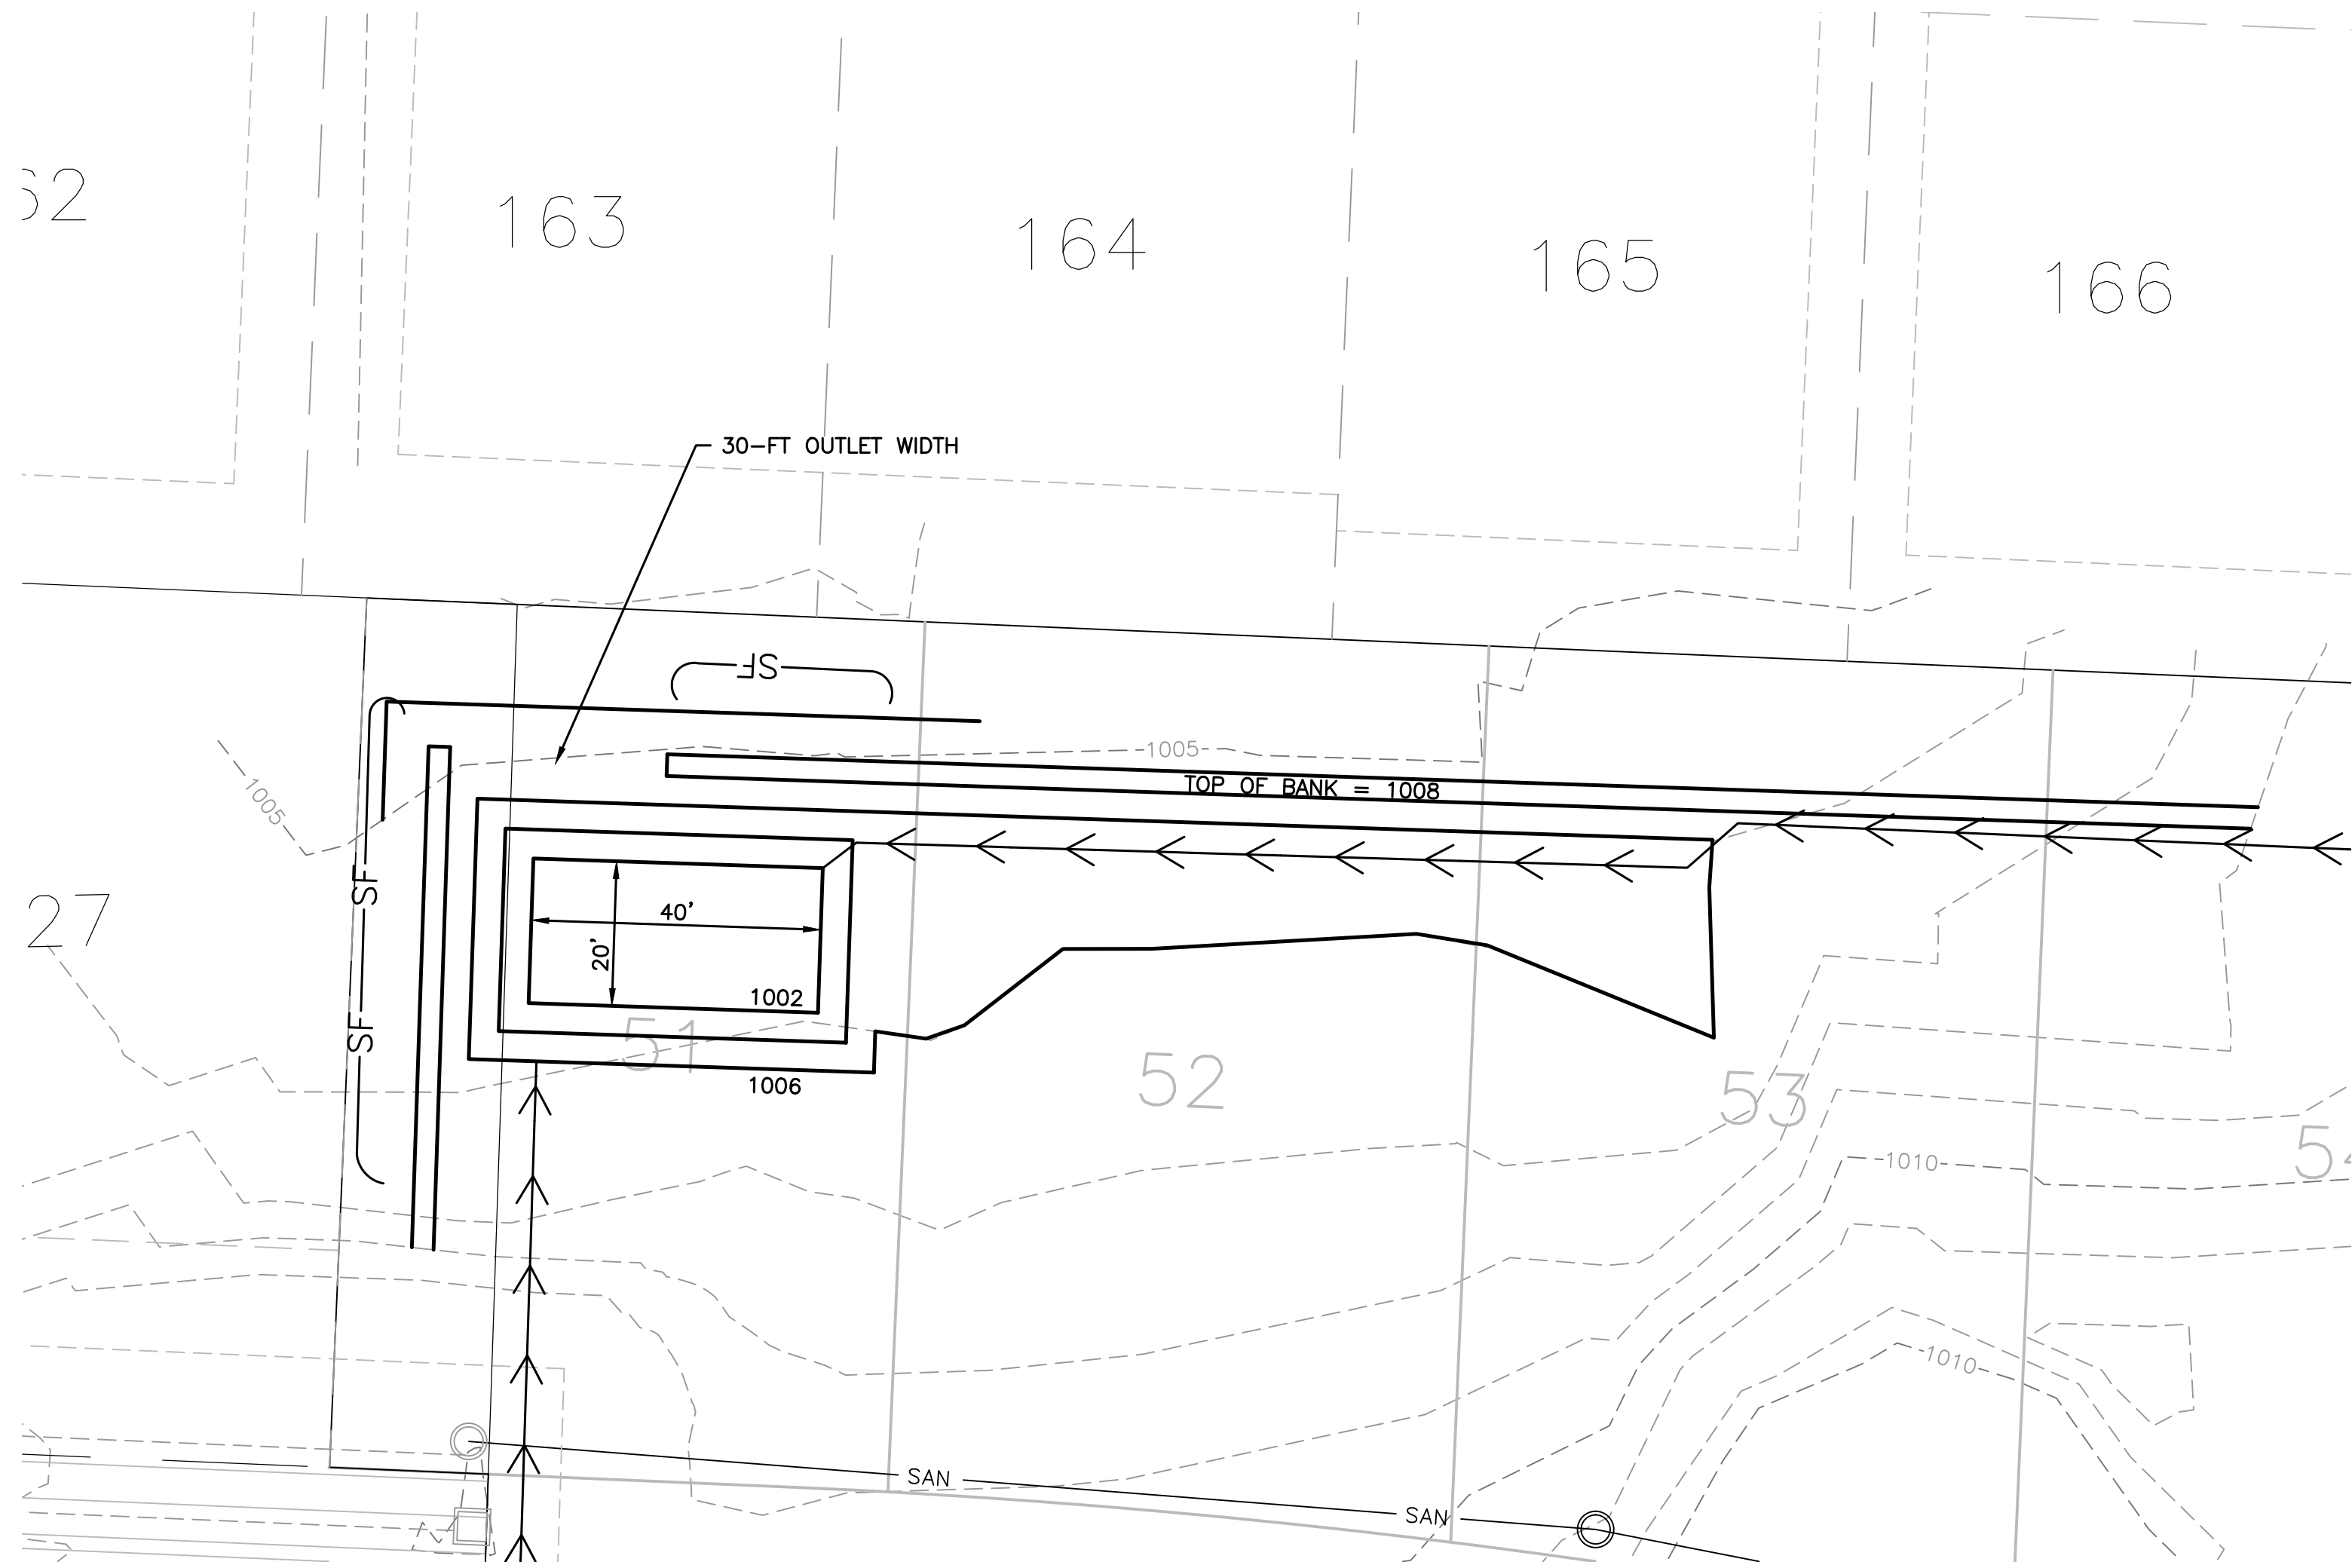

SEDIMENT TRAP #1 PLAN

TRIBUTARY DRAINAGE AREA	4.08 AC
VOLUME REQUIRED (67 CY/AC)	7,381 CF
DESIGN VOLUME PROVIDED (4-FT DEPTH)	7,799 CF
TOP OF BANK ELEVATION	1008
OUTLET WIDTH	30 Ft
TOP OF OUTLET ELEVATION	1007

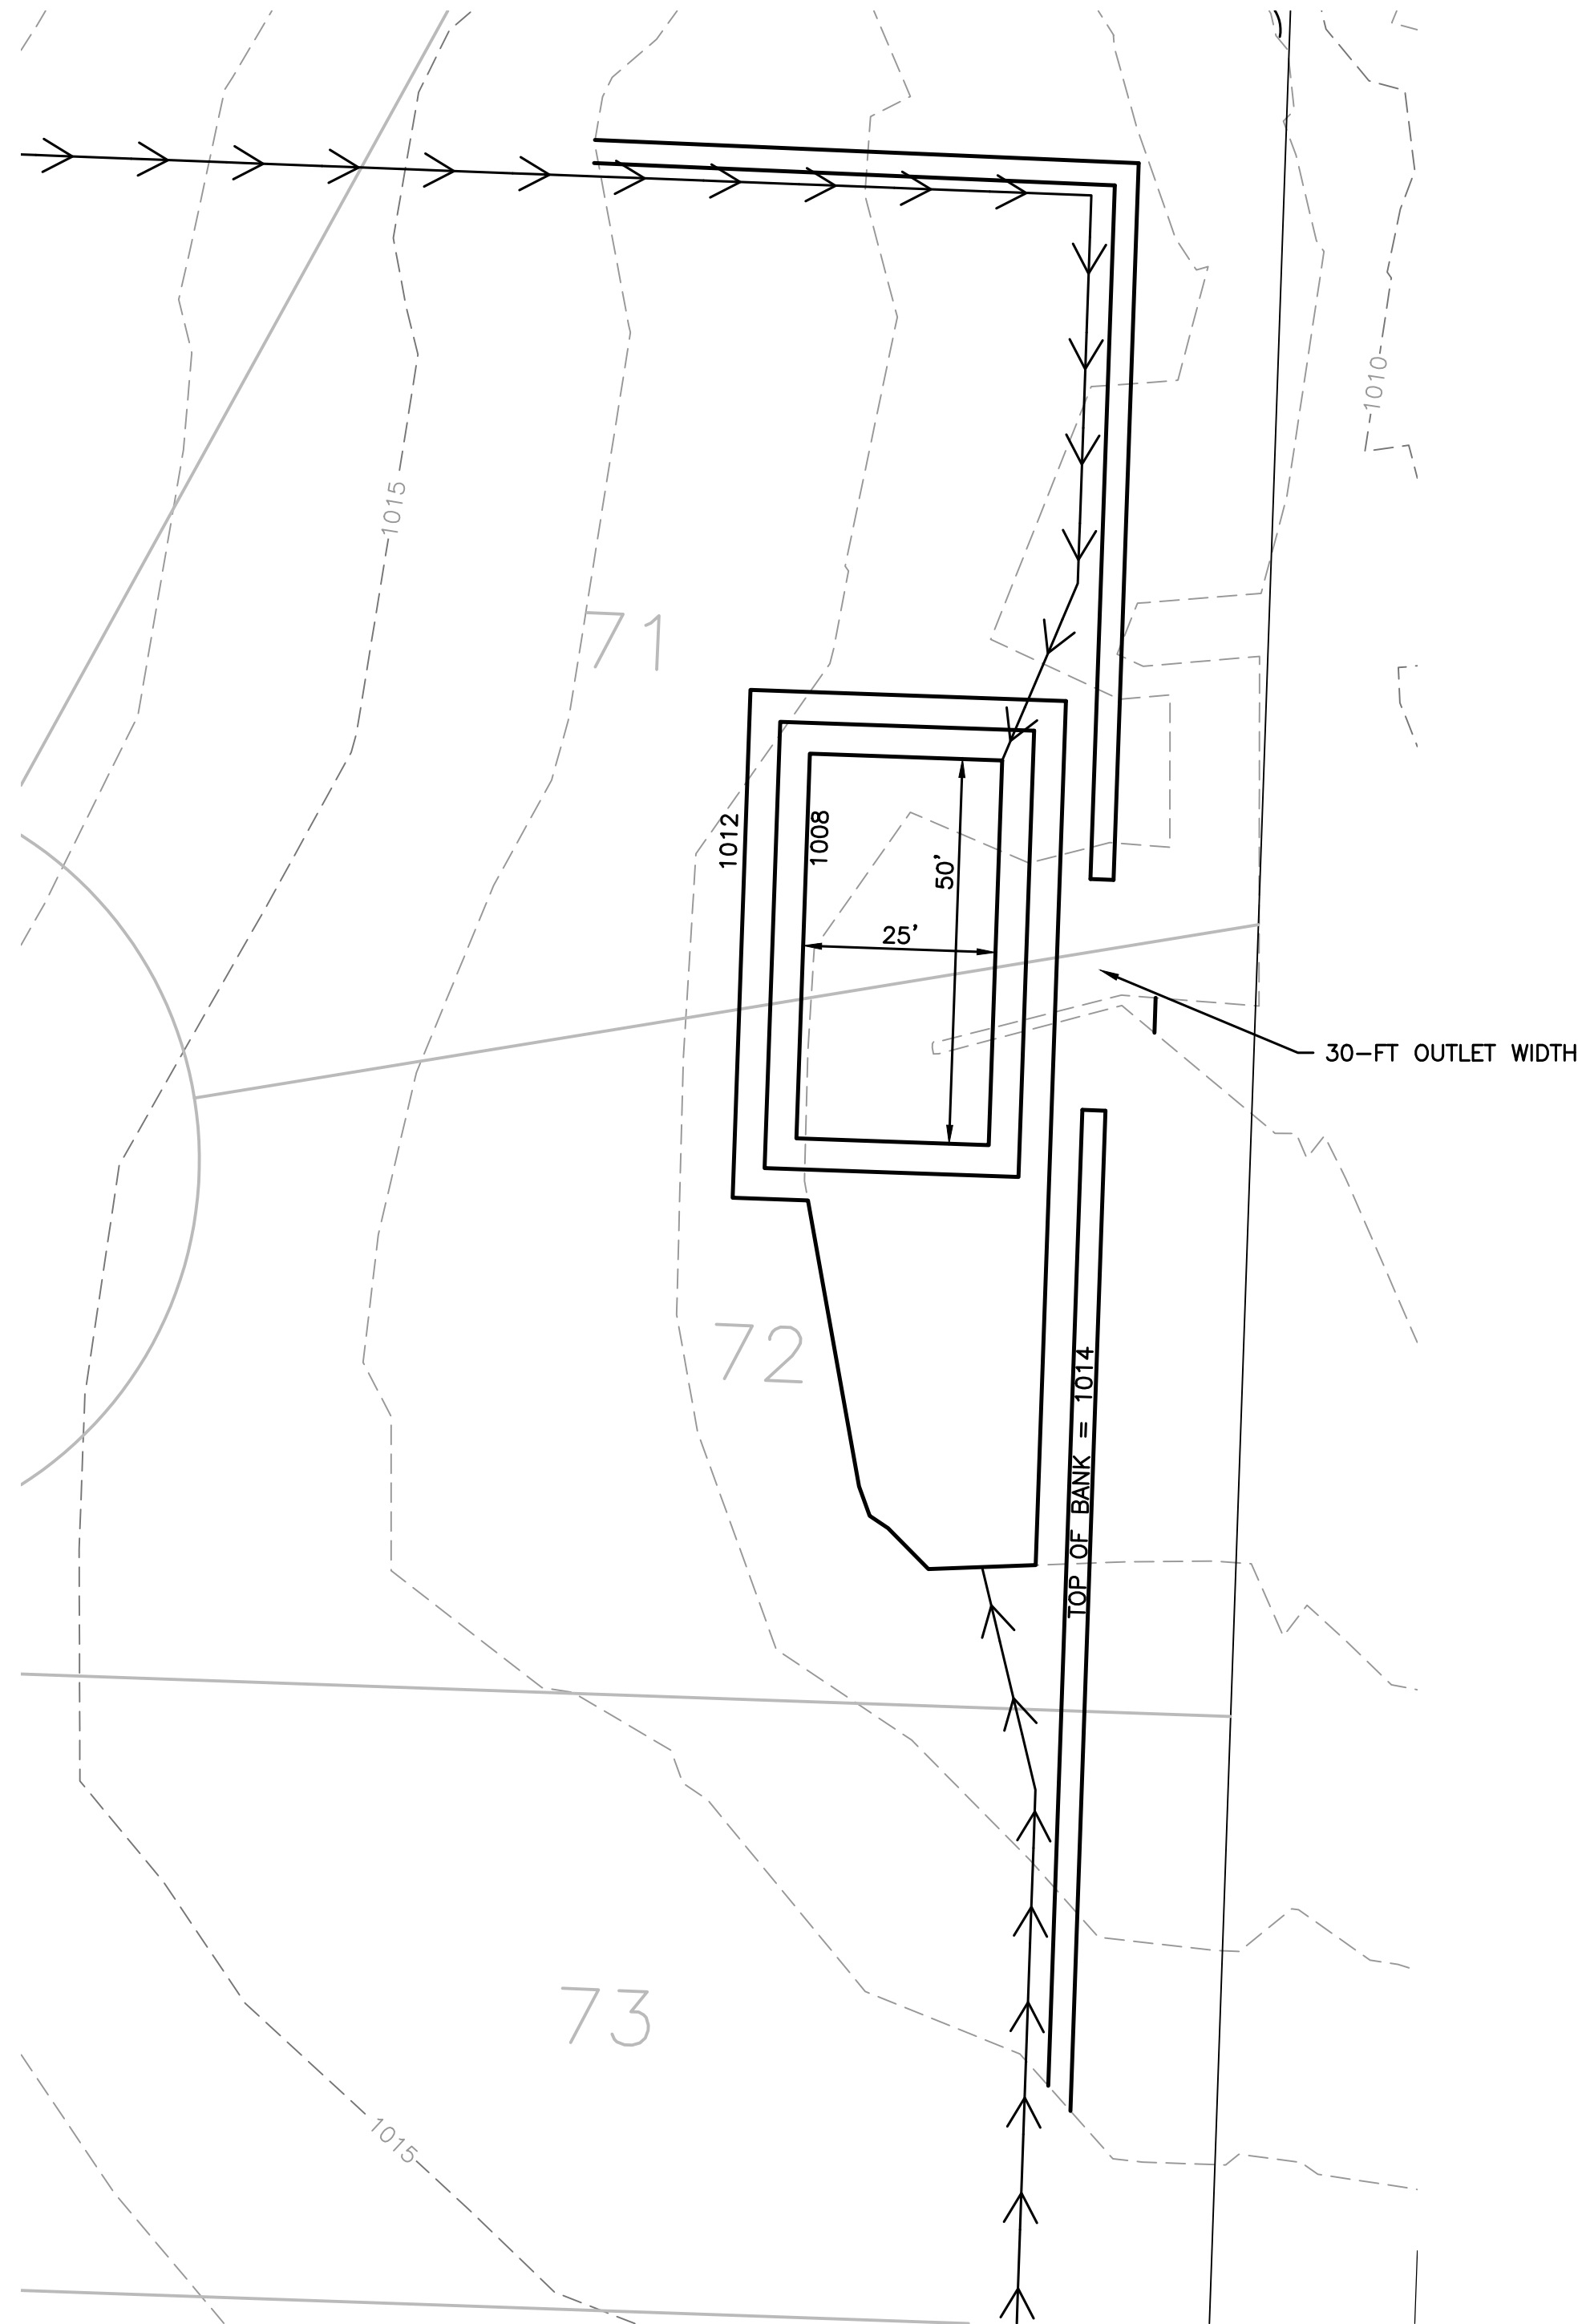


SEDIMENT TRAP #2 PLAN

TRIBUTARY DRAINAGE AREA	4.72 AC
VOLUME REQUIRED (67 CY/AC)	8,538 CF
DESIGN VOLUME PROVIDED (4-FT DEPTH)	8,983 CF
TOP OF BANK ELEVATION	1014
OUTLET WIDTH	30 Ft
TOP OF OUTLET ELEVATION	1013

GENERAL NOTES:

1. TEMPORARY SEDIMENT TRAPS HAVE BEEN DESIGNED PER KC APWA SECTION 5100 DESIGN CRITERIA.
2. REFER TO SHEET 09 FOR TYPICAL KC APWA TEMPORARY SEDIMENT TRAP CONSTRUCTION DETAIL.
3. EXISTING CONTOURS ARE SHOWN AT 1-FT INTERVALS ON THIS SHEET.

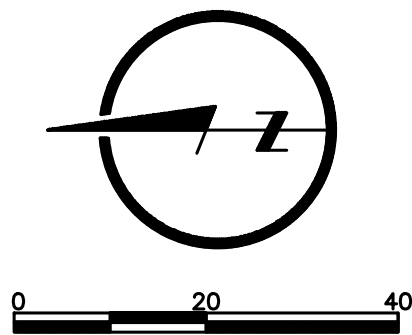

DRAWN BY
JAM

DESIGNED BY
MDM

DATE
09-19-2018

JOB NUMBER-TASKS
0316050.01

BOOK AND PAGE

REVISIONS

08/19/18 - RESUBMITAL PER ADJUSTED LAYOUT

09/19/18 - RESUBMITAL PER CITY COMMENTS

LARKIN/
LAMP RYNEARSON

9001 State Line Rd., Suite 200
Kansas City, Missouri 64114
www.LRA-INC.com

MASS GRADING, EROSION CONTROL,
PAVING, STORM AND SANITARY PLANS
TEMPORARY SEDIMENT TRAP
EROSION AND SEDIMENT CONTROL PLAN

SUMMIT VIEW FARMS 3RD PLAT
LEE'S SUMMIT, MISSOURI

LARKIN LAMP RYNEARSON - ENGINEERS
IACO Certificate of Authority No. 2013011803

STATE OF MISSOURI
MARK DANIEL MCGHEE JR.
NUMBER
PE-2008019568
PROFESSIONAL ENGINEER
09-19-2018

MARK DANIEL MCGHEE JR.
PE - 2008019568

SHEET



06 OF 31

GENERAL NOTES:

1. CONTRACTOR IS RESPONSIBLE FOR KEEPING ALL PUBLIC ROADWAYS ADJACENT TO THE CONSTRUCTION SITE FREE OF DIRT AND DEBRIS RESULTING FROM ACTIVITIES RELATED TO THE CONSTRUCTION OF THIS PROJECT.
2. DISTURBED AREAS SHALL HAVE SURFACES ROUGHENED IN ACCORDANCE WITH KCAPWA SPECIFICATIONS.
3. CONTRACTOR SHALL NOT STRIP ENTIRE PROPERTY. LOCATE STOCKPILE/STORAGE AREAS ON WEST SIDE OF THE SITE ON RIDGE. ADDITIONAL EROSION AND SEDIMENT CONTROL DEVICES SHALL BE PROVIDED AS REQUIRED SHOULD DISTURBED AREAS EXTEND BEYOND PLAN DEPICTED CONTROL MEASURES.

INACTIVE AREA STABILIZATION EROSION AND SEDIMENT CONTROL SEQUENCING:



4. GRADING: CLEAR SITE AND COMPLETE MASS GRADING.
5. IMPLEMENT STEEP SLOPE PROTECTION. DURING GRADING OPERATIONS. PLACE STEEP SLOPE PROTECTION SHOWN ON THE INACTIVE AREA STABILIZATION DRAWING AS SOON AS PRACTICABLE. THIS APPLIES TO SLOPES GREATER THAN 15%.
6. STABILIZE INACTIVE AREAS: THE GROUND COVER AND OTHER STRUCTURAL BMPs SHOWN ON THE INACTIVE AREA STABILIZATION DRAWING MUST BE PLACED WITHIN 14 DAYS OF CESSATION OF MASS GRADING AT EACH LOCATION. IN DETERMINING THE INACTIVE STATUS OF THE GROUND, EVALUATE EACH PORTION OF THE SITE SEPARATELY. THE NEED FOR SUBSEQUENT PLACEMENT OF TRENCHED UTILITIES, FUTURE BUILDING OR OTHER CONSTRUCTION IN AN OTHERWISE INACTIVE AREA IS NOT JUSTIFICATION FOR DELAY OF STABILIZATION.
7. INSTALL SITE IMPROVEMENTS: CONSTRUCT THE REMAINDER OF THE UTILITIES, ROADS, AND OTHER SITE IMPROVEMENTS DEPICTED ON THE CONSTRUCTION PLANS.

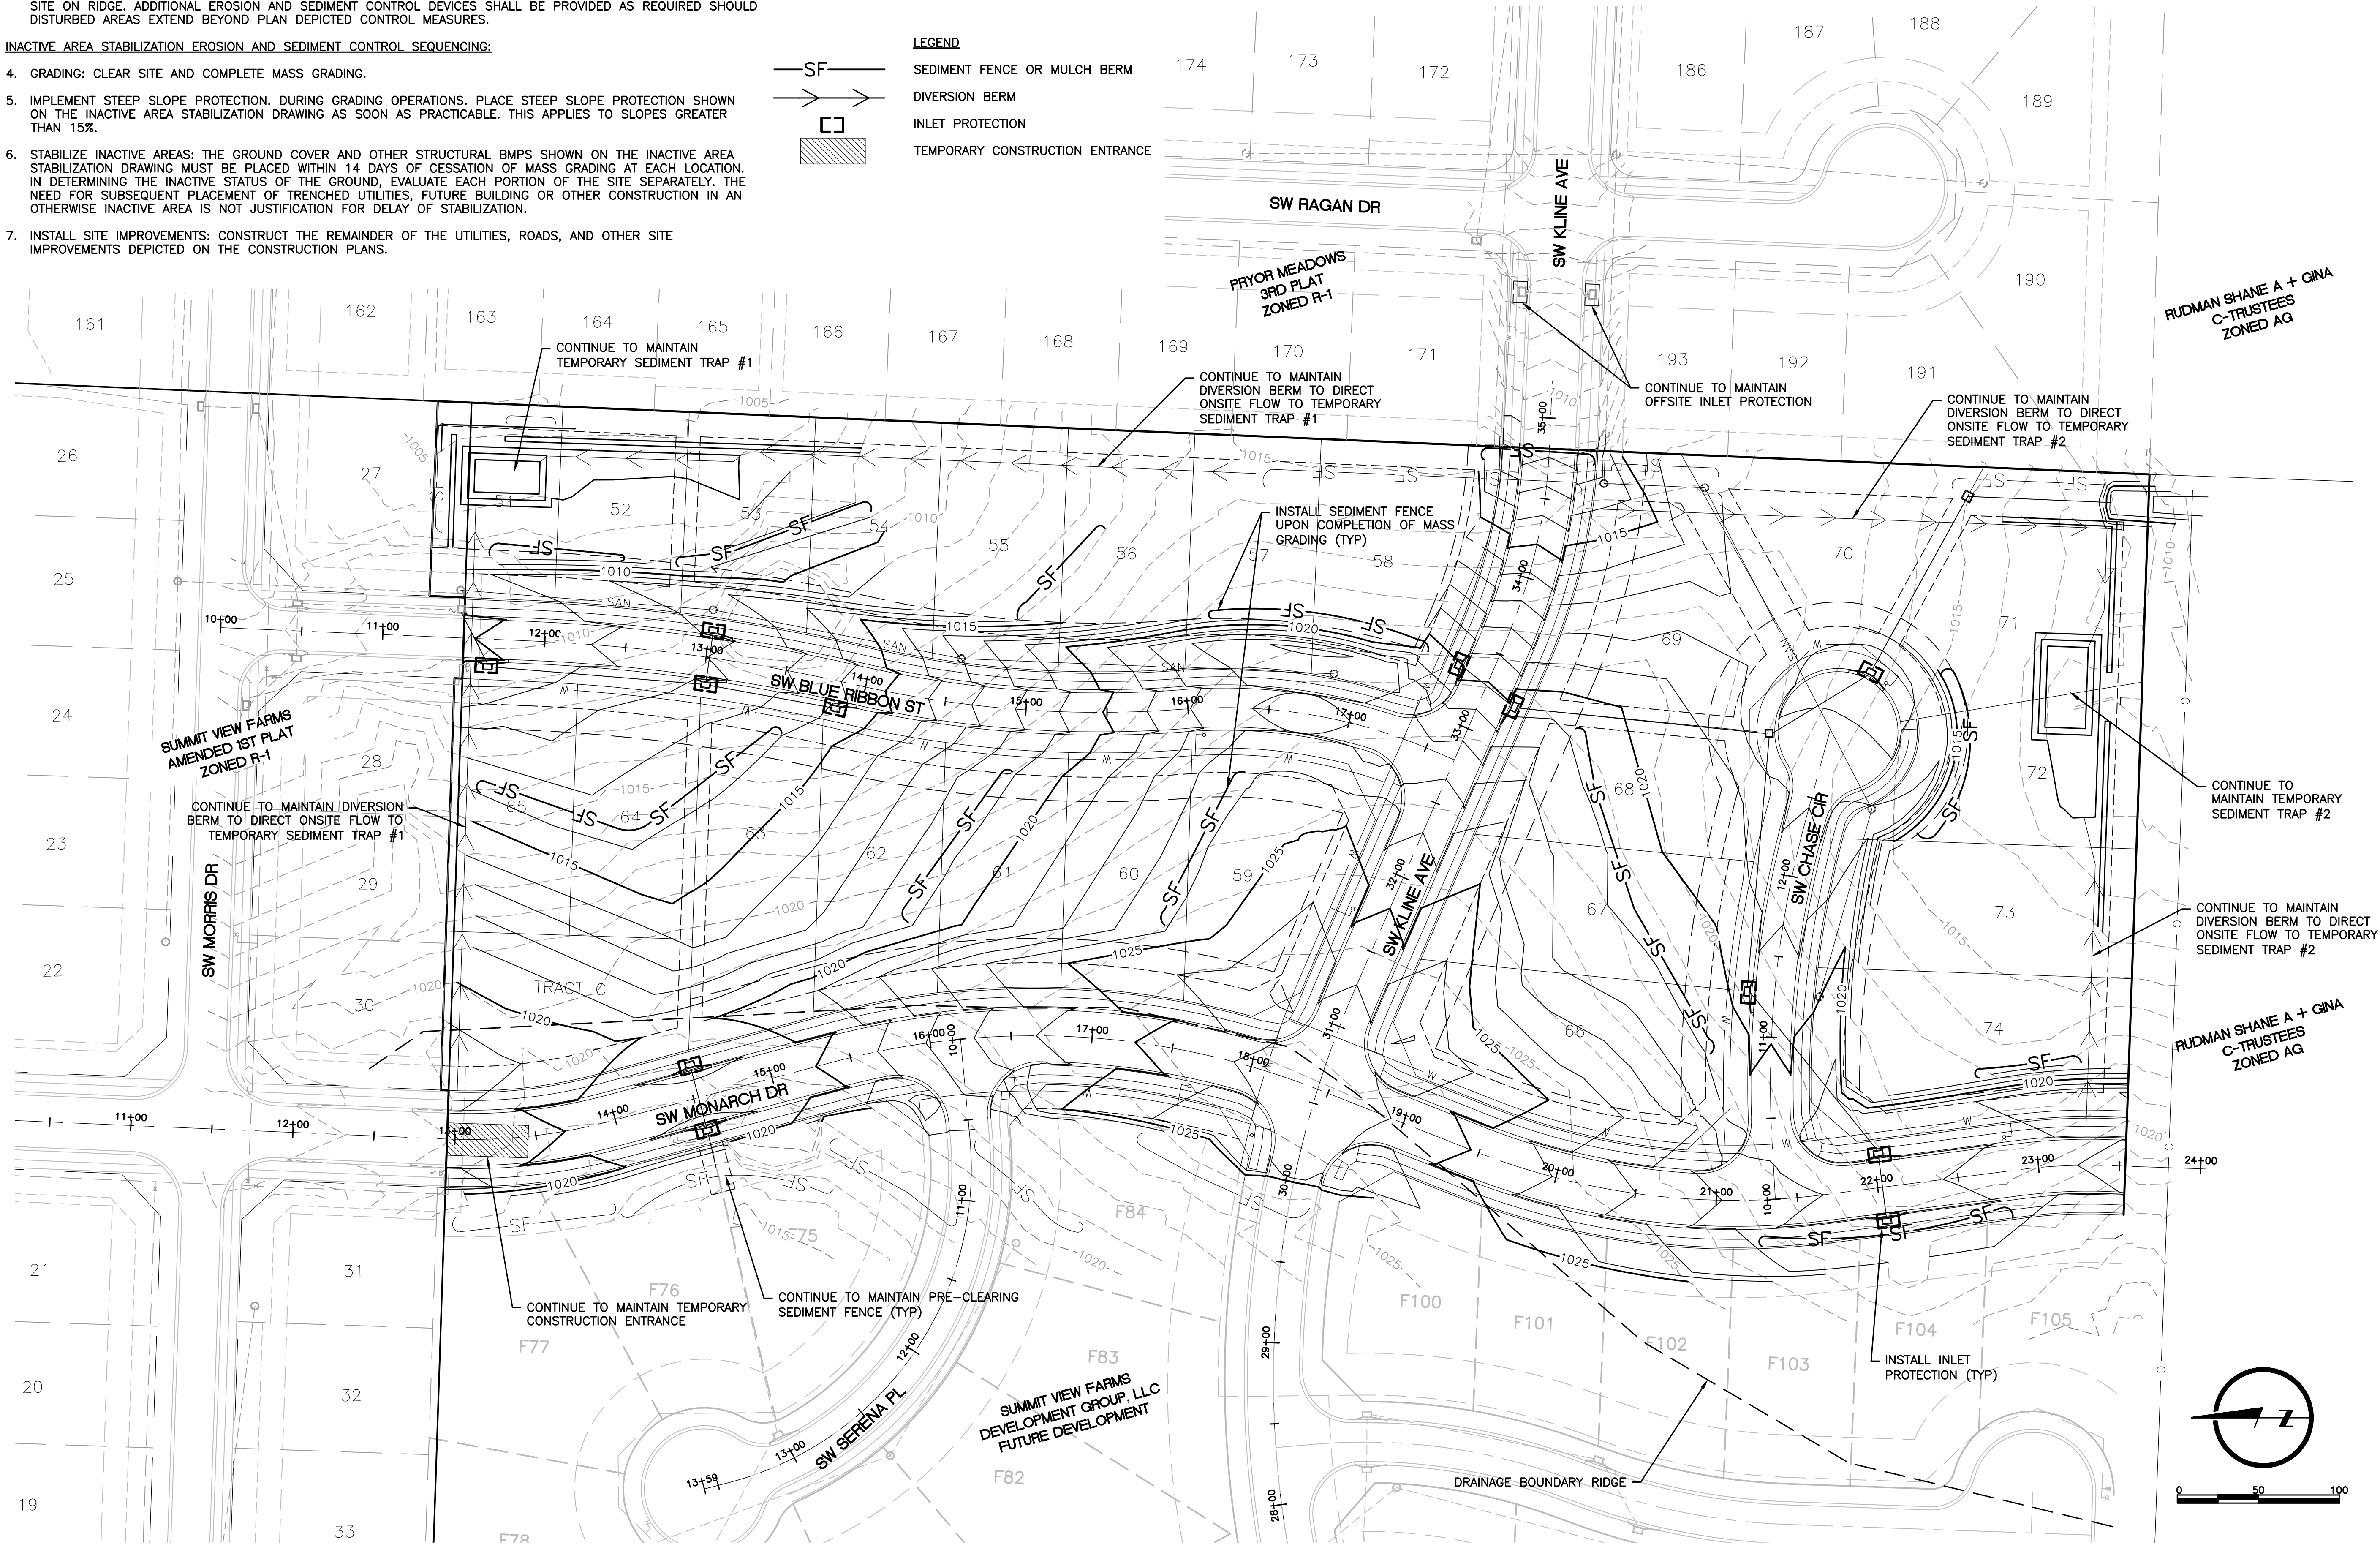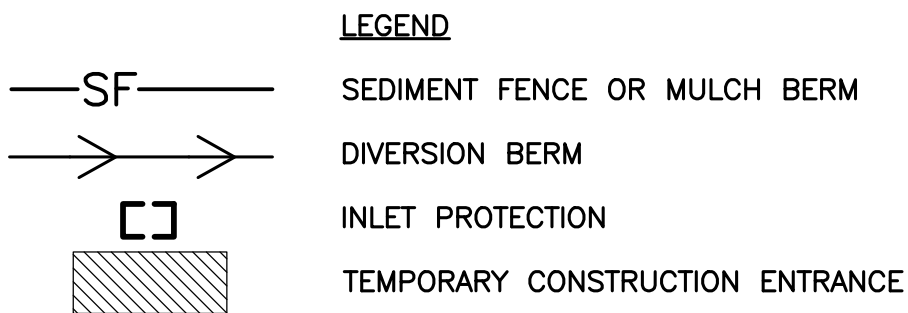

DRAWN BY JAN	DESIGNED BY MDM	DATE 09-19-2018	JOB NUMBER-TASKS 0316050.01	BOOK AND PAGE
REVISIONS				
09/19/18 - RESUBMITAL PER ADJUSTED LAYOUT				
09/19/18 - RESUBMITAL PER CITY COMMENTS				
9001 State Line Rd., Suite 200, 816.361.0440 P. Kansas City, Missouri 64114 816.361.0045 F. www.LRA-inc.com				
LARKIN/ LAMP RYNEARSON				
SUMMIT VIEW FARMS 3RD PLAT LEE'S SUMMIT, MISSOURI				
MASS GRADING, EROSION CONTROL, PAVING, STORM, AND SANITARY PLANS INACTIVE AREA EROSION AND SEDIMENT CONTROL PLAN				
LARKIN LAMP RYNEARSON - ENGINEERS TMO Certificate of Authority No. 2013011903				
STATE OF MISSOURI MARK DANIEL MCGHEE JR. REGISTERED PROFESSIONAL ENGINEER PE-2008019568 09-19-2018				
MARK DANIEL MCGHEE JR. PE - 2008019568				
SHEET				
07 OF 31				



GENERAL NOTES:

1. CONTRACTOR IS RESPONSIBLE FOR KEEPING ALL PUBLIC ROADWAYS ADJACENT TO THE CONSTRUCTION SITE FREE OF DIRT AND DEBRIS RESULTING FROM ACTIVITIES RELATED TO THE CONSTRUCTION OF THIS PROJECT.
 2. DISTURBED AREAS SHALL HAVE SURFACES ROUGHENED IN ACCORDANCE WITH KCAPWA SPECIFICATIONS.
 3. ALL DISTURBED AREAS SHALL BE SEEDED AND MULCHED, INCLUDING AREAS PREVIOUSLY OCCUPIED BY TEMPORARY EROSION CONTROL DEVICES.
- FINAL RESTORATION EROSION AND SEDIMENT CONTROL SEQUENCING:
4. IMPLEMENT FINAL STABILIZATION: COORDINATE REMOVAL OF CONSTRUCTION PHASE BMPS NECESSARY TO PLACE FINAL STABILIZATION WITH LOCAL WEATHER FORECAST SO THAT REMOVAL AND PLACEMENT MAY BE COMPLETED WITHIN A FORECAST DRY PERIOD. DOWN-SLOPE PERIMETER CONTROL SHALL NOT BE REMOVED UNTIL FINAL STABILIZATION IS PLACED AND VEGETATIVE COVER IS ESTABLISHED OVER THE REMAINDER OF THE SITE.
 5. ESTABLISHMENT AND FINAL CONSTRUCTION: ONCE THE REMAINDER OF THE SITE IS STABILIZED INCLUDING ESTABLISHMENT OF SEEDED COVER TYPES, REMOVE THE SEDIMENT CONTROLS AND THE REMAINING ACCESS CONTROLS. RESTORE AREA DISTURBED BY REMOVAL OF SEDIMENT CONTROLS.
 6. PLAN MODIFICATION: THE CONTRACTOR MUST MODIFY THE PLAN IF THE PLAN FAILS TO SUBSTANTIALLY CONTROL EROSION AND OFFSITE SEDIMENTATION. THE CONTRACTOR MAY MODIFY THE PLAN OR CONSTRUCTION SEQUENCE IF IMPLEMENTATION IS INFEASIBLE FOR SITE CONDITIONS OR CONTRACTOR METHODS.

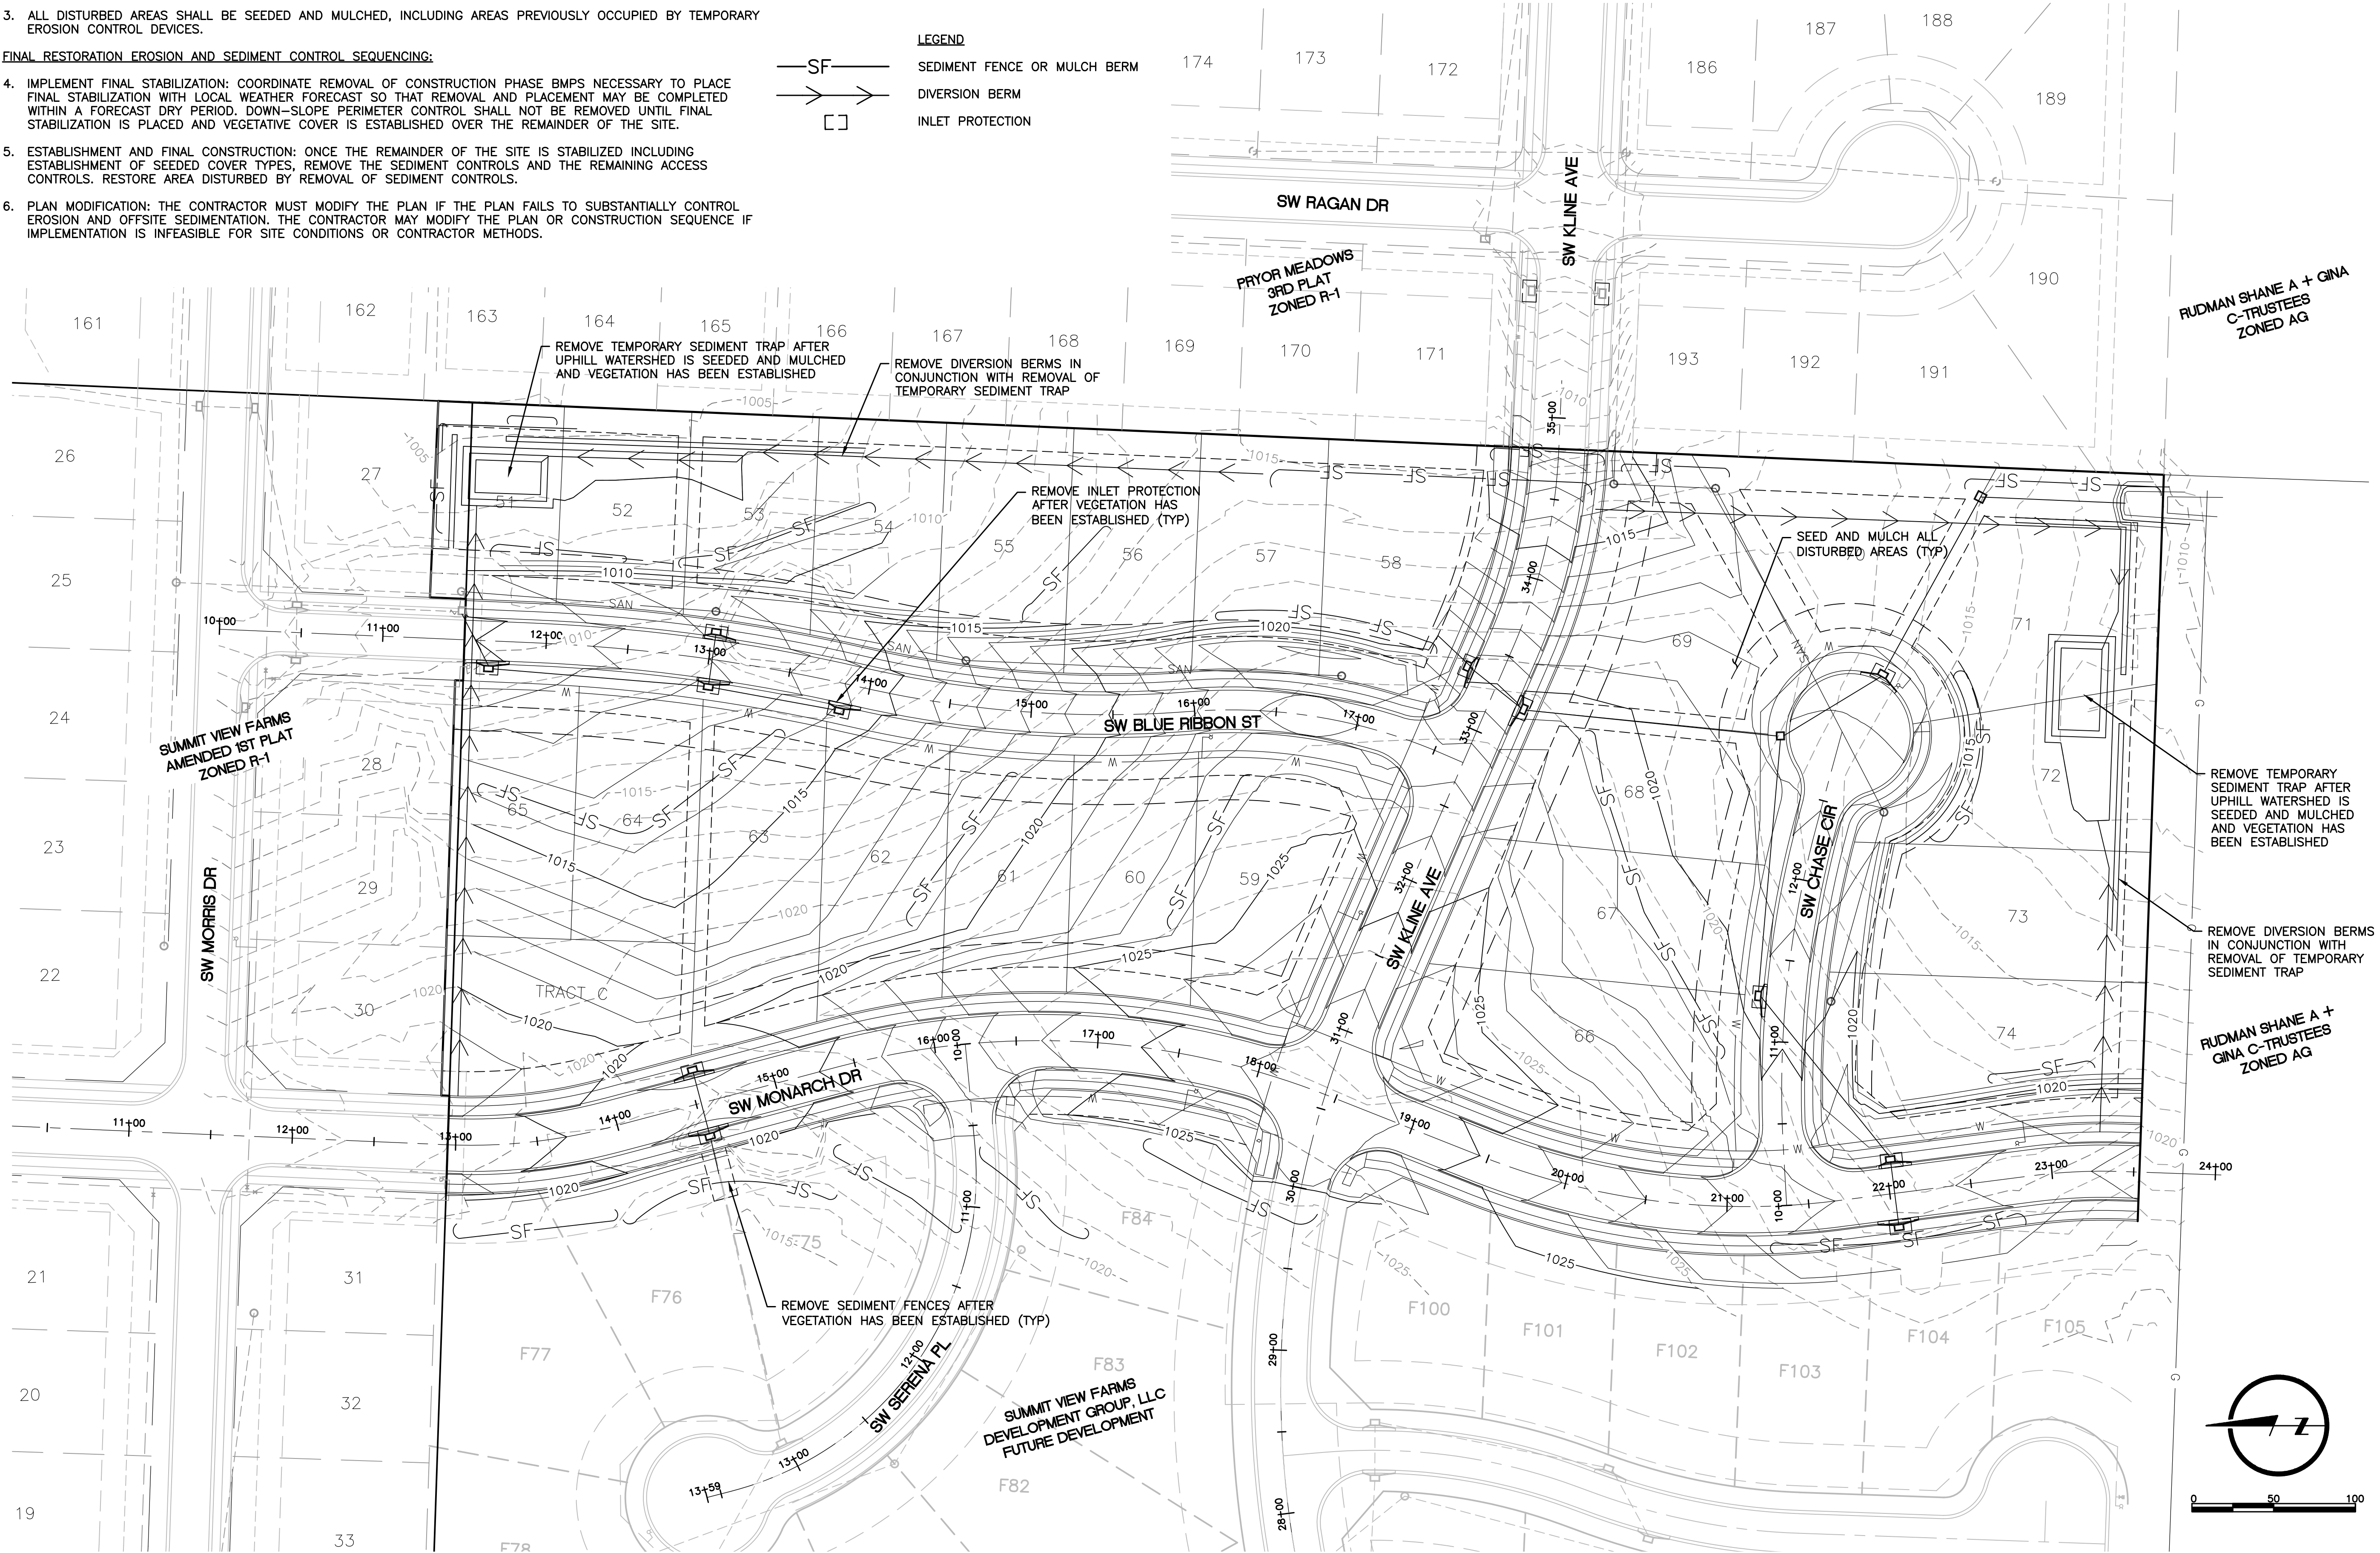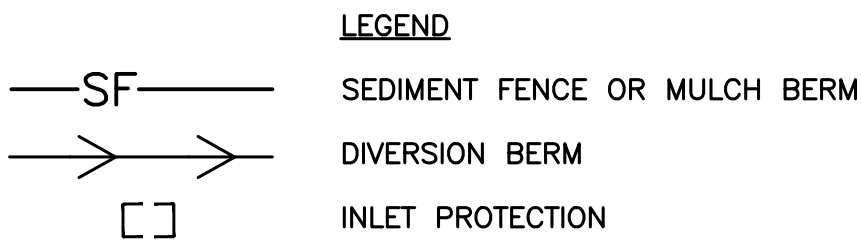

DRAWN BY JAN	DESIGNED BY MDM	DATE 09-19-2018	JOB NUMBER-TASKS 0318050.01	BOOK AND PAGE
REVISIONS				
08/19/18 - RESUBMITAL PER ADJUSTED LAYOUT				
09/19/18 - RESUBMITAL PER CITY COMMENTS				
9001 State Line Rd., Suite 200, 816.361.0440 P. Kansas City, Missouri 64114 816.361.0045 F. www.LRA-Inc.com				
LARKIN/ LAMP RYNEARSON				
SUMMIT VIEW FARMS 3RD PLAT LEE'S SUMMIT, MISSOURI				
MASS GRADING, EROSION CONTROL, PAVING, STORM AND SANITARY PLANS FINAL RESTORATION EROSION AND SEDIMENT CONTROL PLAN				
LARKIN LAMP RYNEARSON - ENGINEERS TMO Certificate of Authority No. 2013011903				
MARK DANIEL MCGHEE JR. PE - 2008019568				
SHEET				
08 OF 31				


L:\Engineering\0318050 SVFDG Summit View Farms 3rd Plat\DRAWINGS\CONSTRUCTION DRAWINGS\ORD-ERC-PLANS\0318050-MG-ESC-DET.dwg, 3/19/2018 8:22:41 AM, JAMIE MCNURY, LAMP RYNEARSON & ASSOCIATES

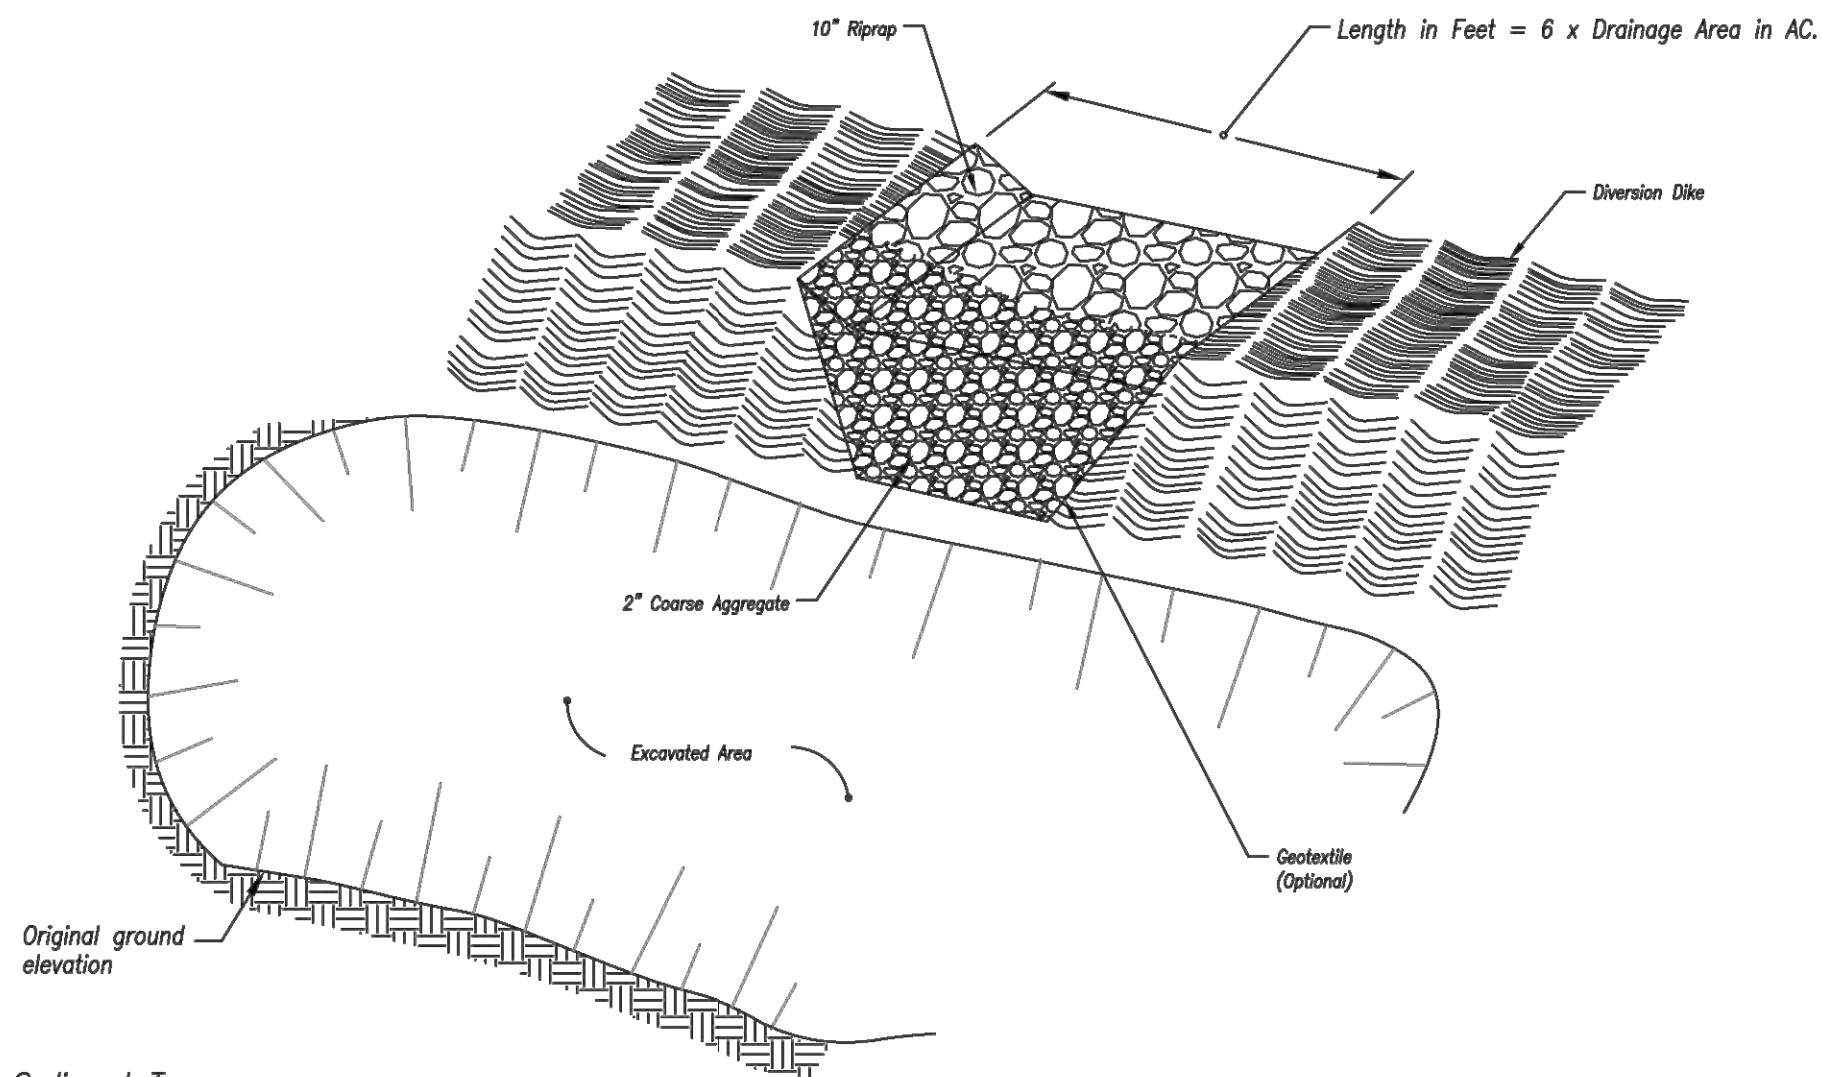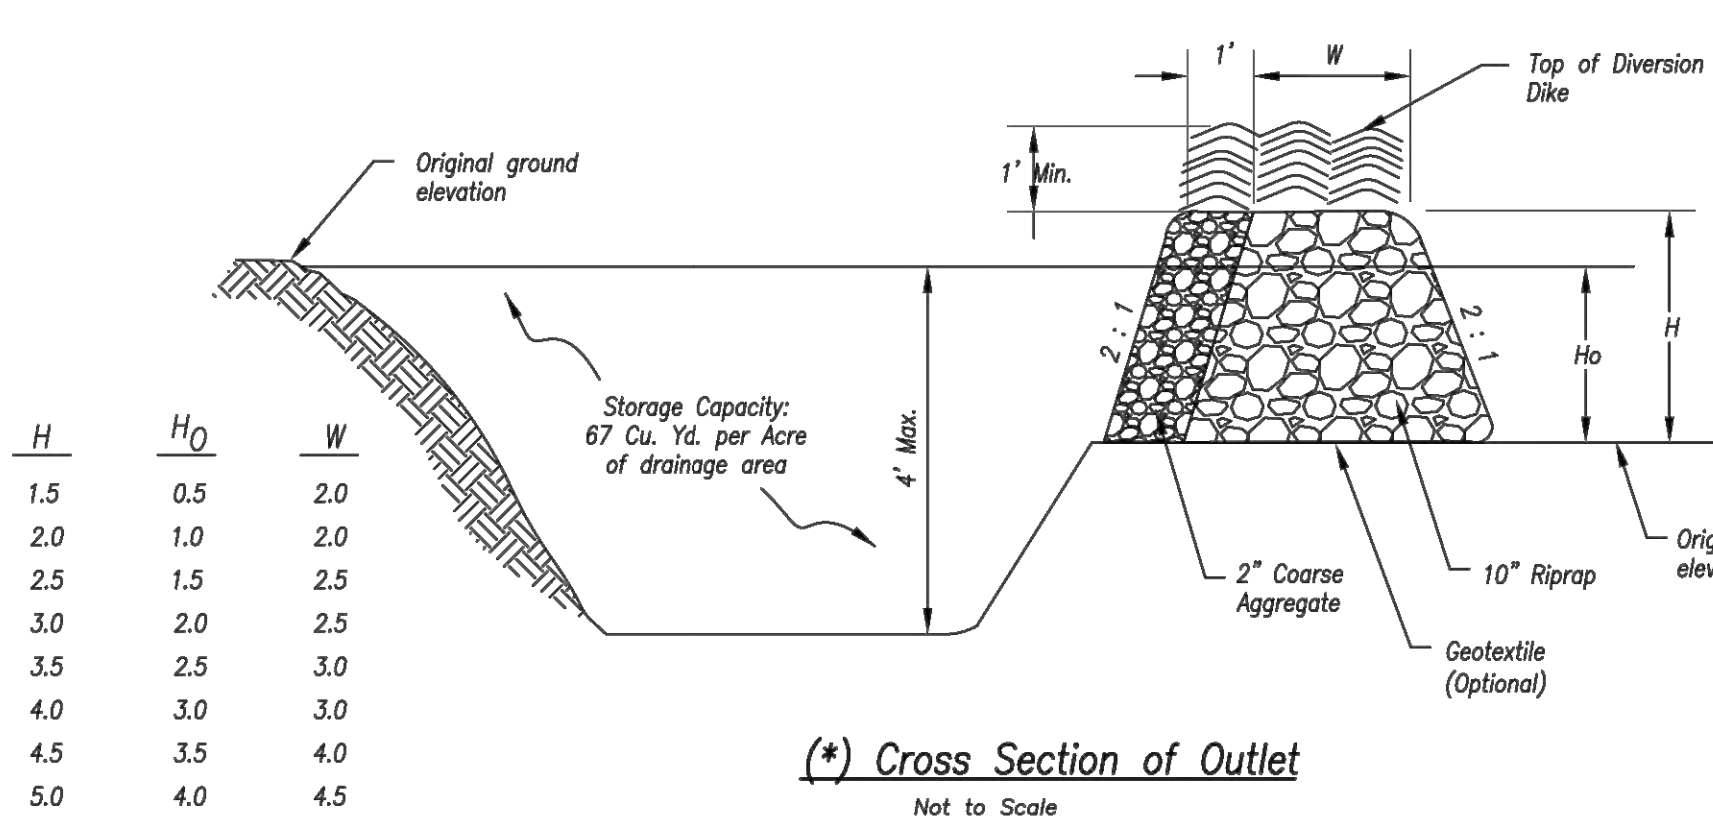

Notes for Sediment Trap:

1. The area under the embankment shall be cleared, grubbed, and stripped of any vegetation and root mat.
2. Fill material for the embankment shall be free of roots or other woody vegetation, organic material, large stones, and other objectionable material. The embankment should be compacted in 6-inch layers by traversing with construction equipment.
3. The earthen embankment shall be stabilized immediately after installation.
4. Construction operations shall be carried out to minimize erosion and water pollution.
5. The structure shall be removed and the area stabilized when the upslope drainage area has been stabilized.
6. All cut and fill slopes shall be 2H : 1V or flatter, except for excavated, wet storage areas which may be at a maximum 1H : 1V grade.

SEDIMENT TRAP

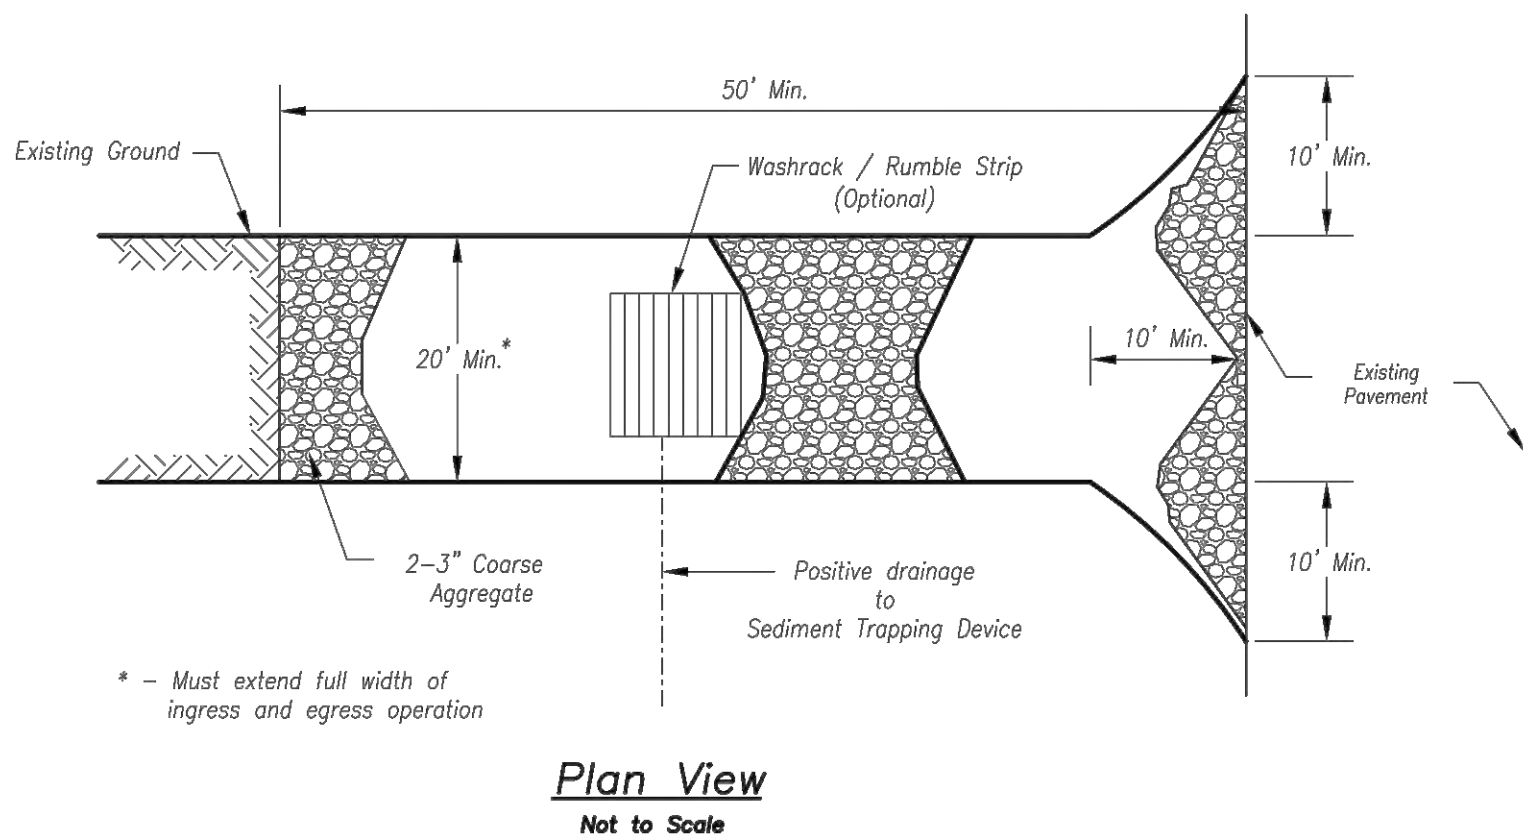

(*) Perspective View of Outlet

(*) - The perspective view and cross section are schematic in nature. Construction plans must provide specific site construction arrangements.

Maintenance for Sediment Trap:


1. Check sediment traps after periods of significant runoff.
2. Remove sediment and restore the trap to its original dimensions when sediment accumulates to 20% of the storage capacity.
3. Immediately repair any erosion damage to the embankment and outlet.
4. Keep outlet and pool area free of all trash and other debris.

CONSTRUCTION ENTRANCE

Notes for Sediment Trap at Culvert Opening:

1. The inlet protection device shall be constructed in a manner that will facilitate clean-out and disposal of trapped sediment and minimize interference with construction activities.
2. The inlet protection devices shall be constructed in such manner that any resultant ponding stormwater will not cause excessive inconvenience or damage to adjacent areas or structures.
3. Geometry of the design will be a horseshoe shape around the culvert inlet.
4. The toe of the riprap shall be no closer than 24" from the culvert opening to provide an acceptable emergency outlet for flows from larger storm events.
5. Storage requirements equivalent to that of temporary sediment trap.
6. 67 C.Y./Acre wet storage below base of stone.
7. 67 C.Y./Acre dry storage from base of stone to top of stone berm.

SEDIMENT TRAP AT CULVERT OPENING

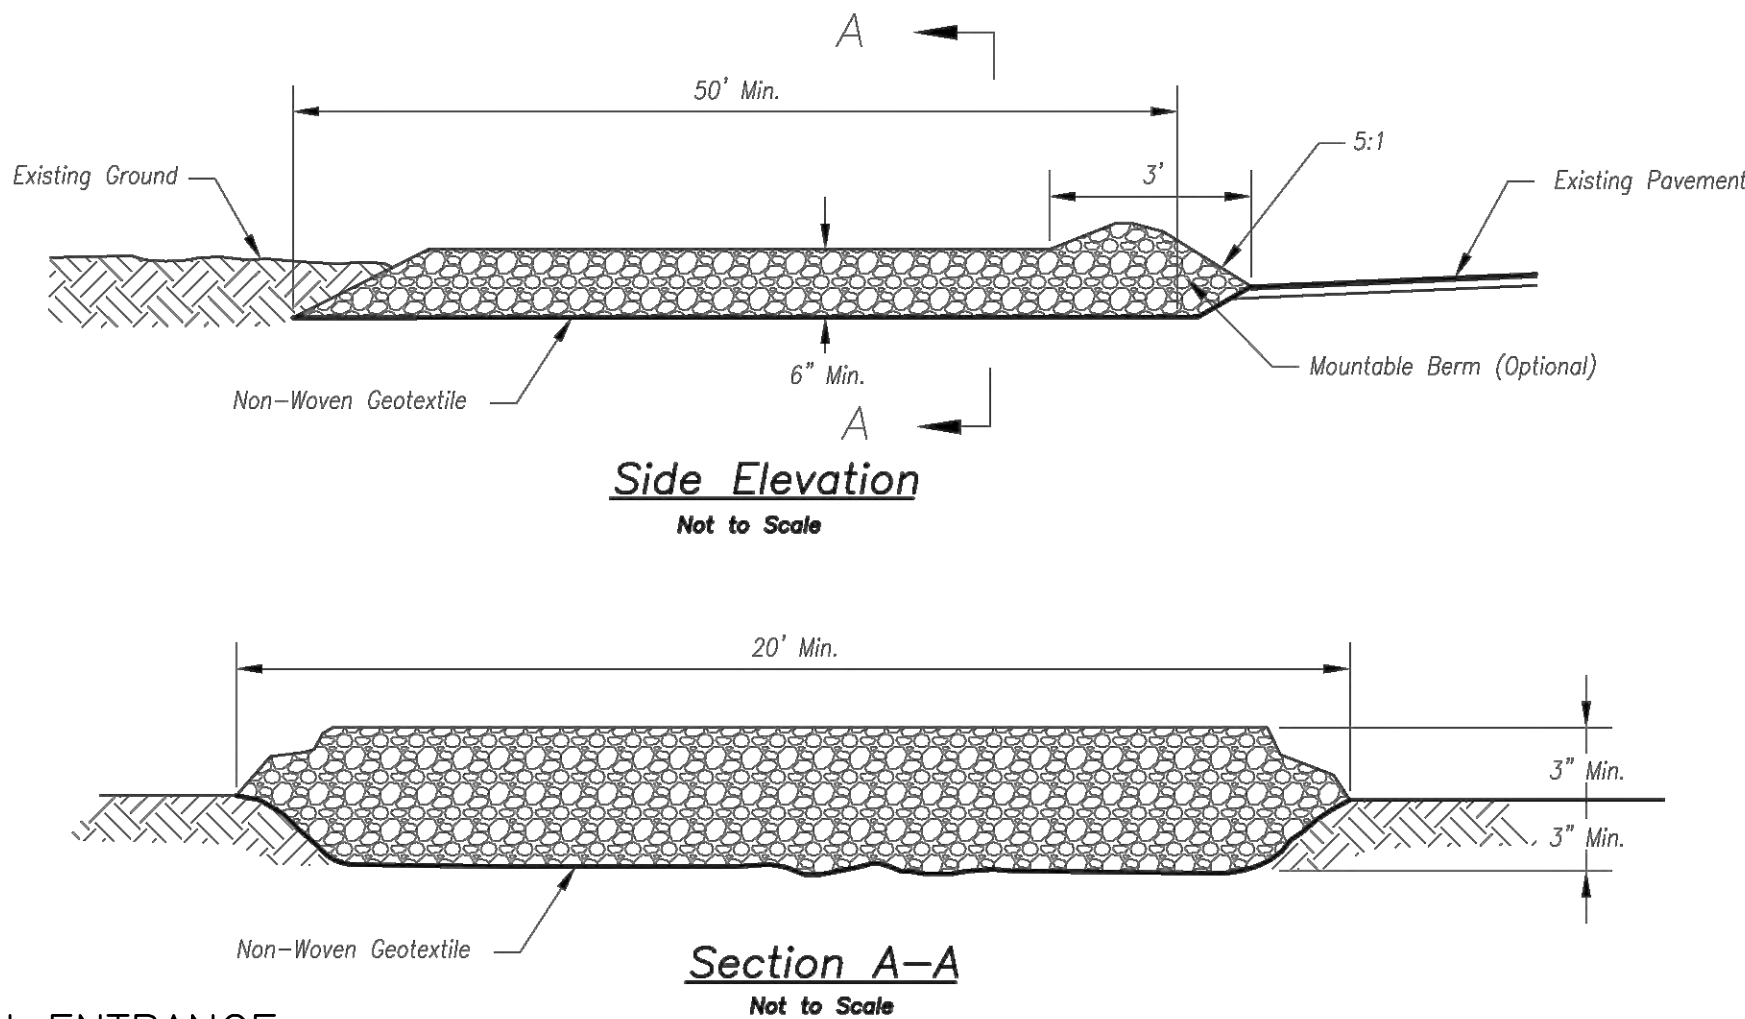

Plan View

Not to Scale

Maintenance for Sediment Trap at Culvert Opening:

1. Check sediment traps after periods of significant runoff.
2. Remove sediment and restore the trap to its original dimensions when sediment accumulates to 20% of the storage capacity.
3. Immediately repair any erosion damage to the embankment and outlet.
4. Keep outlet and pool area free of all trash and other debris.

Notes for Construction Entrance:

1. Avoid locating on steep slopes, at curves on public roads, or downhill of disturbed area.
2. Remove all vegetation and other unsuitable material from the foundation area, grade, and crown for positive drainage.
3. If slope towards the public road exceeds 2%, construct a 6- to 8-inch high ridge with 3H:1V side slopes across the foundation approximately 15 feet from the edge of the public road to divert runoff from it.
4. Install pipe under the entrance if needed to maintain drainage ditches along public roads.
5. Place stone to dimensions and grade as shown on plans. Leave surface sloped for drainage.
6. Divert all surface runoff and drainage from the entrance to a sediment control device.
7. If conditions warrant, place geotextile fabric on the graded foundation to improve stability.

Maintenance for Construction Entrance:


1. Reshape entrance as needed to maintain function and integrity of installation. Top dress with clean aggregate as needed.

Notes for Concrete Washout:

1. Concrete washout areas shall be installed prior to any concrete placement on site.
2. Concrete washout area shall include a flat subsurface pit sized relative to the amount of concrete to be placed on site. The slopes leading out of the subsurface pit shall be 3:1. The vehicle tracking pad shall be sloped towards the concrete washout area.
3. Vehicle tracking control is required at the access point to all concrete washout areas.
4. Signs shall be placed at the construction site entrance, washout area and elsewhere as necessary to clearly indicate the location(s) of the concrete washout area(s) to operators of concrete truck and pump rigs.
5. A one-piece impervious liner may be required along the bottom and sides of the subsurface pit in sandy or gravelly soils.

Maintenance for Concrete Washout:

1. Concrete washout materials shall be removed once the materials have filled the washout to approximately 75% full.
2. Concrete washout areas shall be enlarged as necessary to maintain capacity for wasted concrete.
3. Concrete washout water, wasted pieces of concrete and all other debris in the subsurface pit shall be transported from the job site in a water-tight container and disposed of properly.
4. Concrete washout areas shall remain in place until all concrete for the project is placed.
5. When concrete washout areas are removed, excavations shall be filled with suitable compacted backfill and topsoil, any disturbed areas associated with the installation, maintenance, and/or removal of the concrete washout areas shall be stabilized.

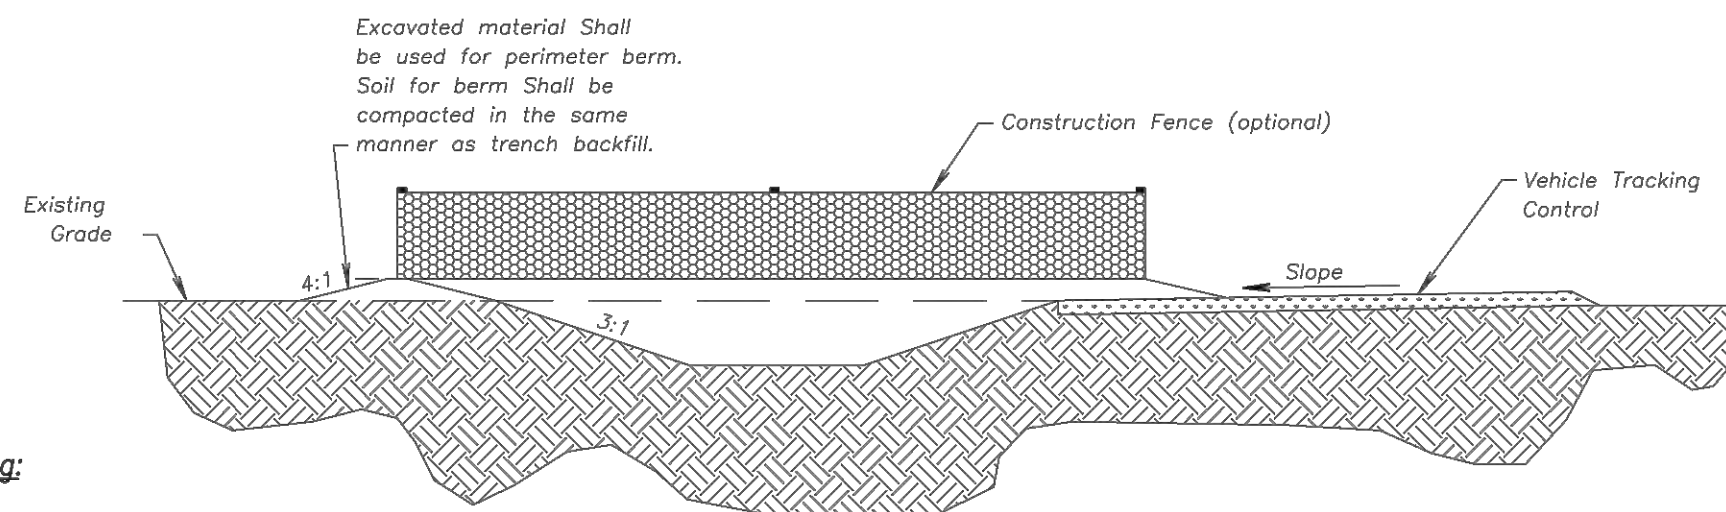

AMERICAN PUBLIC WORKS ASSOCIATION



KANSAS CITY
METRO CHAPTER

SEDIMENT TRAPS

CONSTRUCTION ENTRANCE
AND CONCRETE WASHOUT

STANDARD DRAWING
NUMBER ESC-08
ADOPTED:
10/24/2016
STANDARD DRAWING
NUMBER ESC-01
ADOPTED:
10/24/2016

MASS GRADING, EROSION CONTROL,
PAVING, STORM AND SANITARY PLANS

EROSION CONTROL DETAILS

LARKIN RYNEARSON - ENGINEERS
Two Certificate of Authority No. 2013011593



09-19-2018

MARK DANIEL MCGHEE JR.
PE - 2008019568

SHEET

09 OF 31

LARKIN/
LAMP RYNEARSON

SUMMIT VIEW FARMS 3RD PLAT
LEE'S SUMMIT, MISSOURI


9001 State Line Rd., Suite 200
Kansas City, Missouri 64114
www.LRA-inc.com

PERSONS

09/10/18 - RESUBMITAL PER ADJUSTED LAYOUT
09/19/18 - RESUBMITAL PER CITY COMMENTS

DRAWN BY: JAM
DESIGNED BY: NDM
DATE: 09-19-2018
JOB NUMBER-TASKS: 0318050.01
BOOK AND PAGE:

L:\Engineering\0318050 SVFDG Summit View Farms 3rd Plat\DRAWINGS\CONSTRUCTION DRAWINGS\ORD-ERC-PLANS\0318050-ING-ESC-BET.dwg, 3/19/2018 8:24:25 AM, JAMIE MCNURY, LAMP RYNEARSON & ASSOCIATES

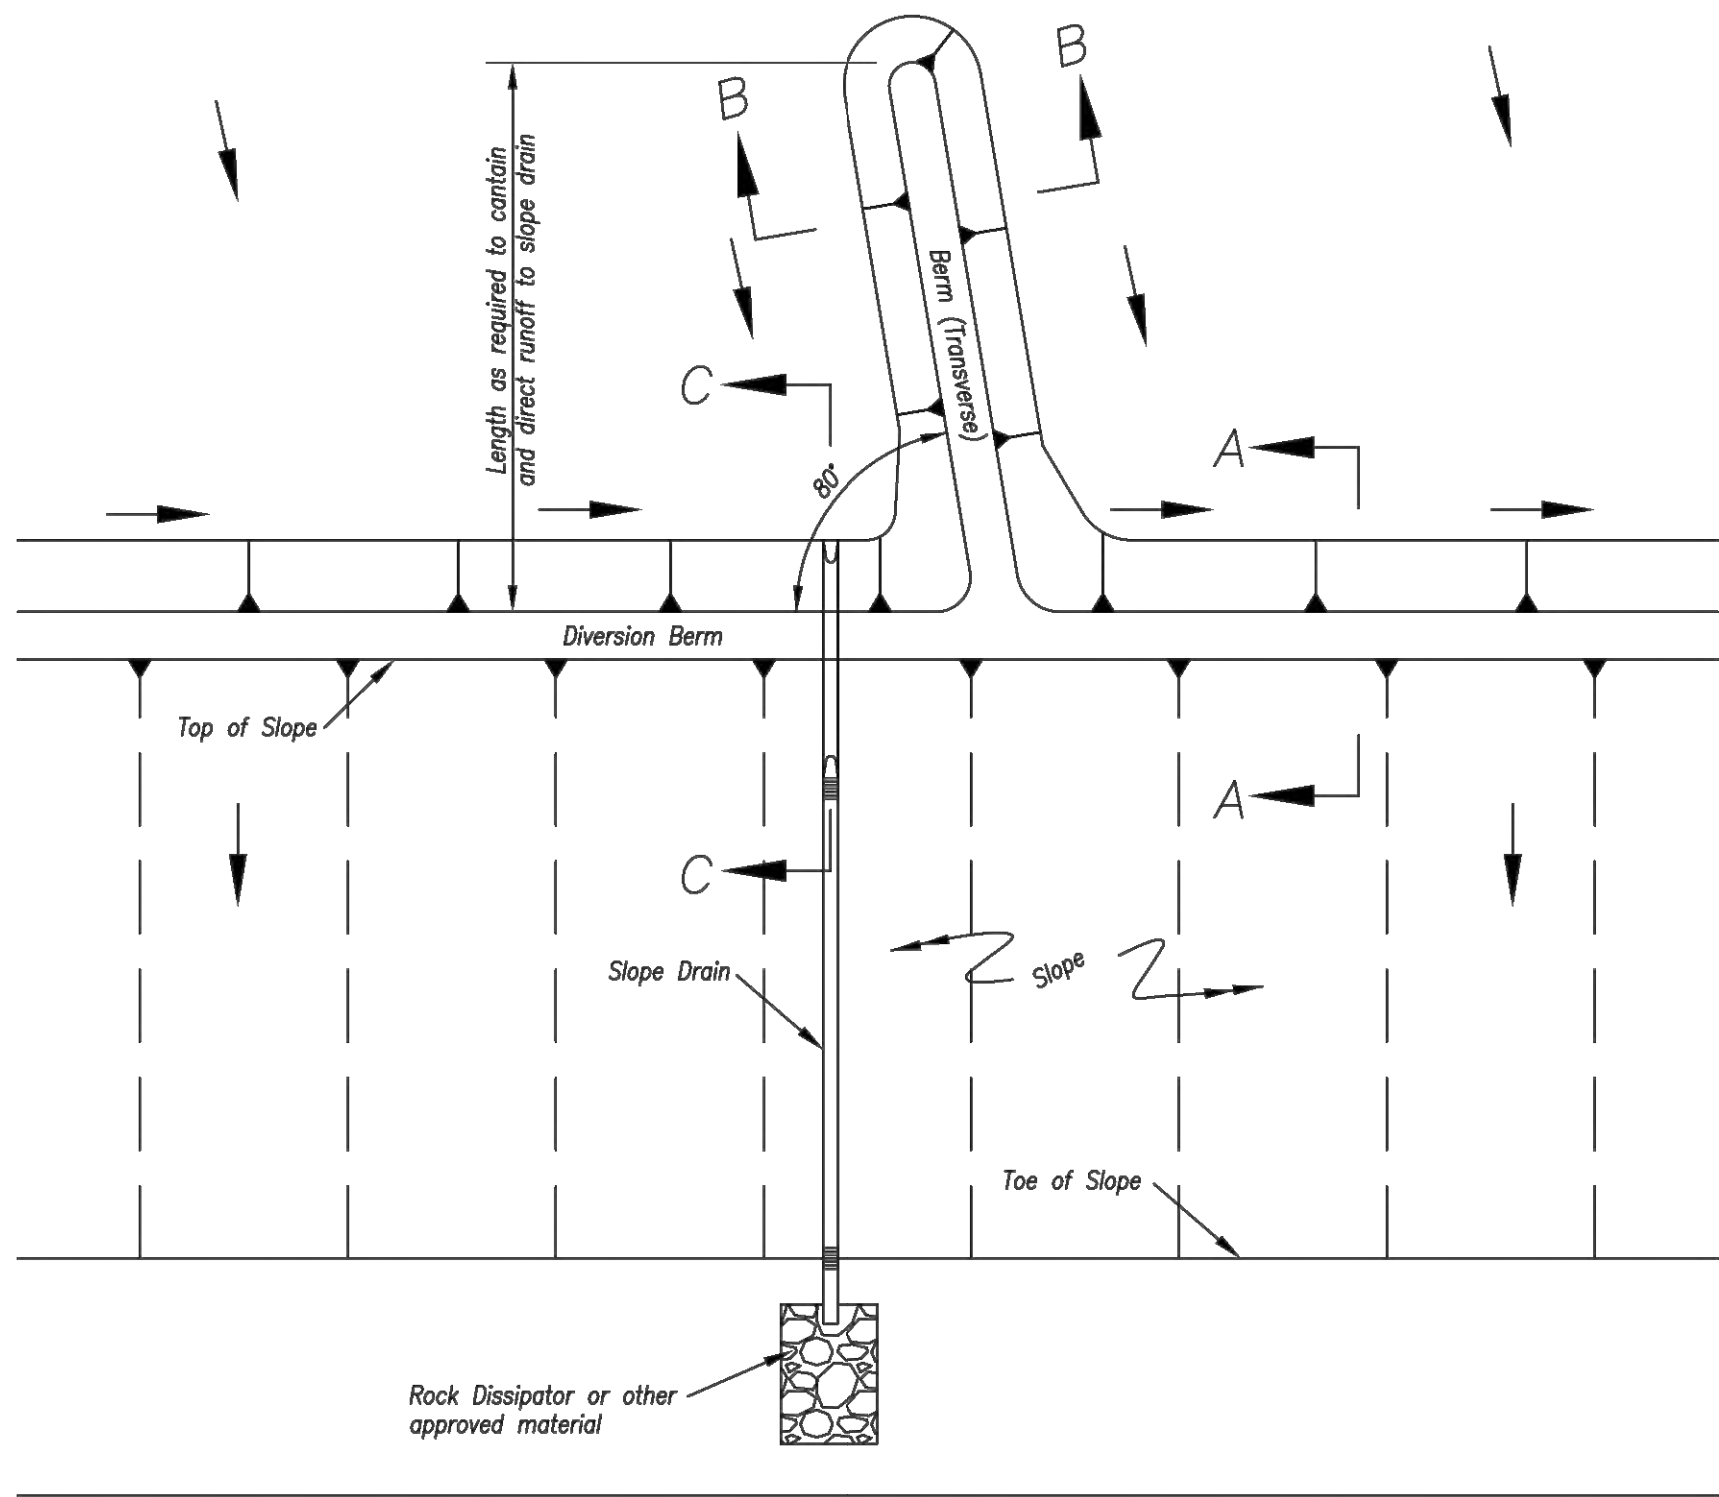

TYPICAL PLAN VIEW OF DIVERSION BERM AND SLOPE DRAIN

Notes for Diversion Berm:

1. Slope drains are optional, but may be required by the engineer if the berm is at the top of a steep slope.
2. Diversion berms must be installed as a first step in the land-disturbing activity and must be functional prior to upslope land disturbance.
3. The berm should be adequately compacted to prevent failure.
4. Temporary or permanent seeding and mulch shall be applied to the berm immediately following its construction.
5. Place the berm so to minimize damages by construction operations and traffic.
6. The berm must discharge to a temporary sediment trap or stabilized area.
7. All trees, brush, stumps, obstructions and other objectionable material shall be removed and disposed of so as not to interfere with the proper functioning of diversion.
8. The diversion shall be excavated or shaped to line, grade and cross-section as required to meet the criteria specified herein, free of irregularities which will impede flow.
9. Fills shall be compacted as needed to prevent unequal settlement that would cause damage in the completed diversion. Fill shall be composed of soil which is free from excessive organic debris, rocks or other objectionable materials.

Maintenance:



1. Berm shall be reshaped, compacted, and stabilized as necessary to maintain its function.
2. Breaches in the berm shall be repaired immediately.

Notes for Slope Drain:


1. Slope Drain and Diversion Berm may be used on either project foreslopes or project backslopes.
2. Discharge of Slope Drains shall be into stabilized ditch or area, or into Sediment Basin.
3. Pipe shall be secured in place as approved by Engineer.

Maintenance:

1. Accumulation of any visible sediment at the inlet and outlet shall be removed promptly.
2. Outlet conditions shall be repaired if scour is observed. Leaking or damaged section of pipe shall be repaired immediately.
3. Barriers directing water to the inlet shall be monitored for continuity and effectiveness.

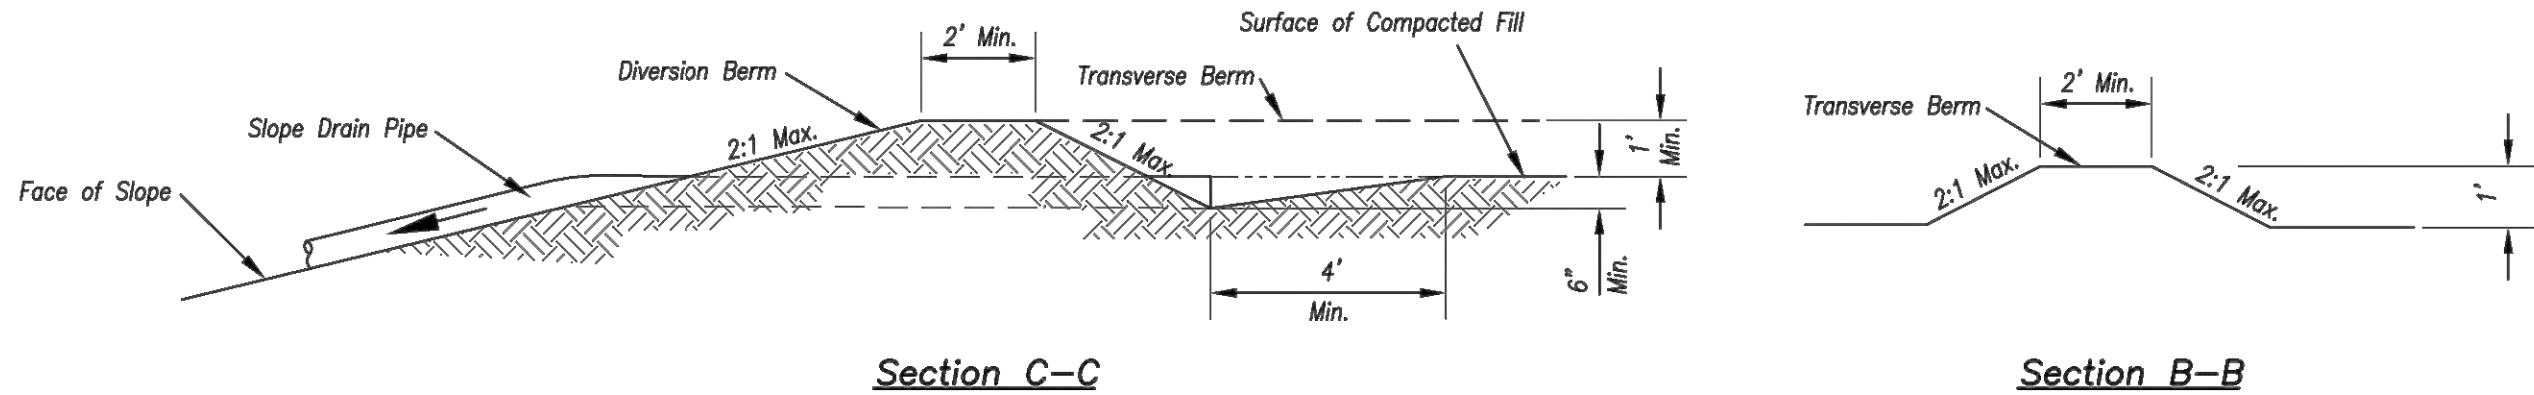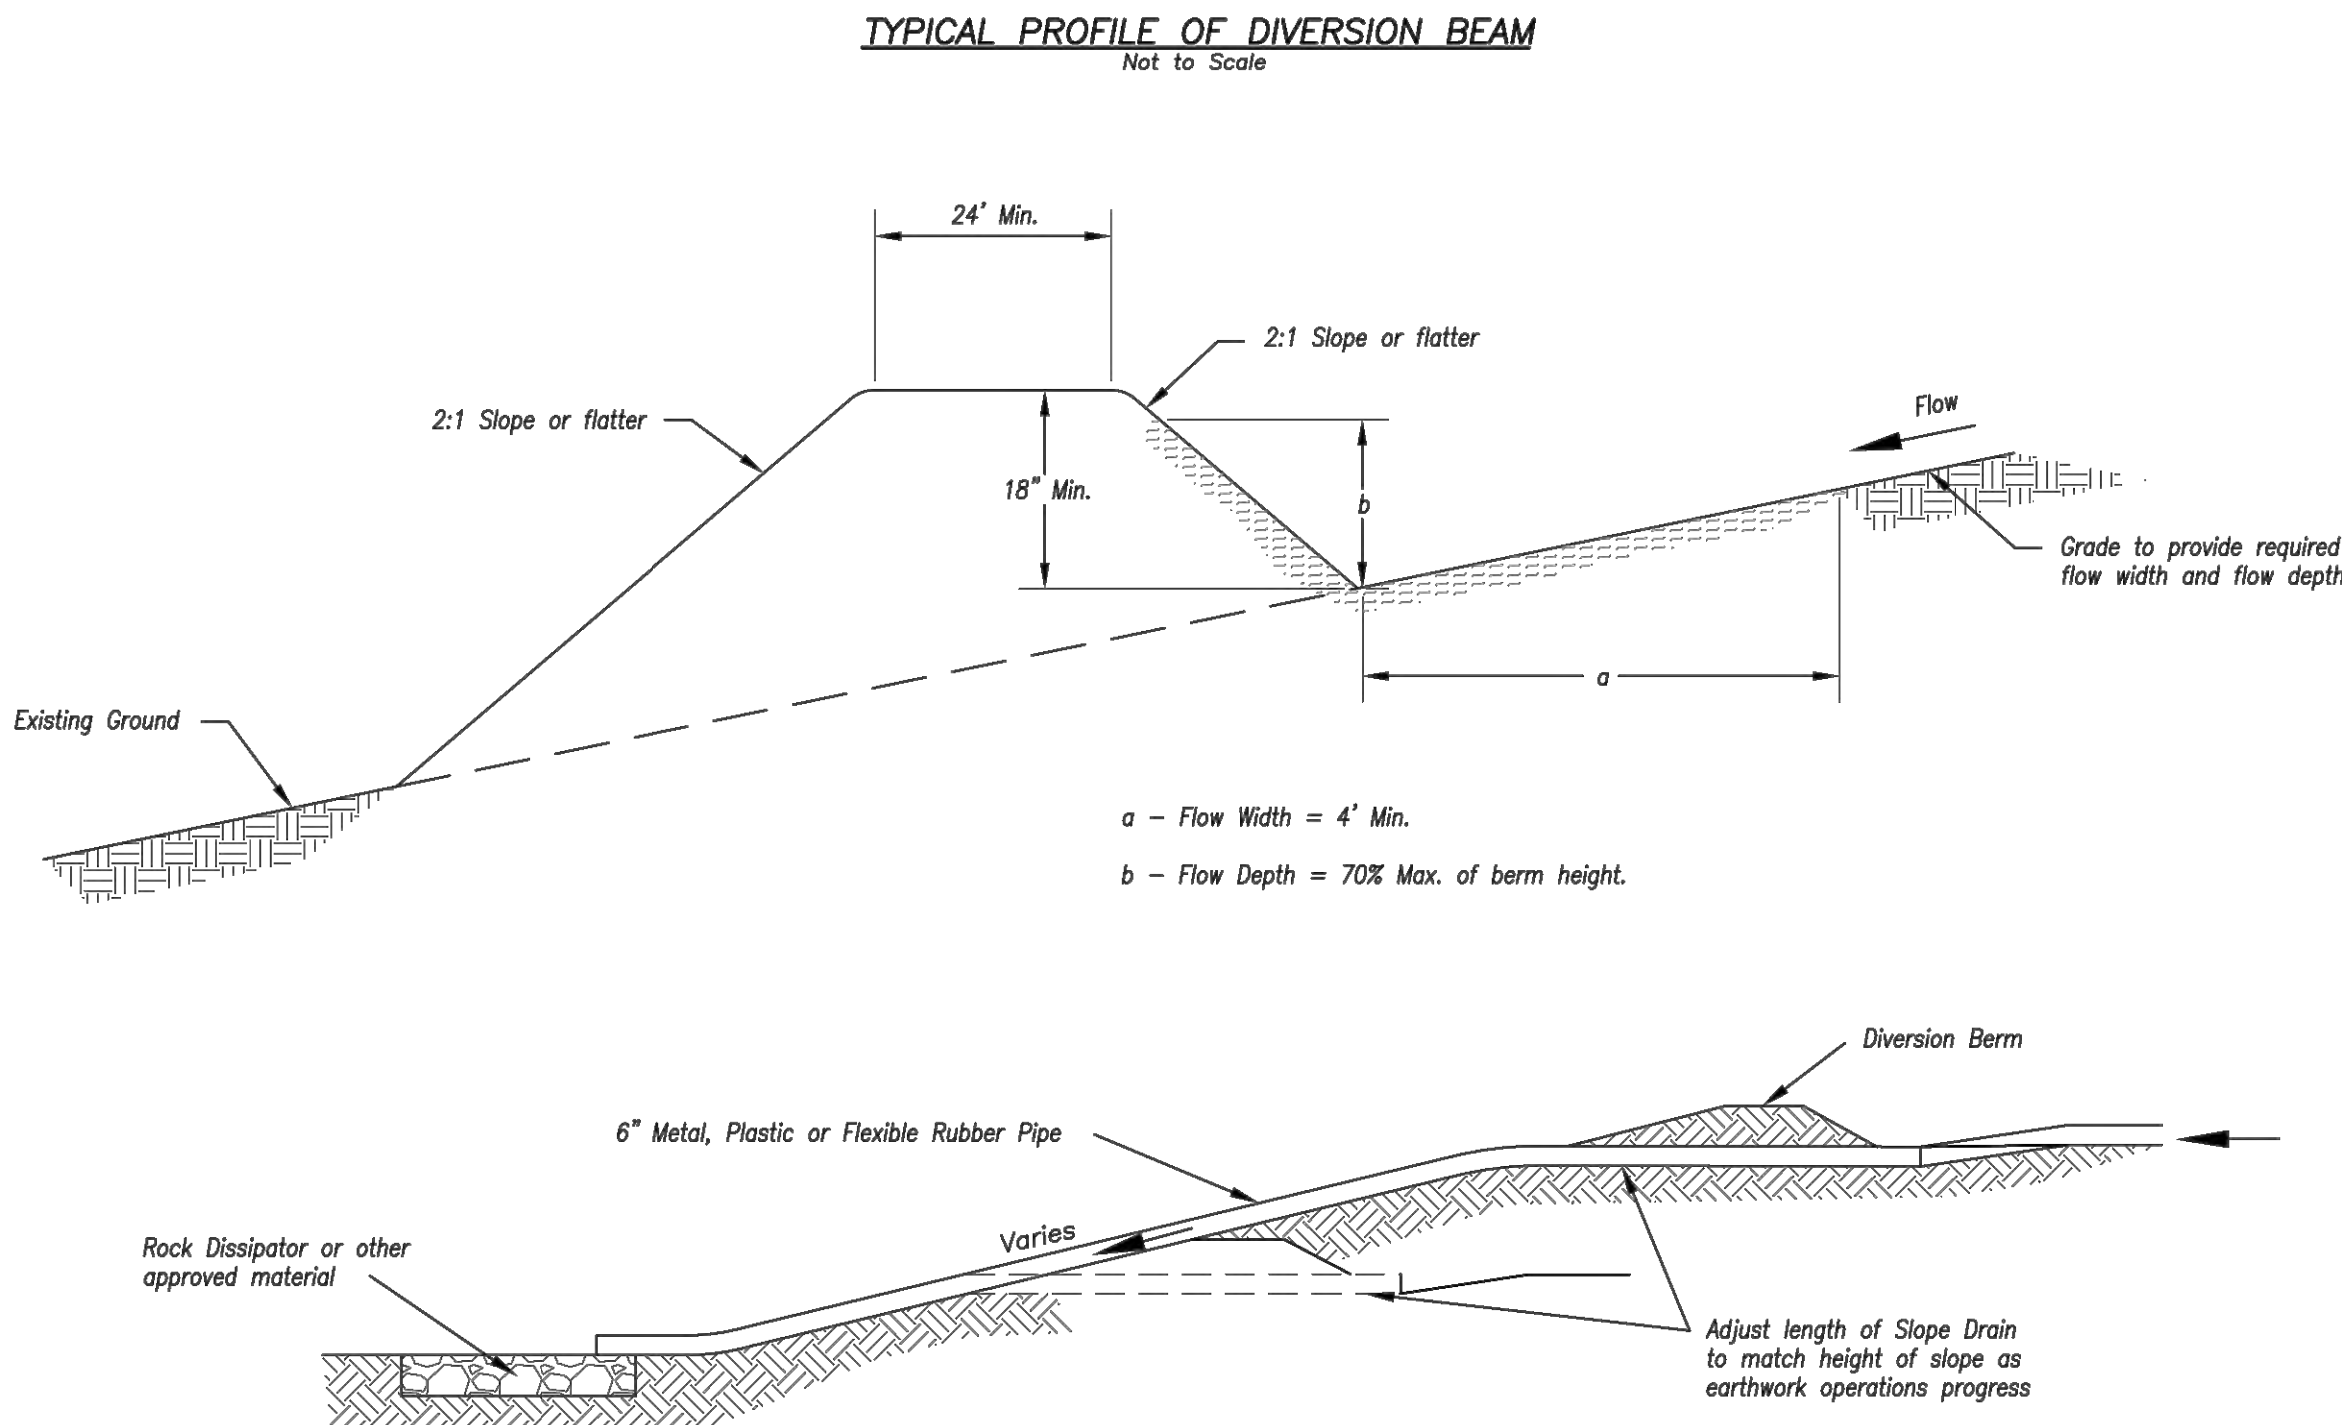

TYPICAL PROFILE OF DIVERSION BERM WITH SLOPE DRAIN

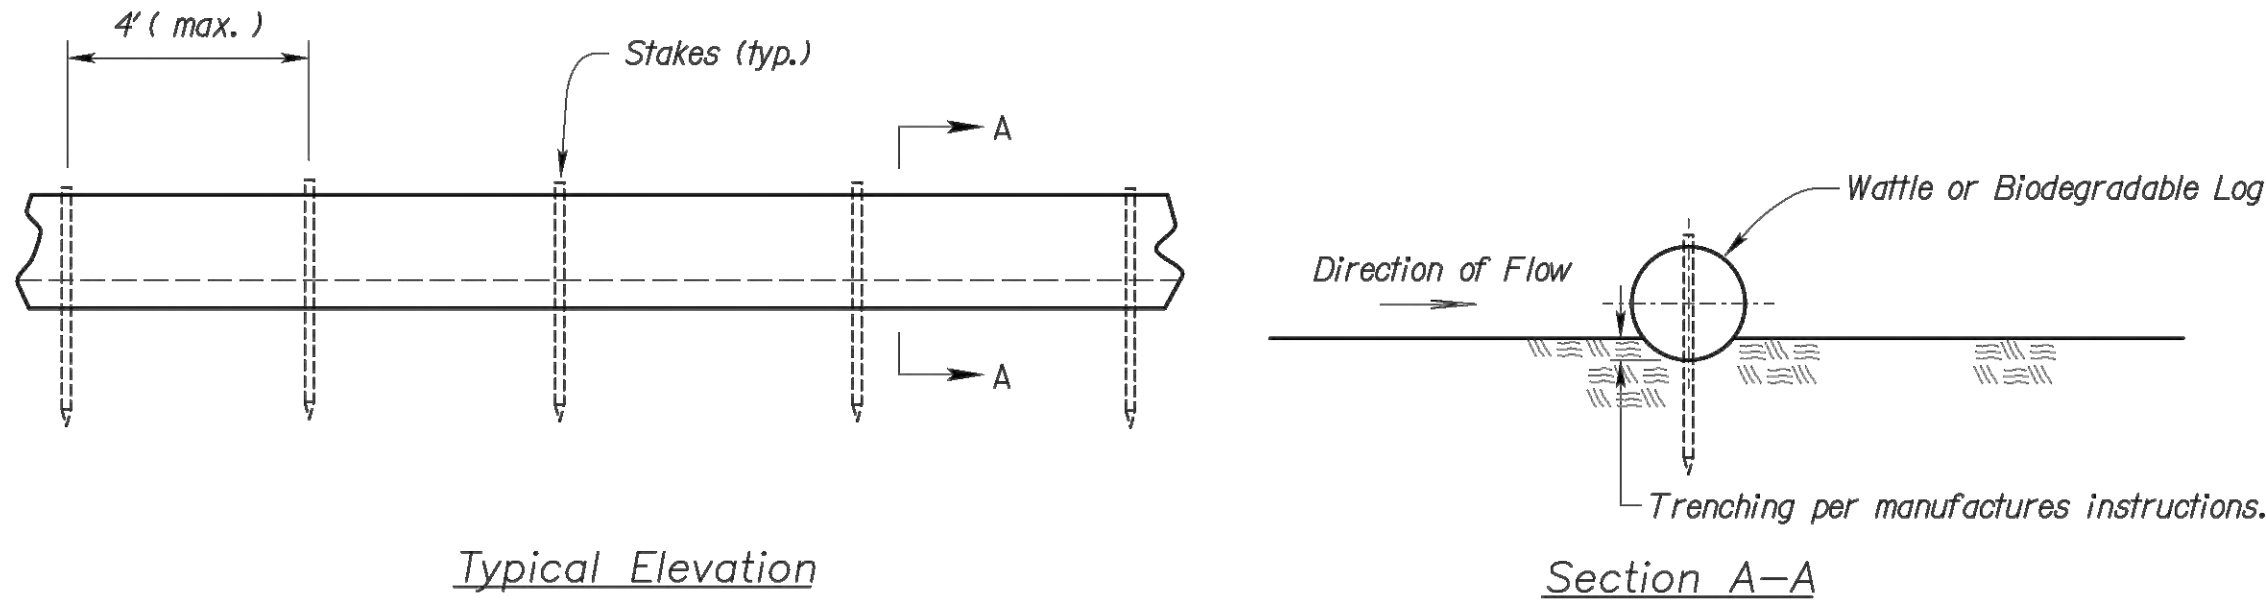

Notes for Wattles and Biodegradable Log Slope Protection:

1. The Slope barriers shall be placed along contour lines, with a short section turned upgrade at each end of the barrier. The maximum length of the slope barrier shall not exceed 250 feet, and the barrier ends need to be staggered.
2. Install wattles and biodegradable logs per manufacturer's instructions.
3. Spacing of stakes per manufacturer's instructions with 4' max. spacing. Length of stakes shall be a minimum of 2 times the diameter of the log with minimum of 24".

WATTLES AND BIODEGRADABLE LOG

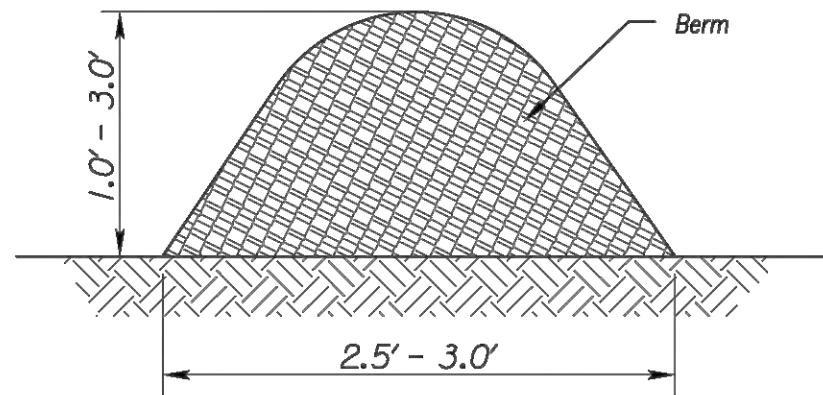


Figure 1
(Perimeter Control)

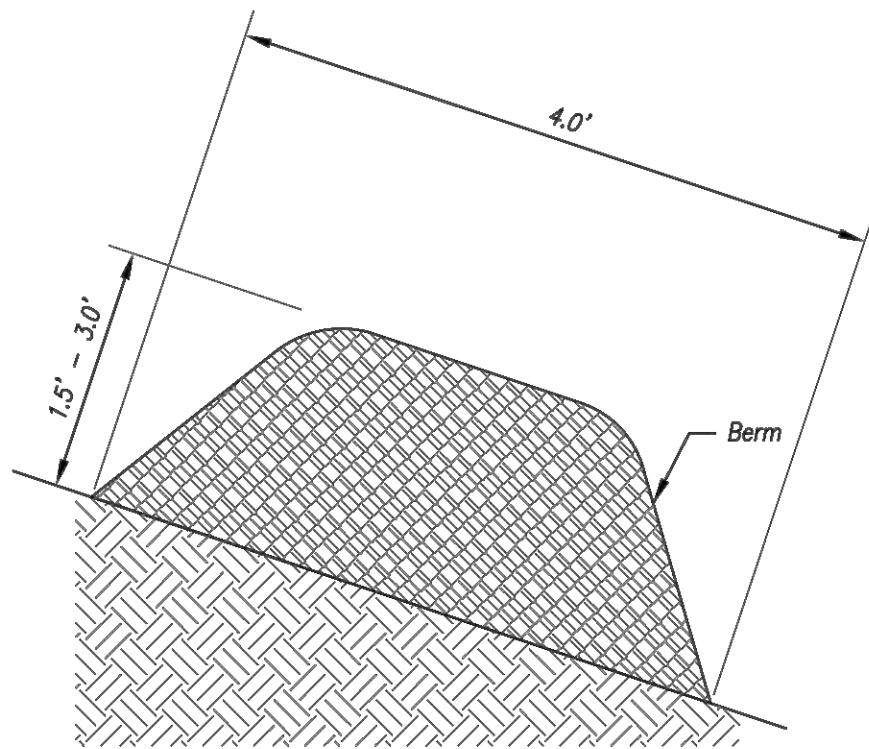


Figure 2
(Steep Slopes)

Notes for Mulch and Compost Filter Beam:

1. The sediment control berm shall be placed uncompacted in a windrow at locations shown on the plans or as directed by the engineer.
2. Parallel to the base of the slope, or around the perimeter of other affected areas, construct a 1 to 3 foot high by 2.5 to 3 foot wide berm (see Figure 1). For maximum water treatment ability or for steep slopes, construct a 1.5 to 3 foot high trapezoidal berm that is a minimum of 4 feet wide at the base (see Figure 2). In extreme conditions, or where specified by the engineer, a second berm shall be constructed at the top of the slope. Engineer will specify berm requirements.
3. If berm is to be left as permanent or part of the natural landscape, the compost berm may be seeded during application for permanent vegetation.
4. Do not use compost or wood mulch berms in any runoff channels or concentrated flow areas.
5. Wood mulch shall consist of tree and shrub debris resulting from clearing and grubbing and shall be ground by the mechanical means such as a chipper, hammermill, tub grinder or other approved method. Mulch sizing varies with a maximum width of 2" and a maximum length of 10".

Maintenance for Mulch and Compost Filter Beam:

1. Berm shall be reshaped and material added as necessary to maintain function and dimensions.
2. Breaches in the berm shall be repaired promptly.

MULCH OR COMPOST FILTER BERMS

AMERICAN PUBLIC WORKS ASSOCIATION	
	KANSAS CITY METRO CHAPTER
DIVERSION BERMS AND SLOPE DRAINS	STANDARD DRAWING NUMBER ESC-05
ADOPTED: 10/24/2016	
WATTLES/BIODEGRADABLE LOG AND MULCH/COMPOST FILTER BERM	STANDARD DRAWING NUMBER ESC-04
	ADOPTED: 10/24/2016


DESIGNED BY	AM
DATE	09-19-2018
JOB NUMBER-TASKS	0318050.01
BOOK AND PAGE	

PERSONS	09/10/18 - RESUBMITAL PER ADJUSTED LAYOUT	816.361.0040 P
	09/19/18 - RESUBMITAL PER CITY COMMENTS	816.361.0045 F
		9001 State Line Rd., Suite 200 Kansas City, Missouri 64114 www.LRA-inc.com
		LARKIN/LAMP RYNEARSON
		SUMMIT VIEW FARMS 3RD PLAT LEE'S SUMMIT, MISSOURI


MASS GRADING, EROSION CONTROL, PAVING, STORM AND SANITARY PLANS
EROSION CONTROL DETAILS

LARKIN LAMP RYNEARSON - ENGINEERS
NO Certificate of Authority No. 2013011503


09-19-2018
MARK DANIEL MCGHEE JR. PE - 2008019568
SHEET
10 OF 31

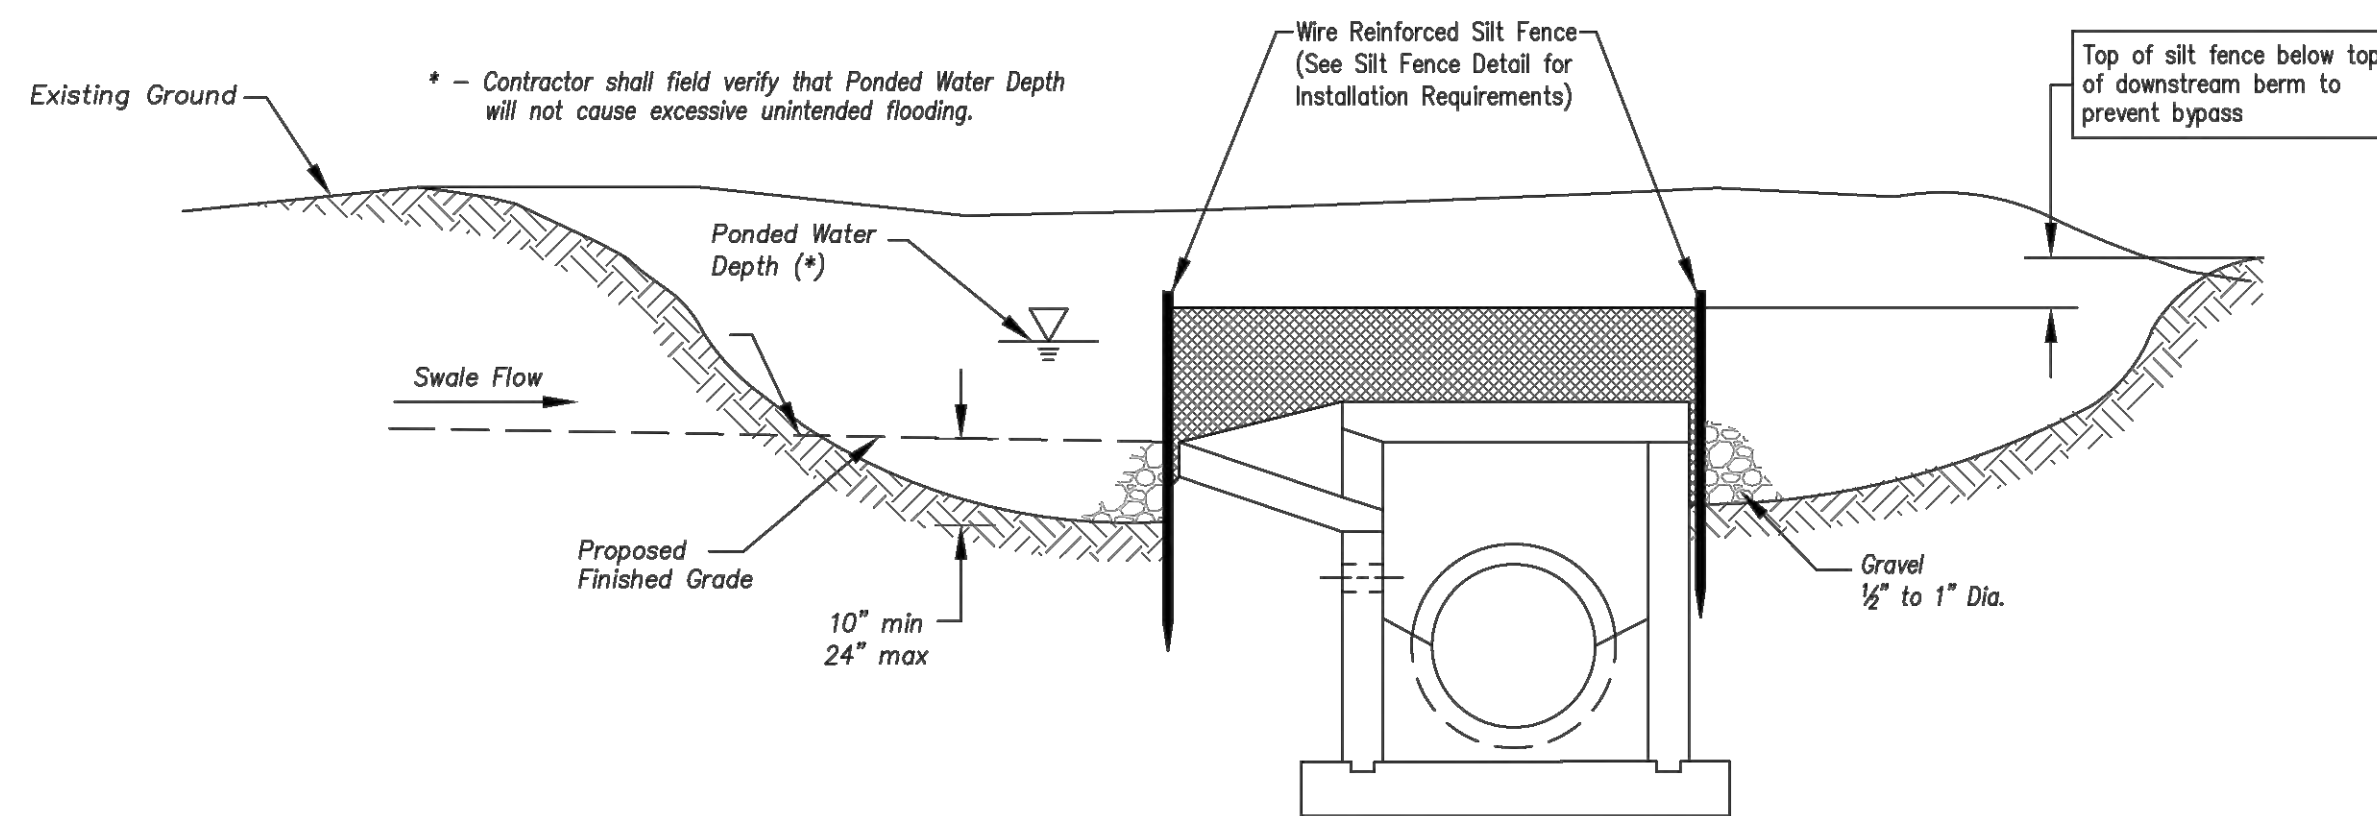


Section A-A
Not to Scale

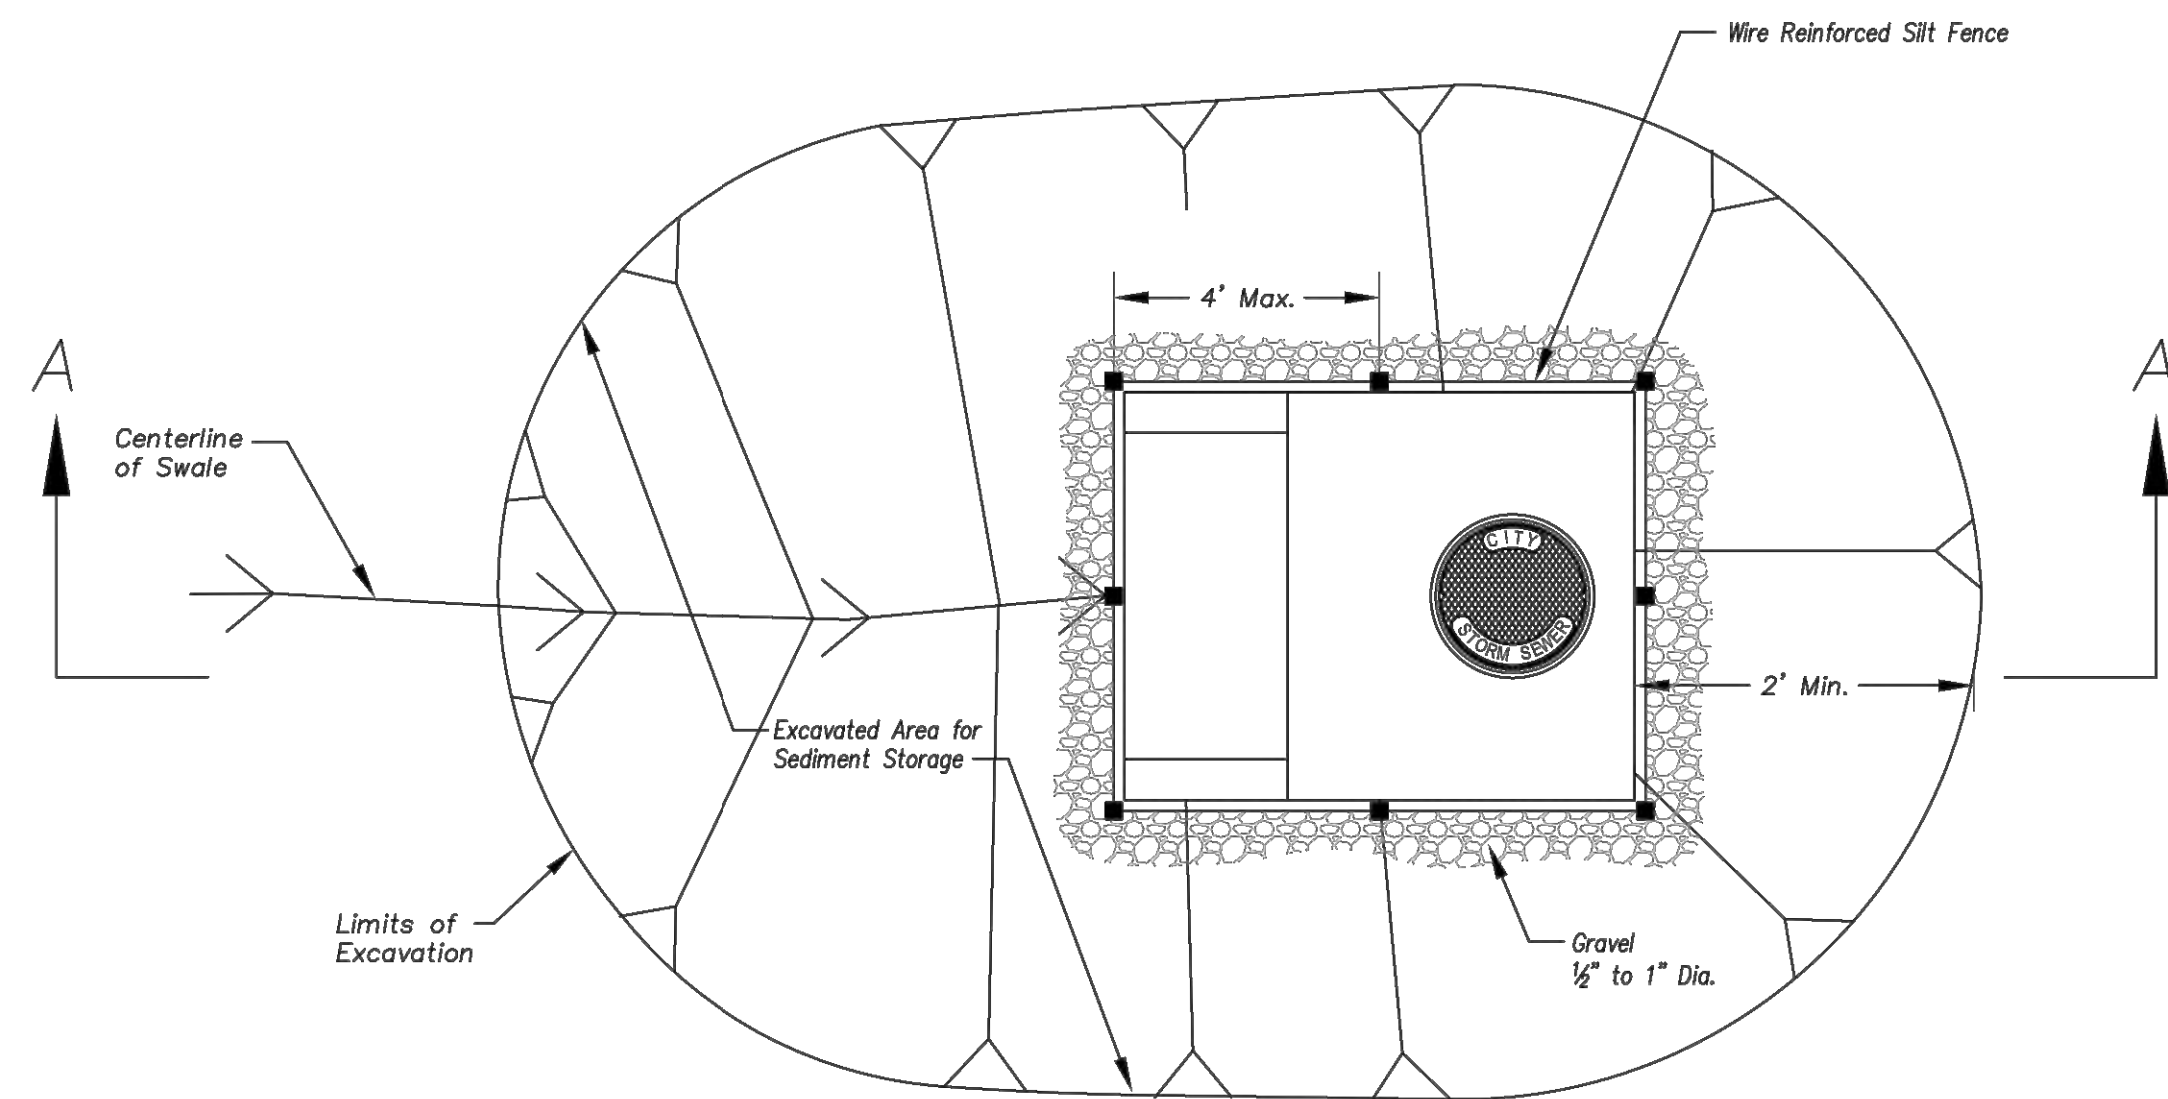


PLAN
NOT TO SCALE

EARLY STAGE AREA INLET
(ALL OPEN BOXES AND INLETS NOT AT FINAL GRADE)

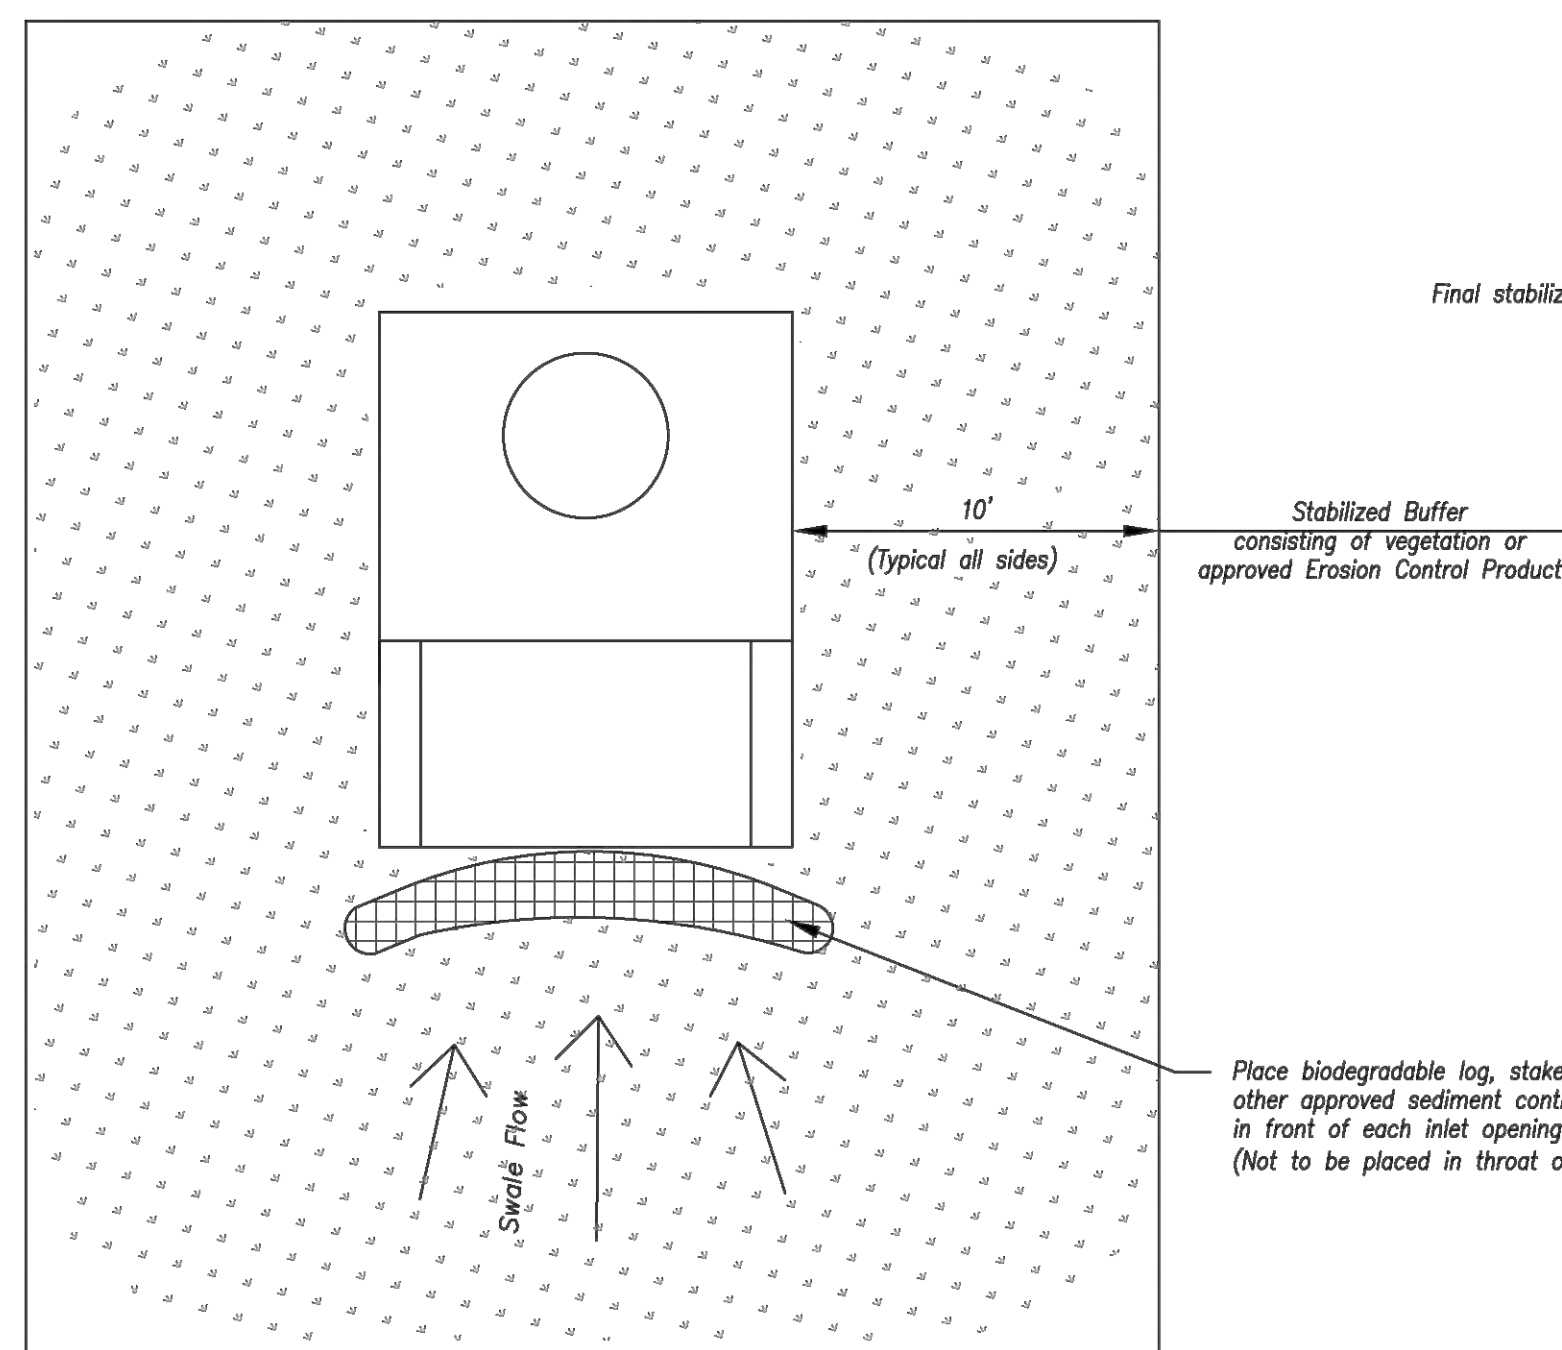

Plan
Not to Scale

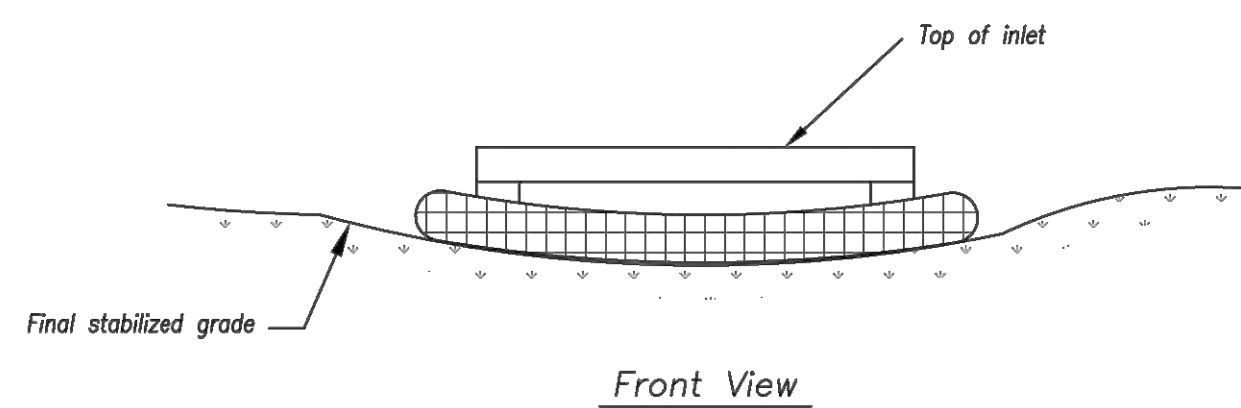


- Notes:

1. Early Stage Area Inlet Sediment Barrier to be installed immediately after inlet or junction box is constructed.
2. Silt fence shall remain in place until excavated area is removed and Late Stage Area Inlet is being installed.
3. Backfill excavated area ONLY after final grading of the site. Stabilization of the site is to immediately follow.
4. Wire reinforced silt fence may be used in place of silt fence attached to wood frame.

- Maintenance:

1. Remove deposited sediment from excavated storage areas when available storage has been reduced by 20%.
2. Remove deposited sediment from filter socks or similar when any accumulation of sediment is visible.
3. Repair or replace as necessary to maintain function and integrity of installation.

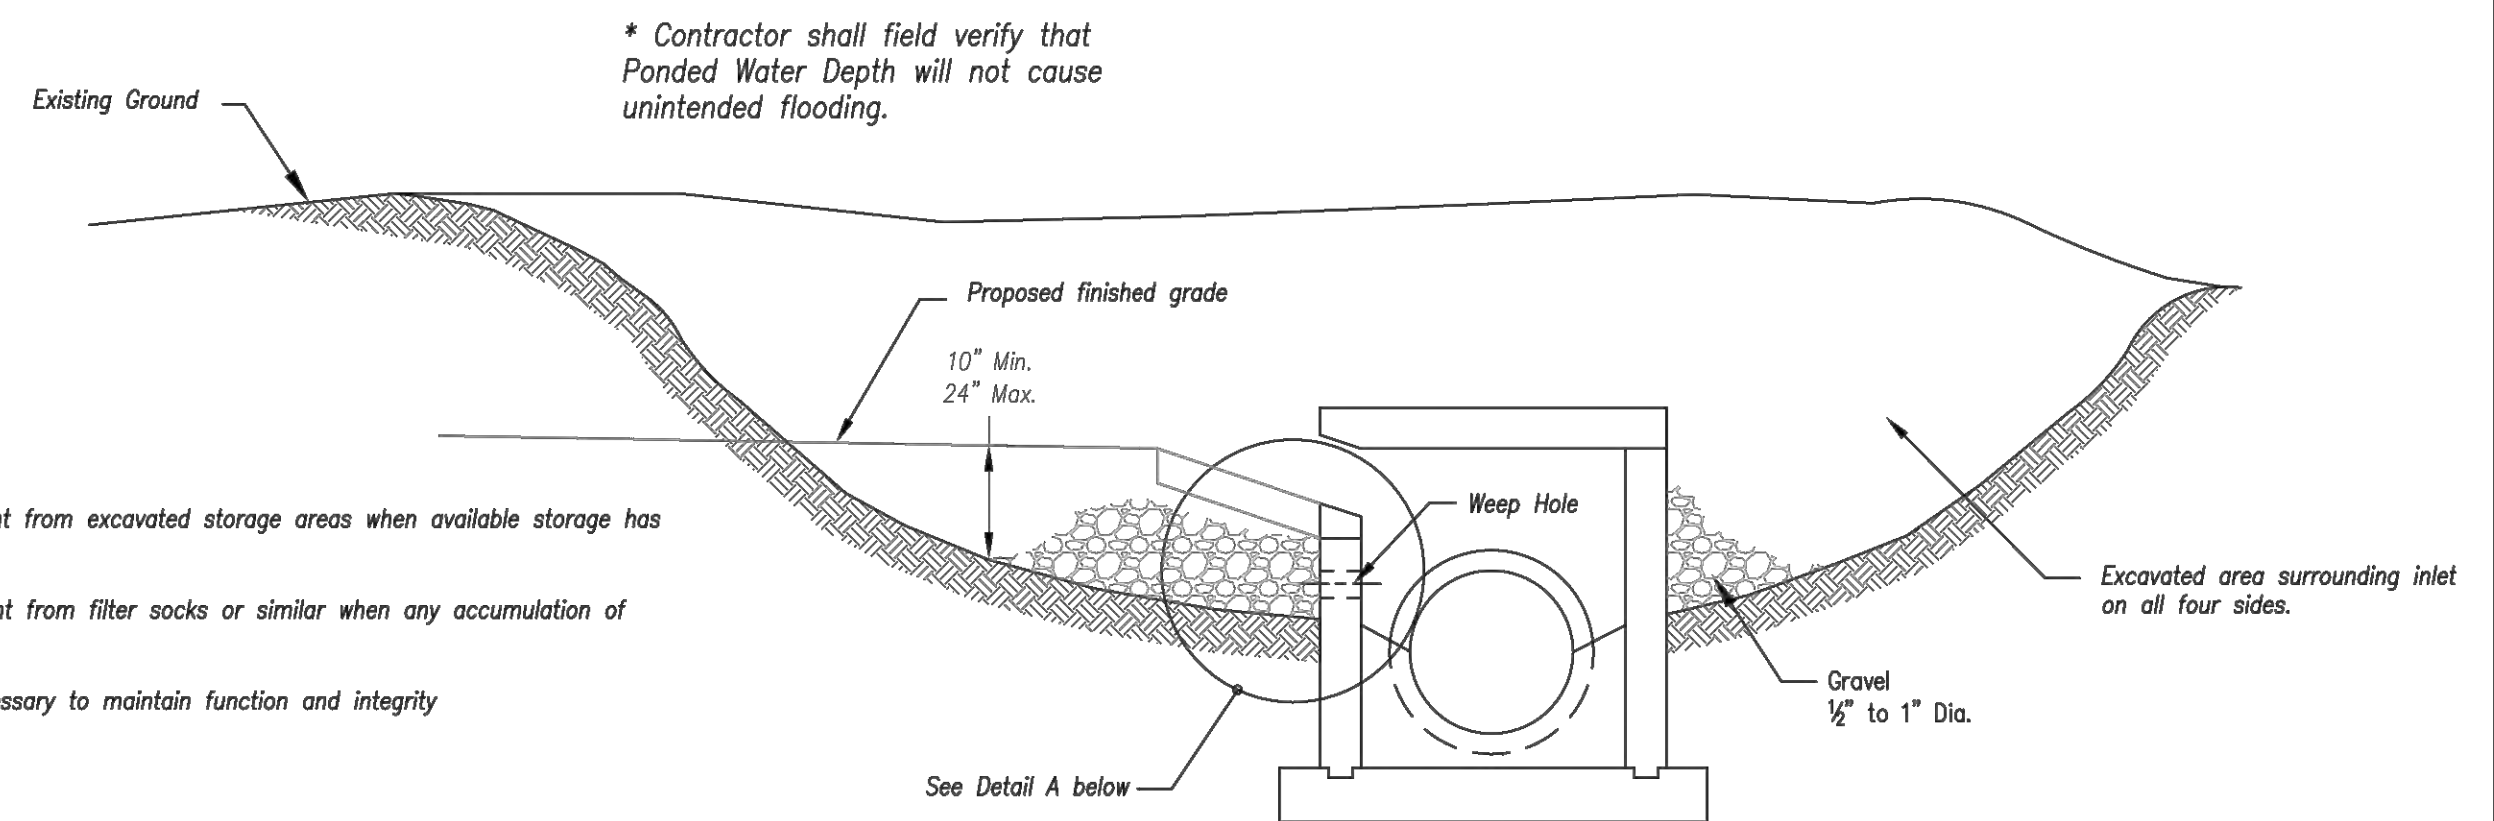


- Maintenance:


1. Remove deposited sediment from excavated storage areas when available storage has been reduced by 20%.
2. Remove deposited sediment from filter socks or similar when any accumulation of sediment is visible.
3. Repair or replace as necessary to maintain function and integrity of installation.

- Notes:

1. Immediately following inlet construction and prior to construction of curb and inlet throat, protect inlet opening by installing 2" X 10" (min.) board wrapped in silt fence. Structures shall have excavated storage area on all four sides to allow settling of sediment (Early Stage Curb Inlet).
2. When inlet is completed and curb poured, filter socks or approved equal should be used (Late Stage Curb Inlet). Straw wattles are not approved for curb inlet use.
3. Contractor to field verify ponding water shall not create a traffic hazard.

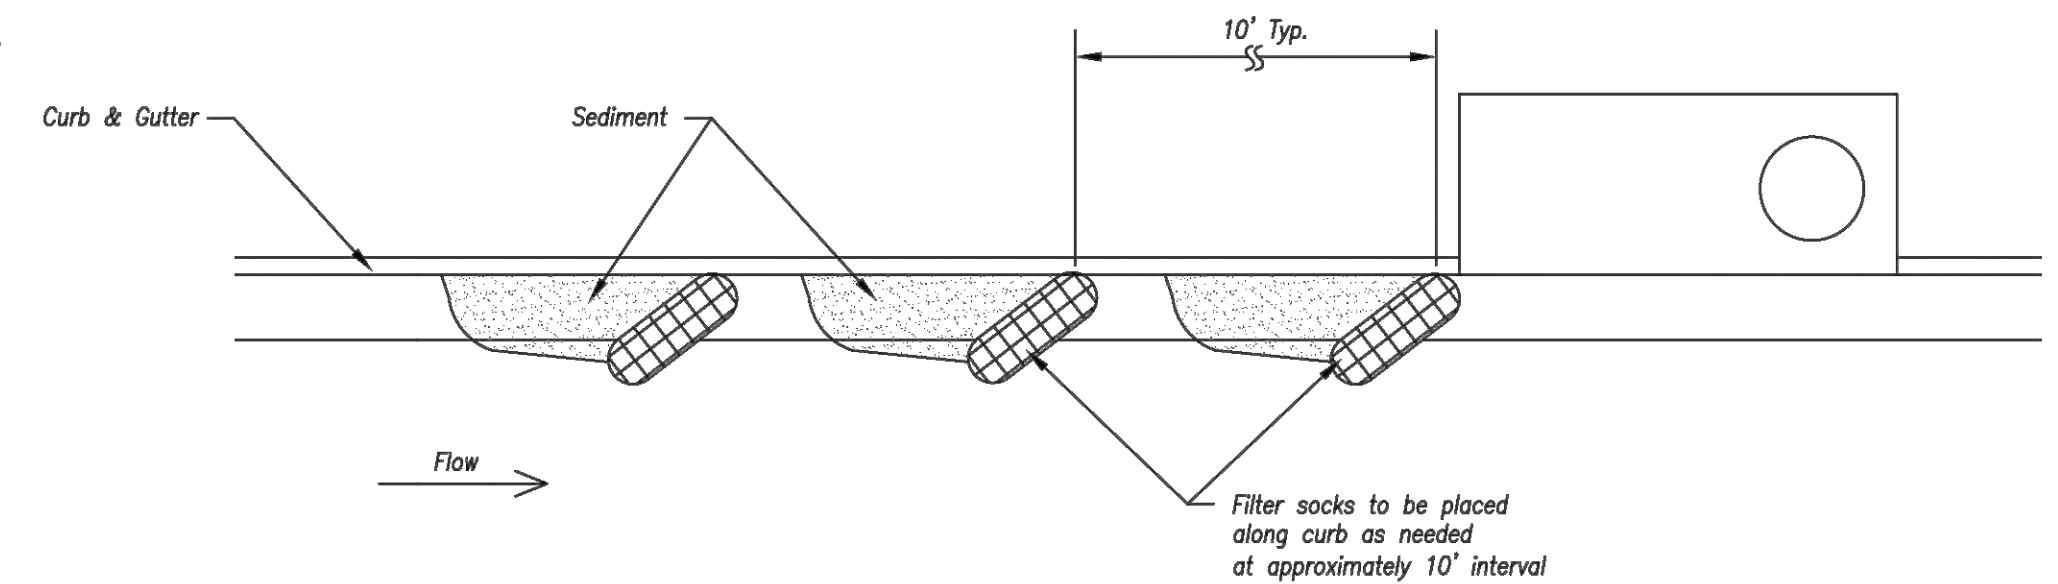


On Grade Curb Inlet Protection

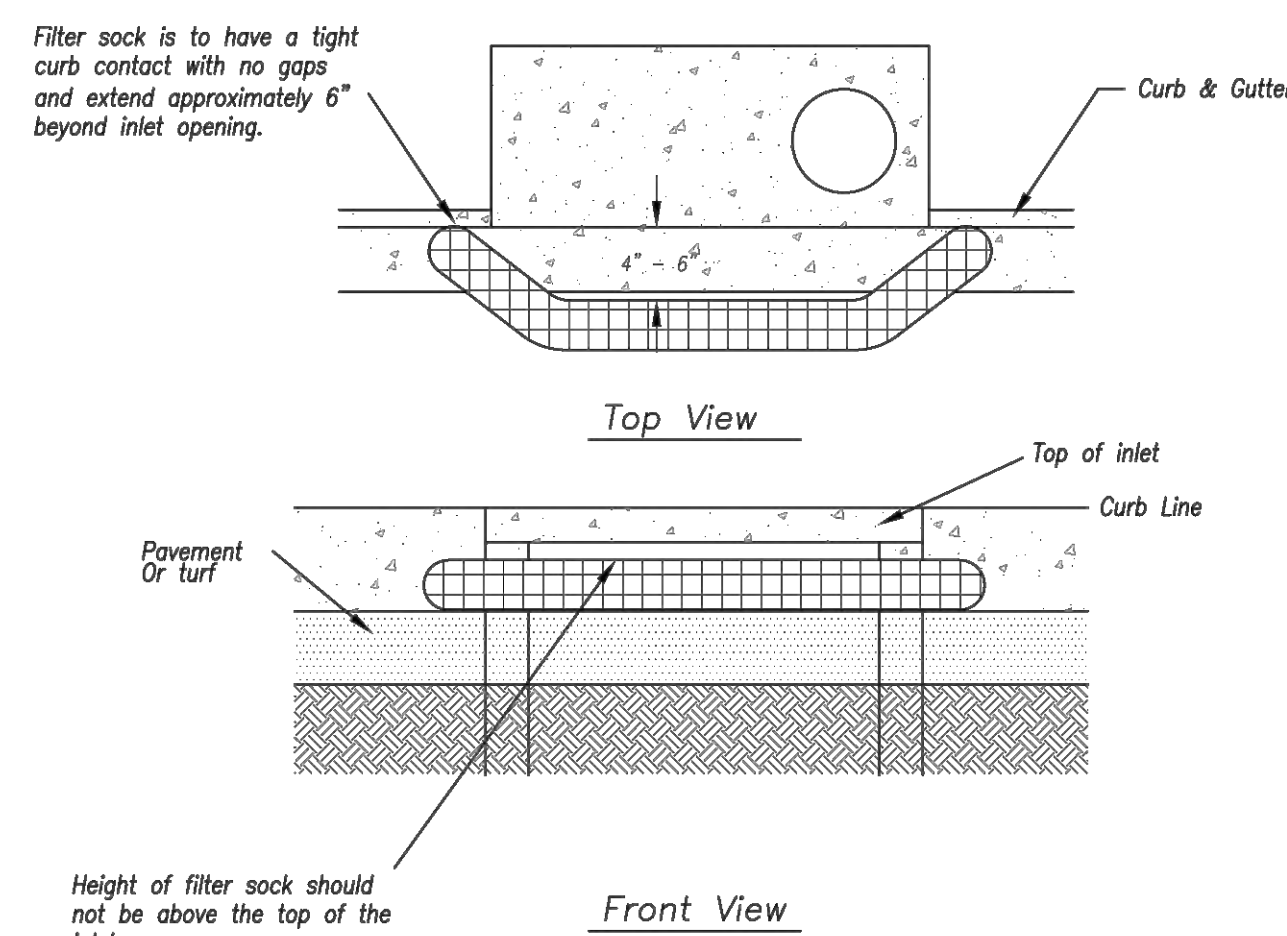

Sump Inlet Sediment Filter


- LATE STAGE CURB INLET
(After Pouring Curb and Inlet Throat)

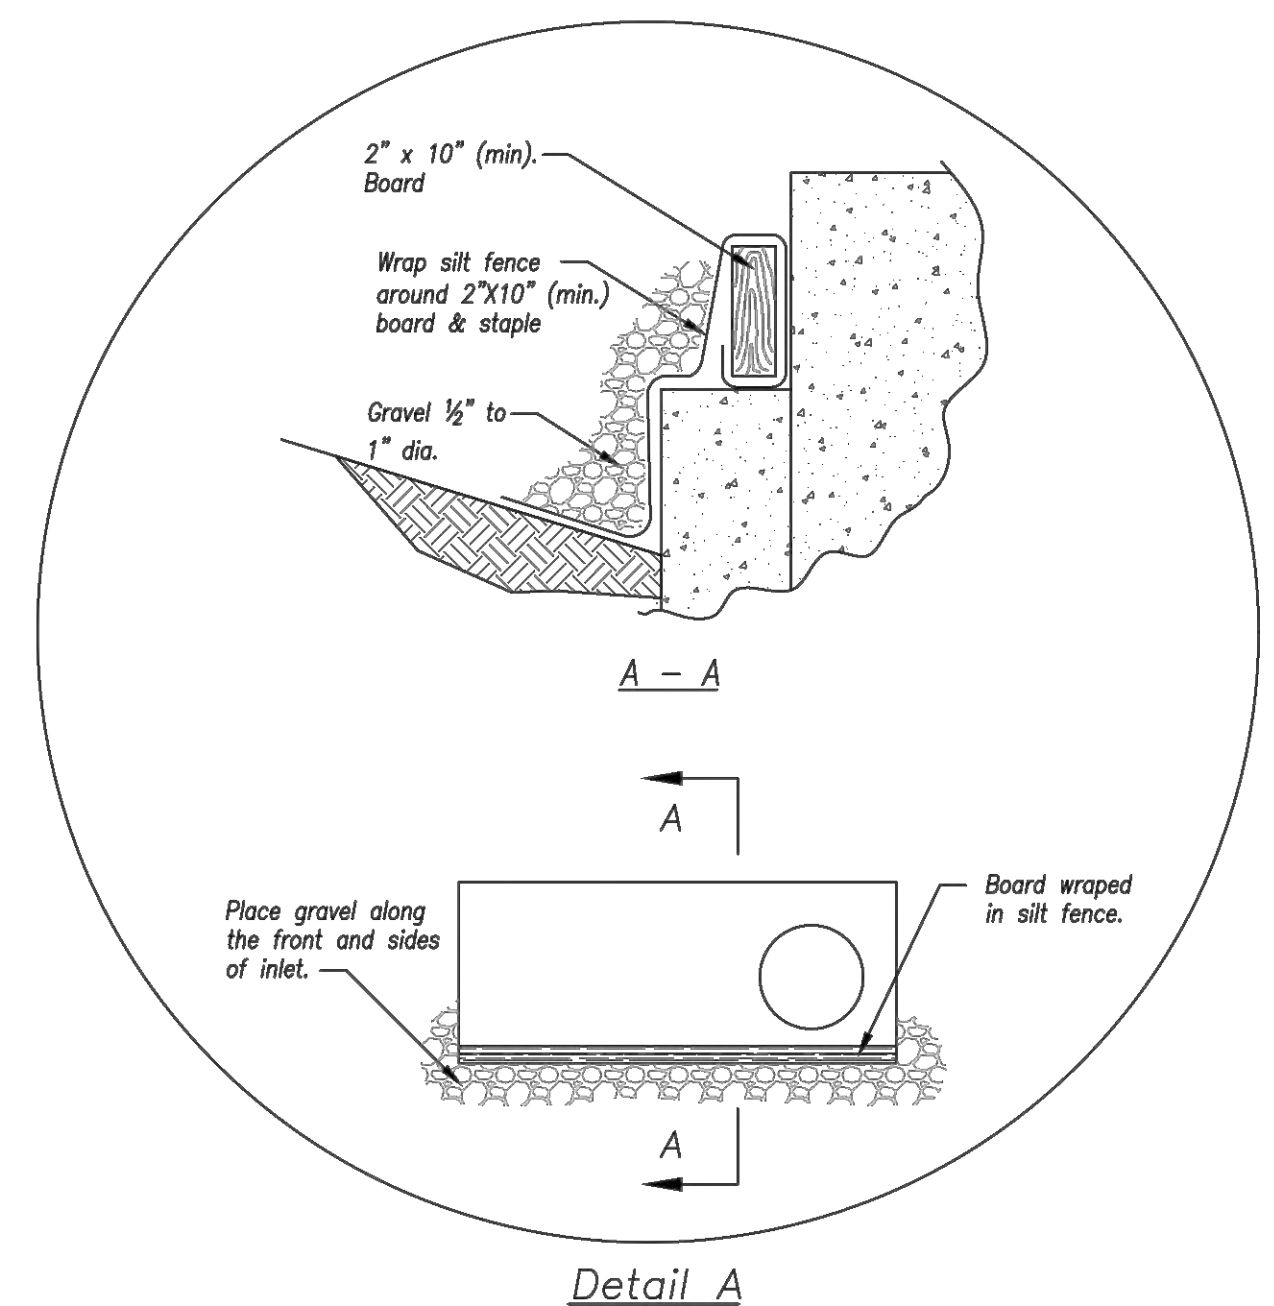

EARLY STAGE CURB INLET
(Open Box and Prior to Pouring
Curb and Inlet Throat)

AMERICAN PUBLIC WORKS ASSOCIATION Kansas City Metro Chapter  AMERICAN PUBLIC WORKS ASSOCIATION		KANSAS CITY METRO CHAPTER
CURB INLET PROTECTION	STANDARD DRAWING NUMBER ESC-06 ADOPTED: 10/24/2016	
AREA INLET AND JUNCTION BOX PROTECTION	STANDARD DRAWING NUMBER ESC-07 ADOPTED: 10/24/2016	


L:\Engineering\0318050 SVFDG Summit View Farms 3rd Plat\DRAWINGS\CONSTRUCTION DRAWINGS\ORD-ERC-PLANS\0318050-MG-ESC-DET.dwg, 9/19/2018 8:32:30 AM, JAMIE MCNURY, LAMP RYNEARSON & ASSOCIATES

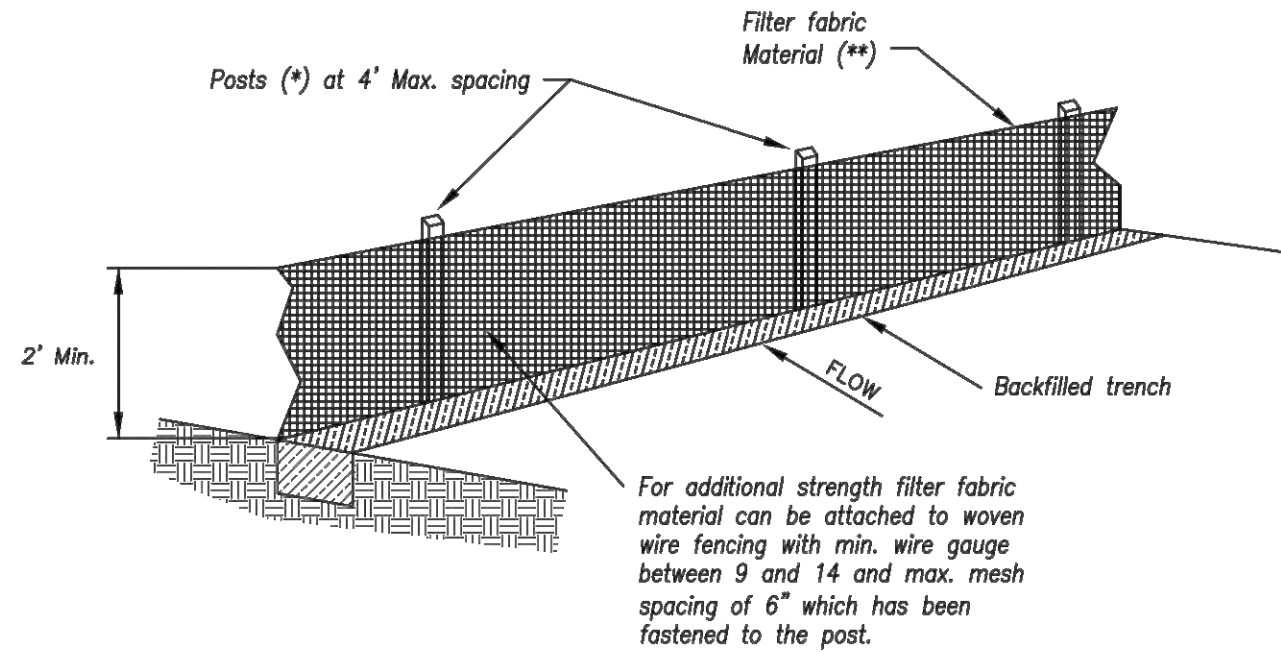

- (*) **POSTS**
- MIN. LENGTH 4'
 - HARDWOOD 1 3/8" x 1 3/8"
 - NO.2 SOUTHERN PINE 2 3/8" x 2 3/8"
 - STEEL 1.33 LB/FT

(**) - Geotextile Fabric shall meet the requirements of AASHTO M288

SILT FENCE DETAILS
Not to Scale

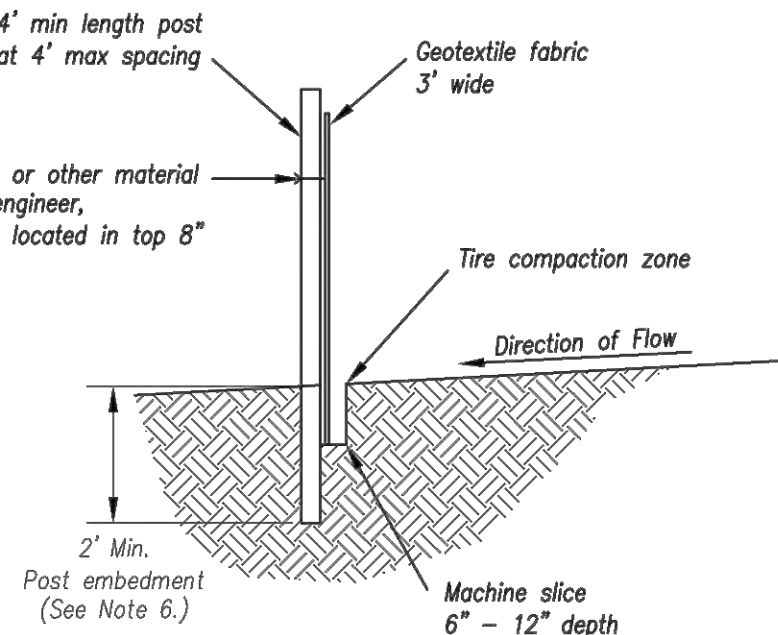

Notes:

1. In order to contain water, the ends of the silt fence must be turned uphill (Figure A).
2. Long perimeter runs of silt fence must be limited to 100'. Runs should be broken up into several smaller segments to minimize water concentrations (Figure A).
3. Long slopes should be broken up with intermediate rows of silt fence to slow runoff velocities.
4. Attach fabric to upstream side of post.
5. Install posts a minimum of 2' into the ground.
6. Trenching will only be allowed for small or difficult installation, where slicing machine cannot be reasonably used.

Maintenance:

1. Remove and dispose of sediment deposits when the deposit approaches 1/3 the height of silt fence.
2. Repair as necessary to maintain function and structure.




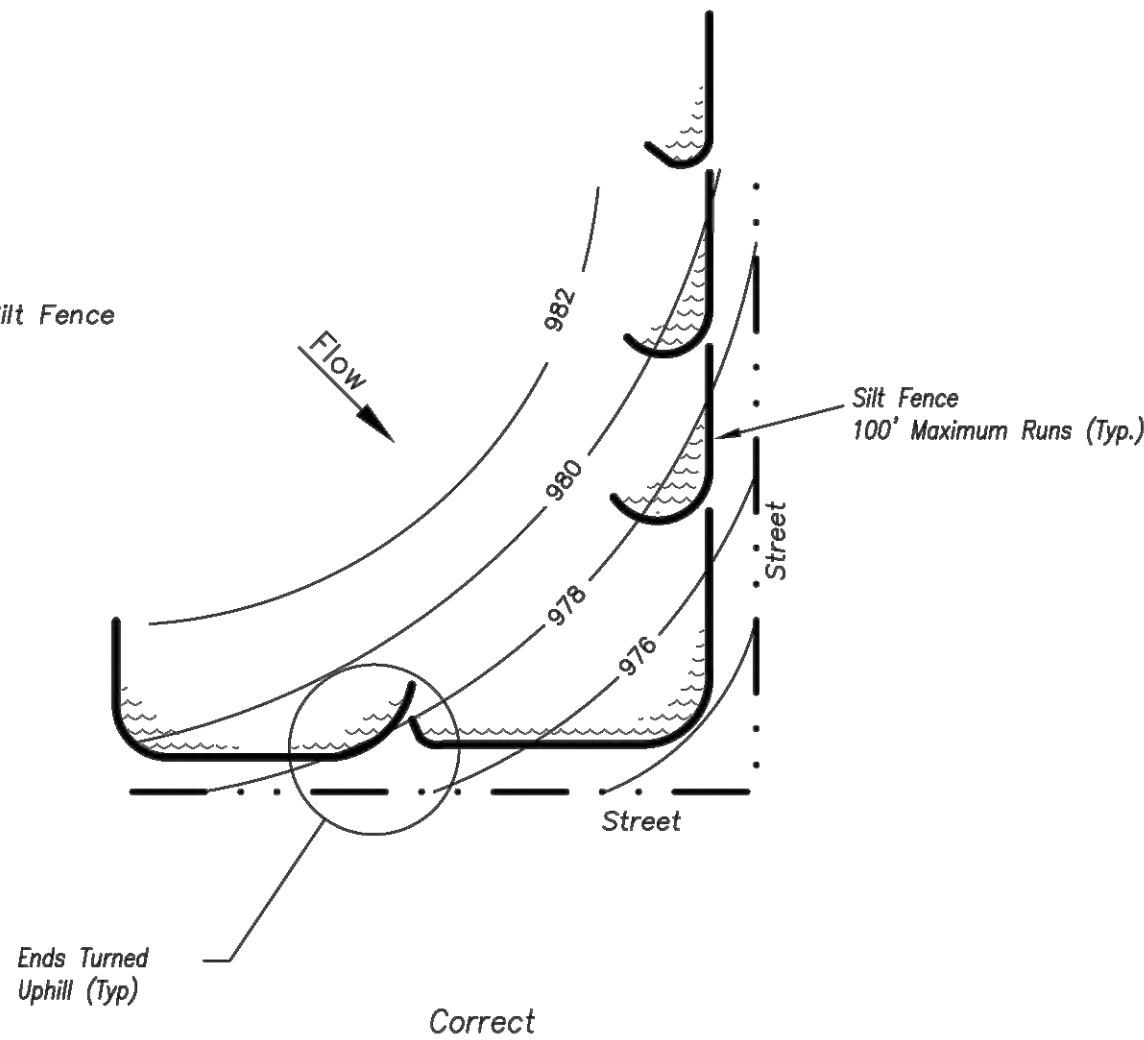


Figure A

SILT FENCE LAYOUT
Not to Scale

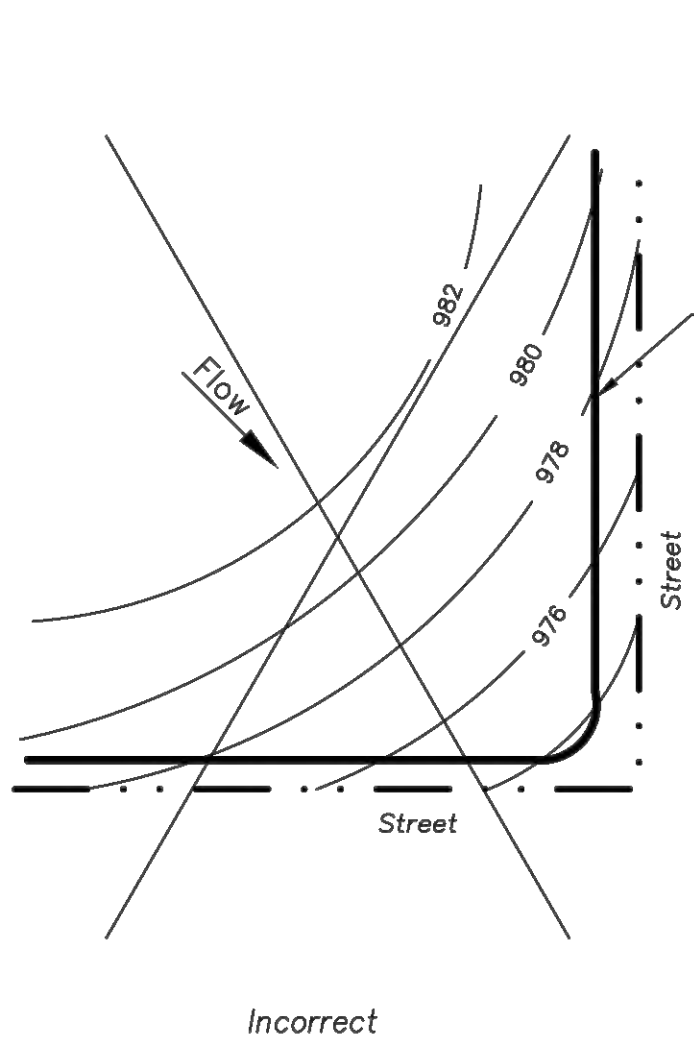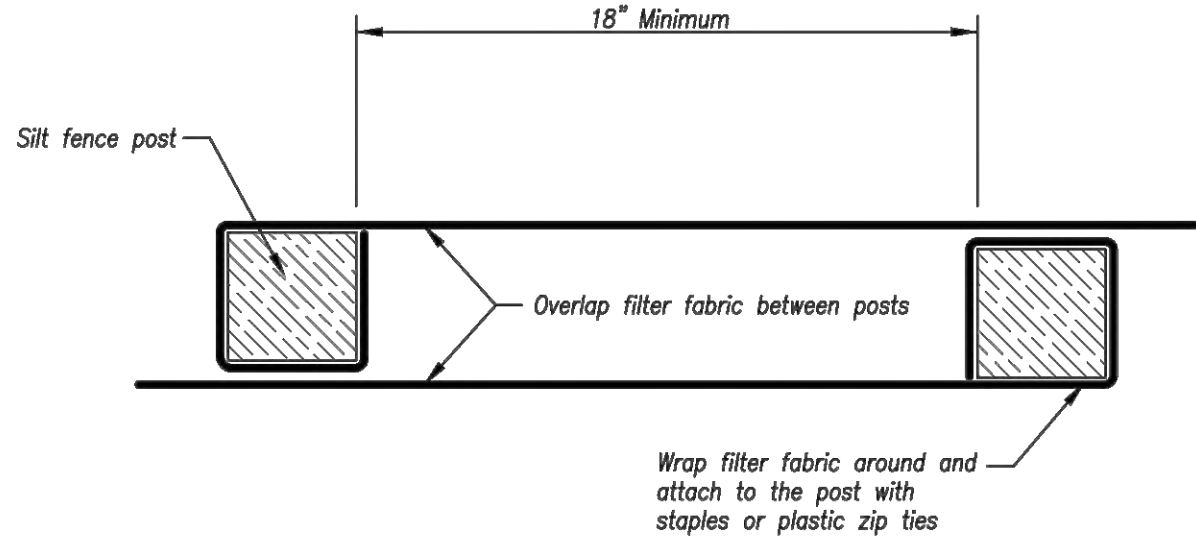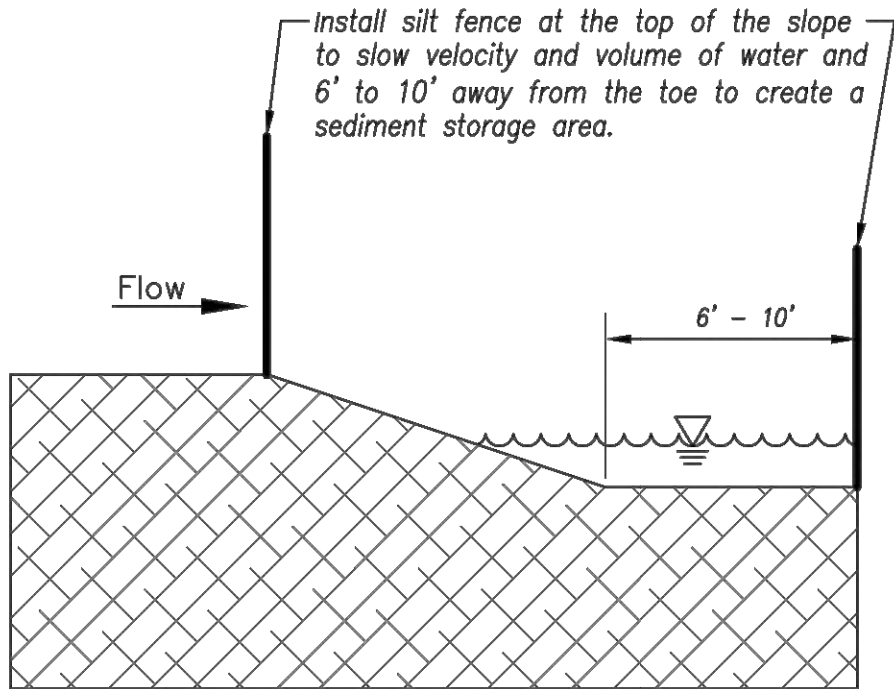


JOINING FENCE SECTIONS
Not to Scale

AMERICAN PUBLIC WORKS ASSOCIATION	
	KANSAS CITY METRO CHAPTER
SILT FENCE	STANDARD DRAWING NUMBER ESC-03
	ADOPTED: 10/24/2016


Modified from 2015 Overland Park Standard Details for Erosion and Sediment Control.

DESIGNED BY NDM	DATE 09-19-2018	JOB NUMBER-TASKS 0318050.01	BOOK AND PAGE
PERSONS			
09/10/18 - RESUBMITAL PER ADJUSTED LAYOUT			
09/19/18 - RESUBMITAL PER CITY COMMENTS			
9001 State Line Rd., Suite 200 Kansas City, Missouri 64114 www.LRA-inc.com			
LARKIN/ LAMP RYNEARSON		SUMMIT VIEW FARMS 3RD PLAT LEE'S SUMMIT, MISSOURI	
MASS GRADING, EROSION CONTROL, PAVING, STORM AND SANITARY PLANS		EROSION CONTROL DETAILS	
LARKIN LAMP RYNEARSON - ENGINEERS			
Two Certificate of Authority No. 2013011503			
			
MARK DANIEL MCGHEE JR. PE - 2008019568			
SHEET			
12 OF 31			

L:\Engineering\031850 SVFDG Summit View Farms 3rd Plat\DRAWINGS\CONSTRUCTION\DRAWINGS\PAV-PLANS\031850-PAV-MDP.dwg, 10/30/2019 5:08:52 PM, DAN MCHEE, LAMP RYNEARSON & ASSOCIATES

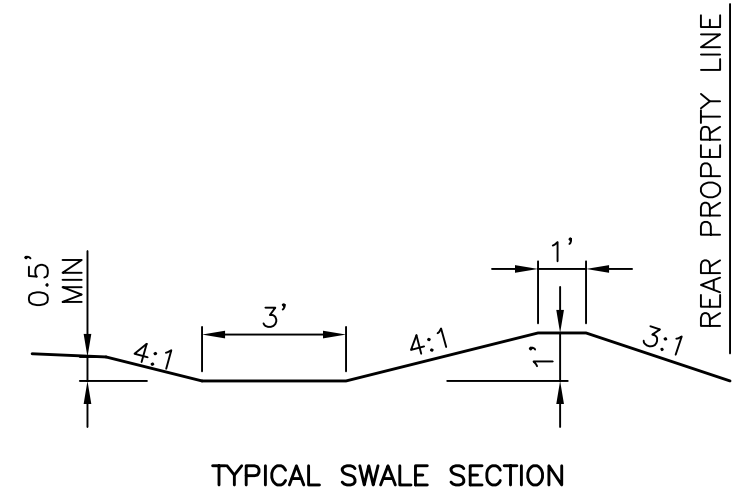


LOT	1% STORM SWALE DEPTH
52	0.38 FEET
53	0.35 FEET
54	0.27 FEET

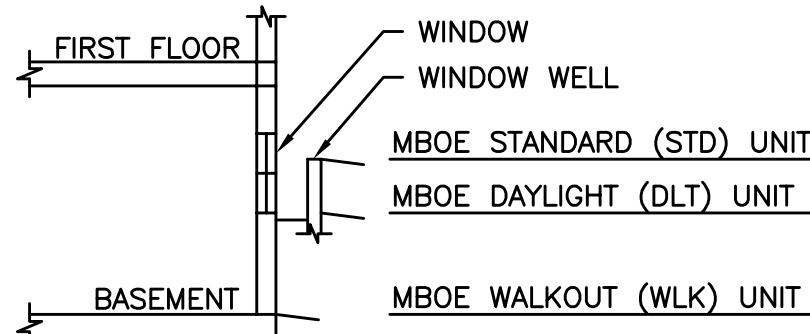


TYPICAL UNIT SECTION
NOT TO SCALE

GENERAL NOTES:

1. MINIMUM BUILDING OPENING ELEVATIONS (MBOE'S) SHOWN REPRESENT THE MINIMUM RECOMMENDED ELEVATIONS THAT WILL PROVIDE ADEQUATE POSITIVE STORM WATER DRAINAGE TO THE LOWEST POINT ON THE LOT FROM THE ANTICIPATED LOW SIDE OF THE BUILDING. THE HOME BUILDER SHALL BE RESPONSIBLE FOR ENSURING ADEQUATE POSITIVE DRAINAGE AWAY FROM ALL BUILDING OPENINGS TO PREVENT LOCALIZED STRUCTURE FLOODING.
2. A DAYLIGHT OR STANDARD UNIT MAY BE CONSTRUCTED ON WALKOUT LOT, AND A STANDARD UNIT MAY BE CONSTRUCTED ON A DAYLIGHT LOT.
3. A DAYLIGHT UNIT IS DEFINED AS A UNIT HAVING A WINDOW ON THE BASEMENT LEVEL WITH AT LEAST 5'-4" OF CLEARANCE FROM THE FINISHED FIRST FLOOR ELEVATION TO THE BOTTOM OF THE WINDOW. CLEARANCES LESS THAN 5'-4" ARE DEFINED AS STANDARD UNITS, WHETHER OR NOT A WINDOW WELL IS REQUIRED.
4. REFER TO SANITARY SEWER SHEETS FOR SEWER MAIN AND LATERAL ELEVATIONS. BASEMENT ELEVATION MAY NEED TO BE HIGHER THAN MBOE SHOWN FOR GRAVITY BASEMENT SEWER SERVICE.
5. ALL FRONT LOT ELEVATIONS ARE PROPOSED ELEVATIONS.
6. HOME BUILDERS SHALL MAINTAIN 2% GRADE, 1.5% ACROSS SIDEWALKS, WITHIN RIGHT-OF-WAY. AS-BUILT ELEVATIONS SHOWN AT RIGHT-OF-WAY ARE CALCULATED FROM AS-BUILT BACK OF CURB ELEVATIONS.

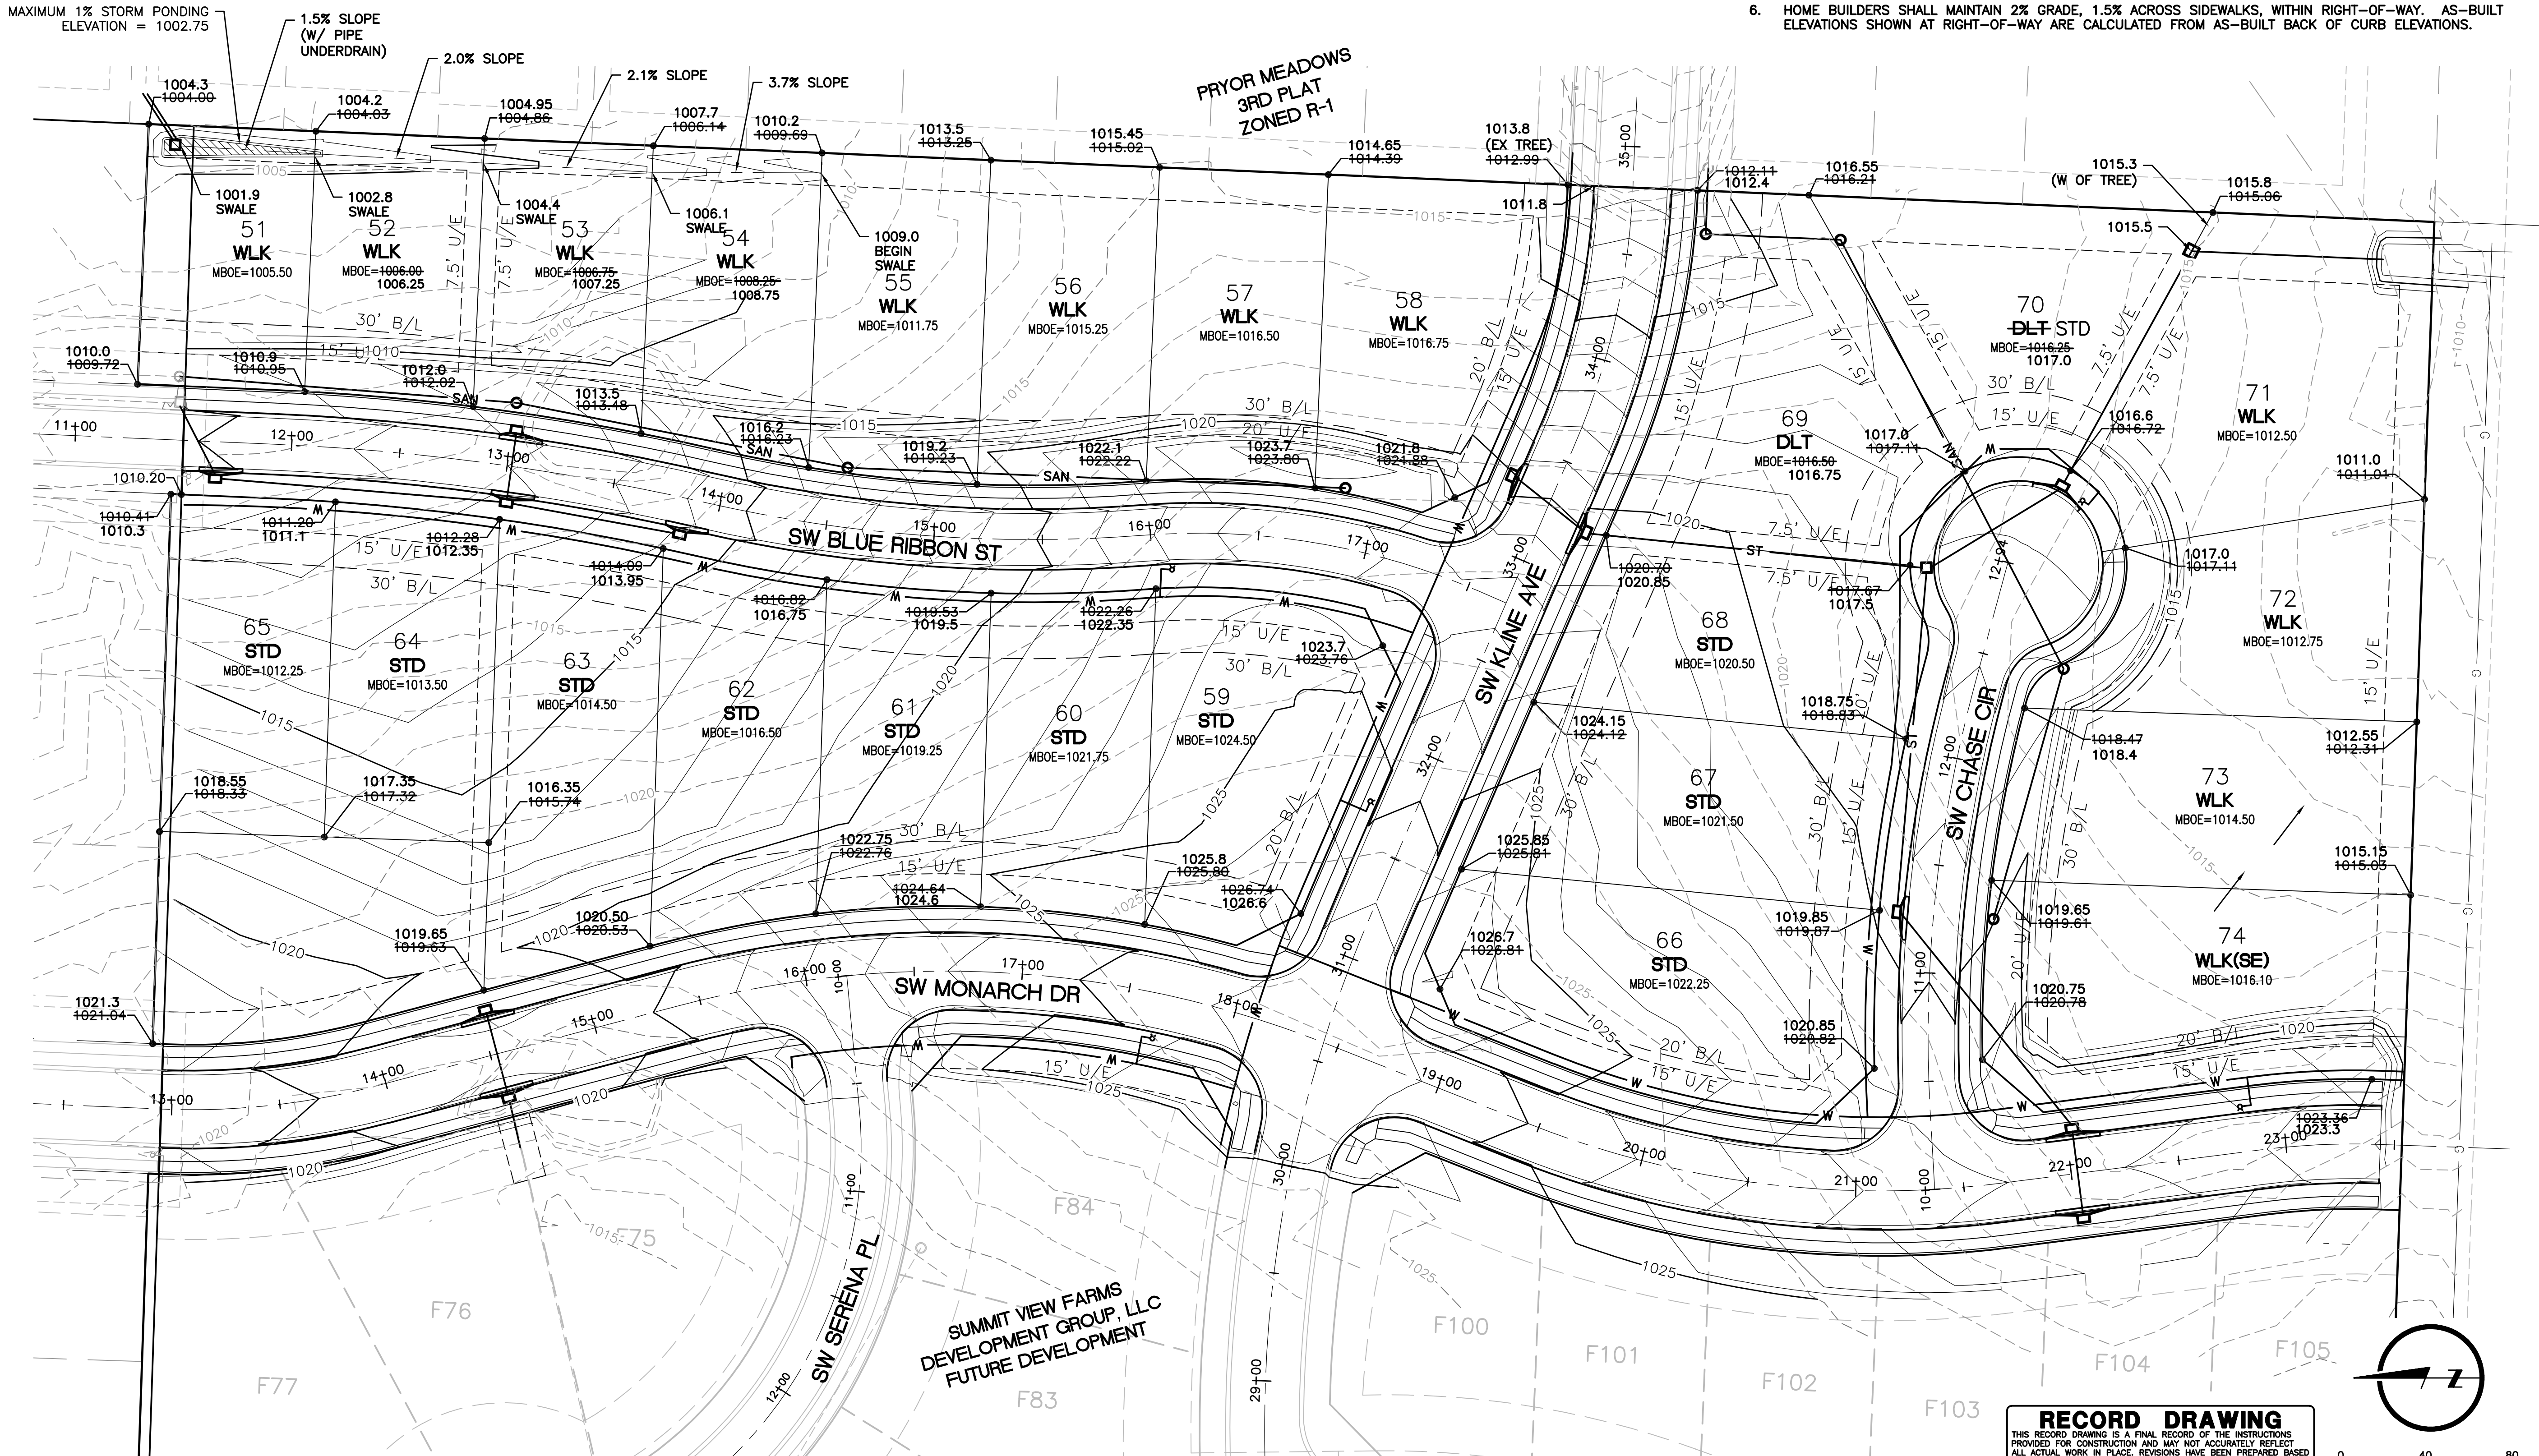


RECORD DRAWING
THIS RECORD DRAWING IS A FINAL RECORD OF THE INSTRUCTIONS PROVIDED FOR CONSTRUCTION AND MAY NOT ACCURATELY REFLECT ALL ACTUAL WORK IN PLACE. REVISIONS HAVE BEEN PREPARED BASED ON INFORMATION FURNISHED BY OTHERS. THOSE RELYING ON THIS RECORD DRAWING ARE ADVISED TO VERIFY ALL INFORMATION.

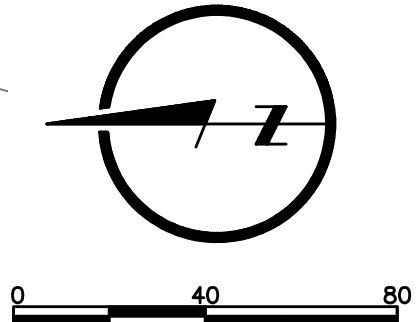


DRAWN BY AJM	DESIGNED BY MDM	DATE 10-05-2018	JOB NUMBER-TASKS 031850.01	BOOK AND PAGE
REVISIONS				
09/10/18 - RESUBMITAL PER ADJUSTED LAYOUT	816.361.0440 P	816.361.0045 F		
09/19/18 - RESUBMITAL PER CITY COMMENTS	9001 State Line Rd, Suite 200	Kansas City, Missouri 64114		
10/05/18 - RESUBMITAL PER CITY COMMENTS	www.LRA-inc.com			
03/01/19 - REVISION 1				
10/13/19 - AS-GRADED MASTER DRAINAGE PLAN				
10/30/19 - AS-GRADED MASTER DRAINAGE PLAN				
LARKIN/LAMP RYNEARSON				
SUMMIT VIEW FARMS 3RD PLAT				
LEE'S SUMMIT, MISSOURI				
MASS GRADING, EROSION CONTROL, PAVING, STORM AND SANITARY PLANS				
MASTER DRAINAGE PLAN				
LARKIN LAMP RYNEARSON - ENGINEERS				
MO Certificate of Authority No. 20130119303				
MARK DANIEL MCGHEE JR.				
PE - 2008019568				
SHEET				
13 OF 31				


L:\Engineering\031850 SVT03 Summit View Forms 3rd Plat\DRAWINGS\CONSTRUCTION DRAWINGS\PAV-PLANS\0318050-PAV-TYP.dwg, 9/19/2018 8:41:10 AM, JAMIE MCLEURY, LAMP RYNEARSON & ASSOCIATES

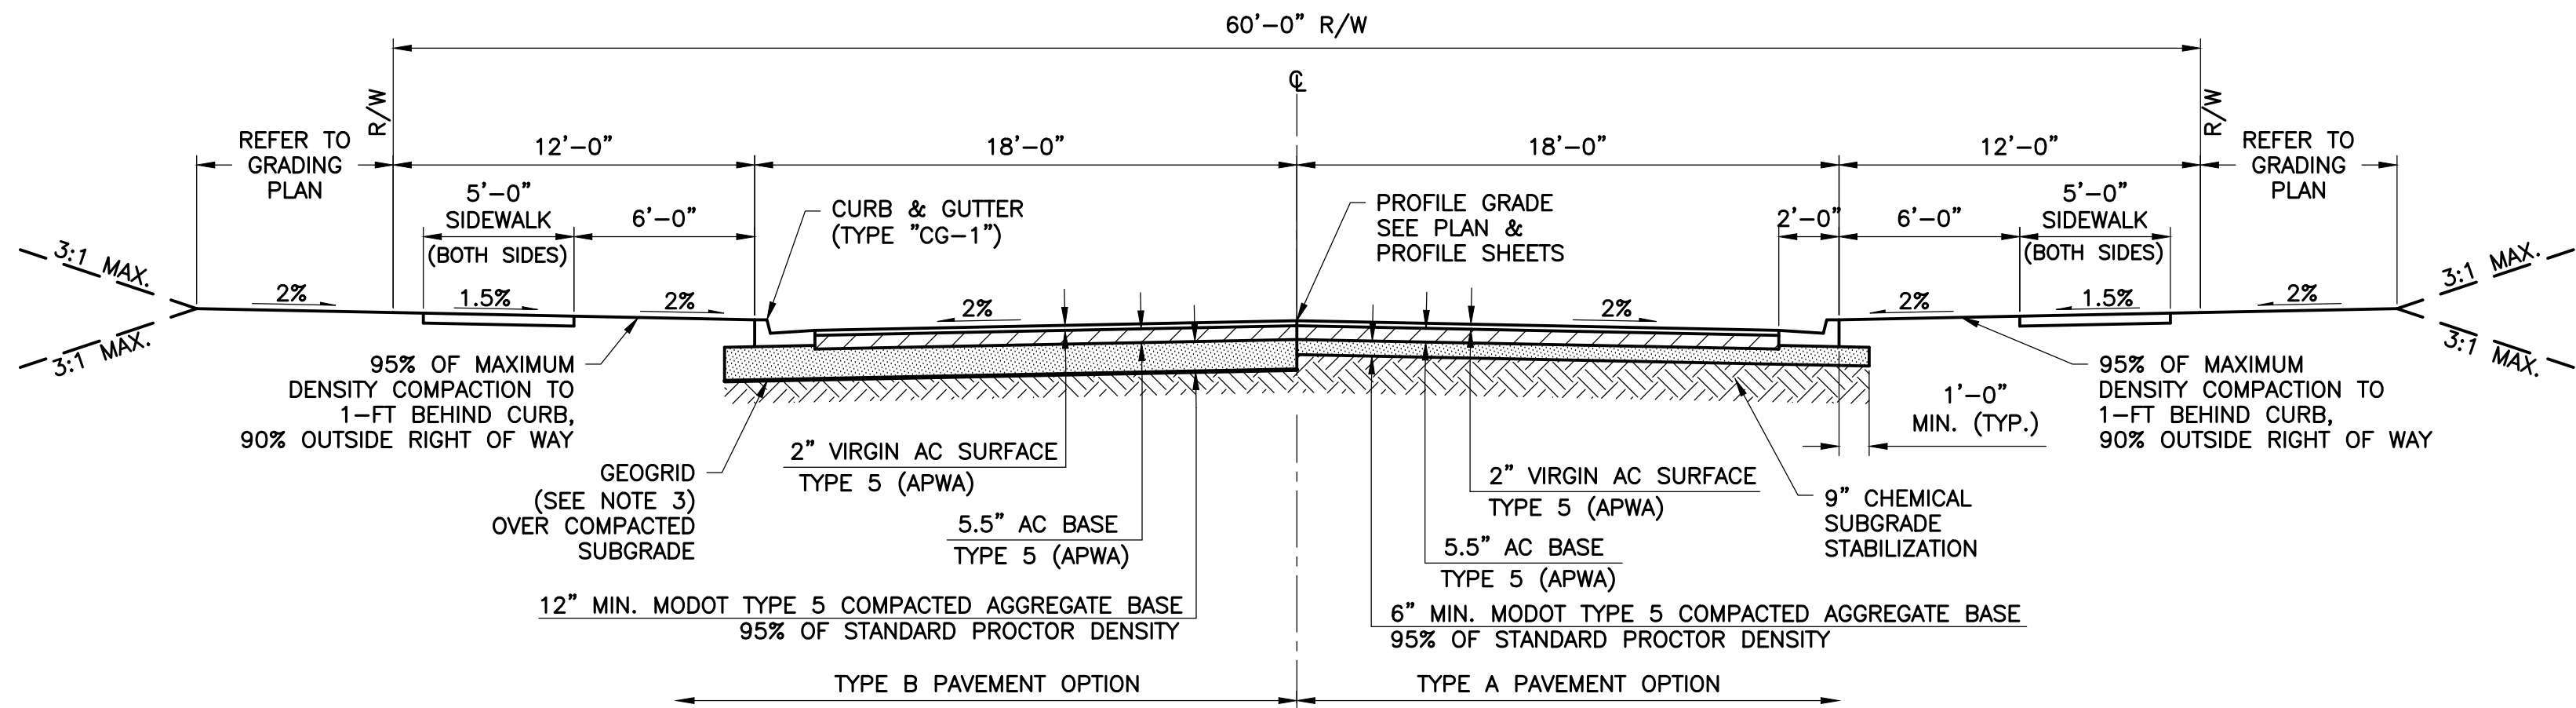

TYPICAL 36' COLLECTOR STREET SECTION
NOT TO SCALE

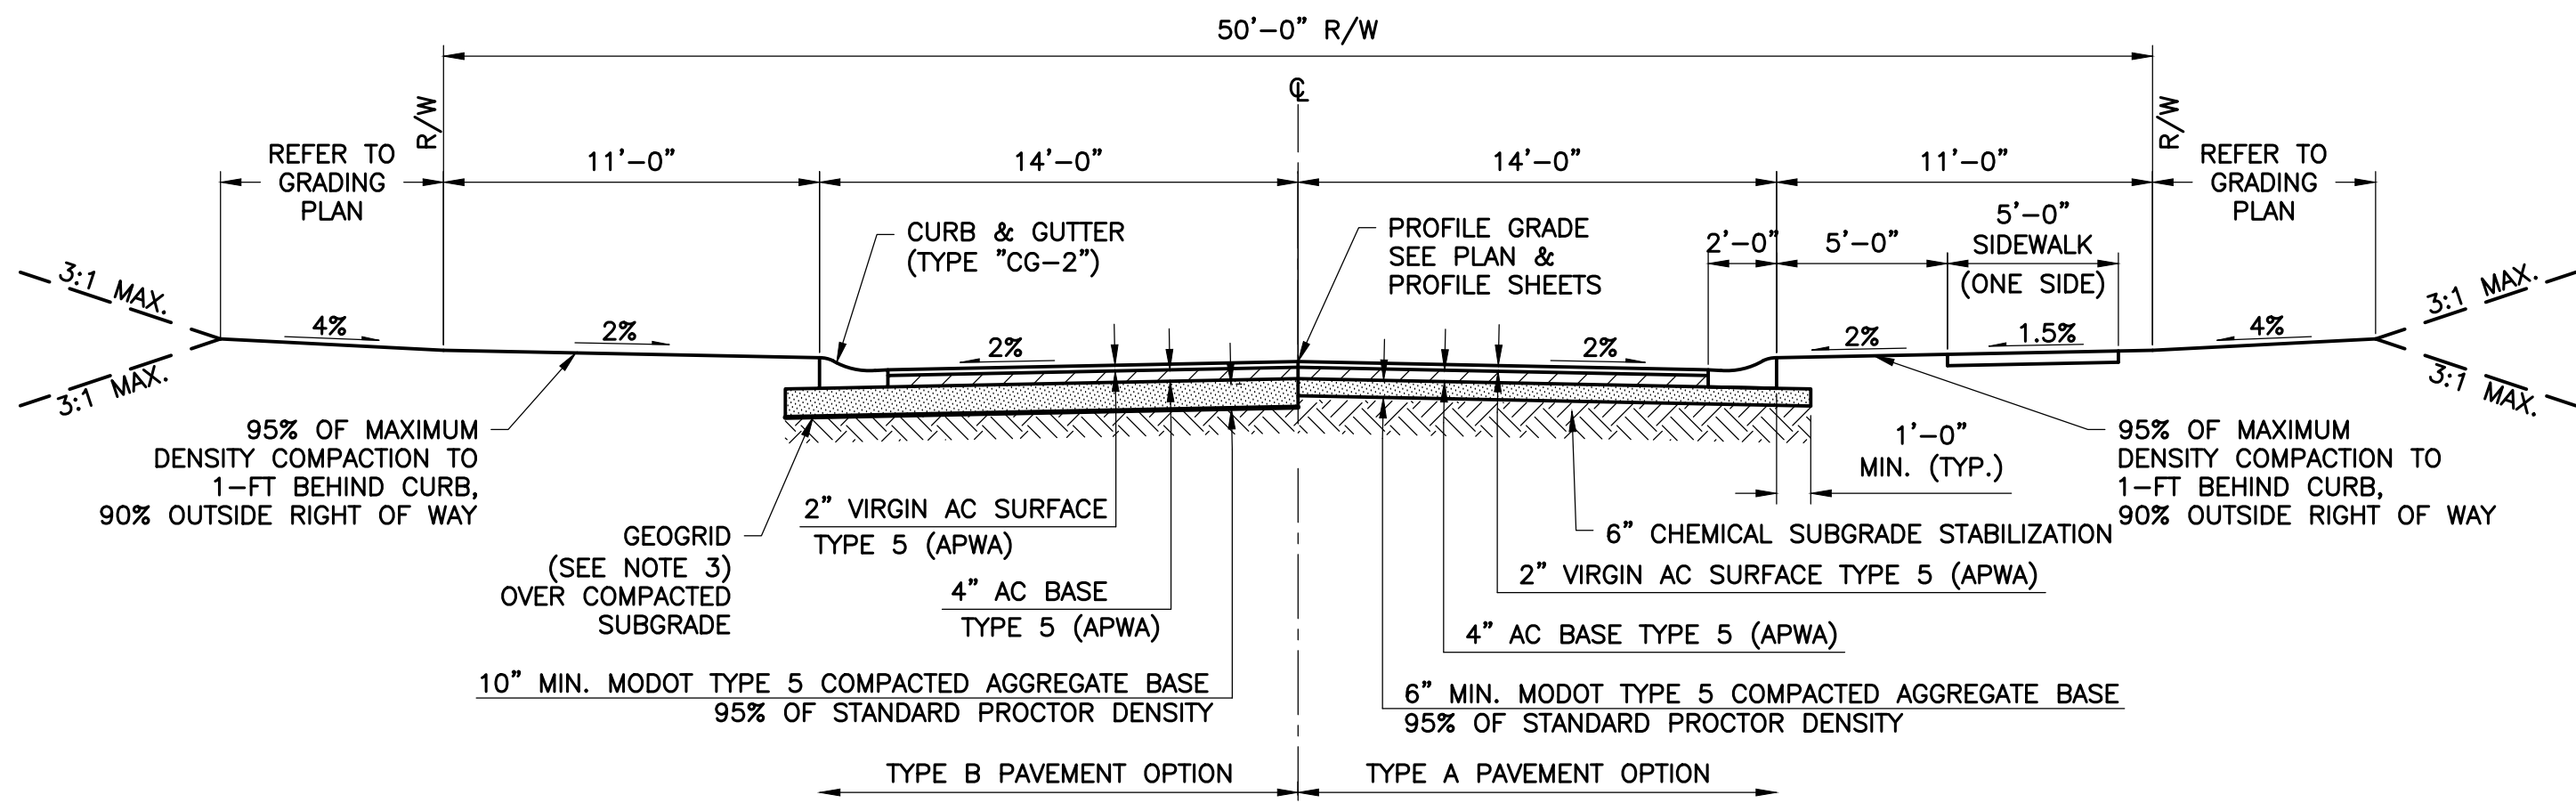

TYPICAL 28' LOCAL/ACCESS STREET SECTION
NOT TO SCALE

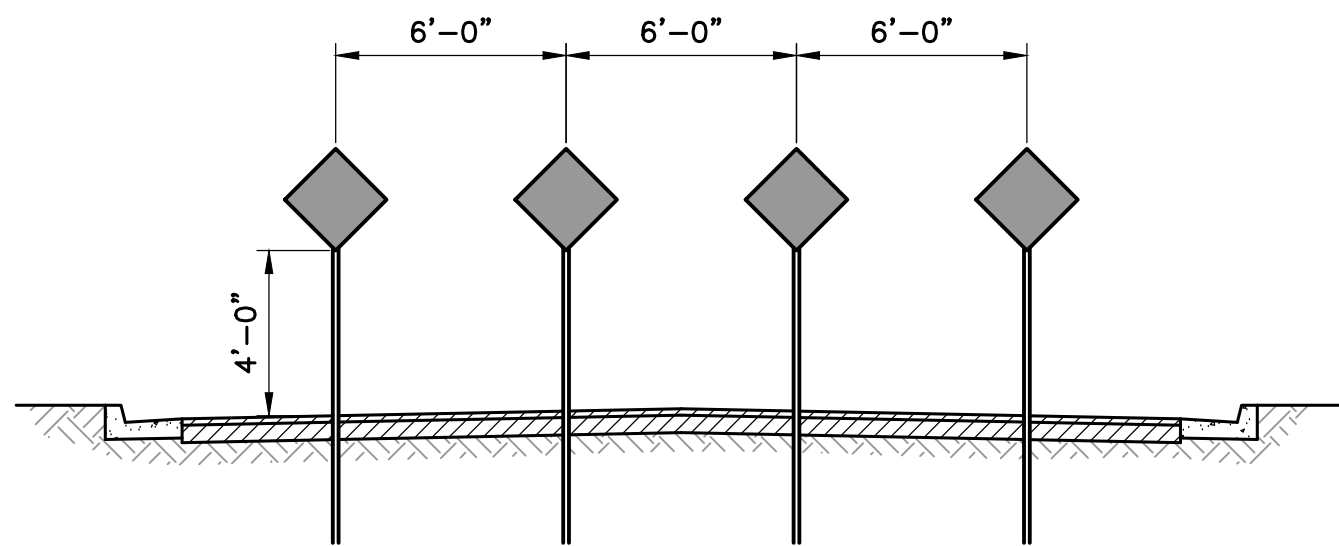

TYPE OM4-3 END PAVEMENT MARKERS
NOT TO SCALE


1. TYPE OM4-3 OBJECT MARKERS (SIZE 18"x18") ARE TO BE INSTALLED AT THE TERMINATION POINTS OF SW MONARCH DR., SW KLINE AVE, AND SW SERENA PL.
2. SIGN INSTALLATION AND MATERIALS TO CONFORM TO THE CITY OF LEE'S SUMMIT STANDARD DESIGN CRITERIA.

GENERAL NOTES


1. REFER TO LEE'S SUMMIT STANDARD DETAIL GEN-4 FOR CURB SECTIONS AND ADDITIONAL NOTES. SEE SHEET 28 OF 31.
2. GEOGRID MUST MEET SPECIFICATIONS OF LEE'S SUMMIT SECTION 2200, 2201.6.C.
3. MATERIAL DEPTHS PROVIDED ARE CITY'S ABSOLUTE MINIMUM ACCEPTABLE DEPTHS.
4. ALL SIDEWALK SHOWN ALONG TRACTS SHALL BE CONSTRUCTED DURING PUBLIC INFRASTRUCTURE CONSTRUCTION.
5. ADA ACCESSIBLE RAMP SHALL BE CONSTRUCTED DURING PUBLIC INFRASTRUCTURE CONSTRUCTION.

DRAWN BY JAM	DESIGNED BY MDM	DATE 09-19-2018	JOB NUMBER-TASKS 0318050.01	BOOK AND PAGE
REVISIONS				
08/19/18 - RESUBMITAL PER ADJUSTED LAYOUT				
09/19/18 - RESUBMITAL PER CITY COMMENTS				
9001 State Line Rd., Suite 200, 816.361.0440 P Kansas City, Missouri 64114 816.361.0045 F www.LRA-Inc.com				
LARKIN/ LAMP RYNEARSON				
SUMMIT VIEW FARMS 3RD PLAT LEE'S SUMMIT, MISSOURI				
MASS GRADING, EROSION CONTROL, PAVING, STORM AND SANITARY PLANS TYPICAL STREET SECTION AND DETAILS SHEET				
LARKIN LAMP RYNEARSON - ENGINEERS LMO Certificate of Authority No. 2013011803				
MARK DANIEL MCGHEE JR. PE - 2008019568				
SHEET				
14 OF 31				

L:\Engineering\031959 SVF03 Summit View Farms 3rd Plat\Drawings\CONSTRUCTION DRAWINGS\PAV-PLANS\PAV-PNP-01.dwg, 2/4/2020 1:44:01 PM, DAN MCGHEE, LAMP RYNEARSON & ASSOCIATES

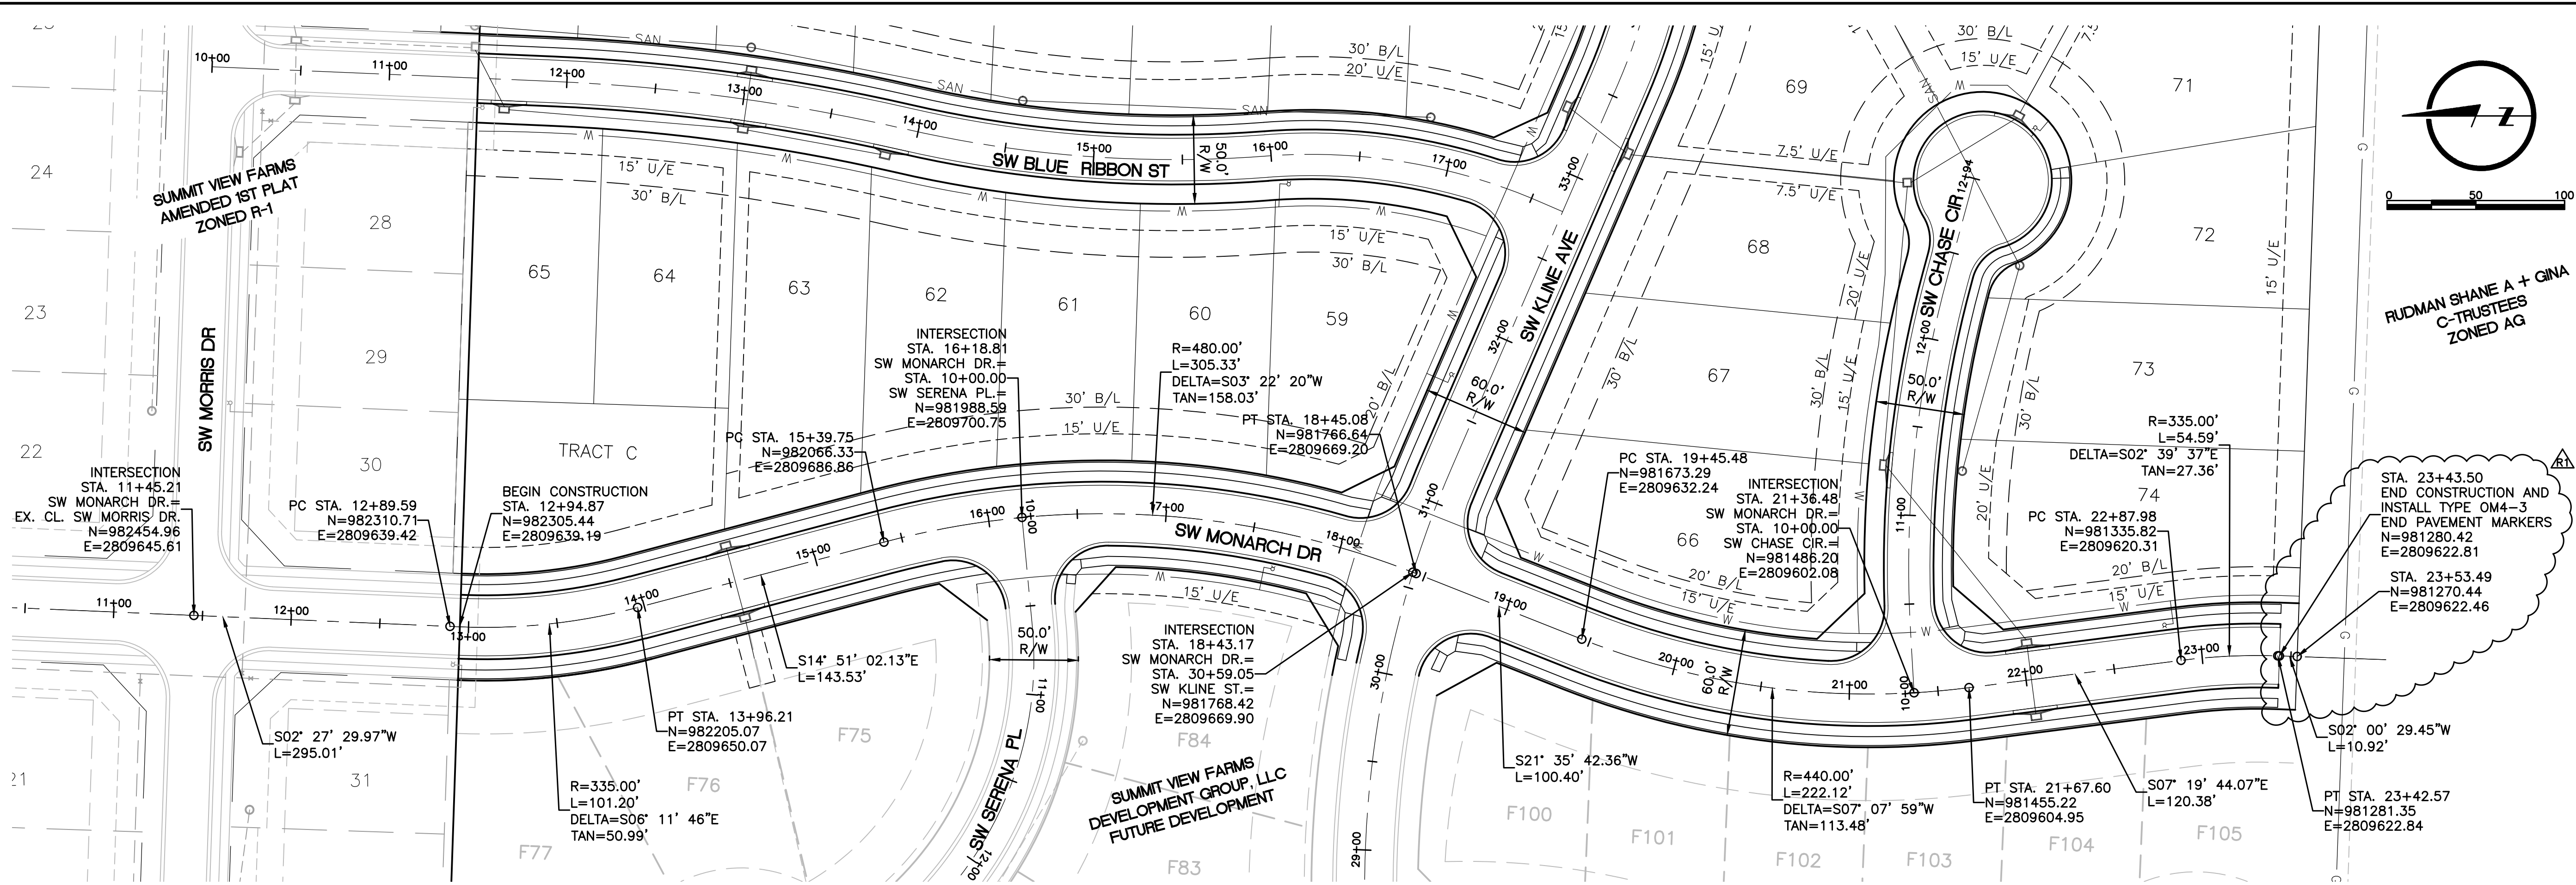


SW MONARCH DR

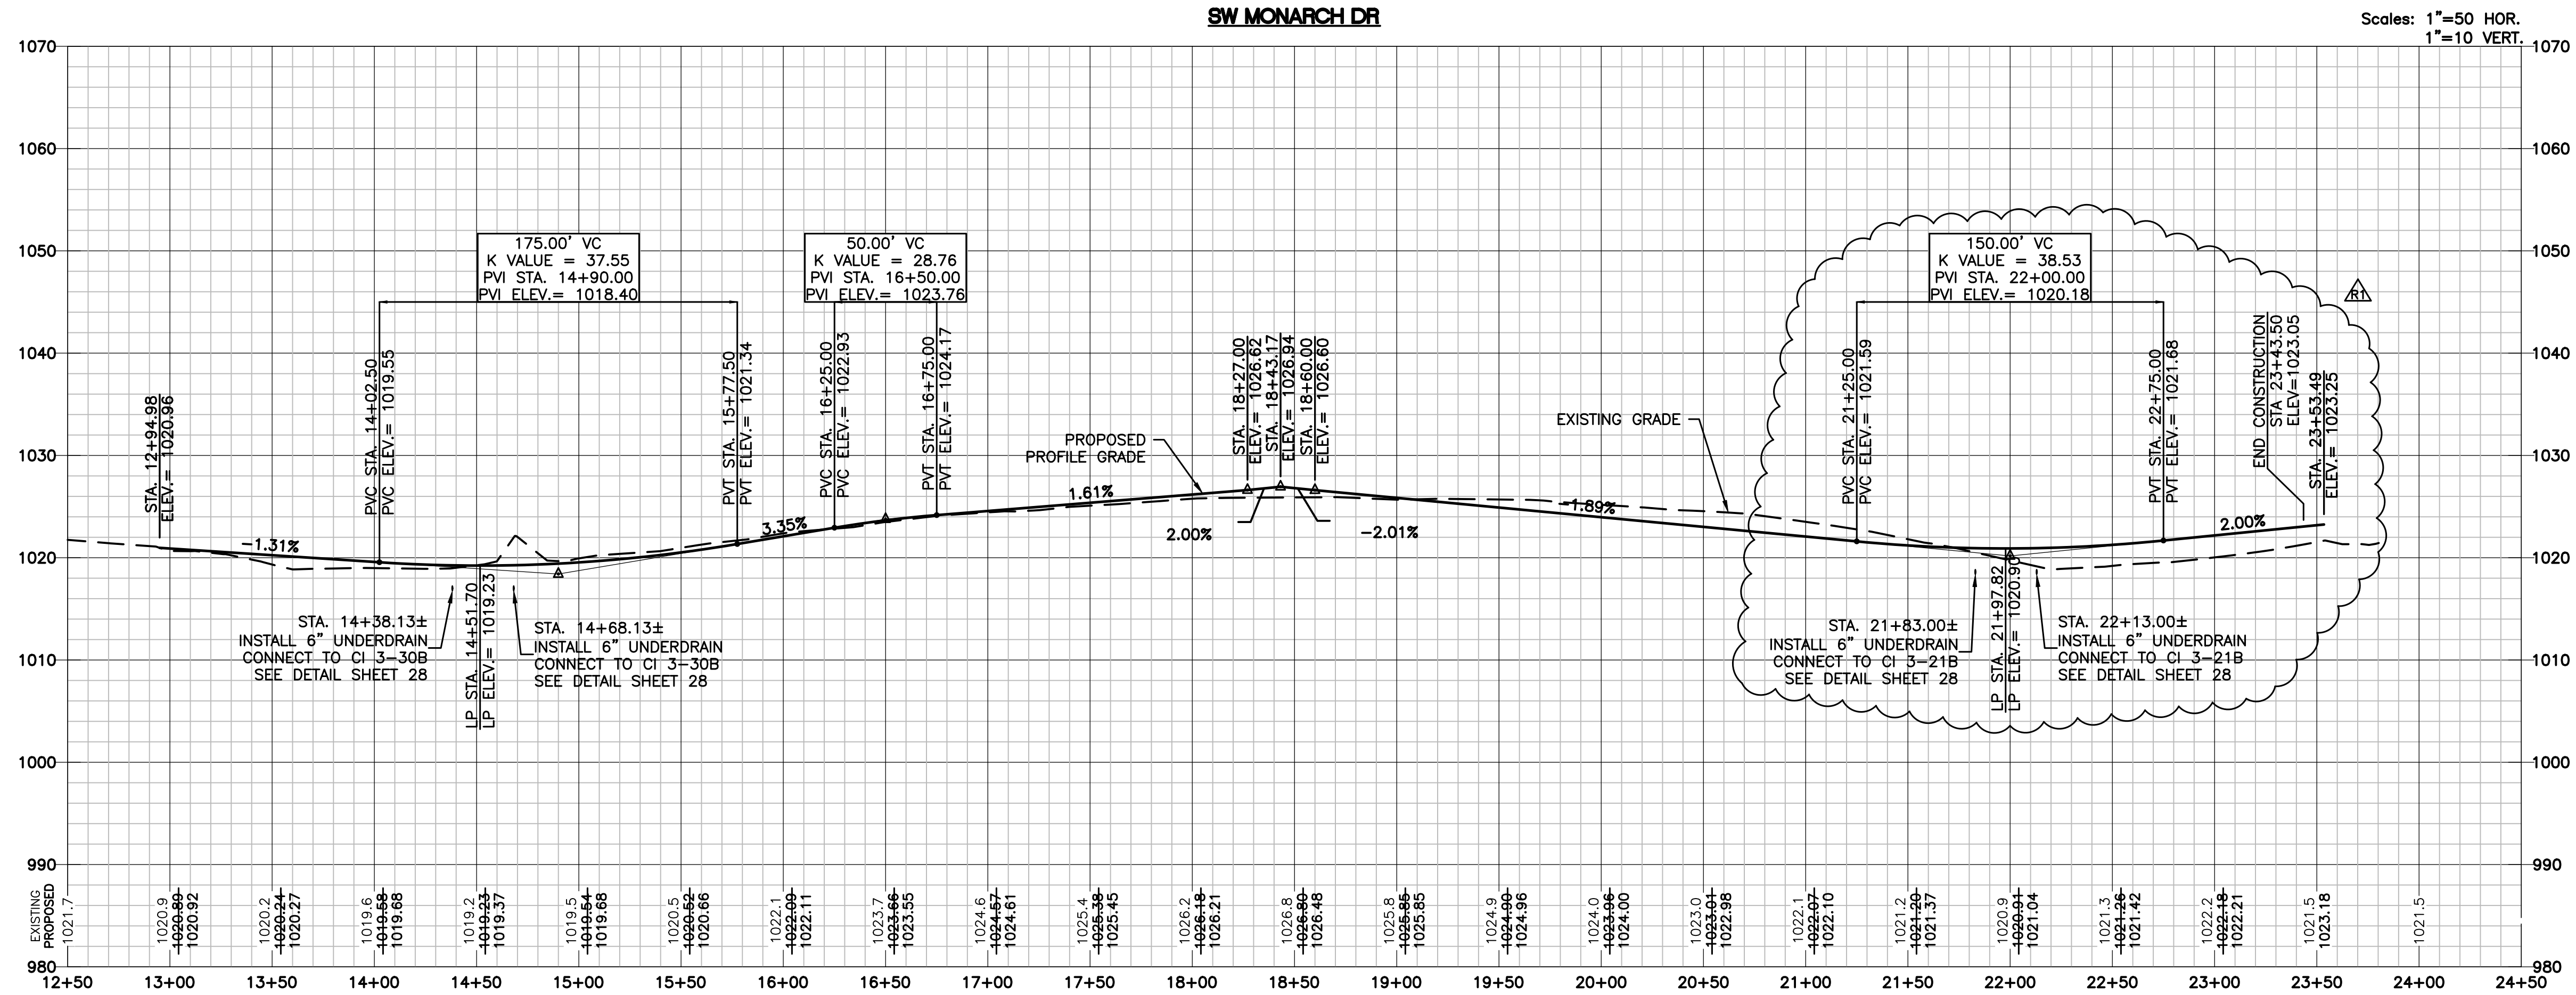



DRAWN BY JAM	DESIGNED BY MDM	DATE 03/07/19	JOB NUMBER-TASKS 09-19-2018 02-04-2020 - AS-BUILT	BOOK AND PAGE 031959.01
REVISIONS 08/19/18 - RESUBMITAL PER ADJUSTED LAYOUT 09/19/18 - RESUBMITAL PER CITY COMMENTS 03/07/19 - REVISION 1 02-04-2020 - AS-BUILT				
9001 State Line Rd, Suite 200, 816.961.0440 P Kansas City, Missouri 64114 816.961.0045 F www.LRA-inc.com				
LARKIN/ LAMP RYNEARSON				
SUMMIT VIEW FARMS 3RD PLAT LEE'S SUMMIT, MISSOURI				
MASS GRADING, EROSION CONTROL, PAVING, STORM AND SANITARY PLANS SW MONARCH DRIVE STREET PLAN/PROFILE SHEET				
LARKIN LAMP RYNEARSON - ENGINEERS TMO Certificate of Authority No. 2013011903				
STATE OF MISSOURI MARK DANIEL MCGHEE JR. REGISTERED PROFESSIONAL ENGINEER FE-2008019568 02-04-2020				
MARK DANIEL MCGHEE JR. PE - 2008019568				
SHEET				
15 OF 31				

L:\Engineering\031959 SVF03 Summit View Farms 3rd Plat\Drawings\CONSTRUCTION DRAWINGS\PAV-PLANS\PAV-PNP-02.dwg, 2/4/2020 1:46:39 PM, DAN MCGHEE, LAMP RYNEARSON & ASSOCIATES

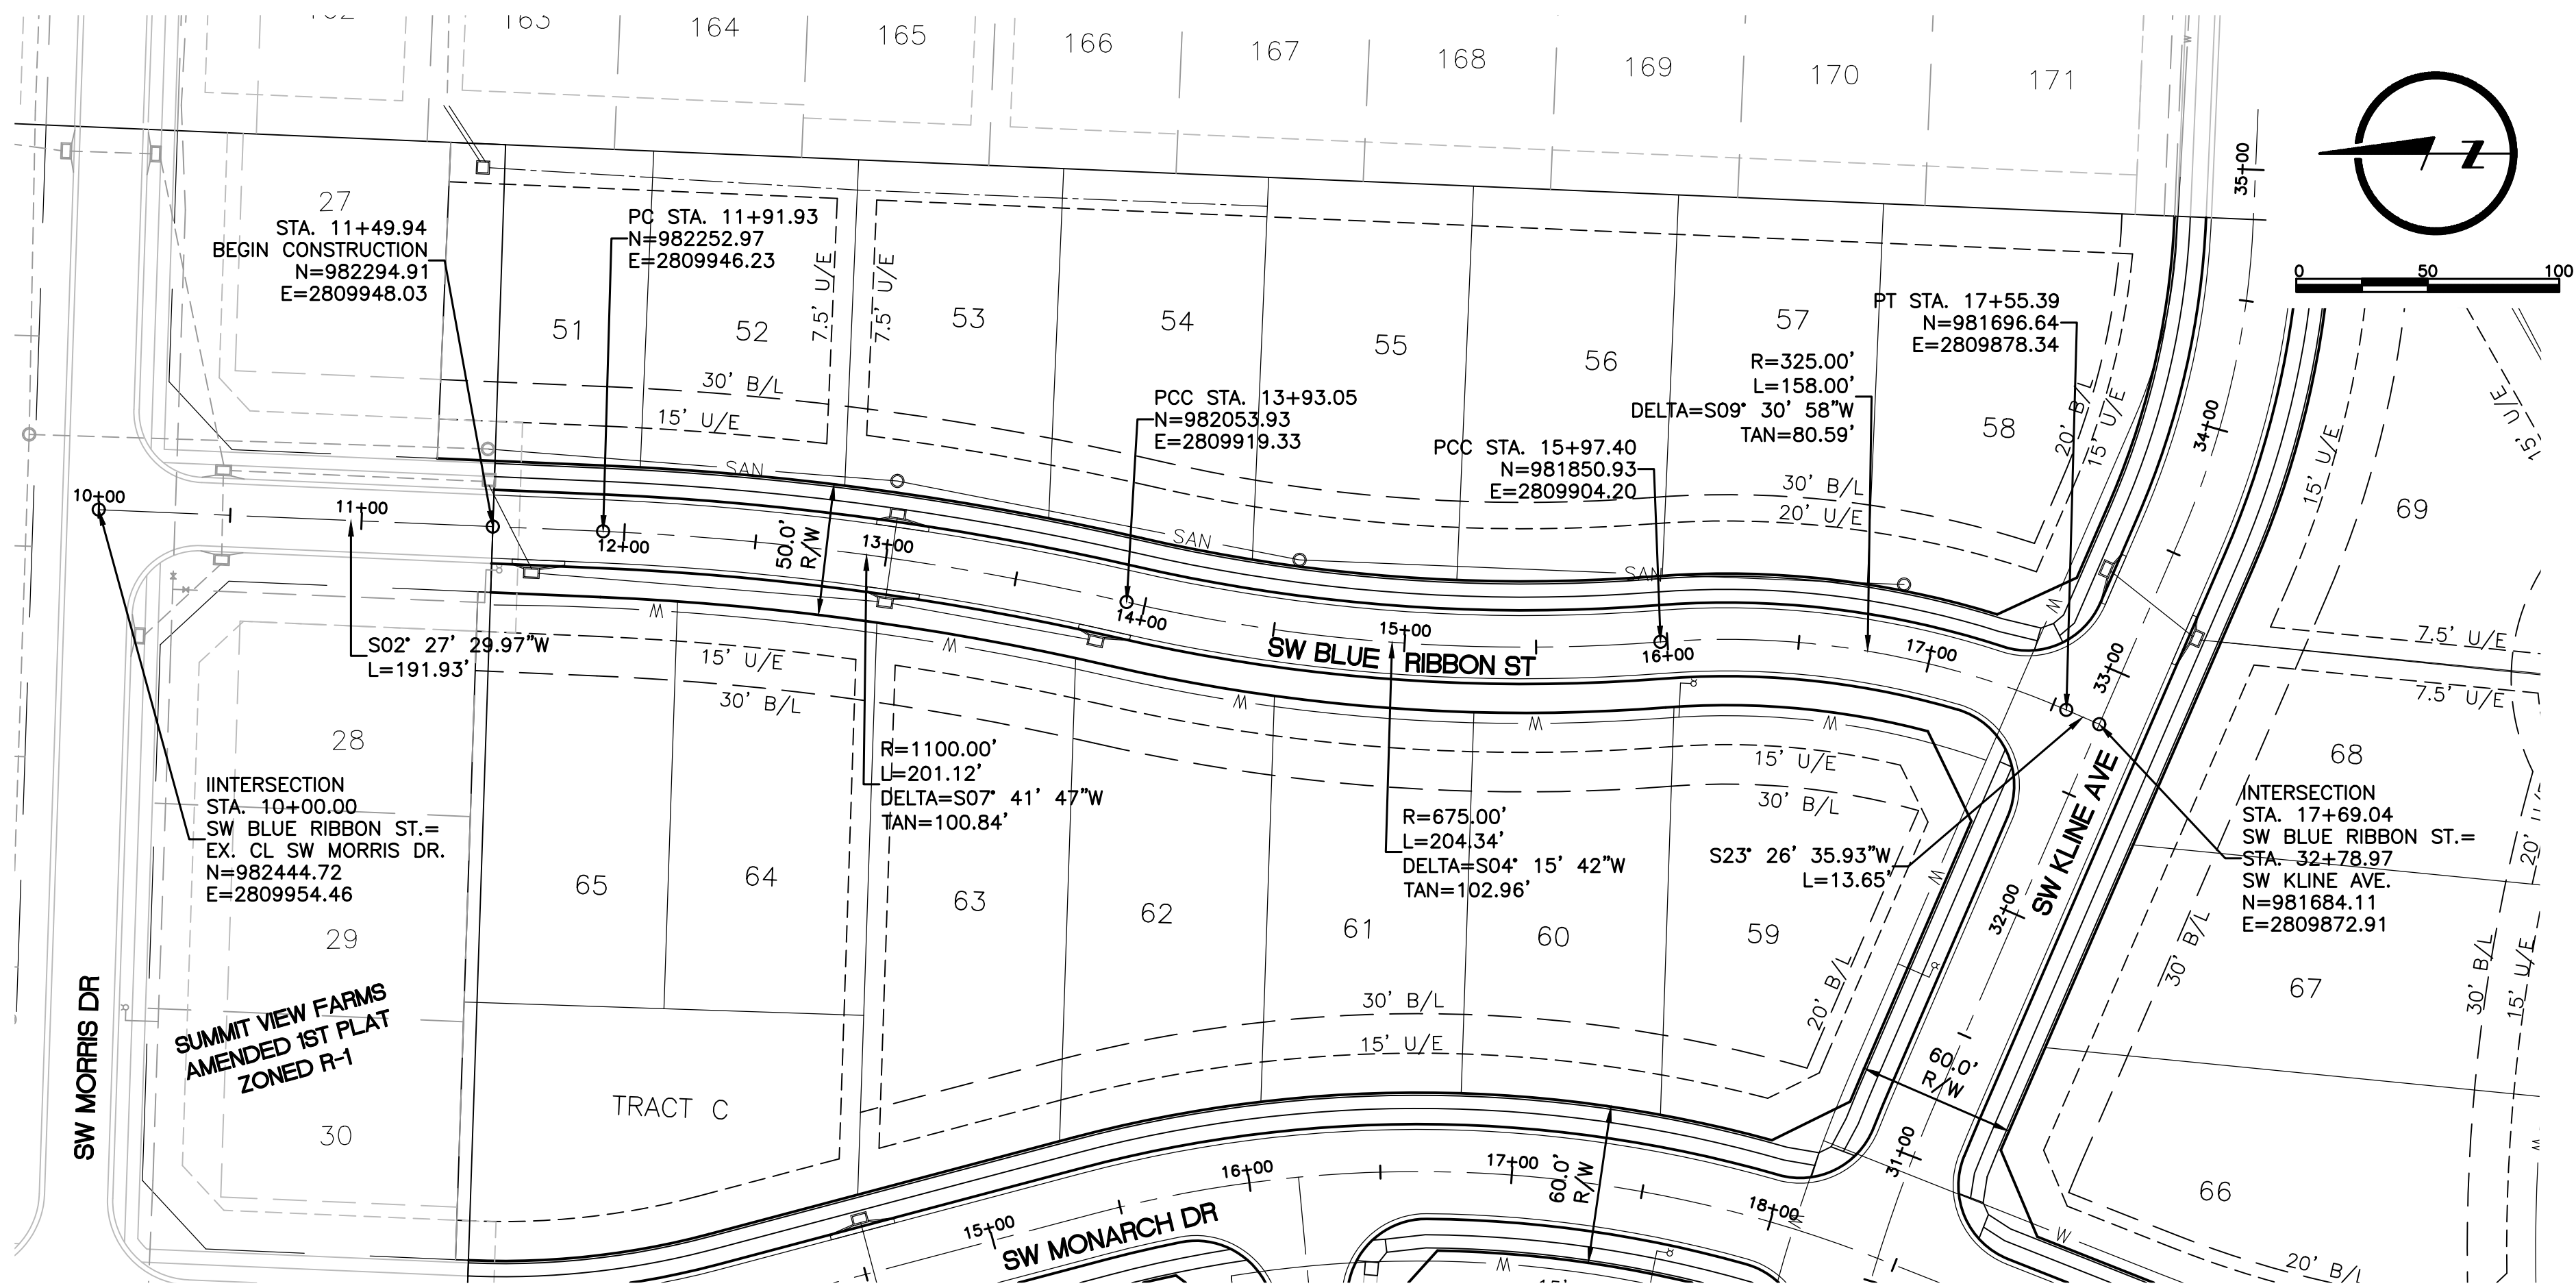


SW BLUE RIBBON ST

Scales: 1"=50 HOR.
1"=10 VERT.

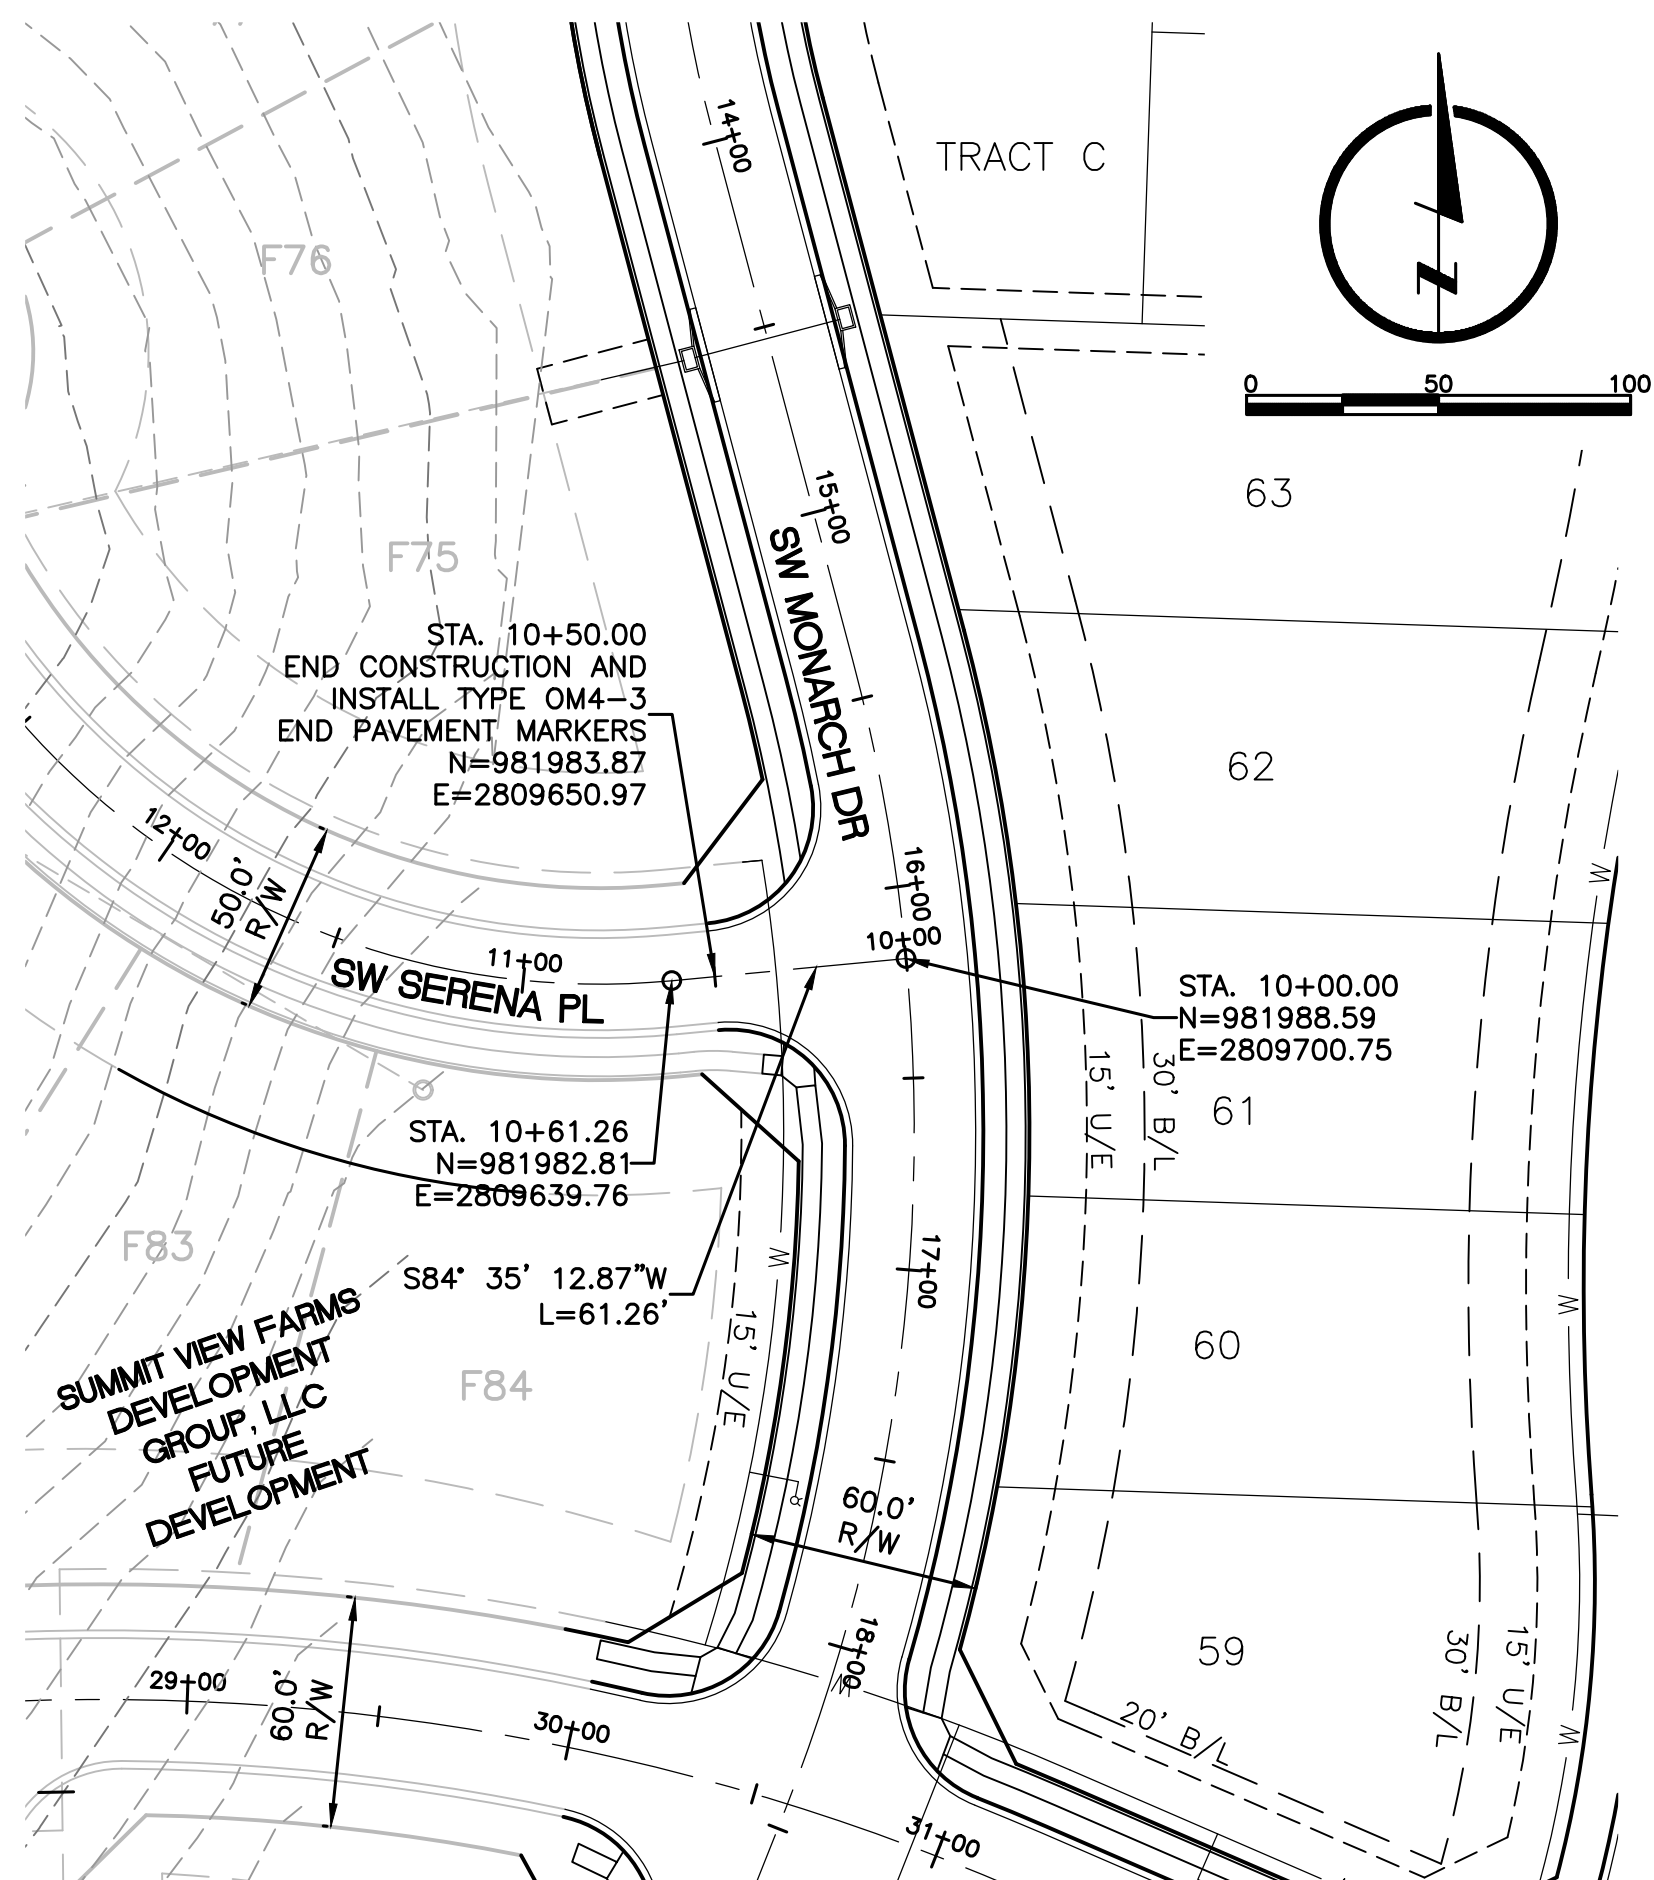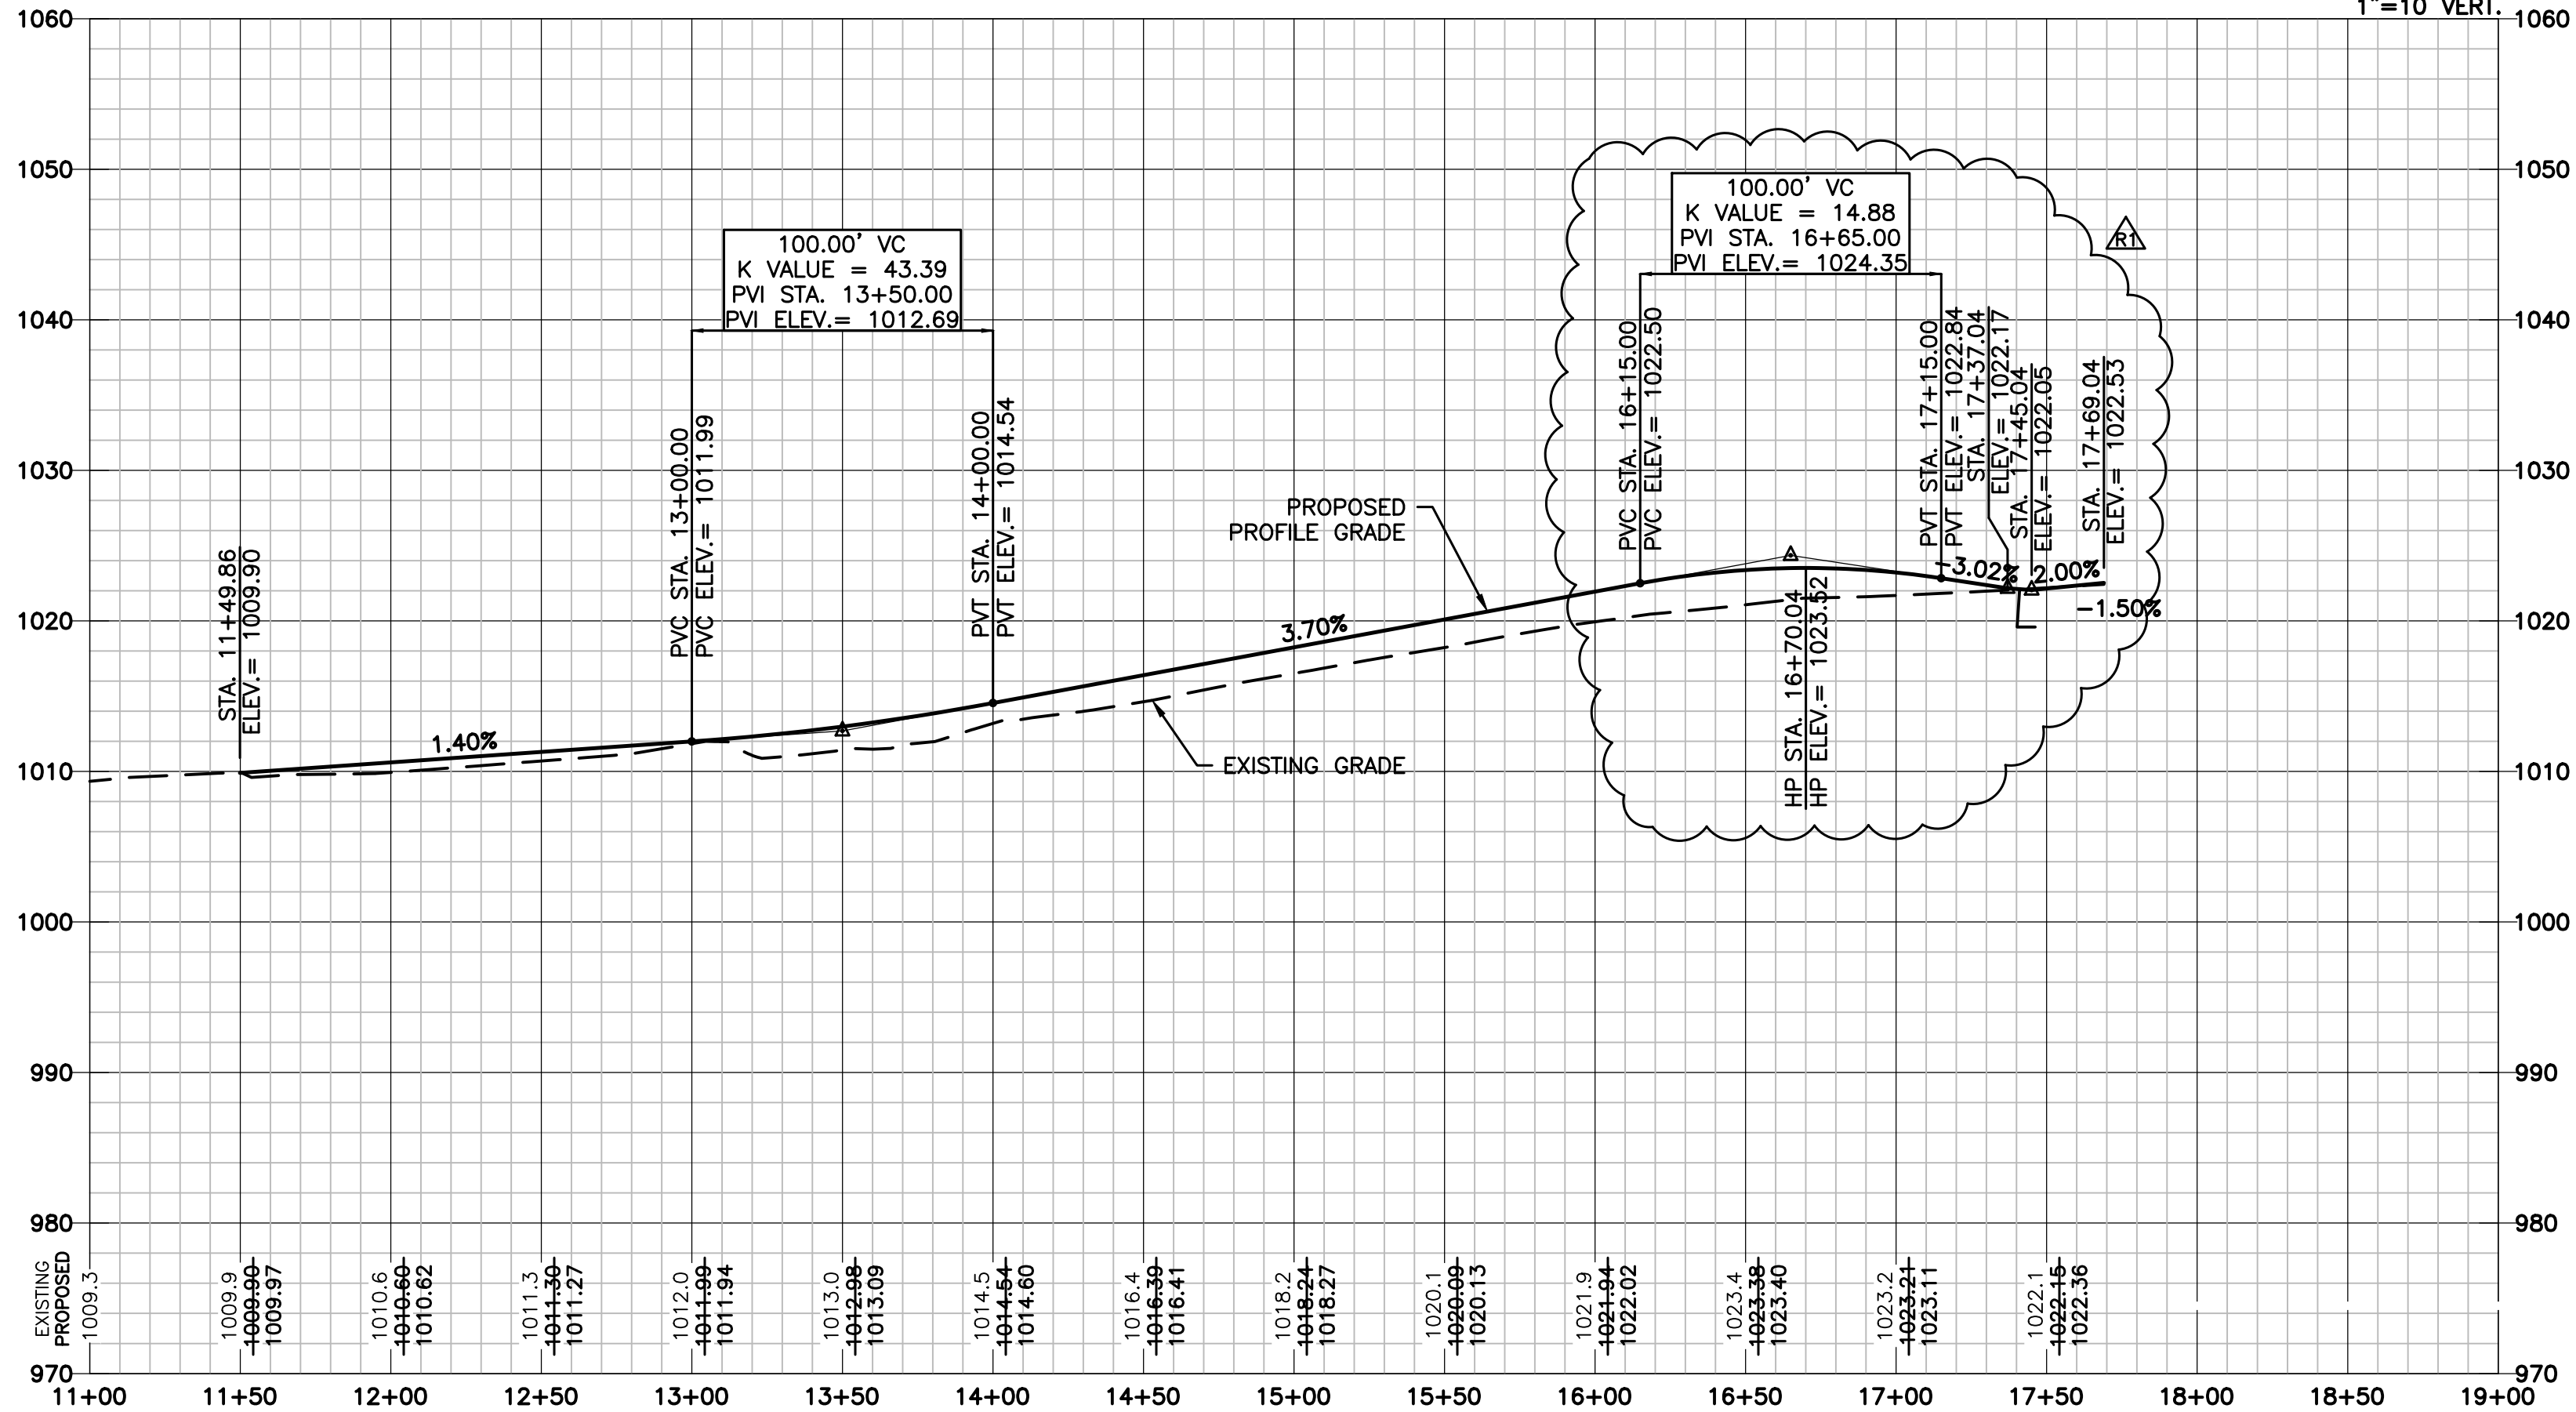

SW SERENA PL

Scales: 1"=50 HOR.
1"=10 VERT.

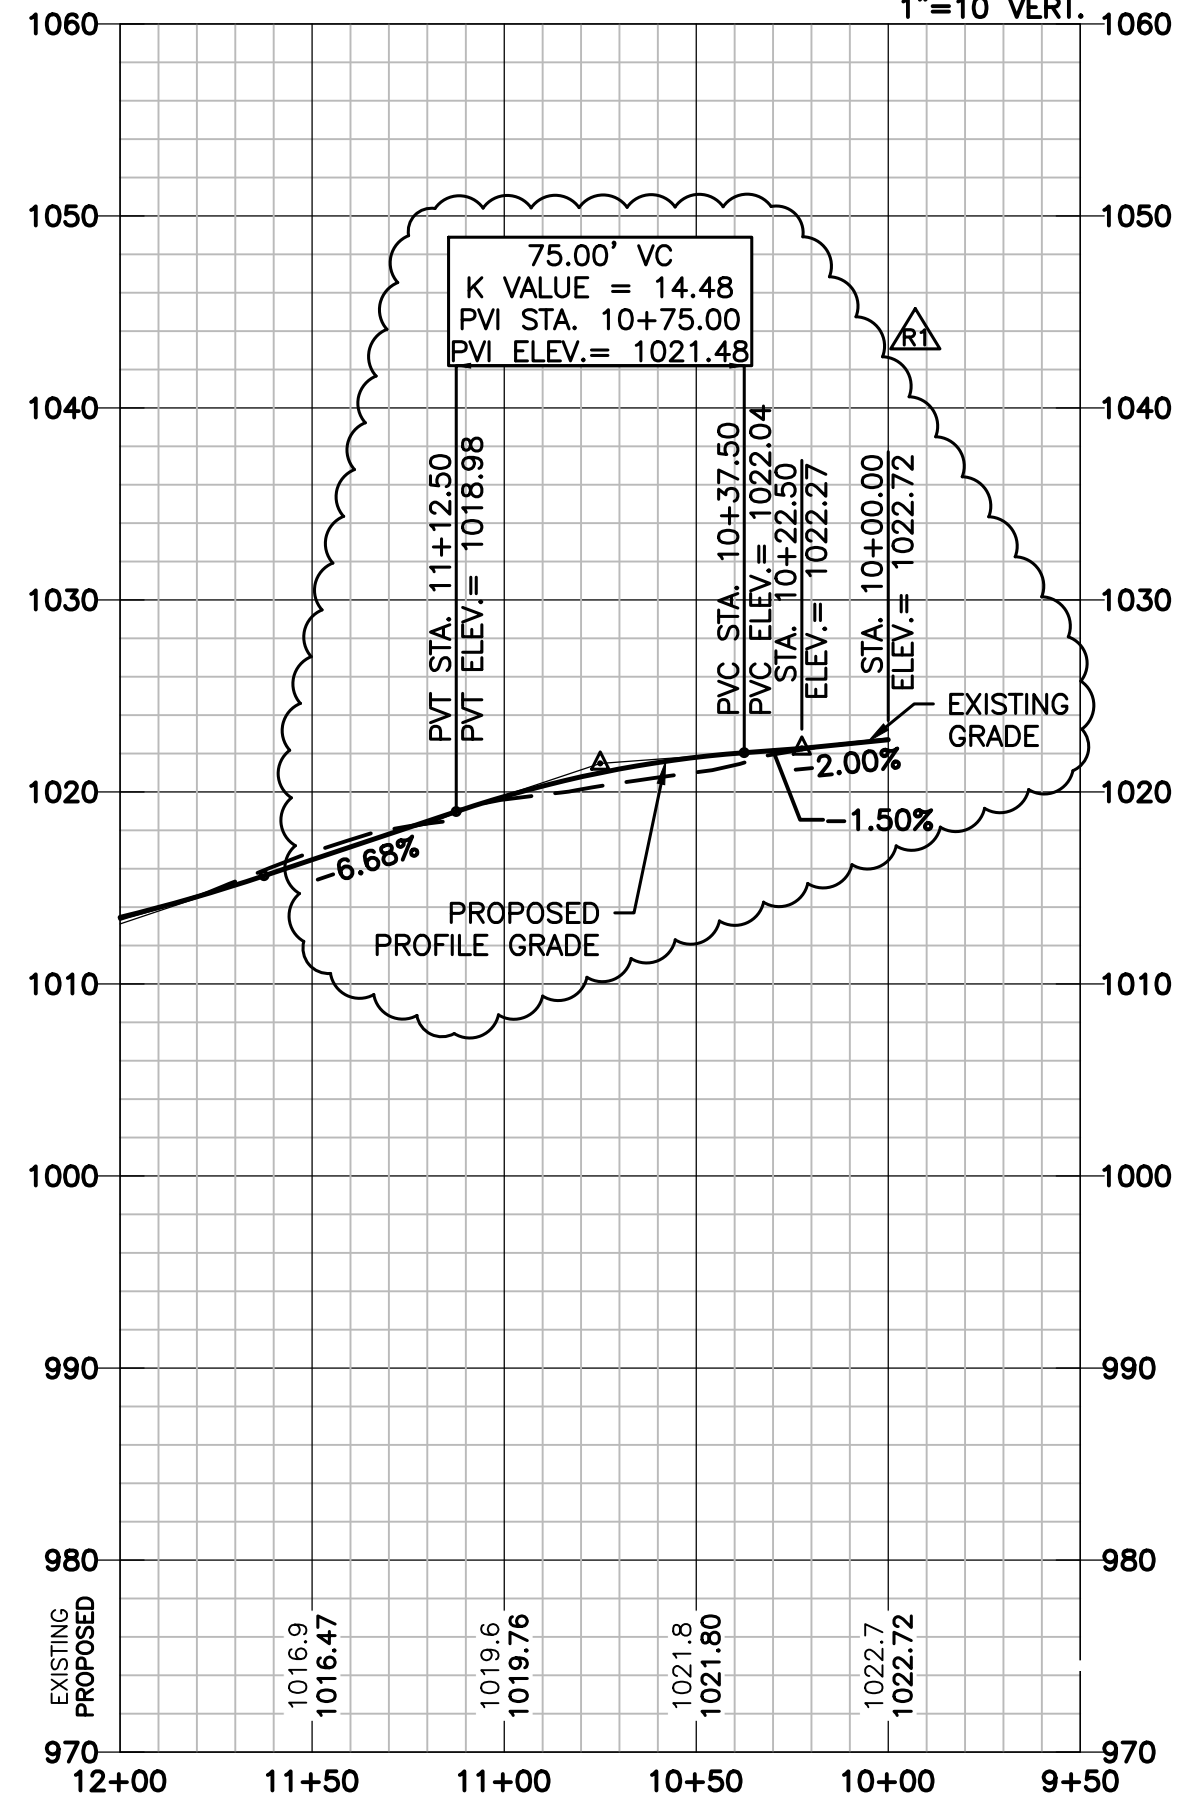

MASS GRADING, EROSION CONTROL,
PAVING, STORM AND SANITARY PLANS
SW BLUE RIBBON STREET
STREET PLAN/PROFILE SHEET

LARKIN LAMP RYNEARSON - ENGINEERS
LMO Certificate of Authority No. 2013011903







02-04-2020

MARK DANIEL MCGHEE, JR.




PE - 2008019568

SHEET

L:\Engineering\031959 SVF03 Summit View Farms 3rd Plat\Drawings\CONSTRUCTION DRAWINGS\PAV-PLANS\PAV-PNP-03.dwg, 2/4/2020 1:48:46 PM, DAN MCGHEE, LAMP RYNEARSON & ASSOCIATES

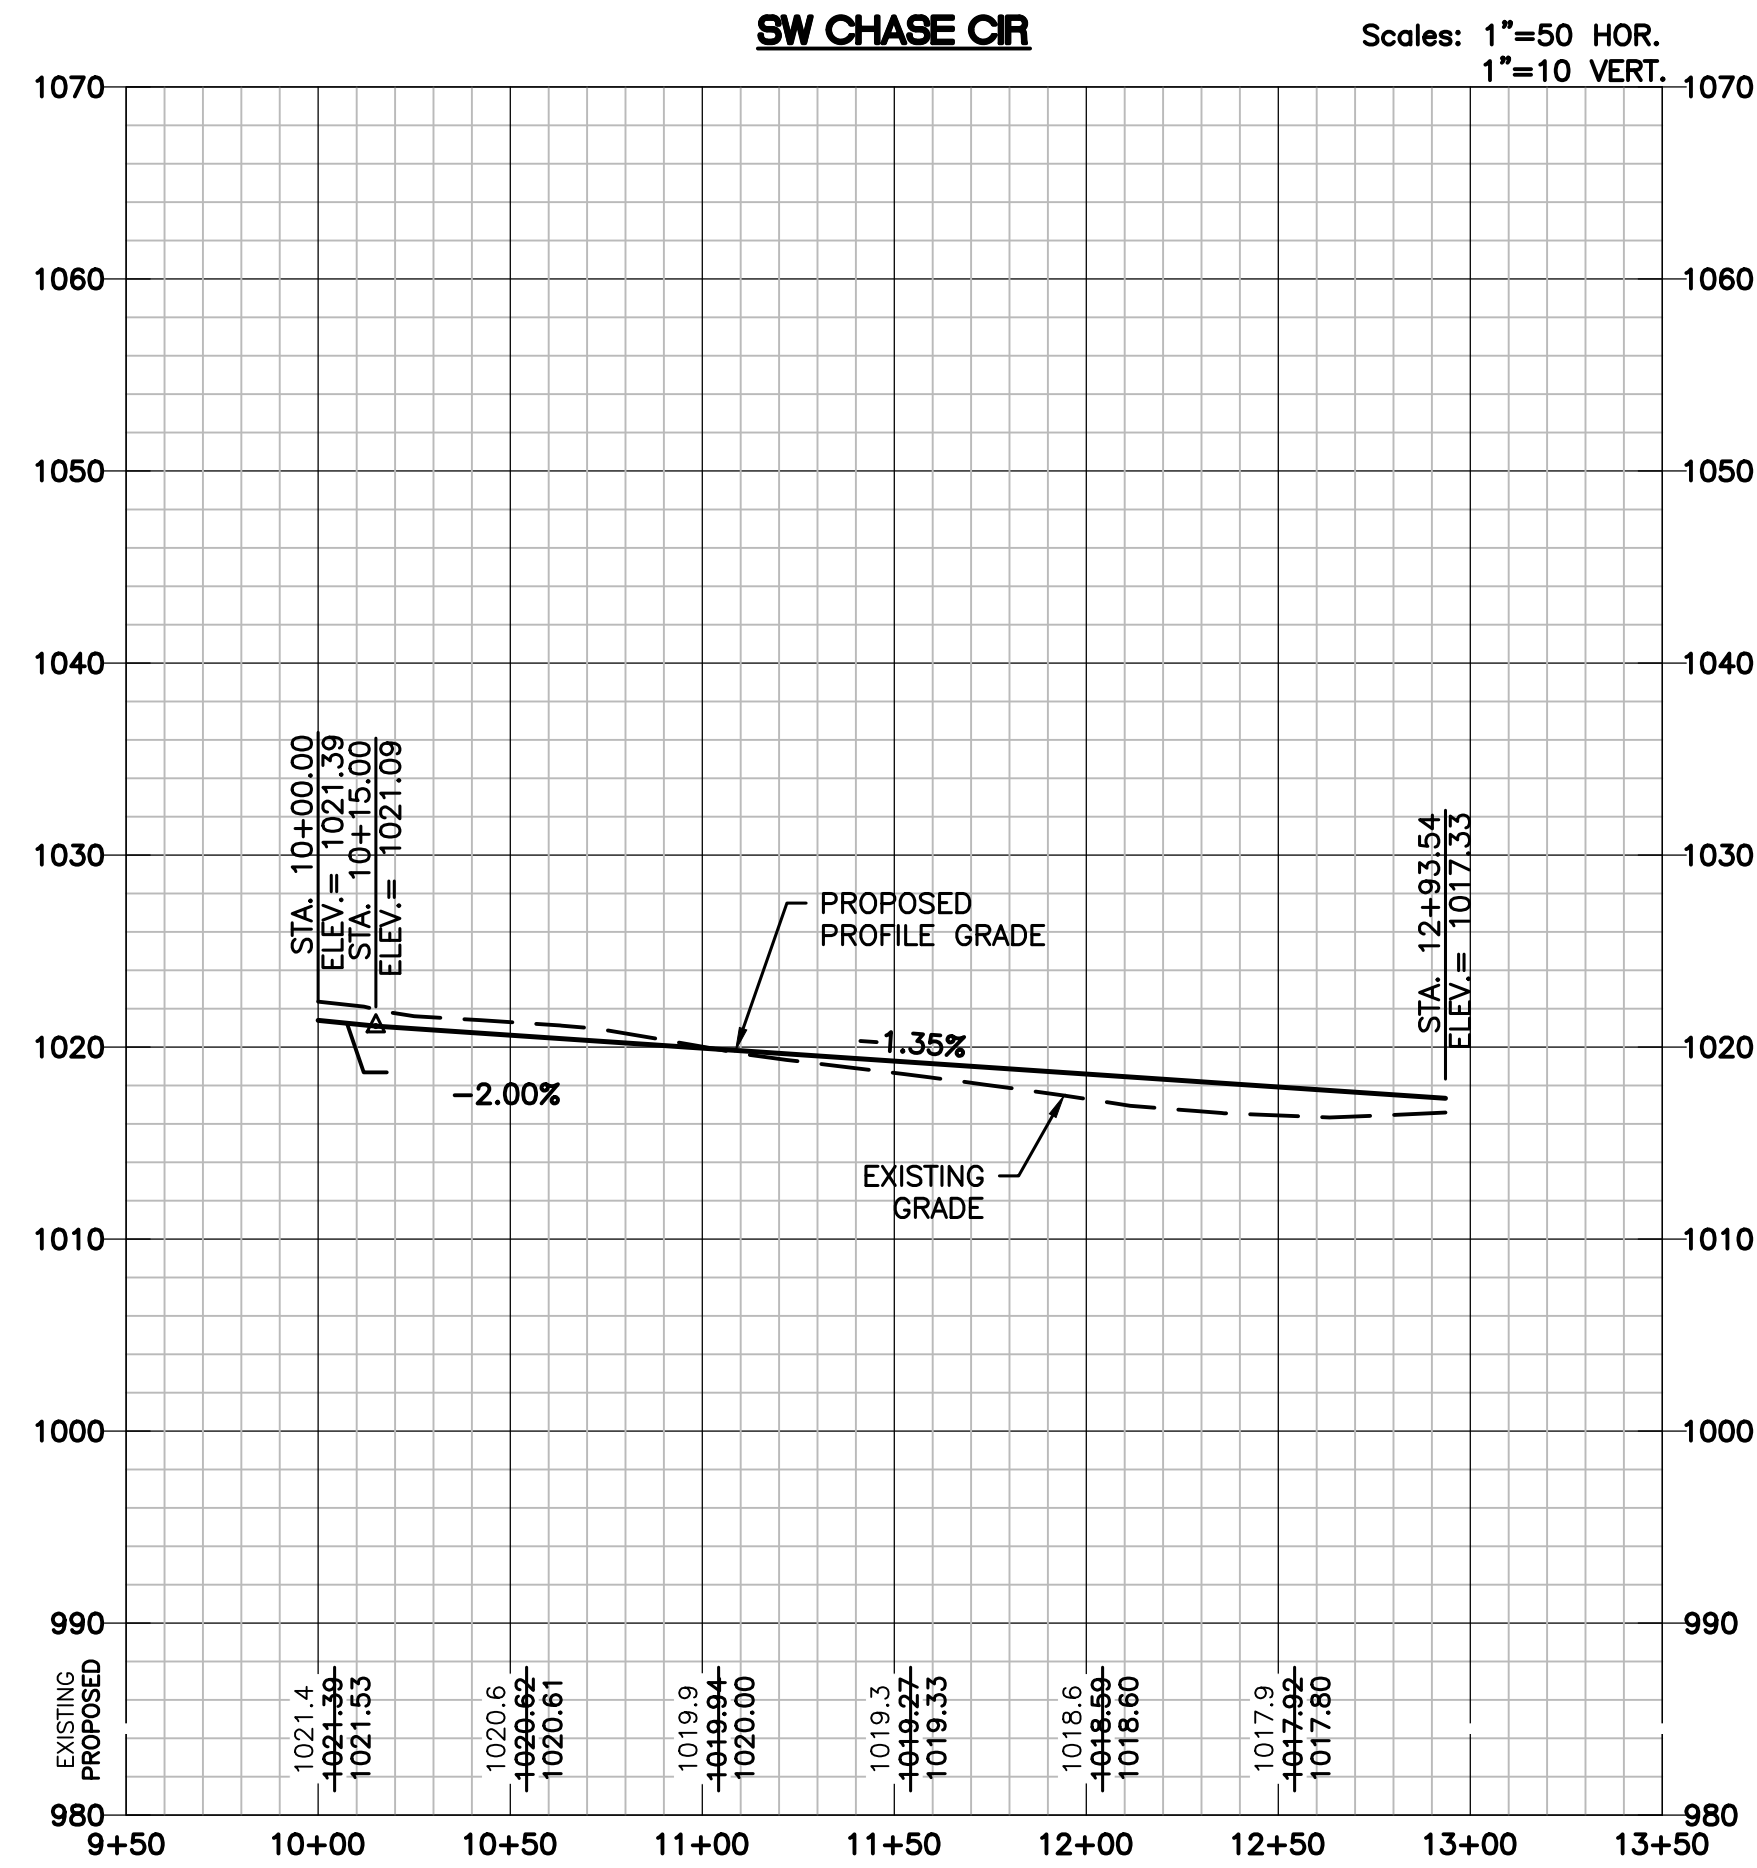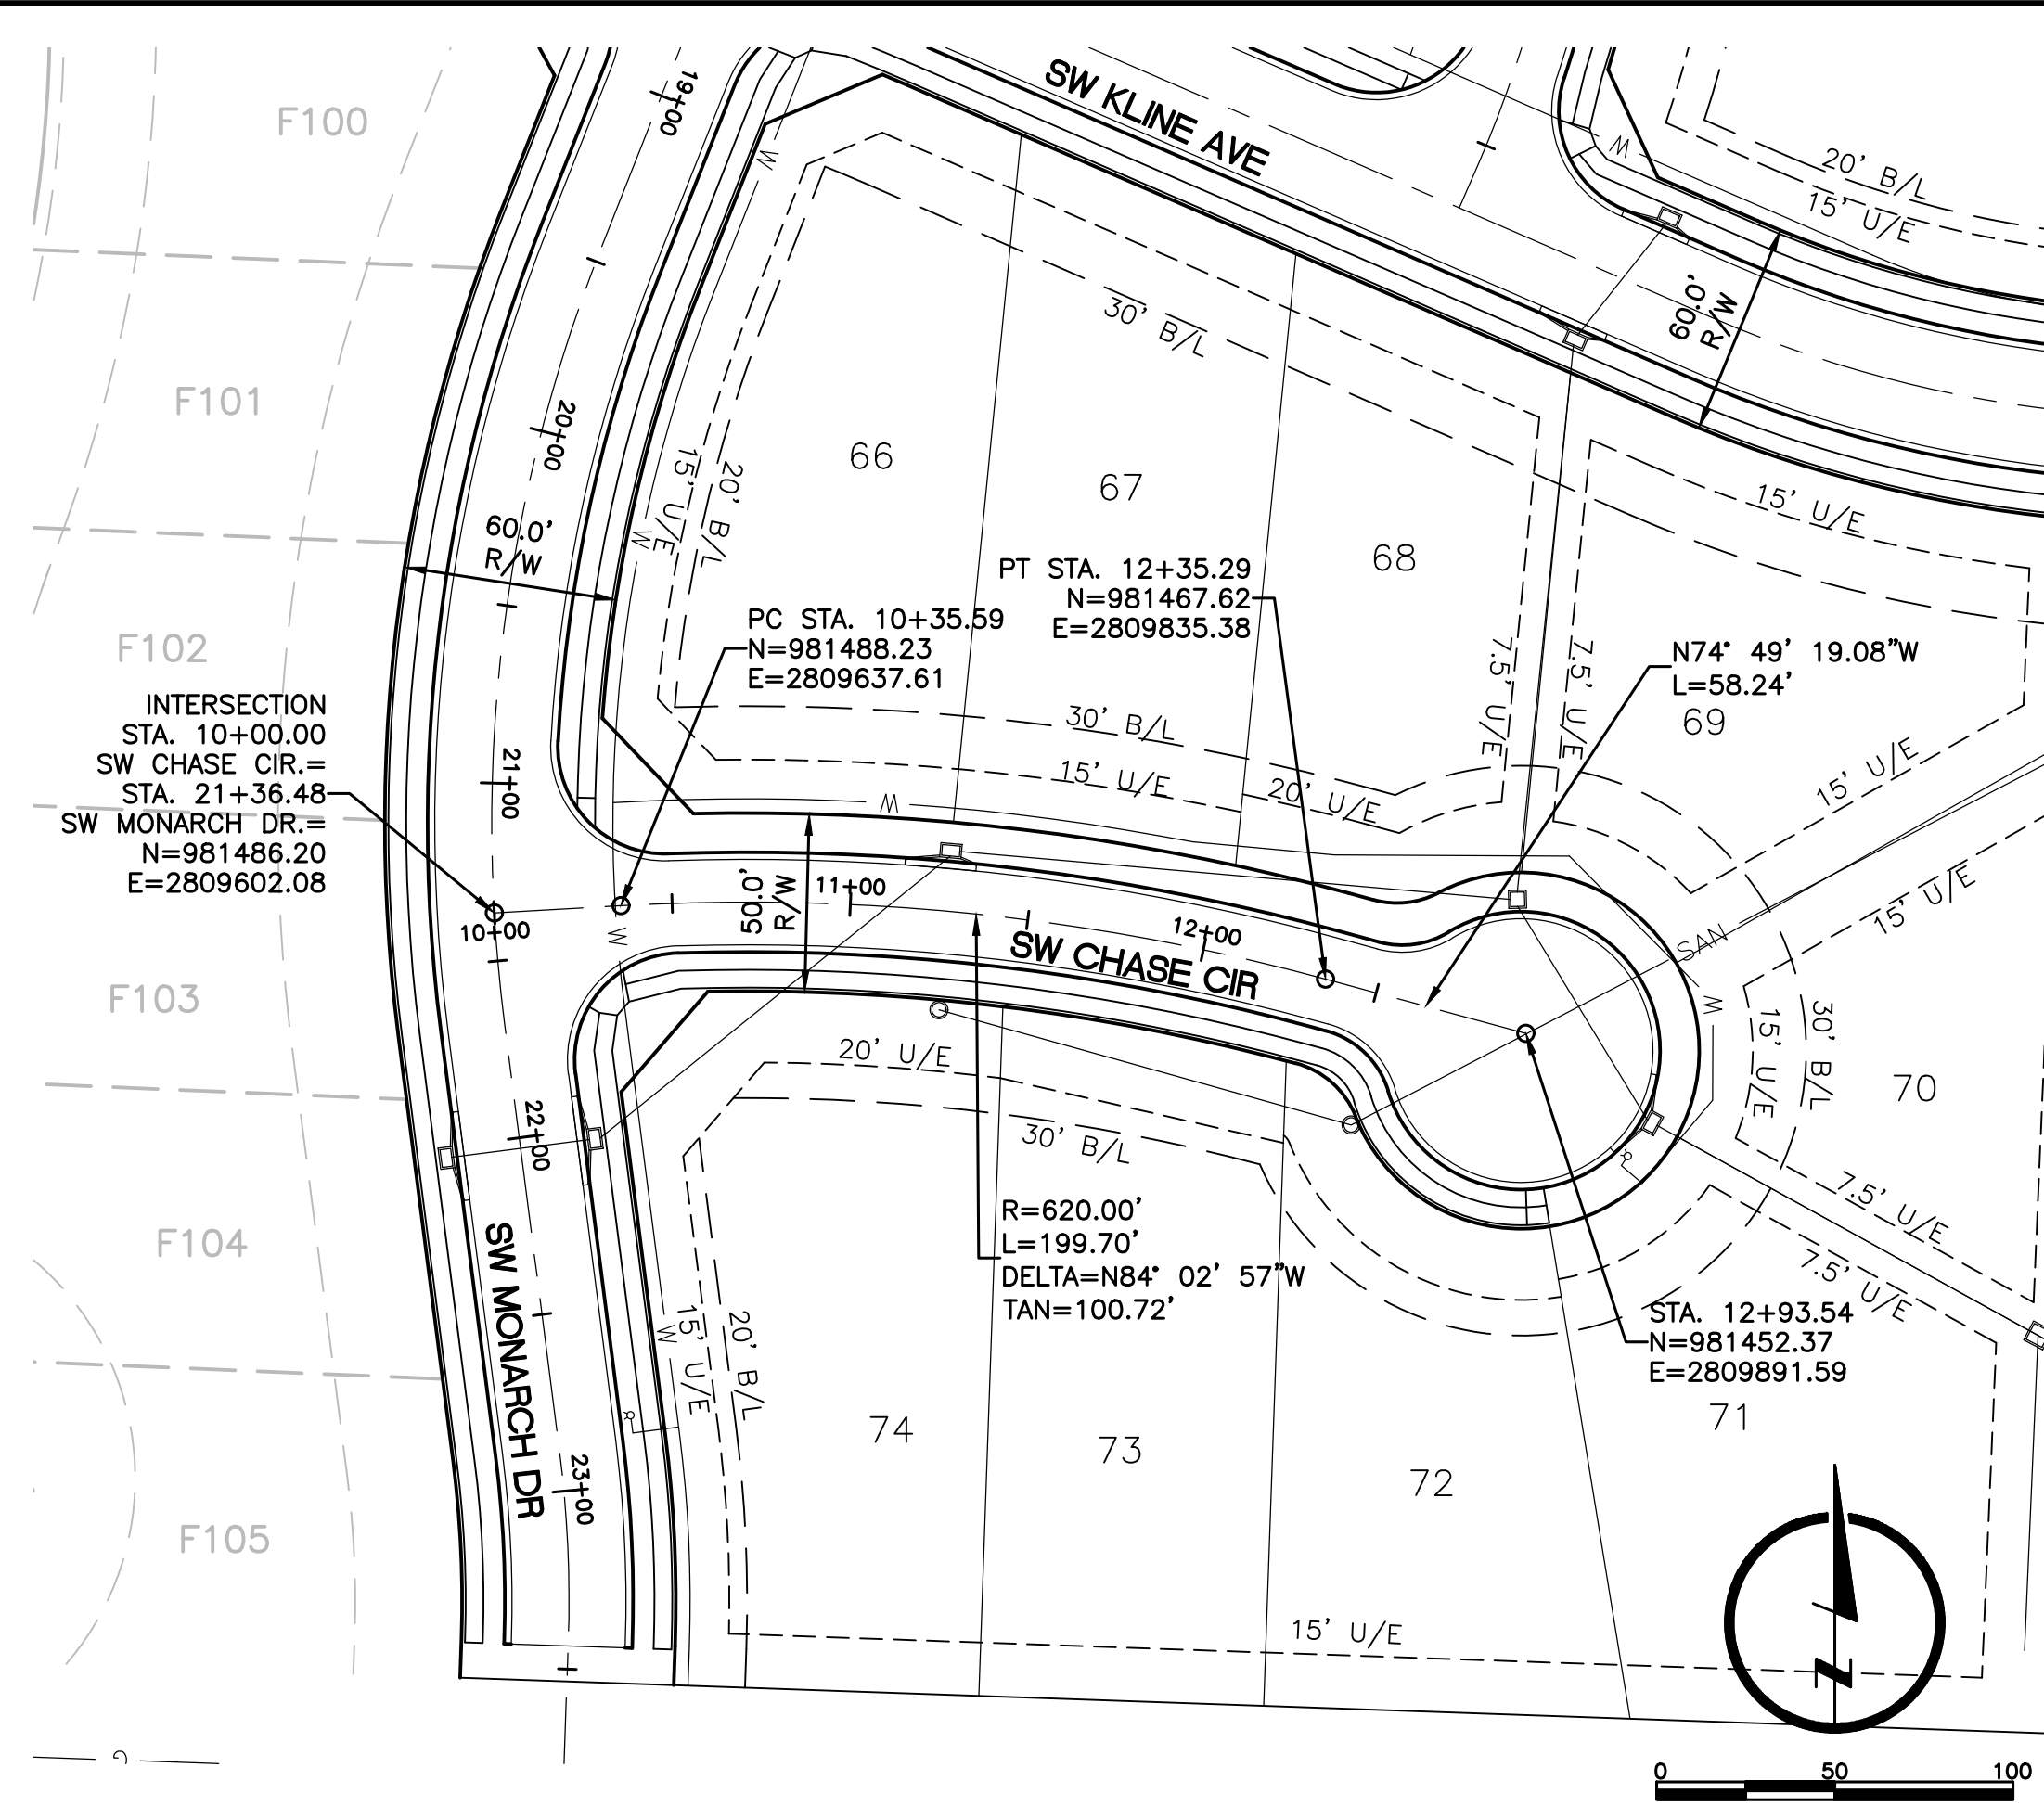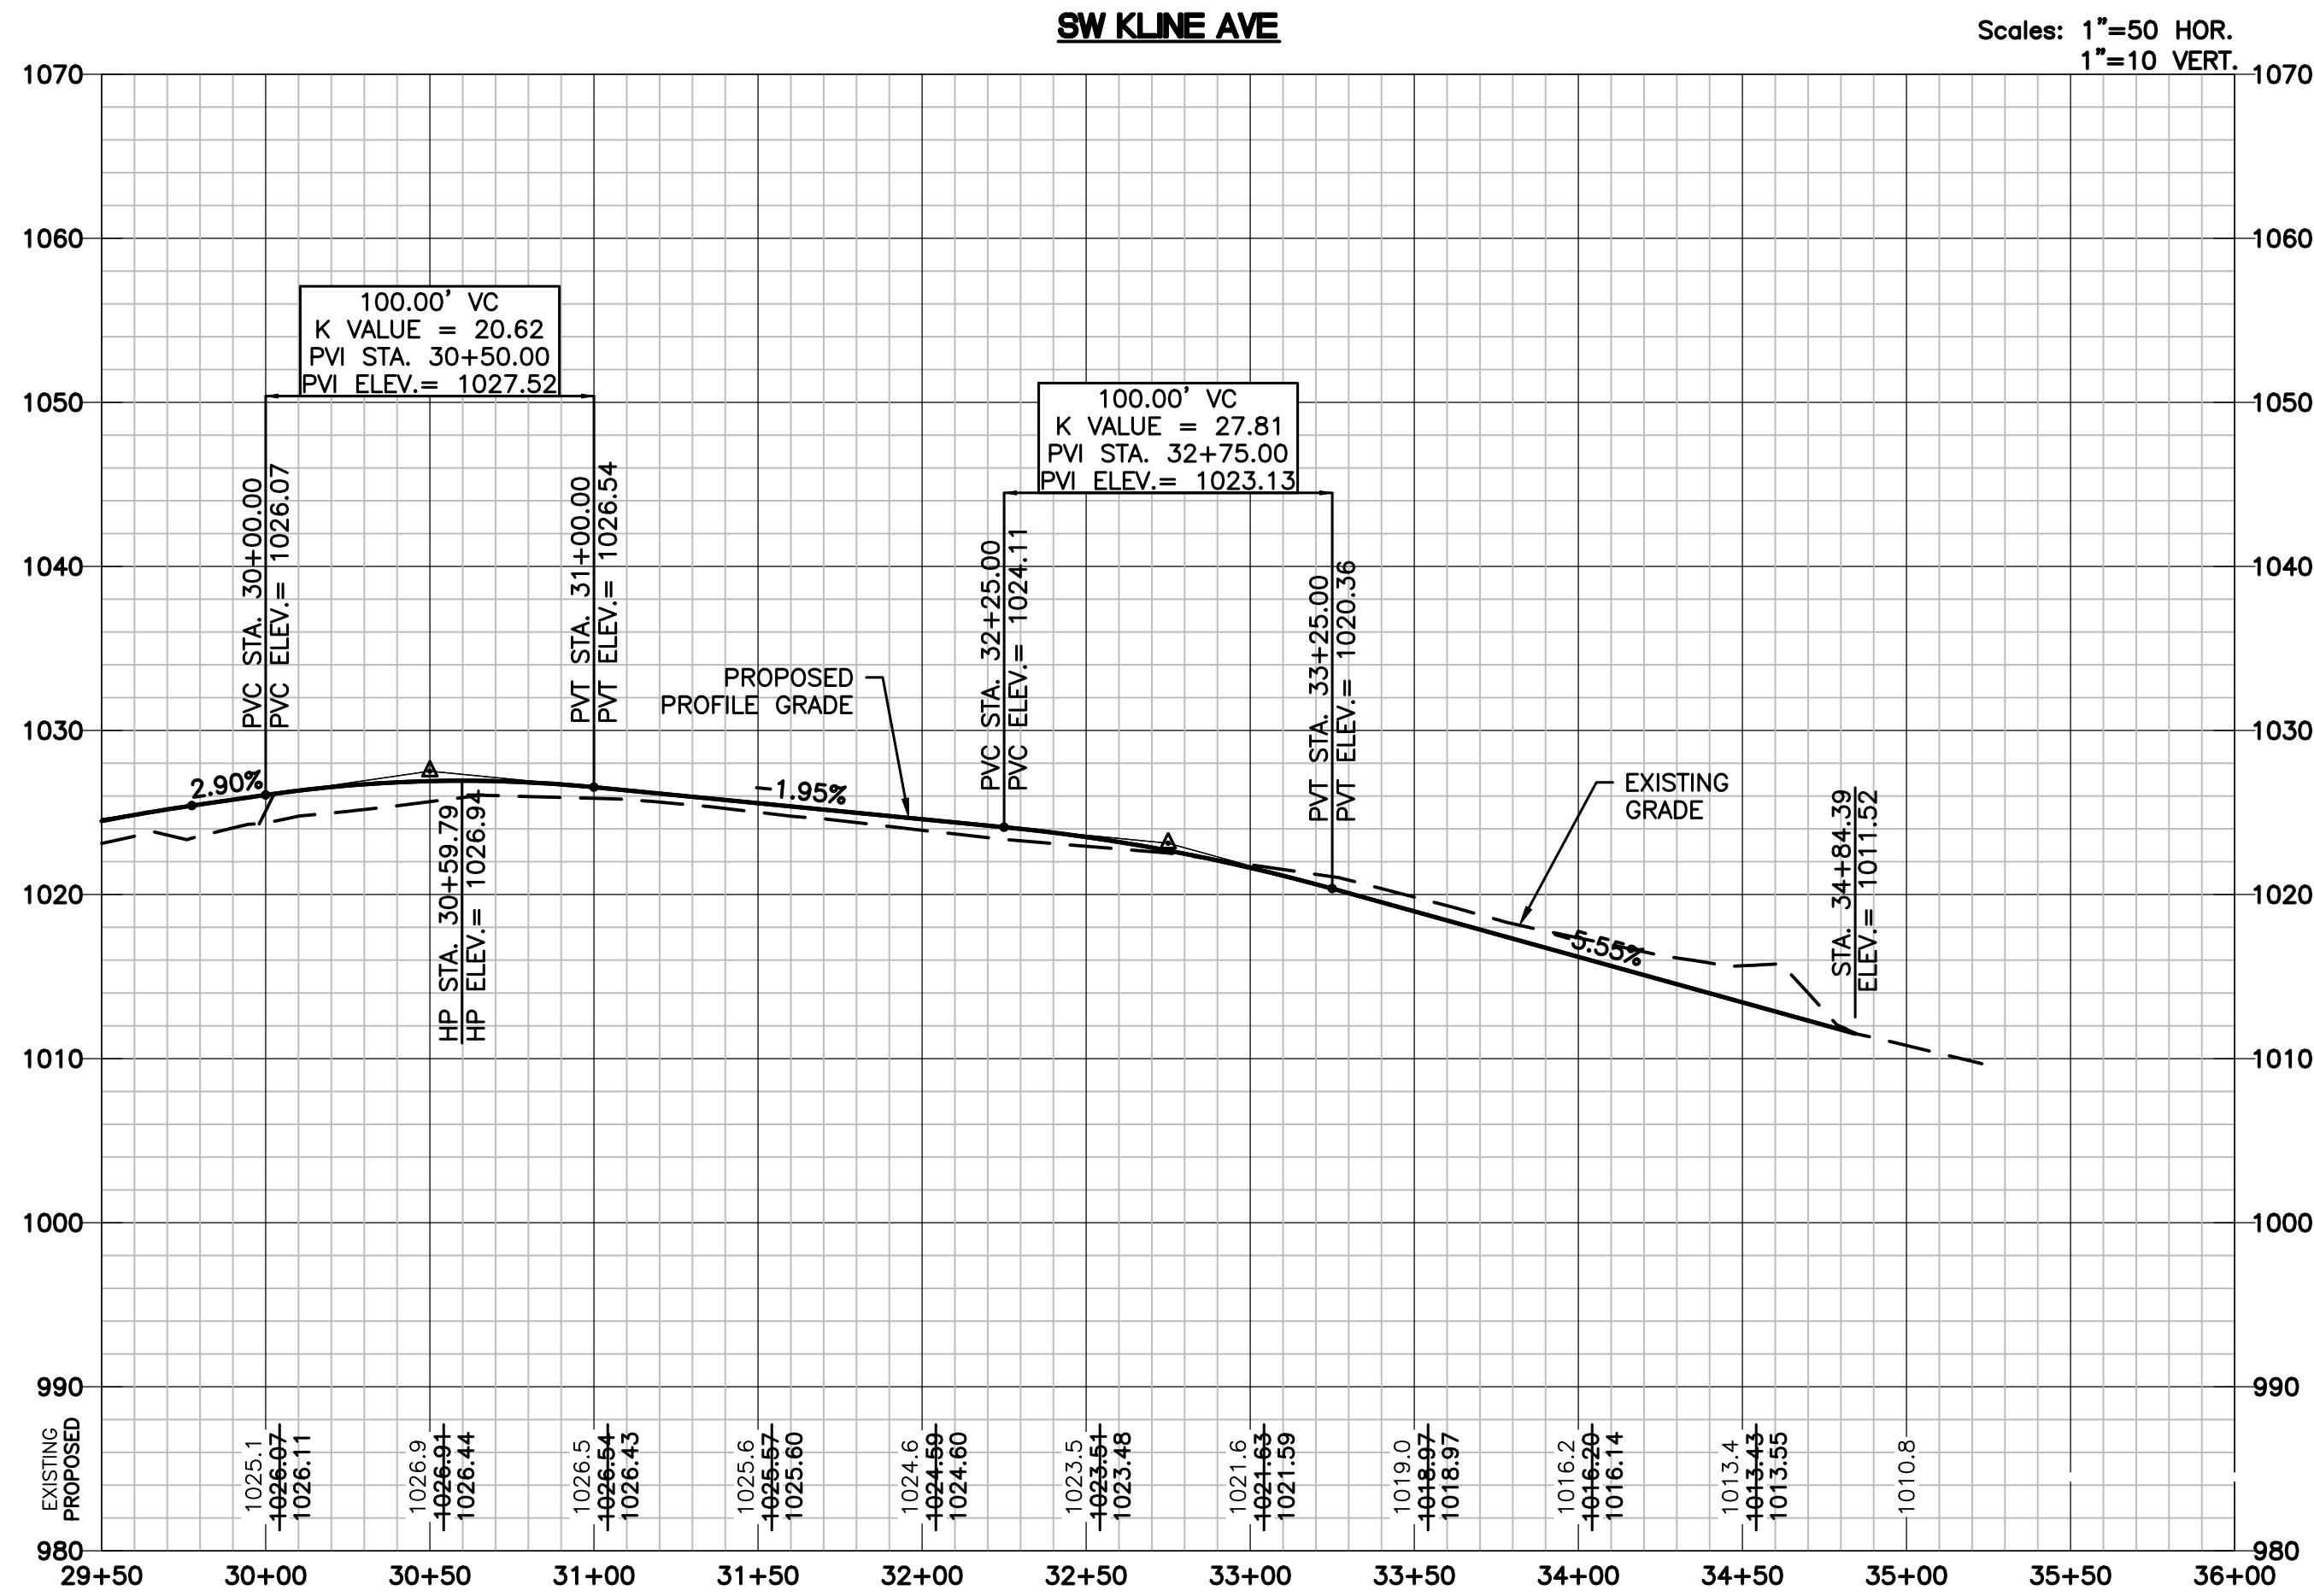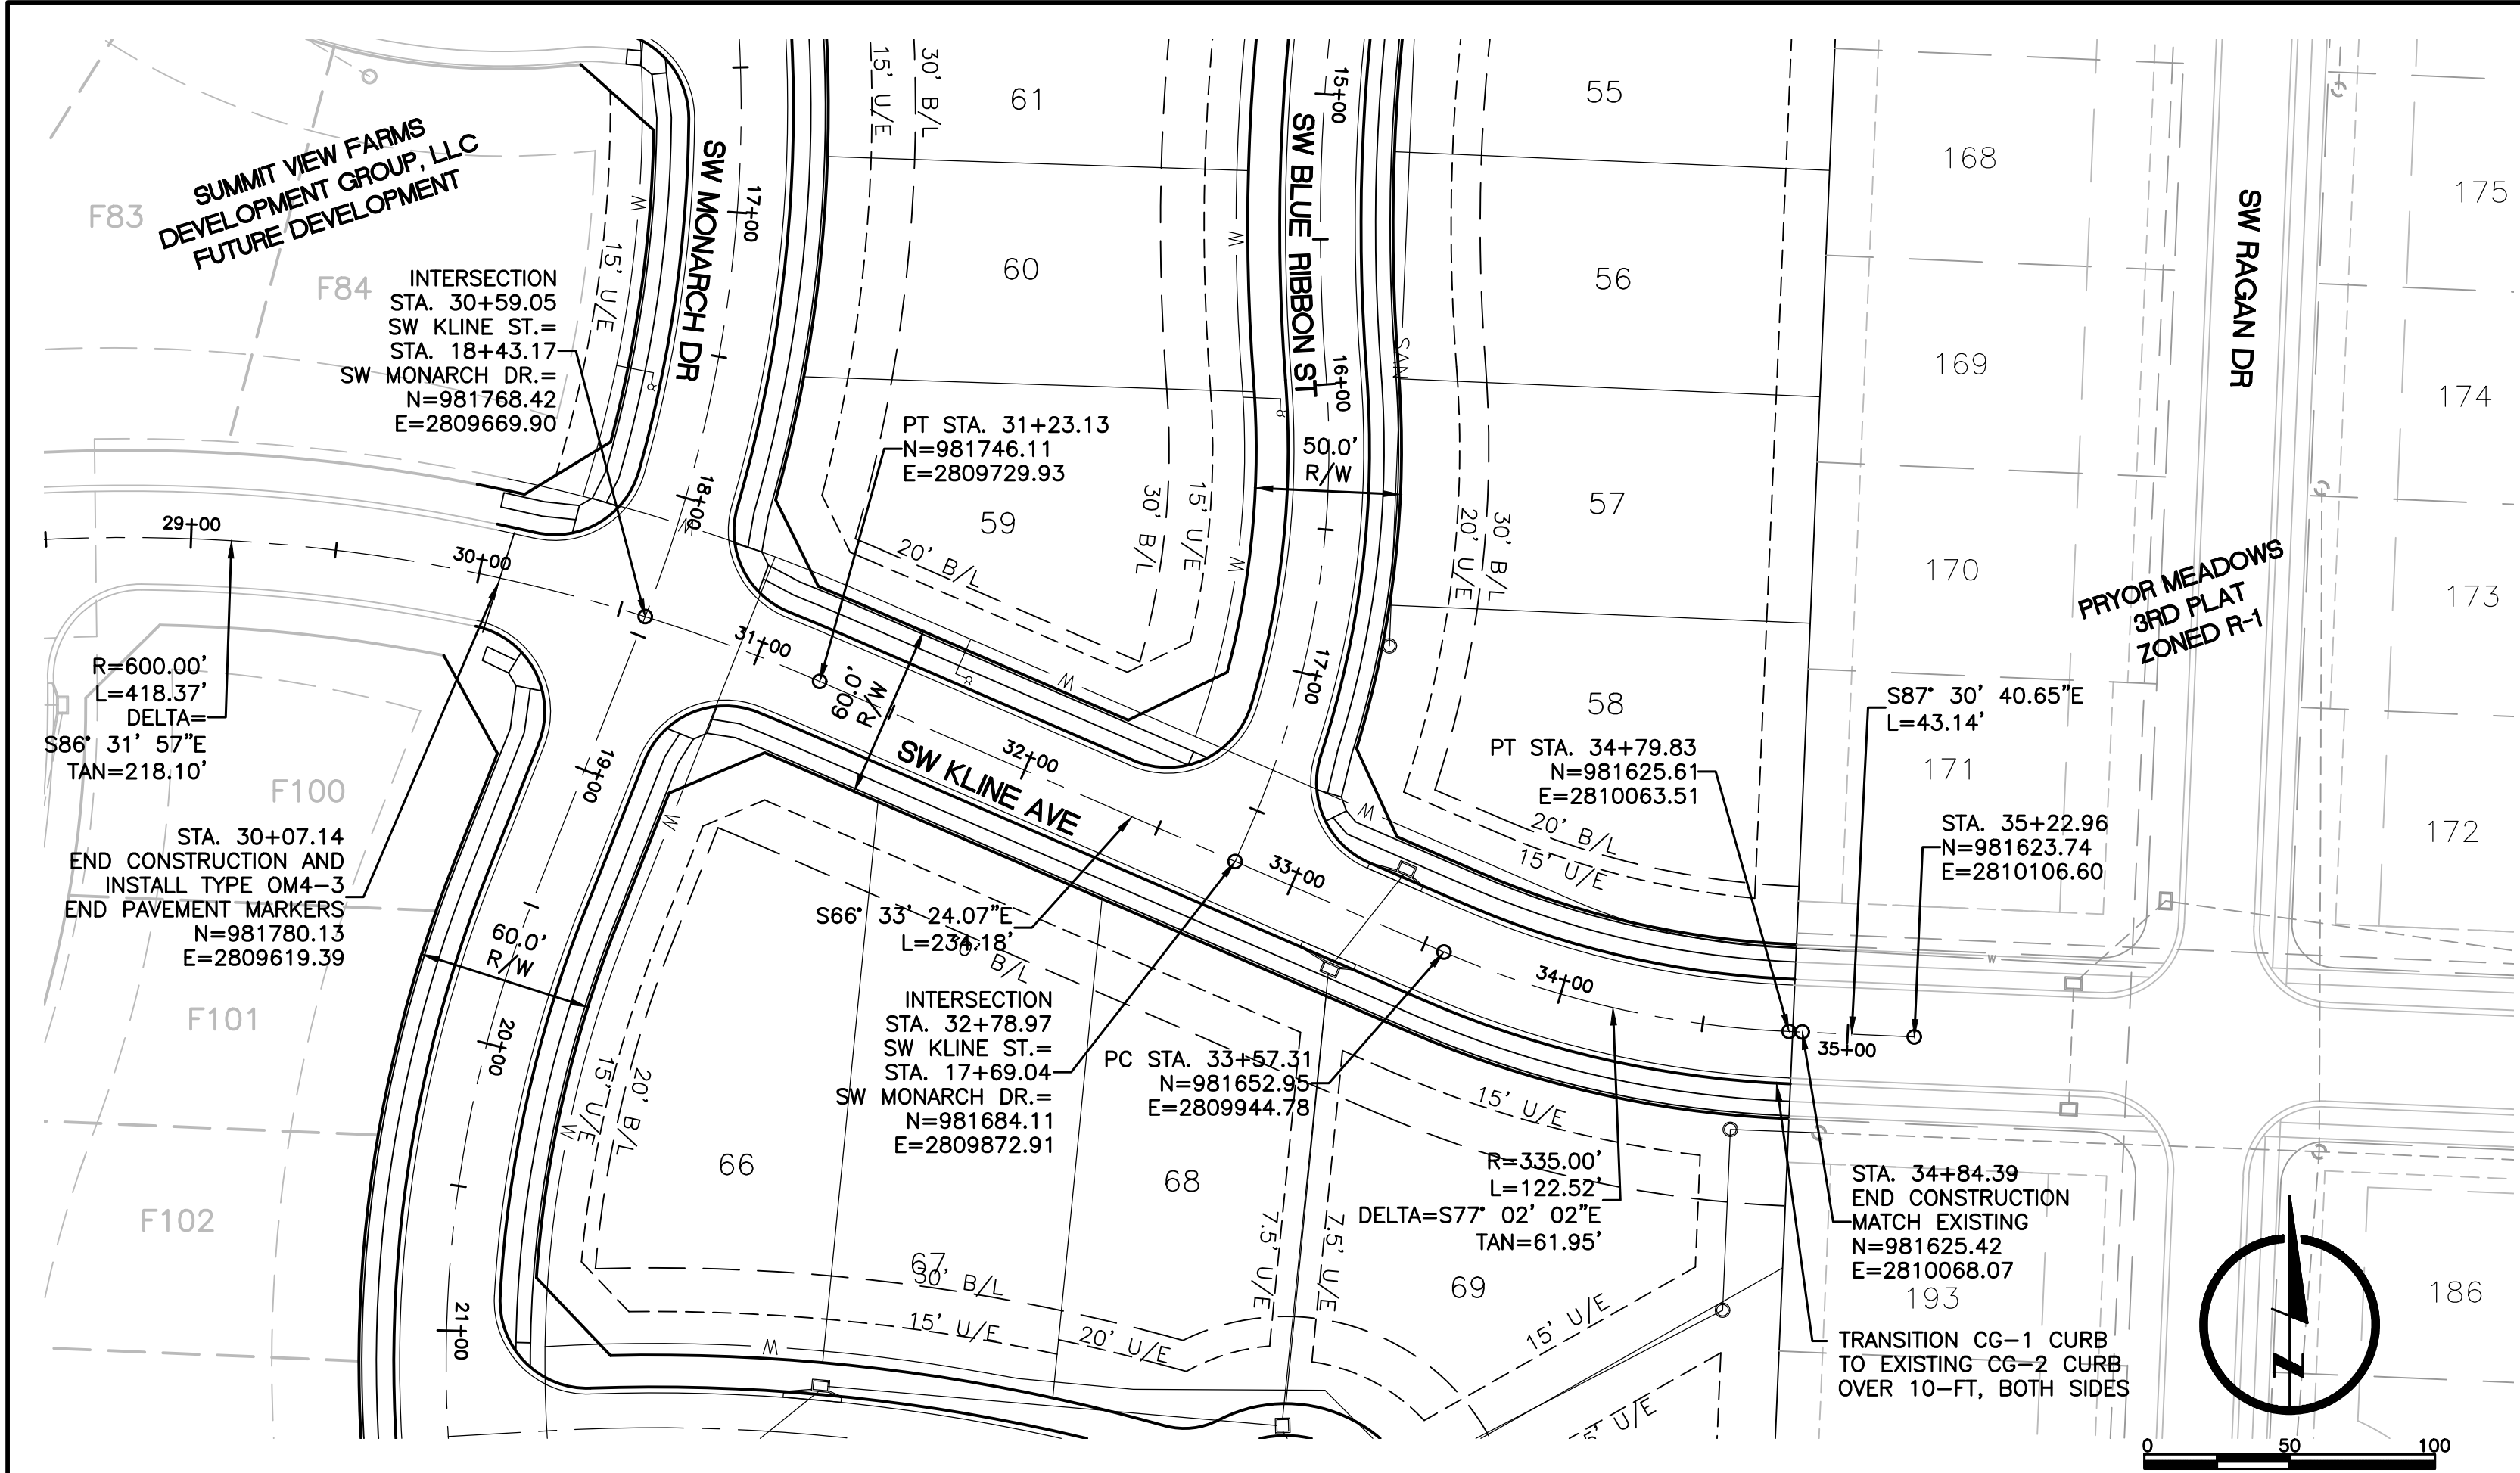


DRAWN BY JAM	DESIGNED BY MDM	DATE 09-19-2018	JOB NUMBER-TASKS 031959.01	BOOK AND PAGE
REVISIONS				
08/19/18 - RESUBMITAL PER ADJUSTED LAYOUT				
09/19/18 - RESUBMITAL PER CITY COMMENTS				
02/04/2020 - AS-BUILTS				
LARKIN/RYNEARSON 9001 State Line Rd., Suite 200 Kansas City, Missouri 64114 www.LRA-inc.com				
MASS GRADING, EROSION CONTROL, PAVING, STORM AND SANITARY PLANS SW KLINE AVENUE AND SW CHASE CIRCLE STREET PLAN/PROFILE SHEET				
LARKIN LAMP RYNEARSON - ENGINEERS MEO Certificate of Authority No. 2013011903				
MARK DANIEL MCGHEE JR. PE - 2008019568				
SHEET				
17 OF 31				

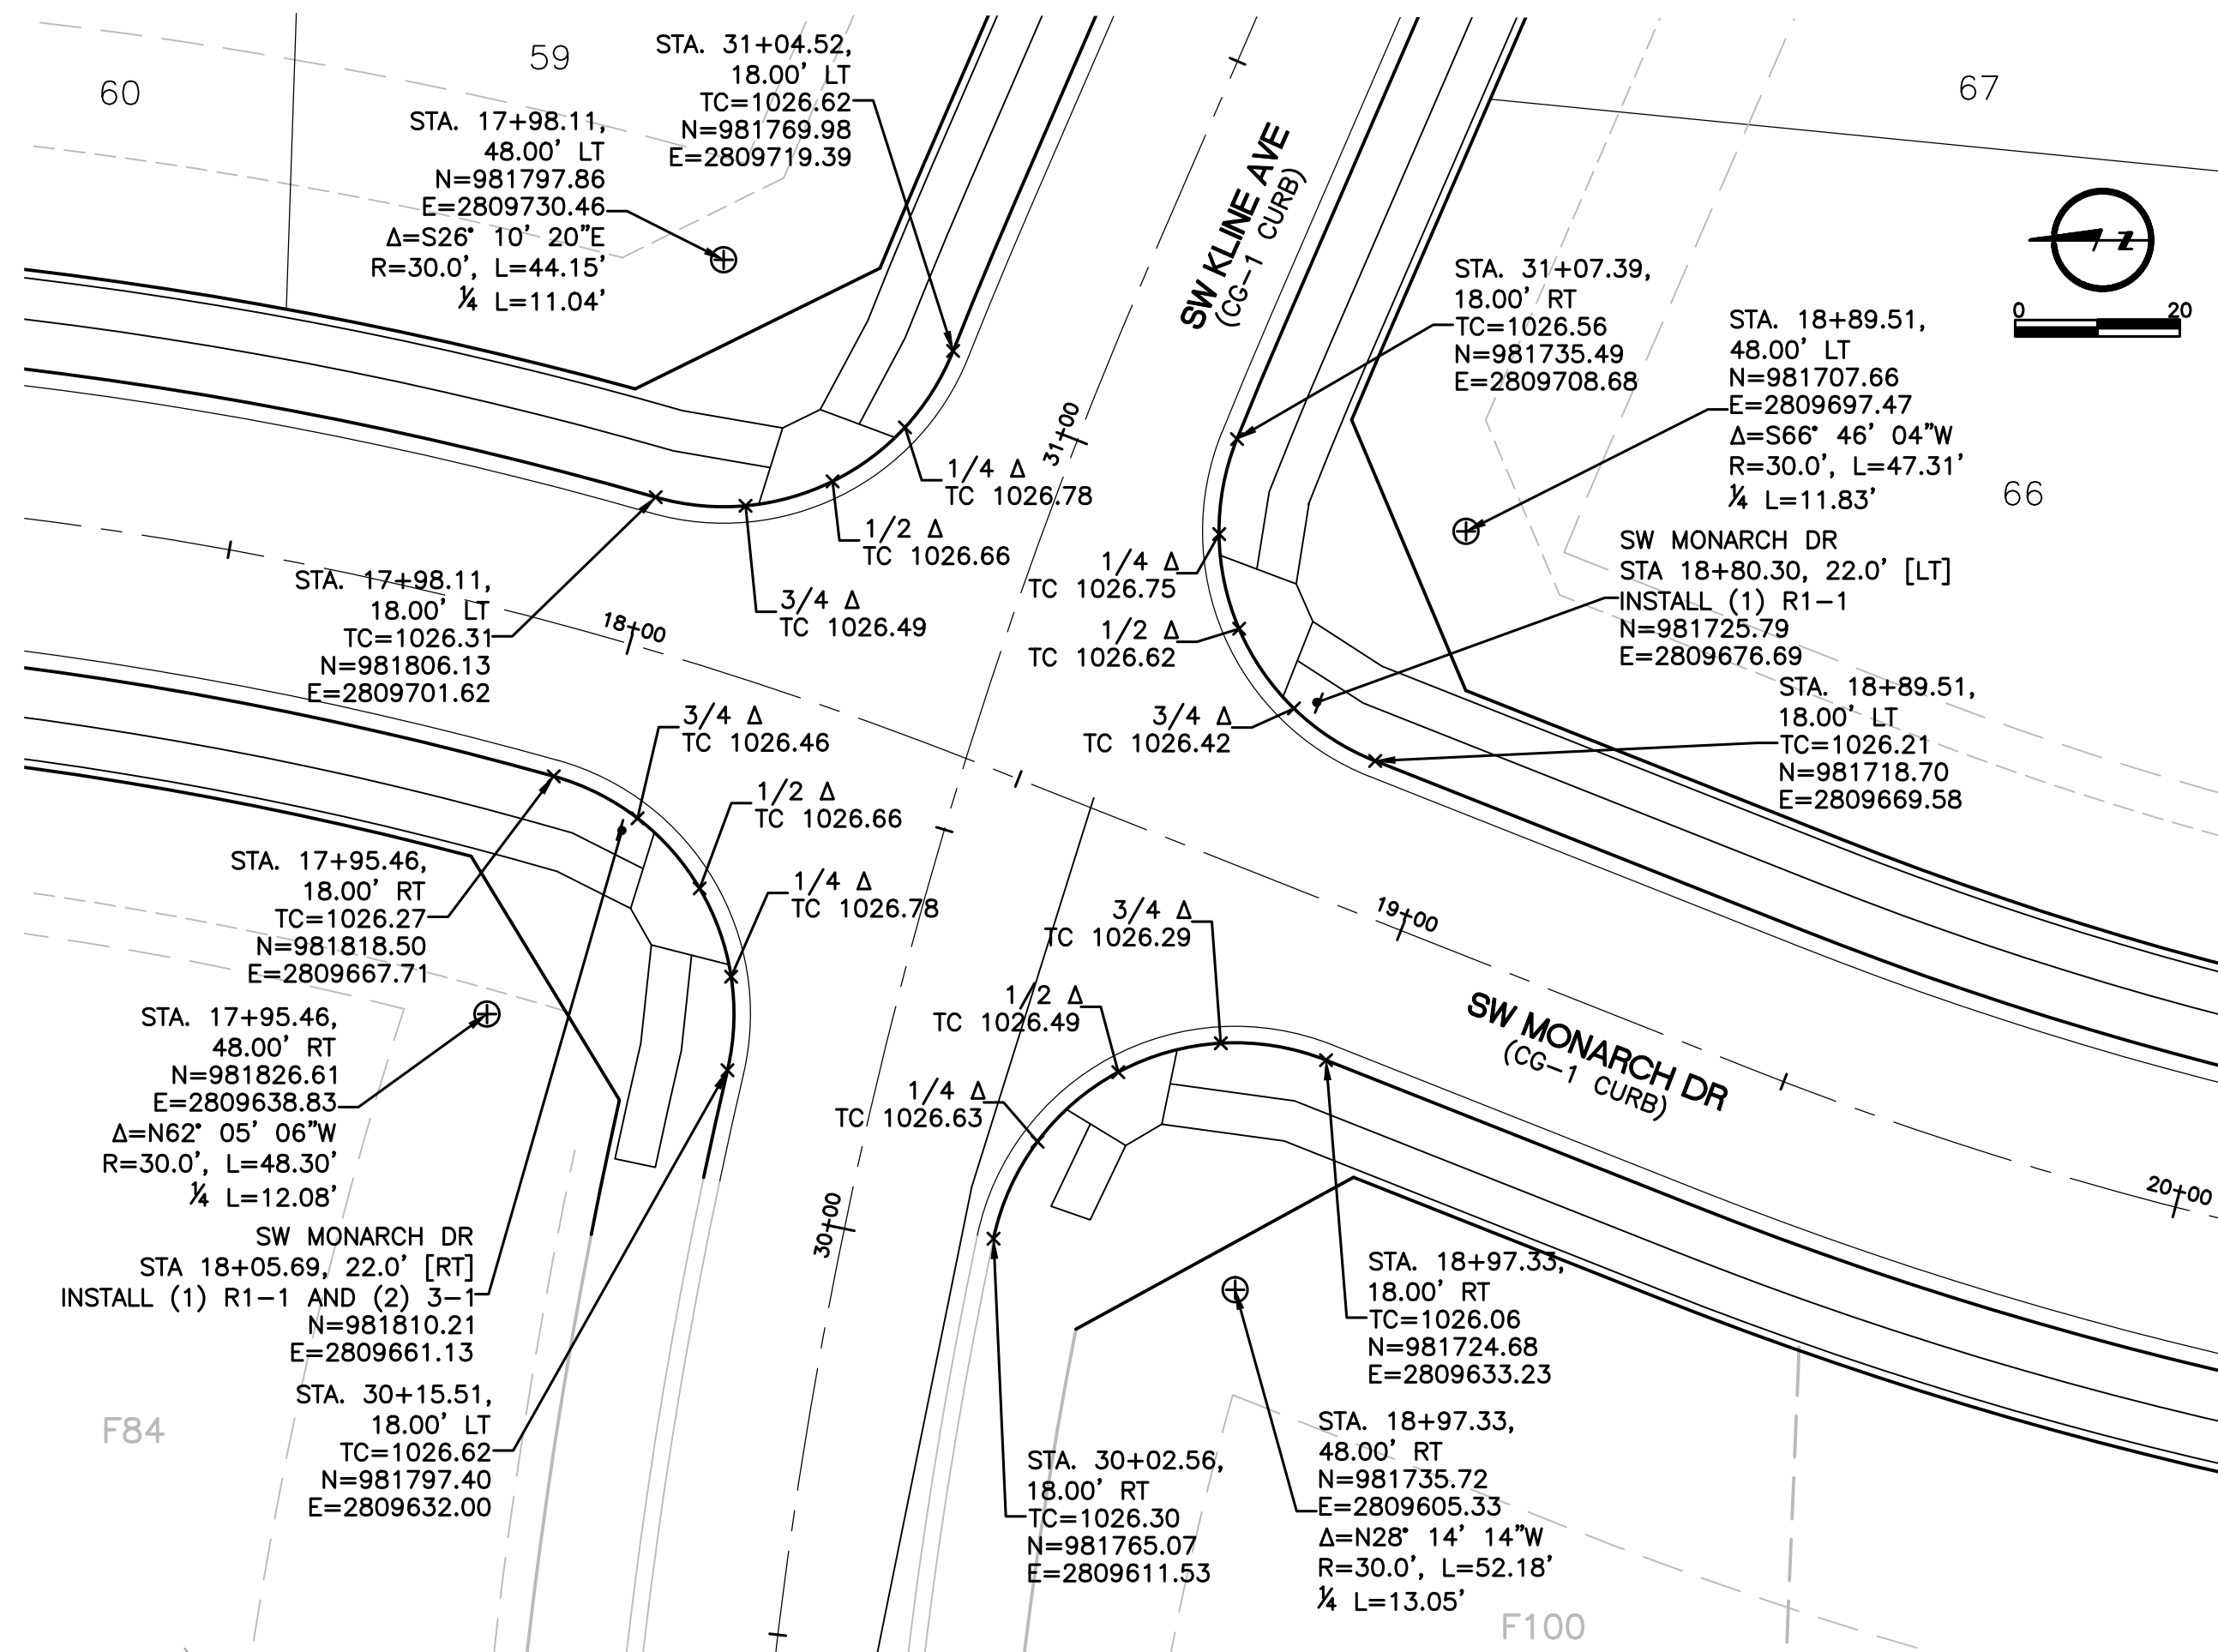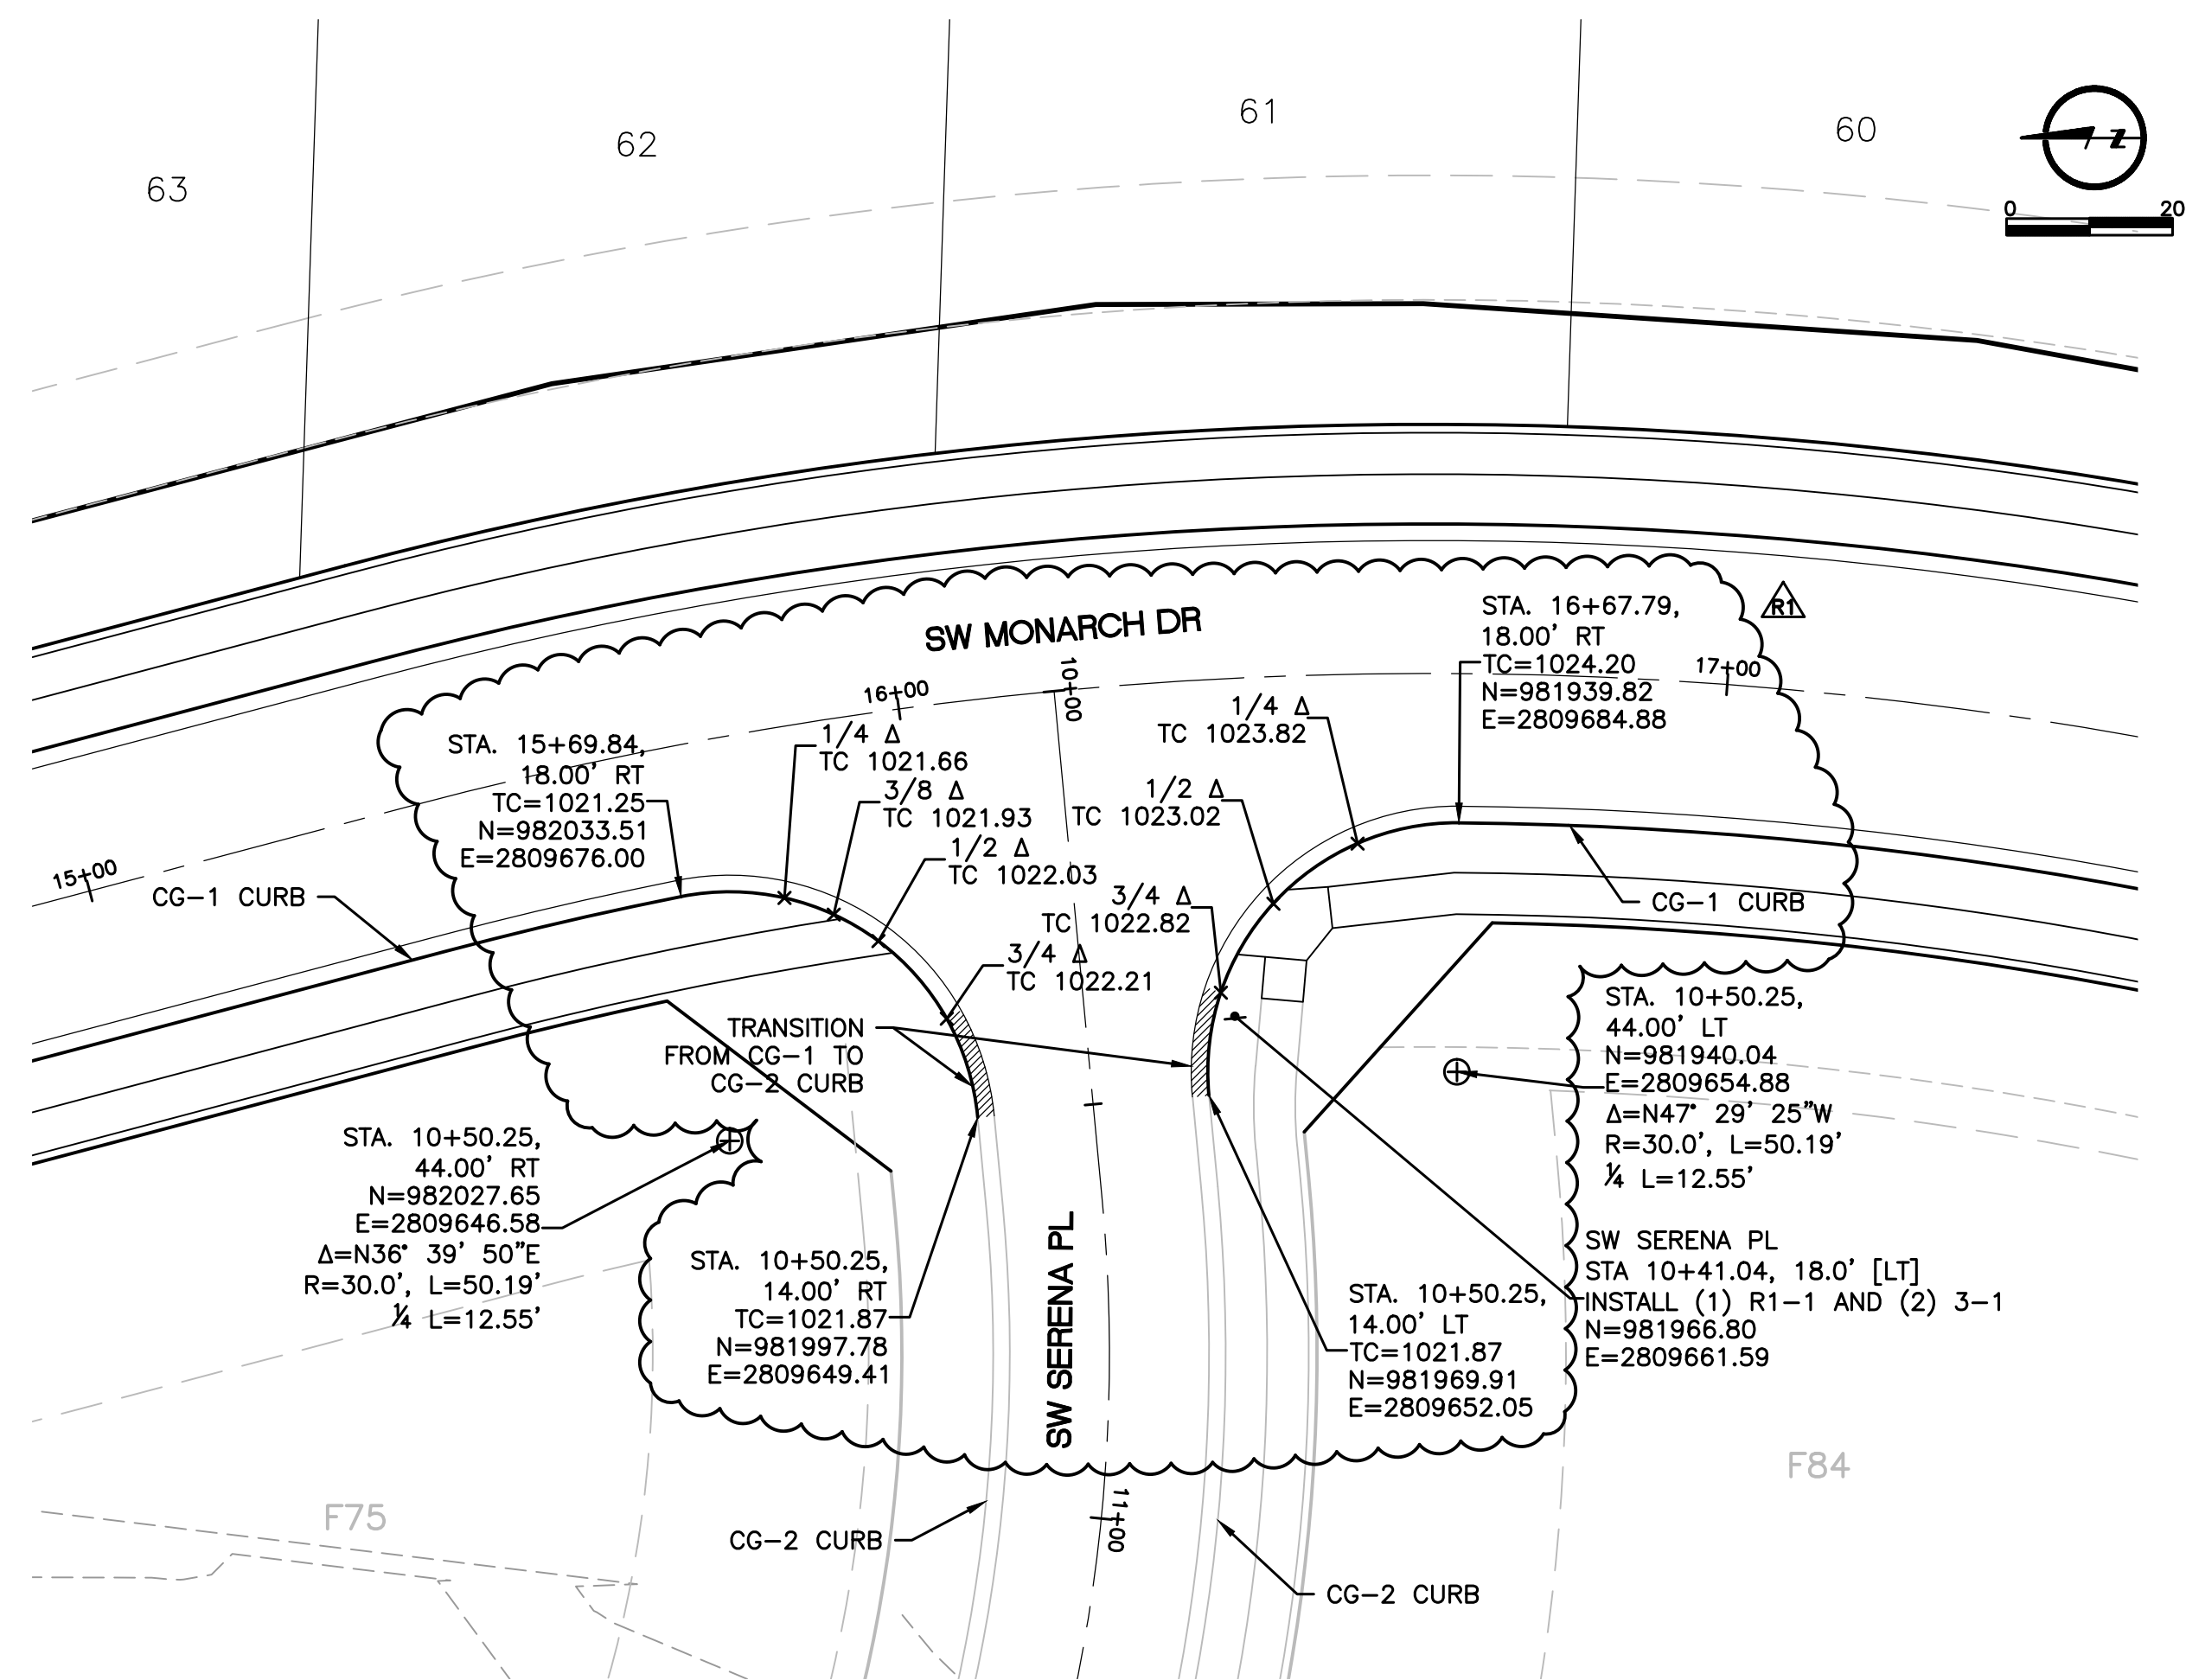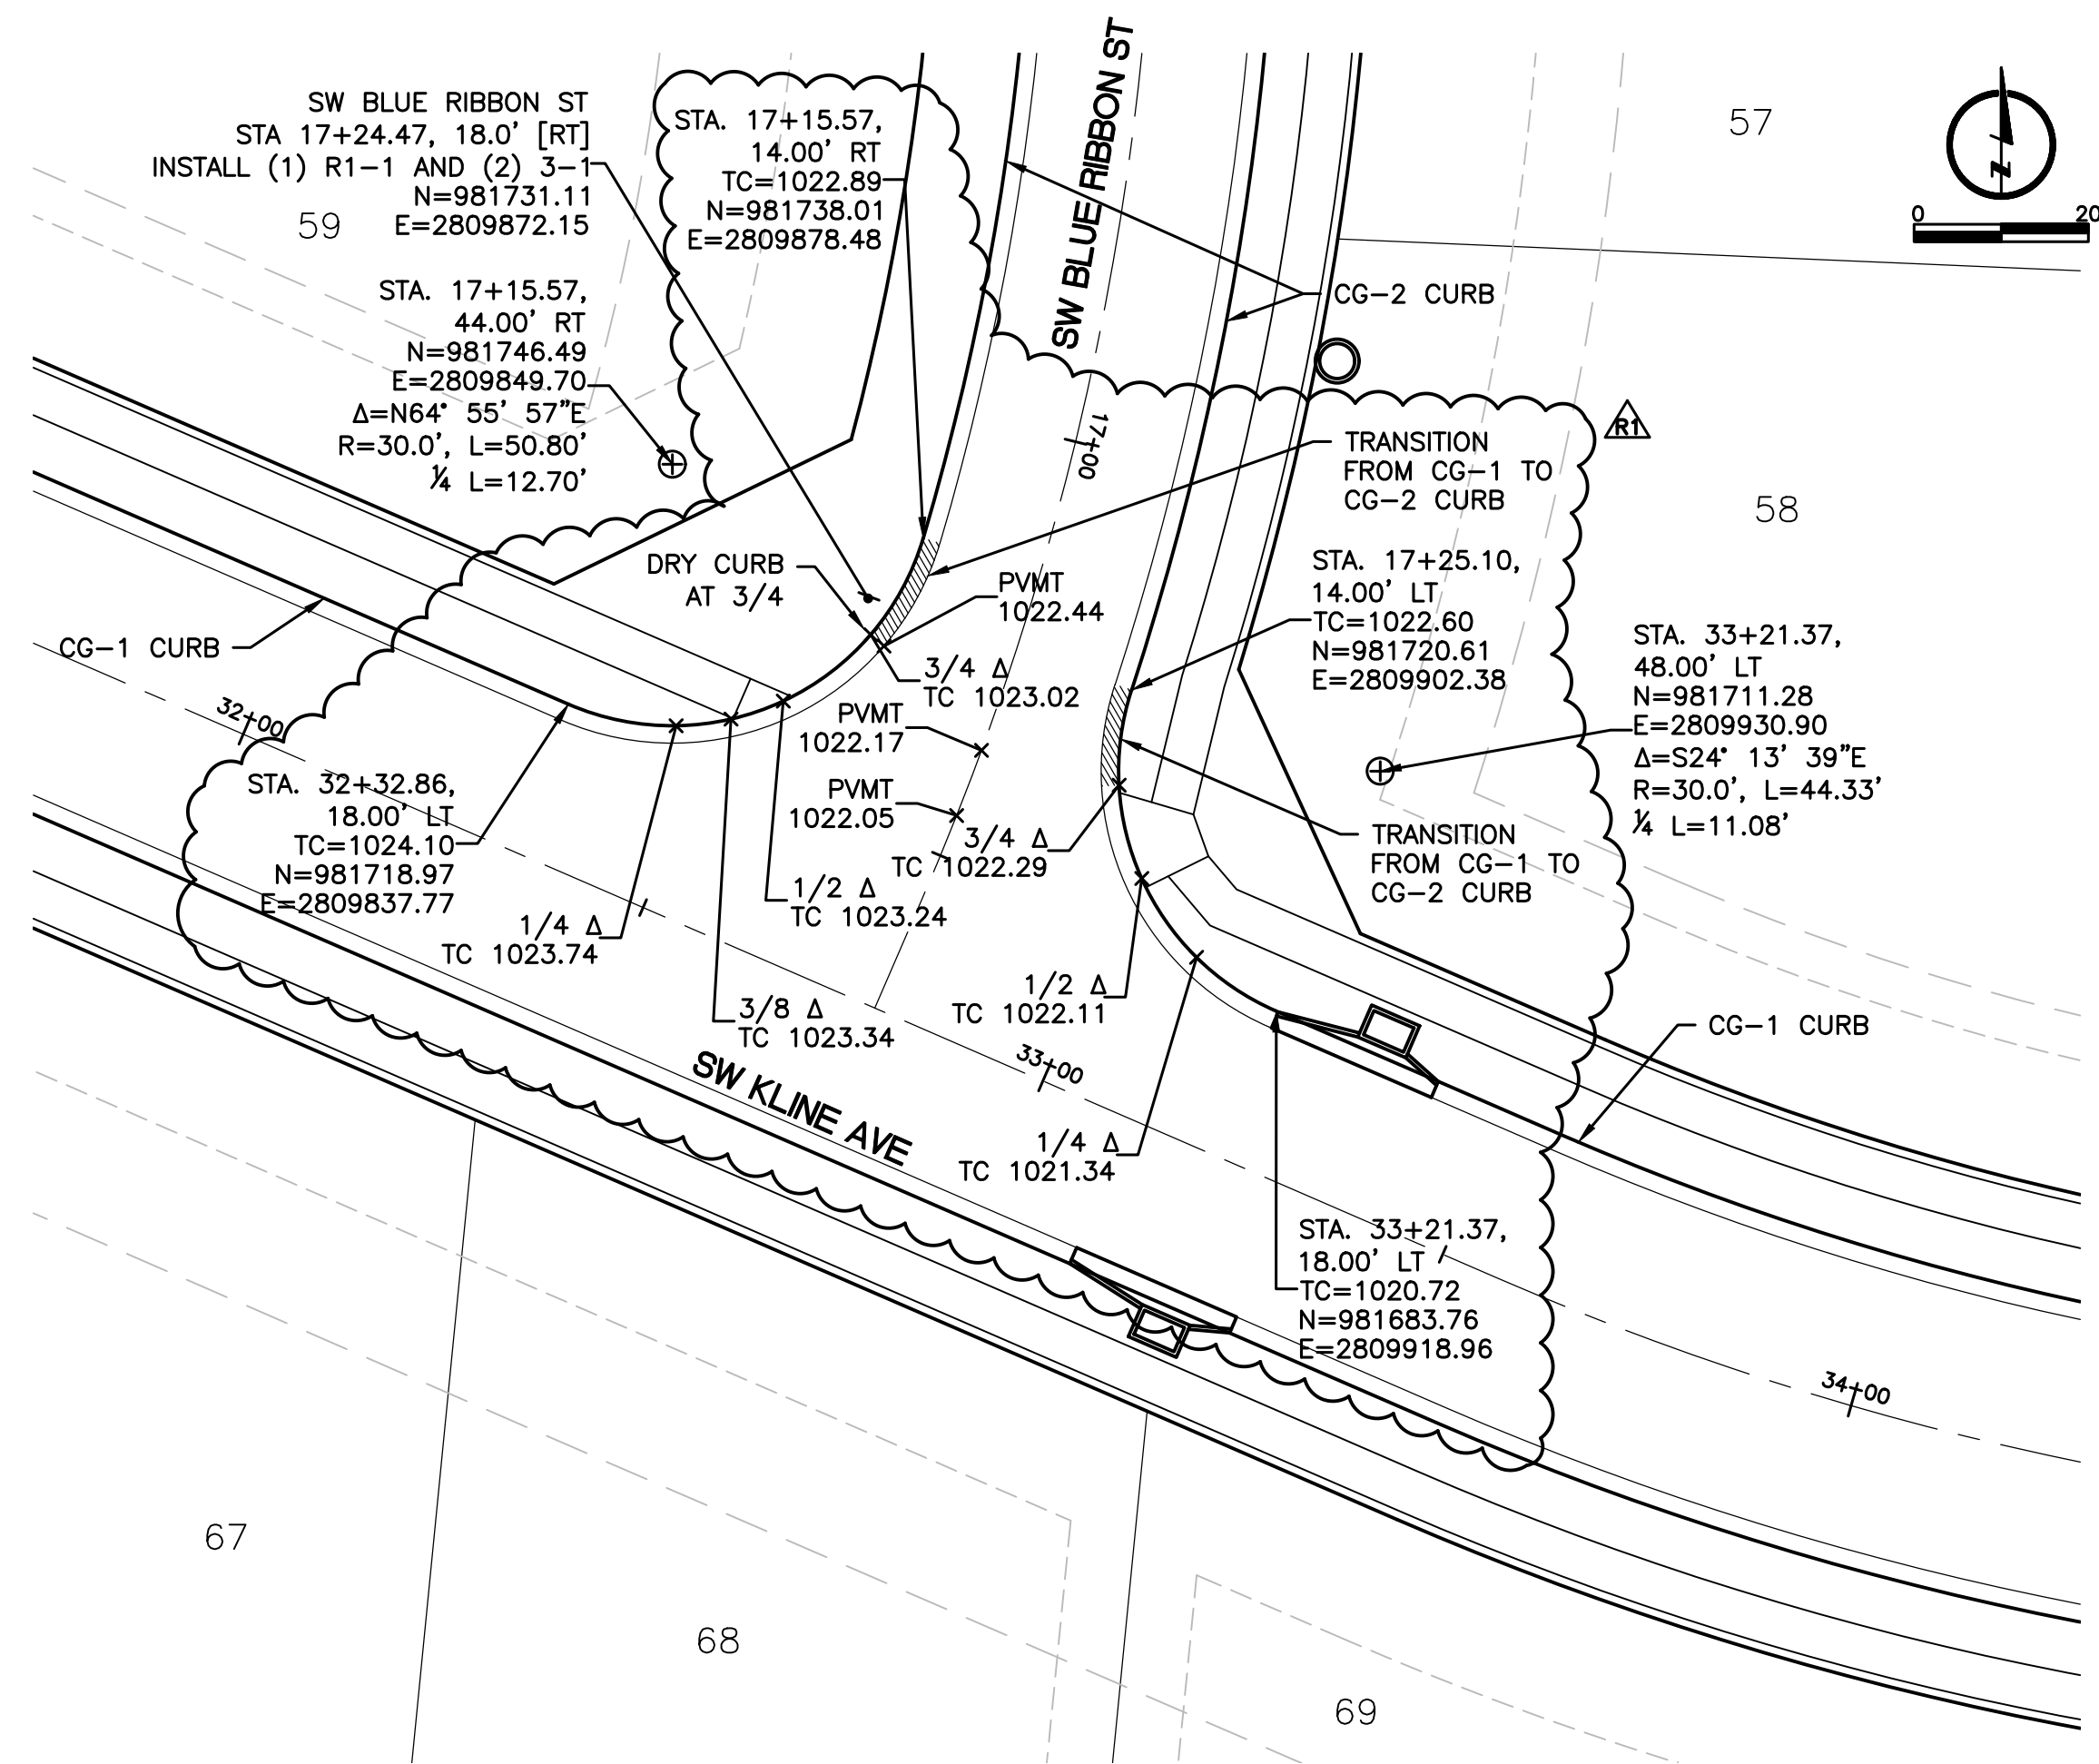

NOTES

1. R1-1 IS STOP SIGN AND 3-1 IS STREET SIGN. REFER TO CITY STANDARD DETAILS FOR MOUNTING AND SIGN REQUIREMENTS. TWO STREET SIGNS REQUIRED FOR EACH SIDE OF POST, PER STREET NAME.
2. TOP OF CURB ELEVATIONS AT RAMP LOCATIONS ARE THEORETICAL CURB ELEVATIONS (PROJECTING THROUGH RAMP). REFER TO SIDEWALK RAMP DETAIL SHEET FOR RAMP ELEVATIONS. CURB IS TO BE DEPRESSED AT RAMP LOCATIONS.

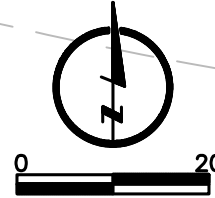

- ## NOTES
1. R1-1 IS STOP SIGN AND 3-1 IS STREET SIGN.
REFER TO CITY STANDARD DETAILS FOR MOUNTING AND SIGN REQUIREMENTS. TWO STREET SIGNS REQUIRED FOR EACH SIDE OF POST, PER STREET NAME.
 2. TOP OF CURB ELEVATIONS AT RAMP LOCATIONS ARE THEORETICAL CURB ELEVATIONS (PROJECTING THROUGH RAMP). REFER TO SIDEWALK RAMP DETAIL SHEET FOR RAMP ELEVATIONS. CURB IS TO BE DEPRESSED AT RAMP LOCATIONS.

REVISIONS		DRAWN BY
08/10/18	— RESUBMITTAL PER ADJUSTED LAYOUT	AJM
09/19/18	— RESUBMITTAL PER CITY COMMENTS	DESIGNED BY
03/01/19	— REVISION 1	MDM
DATE		
10-05-2018		
JOB NUMBER-TASKS		
0318050.01		
BOOK AND PAGE		

9901 State Line Rd., Suite 200 816.361.0440 | P
Kansas City, Missouri 64114 816.361.0045 | F
www.LRA-inc.com



SUMMIT VIEW FARMS 3RD PLAT
LEE'S SUMMIT, MISSOURI

**MASS GRADING, EROSION CONTROL,
PAVING, STORM AND SANITARY PLANS**

INTERSECTION LAYOUT PLAN




LARKIN LAMP RYNEARSON - ENGINEERS
MO Certificate of Authority No. 2013011903



MARK DANIEL MCGHEE JR.
PE - 2008019568

SHEET

L:\Engineering\031850 SVFDG Summit View Forms 3rd Plat\Drawings\CONSTRUCTION DRAWINGS\PAV-PLANS\031850-SW-RAMP-3.dwg, 3/1/2019 8:19:10 AM, DAN MCGHEE, LAMP RYNEARSON & ASSOCIATES

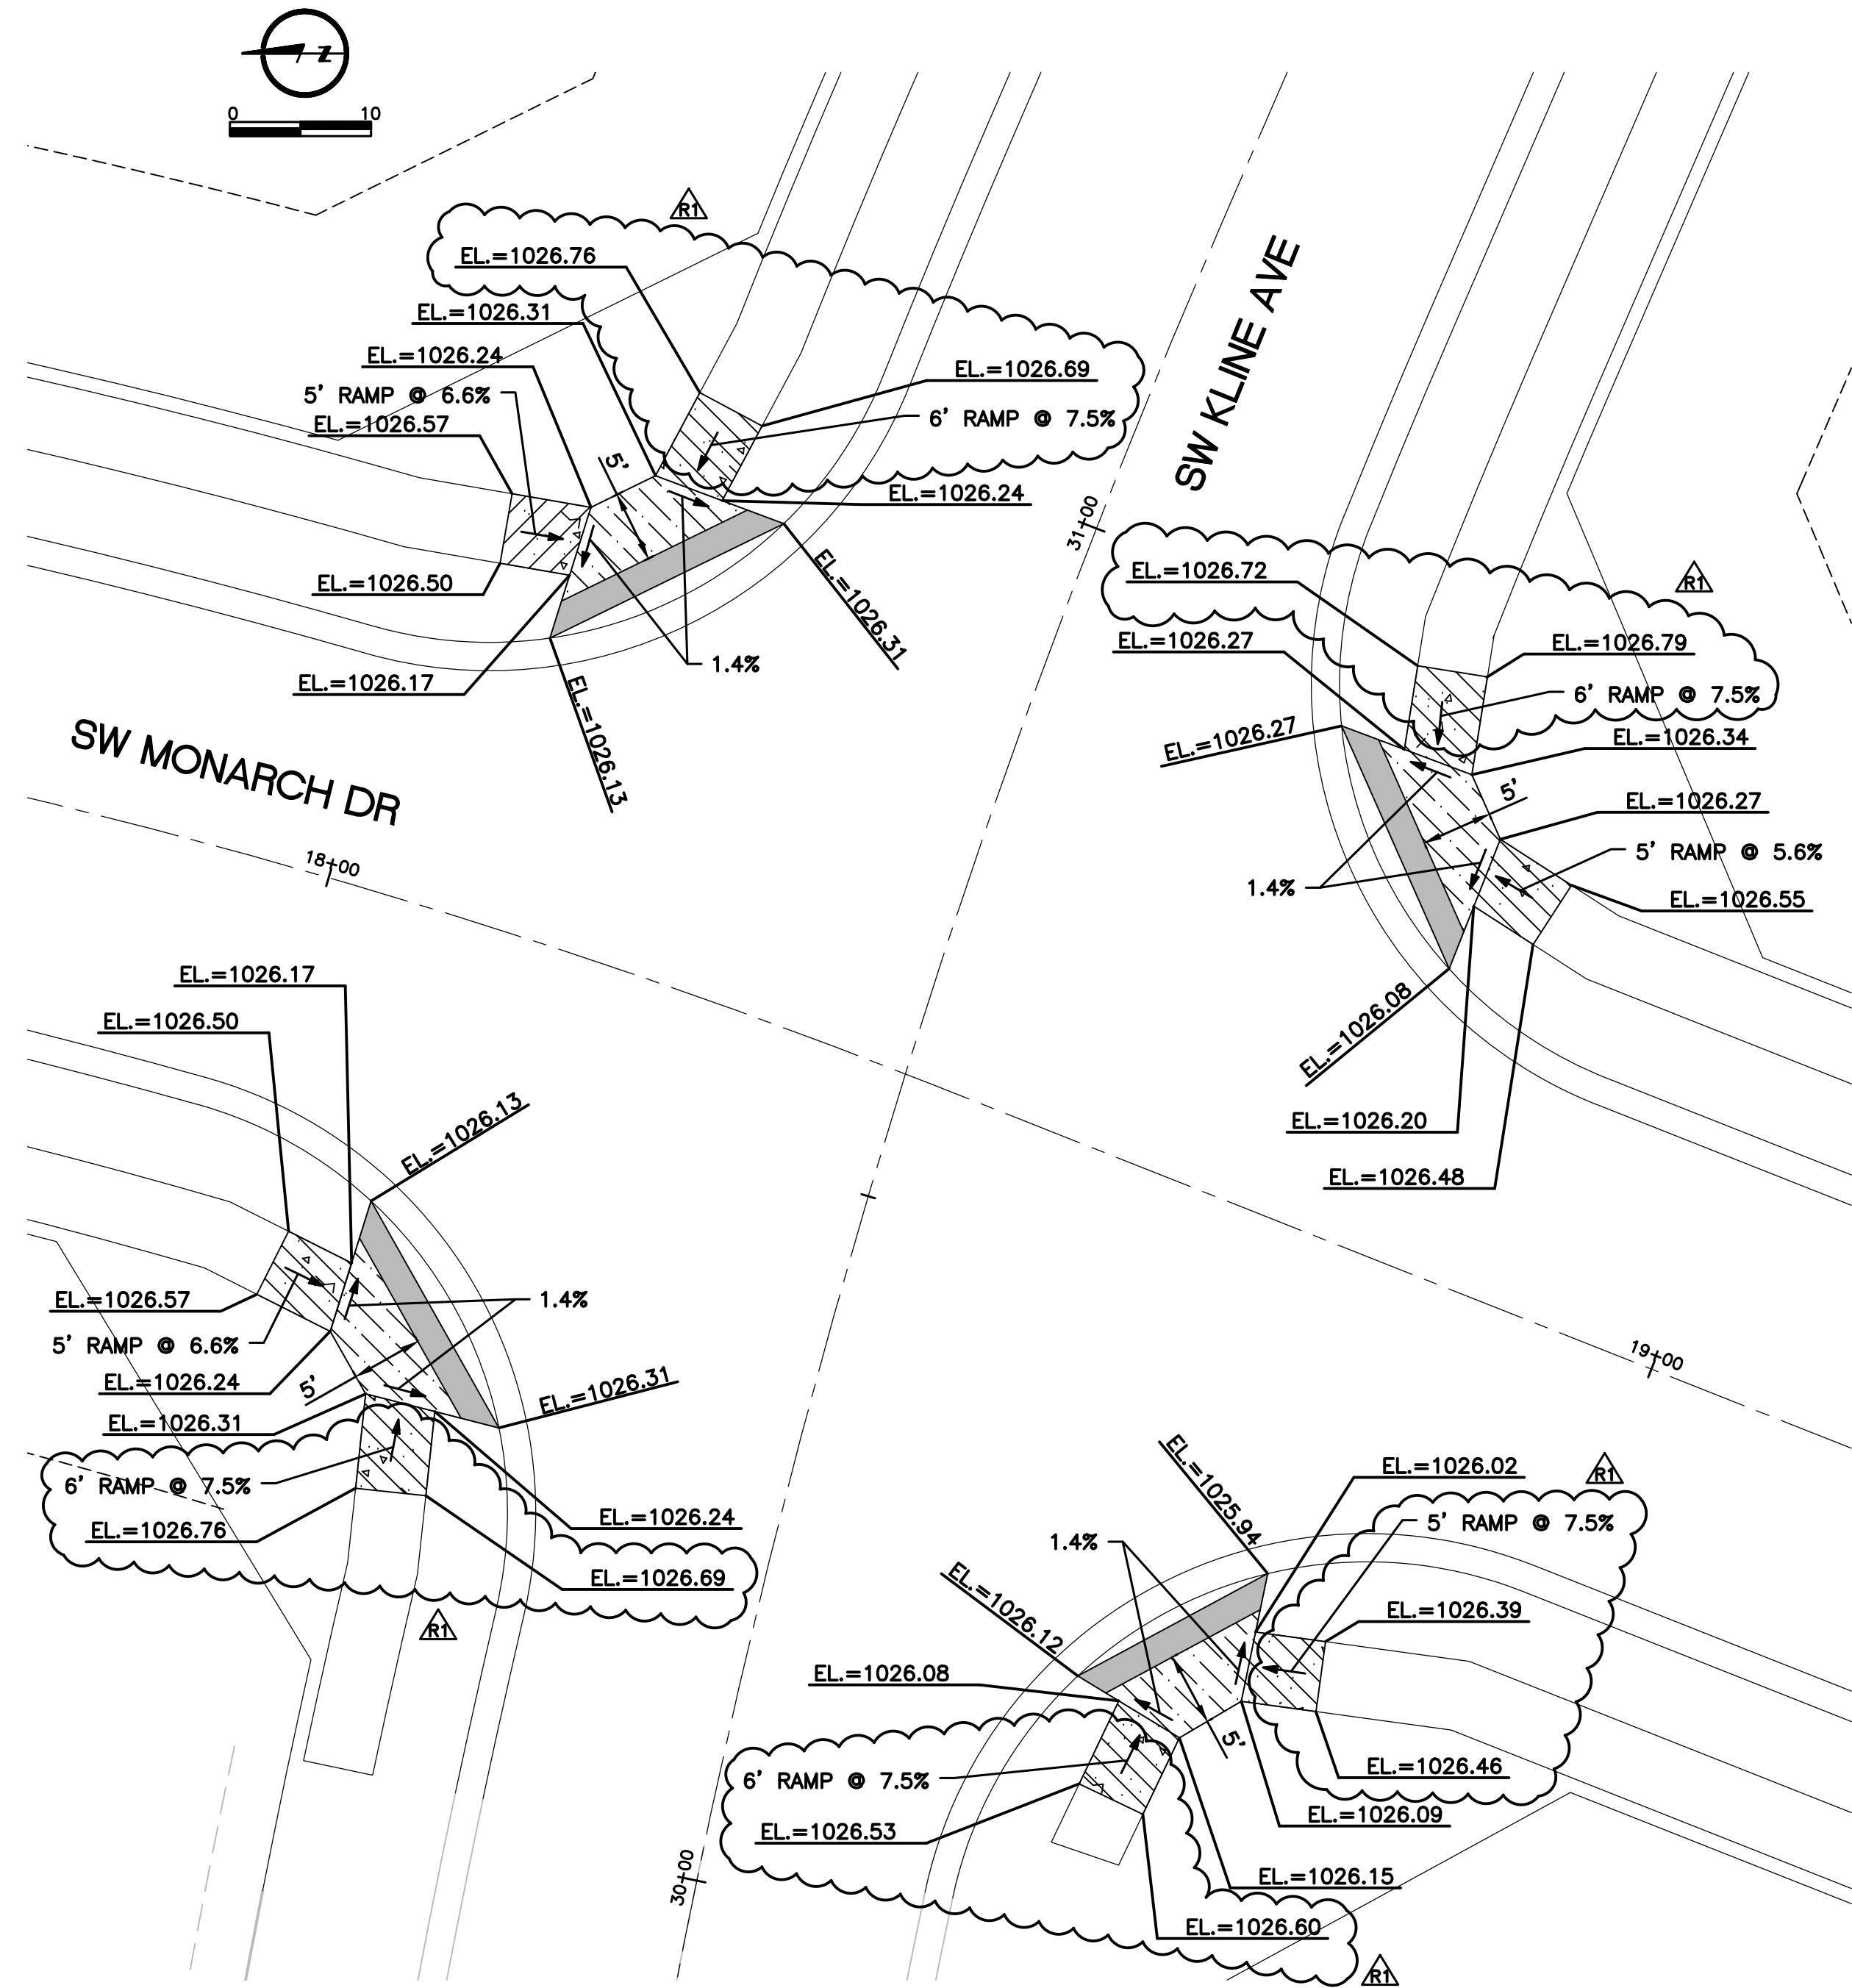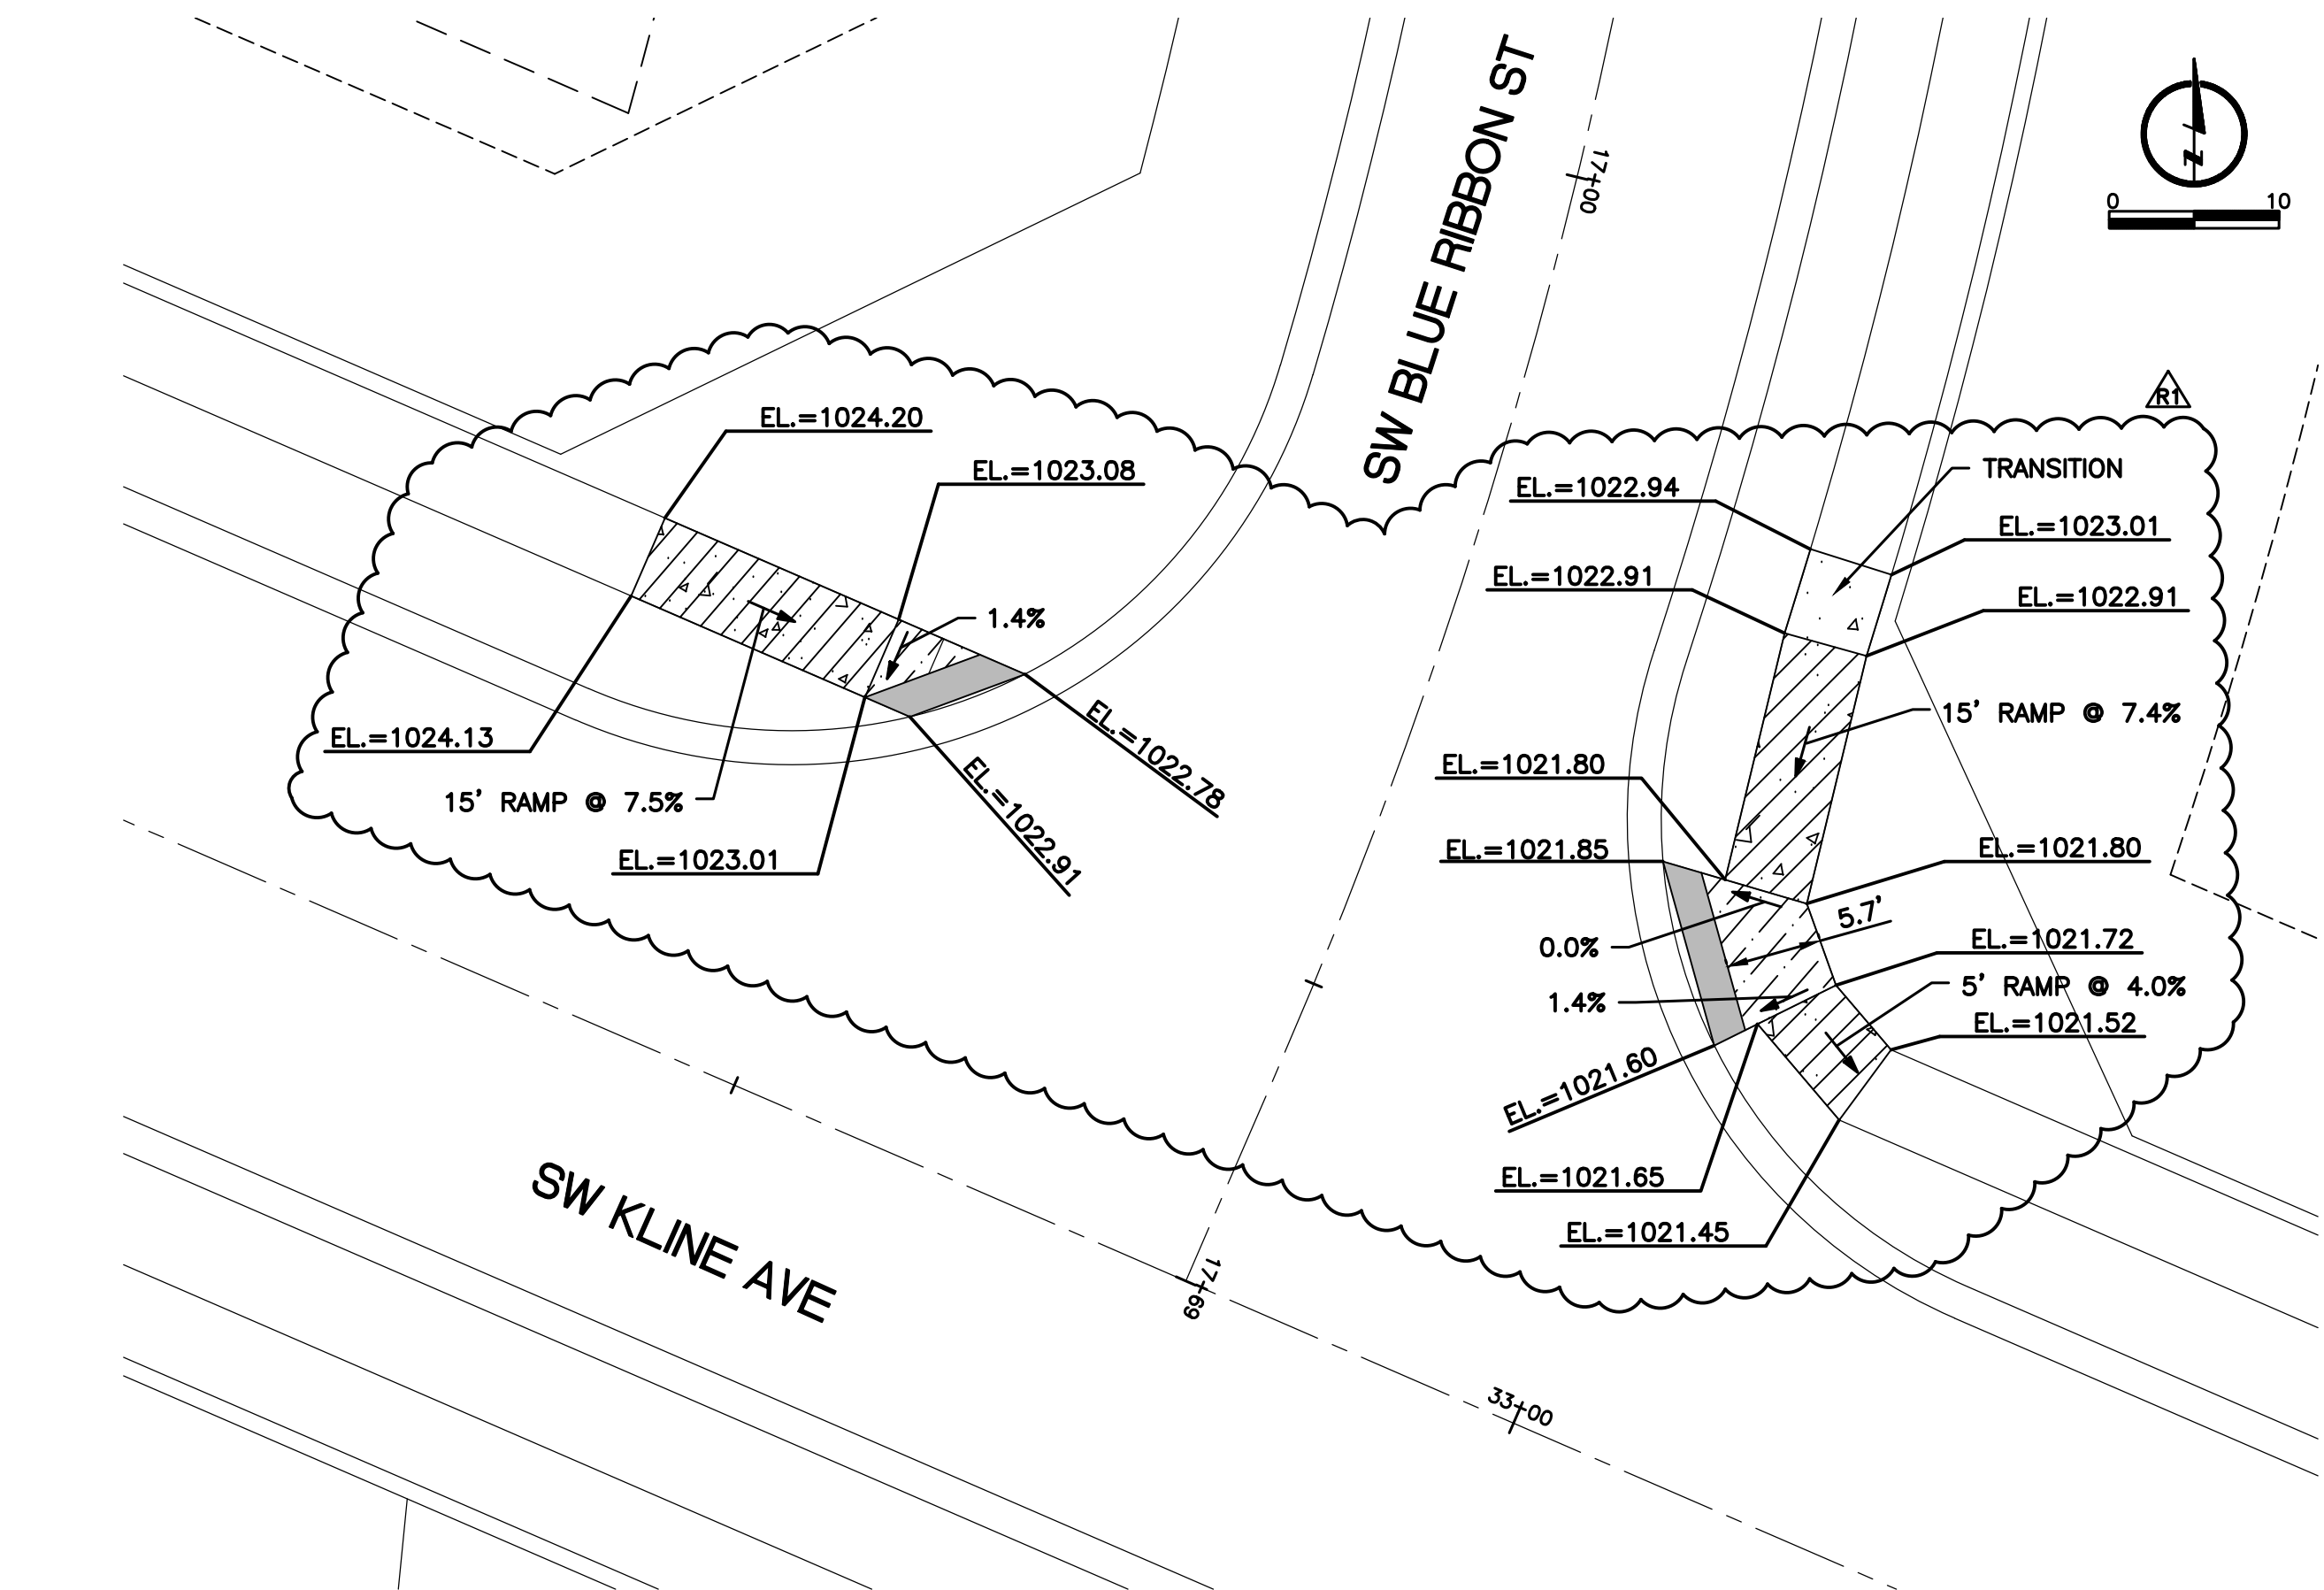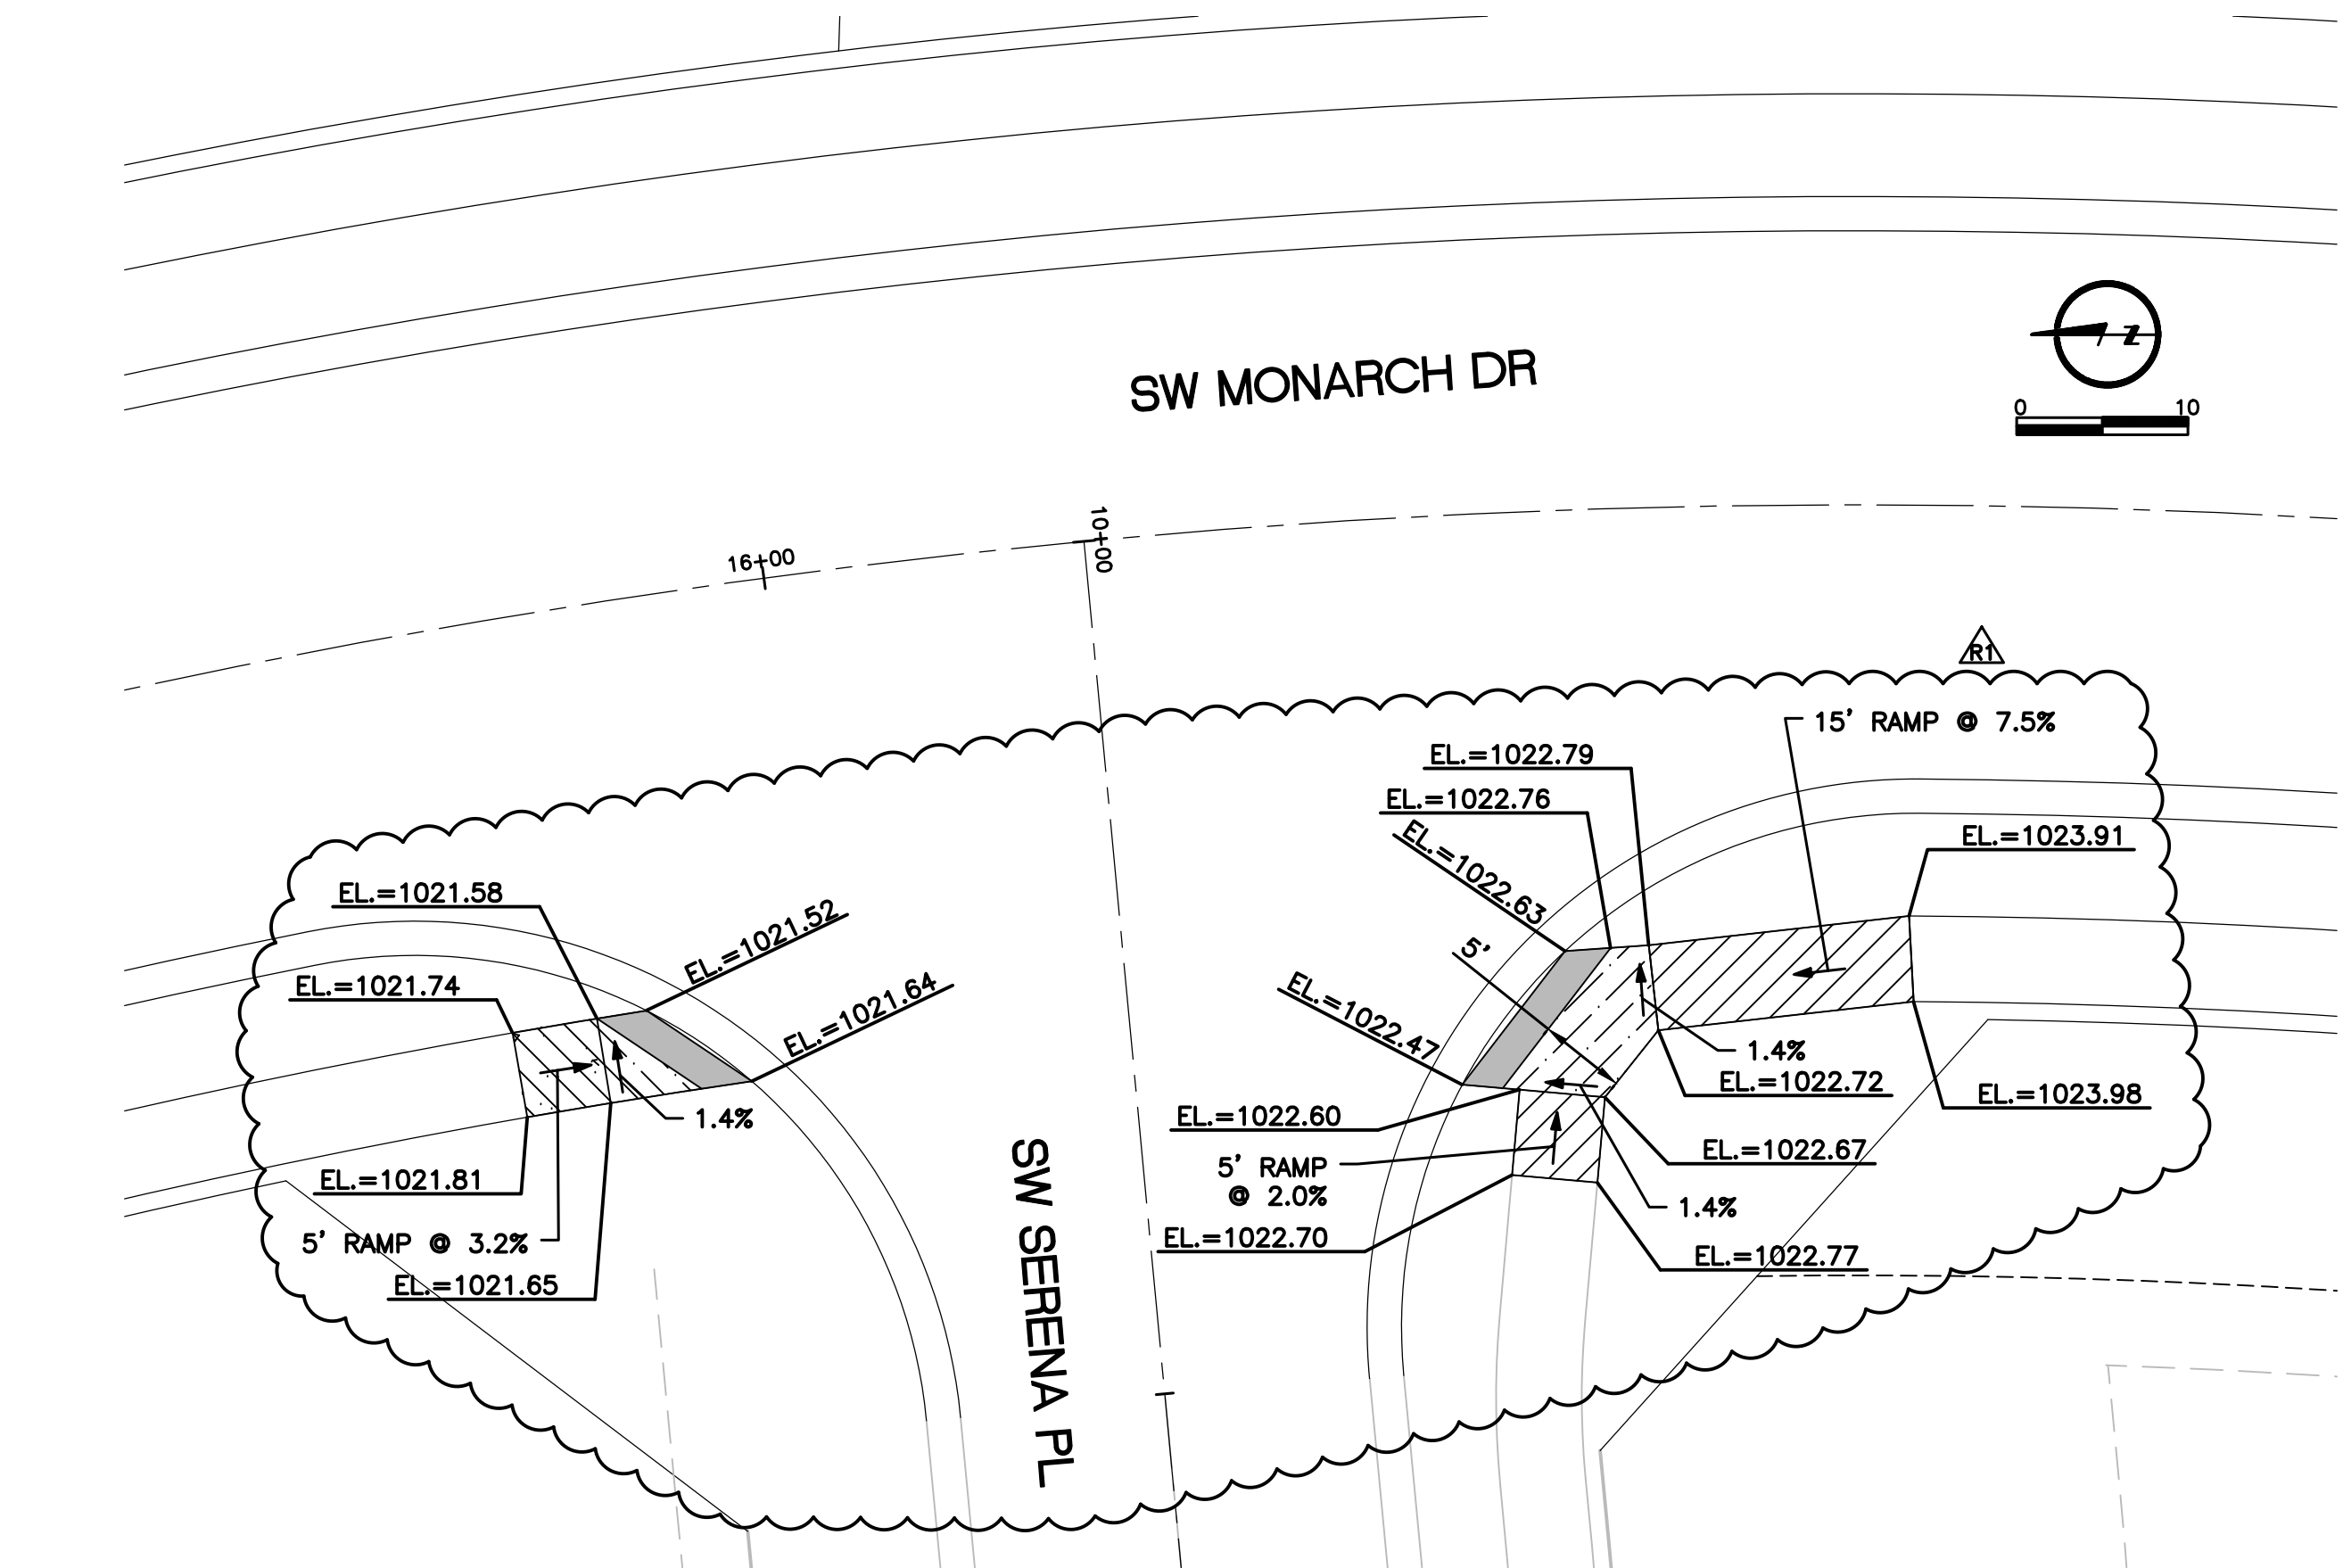


NOTE:
SEE SHEET 28 FOR ADA RAMP STANDARD DETAIL.


REVISIONS	DRAWN BY	AM
	DESIGNED BY	MDM
	DATE	10-05-2018
	JOB NUMBER-TASKS	031850.01
BOOK AND PAGE		
9001 State Line Rd., Suite 200 816.361.0440 P Kansas City, Missouri 64114 816.361.0045 F www.LRA-INC.com		
LARKIN/RYNEARSON LAMP RYNEARSON		
SUMMIT VIEW FARMS 3RD PLAT LEE'S SUMMIT, MISSOURI		
MASS GRADING, EROSION CONTROL, PAVING, STORM AND SANITARY PLANS		
INTERSECTION LAYOUT PLAN		
LARKIN LAMP RYNEARSON - ENGINEERS MEO Certificate of Authority No. 2013011903		
MARK DANIEL MCGHEE JR. PE - 2008019568		
SHEET		
20 OF 31		

L:\Engineering\031850 SVFDG Summit View Forms 3rd Plat\Drawings\CONSTRUCTION DRAWINGS\PAV-PLANS\031850-SW-RAMPS.dwg, 3/1/2019 2:17:23 PM, DAN MCGHEE, LAMP RYNEARSON & ASSOCIATES

SW MONARCH DR

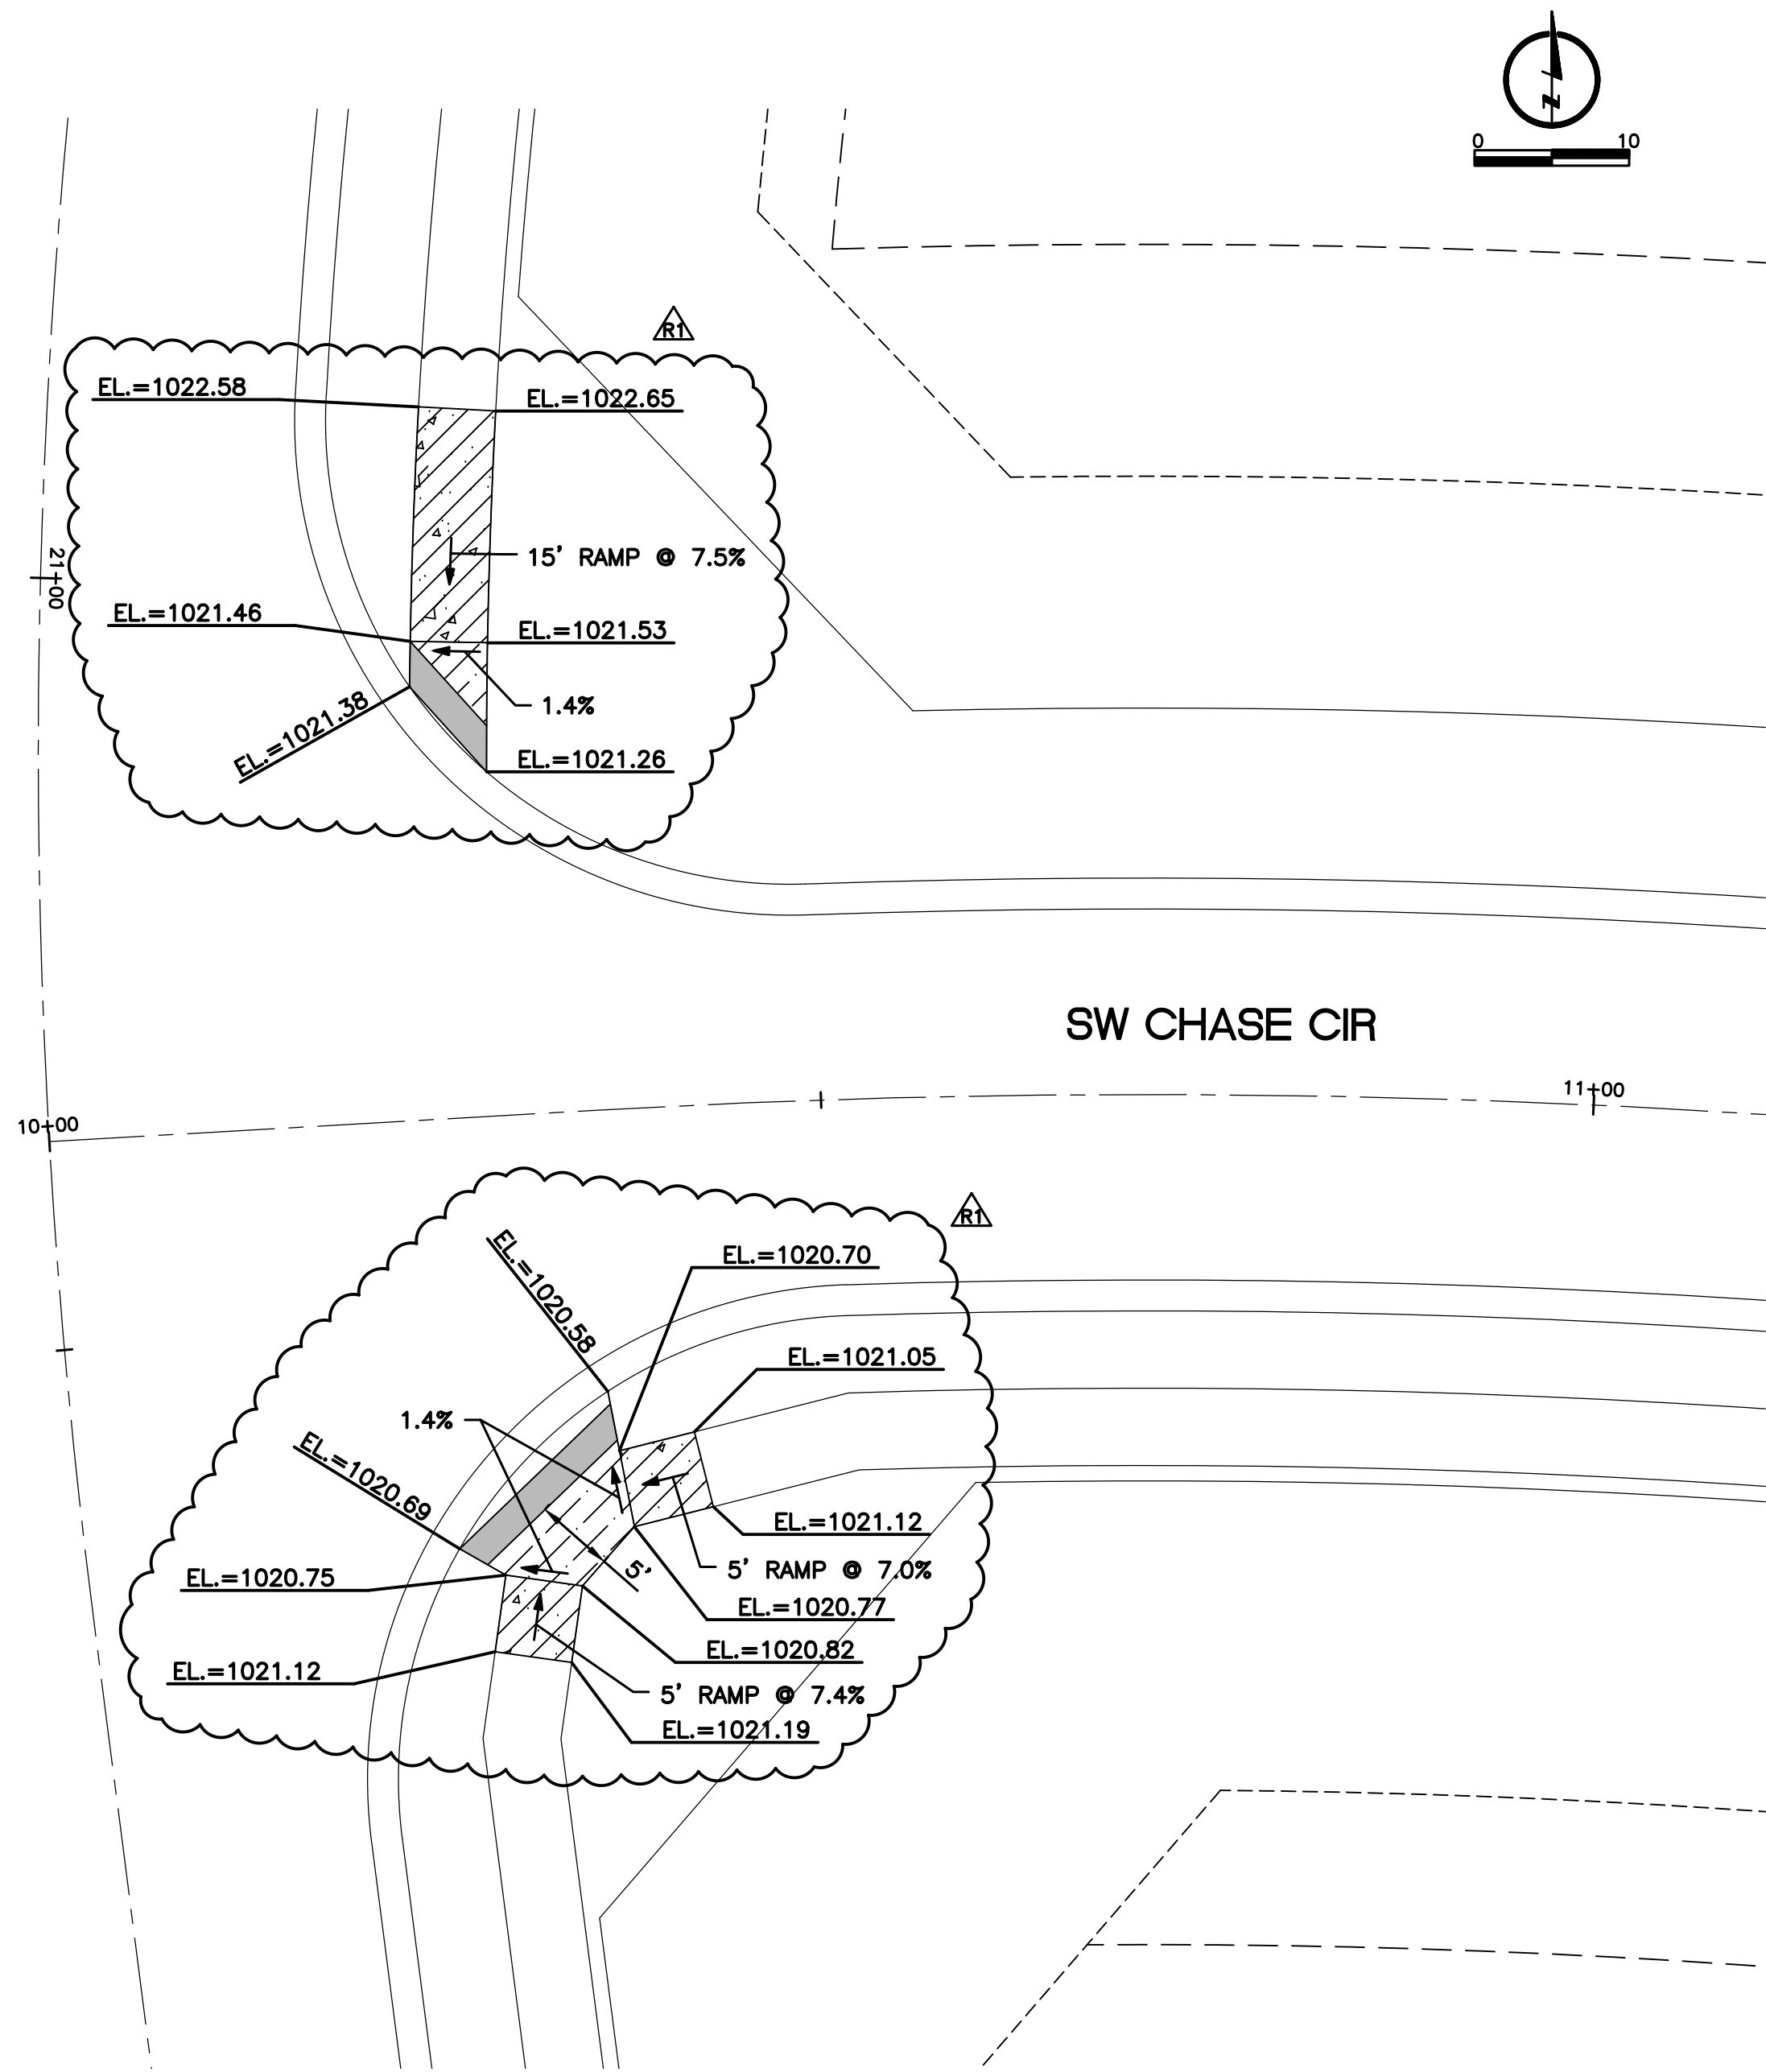

SW CHASE CIR

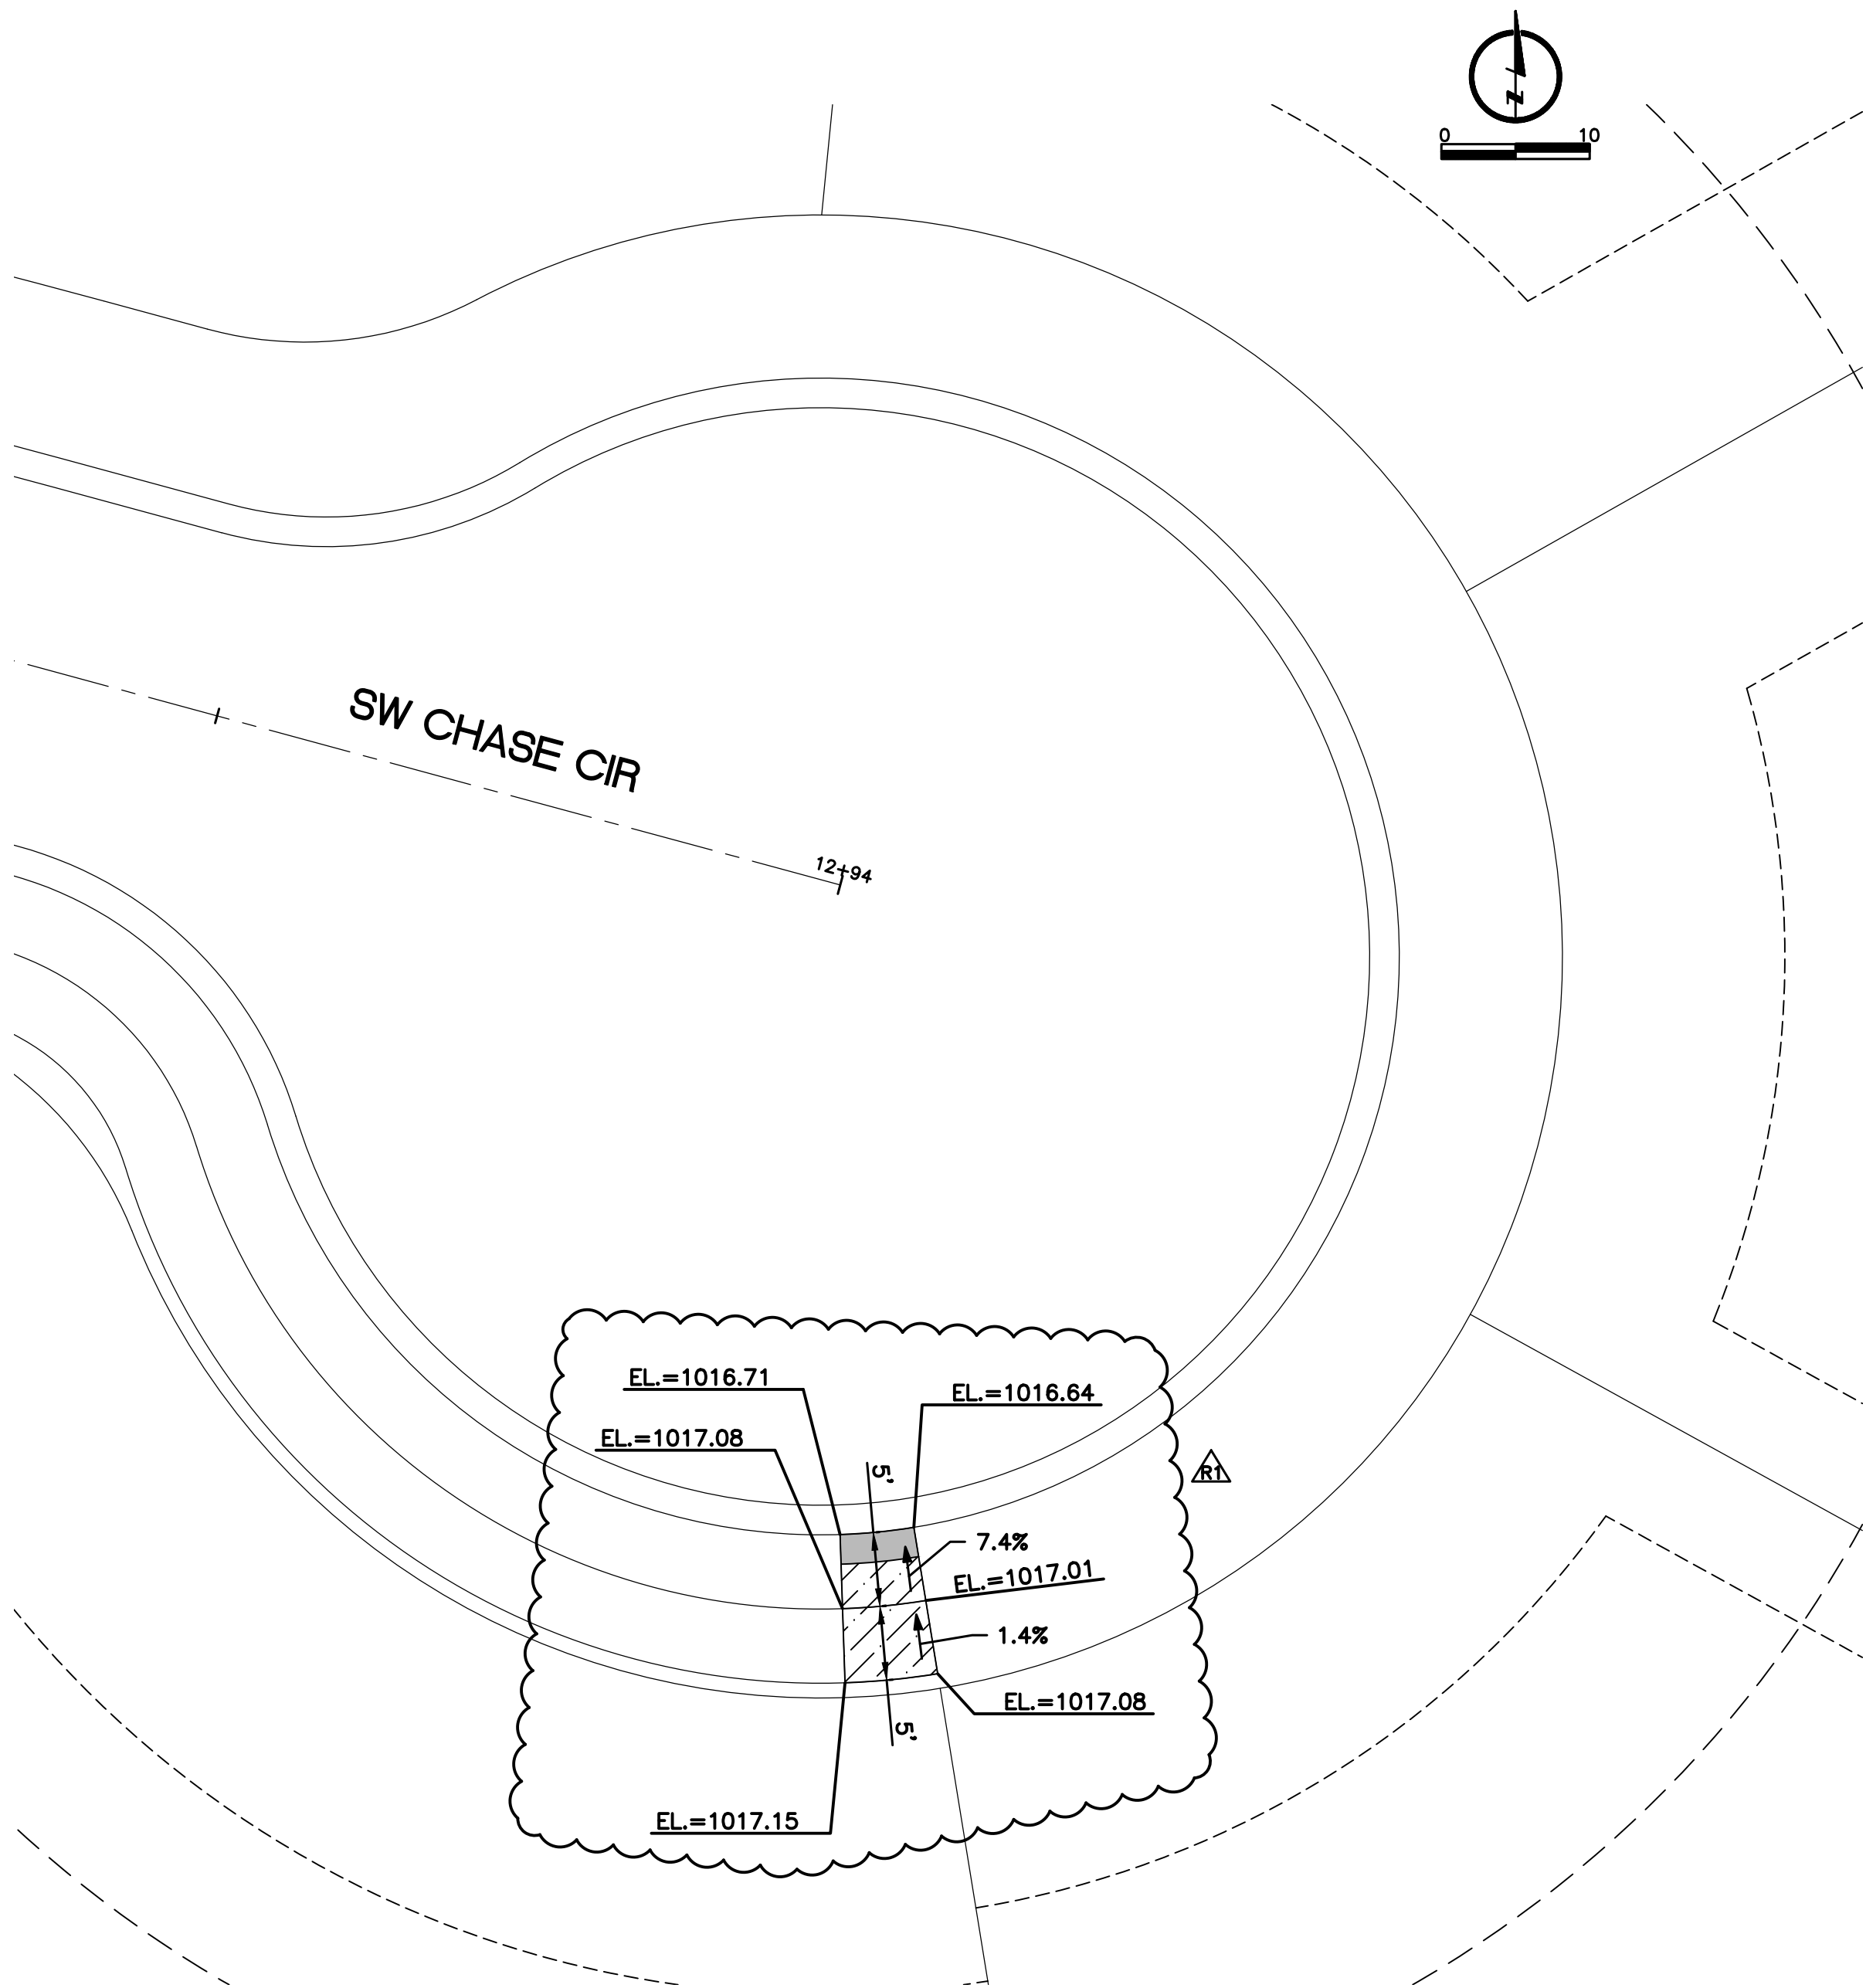

NOTE:
SEE SHEET 28 FOR ADA RAMP STANDARD DETAIL.

MASS GRADING, EROSION CONTROL,
PAVING, STORM AND SANITARY PLANS
INTERSECTION LAYOUT PLAN

LARKIN LAMP RYNEARSON - ENGINEERS
MEO Certificate of Authority No. 2013011803



MARK DANIEL MCGHEE JR.
PE - 2008019568

SHEET

21 OF 31

9001 State Line Rd., Suite 200 816.361.0440 | P
Kansas City, Missouri 64114 816.361.0045 | F
www.LRA-INC.com




SUMMIT VIEW FARMS 3RD PLAT
LEE'S SUMMIT, MISSOURI

DRAWN BY	AM
DESIGNED BY	MDM
DATE	10-05-2018
JOB NUMBER-TASKS	031850.01
BOOK AND PAGE	

REVISIONS	08/19/18 - RESUBMITAL PER ADJUSTED LAYOUT
	09/19/18 - RESUBMITAL PER CITY COMMENTS
	03/01/19 - REVISION 1

L:\Engineering\031650 SVT00 Summit View Farms 3rd Plat\Drawings\CONSTRUCTION DRAWINGS\PAV-PLANS\PAV-DRN-MAP.dwg, 9/19/2018 9:28:31 AM, JAMIE MCURRY, LAMP RYNEARSON & ASSOCIATES

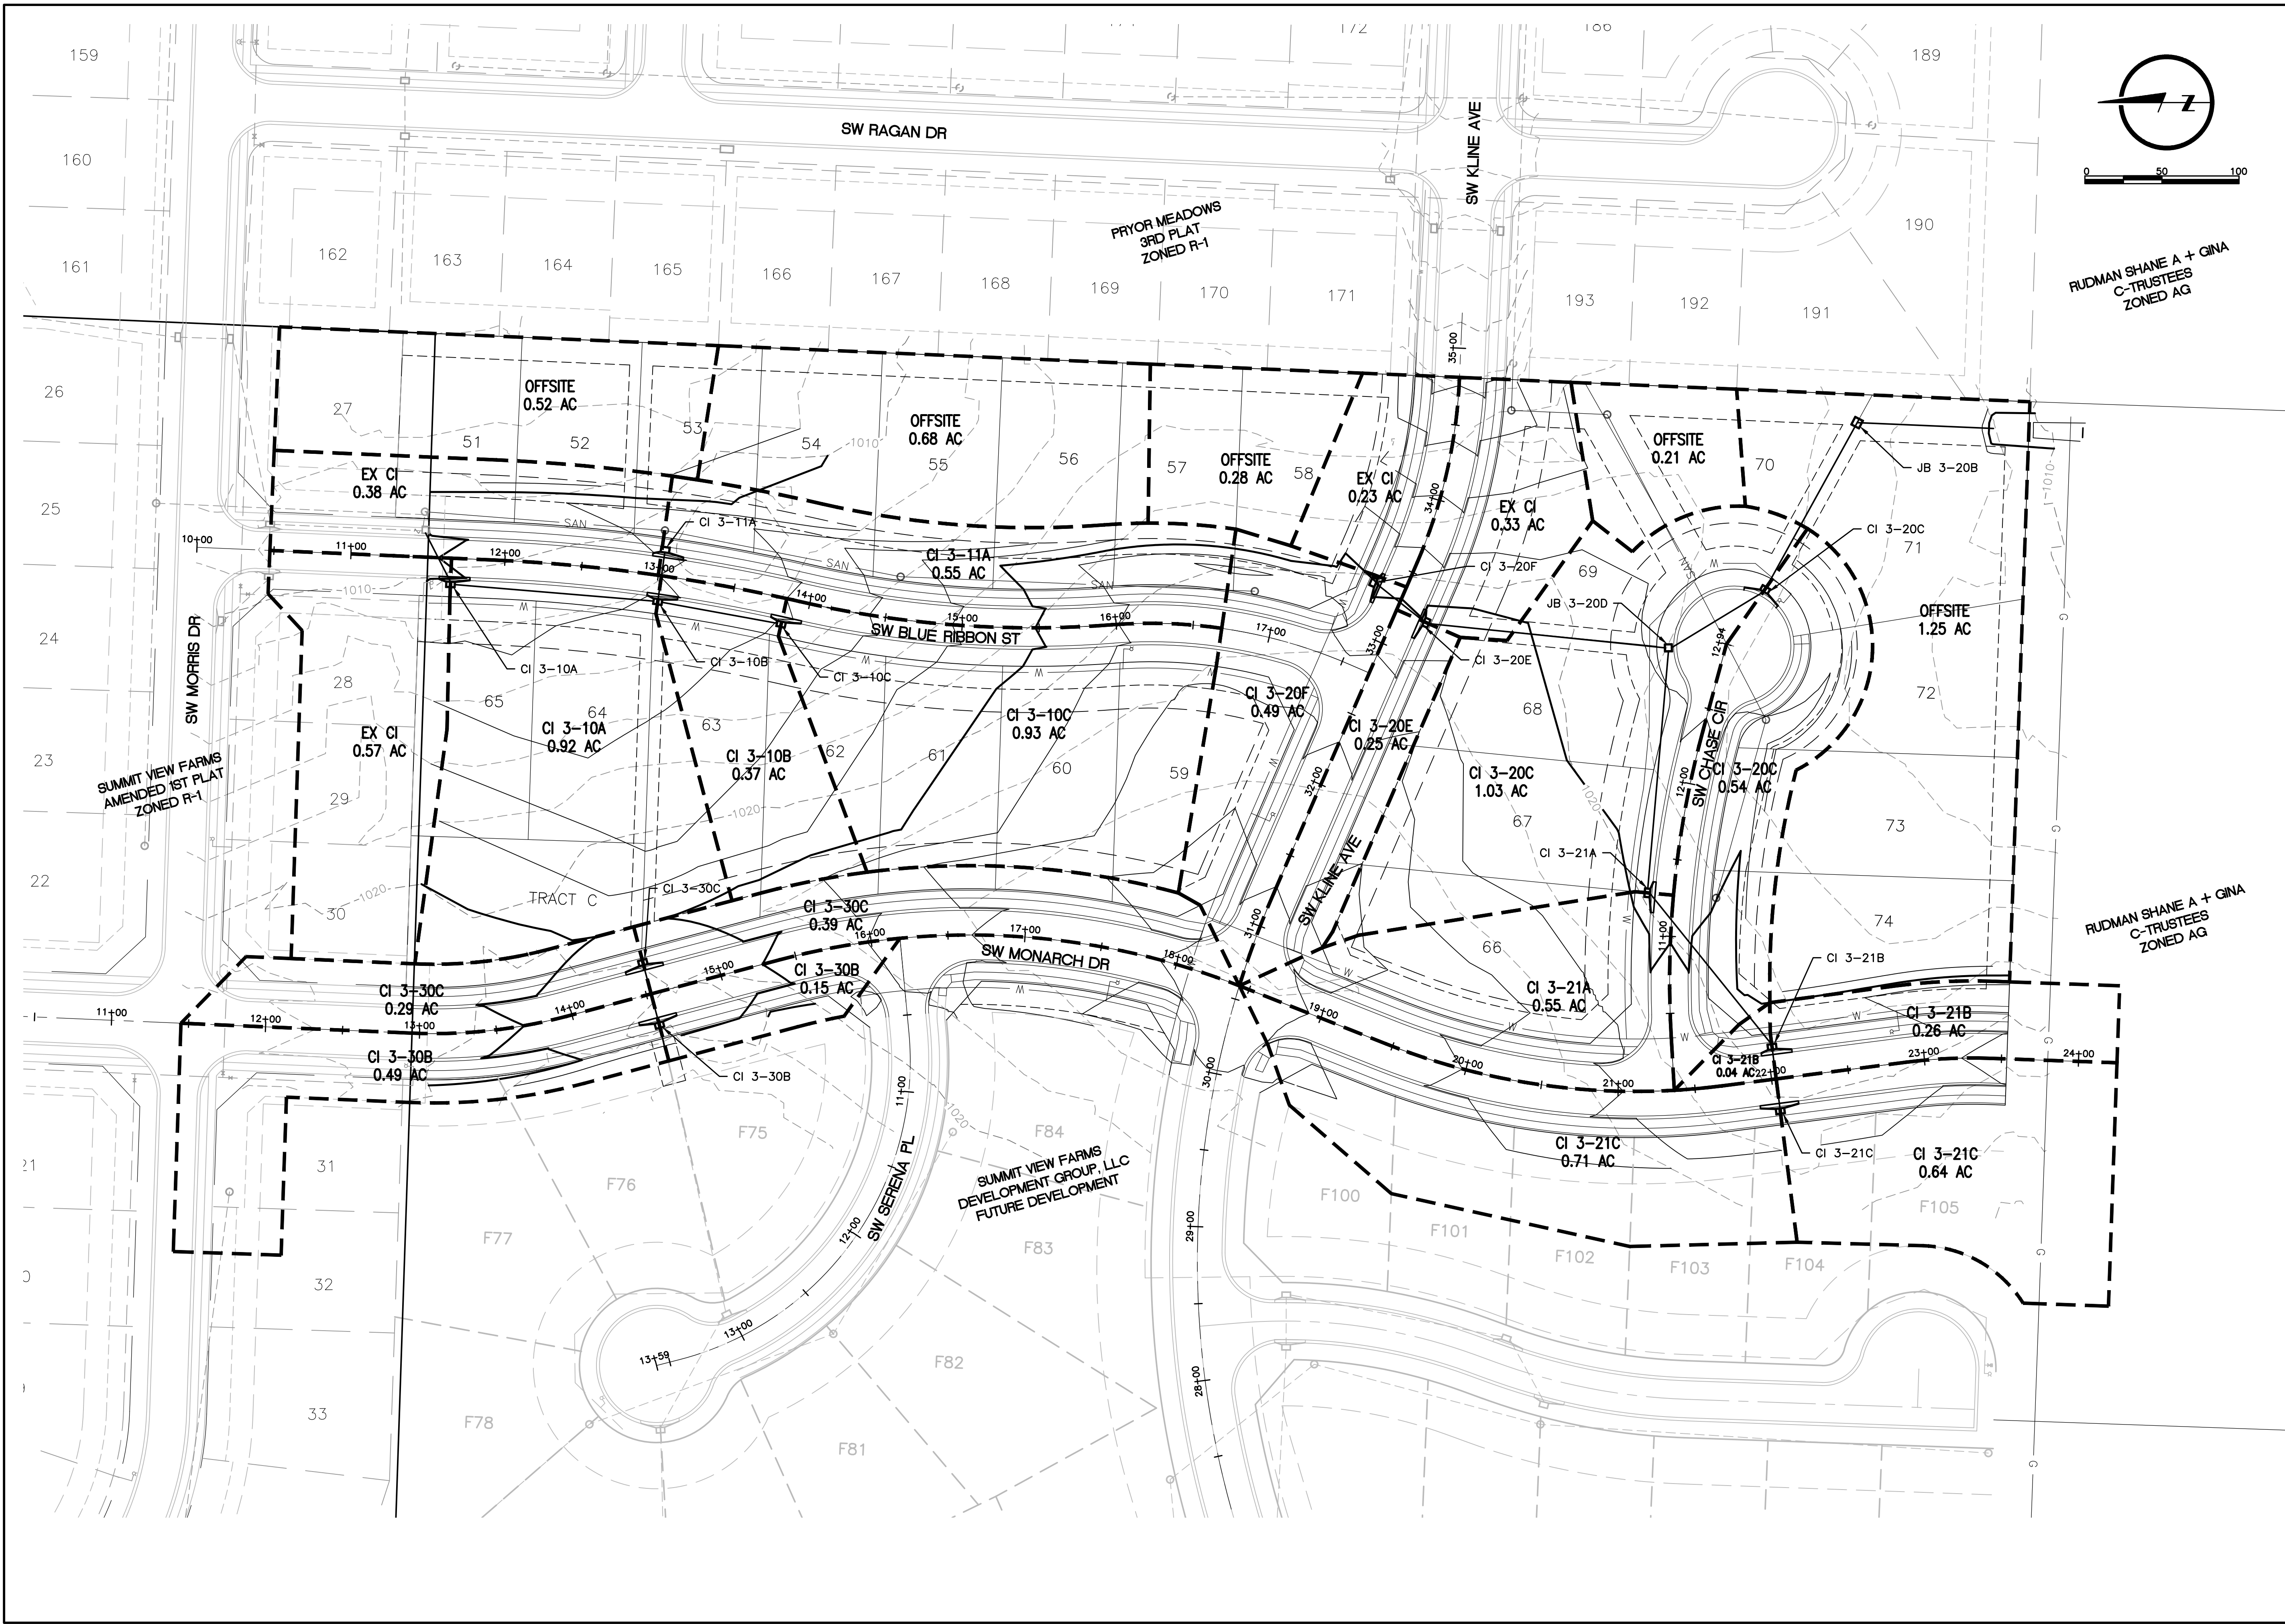

DRAWN BY JAM		DESIGNED BY MDM		DATE 09-19-2018		JOB NUMBER-TASKS 031650.01		BOOK AND PAGE	
PERSONS		REVISIONS		REVISIONS		REVISIONS		REVISIONS	
08/19/18 - RESUBMITAL PER ADJUSTED LAYOUT		09/19/18 - RESUBMITAL PER CITY COMMENTS		09/19/18 - RESUBMITAL PER CITY COMMENTS		09/19/18 - RESUBMITAL PER CITY COMMENTS		09/19/18 - RESUBMITAL PER CITY COMMENTS	
9001 State Line Rd., Suite 200 Kansas City, Missouri 64114 www.LRA-INC.com		816.361.0440 [P] 816.361.0045 [F]		816.361.0045 [F]		816.361.0045 [F]		816.361.0045 [F]	
LARKIN/ LAMP RYNEARSON		SUMMIT VIEW FARMS 3RD PLAT LEE'S SUMMIT, MISSOURI		SUMMIT VIEW FARMS 3RD PLAT LEE'S SUMMIT, MISSOURI		SUMMIT VIEW FARMS 3RD PLAT LEE'S SUMMIT, MISSOURI		SUMMIT VIEW FARMS 3RD PLAT LEE'S SUMMIT, MISSOURI	
MASS GRADING, EROSION CONTROL, PAVING, STORM AND SANITARY PLANS		DRAINAGE AREA MAP		DRAINAGE AREA MAP		DRAINAGE AREA MAP		DRAINAGE AREA MAP	
LARKIN LAMP RYNEARSON - ENGINEERS		LMO Certificate of Authority No. 2013011903		LMO Certificate of Authority No. 2013011903		LMO Certificate of Authority No. 2013011903		LMO Certificate of Authority No. 2013011903	
STATE OF MISSOURI MARK DANIEL MCGHEE JR. PE-2008019568 09-19-2018		STATE OF MISSOURI MARK DANIEL MCGHEE JR. PE-2008019568 09-19-2018		STATE OF MISSOURI MARK DANIEL MCGHEE JR. PE-2008019568 09-19-2018		STATE OF MISSOURI MARK DANIEL MCGHEE JR. PE-2008019568 09-19-2018		STATE OF MISSOURI MARK DANIEL MCGHEE JR. PE-2008019568 09-19-2018	
MARK DANIEL MCGHEE JR. PE-2008019568		MARK DANIEL MCGHEE JR. PE-2008019568		MARK DANIEL MCGHEE JR. PE-2008019568		MARK DANIEL MCGHEE JR. PE-2008019568		MARK DANIEL MCGHEE JR. PE-2008019568	
SHEET		SHEET		SHEET		SHEET		SHEET	
22 OF 31		22 OF 31		22 OF 31		22 OF 31		22 OF 31	

L:\Engineering\031850 SVFDG Summit View Forms 3rd Plat\DRAWINGS\CONSTRUCTION DRAWINGS\PAV-PLANS\PAV-CRI-MAP.dwg, 9/19/2018 9:54:57 AM, JAMIE MCJURRY, LAMP RYNEARSON & ASSOCIATES

SUMMIT VIEW FARMS 3RD PLAT STORM SEWER CALCULATIONS																																												
PIPE	NODE UPSTREAM DOWNSTREAM	INLET TC (MIN)	INLET AREA (ACRES)	RUNOFF COEFF.	TOTAL CA (ACRES)	10% STORM INTENSITY (IN/HR)	10% RUNOFF (CFS)	TOTAL 10% RUNOFF (CFS)	10% RUNOFF CAPTURED (CFS)	10% PIPE FLOW (CFS)	DESIGN VELOCITY (FT/S)	FULL FLOW VELOCITY (FT/S)	FULL FLOW CAPACITY (CFS)	TOTAL 1% RUNOFF (CFS)	1% PIPE FLOW (CFS)	1% STORM	10% STORM HGL UPSTREAM DOWNSTREAM (FT)	1% STORM HGL UPSTREAM DOWNSTREAM (FT)	INVERT UPSTREAM DOWNSTREAM (FT)	SECTION MATERIAL	SECTION SIZE	SLOPE (%)	LENGTH (FT)	10% SPREAD (FT)	25% SPREAD (FT)																			
LINE 3-10																																												
1	CI 3-10A JB 103633	7.0	0.92	0.51	0.47	6.8	3.19	3.64	2.71	8.73	6.39	6.03	10.65	7.44	13.24	SUR.	1006.54 1006.03	1007.37 1006.75	1005.40 1005.00	HDPE	18"	1.03	38.87	11.55	N/A																			
2	CI 3-10B CI 3-10A	6.6	0.37	0.51	0.19	6.9	1.30	2.45	2.00	6.02	4.89	6.27	11.07	5.24	9.08	SUR.	1008.35 1006.93	1010.01 1009.00	1007.40 1005.90	HDPE	18"	1.11	134.93	10.12	N/A																			
3	CI 3-10C CI 3-10B	7.2	0.93	0.51	0.47	6.7	3.19	3.19	2.04	2.04	3.78	7.14	8.77	5.62	2.66	SUR.	1010.07 1008.71	1011.09 1010.96	1009.50 1008.00	HDPE	15"	1.84	81.39	9.73	N/A																			
LINE 3-11																																												
4	CI 3-11A CI 3-10B	7.0	0.55	0.65	0.36	6.8	2.43	2.43	1.99	1.99	3.04	5.34	7.83	4.27	3.00	SUR.	1008.81 1008.72	1011.01 1010.94	1008.25 1007.90	HDPE	15"	1.03	34.00	10.09	N/A																			
LINE 3-20																																												
5	JB 3-20B FES 3-20A	N/A	N/A	N/A	N/A	N/A	N/A	N/A	N/A	17.25	6.14	6.13	29.23	N/A	29.76	PIPE	1010.10 1009.63	1010.79 1010.34	1008.70 1008.25	RCP	30"	0.54	83.57	N/A	N/A																			
6	CI 3-20C JB 3-20B	7.3	1.57	0.54	0.85	6.7	5.69	5.99	5.99	17.25	6.43	8.57	42.05	10.91	29.76	PIPE	1011.90 1010.49	1012.36 1011.59	1010.50 1009.20	HDPE	30"	1.05	123.63	11.93 (N) 9.56 (S)	N/A																			
7	JB 3-20D CI 3-20C	N/A	N/A	N/A	N/A	N/A	N/A	N/A	N/A	11.59	5.51	7.28	22.88	N/A	18.85	PIPE	1012.95 1012.28	1013.31 1012.70	1011.75 1011.00	HDPE	24"	1.02	73.28	N/A	N/A																			
8	CI 3-20E JB 3-20D	6.0	0.25	0.70	0.18	7.1	1.28	1.28	1.23	3.26	4.92	5.92	7.27	2.17	4.55	PIPE	1015.69 1013.55	1015.86 1013.90	1015.00 1013.00	HDPE	15"	1.27	157.88	5.92	6.42																			
9	CI 3-20F CI 3-20E	6.9	0.49	0.60	0.29	6.8	2.37	2.37	2.03	2.03	4.11	5.66	6.94	3.53	2.68	PIPE	1016.53 1015.94	1016.66 1016.18	1016.00 1015.50	RCP	15"	1.16	43.29	6.97	7.57																			
LINE 3-21																																												
10	CI 3-21A JB 3-20D	6.5	0.55	0.55	0.30	6.9	2.10	2.10	1.79	8.33	6.33	6.13	10.84	3.69	14.30	SUR.	1015.07 1013.24	1016.71 1013.75	1013.95 1012.25	HDPE	18"	1.07	159.59	9.84	N/A																			
11	CI 3-21B CI 3-21A	6.6	0.30	0.71	0.21	6.9	1.46	1.46	1.46	6.54	5.43	5.98	10.56	2.57	11.51	SUR.	1016.74 1015.40	1019.74 1018.20	1015.75 1014.45	HDPE	18"	1.01	128.57	4.30 (N) 7.66 (S)	4.65 (N) 8.32 (S)																			
12	CI 3-21C CI 3-21B	6.8	1.35	0.55	0.74	6.8	5.08	5.08	5.08	5.08	5.77	5.74	7.05	8.94	8.94	SUR.	1017.66 1017.04	1021.12 1020.32	1016.75 1016.25	RCP	15"	1.19	42.00	9.94 (N) 9.61 (S)	10.83 (N) 10.46 (S)																			
LINE 3-30																																												
13	CI 3-30B FES 3-30A	7.4	0.64	0.66	0.42	6.7	2.83	2.83	2.83	6.13	8.54	11.84	14.53	4.99	10.80	PIPE	1015.75 1014.13	1015.95 1014.36	1014.75 1013.56	HDPE	15"	5.06	42.00	9.08 (N) 6.31 (S)	9.88 (N) 6.85 (S)																			
14	CI 3-30C CI 3-30B	6.4	0.68	0.70	0.48	6.9	3.30	3.30	3.30	3.30	3.93	5.74	7.05	5.81	5.81	SUR.	1016.48 1016.17	1017.18 1016.84	1015.75 1015.25	RCP	15"	1.19	23.50	7.91 (N) 8.68 (S)	8.60 (N) 9.45 (S)																			

NOTES
REFER TO STORM SEWER PLAN AND PROFILE SHEETS FOR FINAL PIPE MATERIALS, ELEVATIONS, AND SLOPES.

RIP RAP CALCULATIONS
Using USDA, SCS (1975) procedure (containing nomographs)
Minimum tailwater condition
1% Storm depth of flow at pipe outlet = 2.11 ft (pipe is 85% full)
1% Storm pipe velocity = 6.72 ft/s
D₅₀ Riprap size = intersection of depth and velocity curve = 0.6 ft (using 9-inches)
Apron length corresponding to depth and velocity intersection, at 2.11 ft depth = 18 feet (use 20 feet)

DRAWN BY
AJM

DESIGNED BY
MDM

DATE
09-19-2018

JOB NUMBER-TASKS
031850.01

BOOK AND PAGE

REVISIONS

08/19/18 - RESUBMITAL PER ADJUSTED LAYOUT

09/19/18 - RESUBMITAL PER CITY COMMENTS

9001 State Line Rd., Suite 200
Kansas City, Missouri 64114
www.LRA-Inc.com

LARKIN/
LAMP RYNEARSON



MASS GRADING, EROSION CONTROL,
PAVING, STORM AND SANITARY PLANS

DRAINAGE CALCULATIONS

LARKIN LAMP RYNEARSON - ENGINEERS
MEO Certificate of Authority No. 2013011803



09-19-2018


MARK DANIEL MCGHEE JR.
PE - 2008019568

SHEET


23

OF


31

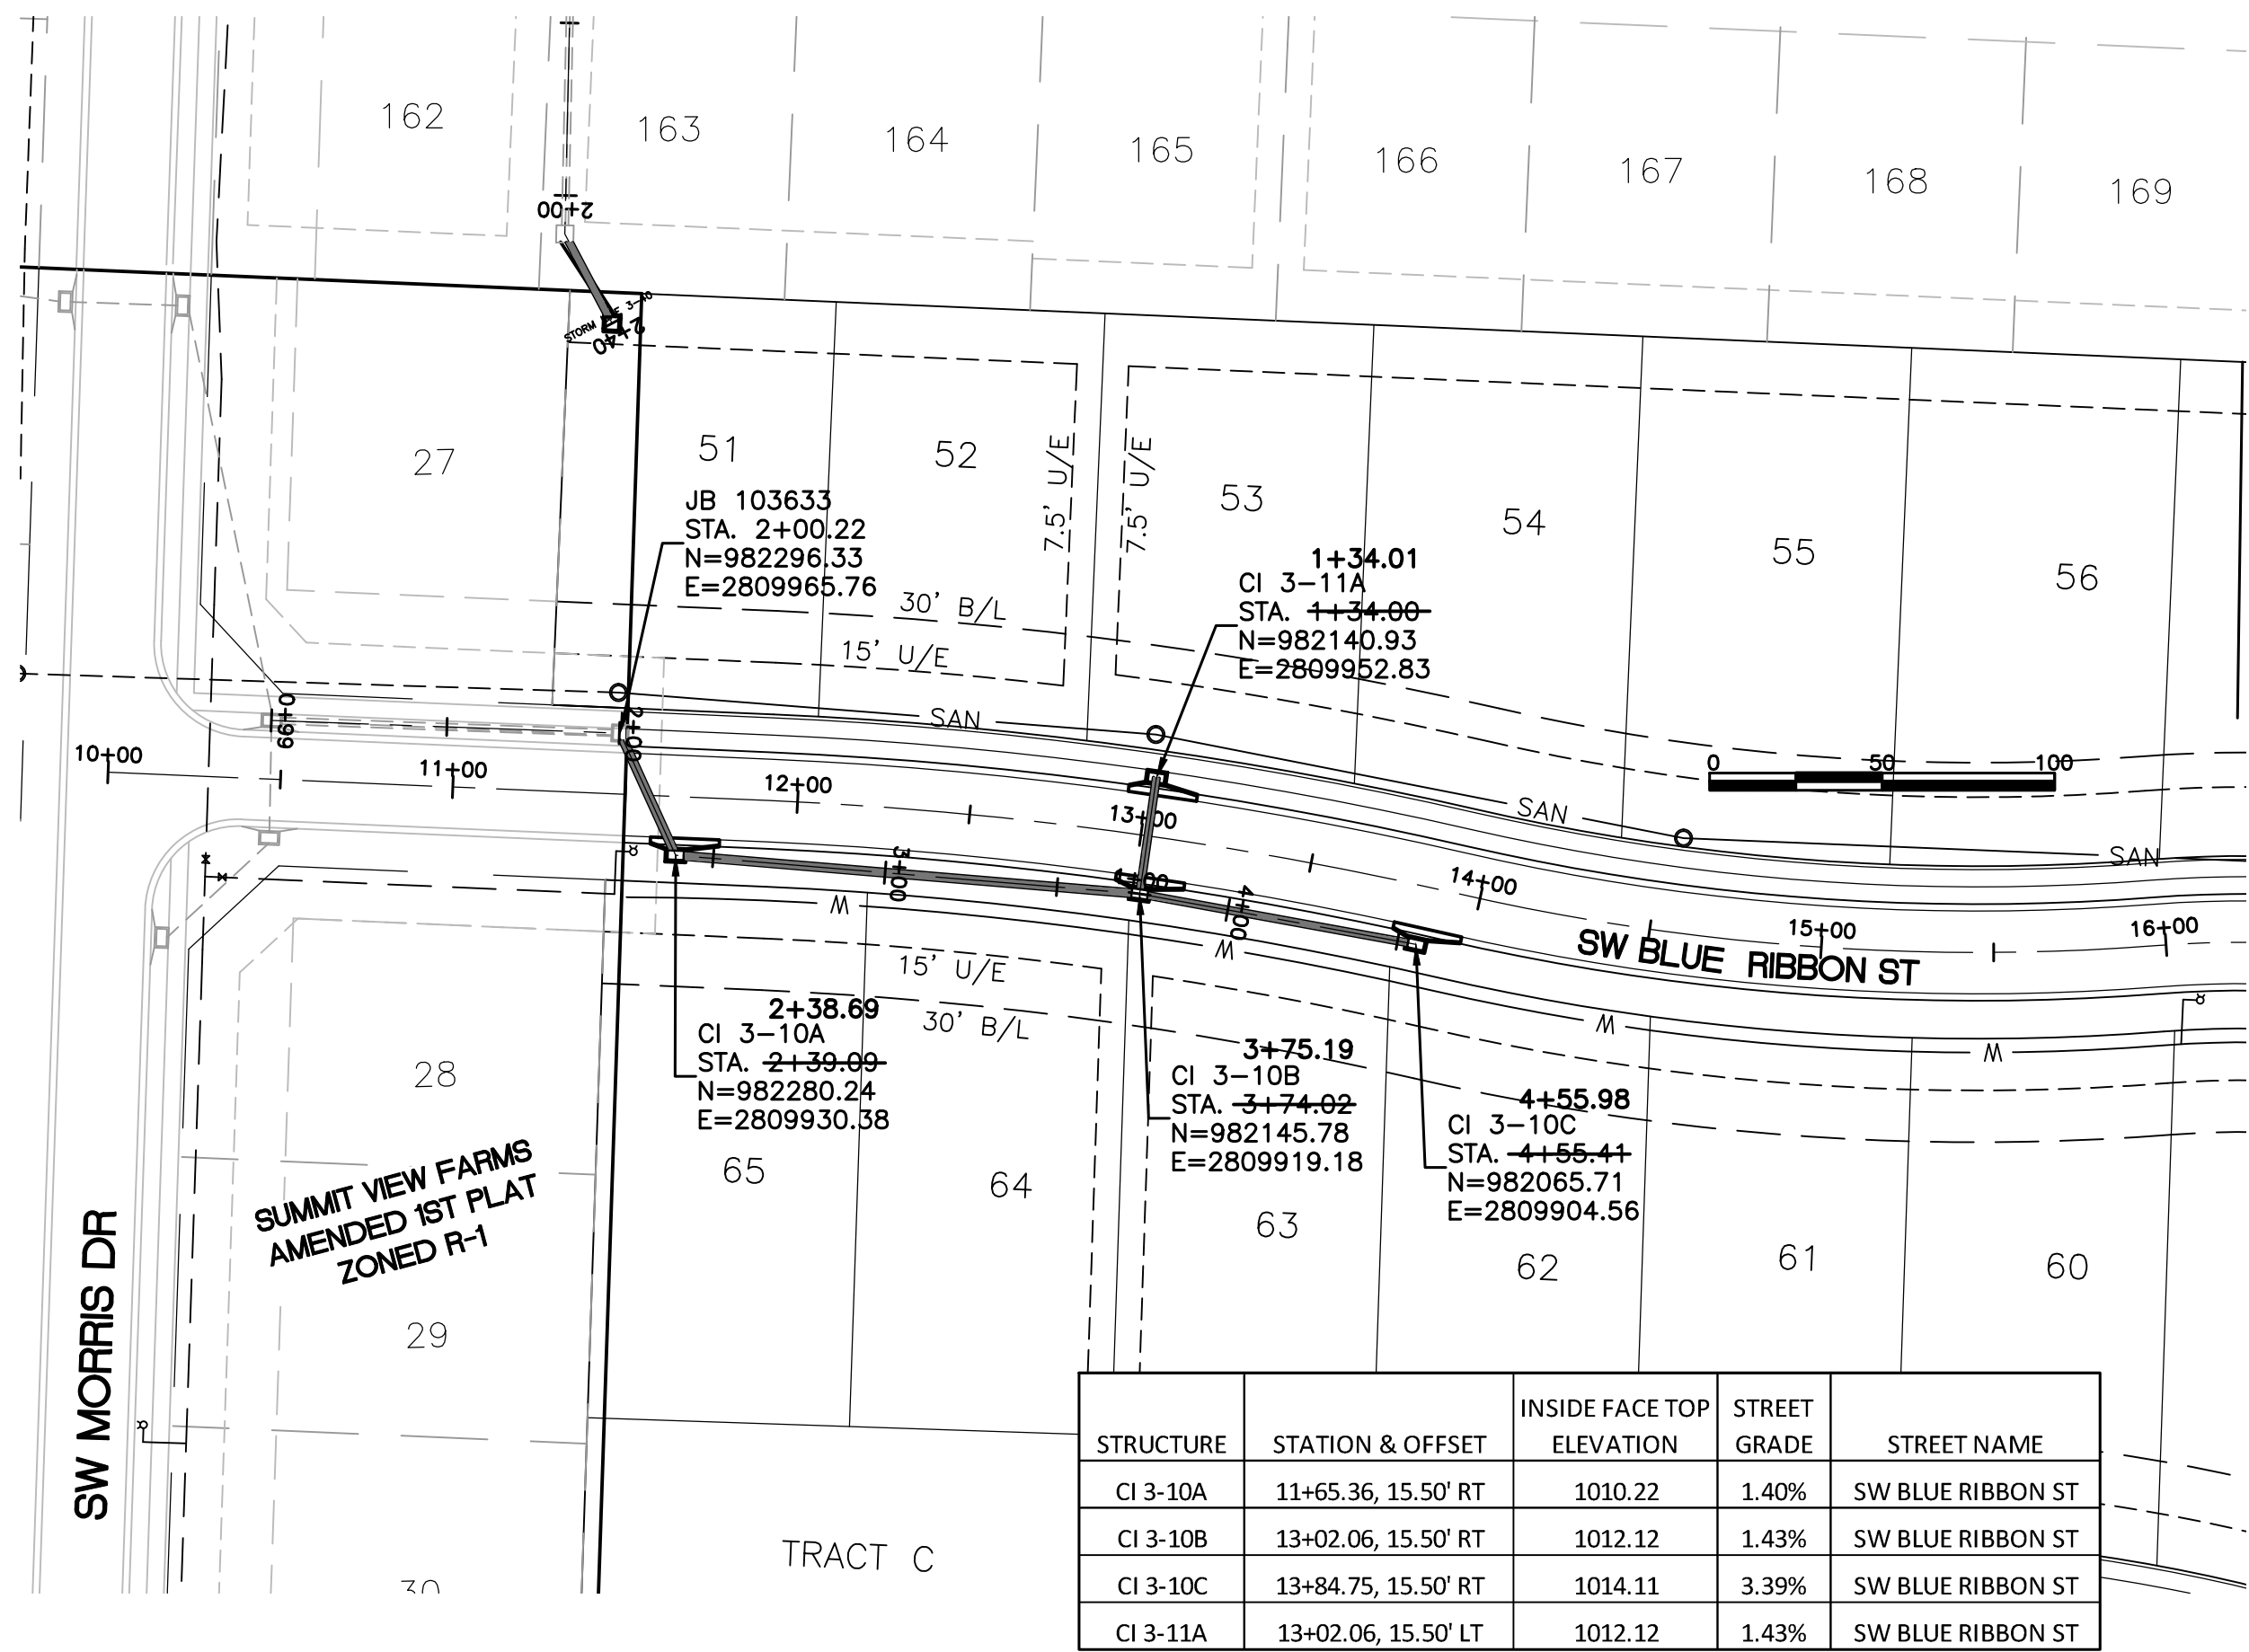


STORM LINE 3-10

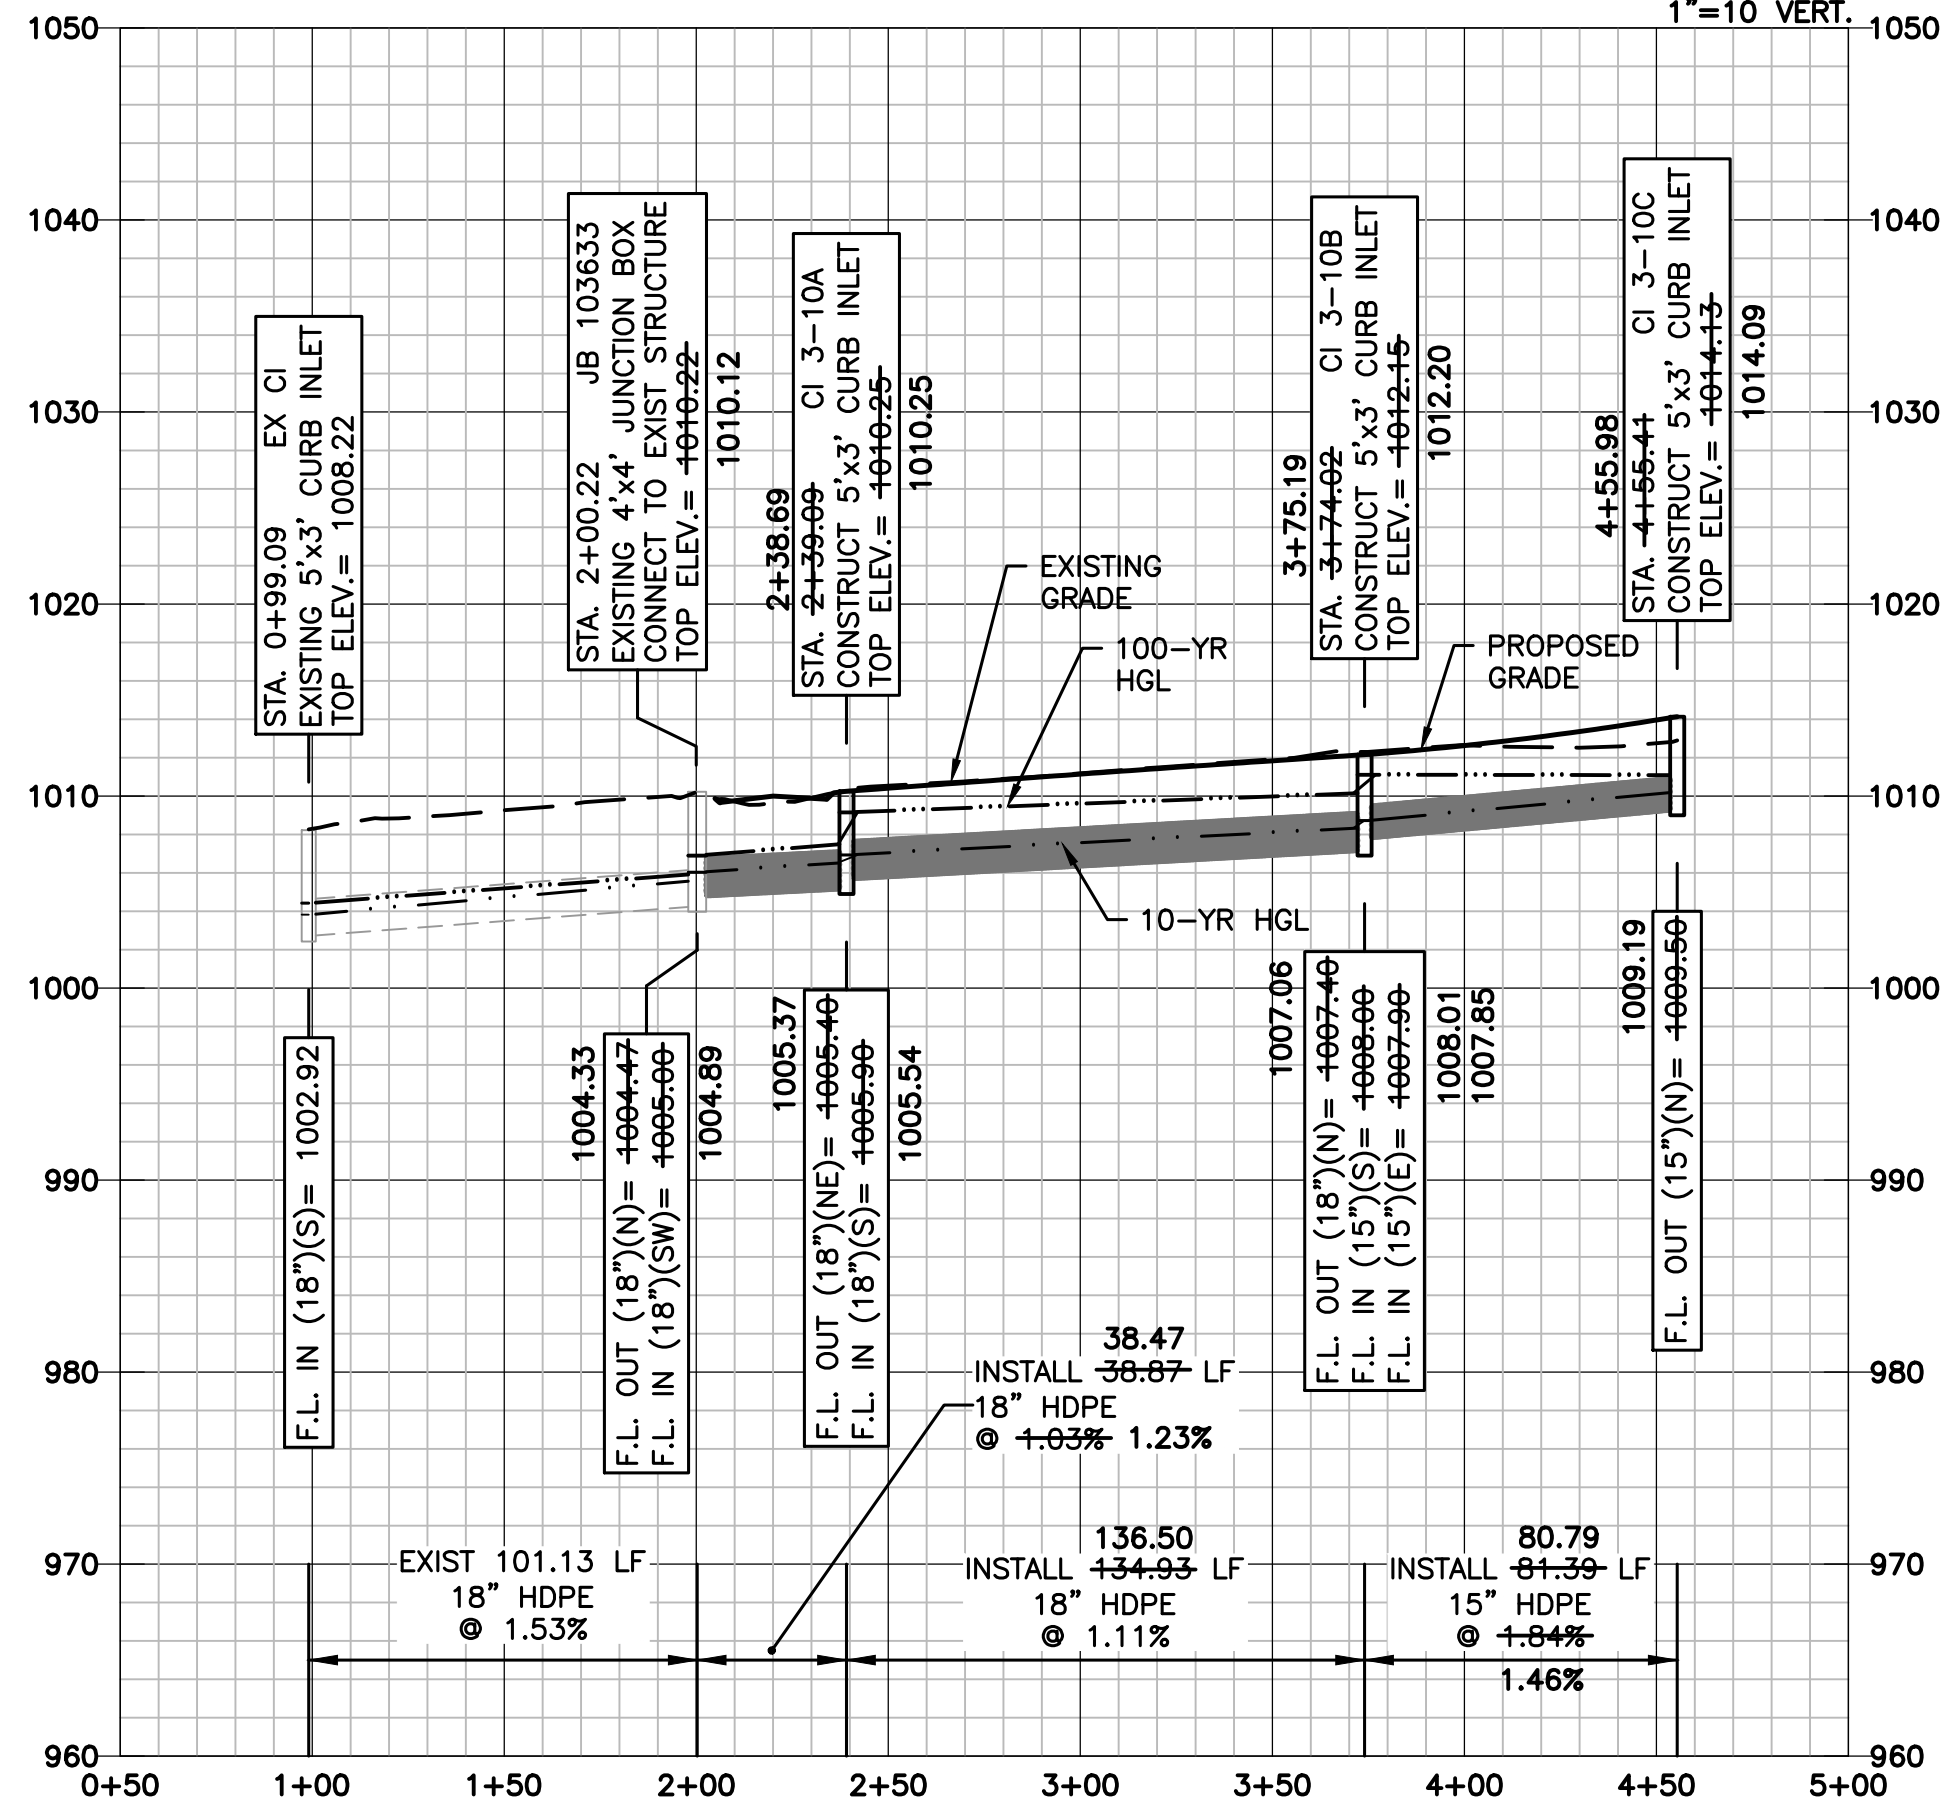Scales: 1"=50 HOR.
1"=10 VERT.

STORM LINE 3-11

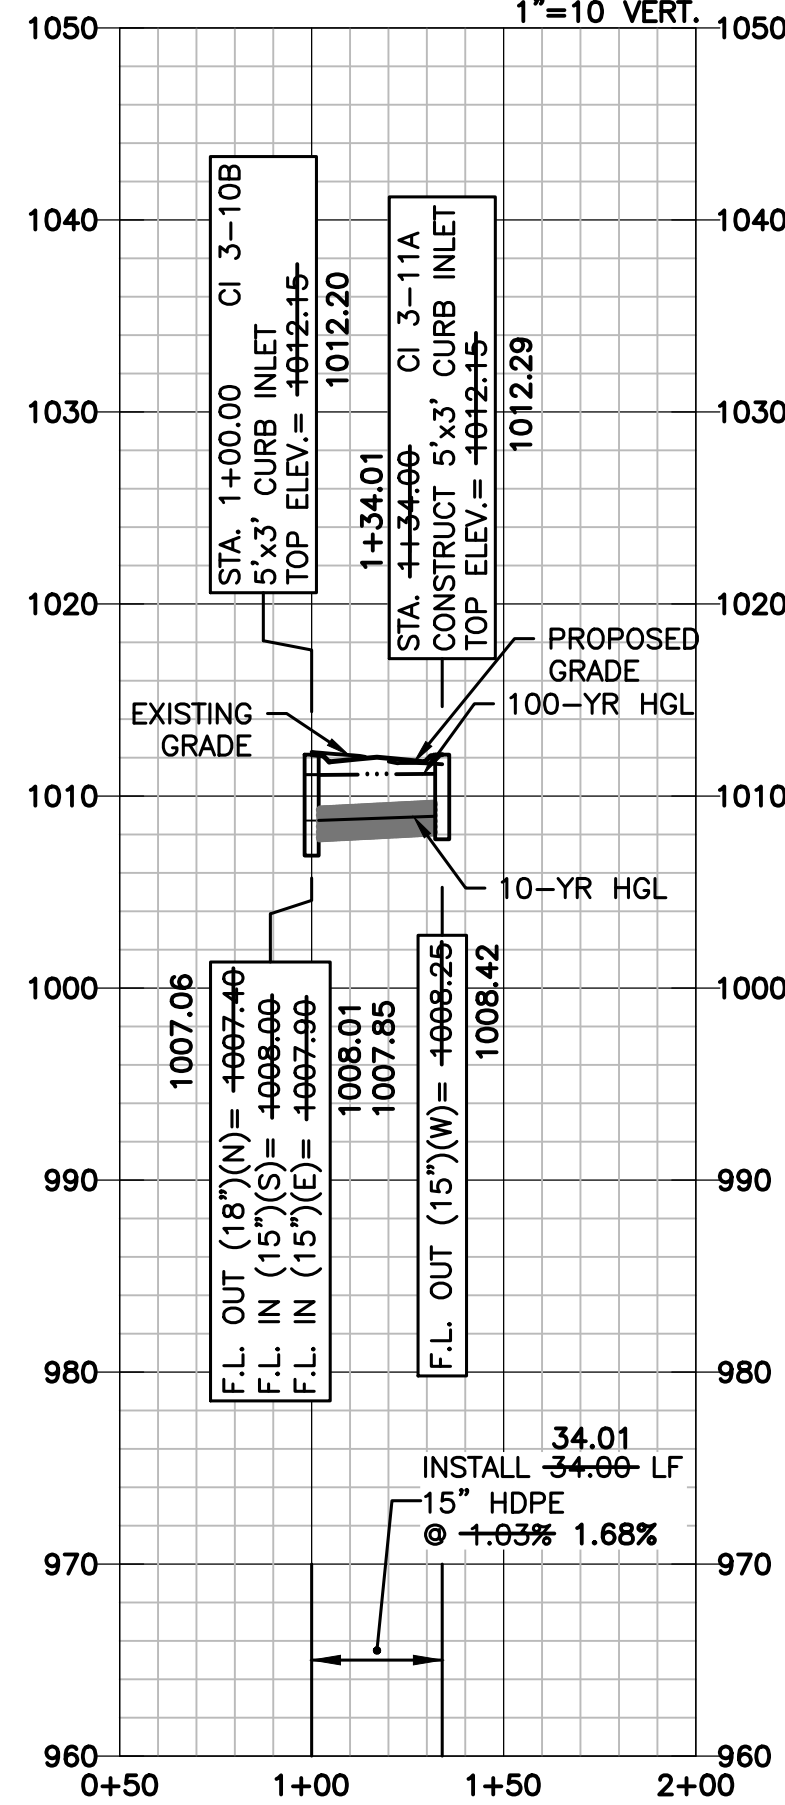Scales: 1"=50 HOR.
1"=10 VERT.

STORM LINE 3-30

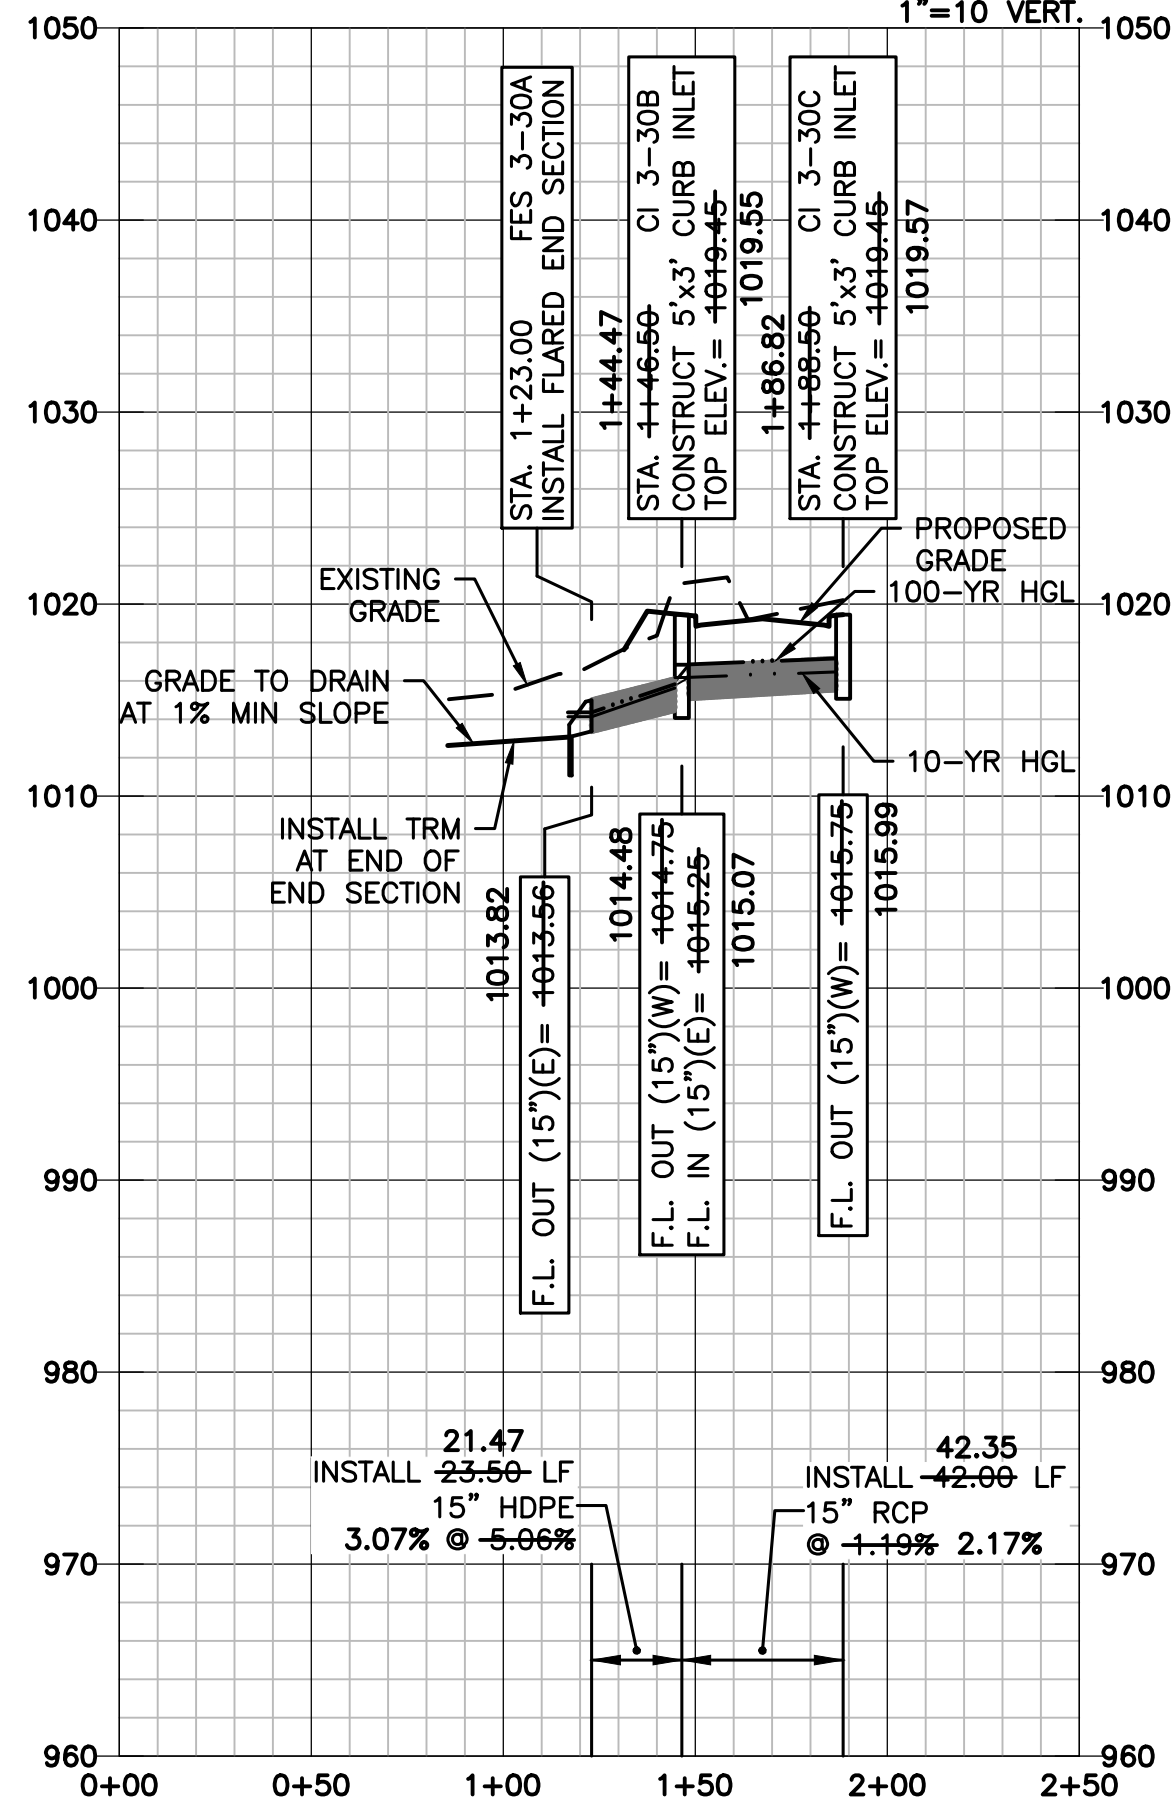Scales: 1"=50 HOR.
1"=10 VERT.

STRUCTURE	STATION & OFFSET	INSIDE FACE TOP ELEVATION	STREET GRADE	STREET NAME
FES 3-30A	14+52.43, 44.49' RT	N/A	N/A	SW MONARCH DR
CI 3-30B	14+53.13, 19.50' RT	1019.42	SUMP	SW MONARCH DR
CI 3-30C	14+53.13, 19.50' LT	1019.42	SUMP	SW MONARCH DR

STORM SEWER NOTES (APPLICABLE TO ALL STORM PLAN AND PROFILE SHEETS):

- POLYPROPYLENE PIPE OR CONCRETE PIPE MAY BE USED IN LIEU OF HDPE PIPE. ALL PIPE SHALL MEET CITY SPECIFICATIONS (LEES SUMMIT SECTION 2600).
- PROPOSED CURB INLETS SHALL CONFORM TO CITY STANDARD DETAIL STM-1 AND JUNCTION BOXES TO STM-3.
- COORDINATES AND TOP ELEVATIONS SHOWN ARE LOCATED AT CENTER OF STRUCTURES. ROAD OFFSETS ARE AT INSIDE FACE OF CURB INLETS.
- PIPE LENGTHS AND SLOPES ARE FROM CENTER OF STRUCTURE TO CENTER OF STRUCTURE.
- INSIDE FRONT FACE OF CURB INLETS SHALL BE LOCATED 1.5 FEET BEHIND BACK OF CURB. STRUCTURE SHALL BE PARALLEL WITH CURB ALIGNMENT AND TOP SHALL BE SLOPED TO CONFORM TO GRADE OF STREET.
- WATER MAINS AND STORM SEWERS SHALL HAVE AT LEAST 5'-FT OF CLEAR HORIZONTAL SEPARATION.

 LARKIN/ LAMP RYNEARSON	9001 State Line Rd., Suite 200 Kansas City, Missouri 64114 www.LRA-inc.com		DRAWN BY AJM	
			DESIGNED BY MDM	
			DATE 09-19-2018	
			JOB NUMBER-TASKS 0318050.01	
			BOOK AND PAGE	
SUMMIT VIEW FARMS 3RD PLAT LEE'S SUMMIT, MISSOURI		REVISIONS		
		08/19/18 – RESUBMITAL PER ADJUSTED LAYOUT		
		09/19/18 – RESUBMITAL PER CITY COMMENTS		
		02/04/2020 – AS-BUILTS		

MASS GRADING, EROSION CONTROL,
PAVING, STORM AND SANITARY PLANS
STORM SEWER PLAN AND PROFILE
LINES 3-10, 3-11 AND 3-30





LARKIN LAMP RYNEARSON - ENGINEERS
MIO Certificate of Authority No. 2013011903

MARK DANIEL MCGHEE JR.

PE - 2008019568

SHEET

L:\Engineering\031850 SVF03 Summit View Forms 3rd Plan\Drawings\CONSTRUCTION DRAWINGS\PAV-PLANS\PAV-STM-RWP-02.dwg, 2/4/2020 1:51:54 PM, DAN MCSHIE, LAMP RYNEARSON & ASSOCIATES

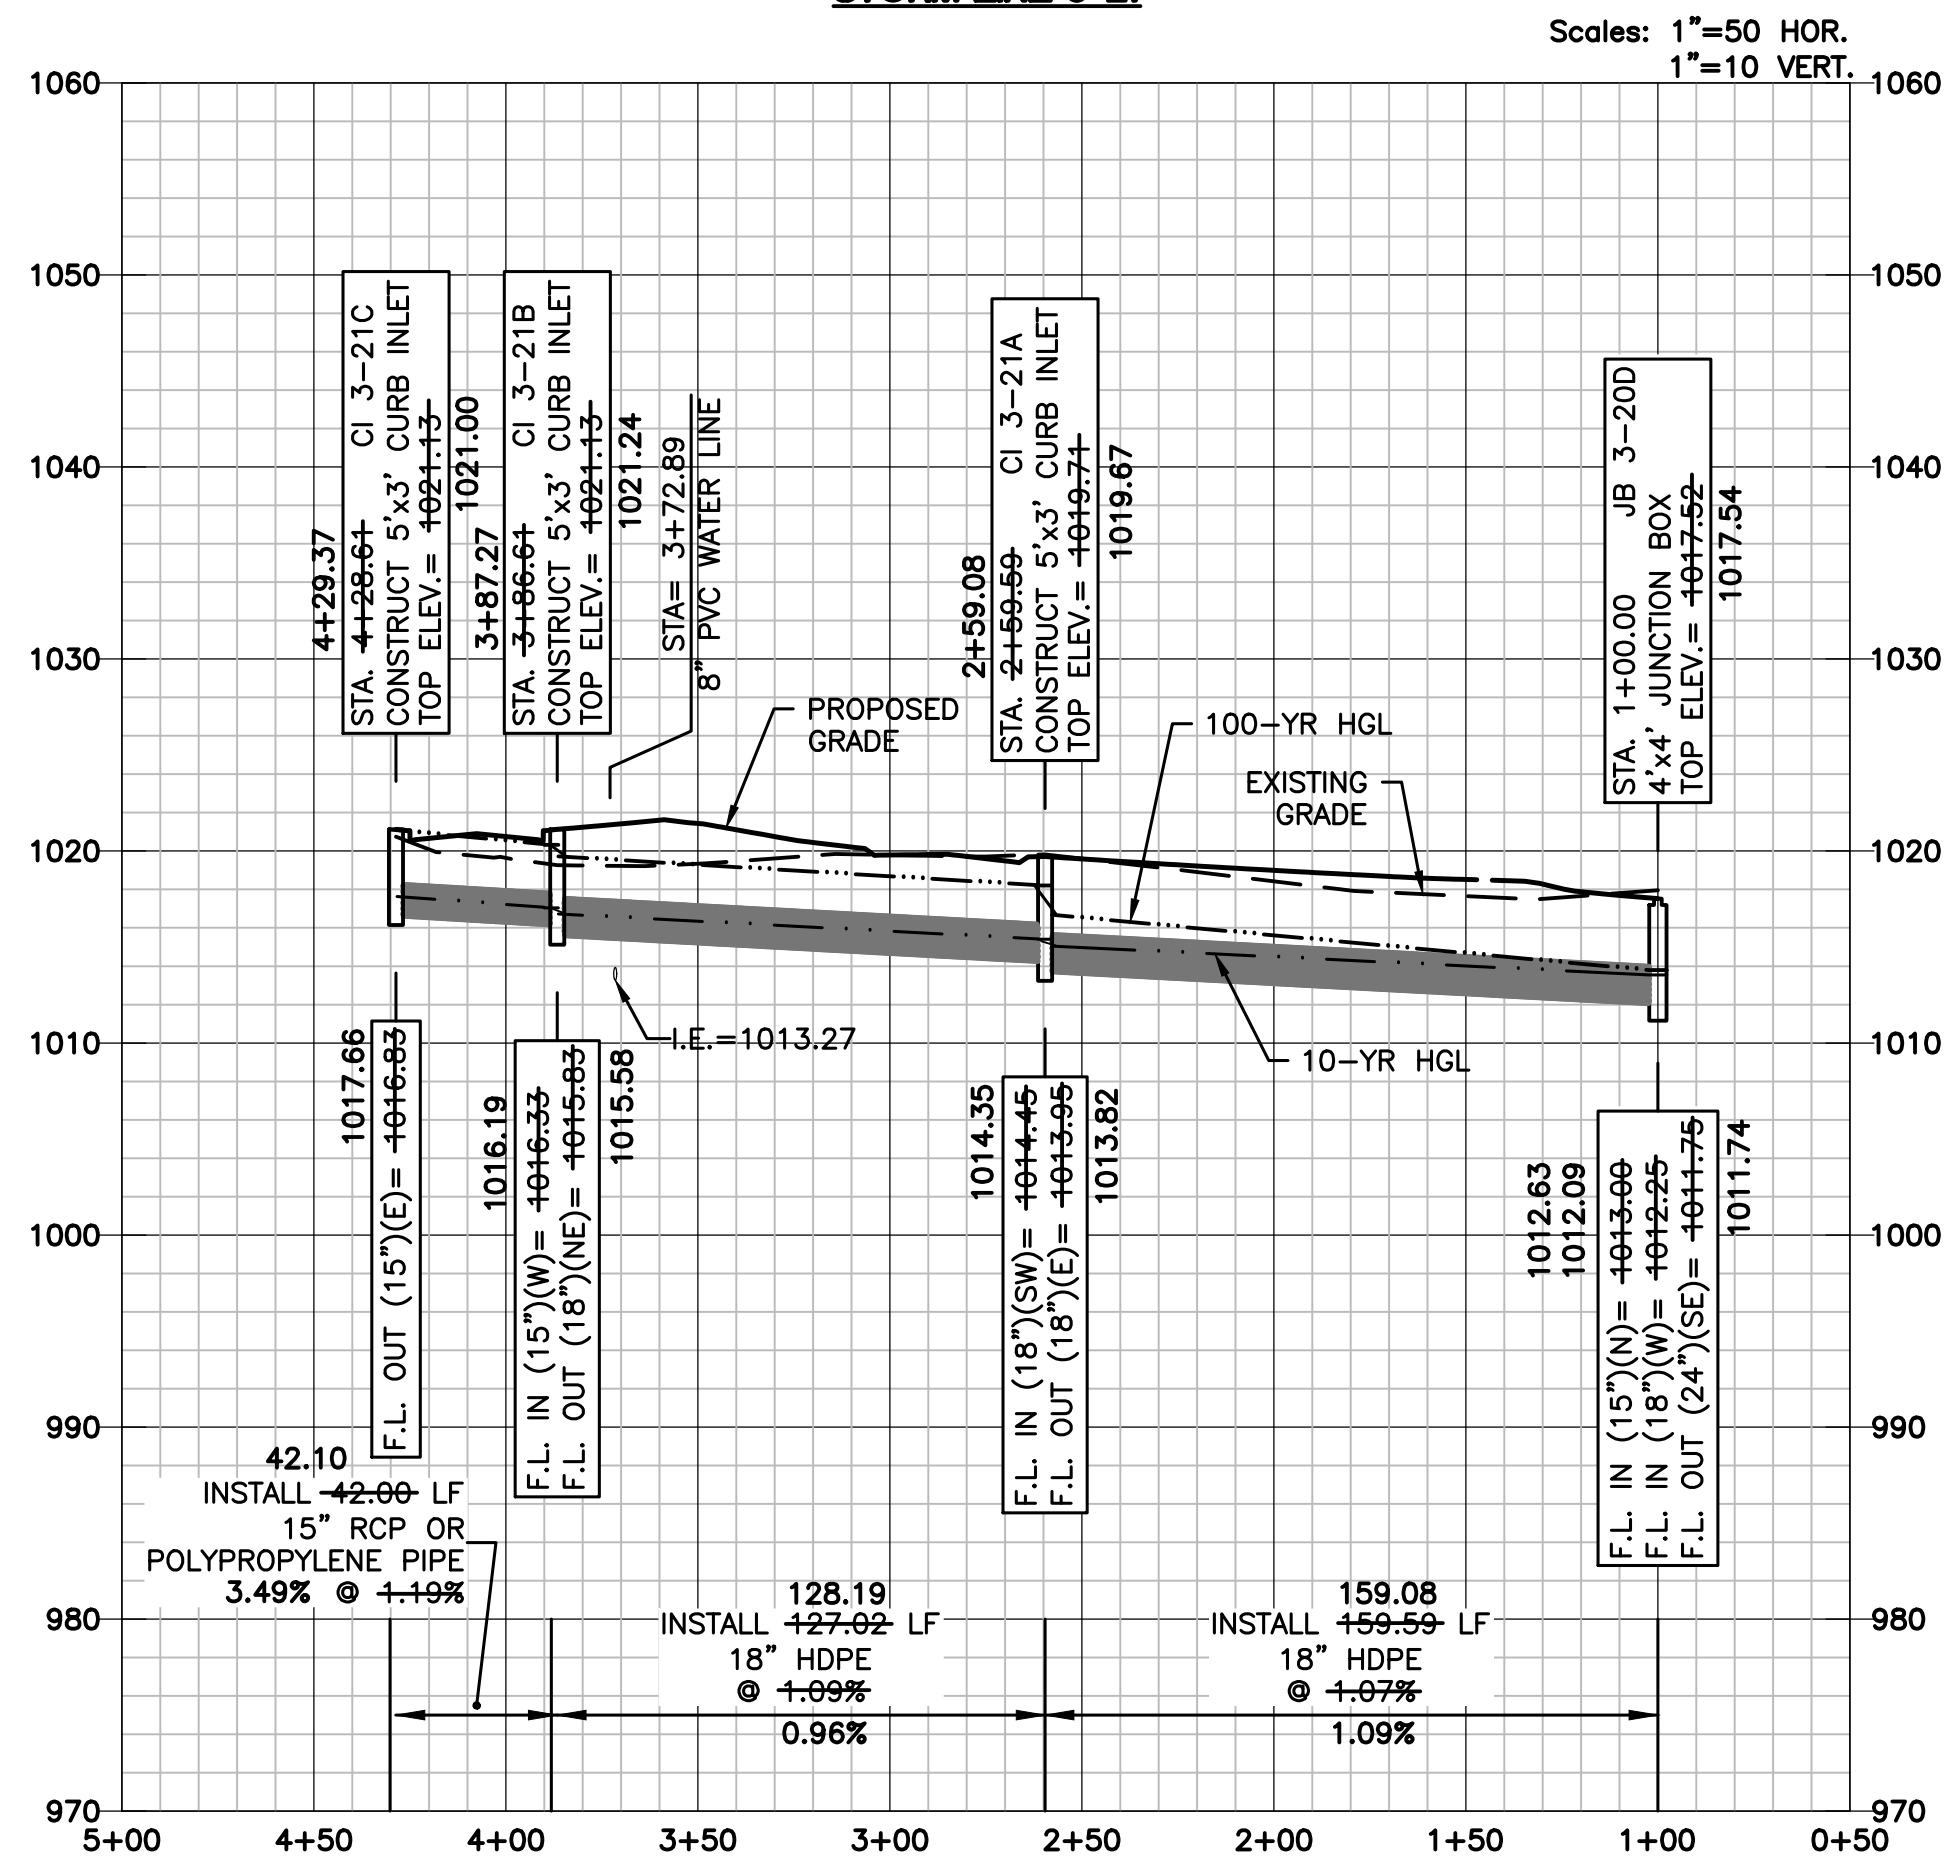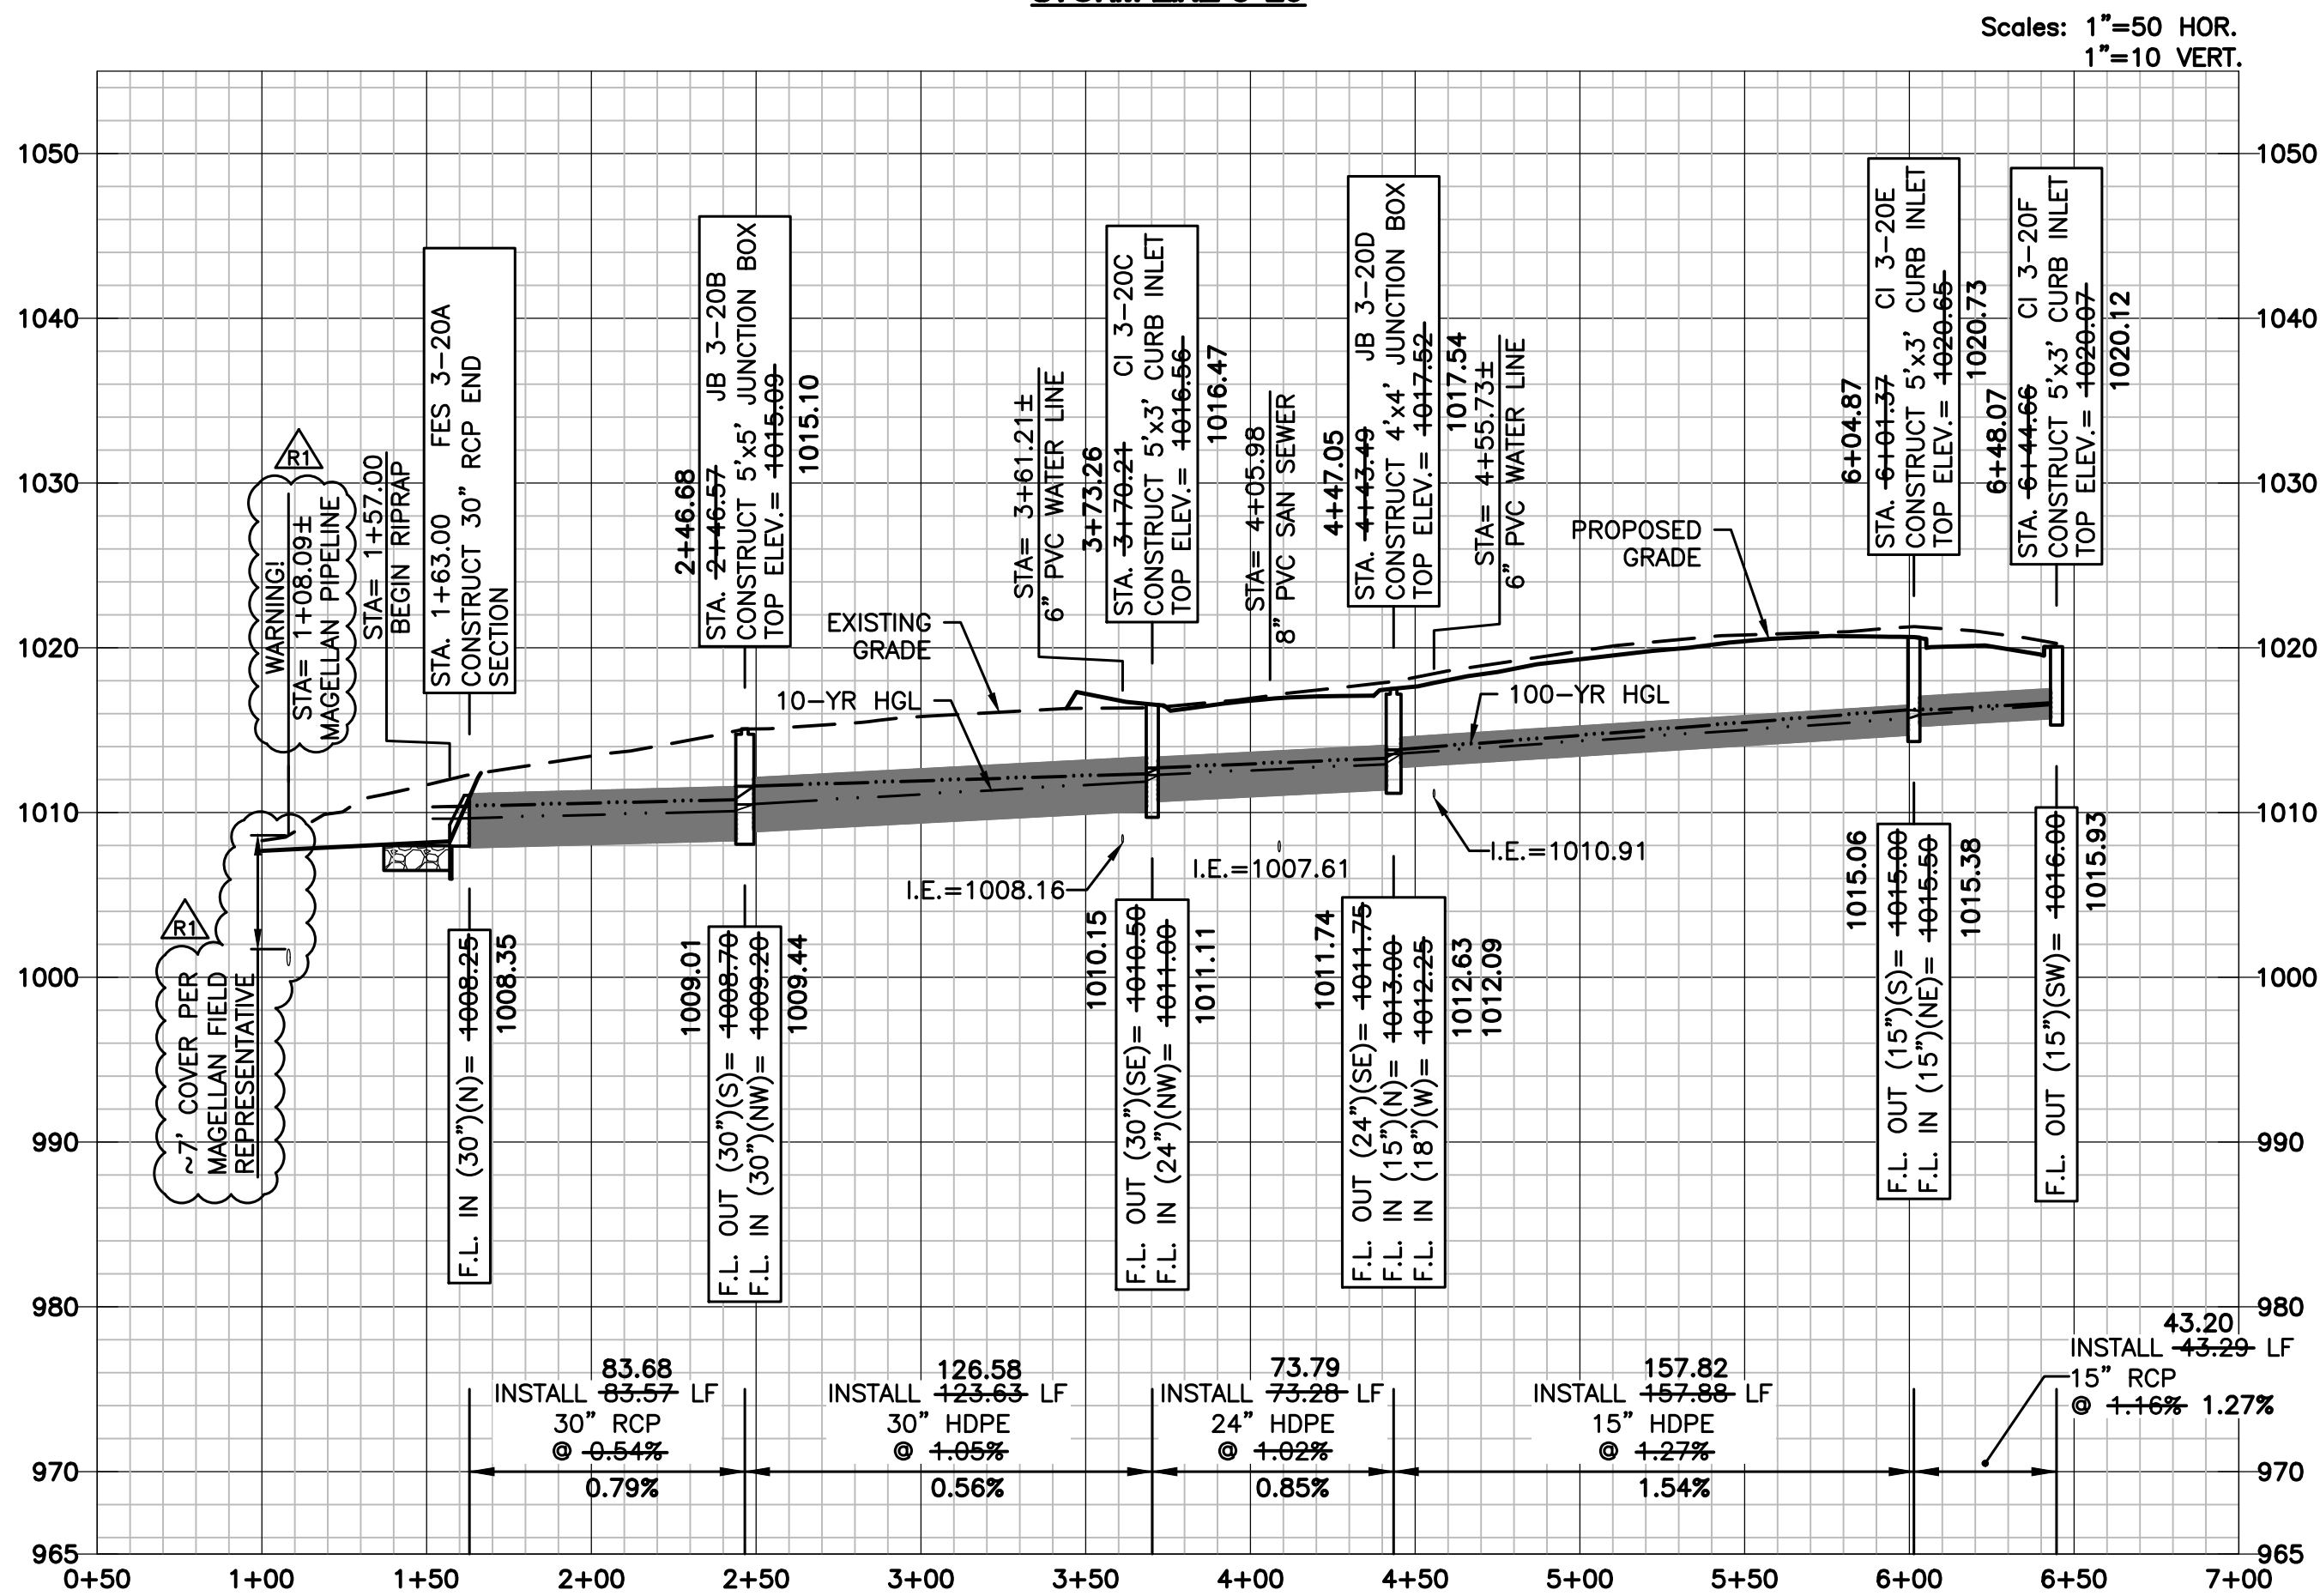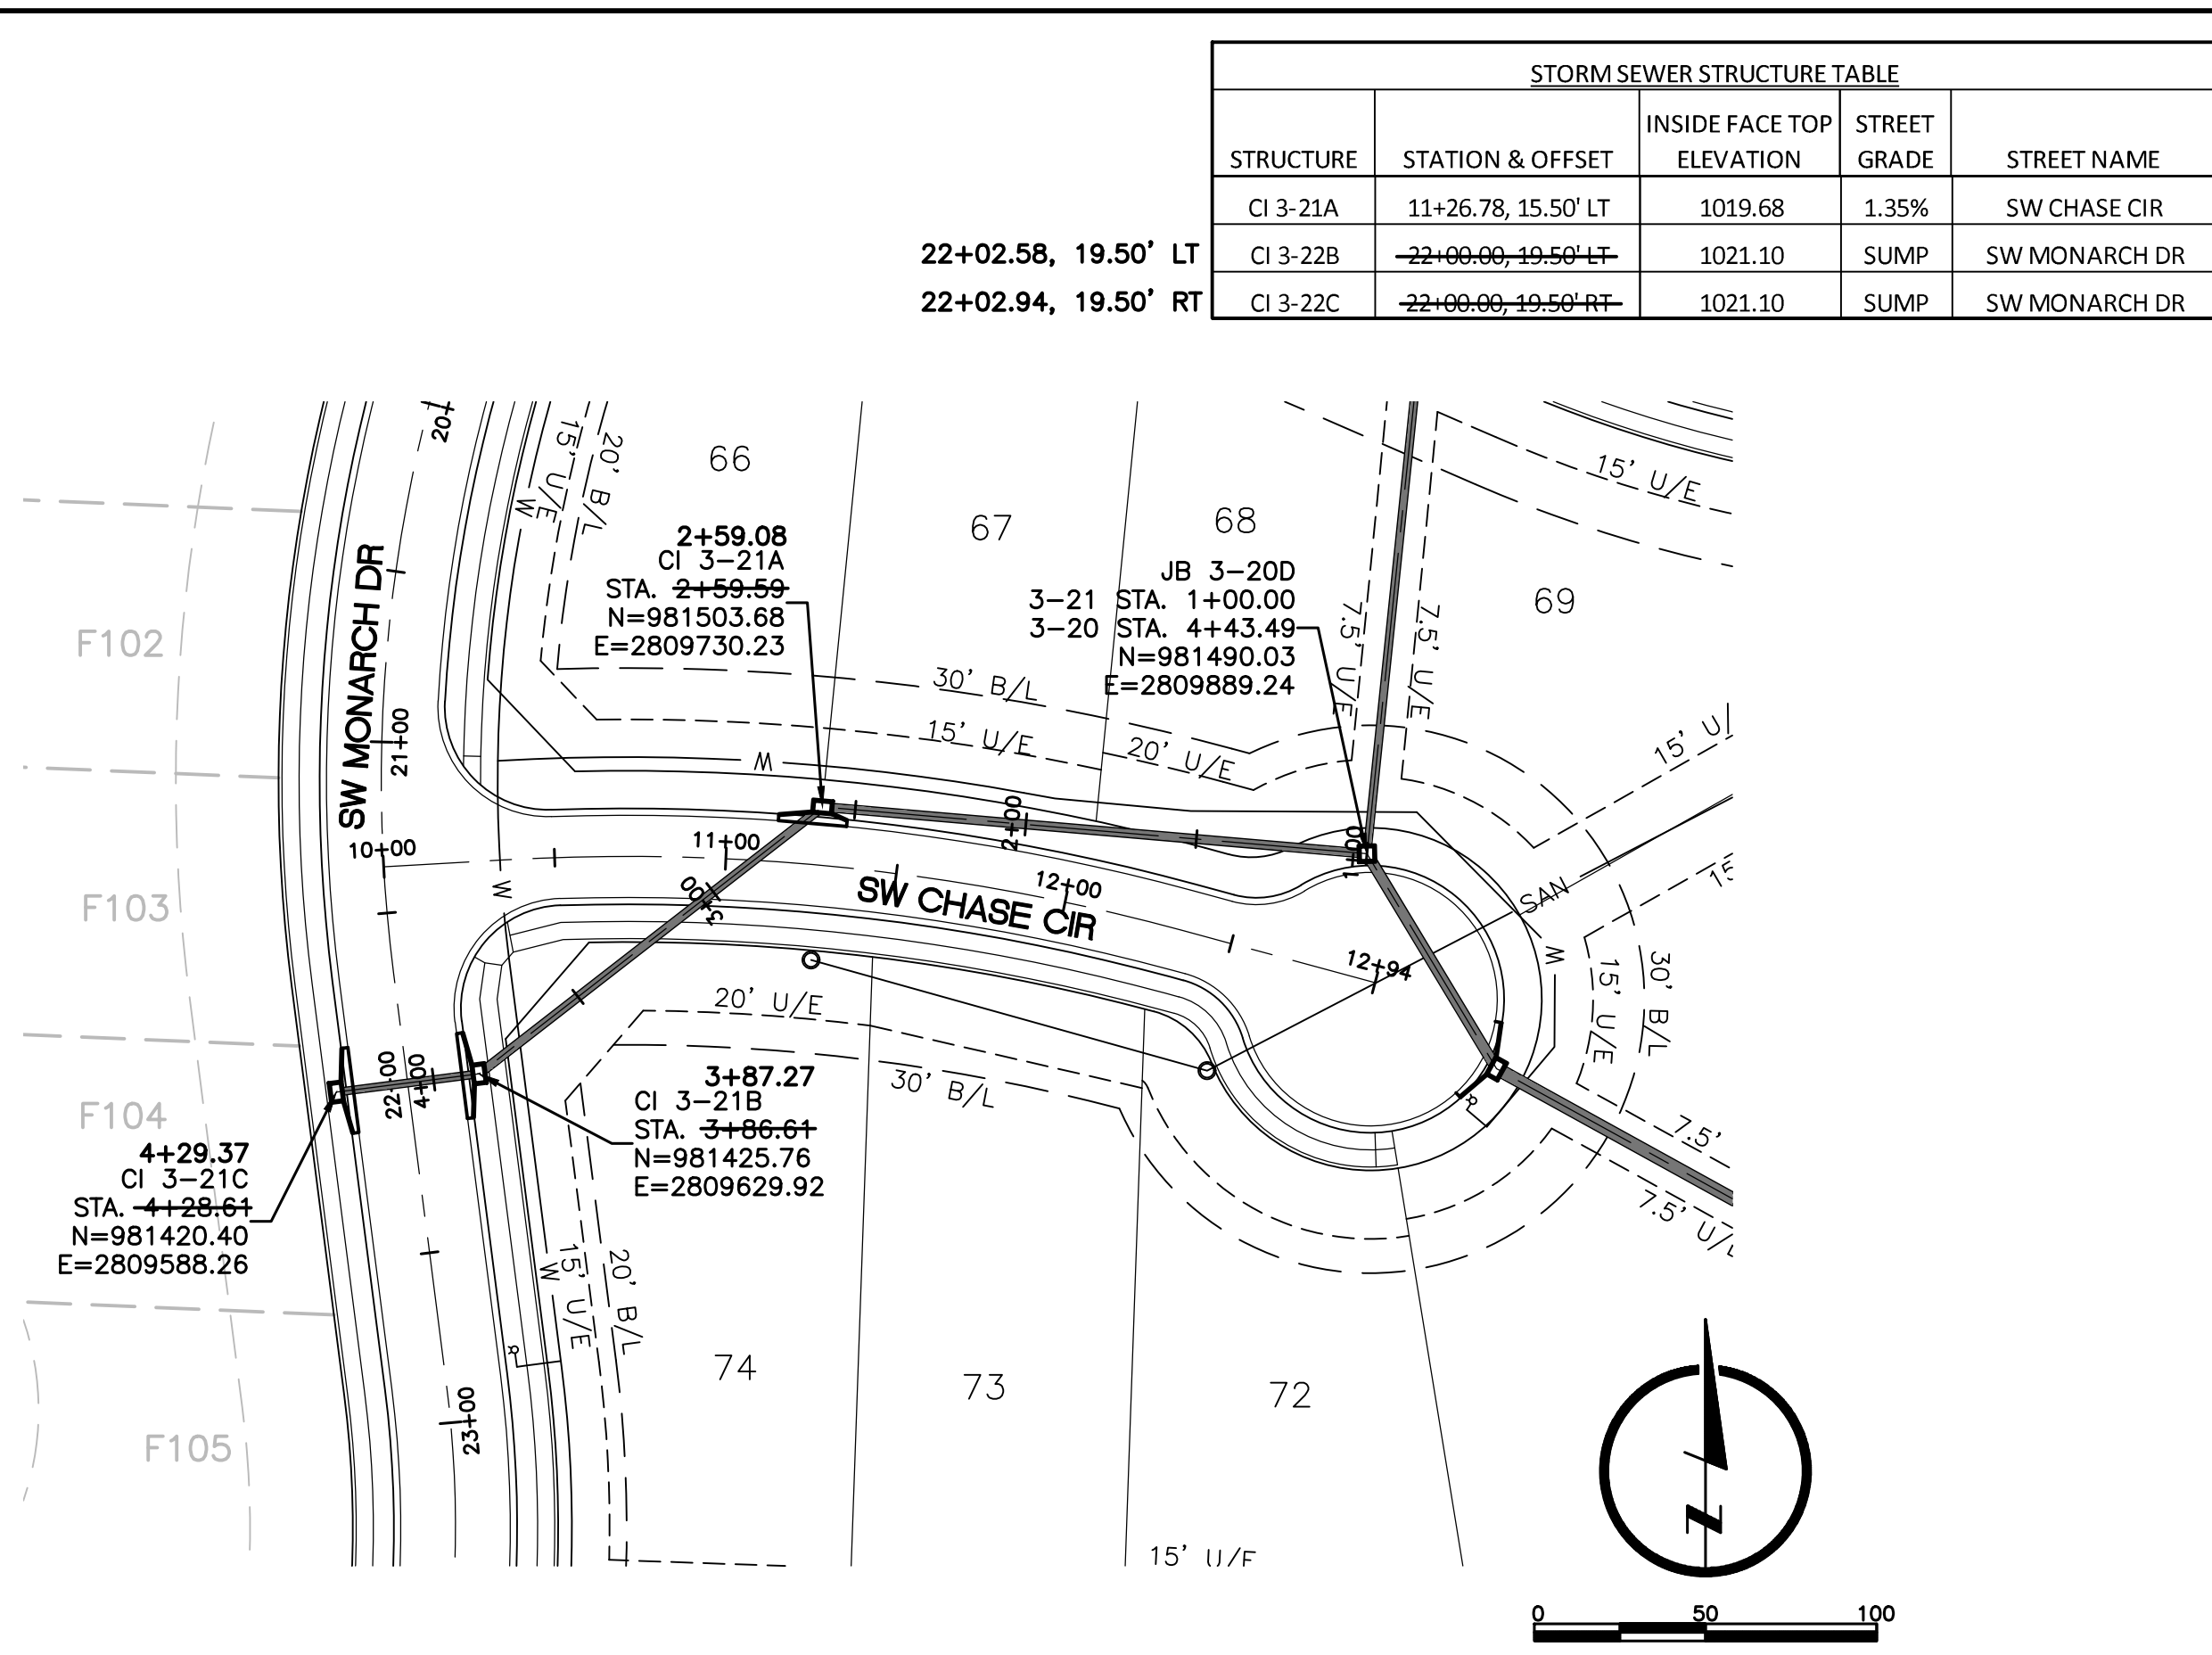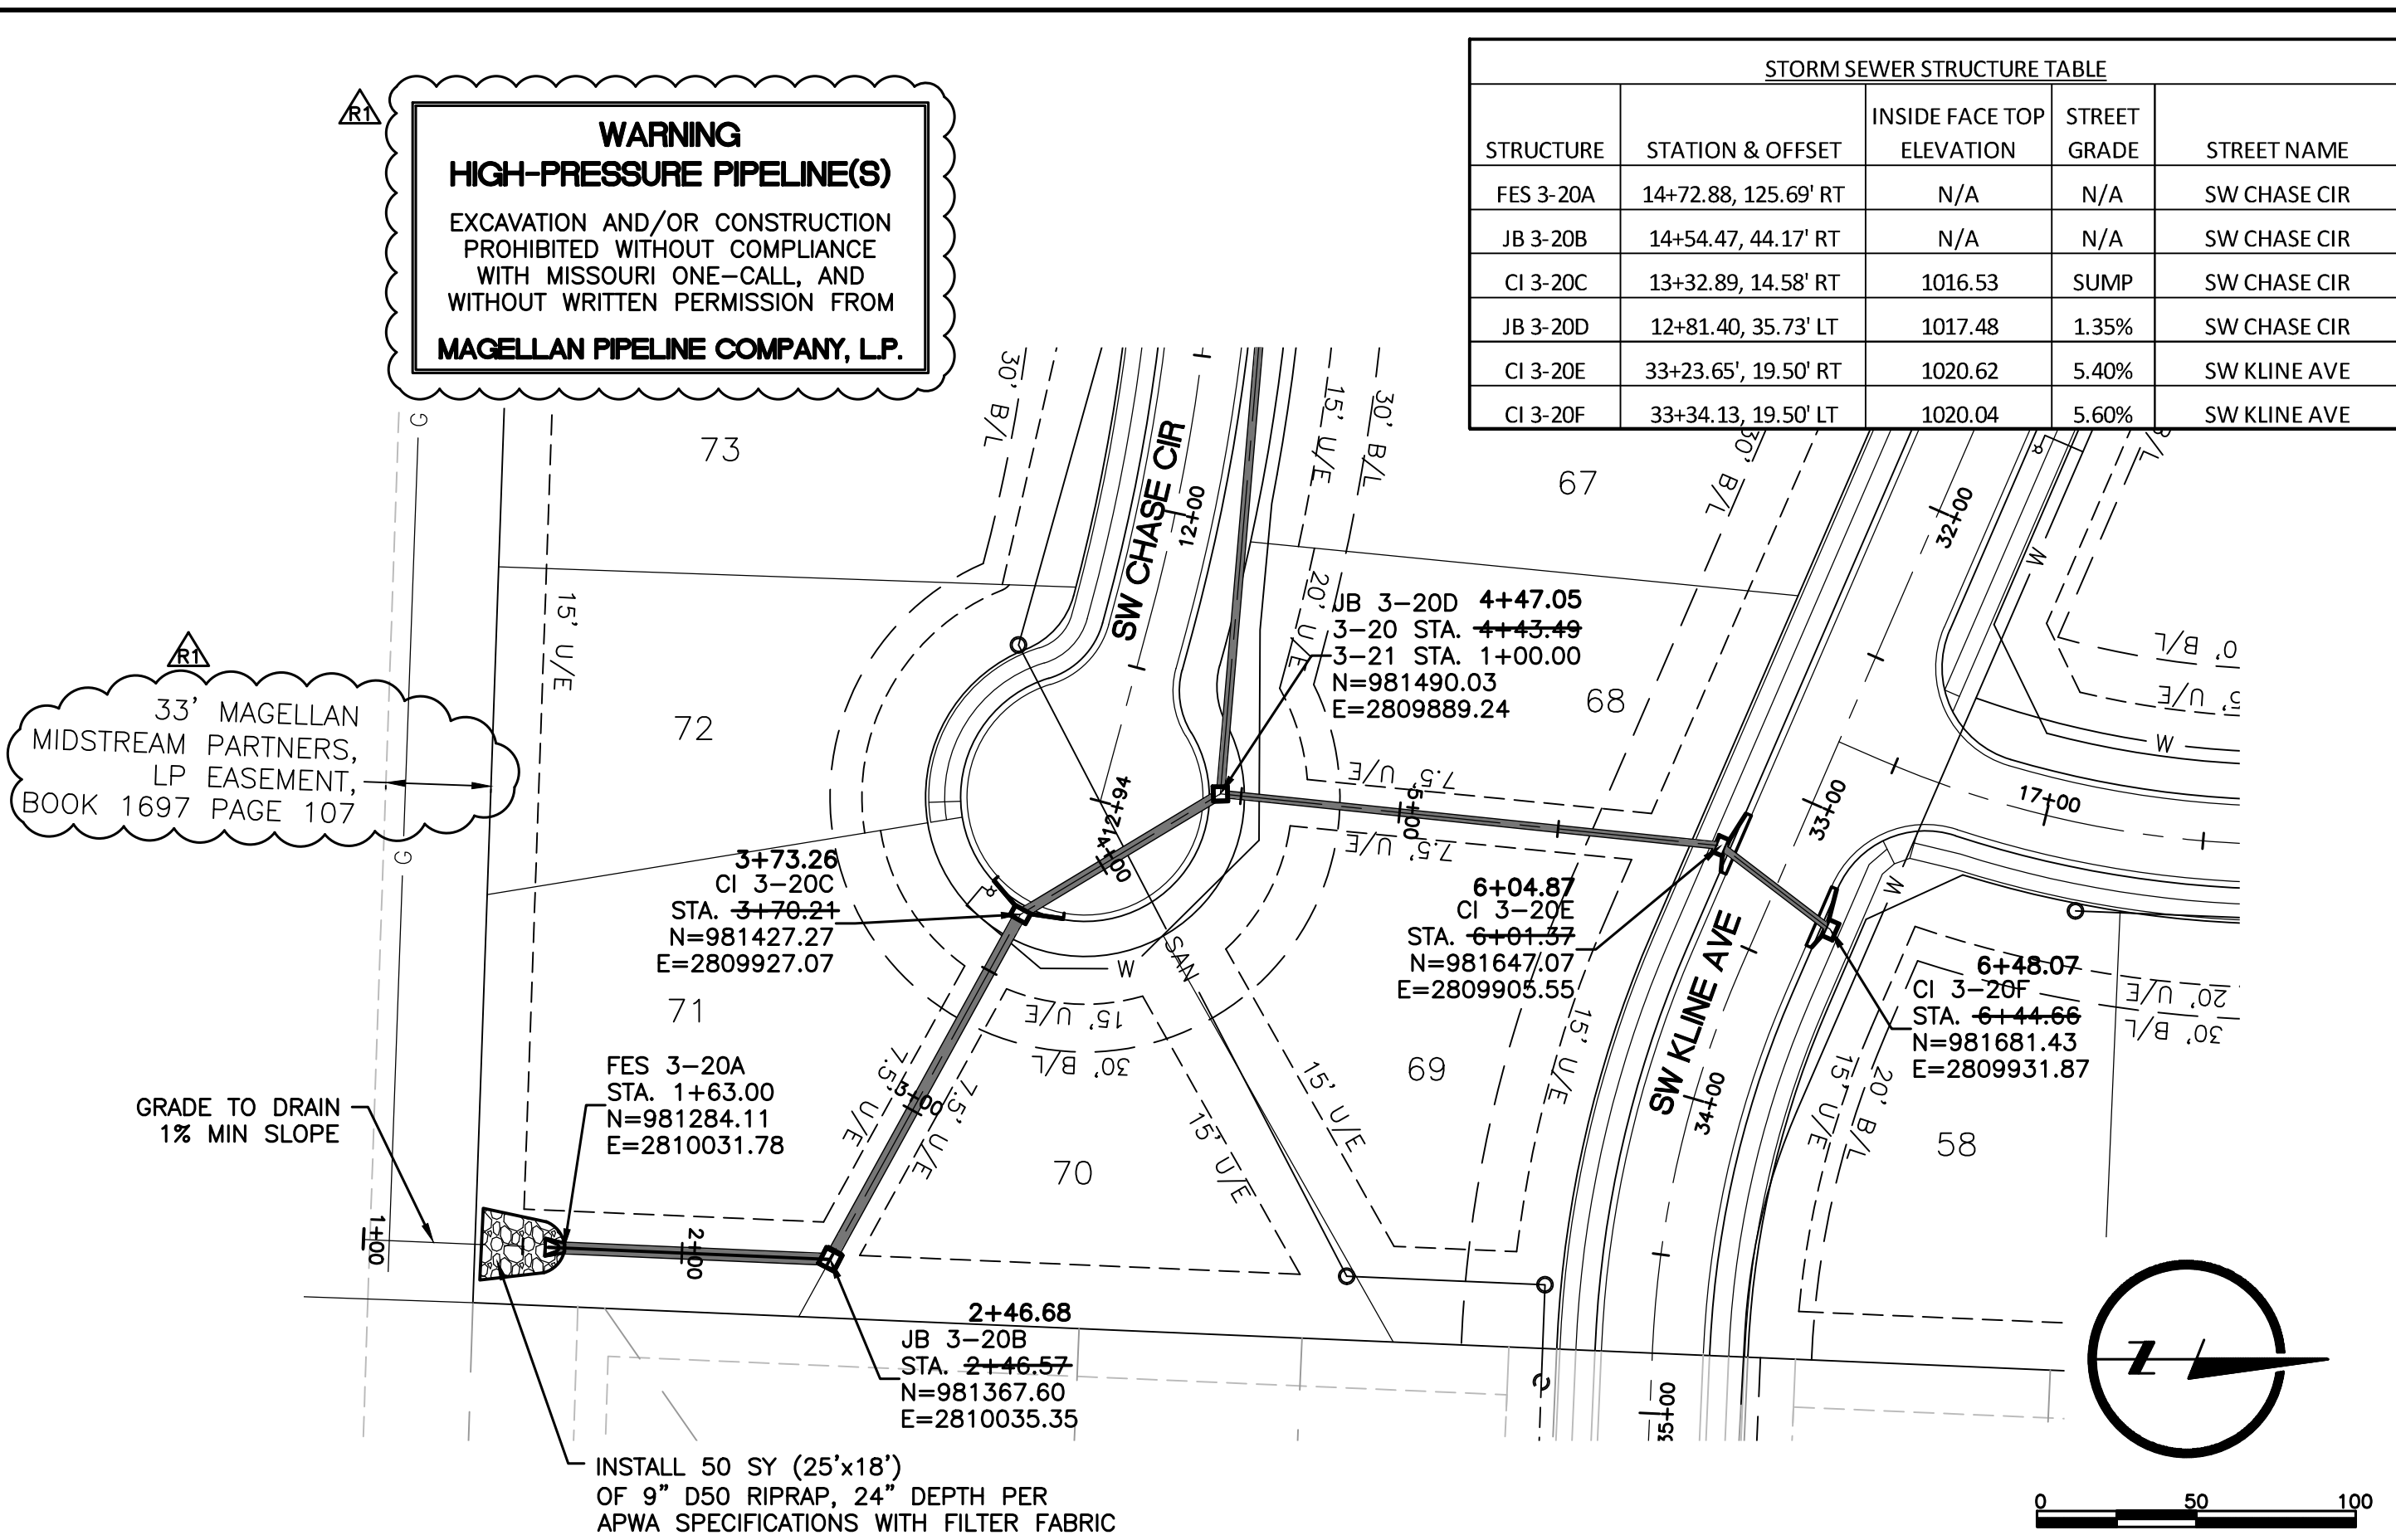

STORM SEWER STRUCTURE TABLE				
STRUCTURE	STATION & OFFSET	INSIDE FACE TOP ELEVATION	STREET GRADE	STREET NAME
FES 3-20A	14+72.88, 125.69' RT	N/A	N/A	SW CHASE CIR
JB 3-20B	14+54.47, 44.17' RT	N/A	N/A	SW CHASE CIR
CI 3-20C	13+32.89, 14.58' RT	1016.53	SUMP	SW CHASE CIR
JB 3-20D	12+81.40, 35.73' LT	1017.48	1.35%	SW CHASE CIR
CI 3-20E	33+23.65', 19.50' RT	1020.62	5.40%	SW KLINE AVE
CI 3-20F	33+34.13, 19.50' LT	1020.04	5.60%	SW KLINE AVE

STORM SEWER STRUCTURE TABLE				
STRUCTURE	STATION & OFFSET	INSIDE FACE TOP ELEVATION	STREET GRADE	STREET NAME
CI 3-21A	11+26.78, 15.50' LT	1019.68	1.35%	SW CHASE CIR
CI 3-22B	22+00.00, 19.50' LT	1021.10	SUMP	SW MONARCH DR
CI 3-22C	22+00.00, 19.50' RT	1021.10	SUMP	SW MONARCH DR

DRAWN BY
JAM

DESIGNED BY
MDM

DATE
03/01/19 - REVISION 1

JOB NUMBER-TASKS
09-19-2018
031850.01

BOOK AND PAGE

REVISIONS

08/19/18 - RESUBMITAL PER ADJUSTED LAYOUT

09/19/18 - RESUBMITAL PER CITY COMMENTS

03/01/19 - REVISION 1

02/04/2020 - AS-BUILT

LARKIN/RYNEARSON

LAMP RYNEARSON

9001 State Line Rd., Suite 200
Kansas City, Missouri 64114
www.LRA-inc.com

MASS GRADING, EROSION CONTROL
PAVING, STORM AND SANITARY PLANS
STORM SEWER PLAN AND PROFILE
LINES 3-20 AND 3-21

SUMMIT VIEW FARMS 3RD PLAT
LEE'S SUMMIT, MISSOURI

LARKIN RYNEARSON - ENGINEERS

Two Certificate of Authority No. 2013011903

STATE OF MISSOURI

MARK DANIEL MCGHEE JR.

REGISTERED PROFESSIONAL ENGINEER


PE - 2008019568

02-04-2020

MARK DANIEL MCGHEE JR.
PE - 2008019568

SHEET

25 OF 31

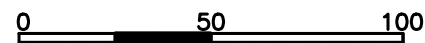

NOTES
FIELD INLET CAPACITY IS CALCULATED AT TOP OF HIGHEST WINDOW ELEVATION

THE FULL FLOW PIPE CAPACITY (8.43 CFS) AND FIELD INLET OPENING CAPACITY (10.2 CFS) EXCEEDS THE 1% STORM PEAK RUNOFF RATE (6.98 CFS). THE EXTENSION IS DESIGNED TO CONVEY THE 1% STORM.




1. LOCATE RING AND COVER OVER OUTLET ON BLANK WALL.
2. USE $\frac{3}{4}$ " CHAMFER ON ALL EXPOSED CONCRETE CORNERS.
3. FLOOR OF INLET GROUDED AND SHAPED TO MATCH PIPE INVERT TO PROVIDE SMOOTH FLOW.
4. STEPS REQUIRED AT 16' O.C. WHEN DEPTH FROM TOP OF CASTING TO INVERT EXCEEDS 3' ON BLANK WALL IF POSSIBLE.
5. BOXOUTS WILL NOT BE ALLOWED TO PROJECT THROUGH THE CORNERS OF THE STRUCTURE.
6. THE MINIMUM REINFORCING SHALL BE 1 H-BAR OVER A CAST-IN-PLACE PIPE AND 2 H-BARS OVER A PRECAST BOXOUT.
7. SHOW FIELD INLET ORIENTATION ON PLANS PLUS NUMBER AND SIDE OF OPENINGS.
8. PRECAST LIDS SHALL BE PINNED, SEALED WITH NON-SHRINKABLE GROUT AND REMOVABLE FOR FUTURE MAINTENANCE.
9. FOR RING AND COVER SEE THE STORMWATER APPROVED PRODUCT LIST.

PUBLIC WORKS ENGINEERING DIVISION | 220 SE GREEN STREET | LEE'S SUMMIT, MO 64063


FIELD INLET DETAIL

STM-2

1. EXISTING UTILITY LOCATIONS AND ELEVATIONS SHALL BE FIELD VERIFIED.
2. REMOVE AND REPLACE EXISTING WOOD FENCE FOR STORM SEWER PIPE INSTALLATION.
3. REMOVE LANDSCAPE TIMBERS ON WEST SIDE OF EXISTING FIELD INLET. TRANSITION GRADE AT INLET TO EXISTING GRADE.
4. MINIMIZE IMPACT TO EXISTING HEDGE ROW AT REAR OF LOTS 51 THROUGH 54 FOR SWALE GRADING.
5. MINIMUM BUILDING OPENING ELEVATIONS (MBOE) ARE INDICATED ON THE LOW SIDE OF THE LOT, FOR THE NORTHEAST CORNER OF THE FUTURE HOMES.

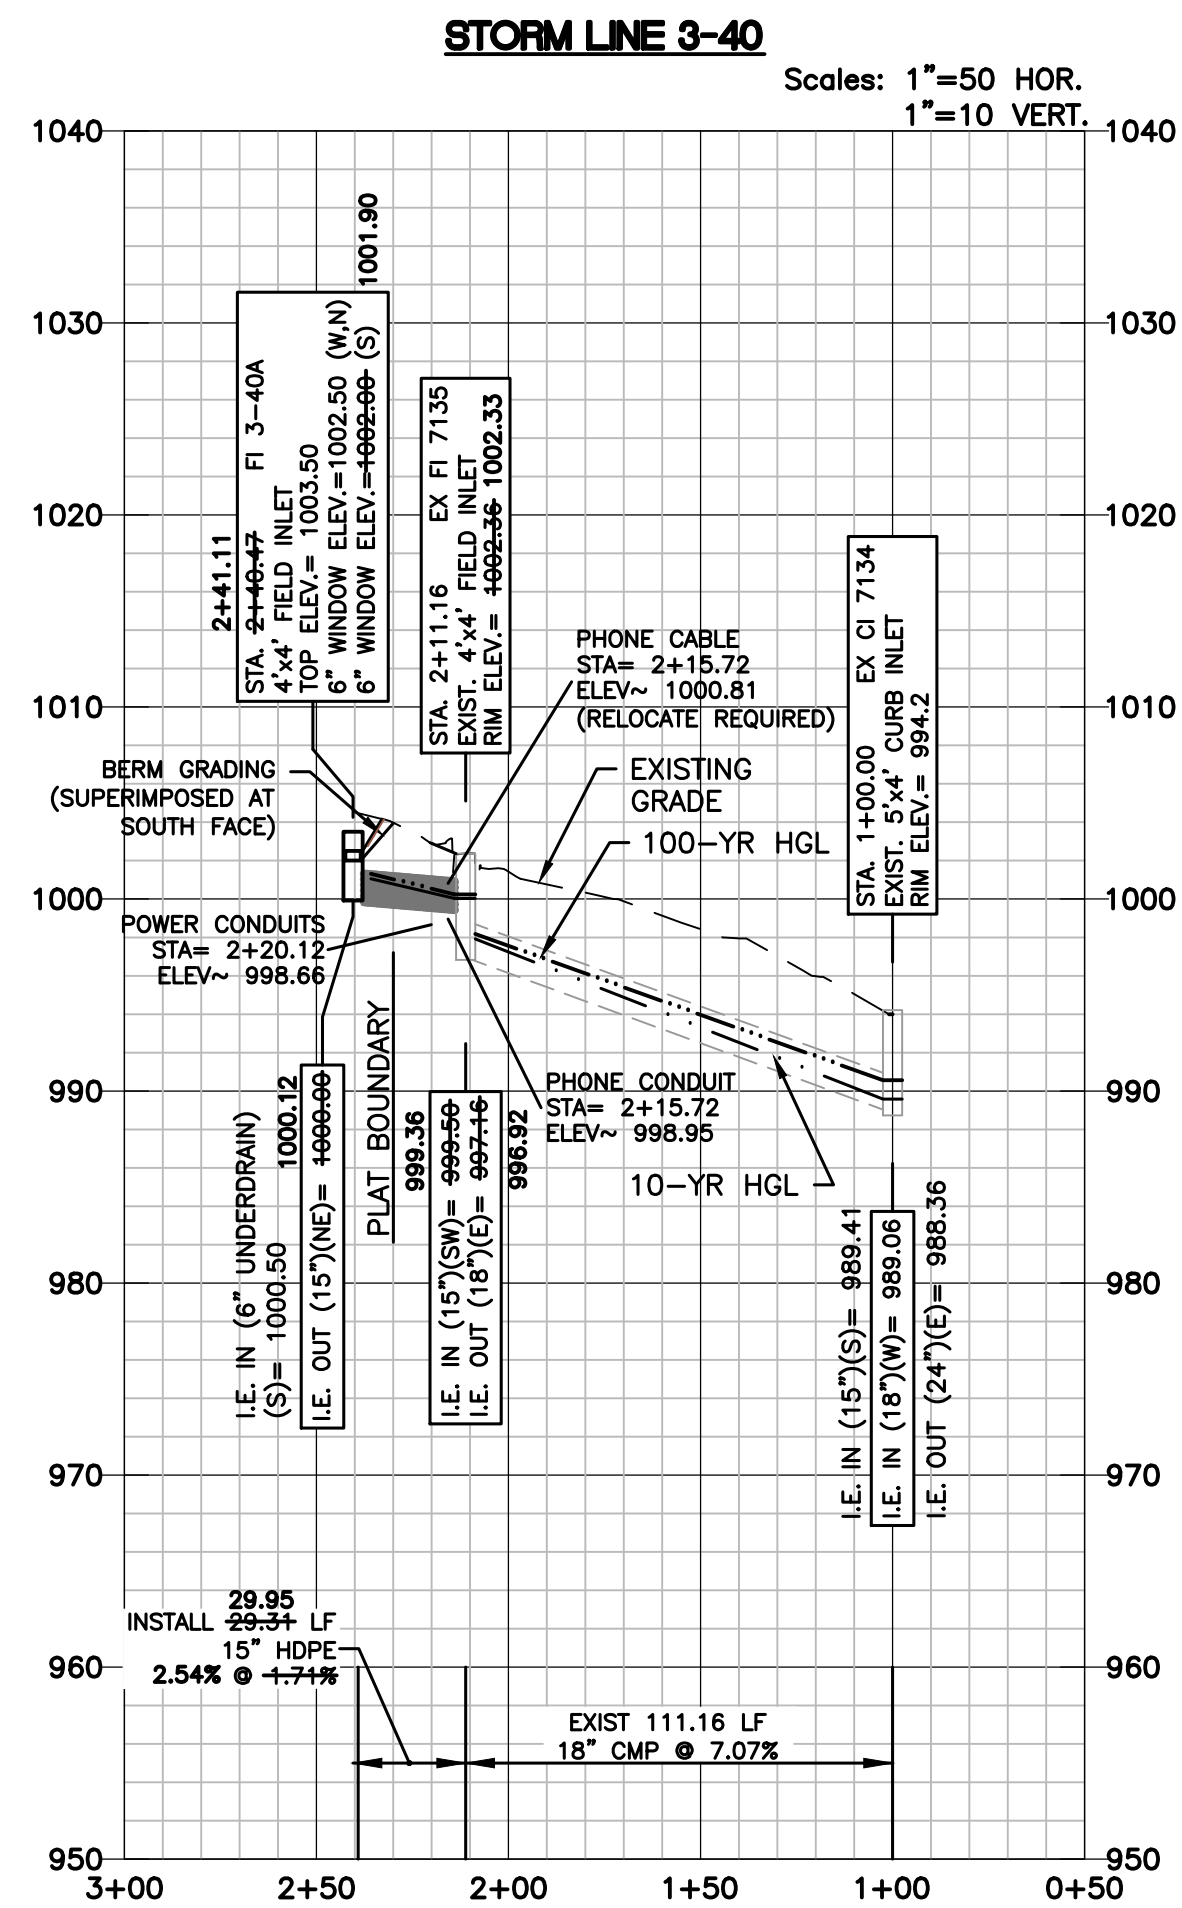

L:\Engineering\031850 SVFDG Summit View Farms 3rd Plat\Drawings\CONSTRUCTION DRAWINGS\PAV-PLANS\PAV-SAN-PWP-01.dwg, 2/4/2020 1:55:11 PM, DAN MCGHEE, LAMP RYNEARSON & ASSOCIATES

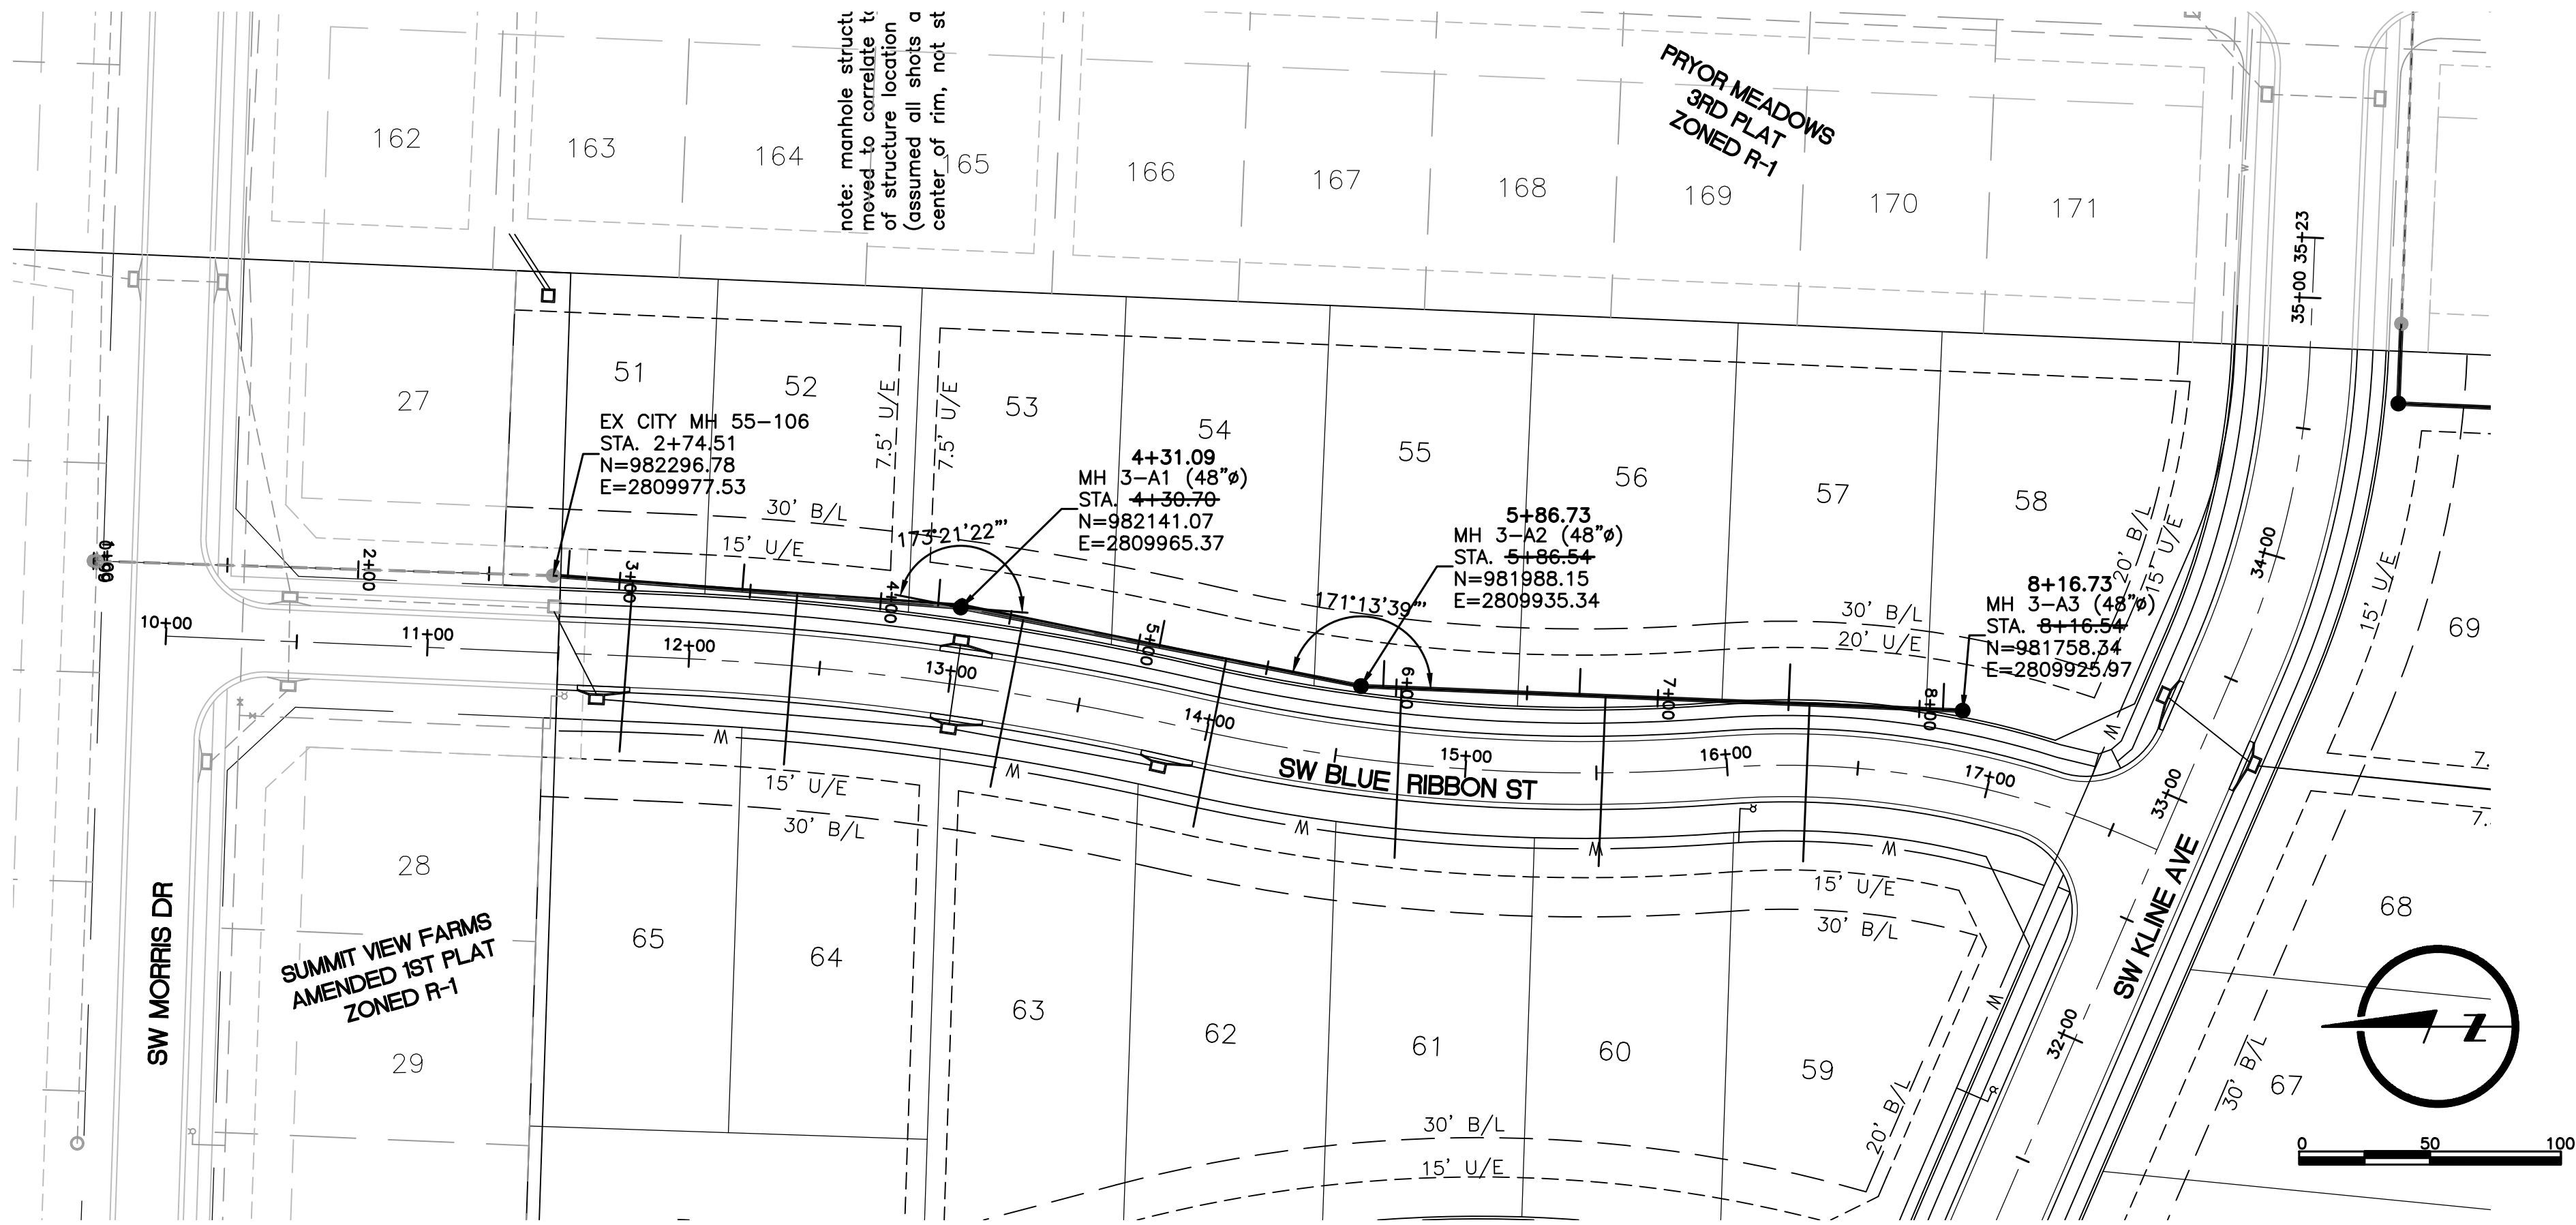


- SANITARY SEWER NOTES (APPLICABLE TO ALL SANITARY SEWER PLAN AND PROFILE SHEETS):**
- PROPOSED MANHOLES SHALL CONFORM TO CITY STANDARD DETAIL SAN-2.
 - COORDINATES, ROAD OFFSETS, AND TOP ELEVATIONS SHOWN ARE LOCATED AT CENTER OF STRUCTURES.
 - PIPE LENGTHS AND SLOPES ARE FROM CENTER OF STRUCTURE TO CENTER OF STRUCTURE.
 - ALL SANITARY SEWER LATERALS SHALL OF A TRENCH CHECK, CONSISTING OF FLOWABLE BACKFILL, INSTALLED DURING CONSTRUCTION. REFER TO LEES SUMMIT SPECIFICATION SECTION 3500.
 - TRACER WIRE SHALL BE INSTALLED ON ALL SERVICE LATERALS PER CITY STANDARD DETAIL SAN-1.
 - WATER MAINS AND SANITARY SEWER MAINS (INCLUDING STRUCTURES) SHALL HAVE AT LEAST 10'-FT OF HORIZONTAL SEPARATION FROM EDGE OF WATER PIPE TO EDGE OF SEWER PIPE OR SEWER STRUCTURE.
 - WATER MAINS AND SANITARY SEWERS SHALL HAVE AT LEAST 18-INCHES OF VERTICAL SEPARATION FROM EDGE OF PIPE TO EDGE OF PIPE. THE CROSSING SHALL BE ARRANGED SO THAT THE SEWER JOINTS WILL BE EQUIDISTANT AND AS FAR AS POSSIBLE FROM THE WATER MAIN JOINTS.

SANITARY SEWER STRUCTURE TABLE		
STRUCTURE	STATION & OFFSET	STREET NAME
MH 3-A1	13+00.19, 29.40' LT	SW BLUE RIBBON ST
MH 3-A2	14+56.25, 27.50' LT	SW BLUE RIBBON ST
MH 3-A3	16+85.16, 27.35' LT	SW BLUE RIBBON ST

Sewer Line	Main Station	Sewer Main Invert Elevation	Lateral Stub Length	Minimum Lateral Stub Elevation	Minimum Service Floor Elevation	Lot
3-A	2+80	997.48	10	999.01	1000.90	51
3-A	2+95	997.80	65	1000.43	1002.30	65
3-A	3+47	998.93	10	1000.46	1002.35	52
3-A	3+68	999.39	65	1002.02	1003.90	64
3-A	4+22	1000.56	10	1002.09	1003.95	53
3-A	4+55	1001.50	65	1004.13	1006.05	63
3-A	5+08	1002.71	10	1004.24	1006.10	54
3-A	5+34	1003.30	65	1005.93	1007.85	62
3-A	5+95	1005.02	10	1006.55	1008.40	55
3-A	6+02	1005.28	65	1007.91	1009.80	61
3-A	6+70	1007.86	10	1009.39	1011.25	56
3-A	6+80	1008.24	65	1010.87	1012.80	60
3-A	7+50	1010.88	15	1012.51	1014.35	57
3-A	7+58	1011.19	60	1013.72	1015.60	59
3-A	8+09	1013.11	10	1014.64	1016.50	58

NOTE: DESIGN LATERAL INFORMATION SHOWN. LATERAL LOCATIONS AND ELEVATIONS WERE NOT AS-BUILT.

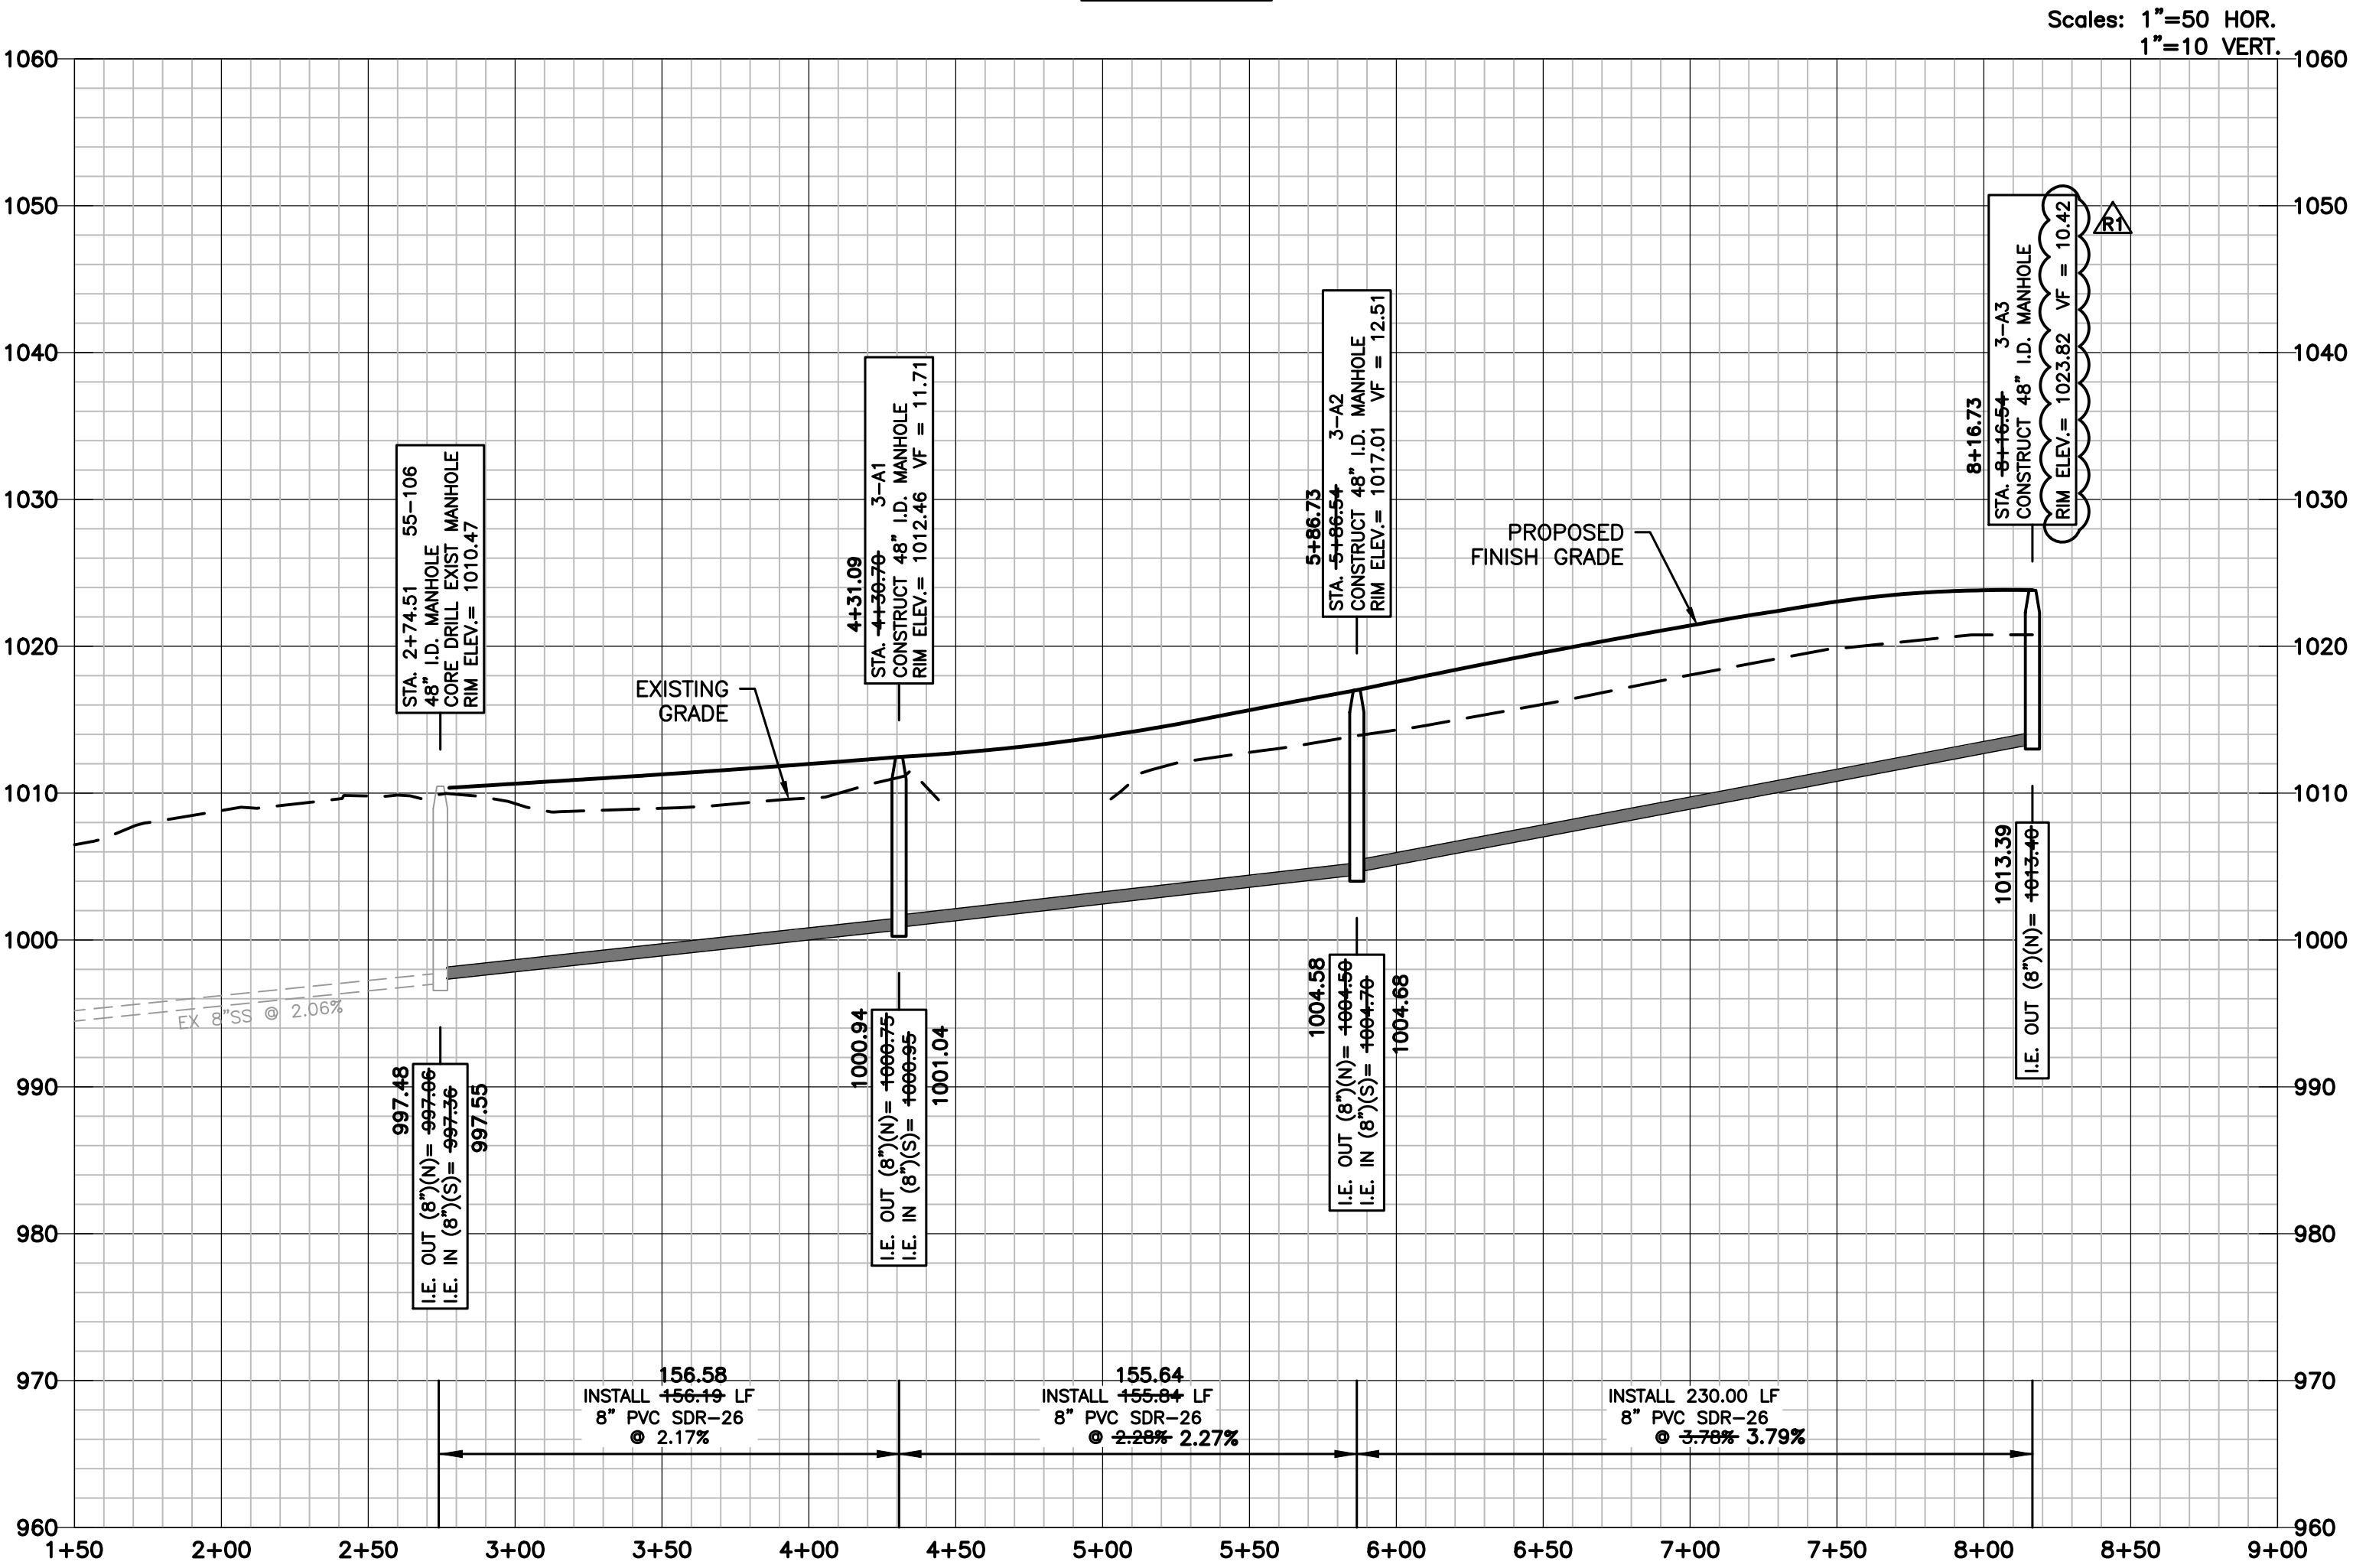

DRAWN BY
JAM

DESIGNED BY
MDM

DATE
03/01/19 - REVISION 1

JOB NUMBER-TASKS
09-19-2018
02/04/2020 - ASBUILTS

BOOK AND PAGE
031850.01

REVISIONS

08/19/18 - RESUBMITAL PER ADJUSTED LAYOUT

09/19/18 - RESUBMITAL PER CITY COMMENTS

9001 State Line Rd., Suite 200
Kansas City, Missouri 64114
www.LRA-inc.com

LARKIN/
LAMP RYNEARSON

SUMMIT VIEW FARMS 3RD PLAT
LEE'S SUMMIT, MISSOURI

MASS GRADING, EROSION CONTROL,
PAVING, STORM AND SANITARY PLANS
SANITARY SEWER PLAN AND PROFILE
LINE 3-A

LARKIN LAMP RYNEARSON - ENGINEERS
TMO Certificate of Authority No. 2013011903


STATE OF MISSOURI
MARK DANIEL MCGHEE JR.
PE-2008019568
PROFESSIONAL ENGINEER
02-04-2020

MARK DANIEL MCGHEE JR.
PE - 2008019568


SHEET

26 OF 31

L:\Engineering\0319050 SVT03 Summit View Farms 3rd Plat\Drawings\CONSTRUCTION DRAWINGS\PAV-PLANS\PAV-SAN-PWP-02.dwg, 2/4/2020 1:58:07 PM, DAN MCSHIEE, LAMP RYNEARSON & ASSOCIATES

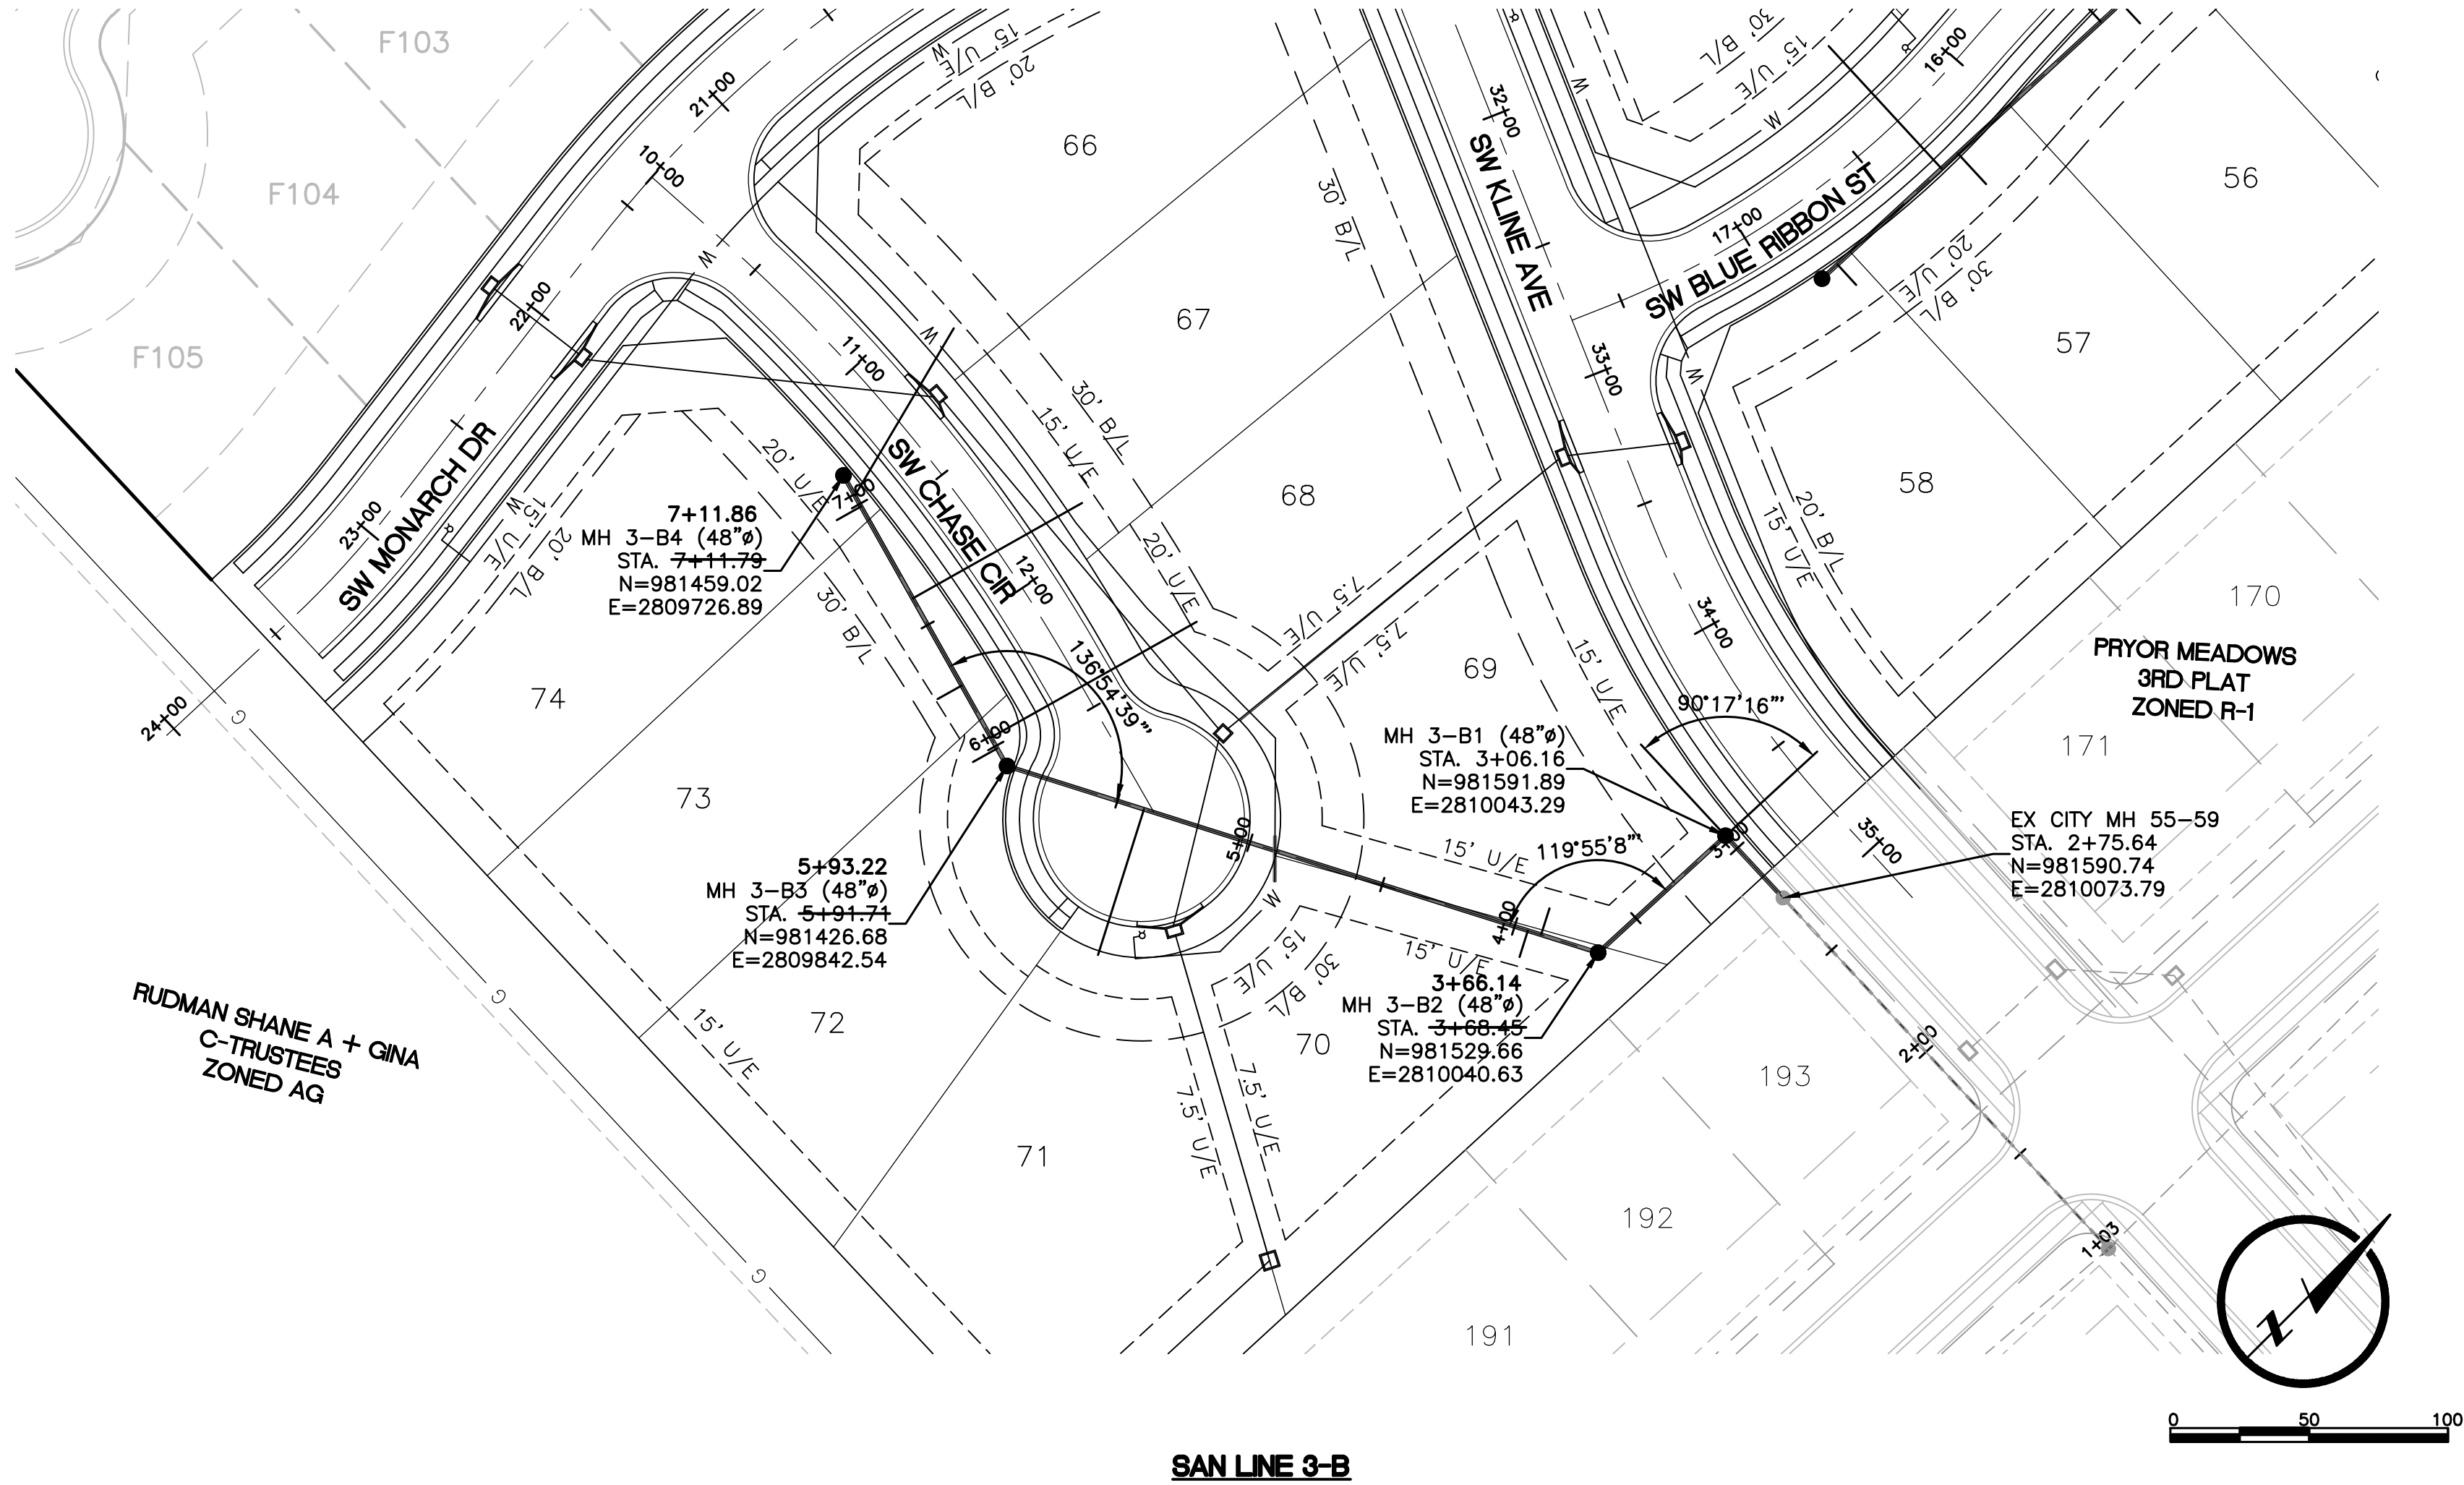

SAN LINE 3-B

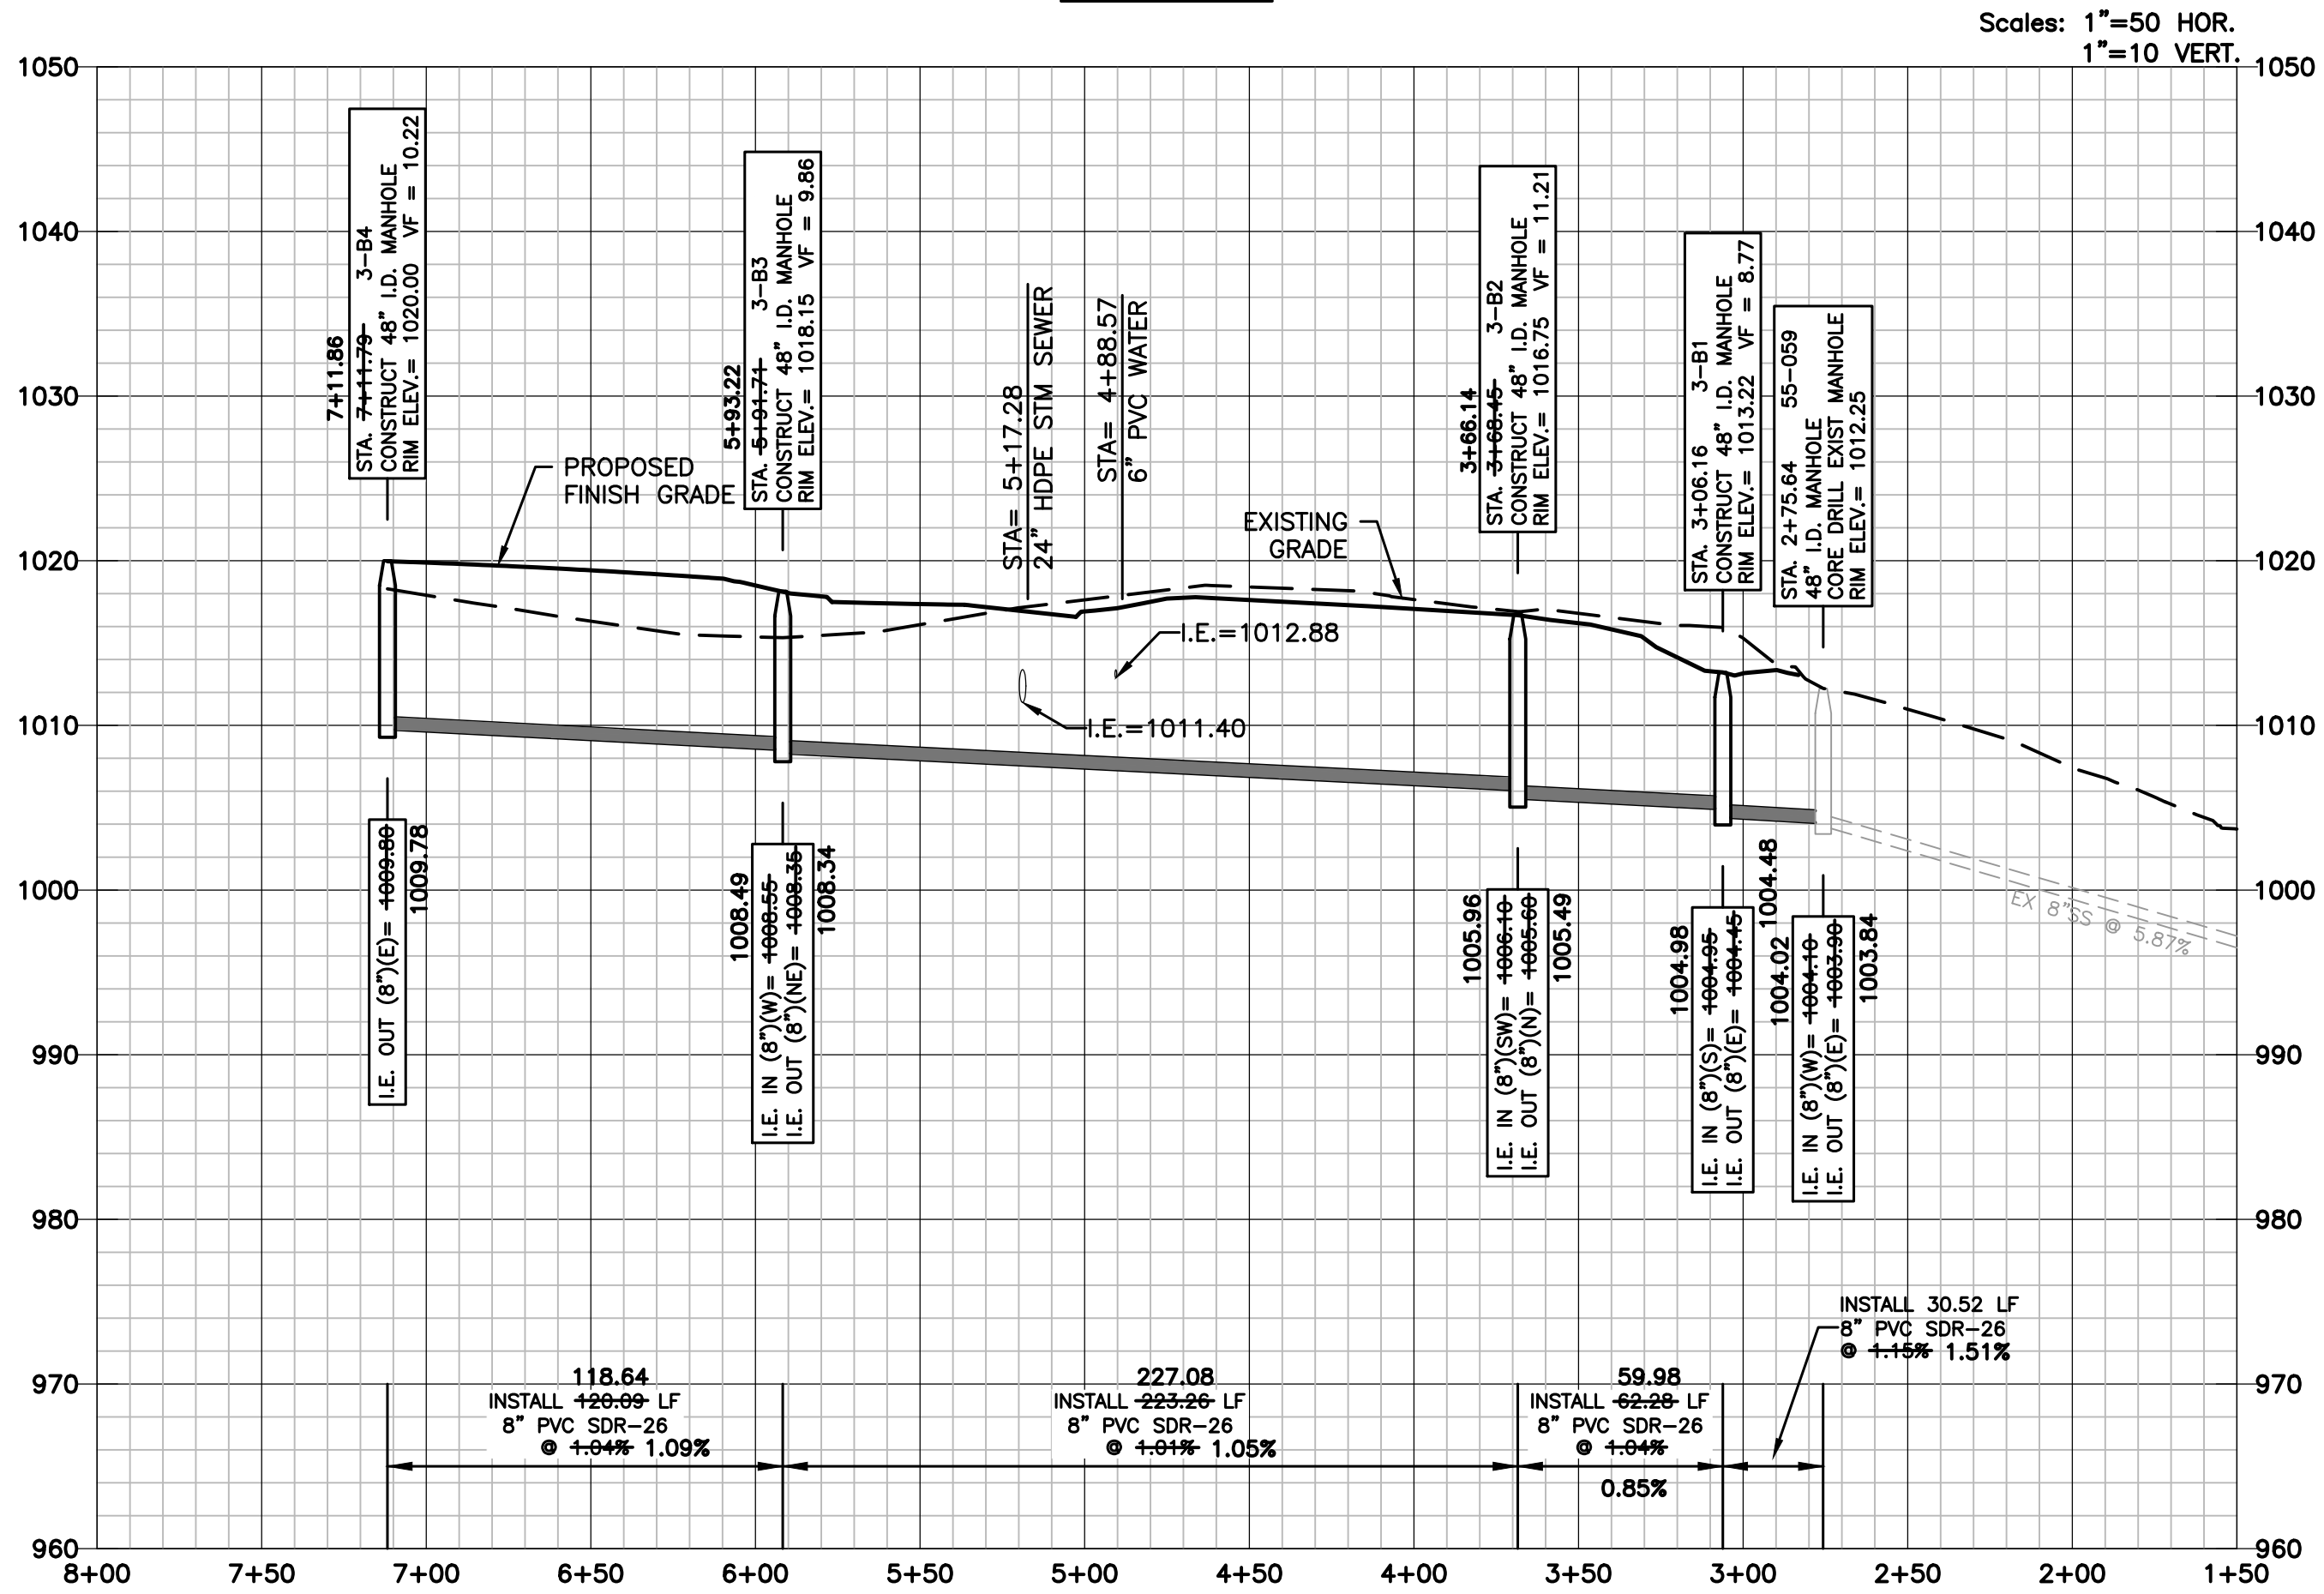

SANITARY SEWER STRUCTURE TABLE		
STRUCTURE	STATION & OFFSET	STREET NAME
MH 3-B1	34+62.86, 35.04' RT	SW KLINE AVE
MH 3-B2	34+65.33, 97.25' RT	SW KLINE AVE
MH 3-B3	12+52.92, 37.63' RT	SW CHASE CIR
MH 3-B4	11+27.49, 27.78' RT	SW CHASE CIR

Sewer Line	Main Station	Sewer Main Invert Elevation	Lateral Stub Length	Minimum Lateral Stub Elevation	Minimum Service Floor Elevation	Lot
3-B	3+90	1006.32	10	1007.85	1009.70	69
3-B	3+95	1006.37	10	1007.90	1009.75	70
3-B	5+40	1007.83	55	1010.26	1012.20	71
3-B	5+99	1008.63	10	1010.16	1012.40	72
3-B	6+03.5	1008.67	85	1011.70	1013.75	68
3-B	6+25	1008.90	10	1010.43	1012.20	73
3-B	6+61	1009.27	70	1012.00	1013.90	67
3-B	6+99	1009.67	10	1011.20	1013.00	74
3-B	7+03.5	1009.71	70	1012.44	1014.35	66

NOTE: DESIGN LATERAL INFORMATION SHOWN. LATERAL LOCATIONS AND ELEVATIONS WERE NOT AS-BUILT.

DRAWN BY

DESIGNED BY

DATE

JOB NUMBER-TASKS

BOOK AND PAGE

08/19/18 - RESUBMITAL PER ADJUSTED LAYOUT

09/19/18 - RESUBMITAL PER CITY COMMENTS

02/04/2020 - ASBUILT

09-19-2018

0319050.01

LARKIN/RYNEARSON

9001 State Line Rd., Suite 200
Kansas City, Missouri 64114
www.LRA-Inc.com

02-04-2020

PE - 2008019568

MASS GRADING, EROSION CONTROL,
PAVING, STORM AND SANITARY PLANS
SANITARY SEWER PLAN AND PROFILE
LINE 3-B

27 OF 31

LARKIN RYNEARSON - ENGINEERS

MO Certificate of Authority No. 2013011903

STATE OF MISSOURI

MARK DANIEL MCGHEE JR.

PROFESSIONAL ENGINEER



2008019568

02-04-2020

MARK DANIEL MCGHEE JR.

PE - 2008019568

SHEET

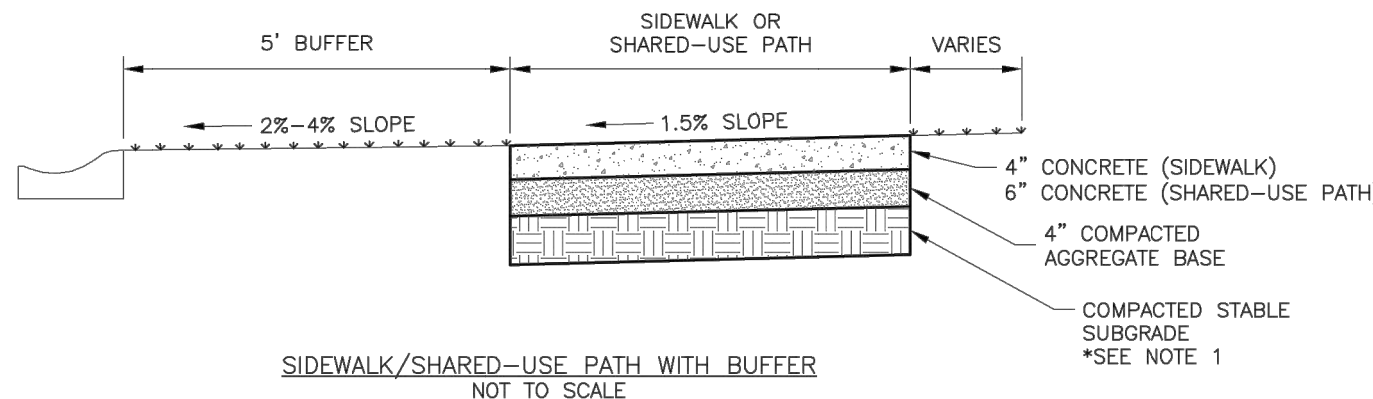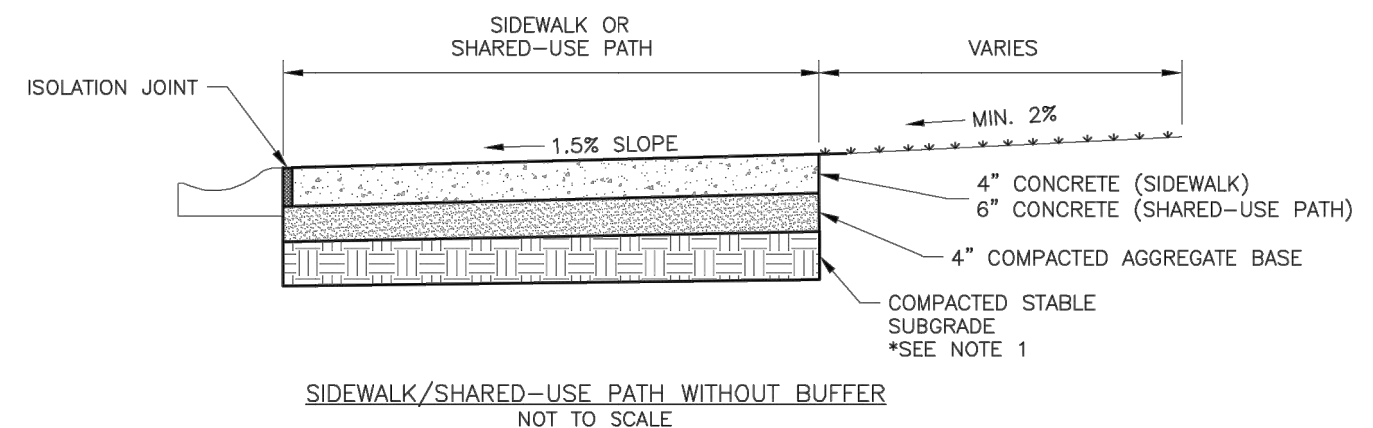

- GENERAL NOTES:

1. SUBGRADE MUST BE OF STABLE, COMPACTED EARTH AND SHALL BE OVERLAYED WITH 4" COMPACTED DENSE GRADED AGGREGATE BASE.
2. 1.5% CROSS SLOPE MUST BE MAINTAINED THROUGH DRIVEWAYS.
3. KCMCM 4X4 CONCRETE MIX SHALL BE REQUIRED FOR ALL SIDEWALKS AND SHARED-USE PATHS OR AS APPROVED BY THE CITY INSPECTOR.
4. ALL SIDEWALKS SHALL GUARANTEE PUBLIC RIGHT OF WAY ACCESSIBILITY GUIDELINES (PROWAG).
5. AN EXPANSION JOINT SHALL BE PLACED AT A MAXIMUM OF 150 FT. CONSTRUCTION JOINTS SHALL BE PLACED THE SAME WIDTH OF SIDEWALK, BUT NO GREATER THAN 10 FT.
6. SIDEWALK-USE PATH WIDTH SHALL BE 10 FT. WIDE.
7. SIDEWALK FINISHING (NO PICTURE FRAMING) AS DIRECTED BY CITY INSPECTOR.
8. WHITE CURING COMPOUND MUST BE APPLIED UNIFORMLY TO THE CONCRETE SURFACE IMMEDIATELY AFTER SHAW FINISHING.



LEE'S SUMMIT
MISSOURI

SIDEWALK/SHARED-USE PATH DETAIL


SIDEWALK/SHARED-USE PATH DETAIL

Date: 04/17

Dewey Bld. MIE









Drawn By: WJF

GEN-2

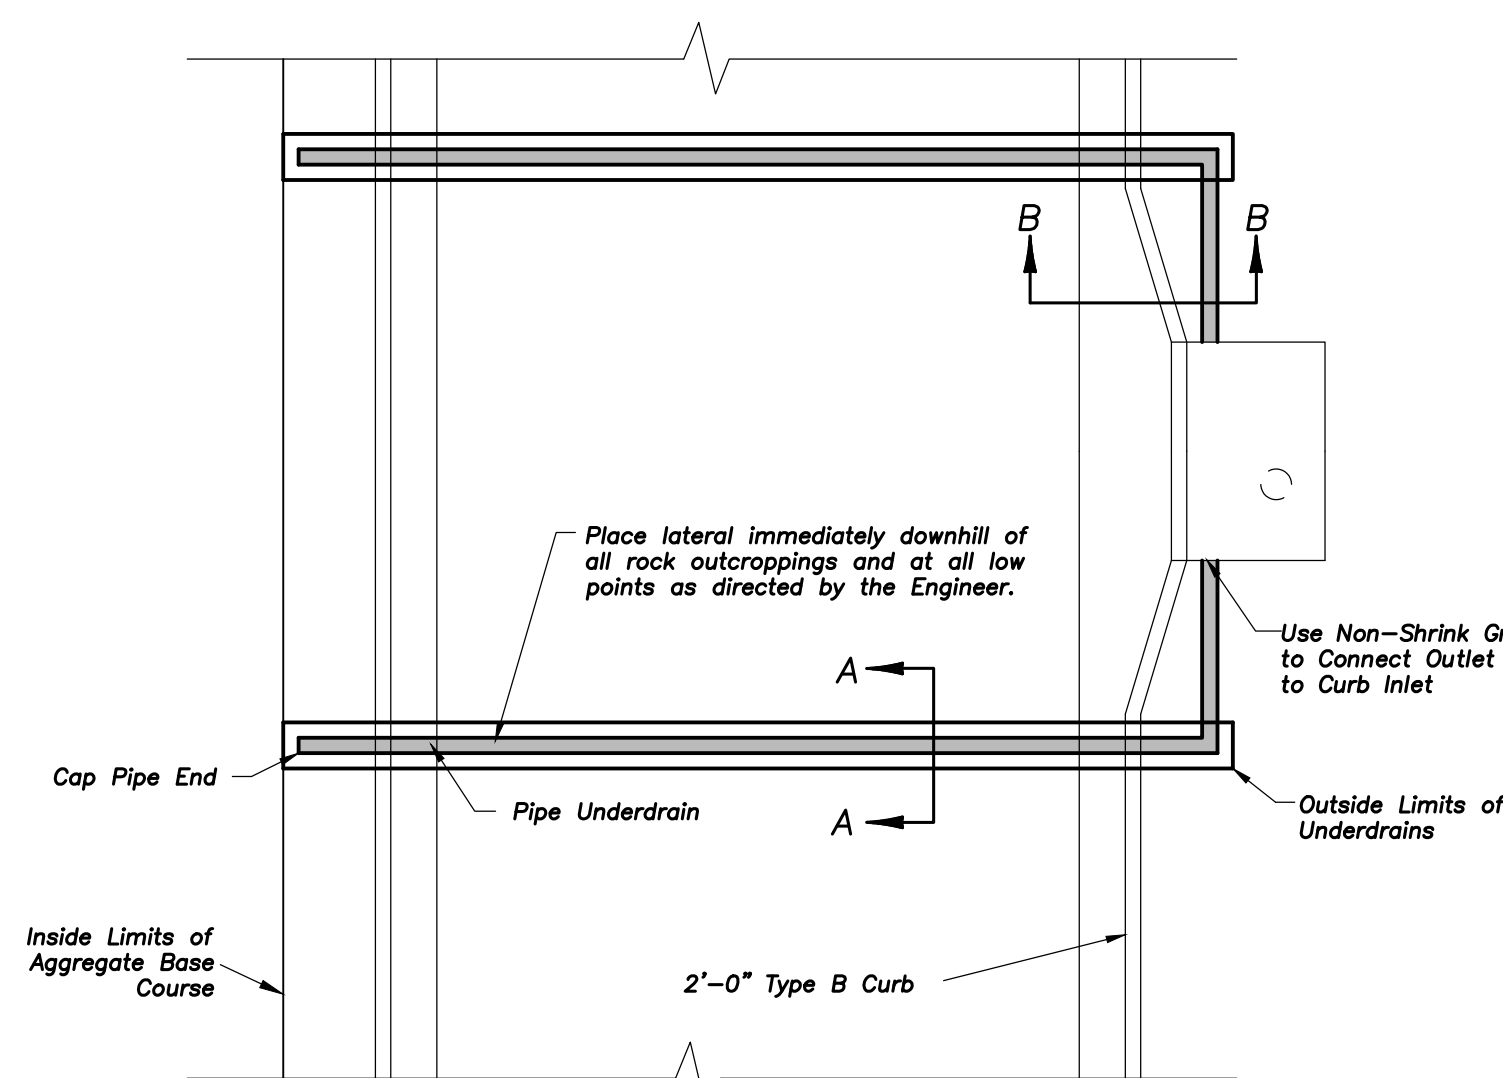


- Underdrain Notes:**

1. A minimum of 12" of select soil (topsoil) shall be placed on exposed rock cut or fill slopes outside the limits of the roadway. All rock and shale slopes shall be benched at a maximum of 2' vertical intervals prior to placement of select soil.
2. All underdrain pipes shall be installed at a minimum slope of 1%. Pipe shall be installed with the perforations placed down.
3. Construct underdrain and fold geotextile over underdrain aggregate to protect the underdrain until the Aggregate Base Course is constructed. Fold the geotextile back and construct the Aggregate Base Course. Geotextile seams shall be overlapped at a minimum of 12".

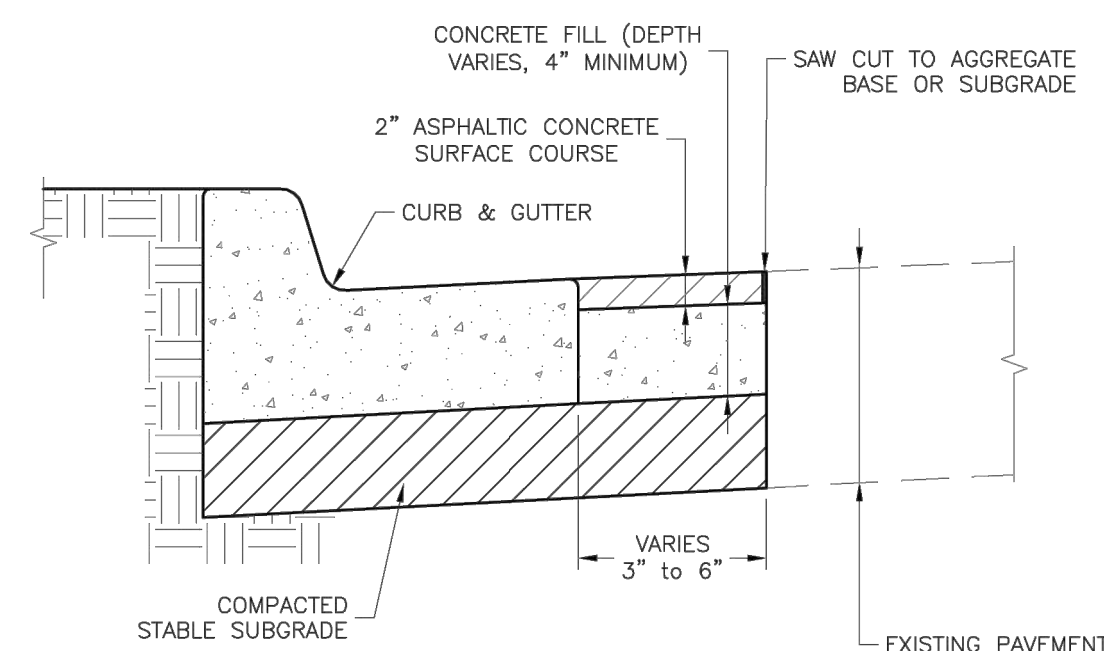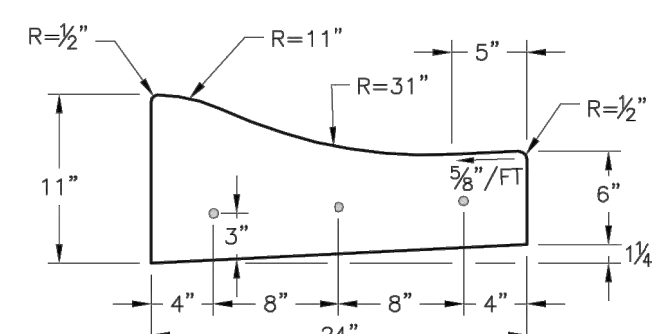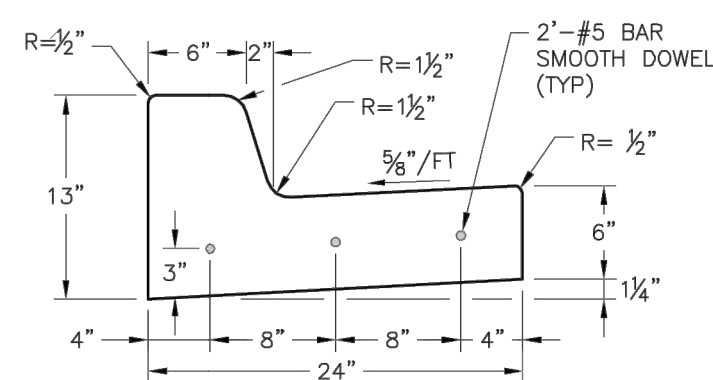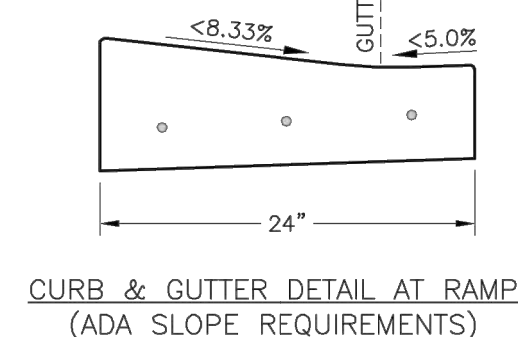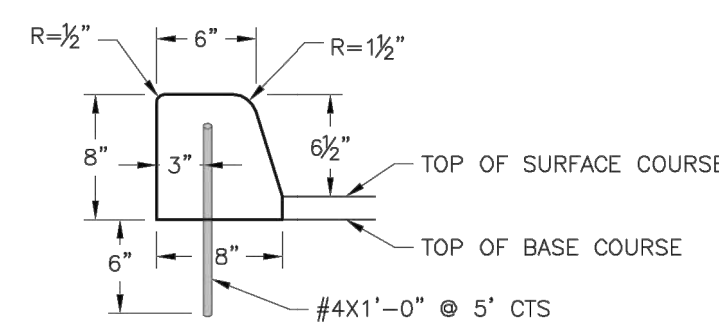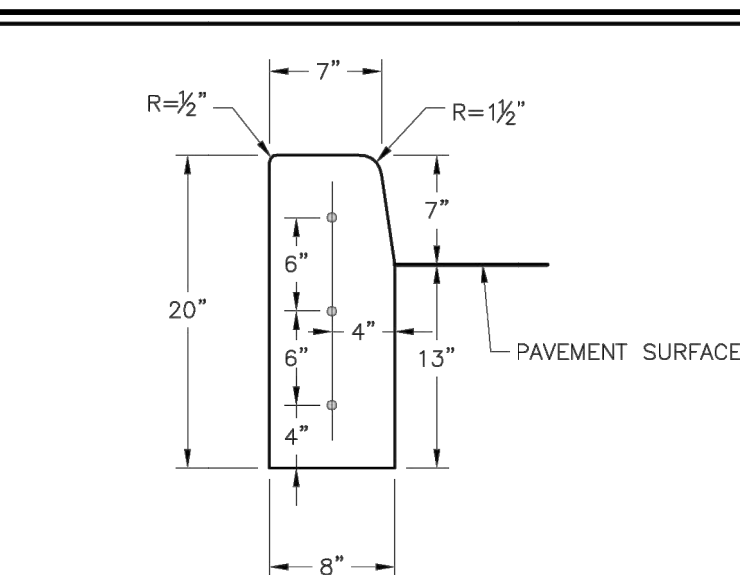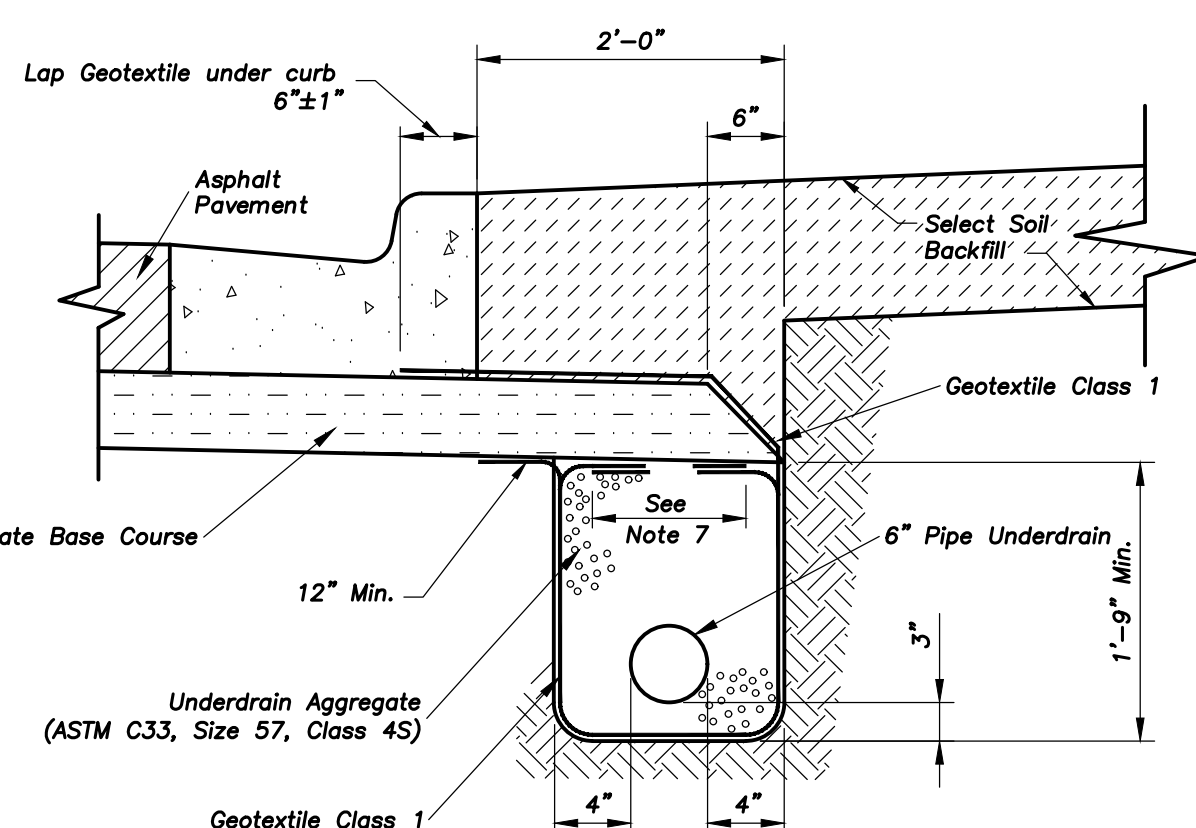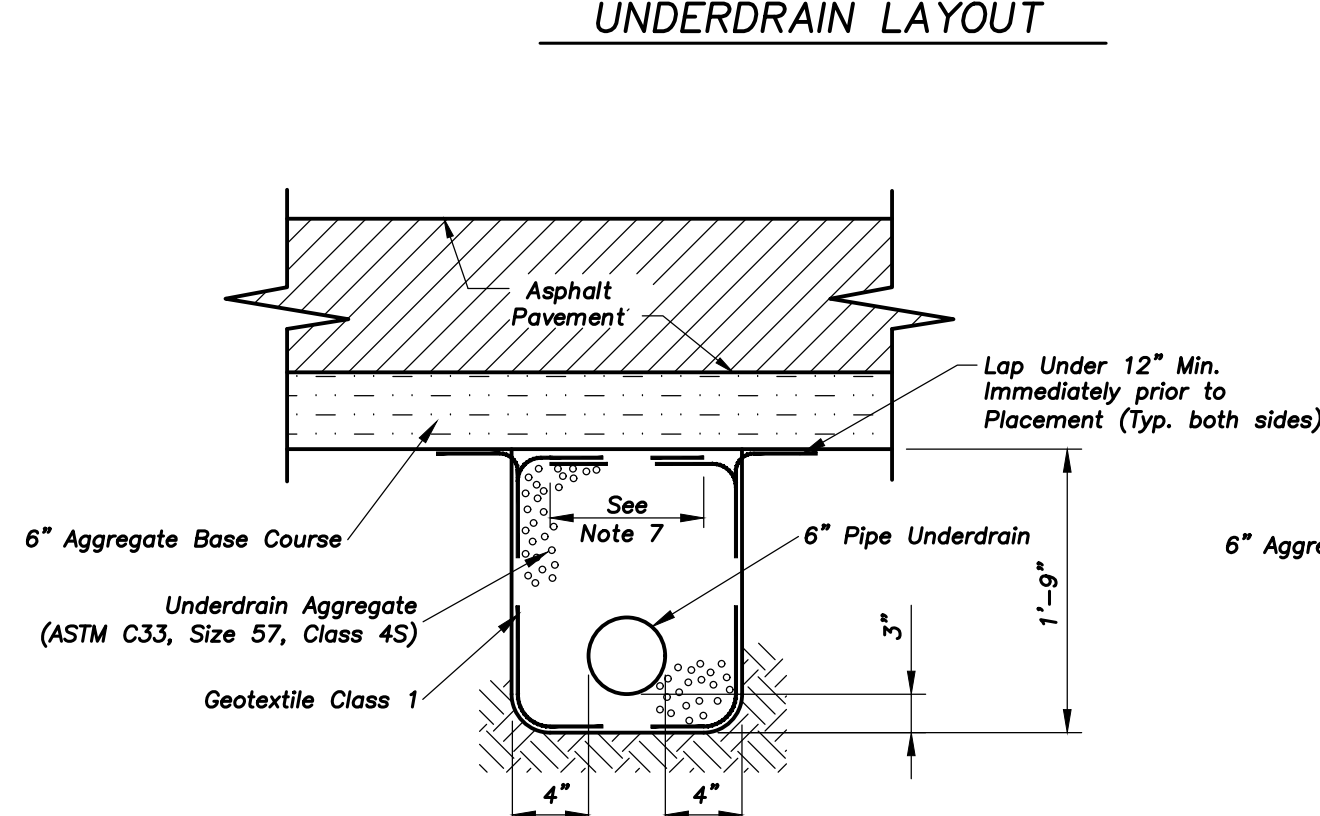

- GENERAL NOTES



1. 3/4" ISOLATION JOINTS WITH 3 (2'-5" BAR) SMOOTH DOWELS SHALL BE PLACED AT RADIUS POINTS AND AT 150' INTERVALS. THESE DOWEL BARS SHALL BE GREASED AND WRAPPED ON ONE END WITH EXPANSION TUBES.
2. 3" DEEP CONTRACTION JOINTS SHALL BE INSTALLED AT APPROXIMATELY 10' INTERVALS. THESE JOINTS SHALL PASS ACROSS THE ENTIRE CURB SECTION.
3. CONCRETE FILL SHALL HAVE UNIFORM AND SMOOTH FINISH
4. KCMMB 4K CONCRETE SHALL BE USED FOR ALL CURB.
5. ASPHALTIC CONCRETE SURFACE COURSE SHALL CONFORM TO STANDARD SPECIFICATIONS SECTION 2205.2.
6. CURBS FOR NEW STREETS SHALL BE BUILT ON ASPHALT OR AGGREGATE BASE AS SHOWN IN TYPICAL SECTION DETAIL.
7. WHITE CURING COMPOUND MUST BE APPLIED UNIMEDIATELY TO THE CONCRETE SURFACE IMMEDIATELY AFTER FINAL FINISHING.

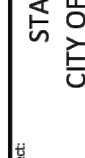

Project: STANDARD DETAILS
CITY OF LEE'S SUMMIT, MO
LEE'S SUMMIT, JACKSON COUNTY, MO

CURB & GUTTER DETAIL

GEN

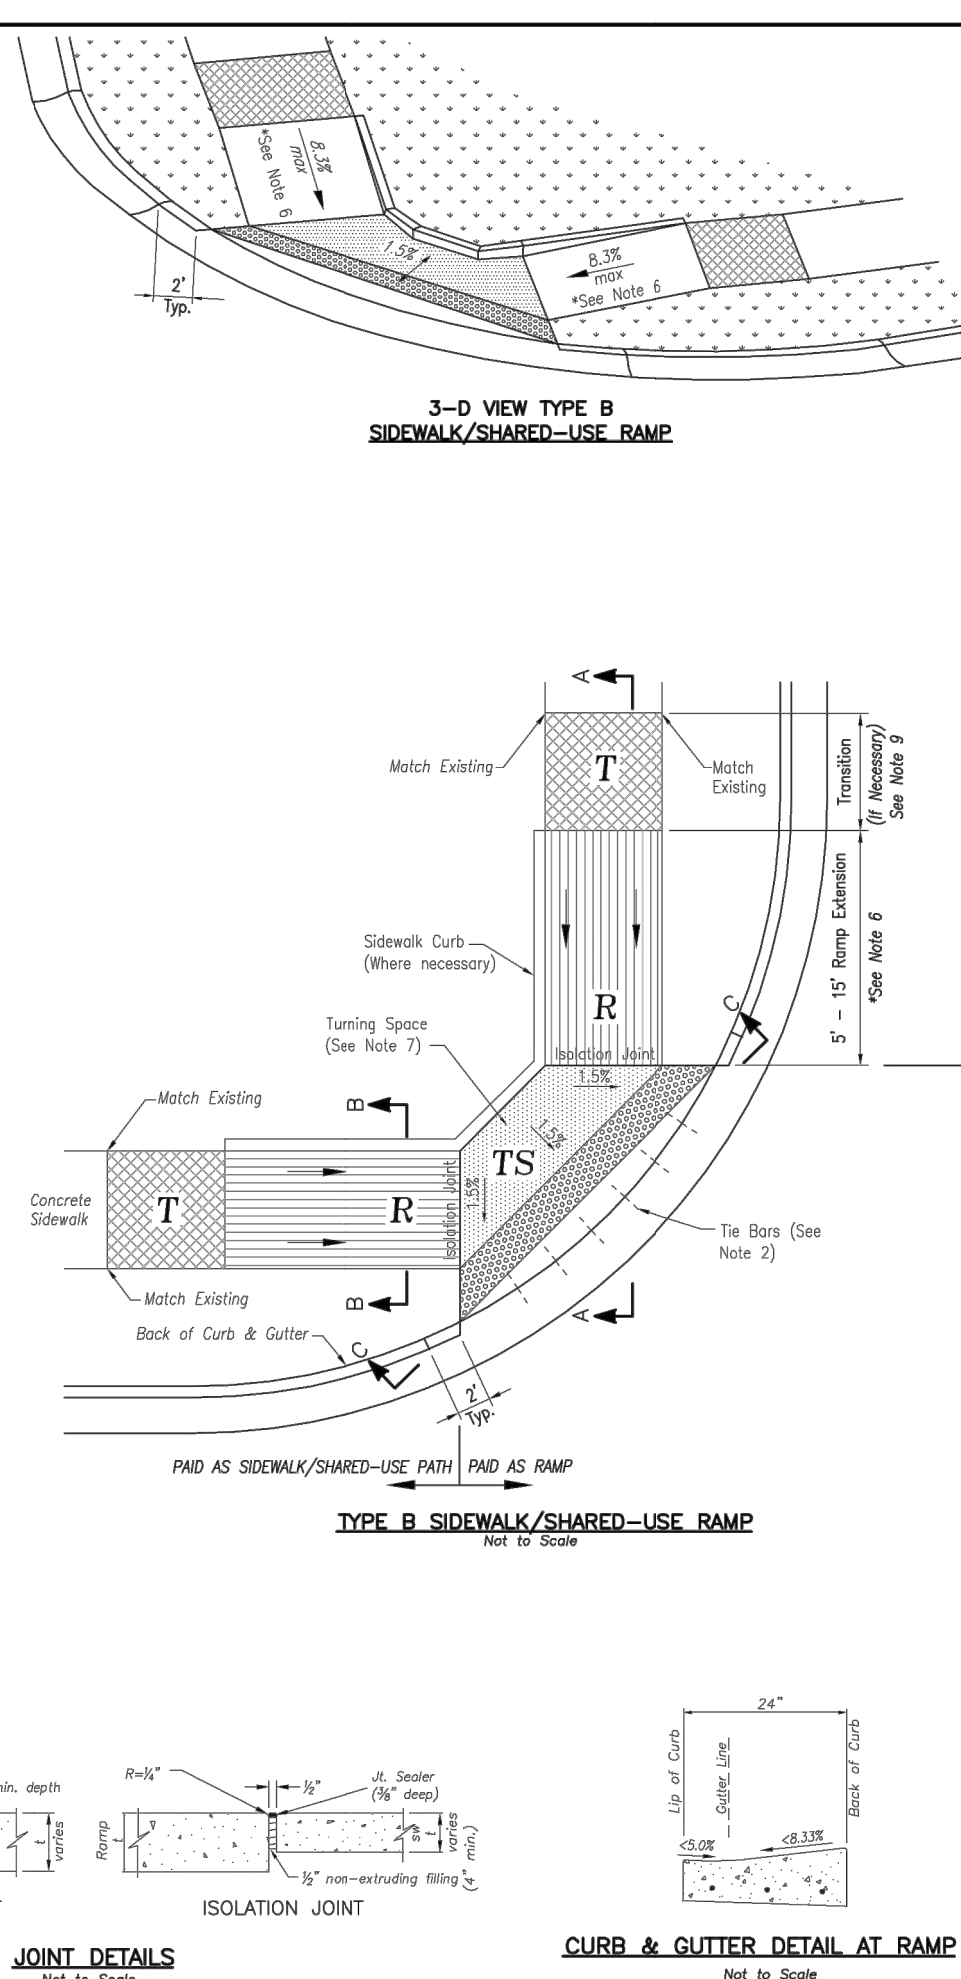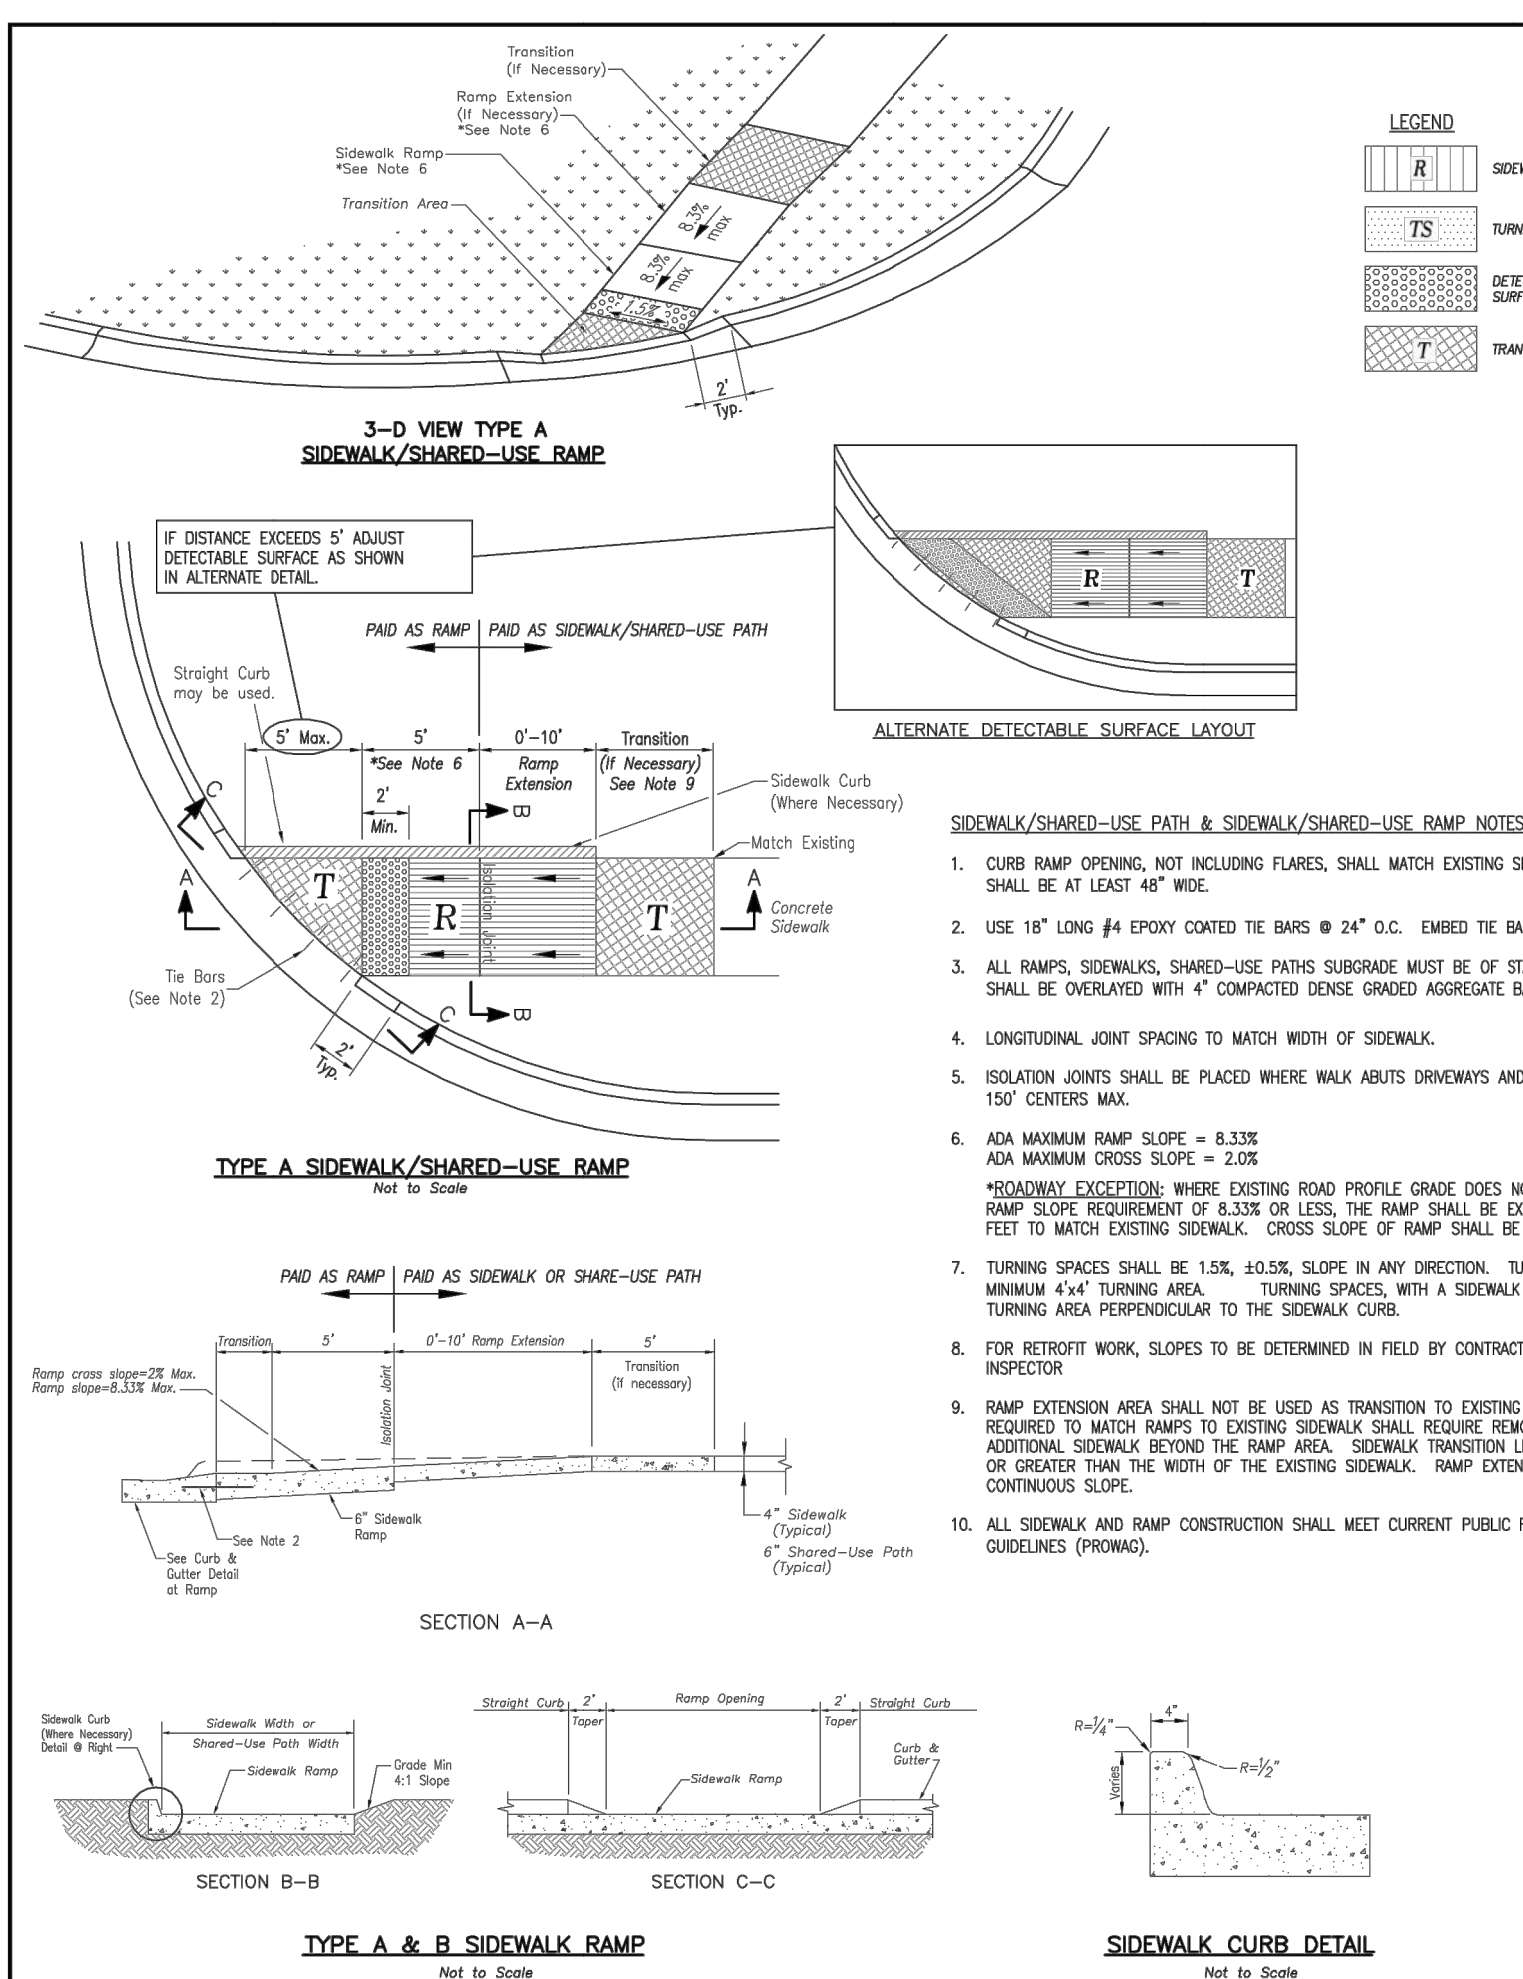

- SIDEWALK/SHARED-USE PATH & SIDEWALK/SHARED-USE RAMP NOTES

5. CURB RAMP OPENING, NOT INCLUDING FENCES, SHALL MATCH EXISTING SIDEWALK WIDTH AND OPENING SHALL BE AT LEAST 48" WIDE.
6. USE 18" LONG #4 EPOXY COATED BARS @ 24" O.C. EMBED THE BARS 9" IN EACH DIRECTION.
7. ALL RAMP SURFACES, SHARED-USUE PATHS SUBGRADE MUST BE STABLE, COMPACTED EARTH AND SHALL BE OVERLAYED WITH A COMPACTED DENSE AGGREGATE BASE.
8. LONGITUDINAL JOINT SPACING TO MATCH WIDTH OF SIDEWALK.
9. ISOLATION JOINTS SHALL BE LOCATED WHERE WALK ABUTS DROWNS AND SIMILAR STRUCTURES, AND 150' CENTERS MAX.
10. ADA MAXIMUM RAMP SLOPE = 8.33%
ADA MAXIMUM CROSS SLOPE = 2.08%
*ROADWAY EXCEPTION: WHERE EXISTING ROAD PROFILE GRADE DOES NOT ALLOW RAMP TO MEET RAMP SLOPE REQUIREMENT OF 8.33% OR LESS, THE RAMP SHALL BE EXTENDED TO A LENGTH OF 19 FEET AND THE MAXIMUM CROSS SLOPE OF THE TRANSITION SHALL BE 15% - 20.4%.
11. TURNING SPACES SHALL BE 1.5X, 20.5X, SLOPE IN ANY DIRECTION. TURNING SPACES SHALL HAVE MINIMUM 4.4'x4.4' TURNING. TURNING SPACES, WITH A SIDEWALK CURB, SHALL HAVE A 5" TURNING AREA PERPENDICULAR TO THE SIDEWALK CURB.
12. FOR RETROFIT WORK, SLOPES TO BE DETERMINED IN FIELD BY CONTRACTOR AND APPROVED BY CITY INSPECTOR
13. RAMP EXTENSION SHALL NOT BE USED AS TRANSITION TO EXISTING SIDEWALK. ANY TRANSITION REQUIRED TO MATCH RAMP TO EXISTING SIDEWALK SHALL REQUIRE REMOVAL AND REPLACEMENT OF THE EXISTING SIDEWALK TO THE FULL WIDTH OF THE TRANSITION. THE RAMP SHALL BE EQUAL TO OR GREATER THAN THE WIDTH OF THE EXISTING SIDEWALK. RAMP EXTENSIONS SHALL BE A CONTINUOUS SLOPE.
14. ALL SIDEWALK AND RAMP CONSTRUCTION SHALL MEET CURRENT PUBLIC RIGHT OF WAY ACCESSIBILITY CODES AND STANDARDS.



STANDARD DETAILS
CITY OF LEE'S SUMMIT, MO
LEE'S SUMMIT, JACKSON COUNTY, MO

RAMP RETROFIT DETAIL


Source: MJE

Checked By: DL

Date: 04/17

GEN-3

L:\Engineering\0318050 SVFD0 Summit View Farms 3rd Plat\DRAWINGS\CONSTRUCTION\PAV-PLANS\PAV-DETAILS.dwg, 9/19/2018 11:09:36 AM, JAMIE MCOURRY, LAMP RYNEARSON & ASSOCIATES

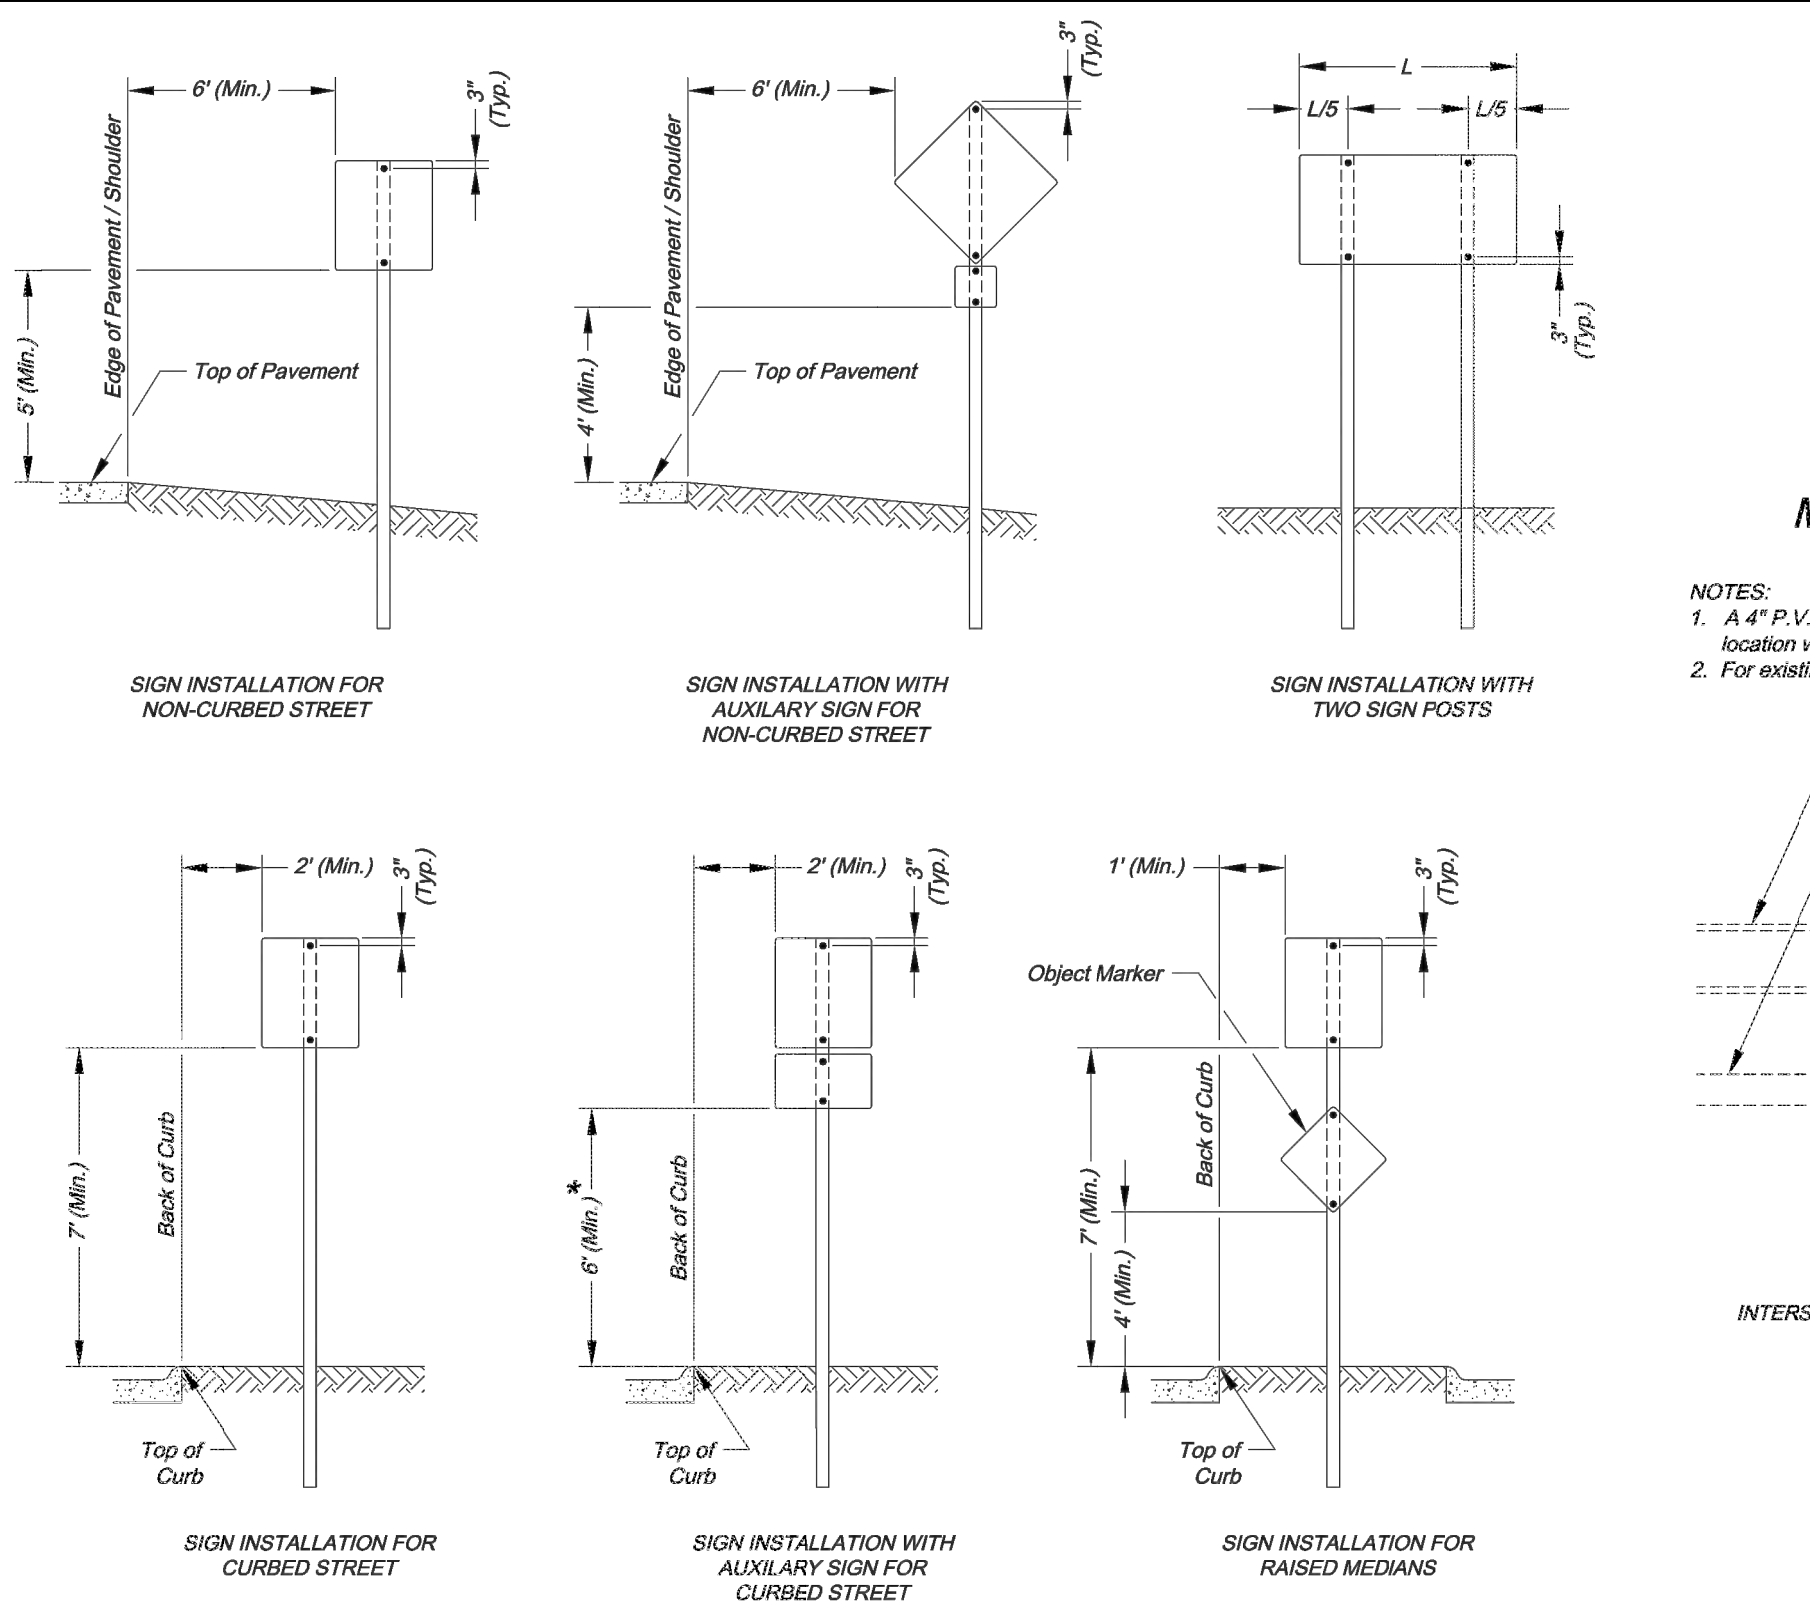

SIGN MOUNTING DETAILS

* The height to the bottom of a sign when it is located in a pedestrian walkway or extends into a walkway shall be a minimum of 80 inches above the walkway.

NOTE:

- Generally, the sign mounting height should not be more than 1' greater than the minimum mounting height.


STANDARD ABBREVIATION LISTS

Named Streets	
Avenue	AVE
Boulevard	BLVD
Circle	CIR
Creek	CR
Court	CT
Crossing	XING
Drive	DR
Highway	HWY
Lane	LN
Parkway	PKWY
Place	PL
Road	RD
Street	ST
Terrace	TER
Trail	TRL
Way	WAY

Numbered Streets	
First	ST
Second	ND
Third	RD
Fourth to Tenth	TH


STREET NAME SIGN QUANTITIES

Sign Designation	Sign Size	Sign Area (Sq. Ft.)	Number	Quantity (Sq. Ft.)
D3-1 (SP-1)	9" x	Sq. Ft.	1	1
D3-1 (SP-2)	9" x			
D3-1 (SP-3)	9" x			
D3-1 (SP-4)	9" x			
D3-1 (SP-5)	9" x			
D3-1 (SP-6)	9" x			

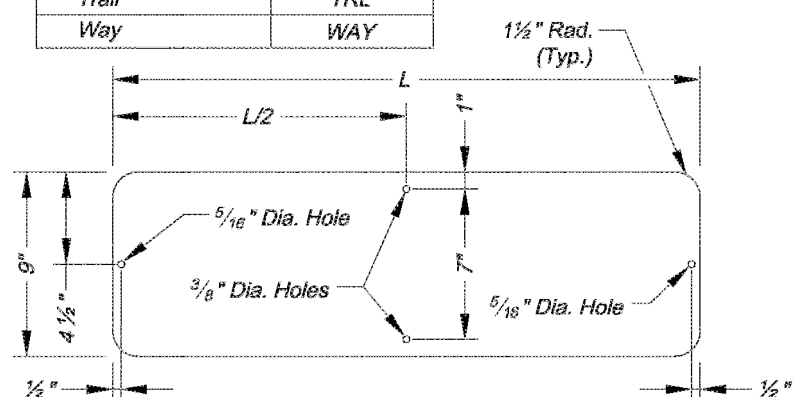

STREET NAME SIGN BLANK DETAILS


For Mounting on Square Steel Posts

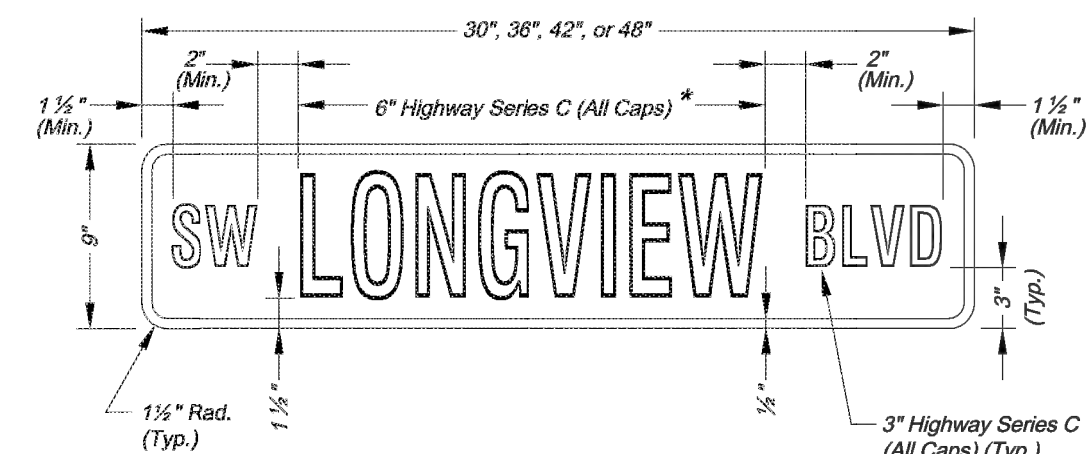


NAMED STREET NAME SIGN DETAIL

* Use Highway Series B (All Caps) in lieu of Series C if necessary to fit text on a 36" sign blank.

PROJECT SIGN DETAILS

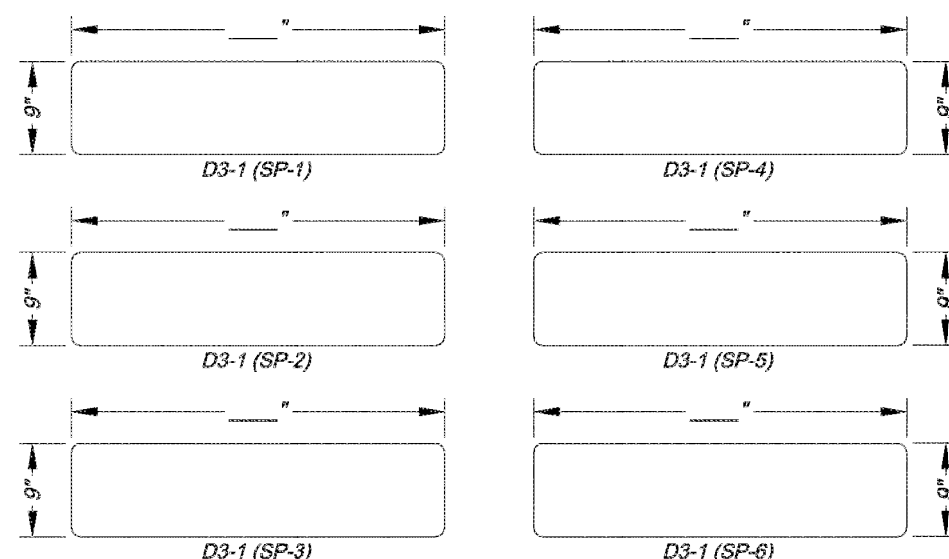


ARROW DETAIL

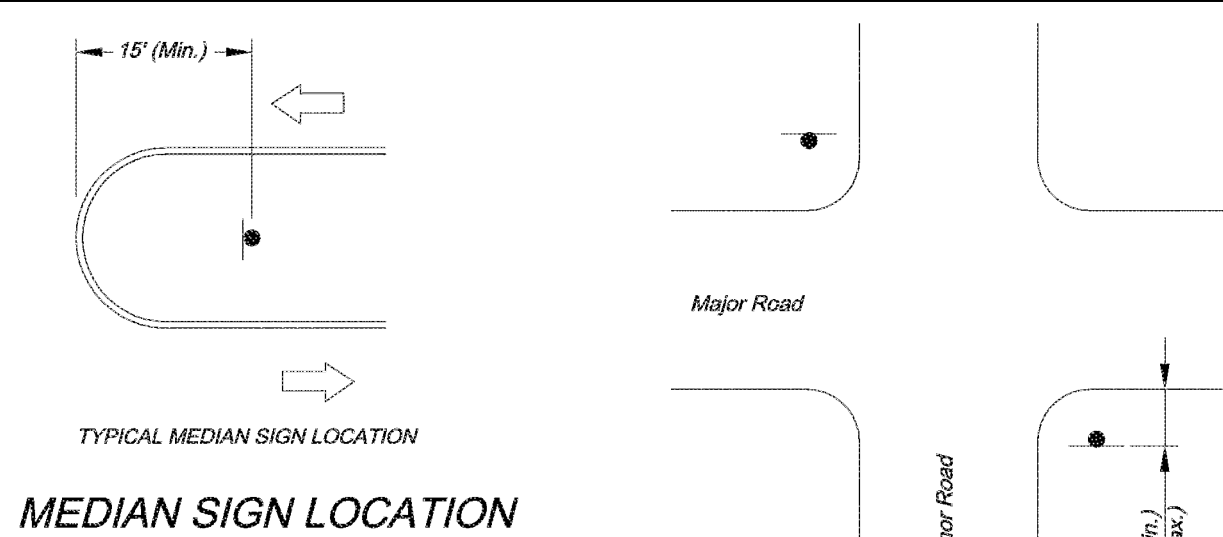


MEDIAN SIGN LOCATION

NOTES:


- A 4" P.V.C. sleeve shall be installed in new concrete medians at each location where a sign is to be installed.
- For existing concrete medians, a 4" hole shall be cored into the concrete.

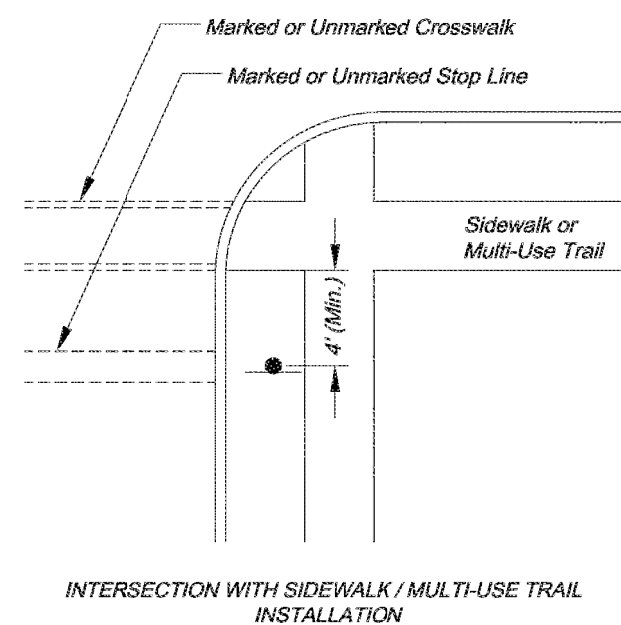

INTERSECTION WITH SIDEWALK / MULTI-USE TRAIL INSTALLATION

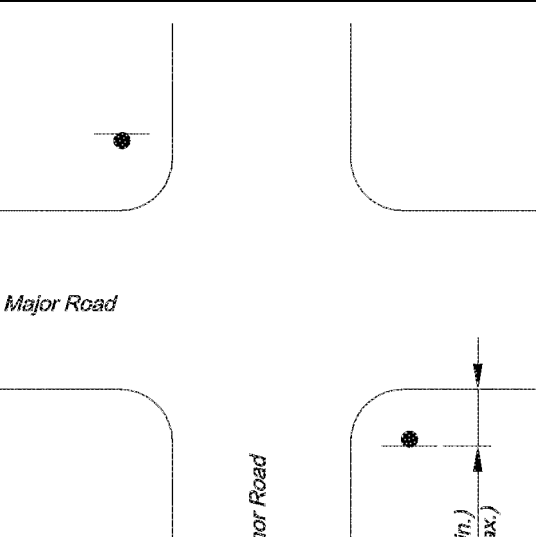


NON-CURVED INTERSECTION INSTALLATION

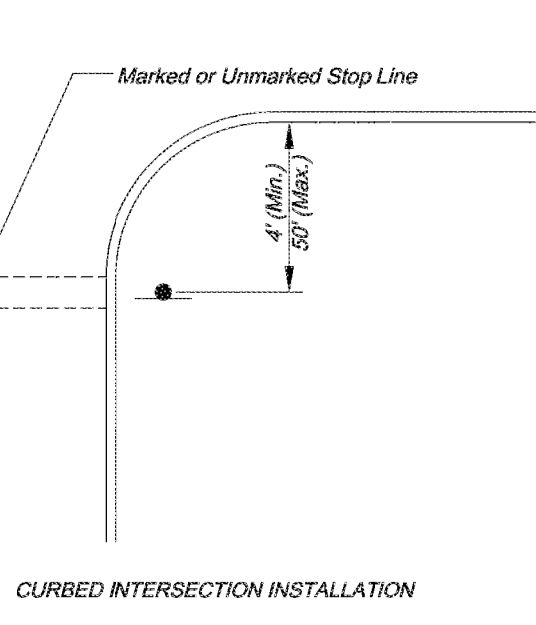


CURBED INTERSECTION INSTALLATION


CONTROL SIGN LOCATION

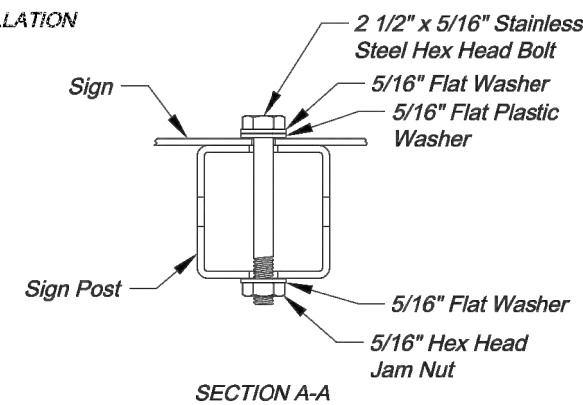

SECTION A-A

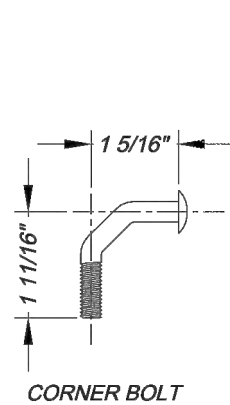

CORNER BOLT

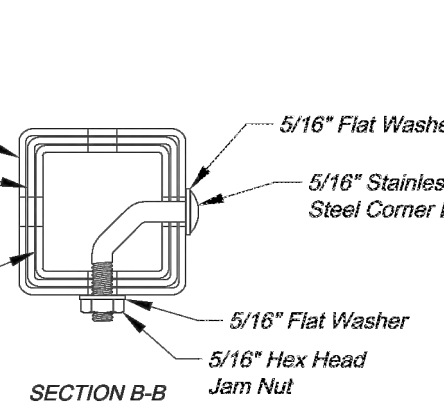

SECTION B-B


SQUARE STEEL POST DETAILS

SQUARE STEEL POST NOTES:


- Square steel sign posts and break-away anchor shall consist of the following materials:
 - Sign Post - 14 Ga. 2" x 2" Square Steel Post
 - Post Anchor - 12 Ga. 2 1/4" x 2 1/4" x 36" Square Steel Post
 - Anchor Sleeve - 12 Ga. 2 1/4" x 2 1/4" x 18" Square Steel Post
- 14 Gauge posts must meet a certified minimum yield strength of 60,000 psi.
- In all installations the first hole above the finished grade line on the sign post, anchor, and anchor sleeve must be in line for the insertion of the corner bolt.
- The maximum area for one sign post is 9.0 square feet. A sign or combination of signs with an area greater than 9.0 square feet will require two posts. Also, signs with a width greater than 36" (not including 36" x 36" diamond shaped signs) will require two posts.

PERMANENT SIGNING GENERAL NOTES:

- All signing shall be in accordance with the latest edition of the *Manual on Uniform Traffic Control Devices (MUTCD)*.
- The Contractor is responsible for avoiding any and all utilities when installing sign posts, whether the utility is indicated on the plans or not.
- All workmanship and materials shall be subject to the inspection and approval of the Public Works Department of the City of Lee's Summit.
- The Contractor shall stake the location of all sign posts to be installed. The City Inspector shall inspect the staking prior to installation. Minor relocation to avoid conflicts may be allowed with the approval of the City Traffic Engineer or designee.
- Signs shown to be installed on the side of metal poles shall be mounted with stainless steel straps or wing brackets as detailed. No signs are to be installed on wood poles. See Traffic Signal Standard Drawings for the installation of signs on mast arms.
- All post mounted signs shall be installed with breakaway anchors according to the Standard Drawings.
- Existing permanent signs and posts removed by the Contractor for construction purposes which are not to be reinstalled shall be delivered to the City's Public Works Maintenance Facility (1971 SE Hamblen Road). The Contractor shall be responsible for removing and storing equipment in good condition and it is fully responsible for the equipment until it is delivered.
- All Stop, Yield, or street name signs shall be maintained in a conspicuous location for the driving public. All Stop and Yield signs removed for construction purposes can be temporarily erected in reflectorized drums (no less than 7 feet above the pavement surface) until they can be reinstalled. Any temporary Stop or Yield sign installation to be left in place overnight will require prior approval from the City Inspector.

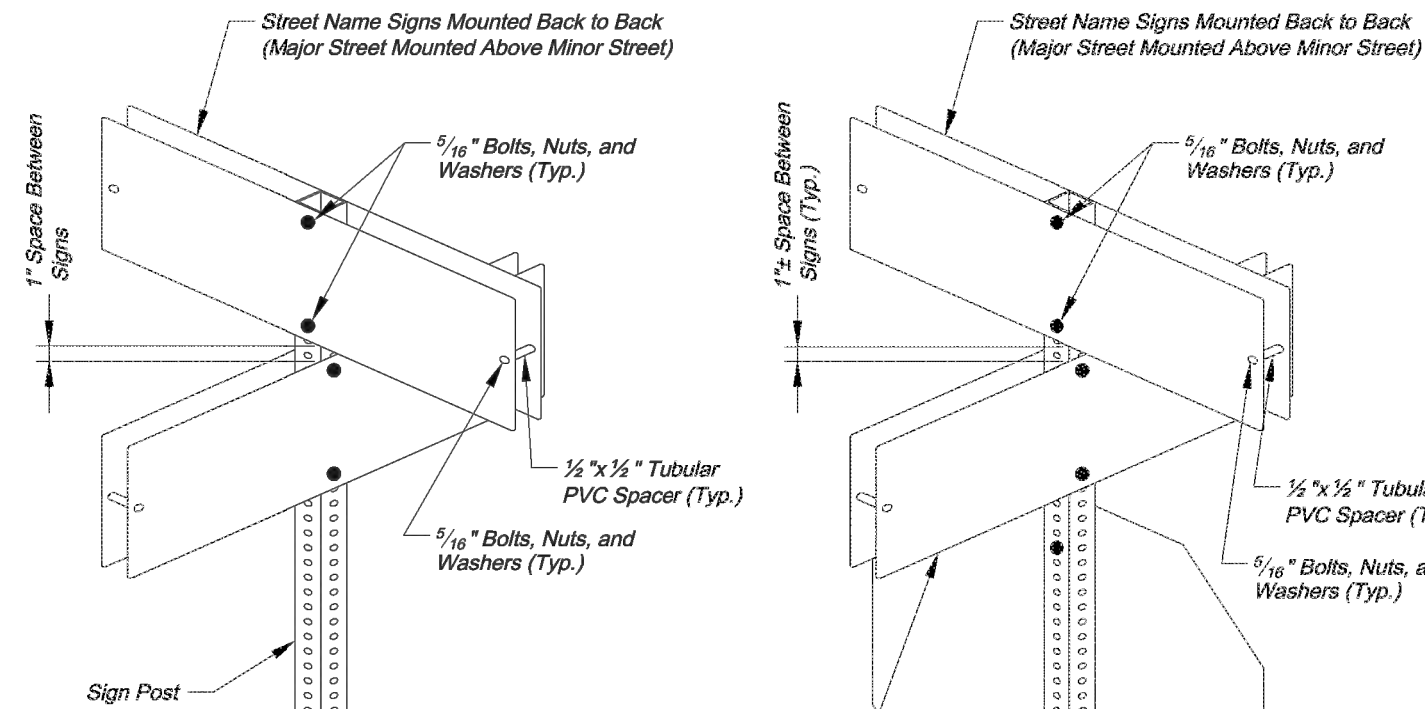

SIGNS INSTALLED SEPARATELY

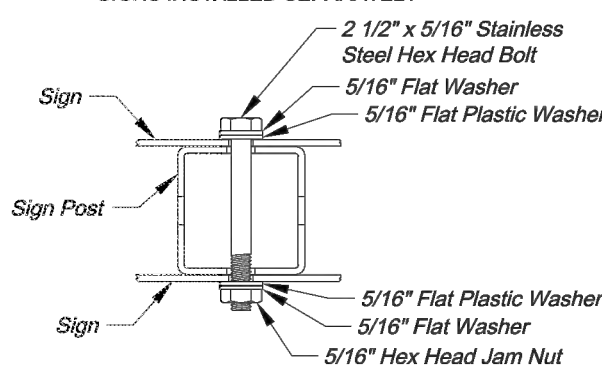


PLAN VIEW

SIGNS INSTALLED WITH OTHER SIGNS


SQUARE STEEL POST MOUNTING DETAILS

NOTES:

- For all street name signs, the legend shall be white and the background shall be green.
- Arrows shall be added to street name signs where the name of a street changes at an intersection. Street name signs with arrows are to be installed on each side of the intersection to indicate the change in names. Arrows shall be white.
- The "PRIVATE STREET" tag should be added to the end of street name signs to indicate where a street that is outside the right-of-way intersects a public street. The background for the "PRIVATE STREET" tag shall be yellow.

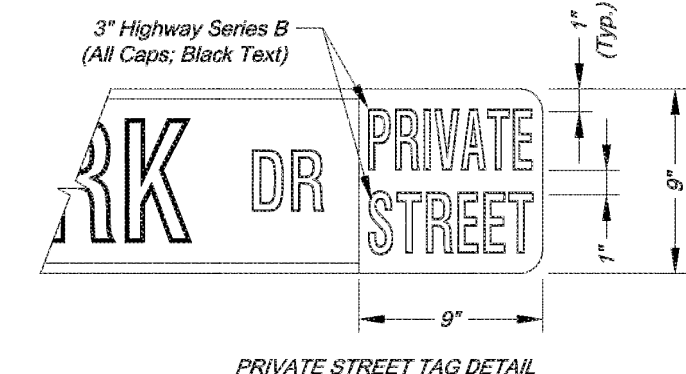

PRIVATE STREET TAG DETAIL

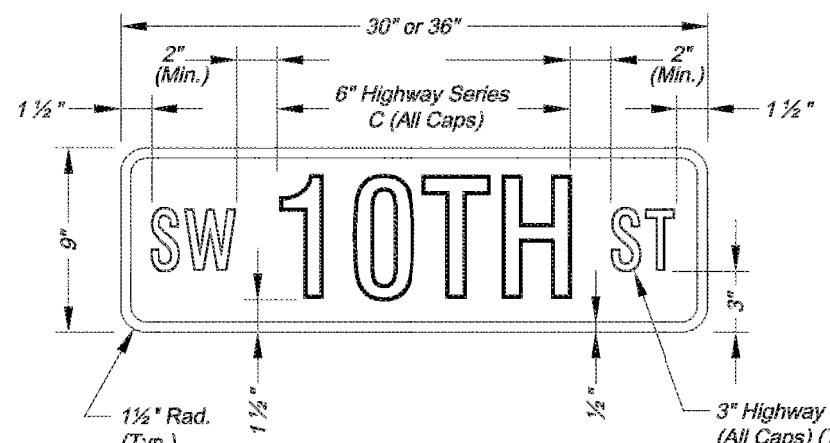

NUMBERED STREET NAME SIGN DETAIL

STREET NAME SIGN FACE DETAILS

DRAWN BY	JAM
DESIGNED BY	MDM
DATE	09-19-2018
JOB NUMBER-TASKS	0318050.01
BOOK AND PAGE	

REVISIONS	08/19/18 - RESUBMITAL PER ADJUSTED LAYOUT
	09/19/18 - RESUBMITAL PER CITY COMMENTS

9001 State Line Rd., Suite 200	816.361.0440 P
Kansas City, Missouri 64114	816.361.0045 F
www.LRA-inc.com	

LARKIN/RYNEARSON	DETAIL SHEET
------------------	--------------

SUMMIT VIEW FARMS 3RD PLAT	LEE'S SUMMIT, MISSOURI
----------------------------	------------------------

MASS GRADING, EROSION CONTROL, PAVING, STORM AND SANITARY PLANS

LARKIN RYNEARSON - ENGINEERS
MIO Certificate of Authority No. 2013011903



MARK DANIEL MCGHEE JR.

PE - 2008019568

SHEET