

AS BUILT PUBLIC WATER PLANS FOR

**Firestone**

COMPLETE AUTO CARE™

# NEW FIRESTONE STORE

3561 SW MARKET STREET  
JACKSON COUNTY  
LEE'S SUMMIT, MISSOURI

GRESHAM SMITH PROJECT NO. 40831.45

OWNER / DEVELOPER

**FS LEE'S SUMMIT, LLC**  
9010 Overlook Boulevard  
Brentwood, Tennessee 37027  
Owner Contact: Jason Horowitz  
Email: [jhorowitz@gbtrealty.com](mailto:jhorowitz@gbtrealty.com)  
Phone: (615) 370-0670

CIVIL ENGINEER



222 Second Avenue South, Suite 1400  
Nashville, TN 37201

Civil Contact: JP Michael, E.I.  
Phone: (615) 770-8175  
Email: [jp.michael@greshamsmith.com](mailto:jp.michael@greshamsmith.com)

SURVEYOR


CORNERSTONE REGIONAL  
SURVEYING, LLC

Contact: William A. Booe  
1921 North Penn  
Independence, KS 67301  
Phone: (620) 331-6767

ARCHITECT

## SGA DESIGN GROUP

1437 South Boulder Ave., Suite 550  
Tulsa, OK 74119  
Contact: Olivia Good, AIA, LEED A.P.  
Phone: (918) 587-8602 Ext. 341

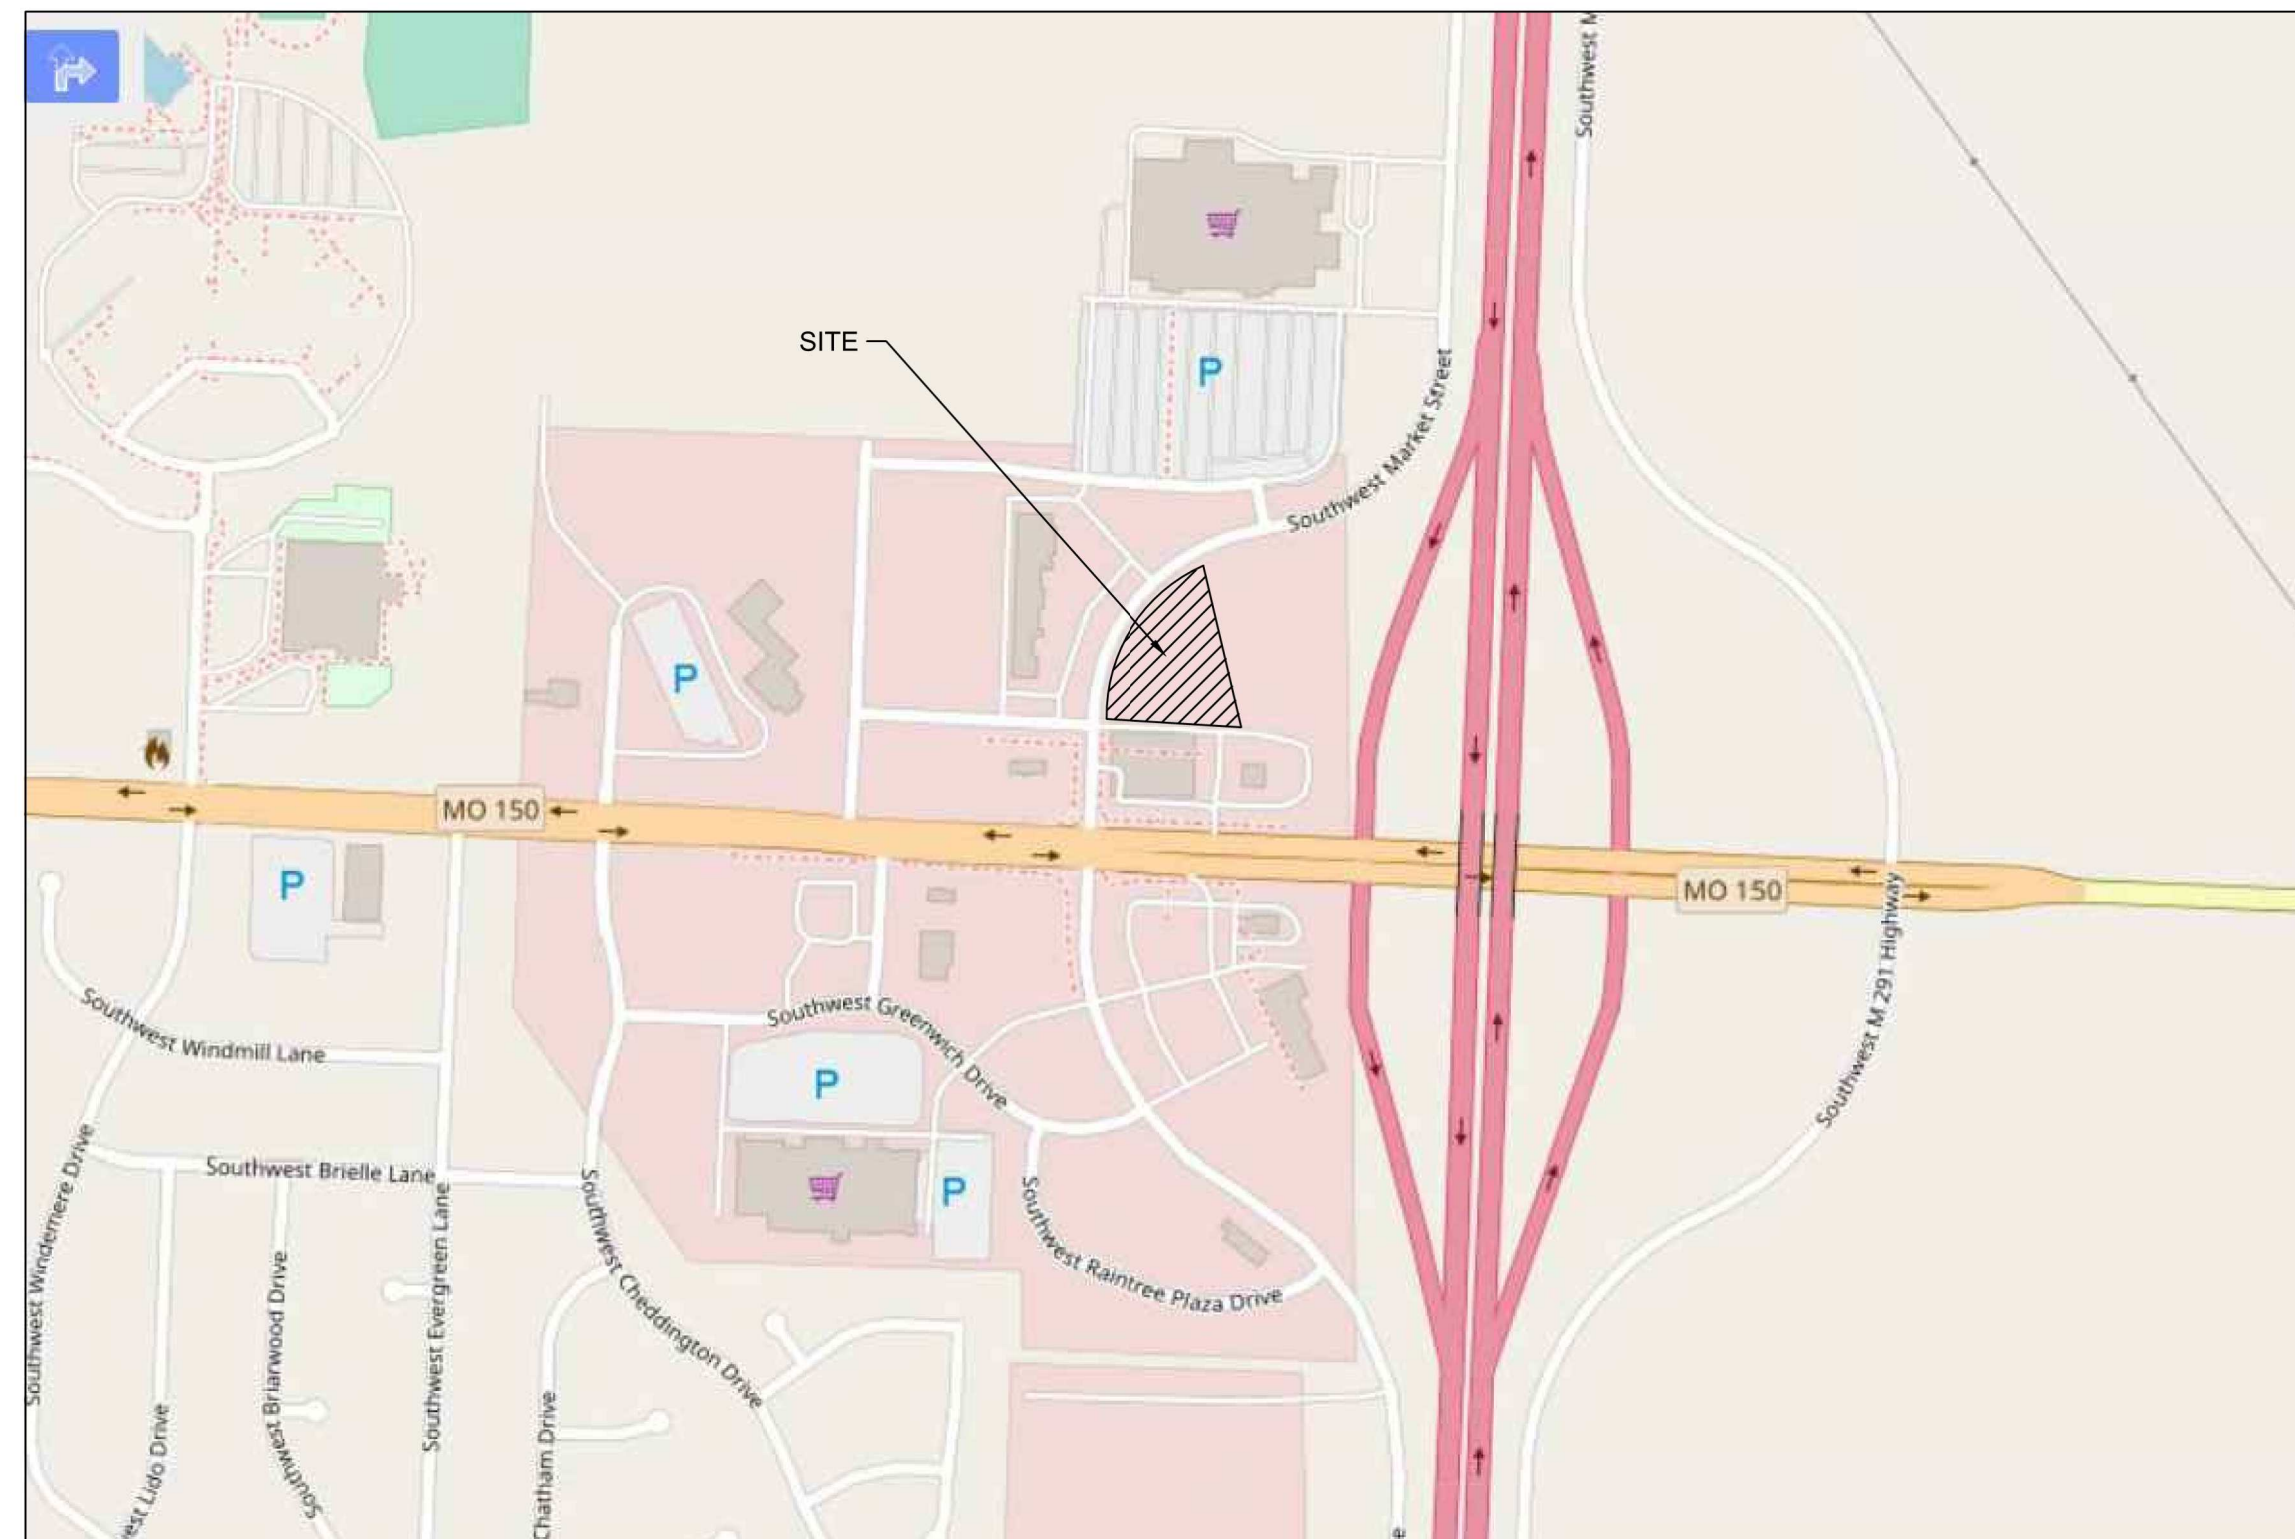

## VICINITY MAP

NOT TO SCALE

SHEET INDEX	
NO.	TITLE
C000	COVER SHEET
C001	GENERAL NOTES
--	EXISTING CONDITIONS PLAN
C501	PUBLIC WATER LINE PLAN
C503	PUBLIC WATER LINE PLAN AND PROFILE
C900	SITE DETAILS
C901	SITE DETAILS
C902	SITE DETAILS
C903	SITE DETAILS
C904	CITY OF LEE'S SUMMIT STANDARD DETAILS

## CONTACT LIST

**PLANNING AND ZONING  
DEVELOPMENT SERVICES**  
220 SE GREEN ST  
LEE'S SUMMIT, MO 64063  
CONTACT: MIKE WEISENBORN  
PHONE: (816) 969-1240

STORMWATER AND WATER  
LEE'S SUMMIT ENGINEERING  
220 SE GREEN ST  
LEE'S SUMMIT, MO 64063  
CONTACT: GENE WILLIAMS  
PHONE: (816) 969-1223

SEWER  
LEE'S SUMMIT PUBLIC WORKS  
220 SE GREEN ST  
LEE'S SUMMIT, MO 64063  
CONTACT: MIKE WEISENBORN  
PHONE: (816) 969-1900

NATURAL GAS  
SPIRE  
3025 SW CLOVER DR  
LEE'S SUMMIT, MO 64082  
CONTACT: BOBBIE SAULSBERG  
PHONE: (816) 519-6909

**BUILDING**  
DEVELOPMENT SERVICES  
220 SE GREEN ST  
LEE'S SUMMIT, MO 64063  
CONTACT: MIKE WEISENBORN  
PHONE: (816) 969-1240

**FIRE PREVENTION**  
**CITY FIRE MARSHAL**  
**207 SE DOUGLAS**  
**LEE'S SUMMIT, MO 64063**  
**CONTACT: MICHAEL SNIDER**  
**PHONE: (816) 969-1300**

**ELECTRIC  
EVERGY**  
10058 RAYTOWN ROAD  
KANSAS CITY, MO 6413  
CONTACT: PHIL INGRAM  
PHONE: (816) 347-4339




**Gresham  
Smith**

GreshamSmith.com

22 Second Avenue South  
Suite 1400  
Nashville, TN 37201

615.770.8100



**Firestone**  
COMPLETE AUTO CARE™

LEE'S SUMMIT, MISSOURI 64082

FOUNDED ON THE EXPRESS CONDITION THAT IT IS NOT TO BE USED IN ANY WAY  
DELETERIOUS TO THE INTERESTS OF BRIDGESTONE RETAIL OPERATIONS, LLC. THE  
ACCEPTANCE OF THIS DRAWING WILL BE CONSTRUED AS AN ACCEPTANCE OF THE  
FOREGOING CONDITION AND AS ADMISSION TO THE EXCLUSIVE OWNERSHIP IN AND TO  
THE DRAWING BY BRIDGESTONE RETAIL OPERATIONS, LLC.

[illegible]

COVER SHEET

# C000

40831.45  
JANUARY 8, 2020







Items Corresponding to Schedule B

- (8) -Terms, provisions and easement contained in the Grading Consent and Temporary Construction Easement Agreement, recorded April 6, 1998 as Document No. 98-I-23424 in Book I-3171 at Page 1069, by and between QuikTrip Corporation, an Oklahoma corporation and E.L. Robinson, Jr. and Letha M. Robinson, Trustees for Trust dated September 22, 1988, for the benefit of the lands in question.  
TEMPORARY EASEMENT IS NO LONGER IN AFFECT.
- (9) -Terms, provisions and easements contained in the Storm Sewer Easement Agreement, recorded April 8, 1998 as Document No. 98-I-23425 in Book I-3171 at Page 1076, by and between QuikTrip Corporation, an Oklahoma corporation and E.L. Robinson, Jr. and Letha M. Robinson, Trustees for Trust dated September 22, 1988, benefiting the lands in question.  
PLOTTED AND SHOWN.
- (10) -Rights of way, easements granted and appurtenances pertaining to the State of Missouri, acting by and through the Missouri highway and Transportation Commission, described by instrument recorded May 10, 1999 as Document No. 1999 I 0038039.  
PLOTTED AND SHOWN.
- (11) -An easement granted to the City of Lee's Summit, a municipal corporation, described by instrument recorded march 23, 2001 as Document No. 2001 I 0018921.  
PLOTTED AND SHOWN.
- (12) -Terms, provisions, easements and boundaries imposed, including but not limited to the limitations of direct access, of the Quitclaim Deed granted to the City of Lee's Summit, a municipal corporation, recorded October 31 2008 as Document No. 2008E0114649.  
PLOTTED AND SHOWN.
- (13) -Amended, 111119;  
Terms and provisions of the Declaration of Restrictions recorded June 26, 2014 as Document No. 2014E0051570, and the First Amendment to Declaration of Restrictions, but omitting any covenants or restrictions, if any, including but not limited to those based upon race, color, religion, sex, sexual orientation, familial status, marital status, disability, handicap, national origin, ancestry, source of income, gender, gender identity, gender expression, medical condition or genetic information, as set forth in applicable state or federal laws, except to the extent that said covenant or restriction is permitted by applicable law.  
AFFECTS SUBJECT PROPERTY, BLANKET IN NATURE, NOT PLOTTABLE
- (14) -The effect of the Scrivener's Affidavit recorded March 23, 2016 as Document No. 2016E0025038.  
DOES NOT AFFECT SUBJECT PROPERTY.
- (15) -An easement for sanitary sewers granted to Lee's Summit, described by instrument recorded April 25, 2016 as Document No. 2016E0035549.  
PLOTTED AND SHOWN.
- (16) -The surviving easements and conditions of the instrument captioned Temporary Construction Easement granted to the QuikTrip Corporation, an Oklahoma corporation, described by instrument recorded May 11, 2017 as Document No. 2017E0042035.  
DOES NOT AFFECT SUBJECT PROPERTY.
- (20) -Added, 111119;  
An easement granted to The City of Lee's Summit, Missouri, described by instrument recorded May 23, 1975 as Document No. I-211265 in Book I-596 at Page 173.  
DOES NOT AFFECT SUBJECT PROPERTY.
- (21) -Added, 111119;  
An easement granted to the City of Lee's Summit, Missouri, described by instrument recorded April 25, 2016 as Document No. 2016E0035549.  
SAME AS ITEM NO. 15, PLOTTED AND SHOWN AS NO. 15.
- (22) -Added, 111119;  
Terms and provisions of the Declaration of Use Restrictions, recorded December 9, 2016 as Document No. 2016E0116521, but omitting any covenants or restrictions, if any, including but not limited to those based upon race, color, religion, sex, sexual orientation, familial status, marital status, disability, handicap, national origin, ancestry, source of income, gender, gender identity, gender expression, medical condition or genetic information, as set forth in applicable state or federal laws, except to the extent that said covenant or restriction is permitted by applicable law.  
AFFECTS SUBJECT PROPERTY, BLANKET IN NATURE, NOT PLOTTABLE


Possible Encroachments

NONE

Flood Note

This property is in no Special Flood Hazard Zone according to Flood Insurance Rate Map, Community Number 200590 0002 A, effective date October 25, 1977.

Vicinity Map

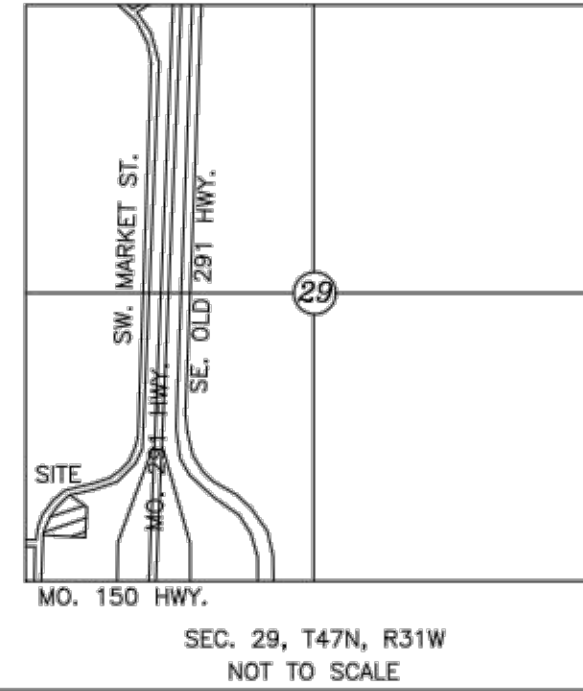

SCALE : 1" = 40'

Commitment Legal Description

FIDELTY NATIONAL TITLE COMMITMENT NO. 191439 REVISION 111119, DATED NOVEMBER 1, 2019 AT 12:00 P.M. A portion of land lying and situated in the Southwest Quarter of Section 29, Township 47 North, Range 31 West of Fifth Principal Meridian, in Lee's Summit, Jackson County, Missouri, being part of a parcel of land described in Book I-1847 at Page 2008, said parcel lying Southeastery of Market Street, Westerly of the West Right-of-Way line of Missouri Highway 291, North of QUIKTRIP 200R, a subdivision of land and Northerly of QUIKTRIP 200R LOT 1A, a subdivision of land.

AS-SURVEYED DESCRIPTION:  
Written by William A. Booe, RLS 2002010970, October 23, 2019  
A tract of land located in a portion of the Southwest Quarter of Section 29, Township 47 North, Range 31 West of the 5th Principal Meridian, Lee's Summit, Jackson County, Missouri, and being more particularly described as follows:  
BEGINNING at the Northwest corner of Lot 1A, Minor Plat of Quiktrip 200R Lot 1A;  
Thence along a curve to the right and the Southeasterly right of way of Market Street, having a radius of 459.32 feet, a length of 320.00 feet and a chord bearing and distance of N 33°05'03" E, 313.57 feet;  
Thence S 54°19'08" E a distance of 136.50 feet;  
Thence S 02°26'15" W a distance of 195.00 feet to the North line of said Lot 1A;  
Thence N 87°33'03" W along said North line a distance of 274.00 feet to the point of beginning, containing 1.237 acres.

Miscellaneous Notes

- (A) The bearings shown hereon are based upon the Missouri State Plane Coordinate System, station no JA-137, N. 974542.6936 E. 2824145.0197, ELEV. 993.438 (NAVD 88), located about 7 miles South of the intersection of Hwy. 150 and Hwy. 291.
- (B) This survey does not reflect any easements, rights-of-way or other instruments of record except those shown on the current mentioned Title Commitment.
- (C) Underground utilities are shown per One call ticket 193242567, dated 11-20-2019.
- (D) At the date this survey was done in the field, earth moving, asphalt paving, concrete work and construction was not complete.
- (E) There is no evidence of subject site being used as a solid waste dump or sanitary land fill.
- (F) There is no evidence of subject site being used as a burial ground or cemetery.
- (G) This survey meets the accuracy requirements for "Urban" property as defined by the Missouri Minimum Standards. Closure 1 in 615041.

ALTA/NSPS Land Title Survey

To:

GBT Realty  
Franklin Land Associates, LLC

This is to certify that this map or plot and the survey on which it is based were made in accordance with the 2016 Minimum Standard Detail Requirements for ALTA/NSPS Land Title Surveys, jointly established and adopted by ALTA and NSPS, and includes Items 1, 2, 3, 4, 5, 6(b), 7(a), 7(b)(1), 8, 9, 11(b), 13, 14, 16, 17 and 18 of Table A thereof. The field work was completed in October 22, 2019.

William A. Booe, RLS 2002010970

Legend of Symbols & Abbreviations


○	Existing Iron Rod	(M)	Measured Dimension
●	Origin Unknown (unless noted)	(D)	Deed Dimension
△	Set 1/2"x24" Iron Rod/Cap (unless otherwise noted)	(P)	Plat Dimension
△	Section Corner	R/W	Right of Way
---	Origin Unknown (unless noted)	○	Storm Drain Manhole
---	Boundary Line	◇	Water Meter
---	Setback Line	+	Guy Wire
---	Fence	⊙	Gas Meter
---	Overhead Electric Line	⊙	Gas Valve
---	Water Line	⊙	Telephone Riser Box
---	Gas Line	+	Gas Line Marker
---	Underground Telephone	⊙	Sanitary Sewer Cleanout
---	Sanitary Sewer Line	⊙	Sanitary Sewer Manhole
---	Bollard	+	Sign
---	Curb Inlet or Area Inlet	+	Light Pole
---	Fire Hydrant	+	Power Pole
---	Handicap Parking	+	Water Valve
---	Electric Cabinet	⊙	Electric Meter






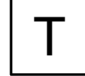

ALTA/NSPS LAND TITLE SURVEY  
of a portion of SECTION 29, TOWNSHIP 47 NORTH,  
RANGE 31 WEST of the 5th PRINCIPAL MERIDIAN,  
JACKSON COUNTY, MISSOURI

DRAWN BY: DLB  
JOB NO. 1-1910401-M  
CHECKED BY: WAB  
LATEST REVISION: 12-10-2019  
PREPARED FOR: GBT Realty

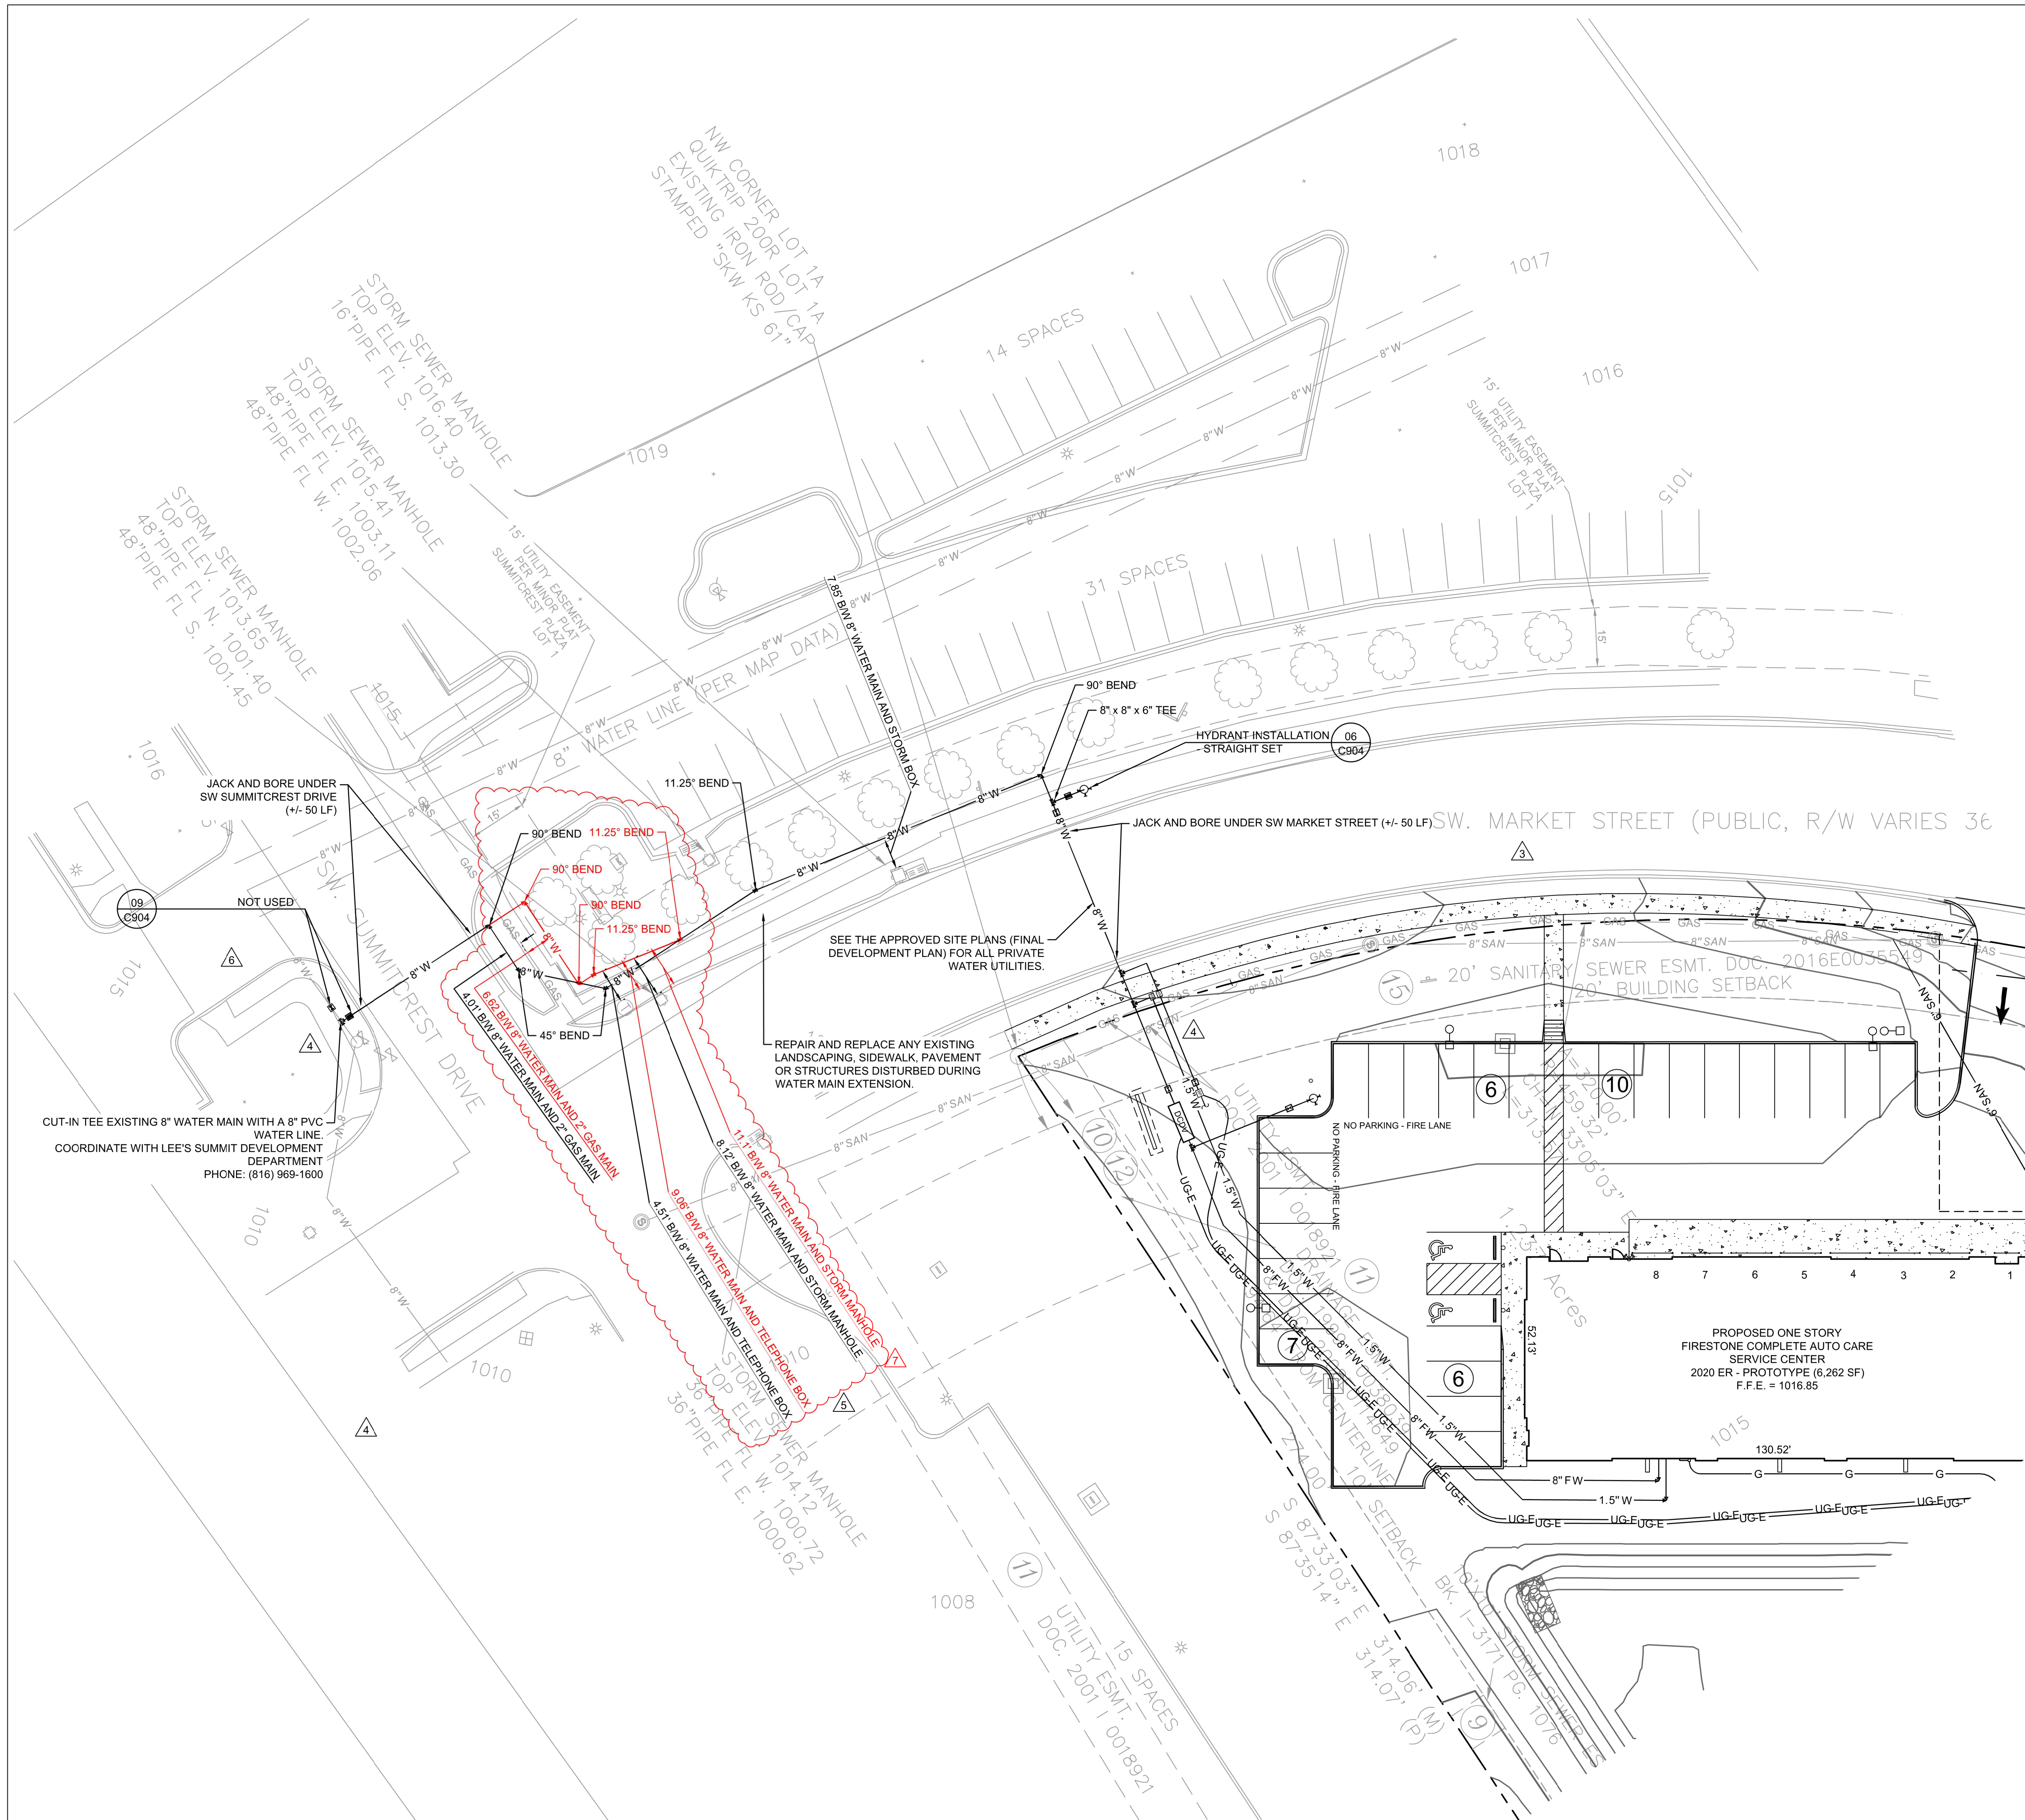**CORNERSTONE**  
Regional Surveying, LLC  
Serving Kansas, Missouri & Oklahoma  
1921 North Penn, Independence, KS 67301 Ph: 620-331-6767





LEGEND	
-----	PROPERTY LINE
=====	BUILDING LINE
-----W-----W-----	WATER LINE
-----SAN-----	SANITARY SEWER
=====	STORM SEWER
-----UG-E-----	UNDERGROUND ELECTRIC
-----G-----G-----	NATURAL GAS
-----	UTILITY EASEMENT
	WATER METER
	BACKFLOW PREVENTER
	WATER VALVE & BOX
	SANITARY MANHOLE
	SANITARY CLEANOUT
	TRANSFORMER
	LIGHT POLE

NOTES:

1. ITEMS IN RED AND CLOUDED IN RED INDICATE AS BUILT CONDITIONS.

[illegible]





THIS DRAWING IS THE PROPERTY OF BRIDGESTONE RETAIL OPERATIONS, LLC AND IS LOANED ON THE EXPRESS CONDITION THAT IT IS NOT TO BE USED IN ANY WAY DELETERIOUS TO THE INTERESTS OF BRIDGESTONE RETAIL OPERATIONS, LLC. THE ACCEPTANCE OF THIS DRAWING WILL BE CONSTRUED AS AN ACCEPTANCE OF THE FOREGOING CONDITION AND AS ADMISSION TO THE EXCLUSIVE OWNERSHIP IN AND TO THE CONTINUING DEVELOPMENT OF BRIDGESTONE RETAIL OPERATIONS, LLC.



[illegible]

# C503

40831.45  
JANUARY 8, 2020

This Line Is 3 Inches When Printed Full Size


1. ITEMS IN RED AND CLOUDED IN RED INDICATE AS BUILT CONDITIONS

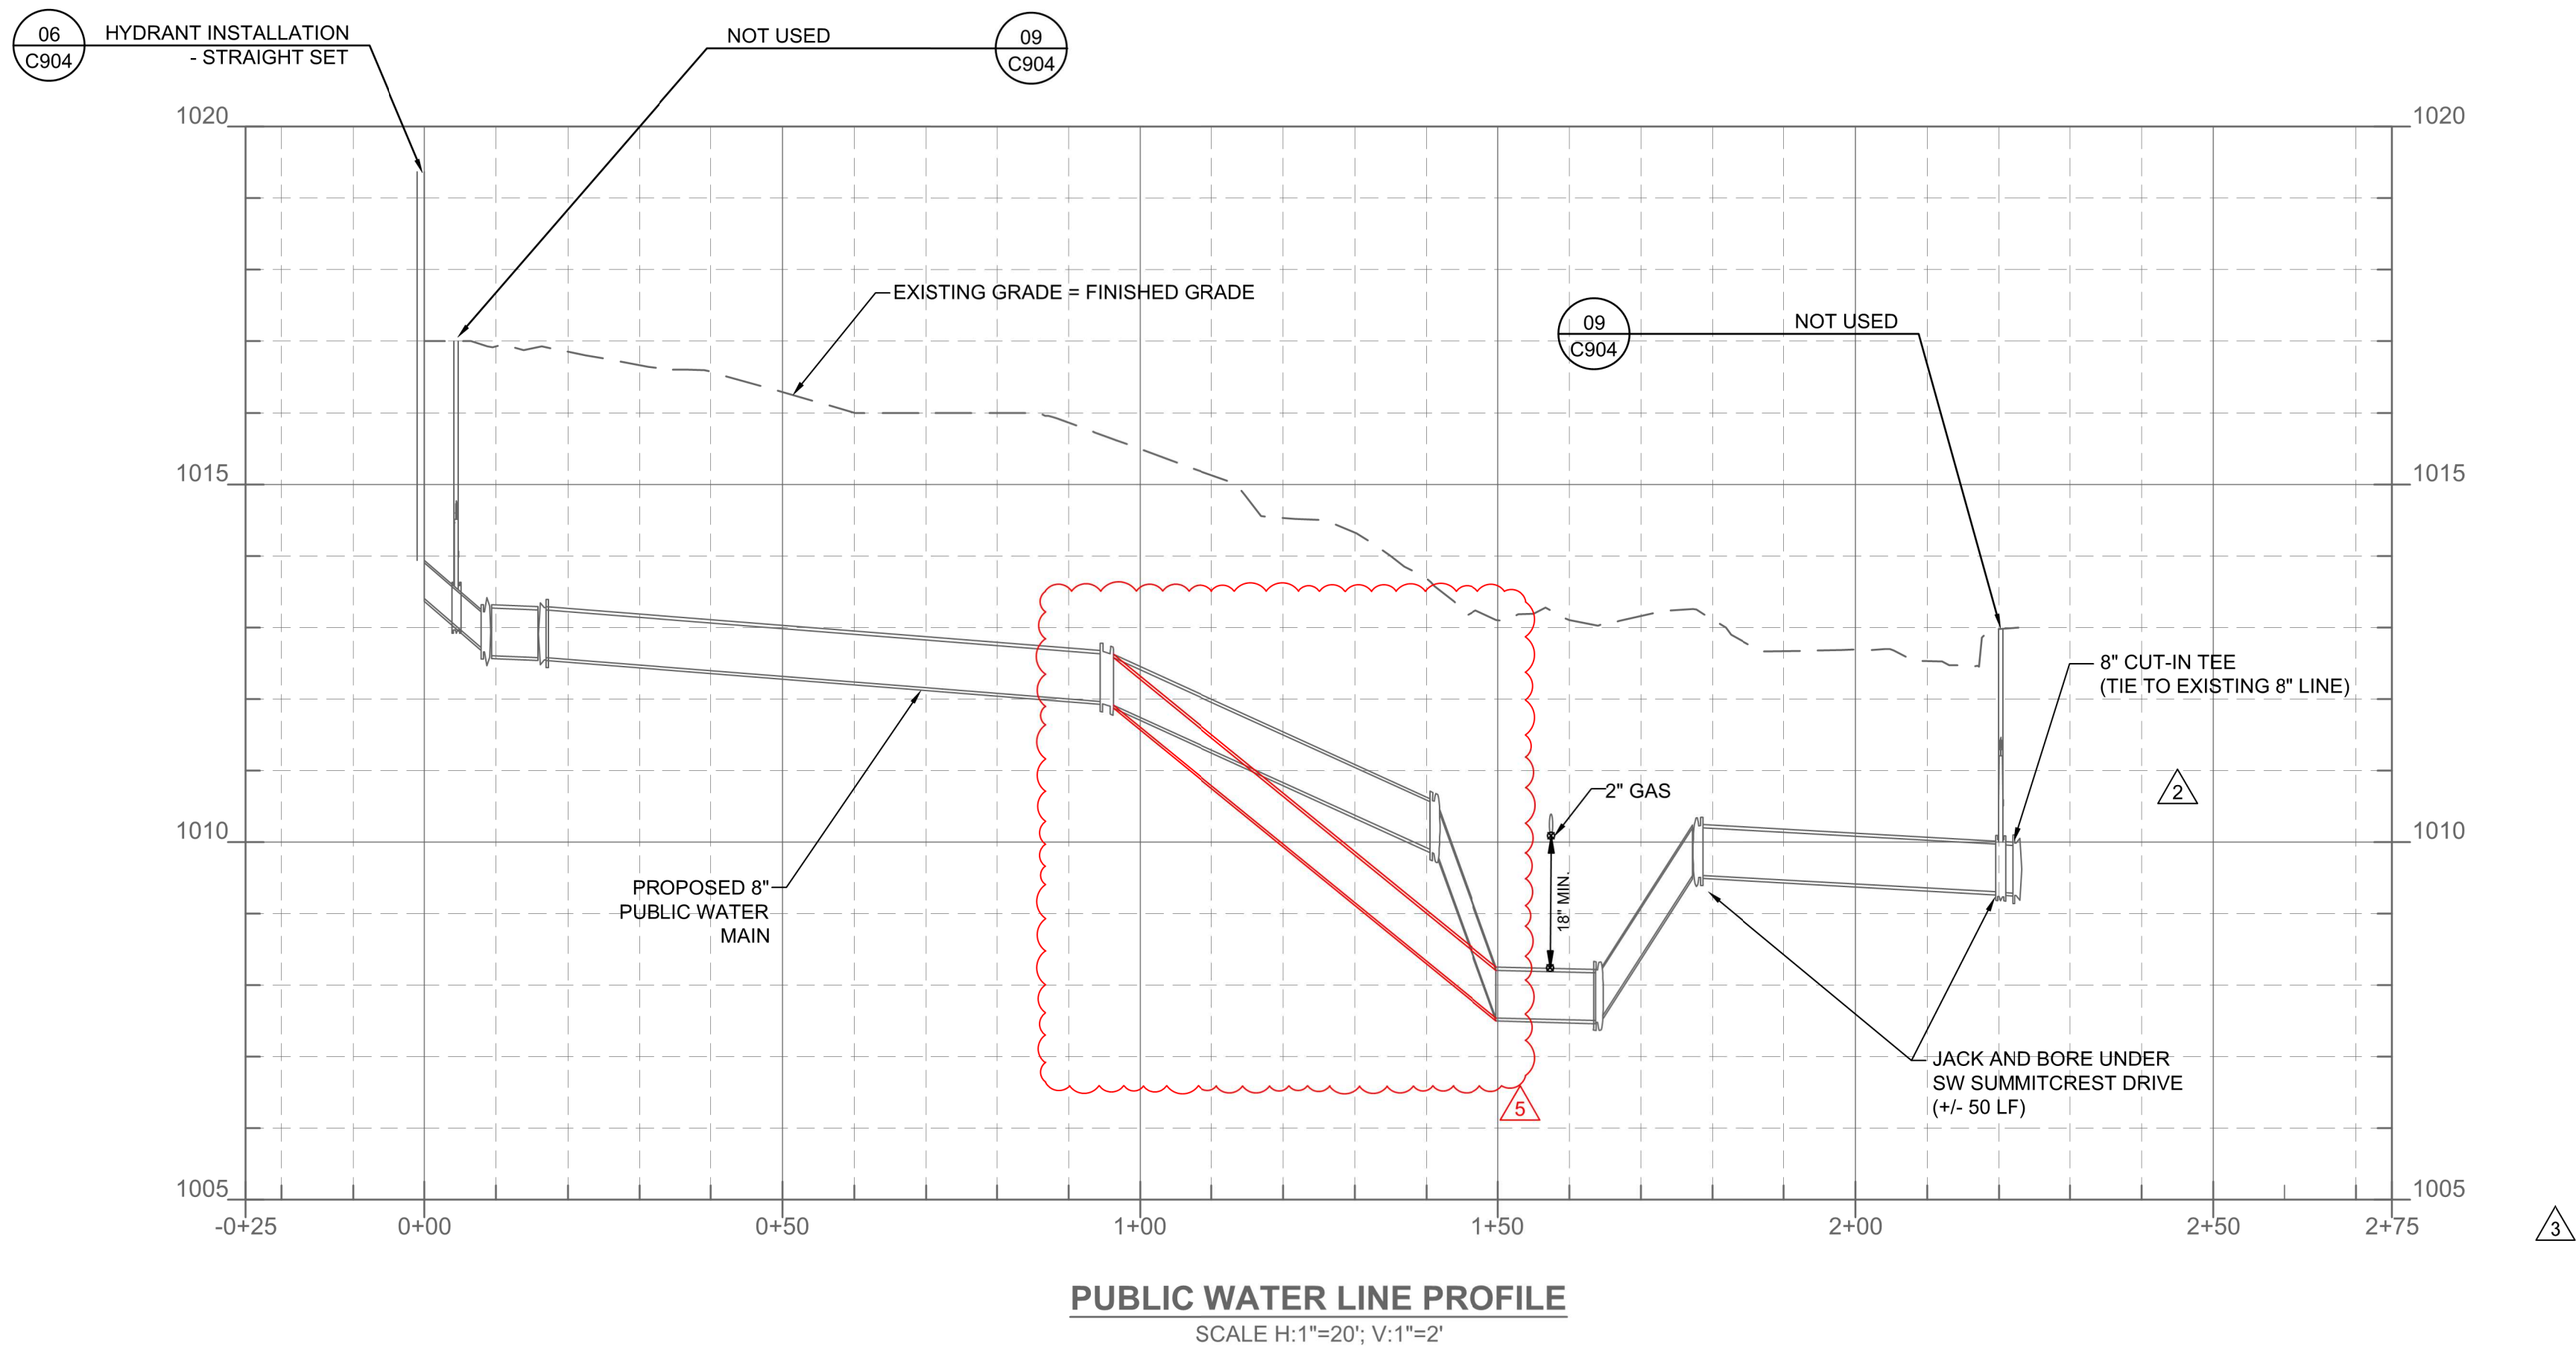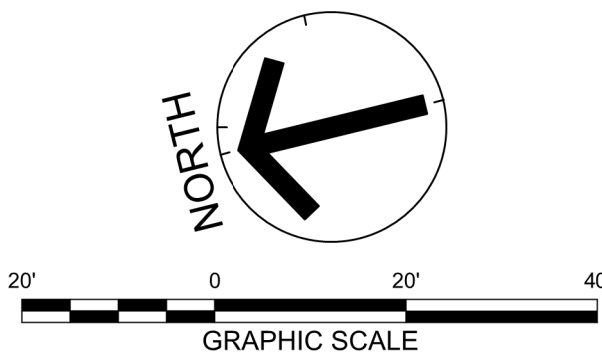









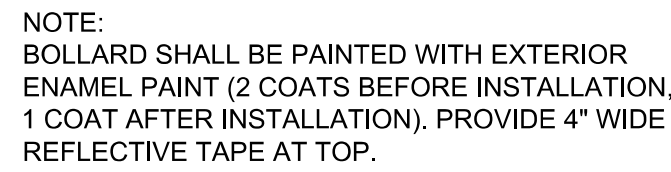

**BOLLARD**  
NOT TO SCALE

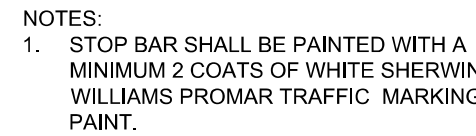

PAINTED DIRECTIONAL ARROWS  
NOT TO SCALE

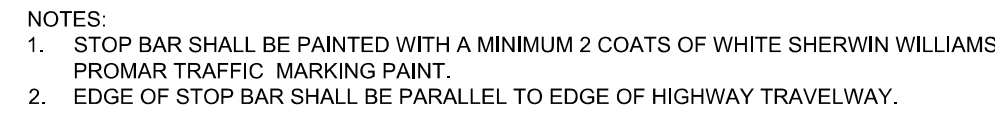

PAINTED STOP BAR  
NOT TO SCALE




NOT USED  
NOT TO SCALE



NOT USED  
NOT TO SCALE







NOT USED  
NOT TO SCALE

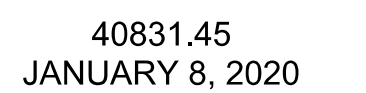







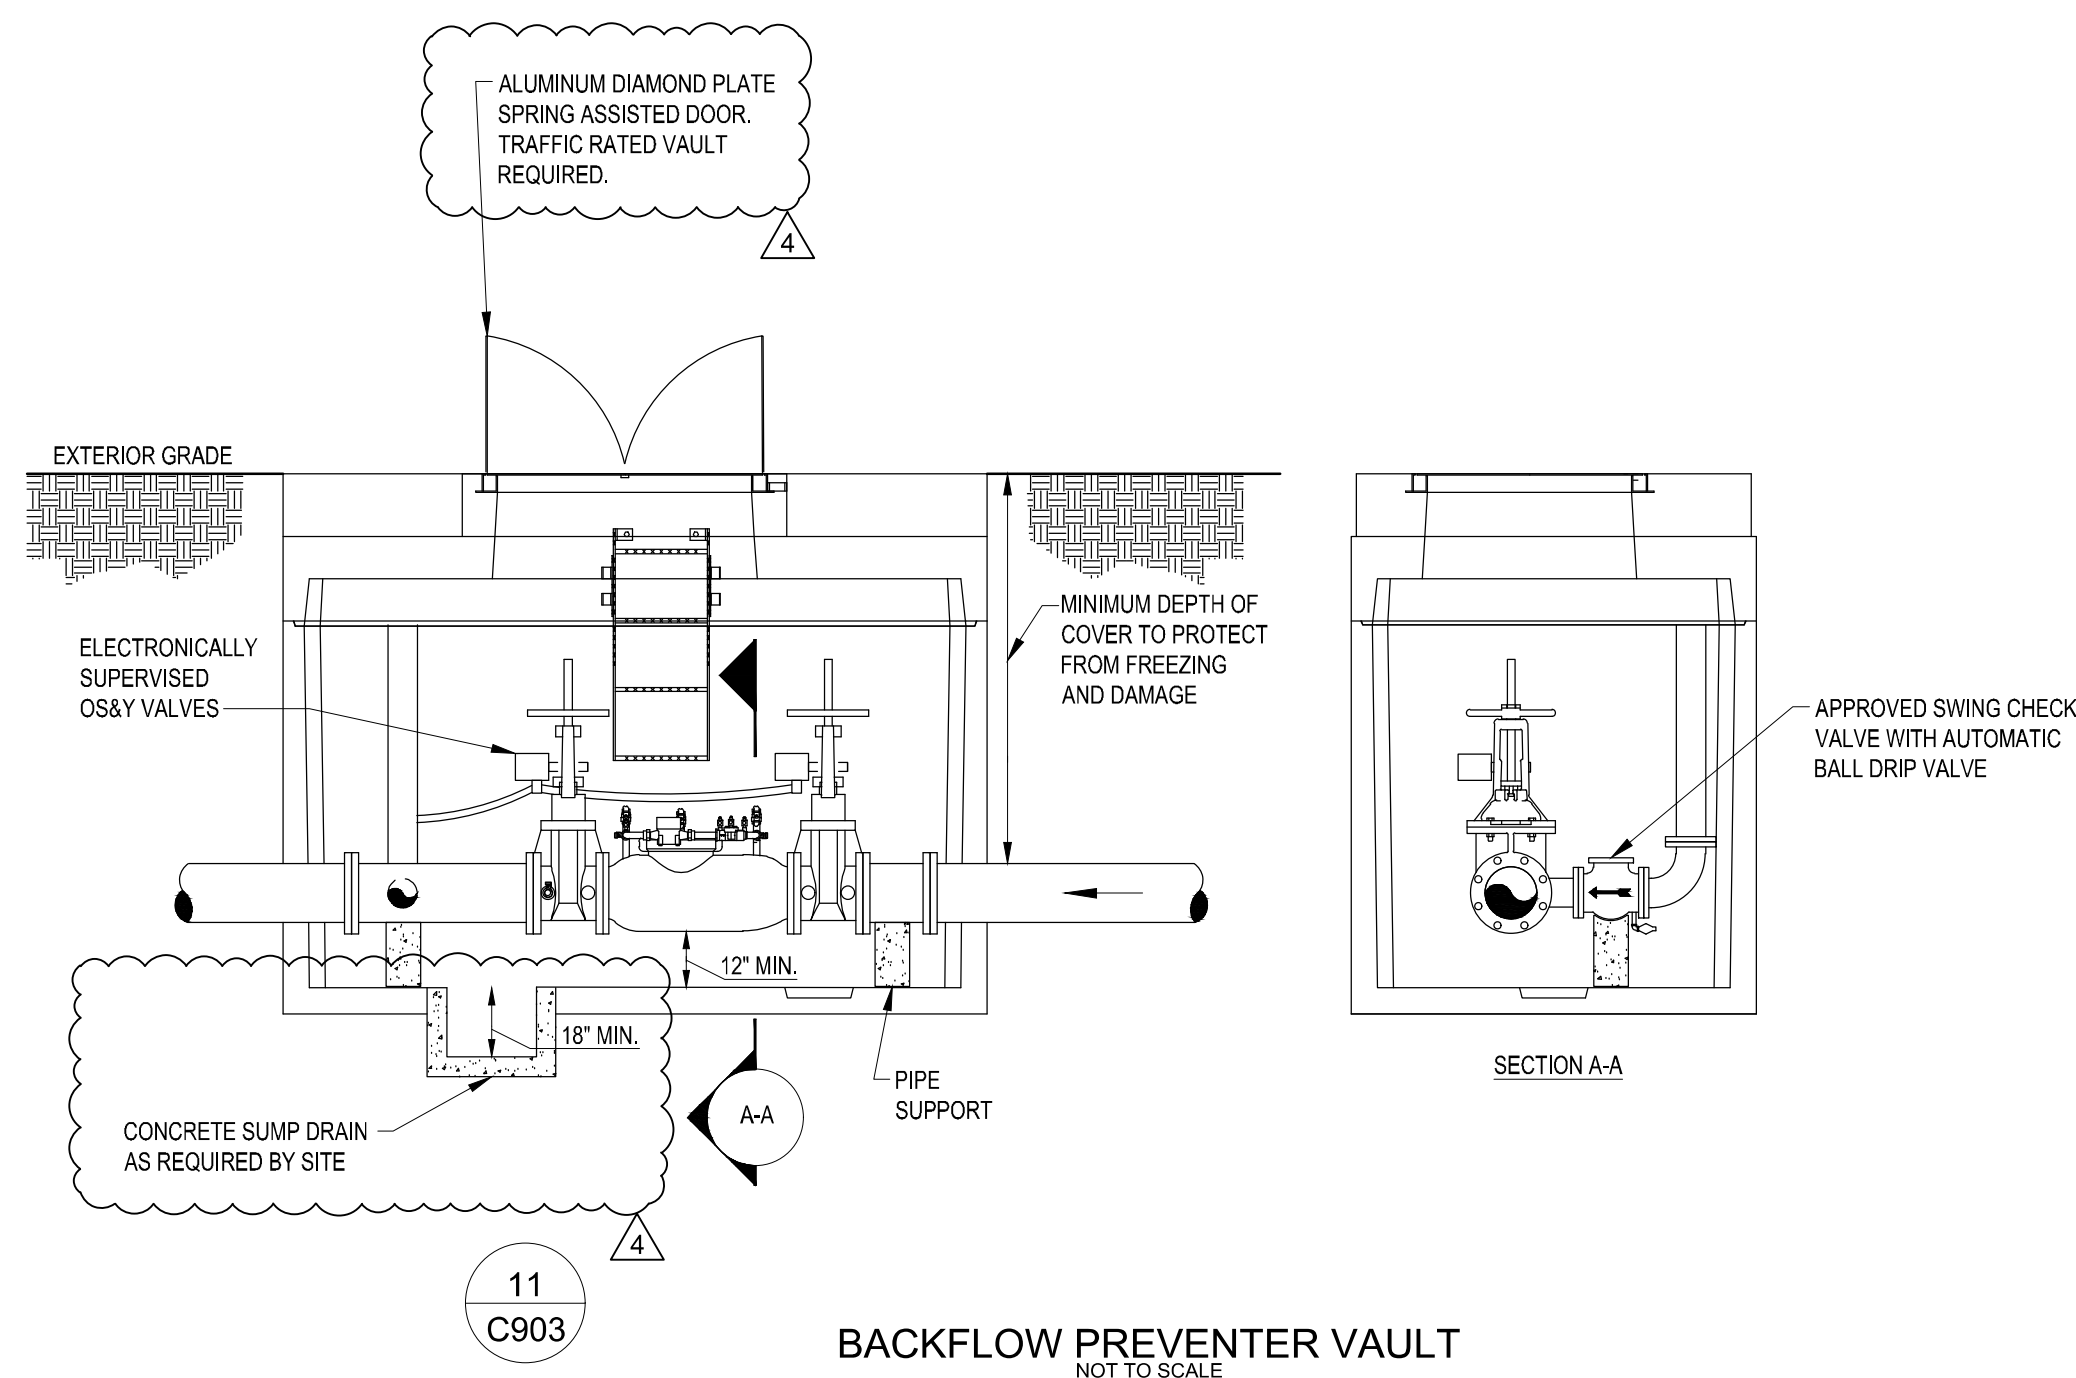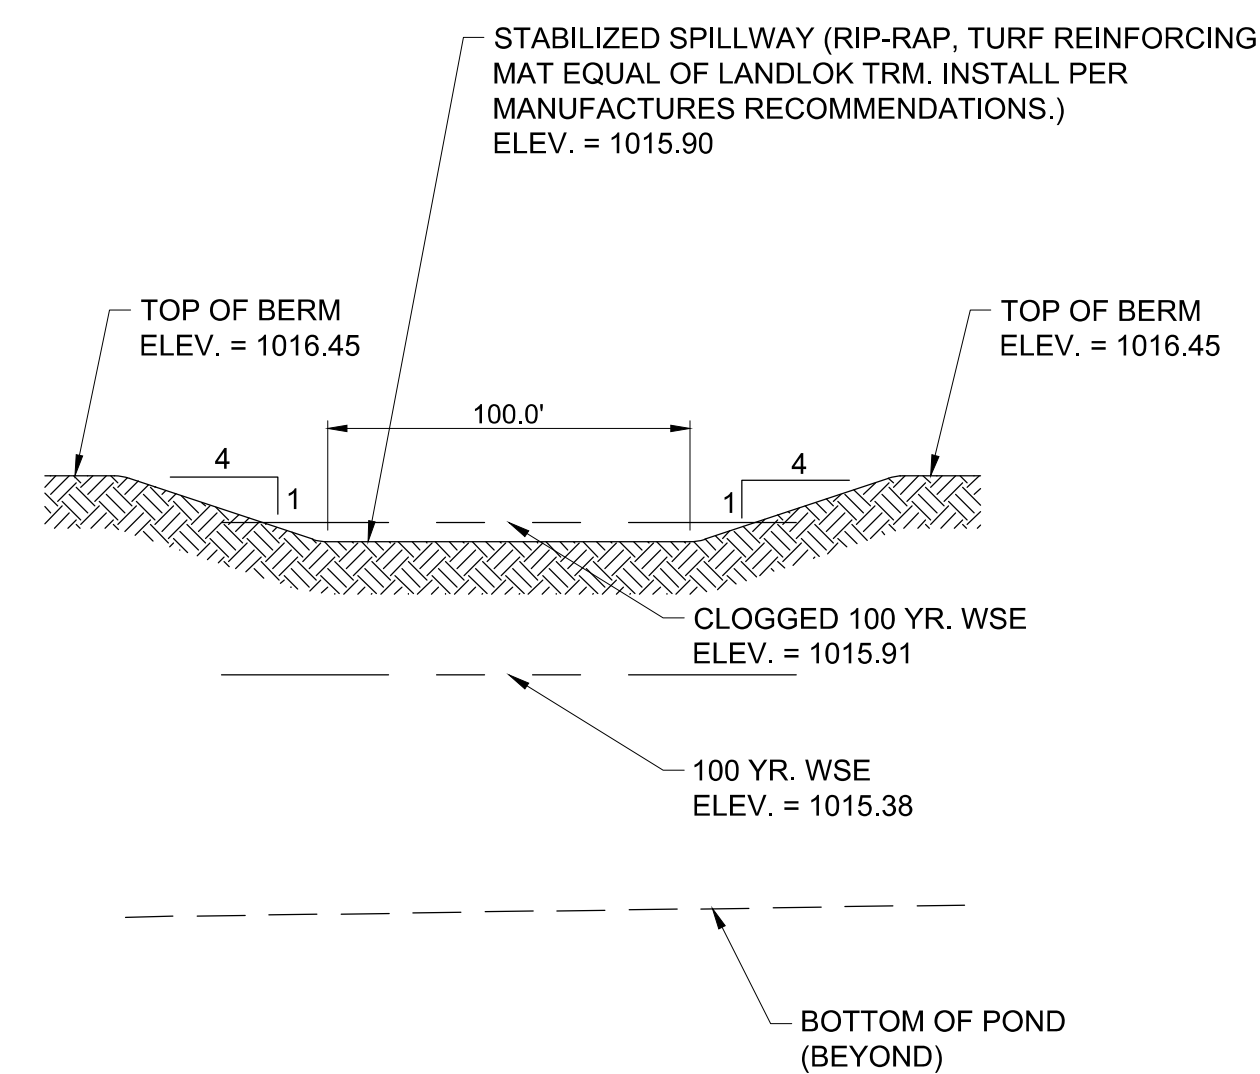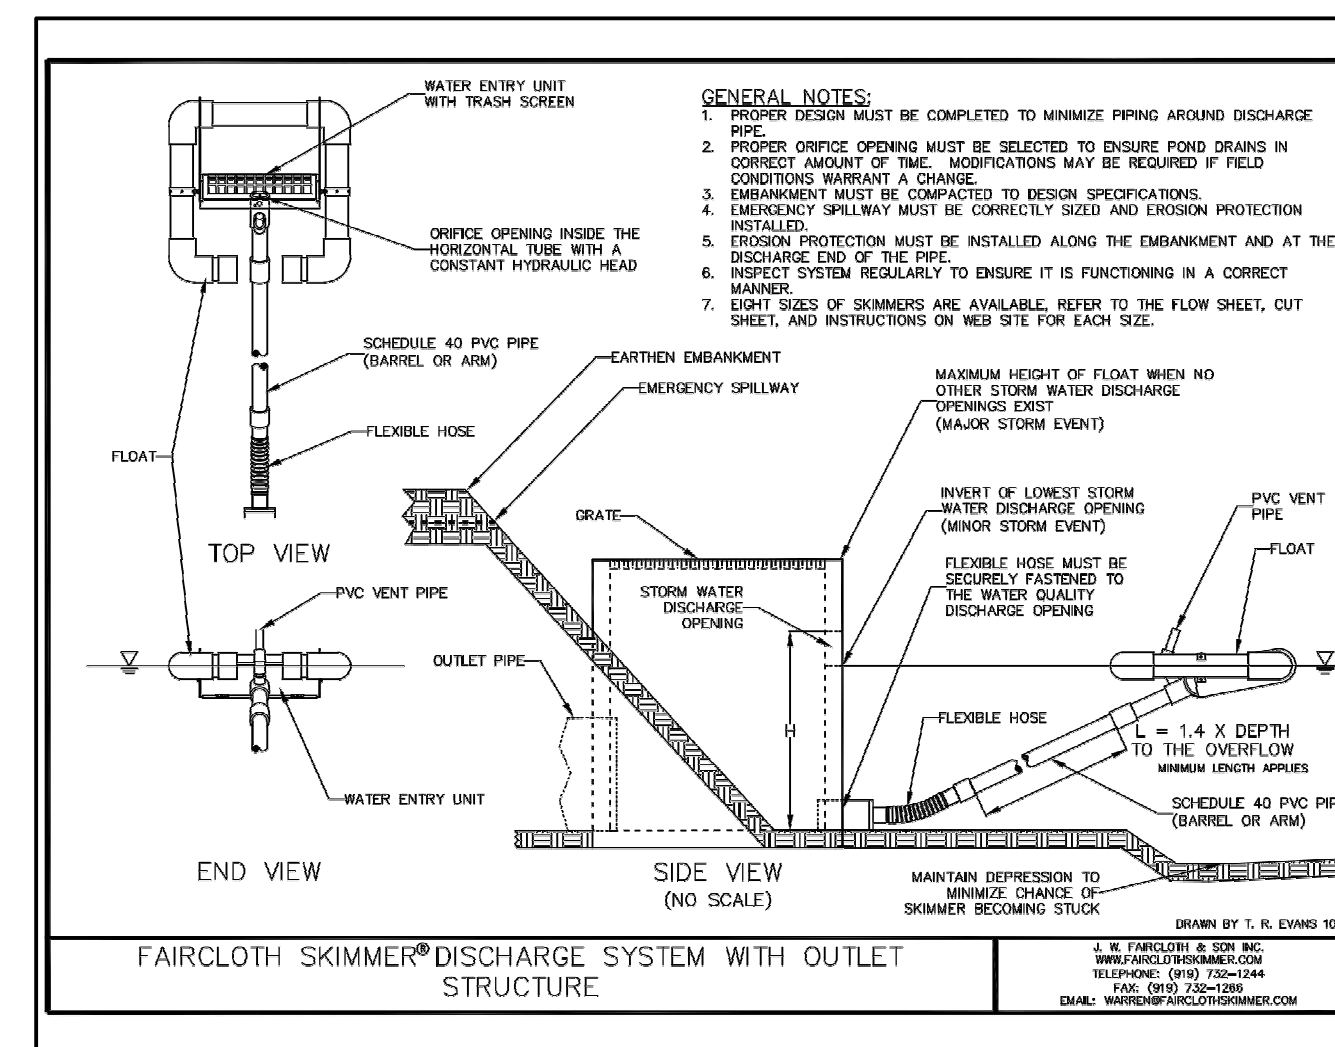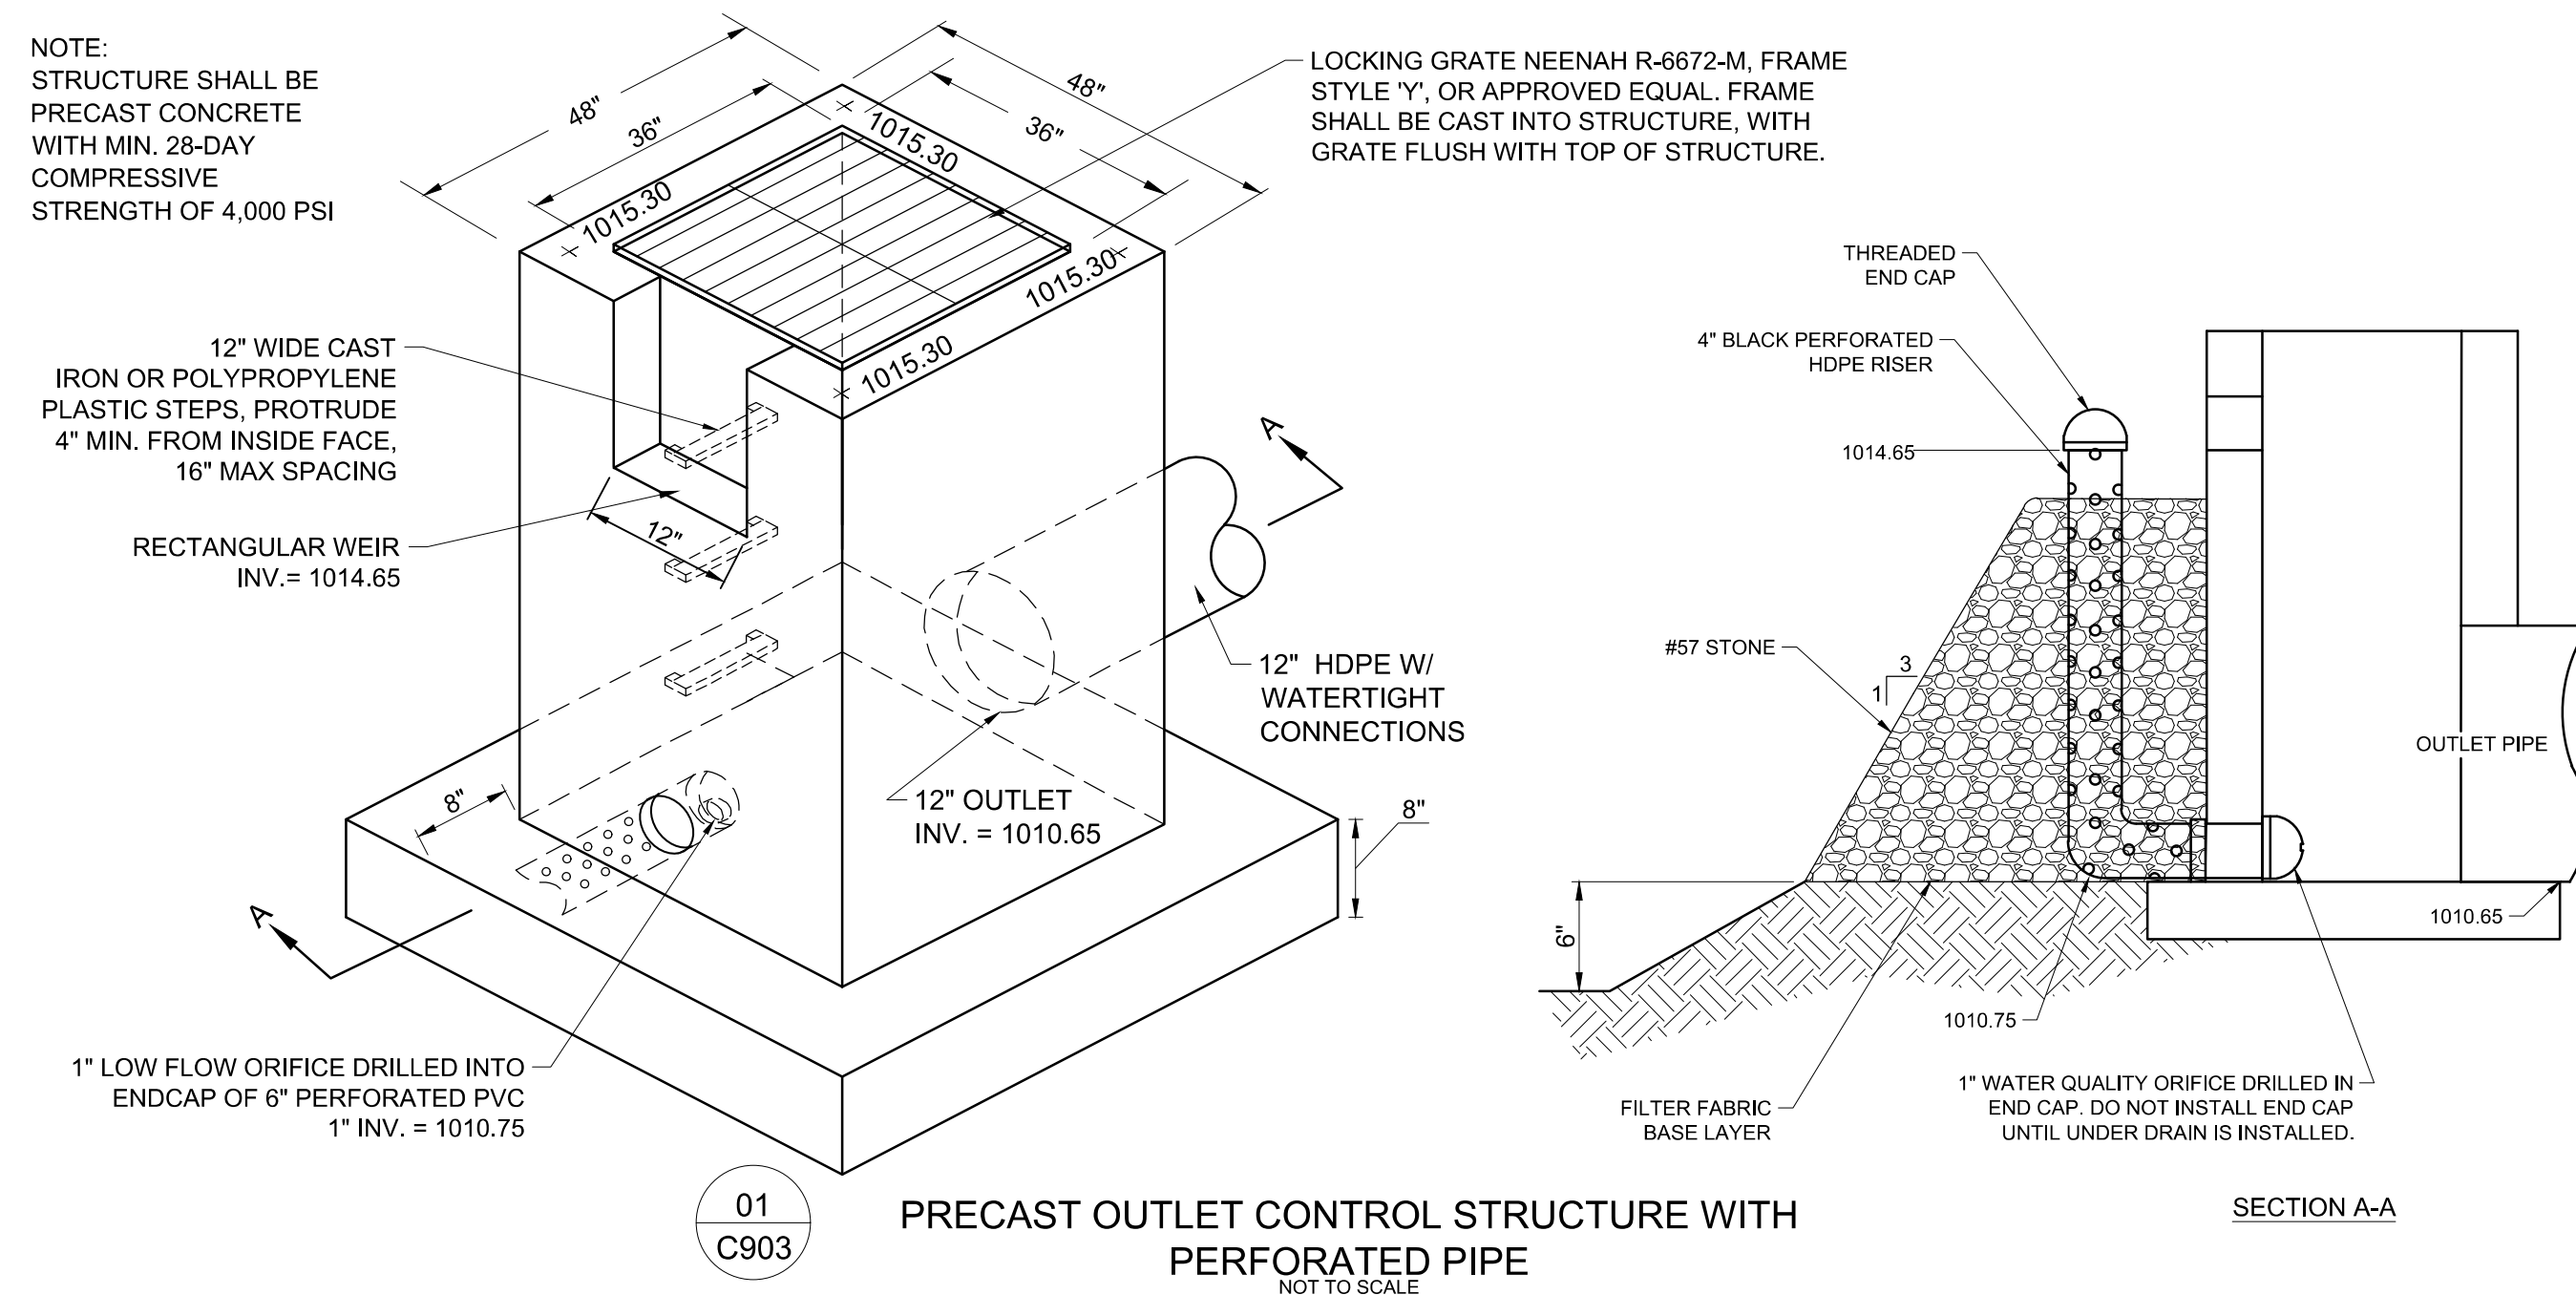


GreshamSmith.com

222 Second Avenue South  
Suite 1400  
Nashville, TN 37201  
615.770.8100



**Firestone**  
COMPLETE AUTO CARE™

3561 SW MARKET STREET  
LEE'S SUMMIT, MISSOURI 64082

THIS DRAWING IS THE PROPERTY OF BRIDGESTONE RETAIL OPERATIONS, LLC AND IS LOANED ON THE EXPRESS CONDITION THAT IT IS NOT TO BE USED IN ANY WAY OTHER THAN THAT AUTHORIZED BY BRIDGESTONE RETAIL OPERATIONS, LLC. ANY ACCEPTANCE OF THIS DRAWING WILL BE CONSTRUED AS AN ACCEPTANCE OF THE FOREGOING CONDITION AND AS ADMISSION TO THE EXCLUSIVE OWNERSHIP IN AND TO THE DRAWING BY BRIDGESTONE RETAIL OPERATIONS, LLC.

[illegible]

## SITE DETAILS

# C903

40831.45  
JANUARY 8, 2020

This Line Is 3 Inches When Printed Full Size





615.770.8100

3561 SW MARKET STREET  
LEE'S SUMMIT, MISSOURI 64082


THIS DRAWING IS THE PROPERTY OF BRIDGESTONE RETAIL OPERATIONS, LLC AND IS LOANED ON THE EXPRESS CONDITION THAT IT IS NOT TO BE USED IN ANY WAY UNFAVORABLE TO THE INTERESTS OF BRIDGESTONE RETAIL OPERATIONS, LLC. THE ACCEPTANCE OF THIS DRAWING WILL BE CONSTRUED AS AN ACCEPTANCE OF THE EXCLUSIVE OWNERSHIP AND AS ADMISSION TO THE EXCLUSIVE OWNERSHIP IN AND TO THE PROJECT AND AS ADMISSION TO THE EXCLUSIVE OWNERSHIP IN AND TO THE PROJECT.



## CITY OF LEE'S SUMMIT STANDARD DETAILS


40831.45  
JANUARY 8, 2020

This Line Is 3 Inches When Printed Full Size

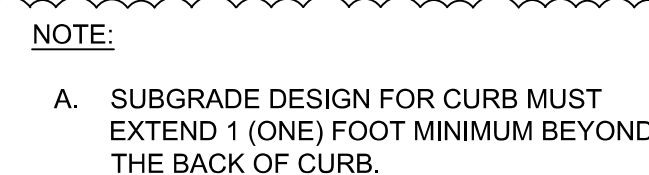

GEN-4


**CURB AND GUTTER DETAIL**  
NOT TO SCALE

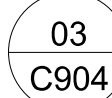

HORIZONTAL THRUST BLOCK  
NOT TO SCALE




VERTICAL THRUST BLOCK  
NOT TO SCALE

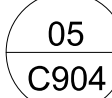

TRENCH CHECK  
NOT TO SCALE




HYDRANT INSTALLATION - STRAIGHT SET  
NOT TO SCALE

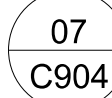

SERVICE CONNECTION - METER WELL  
NOT TO SCALE



CTIY SEWER STUB AND RISER  
NOT TO SCALE

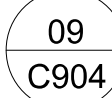

CITY VALVE STEM EXTENSION AND VALVE BOX  
NOT TO SCALE

NOT USED

\\global.gsp\data\Infna\_nf05\4083145\01Work\01CAD\06LP\4083145-C900.dwg - Michael, JP - 5/1/2020 10:15:28 AM