



NW 1/4 SECTION 25, TOWNSHIP 47 N, RANGE 32 W  
IN LEE'S SUMMIT, JACKSON COUNTY, MO

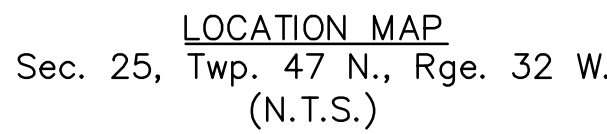

☐ NOT FOR CONSTRUCTION

☒ REVIEWED FOR CONSTRUCTION

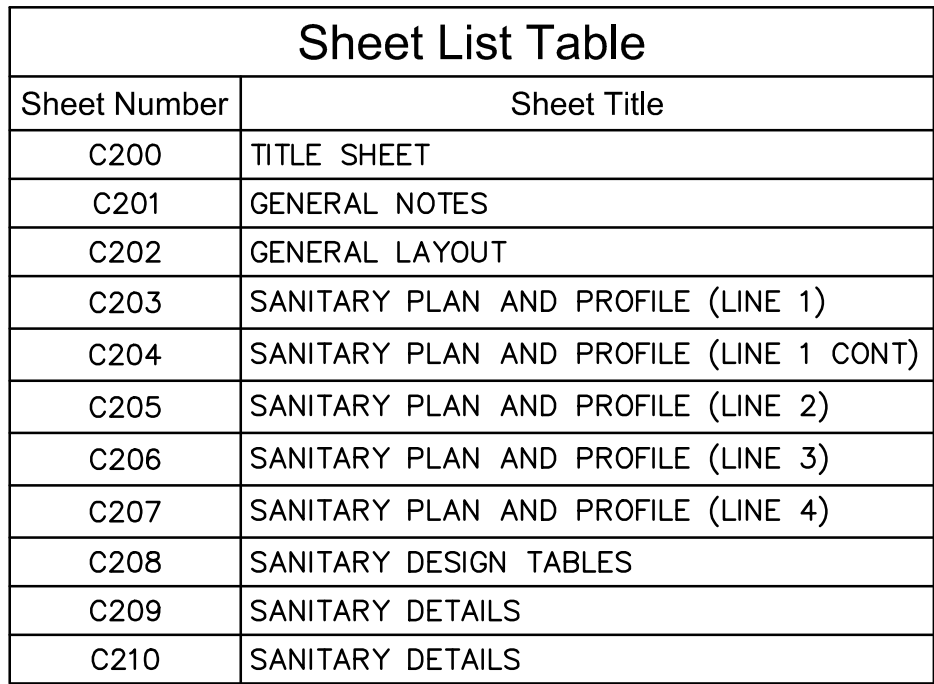

ASBUILT  
1/4/2022

OLSSON HAS BEEN RETAINED TO PROVIDE AS-BUILT DRAWINGS FOR THIS PROJECT.

*Brock M. Worthley*  
BROCK M. WORTHLEY, P.E.  
CIVIL ENGINEER  
MO# PE-2019000237

1/4/2021  
DATE

**Accepted  
Record Drawings**

**These plans have been reviewed for accuracy and are accepted for basic conformance to the approved construction drawings.**

**olson**

[illegible]

# TITLE SHEET SANITARY SEWER PLANS

HAWTHORN RIDGE  
THIRD PLAT

LEE'S SUMMIT, MO

drawn by: \_\_\_\_\_ OLS  
checked by: \_\_\_\_\_ BMW  
approved by: \_\_\_\_\_ BMW  
QA/QC by: \_\_\_\_\_ JES  
project no.: \_\_\_\_\_ A19-1605  
drawing no.: \_\_\_\_\_ C TTL01 A191605  
date: \_\_\_\_\_ 10/02/2020

SHEET  
C200



DWG: F:\2019\1501-2000\019-1605-A\40-Design\AutoCAD\Final Plans - As-Built\Sheets\GNCV\SANITARY\C\_TTL01\_A191605.dwg  
DATE: Jan 04, 2022 10:53am XREFS: C:\PTBLK\_A191605 USER: bworthley

GENERAL NOTES

1. THE CONTRACTOR SHALL BE RESPONSIBLE FOR ENSURING THAT THE PLANS IN THEIR POSSESSION ARE THE MOST CURRENT VERSION ISSUED, ARE FULLY COORDINATED WITH ALL SUBCONTRACTORS, AND PRESENT ON SITE AT ALL TIMES. CURRENT PLANS PREPARED BY OLSSON MAY BE OBTAINED AT THE DIRECTION OF OLSSON'S CLIENT. DIRECT REQUESTS TO OLSSON MAY REQUIRE ADDITIONAL AUTHORIZATIONS, AGREEMENTS, AND/OR FEES. PLEASE CONTACT THE ENGINEER FOR INFORMATION.
2. THE CONTRACTOR SHALL BE RESPONSIBLE FOR ANY DEVIATIONS FROM THESE PLANS UNLESS WRITTEN APPROVAL FROM ENGINEER, OWNER, AND DEVELOPER.
3. ALL WORK AND MATERIALS SHALL BE SUBJECT TO INSPECTION AND APPROVAL BY THE OWNER OR THE OWNER'S REPRESENTATIVE.
4. ALL ESTIMATES OF QUANTITIES ARE FOR INFORMATIONAL PURPOSES ONLY. THE CONTRACTOR SHALL BE RESPONSIBLE FOR DETERMINING QUANTITIES AND ITEMS OF WORK.
5. THE CONTRACTOR SHALL BE RESPONSIBLE FOR PROVIDING ALL LABOR, MATERIALS, AND EQUIPMENT REQUIRED TO COMPLETE THE WORK SHOWN IN THE PLANS.
6. THE CONTRACTOR SHALL BE RESPONSIBLE FOR OBTAINING ALL REQUIRED PERMITS, PAYING ALL FEES, AND FOR OTHERWISE COMPLYING WITH ALL APPLICABLE REGULATIONS GOVERNING THE WORK.
7. THE CONTRACTOR SHALL NOT ENGAGE IN ACTIVITIES THAT MAY ENCR OACH ON WATERS OF THE U.S., INCLUDING WETLANDS, UNTIL ANY NECESSARY PERMITS MAY BE OBTAINED. THE CONTRACTOR SHALL REVIEW AND COMPLY WITH ALL CONDITIONS DESCRIBED IN THE PERMIT.
8. THE CONTRACTOR SHALL BE SOLELY RESPONSIBLE FOR CONDITIONS OF THE JOB SITE. THE SAFETY OF ALL PERSONS INCLUDING VISITORS AND THE GENERAL PUBLIC, AND PROPERTY DURING PERFORMANCE OF THE WORK. THIS REQUIREMENT WILL APPLY CONTINUOUSLY THROUGHOUT THE PROJECT AND NOT BE LIMITED BY WORKING HOURS. ANY CONSTRUCTION OBSERVATION BY THE ENGINEER OF THE CONTRACTOR'S PERFORMANCE IS NOT INTENDED TO INCLUDE REVIEW OF THE ADEQUACY OF THE CONTRACTOR'S SAFETY MEASURES.
9. PRIOR TO COMMENCEMENT OF WORK THE CONTRACTOR SHALL NOTIFY AND COORDINATE WITH ALL UTILITY COMPANIES AND OBTAIN ANY RELEVANT INFORMATION. NOTIFY ENGINEER OF ANY DISCREPANCIES.
10. THE CONTRACTOR IS RESPONSIBLE FOR THE PROTECTION OF ALL BOUNDARY CORNERS AND SECTION CORNERS. ANY BOUNDARY CORNER AND/OR SECTION CORNER DISTURBED OR DAMAGED BY CONSTRUCTION ACTIVITIES SHALL BE RESET BY A LAND SURVEYOR LICENSED IN THE STATE OF MISSOURI, AT THE CONTRACTOR'S EXPENSE.
11. THE CONTRACTOR IS RESPONSIBLE FOR THE PROTECTION OF ADJACENT PROPERTIES AND SHALL TAKE ALL PRECAUTIONS NECESSARY TO PREVENT DAMAGE DURING CONSTRUCTION. THE CONTRACTOR IS ALSO RESPONSIBLE FOR REPAIRING ANY DAMAGE RESULTING FROM CONSTRUCTION ACTIVITIES.
12. PRIOR TO MOVING OFF THE JOB THE CONTRACTOR SHALL NOTIFY THE OWNER AND ENGINEER TO PERFORM A FINAL WALK-THROUGH OF THE CONSTRUCTION SITE.

REFERENCES

1. UNLESS EXPLICITLY DESCRIBED OTHERWISE WITHIN THESE PLANS THE FOLLOWING SHALL APPLY:
  - A. ALL CONSTRUCTION, INCLUDING THOSE LISTED BELOW, SHALL CONFORM TO THE LATEST CODES AND ORDINANCES OF LEE'S SUMMIT, MISSOURI.
  - B. ALL CONSTRUCTION IN MODOT RIGHT-OF-WAY SHALL CONFORM TO THE LATEST SPECIFICATIONS ADOPTED BY U.S. DEPARTMENT OF TRANSPORTATION AND MODOT.
  - C. ALL TRAFFIC CONTROL SIGNAGE SHALL CONFORM WITH THE CURRENT EDITION OF THE MANUAL FOR UNIFORM TRAFFIC CONTROL DEVICES (MUTCD).
  - D. ALL UTILITY EXTENSIONS AND CONSTRUCTION SHALL CONFORM TO THE STANDARDS AND SPECIFICATIONS OF THE UTILITY COMPANIES.
  - E. ALL EXTERIOR PAVEMENT (PCC, ASPHALT, ETC.) SHALL BE IN CONFORMANCE WITH THE SPECIFICATIONS OF LEE'S SUMMIT, MISSOURI
4. THE CONTRACTOR IS RESPONSIBLE FOR CONTACTING THE DELIVERY MANAGER AND COORDINATING ANY MAILBOXES THAT MAY BE DISTURBED. FAILURE TO DO SO MAY SUBJECT THE CONTRACTOR TO PROSECUTION BY THE FEDERAL GOVERNMENT.

EXISTING CONDITIONS

1. THE CONTRACTOR SHALL VISIT THE SITE AND BECOME FAMILIAR WITH THE EXISTING CONDITIONS OF THE PROJECT AREA.
2. THE CONTRACTOR SHALL BE RESPONSIBLE FOR PERFORMING THEIR OWN INVESTIGATIONS AND MAKING THEIR OWN ASSUMPTIONS REGARDING SITE SURFACE AND SUBSURFACE CONDITIONS. THIS INCLUDES THE LOCATION AND CONSISTENCY OF ANY EXISTING ROCK LAYERS UNDERLYING THE PROJECT SITE. CONTACT THE ENGINEER REGARDING ANY DISCREPANCIES THAT MAY AFFECT THE ABILITY TO CONSTRUCT FROM THESE PLANS AS DESIGNED.
3. EXISTING CONDITIONS WERE DETERMINED THROUGH A VARIETY OF METHODS THAT MAY INCLUDE SURVEY, AERIAL IMAGERY, AVAILABLE RECORDS, GIS DATA, ETC. SUBSURFACE CONDITIONS ARE APPROXIMATE AND MAY NOT INCLUDE ALL UTILITIES AND OTHER SITE IMPROVEMENTS PRESENT ON SITE. THE CONTRACTOR SHALL MAKE EXPLORATION EXCAVATIONS AND LOCATE EXISTING UNDERGROUND UTILITIES SUFFICIENTLY AHEAD OF CONSTRUCTION TO PERMIT REVISIONS TO PLANS WHEN CONFLICTS AND DISCREPANCIES ARE FOUND.

CONSTRUCTION

1. THE CONTRACTOR SHALL INSTALL TRAFFIC CONTROL WHILE WORKING IN THE PUBLIC RIGHT-OF-WAY AS SHOWN IN THESE PLANS. IF PLANS ARE NOT PROVIDED, CONTRACTOR SHALL COORDINATE AND PROVIDE CONTROLS TO THE SATISFACTION OF THE RIGHT-OF-WAY OWNER.
2. THE CONTRACTOR SHALL PROTECT ALL TREES OVER 3" CALIPER FROM DAMAGE. NO TREE SHALL BE REMOVED WITHOUT PERMISSION OF THE OWNER, UNLESS SHOWN OTHERWISE ON THESE PLANS.
3. THE CONTRACTOR SHALL DISPOSE ALL WASTE MATERIAL RESULTING

FROM THE PROJECT OFF-SITE AND IN STRICT CONFORMANCE WITH ALL LOCAL CODES AND ORDINANCES.

4. ALL MANHOLES, CATCH BASINS, UTILITY VALVES AND METER PITS ARE TO BE ADJUSTED OR REBUILT TO GRADE AS REQUIRED. NOT ALL ADJUSTMENTS ARE INDICATED IN THE PLANS.
5. THE CONTRACTOR SHALL STREET SWEEP OR OTHERWISE CLEAN ALL ACCESS ROUTES TO THE SITE AT CONCLUSION OF THE PROJECT.

SHOP DRAWINGS

1. THE CONTRACTOR SHALL SUBMIT SHOP DRAWING A MINIMUM OF 7 DAYS PRIOR TO THE REQUESTED DATE OF APPROVAL. ENGINEER SHALL REVIEW SHOP DRAWINGS OR SAMPLES CONFORMANCE WITH THE DESIGN FOR THIS PROJECT AS DESCRIBED IN THE PLANS. THE CONTRACTOR SHALL BE RESPONSIBLE FOR ERRORS OR OMISSIONS IN SHOP DRAWINGS. THE ENGINEER'S REVIEW SHALL NOT EXTEND TO MEANS OR METHODS OF CONSTRUCTION. CONTRACTOR SHALL BE RESPONSIBLE FOR ANY VARIATION FROM THE REQUIREMENTS OF THE CONTRACT DOCUMENTS UNLESS CONTRACTOR HAS NOTIFIED ENGINEER OF EACH SUCH VARIATION AT THE TIME OF SUBMISSION, AND OBTAINED ENGINEER'S WRITTEN APPROVAL OF EACH SUCH VARIATION. PRIOR TO SUBMITTING EACH SHOP DRAWING OR SAMPLE, CONTRACTOR SHALL HAVE REVIEWED AND VERIFIED:
  - A. ALL FIELD MEASUREMENTS, QUANTITIES, DIMENSIONS, SPECIFIED PERFORMANCE CRITERIA, INSTALLATION REQUIREMENTS, MATERIALS, CATALOG NUMBERS AND SIMILAR INFORMATION WITH RESPECT THERETO;
  - B. ALL MATERIALS WITH RESPECT TO INTENDED USE, FABRICATION, SHIPPING, HANDLING, STORAGE, ASSEMBLY AND INSTALLATION PERTAINING TO THE PERFORMANCE OF THE WORK;
  - C. ALL INFORMATION RELATIVE TO MEANS, METHODS, TECHNIQUES, SEQUENCES AND PROCEDURES OF CONSTRUCTION AND SAFETY PRECAUTIONS AND PROGRAMS INCIDENT THERETO;
  - D. CONTRACTOR SHALL ALSO HAVE REVIEWED AND COORDINATED EACH SHOP DRAWING OR SAMPLE WITH OTHER SHOP DRAWINGS AND SAMPLES, AND WITH THE REQUIREMENTS OF THE WORK AND THE CONTRACT DOCUMENTS.
  - E. ALL SUBMITTED SHOP DRAWINGS SHALL BEAR A STAMP OR SPECIFIC WRITTEN INDICATION AND SIGNATURE THAT CONTRACTOR HAS FULLY COMPLETED THE ABOVE TASKS.
2. SHOP DRAWINGS AS DESCRIBED ABOVE ARE REQUIRED FOR, BUT NOT LIMITED TO, THE FOLLOWING:
  - A. ALL SANITARY SEWER STRUCTURES TO BE INSTALLED WITH THIS PROJECT.
  - B. ANY ITEMS IN THESE PLANS THAT ALLOW FOR AN 'APPROVED EQUAL' ALTERNATIVE.

SANITARY SEWER GENERAL NOTES

1. PRIOR TO COMMENCEMENT OF WORK THE CONTRACTOR SHALL NOTIFY AND COORDINATE CONSTRUCTION WITH CITY OF LEE'S SUMMIT, MISSOURI.
2. ALL PIPE LENGTHS ARE CALCULATED LINEARLY FROM CENTER OF STRUCTURE TO CENTER OF STRUCTURE.
4. ALL STRUCTURE DIMENSIONS ARE TO INSIDE FACE OF STRUCTURE.
5. COORDINATES ARE PROVIDED AT THE CENTER OF STRUCTURE. ADDITIONAL COORDINATES PROVIDED ARE PER LOCAL CODES AND ORDINANCES OR AS AN AID WHEN ORIENTING THE LID DURING INSTALLATION.
6. THE CONTRACTOR SHALL EXPOSE EXISTING UTILITIES AT LOCATIONS OF POSSIBLE CONFLICT AND POINTS OF CONNECTION PRIOR TO ANY CONSTRUCTION OF SANITARY SEWER.
7. SANITARY SEWER TRENCHES SHALL BE CONSTRUCTED SUCH THAT UNDISTURBED EXISTING SOIL OR FILL COMPACTED TO 95% PROCTOR DENSITY IS AT A DEPTH THAT IS 18" ABOVE TOP OF PROPOSED PIPE.
8. MANHOLE INVERT CHANNELS SHALL BE SMOOTH, CIRCULAR, AND CONFORMING TO ½ THE ADJACENT PIPE SECTION (INVERT TO CENTER). CHANGES IN DIRECTION OF FLOW SHALL BE MADE WITH A SMOOTH CURVE AND MAINTAIN SHAPE THROUGHOUT. CHANGES IN GRADE OF ADJACENT PIPES SHALL BE TRANSITIONED SMOOTHLY AND EVENLY THROUGH THE MANHOLE.
9. PIPE PENETRATIONS SHALL BE USE GASKETS TO ENSURE WATERTIGHT SEALS.
10. TRACING TAPE SHALL BE INSTALLED ALONG ALL NON-METALLIC SURFACES OR AS DIRECTED BY LOCAL CODES AND ORDINANCES.
11. SEWER LINE INSPECTIONS AND TESTING MUST BE SCHEDULED A MINIMUM OF TWO FULL BUSINESS DAYS IN ADVANCE. CONTRACTOR SHALL FURNISH ALL TESTING EQUIPMENT. TESTING SHALL INCLUDE
  - A. MANDREL TEST OF ALL GRAVITY SEWERS. IF THE MANDREL TEST FAILS ON ANY SECTION OF PIPE, THAT SECTION SHALL BE UNCOVERED AND REPLACED.
  - B. AIR PRESSURE TEST OF ALL GRAVITY SEWERS.
  - C. VACUUM TEST OF ALL MANHOLES.
12. REFER TO SHEET C208 FOR SANITARY DESIGN & SEWER LATERAL INFORMATION.
13. ALL SERVICE LINE CONNECTIONS SHALL BE MADE WITH AN 8"x4" PVC WYE, 4"PVC 45° BEND, AND THE APPROPRIATE LENGTH OF 4" PVC LATERAL (UNLESS OTHERWISE SHOWN) AND CAP. SEE DETAIL SHEET C209.
14. MSFE- INDICATES LOWEST FLOOR SERVICEABLE BY PROPOSED SANITARY SEWER.
15. MAXIMUM DEVIATION FROM LATERAL STATION LOCATIONS AS CALLED OUT SHALL BE 2.0' TO AVOID PIPE JOINT.
16. SANITARY LATERALS ARE DESIGNED @ 2.00% SLOPE. IF RISER IS INDICATED, IT IS TO BE AT THE SANITARY MAIN, UNLESS OTHERWISE NOTED.
17. REFER TO CURRENT CITY SPECIFICATIONS FOR MINIMUM PIPE SLOPES.
18. CONTRACTOR MAY BE REQUIRED TO RECONSTRUCT PIPE AND STRUCTURE IF MINIMUM INVERT DROP OR PIPE SLOPE REQUIREMENTS ARE NOT MET.
19. SANITARY STRUCTURES SHALL BE PER CURRENT CITY DETAILS. IF CITY DOES NOT HAVE PUBLISHED DETAILS STRUCTURES SHALL BE PER CURRENT APWA SPECIFICATIONS.
20. GRAVITY SANITARY SEWER AND WATER LINES SHALL BE SEPARATED BY A MINIMUM OF 10' HORIZONTALLY WHEN PARALLEL AND 2' VERTICALLY WHEN CROSSING. WATER LINES SHALL CROSS ABOVE SANITARY SEWERS.

ESTIMATE OF QUANTITIES

ITEM NO.	DESCRIPTION	UNIT	QUANTITY	AS-BUILT
STREET				
1	8" SANITARY PVC (SDR-26)	L.F.	<del>1819.19</del>	1823.02
2	MANHOLES, STD. 4' DIA.	EA.	<del>—9—</del>	9
3	CONNECTION TO EXISTING MANHOLE	EA.	<del>—2—</del>	2
4	TRACER WIRE	L.F.	<del>2070.78</del>	2070.78*
5	TRACER WIRE BOX	EA.	<del>—42—</del>	42*
6	SERVICE WYE	EA.	<del>—42—</del>	42*
7	4" LATERAL PIPE	L.F.	<del>2070.78</del>	2070.78*

\*AS PROVIDED BY CONTRACTOR

SUMMARY OF QUANTITIES AS INDICATED ABOVE AND ANY QUANTITIES AS SHOWN WITHIN THE PLANS HAVE BEEN PROVIDED FOR PERMITTING PURPOSES ONLY AND ARE NOT INTENDED FOR USE IN PREPARATION OF CONTRACT DOCUMENTS. QUANTITIES INTENDED FOR, BUT NOT LIMITED TO, THE PREPARATION OF PROPOSALS AND BID DOCUMENTS SHALL BE INDEPENDENTLY EVALUATED BY THE ESTIMATING PARTY BASED UPON THE CONTENTS OF THESE PLANS.

CONTROL POINT TABLE


Point Number	Northing	Easting	Point Elevation	Raw Description
90009	981383.7330'	2813865.4520'	1064.23'	CP 60D
90012	981431.6120'	2813832.1000'	1062.71'	CP 60D
90033	981440.4750'	2814063.8700'	1047.98'	CP 60D
90044	981710.8560'	2814198.8050'	1027.00'	CP 60D
90052	981859.5430'	2814200.2150'	1017.51'	CP 60D
90056	981975.4580'	2814144.8570'	1011.69'	CP 60D
90080	981971.2190'	2814027.5570'	1016.72'	CP 60D

VERTICAL CONTROL IS BASED ON THE NORTH AMERICAN VERTICAL DATUM OF 1988 (NAVOD88). THE DEVELOPER IS ADVISED TO USE BENCHMARK INFORMATION FOR VERTICAL CONTROL. HORIZONTAL CONTROL (CONTROL POINT INFORMATION) IS BASED ON THE NORTH AMERICAN DATUM OF 1983 (NAVOD83). THE DEVELOPER IS ADVISED TO USE CONTROL POINT INFORMATION FOR HORIZONTAL CONTROL.


ASBUILT  
1/4/2022

Accepted  
Record Drawings

These plans have been reviewed for accuracy and are accepted for basic conformance to the approved construction drawings.

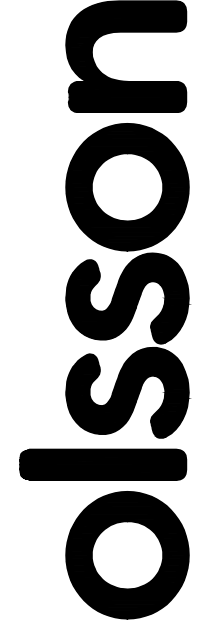

Olsson - Civil Engineering  
Missouri Certificate of Authority #001992  
1301 Burlington Street  
North Kansas City, MO 64116  
TEL 816.361.1177  
www.olsson.com



BY

REVISIONS DESCRIPTION

DATE

REV. NO.

2020

GENERAL NOTES  
SANITARY SEWER PLANS

HAWTHORN RIDGE  
THIRD PLAT

LEE'S SUMMIT, MO

drawn by: \_\_\_\_\_ OLS  
checked by: \_\_\_\_\_ BMW  
approved by: \_\_\_\_\_ BMW  
QA/QC by: \_\_\_\_\_ JES  
project no.: A19-1605  
drawing no.: C\_TTL01\_A191605  
date: 10/02/2020

SHEET  
C201



DWG: F:\2019\1501-2000\019-1605-A\40-Design\AutoCAD\Final Plans - As-Built\Sheets\GEN\SANITARY\C\_GEN01\_A191605.dwg  
DATE: Jan 04, 2022 10:53am  
XREFS: C\_PSSWR\_A191605 C\_PBASE\_A191605 C\_PUTIL\_A191605 C\_PSSW\_A191605 C\_PBASE\_A191605 C\_PUTIL\_A191605  
USER: bwerthley C\_PBASE\_A191605 C\_PTBULK\_A191605 C\_PBN DY\_A191605




Structure Table		
STRUCTURE ID	NORTHING	EASTING
HR2 M.H. 1-6	981182.4294	2814429.6720
HR2 M.H. 2-1	981787.9574	2814426.8908
M.H. 1-1	981804.7594	2814171.2943
M.H. 1-2	981816.5279	2813945.5634
M.H. 1-3	981817.1486	2813857.2635
M.H. 2-1	981683.0783	2813936.8173
M.H. 2-2	981374.4799	2813922.4440
M.H. 3-1	981187.7875	2814283.9028
M.H. 3-2	981187.2256	2814033.8404
M.H. 3-3	981277.3041	2813943.8417
M.H. 4-1	981469.9842	2814294.8413

As-Built Structure Table		
STRUCTURE ID	NORTHING	EASTING
HR2 M.H. 1-6	981182.9110	2814430.5870
HR2 M.H. 2-1	981788.3060	2814427.8000
M.H. 1-1	981803.6150	2814171.1500
M.H. 1-2	981817.5240	2813945.4830
M.H. 1-3	981818.2050	2813857.6470
M.H. 2-1	981683.4240	2813937.4990
M.H. 2-2	981374.7760	2813922.1270
M.H. 3-1	981186.5080	2814284.0020
M.H. 3-2	981186.3100	2814033.6180
M.H. 3-3	981277.9460	2813944.0240
M.H. 4-1	981469.7060	2814295.6480

ASBUILT  
1/4/2022

Accepted  
Record Drawings

These plans have been reviewed for  
accuracy and are accepted for basic  
conformance to the approved  
construction drawings.

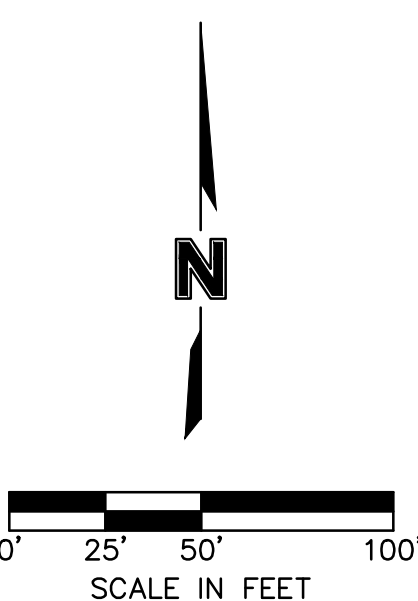

olsson

Olsson - Civil Engineering  
Missouri Certificate of Authority #001592  
1301 Burlington Street  
North Kansas City, MO 64116  
TEL 816.361.1177  
www.olsson.com

STATE OF MISSOURI  
BROCK M. NORTHROP  
PE-2019000237  
1/4/2022  
PROFESSIONAL ENGINEER

BY  
REV. NO. 2 12/02/2020  
3 12/15/2020  
REVISIONS DESCRIPTION  
REVISED PER CITY COMMENTS  
REVISED PER CITY COMMENTS

GENERAL LAYOUT  
SANITARY SEWER PLANS  
HAWTHORN RIDGE  
THIRD PLAT  
LEE'S SUMMIT, MO  
2020




drawn by: OLS  
checked by: BMW  
approved by: BMW  
QA/QC by: JES  
project no.: A19-1605  
drawing no.: C\_GEN01\_A191605  
date: 10/02/2020

SHEET  
C202



DWG: F:\2019\1501-2000\019-1605-A\40-Design\AutoCAD\Final Plans - As-Built\Sheets\GNCA\SANITARY\C\_SAN01\_A191605.dwg  
DATE: Jan 04, 2022 11:24am  
XREFS: C\_PBASE\_A191605 C\_PSSWR\_A191605 C\_PTBLK\_A191605 C\_PBNBY\_A191605 C\_PTUL\_A191605  
USER: bworthley

NOTE:  
CONTRACTOR SHALL FILL AND COMPACT  
TO 95% STANDARD DENSITY TO A POINT  
18" MINIMUM ABOVE THE TOP OF PIPE  
PRIOR TO EXCAVATION FOR THE PIPE.

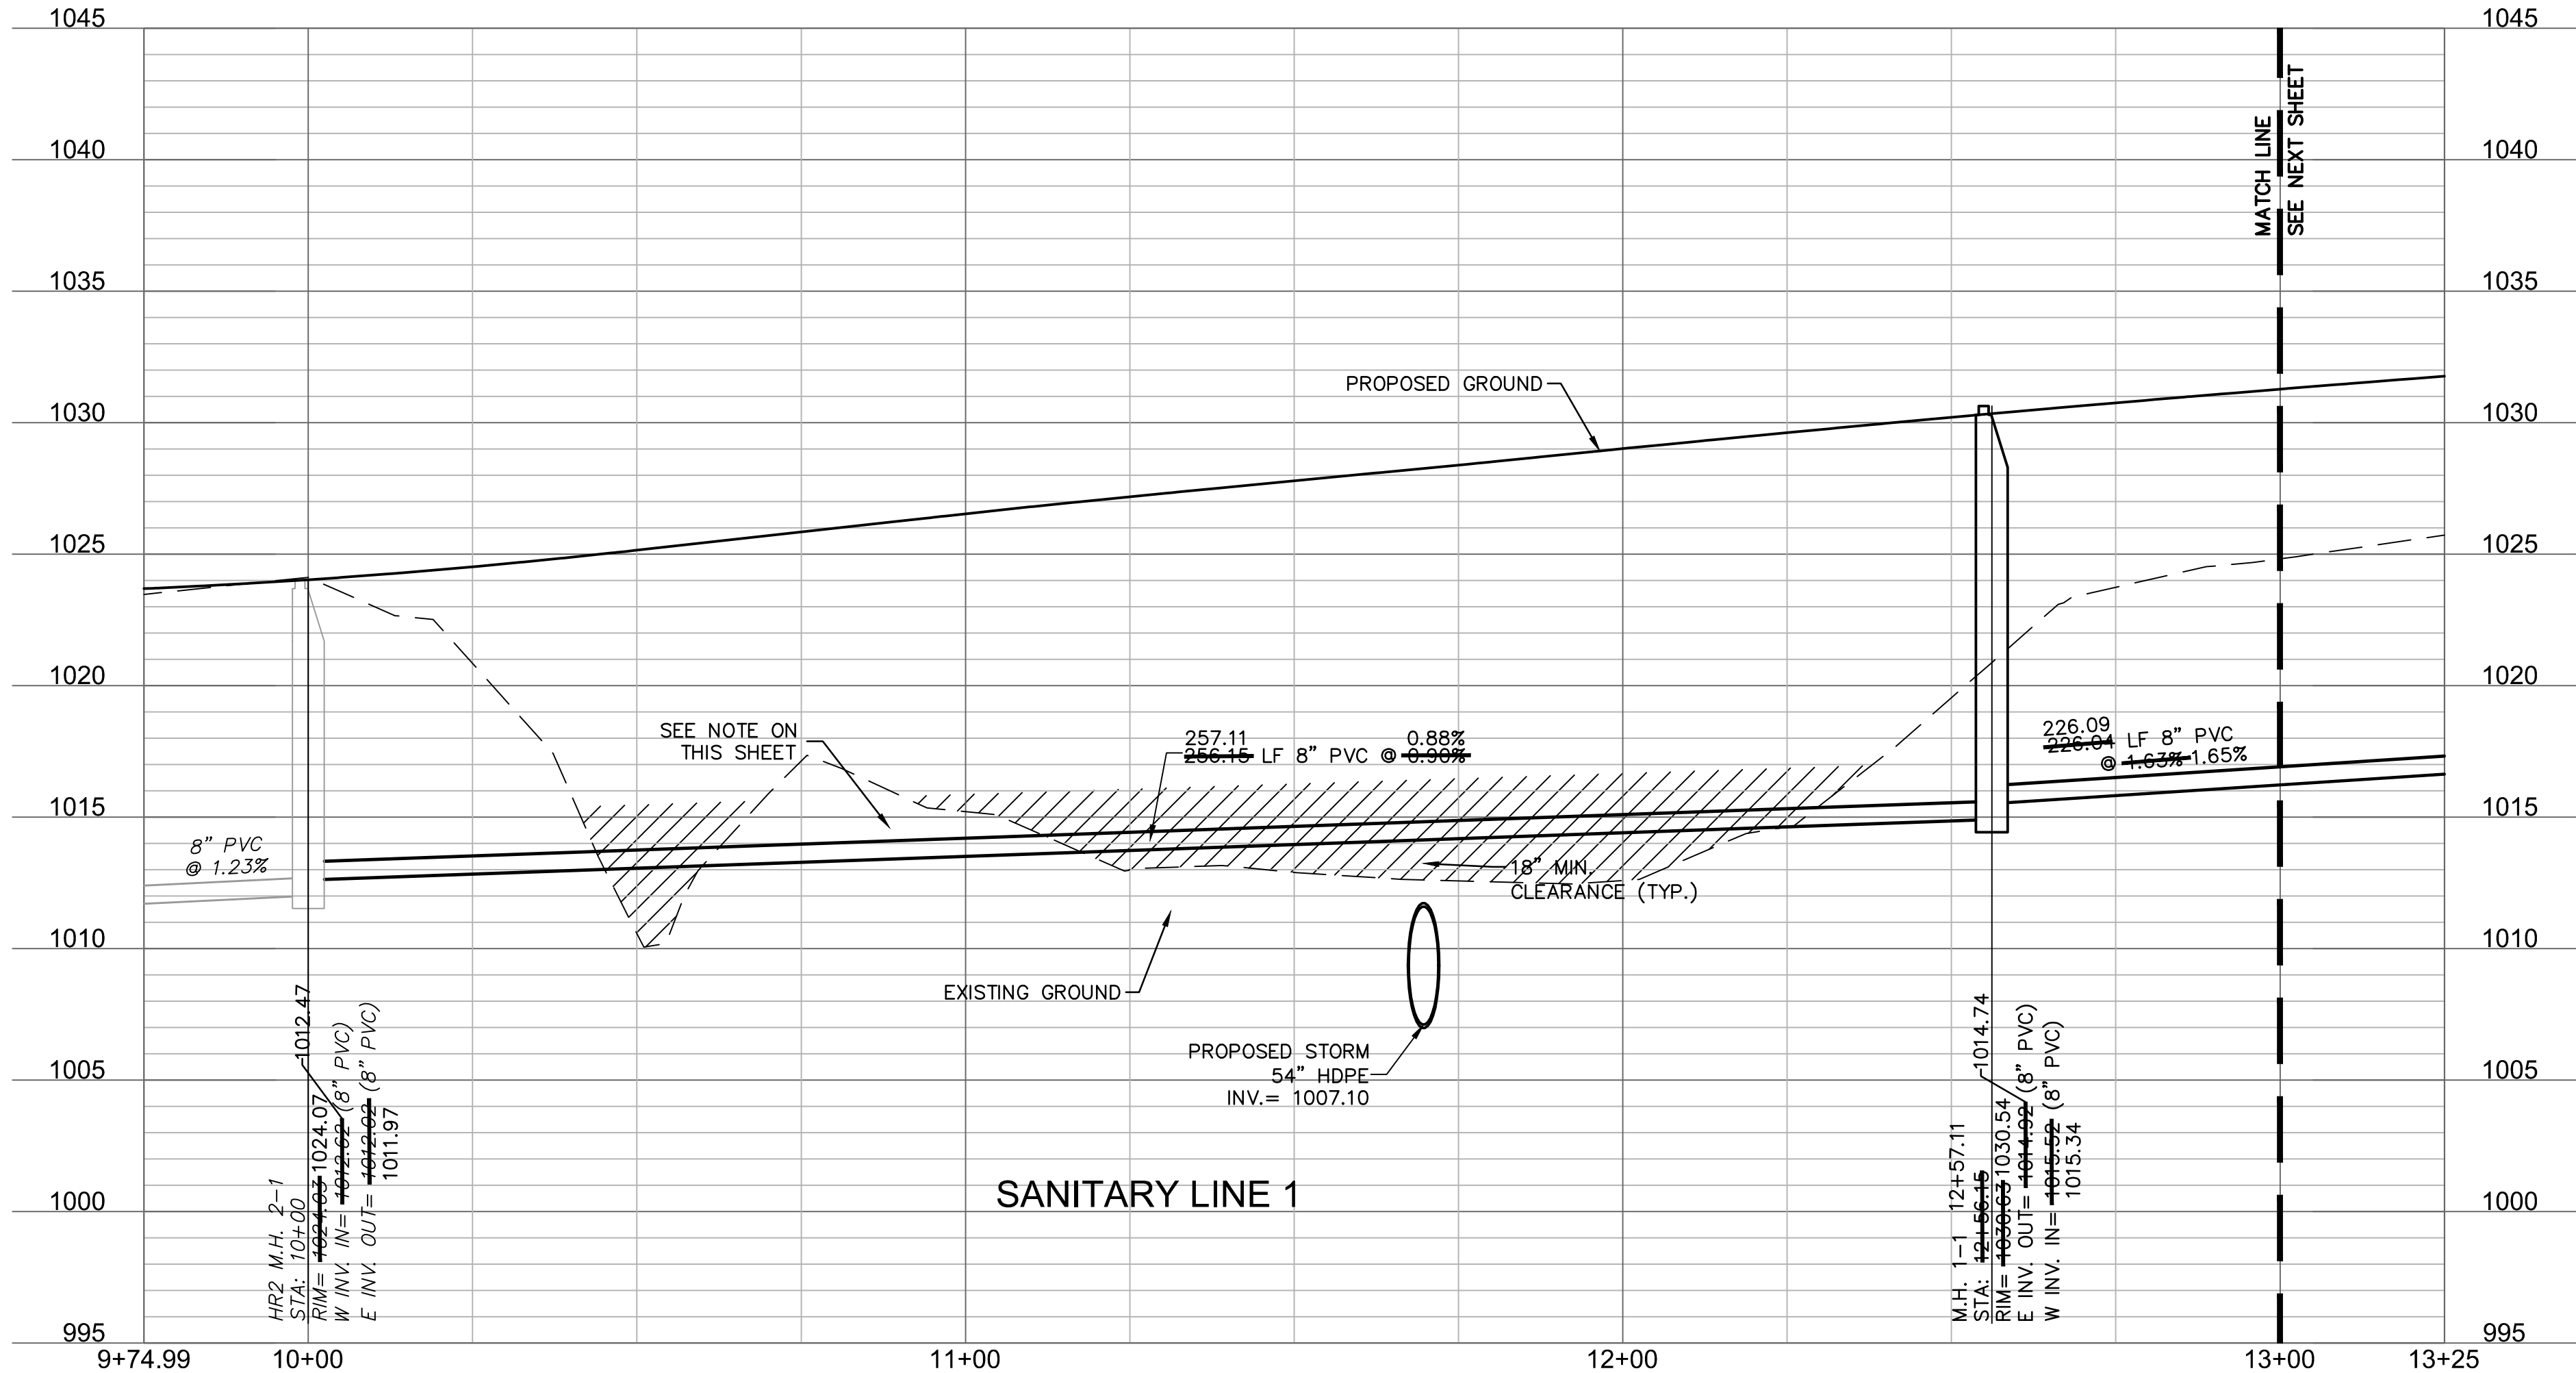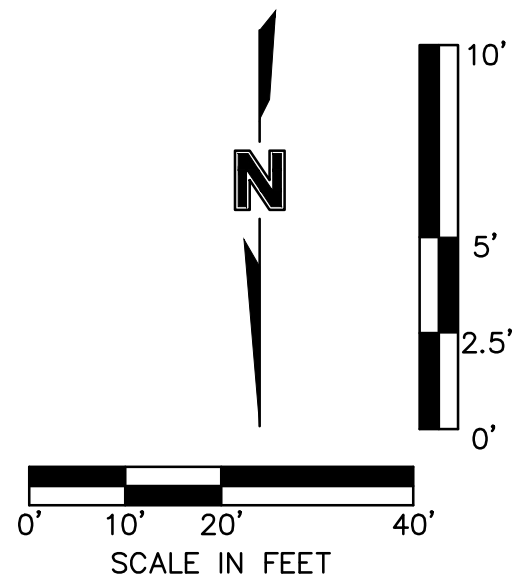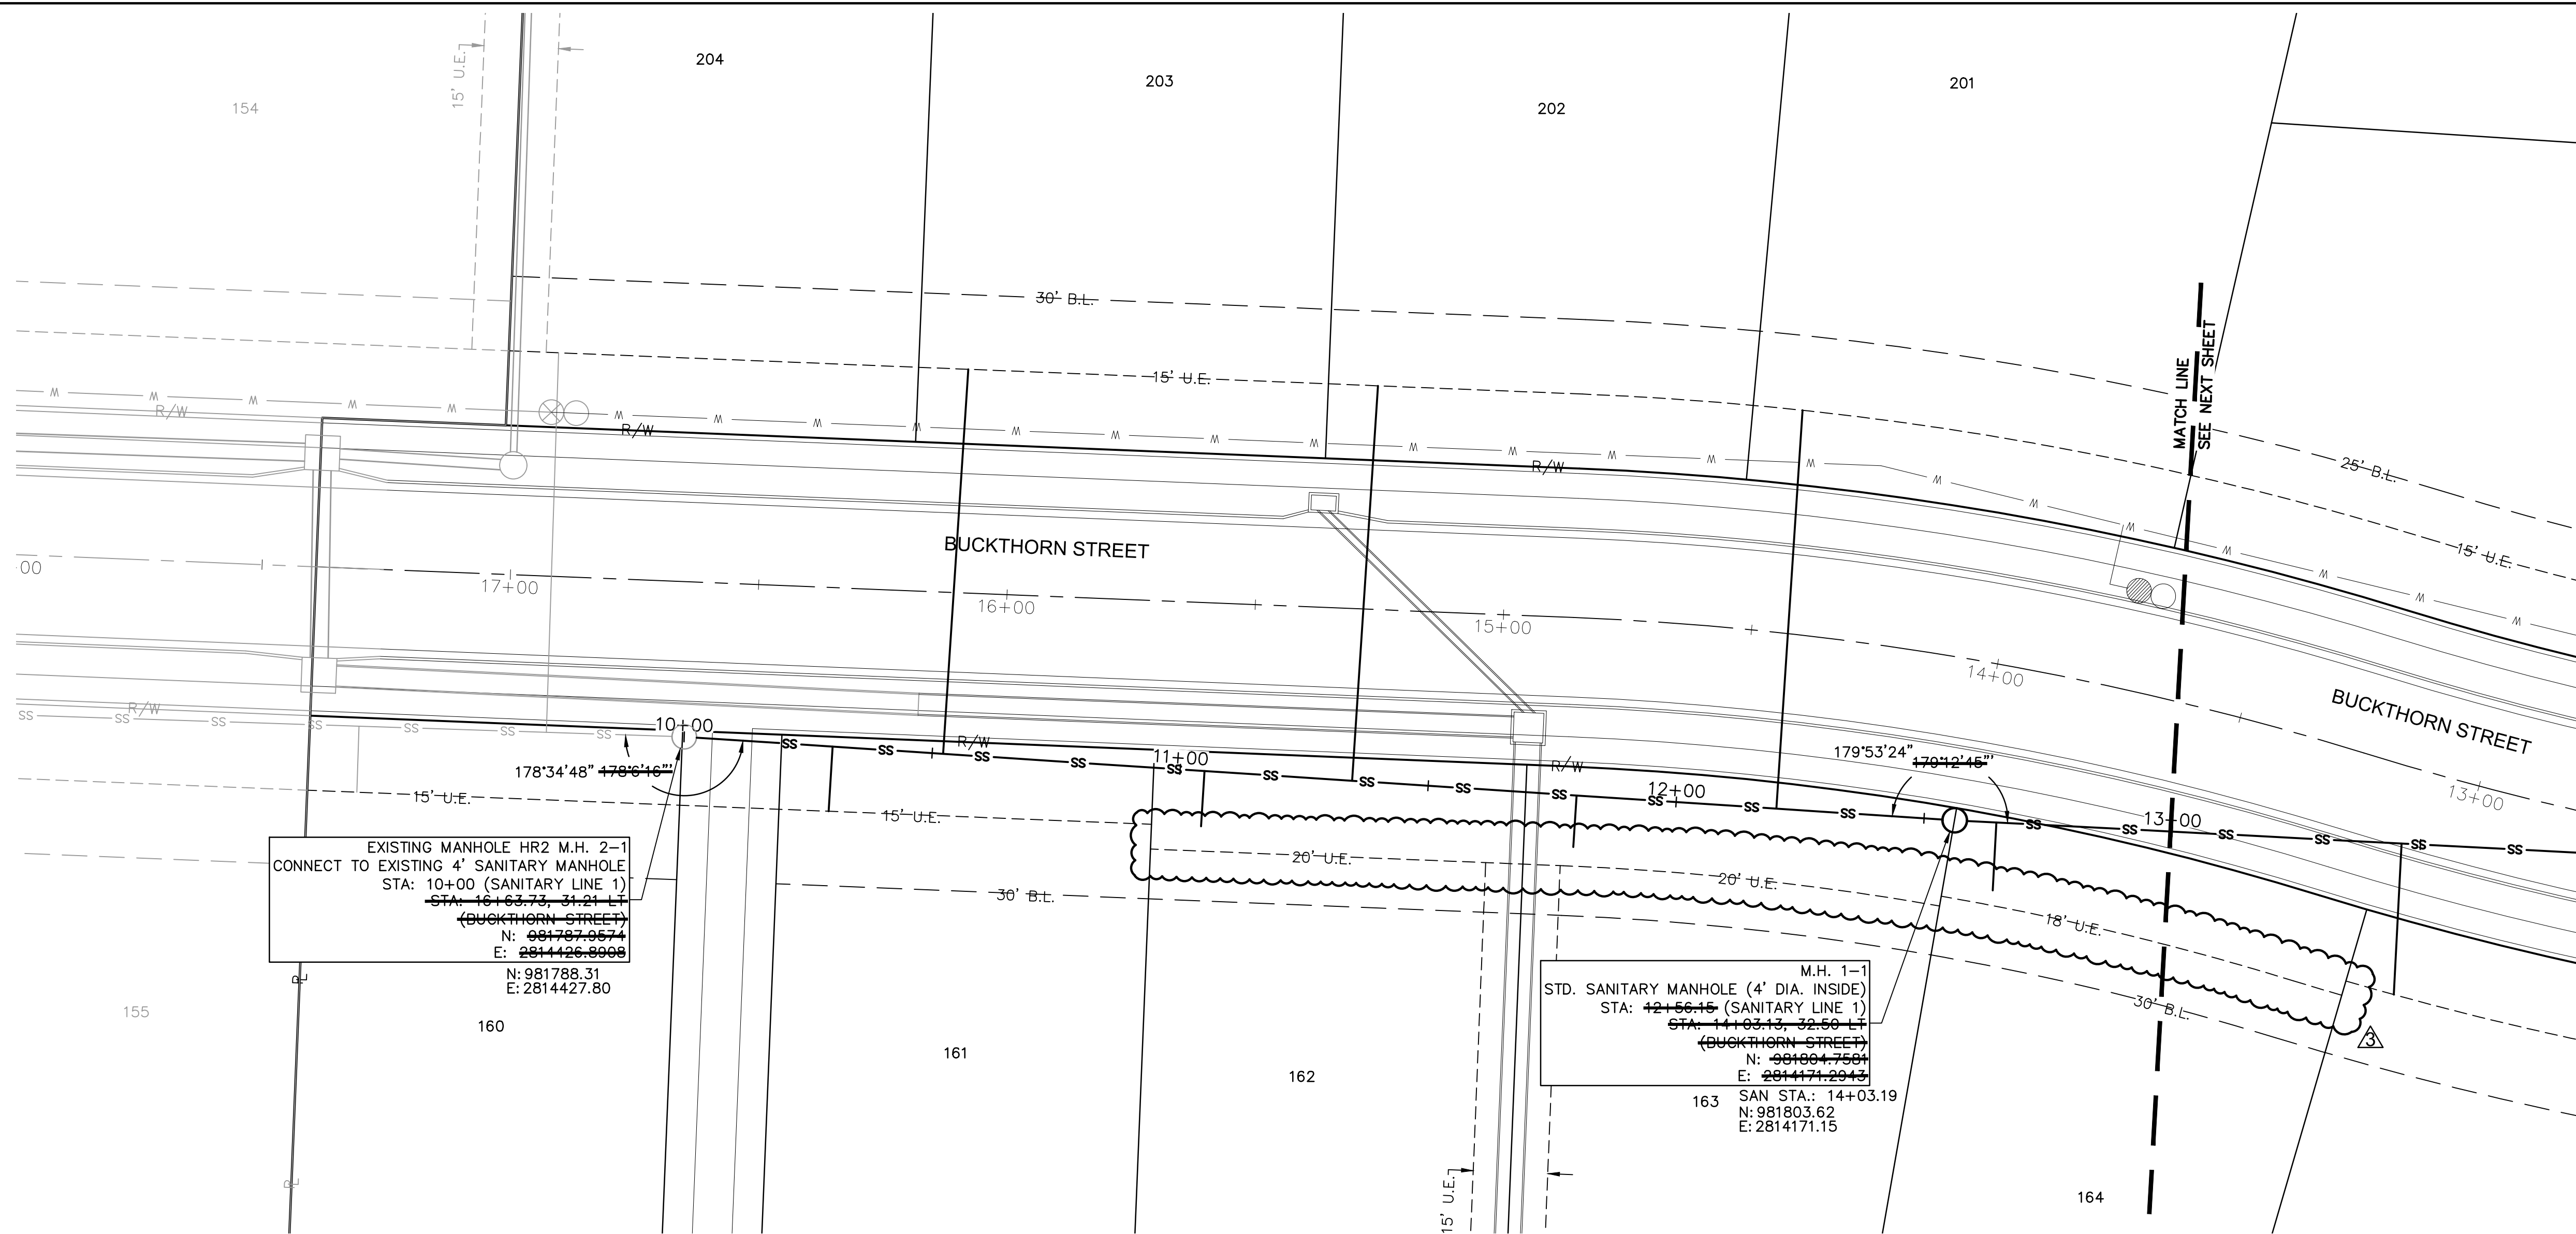

ASBUILT  
1/4/2022

Accepted  
Record Drawings

These plans have been reviewed for  
accuracy and are accepted for basic  
conformance to the approved  
construction drawings.

Olsson - Civil Engineering  
Missouri Certificate of Authority #001592  
1301 Burlington Street  
North Kansas City, MO 64116  
TEL 816.361.1177  
www.olson.com

REV. NO.	DATE	REVISIONS DESCRIPTION
1	11/23/2020	REVISED PER CITY COMMENTS
3	12/15/2020	REVISED PER CITY COMMENTS



SANITARY PLAN AND PROFILE (LINE 1)	
SANITARY SEWER PLANS	
HAWTHORN RIDGE	
THIRD PLAT	
2020	REVISIONS

drawn by: OLS  
checked by: BMW  
approved by: BMW  
QA/QC by: JES  
project no.: A19-1605  
drawing no.: C\_SAN01\_A191605  
date: 10/22/2020

SHEET  
C203



DWG: F:\2019\1501-2000\019-1605-A\40-Design\AutoCAD\Final Plans - As-Built\Sheets\GNCV SANITARY\C\_SAN01\_A191605.dwg  
DATE: Jan 04, 2022 11:24am XREFS: C\_PBASE\_A191605 C\_PSSWR\_A191605 C\_TBLK\_A191605 C\_XBASE\_A191605

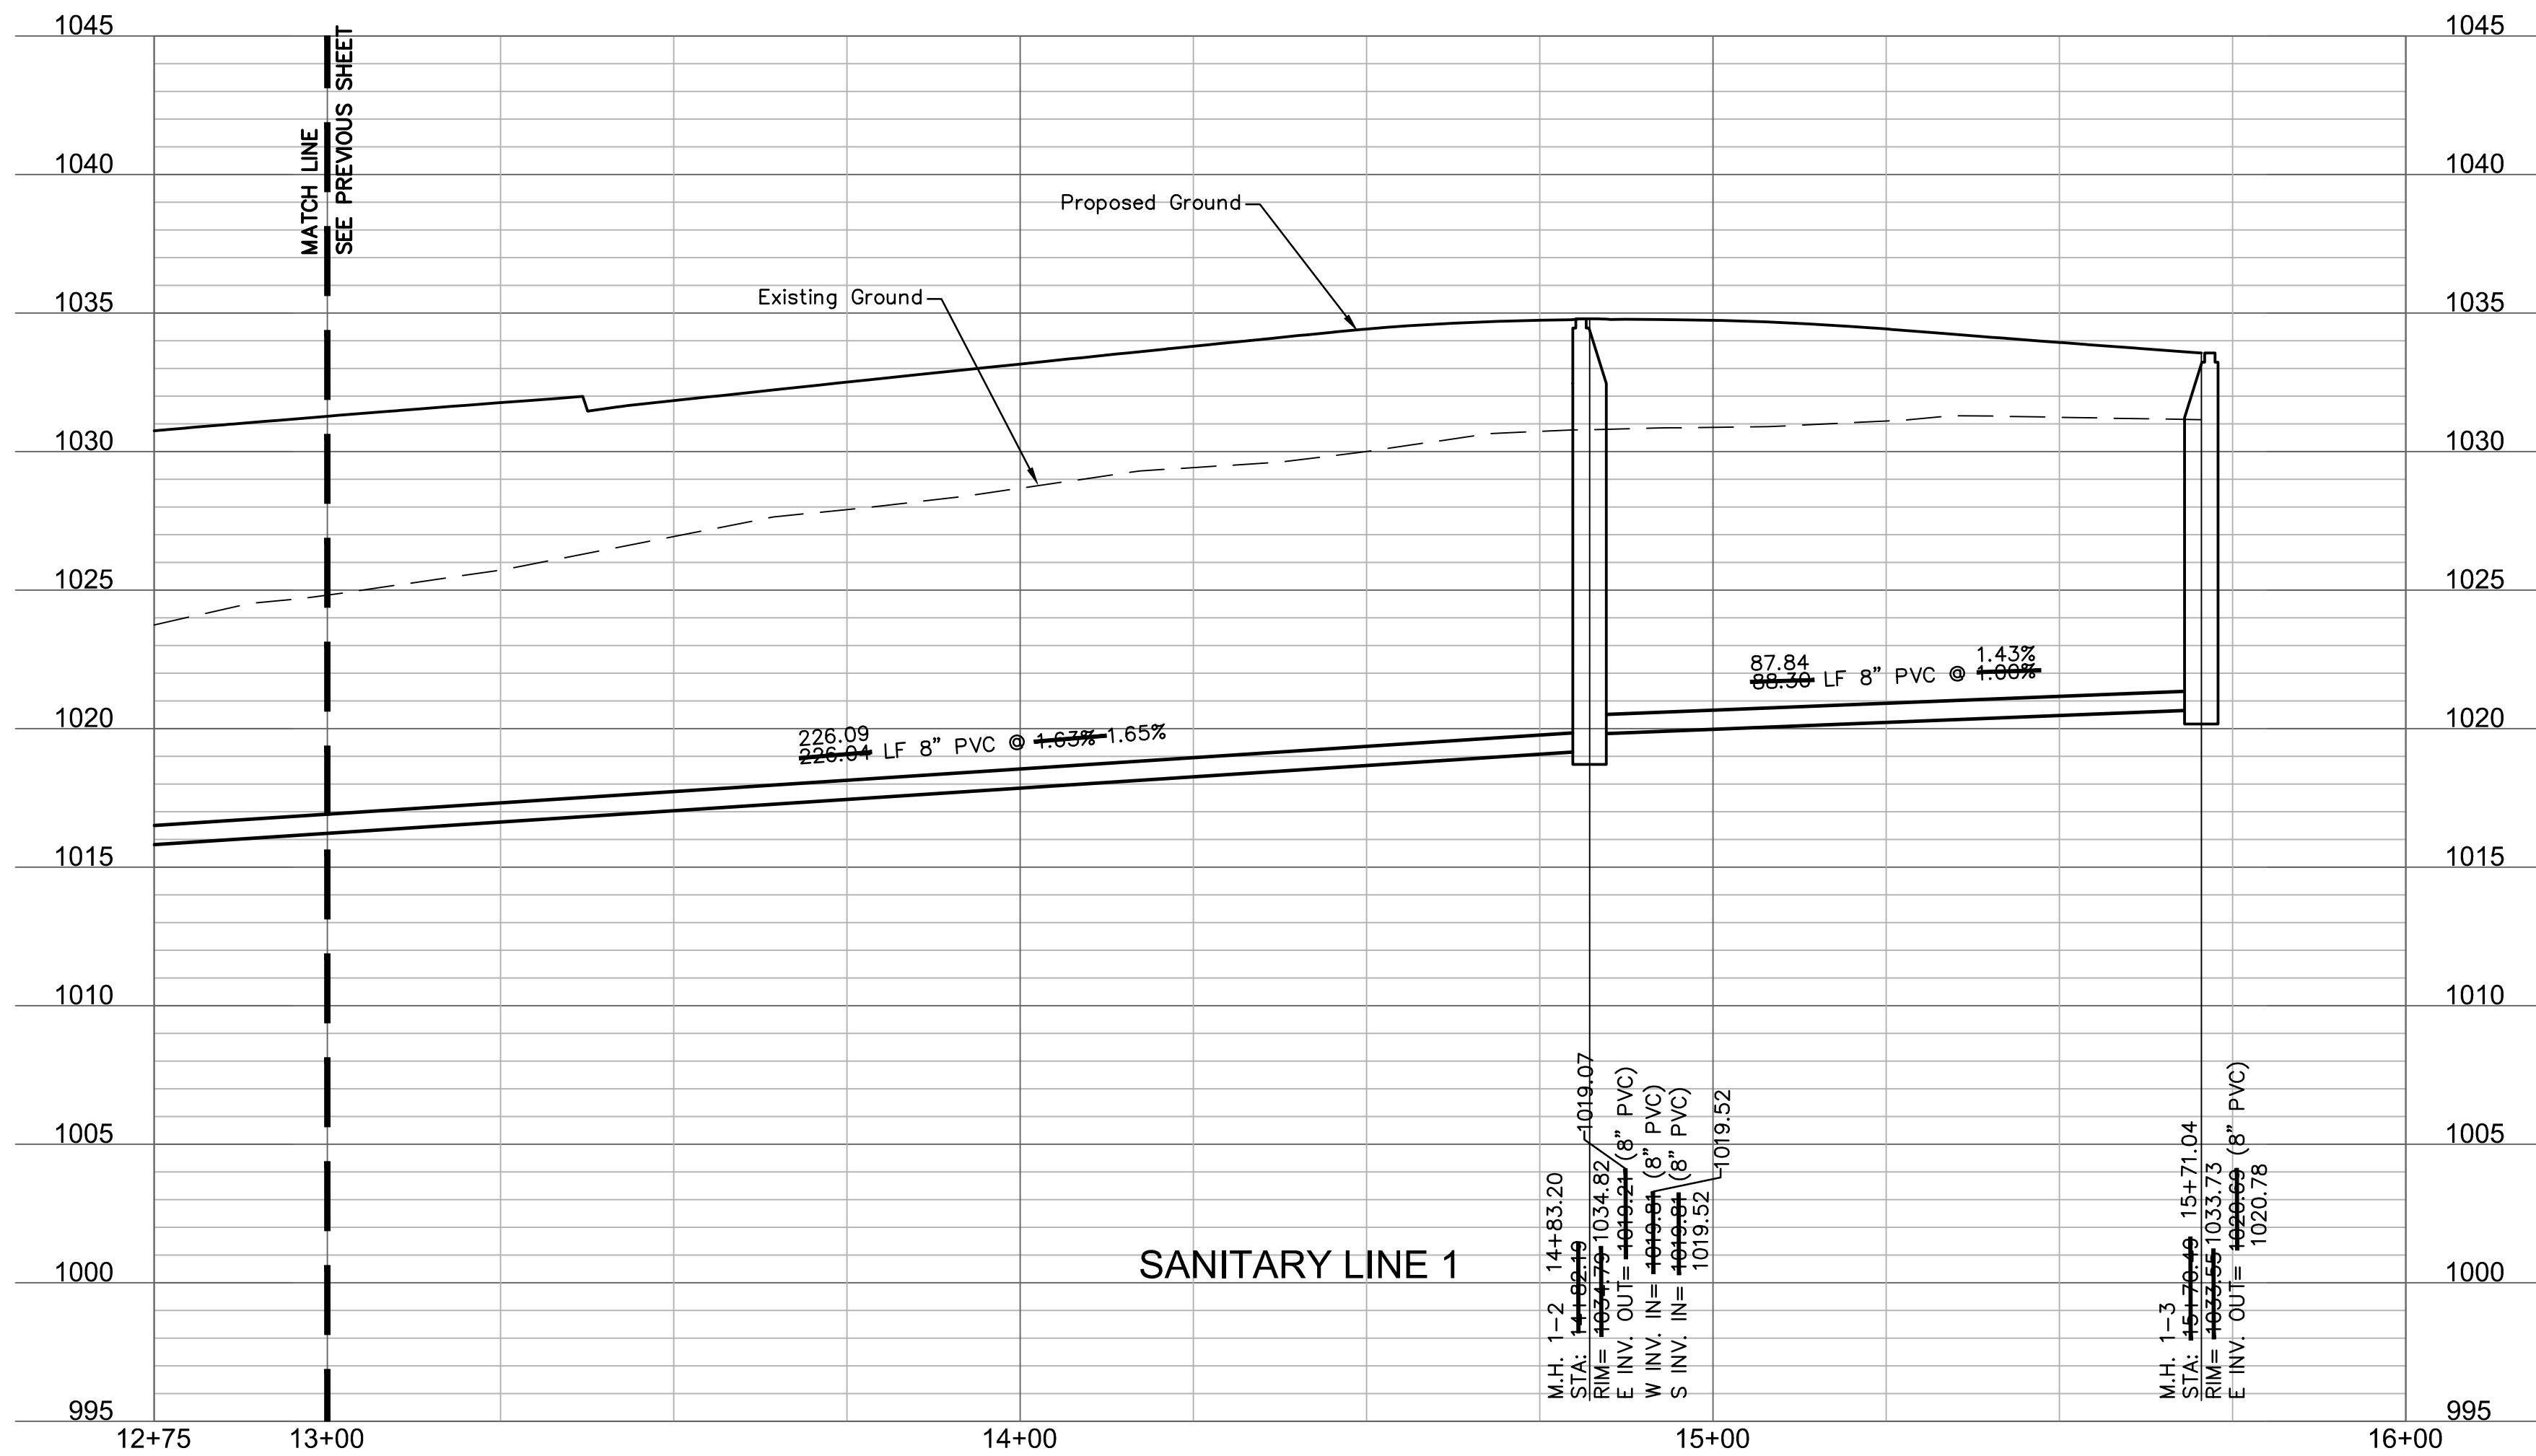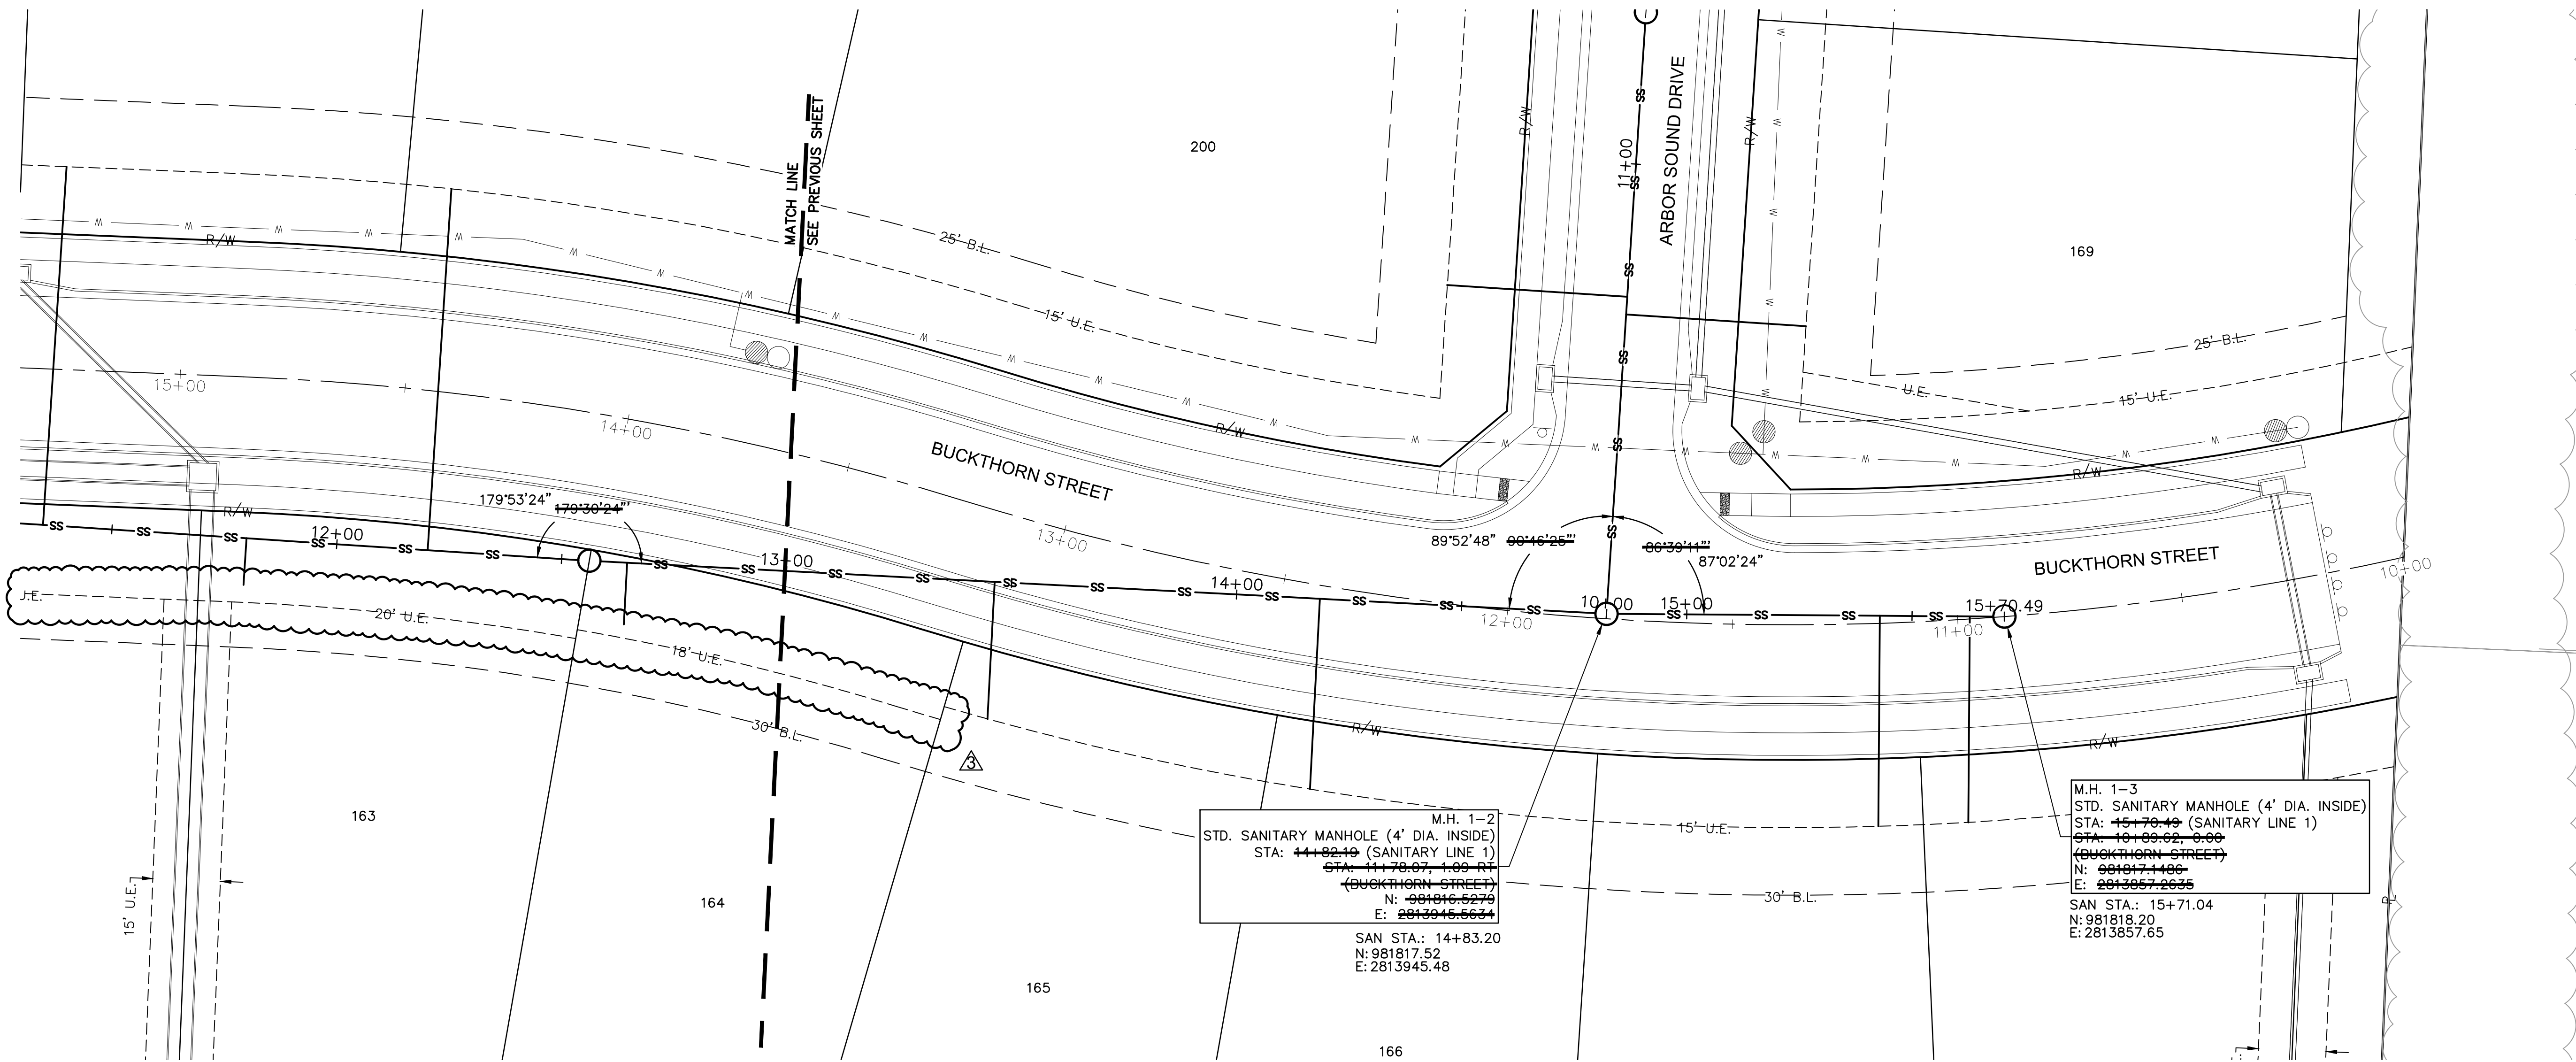

ASBUILT  
1/4/2022

**Accepted  
Record Drawings**

**These plans have been reviewed for accuracy and are accepted for basic conformance to the approved construction drawings.**

**SANITARY PLAN AND PROFILE (LINE 1 CONT)**  
**SANITARY SEWER PLANS**

## HAWTHORN RIDGE THIRD PLAT

LEE'S SUMMIT, MO

SHEET  
C204

drawn by: \_\_\_\_\_ OLS  
checked by: \_\_\_\_\_ BMW  
approved by: \_\_\_\_\_ BMW  
QA/QC by: \_\_\_\_\_ JES  
project no.: \_\_\_\_\_ A19-1605  
drawing no.: C SAN01 A191605  
date: 10/02/2020

2020

## REVISIONS DESCRIPTION



BY



Olsson - Civil Engineering  
Missouri Certificate of Authority #001592  
1301 Burlington Street  
North Kansas City, MO 64116  
TEL 816.361.1177 www.olsson.com

**olson**



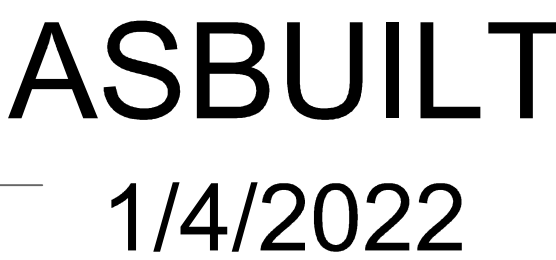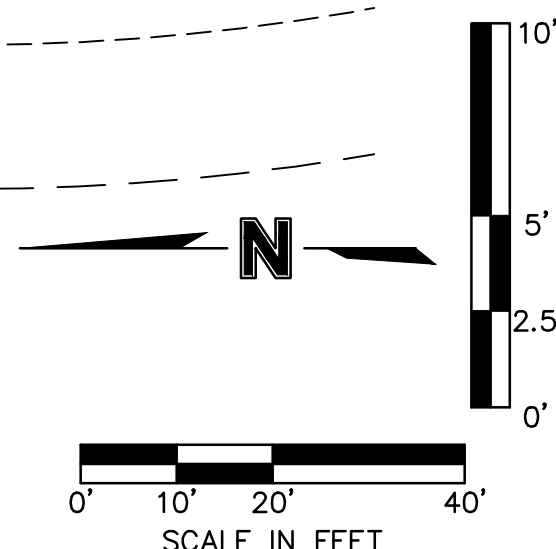


**These plans have been reviewed for accuracy and are accepted for basic conformance to the approved construction drawings.**









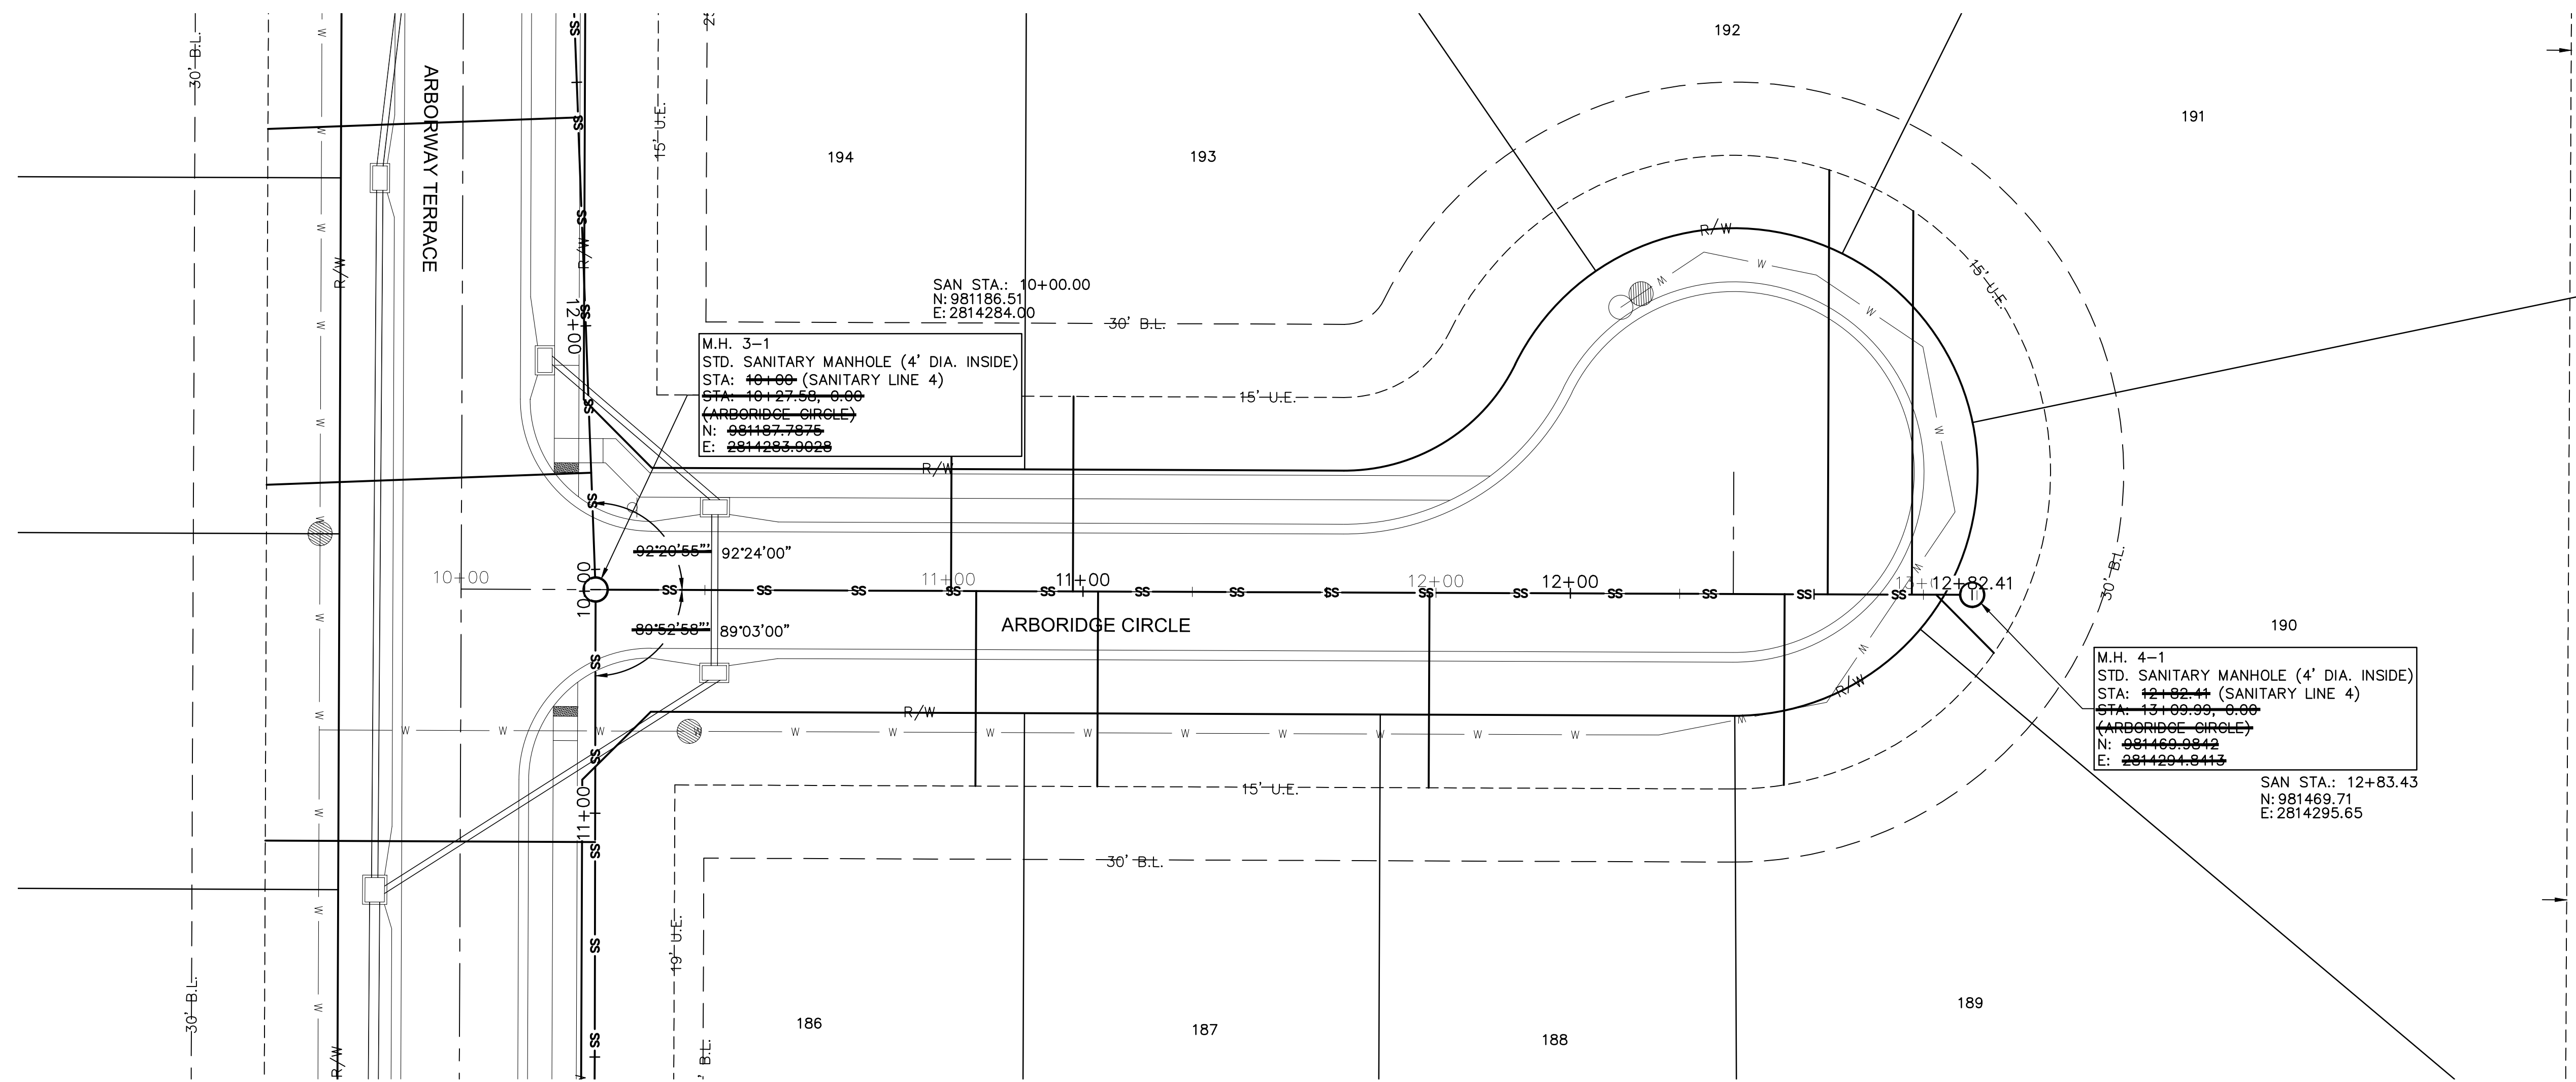

**NOTE:**  
CONTRACTOR SHALL FILL AND COMPACT  
TO 95% STANDARD DENSITY TO A POINT  
18" MINIMUM ABOVE THE TOP OF PIPE  
PRIOR TO EXCAVATION FOR THE PIPE.

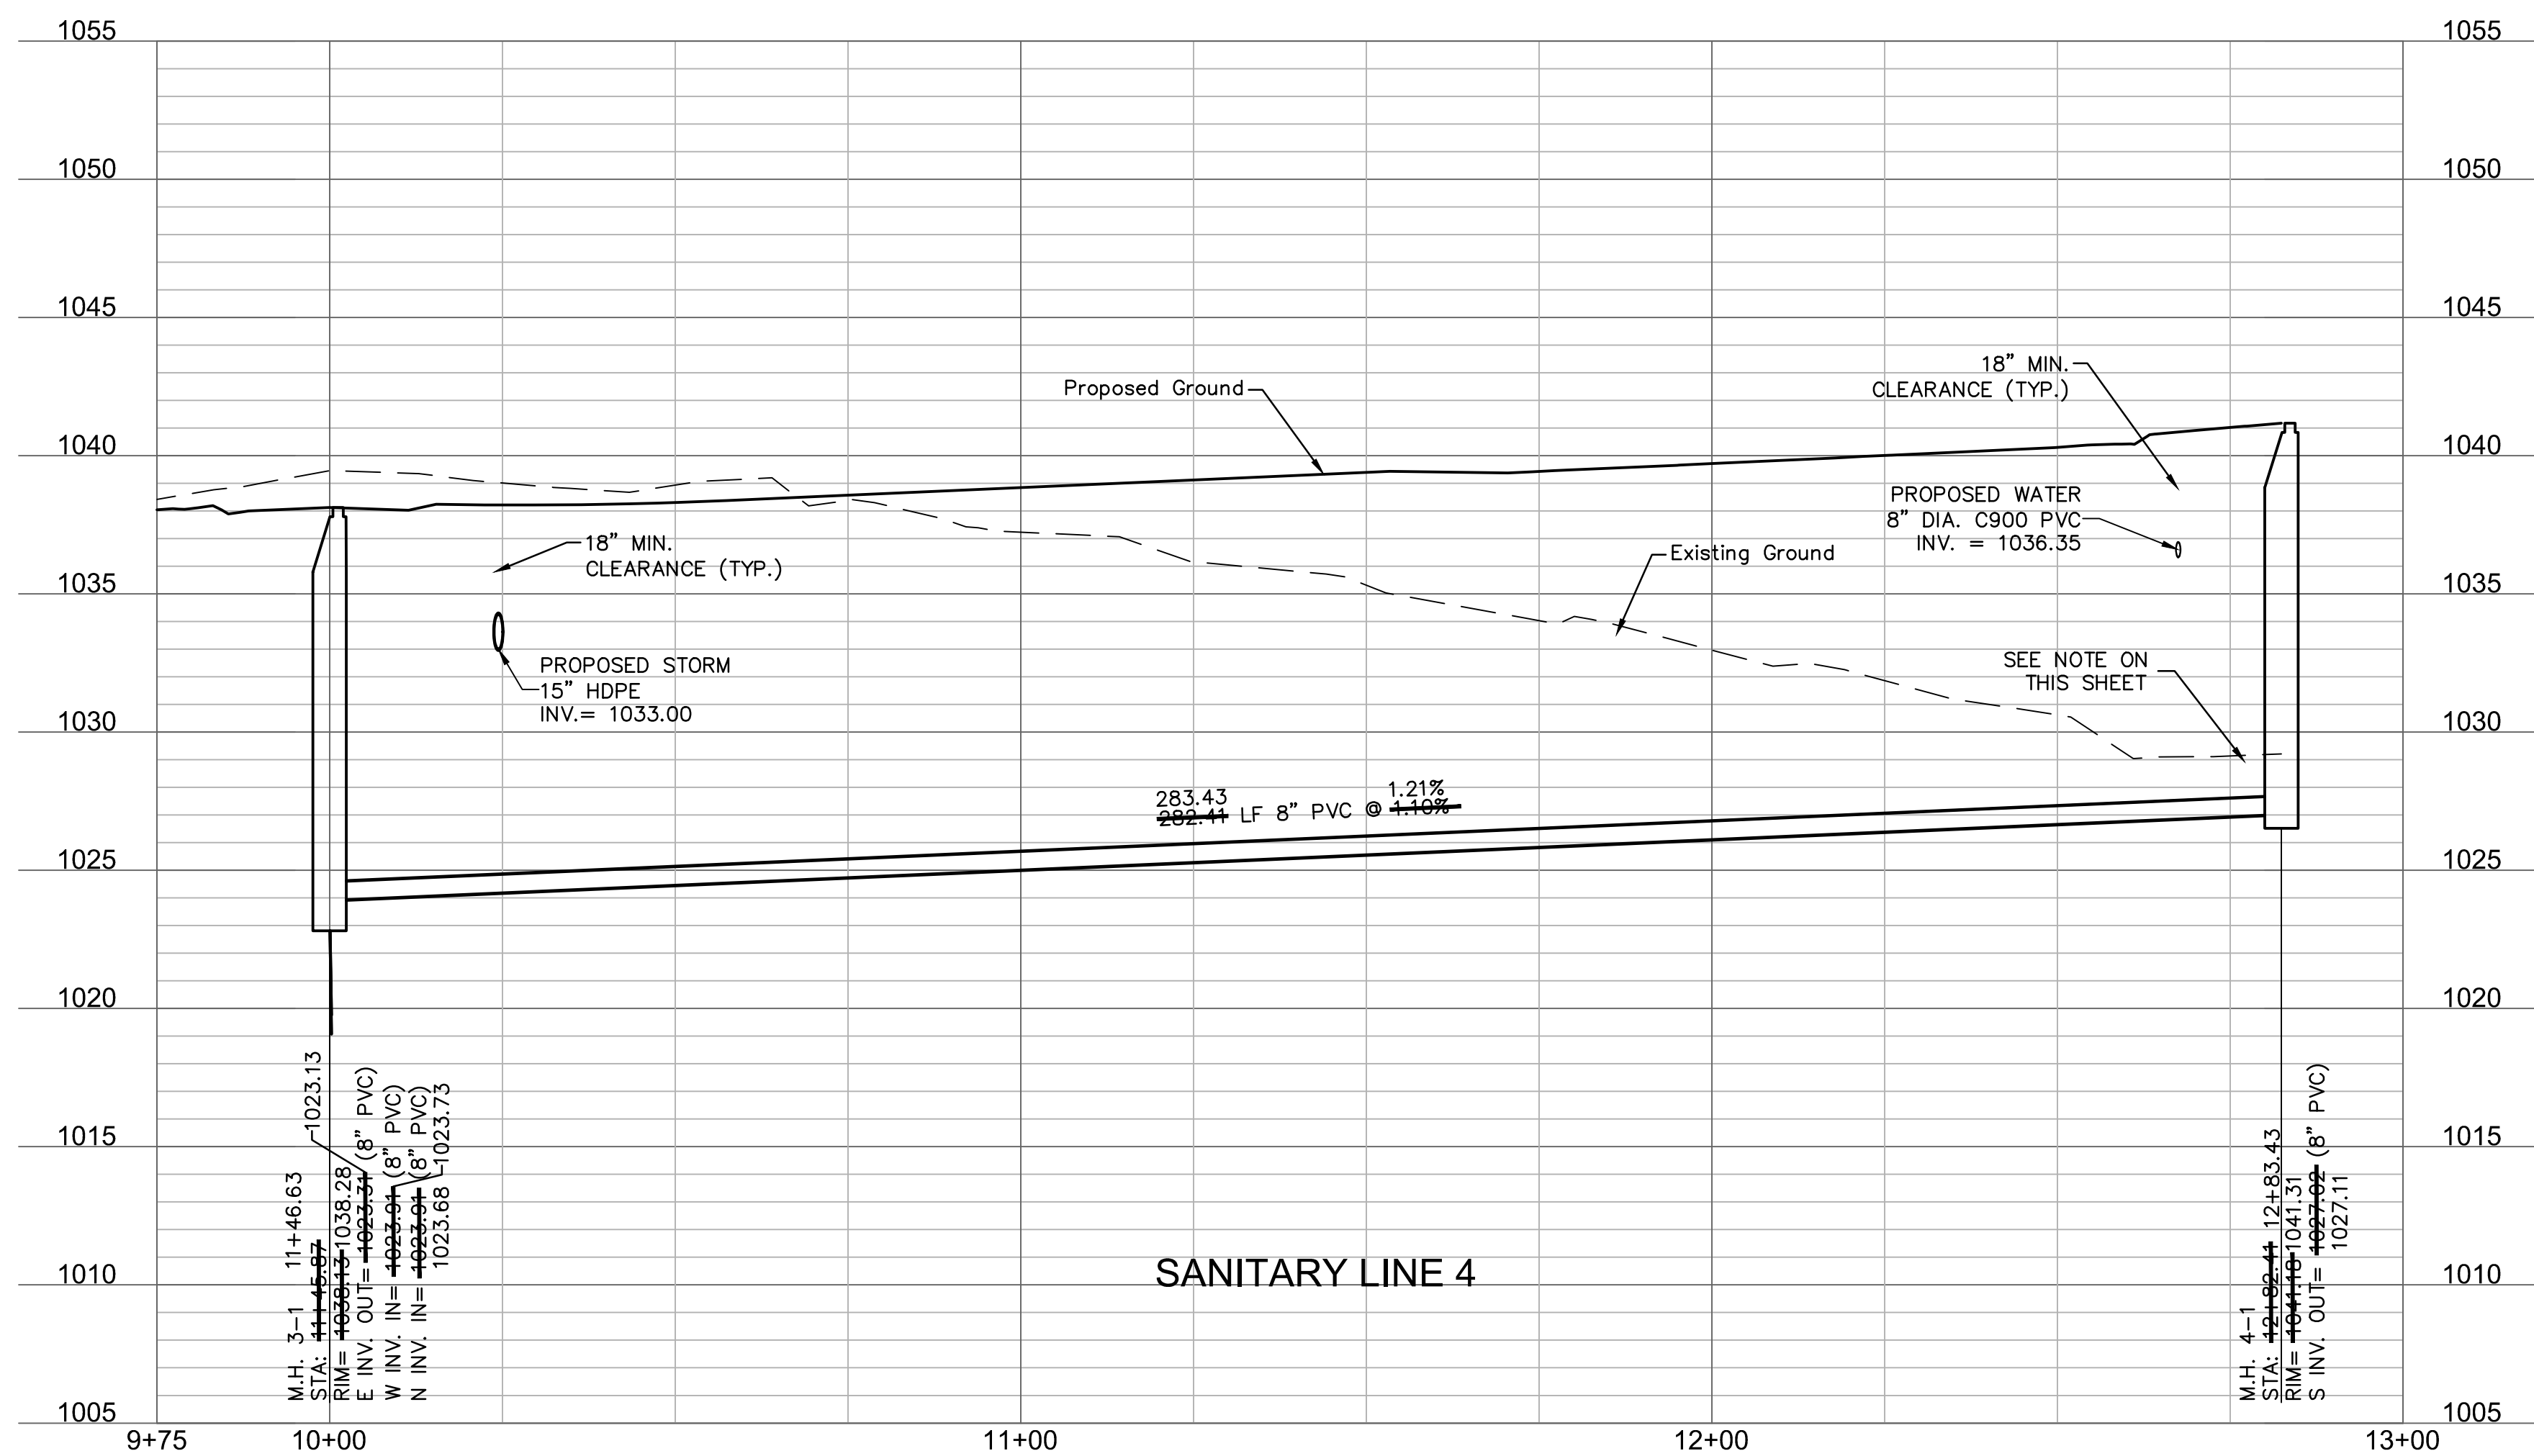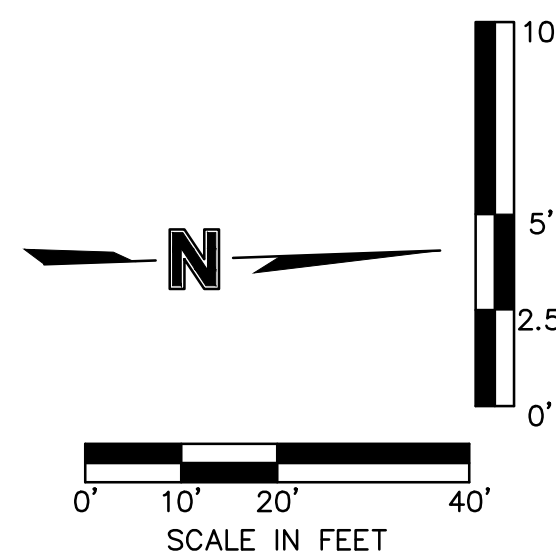

ASBUILT  
1/4/2022

**Accepted  
Record Drawings**

**These plans have been reviewed for accuracy and are accepted for basic conformance to the approved construction drawings.**



Sanitary Sewer Laterals						
Lot Number	Lateral Station	Lateral Length	Riser	Flowline at Main	Flowline at End of Lateral	Minimum Servicable Floor Elevation
		(ft)	(ft)	(ft)	(ft)	(ft)
*160	9+34.53	13.29	0.0	1011.2	1012.5	1015.28
161	10+29.98	13.04	0.0	1012.9	1014.2	1016.95
162	11+04.95	11.14	1.0	1013.6	1015.8	1018.57
163	11+79.94	10.39	2.0	1014.2	1017.4	1020.21
164	12+64.56	13.70	3.0	1015.7	1019.9	1022.67
165	13+46.23	30.43	3.0	1017.0	1021.5	1024.34
166	14+18.51	42.27	3.0	1018.2	1023.0	1025.76
167	15+42.83	46.72	1.0	1020.4	1023.3	1026.13
168	15+62.81	45.70	0.0	1020.6	1022.5	1025.33
169	10+66.57	40.00	1.0	1022.0	1024.8	1027.55
170	11+42.98	40.18	0.0	1025.2	1027.0	1029.83
171	12+15.86	40.84	0.0	1028.9	1030.7	1033.48
172	12+88.82	40.57	1.0	1032.5	1035.3	1038.11
173	13+61.82	40.30	2.0	1036.2	1039.9	1042.73
174	14+34.82	40.03	2.0	1039.8	1043.6	1046.37
175	15+12.90	48.38	3.0	1040.6	1045.5	1048.27
176	15+07.37	100.44	0.0	1040.4	1043.4	1046.19
177	14+59.63	111.41	0.0	1038.8	1042.1	1044.86
178	14+40.61	105.22	0.0	1038.2	1041.3	1044.12
179	13+88.24	46.68	2.0	1035.8	1039.7	1042.48
180	13+17.22	60.67	1.0	1032.3	1035.5	1038.30
181	12+42.81	63.66	2.0	1028.7	1032.9	1035.69
182	11+69.87	66.65	2.0	1025.1	1029.4	1032.18
183	10+94.22	67.68	2.0	1021.8	1026.1	1028.94
184	10+21.25	67.83	2.0	1019.7	1024.0	1026.82
*185	9+52.21	70.78	1.0	1017.5	1020.9	1023.74
186	10+78.08	40.00	1.0	1024.8	1027.5	1030.35
187	11+03.08	40.00	1.0	1025.0	1027.8	1030.62
188	11+71.08	40.00	1.0	1025.8	1028.6	1031.37
189	12+43.95	39.14	1.0	1026.6	1029.4	1032.16
190	12+75.04	16.82	1.0	1026.9	1029.3	1032.05
191	12+70.04	78.70	0.0	1026.9	1029.5	1032.25
192	12+52.79	87.05	0.0	1026.7	1029.4	1032.23
193	10+97.92	40.00	1.0	1025.0	1027.8	1030.57
194	10+72.92	40.00	1.0	1024.7	1027.5	1030.29
195	13+12.22	19.26	7.0	1032.1	1040.3	1043.11
196	14+07.01	39.87	4.0	1038.4	1044.1	1046.94
197	13+22.01	39.55	2.0	1034.2	1037.9	1040.72
198	12+37.01	39.24	1.0	1029.9	1032.7	1035.49
199	11+51.98	39.66	0.0	1025.7	1027.5	1030.27
200	10+70.49	40.05	1.0	1022.1	1024.9	1027.68
201	12+20.23	80.34	1.0	1014.6	1018.2	1020.99
202	11+34.67	79.64	0.0	1013.8	1016.4	1019.22
203	10+52.19	77.55	0.0	1013.1	1015.6	1018.44
*204	9+72.23	76.42	0.0	1011.7	1014.2	1017.01

\*Sanitary sewer lateral installed during 2nd Plat construction.

Information shown reflects design information, not as-built


Sanitary Sewer Design Information											
Upstream Manhole	Downstream Pipe Slope	Downstream Pipe Diameter	Proposed Cumulative Area	Future Cumulative Area	Peak Base Flow	Peak Infiltration Flow	Peak Inflow	Total Peak Flow	Downstream Pipe Mannings N	Downstream Pipe Capacity	Downstream Pipe Full Flow Velocity
	(%)	(in)	(Ac.)	(Ac.)	(gpd)	(gpd)	(cfs)	(cfs)		(cfs)	(fps)
HR2 MH 2-1	1.23%	8	8.10	0.00	12157.33	4052.445	0.238	0.263	0.013	1.34	3.84
MH 1-1	0.90%	8	7.36	0.00	11038.98	3679.660	0.218	0.241	0.013	1.15	3.28
MH 1-2	1.63%	8	5.19	0.00	7788.22	2596.074	0.158	0.175	0.013	1.54	4.43
MH 1-3	1.00%	8	0.60	0.00	902.62	300.872	0.021	0.023	0.013	1.21	3.46
MH 2-1	3.25%	8	3.70	0.00	5547.04	1849.013	0.116	0.127	0.013	2.18	6.24
MH 2-2	5.00%	8	2.68	0.00	4012.64	1337.546	0.086	0.094	0.013	2.70	7.74
HR2 MH 1-6	1.85%	8	7.81	0.00	11714.33	3904.775	0.230	0.254	0.013	1.64	4.71
MH 3-1	2.90%	8	7.13	0.00	10699.86	3566.621	0.212	0.234	0.013	2.06	5.90
MH 3-2	4.90%	8	3.13	0.00	4692.05	1564.015	0.099	0.109	0.013	2.67	7.66
MH 3-3	3.25%	8	1.51	0.00	2261.02	753.673	0.050	0.055	0.013	2.18	6.24
MH 4-1	1.10%	8	3.47	0.00	5203.41	1734.470	0.109	0.120	0.013	1.27	3.63

Accepted  
Record Drawings

These plans have been reviewed for accuracy and are accepted for basic conformance to the approved construction drawings.


NOT ASBUILT



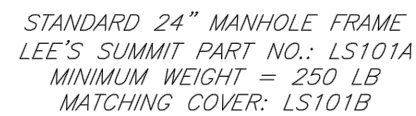


STANDARD 24" MANHOLE FRAME

Date: 09/16/04

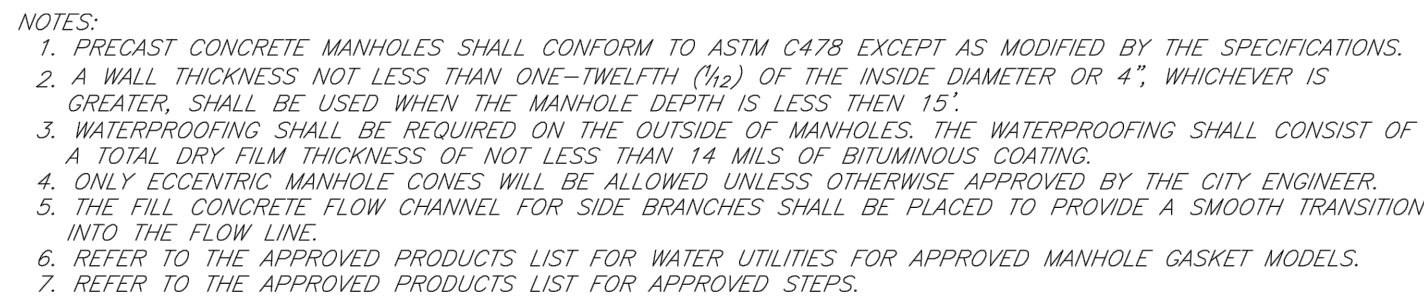


Date: 02/13
Drawn By: JN
Checked By: DL
FILE: SAN-2
Rev: 1/14
Rev:

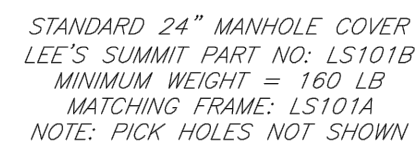


STANDARD 24" MANHOLE COVER

Date: 09/16/04

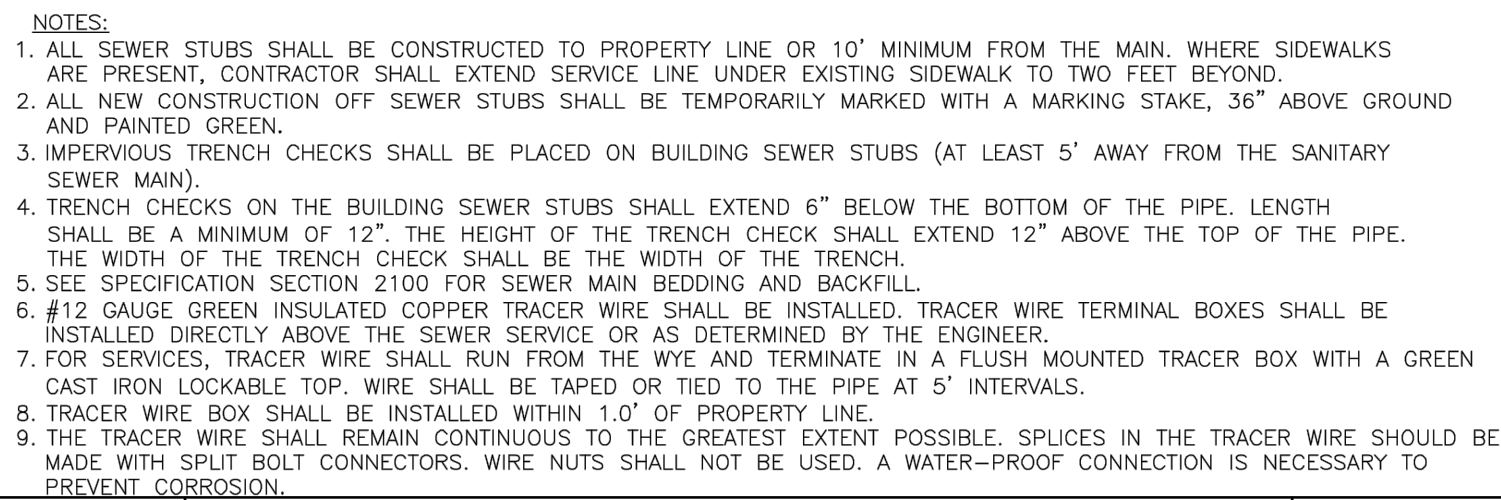

Date: 04/17

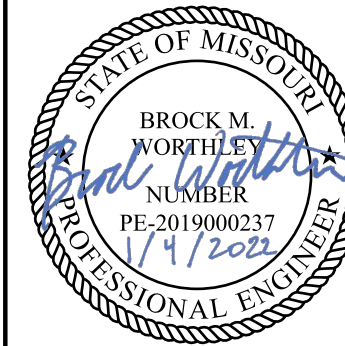

Olsson - Civil Engineering  
Missouri Certificate of Authority #001592  
1301 Burlington Street  
North Kansas City, MO 64116

**olsson**

TEL 816.361.1177      www.olsson.com

## REVISIONS

2020

LEE'S SUMMIT, MO

## SANITARY DETAILS

## SANITARY SEWER PLANS

HAWTHORN RIDGE  
THIRD PLAT

drawn by: \_\_\_\_\_ OLS  
checked by: \_\_\_\_\_ BMW  
approved by: \_\_\_\_\_ BMW  
QA/QC by: \_\_\_\_\_ JES  
project no.: \_\_\_\_\_ A19-1605  
drawing no.: C DTL01 A191605  
date: \_\_\_\_\_ 10/02/2020


SHEET  
C209

**Accepted  
Record Drawings**

**These plans have been reviewed for accuracy and are accepted for basic conformance to the approved construction drawings.**

NOT ASBUILT



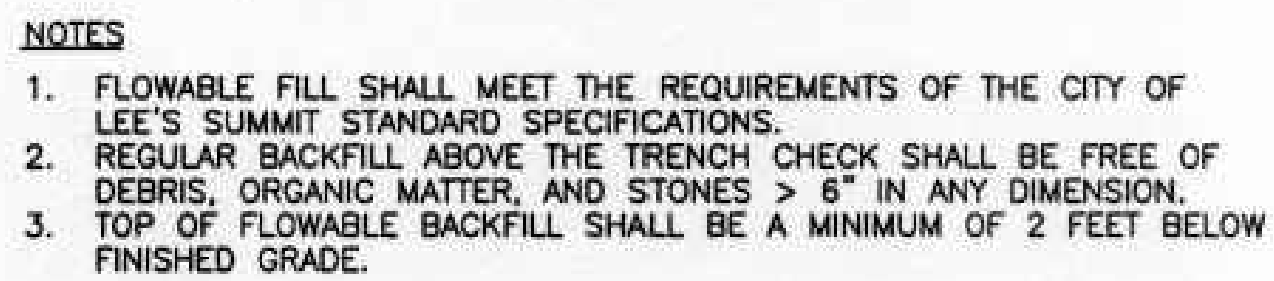

### TRENCH CHECK

Rev



1. A MINIMUM OF 36 INCHES OF COVER SHALL BE OVER THE TOP OF THE PIPE. THIS MINIMUM OF COVER SHALL BE FROM THE TOP OF PIPE TO THE FINISHED GRADE.
2. BEDDING AGGREGATE MATERIAL SHALL BE PER SECTION 6900 AND 2102 OF THE CITY DESIGN AND CONSTRUCTION MANUAL. BEDDING AGGREGATE SHALL BE PLACED FROM A LEVEL 6 INCHES BELOW THE BOTTOM OF THE PIPE TO A LEVEL 12 INCHES ABOVE THE TOP OF THE PIPE.
3. BACKFILL MATERIAL AND PLACEMENT SHALL BE PER SECTION 6900 AND 2102 OF THE CITY DESIGN AND CONSTRUCTION MANUAL.
4. TRENCHING SHALL BE IN ACCORDANCE WITH CURRENT OSHA REGULATIONS. SLOPES MUST NOT EXTEND BELOW TOP OF BEDDING.
5. MINIMUM AND MAXIMUM TRENCH WIDTHS SHALL BE IN ACCORDANCE WITH PIPE MANUFACTURERS RECOMMENDATION AS APPROVED ON ENGINEERING PLANS.

**These plans have been reviewed for accuracy and are accepted for basic conformance to the approved construction drawings.**