

LOT 10 LAKEWOOD BUSINESS PARK

LOT 10 I-470 BUSINESS & TECHNOLOGY CENTER
2601 NE MCBAIN DRIVE
LEE'S SUMMIT, MO 64064

ISSUED FOR: FINAL DEVELOPMENT PLAN
CITY COMMENTS #03 - 01/12/2022



POWELL C W M
ARCHITECTURE/ENGINEERING/SURVEYING
3200 S. State Route 297, Bldg. 1, Independence, MO 64057
(816) 373-4800 | powellcwm.com

Certificates of Authority
Architecture: MO 310 / KS 73
Engineering: MO 41 / KS 241
Land Surveying: MO 123 / KS 36

CLIENT
DAVID WARD
WARD DEVELOPMENT
1120 EAGLE RIDGE BLVD
GRAIN VALLEY, MO 64029
david@safetyminstorage.com

LOT 10 LAKEWOOD
BUSINESS PARK
LOT 10 I-470 BUSINESS PARK
LEE'S SUMMIT, MO 64064

GENERAL NOTES

- CONTRACTOR SHALL VISIT THE SITE, FAMILIARIZE THEMSELVES WITH EXISTING CONDITIONS AND OWNER REVIEW AND UNDERSTAND THE REQUIREMENTS OF THE CONTRACT DOCUMENTS. CONTRACTOR SHALL VERIFY ALL DIMENSIONS, ELEVATIONS AND CONDITIONS PRIOR TO BEGINNING ANY WORK AND SHALL NOTIFY THE ARCHITECT OF ANY DISCREPANCY. DO NOT SCALE DRAWINGS. CONTRACTOR SHALL BE RESPONSIBLE FOR ALL CORRECTIONS AND REPAIRS REQUIRED DUE TO THEIR FAILURE TO DO SO. GENERAL CONTRACTOR SHALL BE RESPONSIBLE TO ENSURE THAT ALL SUB-CONTRACTORS RECEIVE ALL ARCHITECTURAL, STRUCTURAL, MECHANICAL, PLUMBING AND ELECTRICAL DRAWINGS.
- SOLELY AS A CONVENIENCE TO THE OWNER AND CONTRACTOR, THE ARCHITECT MAY INCLUDE DOCUMENTS PREPARED BY CERTAIN CONSULTANTS (OR INCORPORATE THE RECOMMENDATIONS OF SAID CONSULTANTS INTO DOCUMENTS PREPARED BY THE ARCHITECT) WITHIN THE SET OF DOCUMENTS ISSUED BY THE ARCHITECT. IT IS EXPRESSLY UNDERSTOOD, THAT BY SUCH ISSUANCE, THE ARCHITECT ASSUMES NO LIABILITY FOR THE SERVICES OF SAID CONSULTANTS.
- ALL WORK AND MATERIALS SHALL CONFORM TO THE APPLICABLE CODES LISTED IN THE PROJECT CODE SUMMARY.
- UNLESS OTHERWISE INDICATED ON THESE DRAWINGS AND SPECIFICATIONS AS BEING N.I.C. OR EXISTING, ALL ITEMS, MATERIALS, ETC. AND INSTALLATIONS OF THE SAME ARE A PART OF THE CONTRACT DEFINED BY THESE DRAWINGS AND SPECIFICATIONS AND THEIR INTENT.
- CONTRACTOR SHALL ASSUME SOLE AND COMPLETE RESPONSIBILITY FOR JOB SITE CONDITIONS AND COMPLY WITH SAFETY REGULATIONS AND RESTRICTIONS AS REQUIRED FOR WORKERS AND PEDESTRIAN PROTECTION DURING THE COURSE OF CONSTRUCTION OF THIS PROJECT. PROVIDE PROTECTION AS REQUIRED TO PREVENT ANY DAMAGE TO EXISTING CONSTRUCTION WITHIN AND ADJACENT TO JOB SITE. WHERE DAMAGE OCCURS, THE CONTRACTOR SHALL REPAIR OR REPLACE DAMAGED AREA AND/OR MATERIAL AS REQUIRED TO THE OWNER'S APPROVAL AT NO ADDITIONAL COST. THIS REQUIREMENT SHALL APPLY CONTINUOUSLY AND MAY NOT BE LIMITED TO NORMAL WORKING HOURS. PROVIDE SECURITY FENCE AND GATES AS NECESSARY AROUND THE AREA WITHIN THE SCOPE OF WORK.
- IF THERE ARE TRENCHES OR EXCAVATION 5'-0" OR MORE IN DEPTH INTO WHICH A PERSON IS REQUIRED TO DESCEND, CONTRACTOR SHALL OBTAIN NECESSARY PERMIT FROM THE APPROPRIATE LOCAL GOVERNING AGENCY.
- PROVIDE ALL LABOR, MATERIALS, EQUIPMENT, TOOLS, TRANSPORTATION, UTILITIES, OTHER SERVICES AND RELATED TASKS NECESSARY FOR PROPER EXECUTION OF THE CONSTRUCTION REQUIRED BY CONTRACT DOCUMENTS.
- ANY REVISION OR ADDITIONAL WORK REQUIRED BY FIELD CONDITIONS OR LOCAL GOVERNING AUTHORITIES SHALL BE BROUGHT TO THE ATTENTION OF THE ARCHITECT BEFORE PROCEEDING.
- THE CONTRACTOR SHALL BE RESPONSIBLE FOR OBTAINING AND PAYING FOR ALL PERMITS, LICENSES, INSPECTIONS AND TESTING INDICATED ON THE PLANS AND BY SPECIFICATIONS OR REQUIRED BY THE SOILS REPORT AND/OR REQUIRED BY ANY GOVERNMENT AGENCY.
- CONTRACTOR SHALL VERIFY THE SIZE AND LOCATION OF ALL UTILITY LINES AND STUBS TO THE BUILDING(S) AS MAY BE INDICATED ON THE PLANS.
- NO ADDITIONAL ROOF OPENING OR ROOF MOUNTED EQUIPMENT IS ALLOWED BEYOND THAT WHICH IS SHOWN ON THESE PLANS WITHOUT WRITTEN CONSENT OF THE ARCHITECT AND STRUCTURAL ENGINEER.
- NO STRUCTURAL MEMBER SHALL BE CUT FOR PIPES, HVAC DUCTS, ETC., UNLESS SPECIFICALLY DETAILED AND/OR APPROVED BY THE ARCHITECT AND STRUCTURAL ENGINEER.
- ALL SHOP WELDING TO BE DONE IN A CERTIFIED LICENSED SHOP. ALL FIELD WELDING SHALL BE DONE ONLY BY CERTIFIED WELDERS UNDER CONTINUOUS INSPECTION WITH CERTIFICATE ISSUED AS REQUIRED BY BUILDING OFFICIAL.
- WHERE LARGER STUDS OR FURRING IS REQUIRED TO COVER DUCTS, PIPING, CONDUIT, ETC., THE LARGER SIZE STUD OR FURRING SHALL EXTEND THE FULL LENGTH OF THE SURFACE WHERE THE FURRING OCCURS.
- NO HAZARDOUS MATERIALS WILL BE STORED AND/OR USED WITHIN THE BUILDING WHICH EXCEED THE QUANTITIES ALLOWED BY CODE.
- INSTALLATION OF ANY BUILDING INSULATION WHICH CONTAINS OR UTILIZES AN OZONE DEPLETING COMPOUND IS PROHIBITED.
- NO BUILDING OR PORTION OF A BUILDING SHALL BE OCCUPIED OR USED FOR STORAGE PRIOR TO THE ISSUANCE OF THE CERTIFICATE OF OCCUPANCY.
- THE BUILDING AND FACILITIES MUST BE ACCESSIBLE TO AND FUNCTIONAL FOR THE PHYSICALLY DISABLED IN ACCORDANCE WITH AMERICANS WITH DISABILITIES ACT (ADA) AND ALL OTHER STATE/FEDERAL GOVERNING AGENCIES.

CONSTRUCTION NOTES

- ALL WORK PERFORMED SHALL BE IN ACCORDANCE WITH THE BUILDING CODE OF THE AUTHORITY HAVING JURISDICTION AND THE RULES AND REGULATIONS OF ALL AGENCIES, DEPARTMENTS AND COMMISSIONS HAVING JURISDICTION. WHERE DISCREPANCIES OCCUR AND/OR WHERE THERE ARE CONFLICTS OR OMISSIONS IN THE DRAWINGS AND APPLICATIONS, THE CONTRACTOR SHALL NOTIFY THE ARCHITECT IMMEDIATELY AND REFRAIN FROM STARTING AND COMPLETING SUCH WORK, OR DEPENDENT WORK, UNTIL TOLD BY THE ARCHITECT TO PROCEED.
- THE CONTRACTOR SHALL VERIFY ALL DIMENSIONS AND EXISTING CONDITIONS IN THE FIELD PRIOR TO COMMENCING WORK, AND SHALL REPORT TO THE ARCHITECT ANY CONDITION OR DISCREPANCY BETWEEN DRAWINGS AND FIELD CONDITIONS REQUIRING MODIFICATIONS BEFORE PROCEEDING WITH THE WORK.
- MINOR DETAILS NOT USUALLY SHOWN OR SPECIFIED, BUT NECESSARY FOR PROPER CONSTRUCTION OF ANY PART OF THE WORK SHALL BE INCLUDED AS IF THEY WERE INDICATED IN THE DRAWINGS.
- REFERENCING OF DRAWINGS IS FOR CONVENIENCE ONLY AND DOES NOT LIMIT APPLICATION OF ANY DRAWING.
- THE CONTRACTOR SHALL BE RESPONSIBLE FOR THE PROTECTION OF ALL CONDITIONS AND MATERIALS WITHIN THE PROPOSED CONSTRUCTION AREAS. THE CONTRACTOR SHALL DESIGN AND INSTALL ADEQUATE SHORING AND BRACING FOR ALL STRUCTURAL OR REMOVAL TASKS. THE CONTRACTOR SHALL HAVE SOLE RESPONSIBILITY FOR ANY DAMAGE OR INJURIES CAUSED BY OR DURING THE EXECUTION OF THE WORK.
- NOTES APPEAR ON VARIOUS SHEETS FOR VARIOUS SYSTEMS AND MATERIALS. SHEETS ARE TO BE OWNER REVIEWED AND NOTES ON ANY ONE SHEET ARE TO BE APPLIED TO RELATED SYSTEMS AND MATERIALS DEPICTED ON OTHER DRAWINGS.
- DETAILS NOT SHOWN ARE SIMILAR IN CHARACTER TO THOSE THAT ARE, WHERE SPECIFIC DIMENSIONS, DETAILS, OR DESIGN INTENT CANNOT BE DETERMINED, CONSULT THE ARCHITECT BEFORE PROCEEDING WITH THE WORK.
- THE CONTRACTOR SHALL LAY OUT HIS OWN WORK, AND SHALL PROVIDE ALL DIMENSIONS REQUIRED FOR OTHER TRADES.
- THE CONTRACTOR SHALL DO ALL CUTTING, PATCHING AND REPAIRING AS REQUIRED TO PERFORM ALL OF THE WORK INDICATED ON THE DRAWINGS, AND ALL OTHER WORK THAT MAY BE REQUIRED TO COMPLETE THE JOB.
- GUTTER AND DOWNSPOUT SIZING PER OWNER'S CONTRACTOR.


INSTRUCTION TO CONTRACTOR

- THE INTENT OF THE SET OF CONTRACT DOCUMENTS IS TO INCLUDE ALL ITEMS NECESSARY FOR THE PROPER EXECUTION AND COMPLETION OF THE WORK BY THE CONTRACTOR AS BINDING PERFORMANCE. THE CONTRACTOR SHALL BE REQUIRED ONLY TO THE EXTENT CONSISTENT WITH THE CONTRACT DOCUMENTS AND SPECIFICATIONS REASONABLY INFERRABLE FROM THEM AS BEING NECESSARY TO PRODUCE THE INDICATED RESULTS.
- ORGANIZATION OF THE SPECIFICATIONS INTO DIVISIONS, SECTIONS AND ARTICLES, ARRANGEMENT OF DRAWINGS SHALL NOT CONTROL THE CONTRACTOR, IN DIVIDING THE WORK AMONG SUBCONTRACTORS OR IN ESTABLISHING THE EXTENT OF WORK TO BE PERFORMED BY ANY TRADE.
- UNLESS OTHERWISE STATED IN THE CONTRACT DOCUMENTS, WORDS WHICH HAVE WELL-KNOWN TECHNICAL OR CONSTRUCTION INDUSTRY MEANINGS ARE USED IN THE CONTRACT DOCUMENTS IN ACCORDANCE WITH SUCH RECOGNIZED MEANINGS.
- GENERAL CONTRACTOR AND ELECTRICAL SUBCONTRACTOR TO FULLY COORDINATE ALL ELECTRICAL DEVICE BODIES AND COVER PLATES PER THE SPECIFICATIONS. DEVICE BODIES AND COVER PLATES ARE COLOR COORDINATED WITH SPECIALTY FINISHES. PROVIDE DEVICE BODY AND COVER PLATES TO THE ARCHITECT FOR OWNER REVIEW AND APPROVAL.
- GENERAL CONTRACTOR TO FULLY COORDINATE WITH MECHANICAL/PLUMBING SUBCONTRACTORS. ALL FIXTURE/DEVICE COLORS WHERE FIXTURE/DEVICE UNITS ARE PLACED WITHIN WALLS AND CEILING ASSEMBLIES VS ADJACENT MATERIAL FINISH COLOR.

SHEET INDEX

#	SHEET NAME	PERMIT - 2021.09.24	CITY COMMENTS 01 - 2021.11.11	CITY COMMENTS 02 - 2021.12.22	CITY COMMENTS 03 - 2022.01.12
GENERAL					
G-100-BP	COVER SHEET - BUILDING PERMIT	X	X		
G-100-FDP	COVER SHEET - FINAL DEV. PLAN			X	D
CIVIL					
C-001	COVER SHEET	X	X	X	X
C-101	DEMOLITION PLAN	X	X	X	X
C-121	EROSION CONTROL PLAN PHASE 1	X	X	X	X
C-122	EROSION CONTROL PLAN PHASE 2	X	X	X	X
C-123	EROSION CONTROL PLAN PHASE 3	X	X	X	X
C-131	EROSION CONTROL DETAILS	X	X	X	X
C-132	EROSION CONTROL DETAILS	X	X	X	X
C-201	DIMENSION PLAN	X	X	X	D
C-202	ADA RAMP DETAILS		X	X	
C-301	GRADING PLAN	X	X	X	D
C-302	ADA RAMP GRADING DETAILS		X	X	
C-401	UTILITY PLAN	X	X	X	X
C-411	STORM PROFILES	X	X	X	X
C-421	DRAINAGE AREA MAP	X	X	X	X
C-501	DETAILS	X	X	X	X
LANDSCAPE					
L-100	LANDSCAPE PLAN	X	X	X	
ARCHITECTURAL					
A-001	LIFE SAFETY AND CODE SHEET	X	X	X	
A-002	ROOF DRAINAGE PLAN	X	X	X	
A-100	OVERALL MAIN LEVEL FLOOR PLAN	X	X	X	
A-110	MAIN LEVEL FLOOR PLAN - AREA A	X	X	X	
A-111	MAIN LEVEL FLOOR PLAN - AREA B	X	X	X	
A-130	ENLARGED PLANS	X	X	X	
A-200	ROOF PLAN	X	X	X	
A-301	EXTERIOR ELEVATIONS	X	X	X	
A-400	WALL SECTIONS & DETAILS	X	X	X	
A-401	PERSPECTIVES	X	X	X	
STRUCTURAL					
S001	STRUCTURAL GENERAL NOTES	X	X	X	
S100	FOUNDATION PLAN	X	X	X	
S101	FOUNDATION PLAN	X	X	X	
MECHANICAL/PLUMBING					
MP001	MECHANICAL AND PLUMBING SPECIFICATIONS AND SYMBOLS	X	X	X	
MP002	MECHANICAL AND PLUMBING SCHEDULES AND DETAILS	X	X	X	
MECHANICAL					
M-101	MECHANICAL PLAN WEST	X	X	X	
M-102	MECHANICAL PLAN EAST	X	X	X	
PLUMBING					
P-101	PLUMBING PLAN WEST	X	X	X	
P-102	PLUMBING PLAN EAST	X	X	X	
ELECTRICAL					
E-001	ELECTRICAL SPECIFICATIONS AND SYMBOLS	X	X	X	X
E-002	PHOTOMETRIC PLAN	X	X	X	X
E-003	PHOTOMETRIC PLAN	X	X	X	X
E-101	ELECTRICAL PLAN - WEST	X	X	X	
E-102	ELECTRICAL PLAN - EAST	X	X	X	
E-201	ELECTRICAL EQUIPMENT POWER PLAN - WEST	X	X	X	
E-202	ELECTRICAL EQUIPMENT POWER PLAN - EAST	X	X	X	
E-301	ELECTRICAL SCHEDULES AND DIAGRAMS	X	X	X	X

VICINITY MAP

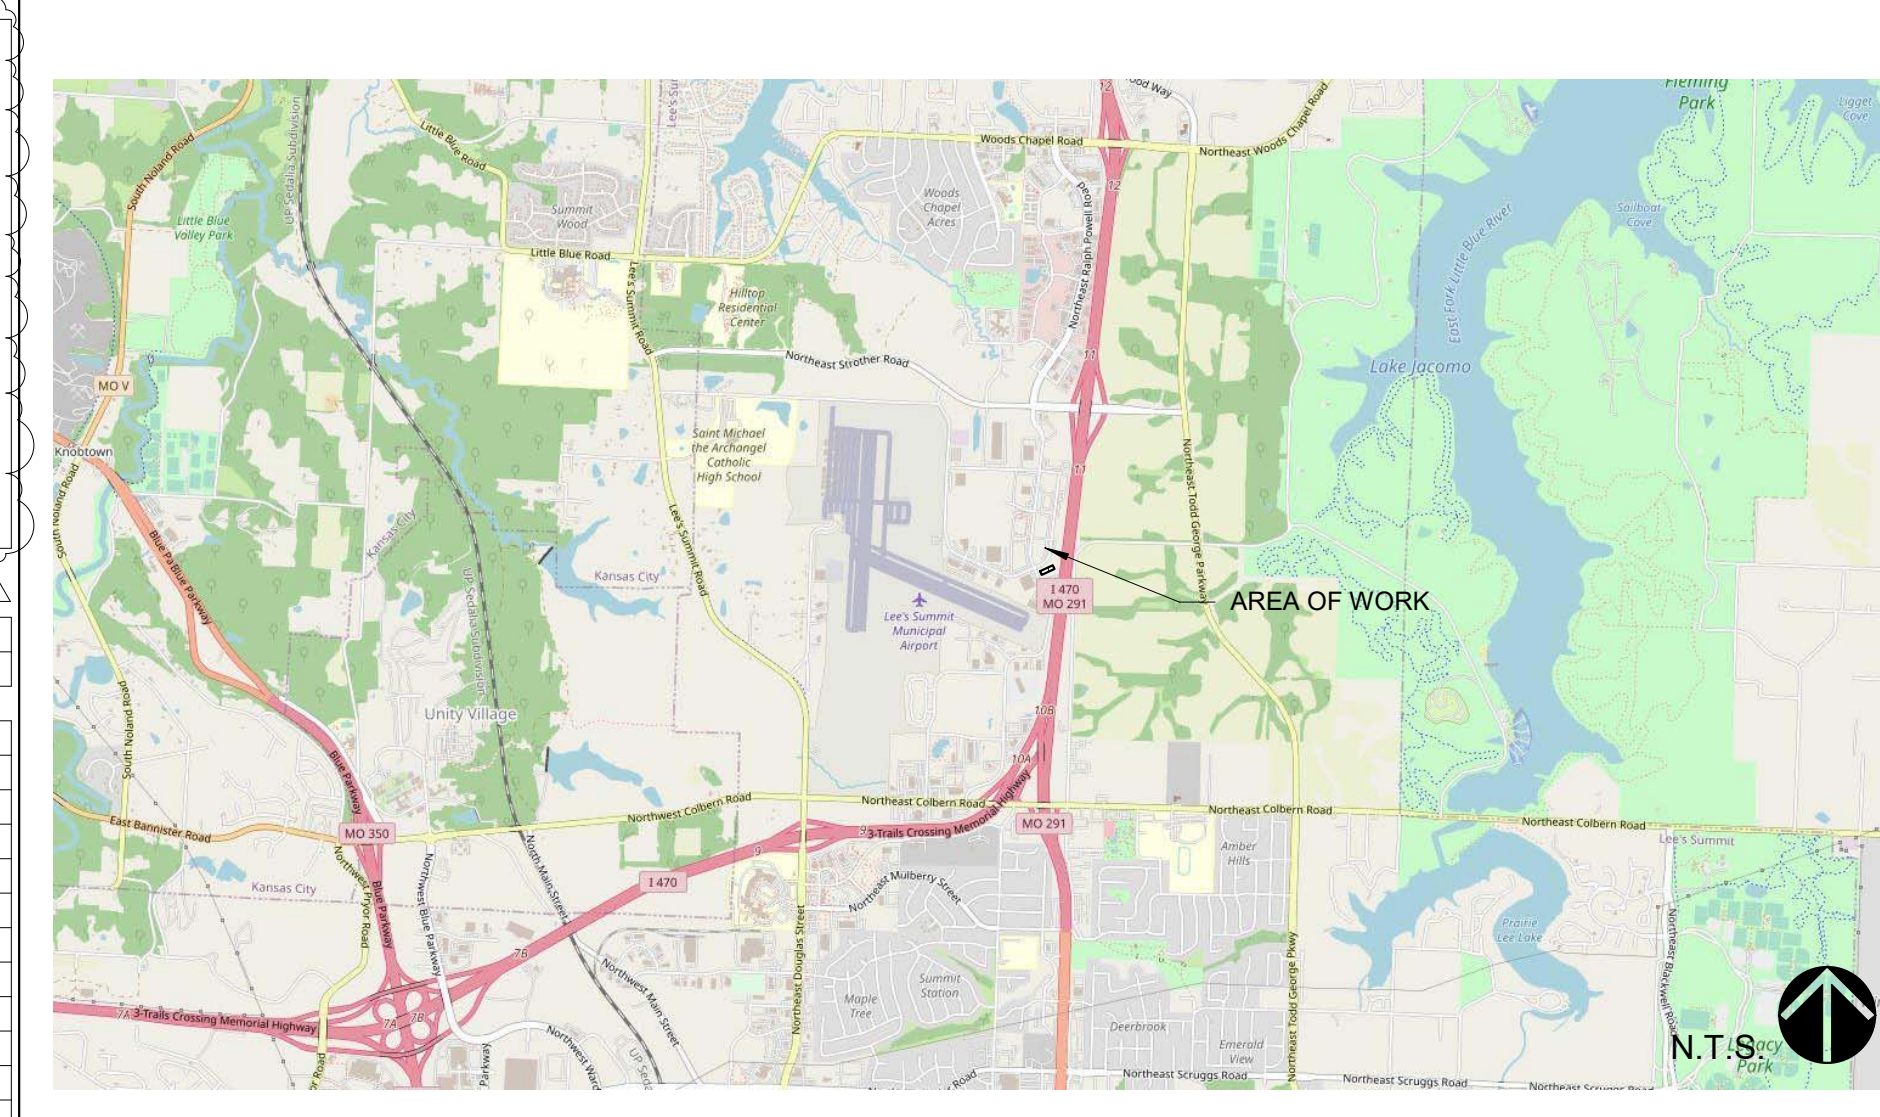

PROJECT DIRECTORY

OWNER
DAVID WARD
WARD DEVELOPMENT
1120 EAGLE RIDGE BLVD
GRAIN VALLEY, MO 64029
PHONE: 816-229-8115
EMAIL: DAVID@SAFETYMINSTORAGE.COM

STRUCTURAL ENGINEER

STAND SEI
8234 ROBINSON ST.
OVERLAND PARK, KS 66204
NAME: PAUL SPEARS, STRUCT. ENGINEER
PHONE: (913) 214-2169
EMAIL:

MECHANICAL / ELECTRICAL / PLUMBING ENGINEER

JSC ENGINEERS
1901 NW BLUE PKWY, 3RD FLOOR
UNITY VILLAGE, MO 64065
NAME: JUSTIN SMOTHERS, MEP ENGINEER
PHONE: (816) 272-5289
EMAIL: JSMOTHERS@JSCENGINEERS.COM

ARCHITECT / CIVIL ENGINEER

POWELL C W M
ARCHITECTURE/ENGINEERING/SURVEYING
1100 S. Loop West 210, Bldg. 1, Independence, MO 64057
816.373.4800 | powellcwm.com

NAME: NICK CURTIS, ARCHITECT
PHONE: 816.373.4800
EMAIL: NCURTIS@POWELLCWM.COM

NAME: TOBY WILLIAMS, CIVIL ENGINEER
PHONE: 816.373.4800
EMAIL: TWILLIAMS@POWELLCWM.COM

RELEASED FOR CONSTRUCTION
As Noted on Plans Review
Development Services Department
Lee's Summit, Missouri
01/14/2022

© 2021 Powell CWM, Inc. This drawing has been prepared by Powell CWM, Inc. The drawing is provided as an instrument of service by Powell CWM, Inc. and is intended for use on this project only. Pursuant to the Architectural Works Copyright Protection Act of 1990, all drawings, specifications, notes and designs, including the overall form, arrangement and composition of spaces and elements appearing herein constitute the original, copyrighted work of Powell CWM, Inc. Any reproduction, use, or disclosure of information contained herein without prior written consent of Powell CWM, Inc. is strictly prohibited.

NO.	REVISIONS	DATE
1	DESCRIPTION: COMMENTS #01	11/12/2021
2	FDP - CITY COMMENTS #02	12/22/2021
3	FDP - CITY COMMENTS #03	01/12/2022

DRAWN BY: NC
CHECKED BY: NC
PROJECT #: 21-1902
ISSUE DATE: 2021.09.24
ISSUED FOR: PERMIT

COVER SHEET - FINAL DEV. PLAN
G-100-FDP

Lot 10 I-470 BUSINESS AND TECHNOLOGY CENTER

GENERAL NOTES


- THE CONSTRUCTION COVERED BY THESE PLANS SHALL CONFORM TO ALL APPLICABLE STANDARDS AND SPECIFICATIONS OF THE PUBLIC WORKS DEPARTMENT OF THE CITY OF LEE'S SUMMIT, MISSOURI, IN CURRENT USAGE AND ALL SUPPLEMENTS THERE TO.
- REFER TO THE CURRENT VERSION OF THE KC METRO CHAPTER AMERICAN PUBLIC WORKS ASSOCIATION, STANDARD SPECIFICATIONS & INSTALLATION FOR THE GUIDING REFERENCE AS WELL MDNR.
- DO NOT SCALE THESE DRAWINGS.
- NO GEOLOGICAL INVESTIGATION WAS PERFORMED ON THIS SITE.
- CONTRACTOR IS RESPONSIBLE FOR ALL PERMITS, BONDS, AND INSURANCE REQUIRED BY THE CITY.
- THE UTILITY LOCATIONS SHOWN ON THESE PLANS ARE TAKEN FROM UTILITY COMPANY RECORDS AND ARE APPROXIMATE ONLY. THEY DO NOT CONSTITUTE ACTUAL FIELD LOCATIONS. THE CONTRACTOR SHALL VERIFY THE LOCATION AND DEPTH OF ALL UTILITIES PRIOR TO CONSTRUCTION.
- CLEARING AND GRUBBING OPERATIONS AND DISPOSAL OF ALL DEBRIS THEREFROM SHALL BE PERFORMED BY THE CONTRACTOR IN STRICT ACCORDANCE WITH ALL STATE AND LOCAL CODES.
- THE DEVELOPER / OWNER SHALL CONTROL EROSION AND SILTATION DURING ALL PHASES OF CONSTRUCTION, AND SHALL KEEP THE STREETS CLEAN OF MUD AND DEBRIS.
- ALL EXCESS MATERIAL SHALL BE REMOVED LEGALLY FROM SITE AND DISPOSED OF OFF SITE.
- TRAFFIC CONTROL AND MAINTENANCE OF TRAFFIC DURING CONSTRUCTION SHALL BE THE RESPONSIBILITY OF THE CONTRACTOR AND SHALL BE IN ACCORDANCE WITH THE REQUIREMENTS OF THE PUBLIC WORKS DEPARTMENT.
- EROSION CONTROL MEASURES SHALL BE PROVIDED AT ALL LOCATIONS WHERE DRAINAGE IS LEAVING THE PROJECT SITE. THE EROSION CONTROL PLAN SHOWS MINIMUM EROSION CONTROL MEASURES TO BE PROVIDED. ADDITIONAL SITE SPECIFIC MEASURES MAY BE NECESSARY AND SHALL BE PROVIDED BY THE DEVELOPER / OWNER, AT THE CONTRACTOR'S EXPENSE.
- ANY EXISTING OR NEW STORM SEWER INLETS IN USE DURING DEMOLITION, GRADING OR CONSTRUCTION SHALL HAVE INLET PROTECTION.
- THE CONTRACTOR SHALL FIELD VERIFY ALL SITE CONDITIONS AND SHALL REPORT ANY DISCREPANCIES BETWEEN ACTUAL AND PLAN SHOWN CONDITIONS TO THE ENGINEER PRIOR TO BEGINNING CONSTRUCTION.
- THE CONTRACTOR SHALL VERIFY ALL DIMENSIONS AND QUANTITIES SHOWN ON THESE PLANS AND SHALL REPORT ANY DISCREPANCIES TO THE ENGINEER PRIOR TO COMMENCING ANY RELATED WORK. THE CONTRACTOR SHALL BE SOLELY RESPONSIBLE FOR DETERMINING THE LOCATION OF ALL EXISTING UTILITIES AND UNDERGROUND INSTALLATIONS, INCLUDING SERVICE CONNECTIONS, IN ADVANCE OF EXCAVATION OR TRENCHING, AND PROTECT THE SAME AS REQUIRED TO MAINTAIN GOOD OPERATING CONDITION.
- THE CONTRACTOR SHALL USE HIS OWN INFORMATION AND NOT RELY UPON ANY INFORMATION SHOWN ON THE DRAWINGS CONCERNING EXISTING UNDERGROUND INSTALLATIONS.
- ANY DELAY, ADDITIONAL WORK, OR EXTRA COST TO THE CONTRACTOR CAUSED BY OR RESULTING FROM DAMAGE TO EXISTING UNDERGROUND INSTALLATIONS SHALL NOT CONSTITUTE A CLAIM FOR EXTRA WORK, ADDITIONAL PAYMENT, OR DAMAGES. ALL DAMAGE TO EXISTING UTILITIES INCLUDING SERVICE CONNECTIONS SHALL BE REPAIRED BY AND AT THE EXPENSE OF THE CONTRACTOR.
- THE CONTRACTOR SHALL OBTAIN ALL NECESSARY PERMITS PRIOR TO BEGINNING CONSTRUCTION ACTIVITIES AND OBTAIN ALL NECESSARY INSPECTIONS THROUGHOUT THE CONSTRUCTION ACTIVITIES.
- ALL EXCAVATION SHALL BE UNCLASSIFIED. NO SEPARATE PAYMENT WILL BE MADE FOR ROCK EXCAVATION.
- CONTRACTOR SHALL BE RESPONSIBLE FOR ALL RELOCATIONS, INCLUDING BUT NOT LIMITED TO ALL UTILITIES, STORM DRAINAGE, AND SIGNS AS REQUIRED, ALL WORK SHALL BE IN ACCORDANCE WITH THE GOVERNING AUTHORITIES' SPECIFICATIONS AND SHALL BE APPROVED BY SUCH. ALL COST SHALL BE INCLUDED IN THE CONTRACT WITH THE OWNER. ADDITIONALLY, ALL EXISTING UTILITY TOPS SHALL BE ADJUSTED TO FINISHED GRADE.
- REMOVAL OF EXISTING PAVING AND/OR BORING AT THE CONTRACTOR'S DISCRETION SHALL BE INCLUDED AS A PART OF ALL UTILITY INSTALLATIONS WHERE APPLICABLE AT THE CONTRACTOR'S EXPENSE AS WELL AS REPLACEMENT/REPAIR OF ALL DISTURBED MATERIALS IN ACCORDANCE WITH LOCAL SPECIFICATIONS AND CODES.
- THE CONTRACTOR SHALL COORDINATE ALL CONSTRUCTION SCHEDULES AND ACTIVITIES WITH THE APPROPRIATE UTILITY OWNER AND ADJACENT PROPERTY OWNERS TO MINIMIZE DISRUPTION TO ADJACENT PROPERTY OWNERS INCLUDING VEHICULAR ACCESS.
- THE CONTRACTOR SHALL COORDINATE ALL UTILITY WORK, INCLUDING DEMOLITION AND REMOVAL, WITH THE APPROPRIATE UTILITY COMPANIES AND SERVICE PROVIDERS PRIOR TO DISCONTINUATION OF SERVICE. UTILITIES NOT NOTED FOR DEMOLITION SHALL REMAIN IN SERVICE AT ALL TIMES.
- THE CONTRACTOR SHALL MAINTAIN EXISTING UTILITY SERVICE TO ALL ADJOINING PROPERTIES UNTIL THE RELOCATED UTILITIES ARE INSPECTED AND APPROVED.
- ALL EXISTING UTILITIES SHALL BE REMOVED BACK TO THE CLOSEST STRUCTURE AND CAPPED AT THAT LOCATION UNLESS OTHERWISE INDICATED IN THESE PLANS.
- REMOVE ALL TREES, GRASS, WEEDS, ROOTS, AND OTHER DEBRIS FROM THE AREA TO BE EXCAVATED, FILLED OR GRADED.
- IF EXCAVATED MATERIAL IS UNSUITABLE FOR COMPACTION, AS DETERMINED BY THE GEOTECHNICAL ENGINEER, THE CONTRACTOR SHALL FURNISH SUITABLE BORROW.
- ALL SLOPES, CUT OR FILL, SHALL BE GRADED TO MAXIMUM FINISH SLOPE OF THREE (3) FEET HORIZONTAL TO ONE (1) FOOT VERTICAL. NO GRADED SLOPE SHALL EXCEED 3:1 WITHOUT SPECIFIC SLOPE PLANTING OR REINFORCEMENT.
- SITE SHALL BE GRADED TO ENSURE DRAINAGE OF WATER FROM ALL SURFACES.
- THE CONTRACTOR IS RESPONSIBLE FOR PROVIDING ALL SURFACE AND GROUNDWATER CONTROL MEASURES.
- GRADES NOT OTHERWISE INDICATED ON THE PLANS SHALL BE UNIFORM LEVELS OR SLOPES BETWEEN POINTS WHERE ELEVATIONS ARE GIVEN. ABRUPT CHANGES IN SLOPES SHALL BE WELL ROUNDED.
- STORM DRAINAGE SYSTEMS WITHIN THE PROJECT AREA ARE TO BE COMPLETELY WELL ROUNDED AT THE COMPLETION OF THE PROJECT.
- EXISTING TREES WHERE INDICATED SHALL BE PROTECTED FROM CONSTRUCTION ACTIVITIES. ALL TREE PROTECTION FENCING TO BE INSPECTED DAILY AND ALL GRADING ACTIVITIES TO REMAIN OUTSIDE THE DRIP LINES.
- ALL TREE PROTECTION MEASURES SHALL BE INSTALLED PRIOR TO GRADING.
- ALL SOILS UNDERCUTTING, OVER EXCAVATION, UNDER DRAIN INSTALLATION, AND ROCK FILLS SHALL BE DETERMINED AND DIRECTED BY THE SOILS ENGINEER.
- FILL AREAS TO BE COMPACTED TO 95% STANDARD PROCTOR MINIMUM UNLESS OTHERWISE INDICATED BY GEOTECHNICAL ENGINEER.
- UNLESS OTHERWISE INDICATED, ALL DISTURBED SOIL AREAS TO RECEIVE 6 INCHES OF TOPSOIL AND TO BE SEED AND MULCHED.
- THE CONTRACTOR SHALL PERFORM ALL CUTTING, PATCHING, AND REPAIRING AS REQUIRED TO PERFORM ALL OF THE WORK INDICATED ON THE DRAWINGS, AND ALL OTHER WORK THAT MAY BE REQUIRED TO COMPLETE THE JOB.

CONSTRUCTION NOTES

- ALL WORK PERFORMED SHALL BE IN ACCORDANCE WITH THE BUILDING CODE OF THE AUTHORITY HAVING JURISDICTION AND THE RULES AND REGULATIONS OF ALL AGENCIES, DEPARTMENTS AND COMMISSIONS HAVING JURISDICTION. WHERE DISCREPANCIES OCCUR AND/OR WHERE THERE ARE CONFLICTS OR OMISSIONS IN THE DRAWINGS AND APPLICATIONS, THE CONTRACTOR SHALL NOTIFY THE ARCHITECT IMMEDIATELY AND REFRAIN FROM STARTING AND COMPLETING SUCH WORK, OR DEPENDENT WORK, UNTIL TOLD BY THE ARCHITECT TO PROCEED.
- THE CONTRACTOR SHALL VERIFY ALL DIMENSIONS AND EXISTING CONDITIONS IN THE FIELD PRIOR TO COMMENCING WORK, AND SHALL REPORT TO THE ARCHITECT ANY CONDITION OR DISCREPANCY BETWEEN DRAWINGS AND FIELD CONDITIONS REQUIRING MODIFICATIONS BEFORE PROCEEDING WITH THE WORK.
- MINOR DETAILS NOT USUALLY SHOWN OR SPECIFIED, BUT NECESSARY FOR PROPER CONSTRUCTION OF ANY PART OF THE WORK SHALL BE INCLUDED AS IF THEY WERE INDICATED IN THE DRAWINGS.
- REFERENCING OF DRAWINGS IS FOR CONVENIENCE ONLY AND DOES NOT LIMIT APPLICATION OF ANY DRAWING.
- THE CONTRACTOR SHALL BE RESPONSIBLE FOR THE PROTECTION OF ALL CONDITIONS AND MATERIALS WITHIN THE PROPOSED CONSTRUCTION AREAS. THE CONTRACTOR SHALL DESIGN AND INSTALL ADEQUATE SHORING AND BRACING FOR ALL STRUCTURAL OR REMOVAL TASKS. THE CONTRACTOR SHALL HAVE SOLE RESPONSIBILITY FOR ANY DAMAGE OR INJURIES CAUSED BY OR DURING THE EXECUTION OF THE WORK.
- NOTES APPEAR ON VARIOUS SHEETS FOR VARIOUS SYSTEMS AND MATERIALS. SHEETS ARE TO BE OWNER REVIEWED AND NOTES ON ANY ONE SHEET ARE TO BE APPLIED TO RELATED SYSTEMS AND MATERIALS DEPICTED ON OTHER DRAWINGS.
- DETAILS NOT SHOWN ARE SIMILAR IN CHARACTER TO THOSE THAT ARE. WHERE SPECIFIC DIMENSIONS, DETAILS, OR DESIGN INTENT CANNOT BE DETERMINED, CONSULT THE ENGINEER BEFORE PROCEEDING WITH THE WORK.
- THE CONTRACTOR SHALL LAY OUT HIS OWN WORK, AND SHALL PROVIDE ALL DIMENSIONS REQUIRED FOR OTHER TRADES.
- THE CONTRACTOR SHALL DO ALL CUTTING, PATCHING AND REPAIRING AS REQUIRED TO PERFORM ALL OF THE WORK INDICATED ON THE DRAWINGS, AND ALL OTHER WORK THAT MAY BE REQUIRED TO COMPLETE THE JOB.

FINAL DEVELOPMENT PLAN

LEE'S SUMMIT, JACKSON COUNTY, MISSOURI

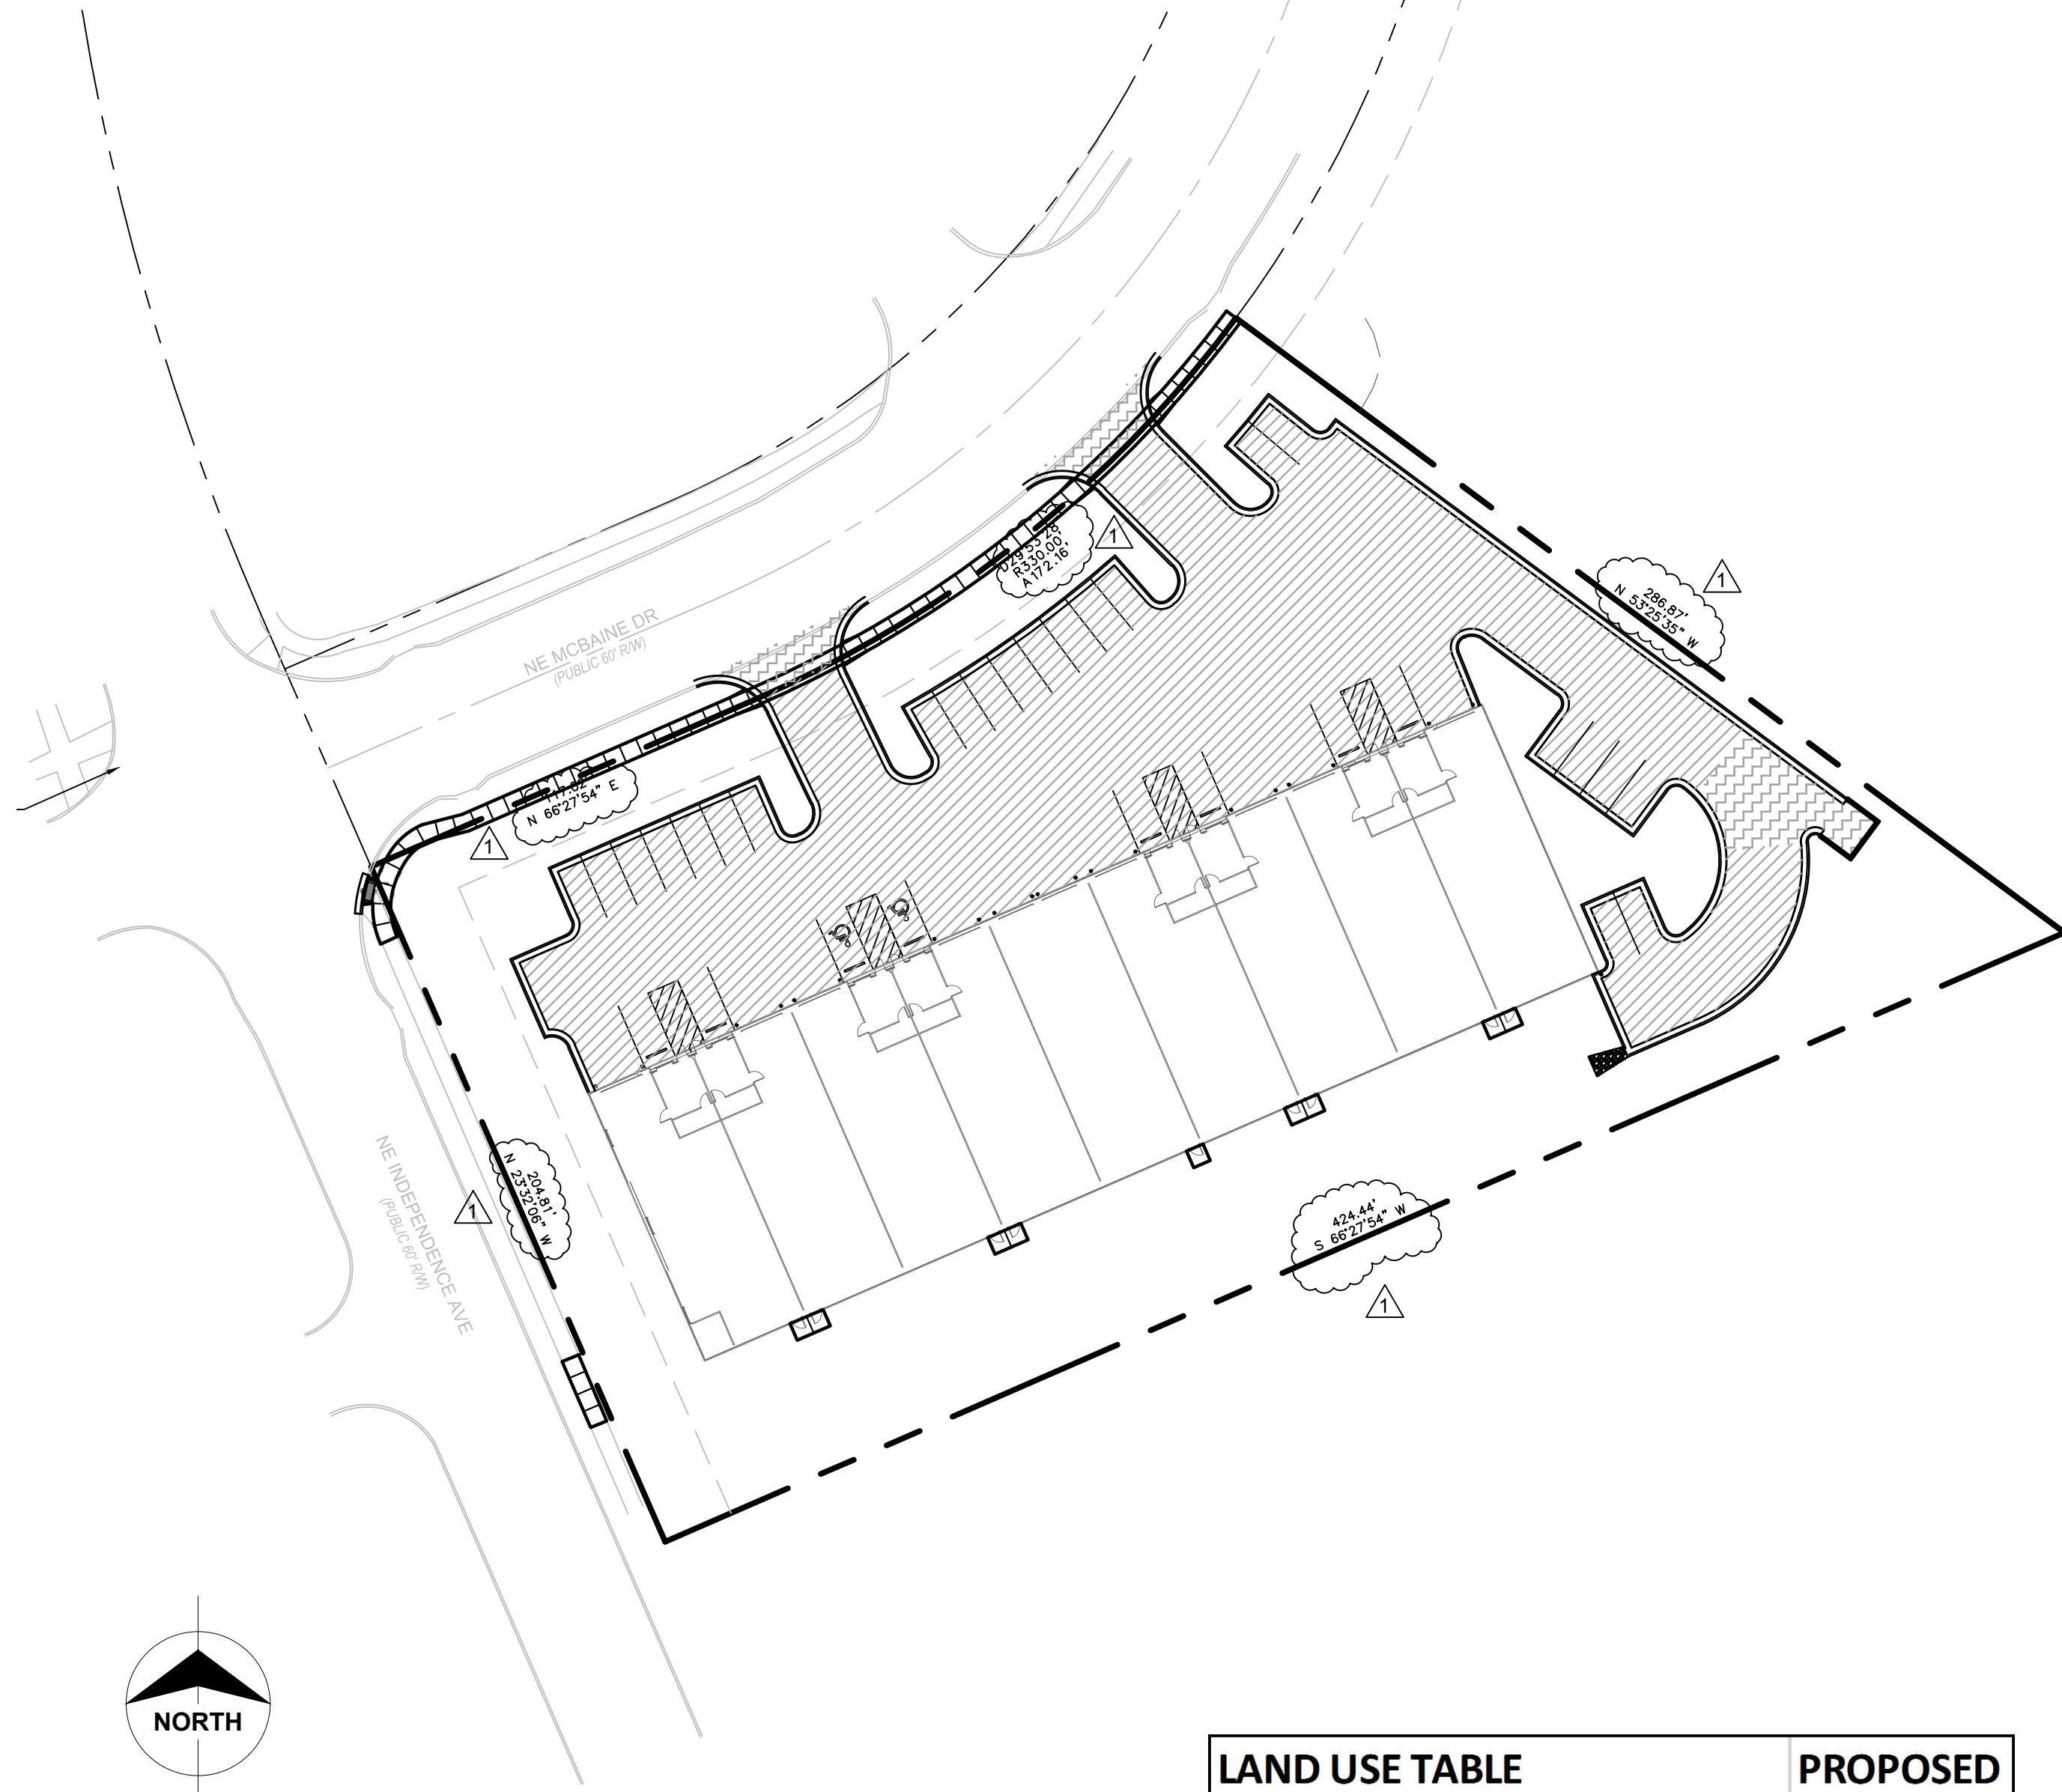

LEGAL DESCRIPTION
 LOT 10, I-470 BUSINESS AND TECHNOLOGY CENTER, A
 SUBDIVISION IN LEE'S SUMMIT, JACKSON COUNTY, MISSOURI

DEVELOPER:
 David Ward
 Ward Development
 1120 NW Eagle Ridge Blvd.
 Grain Valley, MO
 816-229-8115

NOTES:


- Site is located within an area of minimal flood hazard (Flood Zone X) in FEMA FIRM Panel number 29095C0430G (effective 1/20/2017).
- No oil or gas wells are present on site per Missouri DNR record.
- Requirements of the City of Lee's Summit Design and Construction Manual shall govern.

C-001	Cover Sheet
C-101	Demolition Plan
C-121	Erosion Control Plan Phase 1
C-122	Erosion Control Plan Phase 2
C-123	Erosion Control Plan Phase 3
C-131	Erosion Control Details
C-132	Erosion Control Details
C-201	Dimension Plan
C-202	ADA Ramp Details
C-301	Grading Plan
C-302	ADA Ramp Grading Details
C-401	Utility Plan
C-411	Storm Profiles
C-421	Drainage Area Map
C-501	Details
C-502	Details
C-503	Details
L-100	Landscape Plan

UTILITIES

- | | |
|---|--|
| EVERGY
1200 Main St.
PO Box 418679
Kansas City, MO 64141
888.471.5275 | AT&T
215 N Spring St.
Independence, MO 64050
816.325.5610 |
| SPIRE
3025 SE Clover Dr.
Lee's Summit, MO 64082
800.582.1234 | SPECTRUM
6550 Winchester Ave.
Kansas City, MO 64133
816.358.5360 |
| CITY OF LEE'S SUMMIT
220 SE Green St.
Lee's Summit, MO 64063
816.969.1800 | MISSOURI ONE CALL
1.800.344.7483 |

LAND USE TABLE	PROPOSED
TOTAL FLOOR AREA (SF)	21,897
NUMBER OF DWELLING UNITS	0
LAND AREA (AC)	1.79
REQUIRED PARKING SPACES	28
PROVIDED PARKING SPACES	31
IMPERVIOUS COVERAGE (AC)	1.26
FLOOR AREA RATIO (FAR)	0.281

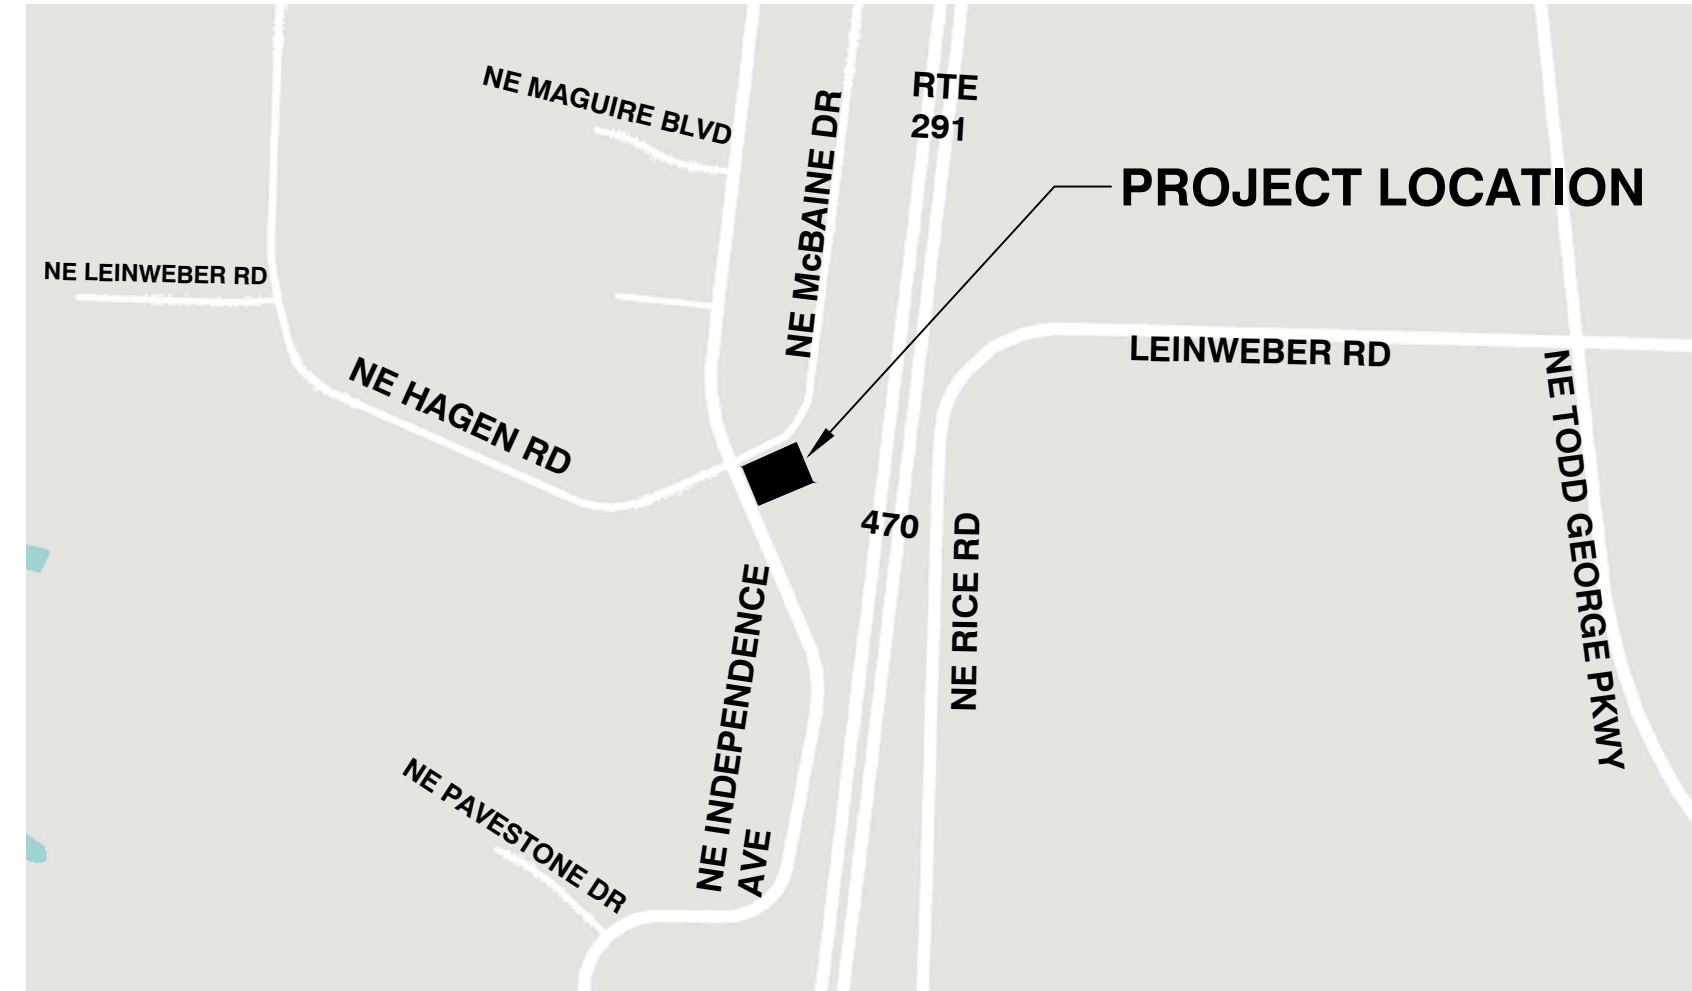

VICINITY MAP
NOT TO SCALE


RELEASED FOR CONSTRUCTION
 As Noted on Plans Review
 Development Services Department
 Lee's Summit, Missouri
 01/14/2022



Certificates of Authority
 Architecture: MO 310 / KS 13
 Engineering: MO 4 / KS 241
 Land Surveying: MO 123 / KS 34

© 2019 Powell CWM, Inc.
 This drawing has been prepared by Powell CWM, Inc. This drawing is provided as an instrument of service by Powell CWM and is intended for use on this project only, pursuant to the Architectural Works Copyright Protection Act of 1990, all drawings, specifications, notes and designs, including the overall form arrangement and composition of spaces and elements appearing herein constitute the original copyrighted work of Powell CWM, Inc. Any reproduction, use or disclosure of information contained herein without prior written consent of Powell CWM, Inc. is strictly prohibited.

Toby L. Williams, PE
 PE-2019038948 (MISSOURI #)

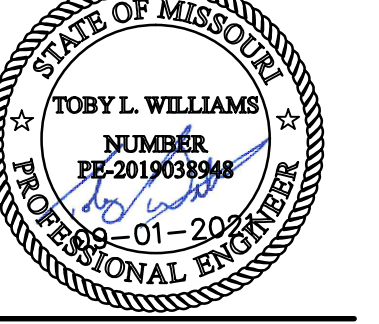



PREPARED FOR:
 WARD DEVELOPMENT
 DAVID WARD
 1120 NW EAGLE RIDGE BLVD.
 GRAIN VALLEY, MO 64029
 (816) 229-8115


LOT 10, I-470 BUSINESS AND TECHNOLOGY CENTER
 2601 NE MCBAIN DRIVE
 LEE'S SUMMIT, MO 64064

REVISIONS	NO.	DATE / DESCRIPTION
	1	11/09/2021 - CITY COMMENTS
	2	12/22/2021 - CITY COMMENTS

PROJECT #: 21-1902
 ISSUE DATE: 09/01/2021
 ISSUED FOR:

LEGEND

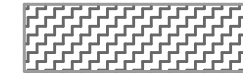
-  EXISTING SIDEWALK TO BE REMOVED
-  EXISTING CURBS TO BE REMOVED

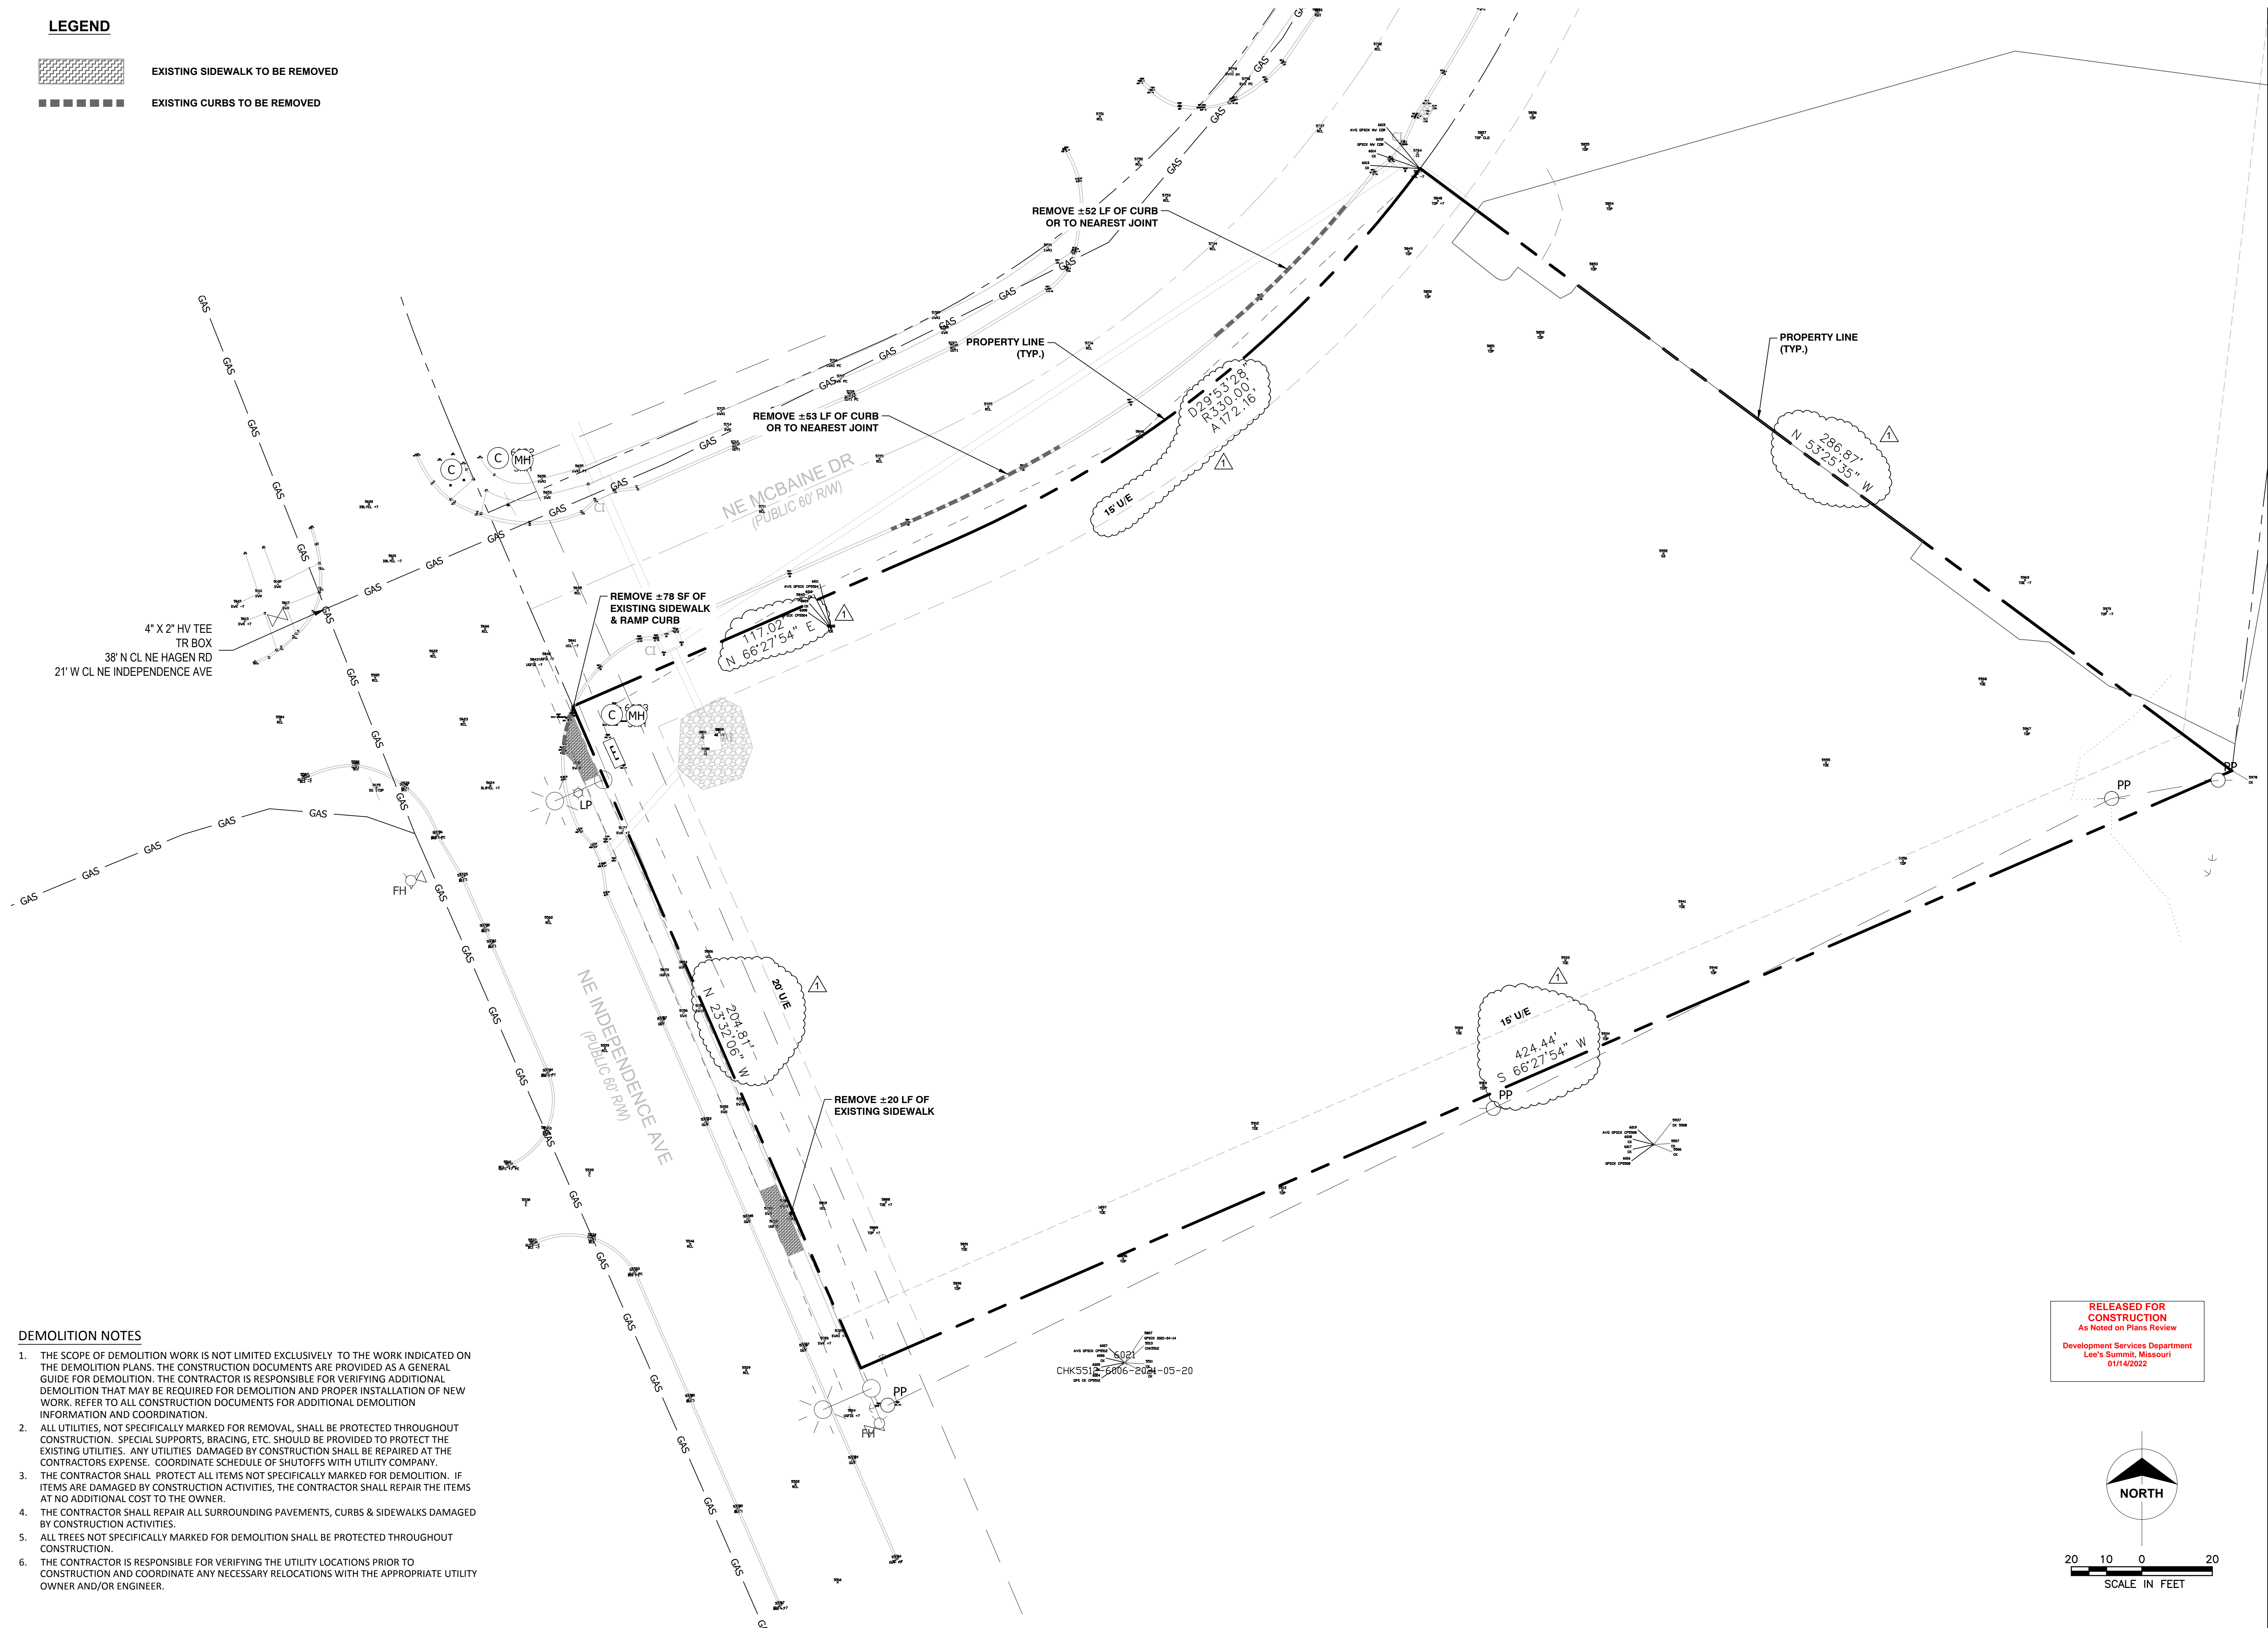

DEMOLITION NOTES

1. THE SCOPE OF DEMOLITION WORK IS NOT LIMITED EXCLUSIVELY TO THE WORK INDICATED ON THE DEMOLITION PLANS. THE CONSTRUCTION DOCUMENTS ARE PROVIDED AS A GENERAL GUIDE FOR DEMOLITION. THE CONTRACTOR IS RESPONSIBLE FOR VERIFYING ADDITIONAL DEMOLITION THAT MAY BE REQUIRED FOR DEMOLITION AND PROPER INSTALLATION OF NEW WORK. REFER TO ALL CONSTRUCTION DOCUMENTS FOR ADDITIONAL DEMOLITION INFORMATION AND COORDINATION.
2. ALL UTILITIES, NOT SPECIFICALLY MARKED FOR REMOVAL, SHALL BE PROTECTED THROUGHOUT CONSTRUCTION. SPECIAL SUPPORTS, BRACING, ETC. SHOULD BE PROVIDED TO PROTECT THE EXISTING UTILITIES. ANY UTILITIES DAMAGED BY CONSTRUCTION SHALL BE REPAIRED AT THE CONTRACTORS EXPENSE. COORDINATE SCHEDULE OF SHUTOFFS WITH UTILITY COMPANY.
3. THE CONTRACTOR SHALL PROTECT ALL ITEMS NOT SPECIFICALLY MARKED FOR DEMOLITION. IF ITEMS ARE DAMAGED BY CONSTRUCTION ACTIVITIES, THE CONTRACTOR SHALL REPAIR THE ITEMS AT NO ADDITIONAL COST TO THE OWNER.
4. THE CONTRACTOR SHALL REPAIR ALL SURROUNDING PAVEMENTS, CURBS & SIDEWALKS DAMAGED BY CONSTRUCTION ACTIVITIES.
5. ALL TREES NOT SPECIFICALLY MARKED FOR DEMOLITION SHALL BE PROTECTED THROUGHOUT CONSTRUCTION.
6. THE CONTRACTOR IS RESPONSIBLE FOR VERIFYING THE UTILITY LOCATIONS PRIOR TO CONSTRUCTION AND COORDINATE ANY NECESSARY RELOCATIONS WITH THE APPROPRIATE UTILITY OWNER AND/OR ENGINEER.


RELEASED FOR
CONSTRUCTION
As Noted on Plans Review
Development Services Department
Lee's Summit, Missouri
01/14/2022

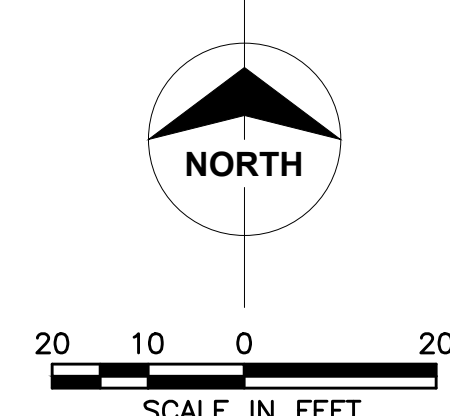

Certificates of Authority
Architecture: MO 318 / KS 13
Engineering: MO 4 / KS 241
Land Surveying: MO 123 / KS 34

© 2019 Powell CWM, Inc.
This drawing has been prepared by Powell CWM, Inc. This drawing is provided as an instrument of service by Powell CWM and is intended for use on this project only, pursuant to the Architectural Works Copyright Protection Act of 1990. All drawings, specifications, notes and designs, including the overall form arrangement and composition of spaces and elements appearing herein constitute the original copyrighted work of Powell CWM, Inc. Any reproduction, use or disclosure of information contained herein without prior written consent of Powell CWM, Inc. is strictly prohibited.

Toby L. Williams, PE
PE-2019038948 (MISSOURI #)

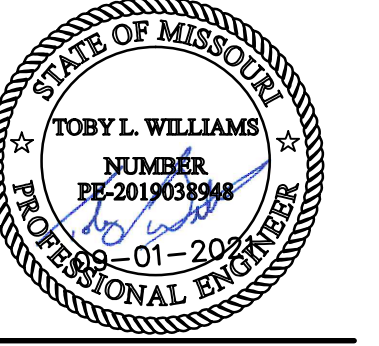

PREPARED FOR:
WARD DEVELOPMENT
DAVID WARD
1120 NW EAGLE RIDGE BLVD.
GRAIN VALLEY, MO 64029
(816) 229-8115





LOT 10, I-470 BUSINESS AND TECHNOLOGY CENTER
2601 NE MCBAIN DRIVE
LEE'S SUMMIT, MO 64064

REVISIONS	NO.	DATE / DESCRIPTION
	1	11/09/2021 - CITY COMMENTS


PROJECT #: 21-1902
ISSUE DATE: 09/01/2021
ISSUED FOR:

DEMOLITION PLAN

LEGEND:

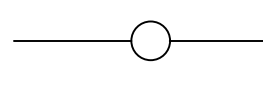-  **INLET PROTECTION**
RE: C-131
-  **CONSTRUCTION ENTRANCE**
RE: C-132
-  **SILT FENCE**
RE: C-131
-  **CONCRETE WASHOUT**
RE: C-132

NOTE: AREA OF DISTURBANCE = 1.65 AC

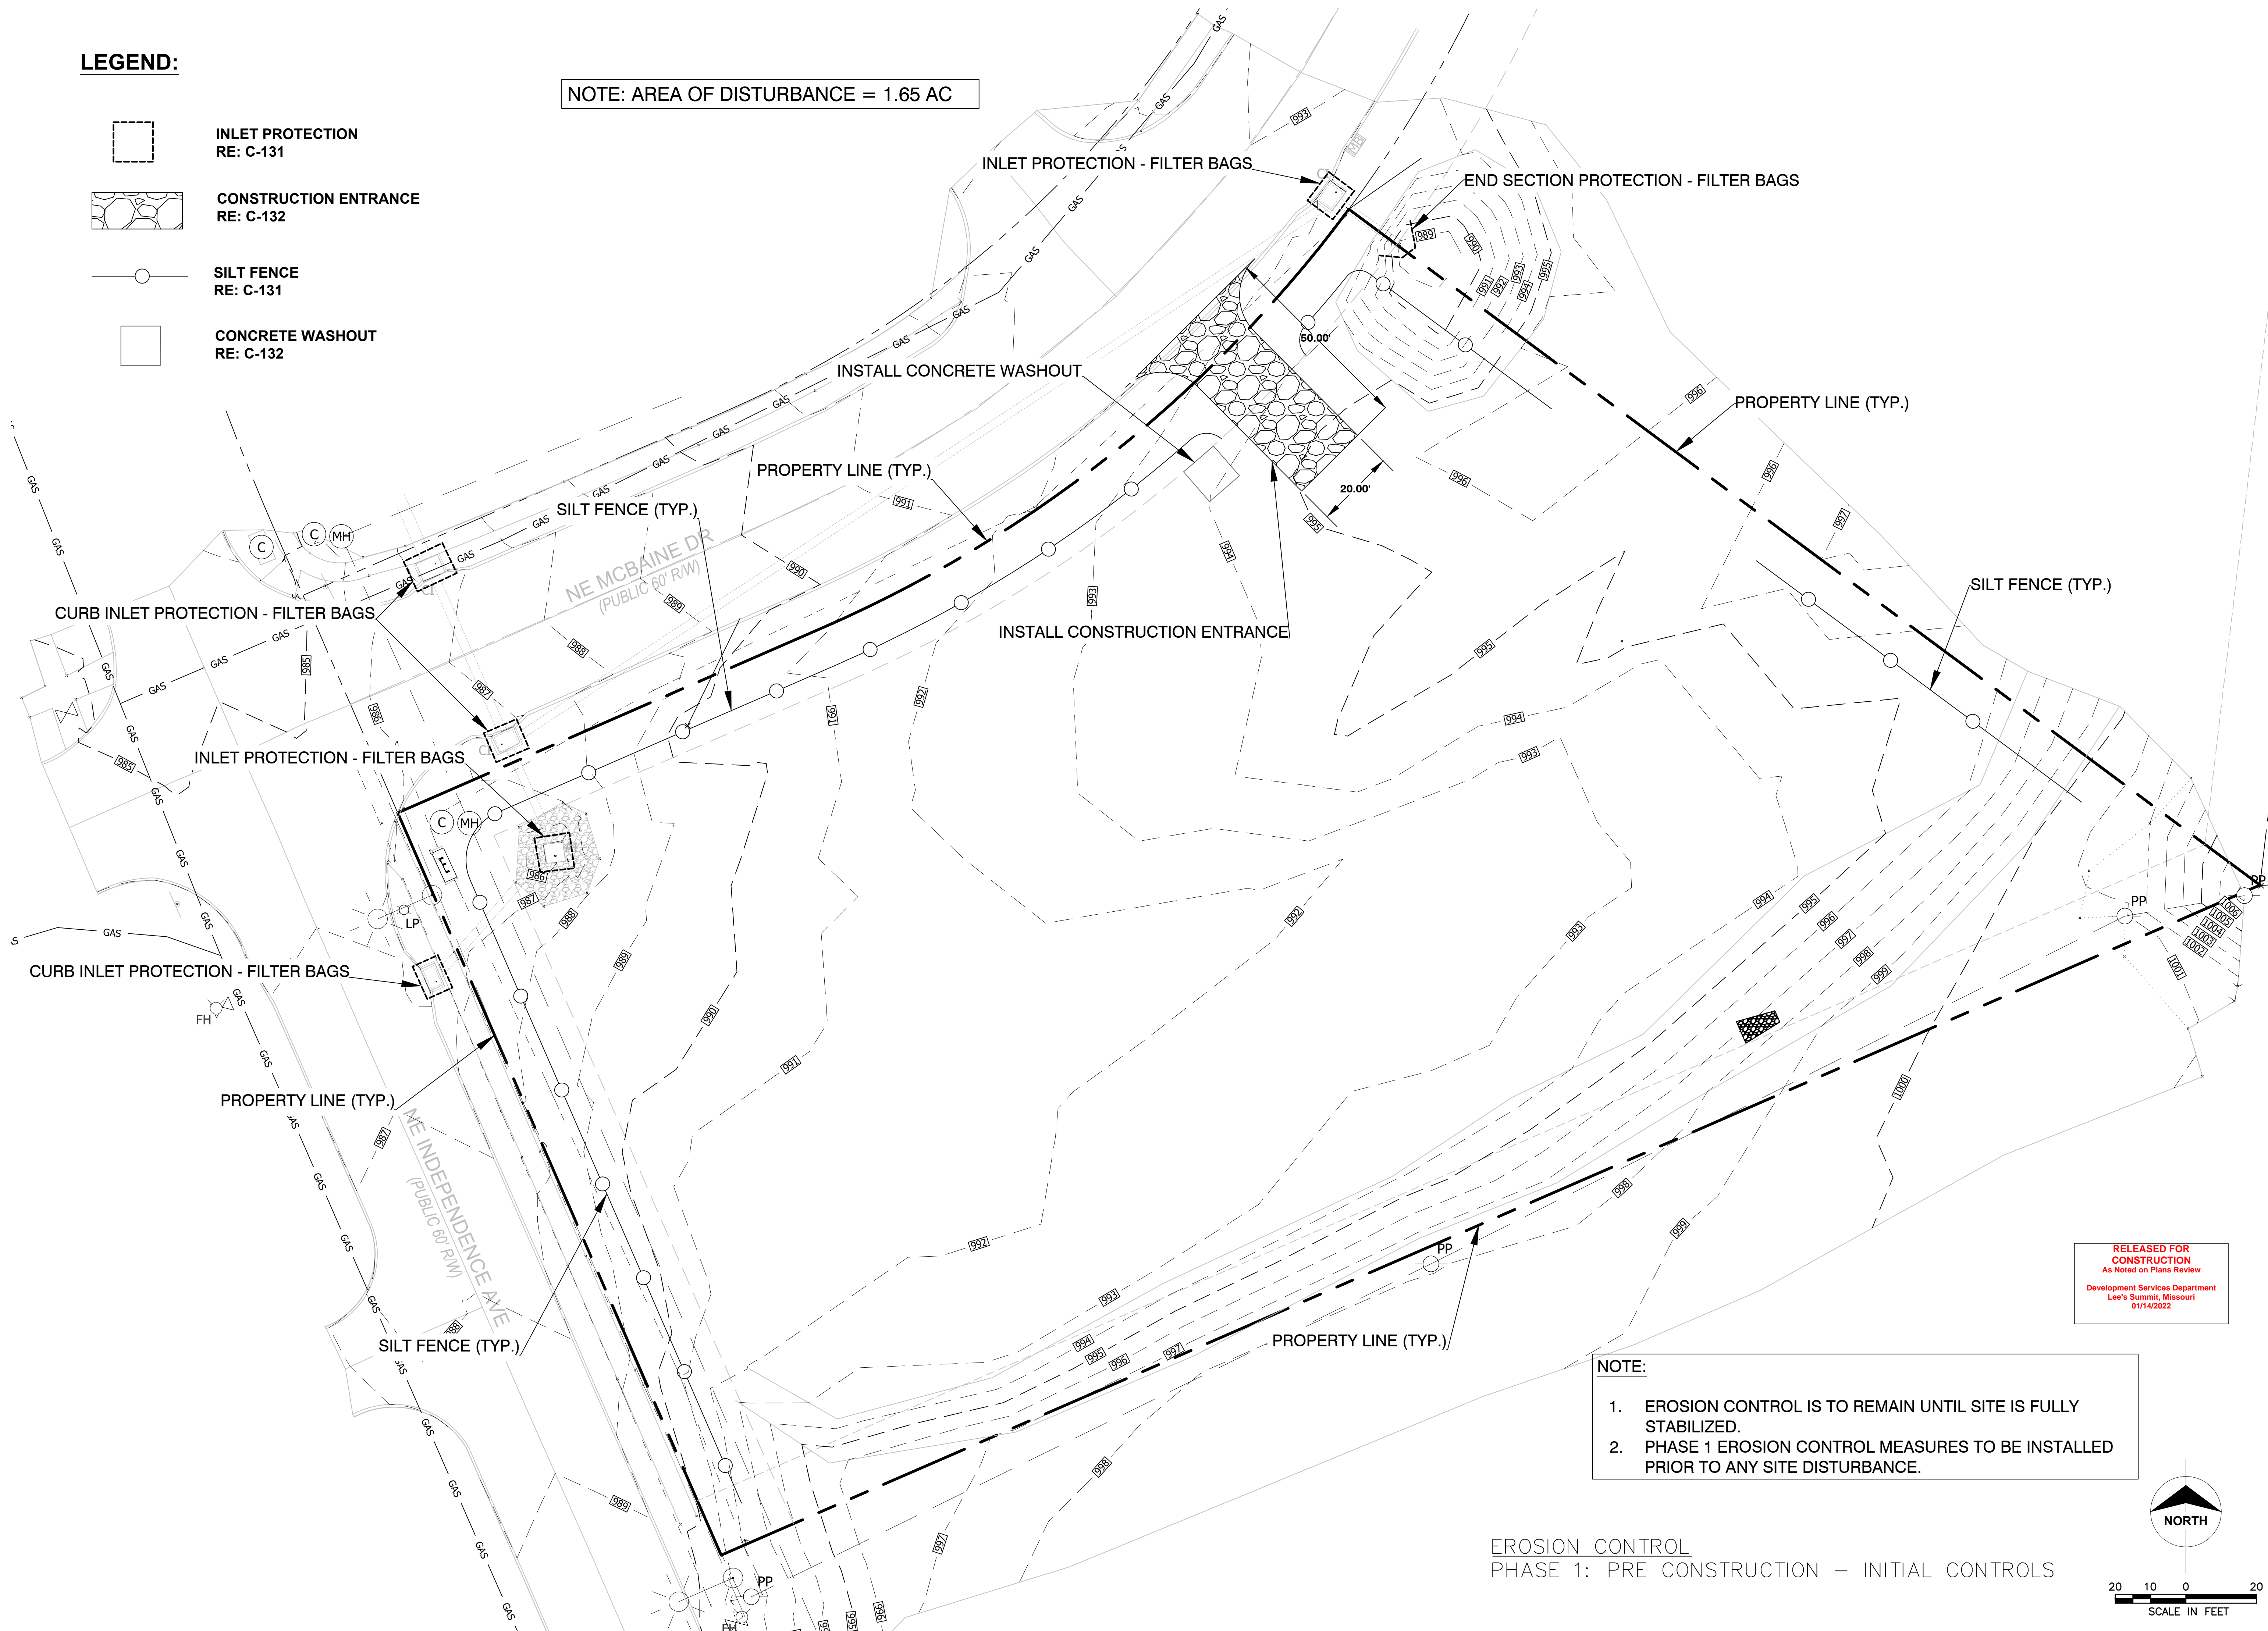

NOTE:


1. EROSION CONTROL IS TO REMAIN UNTIL SITE IS FULLY STABILIZED.
2. PHASE 1 EROSION CONTROL MEASURES TO BE INSTALLED PRIOR TO ANY SITE DISTURBANCE.

RELEASED FOR
CONSTRUCTION
As Noted on Plans Review
Development Services Department
Lee's Summit, Missouri
01/14/2022

Certificates of Authority
Architecture: MO 318 / KS 33
Engineering: MO 4 / KS 241
Land Surveying: MO 123 / KS 34

© 2019 Powell CWM, Inc.
This drawing has been prepared by Powell CWM, Inc. This drawing is provided as an instrument of service by Powell CWM and is intended for use on the project only, pursuant to the Architectural Works Copyright Protection Act of 1990, all drawings, specifications, notes and designs, including the overall form arrangement and composition of spaces and elements appearing herein constitute the original copyrighted work of Powell CWM, Inc. Any reproduction, use or disclosure of information contained herein without prior written consent of Powell CWM, Inc. is strictly prohibited.

Toby L. Williams, PE
PE-2019038948 (MISSOURI #)

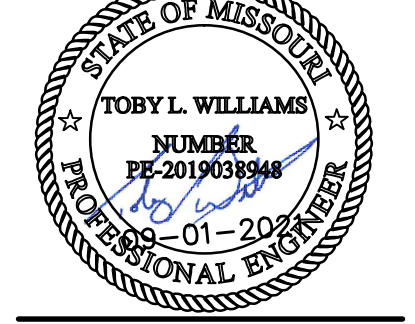

PREPARED FOR:
WARD DEVELOPMENT
DAVID WARD
1120 NW EAGLE RIDGE BLVD.
GRAIN VALLEY, MO 64029
(816) 229-8115


LOT 10, I-470 BUSINESS AND TECHNOLOGY CENTER
 2601 NE MCBAIN DRIVE
 LEE'S SUMMIT, MO 64064

REVISIONS	NO.	DATE / DESCRIPTION

PROJECT #: 21-1902
ISSUE DATE: 09/01/2021
ISSUED FOR:



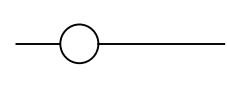
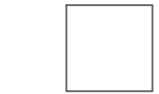
FOR PERMIT

EROSION CONTROL PLAN
PHASE 1
C-121

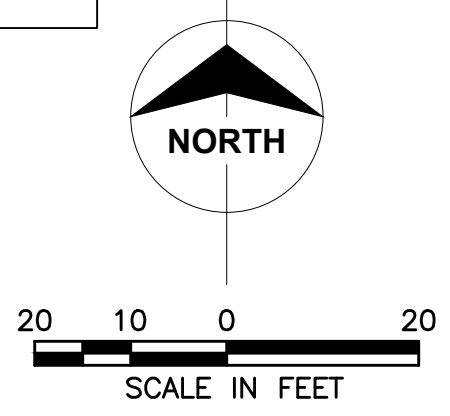


EROSION CONTROL
PHASE 1: PRE CONSTRUCTION – INITIAL CONTROLS

LEGEND:

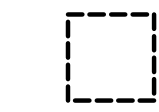
-  INLET PROTECTION
RE: C-131
-  CONSTRUCTION ENTRANCE
RE: C-132
-  SILT FENCE
RE: C-131
-  CONCRETE WASHOUT
RE: C-132

NOTE: AREA OF DISTURBANCE = 1.65 AC

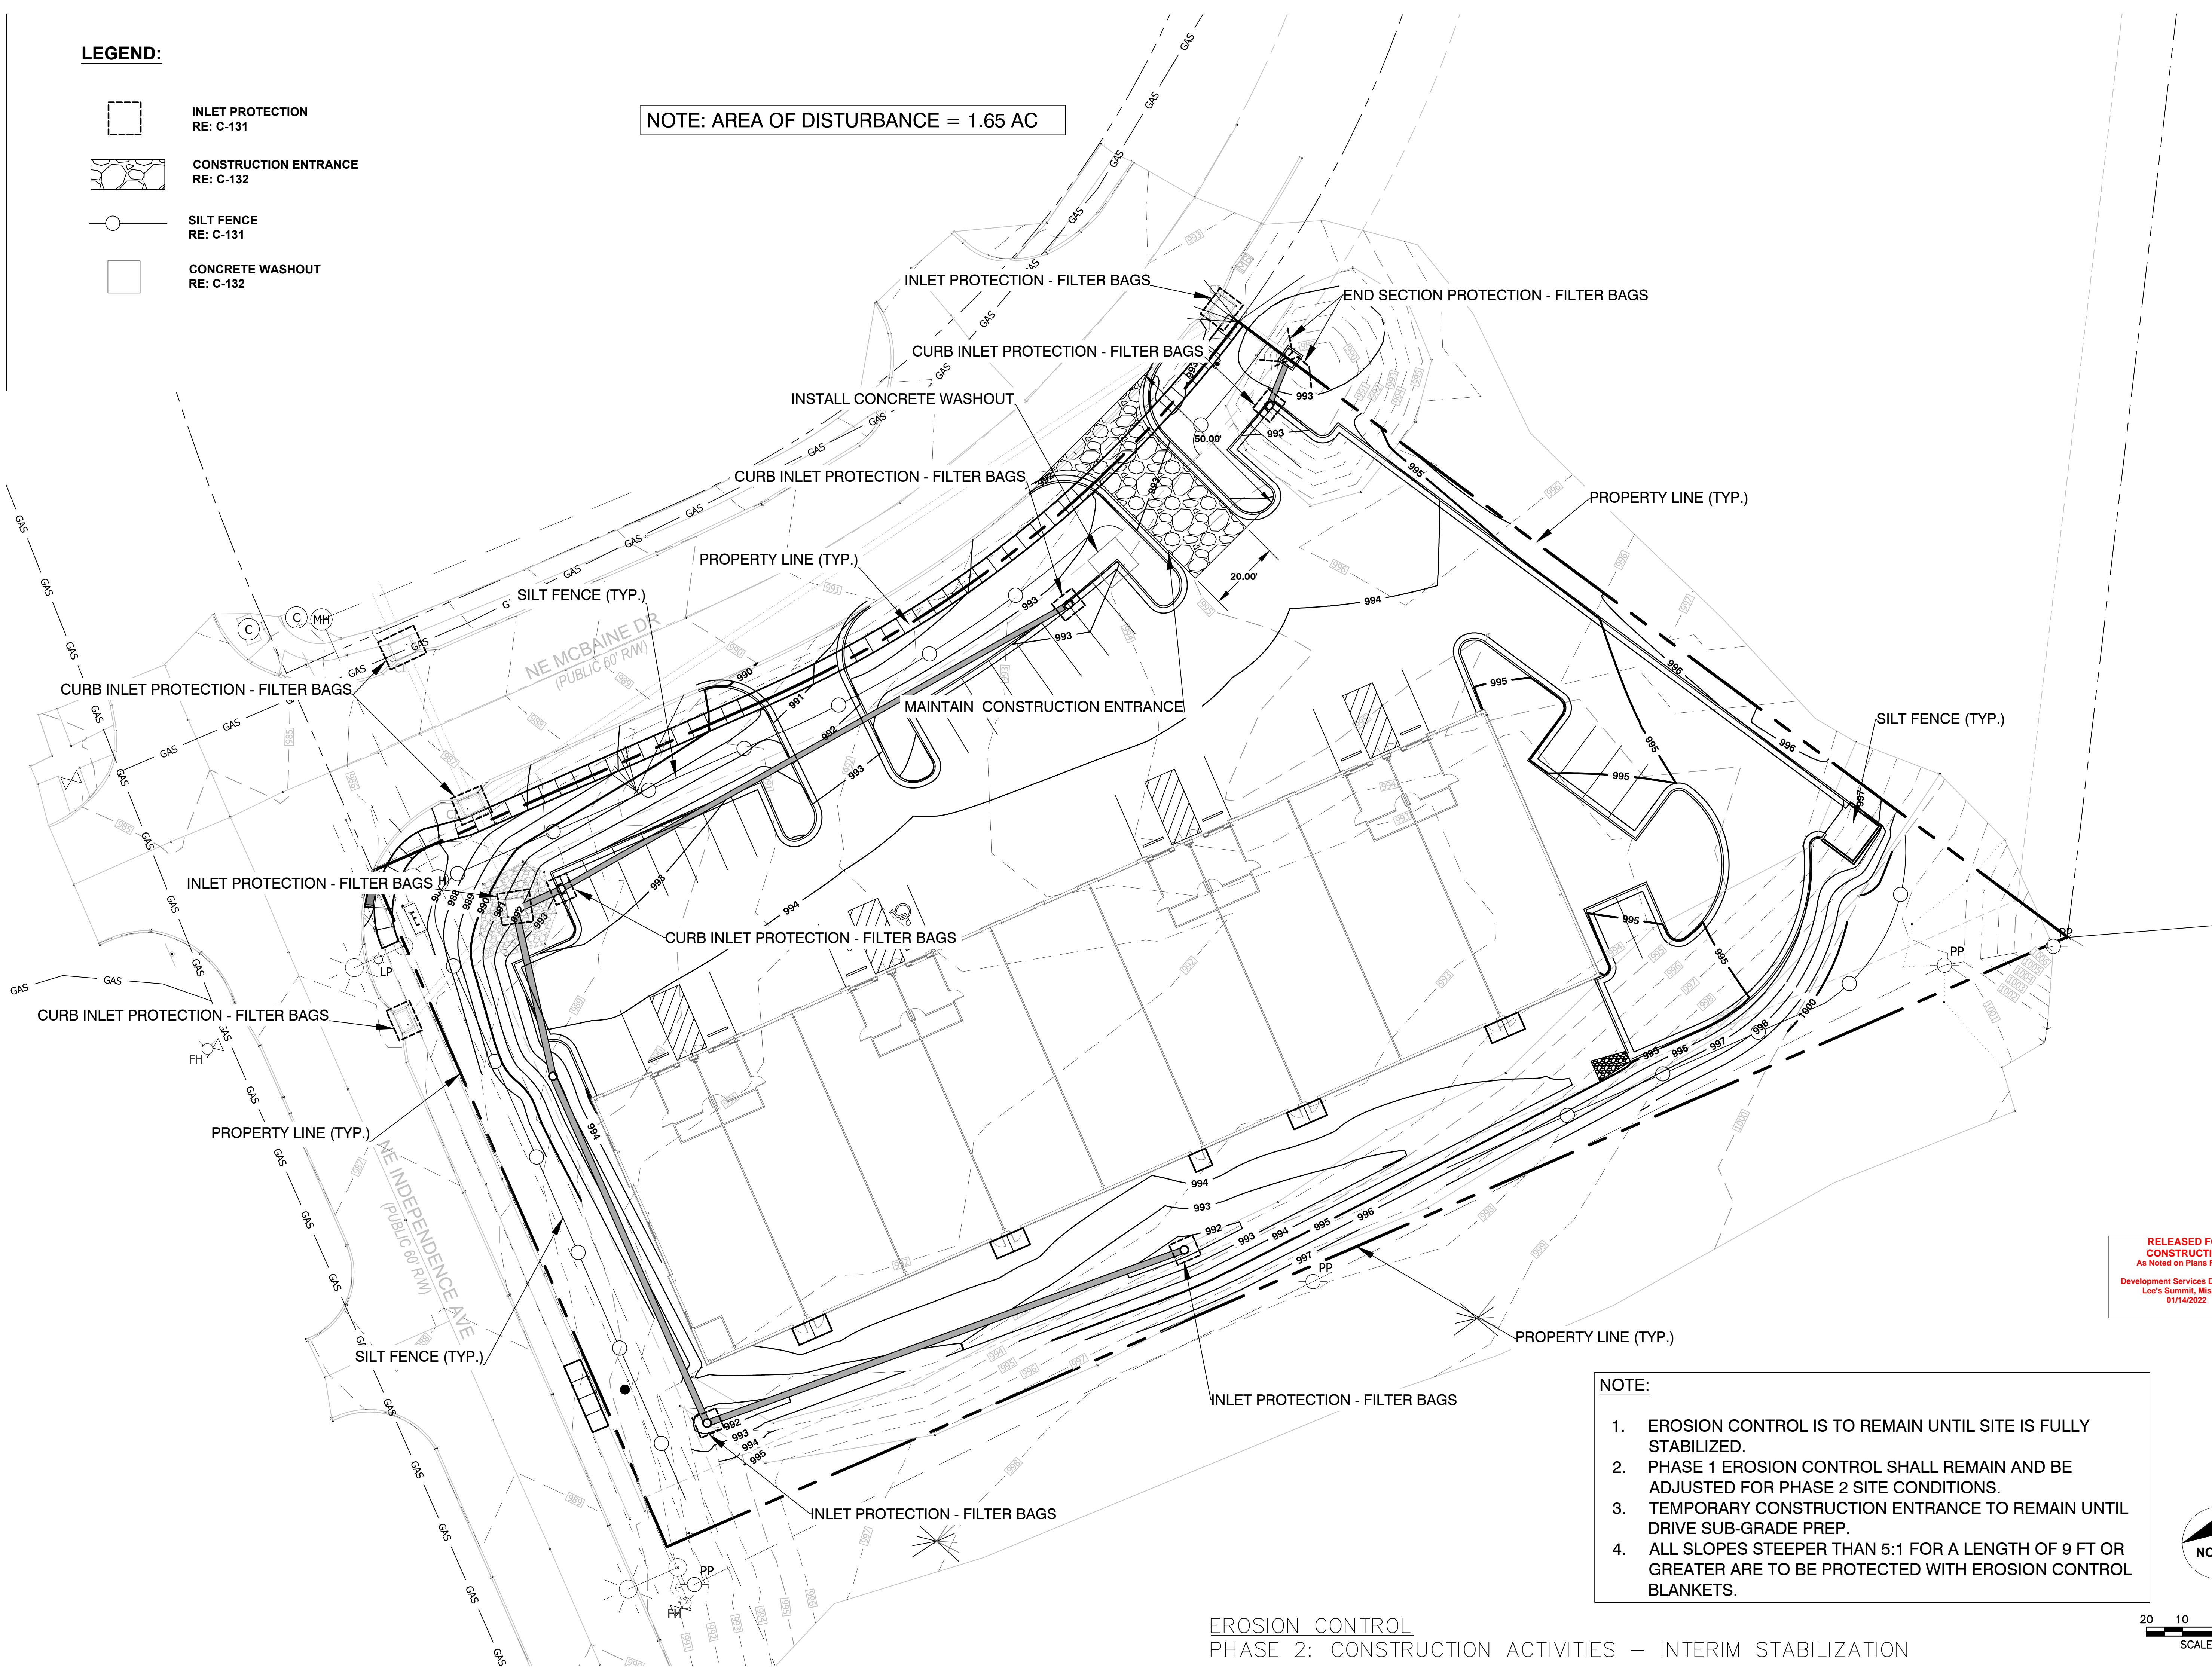

- NOTE:**
1. EROSION CONTROL IS TO REMAIN UNTIL SITE IS FULLY STABILIZED.
 2. PHASE 1 EROSION CONTROL SHALL REMAIN AND BE ADJUSTED FOR PHASE 2 SITE CONDITIONS.
 3. TEMPORARY CONSTRUCTION ENTRANCE TO REMAIN UNTIL DRIVE SUB-GRADE PREP.
 4. ALL SLOPES STEEPER THAN 5:1 FOR A LENGTH OF 9 FT OR GREATER ARE TO BE PROTECTED WITH EROSION CONTROL BLANKETS.

RELEASED FOR CONSTRUCTION
As Noted on Plans Review
Development Services Department
Lee's Summit, Missouri
01/14/2022

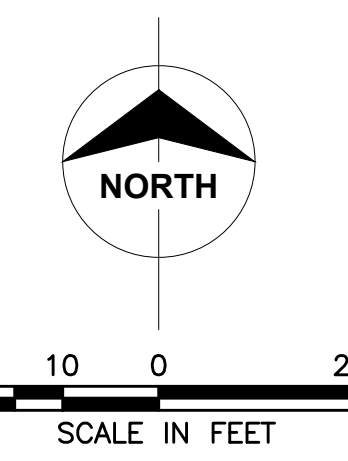


EROSION CONTROL
PHASE 2: CONSTRUCTION ACTIVITIES – INTERIM STABILIZATION

Certificates of Authority
Architecture: MO 318 / KS 73
Engineering: MO 4 / KS 241
Land Surveying: MO 123 / KS 34

© 2019 Powell CWM, Inc. This drawing has been prepared by Powell CWM, Inc. This drawing is provided as an instrument of service by Powell CWM and is intended for use on the project only, pursuant to the Architectural Works Copyright Protection Act of 1990, all drawings, specifications, ideas and designs, including the overall form arrangement and composition of spaces and elements appearing herein constitute the original copyrighted work of Powell CWM, Inc. Any reproduction, use or disclosure of information contained herein without prior written consent of Powell CWM, Inc. is strictly prohibited.

Toby L. Williams, PE
PE-2019038948 (MISSOURI #)

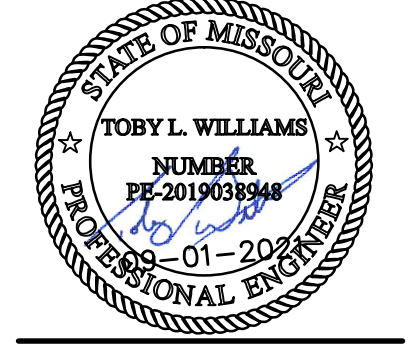

PREPARED FOR:
WARD DEVELOPMENT
DAVID WARD
1120 NW EAGLE RIDGE BLVD.
GRAIN VALLEY, MO 64029
(816) 229-8115


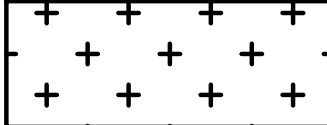
LOT 10, I-470 BUSINESS AND TECHNOLOGY CENTER
2601 NE MCBAIN DRIVE
LEE'S SUMMIT, MO 64064

REVISIONS NO.	DATE / DESCRIPTION


PROJECT #: 21-1902
ISSUE DATE: 09/01/2021
ISSUED FOR:

FOR PERMIT
EROSION CONTROL PLAN
PHASE 2

LEGEND:


-  **INLET PROTECTION**
RE: C-131
-  **SEED OR SOD**
RE: C-131

NOTE: AREA OF DISTURBANCE = 1.65 AC

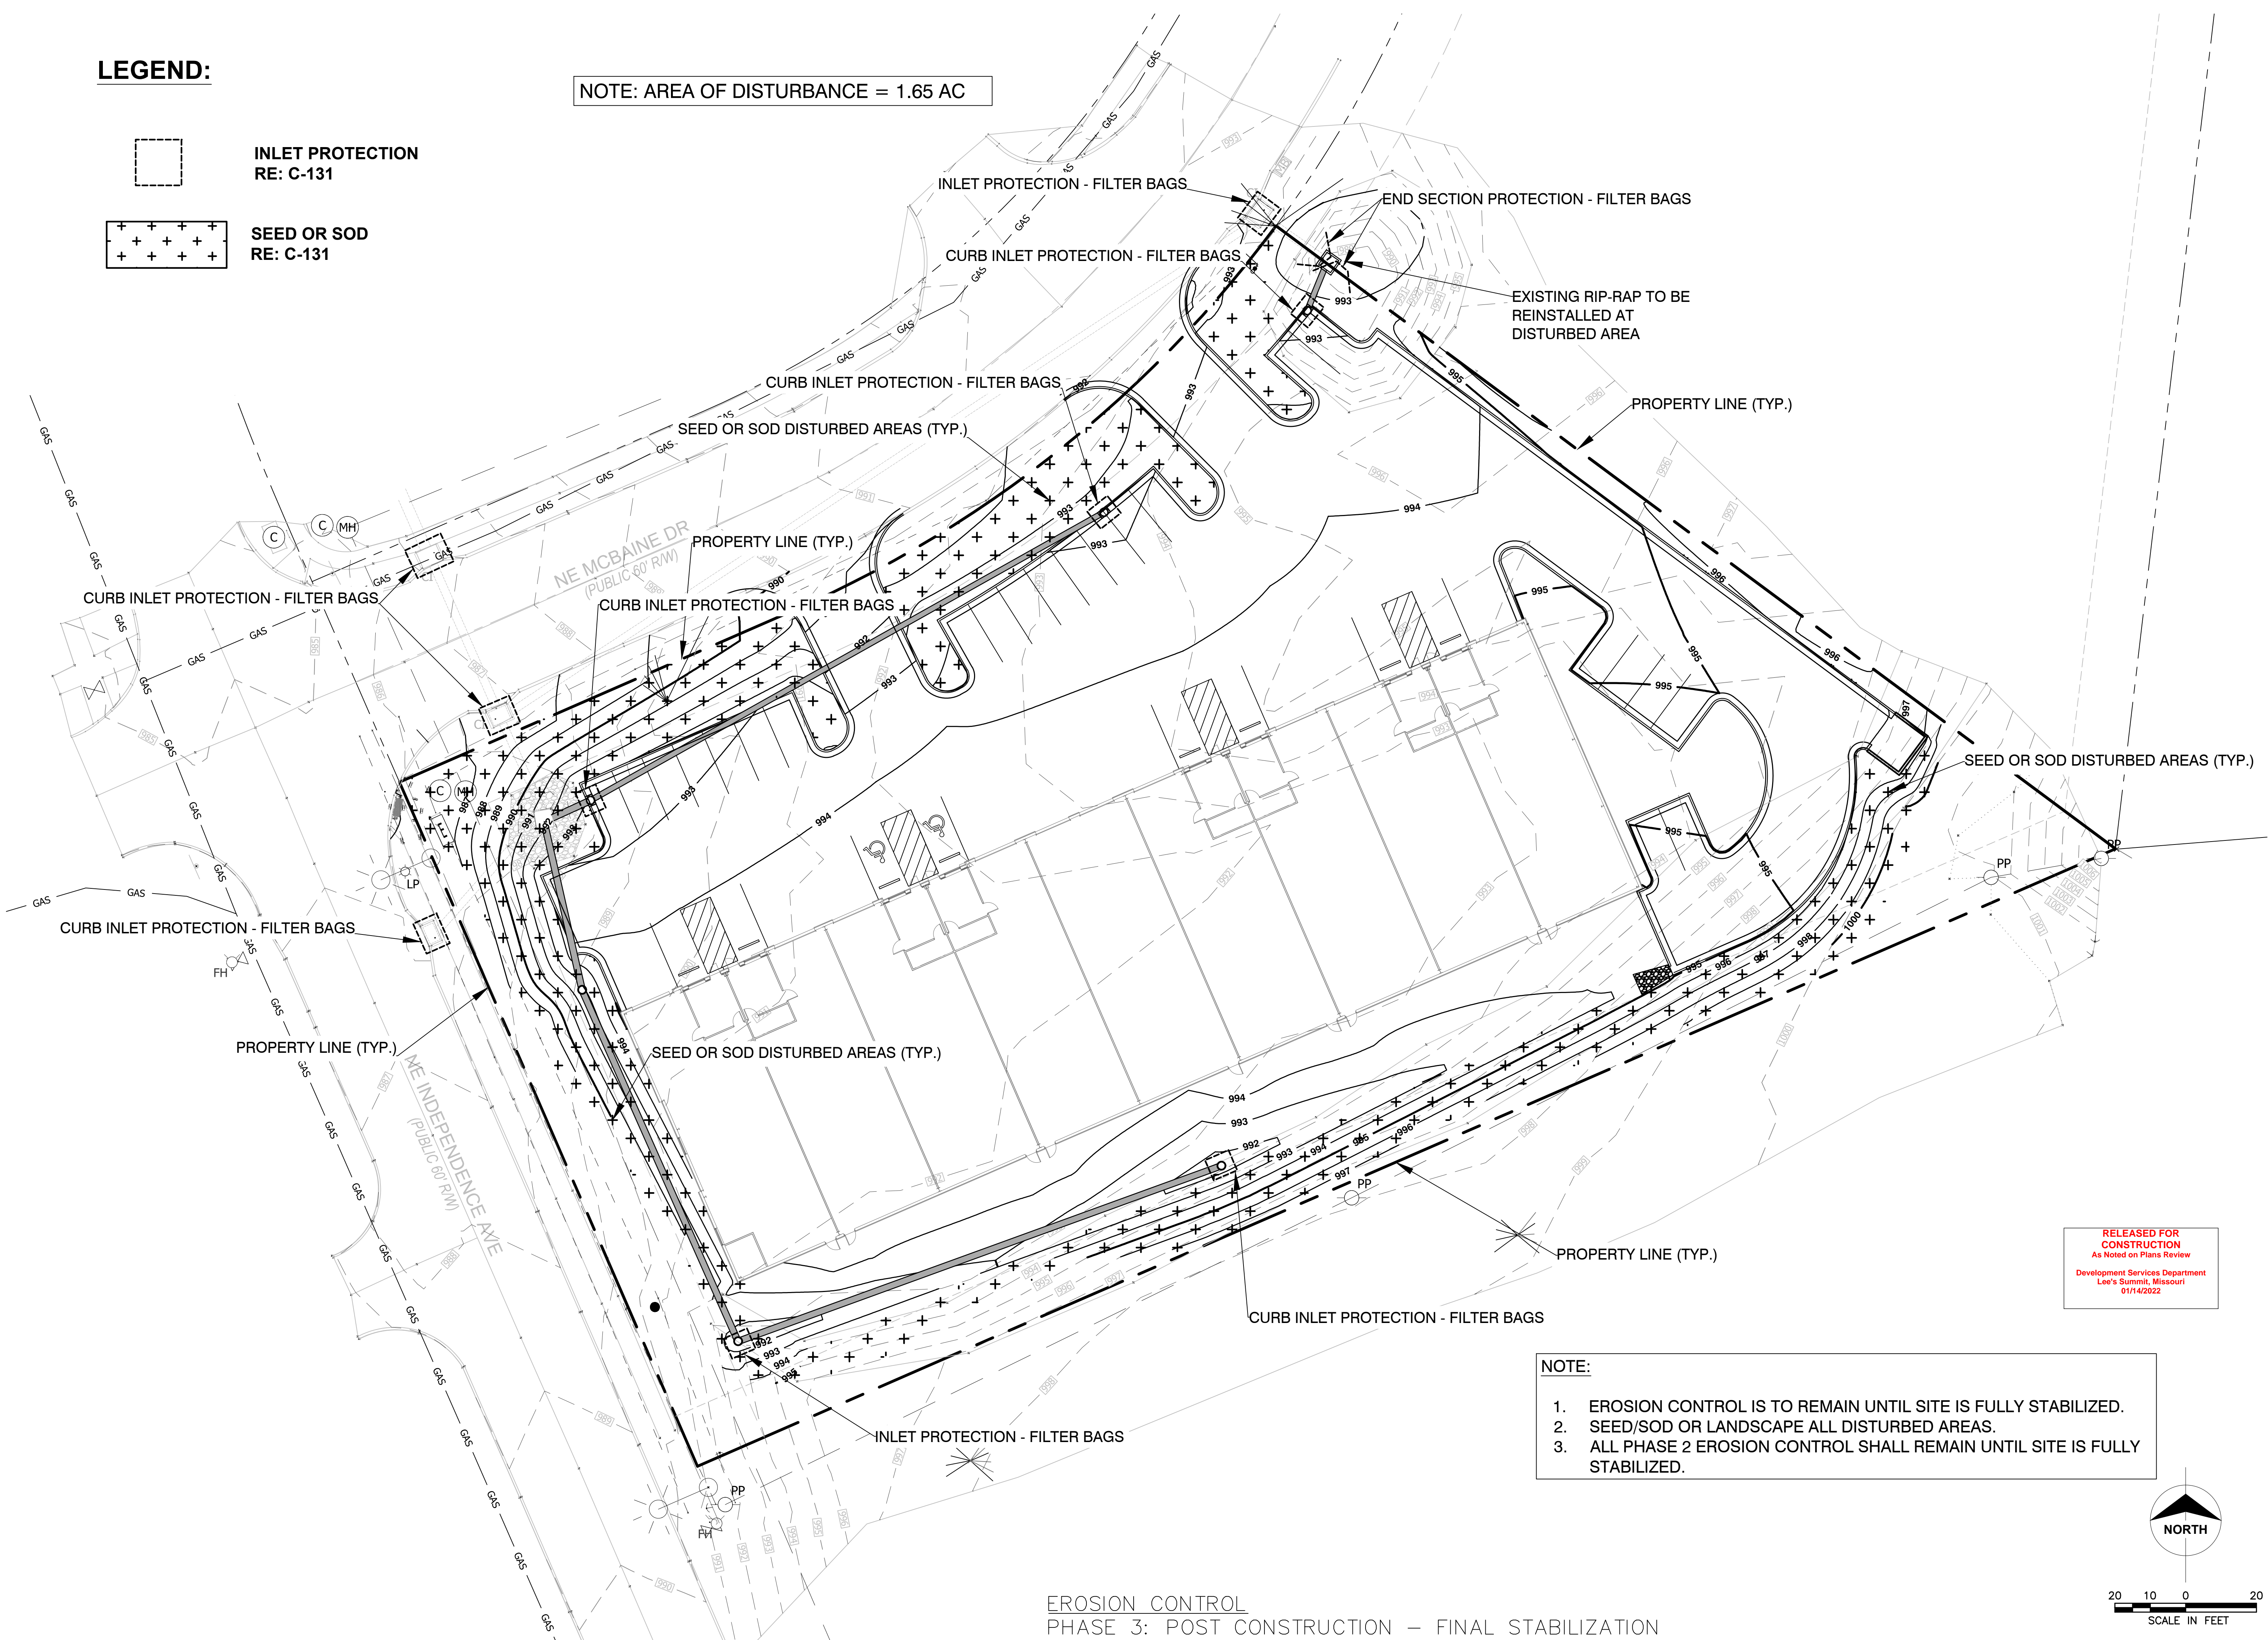

- NOTE:**
1. EROSION CONTROL IS TO REMAIN UNTIL SITE IS FULLY STABILIZED.
 2. SEED/SOD OR LANDSCAPE ALL DISTURBED AREAS.
 3. ALL PHASE 2 EROSION CONTROL SHALL REMAIN UNTIL SITE IS FULLY STABILIZED.

RELEASED FOR
CONSTRUCTION
As Noted on Plans Review
Development Services Department
Lee's Summit, Missouri
01/14/2022

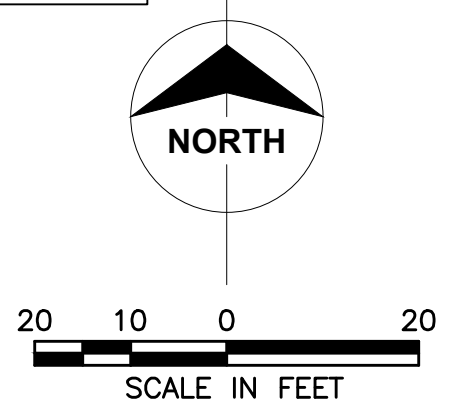


EROSION CONTROL
PHASE 3: POST CONSTRUCTION – FINAL STABILIZATION

Certificates of Authority
Architecture: MO 318 / KS 33
Engineering: MO 4 / KS 241
Land Surveying: MO 123 / KS 34

© 2019 Powell CWM, Inc. This drawing has been prepared by Powell CWM, Inc. This drawing is provided as an instrument of service by Powell CWM and is intended for use on this project only, pursuant to the Architectural Works Copyright Protection Act of 1990, all drawings, specifications, plans and designs, including the overall form arrangement and composition of spaces and elements appearing herein constitute the original copyrighted work of Powell CWM, Inc. Any reproduction, use or disclosure of information contained herein without prior written consent of Powell CWM, Inc. is strictly prohibited.

Toby L. Williams, PE
PE-2019038948 (MISSOURI #)

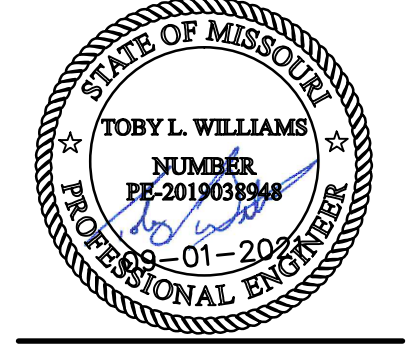


PREPARED FOR:
WARD DEVELOPMENT
DAVID WARD
1120 NW EAGLE RIDGE BLVD.
GRAIN VALLEY, MO 64029
(816) 229-8115

LOT 10, I-470 BUSINESS AND TECHNOLOGY CENTER
2601 NE MCBAIN DRIVE
LEE'S SUMMIT, MO 64064


REVISIONS NO.	DATE / DESCRIPTION

PROJECT #: 21-1902
ISSUE DATE: 09/01/2021
ISSUED FOR:



FOR PERMIT
EROSION CONTROL PLAN
PHASE 3
C-123

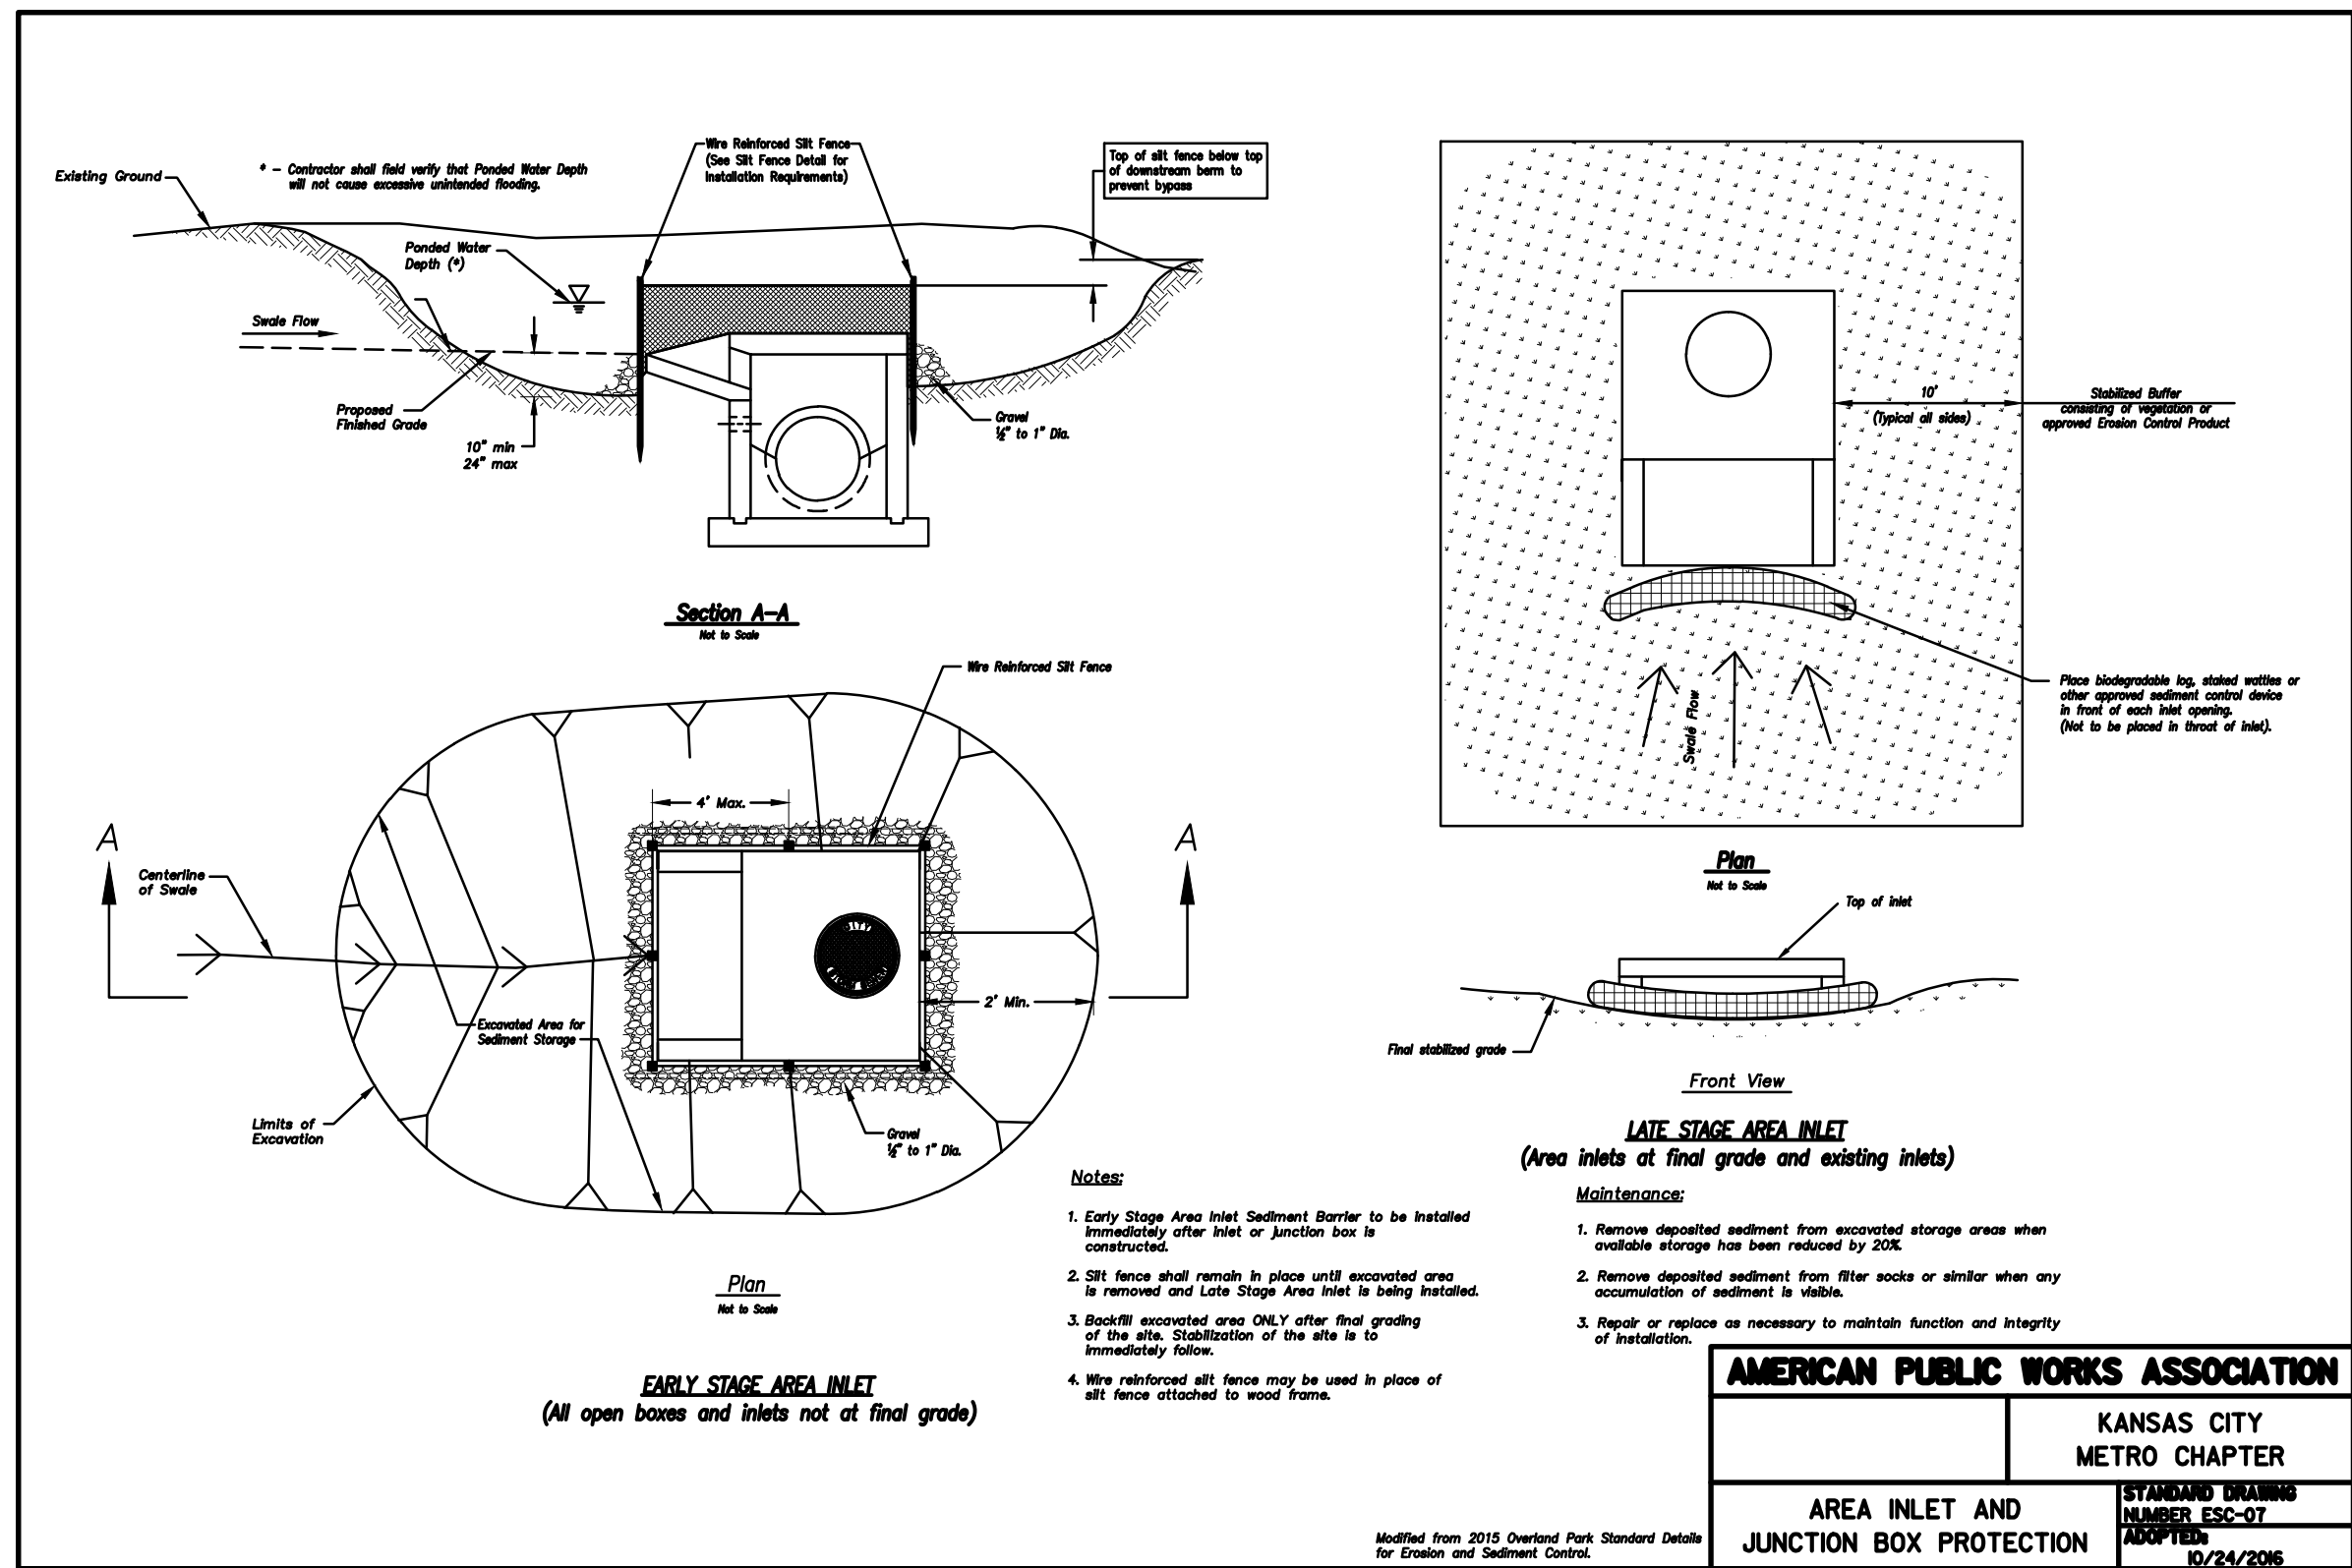


AMERICAN PUBLIC WORKS ASSOCIATION	
KANSAS CITY METRO CHAPTER	
AREA INLET AND JUNCTION BOX PROTECTION	STANDARD DRAWING NUMBER ESC-07 REVISED 10/24/2006

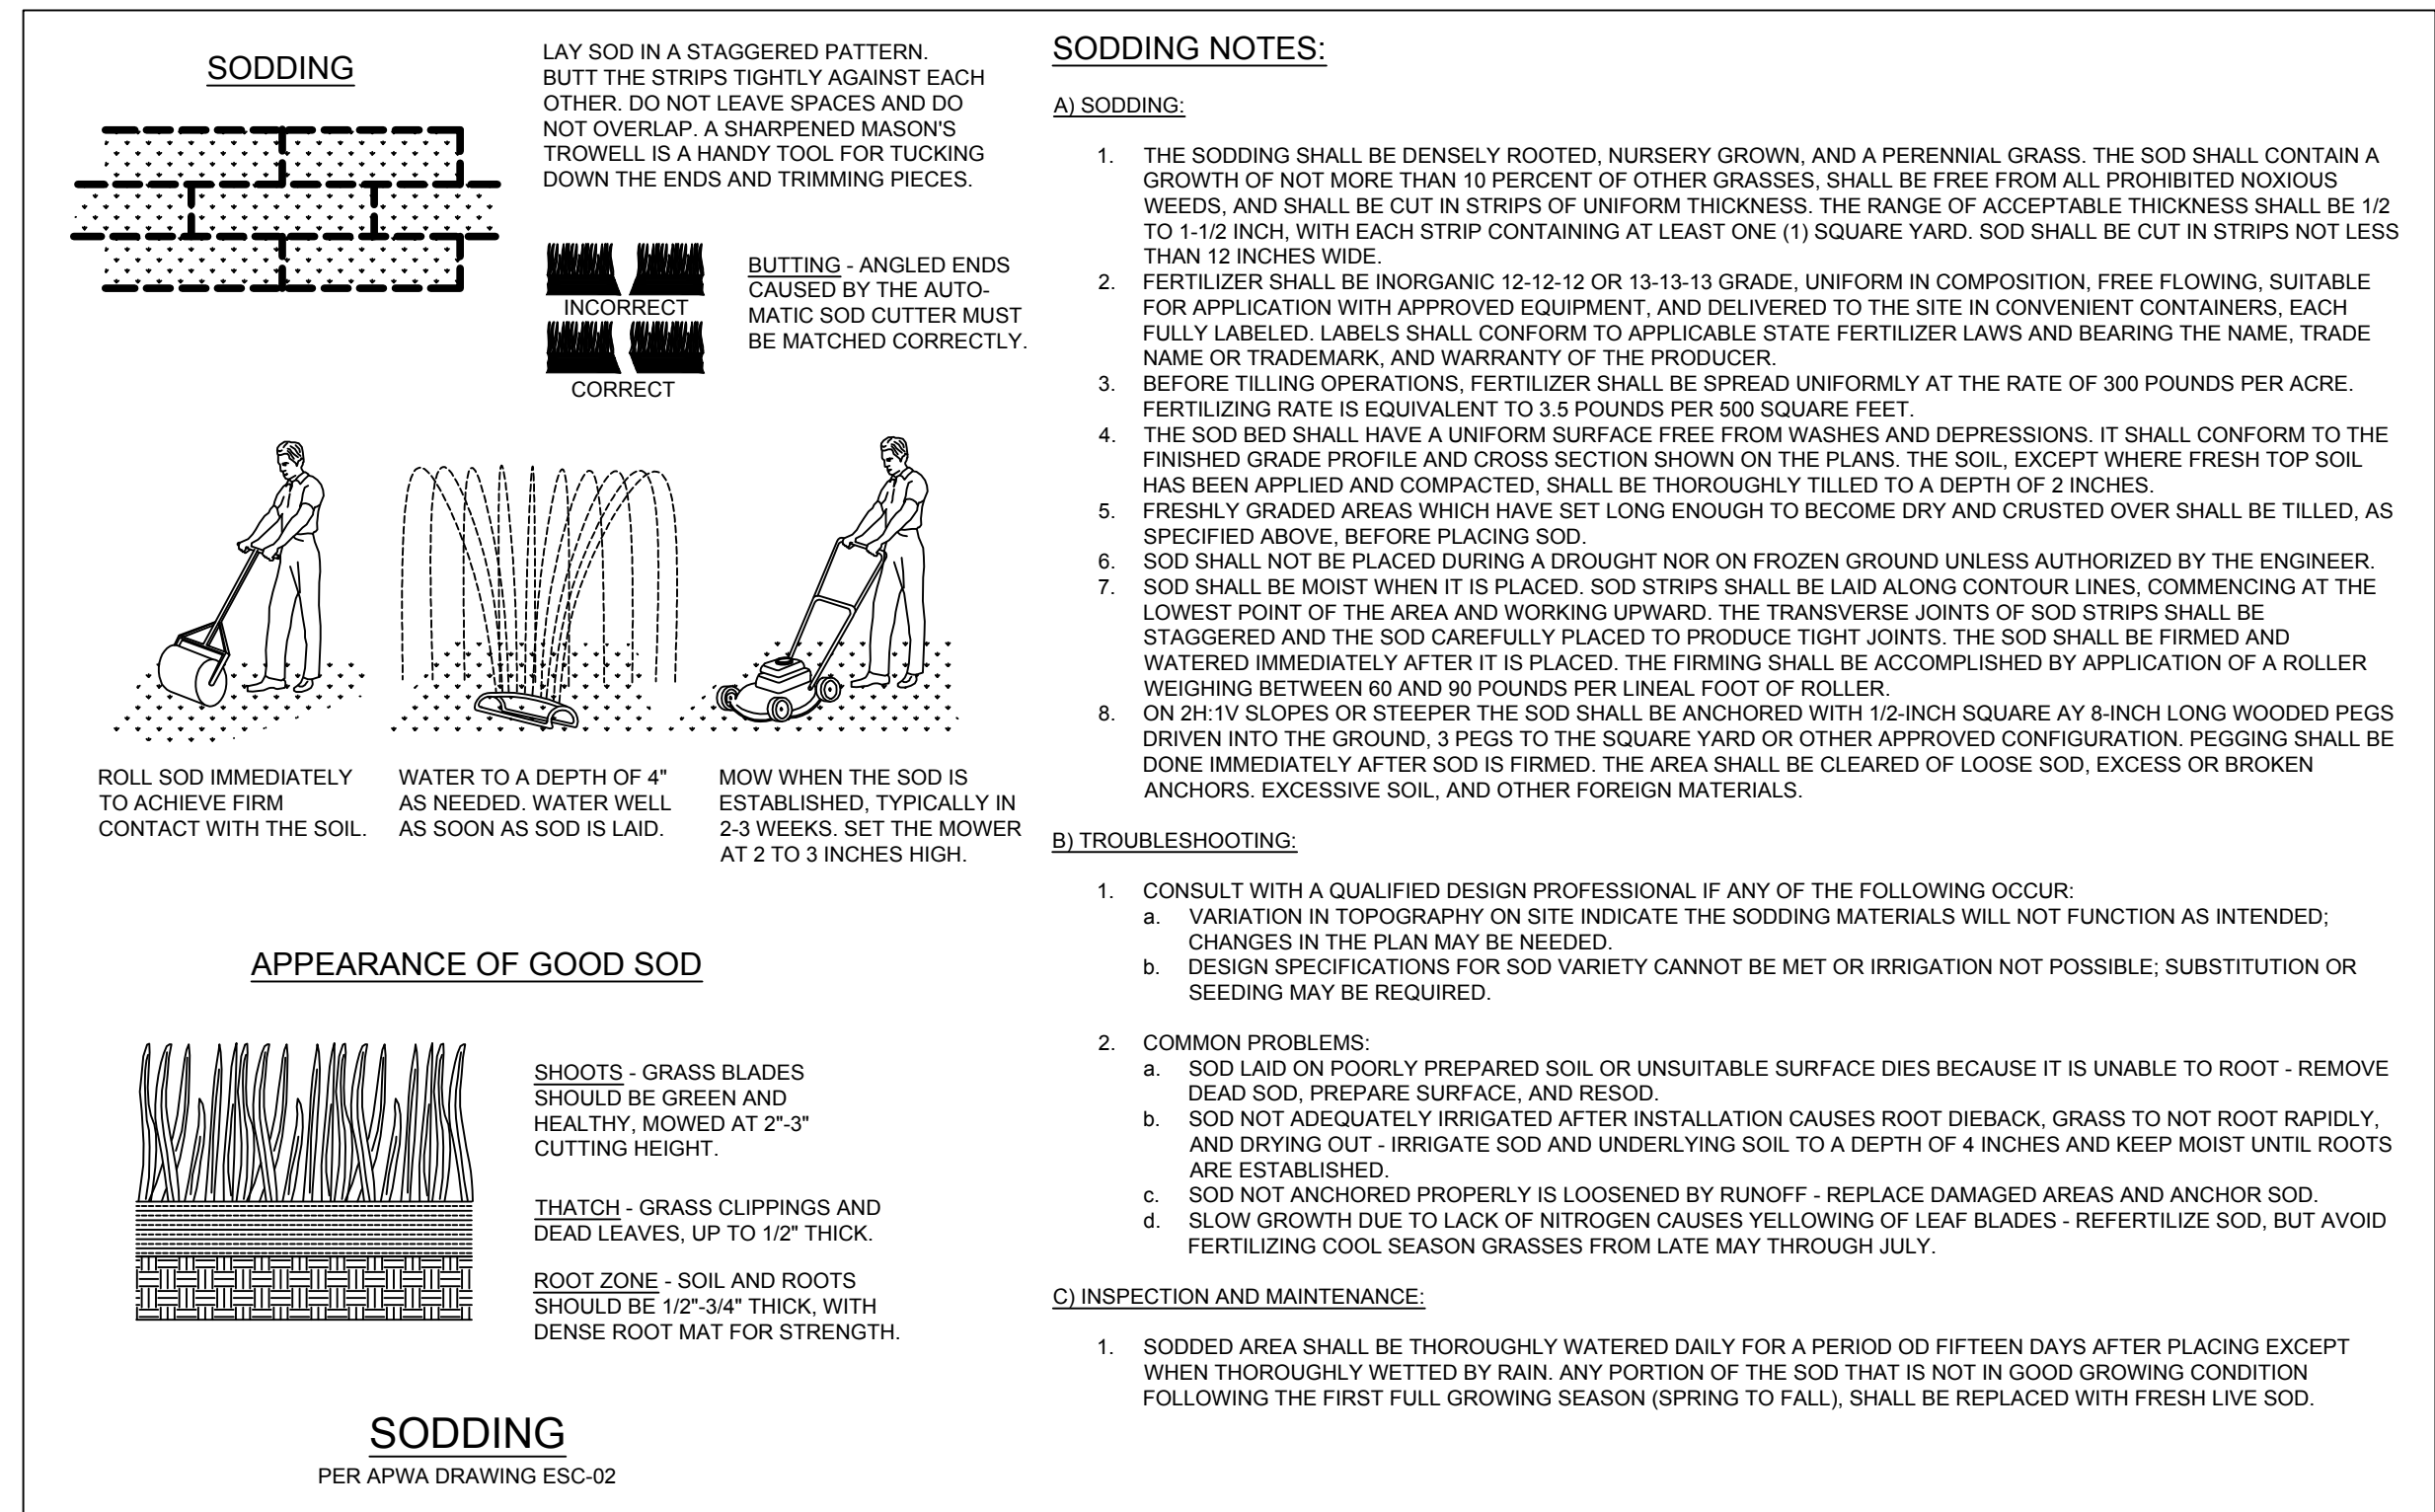

AMERICAN PUBLIC WORKS ASSOCIATION	
KANSAS CITY METRO CHAPTER	
SILT FENCE	STANDARD DRAWING NUMBER ESC-03 REVISED 10/24/2006

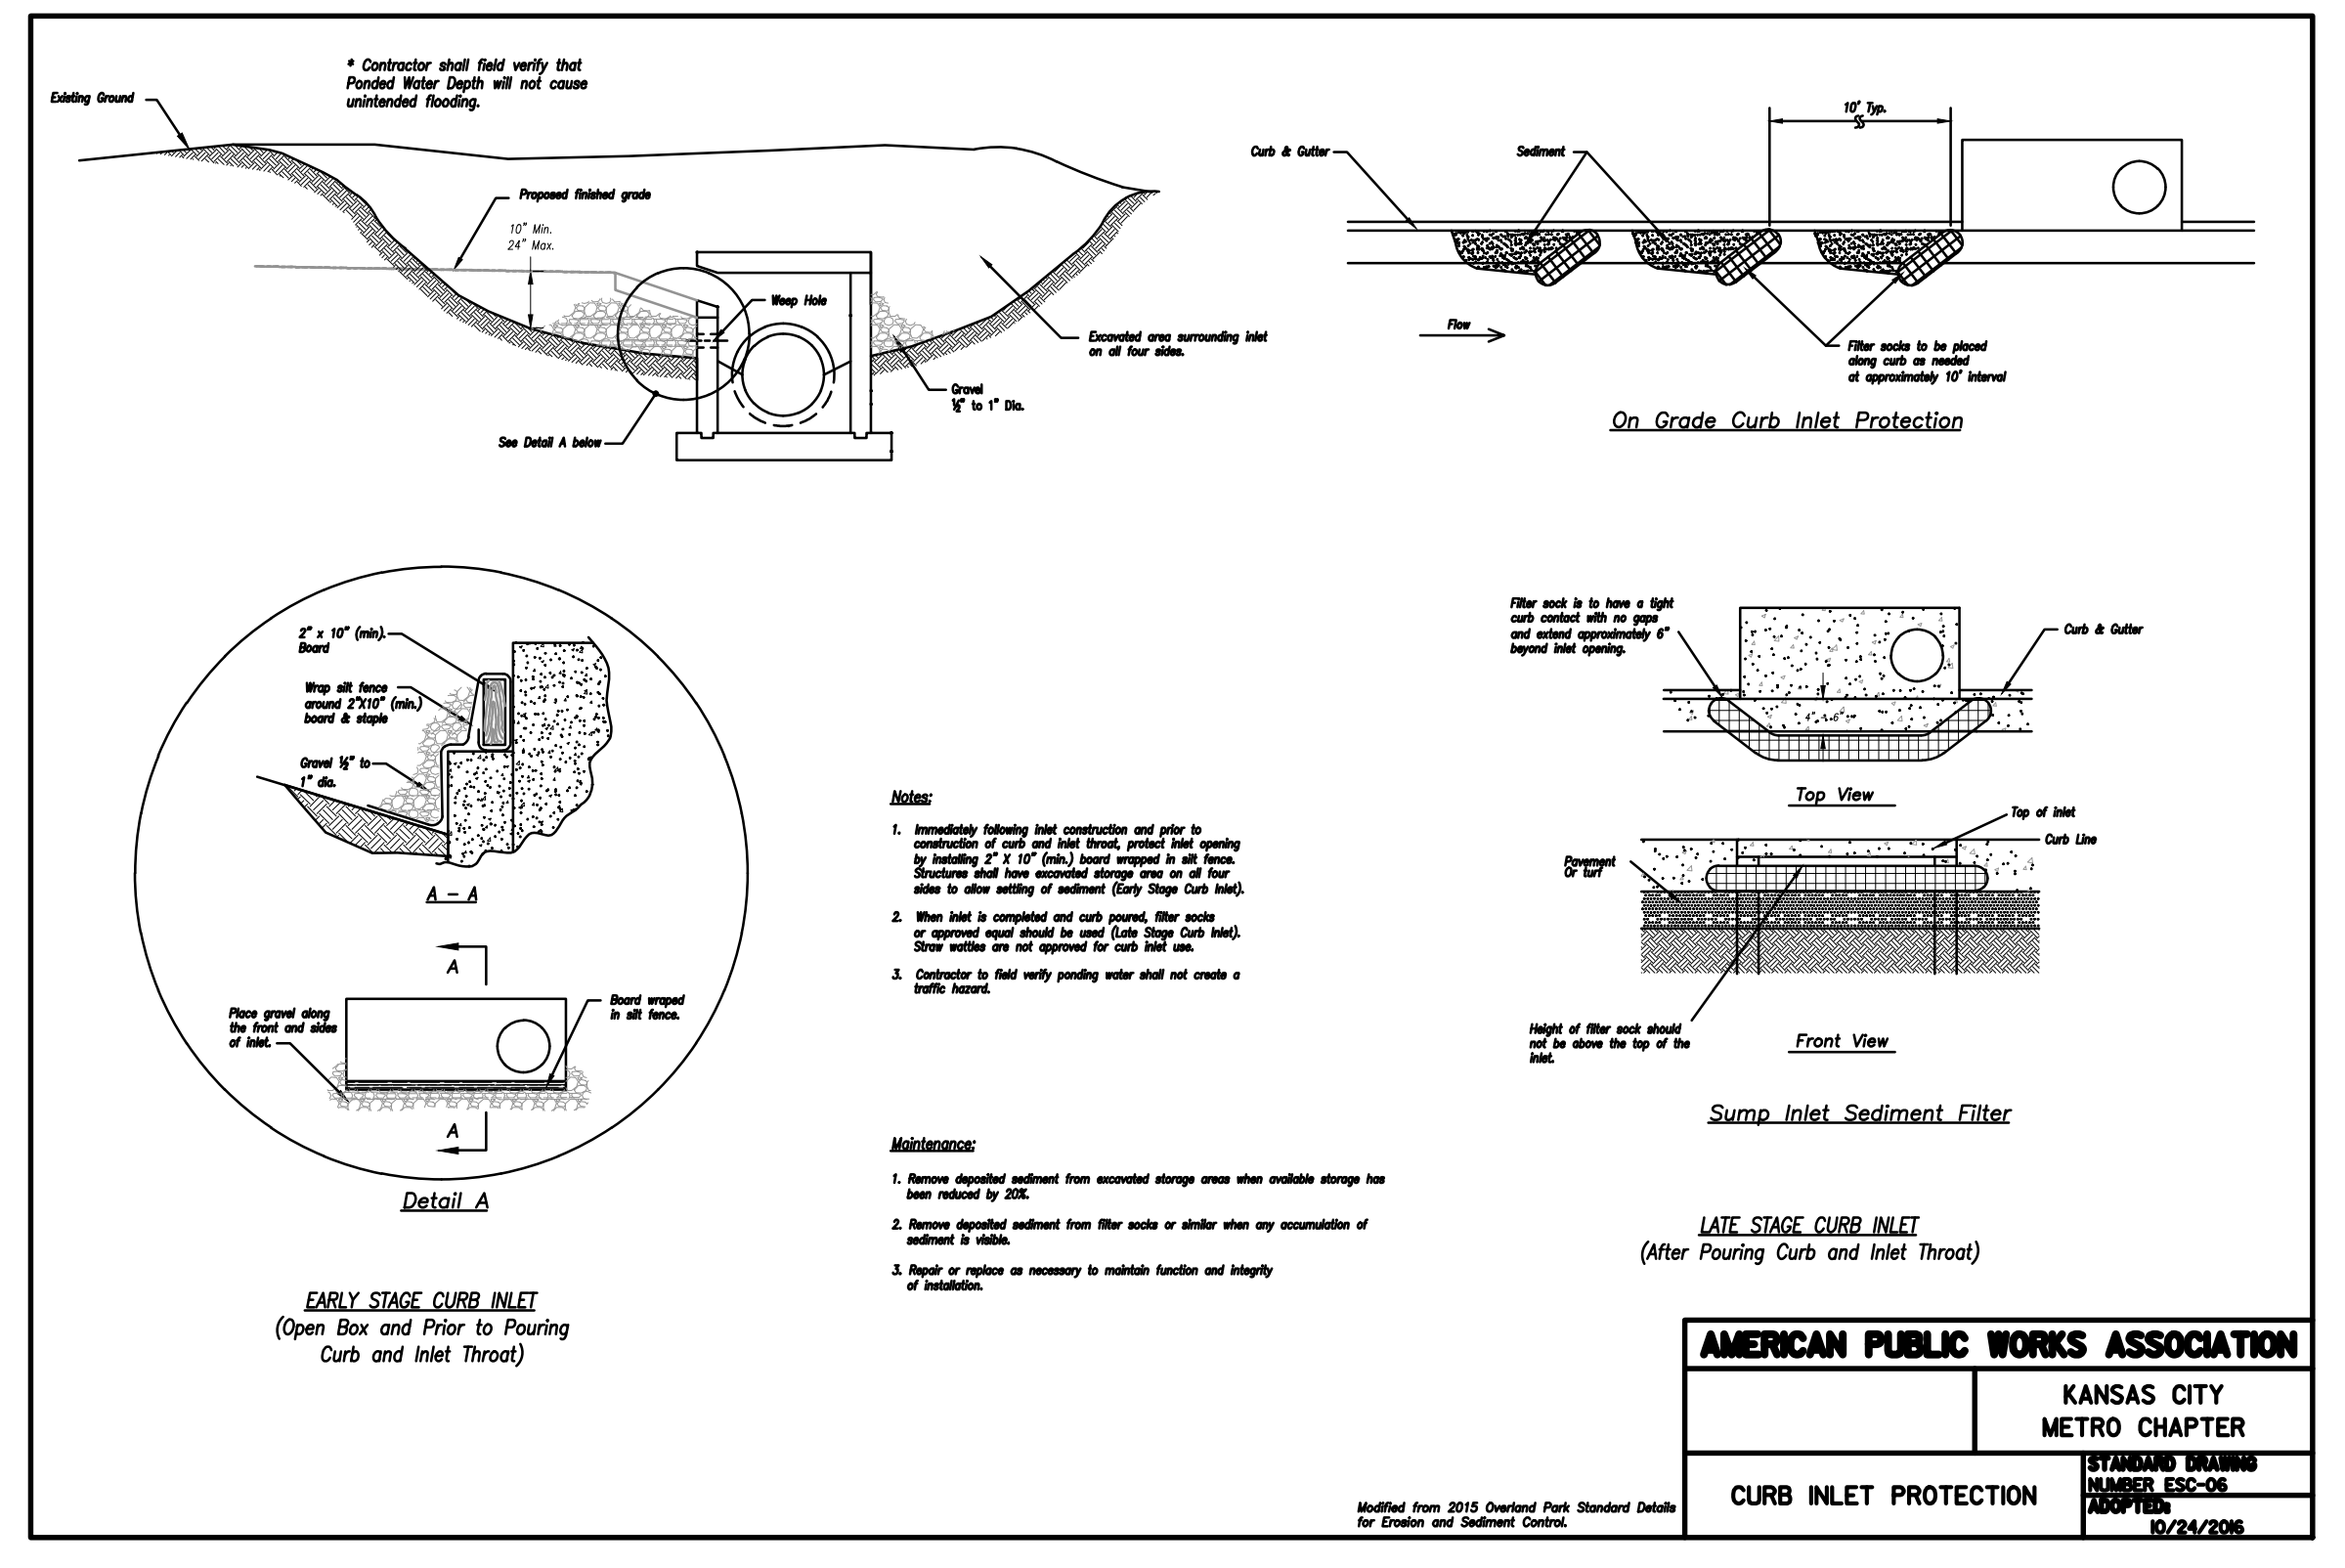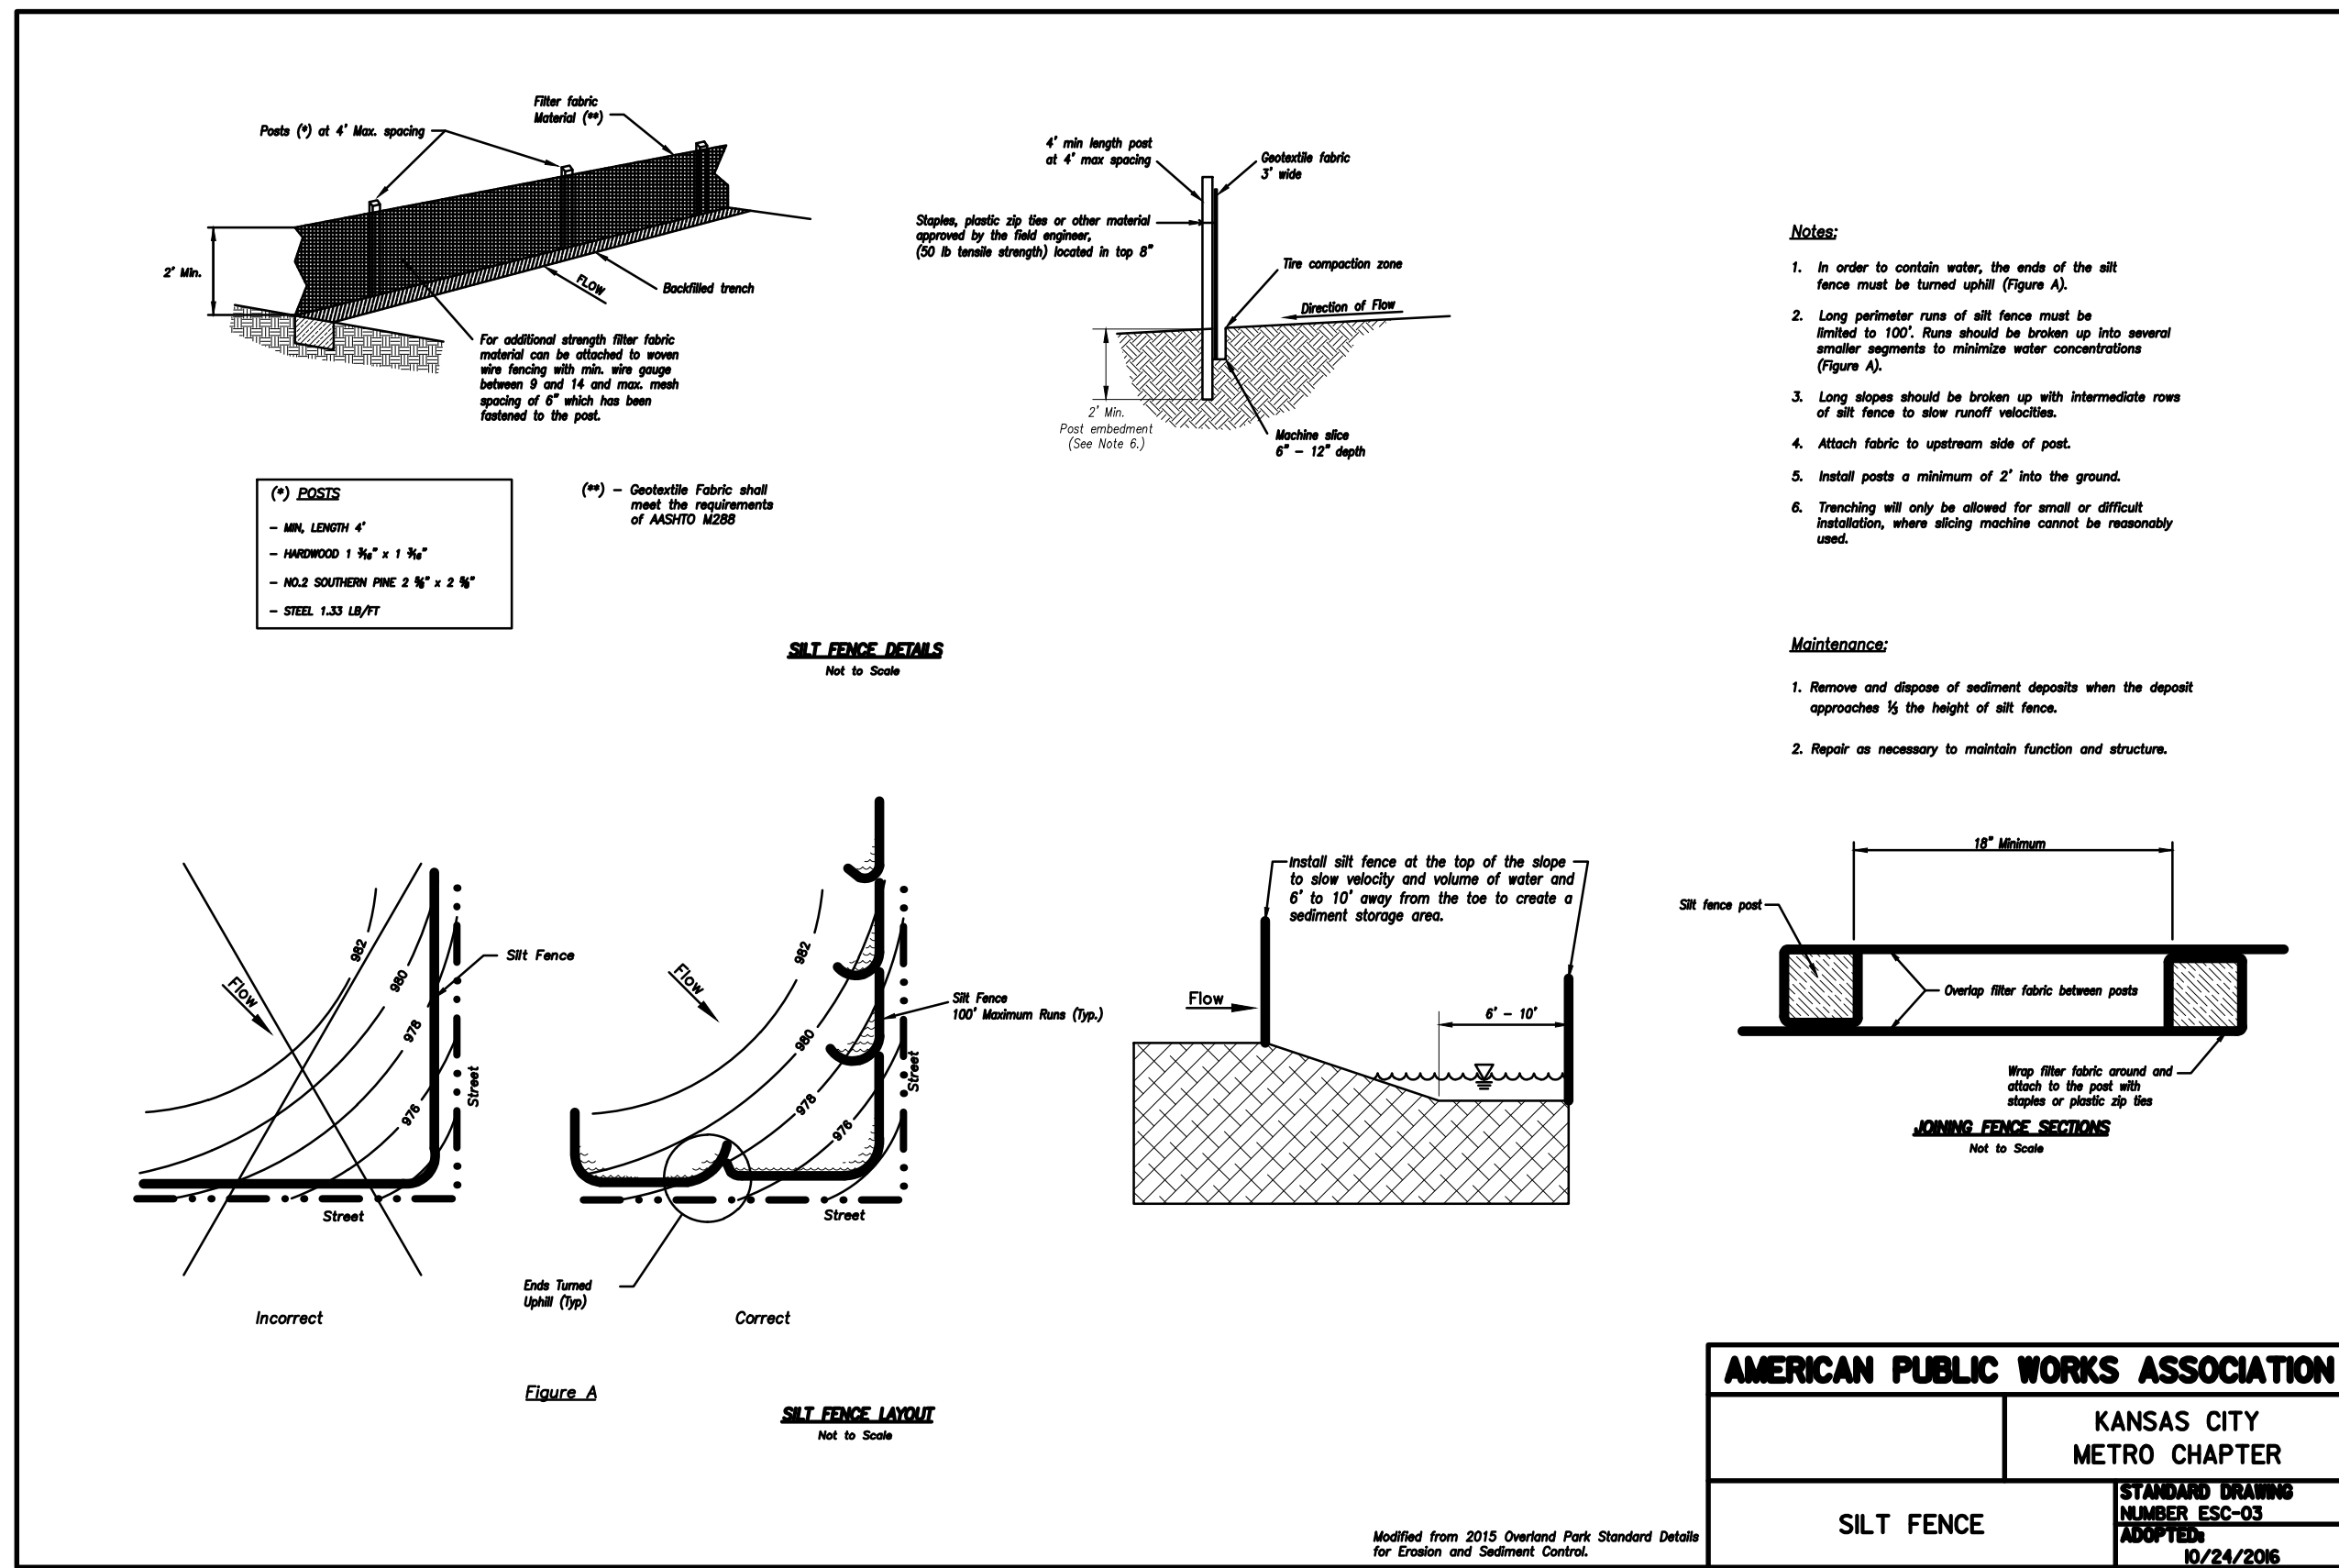

AMERICAN PUBLIC WORKS ASSOCIATION	
KANSAS CITY METRO CHAPTER	
CURB INLET PROTECTION	STANDARD DRAWING NUMBER ESC-06 REVISED 10/24/2006

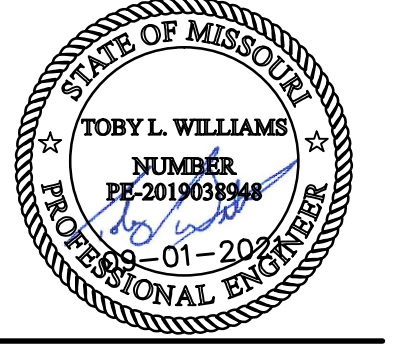


PREPARED FOR:
WARD DEVELOPMENT
DAVID WARD
1120 NW EAGLE RIDGE BLVD.
GRAIN VALLEY, MO 64029
(816) 229-8115

LOT 10, I-470 BUSINESS AND TECHNOLOGY CENTER
2601 NE MCBAIN DRIVE
LEE'S SUMMIT, MO 64064


REVISIONS NO. DATE / DESCRIPTION	PROJECT #: 21-1902
	ISSUE DATE: 09/01/2021
	ISSUED FOR:

FOR PERMIT
EROSION CONTROL
DETAILS
C-131


RELEASED FOR
CONSTRUCTION
As Noted on Plans Review
Development Services Department
Lee's Summit, Missouri
01/14/2022

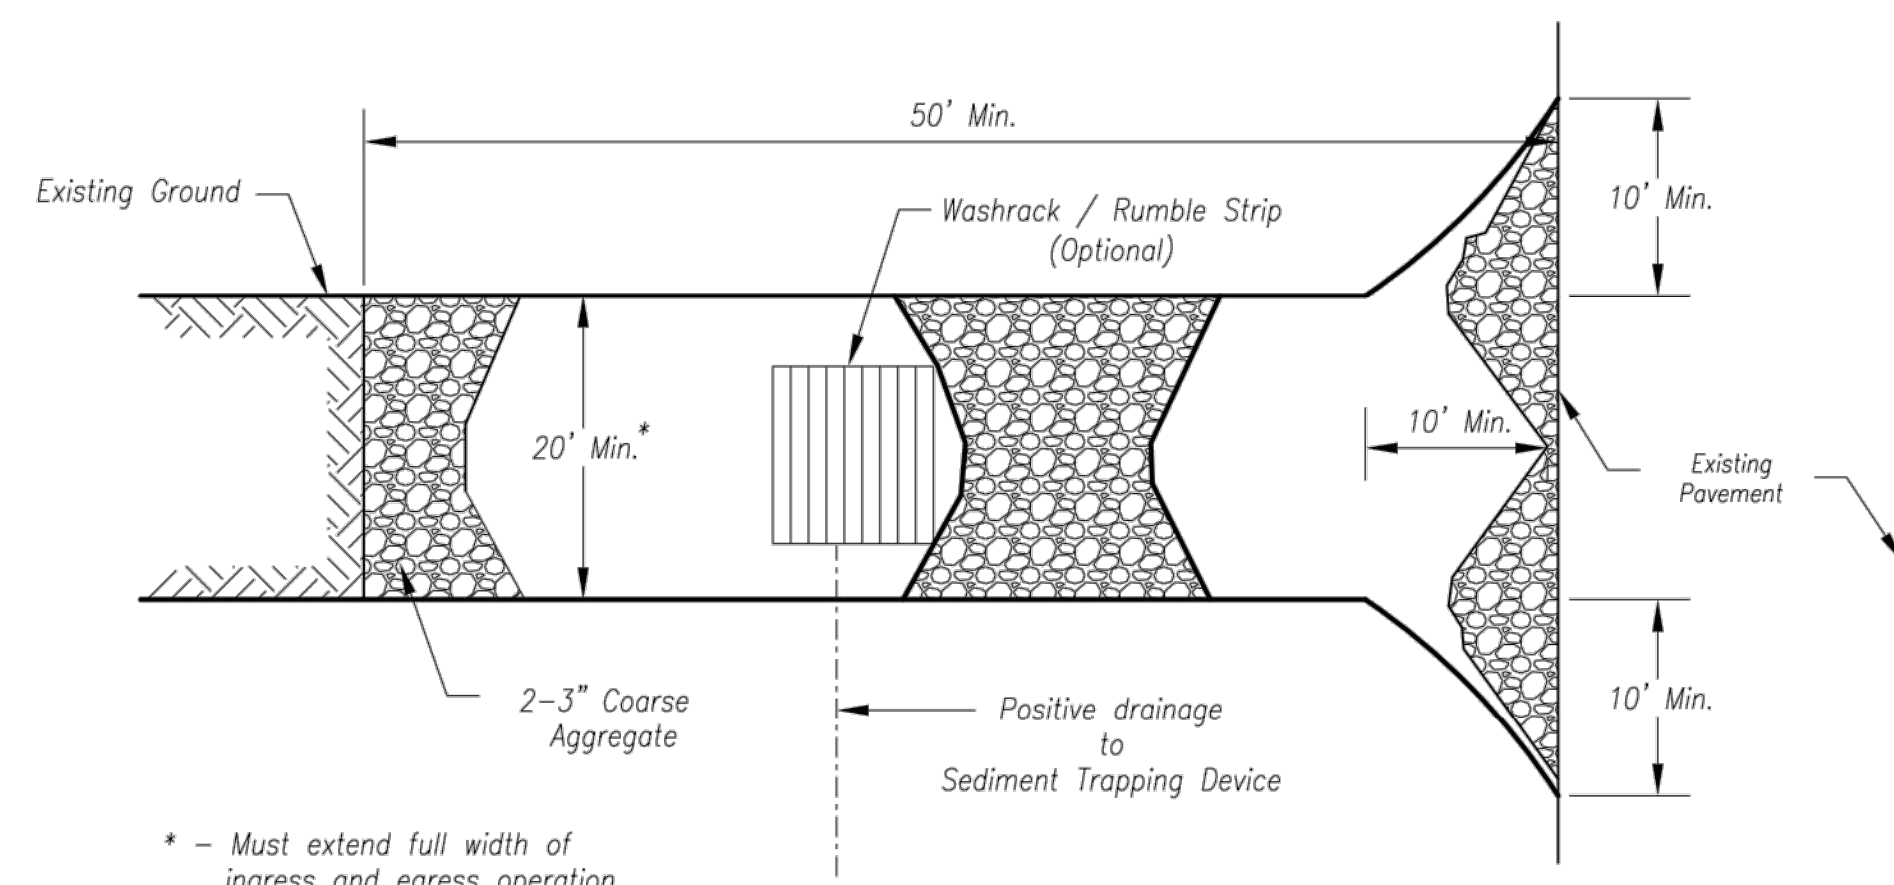

Plan View
Not to Scale

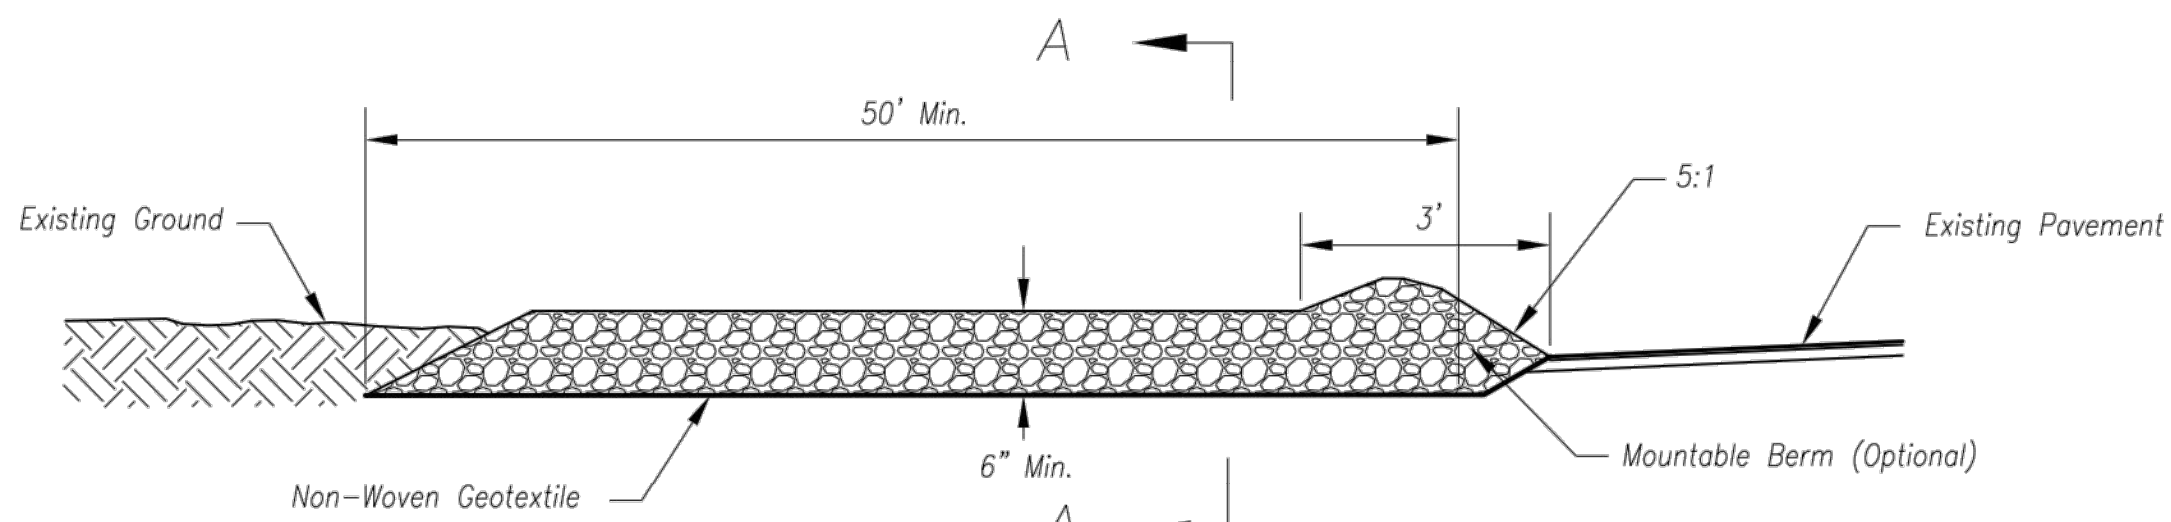

Side Elevation
Not to Scale

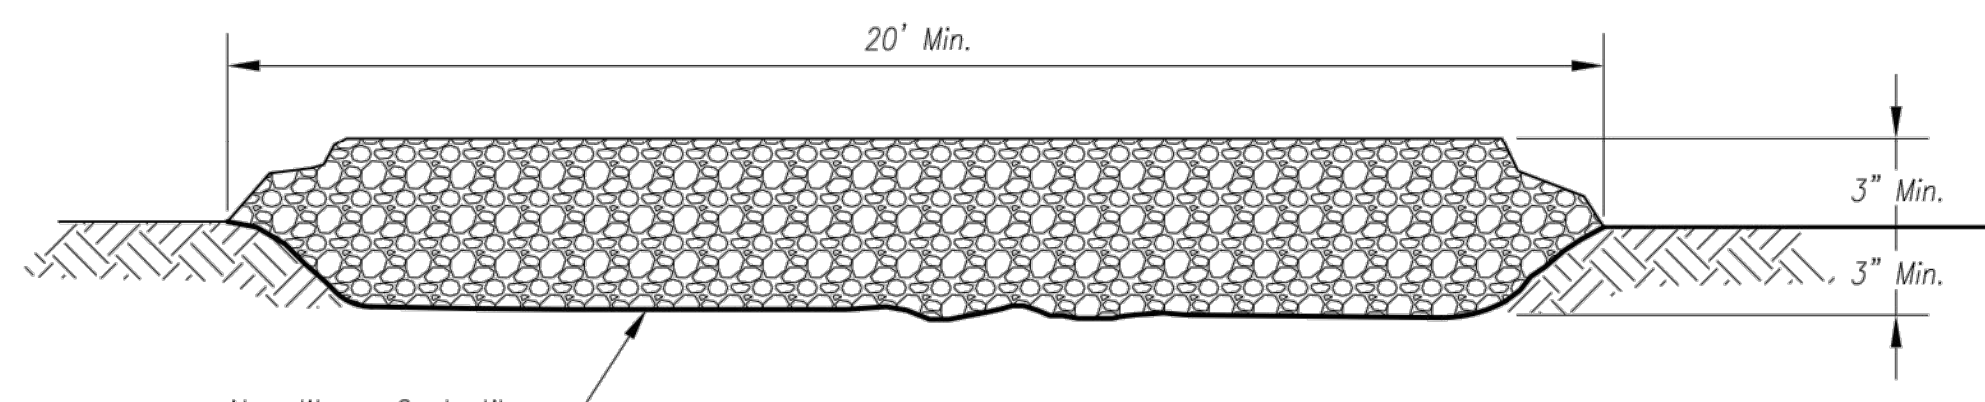

Section A-A
Not to Scale

Notes for Construction Entrance:

1. Avoid locating on steep slopes, at curves on public roads, or downhill of disturbed area.
2. Remove all vegetation and other unsuitable material from the foundation area, grade, and crown for positive drainage.
3. If slope towards the public road exceeds 2%, construct a 6- to 8-inch high ridge with 3H:1V side slopes across the foundation approximately 15 feet from the edge of the public road to divert runoff from it.
4. Install pipe under the entrance if needed to maintain drainage ditches along public roads.
5. Place stone to dimensions and grade as shown on plans. Leave surface sloped for drainage.
6. Divert all surface runoff and drainage from the entrance to a sediment control device.
7. If conditions warrant, place geotextile fabric on the graded foundation to improve stability.

Maintenance for Construction Entrance:

1. Reshape entrance as needed to maintain function and integrity of installation. Top dress with clean aggregate as needed.


CONSTRUCTION ENTRANCE

Notes for Concrete Washout:

1. Concrete washout areas shall be installed prior to any concrete placement on site.
2. Concrete washout area shall include a flat subsurface pit sized relative to the amount of concrete to be placed on site. The slopes leading out of the subsurface pit shall be 3:1. The vehicle tracking pad shall be sloped towards the concrete washout area.
3. Vehicle tracking control is required at the access point to all concrete washout areas.
4. Signs shall be placed at the construction site entrance, washout area and elsewhere as necessary to clearly indicate the location(s) of the concrete washout area(s) to operators of concrete truck and pump rigs.
5. A one-piece impervious liner may be required along the bottom and sides of the subsurface pit in sandy or gravelly soils.

Maintenance for Concrete Washout:

1. Concrete washout materials shall be removed once the materials have filled the washout to approximately 75% full.
2. Concrete washout areas shall be enlarged as necessary to maintain capacity for wasted concrete.
3. Concrete washout water, wasted pieces of concrete and all other debris in the subsurface pit shall be transported from the job site in a water-tight container and disposed of properly.
4. Concrete washout areas shall remain in place until all concrete for the project is placed.
5. When concrete washout areas are removed, excavations shall be filled with suitable compacted backfill and topsoil, any disturbed areas associated with the installation, maintenance, and/or removal of the concrete washout areas shall be stabilized.

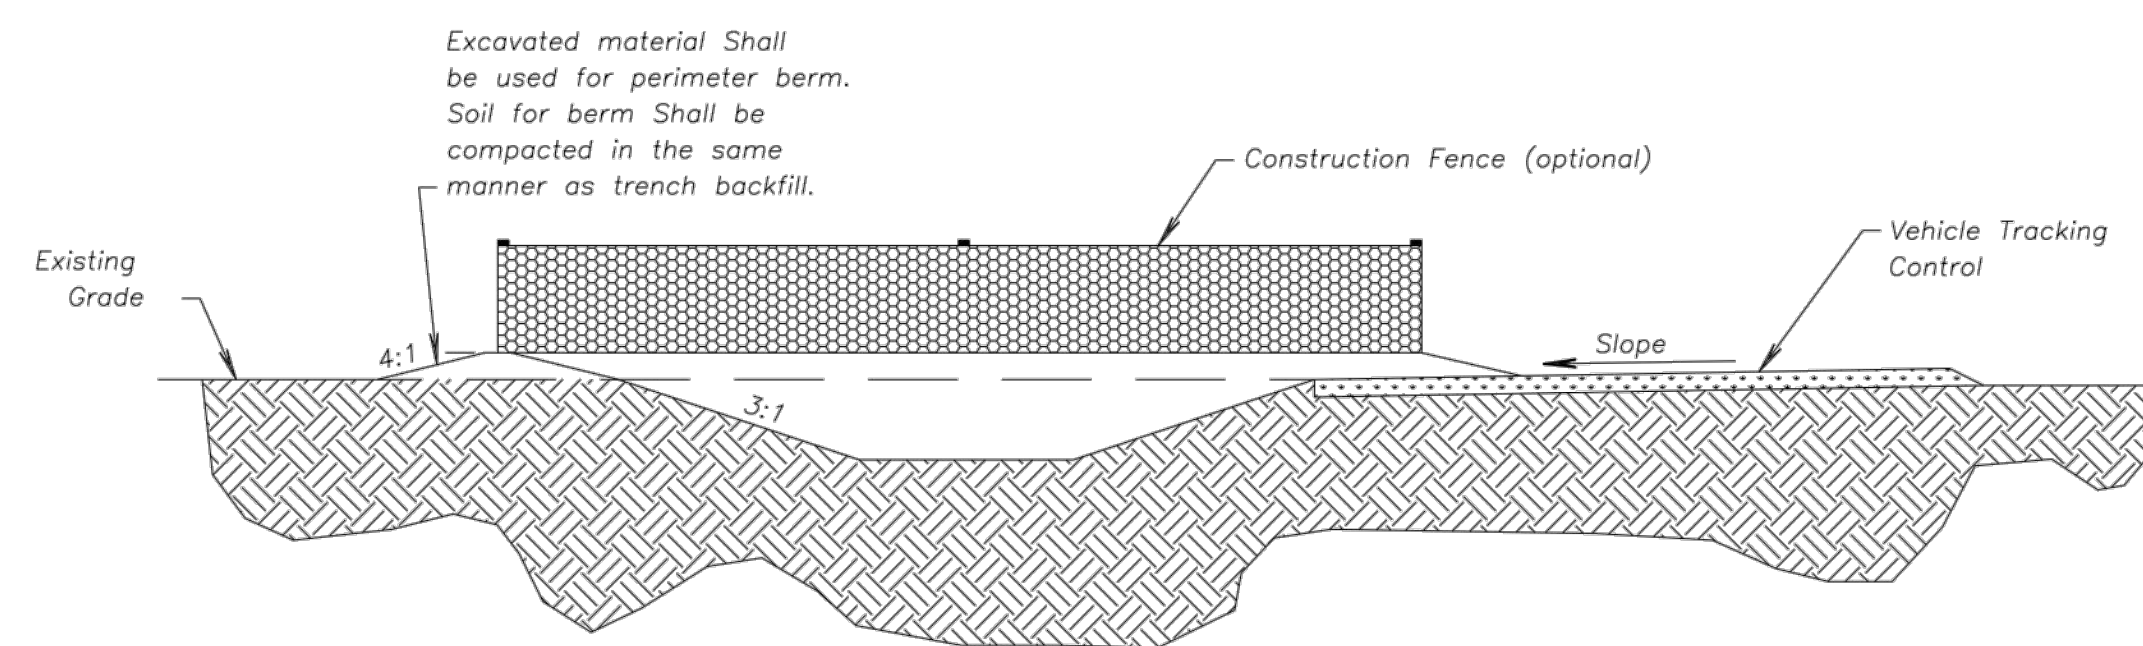

CONCRETE WASHOUT

RELEASED FOR CONSTRUCTION
As Noted on Plans Review
Development Services Department
Lee's Summit, Missouri
01/14/2022


Construction Entrance modified from 2015 Overland Park Standard Details for Erosion and Sediment Control; Concrete Washout modified from 2009 City of Great Bend Standard Drawings.

AMERICAN PUBLIC WORKS ASSOCIATION	
 Kansas City Metro Chapter AMERICAN PUBLIC WORKS ASSOCIATION	KANSAS CITY METRO CHAPTER
CONSTRUCTION ENTRANCE AND CONCRETE WASHOUT	STANDARD DRAWING NUMBER ESC-01 ADOPTED: 10/24/2016

Certificates of Authority
Architecture: MO 318 / KS 33
Engineering: MO 4 / KS 241
Land Surveying: MO 123 / KS 36

© 2019 Powell CWM, Inc. This drawing has been prepared by Powell CWM, Inc. This drawing is provided as an instrument of service by Powell CWM and is intended for use on the project only pursuant to the Architectural Works Copyright Protection Act of 1990, all drawings, specifications, lists and designs, including the overall form arrangement and composition of spaces and elements appearing herein constitute the original copyrighted work of Powell CWM, Inc. Any reproduction, use or disclosure of information contained herein without prior written consent of Powell CWM, Inc. is strictly prohibited.

Toby L. Williams, PE
PE-2019038948 (MISSOURI #)

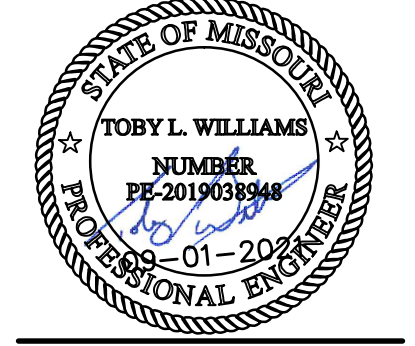

PREPARED FOR:
WARD DEVELOPMENT
DAVID WARD
1120 NW EAGLE RIDGE BLVD.
GRAIN VALLEY, MO 64029
(816) 229-8115


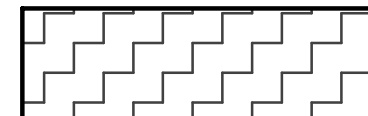
 
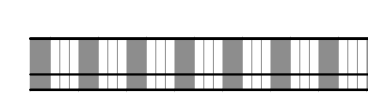
LOT 10, I-470 BUSINESS AND TECHNOLOGY CENTER
 2601 NE MCBAIN DRIVE
 LEE'S SUMMIT, MO 64064

REVISIONS NO.	DATE / DESCRIPTION


PROJECT #: 21-1902
ISSUE DATE: 09/01/2021
ISSUED FOR:

FOR PERMIT
EROSION CONTROL DETAILS
C-132


LEGEND:

-  NEW CONCRETE PAVEMENT
-  NEW HEAVY DUTY CONCRETE PAVEMENT
-  NEW TYPE CG-1 CURB & GUTTER
-  NEW TYPE CG-1 CURB & GUTTER (DRY)



OFFICE AREA = 1,840 SQ. FT.
 WAREHOUSE AREA = 16,583 SQ. FT.
 REQUIRED PARKING PER OFFICE 4/1,000 sq. ft. = 8 STALLS
 REQUIRED PARKING PER WAREHOUSE 1/1,000 sq. ft. = 20 STALLS
 PARKING PROVIDED = 31 STALLS

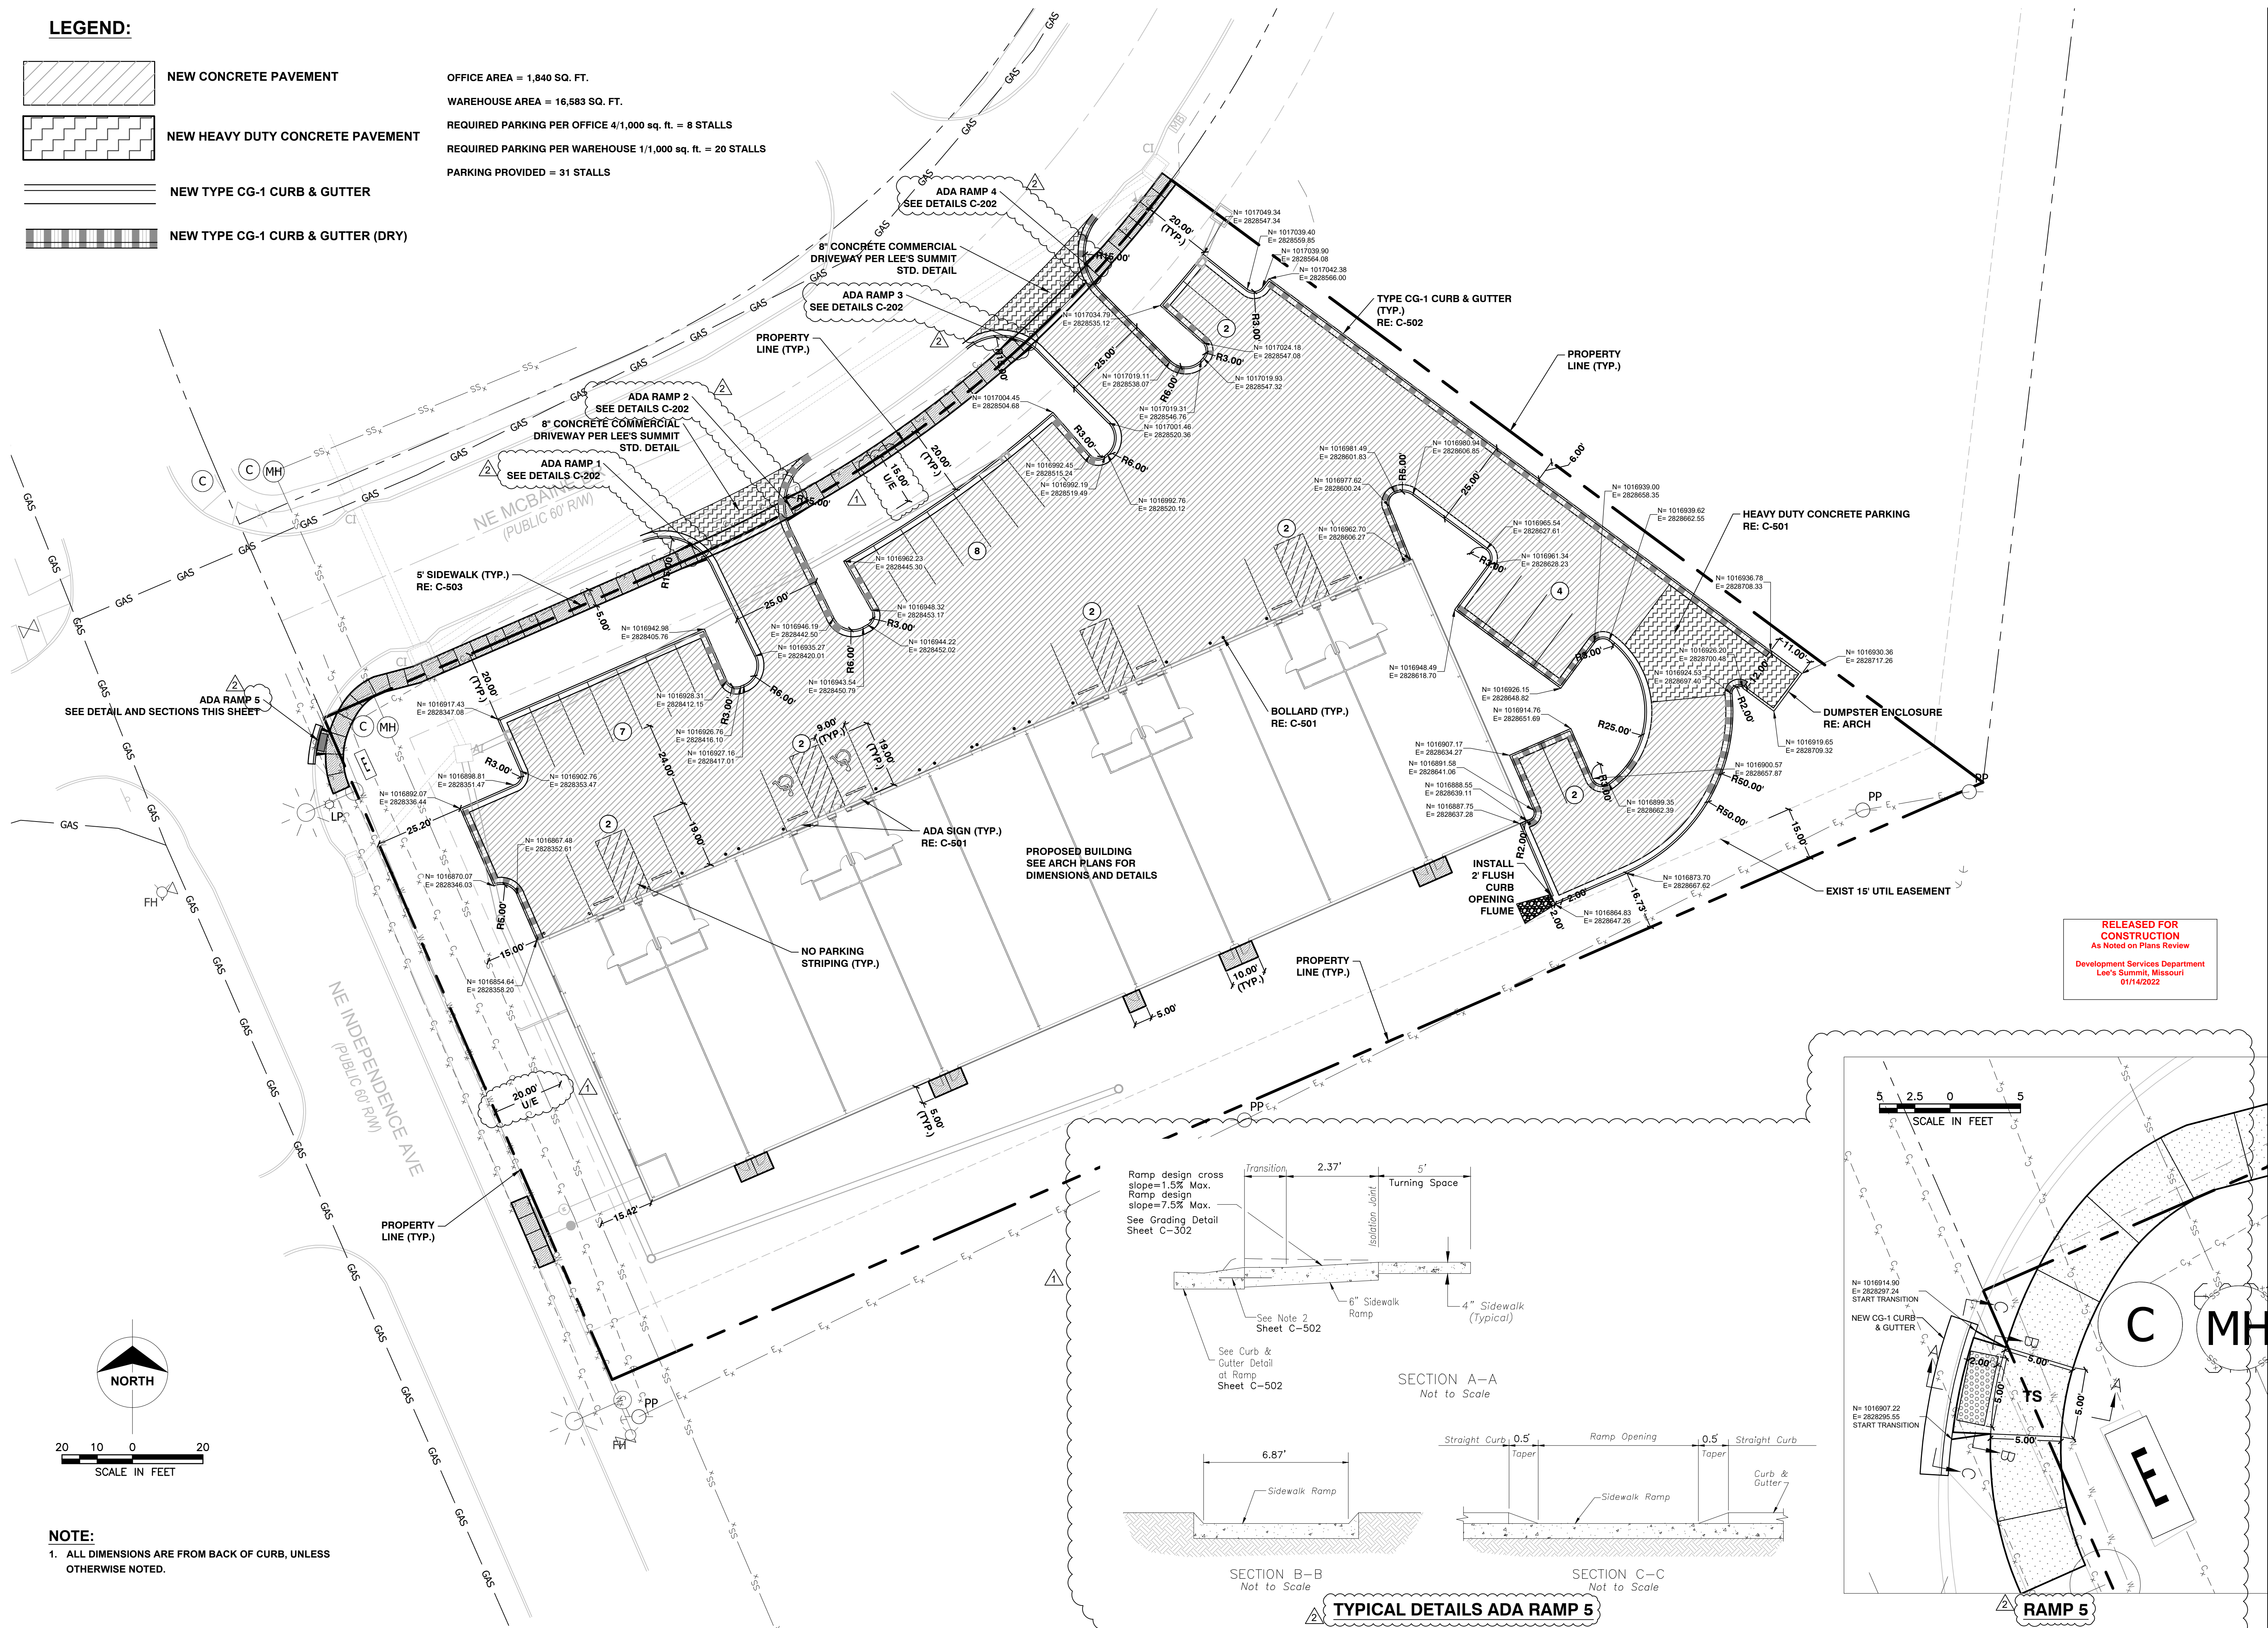

RELEASED FOR CONSTRUCTION
 As Noted on Plans Review
 Development Services Department
 Lee's Summit, Missouri
 01/14/2022

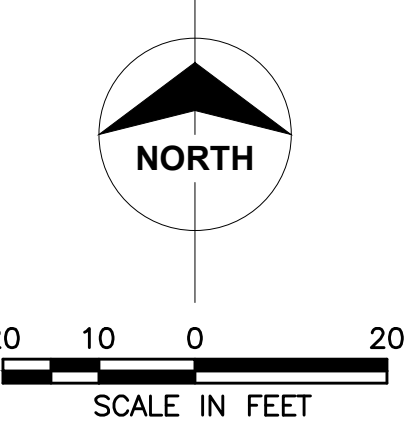


NOTE:
 1. ALL DIMENSIONS ARE FROM BACK OF CURB, UNLESS OTHERWISE NOTED.

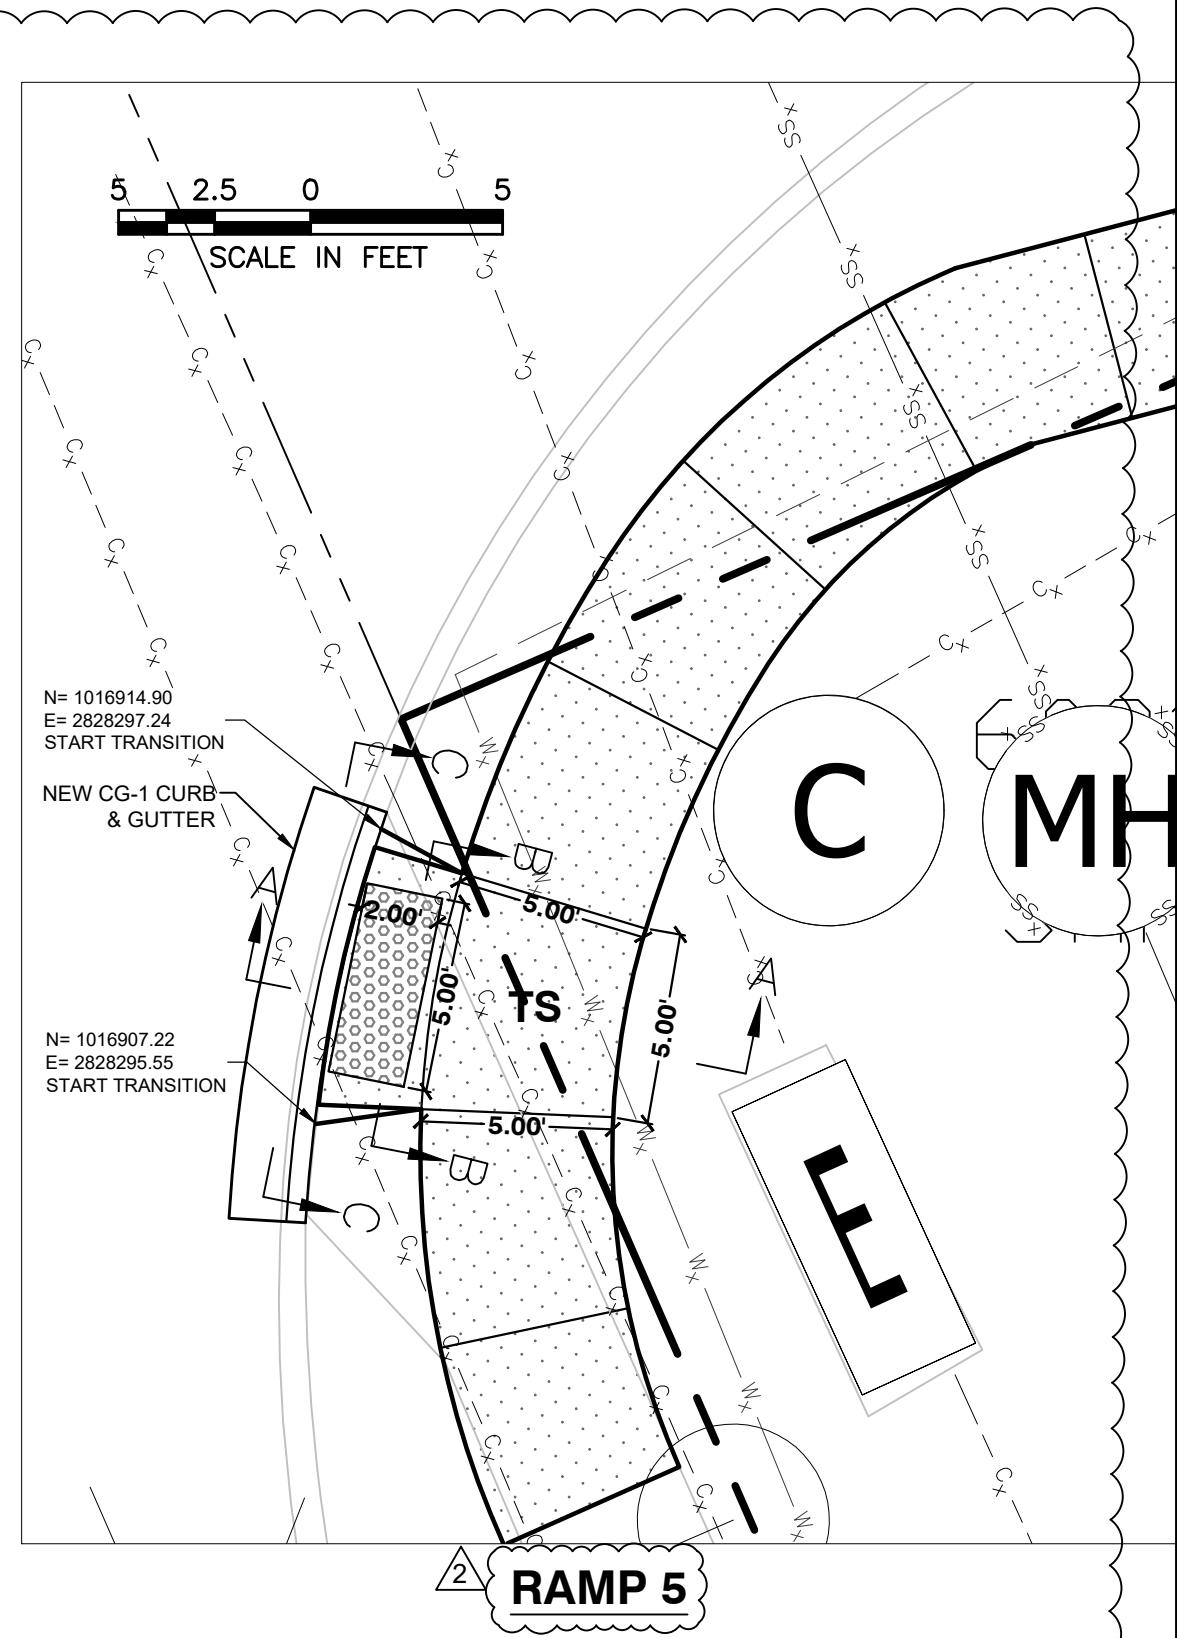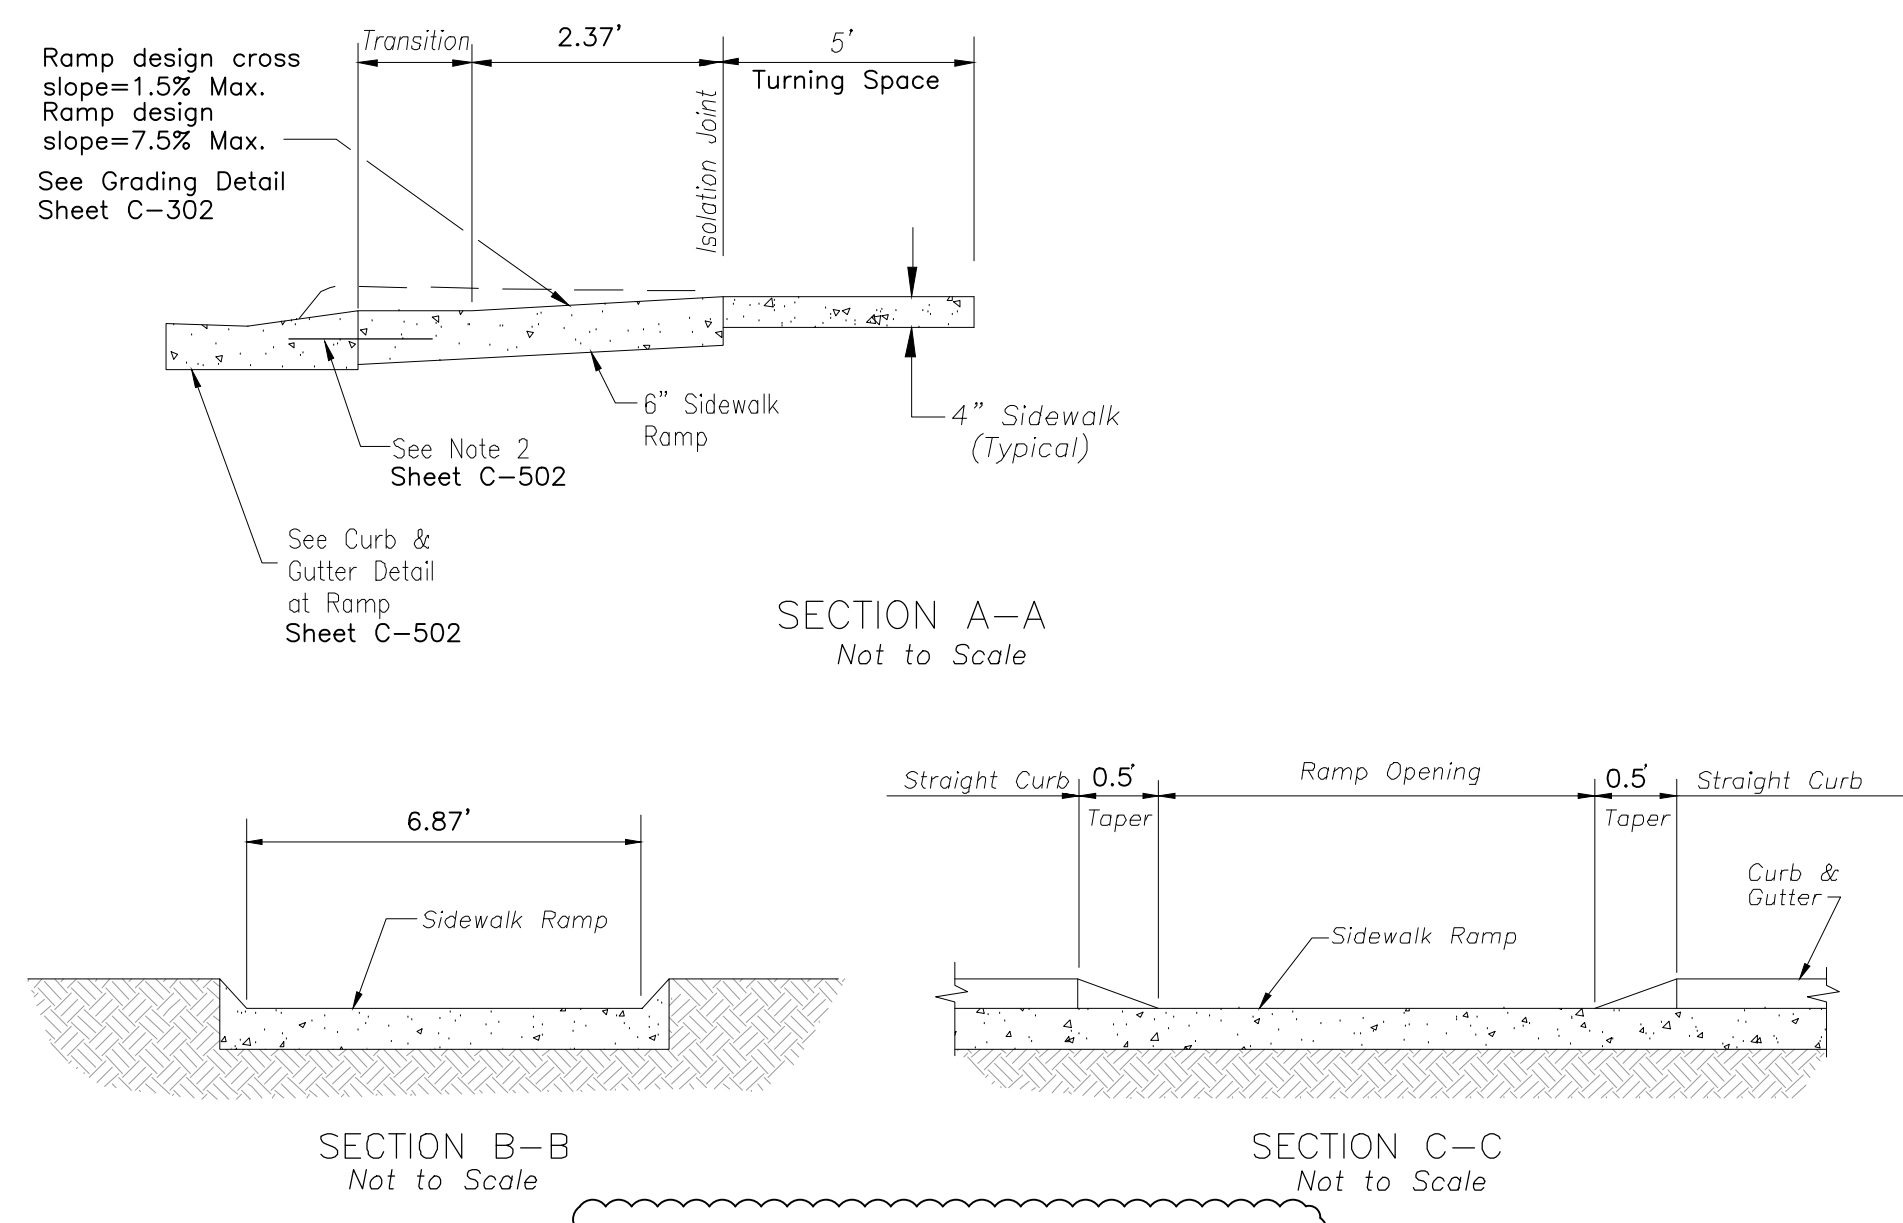

Certificate of Authority
 Architecture: MO 318 / E. 13
 Engineering: MO 4 / K.S. 241
 Land Surveying: MO 123 / K.S. 34

© 2019 Powell CWM, Inc.
 This drawing has been prepared by Powell CWM, Inc. This drawing is provided as an instrument of service by Powell CWM and is intended for use on this project only, pursuant to the Architectural Works Copyright Protection Act of 1990. All drawings, specifications, notes and design, including the overall form arrangement and composition of spaces and elements appearing herein constitute the original copyrighted work of Powell CWM, Inc. Any reproduction, use or disclosure of information contained herein without prior written consent of Powell CWM, Inc. is strictly prohibited.

Toby L. Williams, PE
 PE-2019038948 (MISSOURI #)

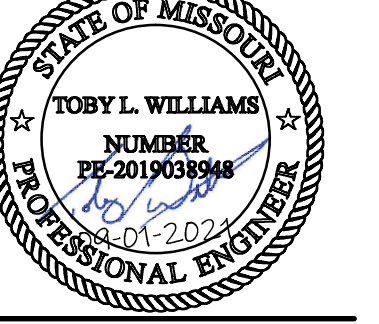


PREPARED FOR:
 WARD DEVELOPMENT
 DAVID WARD
 1120 NW EAGLE RIDGE BLVD.
 GRAIN VALLEY, MO 64029
 (816) 229-8115


LOT 10, I-470 BUSINESS AND TECHNOLOGY CENTER
 2601 NE MCBAIN DRIVE
 LEE'S SUMMIT, MO 64064

REVISIONS	NO.	DATE / DESCRIPTION
	1	1-11/09/2021 - CITY COMMENTS
	2	1-22/22/2021 - CITY COMMENTS


PROJECT #: 21-1902
 ISSUE DATE: 09/01/2021
 ISSUED FOR:

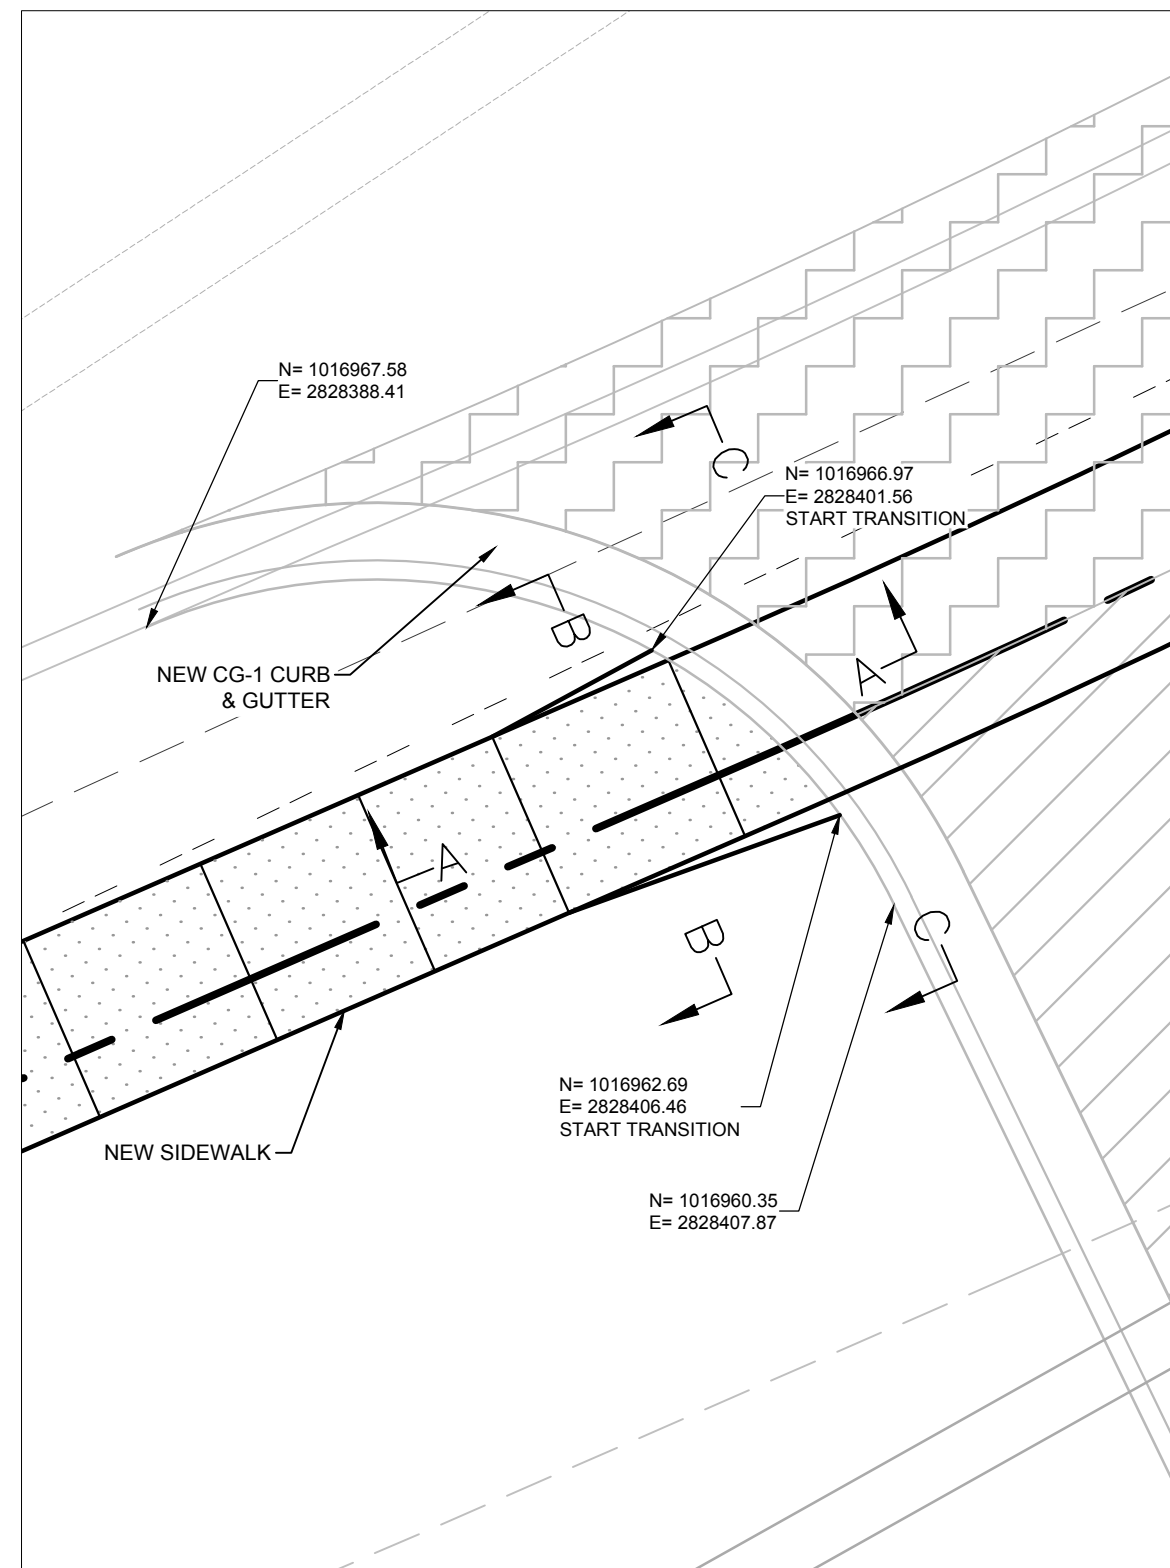


ADA RAMP 1

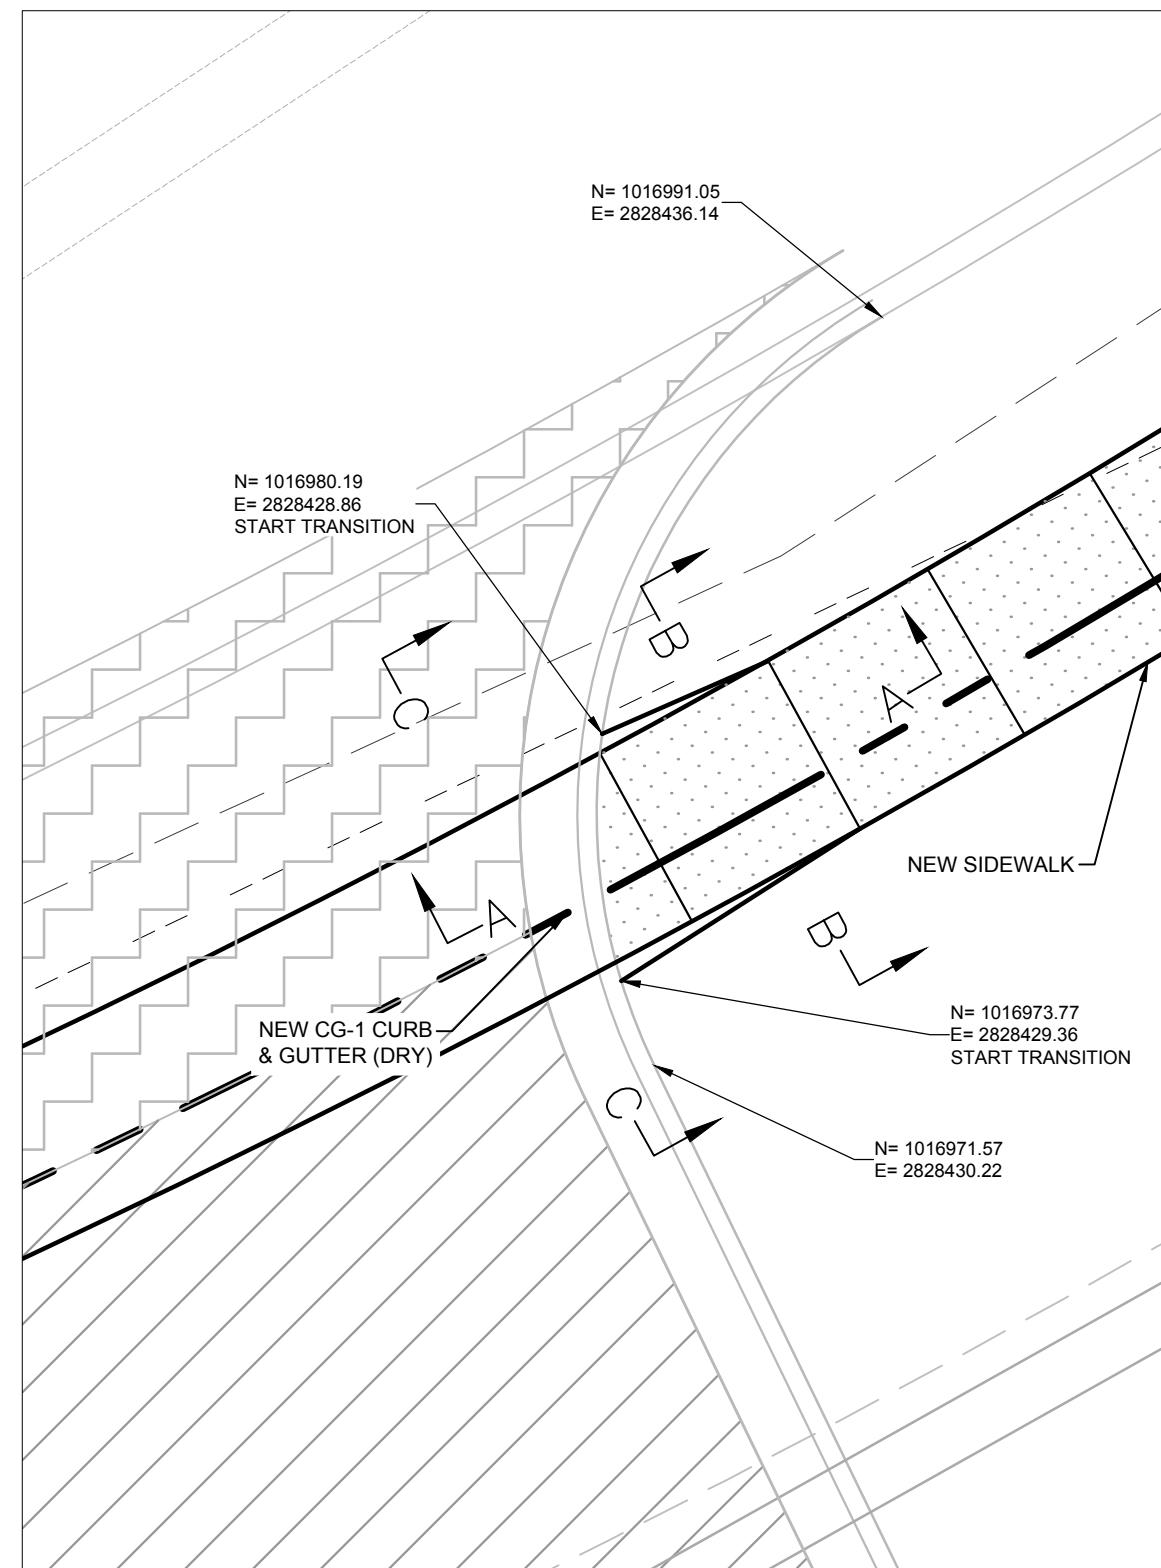


ADA RAMP 2

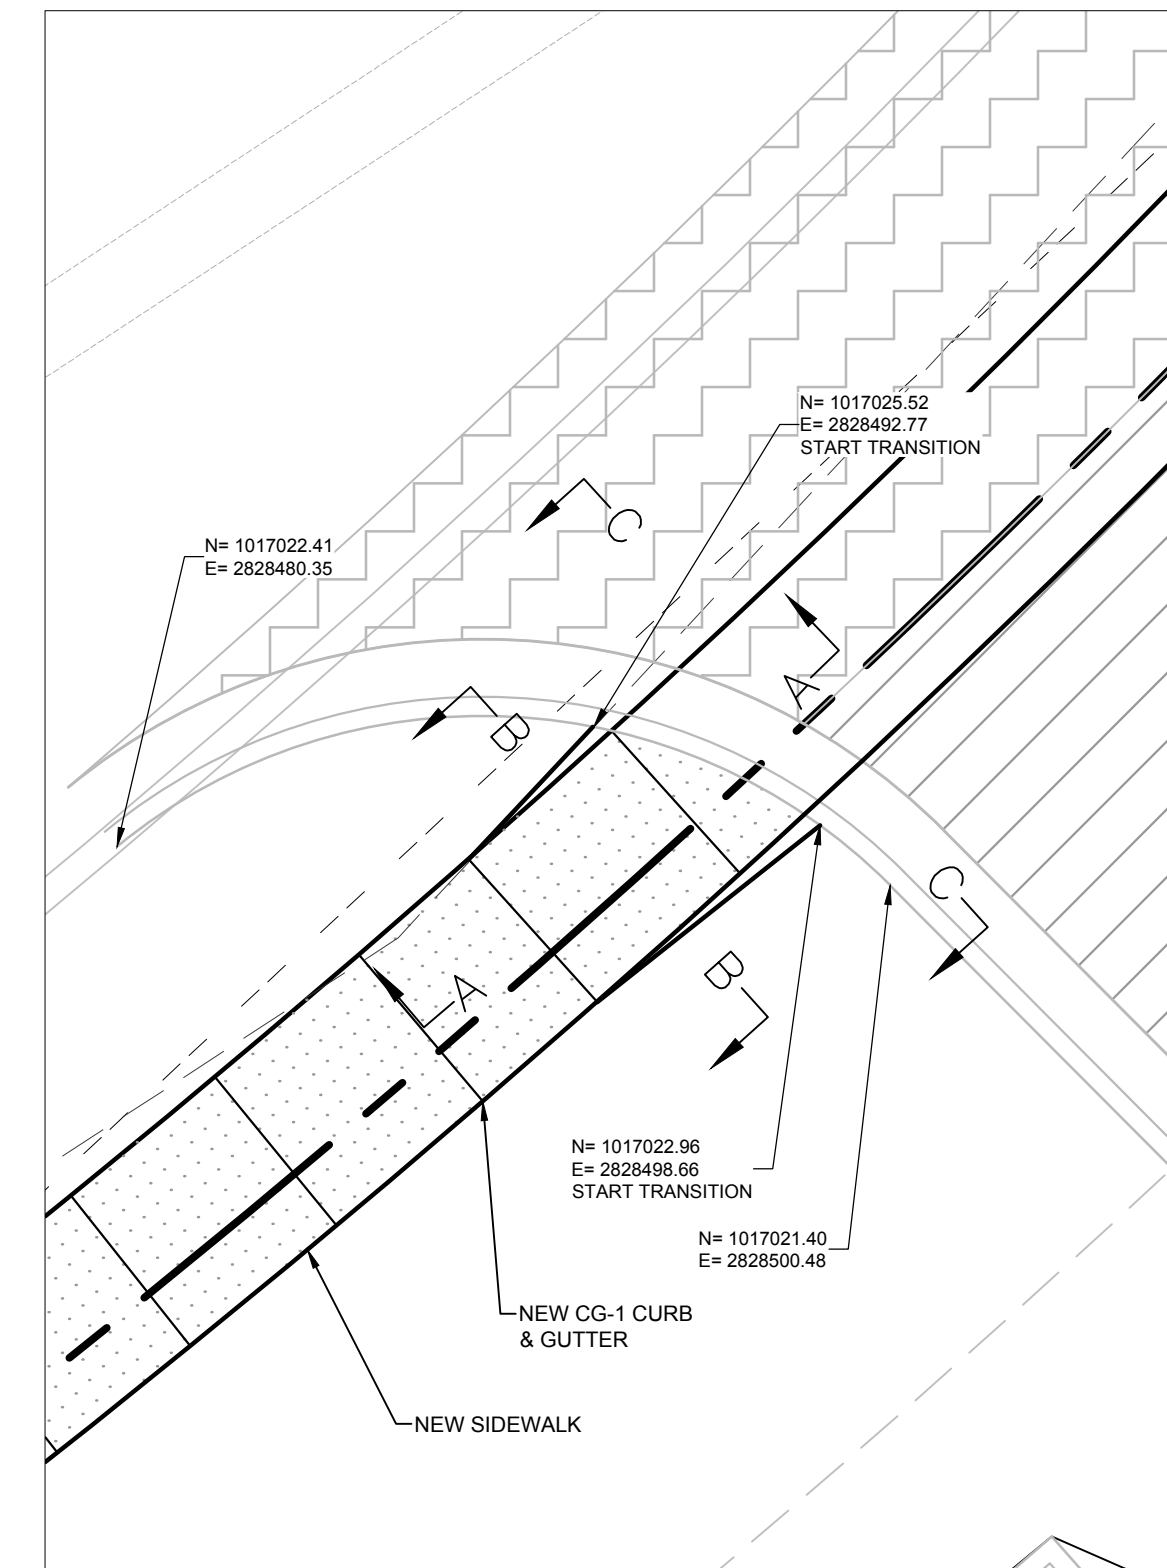

ADA RAMP 3

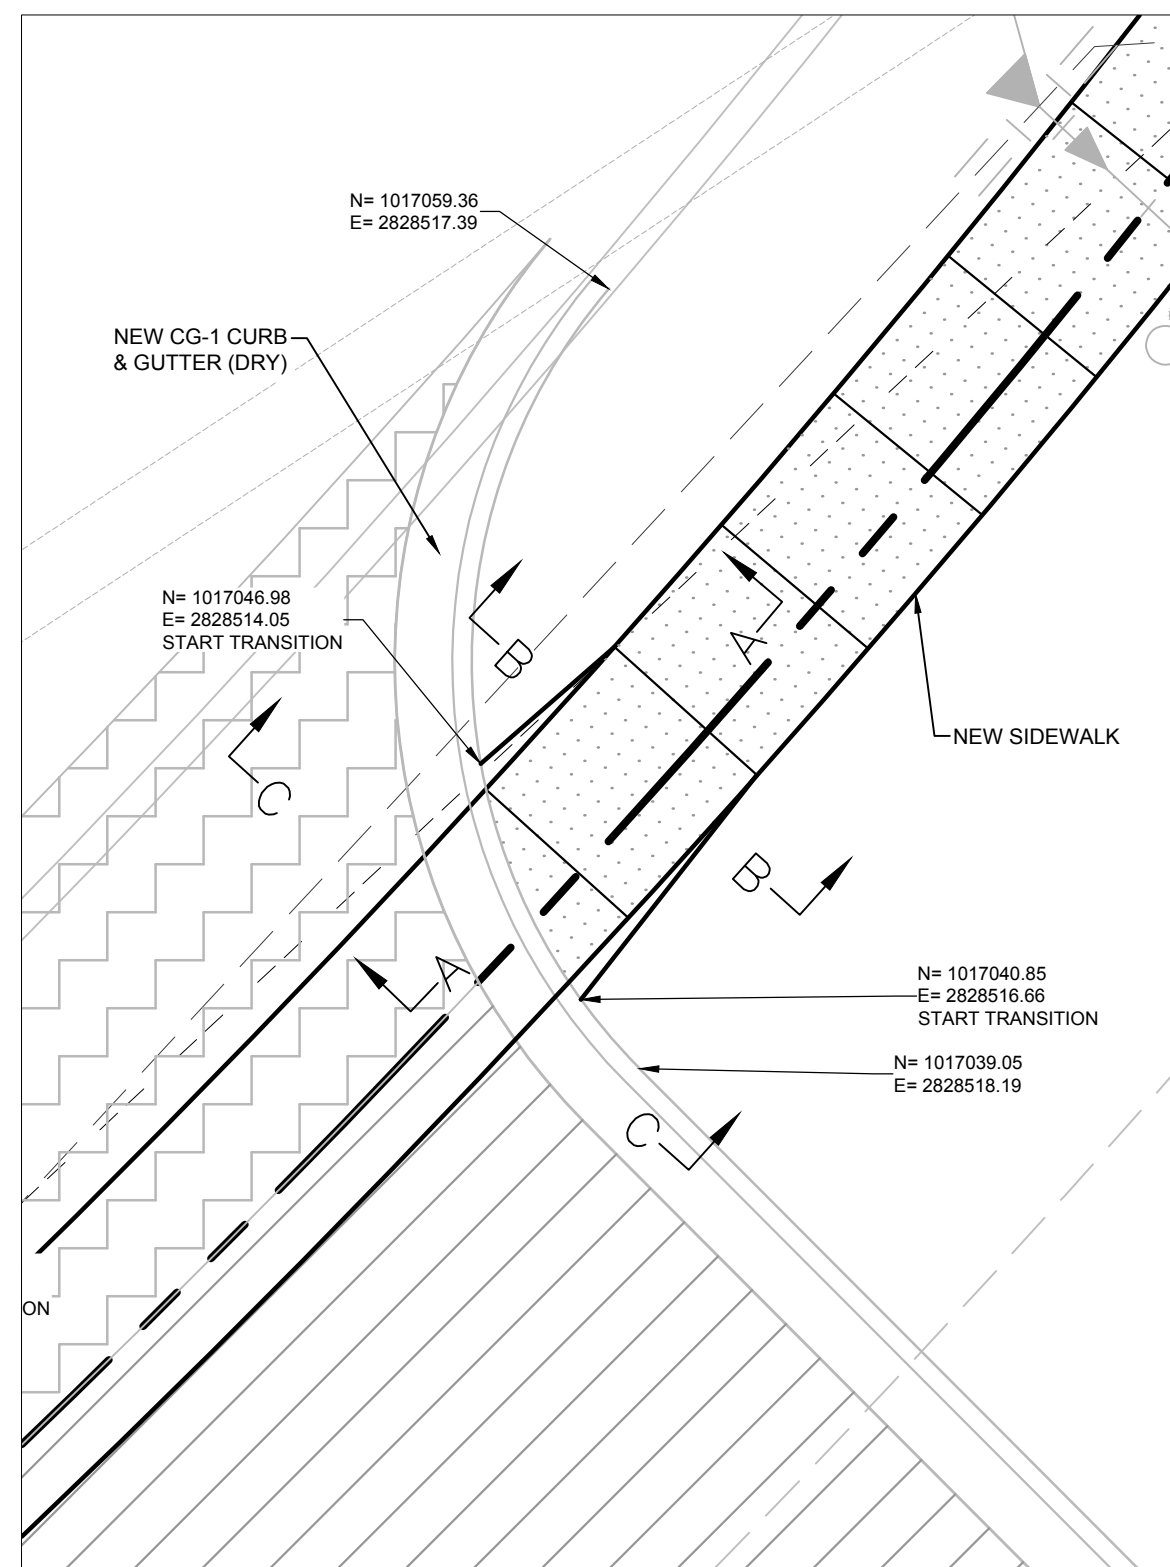


ADA RAMP 4

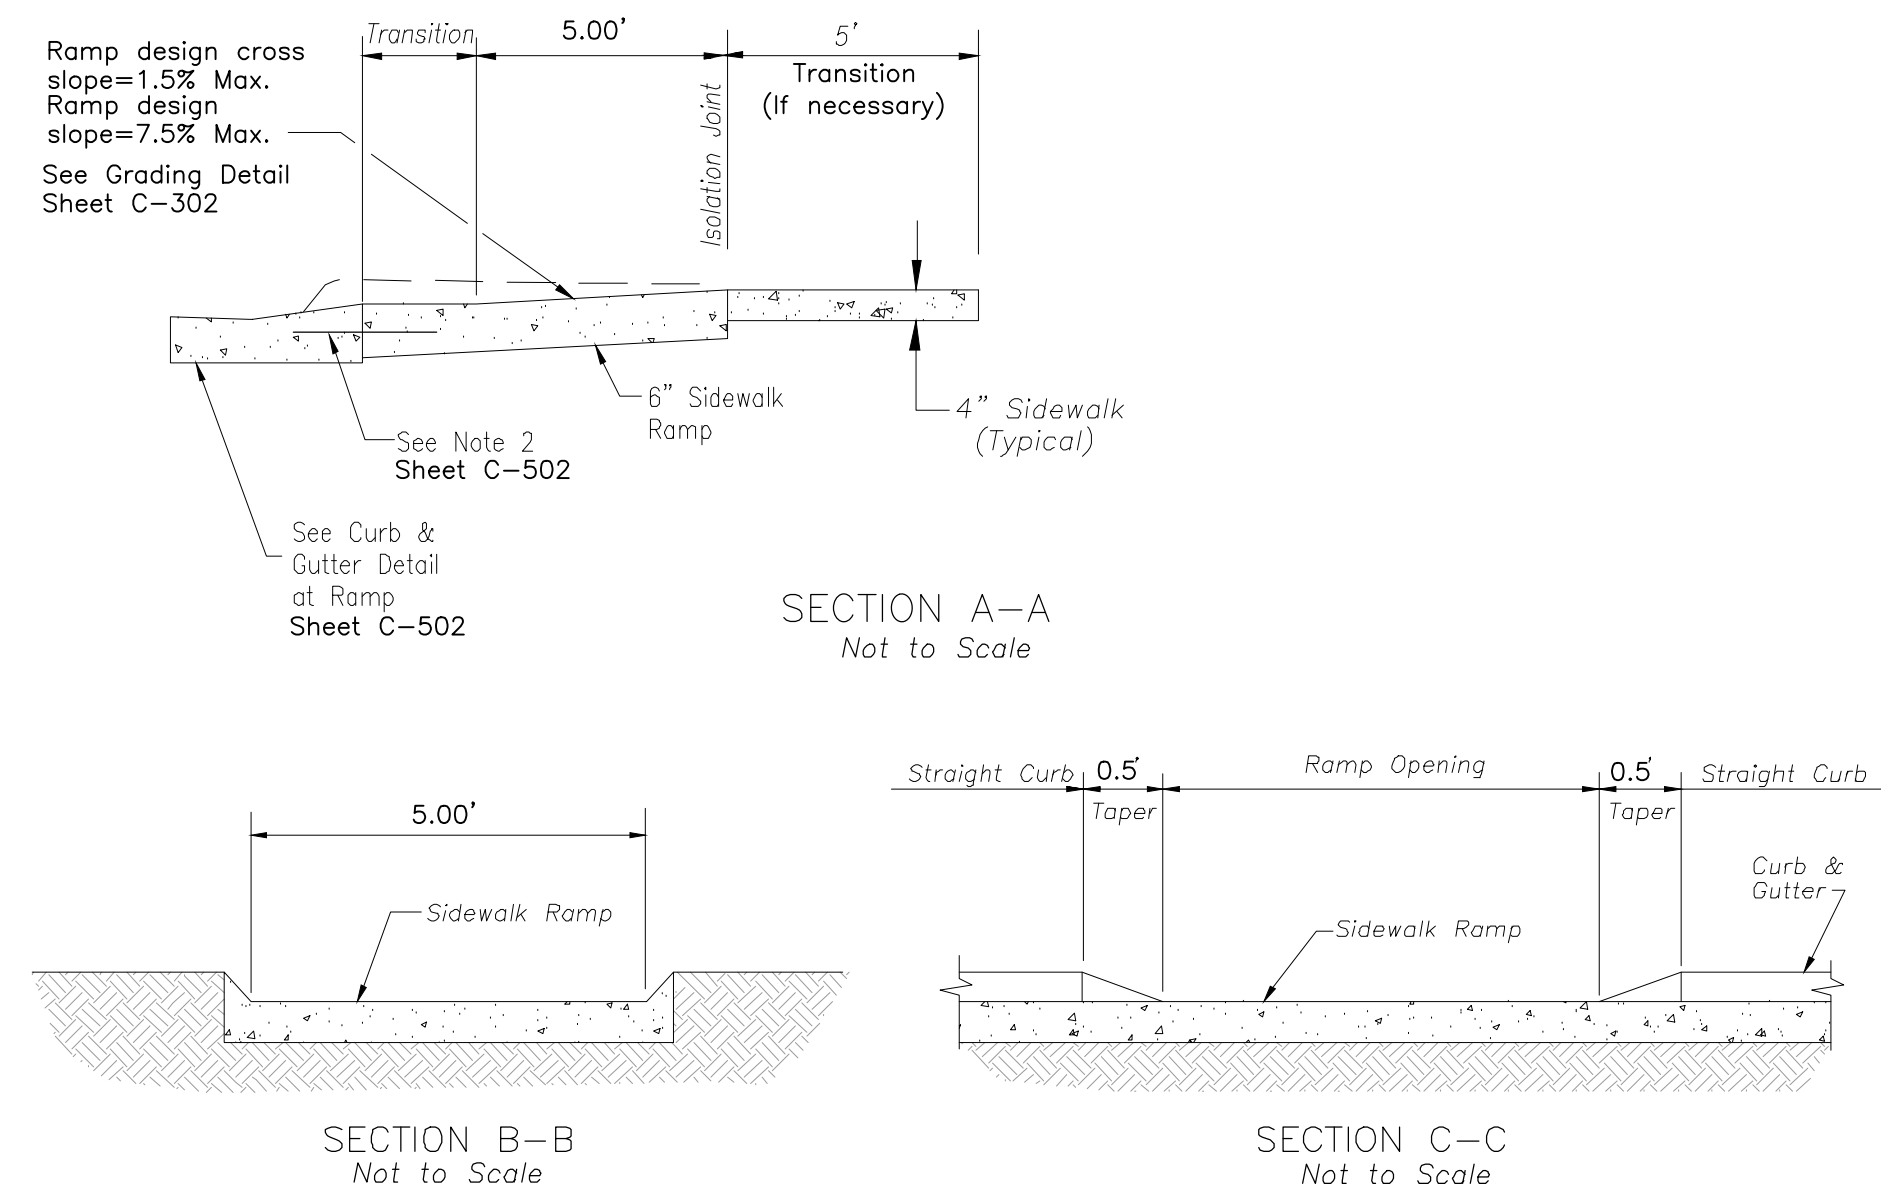

TYPICAL DETAILS ADA RAMP 1-4

RELEASED FOR CONSTRUCTION
As Noted on Plans Review
Development Services Department
Lee's Summit, Missouri
01/14/2022

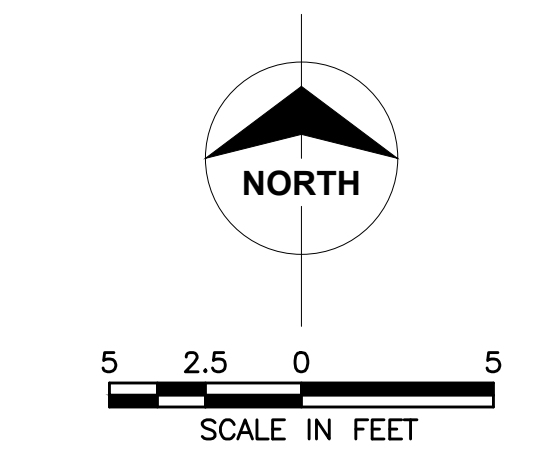


REMOVED DIMENSIONS AND ADDED TO C-302 TO CORRELATE WITH SPOT ELEVATIONS

Certificates of Authority
Architecture: MO 310 / KS 13
Engineering: MO 4 / KS 241
Land Surveying: MO 123 / KS 34

© 2019 Powell CWM, Inc.
This drawing has been prepared by Powell CWM, Inc. This drawing is provided as an instrument of service by Powell CWM and is intended for use on this project only, pursuant to the Architectural Works Copyright Protection Act of 1990, all drawings, specifications, notes and designs, including the overall form arrangement and composition of spaces and elements appearing herein constitute the original copyrighted work of Powell CWM, Inc. Any reproduction, use or disclosure of information contained herein without prior written consent of Powell CWM, Inc. is strictly prohibited.

Toby L. Williams, PE
PE-2019038948 (MISSOURI #)

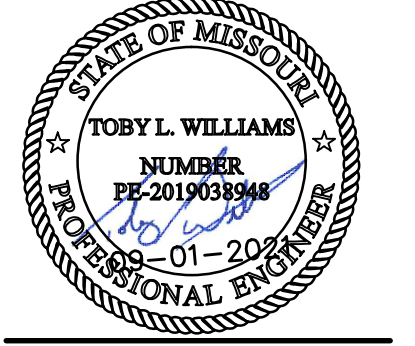

PREPARED FOR:
WARD DEVELOPMENT
DAVID WARD
1120 NW EAGLE RIDGE BLVD.
GRAIN VALLEY, MO 64029
(816) 229-8115

LOT 10, I-470 BUSINESS AND TECHNOLOGY CENTER
2601 NE MCBAIN DRIVE
LEE'S SUMMIT, MO 64064


REVISIONS	NO.	DATE / DESCRIPTION
	1	12/22/2021 - CITY COMMENTS
	2	01/10/2022 - CITY COMMENTS

PROJECT #: 21-1902
ISSUE DATE: 09/01/2021
ISSUED FOR:


NOTE:
 TC = TOP OF CURB
 GUT = GUTTER
 M.E. = MATCH EXISTING

- GRADING NOTES :**
1. ALL ELEVATIONS SHOWN ARE TO FINISHED GRADE SURFACE.
 2. ALL EXISTING UTILITY PULL BOXES, HAND HOLES, MANHOLES, VALVE BOXES, METERS, AND OTHER APPURTENANCES TO REMAIN, SHALL BE ADJUSTED TO NEW GRADES.

Total Disturbed Area: 1.65 acres

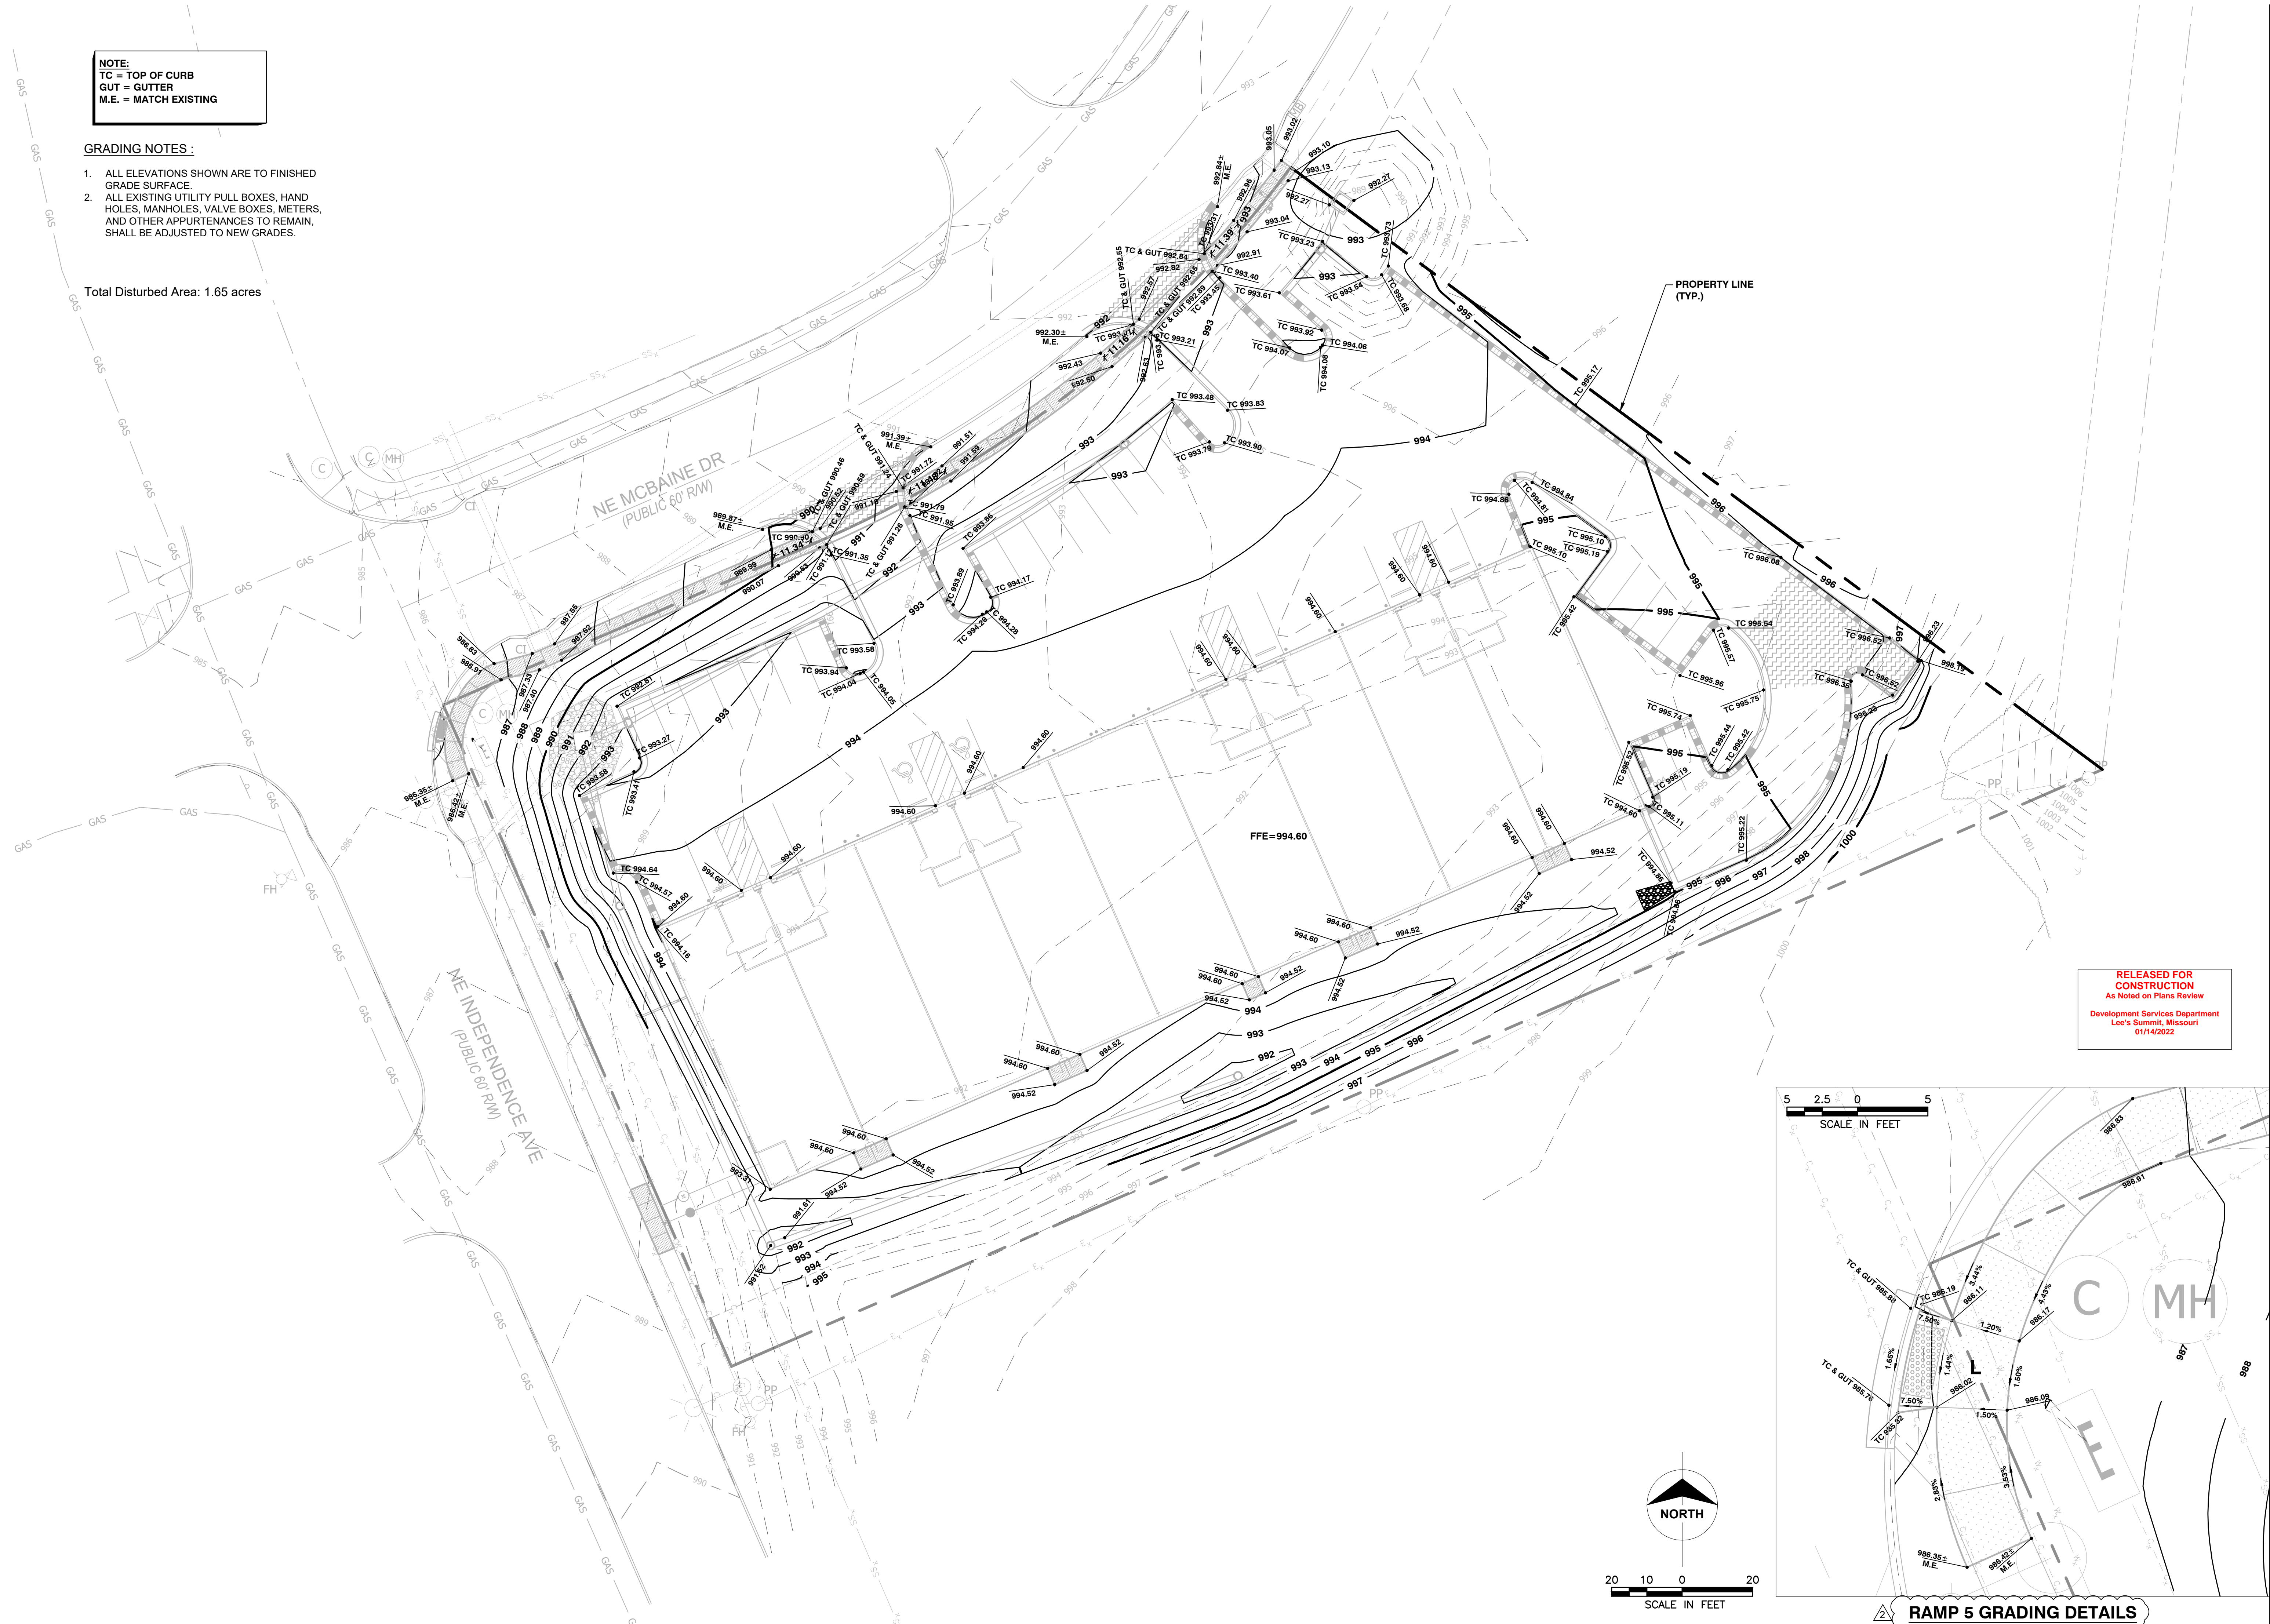


RELEASED FOR CONSTRUCTION
 As Noted on Plans Review
 Development Services Department
 Lee's Summit, Missouri
 01/14/2022

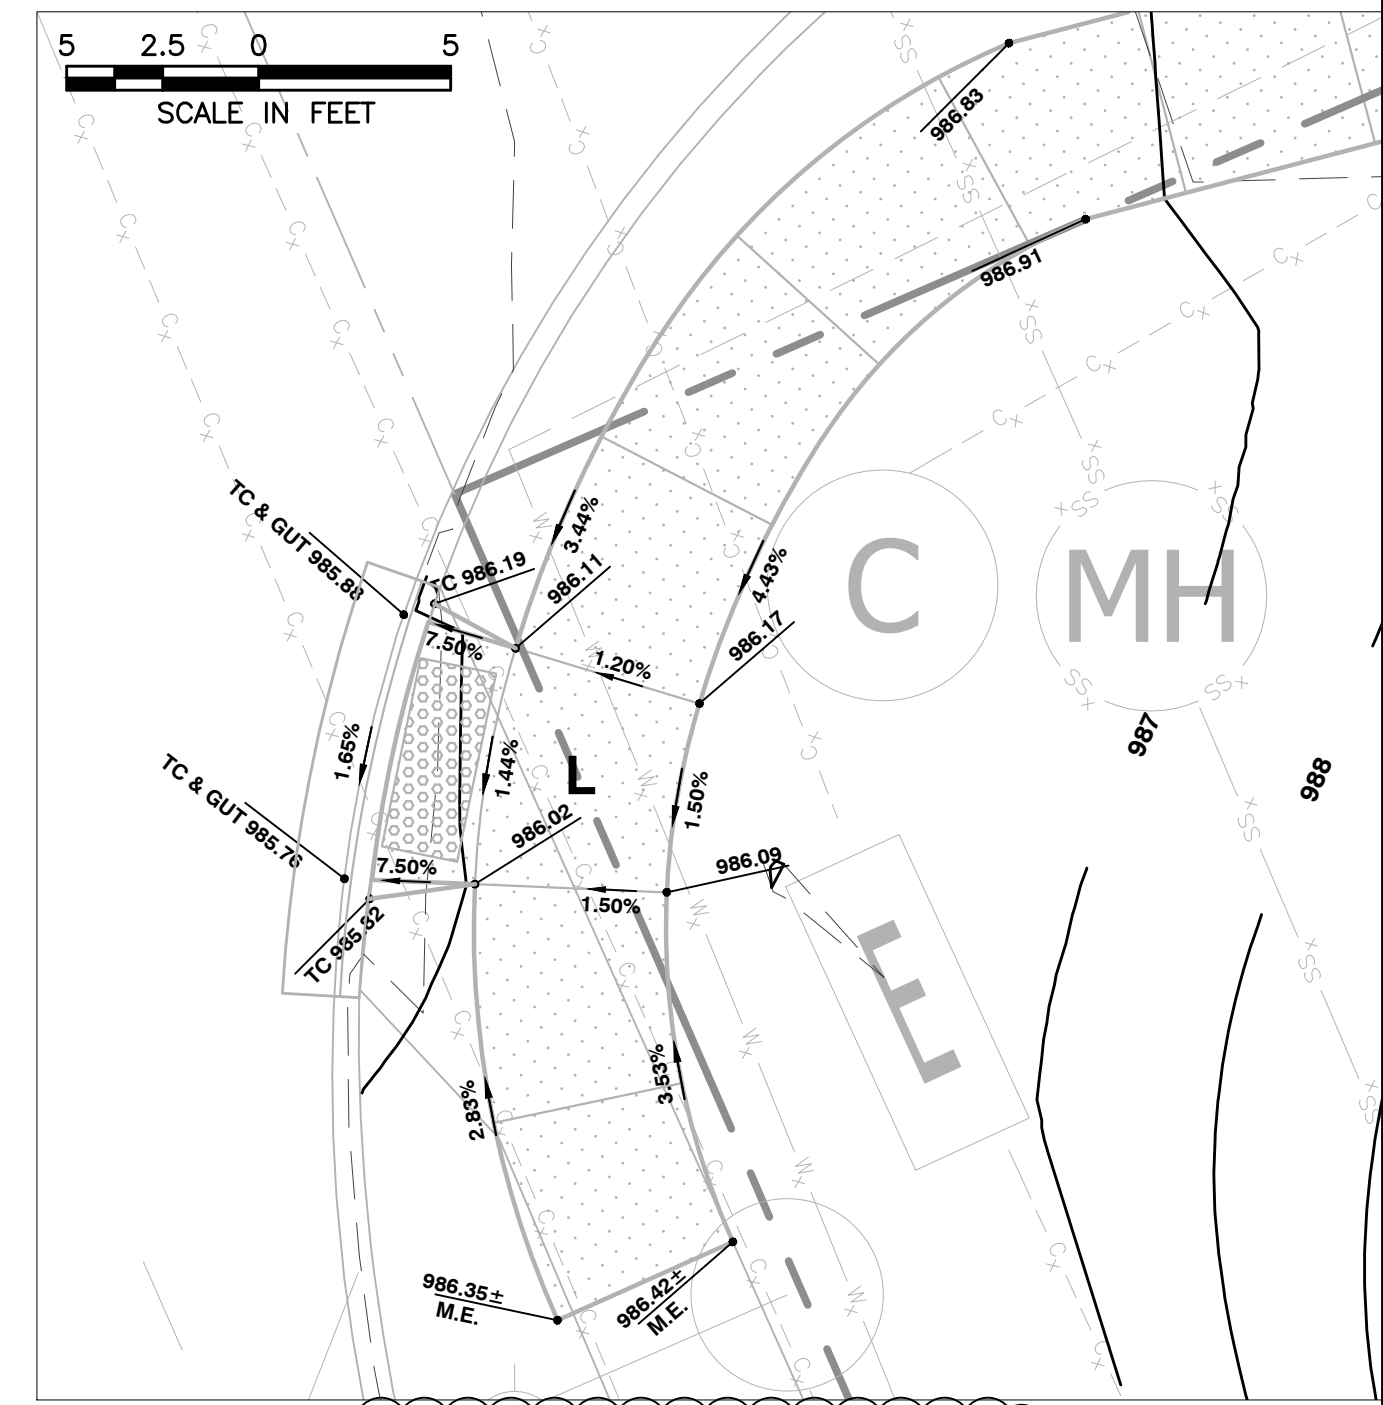

Certificate of Authority
 Architecture: MO 110 / E 13
 Engineering: MO 4 / K5 241
 Land Surveying: MO 123 / K5 36

© 2019 Powell CWM, Inc.
 This drawing has been prepared by Powell CWM, Inc. This drawing is provided as an instrument of service by Powell CWM and is intended for use on this project only, pursuant to the Architectural Works Copyright Protection Act of 1990, all drawings, specifications, notes and designs, including the overall form arrangement and composition of spaces and elements appearing herein constitute the original copyrighted work of Powell CWM, Inc. Any reproduction, use or disclosure of information contained herein without prior written consent of Powell CWM, Inc. is strictly prohibited.

Toby L. Williams, PE
 PE-2019038948 (MISSOURI #)

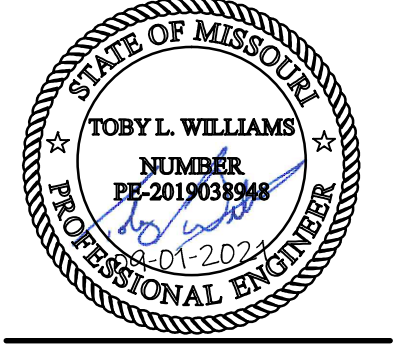


PREPARED FOR:
 WARD DEVELOPMENT
 DAVID WARD
 1120 NW EAGLE RIDGE BLVD.
 GRAIN VALLEY, MO 64029
 (816) 229-8115


LOT 10, I-470 BUSINESS AND TECHNOLOGY CENTER
 2601 NE MCBAIN DRIVE
 LEE'S SUMMIT, MO 64064

REVISIONS	NO.	DATE / DESCRIPTION
	1	11/09/2021 - CITY COMMENTS
	2	12/22/2021 - CITY COMMENTS


PROJECT #: 21-1902
 ISSUE DATE: 09/01/2021
 ISSUED FOR:

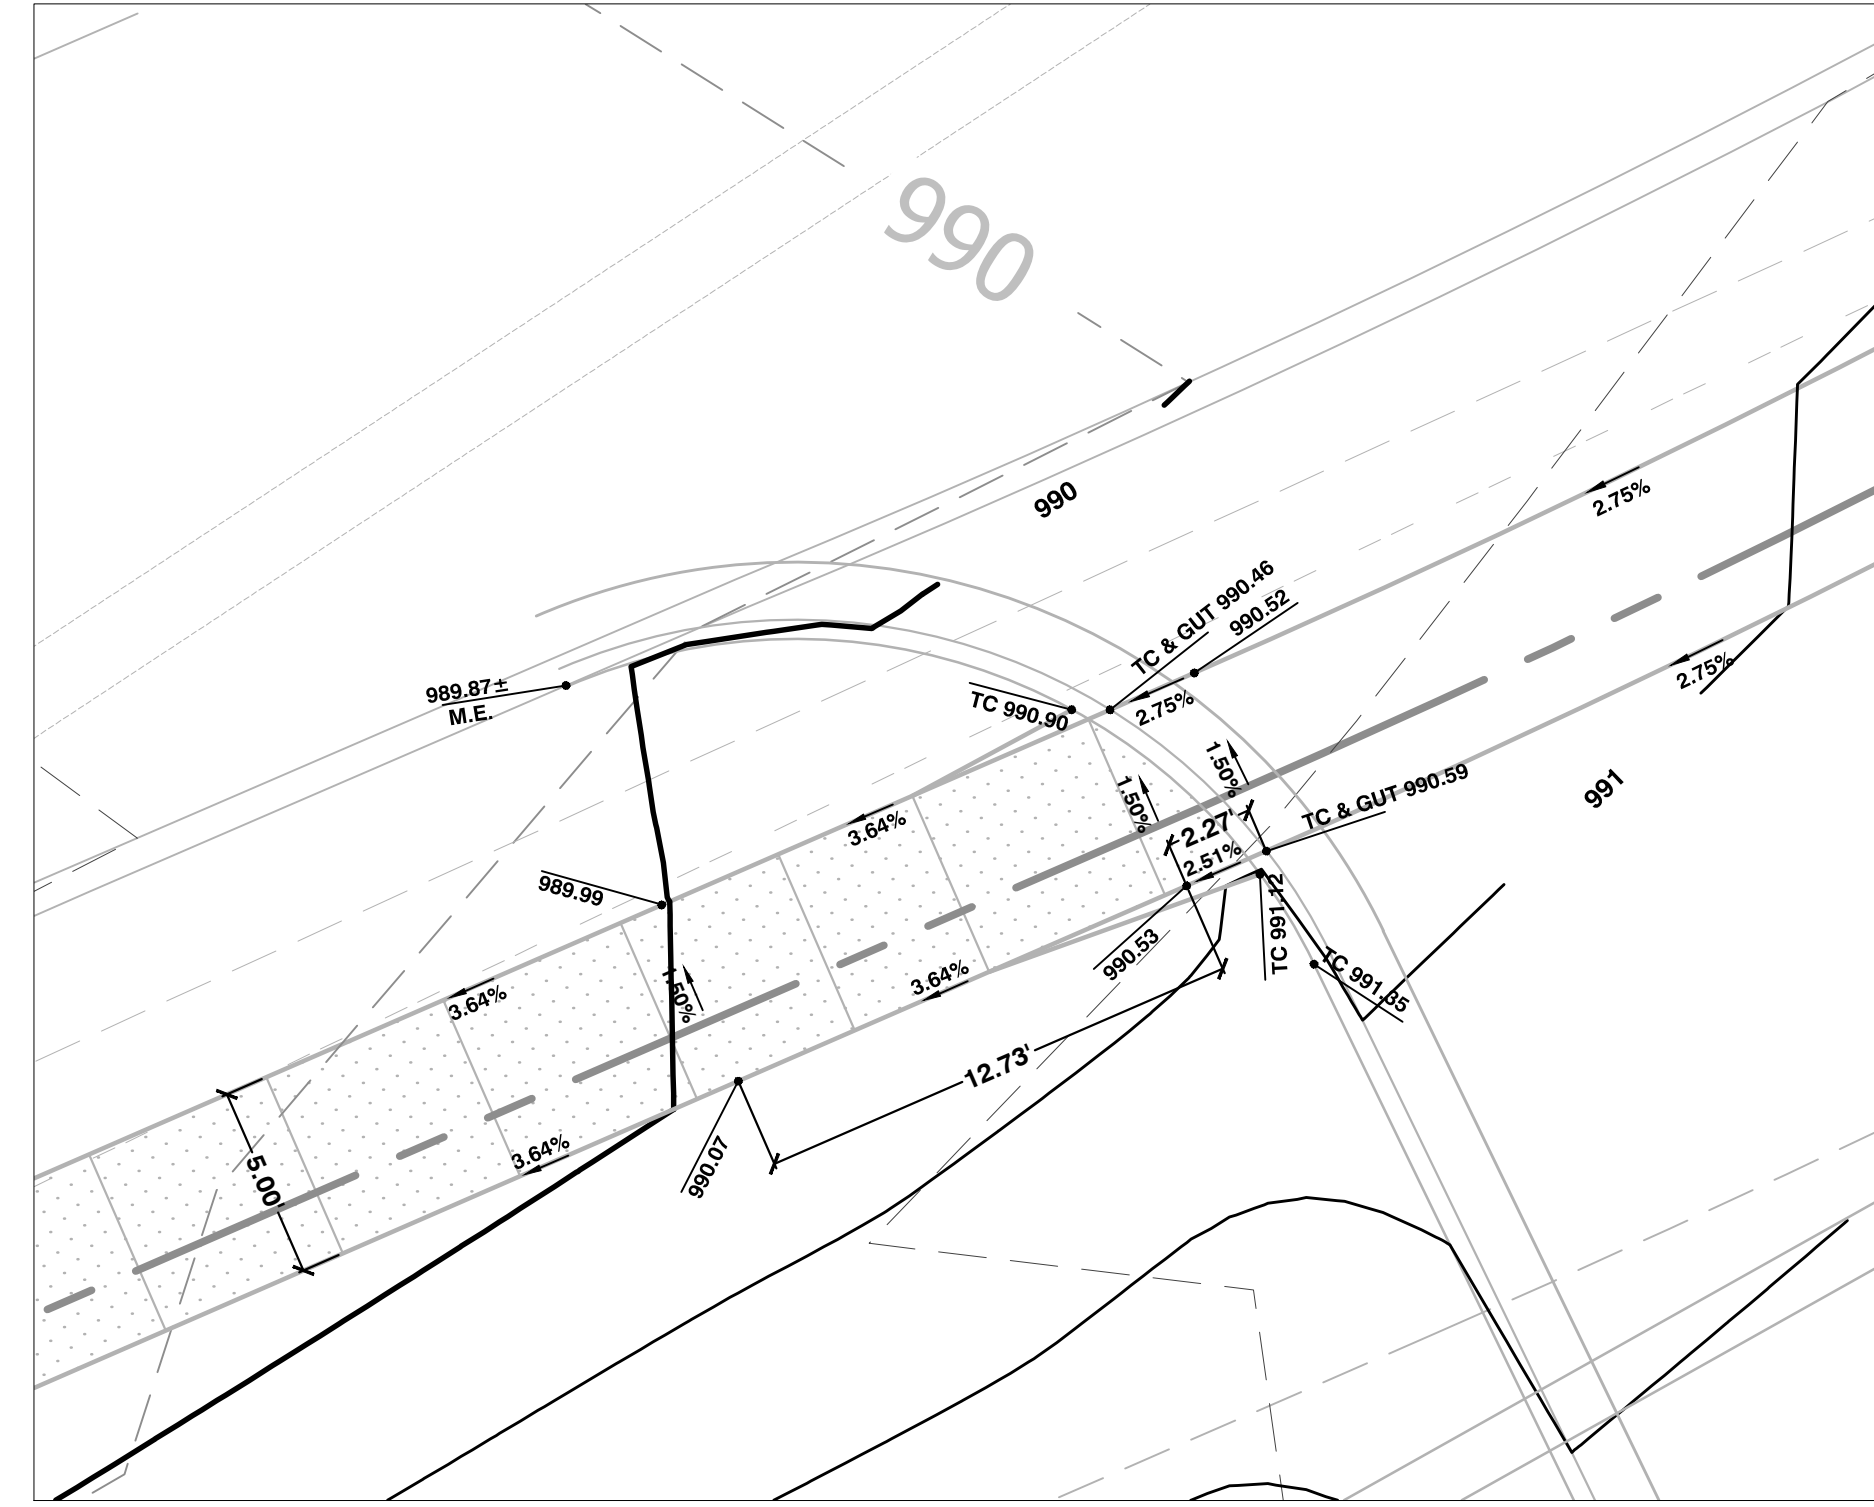


**ADA RAMP 1 GRADING
DETAILS**

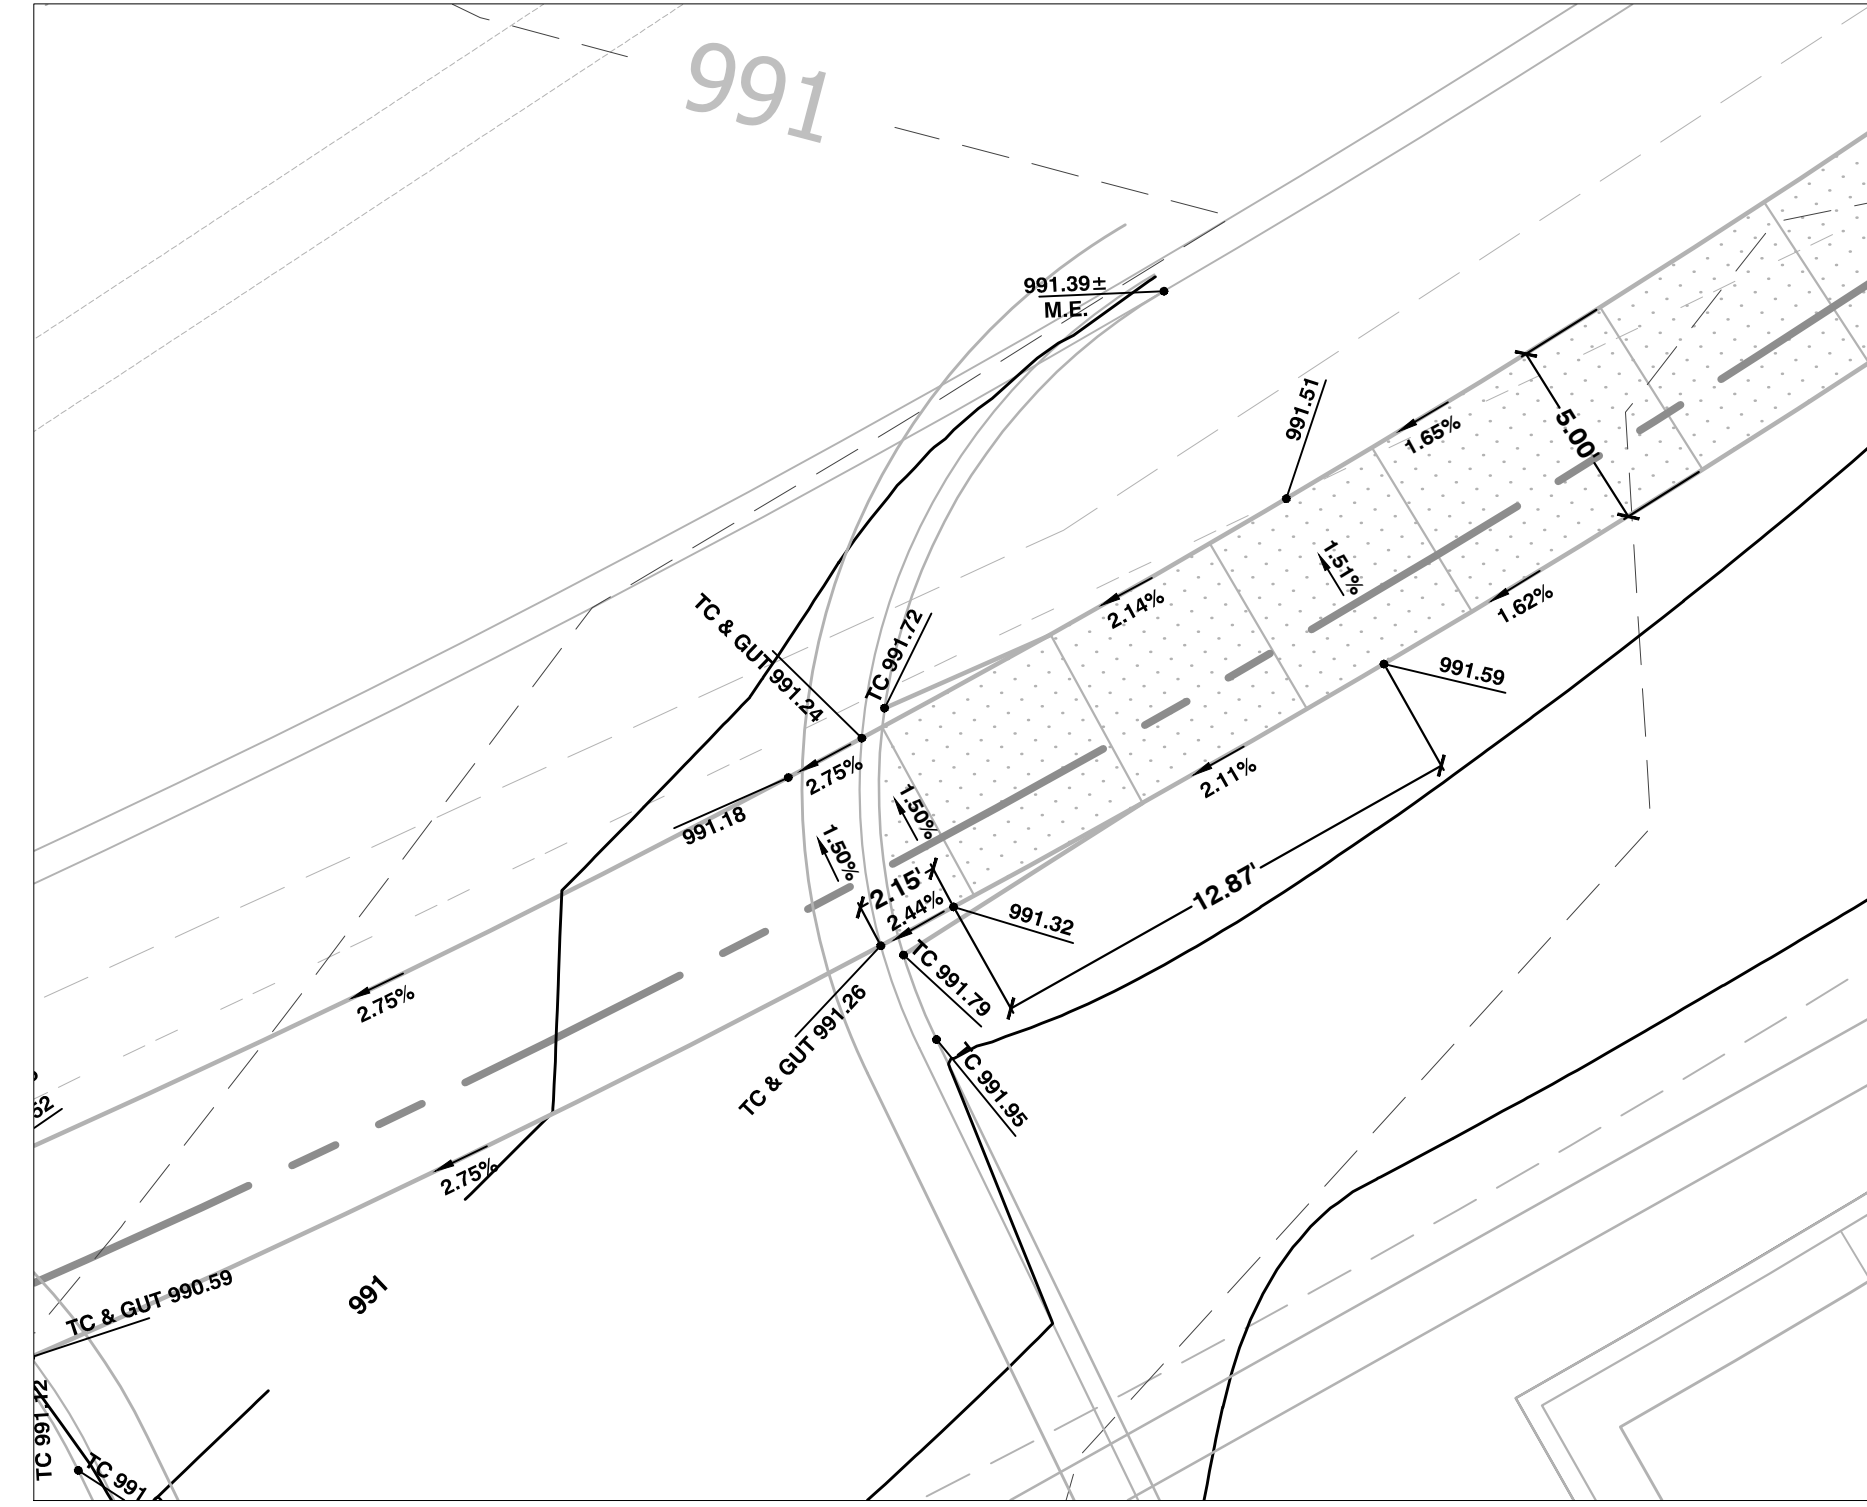

**ADA RAMP 2 GRADING
DETAILS**

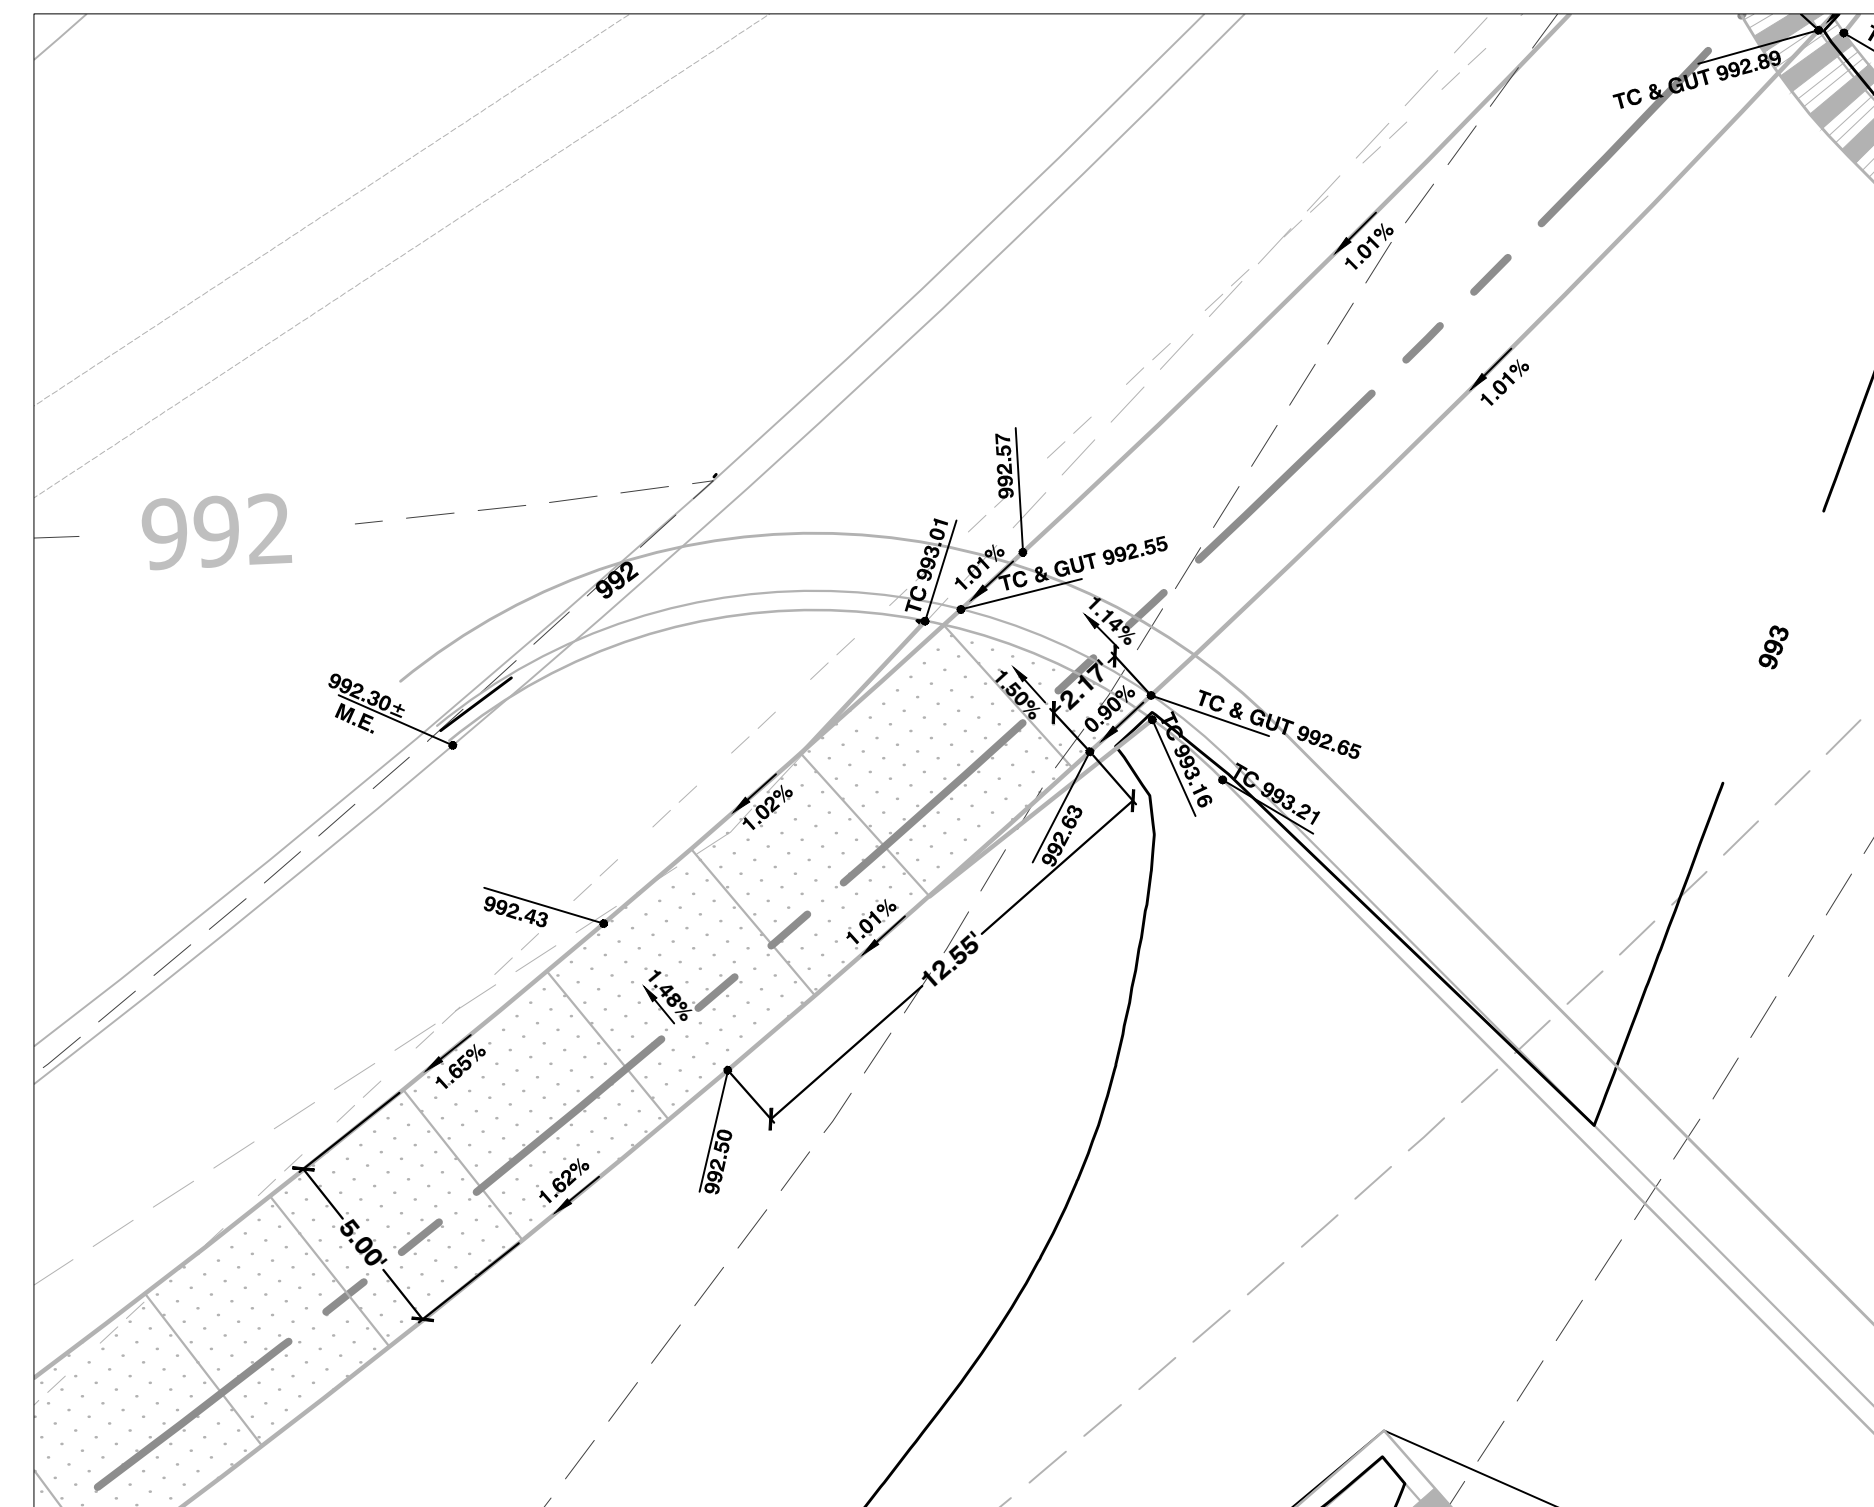



**ADA RAMP 3 GRADING
DETAILS**

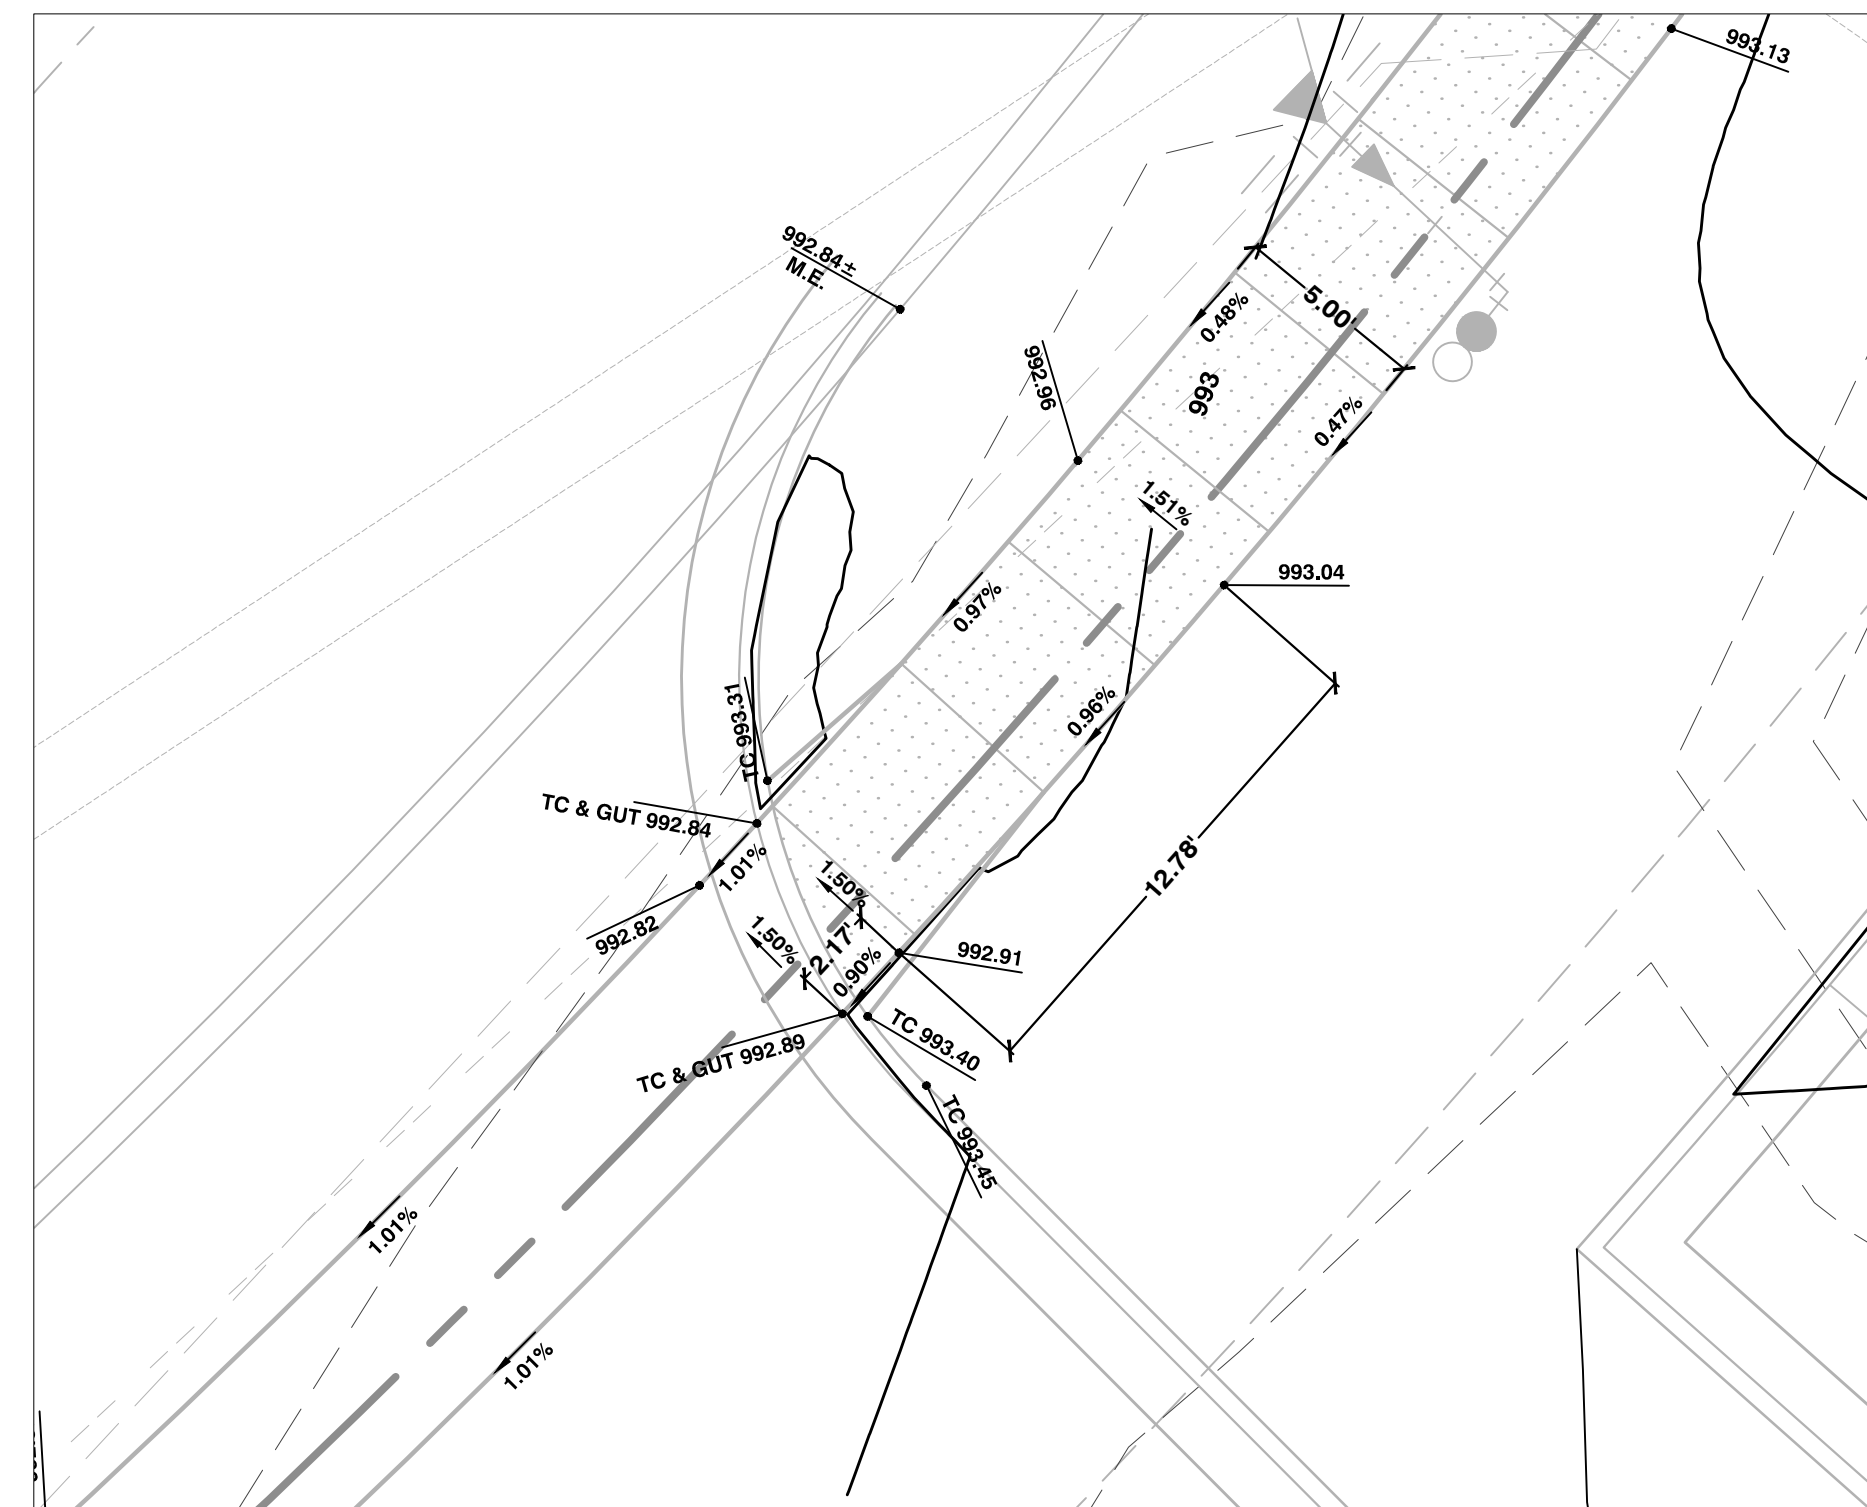

**ADA RAMP 4 GRADING
DETAILS**

**RELEASED FOR
CONSTRUCTION**
As Noted on Plans Review
Development Services Department
Lee's Summit, Missouri
01/14/2022


▲ ADD DIMENSIONS TO
DETAILS

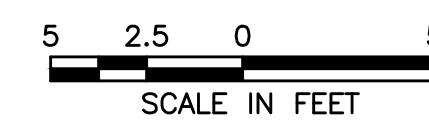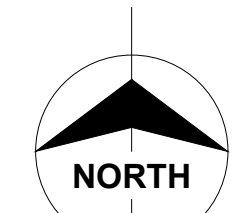

Certificate of Authority
Architecture: MO 310 / KS 13
Engineering: MO 4 / KS 241
Land Surveying: MO 123 / KS 34

© 2019 Powell CWM, Inc.
This drawing has been prepared by Powell CWM, Inc. This drawing is provided as an instrument of service by Powell CWM and is intended for use on this project only, pursuant to the Architectural Works Copyright Protection Act of 1990, all drawings, specifications, notes and designs, including the overall form arrangement and composition of spaces and elements appearing herein constitute the original copyrighted work of Powell CWM, Inc. Any reproduction, use or disclosure of information contained herein without prior written consent of Powell CWM, Inc. is strictly prohibited.

Toby L. Williams, PE
PE-2019038948 (MISSOURI #)

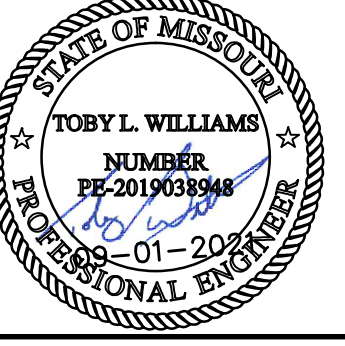


PREPARED FOR:
WARD DEVELOPMENT
DAVID WARD
1120 NW EAGLE RIDGE BLVD.
GRAIN VALLEY, MO 64029
(816) 229-8115


LOT 10, I-470 BUSINESS AND TECHNOLOGY CENTER
2601 NE MCBAIN DRIVE
LEE'S SUMMIT, MO 64064

REVISIONS	NO.	DATE / DESCRIPTION
	1	12/22/2021 - CITY COMMENTS
	2	01/10/2022 - CITY COMMENTS

PROJECT #: 21-1902
ISSUE DATE: 09/01/2021
ISSUED FOR:

ADA RAMP GRADING
DETAILS

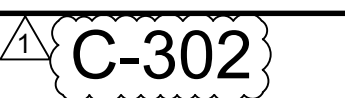

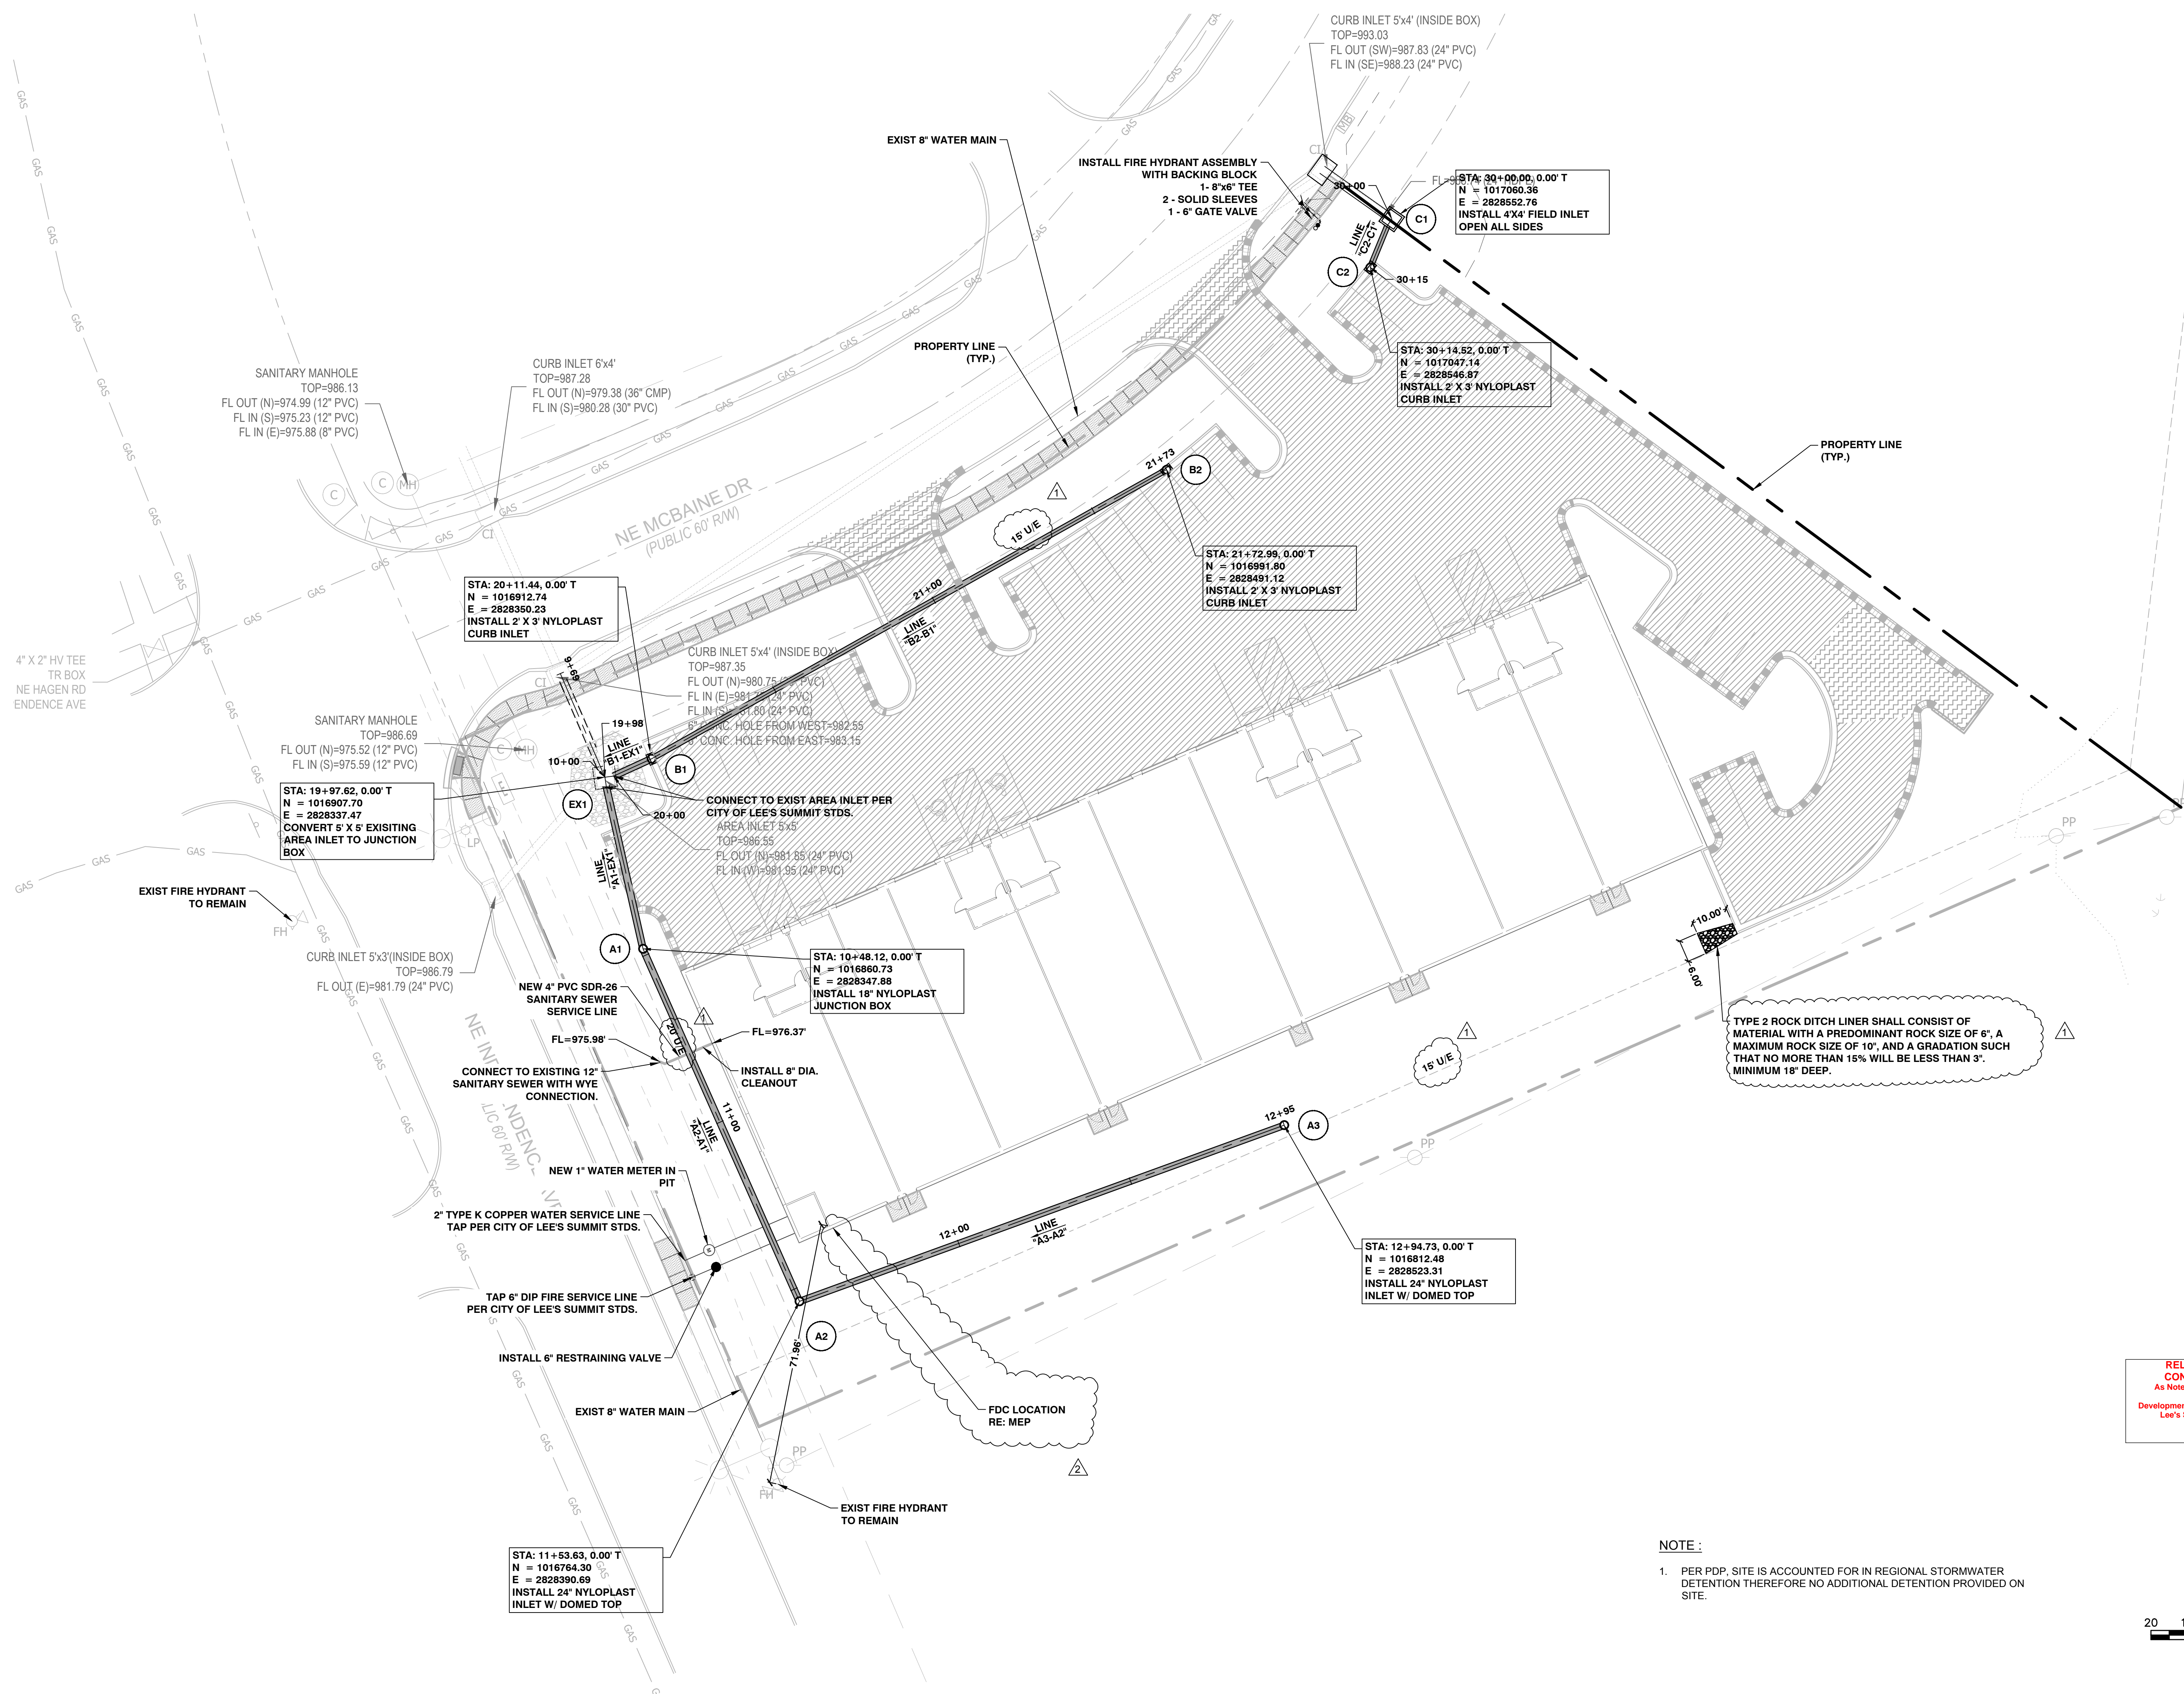

© 2019 Powell CWM, Inc.
 This drawing has been prepared by Powell CWM, Inc. This drawing is provided as an instrument of service by Powell CWM and is intended for use on this project only, pursuant to the Architectural Works Copyright Protection Act of 1990, all drawings, specifications, notes and designs, including the overall form arrangement and composition of spaces and elements appearing herein constitute the original copyrighted work of Powell CWM, Inc. Any reproduction, use or disclosure of information contained herein without prior written consent of Powell CWM, Inc. is strictly prohibited.


Toby L. Williams, PE
 PE-2019038948 (MISSOURI #)
 STATE OF MISSOURI
 TOBY L. WILLIAMS
 NUMBER
 PE-2019038948
 01-20
 PROFESSIONAL ENGINEER

PREPARED FOR:
 WARD DEVELOPMENT
 DAVID WARD
 1120 NW EAGLE RIDGE BLVD.
 GRAIN VALLEY, MO 64029
 (816) 229-8115

LOT 10, I-470 BUSINESS AND TECHNOLOGY CENTER
 2601 NE MCBAIN DRIVE
 LEE'S SUMMIT, MO 64064




RELEASED FOR CONSTRUCTION
 As Noted on Plans Review
 Development Services Department
 Lee's Summit, Missouri
 01/14/2022

NOTE:
 1. PER PDP, SITE IS ACCOUNTED FOR IN REGIONAL STORMWATER DETENTION THEREFORE NO ADDITIONAL DETENTION PROVIDED ON SITE.

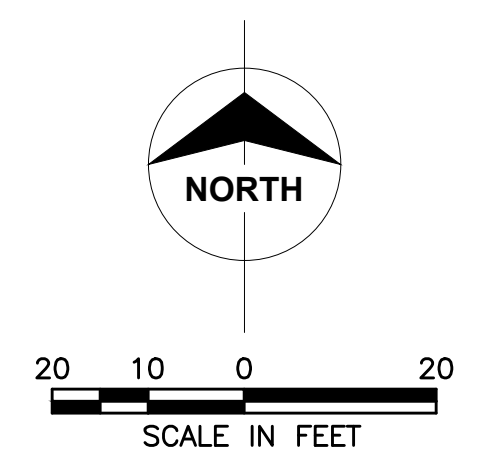

REVISIONS NO.	DATE / DESCRIPTION
1	11/09/2021 - CITY COMMENTS
2	12/22/2021 - CITY COMMENTS


PROJECT #: 21-1902
 ISSUE DATE: 09/01/2021
 ISSUED FOR:
 UTILITY PLAN
C-401

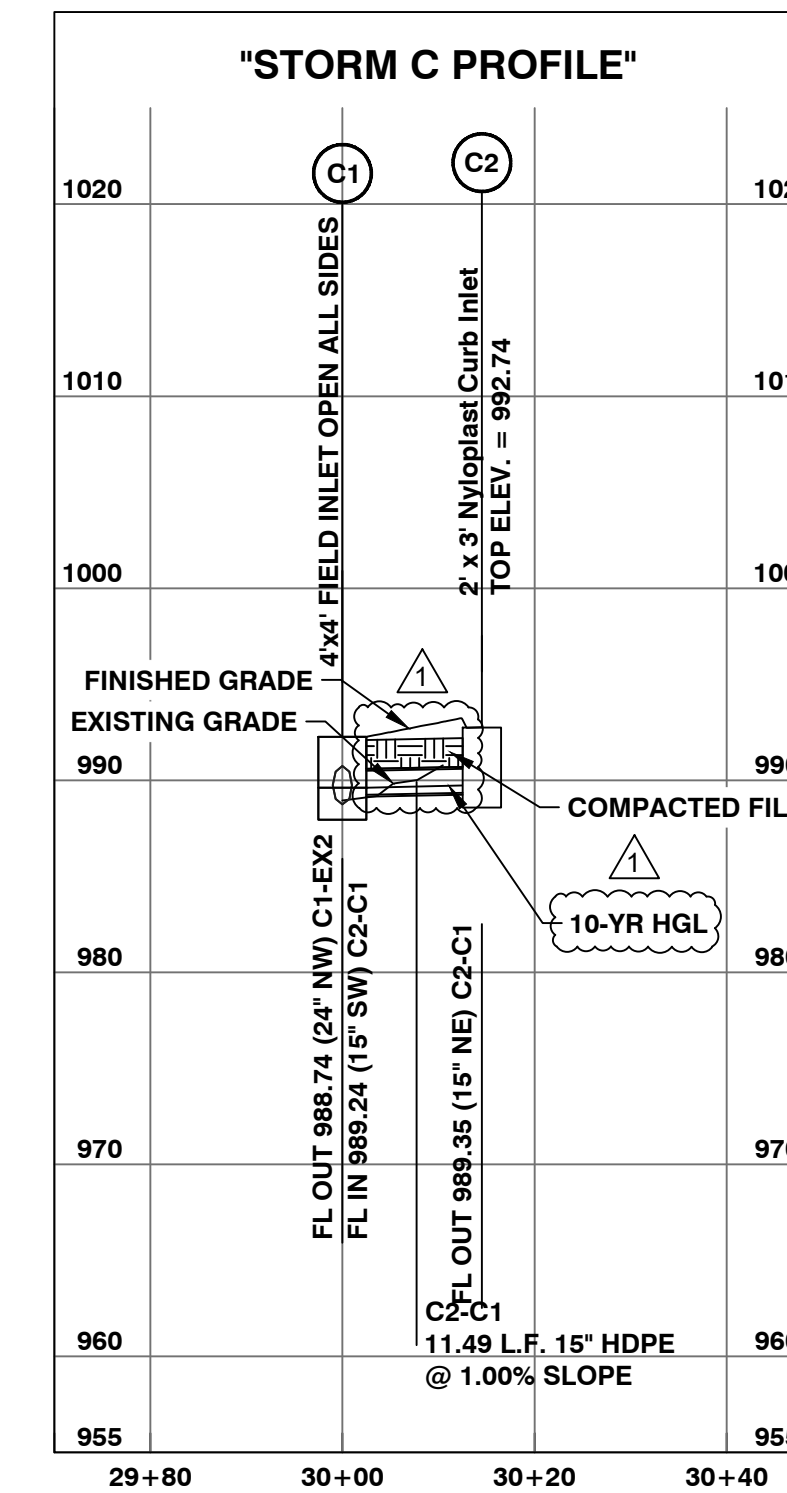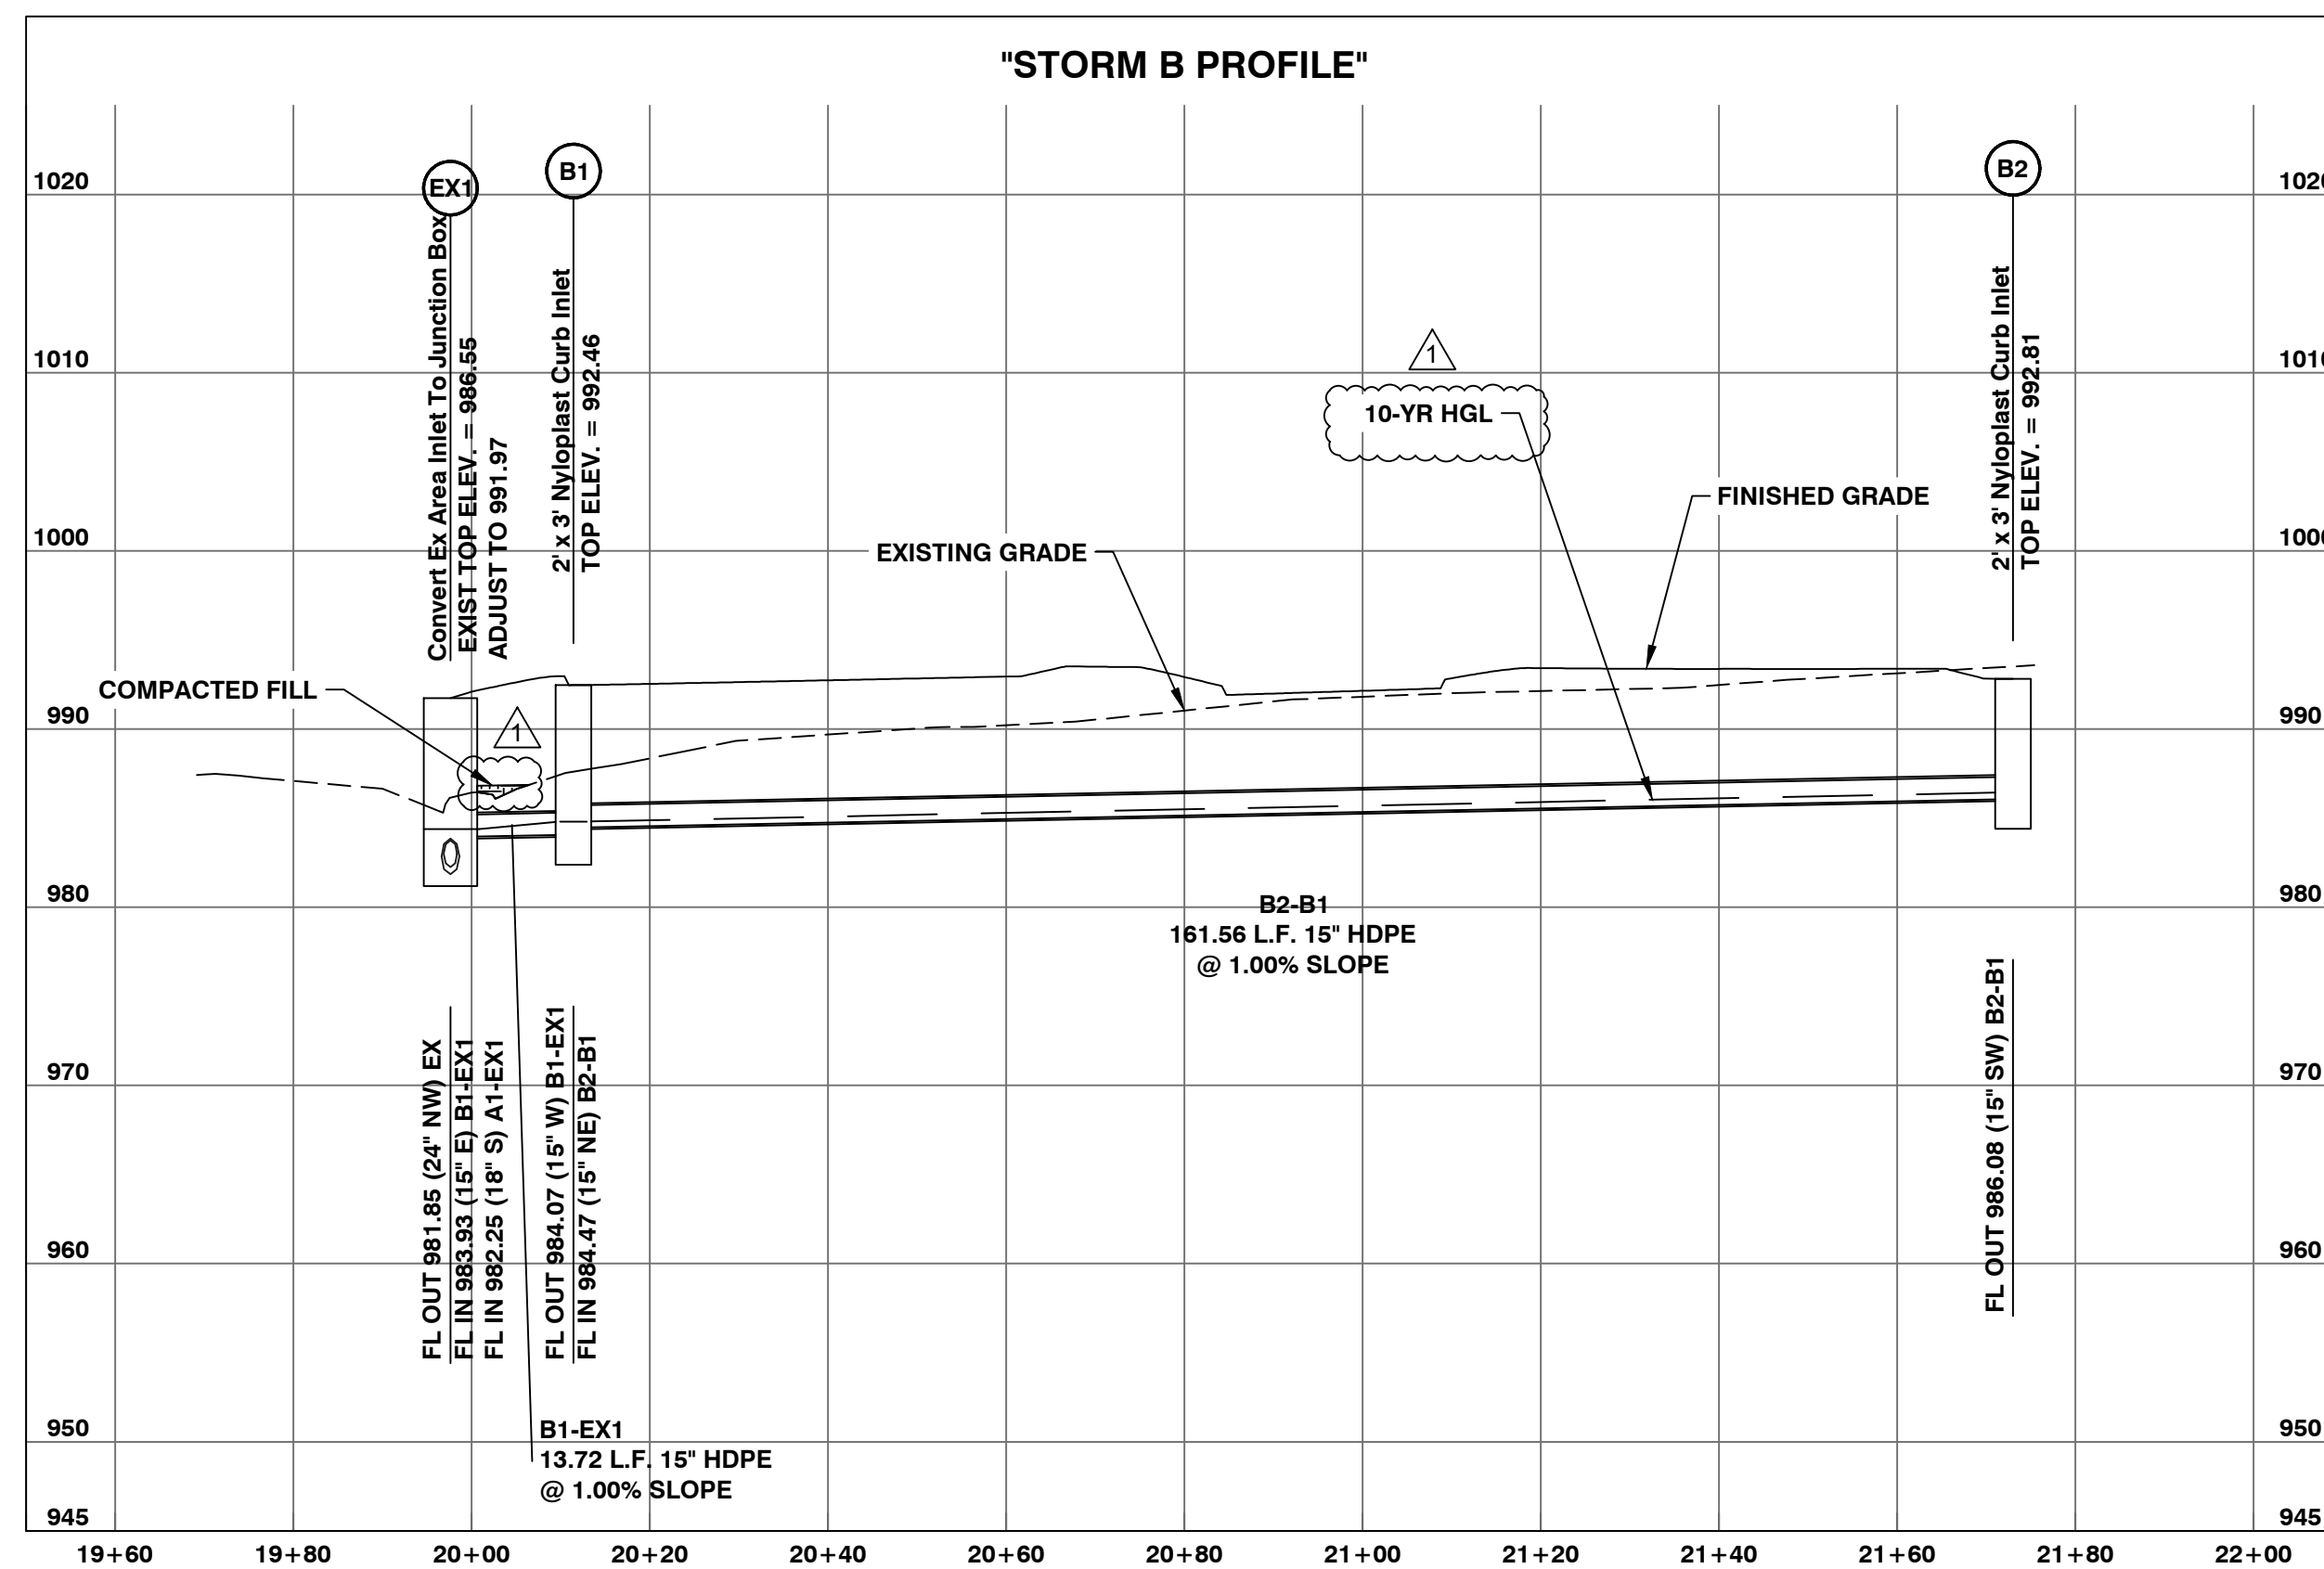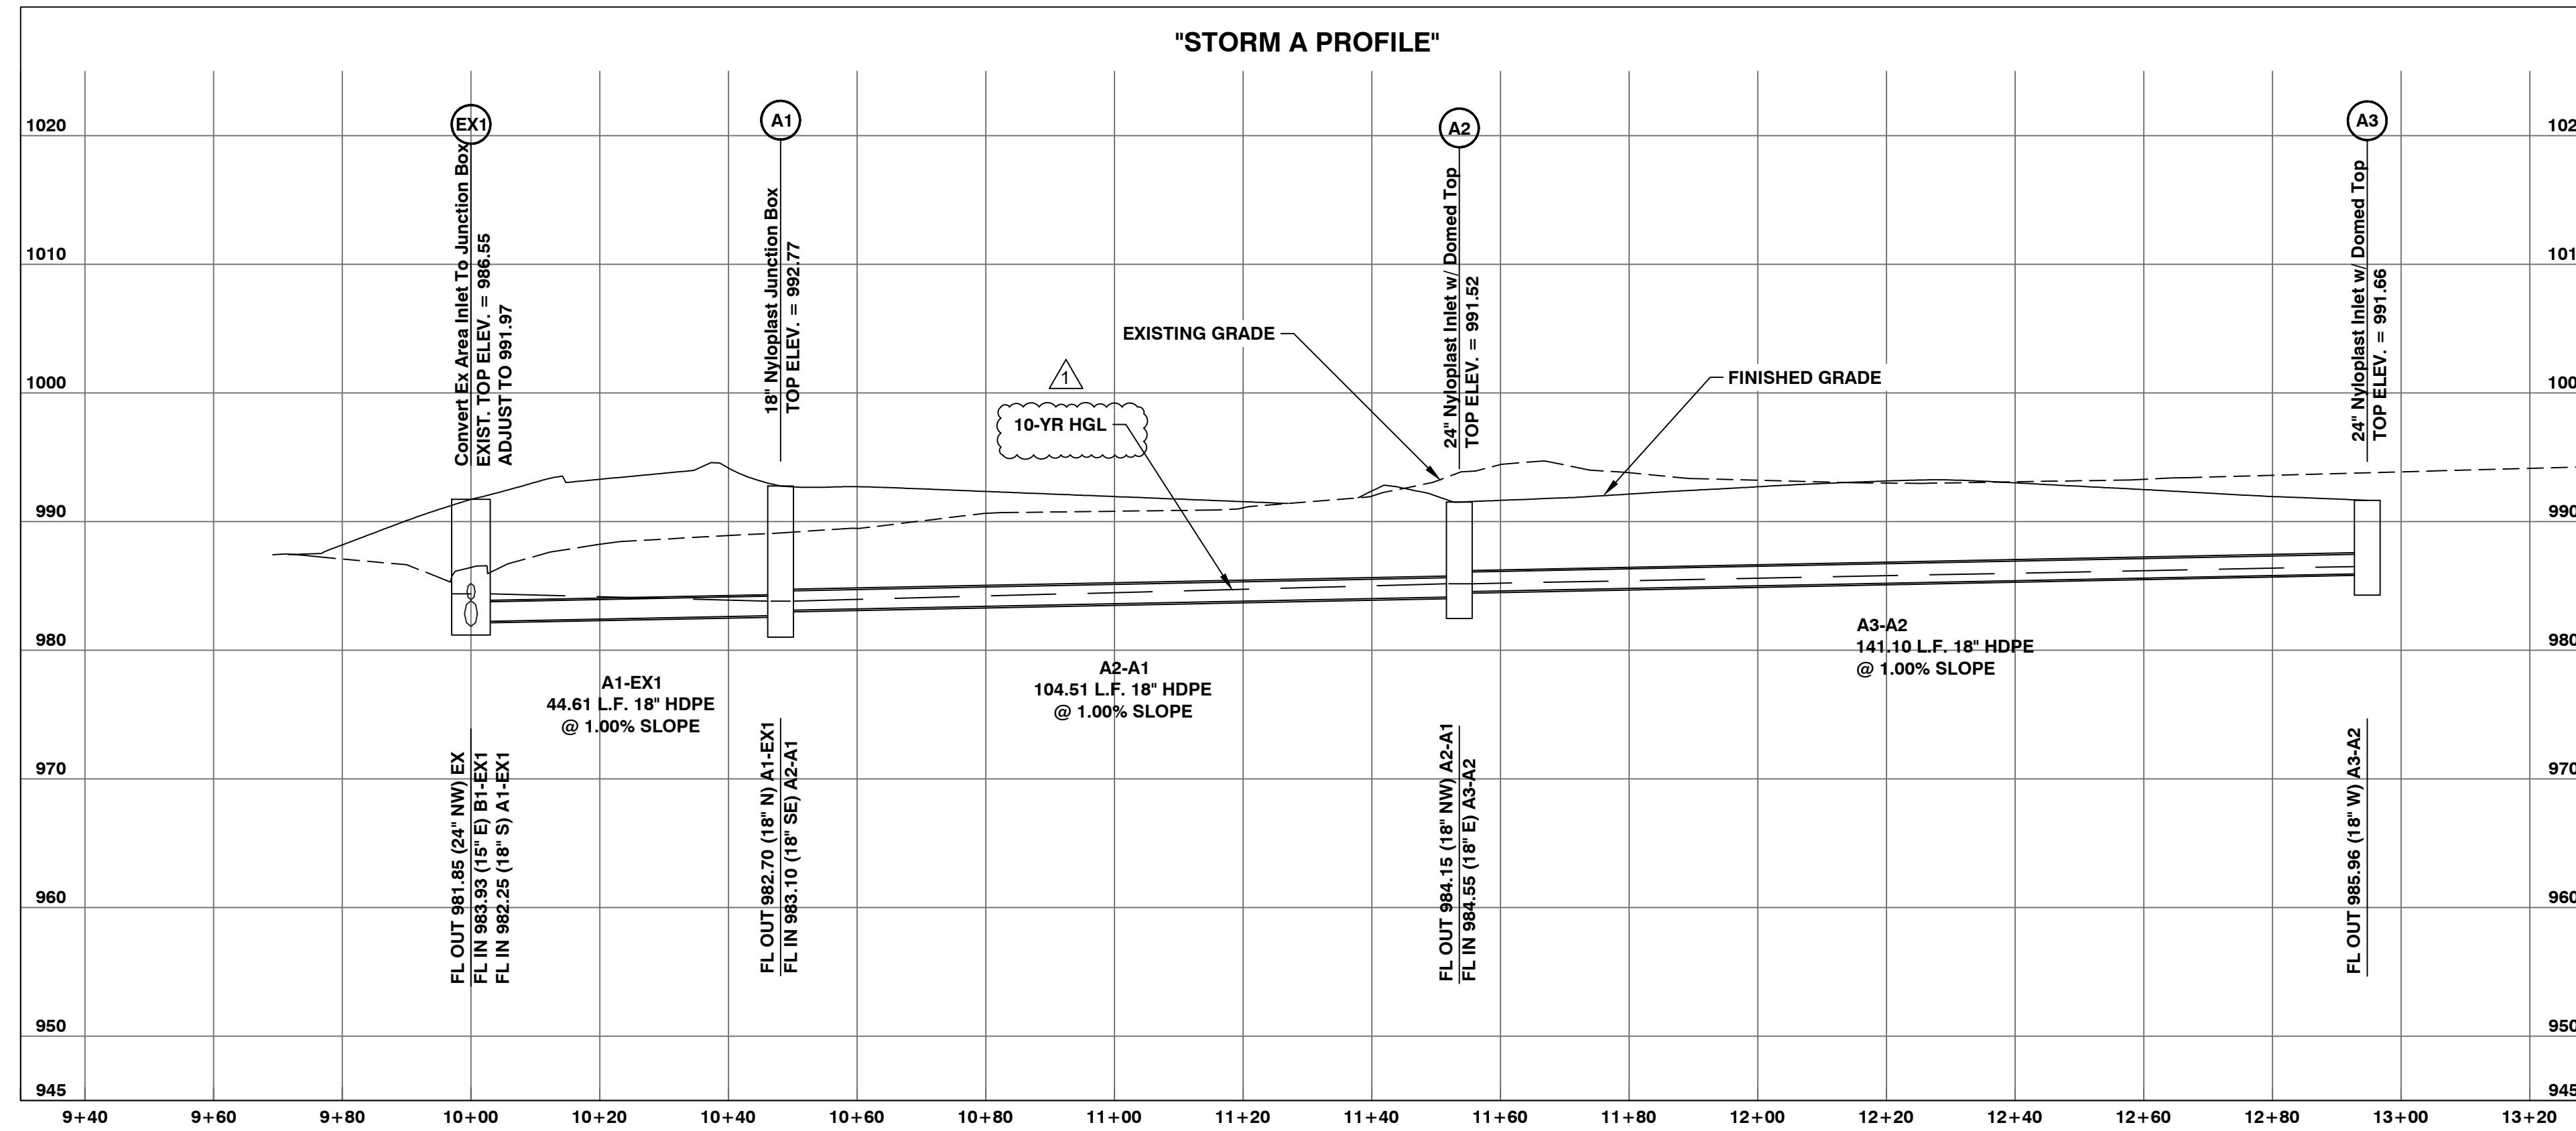

NOTE:

1. ALL TOPS FOR NYLOPLAST 2'x3' CURB INLET ARE AT GUTTER.
2. COMPACTED FILL SHALL BE PLACED TO A MINIMUM 18" ABOVE THE TOP OF THE PIPE PRIOR TO INSTALLATION.


RELEASED FOR CONSTRUCTION
As Noted on Plans Review
Development Services Department
Lee's Summit, Missouri
01/14/2022

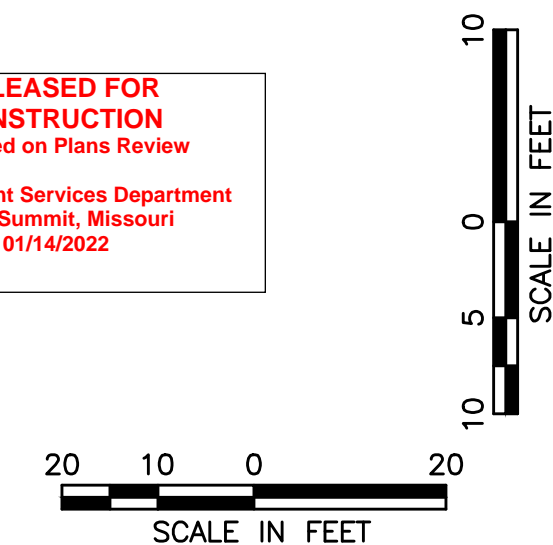

Certificate of Authority
Architecture: MO 310 / KE 13
Engineering: MO 4 / KS 241
Land Surveying: MO 123 / KS 34

© 2019 Powell CWM, Inc.
This drawing has been prepared by Powell CWM, Inc. This drawing is provided as an instrument of service by Powell CWM and is intended for use on this project only, pursuant to the Architectural Works Copyright Protection Act of 1990, all drawings, specifications, notes and designs, including the overall form arrangement and composition of spaces and elements appearing herein constitute the original copyrighted work of Powell CWM, Inc. Any reproduction, use or disclosure of information contained herein without prior written consent of Powell CWM, Inc. is strictly prohibited.

Toby L. Williams, PE
PE-2019038948 (MISSOURI #)

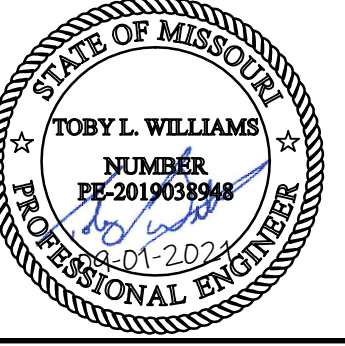


PREPARED FOR:
WARD DEVELOPMENT
DAVID WARD
1120 NW EAGLE RIDGE BLVD.
GRAIN VALLEY, MO 64029
(816) 229-8115

LOT 10, I-470 BUSINESS AND TECHNOLOGY CENTER
2601 NE MCBAIN DRIVE
LEE'S SUMMIT, MO 64064

REVISIONS	NO.	DATE / DESCRIPTION
	1	11/09/2021 - CITY COMMENTS

PROJECT #: 21-1902
ISSUE DATE: 09/01/2021
ISSUED FOR:

STORM PROFILES

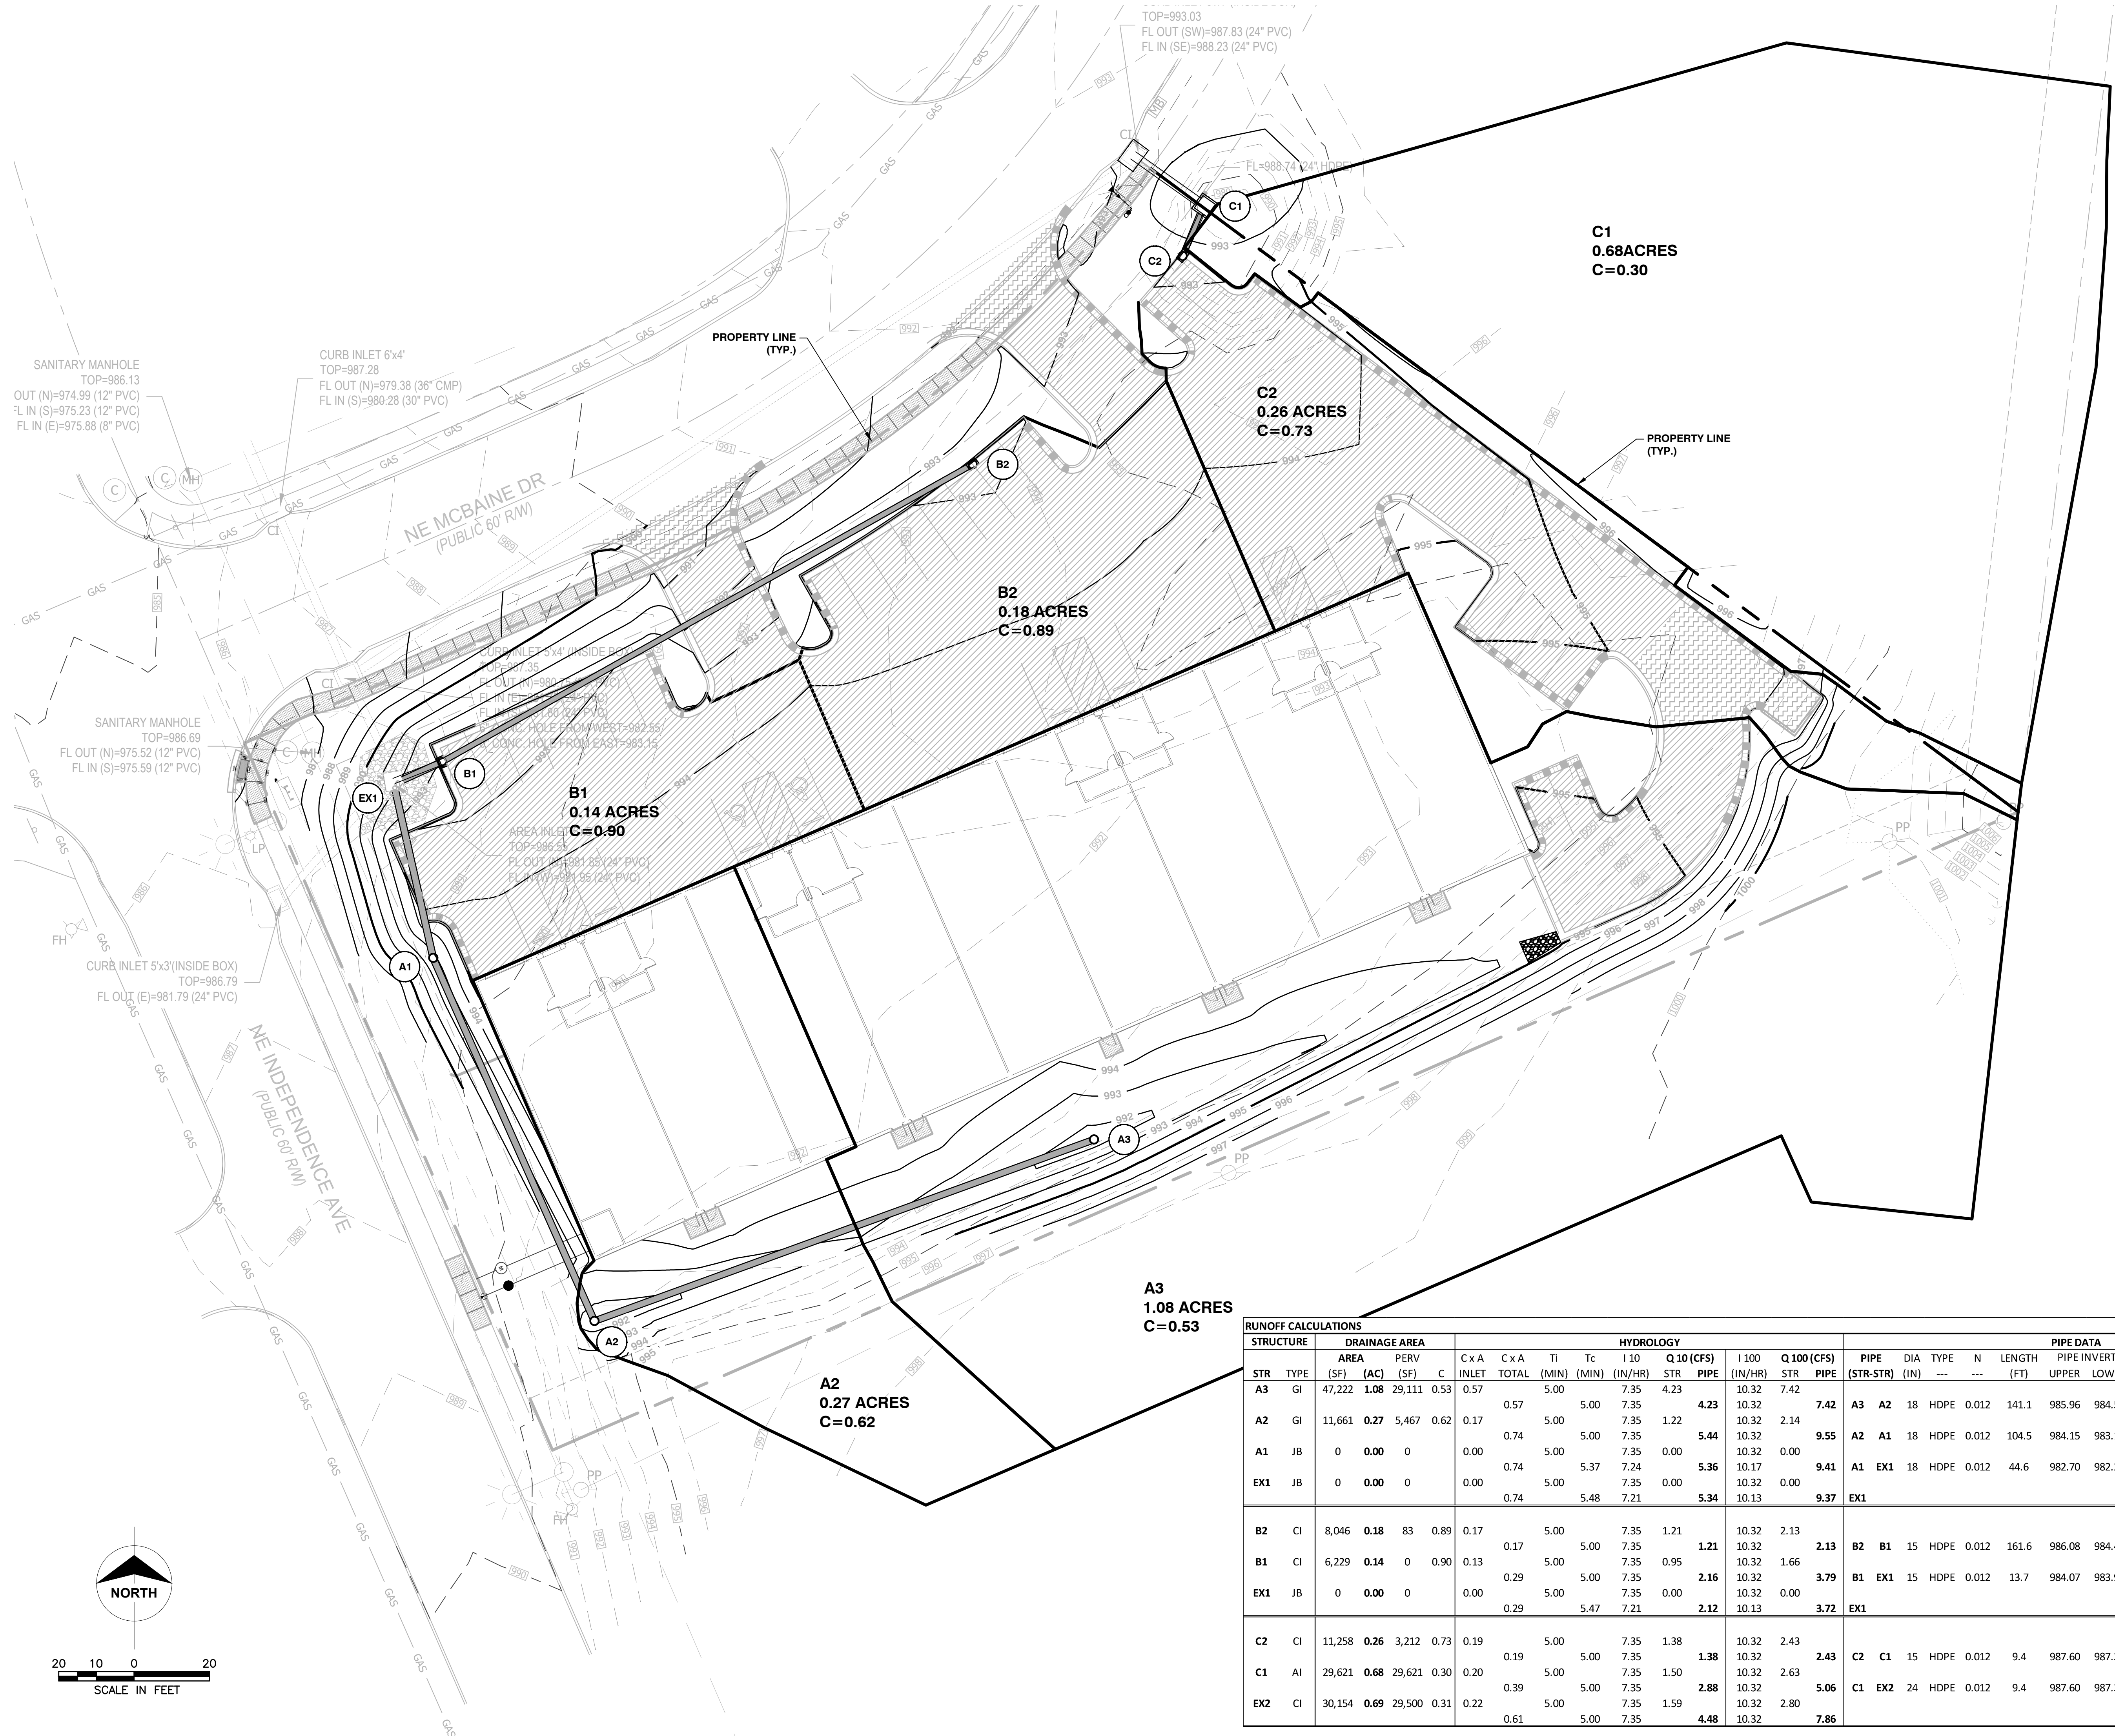


RELEASED FOR CONSTRUCTION
As Noted on Plans Review
Development Services Department
Lee's Summit, Missouri
01/14/2022

STRUCTURE		DRAINAGE AREA				HYDROLOGY										PIPE DATA						% CONVEYANCE							
STR	TYPE	AREA (SF)	PERV (AC)	C	Cx A	Cx A TOTAL	Ti (MIN)	Tc (MIN)	I 10 (IN/HR)	Q 10 (CFS) STR	Q 10 (CFS) PIPE	I 100 (IN/HR)	Q 100 (CFS) STR	Q 100 (CFS) PIPE	PIPE (STR-STR)	DIA (IN)	TYPE	N	LENGTH (FT)	PIPE INVERT UPPER	PIPE INVERT LOWER	SLOPE (%)	AREA (SF)	Qf (CFS)	Vf (FPS)	Tt (MIN)	Q 10 (%)	Q 100 (%)	
A3	GI	47,222	1.08	29,111	0.53	0.57	5.00	7.35	4.23	10.32	7.42	10.32	7.42	7.42	A3	A2	18	HDPE	0.012	141.1	985.96	984.55	1.00	1.77	11.38	6.44	0.37	100.0%	100.0%
A2	GI	11,661	0.27	5,467	0.62	0.17	5.00	7.35	1.22	10.32	2.14	10.32	2.14	2.14	A2	A1	18	HDPE	0.012	104.5	984.15	983.10	1.00	1.77	11.41	6.45	0.27	100.0%	100.0%
A1	JB	0	0.00	0	0.00	0.74	5.00	7.35	0.00	10.32	0.00	10.32	0.00	0.00	A1	EX1	18	HDPE	0.012	44.6	982.70	982.25	1.01	1.77	11.43	6.47	0.11	100.0%	100.0%
EX1	JB	0	0.00	0	0.00	0.74	5.00	7.35	0.00	10.32	0.00	10.32	0.00	0.00	EX1														
B2	CI	8,046	0.18	83	0.89	0.17	5.00	7.35	1.21	10.32	2.13	10.32	2.13	2.13	B2	B1	15	HDPE	0.012	161.6	986.08	984.47	1.00	1.23	6.99	5.69	0.47	100.0%	100.0%
B1	CI	6,229	0.14	0	0.90	0.13	5.00	7.35	0.95	10.32	1.66	10.32	1.66	1.66	B1	EX1	15	HDPE	0.012	13.7	984.07	983.93	1.02	1.23	7.07	5.76	0.04	100.0%	100.0%
EX1	JB	0	0.00	0	0.00	0.29	5.00	7.35	0.00	10.32	0.00	10.32	0.00	0.00	EX1														
C2	CI	11,258	0.26	3,212	0.73	0.19	5.00	7.35	1.38	10.32	2.43	10.32	2.43	2.43	C2	C1	15	HDPE	0.012	9.4	987.60	987.36	2.54	1.23	11.16	9.09	0.02	100.0%	100.0%
C1	AI	29,621	0.68	29,621	0.30	0.20	5.00	7.35	1.50	10.32	2.63	10.32	2.63	2.63	C1	EX2	24	HDPE	0.012	9.4	987.60	987.36	2.54	3.14	39.08	12.44	0.01	100.0%	100.0%
EX2	CI	30,154	0.69	29,500	0.31	0.22	5.00	7.35	1.59	10.32	2.80	10.32	2.80	2.80	EX2														
						0.61	5.00	7.35	4.48	10.32	7.86																		

Certificates of Authority
Architecture: MO 118 / KS 13
Engineering: MO 4 / KS 241
Land Surveying: MO 123 / KS 34

© 2019 Powell CWM, Inc.
This drawing has been prepared by Powell CWM, Inc. This drawing is provided as an instrument of service by Powell CWM and is intended for use on this project only, pursuant to the Architectural Works Copyright Protection Act of 1990. All drawings, specifications, ideas and designs, including the overall form arrangement and composition of spaces and elements appearing herein constitute the original copyrighted work of Powell CWM, Inc. Any reproduction, use or disclosure of information contained herein without prior written consent of Powell CWM, Inc. is strictly prohibited.

Toby L. Williams, PE
PE-2019038948 (MISSOURI #)

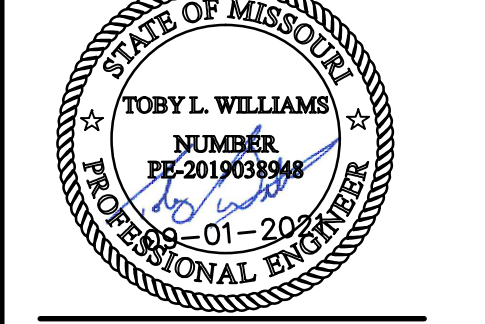

PREPARED FOR:
WARD DEVELOPMENT
DAVID WARD
1120 NW EAGLE RIDGE BLVD.
GRAIN VALLEY, MO 64029
(816) 229-8115

LOT 10, I-470 BUSINESS AND TECHNOLOGY CENTER
2601 NE MCBAIN DRIVE
LEE'S SUMMIT, MO 64064

REVISIONS NO.	DATE/DESCRIPTION


PROJECT #: 21-1902
ISSUE DATE: 09/01/2021
ISSUED FOR:

DRAINAGE AREA MAP

Certificates of Authority
 Architecture: MO 318 / KS 13
 Engineering: MO 4 / KS 241
 Land Surveying: MO 123 / KS 34

© 2019 Powell CWM, Inc.
 This drawing has been prepared by Powell CWM, Inc. This drawing is provided as an instrument of service by Powell CWM and is intended for use on this project only, pursuant to the Architectural Works Copyright Protection Act of 1990, all drawings, specifications, notes and designs, including the overall form arrangement and composition of spaces and elements appearing herein constitute the original copyrighted work of Powell CWM, Inc. Any reproduction, use or disclosure of information contained herein without prior written consent of Powell CWM, Inc. is strictly prohibited.

Toby L. Williams, PE
 PE-2019038948 (MISSOURI #)

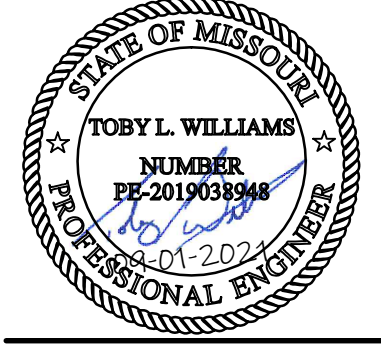

PREPARED FOR:
 WARD DEVELOPMENT
 DAVID WARD
 1120 NW EAGLE RIDGE BLVD.
 GRAIN VALLEY, MO 64029
 (816) 229-8115


LOT 10, I-470 BUSINESS AND TECHNOLOGY CENTER
 2601 NE MCBAIN DRIVE
 LEE'S SUMMIT, MO 64064

REVISIONS	NO.	DATE / DESCRIPTION	CITY COMMENTS
	1	11/09/2021	


PROJECT #: 21-1902
 ISSUE DATE: 09/01/2021
 ISSUED FOR:

DETAILS


C-501

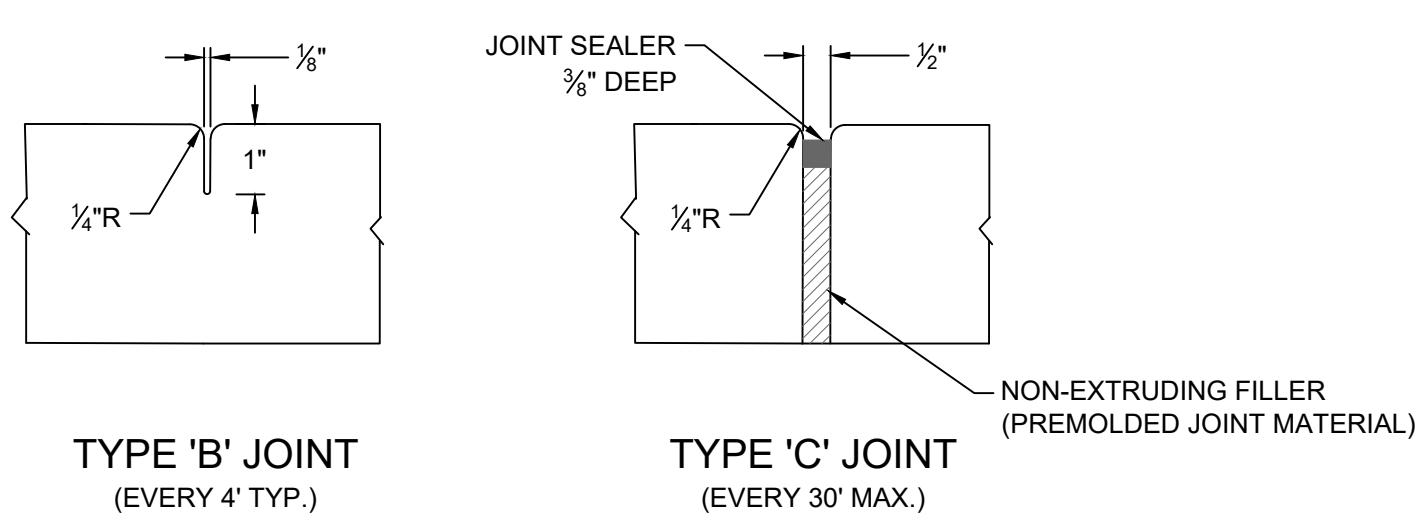


NOTE: SEE LEE'S SUMMIT STD. DETAIL GEN-2 FOR MORE INFORMATION

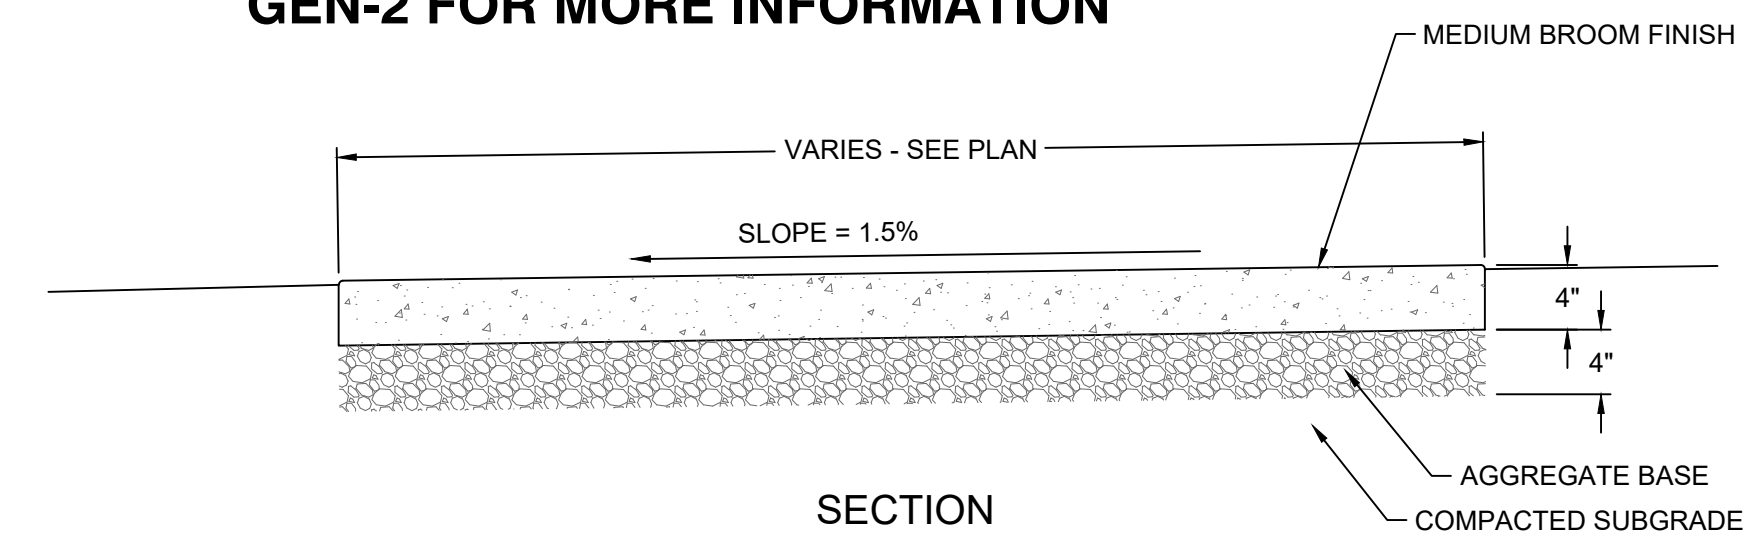


CONCRETE SIDEWALK
 N.T.S.

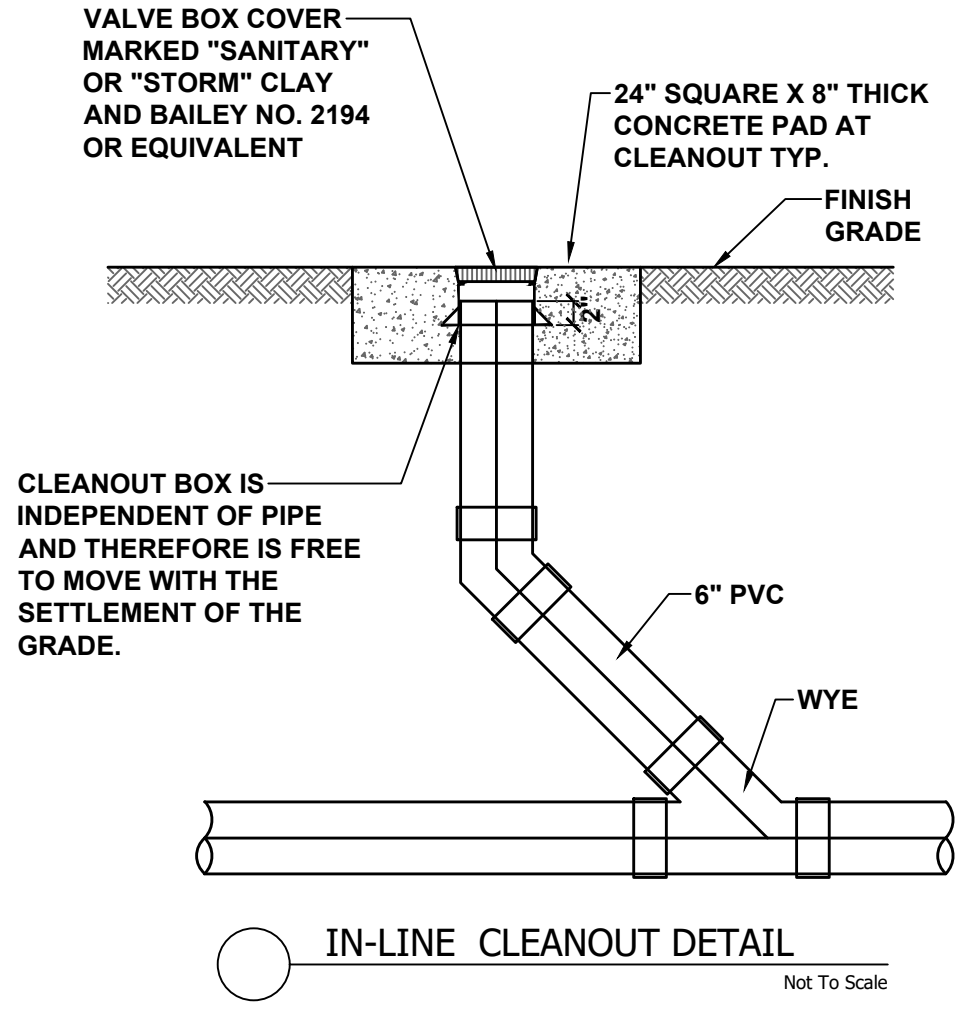


IN-LINE CLEANOUT DETAIL
 Not To Scale

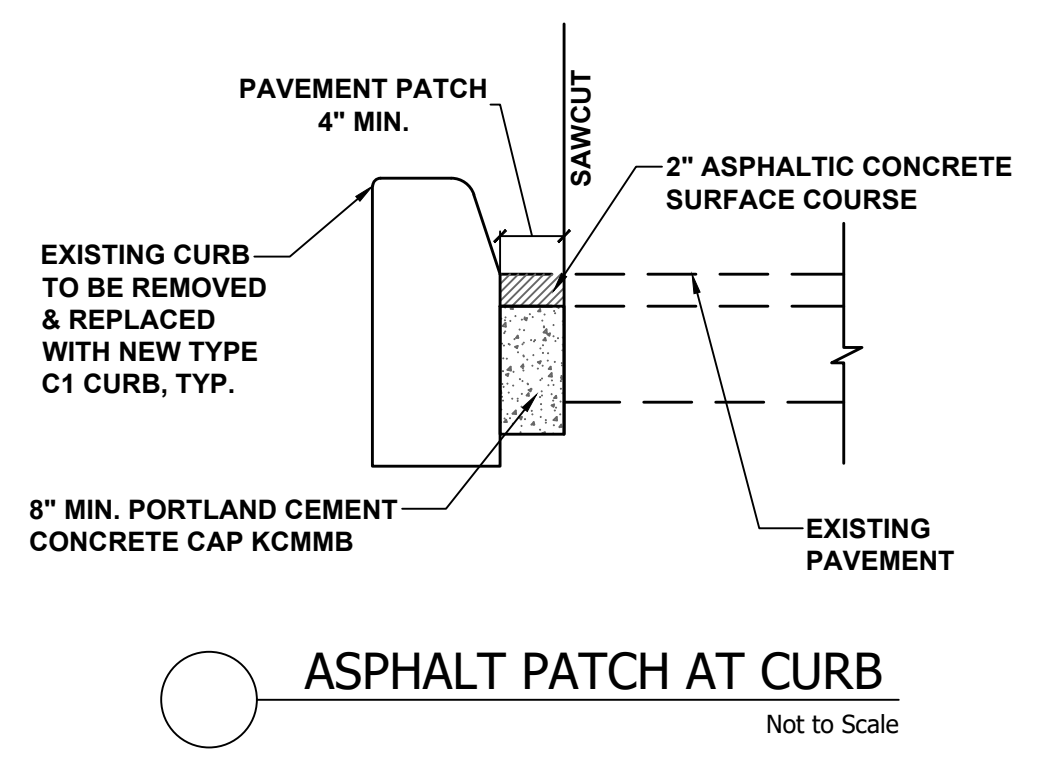

ASPHALT PATCH AT CURB
 Not to Scale

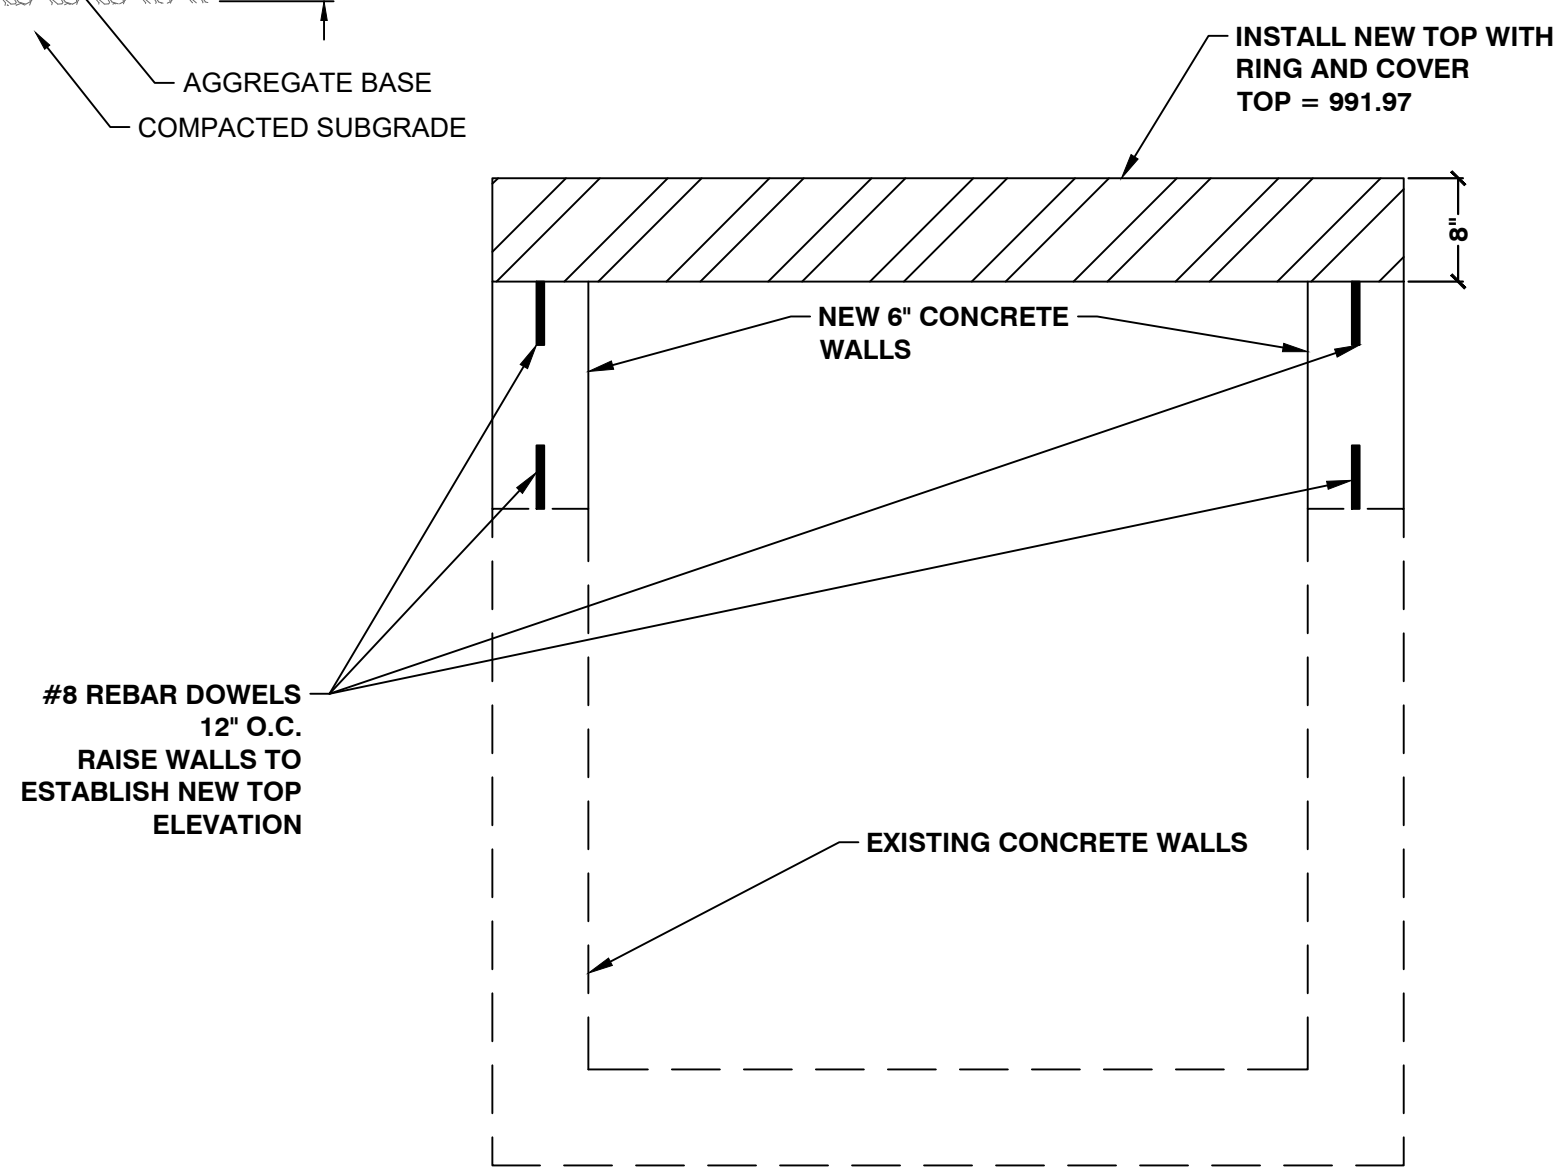


AREA INLET TO JUNCTION BOX
 Not to Scale

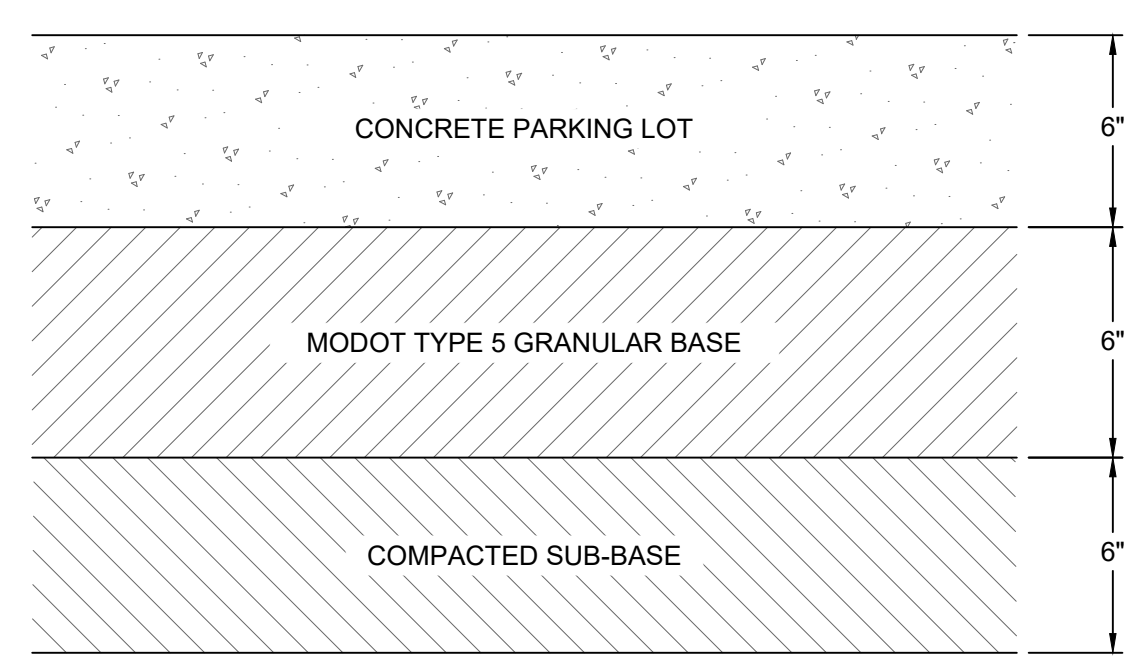


CONCRETE SECTION
 Not to Scale

- SITE PAVING NOTES:**
- PAVING BASE MATERIAL AND COMPACTION REQUIREMENTS ARE TO MEET GEOTECHNICAL REPORT RECOMMENDATIONS.
 - DO NOT INSTALL PAVEMENT UNTIL ALL UTILITY STRUCTURES ARE ADJUSTED TO BE FLUSH WITH FINAL PAVEMENT ELEVATION (I.E. CLEAN OUT COVERS/MANHOLE LIDS ETC..)

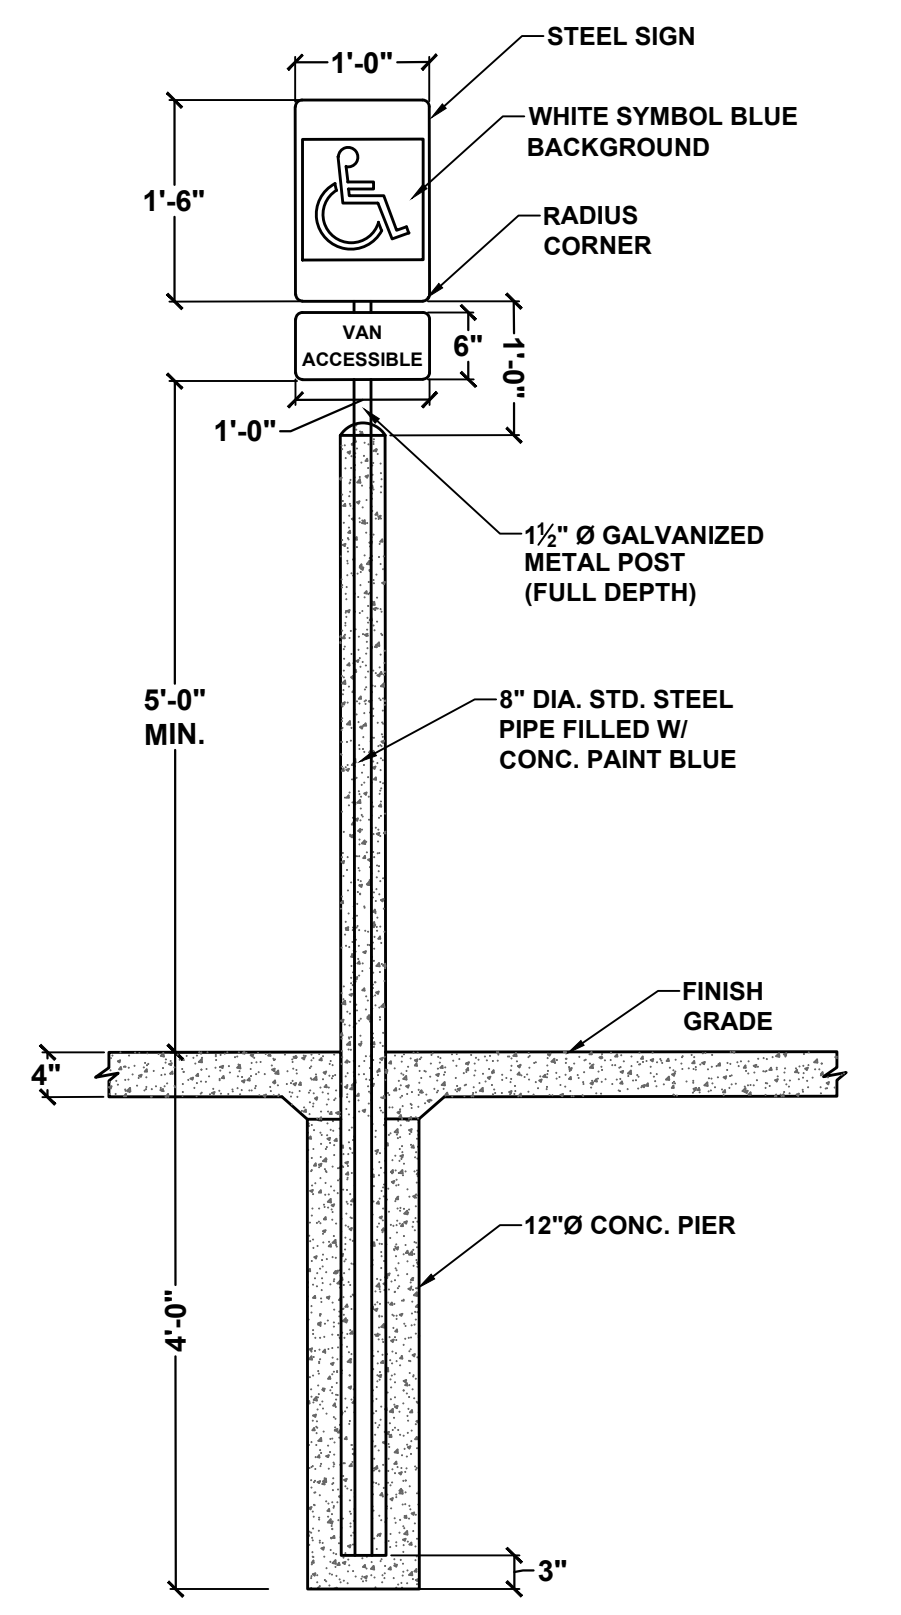


ACCESSIBLE SIGN DETAIL
 Not to Scale

NYLOPLAST 2 FT X 3FT CURB INLET STRUCTURE

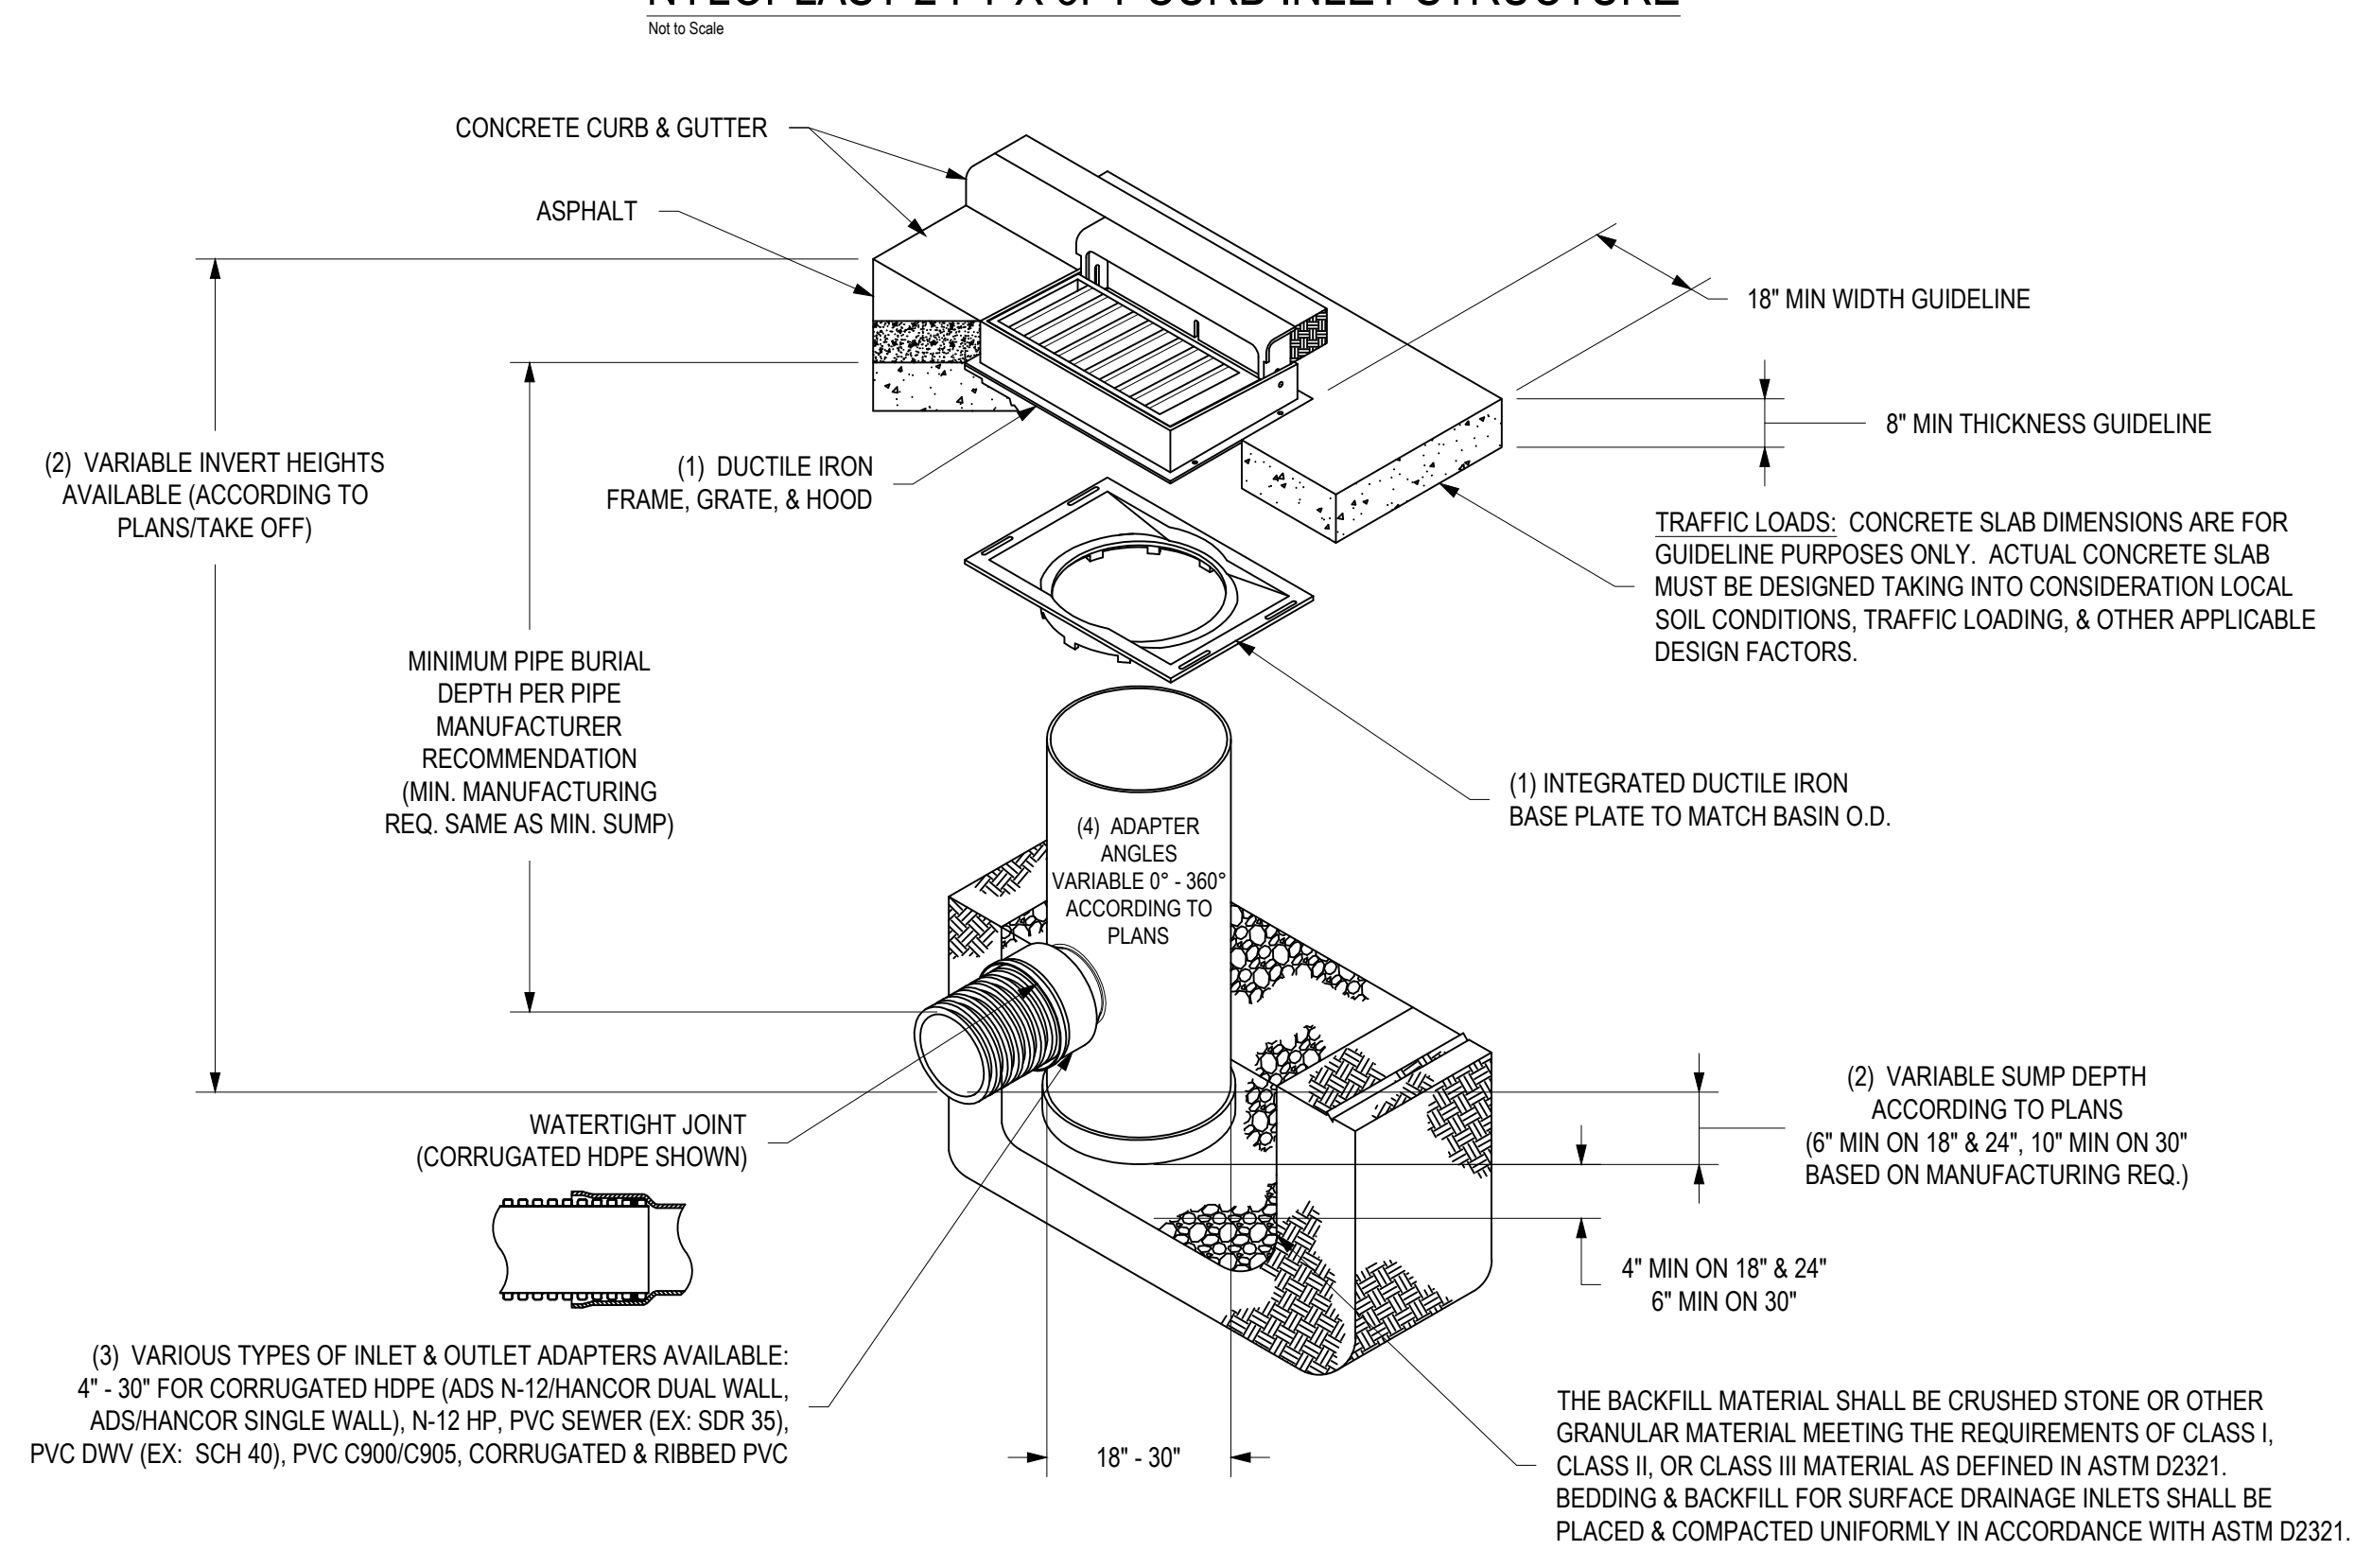


NOTE: ALL CONCRETE SHALL BE KCMMB 4K MIX

NOTE: REINFORCING SHALL CONSIST OF FIBER IN DESIGN MIX.

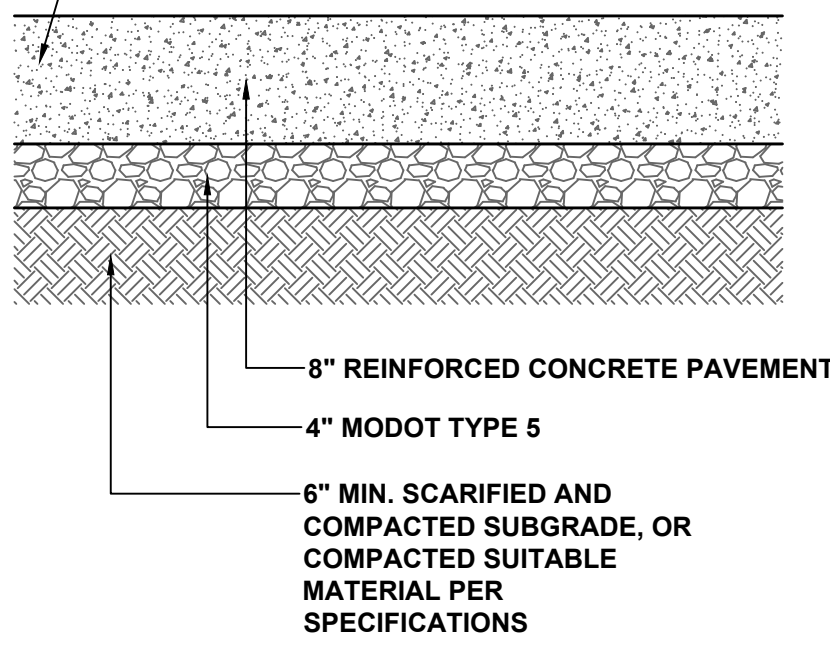


PRIVATE HEAVY DUTY CONCRETE
 Not to Scale


RELEASED FOR CONSTRUCTION
 As Noted on Plans Review
 Development Services Department
 Lee's Summit, Missouri
 01/14/2022

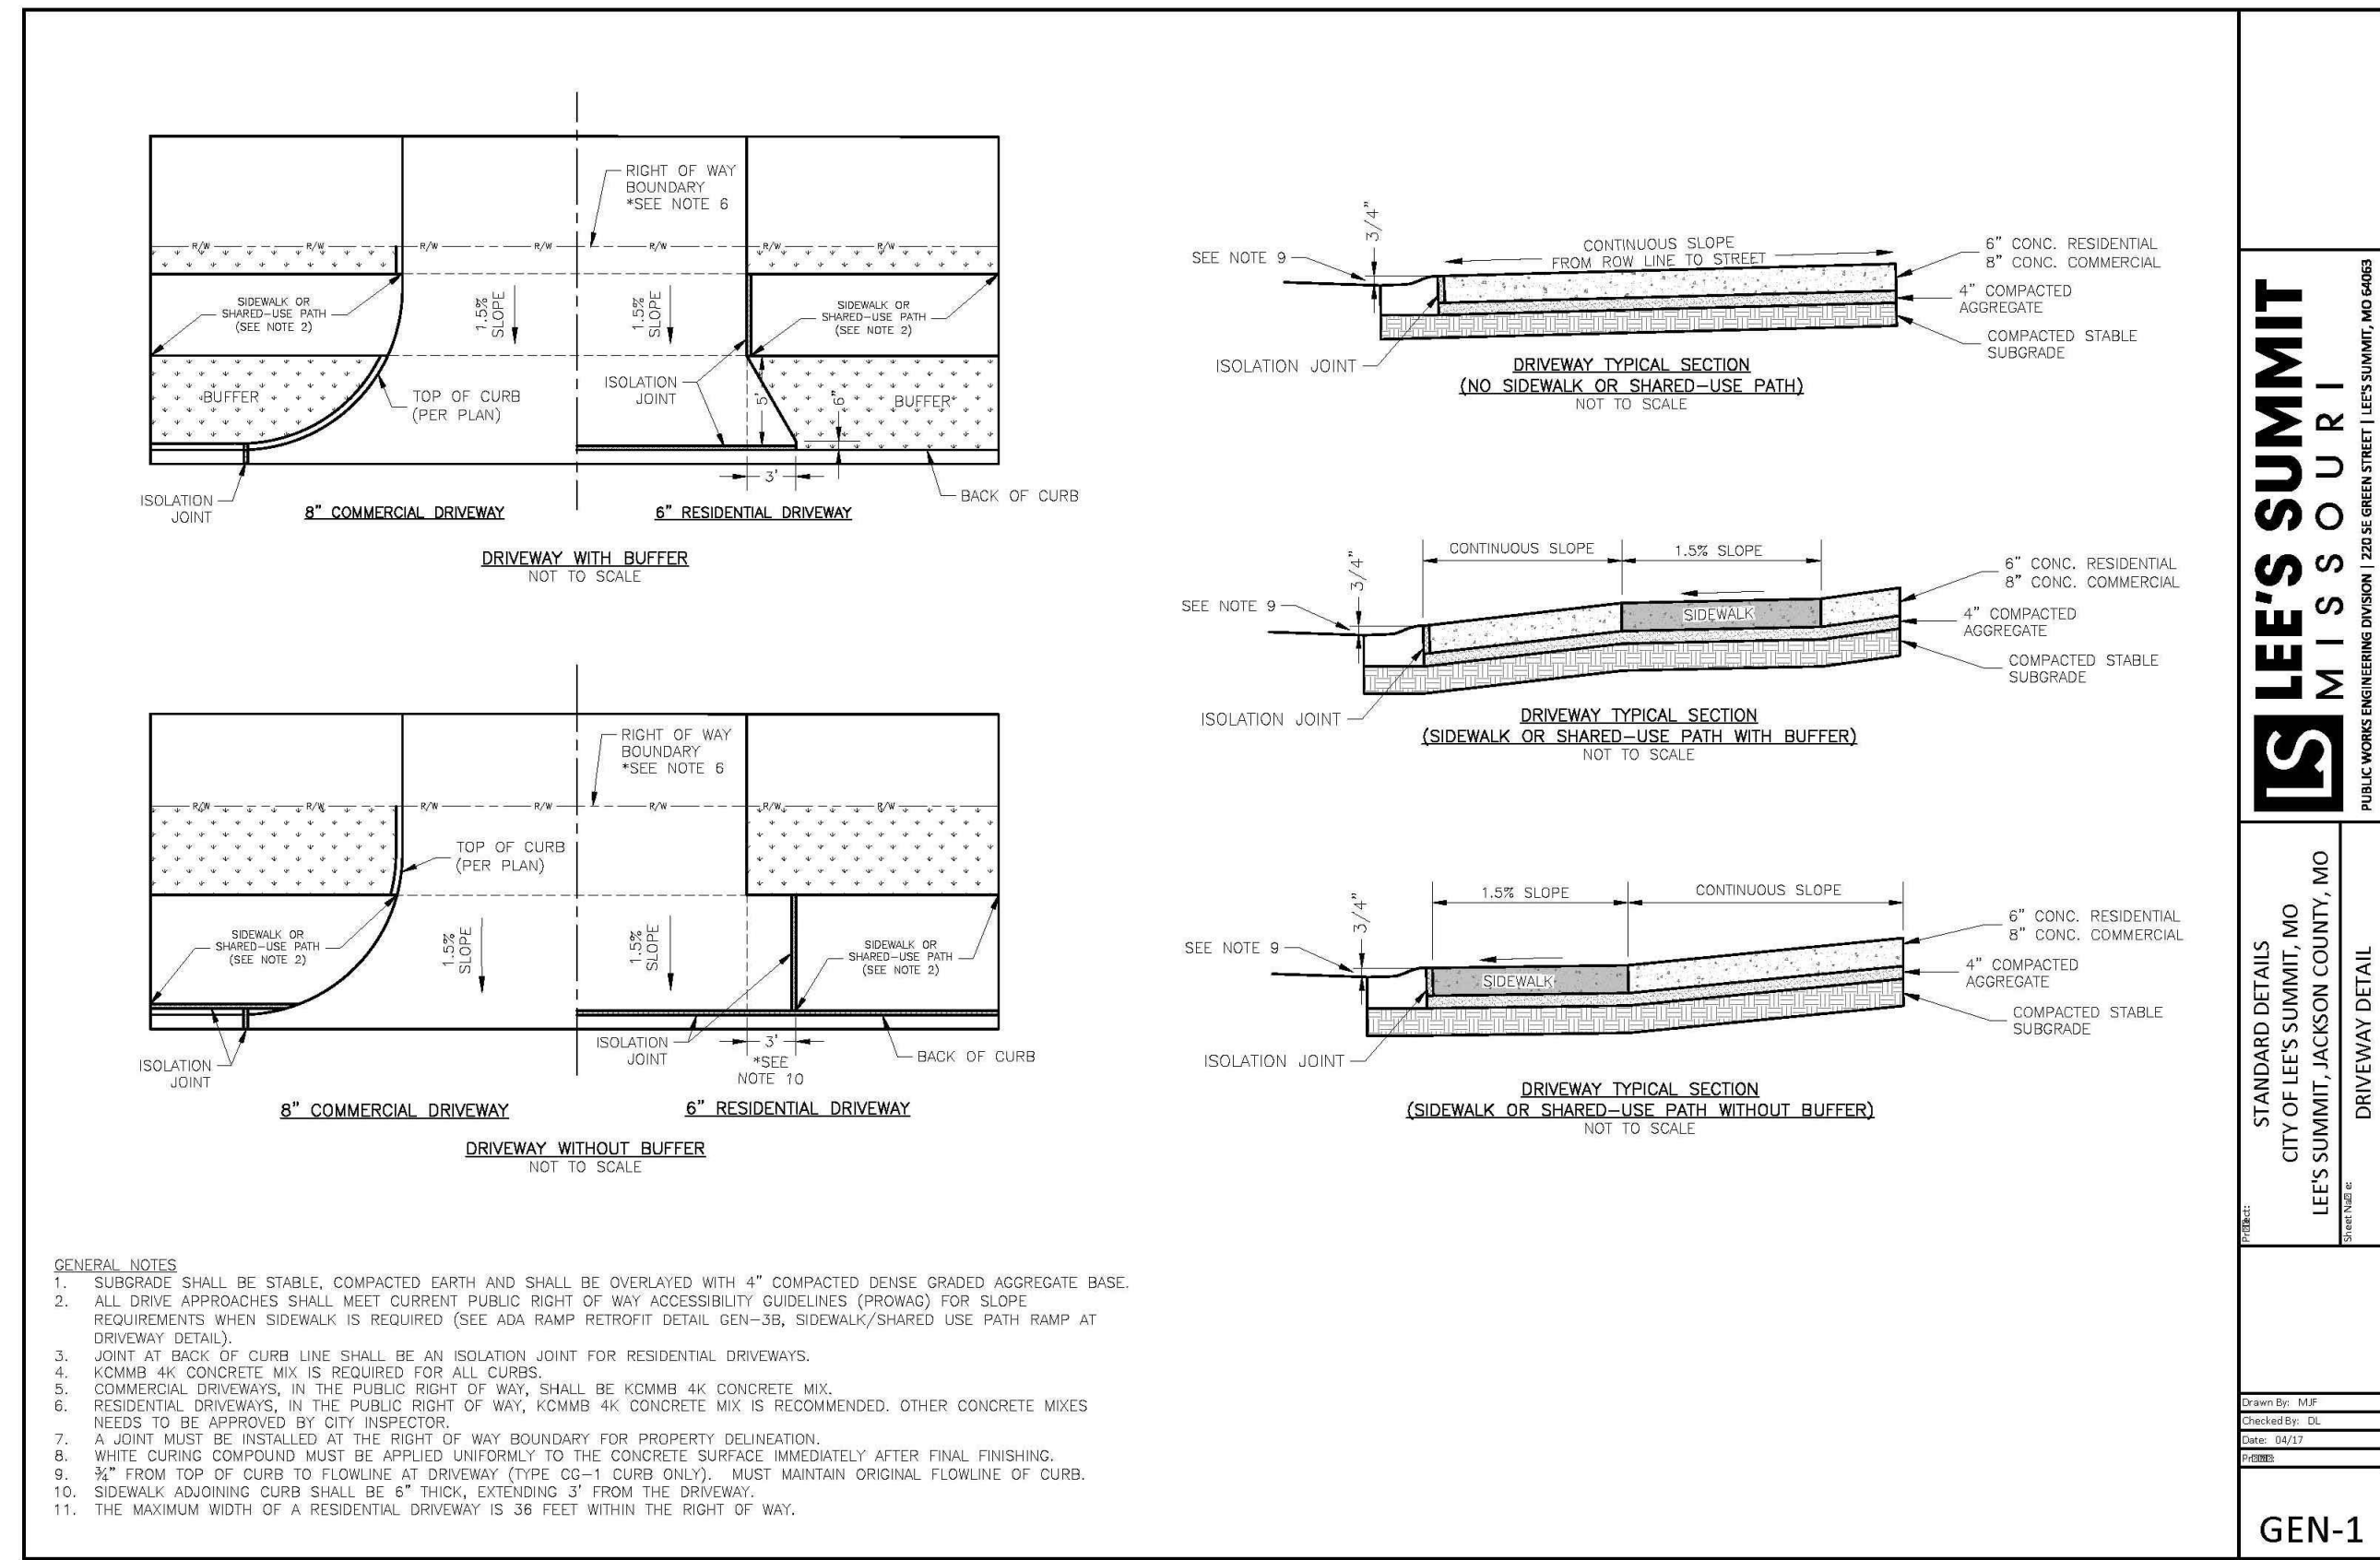


LEE'S SUMMIT MISSOURI
 STANDARD DETAILS
 CITY OF LEE'S SUMMIT, MO
 LEE'S SUMMIT, JACKSON COUNTY, MO
 ADA RAMP RETROFIT DETAIL
 GEN-1

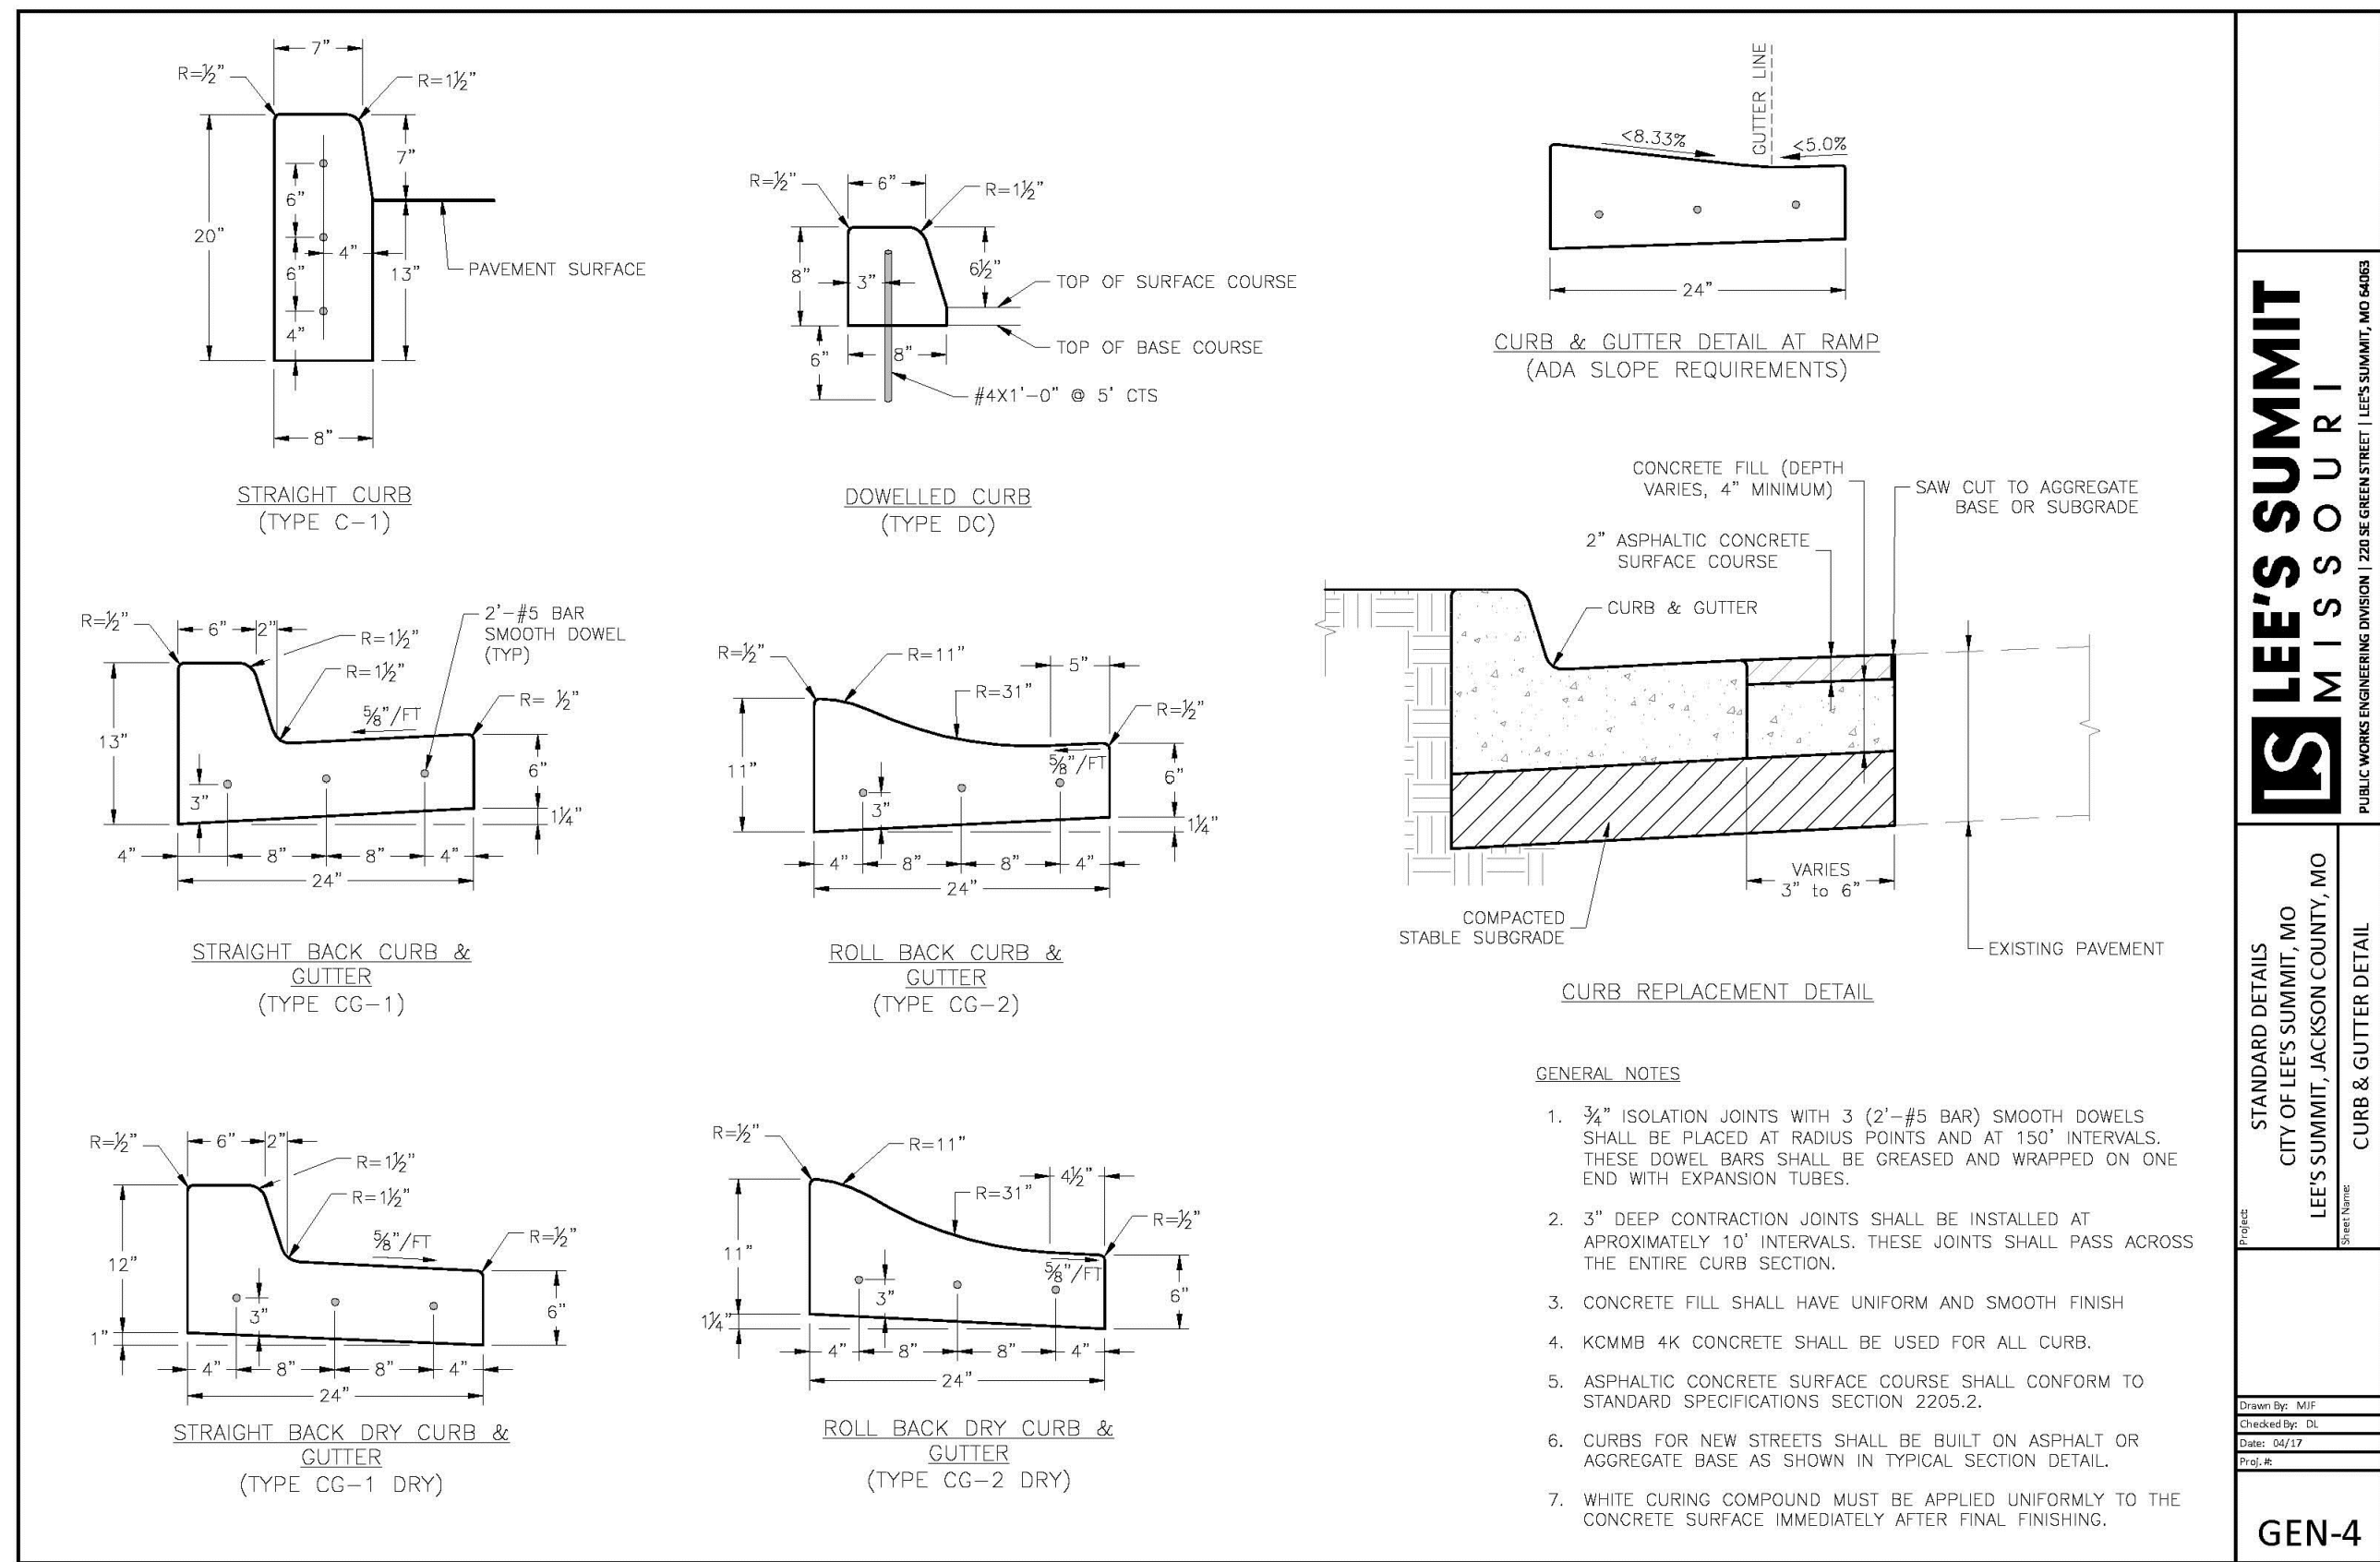

LEE'S SUMMIT MISSOURI
 STANDARD DETAILS
 CITY OF LEE'S SUMMIT, MO
 LEE'S SUMMIT, JACKSON COUNTY, MO
 CURB & GUTTER DETAIL
 GEN-4

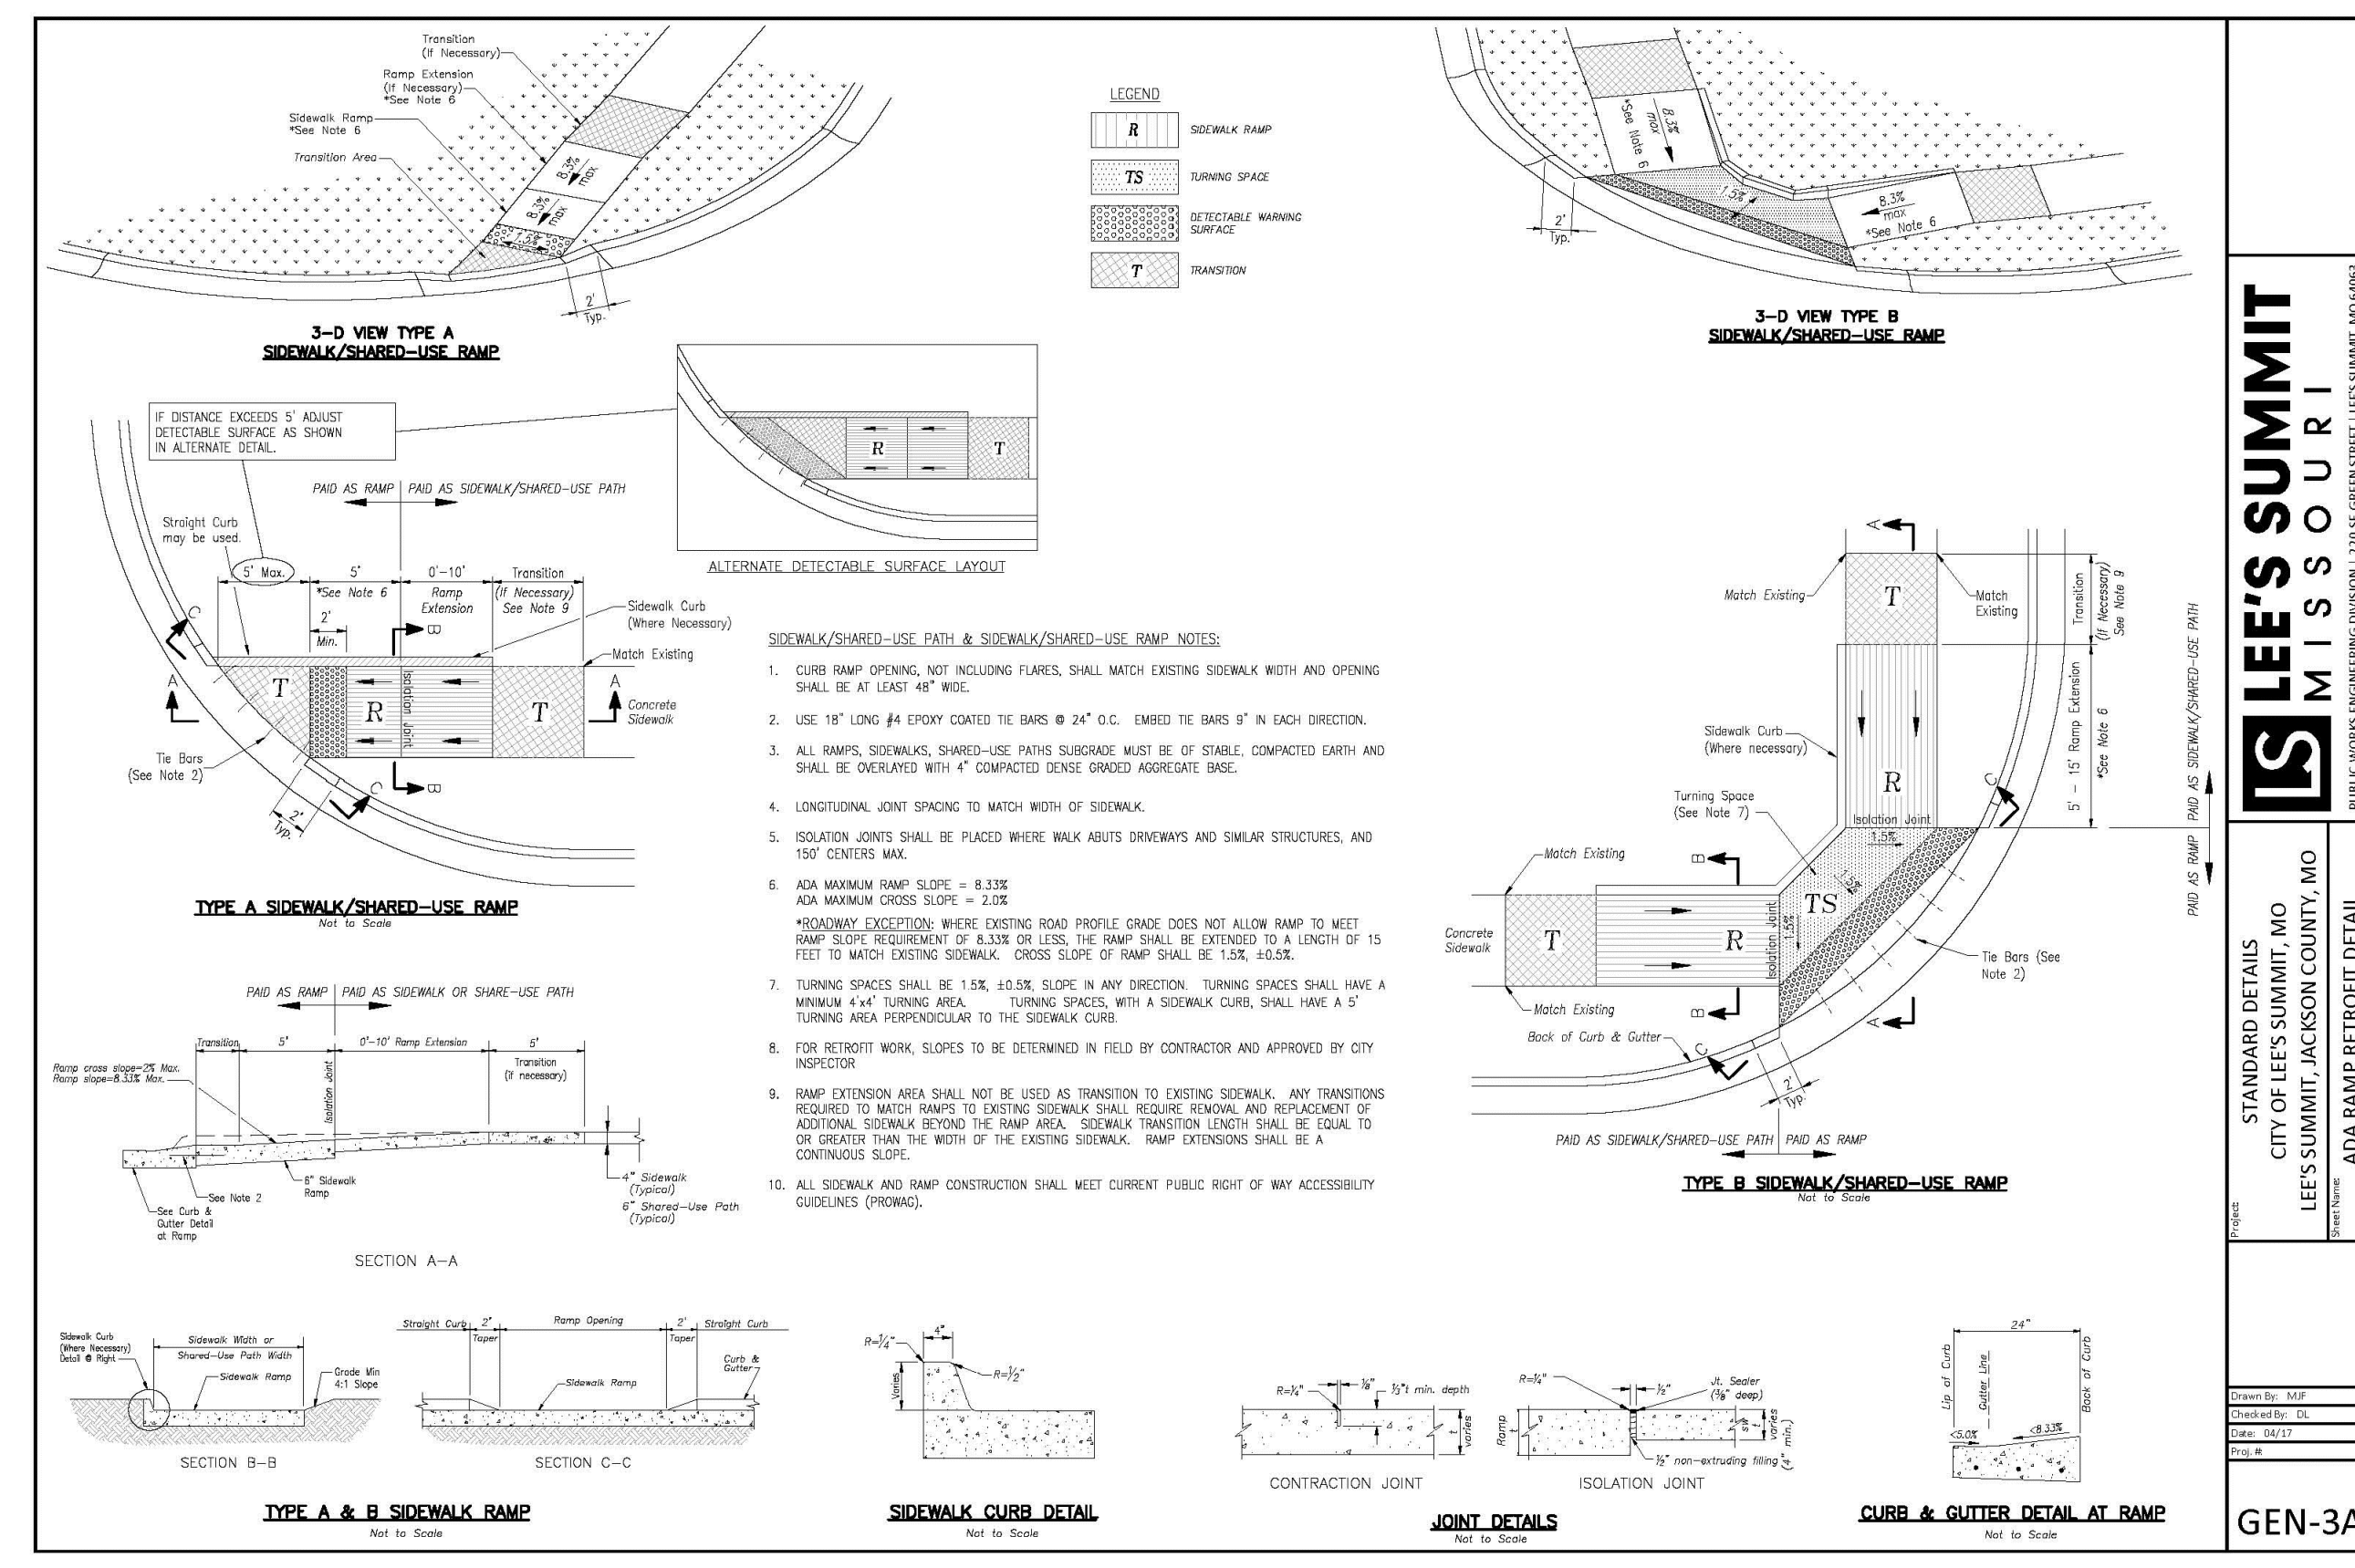

LEE'S SUMMIT MISSOURI
 STANDARD DETAILS
 CITY OF LEE'S SUMMIT, MO
 LEE'S SUMMIT, JACKSON COUNTY, MO
 ADA RAMP RETROFIT DETAIL
 GEN-3A

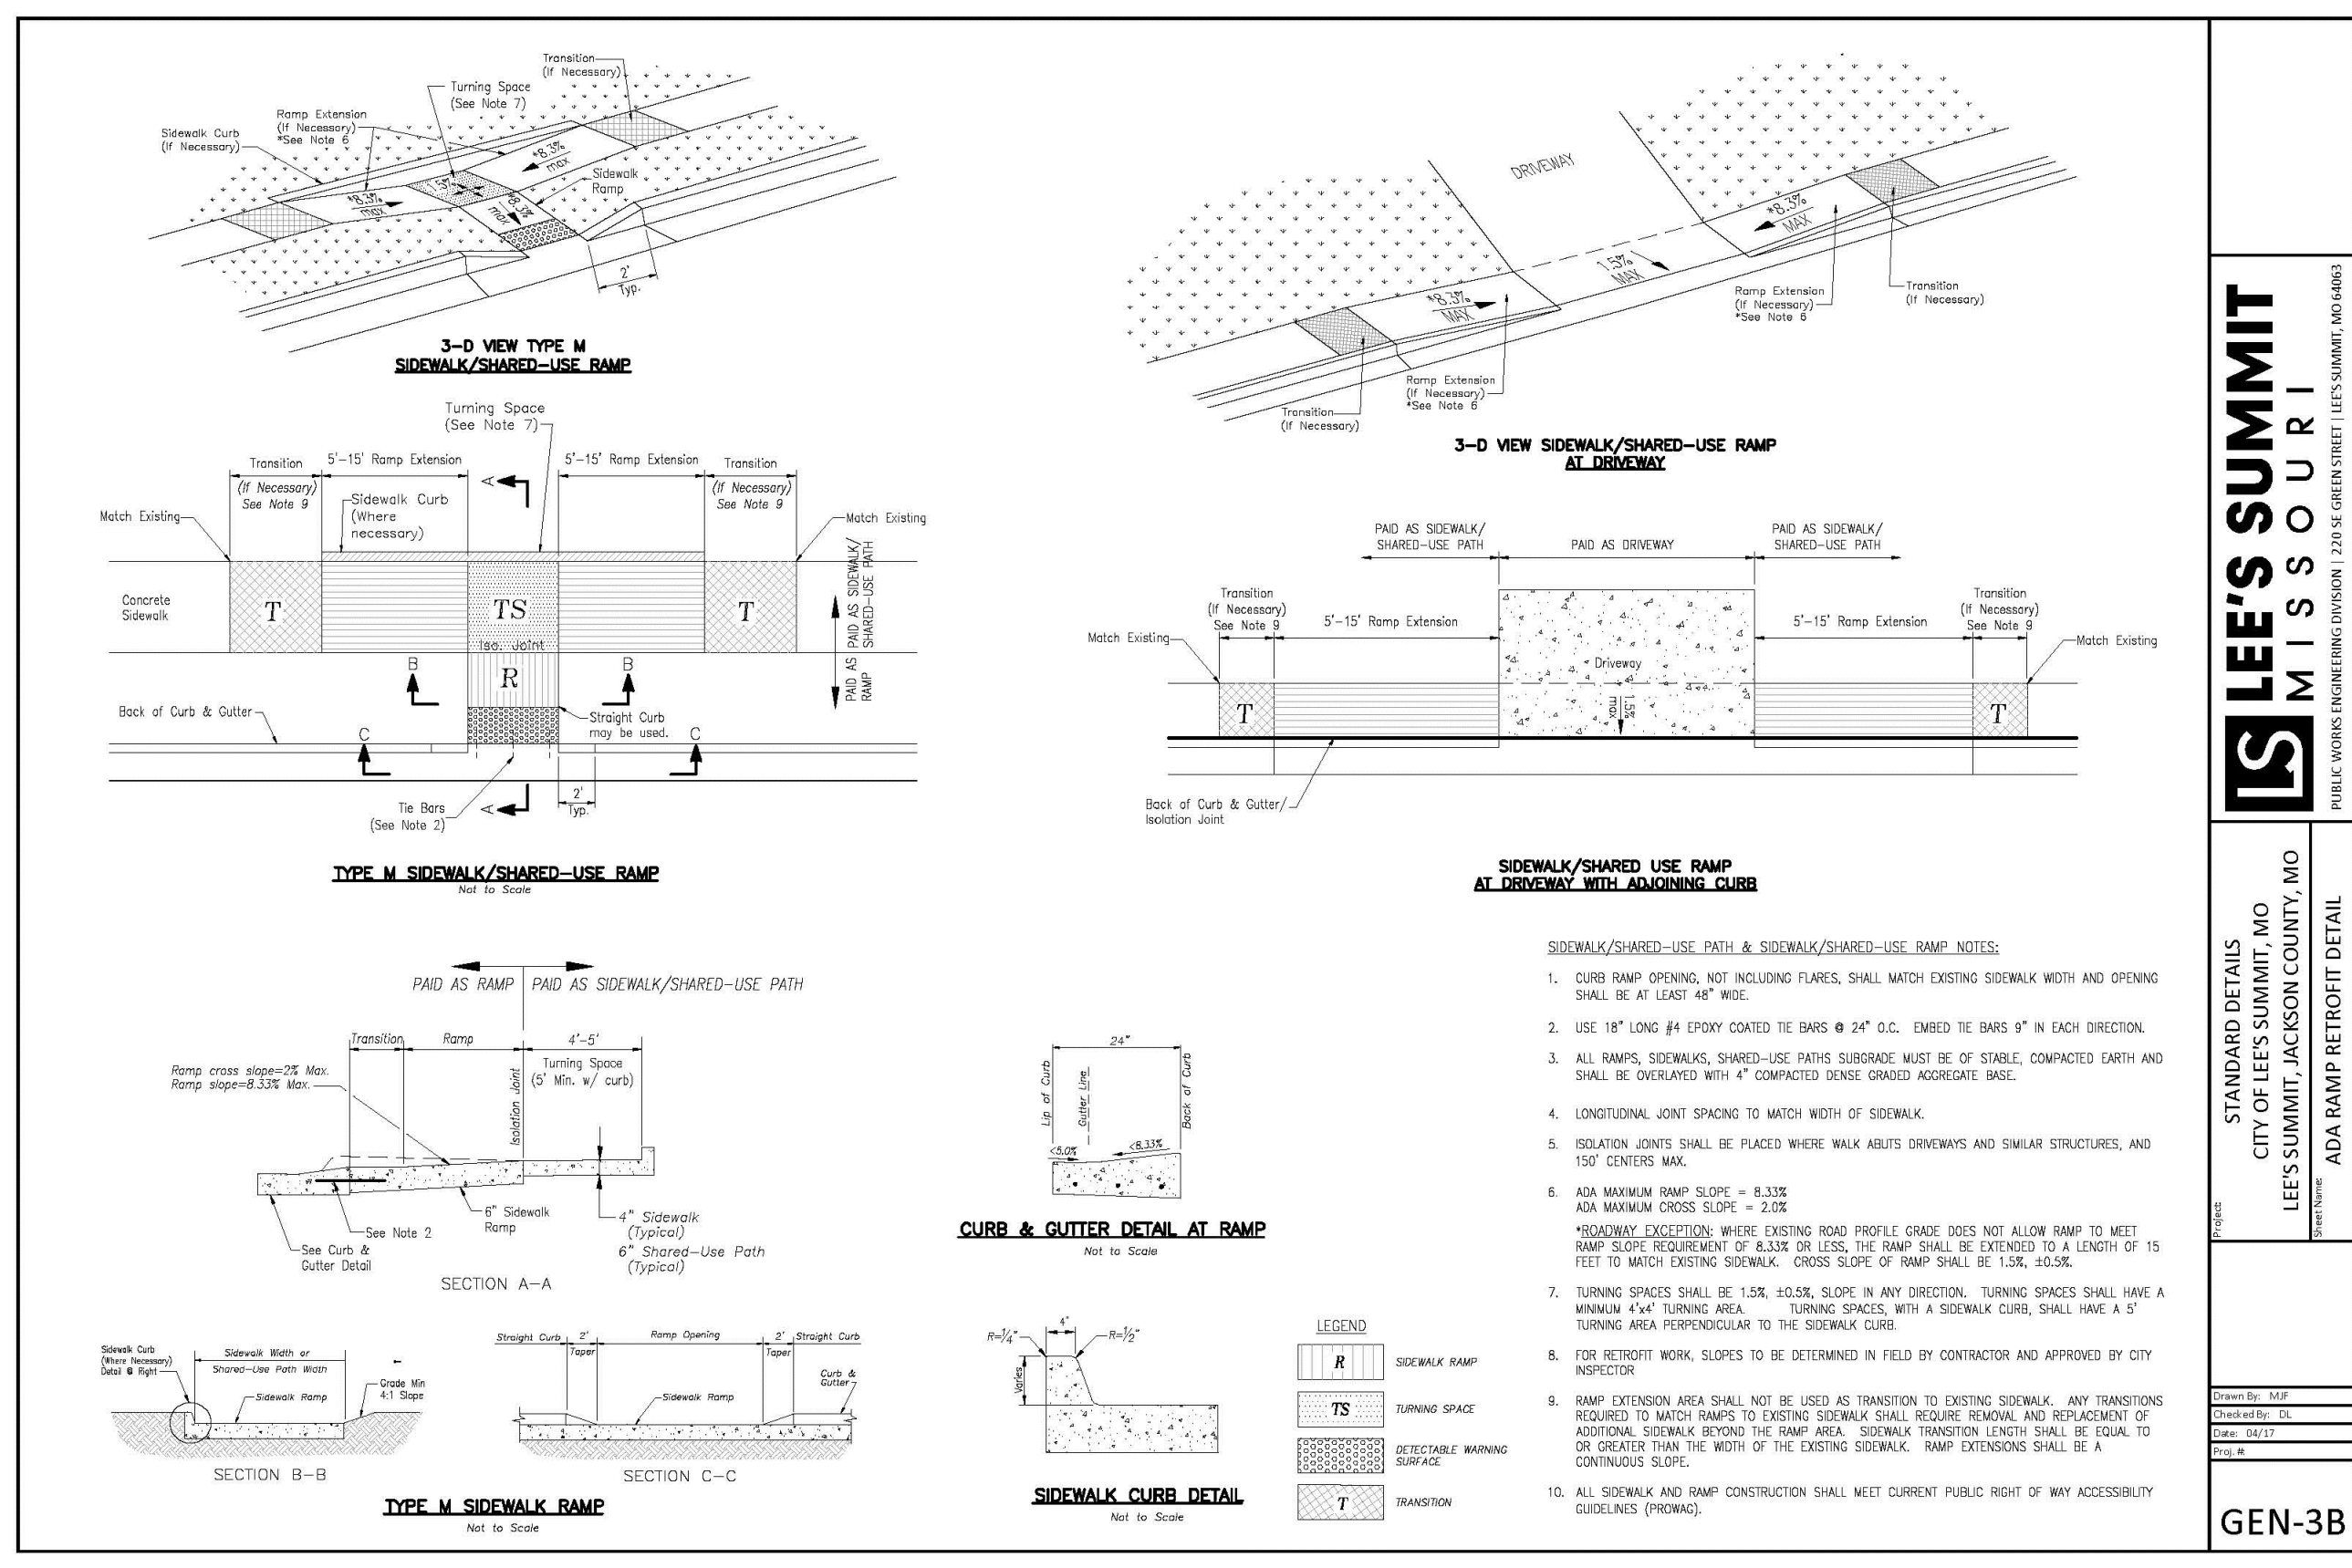

LEE'S SUMMIT MISSOURI
 STANDARD DETAILS
 CITY OF LEE'S SUMMIT, MO
 LEE'S SUMMIT, JACKSON COUNTY, MO
 ADA RAMP RETROFIT DETAIL
 GEN-3B

RELEASED FOR CONSTRUCTION
 As Noted on Plans Review
 Development Services Department
 Lee's Summit, Missouri
 01/14/2022

Certification of Authority
 Authority: MO 187 / ES 13
 Engineering: MO 4 / KS 241
 Land Surveying: MO 123 / KS 34

© 2019 Powell CWM, Inc.
 This drawing has been prepared by Powell CWM, Inc. This drawing is provided as an instrument of service by Powell CWM and is intended for use on this project only, pursuant to the Architectural Works Copyright Protection Act of 1990. All drawings, specifications, ideas and designs, including the overall form arrangement and composition of spaces and elements appearing herein constitute the original copyrighted work of Powell CWM, Inc. Any reproduction, use or disclosure of information contained herein without prior written consent of Powell CWM, Inc. is strictly prohibited.

Toby L. Williams, PE
 PE-2019038948 (MISSOURI #)





TOBY L. WILLIAMS
 PROFESSIONAL ENGINEER
 NUMBER: PE-2019038948
 EXPIRES: 12/31/2023

PREPARED FOR:
 WARD DEVELOPMENT
 DAVID WARD
 1120 NW EAGLE RIDGE BLVD.
 GRAIN VALLEY, MO 64029
 (816) 229-8115

LOT 10, I-470 BUSINESS AND TECHNOLOGY CENTER
 2601 NE MCBAIN DRIVE
 LEE'S SUMMIT, MO 64064

REVISIONS	NO.	DATE / DESCRIPTION
	1	11/09/2021 - CITY COMMENTS

PROJECT #: 21-1902
 ISSUE DATE: 09/01/2021
 ISSUED FOR:

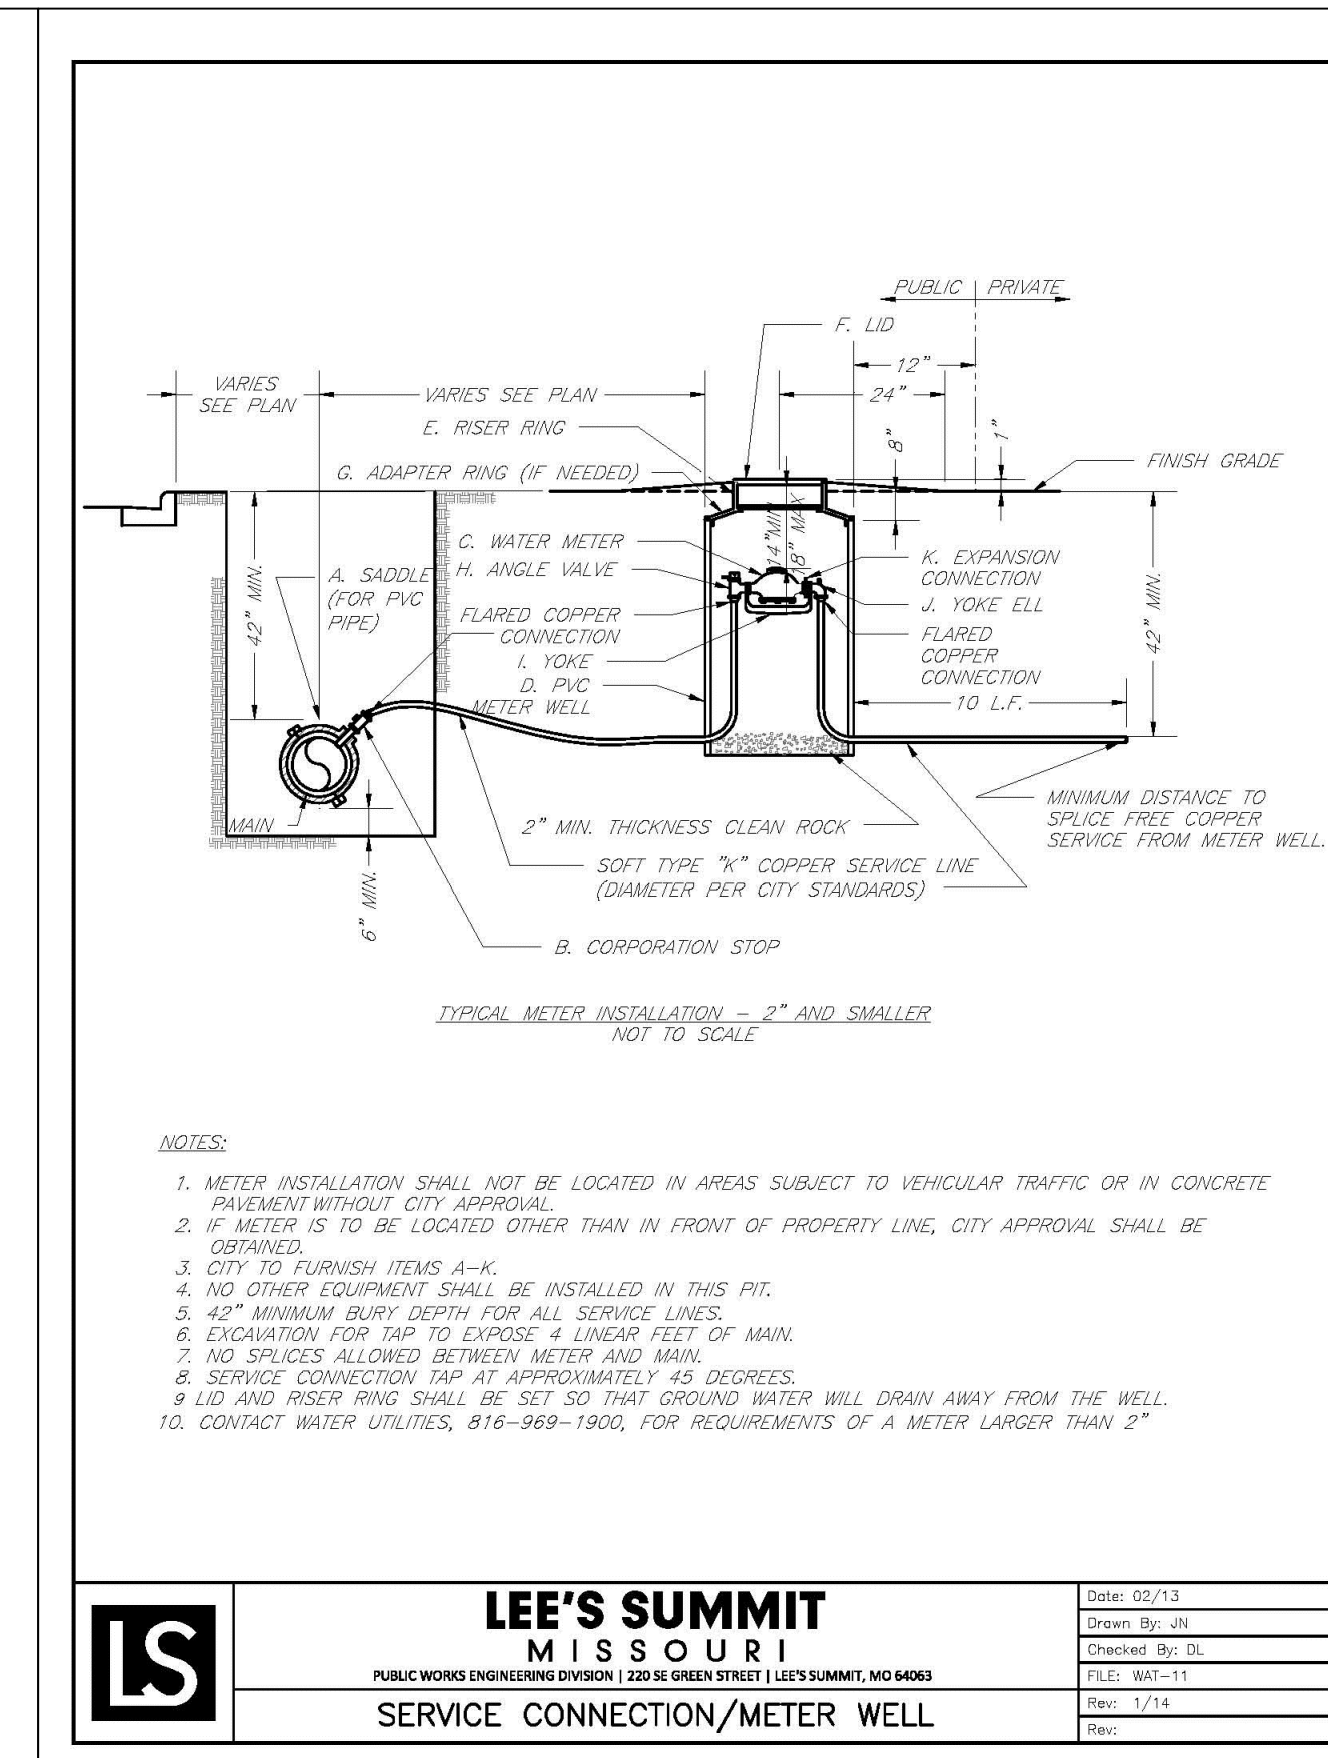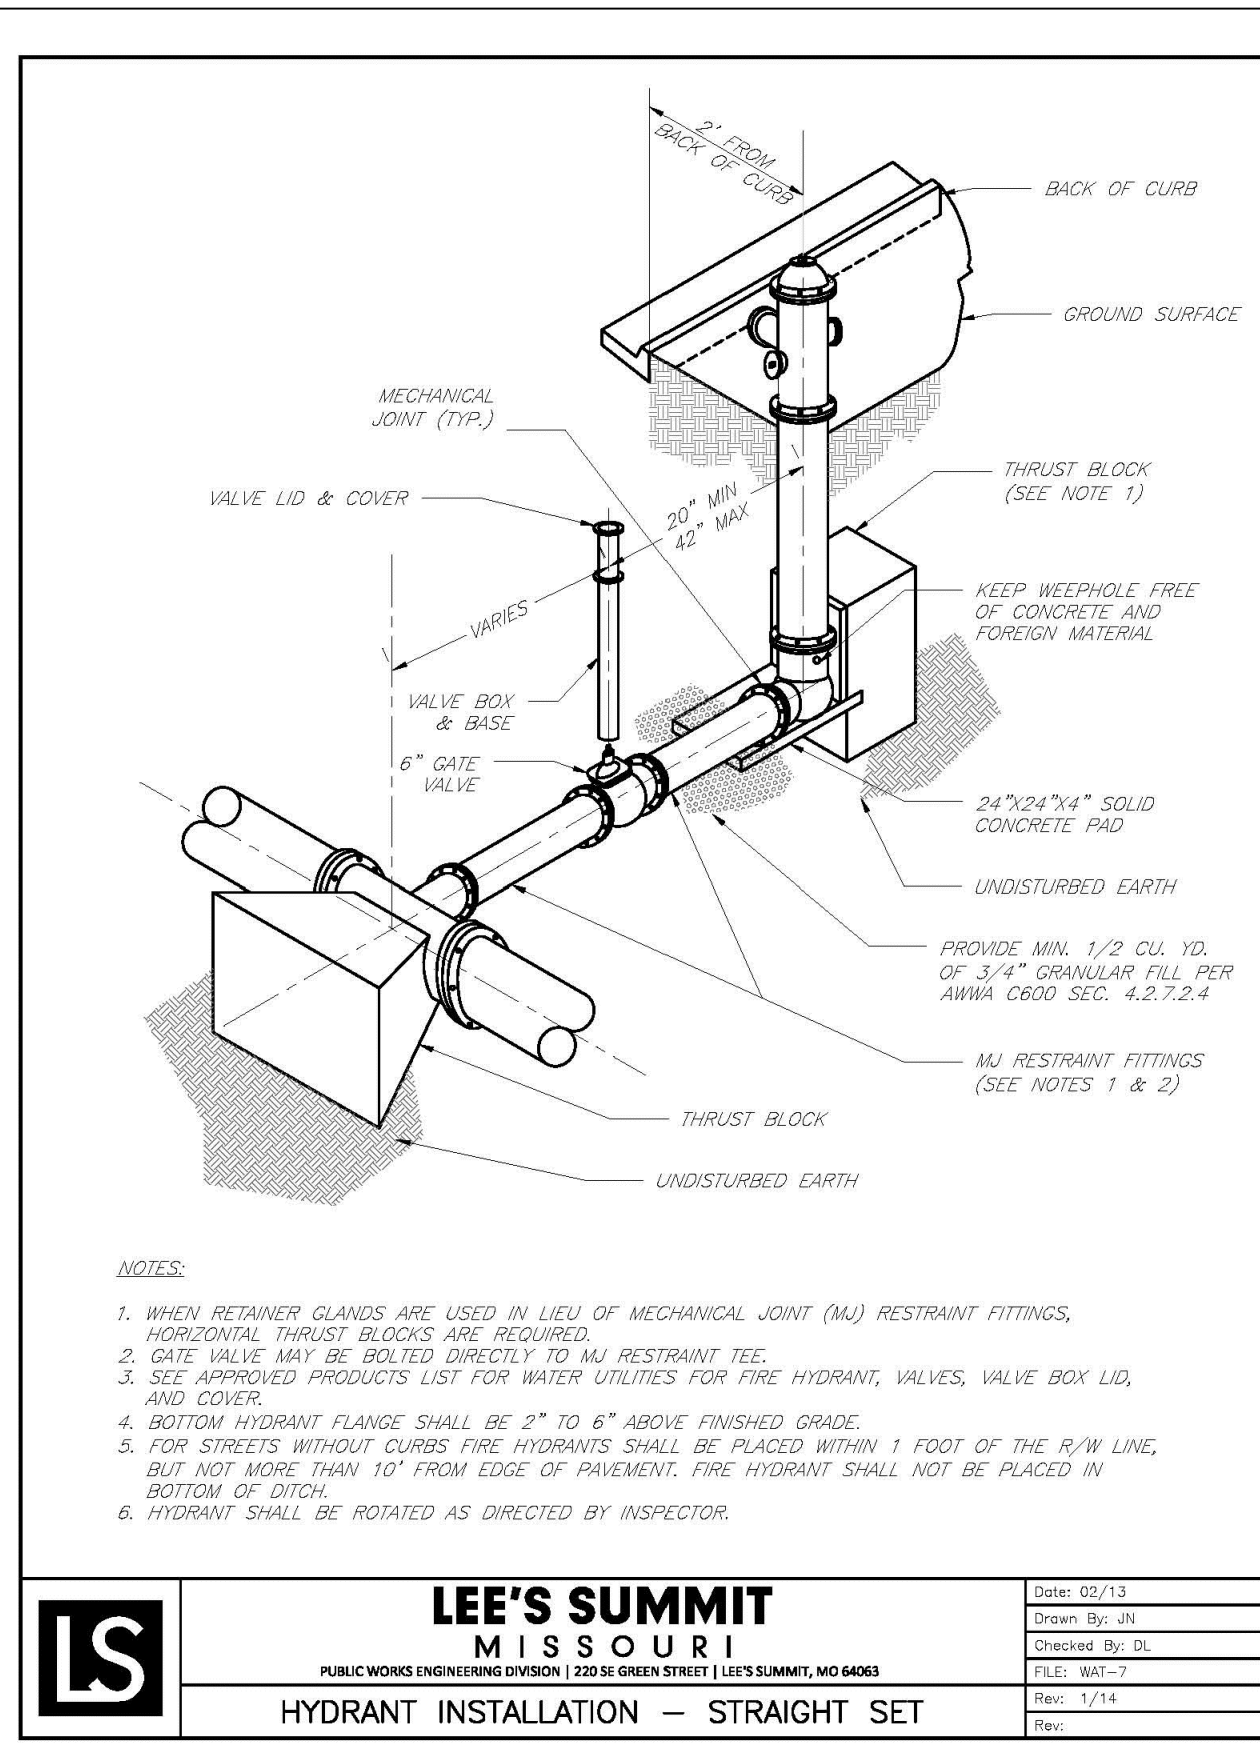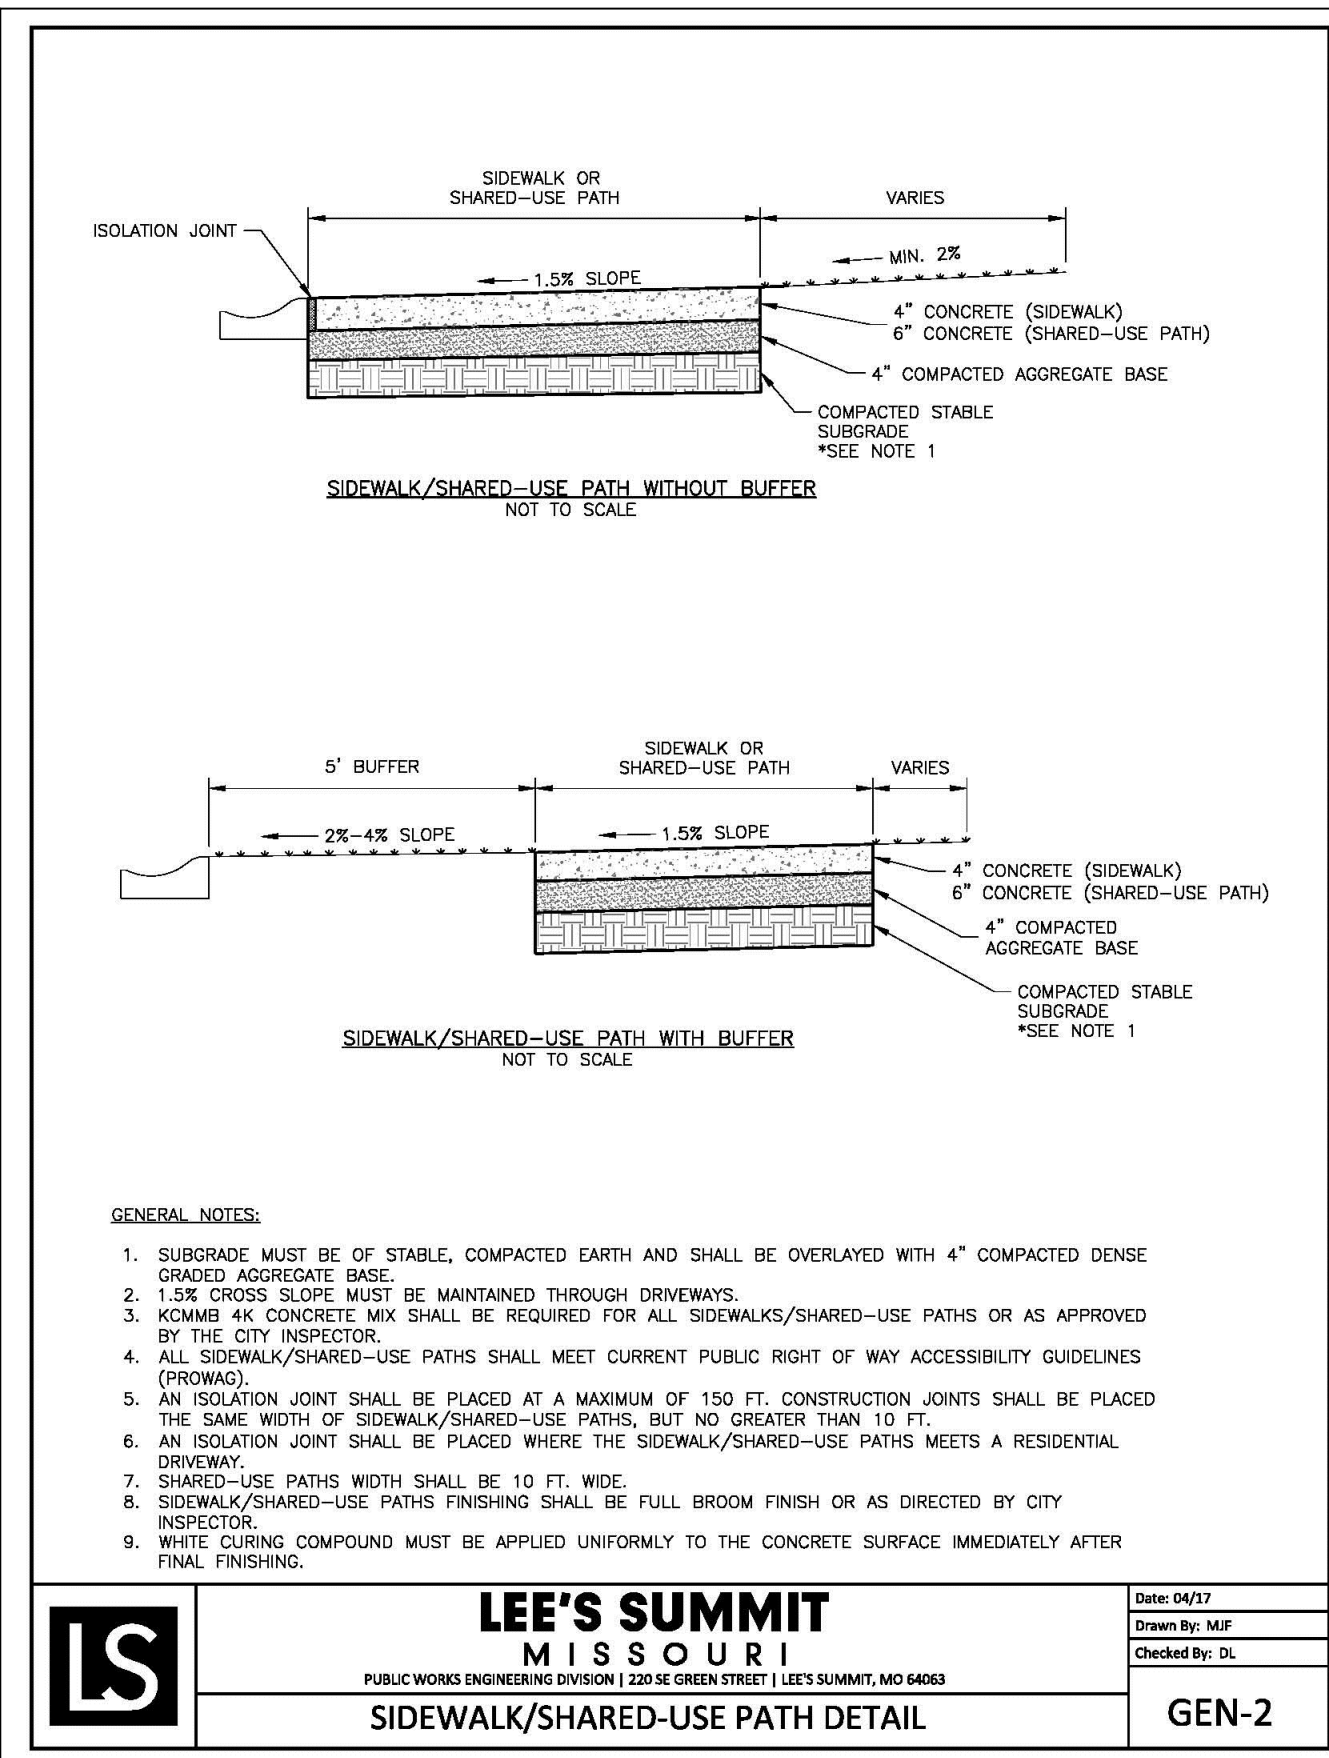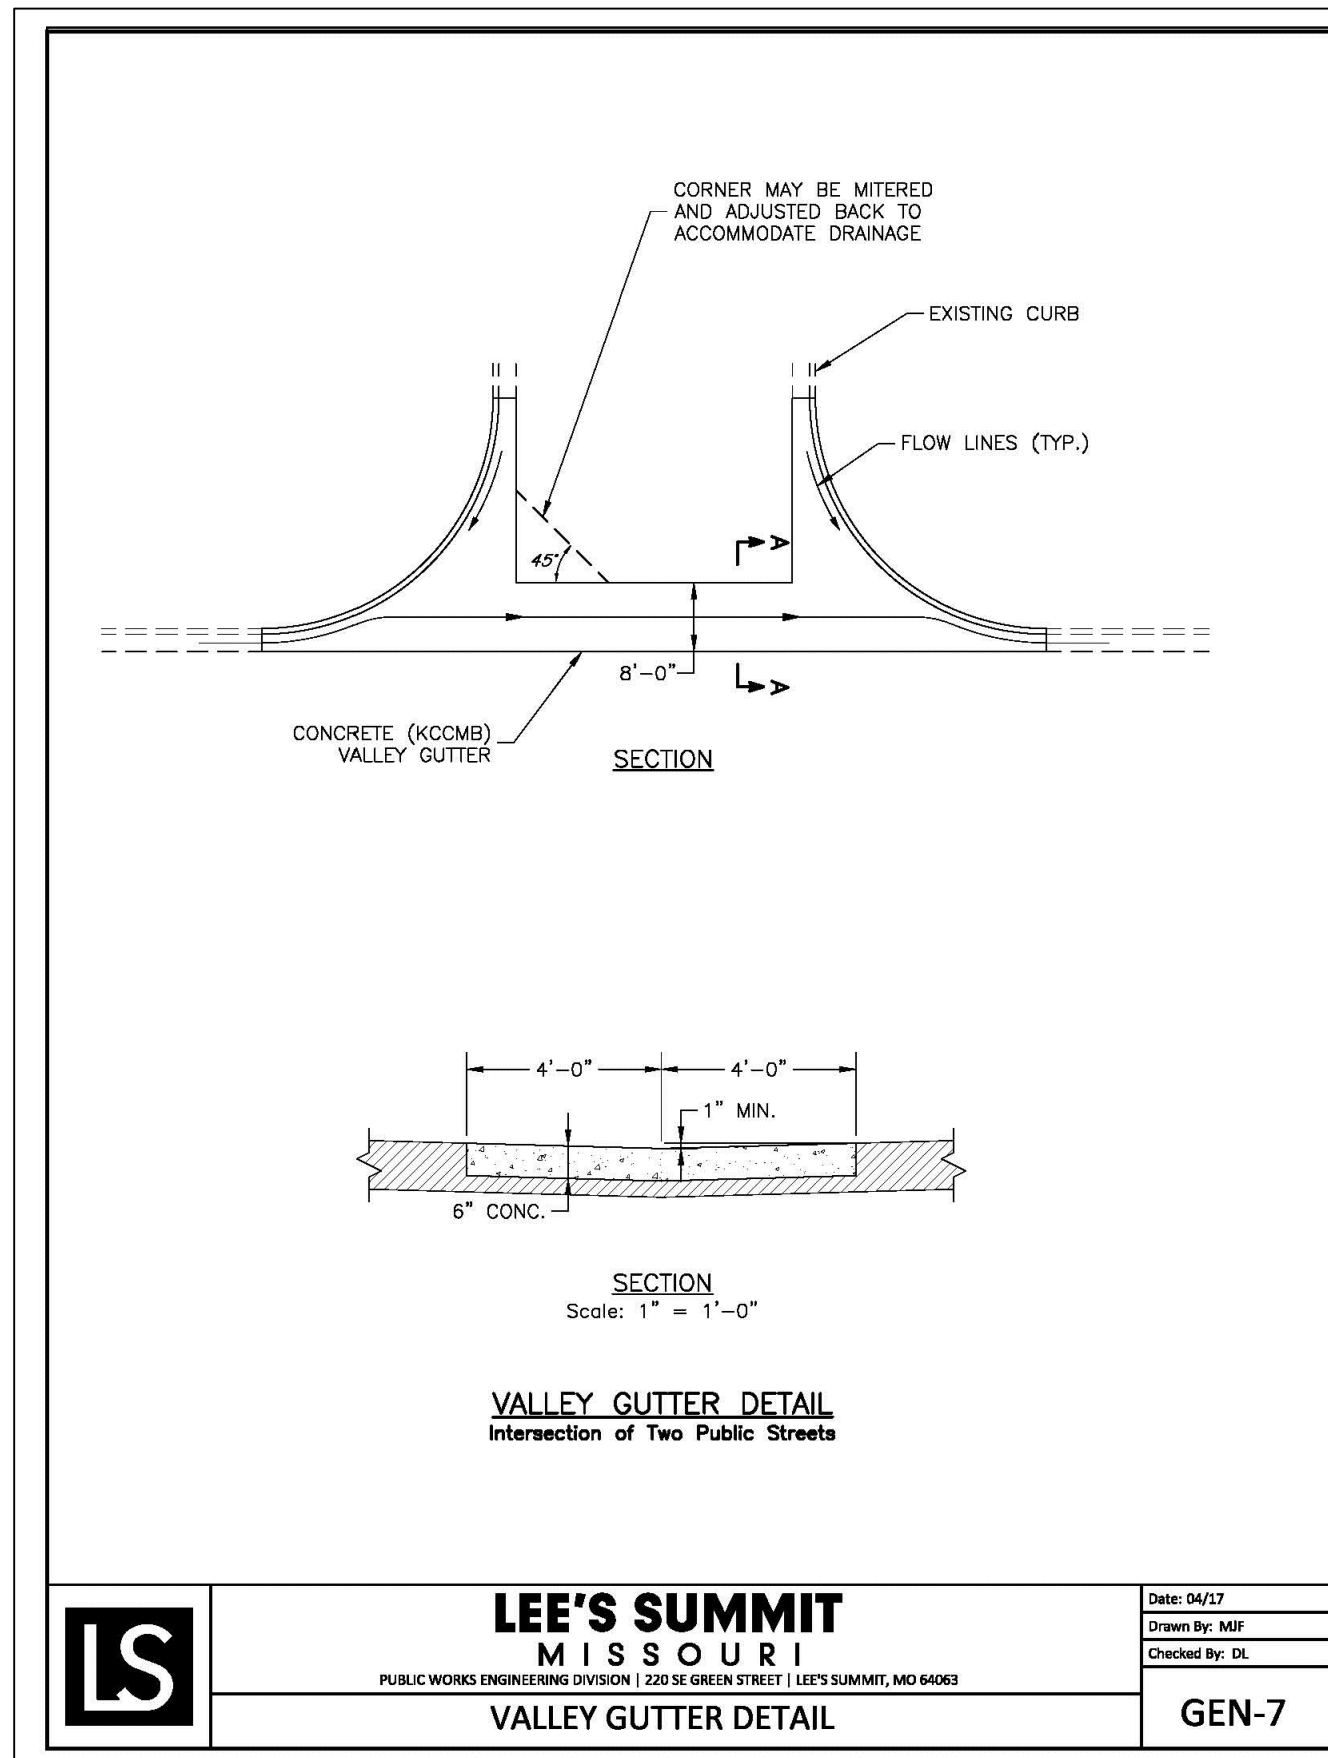


RELEASED FOR CONSTRUCTION
As Noted on Plans Review
Development Services Department
Lee's Summit, Missouri
01/14/2022

Certificate of Authority
Architecture: MO 118 / ES 13
Engineering: MO 4 / ES 241
Land Surveying: MO 123 / ES 34

© 2019 Powell CWM, Inc.
This drawing has been prepared by Powell CWM, Inc. This drawing is provided as an instrument of service by Powell CWM and is intended for use on this project only, pursuant to the Architectural Works Copyright Protection Act of 1990, all drawings, specifications, notes and designs, including the overall form arrangement and composition of spaces and elements appearing herein constitute the original copyrighted work of Powell CWM, Inc. Any reproduction, use or disclosure of information contained herein without prior written consent of Powell CWM, Inc. is strictly prohibited.

Toby L. Williams, PE
PE-2019038948 (MISSOURI #)

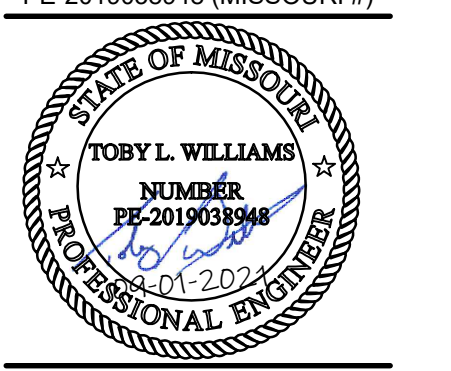

PREPARED FOR:
WARD DEVELOPMENT
DAVID WARD
1120 NW EAGLE RIDGE BLVD.
GRAIN VALLEY, MO 64029
(816) 229-8115

LOT 10, I-470 BUSINESS AND TECHNOLOGY CENTER
2601 NE MCBAIN DRIVE
LEE'S SUMMIT, MO 64064

REVISIONS	NO.	DATE / DESCRIPTION
	1	11/09/2021 - CITY COMMENTS


PROJECT #: 21-1902
ISSUE DATE: 09/01/2021
ISSUED FOR:

GENERAL NOTES

- ALL WORK SHALL COMPLY WITH THE SECTION 2800 OF THE STREET LIGHTING OF KANSAS CITY METROPOLITAN CHAPTER OF THE AMERICAN PUBLIC WORKS ASSOCIATION, CONSTRUCTION & MATERIAL SPECIFICATION, THE SECTION 5800 - STREET LIGHTING OF THE CITY OF LEE'S SUMMIT, MO DESIGN CRITERIA, AND ALL APPLICABLE LEE'S SUMMIT, MO SUPPLEMENTS.
- ALL ELECTRICAL/CONDUIT STREET CROSSINGS NEED TO BE BACKFILLED WITH AB-3 OR FLOWABLE FILL IN ACCORDANCE WITH MUNICIPAL REQUIREMENTS.

Tag	Description	LLF	Luminaire Lumens	Luminaire Watts
S1	DSX1 LED P2 40K T3M MVOLT HS (MH: 30'-0") - PROVIDE WITH PHOTOCELL	0.800	7002	70
S2	DSX1 LED P2 40K RCCO MVOLT (MH: 30'-0") - PROVIDE WITH PHOTOCELL	0.800	5429	70
S3	DSX1 LED P2 40K LCCO MVOLT (MH: 30'-0") - PROVIDE WITH PHOTOCELL	0.800	5429	70
W	WDGE3 LED P2 70CRI R4 40K (MH: 16'-0")	0.800	8779	59.2761


Label	Units	Avg	Max	Min	Max/Min
Parking_Lot	Fc	3.04	9.46	0.50	18.92
Property_Line	Fc	0.16	0.77	0.00	N.A.

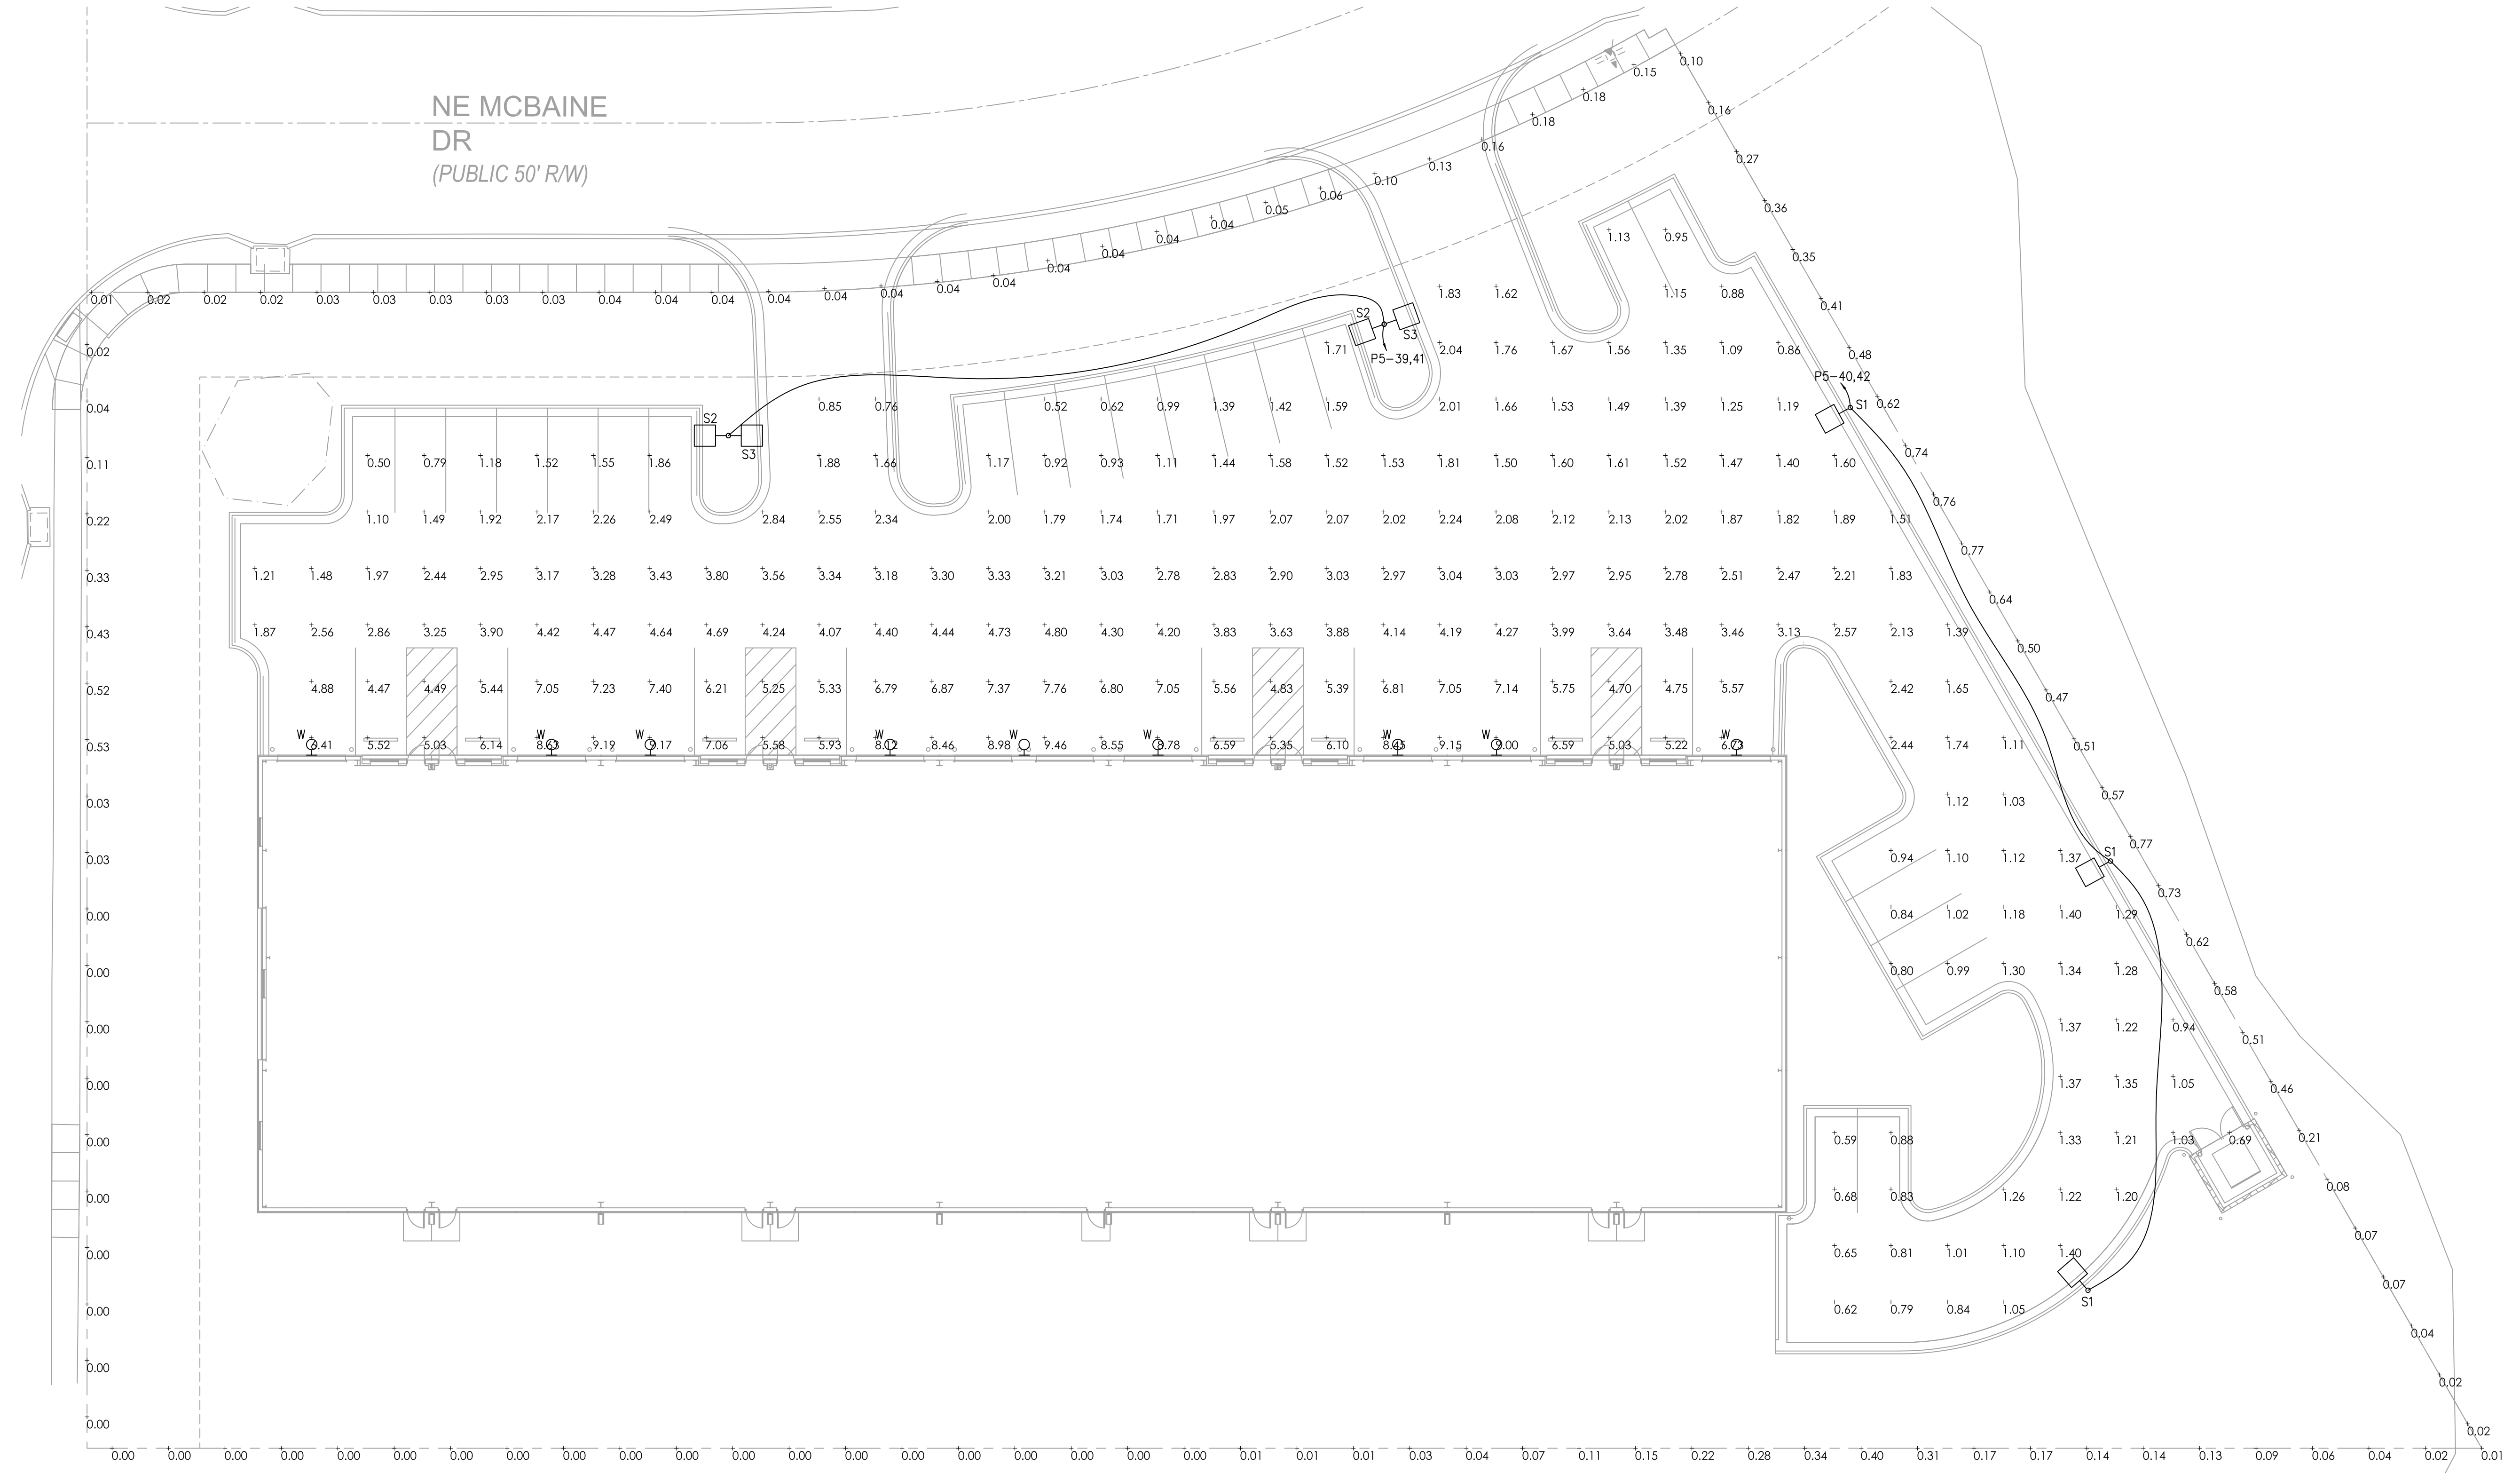

PHOTOMETRIC PLAN

SCALE: 1/16" = 1'-0"

1

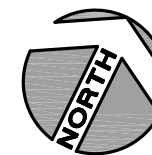

RELEASED FOR CONSTRUCTION
As Noted on Plans Review
Development Services Department
Lee's Summit, Missouri
01/14/2022


ENTIRE SHEET ADDED

Licenses of Authority
Architecture: MO 319 / KS 73
Engineering: MO 4 / KS 241
Land Surveying: MO 123 / KS 36

CLIENT

DAVID WARD
WARD DEVELOPMENT
1120 EAGLE RIDGE BLVD
GRAIN VALLEY, MO 64029
david@seaflyministorage.com

MEP ENGINEER

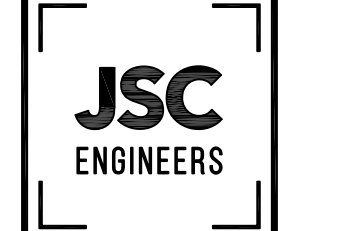

MO CO. NO. 202008781 KS CO. NO. 2418
101 W. BLUE PAVEMENT, SUITE 200, GRAIN VALLEY, MO 64029
JSC ENGINEERS, INC. (A DIVISION OF JSC GROUP, INC.)
PHONE: (816) 225-0285 | EMAIL: jsc@jscengineers.com



09-24-2021

LOT 10 LAKEWOOD BUSINESS PARK
LOT 10 I-470 BUSINESS PARK
LEE'S SUMMIT, MO 64064

REVISIONS	NO.	DATE / DESCRIPTION
	1.	09.24.2021 (PHOTOMETRIC PLAN)


PROJECT #: 21-049
ISSUE DATE: 06/11/2021

ISSUED FOR:
PERMIT


PHOTOMETRIC PLAN

E-002













FIXTURE POLE SPECIFICATION

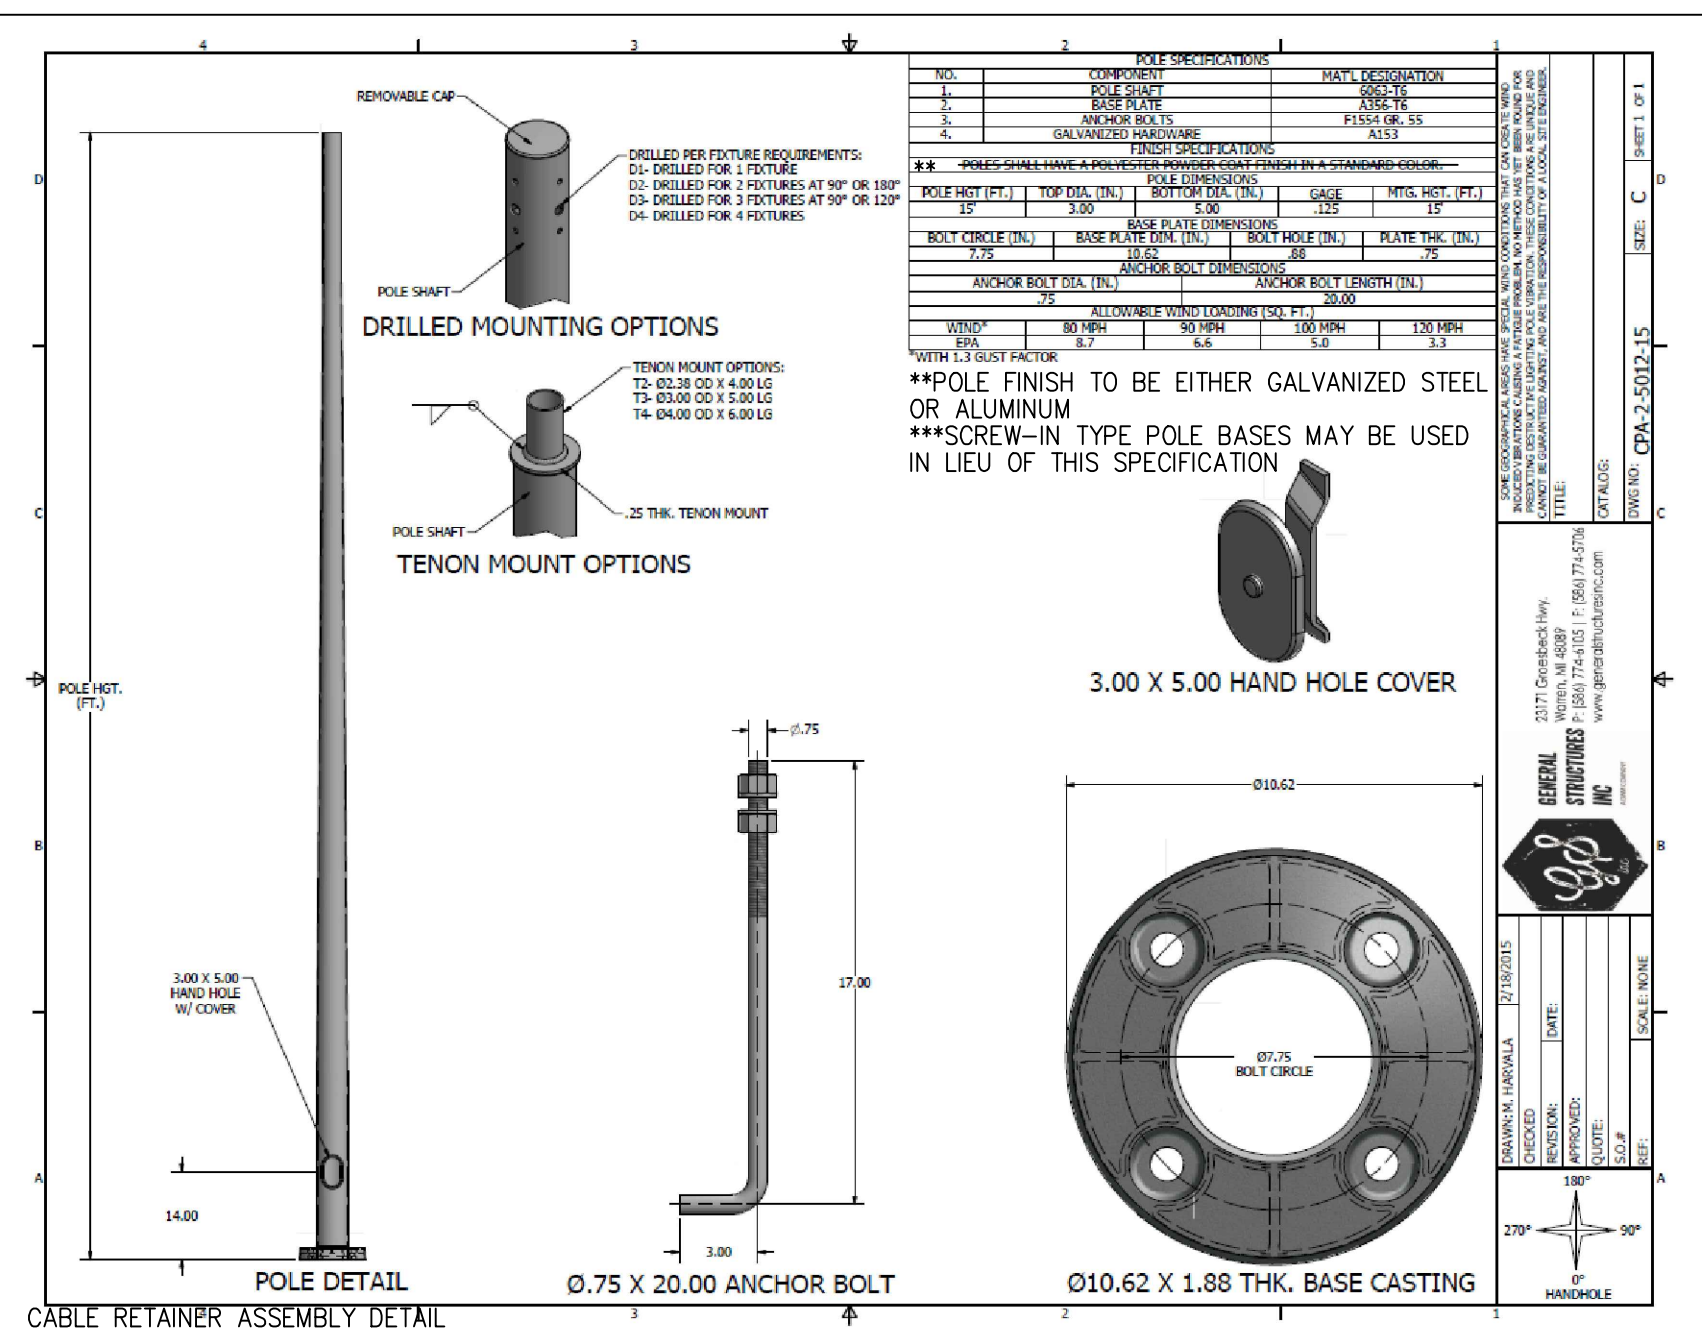

BREAK AWAY FUSE DETAILS

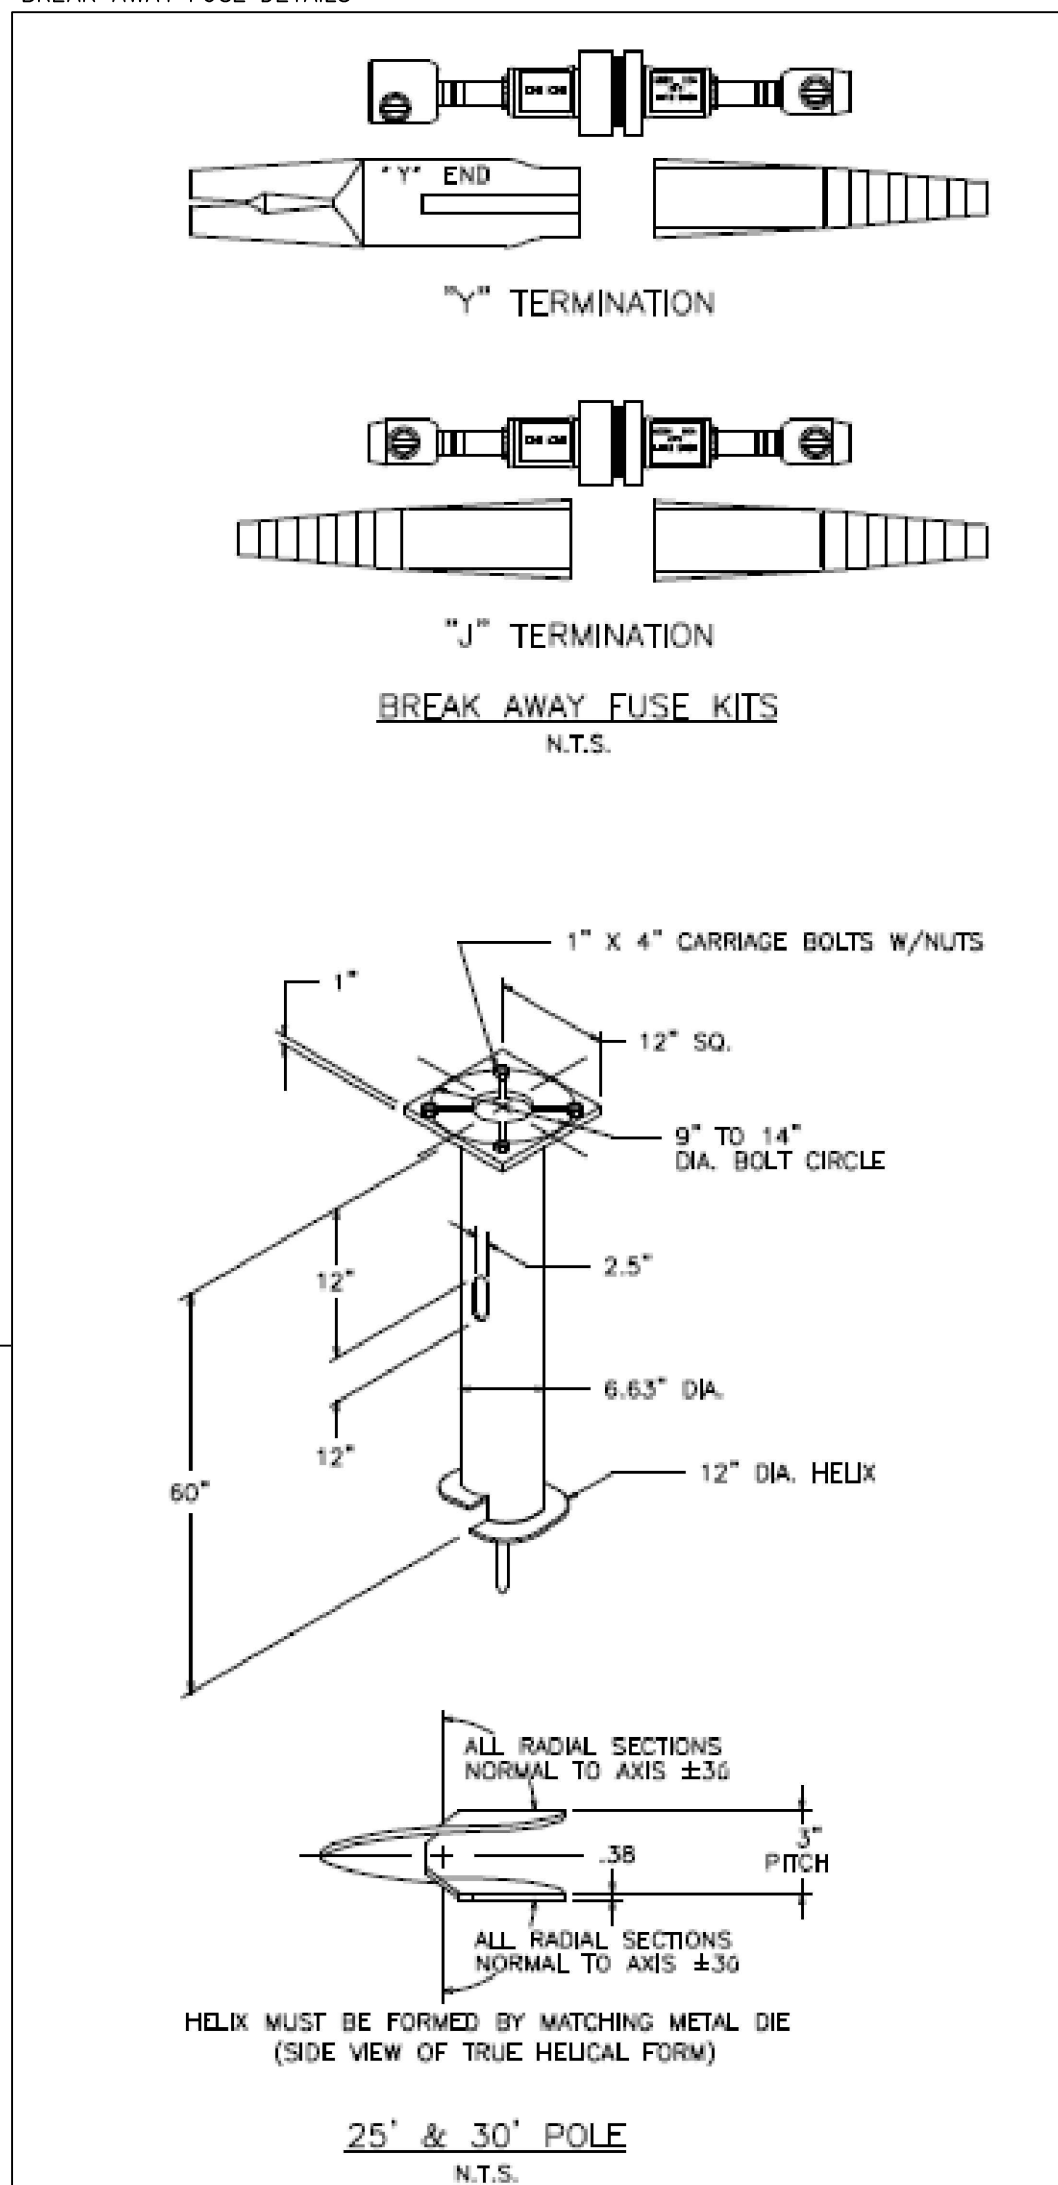

METER PEDESTAL DETAIL - PROVIDE WITH PHOTOCELL LOCATED ON METER PEDESTAL WITH SHIELD AND/OR TIME DELAY FUNCTION.

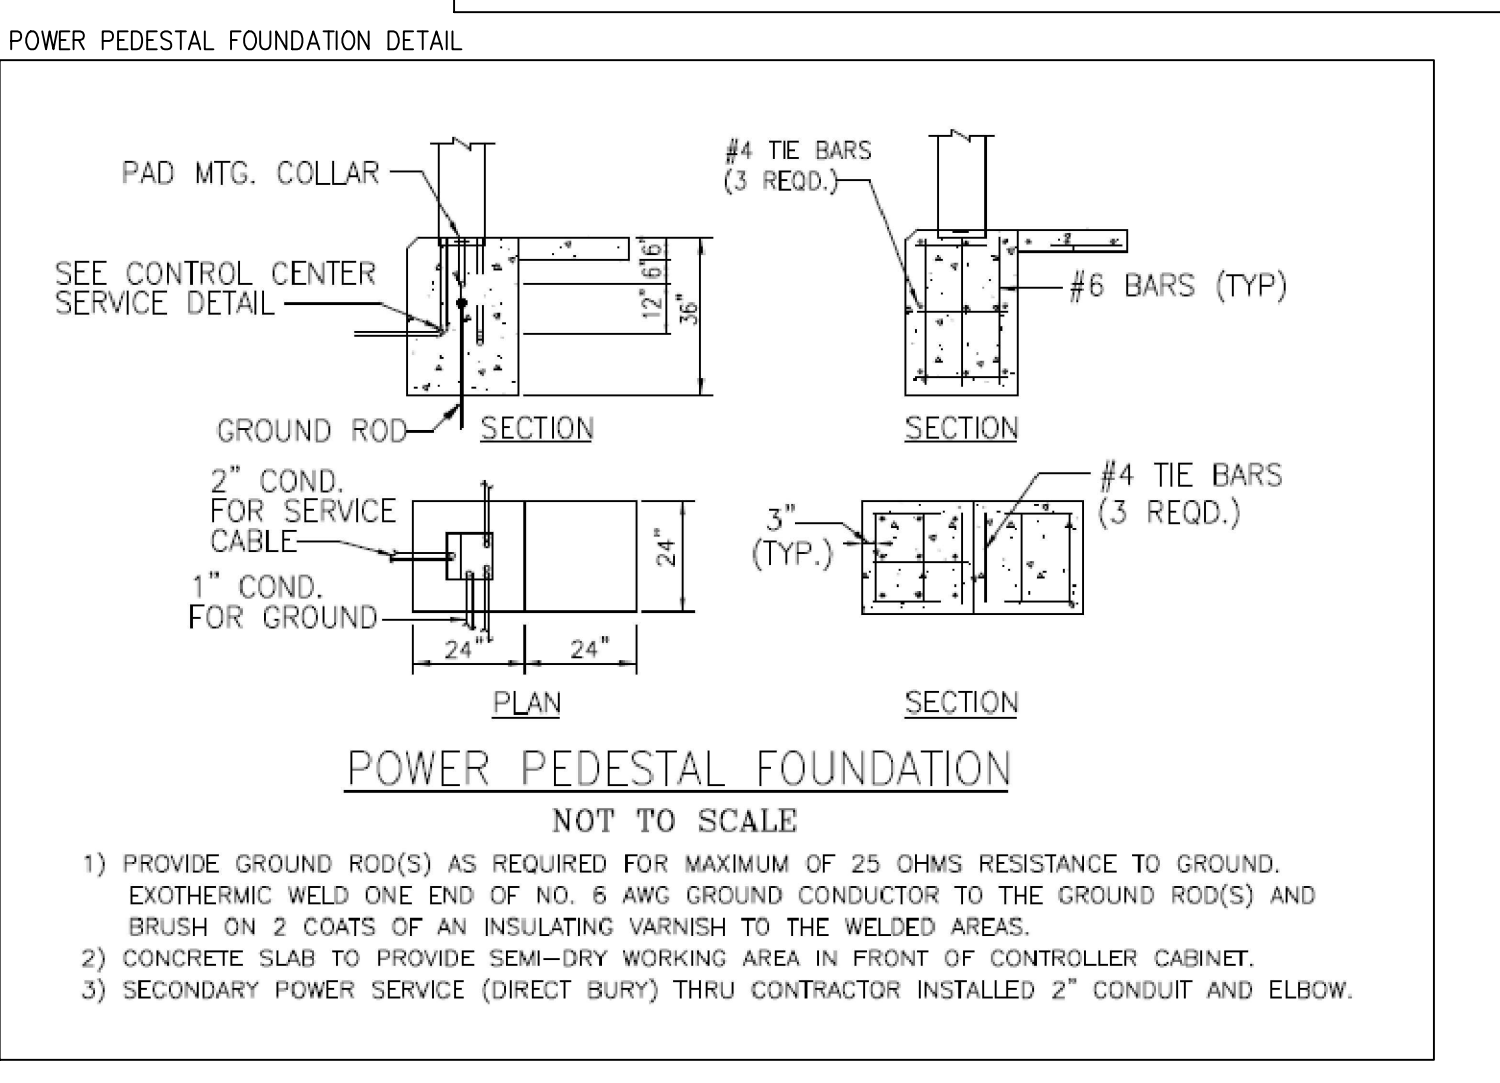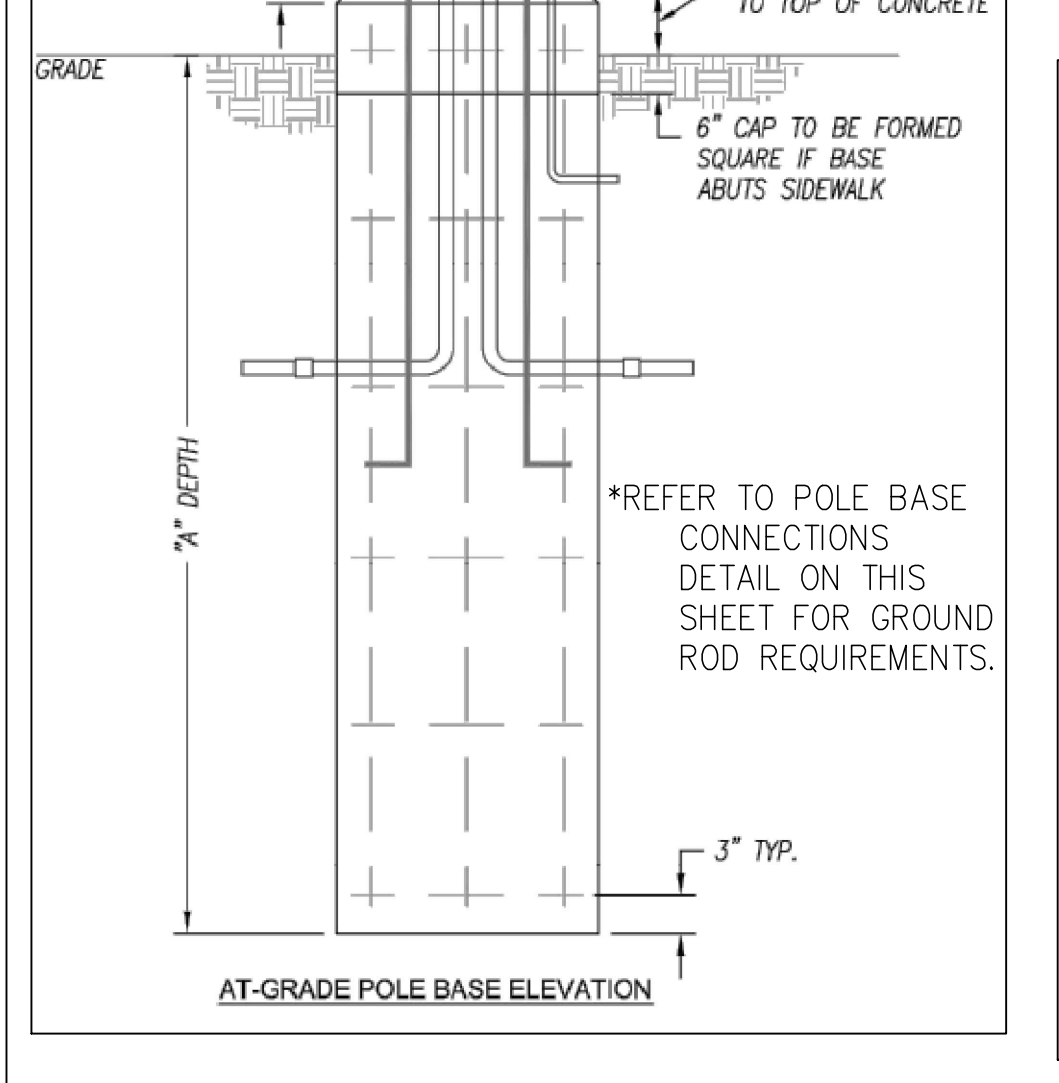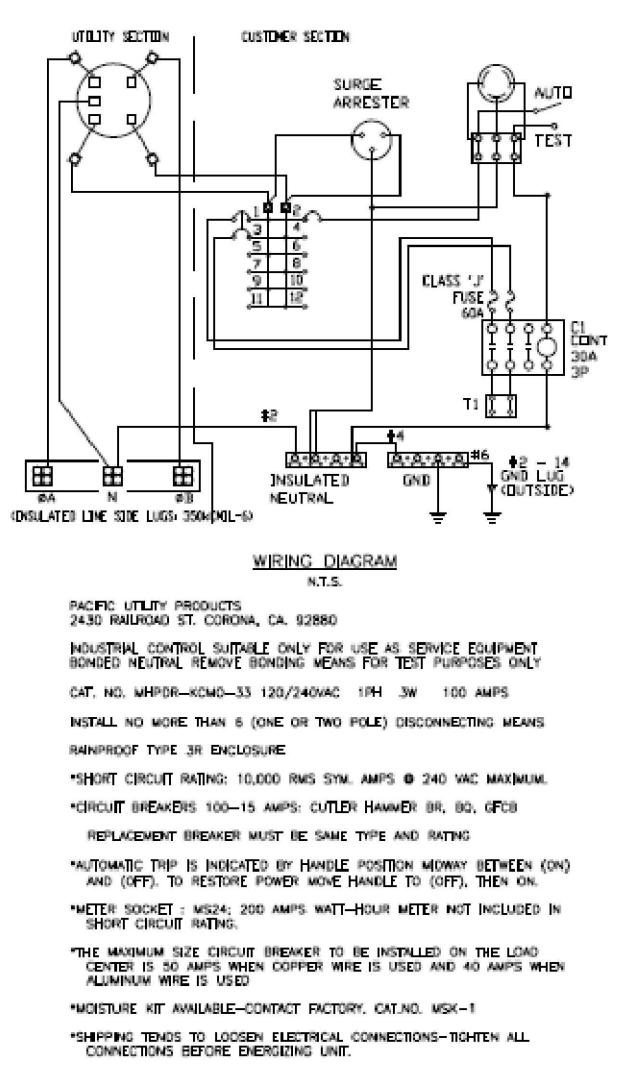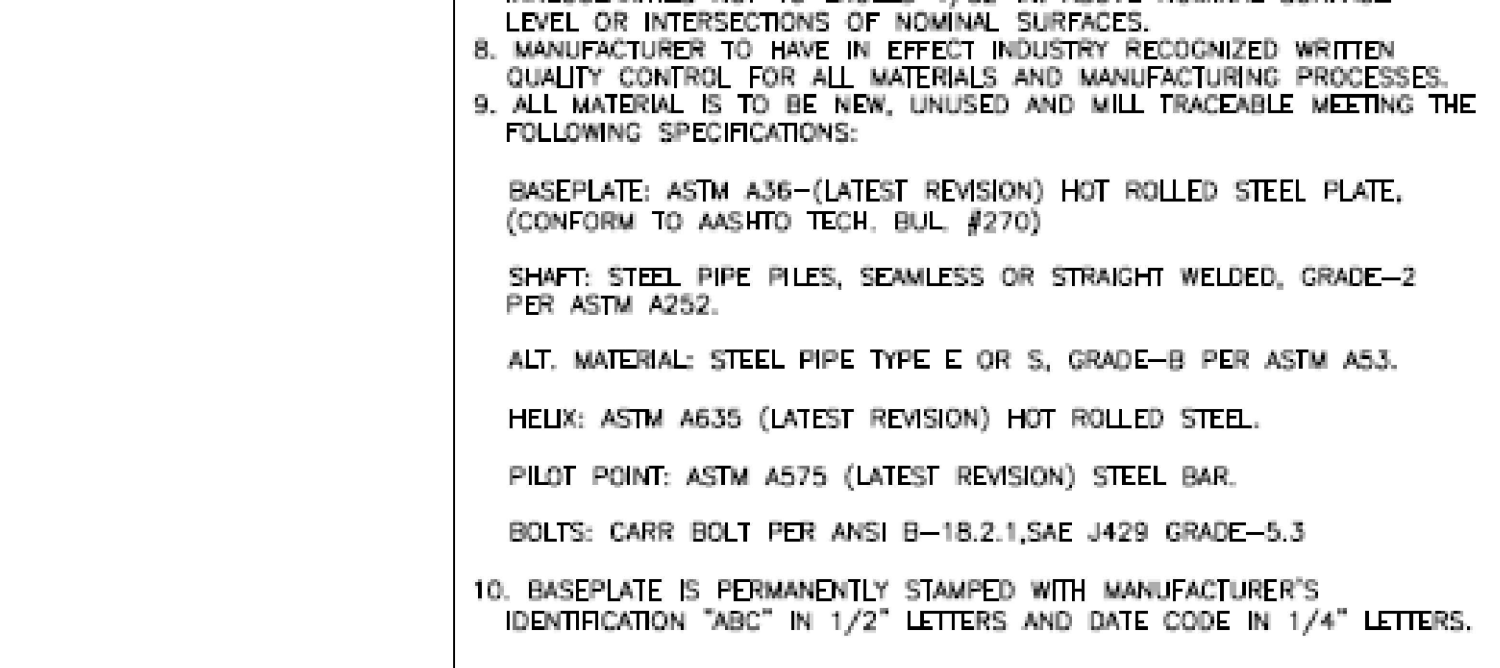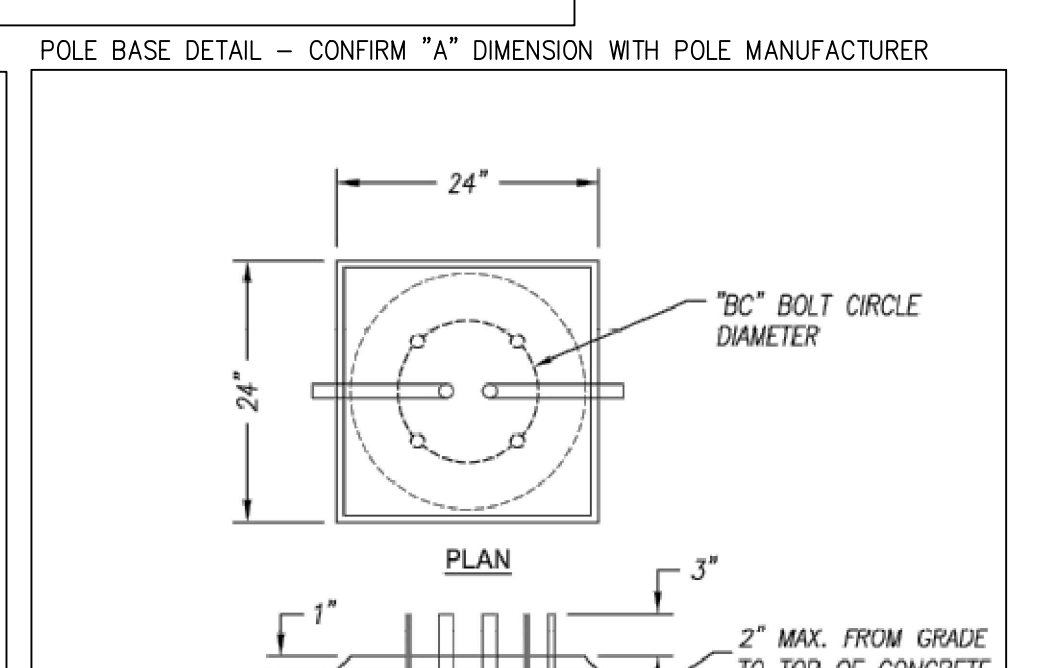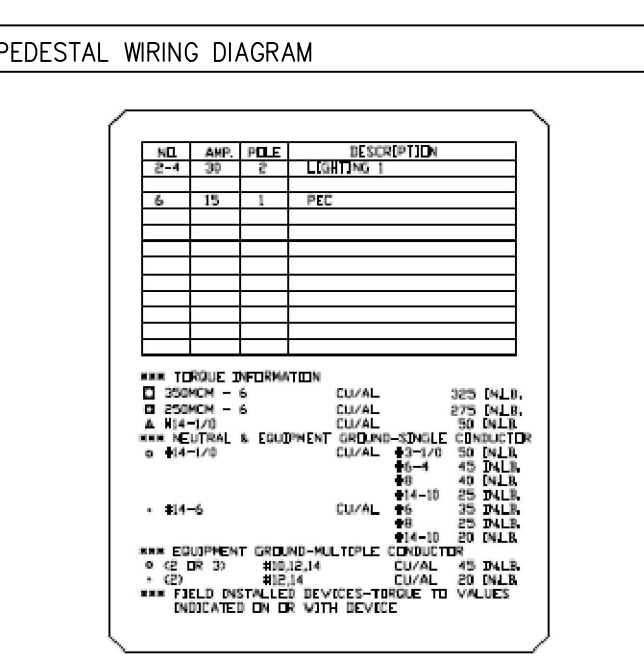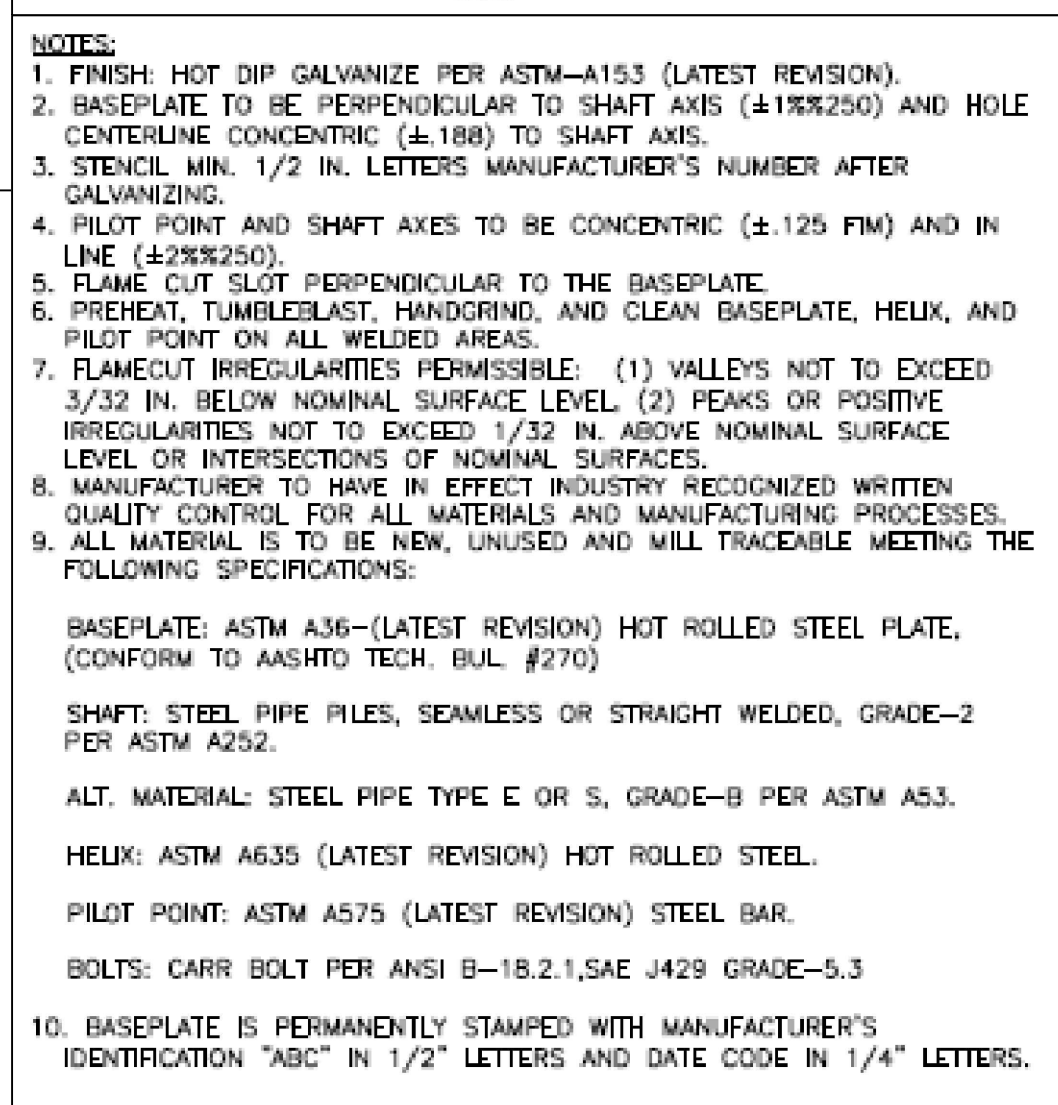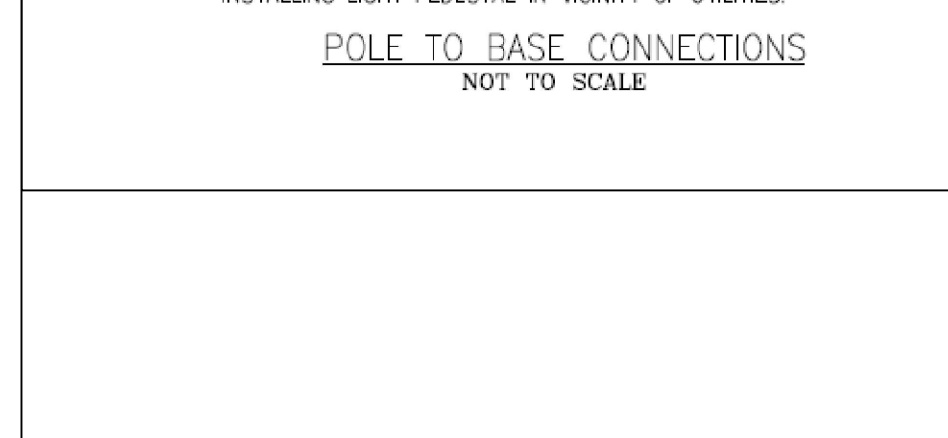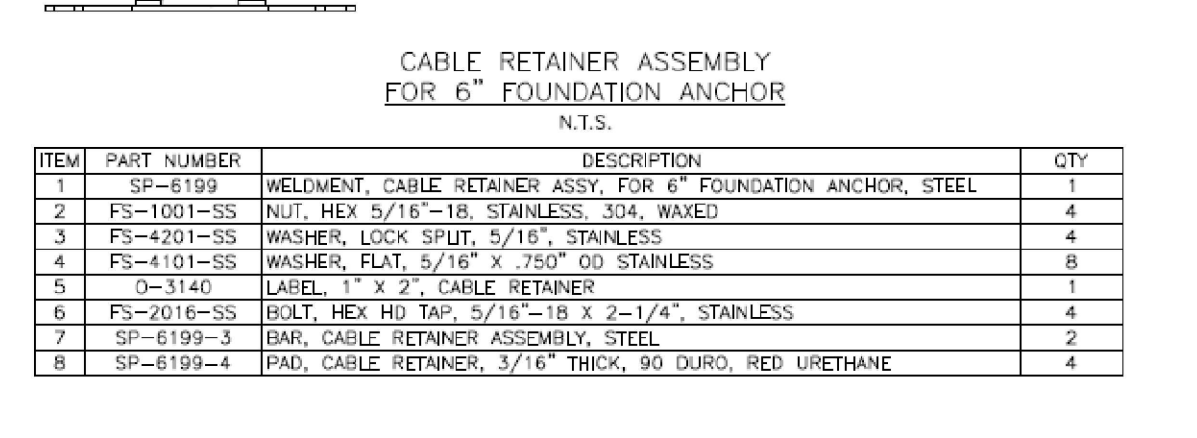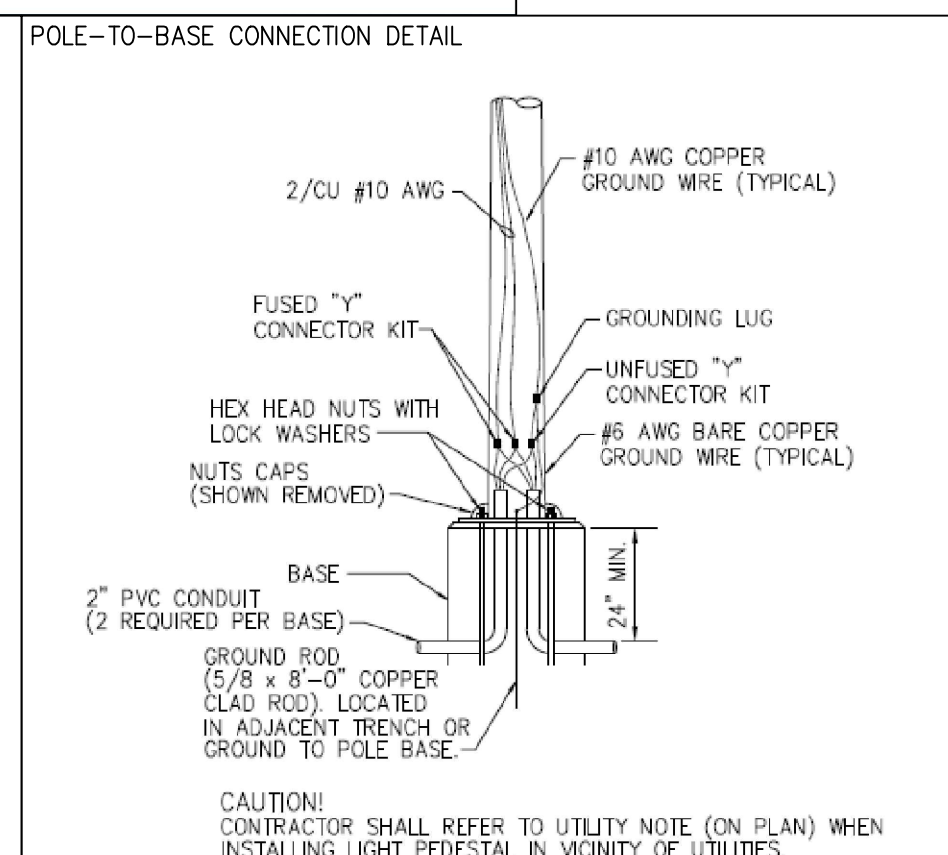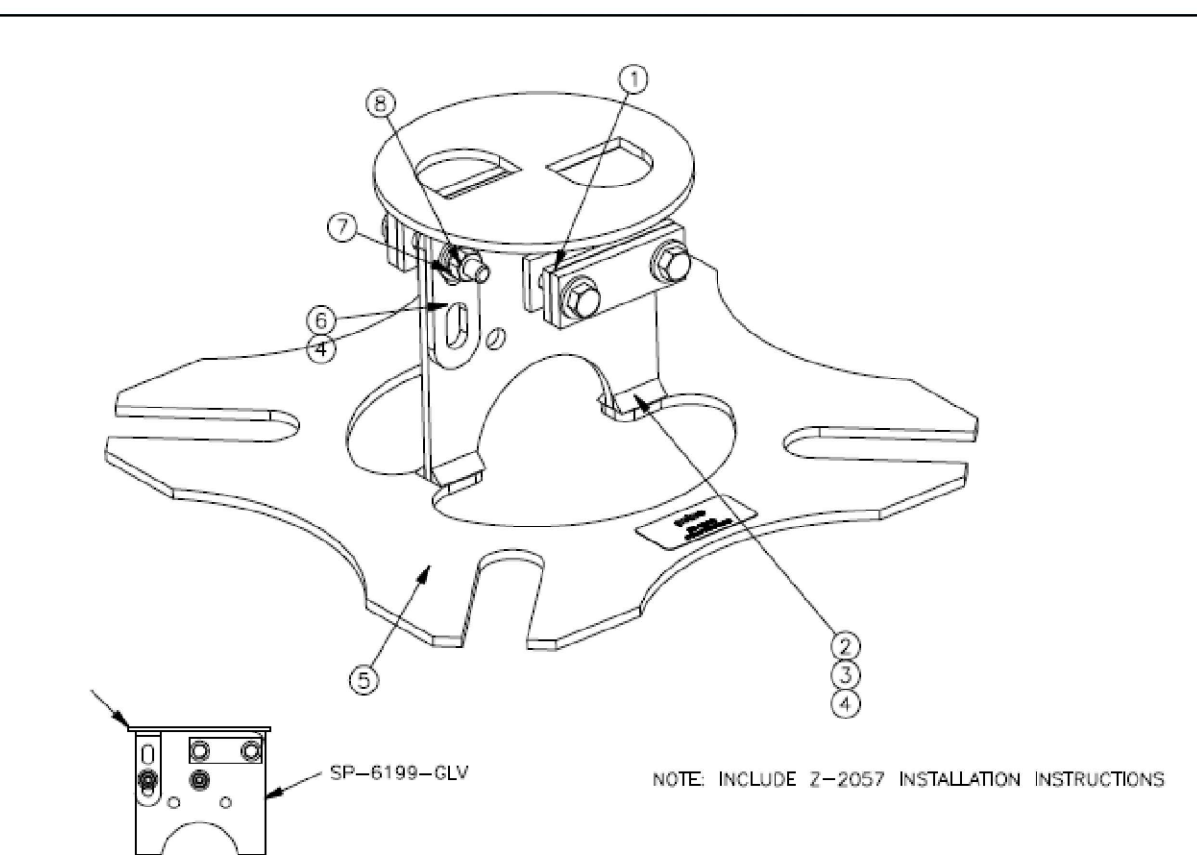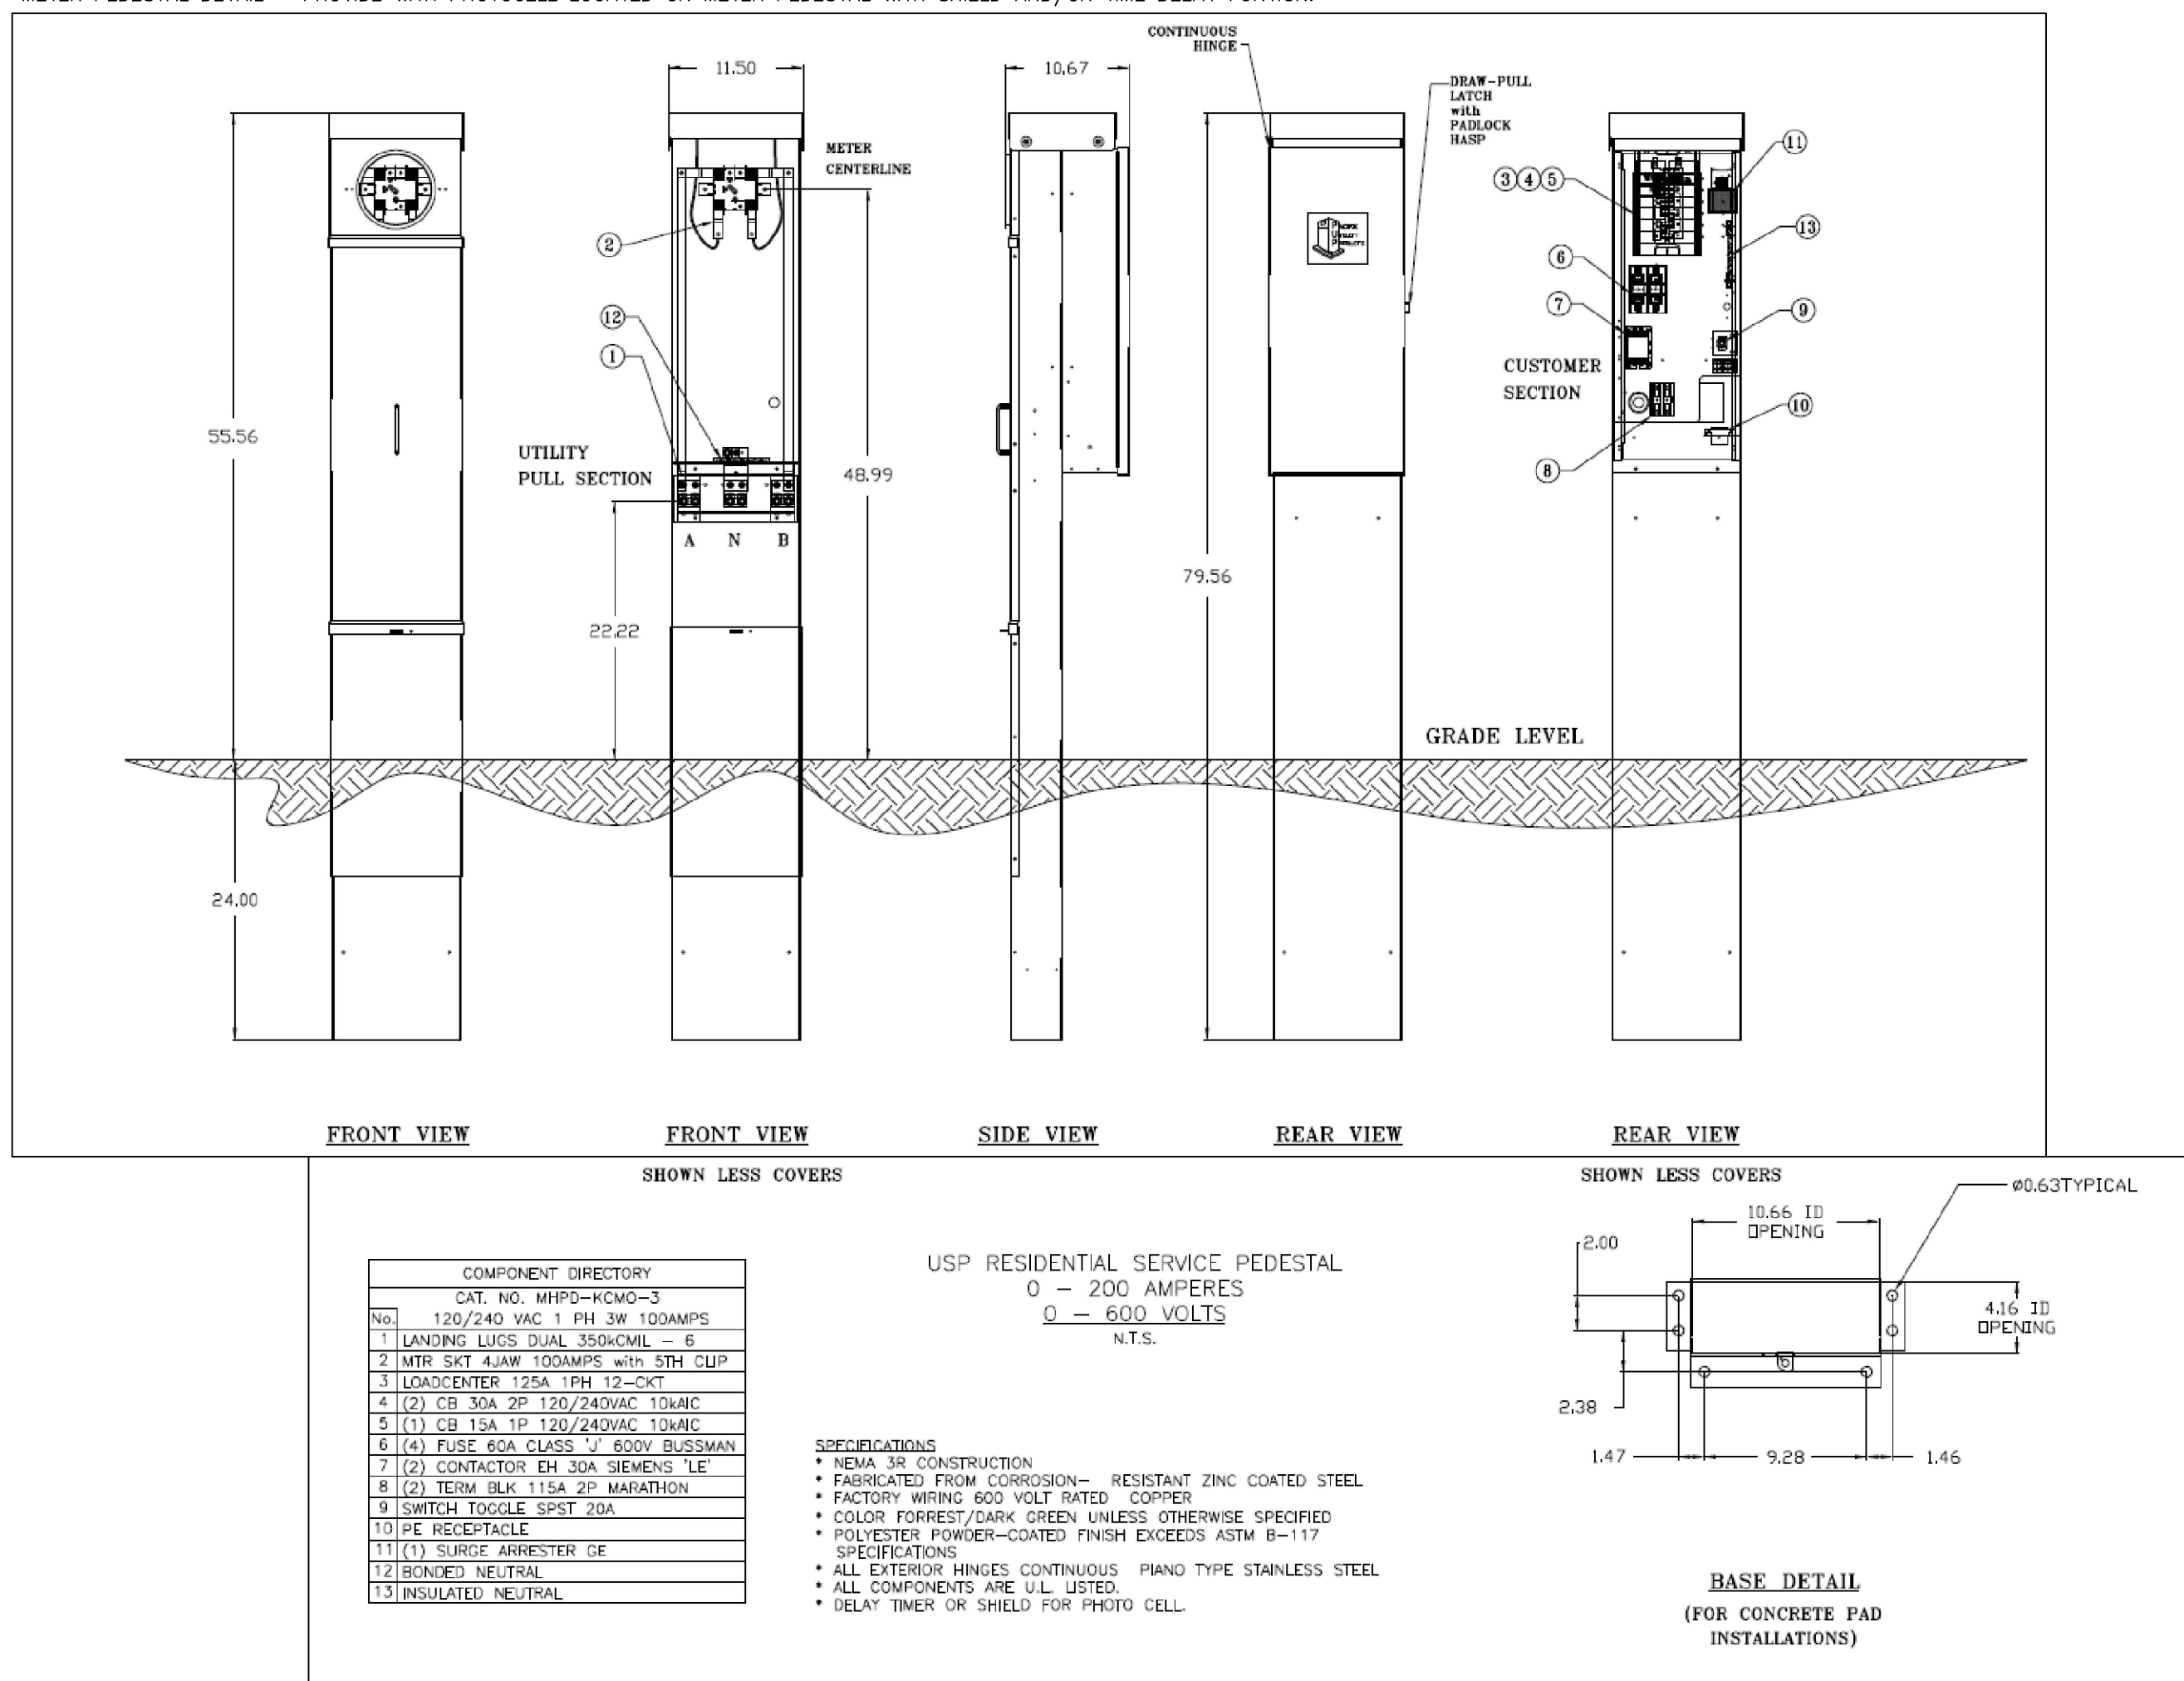

SITE LIGHTING FIXTURE SPECIFICATIONS

FIXTURE "W"

WDGE3 LED
Architectural Wall Sconce

Specifications
Depth (D1): 1.5"
Depth (D2): 9"
Height: 13"
Height H1: 7.12"
Height H2: 3.1/2"
Weight (max): 27 lbs

WDGE LED Family Overview

Luminaire	Standard/LED	Color Temp. (°C)	Finish	F1	F2	F3	F4	F5	F6
WDGE3 LED	4W	—	—	1,500	2,000	—	—	—	—
WDGE2 LED	10W	10W	Standard / night	1,500	2,000	3,000	4,500	6,000	—
WDGE1 LED	15W	15W	Standard / night	1,500	2,000	3,000	4,500	6,000	—
WDGE4 LED	—	—	Standard / night	12,000	16,000	18,000	20,000	22,000	25,000

Ordering Information
EXAMPLE: WDGE3 LED P3 40K 70CRI R3 M3VOLT SRM DBBXD

Series	Package	Color Temperature	CRI	Distribution	Wetproof	Mounting
WDGE3 LED	P1	30K 3000K	70CRI	R2	Type 2	M3VOLT
	P2	40K 4000K	80CRI	R3	Type 3	M3VOLT
	P3	50K 5000K	80CRI	R4	Type 4	M3VOLT
	P4	50K 5000K	80CRI	R5	Forward flow	M3VOLT

Accessories
E1500 Emergency battery backup, Certified in CA
E2000 Emergency battery backup, Certified in CA
E3000 Emergency battery backup, Certified in CA
E4000 Emergency battery backup, Certified in CA
E5000 Emergency battery backup, Certified in CA
E6000 Emergency battery backup, Certified in CA
E7000 Emergency battery backup, Certified in CA
E8000 Emergency battery backup, Certified in CA
E9000 Emergency battery backup, Certified in CA
E10000 Emergency battery backup, Certified in CA

FIXTURES "S1/S2/S3"

FIXTURES "S1/S2/S3"

D-Series Size 1
LED Area Luminaire

Specifications
Depth (D1): 1.015"
Depth (D2): 3.31"
Length: 18.00"
Width: 13"
Height H1: 7.12"
Height H2: 3.1/2"
Weight (max): 27 lbs

Ordering Information
EXAMPLE: DSX1 LED P7 40K T3M VOLT SPA NLTAR2 PIRHN DBBXD

Series	LEDs	Color Temperature	Distribution	Wetproof	Mounting
DSX1 LED	P1	30K 3000K	T5	Type 1 short	M3VOLT
	P2	40K 4000K	T5	Type 1 short	M3VOLT
	P3	50K 5000K	T5	Type 1 short	M3VOLT
	P4	50K 5000K	T5	Type 1 short	M3VOLT
POWELL
ARCHITECTURE/ENGINEERING/SURVEYING
3200 S. State Route 391, Bldg. 1, Independence, MO 64057
816.373.4800 | powell.com

Client
DAVID WARD
WARD DEVELOPMENT
1120 EAGLE RIDGE BLVD
GRAIN VALLEY, MO 64029
david@safetyminstorage.com

MEP ENGINEER
JSC ENGINEERS
AUSTIN R. SMOTHERS
PROFESSIONAL ENGINEER
09-24-2021

LOT 10 LAKEWOOD
BUSINESS PARK
LOT 10 I-470 BUSINESS PARK
LEE'S SUMMIT, MO 64064

REVISIONS
NO. DATE / DESCRIPTION
1. 09-24-2021 (PHOTOMETRIC PLAN)


PROJECT #: 21-049
ISSUE DATE: 06/11/2021
ISSUED FOR: PERMIT

PHOTOMETRIC PLAN
E-003


FIXTURE TYPE	MANUFACTURER		VOLT AMPS	MOUNTING	LAMP TYPE	REMARKS	VOLT
	NAME	SERIES					
A	LITHONIA	EPANL	31	RECESSED/GRID	INCLUDED 4000K LED	LED 2'X4' FLAT PANEL - 4000LM OUTPUT HIGH EFFICIENCY	MVOLT
B	LITHONIA	WF6	14	RECESSED	INCLUDED 2700K LED	WAFER-STYLE 6" LED DOWNLIGHT	MVOLT
C	LITHONIA	CPHB 12LM MVOLT 40K	88	SUSPENDED	INCLUDED 4000K LED	COMPACT HIGH-BAY LED WAREHOUSE FIXTURE - 12000 LUMEN OUTPUT	MVOLT
W	LITHONIA	WDGE3	59	WALL	INCLUDED 4000K LED	EXTERIOR WALL PACK - P2 PACKAGE - PROVIDE WITH 'PE' PHOTOCELL OPTION	MVOLT
ⓔ	LITHONIA	ELM2L-SDRT	5	SURFACE	INCLUDED LED	EMERGENCY EGRESS LIGHTING UNIT WITH 90 MIN. BATTERY PACK	120
ⓔ	LITHONIA	LHQM-LED-R-SD	5	SURFACE	INCLUDED LED	EMERGENCY EXIT EGRESS COMBO LIGHTING UNIT WITH RED FACE EXIT SIGN AND 90 MIN. BATTERY PACK	120
ⓔ	LITHONIA	ELA-B-T-QWP-L0309-SD	5	SURFACE	INCLUDED LED	OUTDOOR EMERGENCY REMOTE EGRESS LIGHTING UNIT	120

CLIENT
DAVID WARD
WARD DEVELOPMENT
1120 EAGLE RIDGE BLVD
GRAIN VALLEY, MO 64029
david@safelyministorage.com

MEP ENGINEER
JSC ENGINEERS

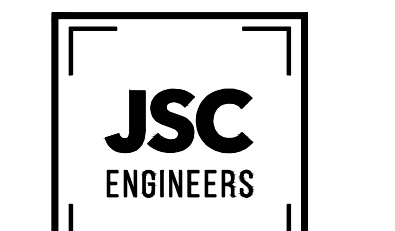

MO: 004-202003091 R3: 004-NO 0-219
961 WASH BLVD PERRYVILLE, MISSOURI 64086
3616 OAKHURST ROAD, INDEPENDENCE, MO
PHONE: 816.251.0281 email: jsc@jsc-engineers.com

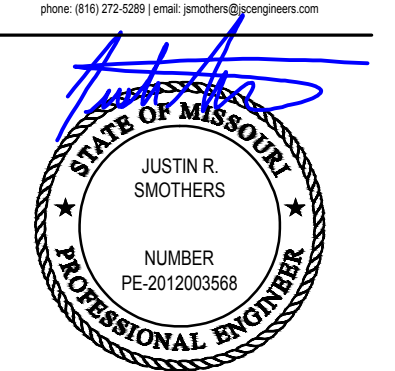

09-24-2021

LOT 10 LAKEWOOD
BUSINESS PARK
LOT 10 I-470 BUSINESS PARK
LEE'S SUMMIT, MO 64064

NO.	DATE / DESCRIPTION
1.	09-24-2021 PHOTO METRIC PLAN

PROJECT #: 21-049
ISSUE DATE: 06/11/2021
ISSUED FOR: PERMIT

ELECTRICAL SCHEDULES AND DIAGRAMS


RELEASED FOR CONSTRUCTION
As Noted on Plans Review
Development Services Department
Lee's Summit, Missouri
01/14/2022

CKT NO.	DESCRIPTION	VOLTAMPS/PHASE			WIRE NO.	BKR AMP	P	WIRE NO.	BKR AMP	VOLTAMPS/PHASE			DESCRIPTION	CKT NO.
		A	B	C						A	B	C		
1	LTG - WAREHOUSE		880		12	20	1	1	20	12	1,000		PWR - GARAGE DOOR 1	2
3	RCPT - WAREHOUSE GEN			720	12	20	1	1	20	12	1,000		PWR - GARAGE DOOR 2	4
5	SPARE					20	1	1	20	12		600	PWR - UH-1	6
7	SPARE					20	1	1	20				SPARE	8
9	SPARE					20	1	1	20				SPARE	10
11	SPARE					20	1	1	20				SPARE	12
13	SPARE					20	1	1	20				SPARE	14
15	SPARE					20	1	1	20				SPARE	16
17	SPARE					20	1	1	20				SPARE	18
19	SPARE					20	1	1	20				SPARE	20
21	PROVISIONAL SPACE						1	1					PROVISIONAL SPACE	22
23	PROVISIONAL SPACE						1	1					PROVISIONAL SPACE	24
25	PROVISIONAL SPACE						1	1					PROVISIONAL SPACE	26
27	PROVISIONAL SPACE						1	1					PROVISIONAL SPACE	28
29	PROVISIONAL SPACE						1	1					PROVISIONAL SPACE	30
31	PROVISIONAL SPACE						1	1					PROVISIONAL SPACE	32
33	PROVISIONAL SPACE						1	1					PROVISIONAL SPACE	34
35	PROVISIONAL SPACE						1	1					PROVISIONAL SPACE	36
37	PROVISIONAL SPACE						1	1					PROVISIONAL SPACE	38
39	LTG - SITE 1		140		10	20	1	1	20	10	105		LTG - SITE 2	40
41							1	1						42
SUBTOTAL		880	880	740						1,000	1,105	705	SUBTOTAL	
TOTAL PHASE A - VA	LOAD	CONN. VA	DF	LOAD	CONN. VA	DF								
1,880	COOLING	0	0	REFRIG	1.00	1.00								
AMP 16	HEATING	600	1.00	SIGN/DISP	1.25	1.25								
1,965	LIGHTING	1,370	1.25	KITCHEN	1.00	1.00								
AMP 16	RECEPTACLES	720	1.0/5	EXISTING	1.00	1.00								
845	MOTORS	2,000	1.00	LRG MOTOR	1.25	1.25								
AMP 7	SUPP HEAT	1.00	1.00	SHOW WNDW	1.25	1.25								
4,690	MSC EQUIP	1.00	1.00	LTG TRACK	1.00	1.00								
AMP 13														

CKT NO.	DESCRIPTION	VOLTAMPS/PHASE			WIRE NO.	BKR AMP	P	WIRE NO.	BKR AMP	VOLTAMPS/PHASE			DESCRIPTION	CKT NO.
		A	B	C						A	B	C		
1	LTG - WAREHOUSE		851		12	20	1	1	20	12	1,000		PWR - GARAGE DOOR	2
3	LTG - OFFICE/RR			76	12	20	1	1	30	10	1,987		PWR - CU-1	4
5	RCPT - OFFICE QUAD			360	12	20	1	1				1,987		6
7	RCPT - OFFICE GEN		540		12	20	1	1	20	12	600		PWR - UH-1	8
9	RCPT - RR GFI		180		12	20	1	1	20	12	1,650		PWR - WH	10
11	RCPT - WAREHOUSE GEN			720	12	20	1	1	15	12	600		PWR - F-1	12
13	SPARE					20	1	1	30	10	1,500		PWR - EW-1 (PNLBD 1 ONLY)	14
15	SPARE					20	1	1			1,500		SPARE	16
17	SPARE					20	1	1	20				SPARE	18
19	SPARE					20	1	1	20				SPARE	20
21	PROVISIONAL SPACE						1	1					PROVISIONAL SPACE	22
23	PROVISIONAL SPACE						1	1					PROVISIONAL SPACE	24
25	PROVISIONAL SPACE						1	1					PROVISIONAL SPACE	26
27	PROVISIONAL SPACE						1	1					PROVISIONAL SPACE	28
29	PROVISIONAL SPACE						1	1					PROVISIONAL SPACE	30
31	PROVISIONAL SPACE						1	1					PROVISIONAL SPACE	32
33	PROVISIONAL SPACE						1	1					PROVISIONAL SPACE	34
35	PROVISIONAL SPACE						1	1					PROVISIONAL SPACE	36
37	PROVISIONAL SPACE						1	1					PROVISIONAL SPACE	38
39	PROVISIONAL SPACE						1	1					PROVISIONAL SPACE	40
41	PROVISIONAL SPACE						1	1					PROVISIONAL SPACE	42
SUBTOTAL		1,391	256	1,080						3,100	5,137	2,911	SUBTOTAL	
TOTAL PHASE A - VA	LOAD	CONN. VA	DF	LOAD	CONN. VA	DF								
4,491	COOLING	2,772	0	REFRIG	1.00	1.00								
AMP 37	HEATING	5,250	1.00	SIGN/DISP	1.25	1.25								
5,393	LIGHTING	927	1.25	KITCHEN	1.00	1.00								
AMP 45	RECEPTACLES	1,800	1.0/5	EXISTING	1.00	1.00								
3,991	MOTORS	1,924	1.00	LRG MOTOR	1.25	1.25								
AMP 33	SUPP HEAT	1.00	1.00	SHOW WNDW	1.25	1.25								
13,875	MSC EQUIP	1,202	1.00	LTG TRACK	1.00	1.00								
AMP 39														


ELECTRICAL PANEL SCHEDULES

SCALE : NO SCALE

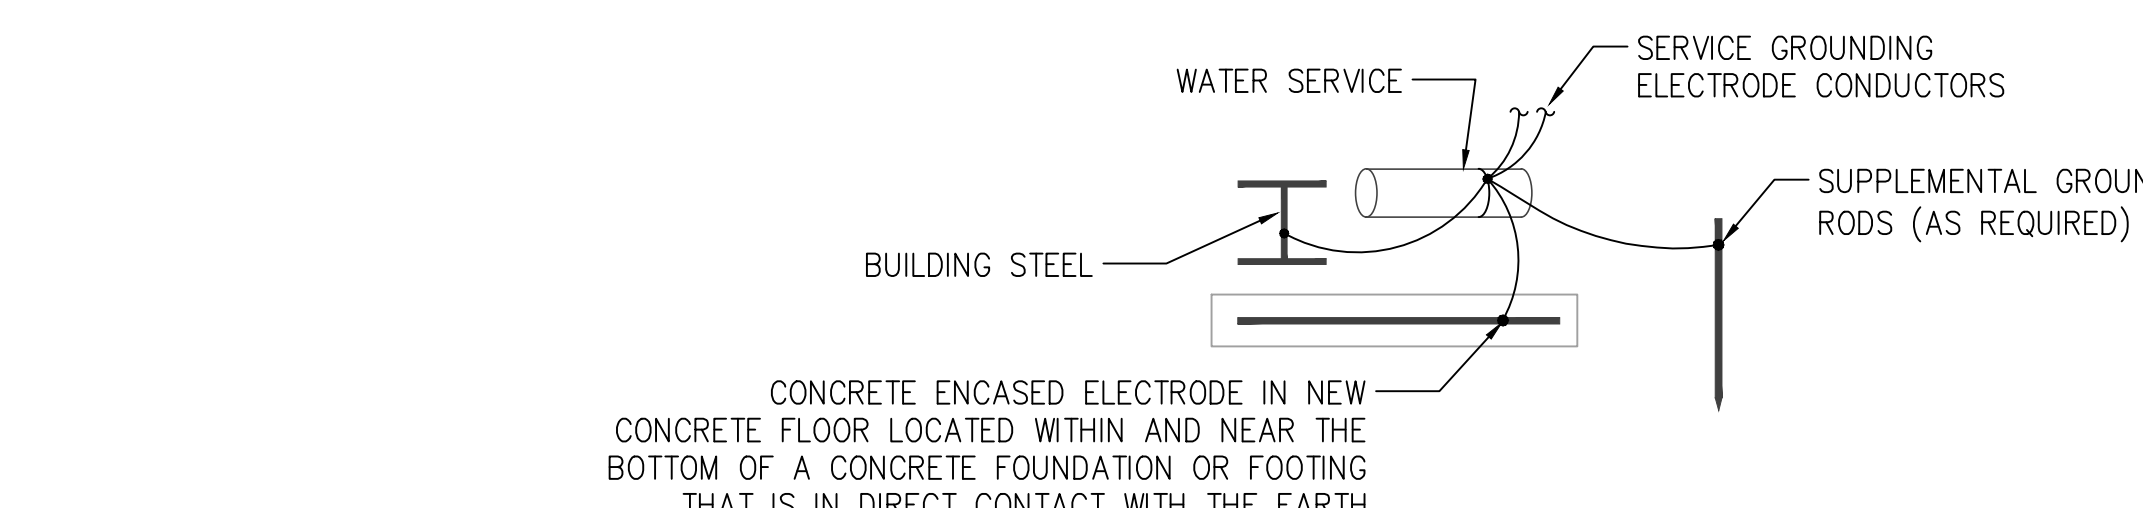

GROUNDING ELECTRODE SYSTEM DIAGRAM

SCALE : NO SCALE

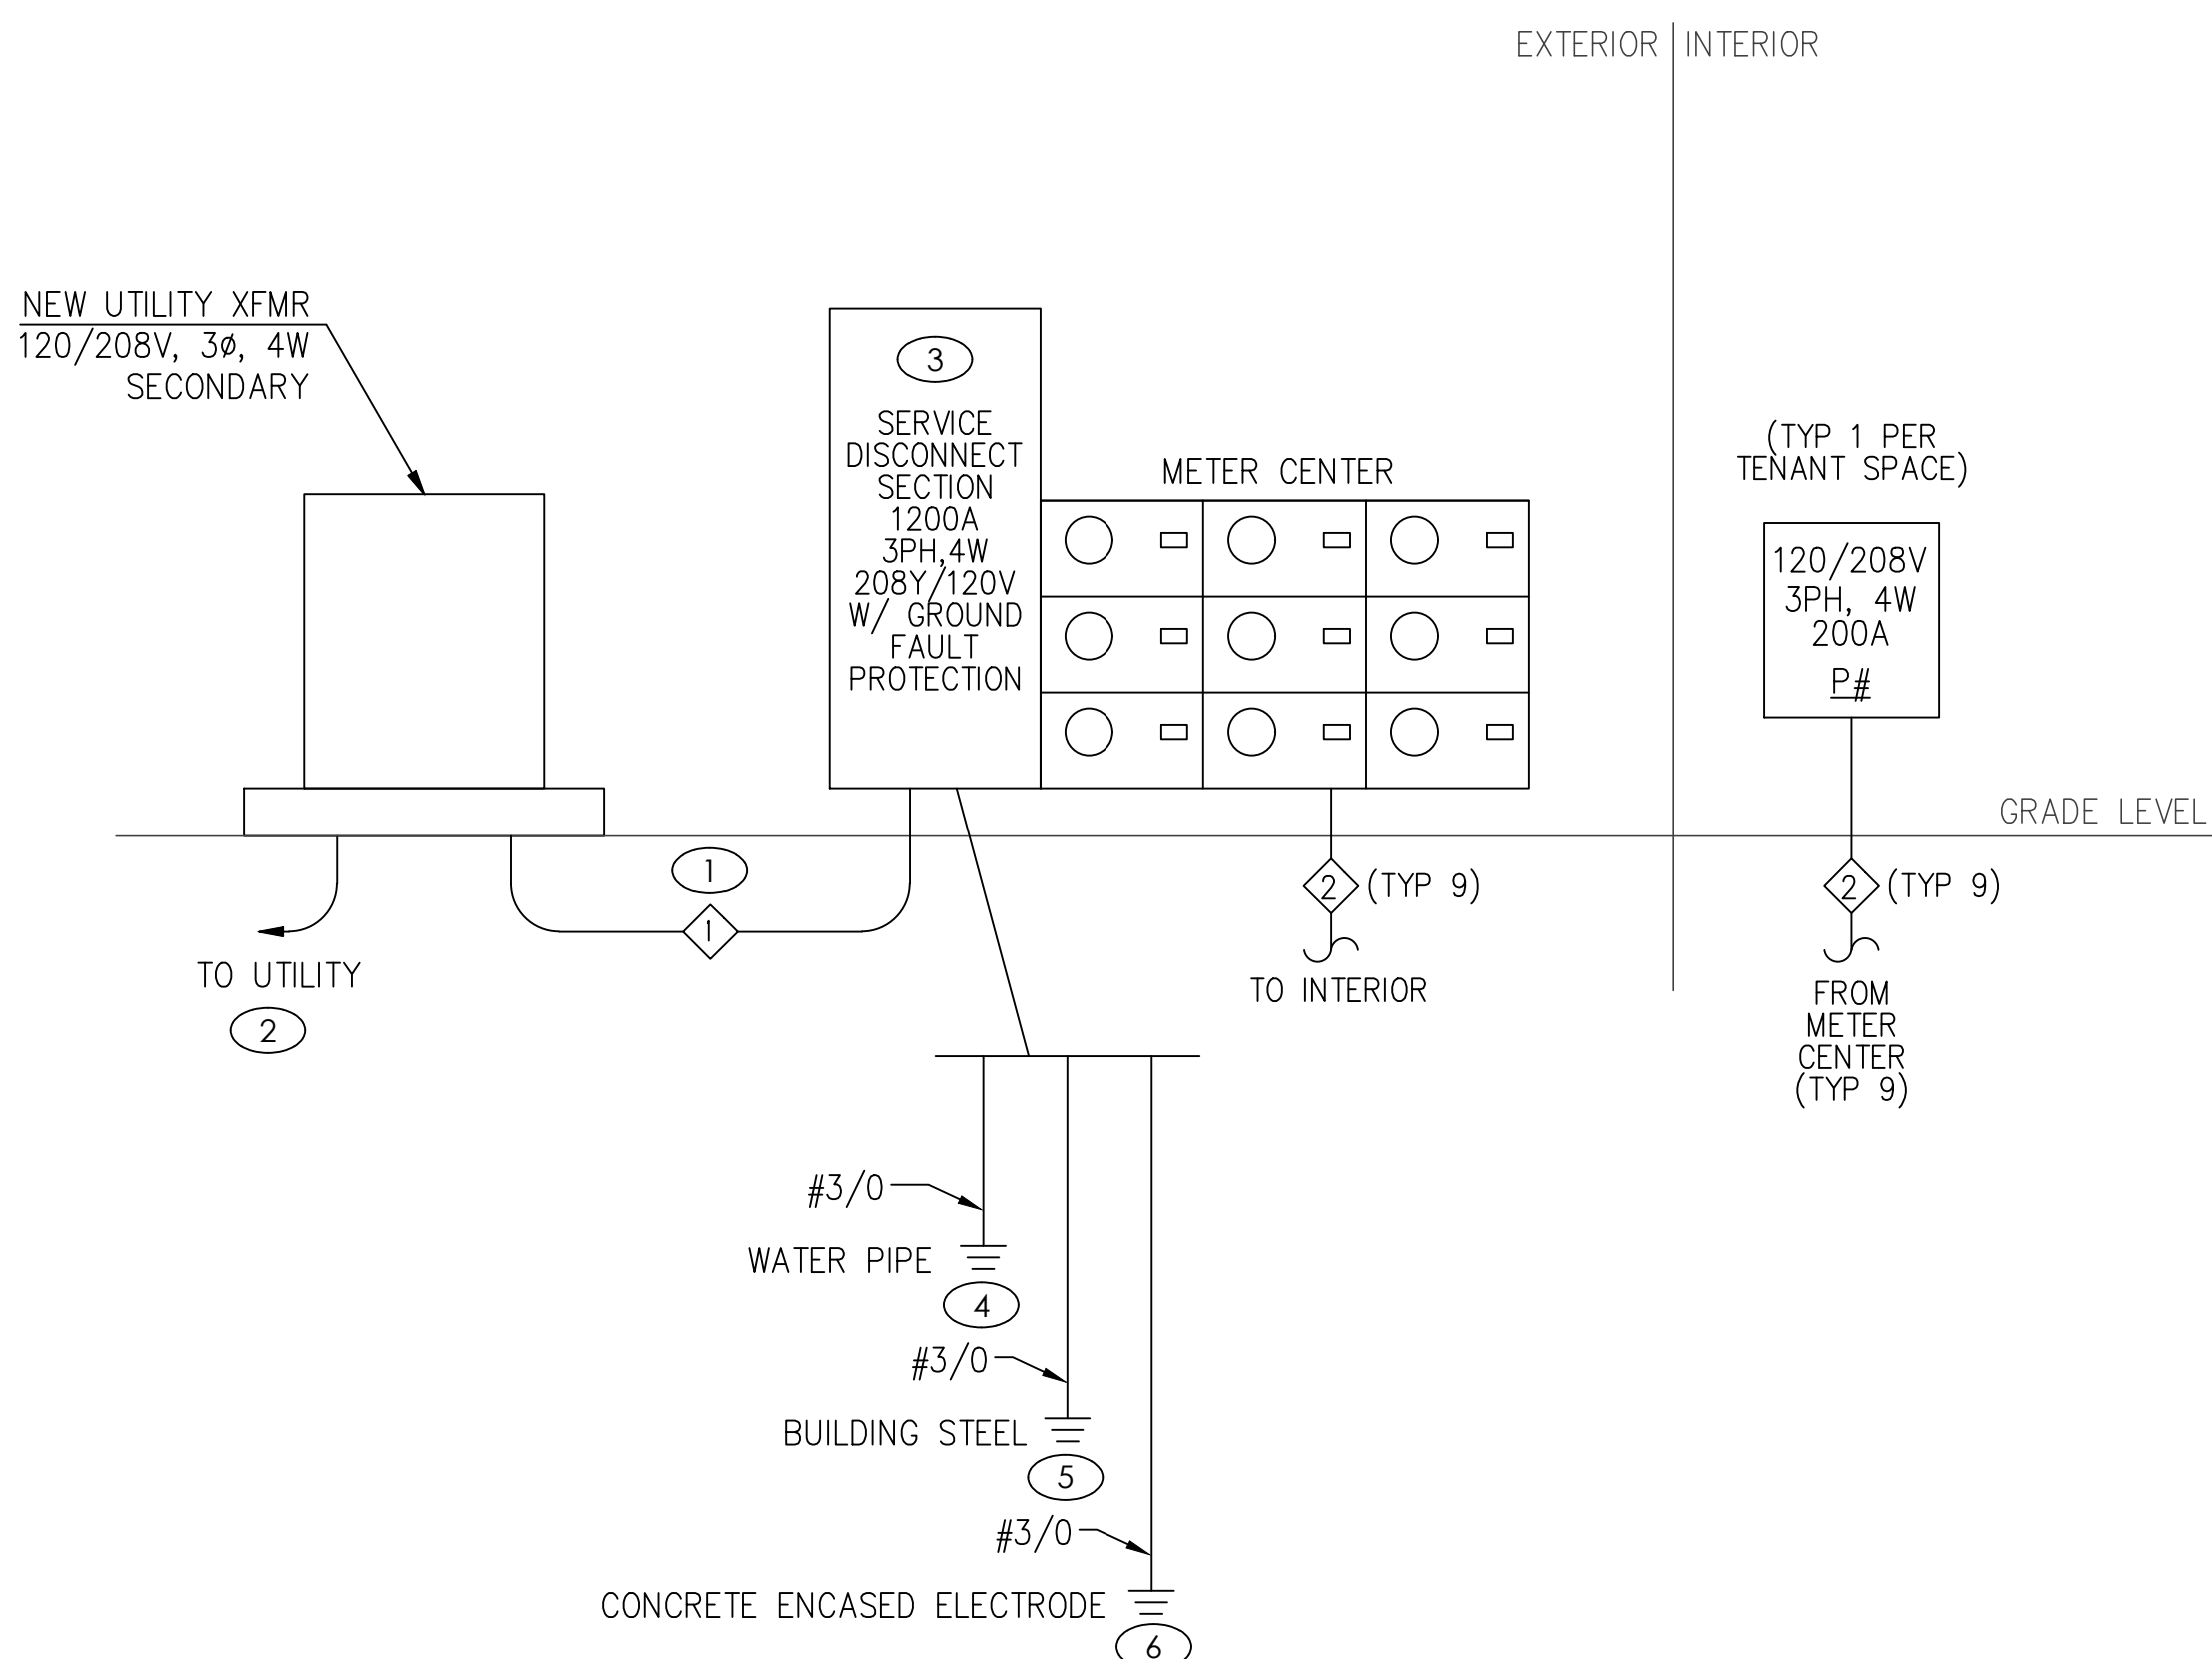

ELECTRICAL SINGLE LINE DIAGRAM

SCALE : NO SCALE

FEEDER NUMBER	CONDUIT AND CONDUCTOR SIZES
1	(4) 4" EA W/ 4 #500KCM AL
2	(1) 2" W/ 4 #3/0 CU & #6 CU GND

THE DESIGN PROFESSIONAL HAS PERFORMED ALL THE REQUIRED VOLTAGE DROP CALCULATIONS FOR ALL BRANCH CIRCUITS AND FEEDERS PER THE NATIONAL ELECTRICAL CODE, ARTICLE 210.19(A)(1) FPN NO. 4.

THE DESIGN PROFESSIONAL HAS PERFORMED ALL THE REQUIRED SHORT CIRCUIT CALCULATIONS AND THE AIC RATING INDICATED FOR EACH DEVICE IS ADEQUATE TO PROTECT THE EQUIPMENT AND THE ELECTRICAL SYSTEM.

KEYED SLD NOTES

- 1. PROVIDE NEW CONDUCTORS TO UTILITY SOURCE. VERIFY EXACT LOCATION AND REQUIREMENTS WITH UTILITY PRIOR TO ROUGH-IN.
- 2. CONTRACTOR TO PROVIDE AND INSTALL TWO 4" PVC CONDUITS FOR SERVICE PRIMARY TO LOCATION DETERMINED BY UTILITY.
- 3. NEW DISCONNECT WITH GROUND FAULT PROTECTION PER UTILITY REQUIREMENTS.
- 4. PROVIDE NEW GROUND PER NEC 250.52(A)(1).
- 5. PROVIDE NEW GROUND PER NEC 250.52(A)(2).
- 6. PROVIDE NEW GROUND PER NEC 250.52(A)(3).