
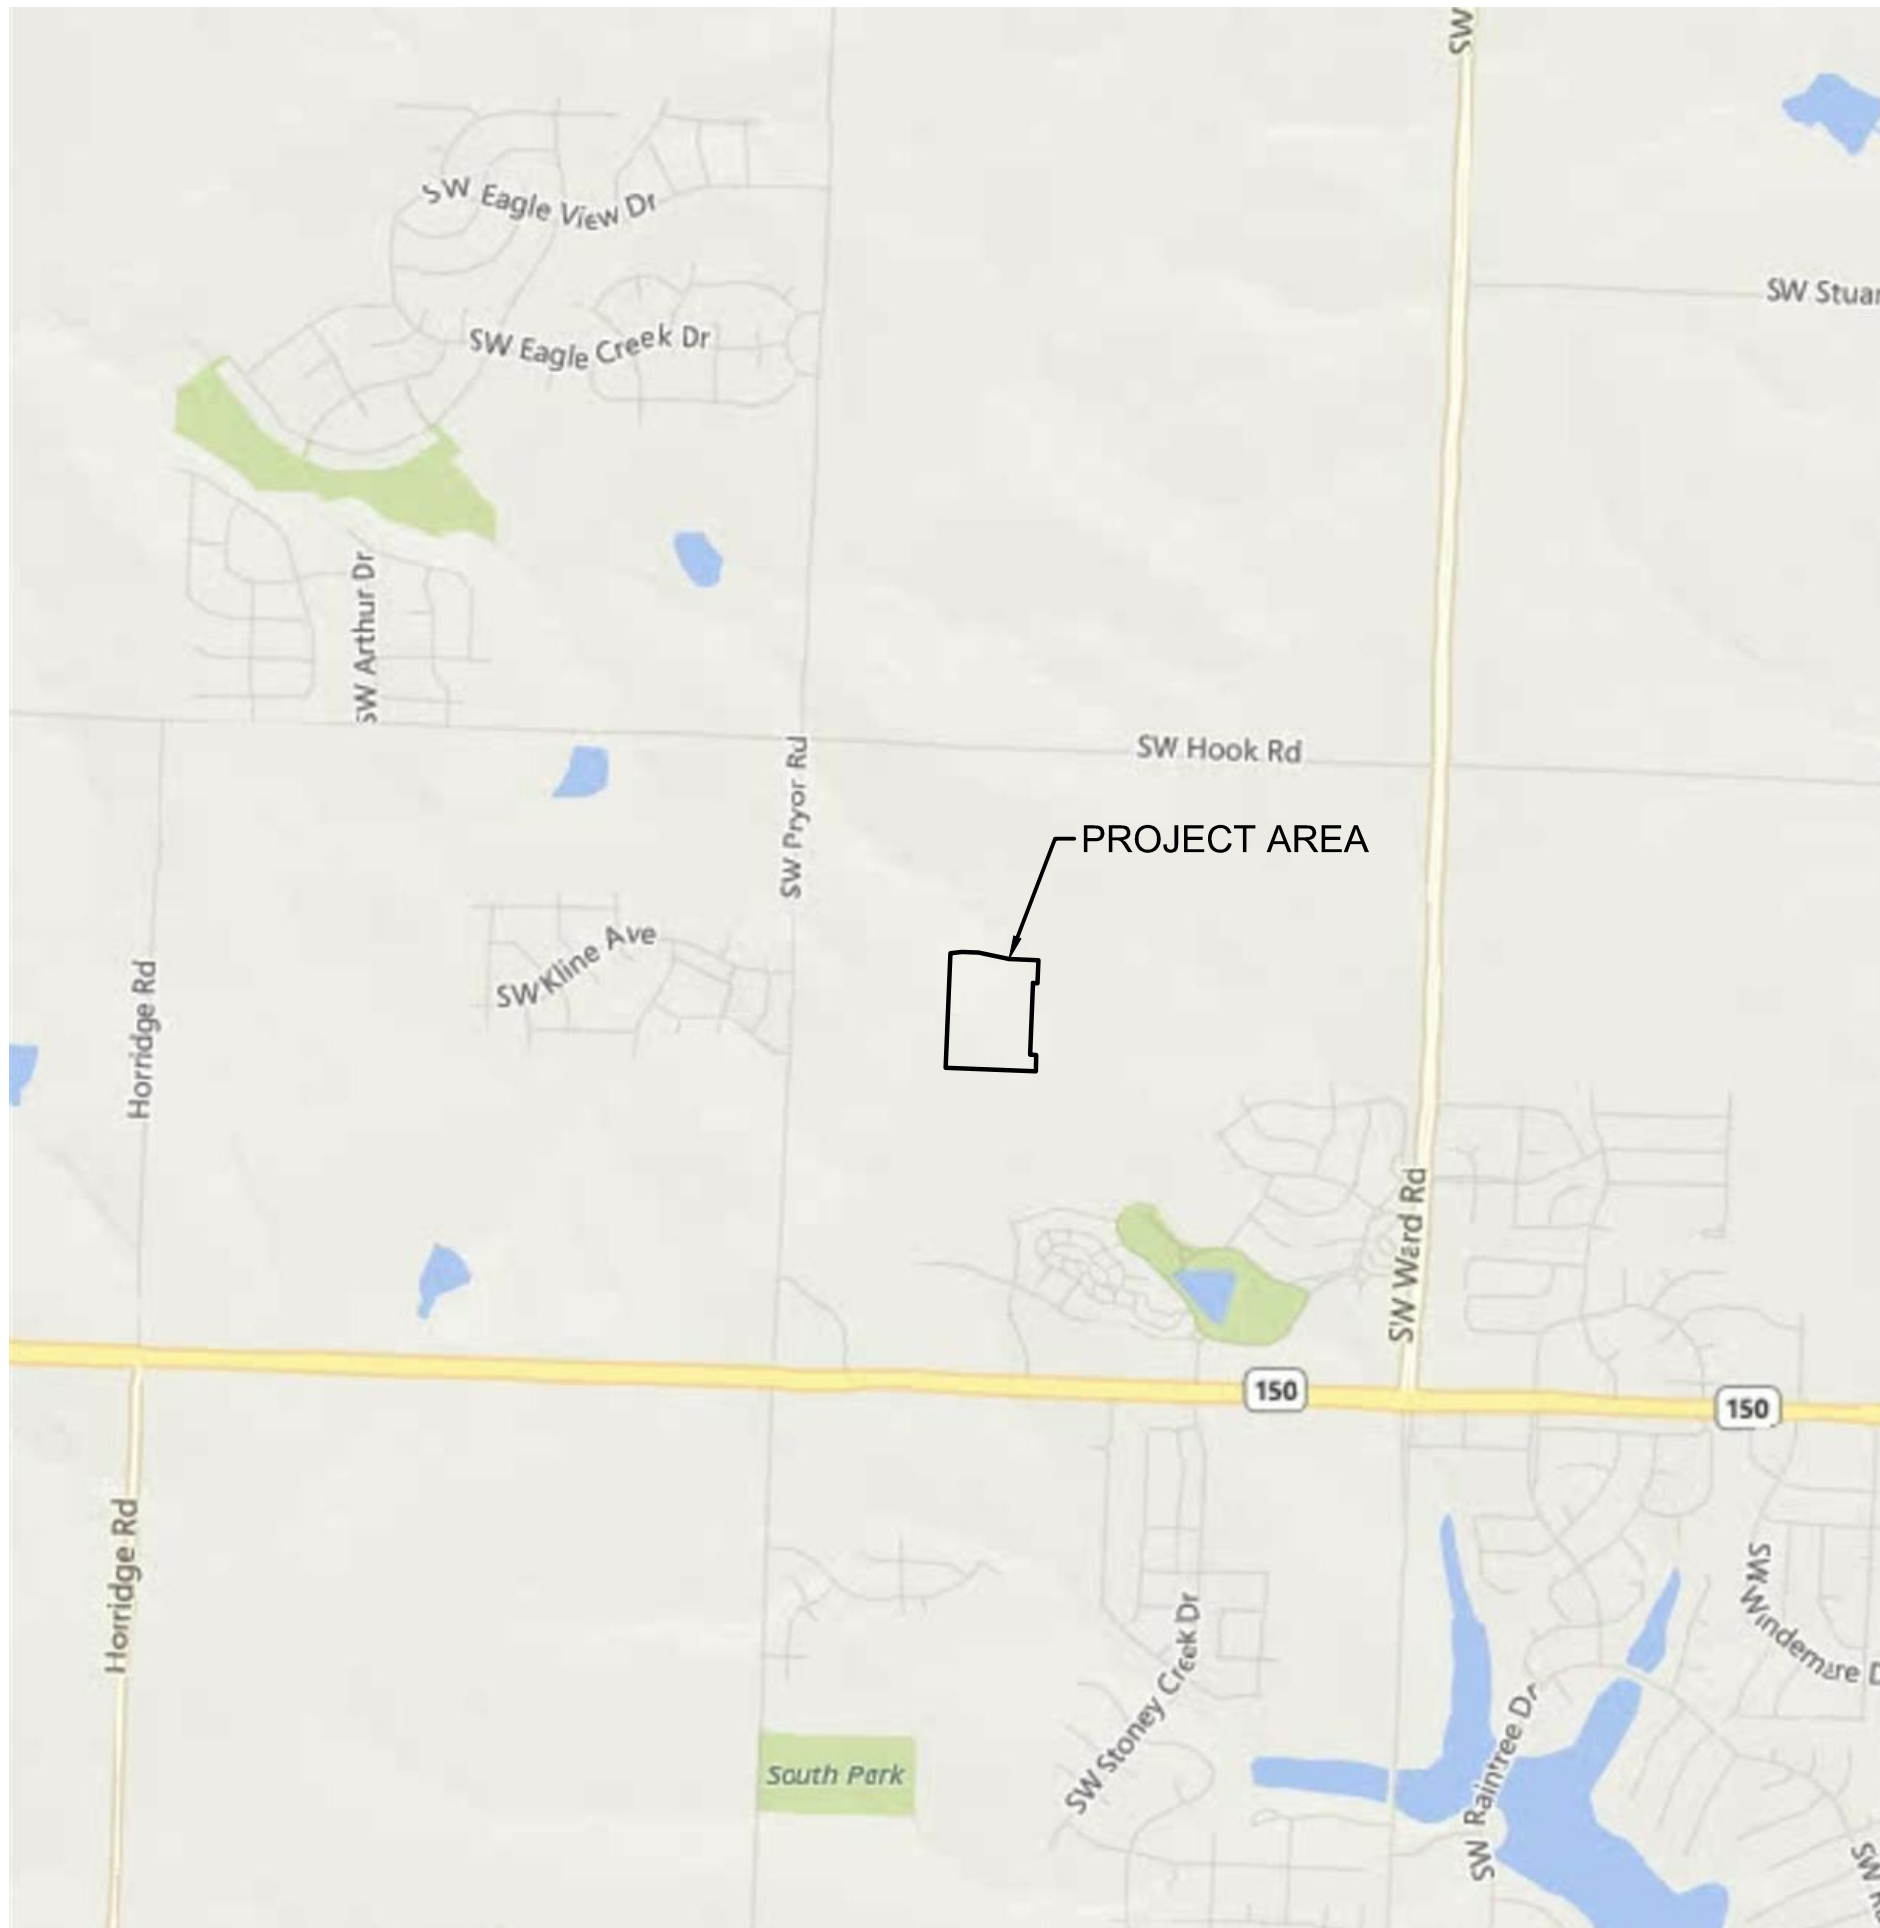


NW 1/4 SECTION 25, TOWNSHIP 47 N, RANGE 32 W
IN LEE'S SUMMIT, JACKSON COUNTY, MO

**Accepted
Record Drawings**

These plans have been reviewed for accuracy and are accepted for basic conformance to the approved construction drawings.

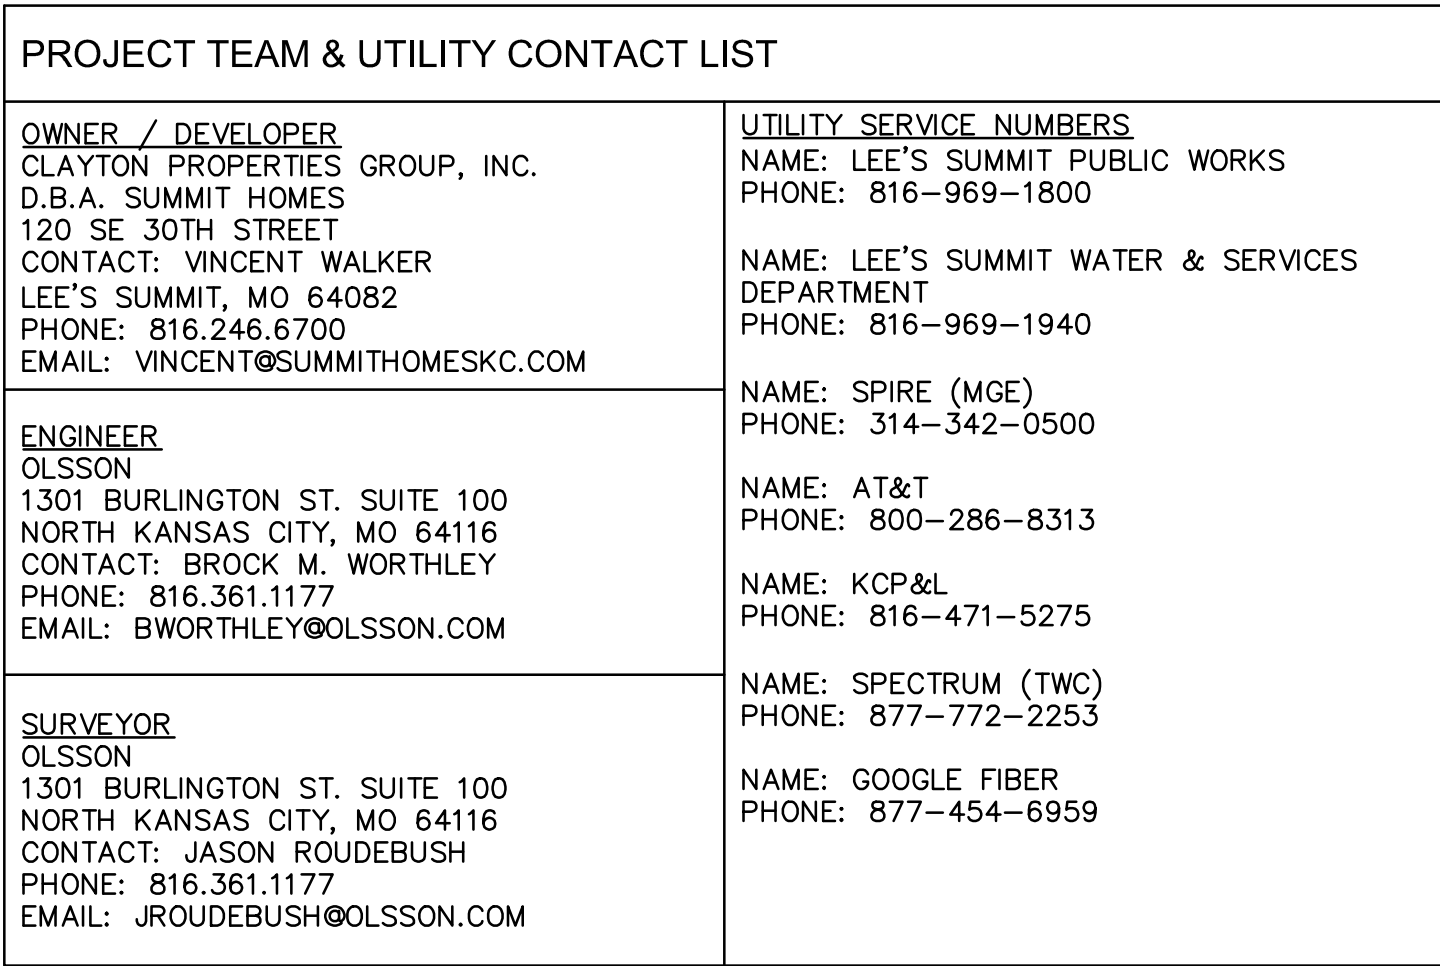

Sheet List Table	
Sheet Number	Sheet Title
C100	COVER SHEET
C101	GENERAL NOTES
C102	GENERAL LAYOUT
C103	TYPICAL SECTIONS
C104	GRADING PLAN (FOR REFERENCE ONLY)
C105	SWALE PLAN AND PROFILE
C106	SWALE PLAN AND PROFILE (CONT)
C107	ROADWAY PLAN AND PROFILE (BUCKTHORN STREET)
C108	ROADWAY PLAN AND PROFILE (BUCKTHORN STREET CONT)
C109	ROADWAY PLAN AND PROFILE (ARBORWAY TERRACE)
C110	ROADWAY PLAN AND PROFILE (ARBORWAY TERRACE CONT)
C111	ROADWAY PLAN AND PROFILE (ARBORWAY TERRACE CONT)
C112	ROADWAY PLAN AND PROFILE (ARBORIDGE CIRCLE)
C113	TRAFFIC CONTROL PLAN
C114	SPOT ELEVATIONS
C115	SPOT ELEVATIONS
C116	SPOT ELEVATIONS
C117	SPOT ELEVATIONS
C118	STORM SEWER PLAN & PROFILE (LINE 1 & 1A)
C119	STORM SEWER PLAN & PROFILE (LINE 2)
C120	STORM SEWER PLAN & PROFILE (LINE 3)
C121	STORM SEWER PLAN & PROFILE (LINE 5)
C122	STORM SEWER PLAN & PROFILE (LINE 4 & 6)
C123	DRAINAGE PLAN
C124	DRAINAGE TABLES
C125	MASTER DRAINAGE PLAN
C126	SIGN DETAILS
C127	STORM SEWER DETAILS
C128	STORM SEWER DETAILS
C129	ROADWAY MARKING DETAILS

A TRACT OF LAND IN THE NORTHWEST QUARTER OF SECTION 25, TOWNSHIP 47 NORTH, RANGE 32 WEST OF THE 5TH PRINCIPAL MERIDIAN IN LEE'S SUMMIT, JACKSON COUNTY, MISSOURI, AND A PORTION OF TRACT E, OF HAWTHORN RIDGE 1ST PLAT, A SUBDIVISION OF LAND RECORDED AS DOCUMENT 2019E020897 IN BOOK 182 AT PAGE 83, IN THE OFFICE OF RECORDER OF DEEDS FOR JACKSON COUNTY, MISSOURI ALL BEING BOUNDED AND DESCRIBED AS FOLLOWS: COMMENCING AT THE SOUTHWEST CORNER OF SAID NORTHWEST QUARTER OF SECTION 25; THENCE SOUTH 87°46'49" EAST ON THE SOUTH LINE OF SAID NORTHWEST QUARTER, 2,653.29 FEET TO THE SOUTHEAST CORNER OF SAID NORTHWEST QUARTER, (CENTER OF SECTION) AND THE POINT OF BEGINNING OF THE TRACT OF LAND TO BE HEREIN DESCRIBED; THENCE ON SAID SOUTH LINE OF SAID NORTHWEST QUARTER, NORTH 87°46'49" WEST, 577.00 FEET; THENCE LEAVING SAID SOUTH LINE, NORTH 02°13'11" EAST, 135.00 FEET; THENCE NORTH 87°46'49" WEST, 50.79 FEET; THENCE NORTH 02°18'36" EAST, 596.57 FEET; THENCE SOUTH 87°41'24" EAST, 37.00 FEET; THENCE NORTH 02°18'36" EAST, 192.00 FEET; THENCE NORTH 87°41'24" WEST, 75.58 FEET; THENCE NORTH 02°18'36" EAST, 39.05 FEET; THENCE NORTH 33°13'50" WEST, 218.11 FEET TO THE SOUTHWESTERLY CORNER OF LOT 21 OF SAID HAWTHORN RIDGE 1ST PLAT; THENCE ON THE SOUTHERLY LINE OF SAID HAWTHORN RIDGE 1ST PLAT THE FOLLOWING 9 CALLS, NORTH 54°57'38" EAST, 130.00 FEET; THENCE SOUTH 35°02'22" EAST, 58.00 FEET; THENCE NORTH 54°57'38" EAST, 175.90 FEET; THENCE SOUTH 65°30'07" EAST, 95.33 FEET; THENCE SOUTH 87°41'24" EAST, 121.73 FEET; THENCE NORTH 02°18'36" EAST, 78.00 FEET; THENCE SOUTH 87°41'24" EAST, 175.00 FEET; THENCE NORTH 02°18'36" EAST, 72.00 FEET; THENCE SOUTH 87°41'24" EAST, 130.00 FEET TO THE SOUTHEASTERLY CORNER OF LOT 28 OF SAID HAWTHORN RIDGE 1ST PLAT AND A POINT ON THE EAST LINE OF SAID NORTHWEST QUARTER; THENCE ON SAID EAST LINE, SOUTH 02°18'36" WEST, 1,392.58 FEET TO THE POINT OF BEGINNING. CONTAINING 827,409 SQUARE FEET OR 19.00 ACRES, MORE OR LESS.

RR SPIKE IN SOUTH FACE OF POWER POLE ON NORTH SIDE OF SW. HOOK ROAD, IMMEDIATELY WEST OF DRIVEWAY FOR HOUSE #1622. ELEVATION= 1024.63'

Brock Worthley
BROCK M. WORTHLEY, P.E.
CIVIL ENGINEER
MO# PE-2019000237

1/18/2021
DATE



Olsson - Civil Engineering
Missouri Certificate of Authority #001592
1301 Burlington Street
North Kansas City, MO 64116


[illegible]

COVER SHEET STREET & STORM SEWER PLANS	2020
HAWTHORN RIDGE THIRD PLAT	
LEE'S SUMMIT, MO	

drawn by: _____ OLS
checked by: _____ BMW
approved by: _____ BMW
QA/QC by: _____ JES
project no.: _____ A19-1605
drawing no.: C TTL01 A191605
date: _____ 10/02/2020

SHEET
C100


DWG: F:\2019\1501-2000\019-1605-A\40-Design\AutoCAD\Final Plans - As-Built\Sheets\GEN\A191605 & STORM\AC_GEN01_A191605.dwg USER: bwerthley C:\PSTRM_A191605
DATE: Jan 18, 2022 3:30pm XREFS: C:\PTBLK_A191605 C:\PBASE_A191605 C:\PUTIL_A191605 C:\PBNDY_A191605

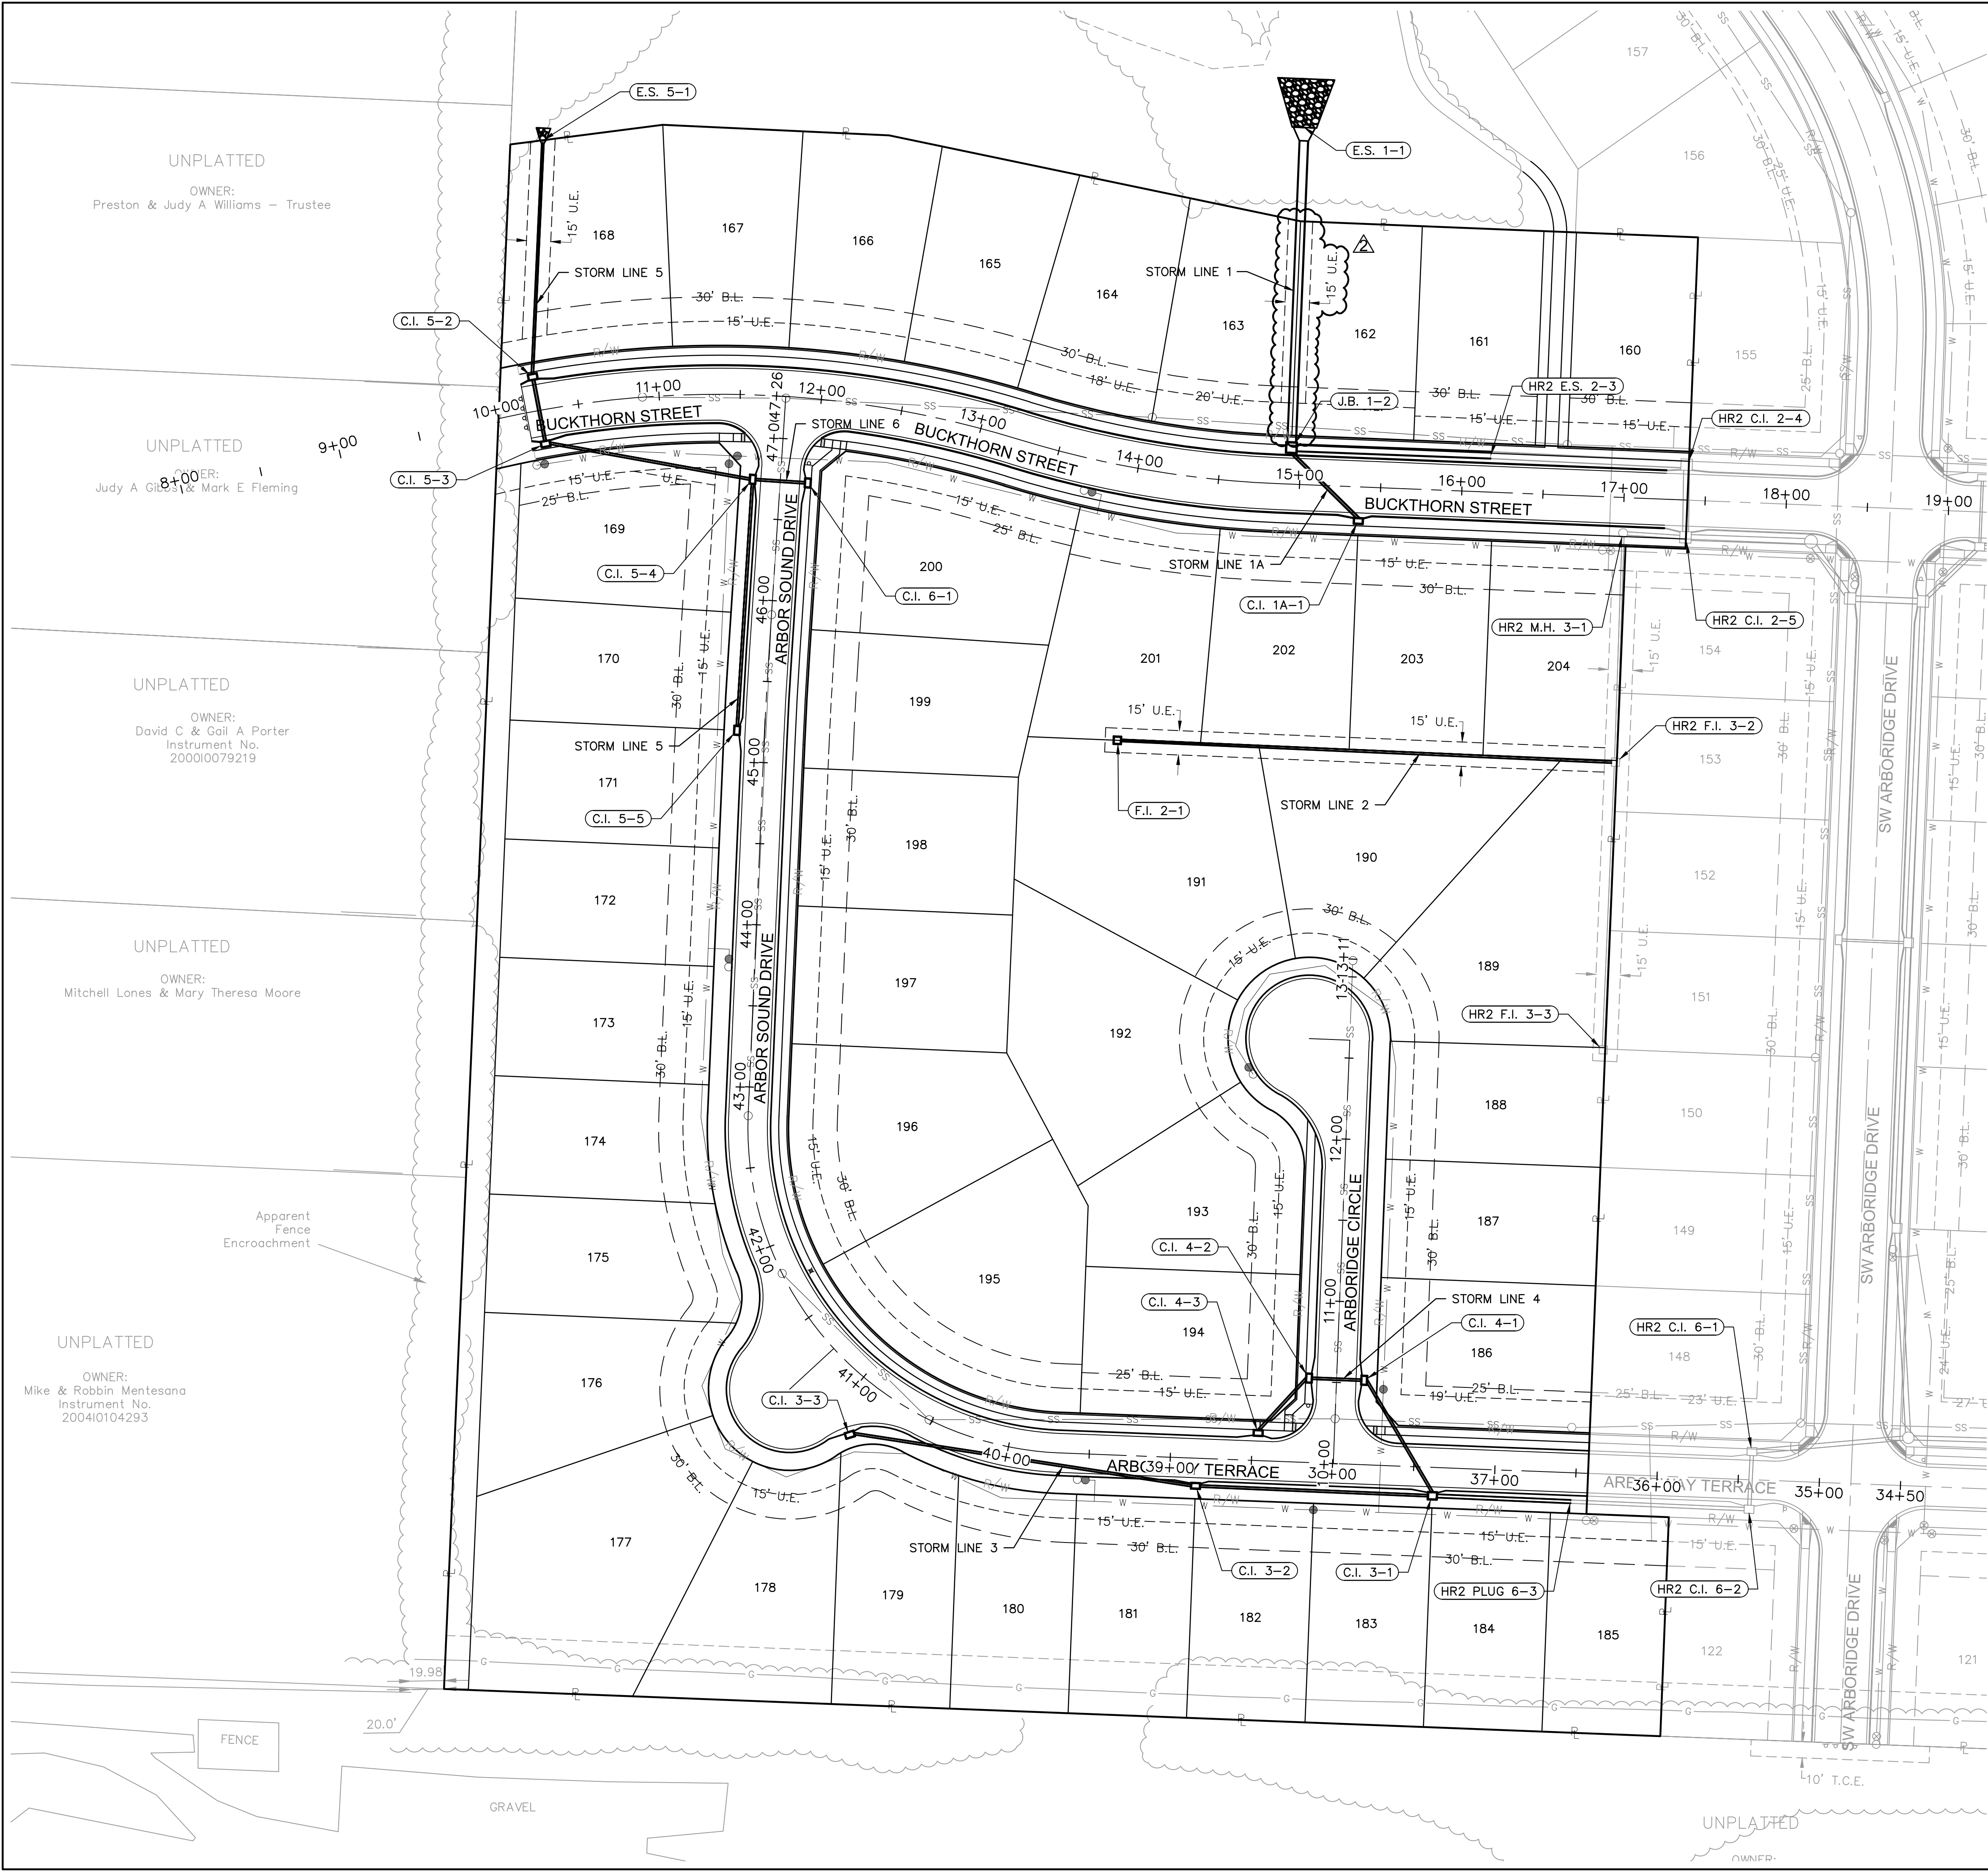

**Accepted
Record Drawings**

These plans have been reviewed for accuracy and are accepted for basic conformance to the approved construction drawings.

NOT ASBUILT

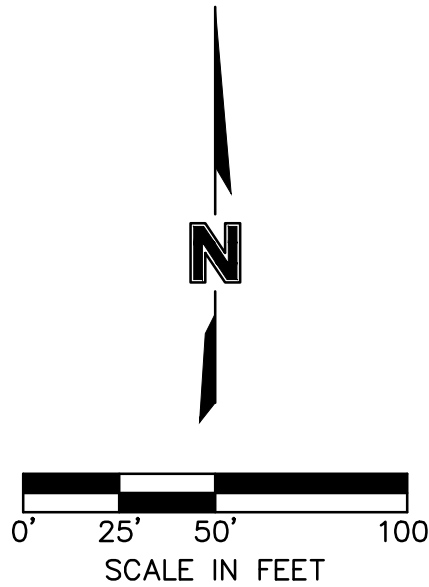

olsson

Olsson - Civil Engineering

Missouri Certificate of Authority #001592

1301 Burlington Street

North Kansas City, MO 64116

TEL 816.361.1177

www.olsson.com

STATE OF MISSOURI

BROCK M. WORTHLEY

PE-2019000237

1/18/2022

PROFESSIONAL ENGINEER

GENERAL LAYOUT
STREET & STORM SEWER PLANS

HAWTHORN RIDGE
THIRD PLAT

LEE'S SUMMIT, MO

REV. NO.	DATE	REVISIONS DESCRIPTION
2	12/02/2020	REVISED PER CITY COMMENTS

BY

REVISIONS

drawn by: OLS

checked by: BMW

approved by: BMW

QA/QC by: JES


project no.: A19-1605

drawing no.: C_GEN01_A191605

date: 10/02/2020

SHEET
C102

DWG: F:\2019\1501-2000\019-1605-A\40-Design\AutoCAD\Final Plans - As-Built\Sheets\GNCV\STREET & STORM\C_TYP01_0191605.dwg
DATE: Jan 18, 2022 3:30pm XREFS: C_PTBULK_0191605 USER: bworthley

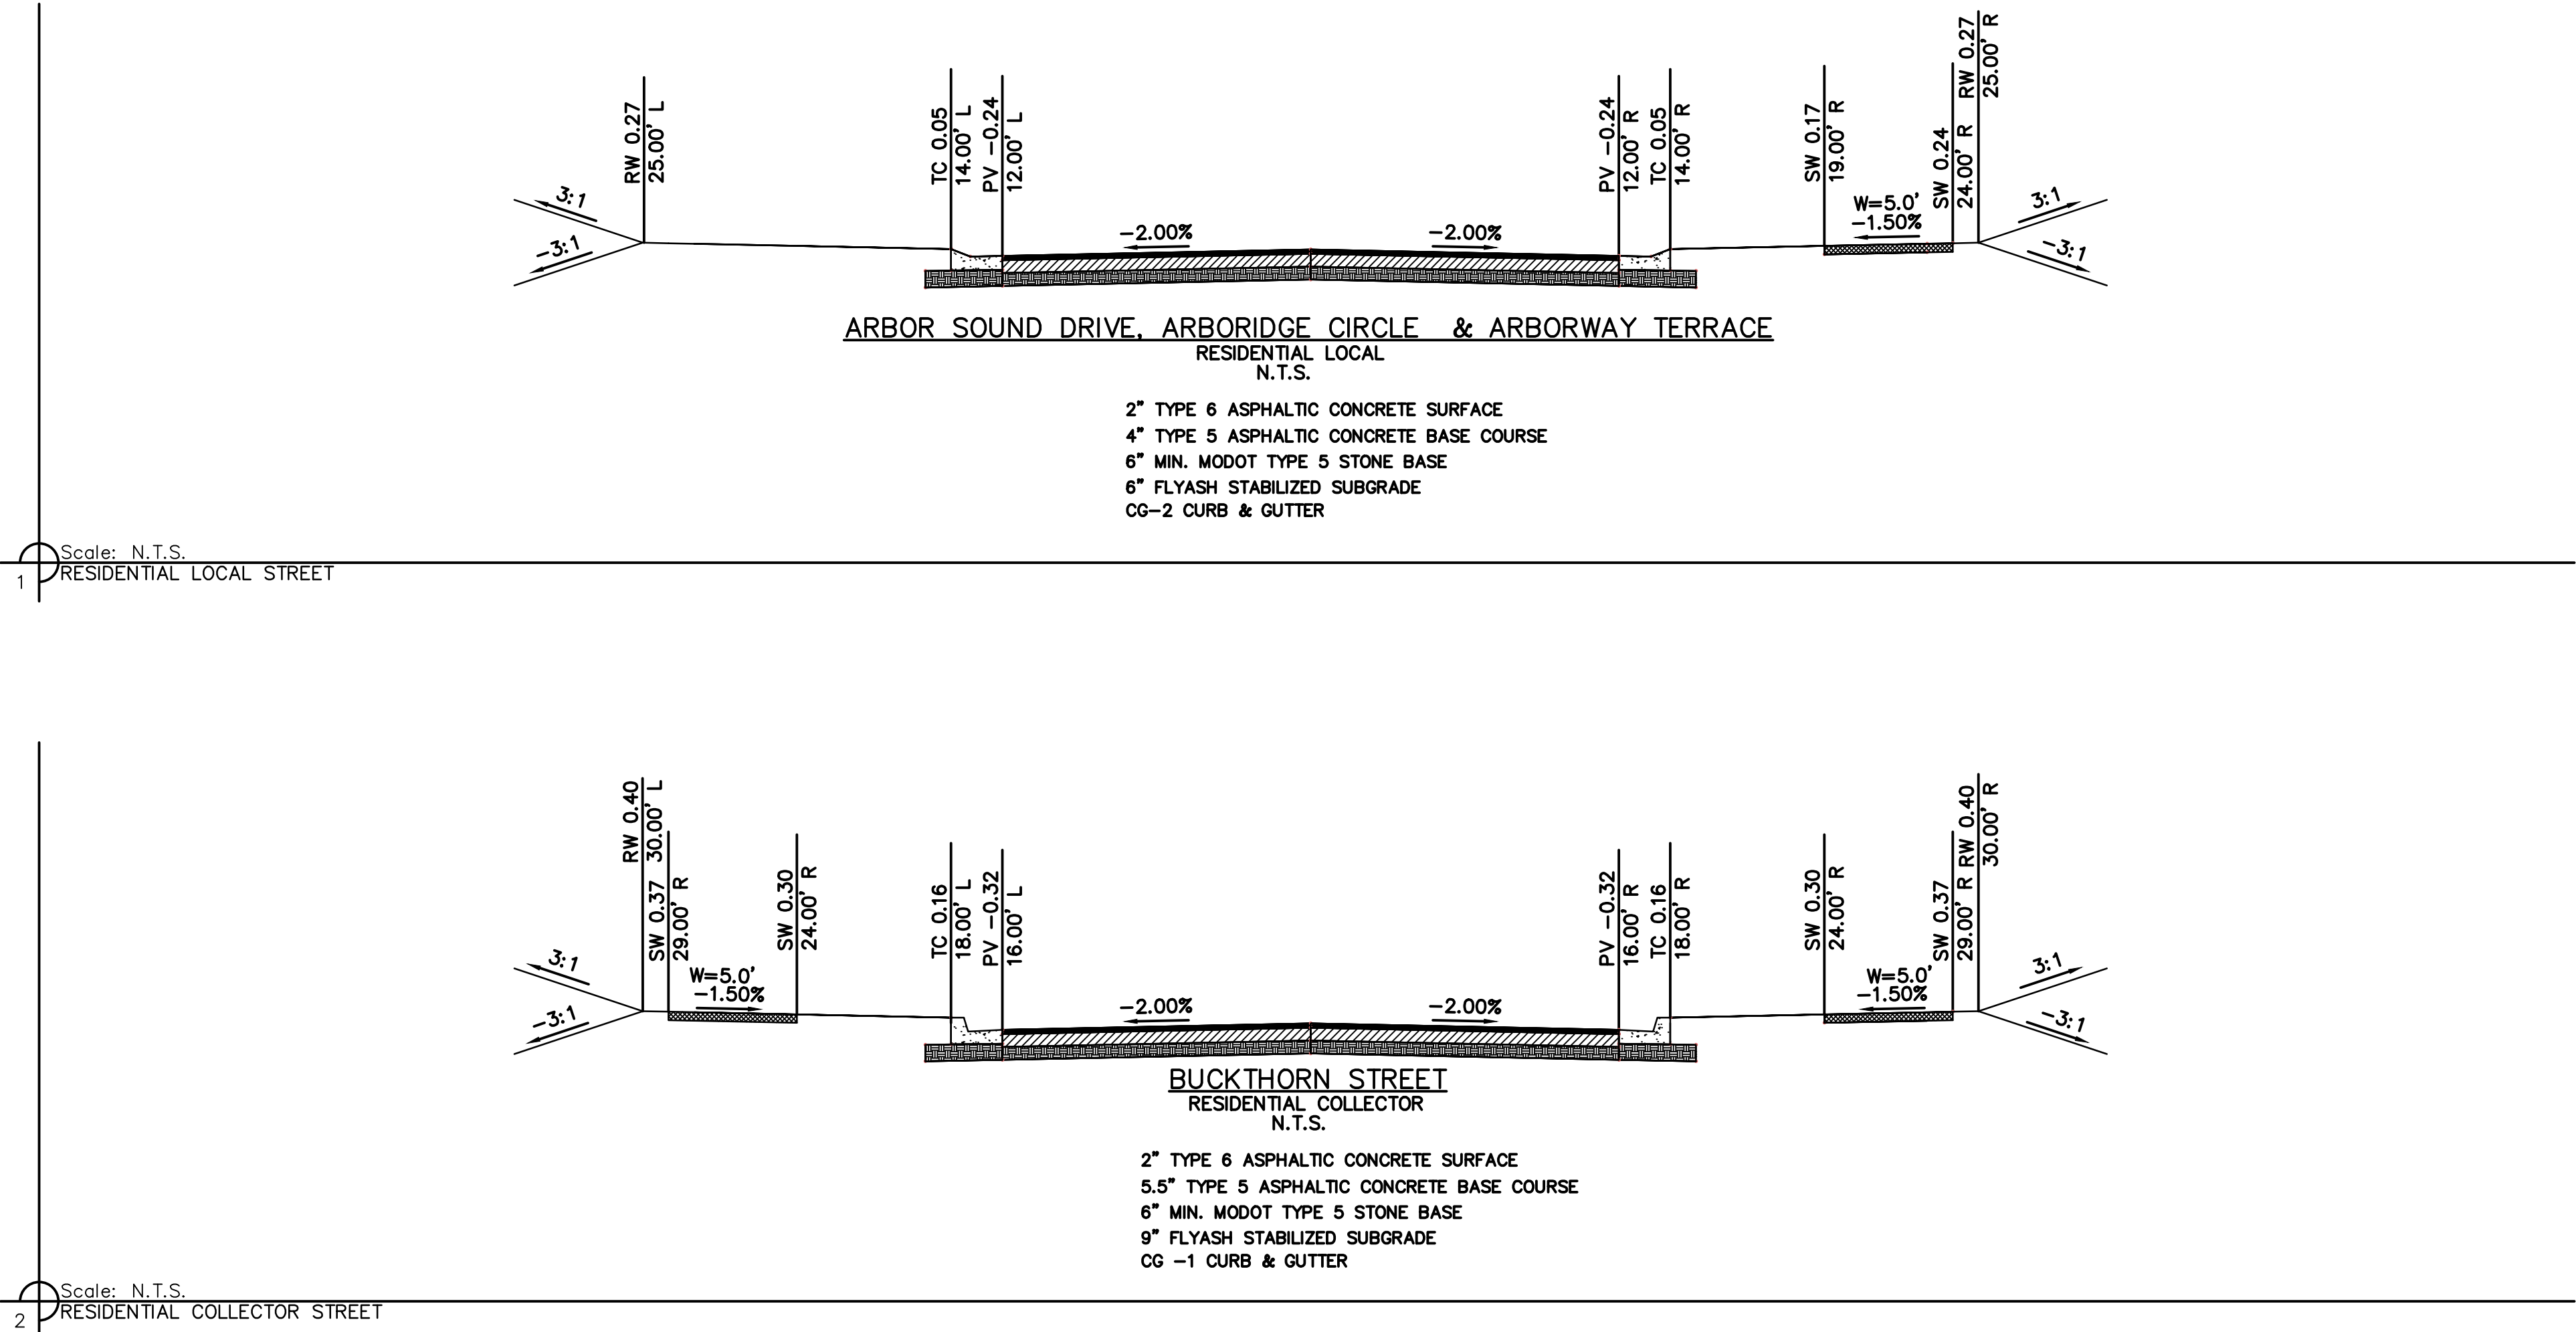

NOT ASBUILT

Accepted
Record Drawings

These plans have been reviewed for
accuracy and are accepted for basic
conformance to the approved
construction drawings.

olsson

Olsson - Civil Engineering
Missouri Certificate of Authority #001592
1301 Burlington Street
North Kansas City, MO 64116
TEL 816.361.1177
www.olsson.com

STATE OF MISSOURI
BROCK M. WORTHLEY
NUMBER
PE-2019000237
1/18/2020
PROFESSIONAL ENGINEER

REV. NO.	DATE	REVISIONS DESCRIPTION	BY

REVISIONS

TYPICAL SECTIONS
STREET & STORM SEWER PLANS

HAWTHORN RIDGE
THIRD PLAT

LEE'S SUMMIT, MO

2020

drawn by: OLS
checked by: BMW
approved by: BMW
QA/QC by: JES
project no.: A19-1605
drawing no.: C_TYP01_0191605
date: 10/02/2020

SHEET
C103

DWG: F:\2019\1501-2000\019-1605-A\40-Design\AutoCAD\Final Plans - As-Built\Sheets\GNCV\STREET & STORM\C_GRD01_A191605.dwg USER: bworthley
DATE: Jan 18, 2022 3:30pm XREFS: C_PTBULK_A191605 C_XBASE_A191605 C_PBASE_A191605 C_PUTIL_A191605 C_PBN DY_A191605

These plans have been reviewed for accuracy and are accepted for basic conformance to the approved construction drawings.


WARNING
HIGH-PRESSURE PIPELINE
EXCAVATION AND/OR CONSTRUCTION PROHIBITED
WITHOUT COMPLIANCE WITH STATE ONE-CALL, AND
WITHOUT WRITTEN PERMISSION FROM
MAGELLAN PIPELINE COMPANY, L.P.

REFER TO MASTER DRAINAGE PLAN FOR AS-BUILT SURFACE

1. CONTRACTOR SHALL ADHERE TO THE "DESIGN AND CONSTRUCTION MANUAL" SECTION 2100 AS ADOPTED BY THE CITY OF LEE'S SUMMIT (LATEST EDITION), FOR EXCAVATION AND EMBANKMENT WORK WITHIN THE PROPOSED RIGHT-OF-WAY.

3. ALL EMBANKMENT OUTSIDE OF RIGHT-OF-WAY SHOULD BE PLACED IN CONTROLLED LIFTS HAVING A MAXIMUM LOOSE LIFT THICKNESS OF 8". EMBANKMENT SHOULD BE COMPACTED TO A MINIMUM OF 95% OF THE MATERIALS MAXIMUM DRY DENSITY AS DETERMINED BY ASTM D-698 (STANDARD PROCTOR COMPACTION). MOISTURE CONTENT OF THE FILL AT THE TIME OF COMPACTION SHALL BE WITHIN A RANGE OF -0 TO +4 PERCENT OF OPTIMUM MOISTURE CONTENT.

LOT FILL INFORMATION			
LOT NUMBER	MAX DEPTH OF FILL (OVER 2' PLACED)	FILL PLACED ON EXISTING SLOPES > 5:1	PROPOSED SLOPES > 3:1
160			
161	17.3	X	
162	19.5	X	
163	20.4	X	
164	12.5	X	
165	10.2		
166	10.3		
167	10.1		
168	9.1		
169			
170			
186	3.9	X	
187	7.3	X	
188	10.8	X	
189	12.9	X	
190	13.4		
191	11.0		
192	6.1		
193	4.9		
194			
195	3.6		
196	3.6		
197			
198			
199			
200			
201		X	
202	6.8	X	
203	6.8	X	
204	5.8	X	

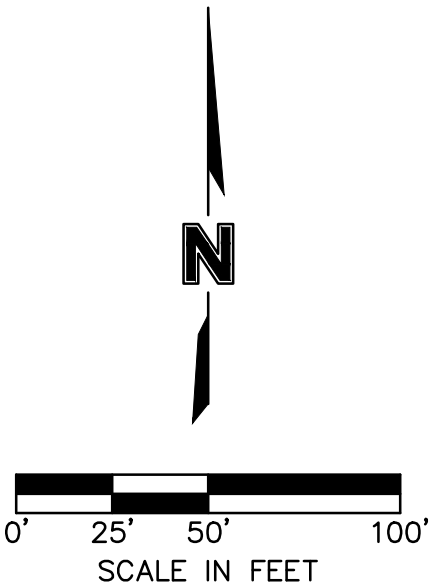

LEGEND	
	EXISTING INDEX CONTOURS
	EXISTING INTERMEDIATE CONTOURS
	PROPOSED INDEX CONTOURS
	PROPOSED INTERMEDIATE CONTOURS

EARTHWORK QUANTITIES		
LOCATION	CUT (C.Y.)	FILL (C.Y.)
STREET	10,423	8,630
SITE	50,641	44,871
TOTAL	61,064	53,501

2. EARTHWORK QUANTITIES DO NOT TAKE INTO CONSIDERATION EXCAVATION, REMOVAL AND DISPOSAL OF MATERIAL DEEMED UNSUITABLE BY A GEOTECHNICAL ENGINEER. THE EARTHWORK CONTRACTOR IS RESPONSIBLE FOR EXCAVATION, REMOVAL AND DISPOSAL OF UNSUITABLE MATERIAL AND FOR REPLACING IT WITH SUITABLE MATERIAL.

DEVISIONS


RE



116

www.olsson.com

DWG: F:\2019\1501-2000\019-1605-A\40-Design\AutoCAD\Final Plans - As-Built\Sheets\SWL01_A191605.dwg
DATE: Jan 18, 2022 3:33pm
USER: bwerthley
C_PSTRM_A191605
C_PBASE_A191605
C_PUTIL_A191605
C_PNDY_A191605
C_PBASE_A191605
C_PSTRM_A191605
C_PSURF_A191605

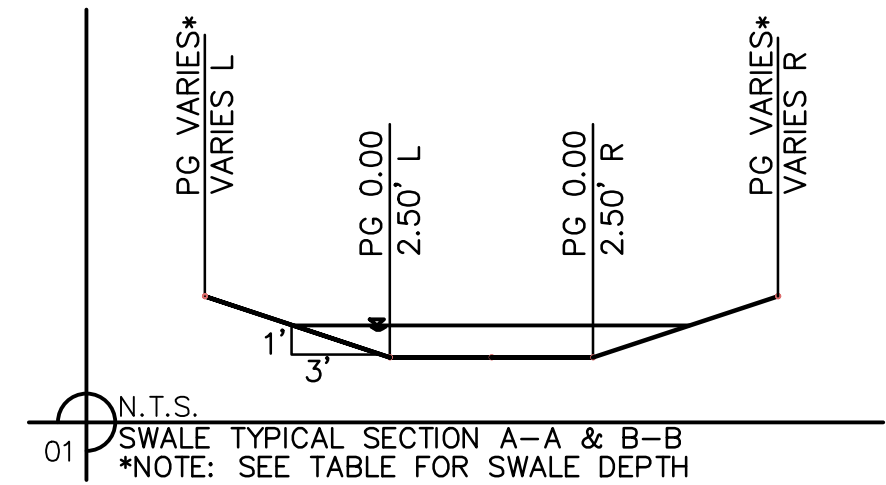


SWALE GRADING NOTES:


1. CONTRACTOR SHALL CONSTRUCT SWALES WITH MINIMUM SLOPE, WIDTH AND DEPTH AS SHOWN IN THE SWALE DESIGN TABLES.
2. AS-BUILT SURVEY IS REQUIRED/APPROVED BY CITY FOR ALL SWALES AND PRIOR TO APPROVAL FOR ANY BUILDING FOUNDATION PERMIT. CONTRACTOR SHALL BE REQUIRED TO REGRADE SWALES AT CONTRACTOR'S EXPENSE IF ABOVE REQUIREMENTS ARE NOT MET.

Swale Drainage Area Table (100 year Return Frequency)						
Section	Drainage Area (ac.)	C	Tc (min)	i (in/hr)	K	Peak Flow (cfs)
A-A	0.79	0.51	5	10.32	1.25	5.20
B-B	1.13	0.51	5	10.32	1.25	7.43

Swale Design Table (100 Year Return Frequency)														
Section Data							Flow Data							
SECTION	Mannings Coefficient	Channel Slope (%)	Min. Swale Depth (ft)	Left Side Slope (H:V)	Right Side Slope (H:V)	Bottom Width (ft)	Discharge (cfs)	Water Depth (ft)	Flow Area (ft ²)	Velocity (ft/sec)	Wetted Perimeter (ft)	Top Width (ft)	Specific Energy (ft)	Shear Stress (lbs/ft ²)
A-A	0.03	1.82%	1.32	3:1	3:1	5.00	5.20	0.32	1.91	2.73	7.02	6.92	0.44	0.31
B-B	0.03	2.23%	1.39	3:1	3:1	5.00	7.43	0.39	2.41	3.09	7.47	7.34	0.54	0.45

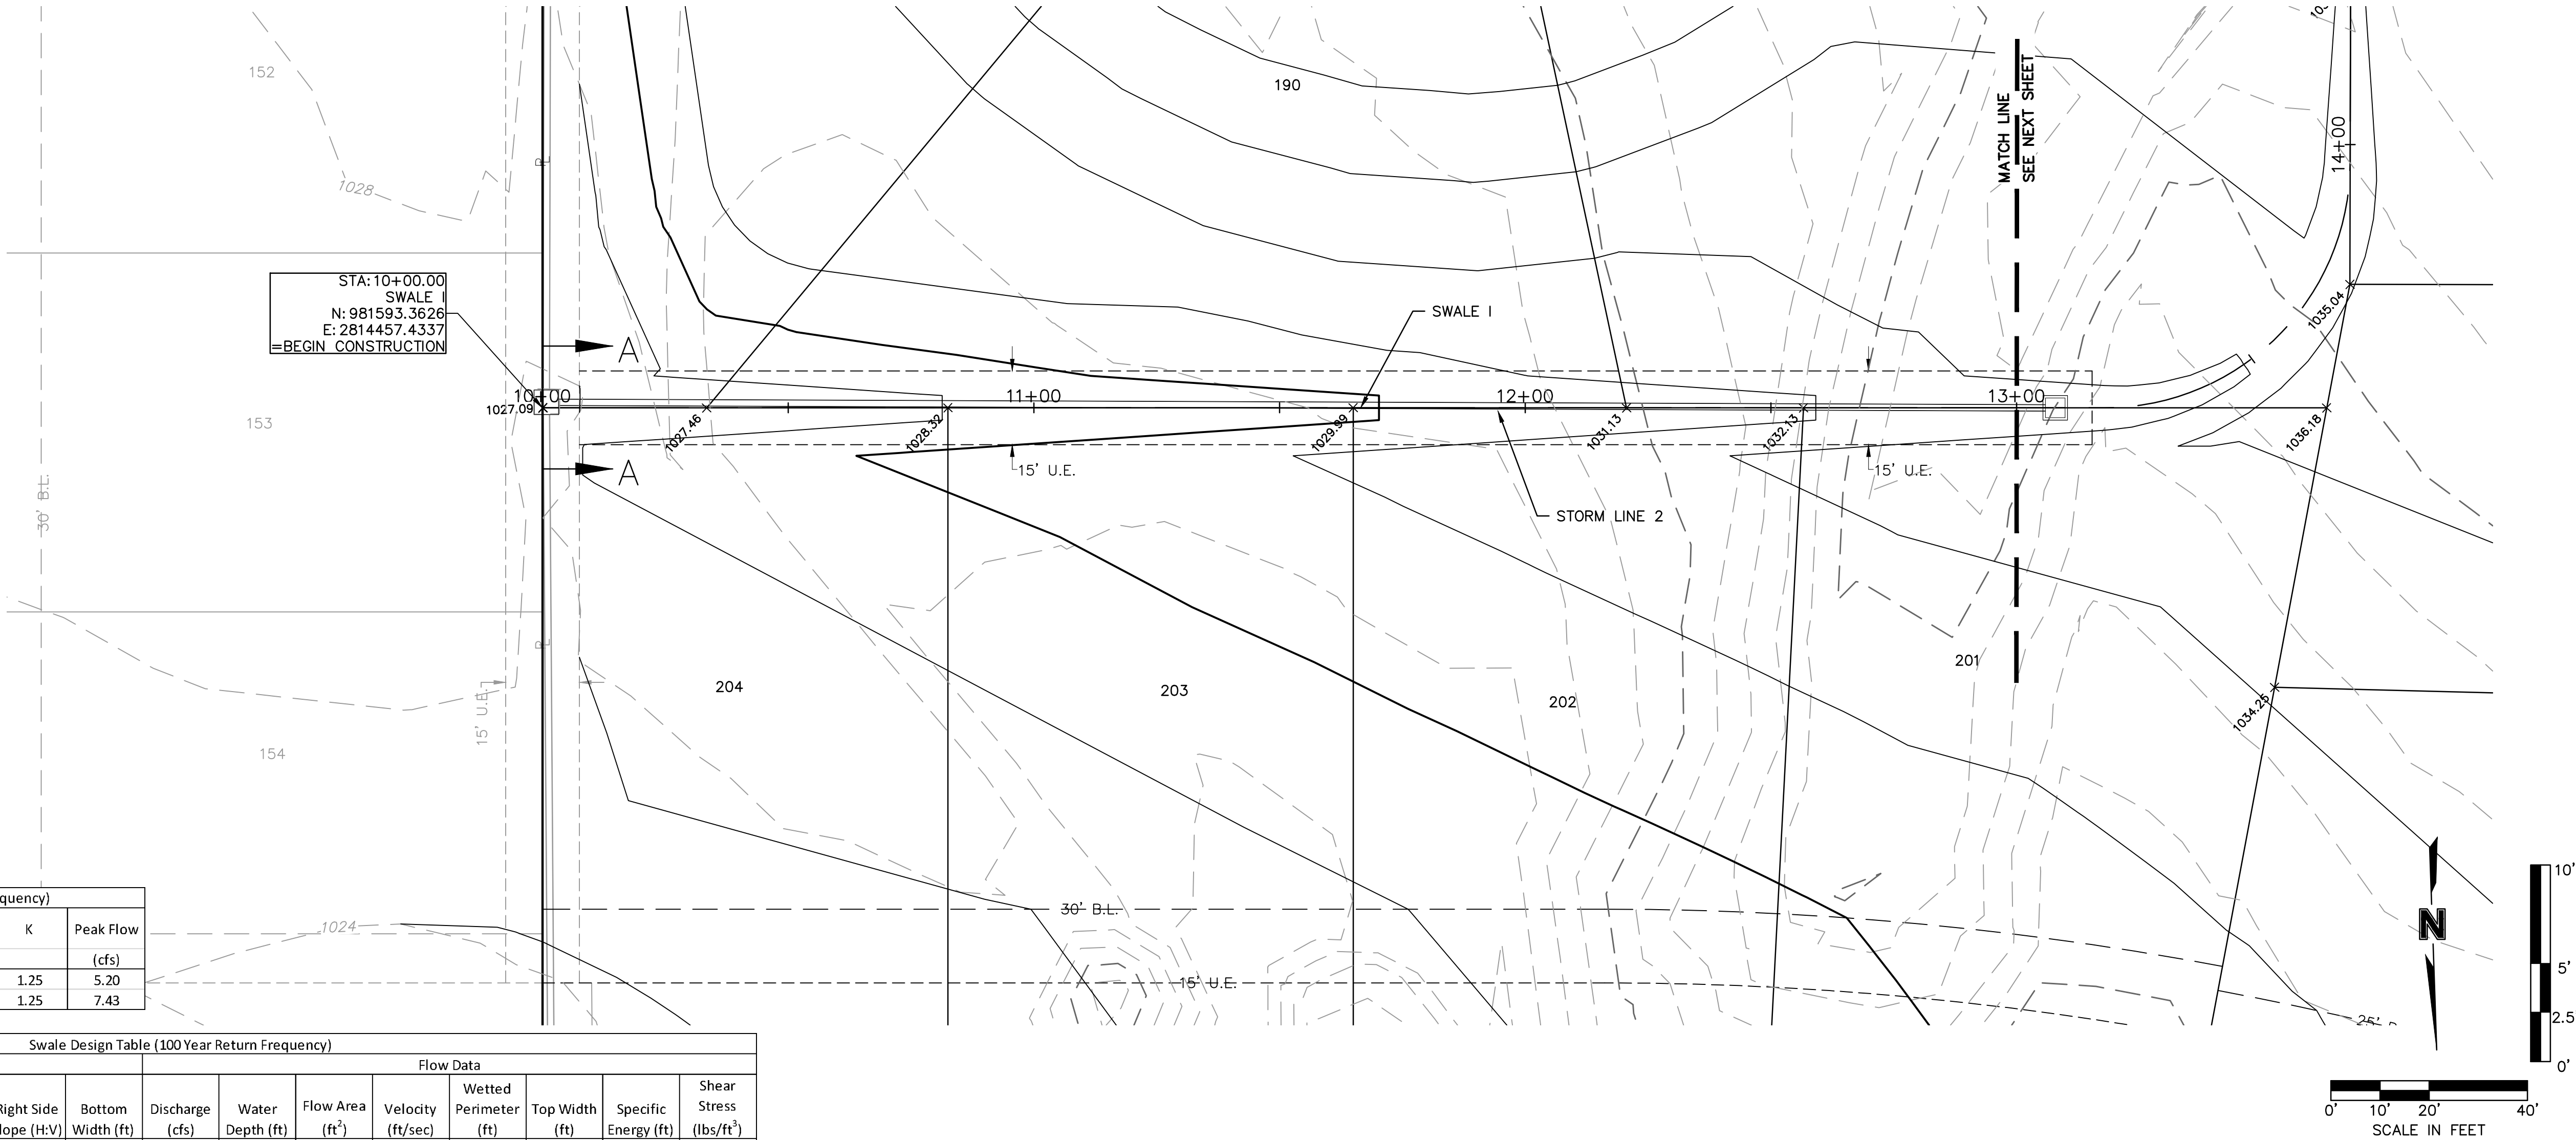

DWG: F:\2019\1501-2000\019-1605-A\40-Design\AutoCAD\Final Plans - As-Built\Sheets\CONV\STREET & STORM\AC_SWL01_A191605.dwg USER: bwerthley
DATE: Jan 18, 2022 3:33pm XREFS: C_PBASE_A191605 C_PUTIL_A191605 C_PSTRM_A191605 C_PSURF_A191605

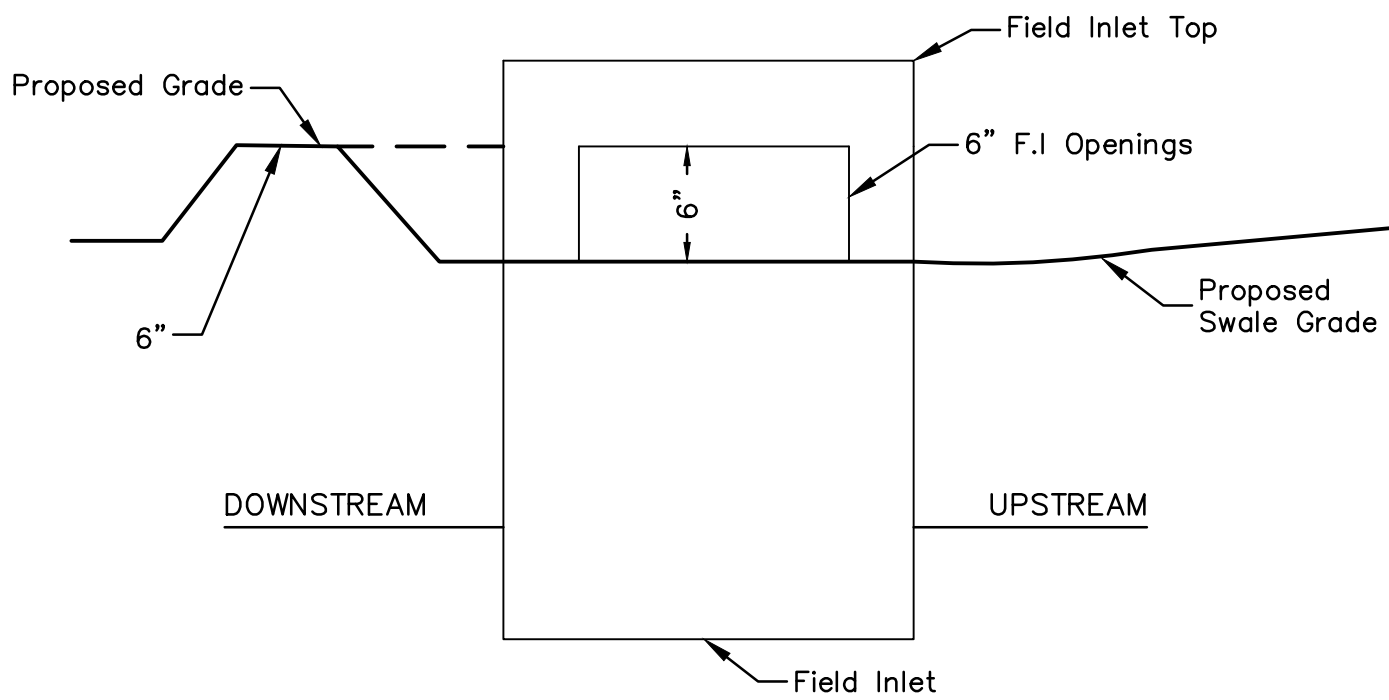



NOTE: INCLUDE SUMP PER ABOVE DETAIL WHERE FIELD INLETS ARE LOCATED WITHIN SWALES.

SUMP DETAIL
N.T.S.

Swale Drainage Area Table (100 year Return Frequency)						
Section	Drainage Area (ac.)	C	Tc (min)	i (in/hr)	K	Peak Flow (cfs)
A-A	0.79	0.51	5	10.32	1.25	5.20
B-B	1.13	0.51	5	10.32	1.25	7.43

Swale Design Table (100 Year Return Frequency)													
Section Data							Flow Data						
SECTION	Mannings Coefficient	Channel Slope (%)	Min. Swale Depth (ft)	Left Side Slope (H:V)	Right Side Slope (H:V)	Bottom Width (ft)	Discharge (cfs)	Water Depth (ft)	Flow Area (ft ²)	Velocity (ft/sec)	Wetted Perimeter (ft)	Top Width (ft)	Specific Energy (ft)
A-A	0.03	1.82%	1.32	3:1	3:1	5.00	5.20	0.32	1.91	2.73	7.02	6.92	0.44
B-B	0.03	2.23%	1.39	3:1	3:1	5.00	7.43	0.39	2.41	3.09	7.47	7.34	0.54


ALIGNMENT CURVES								
CURVE ID #	STATION RANGE	START COORD.	END COORD.	RADIUS (FT)	LENGTH (FT)	DELTA	CHORD BEARING	CHORD LENGTH (FT)
C1	13+17.87 13+96.28	N: 981606.17 E: 2814139.82	N: 981558.36 E: 2814087.86	50.00	78.41	089°51'21"	S47°22'55"W	70.62

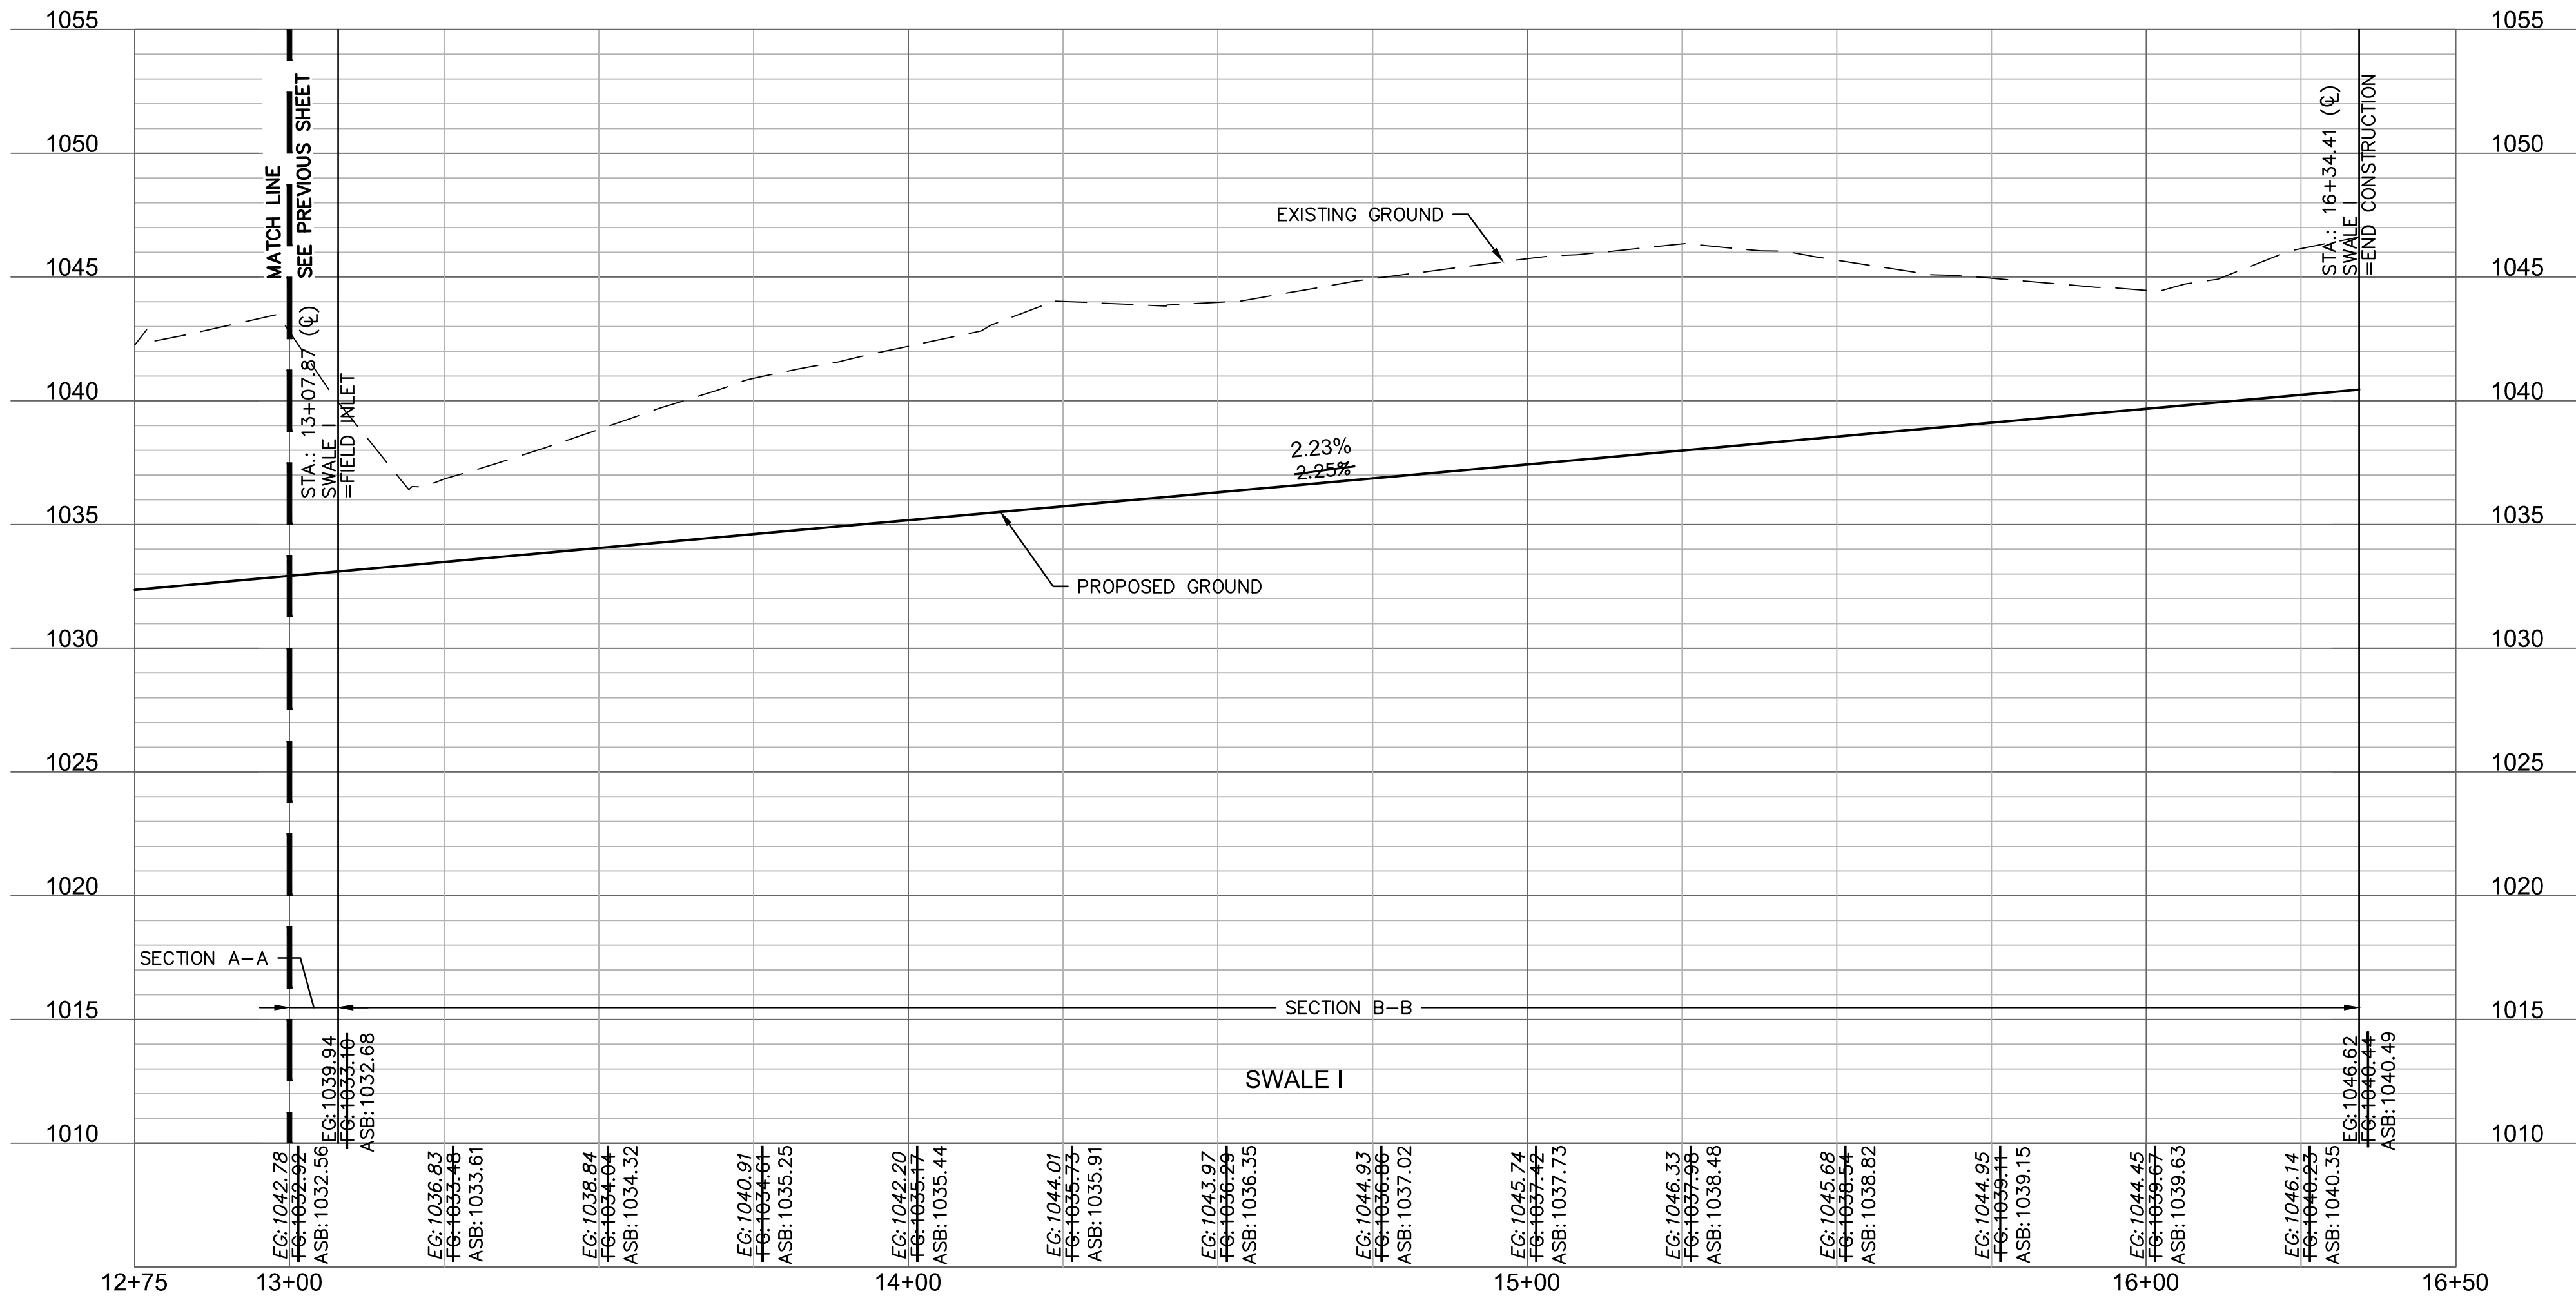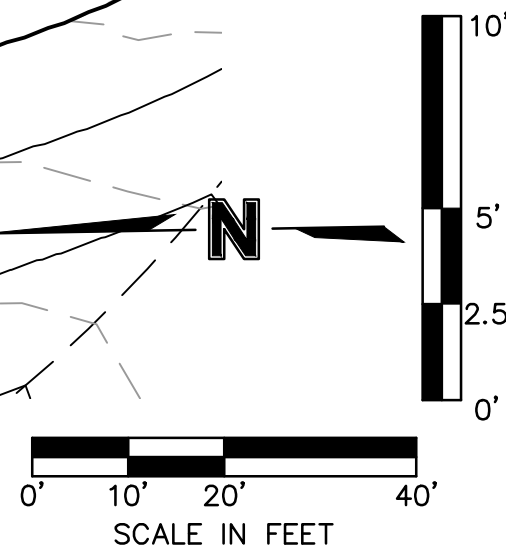

ASBUILT
1/18/2022

Accepted
Record Drawings

These plans have been reviewed for accuracy and are accepted for basic conformance to the approved construction drawings.

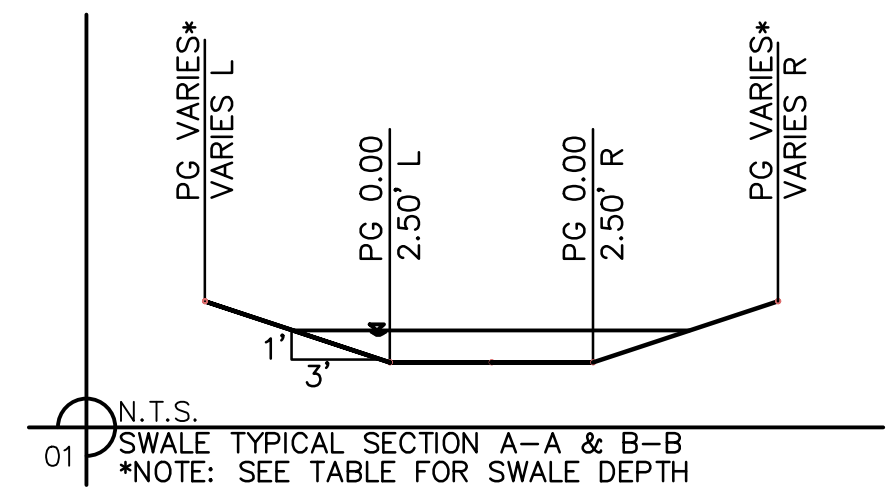

SWALE GRADING NOTES:

- CONTRACTOR SHALL CONSTRUCT SWALES WITH MINIMUM SLOPE, WIDTH AND DEPTH AS SHOWN IN THE SWALE DESIGN TABLES.
- AS-BUILT SURVEY IS REQUIRED/APPROVED BY CITY FOR ALL SWALES AND PRIOR TO APPROVAL FOR ANY BUILDING FOUNDATION PERMIT. CONTRACTOR SHALL BE REQUIRED TO REGRADE SWALES AT CONTRACTOR'S EXPENSE IF ABOVE REQUIREMENTS ARE NOT MET.

Olsson - Civil Engineering
Missouri Certificate of Authority #001592
1301 Burlington Street
North Kansas City, MO 64116
TEL 816.361.1177
www.olsson.com


BY	
REVISIONS DESCRIPTION	
DATE	
REV. NO.	

SWALE PLAN AND PROFILE (CONT) STREET & STORM SEWER PLANS	HAWTHORN RIDGE THIRD PLAT	2020
---	------------------------------	------

drawn by: OLS	checked by: BMW
approved by: BMW	QA/QC by: JES
project no.: A19-1605	drawing no.: C_SWL01_A191605
date: 10/22/2022	

SHEET
C106


DWG: F:\2019\1501-2000\019-1605-A\40-Design\AutoCAD\Final Plans - As-Built\Sheets\GNV\STREET & STORM\AC_RPP01_A191605.dwg USER: bwerthley
DATE: Jan 18, 2022 3:32pm XREFS: C_PTBULK_A191605 C_XBASE_A191605 C_PATT_A191605 C_PBASE_A191605 C_PUTIL_A191605 C_PSURE_A191605 C_PBN DY_A191605

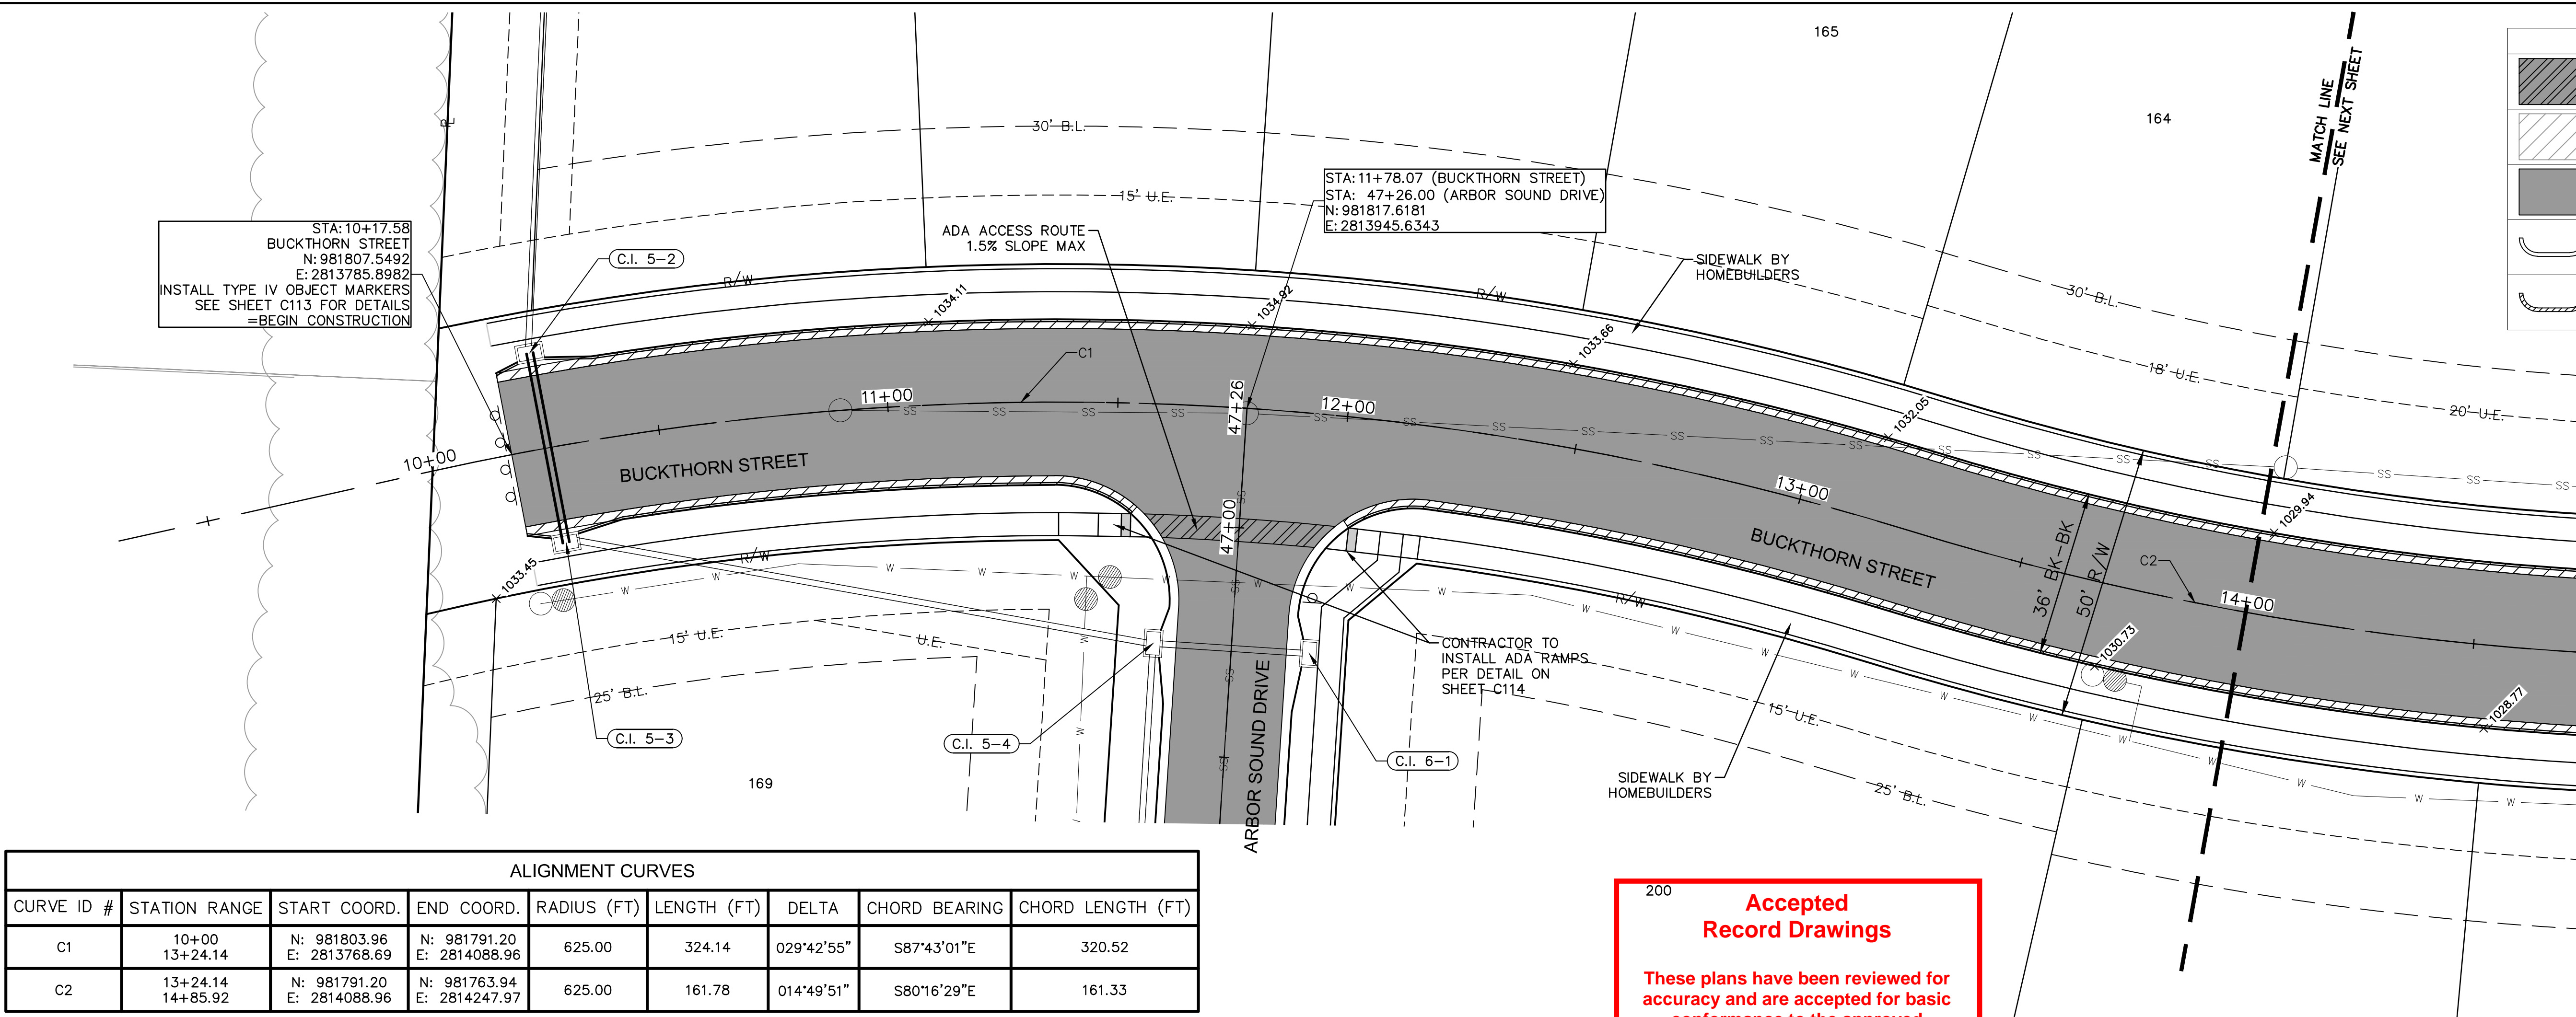



ALIGNMENT CURVES								
CURVE ID #	STATION RANGE	START COORD.	END COORD.	RADIUS (FT)	LENGTH (FT)	DELTA	CHORD BEARING	CHORD LENGTH (FT)
C1	10+00 13+24.14	N: 981803.96 E: 2813768.69	N: 981791.20 E: 2814088.96	625.00	324.14	029°42'55"	S87°43'01"E	320.52
C2	13+24.14 14+85.92	N: 981791.20 E: 2814088.96	N: 981763.94 E: 2814247.97	625.00	161.78	014°49'51"	S80°16'29"E	161.33

200
**Accepted
Record Drawings**

These plans have been reviewed for
accuracy and are accepted for basic
conformance to the approved
construction drawings.

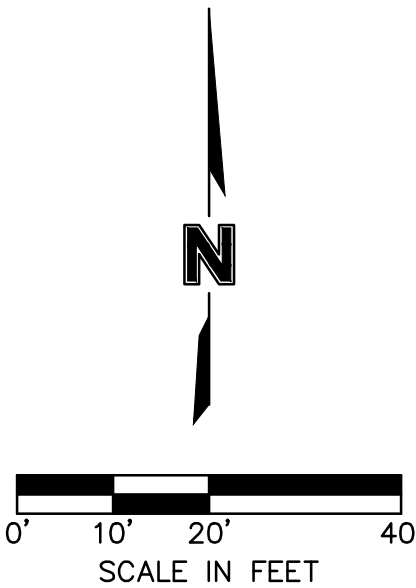

ASBUILT
1/18/2022

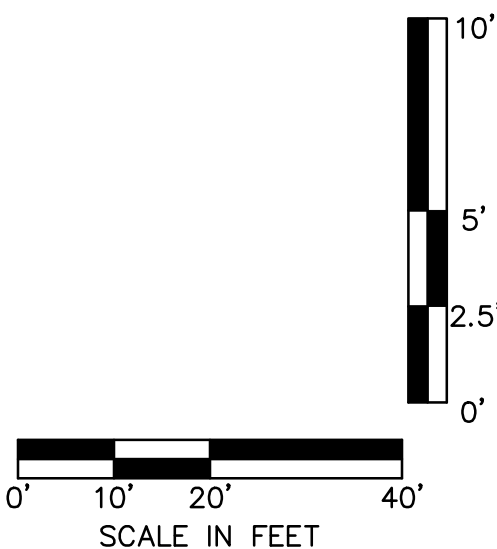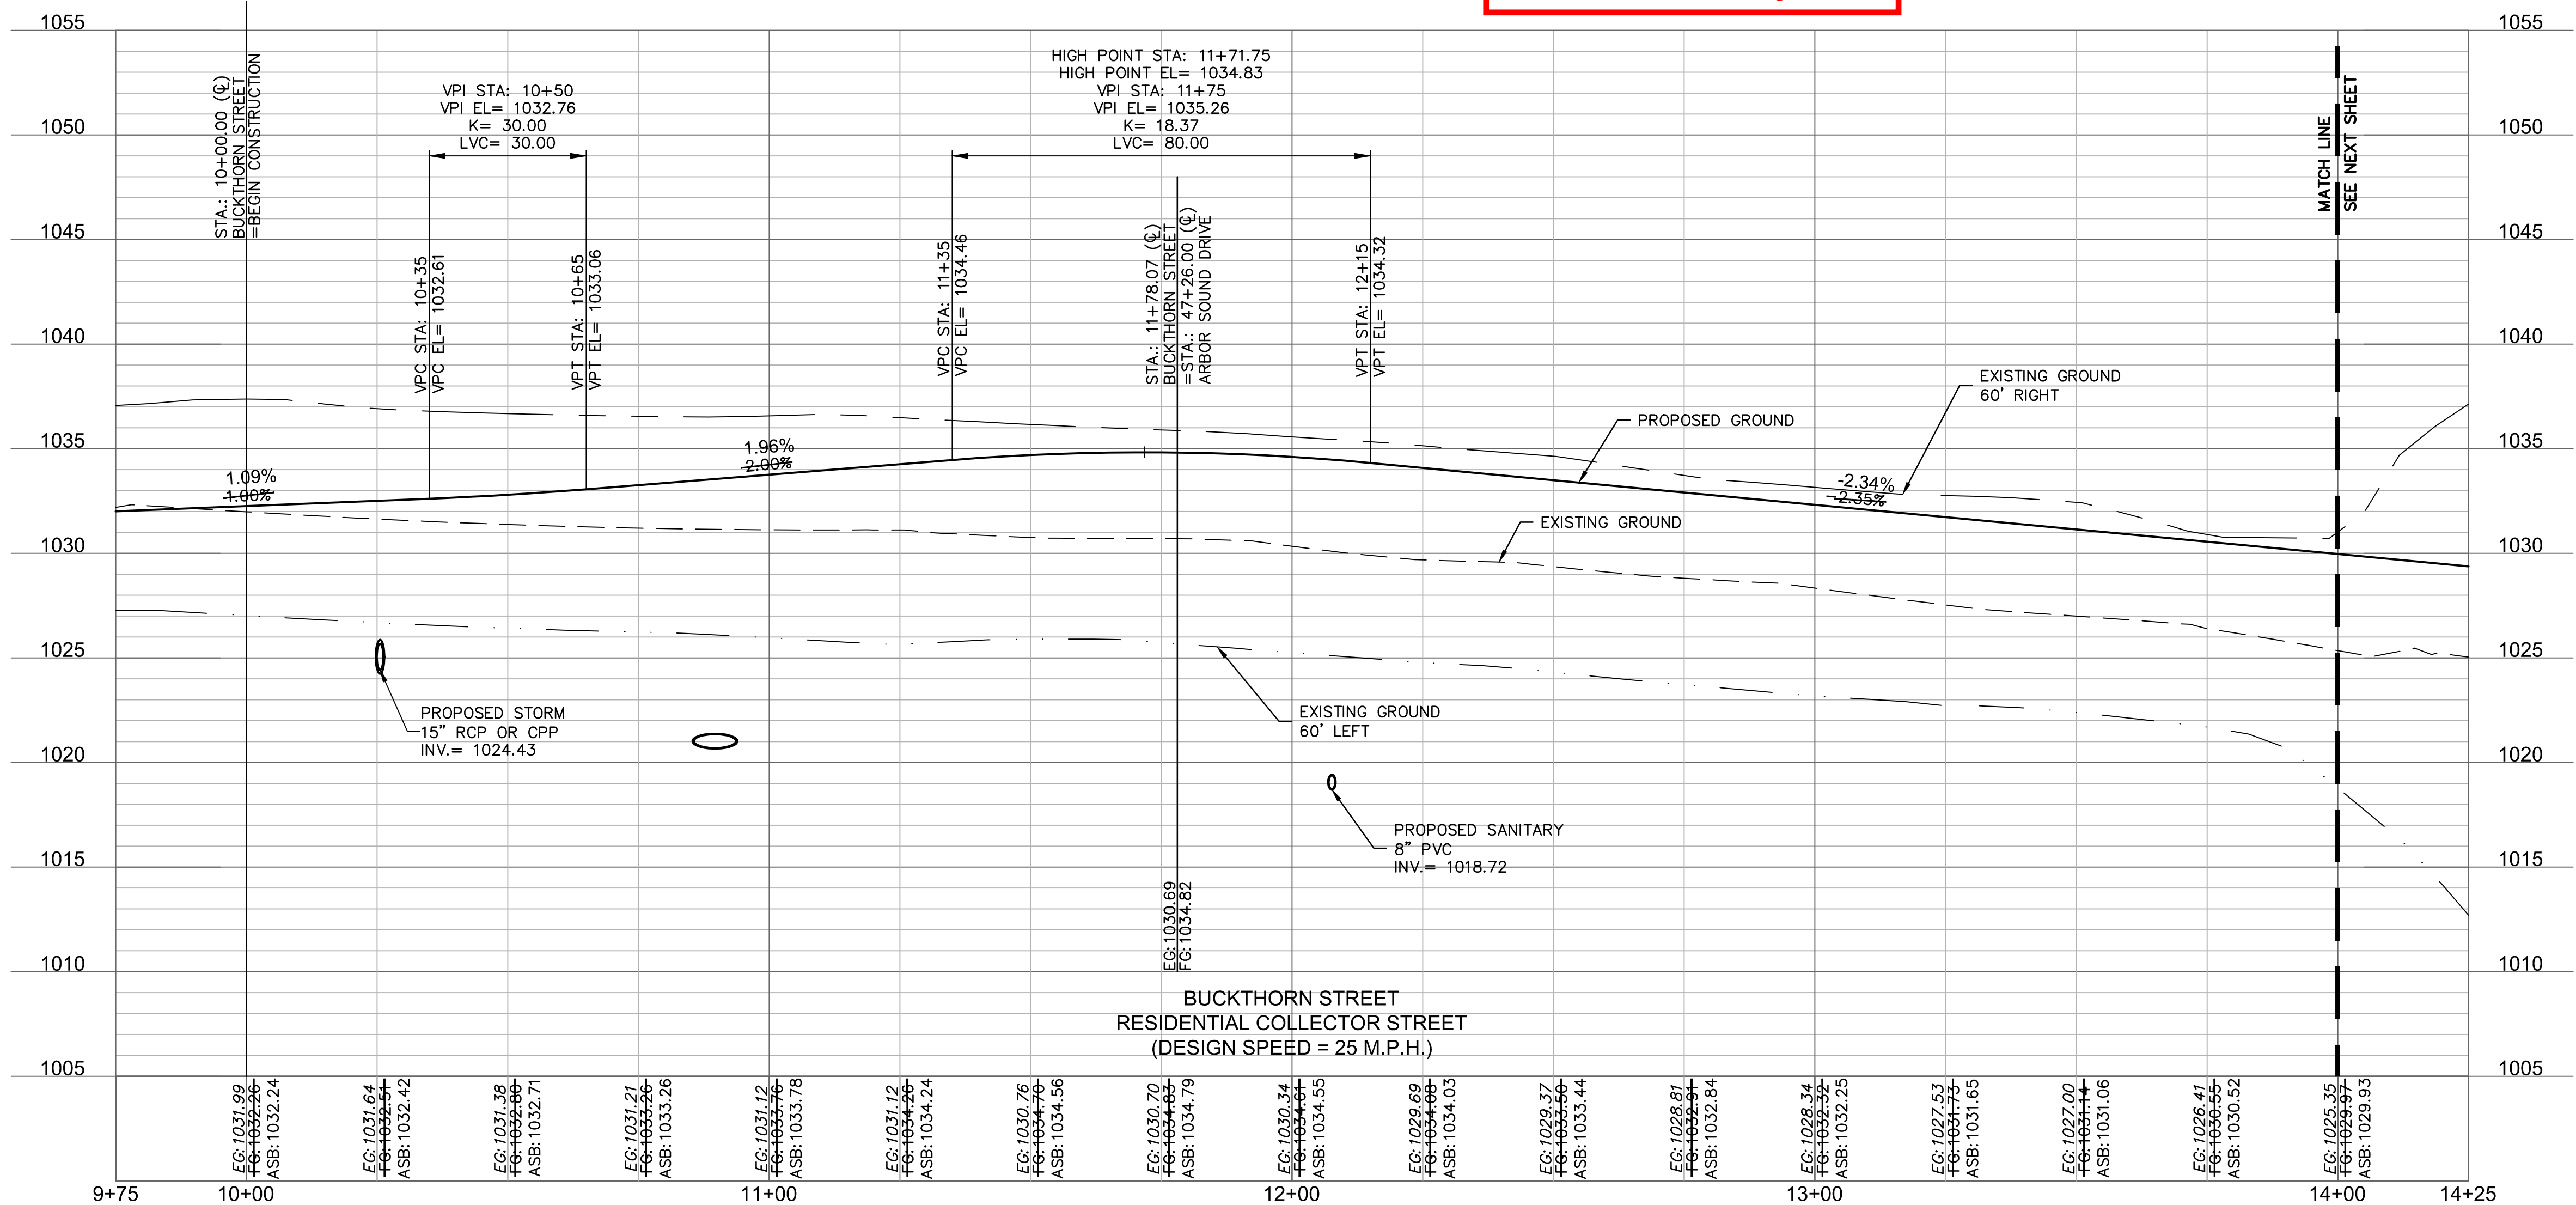

olsson

Olsson - Civil Engineering
Missouri Certificate of Authority #001592
1301 Burlington Street
North Kansas City, MO 64116
TEL 816.361.1177
www.olsson.com

STATE OF MISSOURI
BROCK M. WORTHLEY
NUMBER
PE-2019000237
1/18/2022
PROFESSIONAL ENGINEER

BY

REVISIONS DESCRIPTION
REVISED PER CITY COMMENTS

DATE
11/23/2020

REV. NO.

ROADWAY PLAN AND PROFILE (BUCKTHORN STREET)
STREET & STORM SEWER PLANS



HAWTHORN RIDGE
THIRD PLAT

LEE'S SUMMIT, MO

drawn by: OLS
checked by: BMW
approved by: BMW
QA/QC by: JES
project no.: A19-1605
drawing no.: C_RPP01_A191605
date: 10/22/2020

SHEET
C107

DWG: F:\2019\1501-2000\019-1605-A\40-Design\AutoCAD\Final Plans - As-Built\Sheets\GNCA\STREET & STORM\AC_RPP02_A191605.dwg USER: bworthley C_PATT_A191605 C_PBASE_A191605 C_PUTIL_A191605 C_PSURF_A191605 C_PBDY_A191605
DATE: Jan 18, 2022 3:32pm XREFS: C_PTBULK_A191605

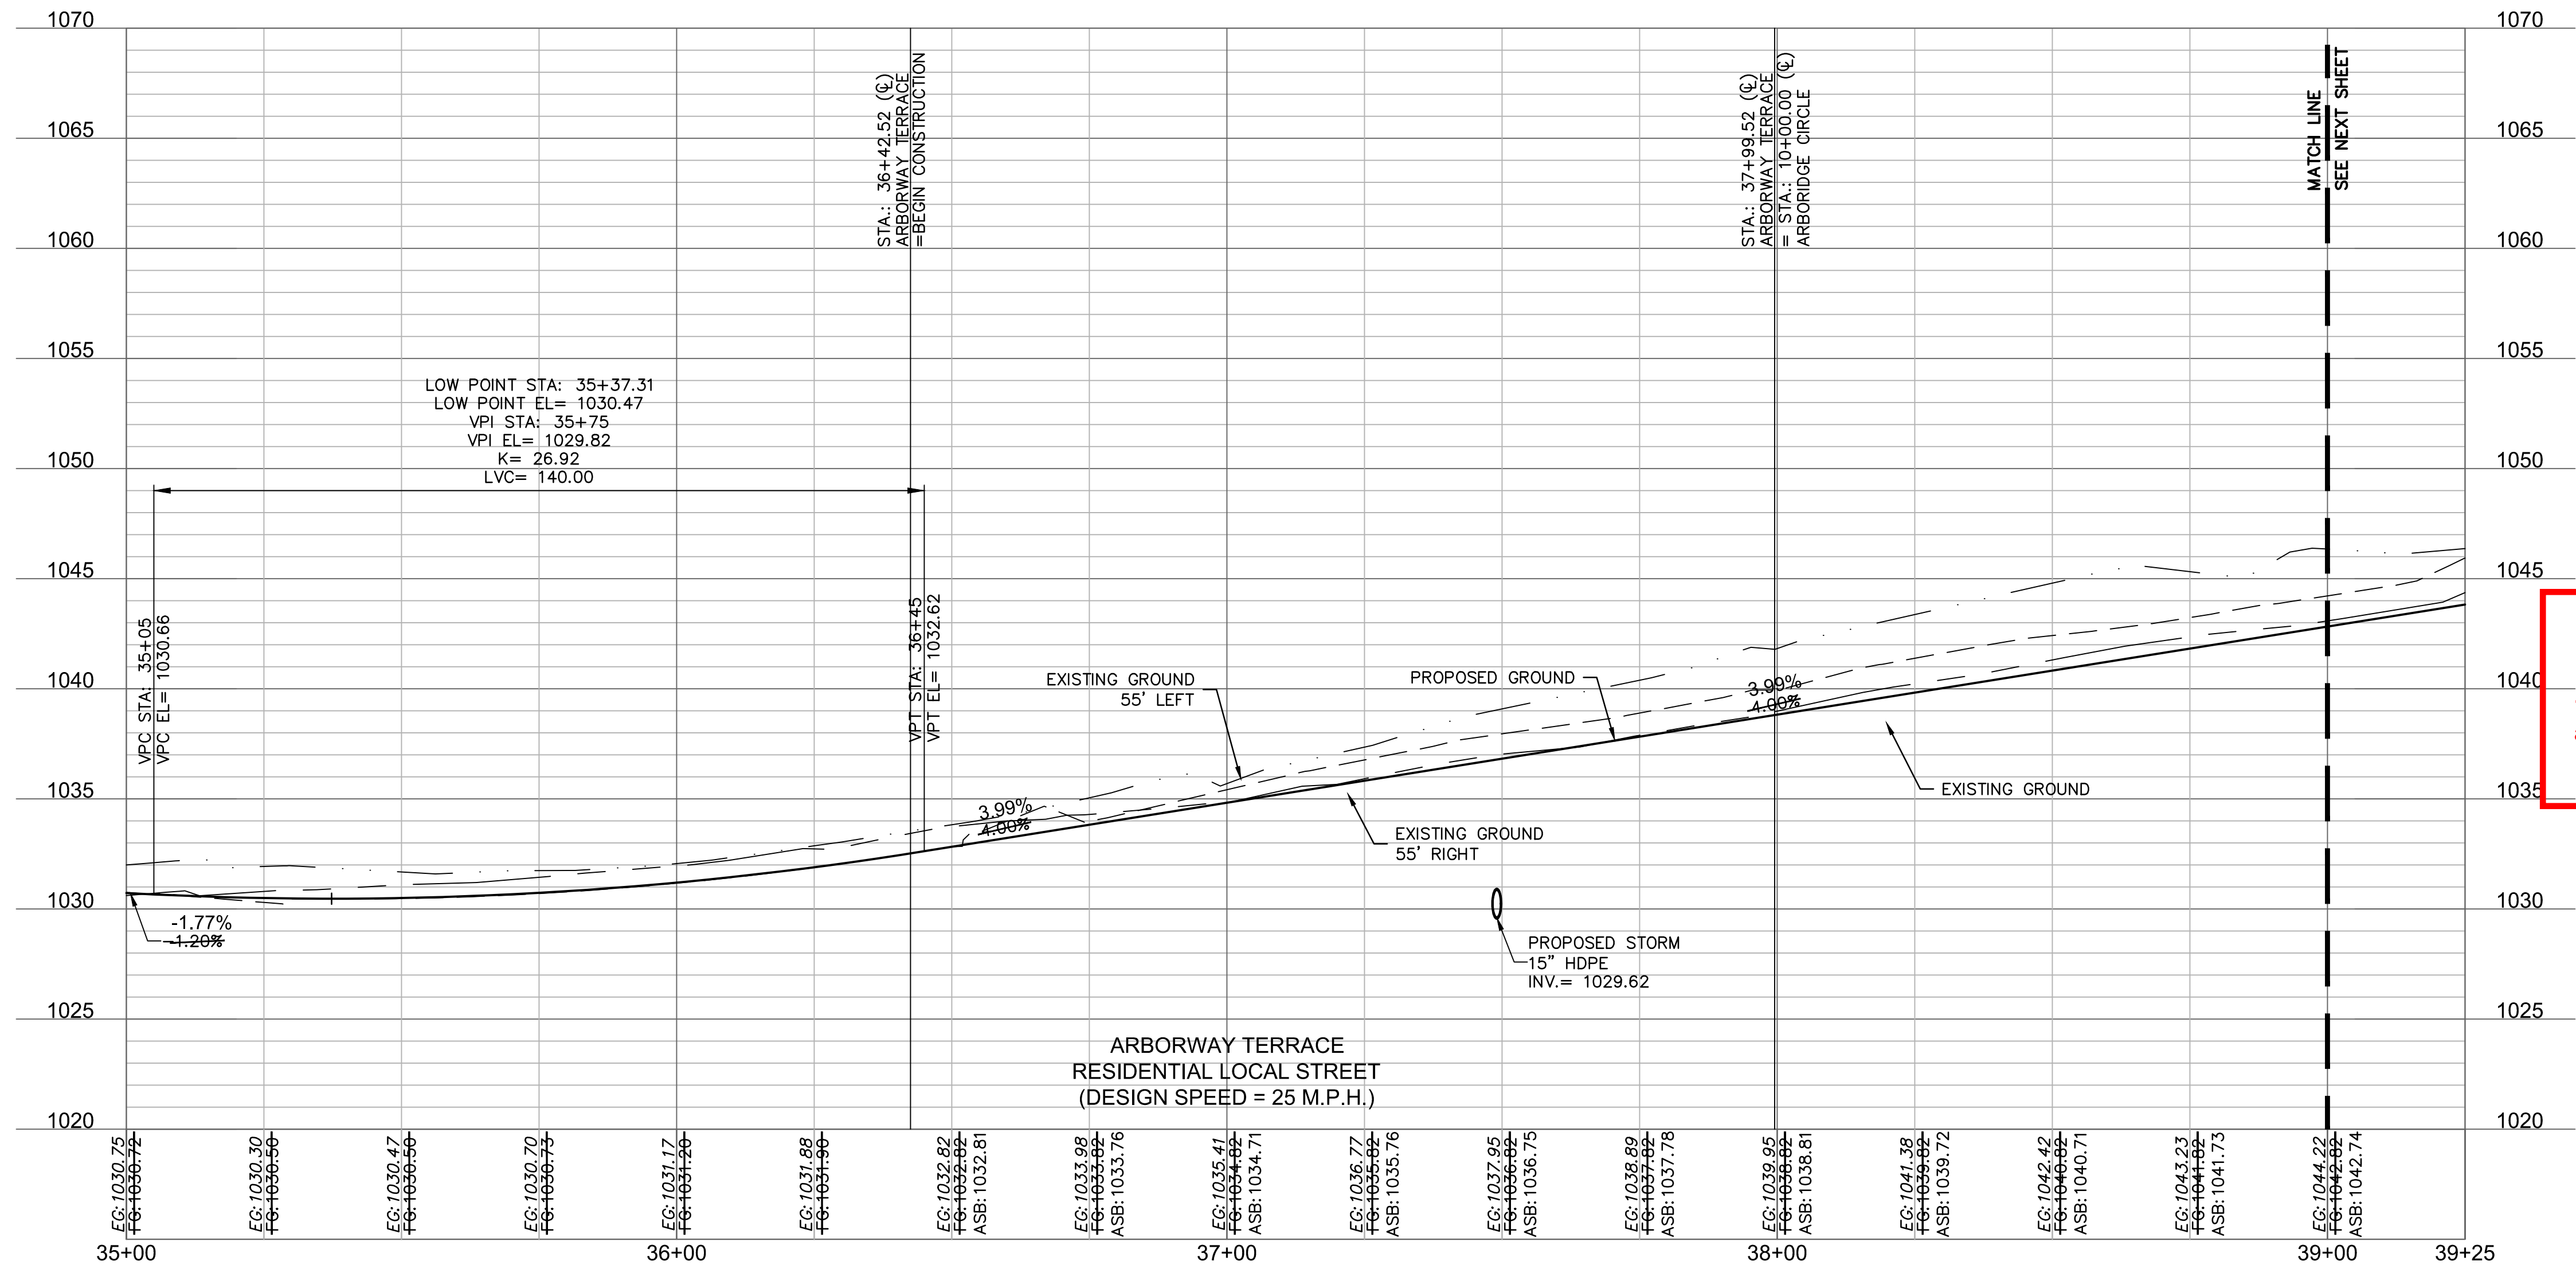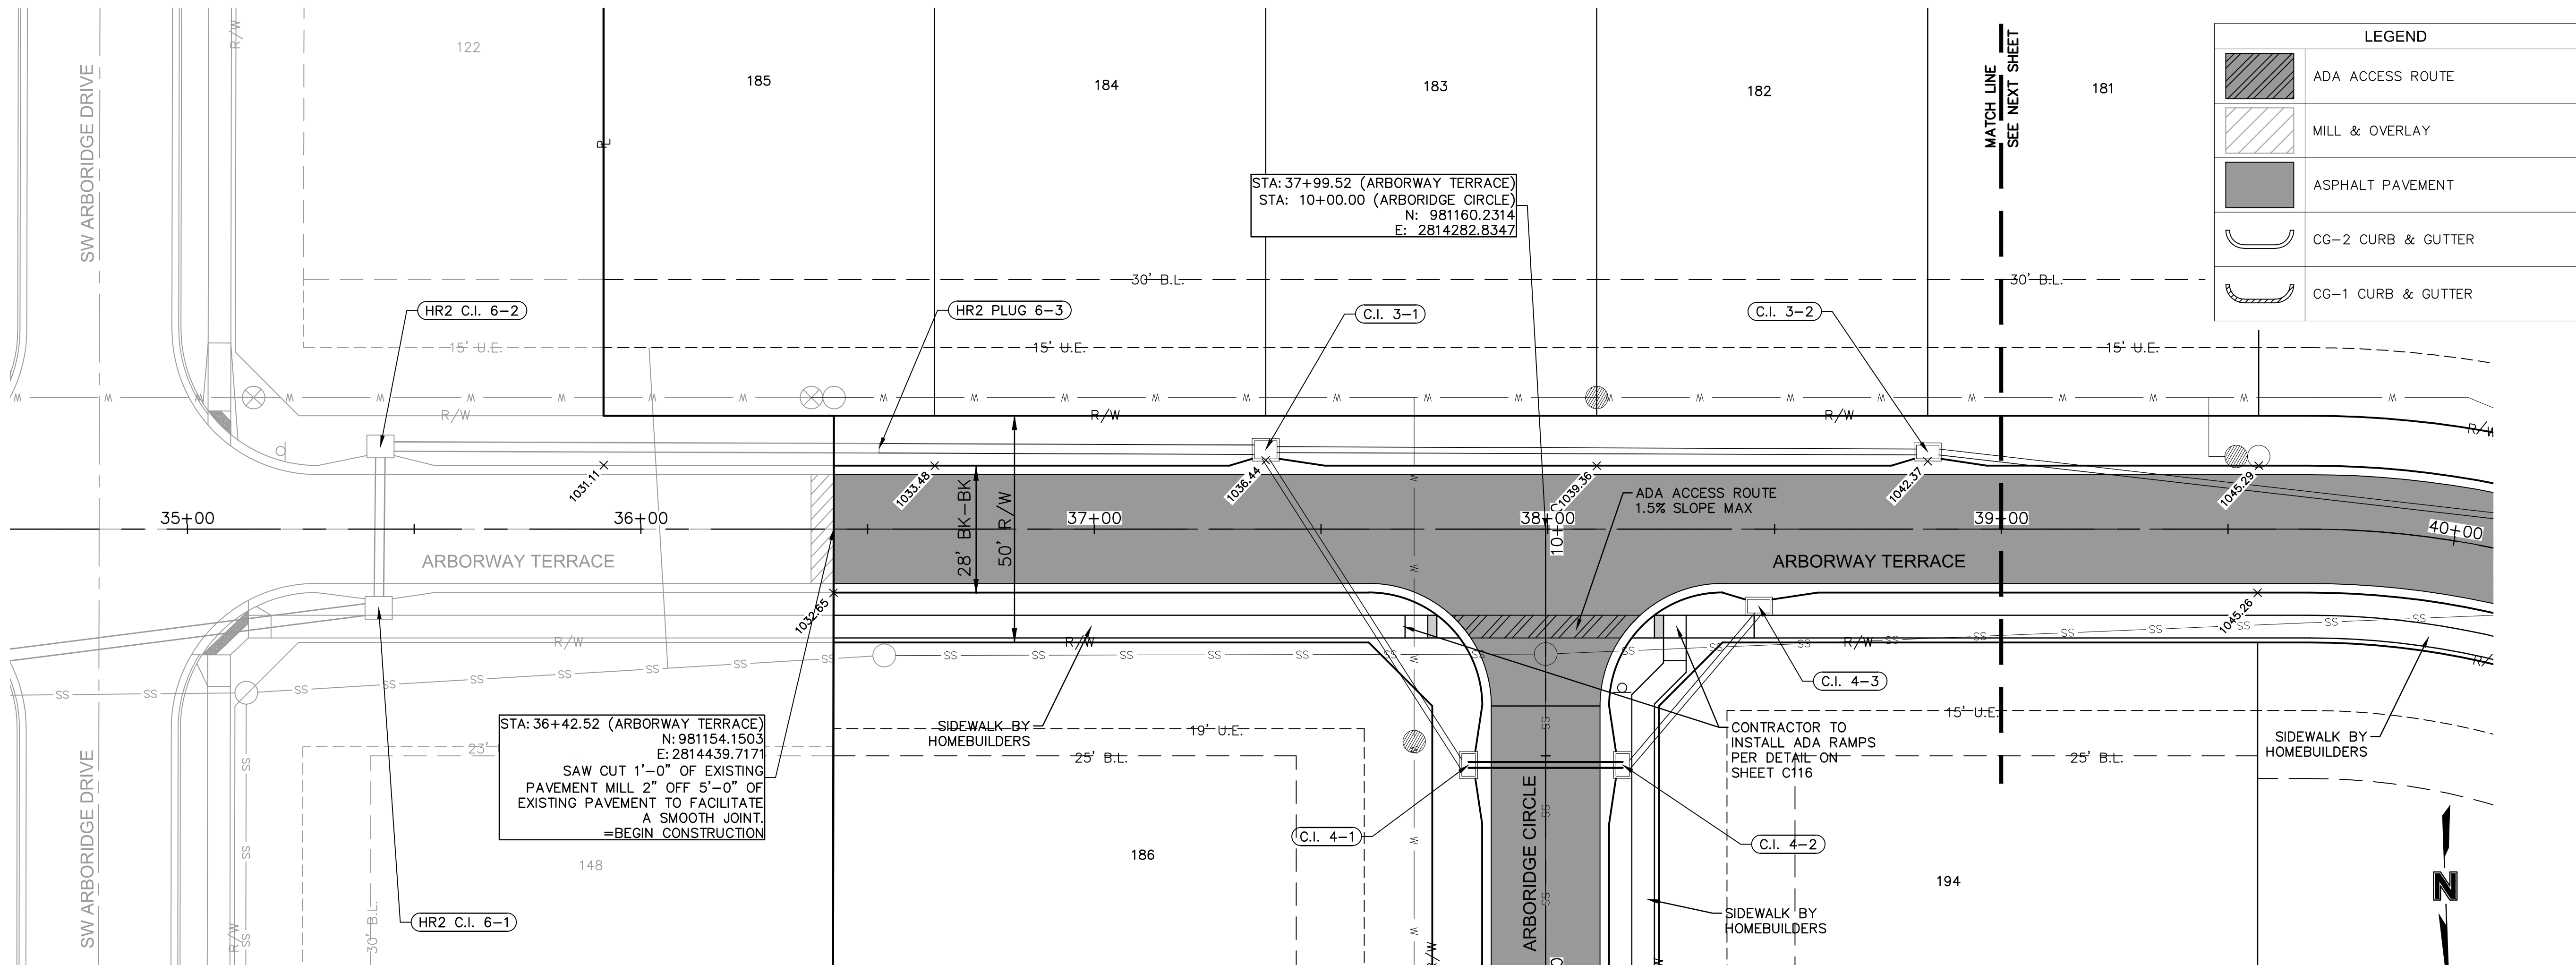

ASBUILT
1/18/2022

Accepted
Record Drawings

These plans have been reviewed for
accuracy and are accepted for basic
conformance to the approved
construction drawings.

olsson

Olsson - Civil Engineering
Missouri Certificate of Authority #001592
1301 Burlington Street
North Kansas City, MO 64116
TEL 816.361.1177
www.olsosn.com

STATE OF MISSOURI
BROCK M. WORTHLEY
PE-2019000237
1/18/2022
PROFESSIONAL ENGINEER

REV.	NO.	DATE	REVISIONS DESCRIPTION
1	1	11/23/2020	REVISED PER CITY COMMENTS

ROADWAY PLAN AND PROFILE (ARBORWAY TERRACE)
STREET & STORM SEWER PLANS

HAWTHORN RIDGE
THIRD PLAT

LEE'S SUMMIT, MO

drawn by: OLS
checked by: BMW
approved by: BMW
QA/QC by: JES
project no.: A19-1605
drawing no.: C_RPP02_A191605
date: 10/02/2020


SHEET
C109

REVISIONS


2020

DWG: F:\2019\1501-2000\019-1605-A\40-Design\AutoCAD\Final Plans - As-Built\Sheets\GNCA\STREET & STORM\AC_RPP02_A191605.dwg USER: bworthley C:\PATT_A191605
DATE: Jan 18, 2022 3:32pm XREFS: C:\PBLK_A191605 C:\PBASE_A191605 C:\PURL_A191605 C:\PSURF_A191605 C:\PBDY_A191605


LEGEND	
ADA ACCESS ROUTE	
MILL & OVERLAY	
ASPHALT PAVEMENT	
CG-2 CURB & GUTTER	
CG-1 CURB & GUTTER	

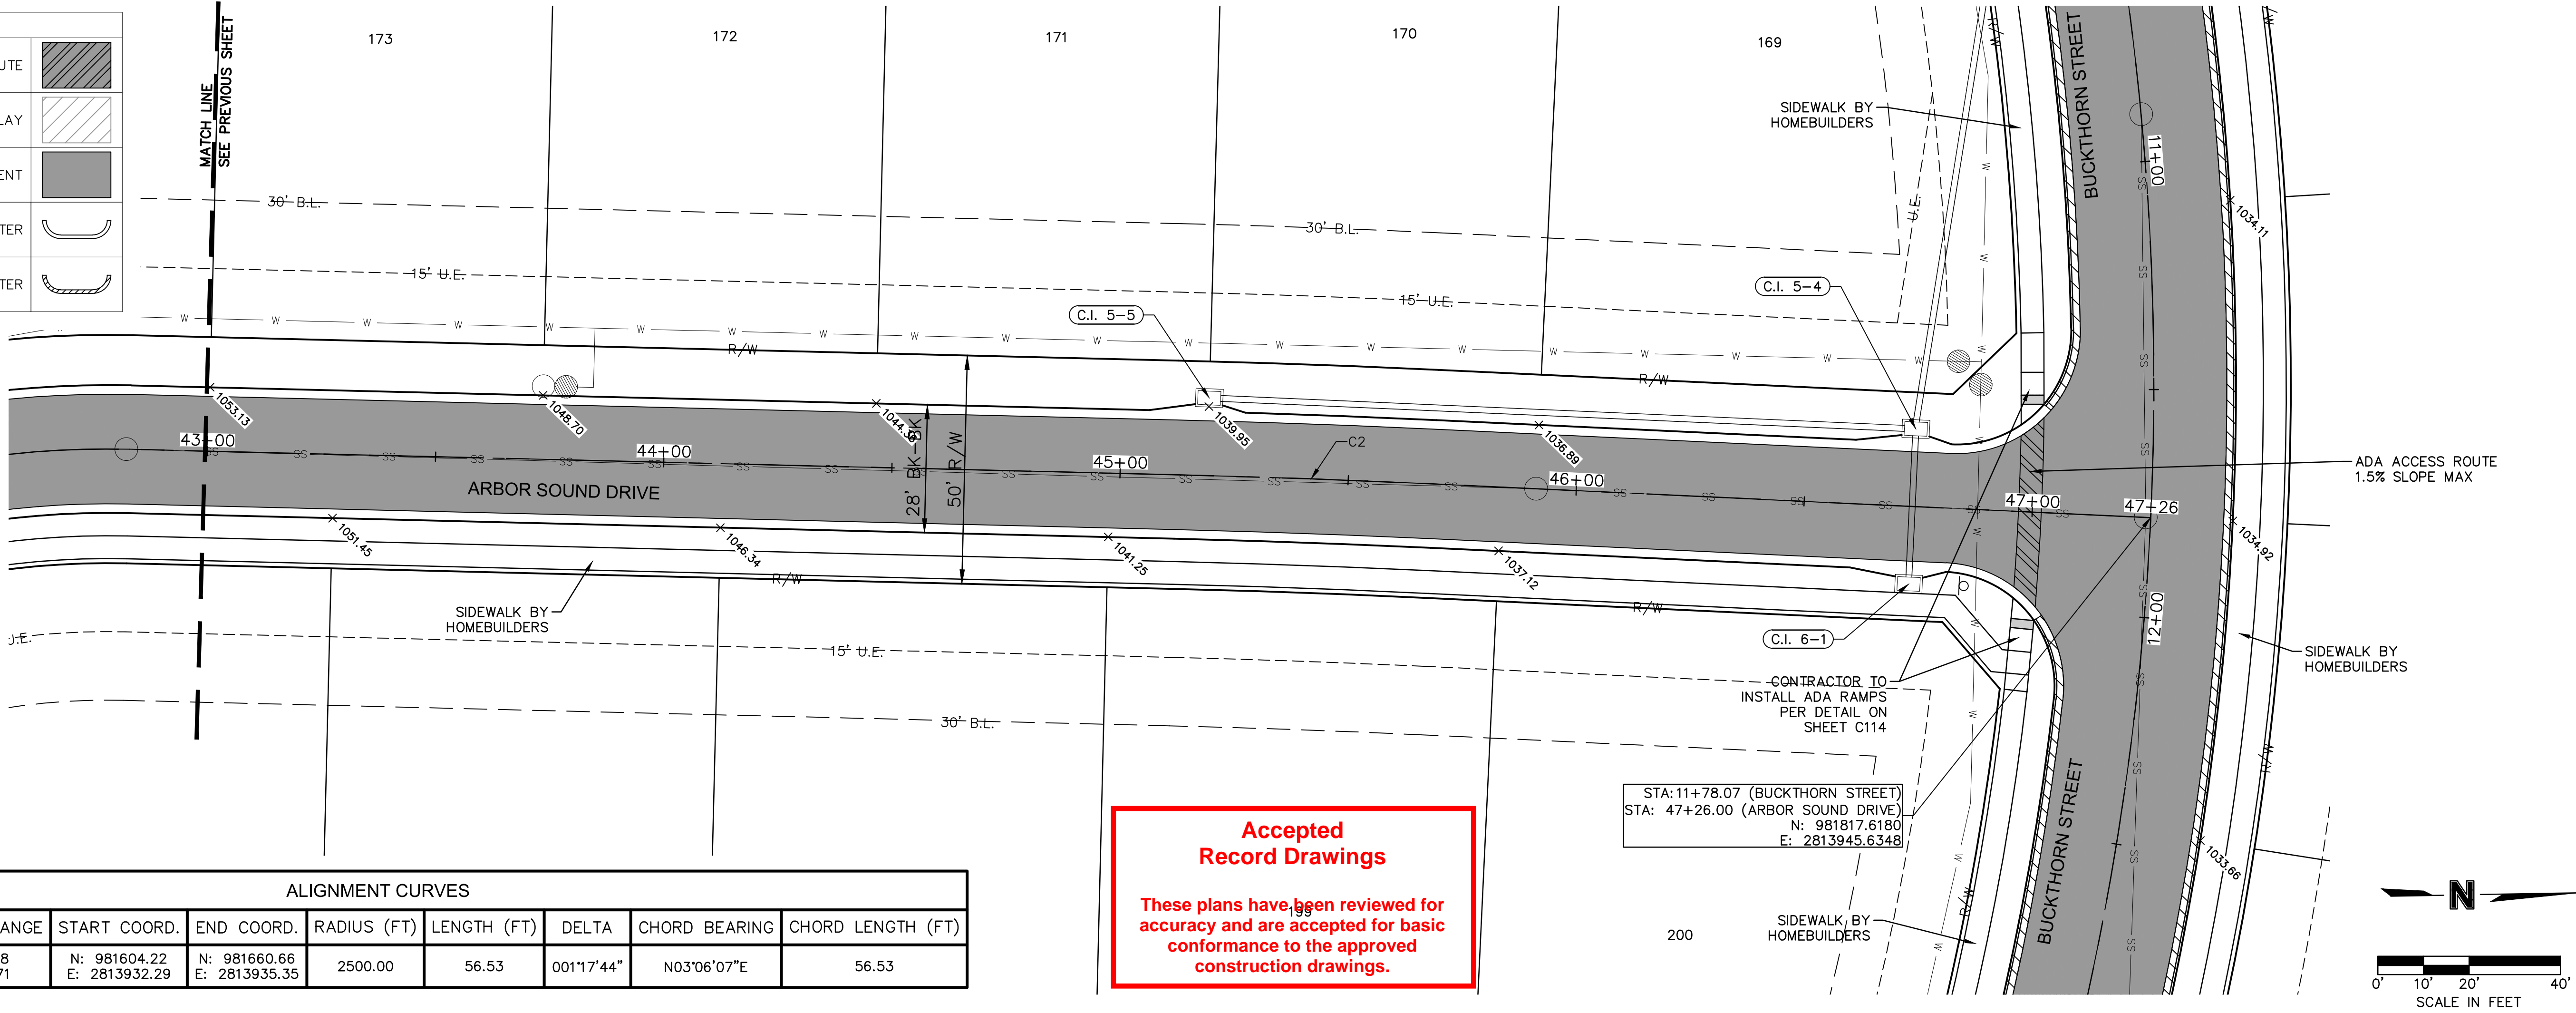

ALIGNMENT CURVES								
CURVE ID #	STATION RANGE	START COORD.	END COORD.	RADIUS (FT)	LENGTH (FT)	DELTA	CHORD BEARING	CHORD LENGTH (FT)
C2	45+12.18 45+68.71	N: 981604.22 E: 2813932.29	N: 981660.66 E: 2813935.35	2500.00	56.53	001°17'44"	N03°06'07"E	56.53

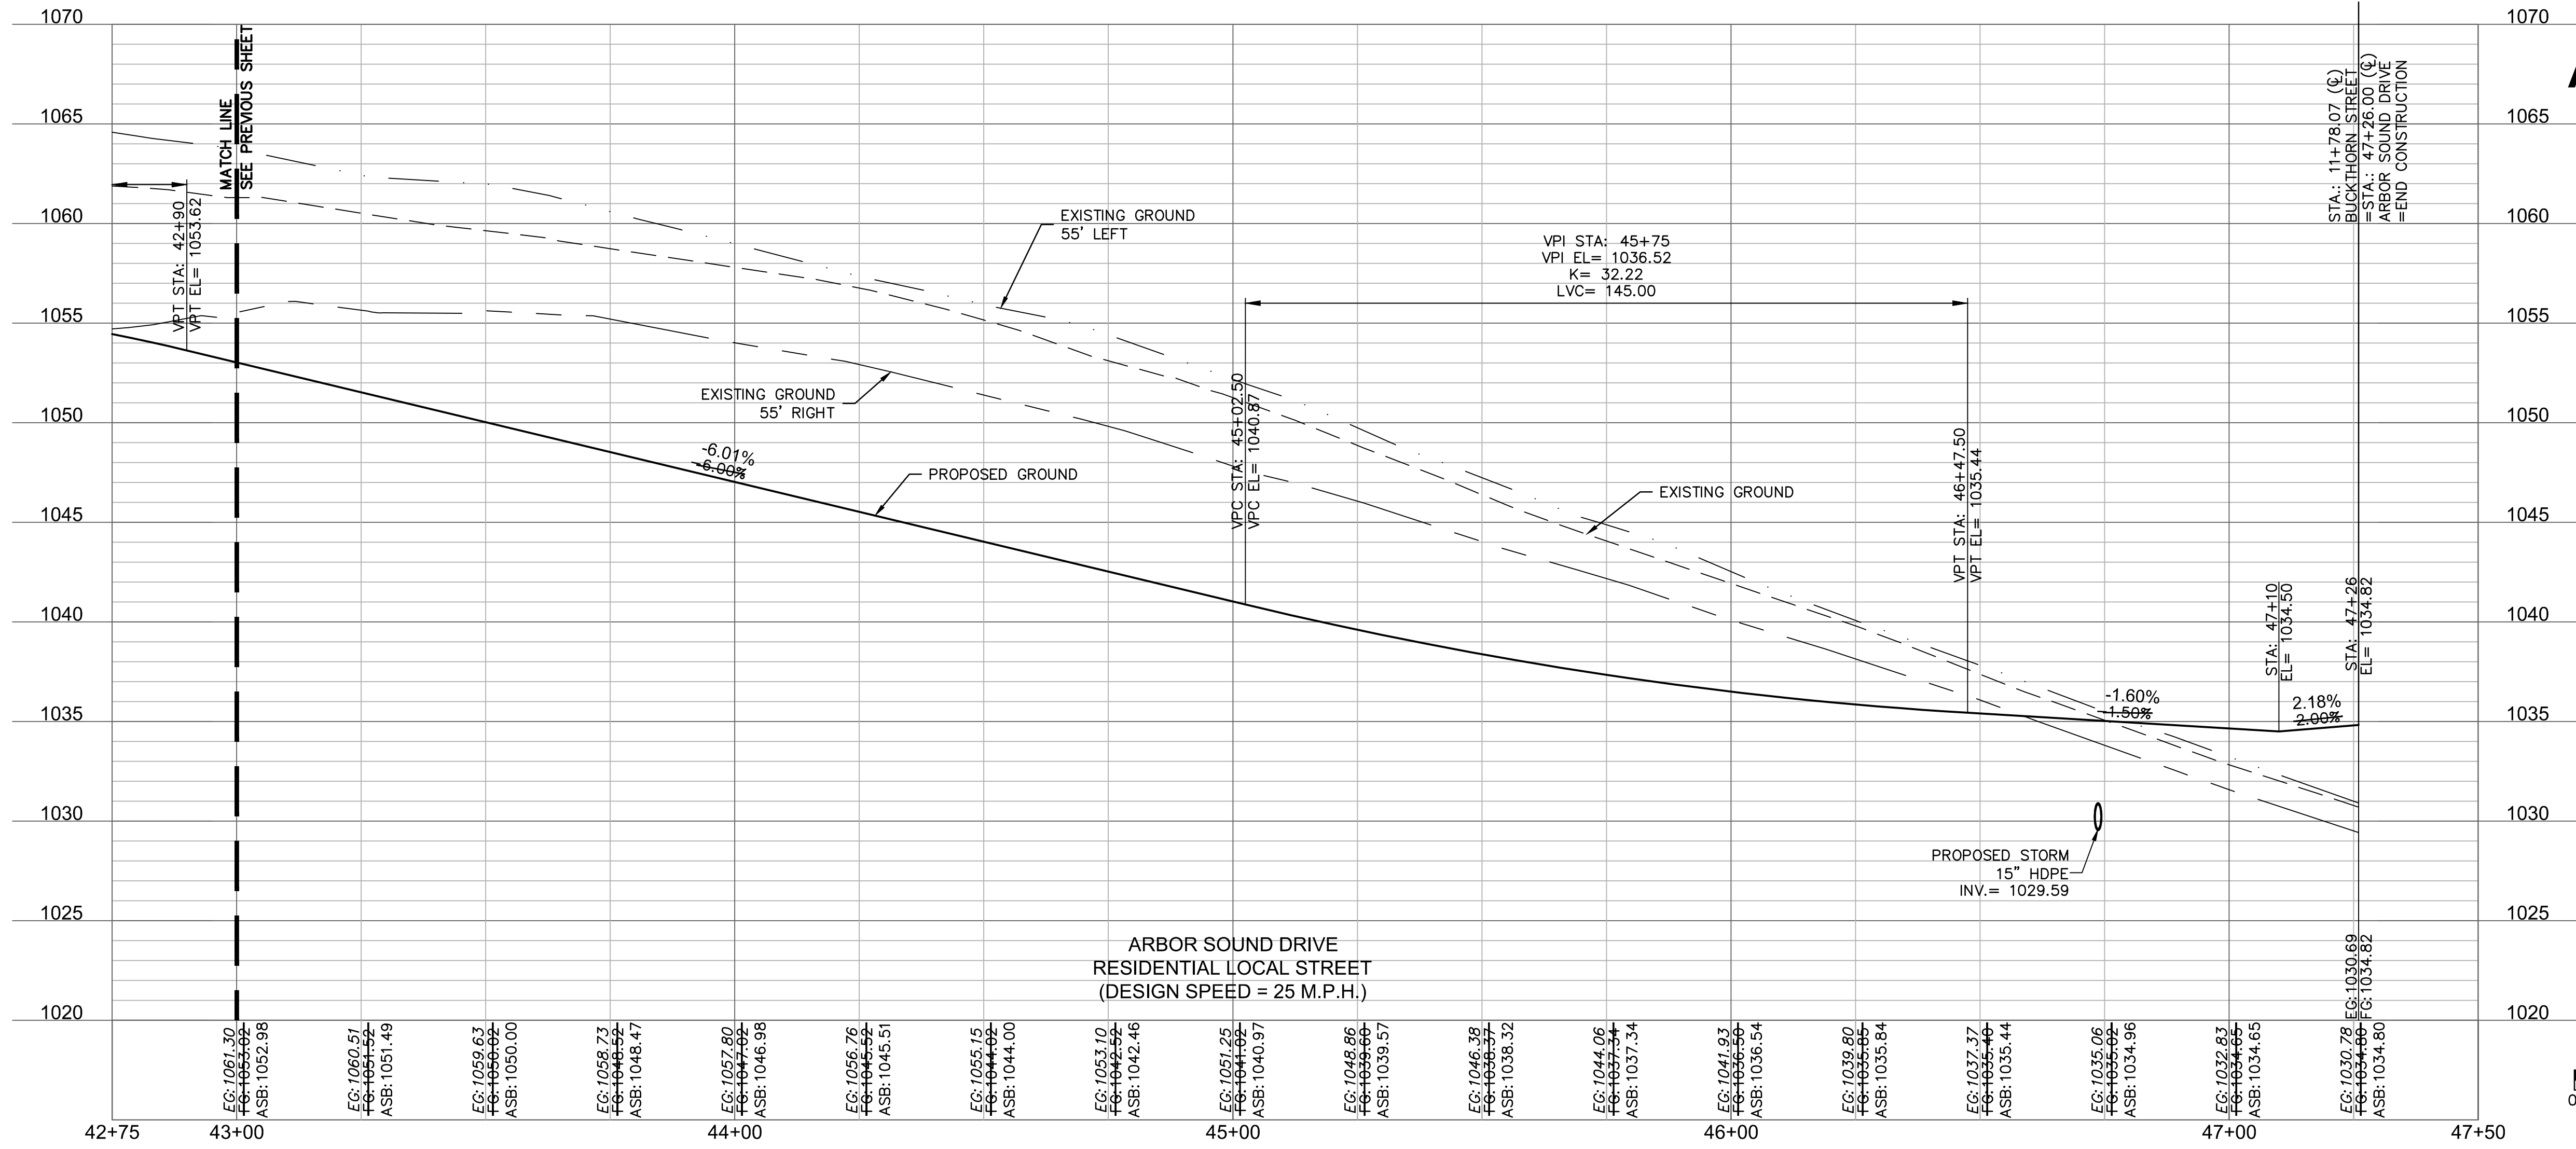

ASBUILT
1/18/2022

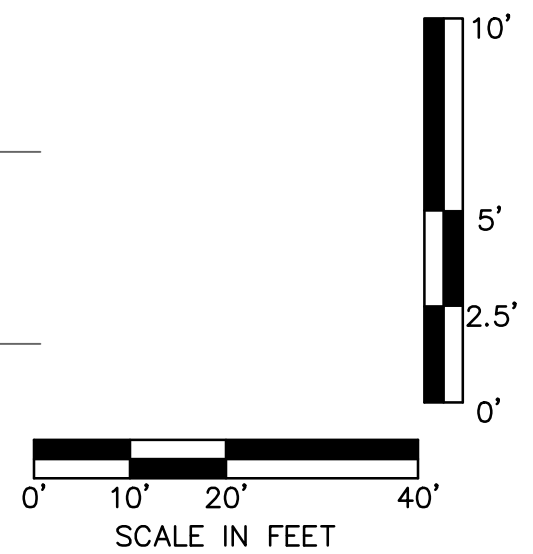

Olsson - Civil Engineering
Missouri Certificate of Authority #001592
1301 Burlington Street
North Kansas City, MO 64116
TEL 816.361.1177
www.olsosn.com

BY	REVISIONS DESCRIPTION	DATE	REV. NO.	2020
	REVISED PER CITY COMMENTS	11/23/2020		

ROADWAY PLAN AND PROFILE (ARBORWAY TERRACE CONT)
STREET & STORM SEWER PLANS


HAWTHORN RIDGE
THIRD PLAT

LEE'S SUMMIT, MO


drawn by: OLS
checked by: BMW
approved by: BMW
QA/QC by: JES
project no.: A19-1605
drawing no.: C_RPP02_A191605
date: 10/02/2020

SHEET
C111

DWG: F:\2019\1501-2000\019-1605-A\40-Design\AutoCAD\Final Plans - As-Built\Sheets\CONV\STREET & STORM\AC_RPP03_A191605.dwg USER: bwerthley
DATE: Jan 18, 2022 3:33pm XREFS: C:\PTBLK_A191605 C:\XBASE_A191605 C:\PATT_A191605 C:\PSURF_A191605 C:\PBNDY_A191605

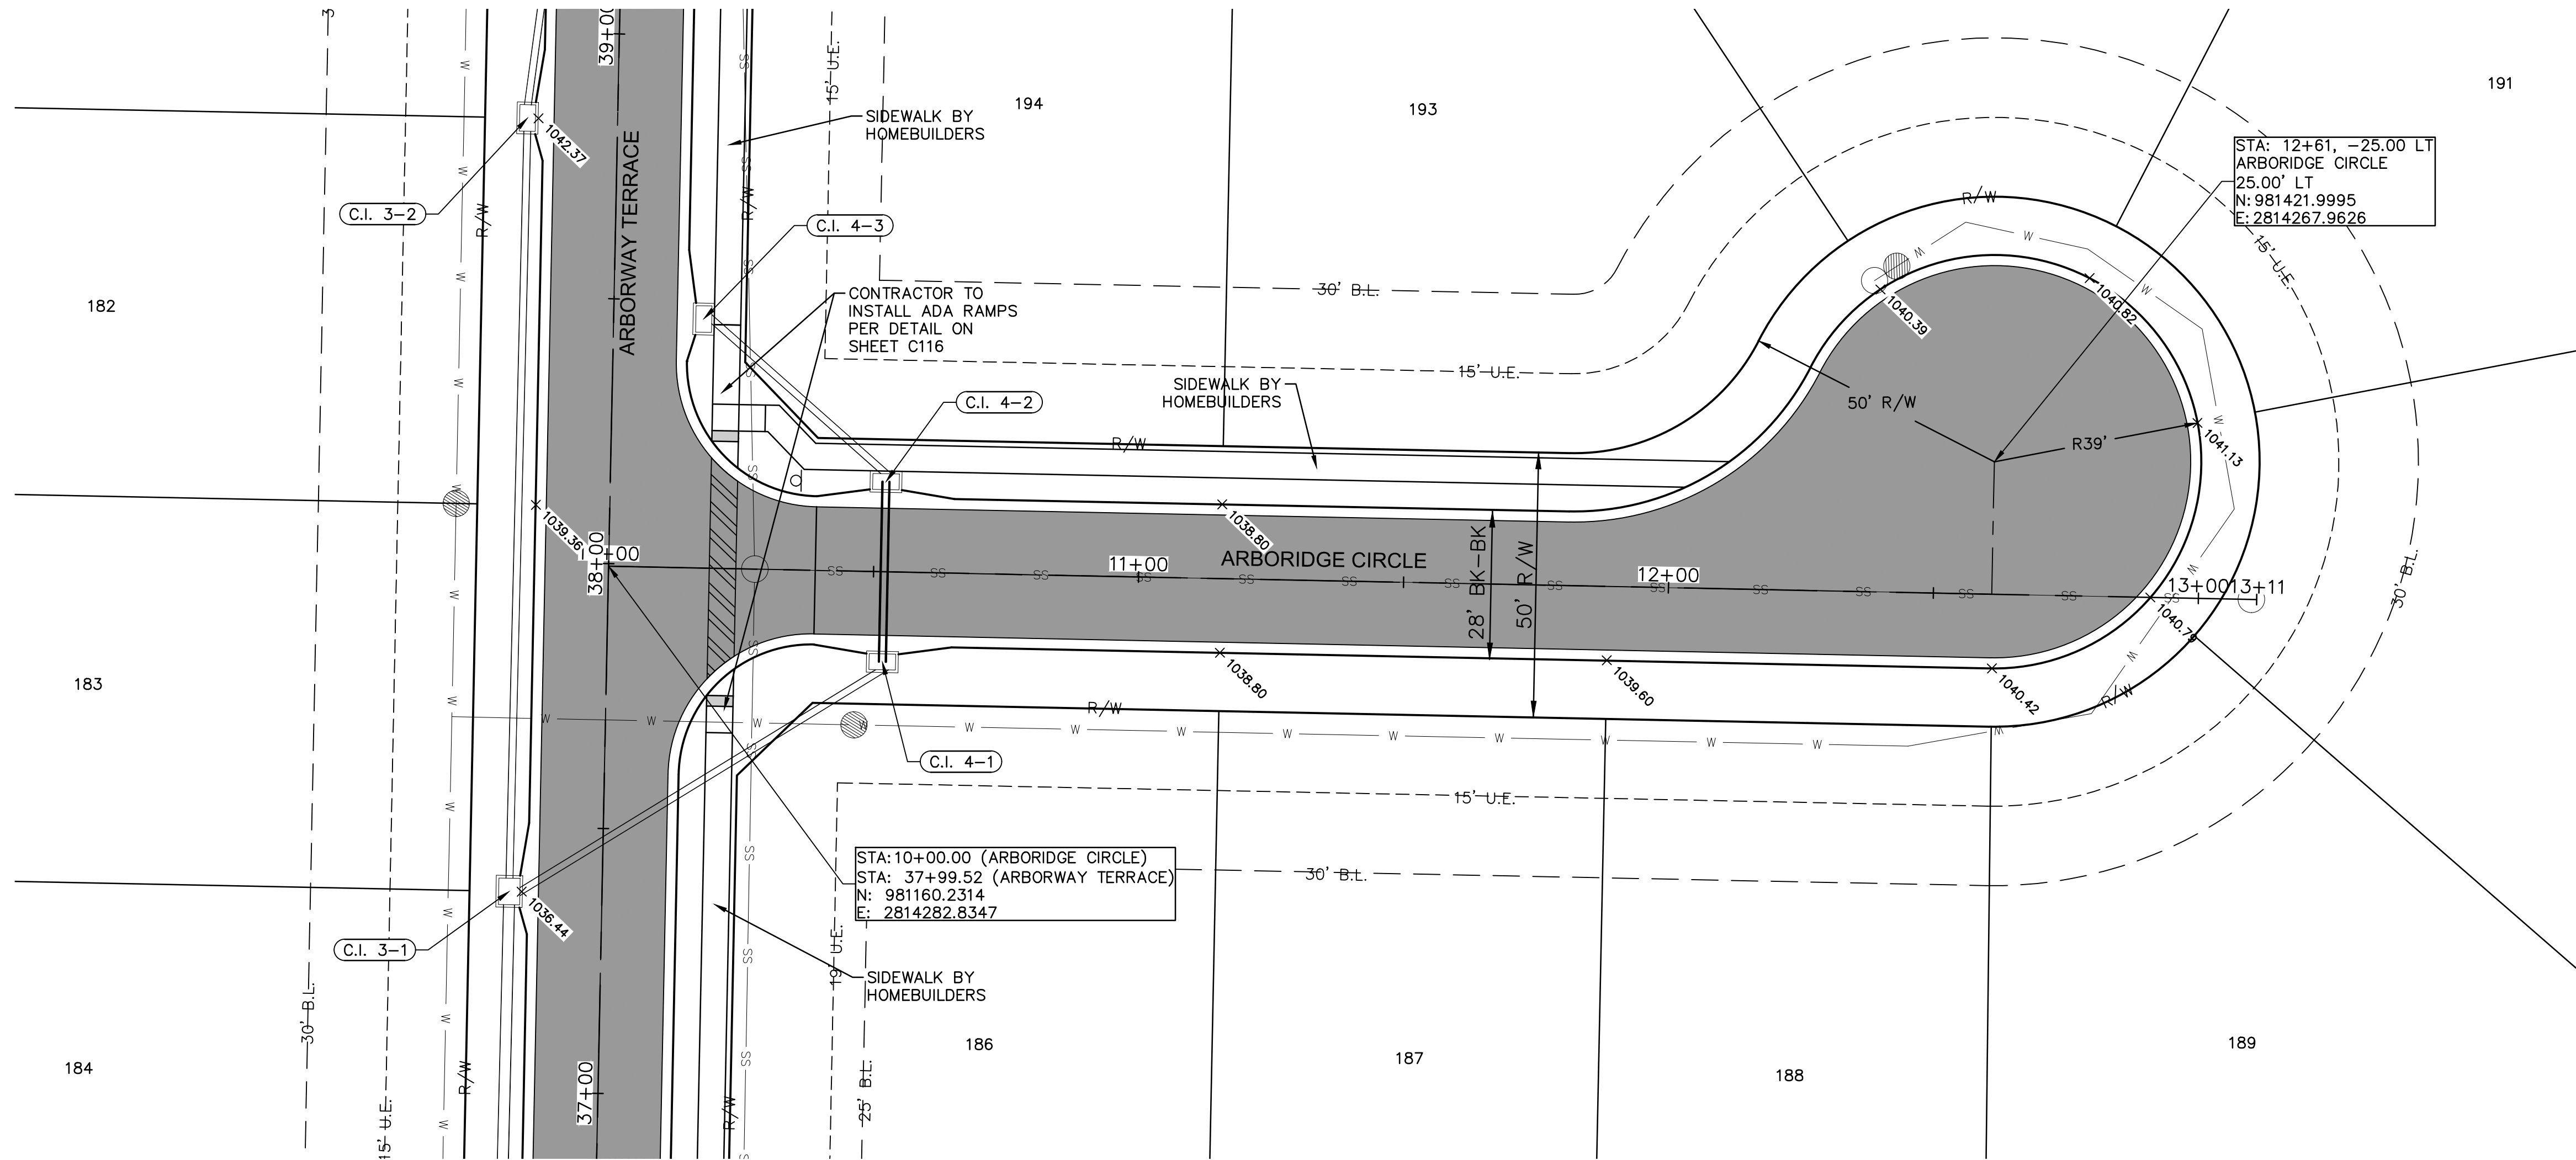



LEGEND	
	ADA ACCESS ROUTE
	MILL & OVERLAY
	ASPHALT PAVEMENT
	CG-2 CURB & GUTTER
	CG-1 CURB & GUTTER

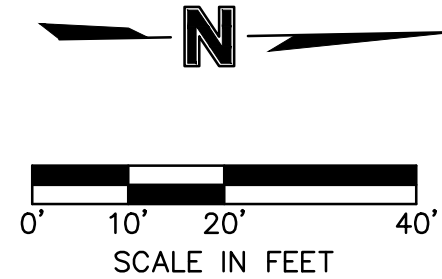

ASBUILT
1/18/2022

Accepted
Record Drawings

These plans have been reviewed for accuracy and are accepted for basic conformance to the approved construction drawings.

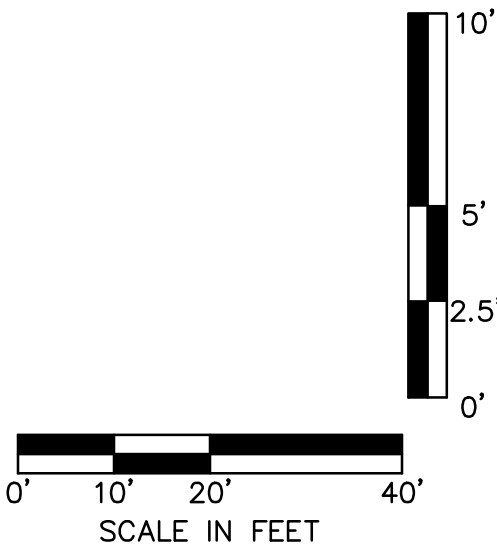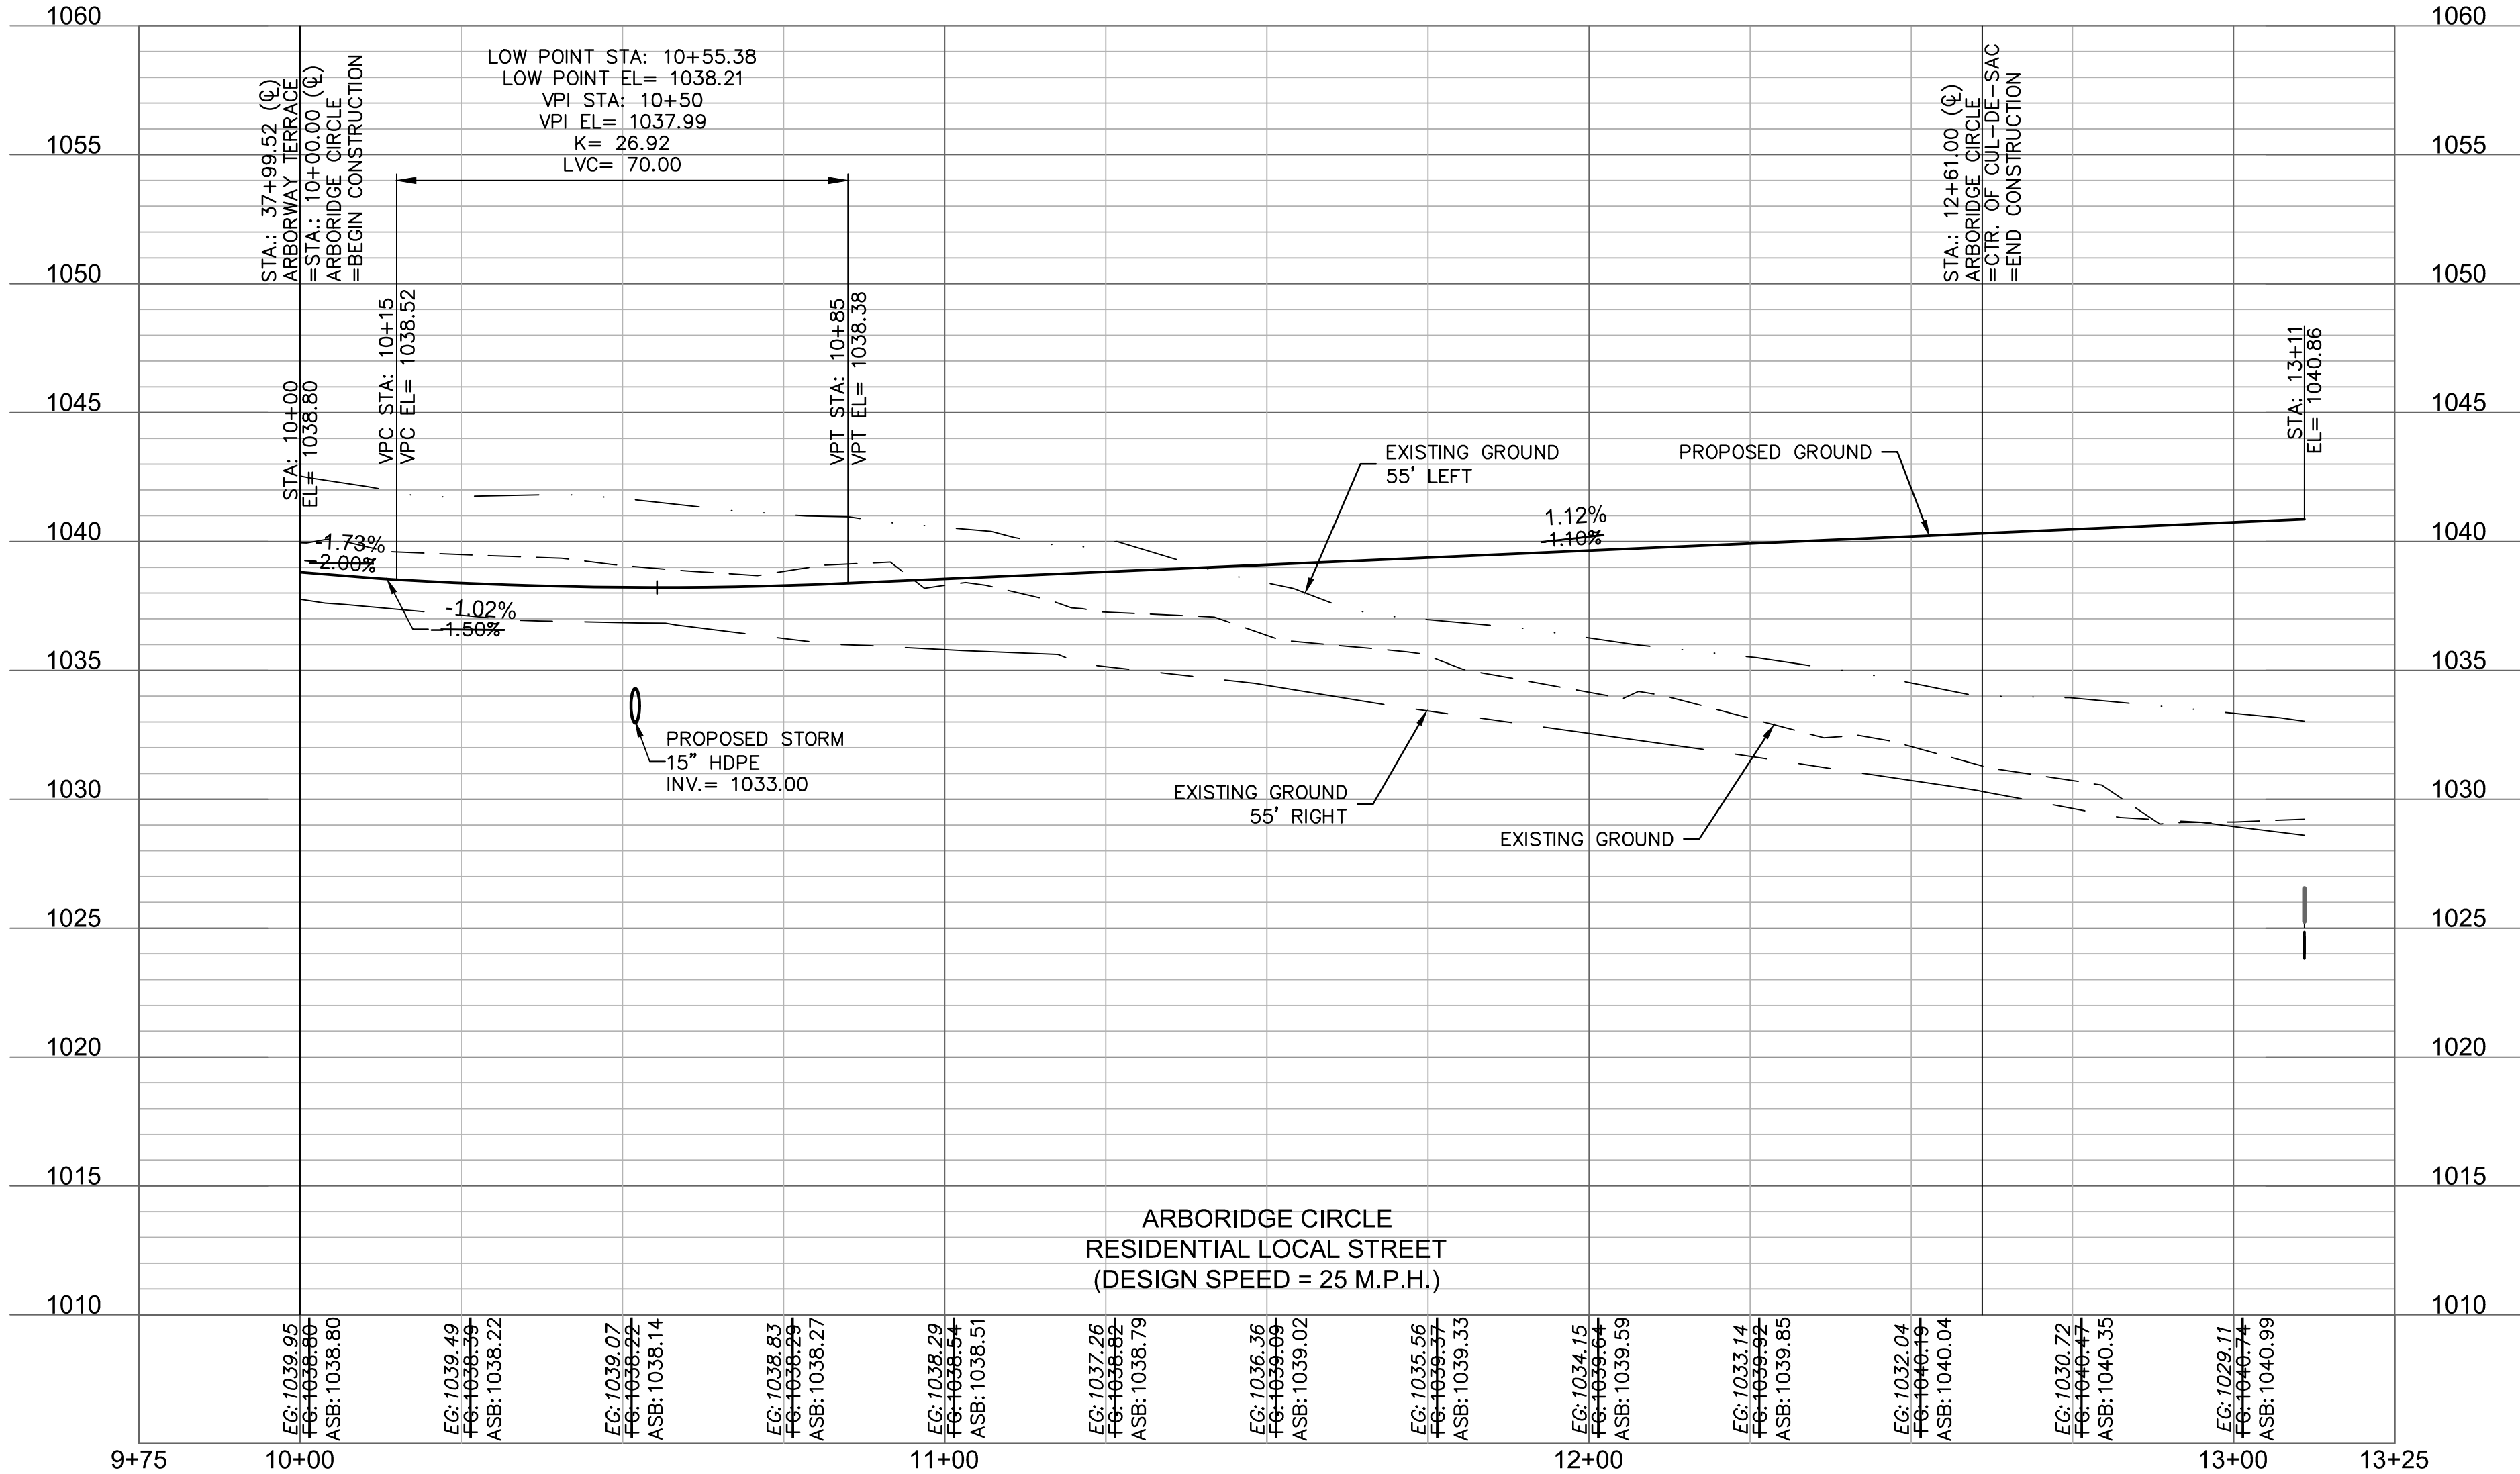


Olsson - Civil Engineering
Missouri Certificate of Authority #01592
1301 Burlington Street
North Kansas City, MO 64116
TEL 816.361.1177
www.olsen.com

REVISIONS	
REV. NO.	REVISIONS DESCRIPTION
1	11/23/2020 REVISED PER CITY COMMENTS

ROADWAY PLAN AND PROFILE (ARBORIDGE CIRCLE) STREET & STORM SEWER PLANS	HAWTHORN RIDGE THIRD PLAT	2020
---	------------------------------	------


drawn by: OLS
checked by: BMW
approved by: BMW
QA/QC by: JES
project no.: C_RPP03_A191605
drawing no.: 10/02/2020

SHEET
C112

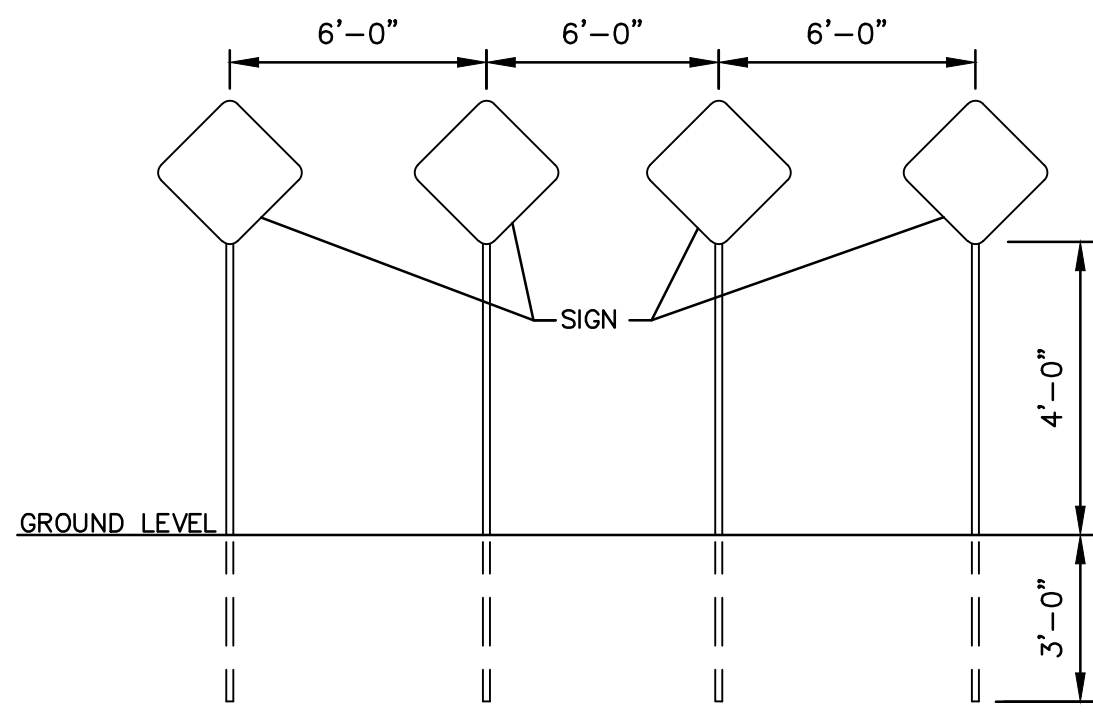

END OF ROAD TREATMENT
N.T.S.

OBJECT MARKERS (TYPE OM4-3, 18"X18")
ARE TO BE INSTALLED 2' FROM END OF
PROPOSED PAVEMENT.

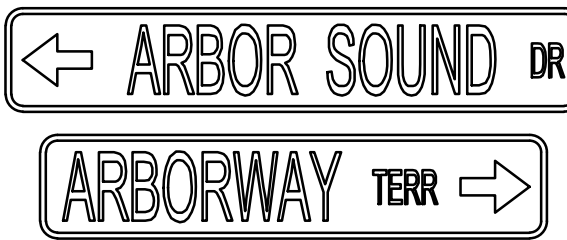


ARBOR SOUND DRIVE & ARBORWAY TERRACE SIGN DETAILS
N.T.S.


NOT ASBUILT

**Accepted
Record Drawings**

These plans have been reviewed for accuracy and are accepted for basic conformance to the approved construction drawings.

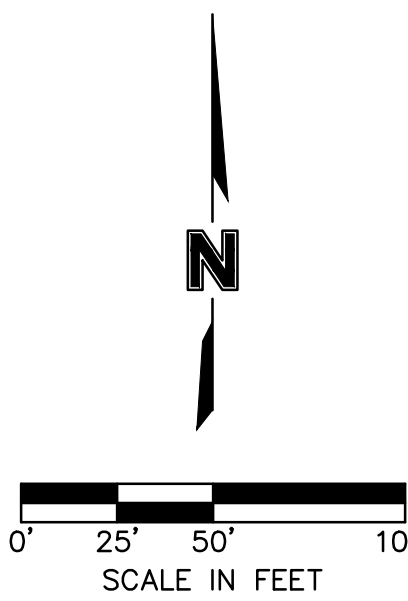

DWG: F:\2019\1501-2000\019-1605-A\40-Design\AutoCAD\Final Plans - As-Built\Sheets\CONV\STREET & STORM\A_C_SPT01_A191605.dwg
DATE: Jan 18, 2022 3:33pm
XREFS: C_PBASE_A191605 C_PUTIL_A191605 C_PBLK_A191605 C_PBNDY_A191605 C_PPATT_A191605 C_PSTRM_A191605
USER: bwortheley

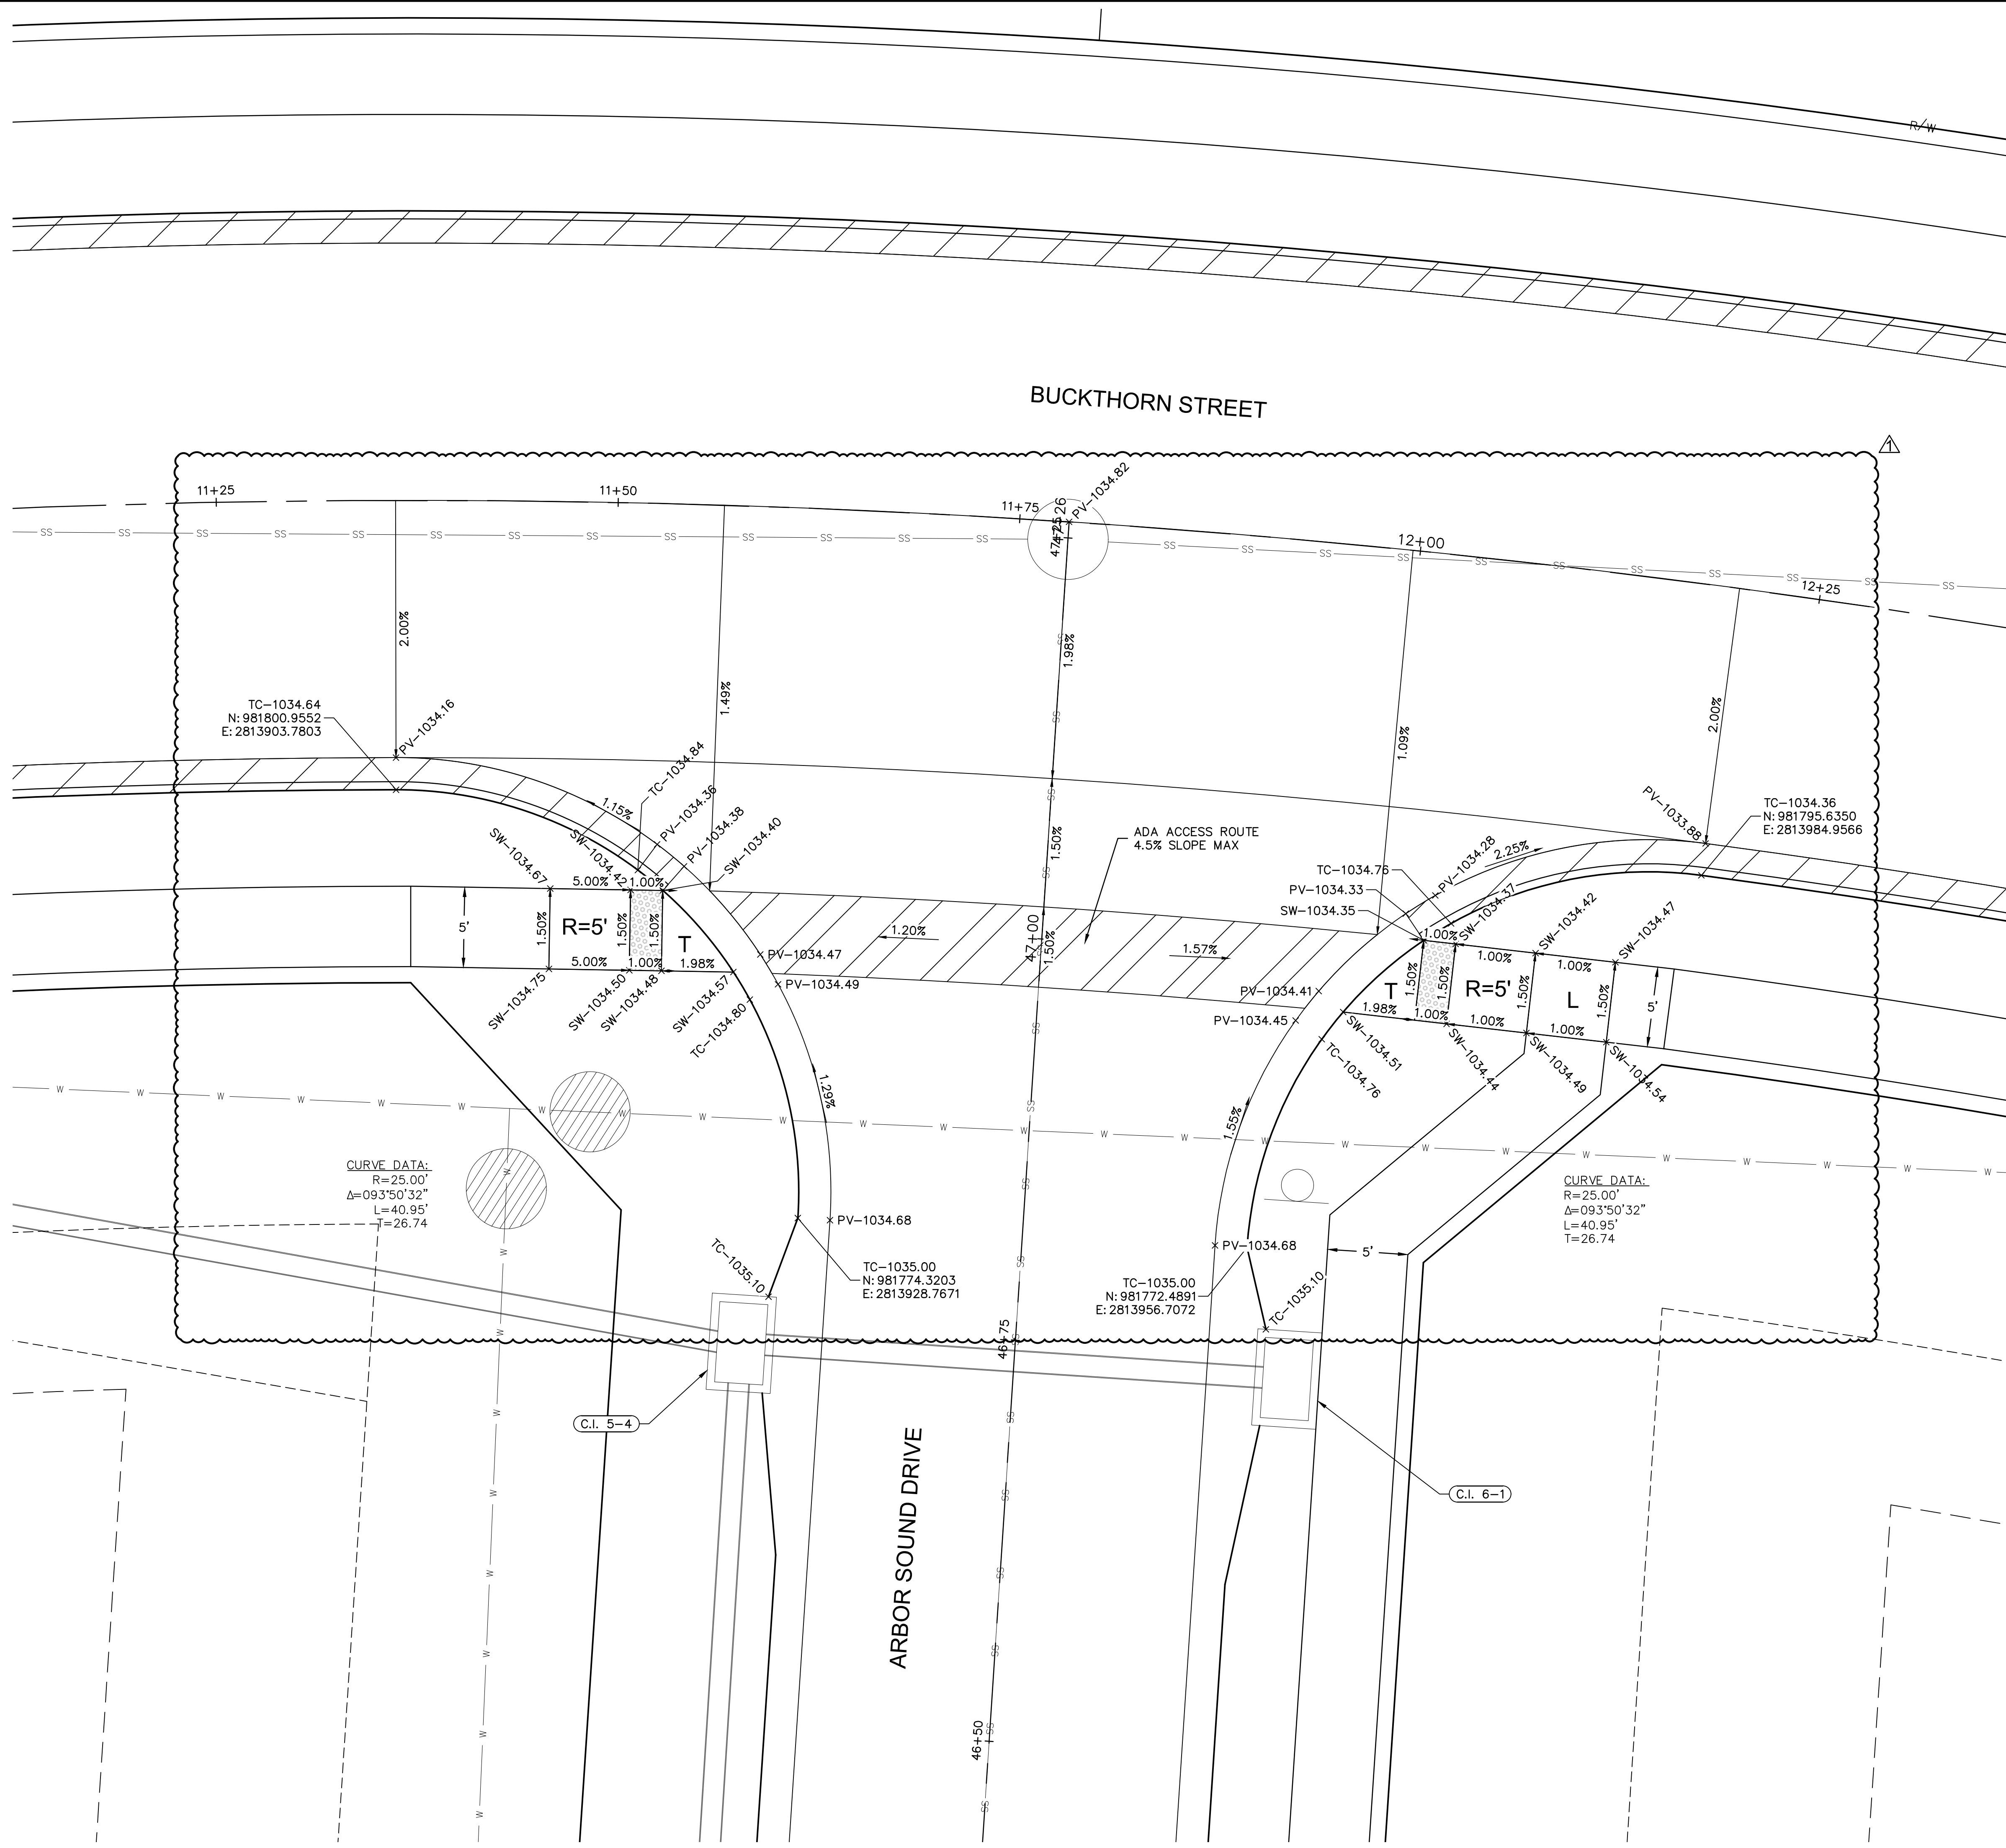

- INTERSECTION AND ADA DETAIL NOTES:
1. ALL ADA CURB RAMPS SHALL BE BUILT PER CURRENT MUNICIPALITY ADOPTED ADA STANDARDS.
 2. CURB RAMP FLARES SHALL NOT BE STEEPER THAN 1:10 MAX SLOPES.
 3. LANDING SHALL BE PROVIDED WHERE INDICATED ON PLAN SHEET OR BY PROWAG STANDARDS. LANDING SHALL BE 4'X4' MINIMUM.
 4. RAMP RUNS SHALL HAVE A MAXIMUM RUNNING SLOPE OF 1:12 UNLESS THE RAMP LENGTH IS OVER 15 FEET, THEN THE SLOPE CAN BE GREATER AS INDICATED IN DETAILS TO REACH STREET GRADES.
 5. LANDINGS SHALL HAVE A MAXIMUM SLOPE OF 2% IN ANY DIRECTION.
 6. CROSS SLOPE FOR RAMPS AND SIDEWALK SHALL NOT EXCEED 2%.
 7. AFTER CURBS HAVE BEEN CONSTRUCTED, AND BEFORE ASPHALT OR CONCRETE PAVEMENT IS POURED, CURBS SHOULD BE MEASURED WITH A LEVEL TO ENSURE CURB ALONG ADA RAMPS AND LANDINGS WILL MEET ADA REQUIREMENTS.
 8. ADA RAMP CONSTRUCTION WILL BE INSPECTED THOROUGHLY BY THE CITY INSPECTOR. CONTRACTOR SHALL BE REQUIRED TO RECONSTRUCT RAMPS, CURBS AND/OR PAVEMENT AT CONTRACTOR'S EXPENSE IF ADA RAMPS AND LANDINGS CANNOT MEET THE ADA REQUIREMENTS, PER APPROVED PLAN OR APPROVED ALTERNATIVE.
 9. CURVE DATA IS FOR BACK OF CURB.

LEGEND	
TC-	TOP OF CURB
PV-	TOP OF PAVEMENT
SW-	SIDEWALK
L	LANDING AREA
R	RAMP AREA
T	TRANSITION AREA
	ADA ACCESS ROUTE
	CG-2 CURB & GUTTER
	CG-1 CURB & GUTTER

NOT ASBUILT

Accepted
Record Drawings

These plans have been reviewed for
accuracy and are accepted for basic
conformance to the approved
construction drawings.

olsson

Olsson - Civil Engineering
Missouri Certificate of Authority #001592
1301 Burlington Street
North Kansas City, MO 64116
TEL 816.361.1177
www.olsson.com

STATE OF MISSOURI
BROCK M. WORTHEY
PE-2019000237
1/18/2022
PROFESSIONAL ENGINEER

BY	
REV. NO.	1
DATE	07/29/2021
REVISED PER CITY COMMENTS	

SPOT ELEVATIONS
STREET & STORM SEWER PLANS

HAWTHORN RIDGE
THIRD PLAT

LEE'S SUMMIT, MO


drawn by: OLS
checked by: BMW
approved by: BMW
QA/QC by: JES
project no.: A19-1605
drawing no.: C_SPT01_A191605
date: 10/02/2020

SHEET
C114


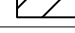

REVISIONS

2020

DWG: F:\2019\1501-2000\019-1605-A\40-Design\AutoCAD\Final Plans - As-Built\1\Sheets\GNVC STREET & STORM\VC_SPT01-A191605.dwg
DATE: Jan 18, 2022 3:33pm XREFS: C:\PBASE\A191605 C:\PUTIL\A191605 C:\PBLK\A191605 C:\PBDY\A191605 C:\PATT\A191605 C:\PSTRM\A191605

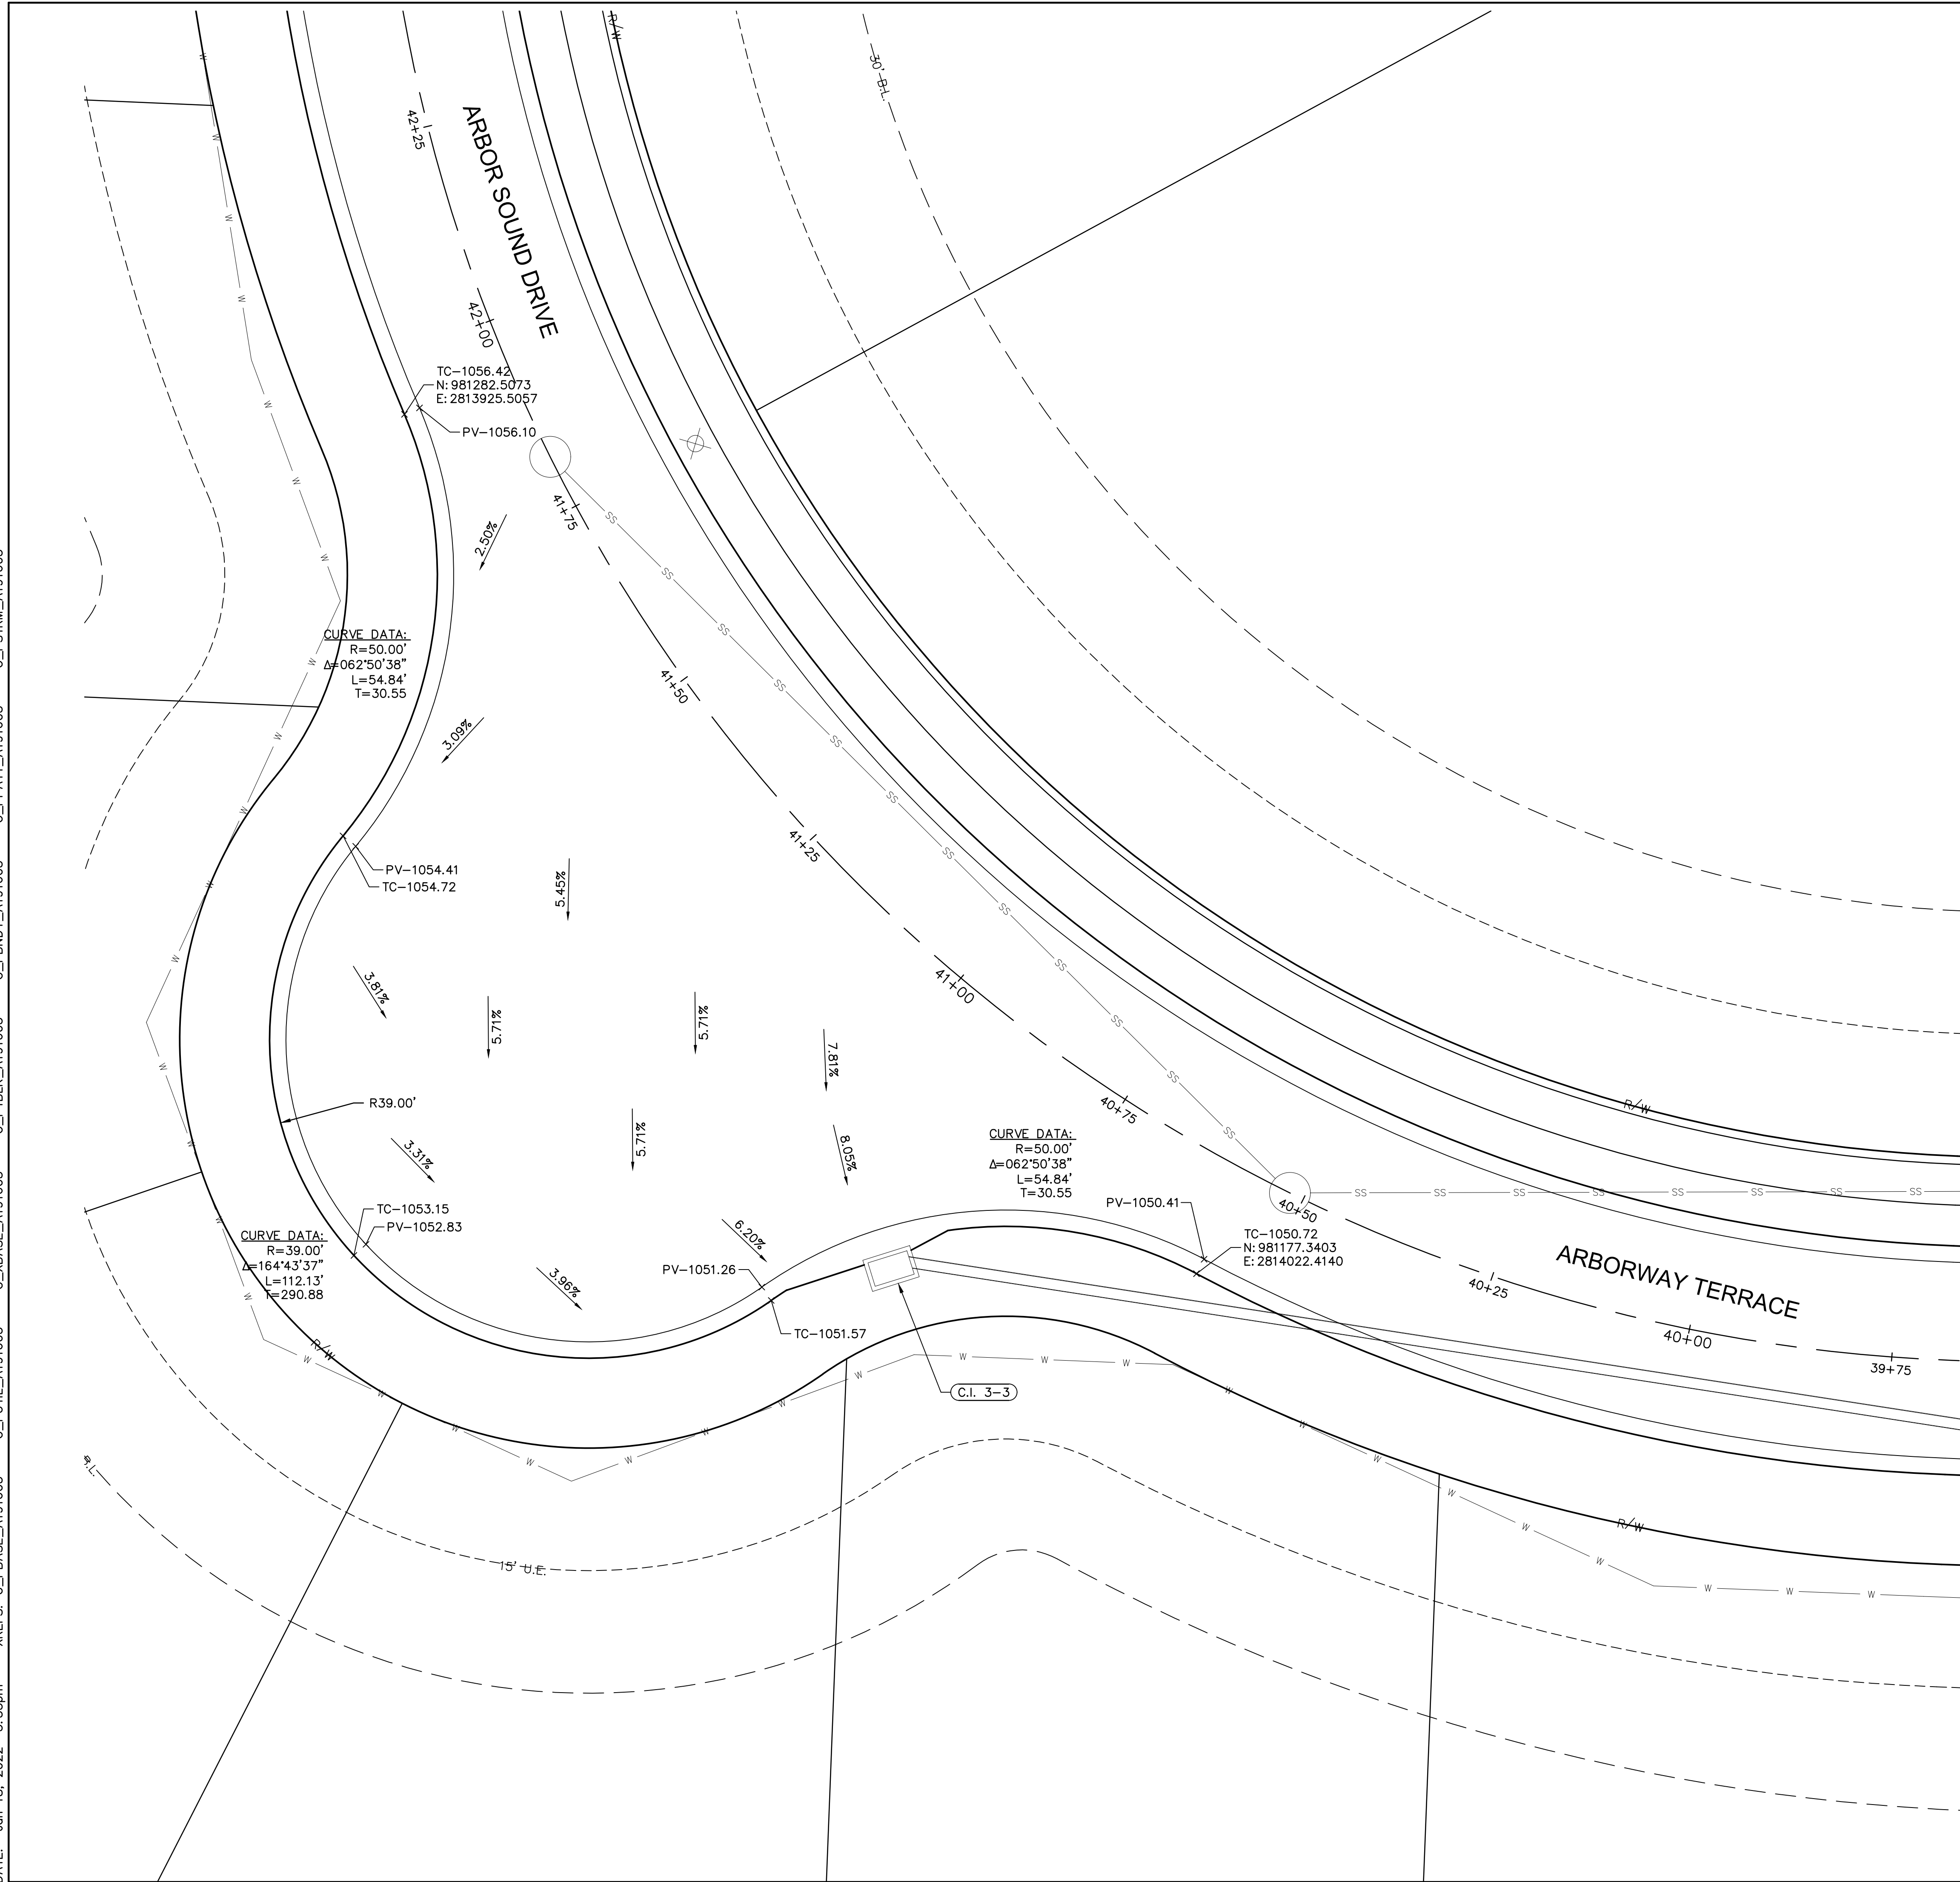


- INTERSECTION AND ADA DETAIL NOTES:
1. ALL ADA CURB RAMPS SHALL BE BUILT PER CURRENT MUNICIPALITY ADOPTED ADA STANDARDS.
2. CURB RAMP FLARES SHALL NOT BE STEEPER THAN 1:10 MAX SLOPES.
3. LANDINGS SHALL BE PROVIDED WHERE INDICATED ON PLAN SHEET OR BY PROWAG STANDARDS. LANDING SHALL BE 4'x4' MINIMUM.
4. RAMP RUNS SHALL HAVE A MAXIMUM RUNNING SLOPE OF 1:12 UNLESS THE RAMP LENGTH IS OVER 15 FEET, THEN THE SLOPE CAN BE GREATER AS INDICATED IN DETAILS TO REACH STREET GRADES.
5. LANDINGS SHALL HAVE A MAXIMUM SLOPE OF 2% IN ANY DIRECTION.
6. CROSS SLOPE FOR RAMPS AND SIDEWALK SHALL NOT EXCEED 2%.
7. AFTER CURBS HAVE BEEN CONSTRUCTED, AND BEFORE ASPHALT OR CONCRETE PAVEMENT IS POURED, CURBS SHOULD BE MEASURED WITH A LEVEL TO ENSURE CURBS ALONG ADA RAMPS AND LANDINGS WILL MEET ADA REQUIREMENTS.
8. ADA RAMP CONSTRUCTION WILL BE INSPECTED THOROUGHLY BY THE CITY INSPECTOR. CONTRACTOR SHALL BE REQUIRED TO RECONSTRUCT RAMPS, PARBS AND/OR PAVEMENT AT CONTRACTOR'S EXPENSE IF ADA RAMPS AND LANDINGS CANNOT MEET THE ADA REQUIREMENTS, PER APPROVED PLAN OR APPROVED ALTERNATIVE.
9. CURVE DATA IS FOR BACK OF CURB.

LEGEND	
TC-	TOP OF CURB
PV-	TOP OF PAVEMENT
SW-	SIDEWALK
L	LANDING AREA
R	RAMP AREA
T	TRANSITION AREA
	ADA ACCESS ROUTE
	CG-2 CURB & GUTTER
	CG-1 CURB & GUTTER

NOT ASBUILT

**Accepted
Record Drawings**

These plans have been reviewed for accuracy and are accepted for basic conformance to the approved construction drawings.

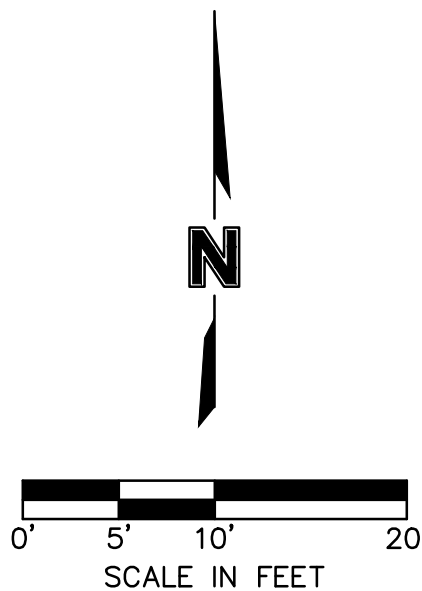

SPOT ELEVATIONS
STREET & STORM SEWER PLANS

HAWTHORN RIDGE
THIRD PLAT

LEE'S SUMMIT, MO

2020

BY

REVISIONS DESCRIPTION

REV. DATE




olson

Olsson - Civil Engineering
Missouri Certificate of Authority #001592
1301 Burlington Street
North Kansas City, MO 64116

drawn by: _____ OLS
checked by: _____ BMV
approved by: _____ BMV
QA/QC by: _____ JES
project no.: _____ A19-1603
drawing no.: _____ C SPT01 A191603
date: _____ 10/02/2020

SHEET
C114

DWG: F:\2019\1501-2000\019-1605-A\40-Design\AutoCAD\Final Plans - As-Built\Sheets\GNCV\STREET & STORM\AC_SPT01_A191605.dwg C_PSTRM_A191605
DATE: Jan 18, 2022 3:33pm XREFS: C_PBASE_A191605 C_PUTIL_A191605 C_PBLK_A191605 C_PBNDY_A191605 C_PATTI_A191605 USER: bworthley

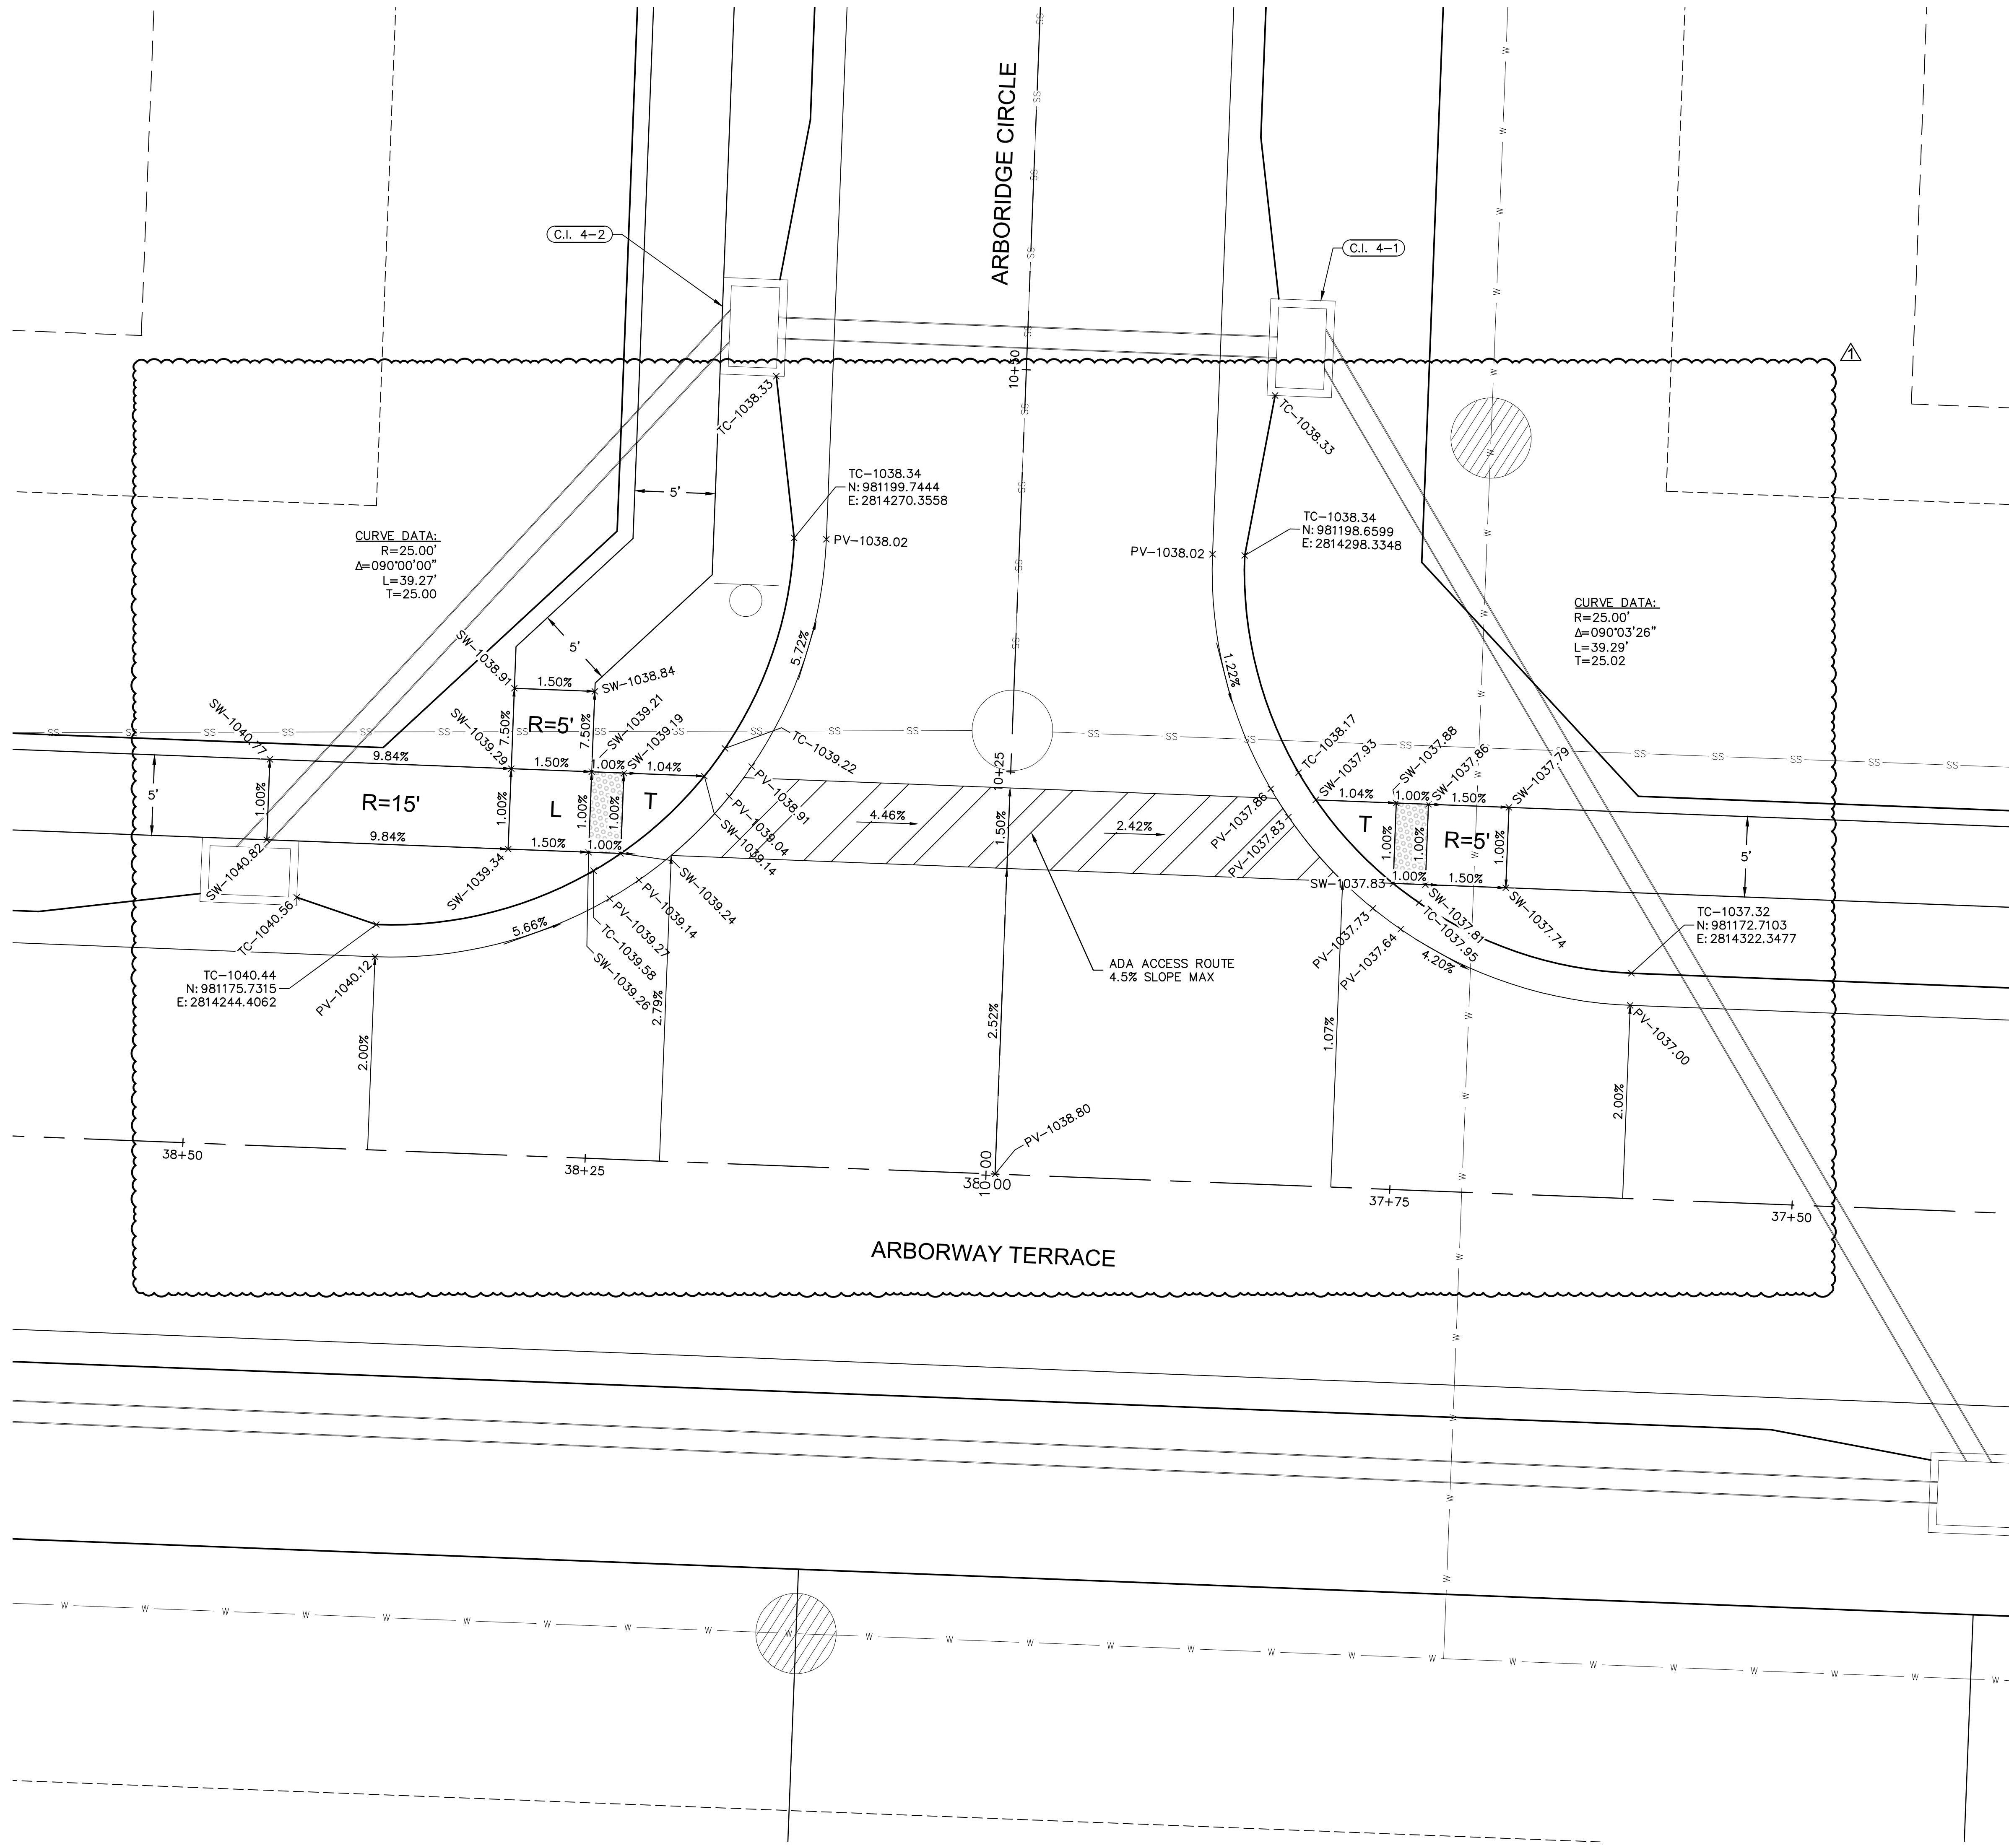


- INTERSECTION AND ADA DETAIL NOTES:
1. ALL ADA CURB RAMPS SHALL BE BUILT PER CURRENT MUNICIPALITY ADOPTED ADA STANDARDS.
 2. CURB RAMP FLARES SHALL NOT BE STEEPER THAN 1:10 MAX SLOPES.
 3. LANDING SHALL BE PROVIDED WHERE INDICATED ON PLAN SHEET OR BY PROWAG STANDARDS. LANDING SHALL BE 4'X4' MINIMUM.
 4. RAMP RUNS SHALL HAVE A MAXIMUM RUNNING SLOPE OF 1:12 UNLESS THE RAMP LENGTH IS OVER 15 FEET, THEN THE SLOPE CAN BE GREATER AS INDICATED IN DETAILS TO REACH STREET GRADES.
 5. LANDINGS SHALL HAVE A MAXIMUM SLOPE OF 2% IN ANY DIRECTION.
 6. CROSS SLOPE FOR RAMPS AND SIDEWALK SHALL NOT EXCEED 2%.
 7. AFTER CURBS HAVE BEEN CONSTRUCTED, AND BEFORE ASPHALT OR CONCRETE PAVEMENT IS POURED, CURBS SHOULD BE MEASURED WITH A LEVEL TO ENSURE CURB ALONG ADA RAMPS AND LANDINGS WILL MEET ADA REQUIREMENTS.
 8. ADA RAMP CONSTRUCTION WILL BE INSPECTED THOROUGHLY BY THE CITY INSPECTOR. CONTRACTOR SHALL BE REQUIRED TO RECONSTRUCT RAMPS, CURBS AND/OR PAVEMENT AT CONTRACTOR'S EXPENSE IF ADA RAMPS AND LANDINGS CANNOT MEET THE ADA REQUIREMENTS, PER APPROVED PLAN OR APPROVED ALTERNATIVE.
 9. CURVE DATA IS FOR BACK OF CURB.

LEGEND	
TC-	TOP OF CURB
PV-	TOP OF PAVEMENT
SW-	SIDEWALK
L	LANDING AREA
R	RAMP AREA
T	TRANSITION AREA
	ADA ACCESS ROUTE
	CG-2 CURB & GUTTER
	CG-1 CURB & GUTTER

NOT ASBUILT

Accepted
Record Drawings

These plans have been reviewed for accuracy and are accepted for basic conformance to the approved construction drawings.

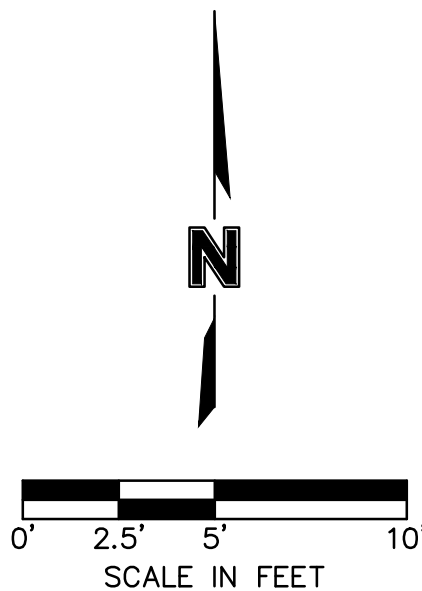

drawn by: OLS
checked by: BMW
approved by: BMW
QA/QC by: JES
project no.: A19-1605
drawing no.: C_SPT01_A191605
date: 10/02/2020

SHEET
C116

SPOT ELEVATIONS
STREET & STORM SEWER PLANS

HAWTHORN RIDGE
THIRD PLAT

LEE'S SUMMIT, MO

REV. NO. 1
DATE 07/29/2021
REVISED PER CITY COMMENTS


BY

REVISIONS

2020

olsson
Olsson - Civil Engineering
Missouri Certificate of Authority #001592
1301 Burlington Street
North Kansas City, MO 64116
TEL 816.361.1177
www.olsosn.com

DWG: F:\2019\1501-2000\019-1605-A\40-Design\AutoCAD\Final Plans - As-Built\Sheets\CONV\STREET & STORM\A_C_SPT01_A191605.dwg
DATE: Jan 18, 2022 3:33pm
XREFS: C_PBASE_A191605 C_PUTIL_A191605 C_PBLK_A191605 C_PBNDY_A191605 C_PPATT_A191605 C_PSTRM_A191605
USER: bworthley

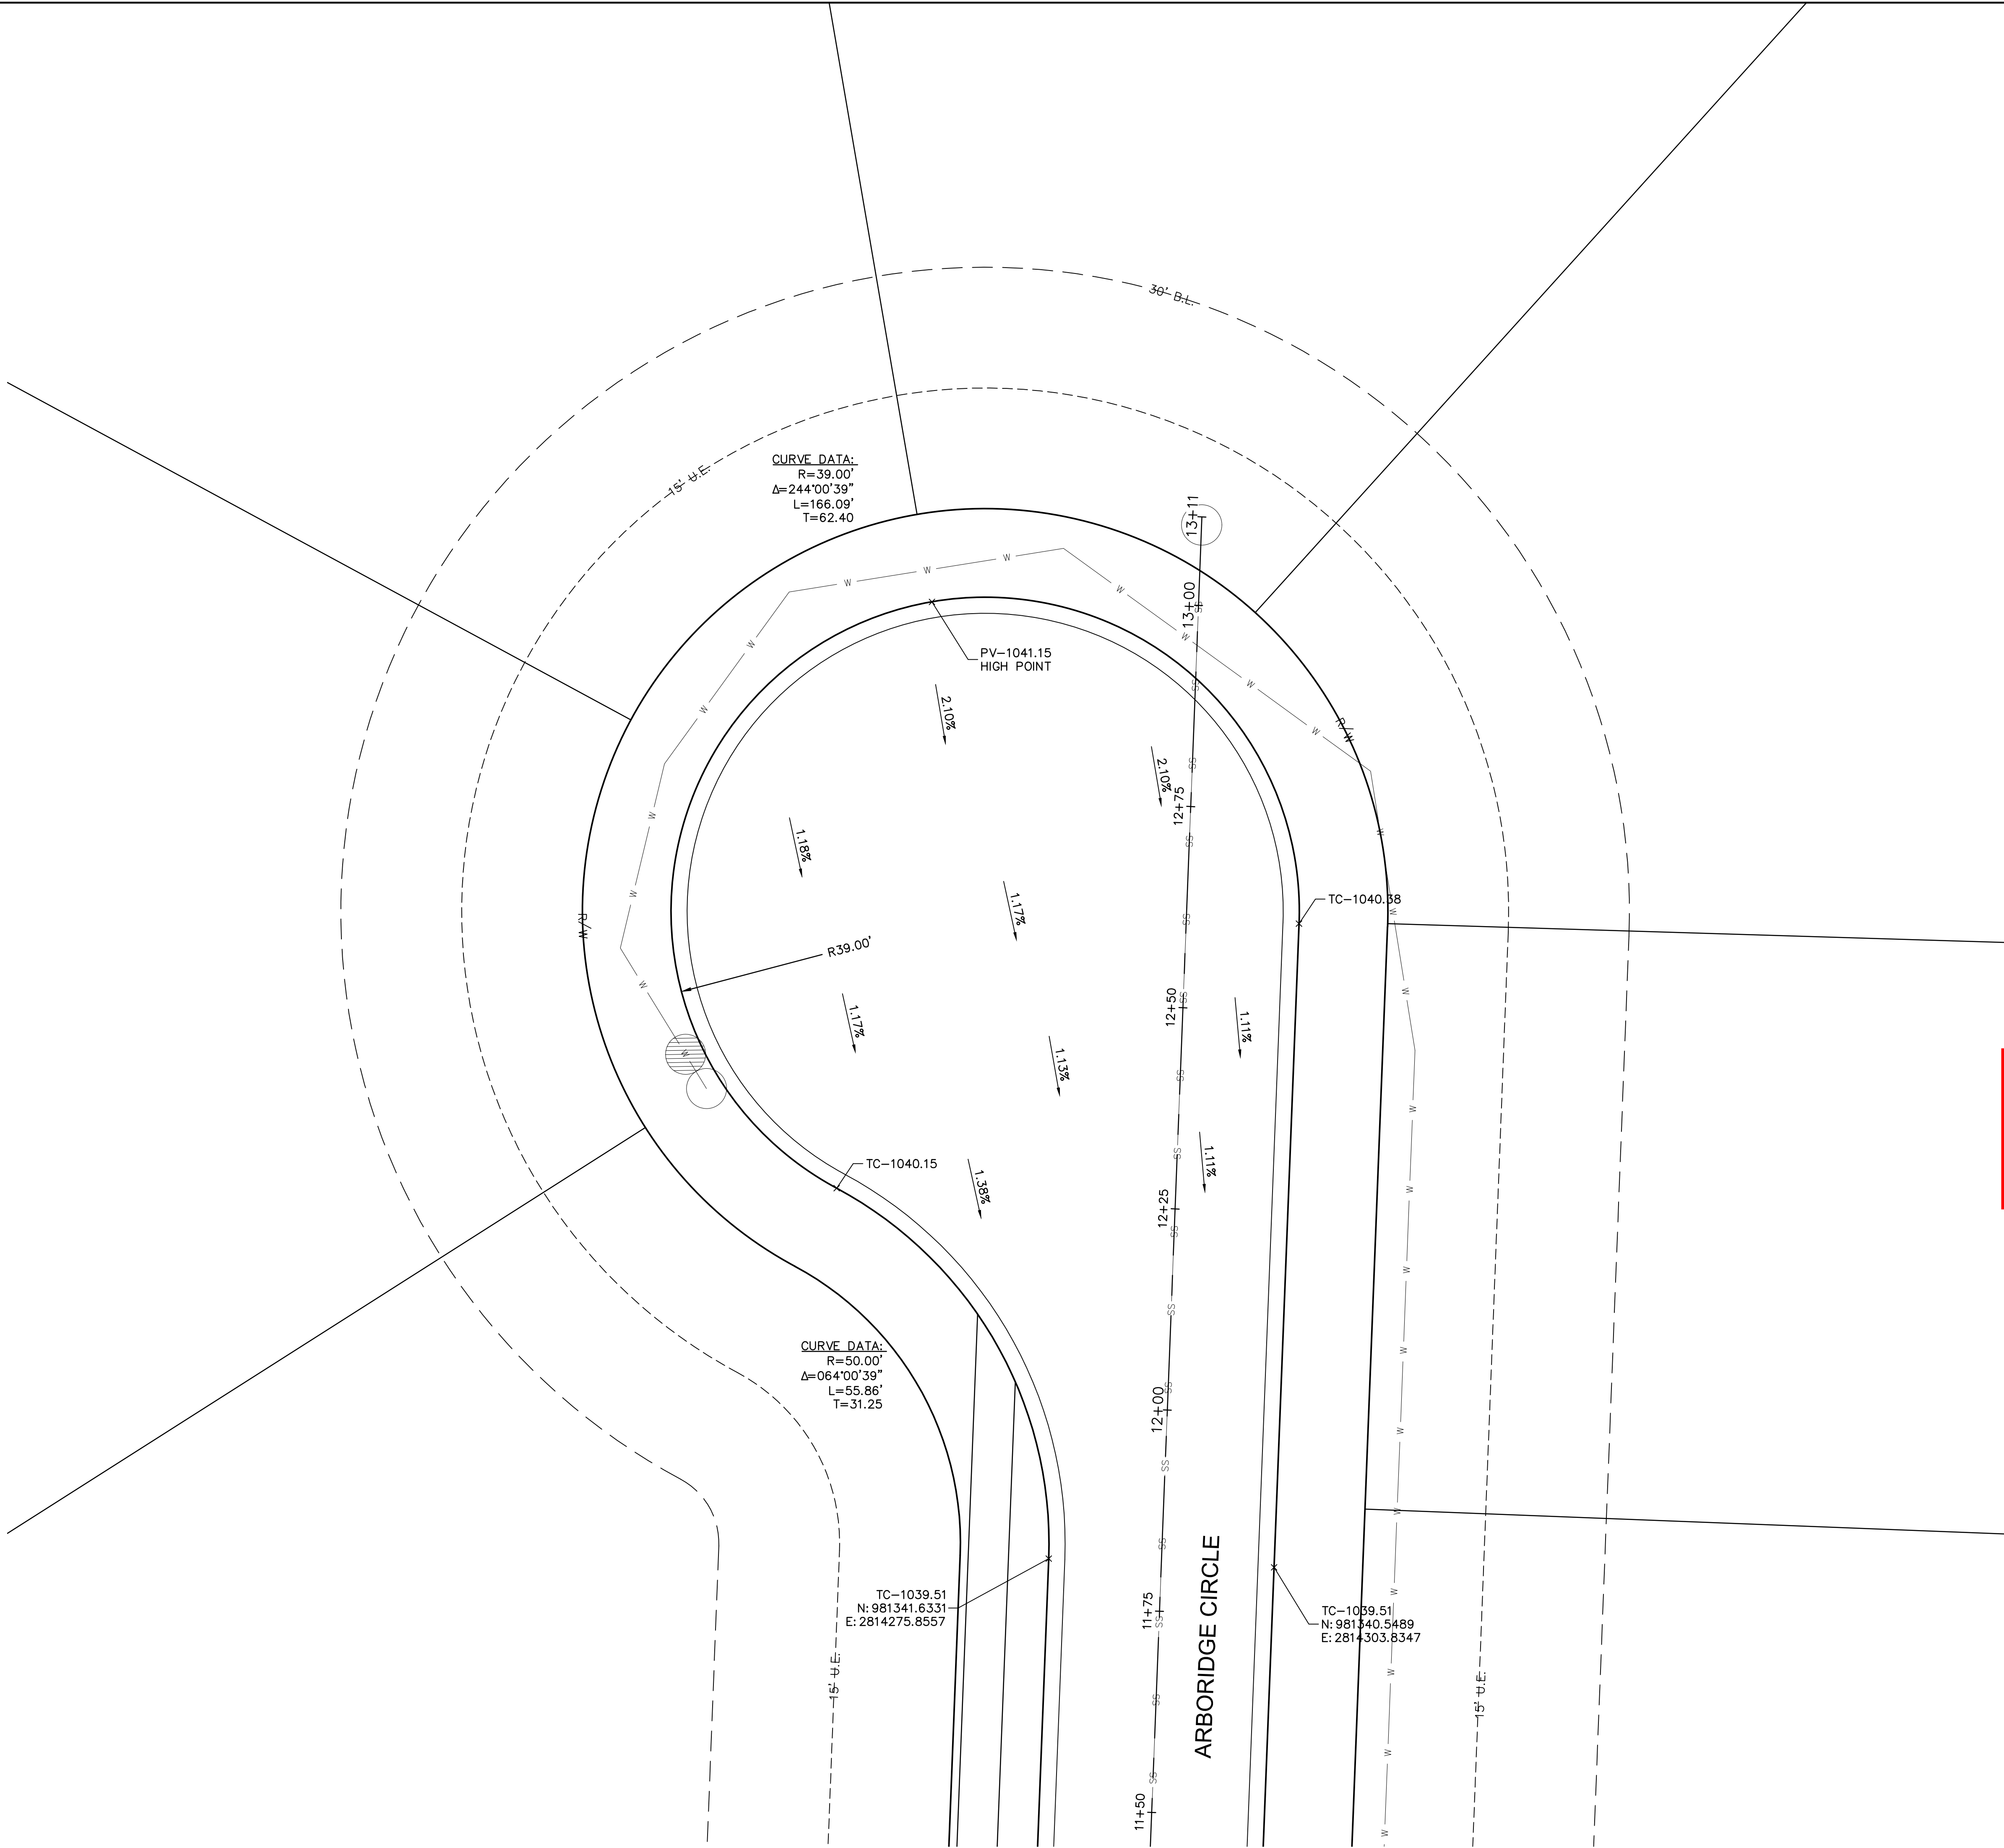

- INTERSECTION AND ADA DETAIL NOTES:
1. ALL ADA CURB RAMPS SHALL BE BUILT PER CURRENT MUNICIPALITY ADOPTED ADA STANDARDS.
 2. CURB RAMP FLARES SHALL NOT BE STEEPER THAN 1:10 MAX SLOPES.
 3. LANDING SHALL BE PROVIDED WHERE INDICATED ON PLAN SHEET OR BY PROWAG STANDARDS. LANDING SHALL BE 4'X4' MINIMUM.
 4. RAMP RUNS SHALL HAVE A MAXIMUM RUNNING SLOPE OF 1:12 UNLESS THE RAMP LENGTH IS OVER 15 FEET, THEN THE SLOPE CAN BE GREATER AS INDICATED IN DETAILS TO REACH STREET GRADES.
 5. LANDINGS SHALL HAVE A MAXIMUM SLOPE OF 2% IN ANY DIRECTION.
 6. CROSS SLOPE FOR RAMPS AND SIDEWALK SHALL NOT EXCEED 2%.
 7. AFTER CURBS HAVE BEEN CONSTRUCTED, AND BEFORE ASPHALT OR CONCRETE PAVEMENT IS POURED, CURBS SHOULD BE MEASURED WITH A LEVEL TO ENSURE CURB ALONG ADA RAMPS AND LANDINGS WILL MEET ADA REQUIREMENTS.
 8. ADA RAMP CONSTRUCTION WILL BE INSPECTED THOROUGHLY BY THE CITY INSPECTOR. CONTRACTOR SHALL BE REQUIRED TO RECONSTRUCT RAMPS, CURBS AND/OR PAVEMENT AT CONTRACTOR'S EXPENSE IF ADA RAMPS AND LANDINGS CANNOT MEET THE ADA REQUIREMENTS, PER APPROVED PLAN OR APPROVED ALTERNATIVE.
 9. CURVE DATA IS FOR BACK OF CURB.

LEGEND	
TC-	TOP OF CURB
PV-	TOP OF PAVEMENT
SW-	SIDEWALK
L	LANDING AREA
R	RAMP AREA
T	TRANSITION AREA
	ADA ACCESS ROUTE
	CG-2 CURB & GUTTER
	CG-1 CURB & GUTTER

NOT ASBUILT

Accepted
Record Drawings

These plans have been reviewed for accuracy and are accepted for basic conformance to the approved construction drawings.

drawn by: OLS
checked by: BMW
approved by: BMW
QA/QC by: JES
project no.: A19-1605
drawing no.: C_SPT01_A191605
date: 10/02/2020

SHEET
C117

SPOT ELEVATIONS
STREET & STORM SEWER PLANS

HAWTHORN RIDGE
THIRD PLAT

LEE'S SUMMIT, MO

REV. NO.

DATE

REVISIONS DESCRIPTION

BY

2020


REVISIONS

olsson

Olsson - Civil Engineering
Missouri Certificate of Authority #001592
1301 Burlington Street
North Kansas City, MO 64116
TEL 816.361.1177 www.olsson.com

STATE OF MISSOURI
BROCK M. WORTHLEY
Professional Engineer
PE-2019000237
10/02/2020

DWG: F:\2019\1501-2000\019-1605-A\40-Design\AutoCAD\Final Plans - As-Built\Sheets\GNCV\STREET & STORM\AC_STM01_A191605.dwg
DATE: Jan 18, 2022 3:34pm
USER: buerthley
C:\PBLK_A191605
C:\PSTRM_A191605
C:\PBASE_A191605
XREFS: C:\PBASE_A191605

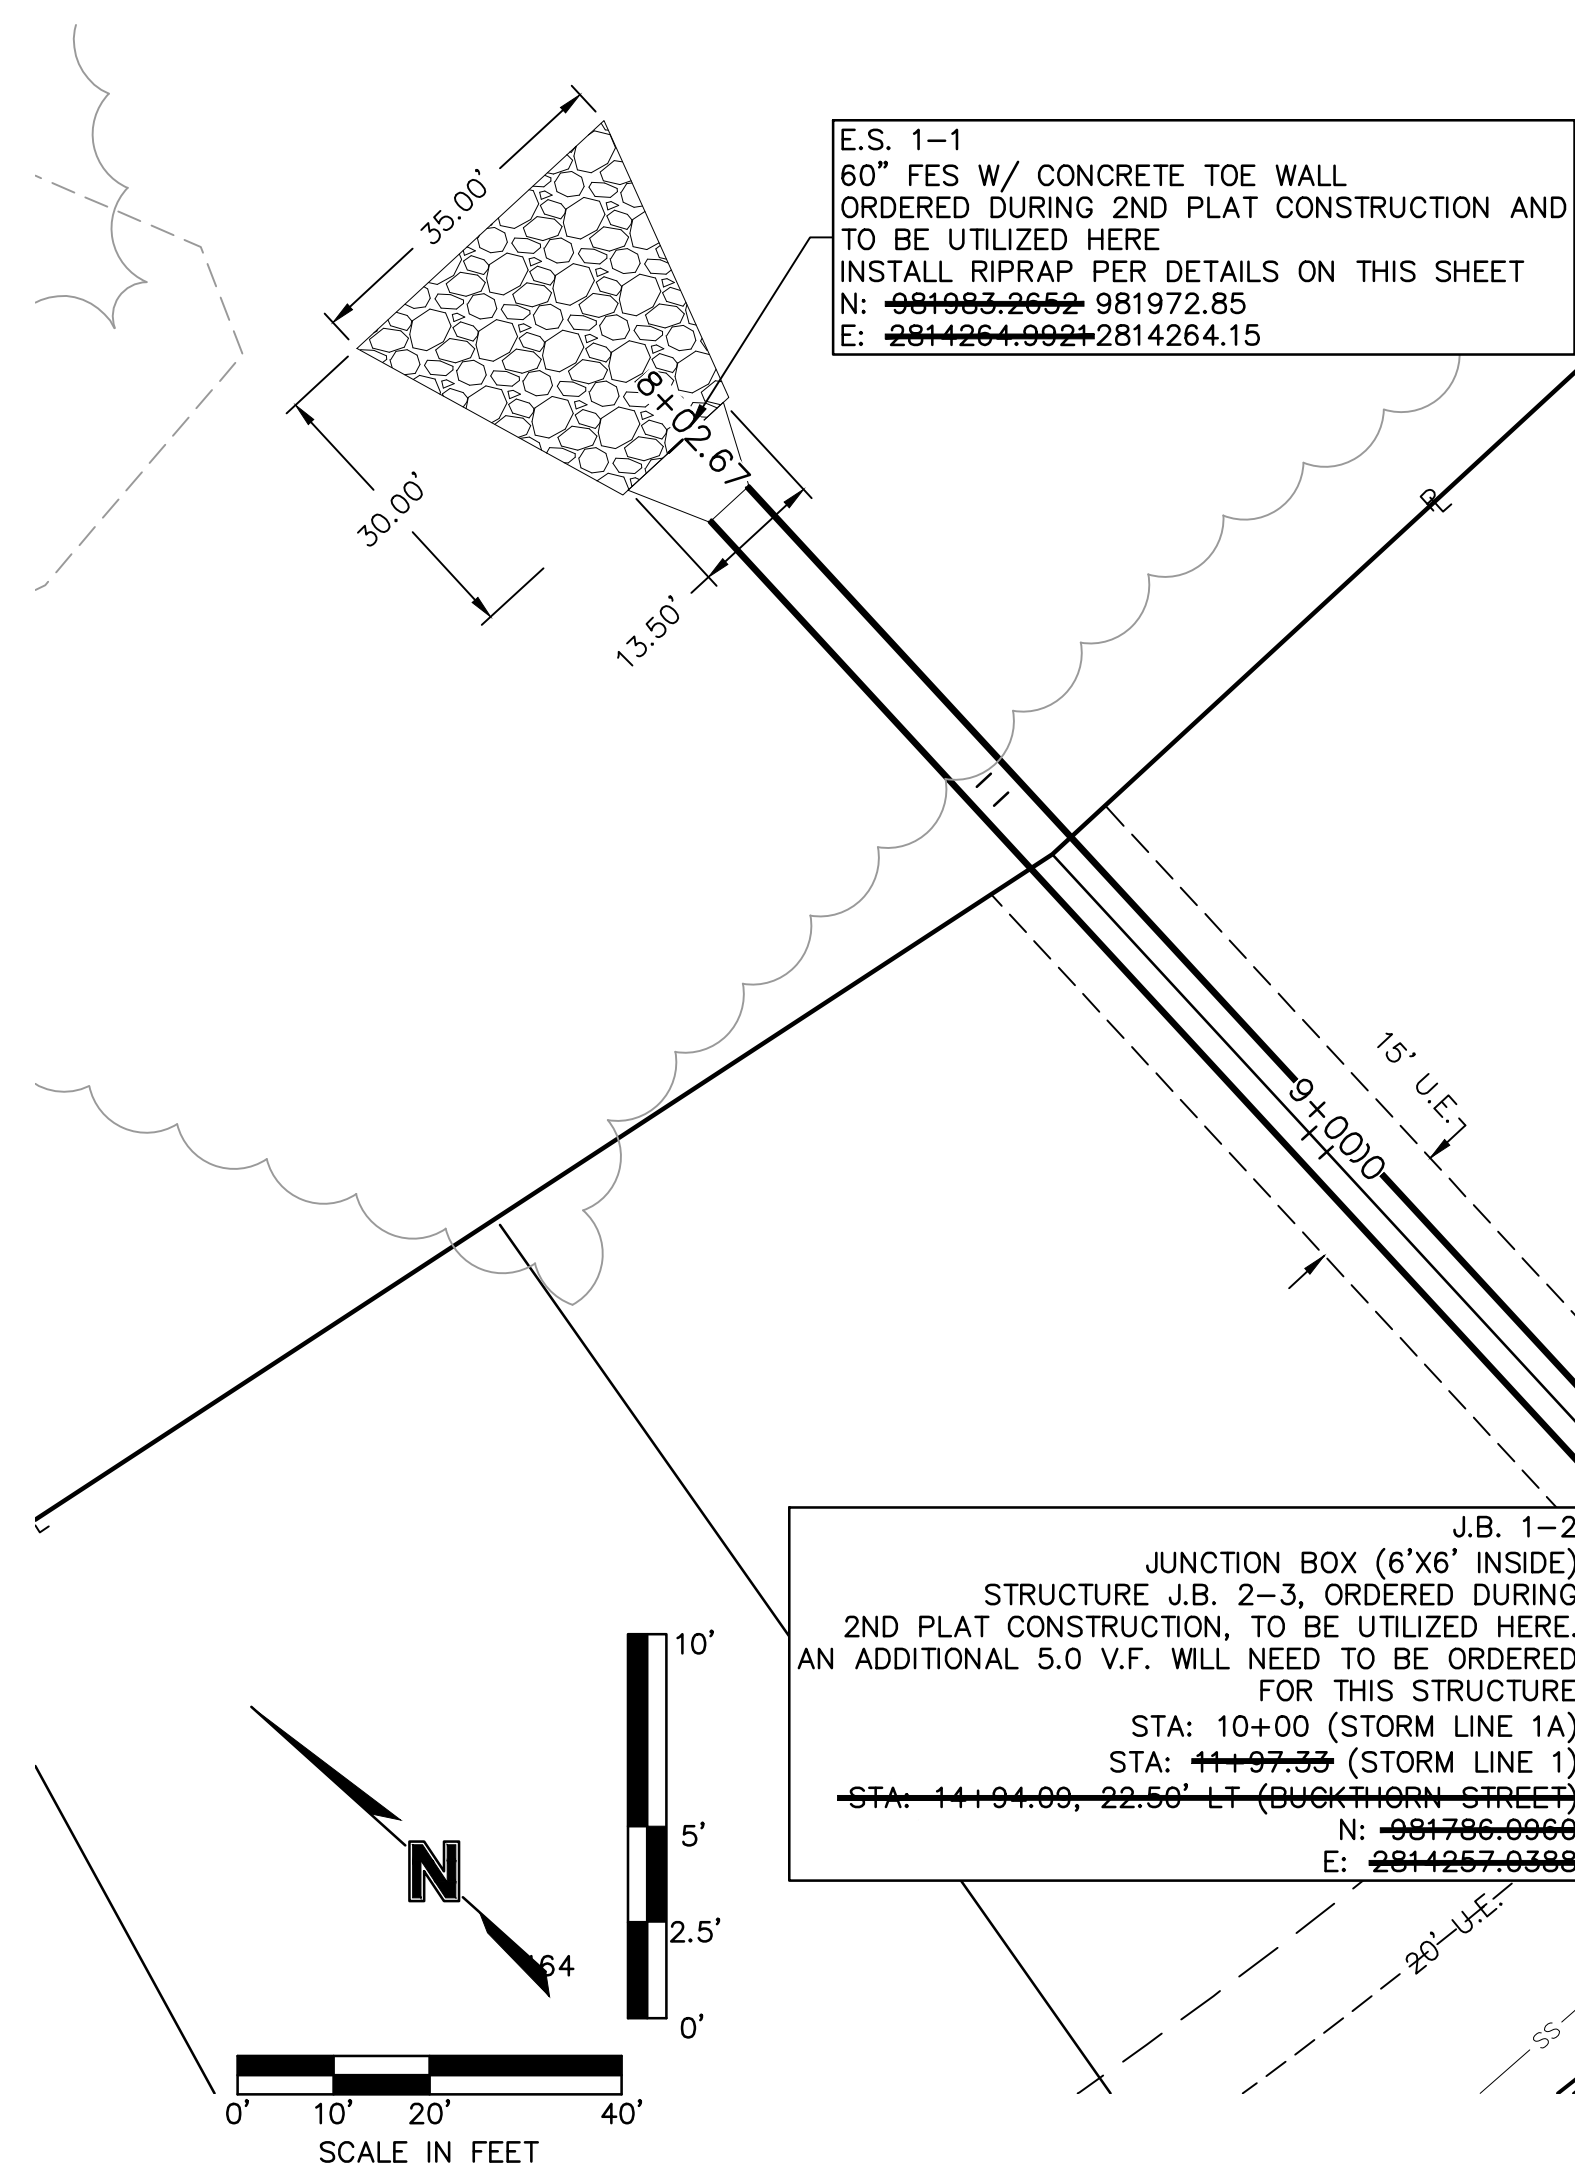

Riprap Calculations						
End Section	Q ₁₀₀ (cfs)	Pipe Diameter (ft)	Class*	D50* (in)	Apron Length (ft)	Apron Depth (ft)
E.S. 1-1	167.23	5	4	14	55	2.57
*Per Table 10.1 HEC 14-FHWA-Energy Dissipators Pg. 10-18					132.29	

NOTE: CONTRACTOR TO INSTALL NONWOVEN GEOTEXTILE UNDERNEATH RIPRAP PER DETAIL ON SHEET C128


HR2 E.S. 2-3
CONNECT TO EXISTING
48" HDPE PIPE
N: 981781.4170
E: 2814379.7769

J.B. 1-2
JUNCTION BOX (6'X6' INSIDE)
STRUCTURE J.B. 2-3, ORDERED DURING
2ND PLAT CONSTRUCTION, TO BE UTILIZED HERE.
AN ADDITIONAL 5.0 V.F. WILL NEED TO BE ORDERED
FOR THIS STRUCTURE
STA: 10+00 (STORM LINE 1A)
STA: 11+97.33 (STORM LINE 1)
STA: 11+94.09, 22.56' LT (BUCKTHORN STREET)
N: 981786.0960
E: 2814256.08

STORM LINE 1 (9+75 - 13+50)

ASBUILT
1/18/2022

NOTE:
CONTRACTOR SHALL FILL AND COMPACT
TO 95% STANDARD DENSITY TO A POINT
18" MINIMUM ABOVE THE TOP OF PIPE
PRIOR TO EXCAVATION FOR THE PIPE.


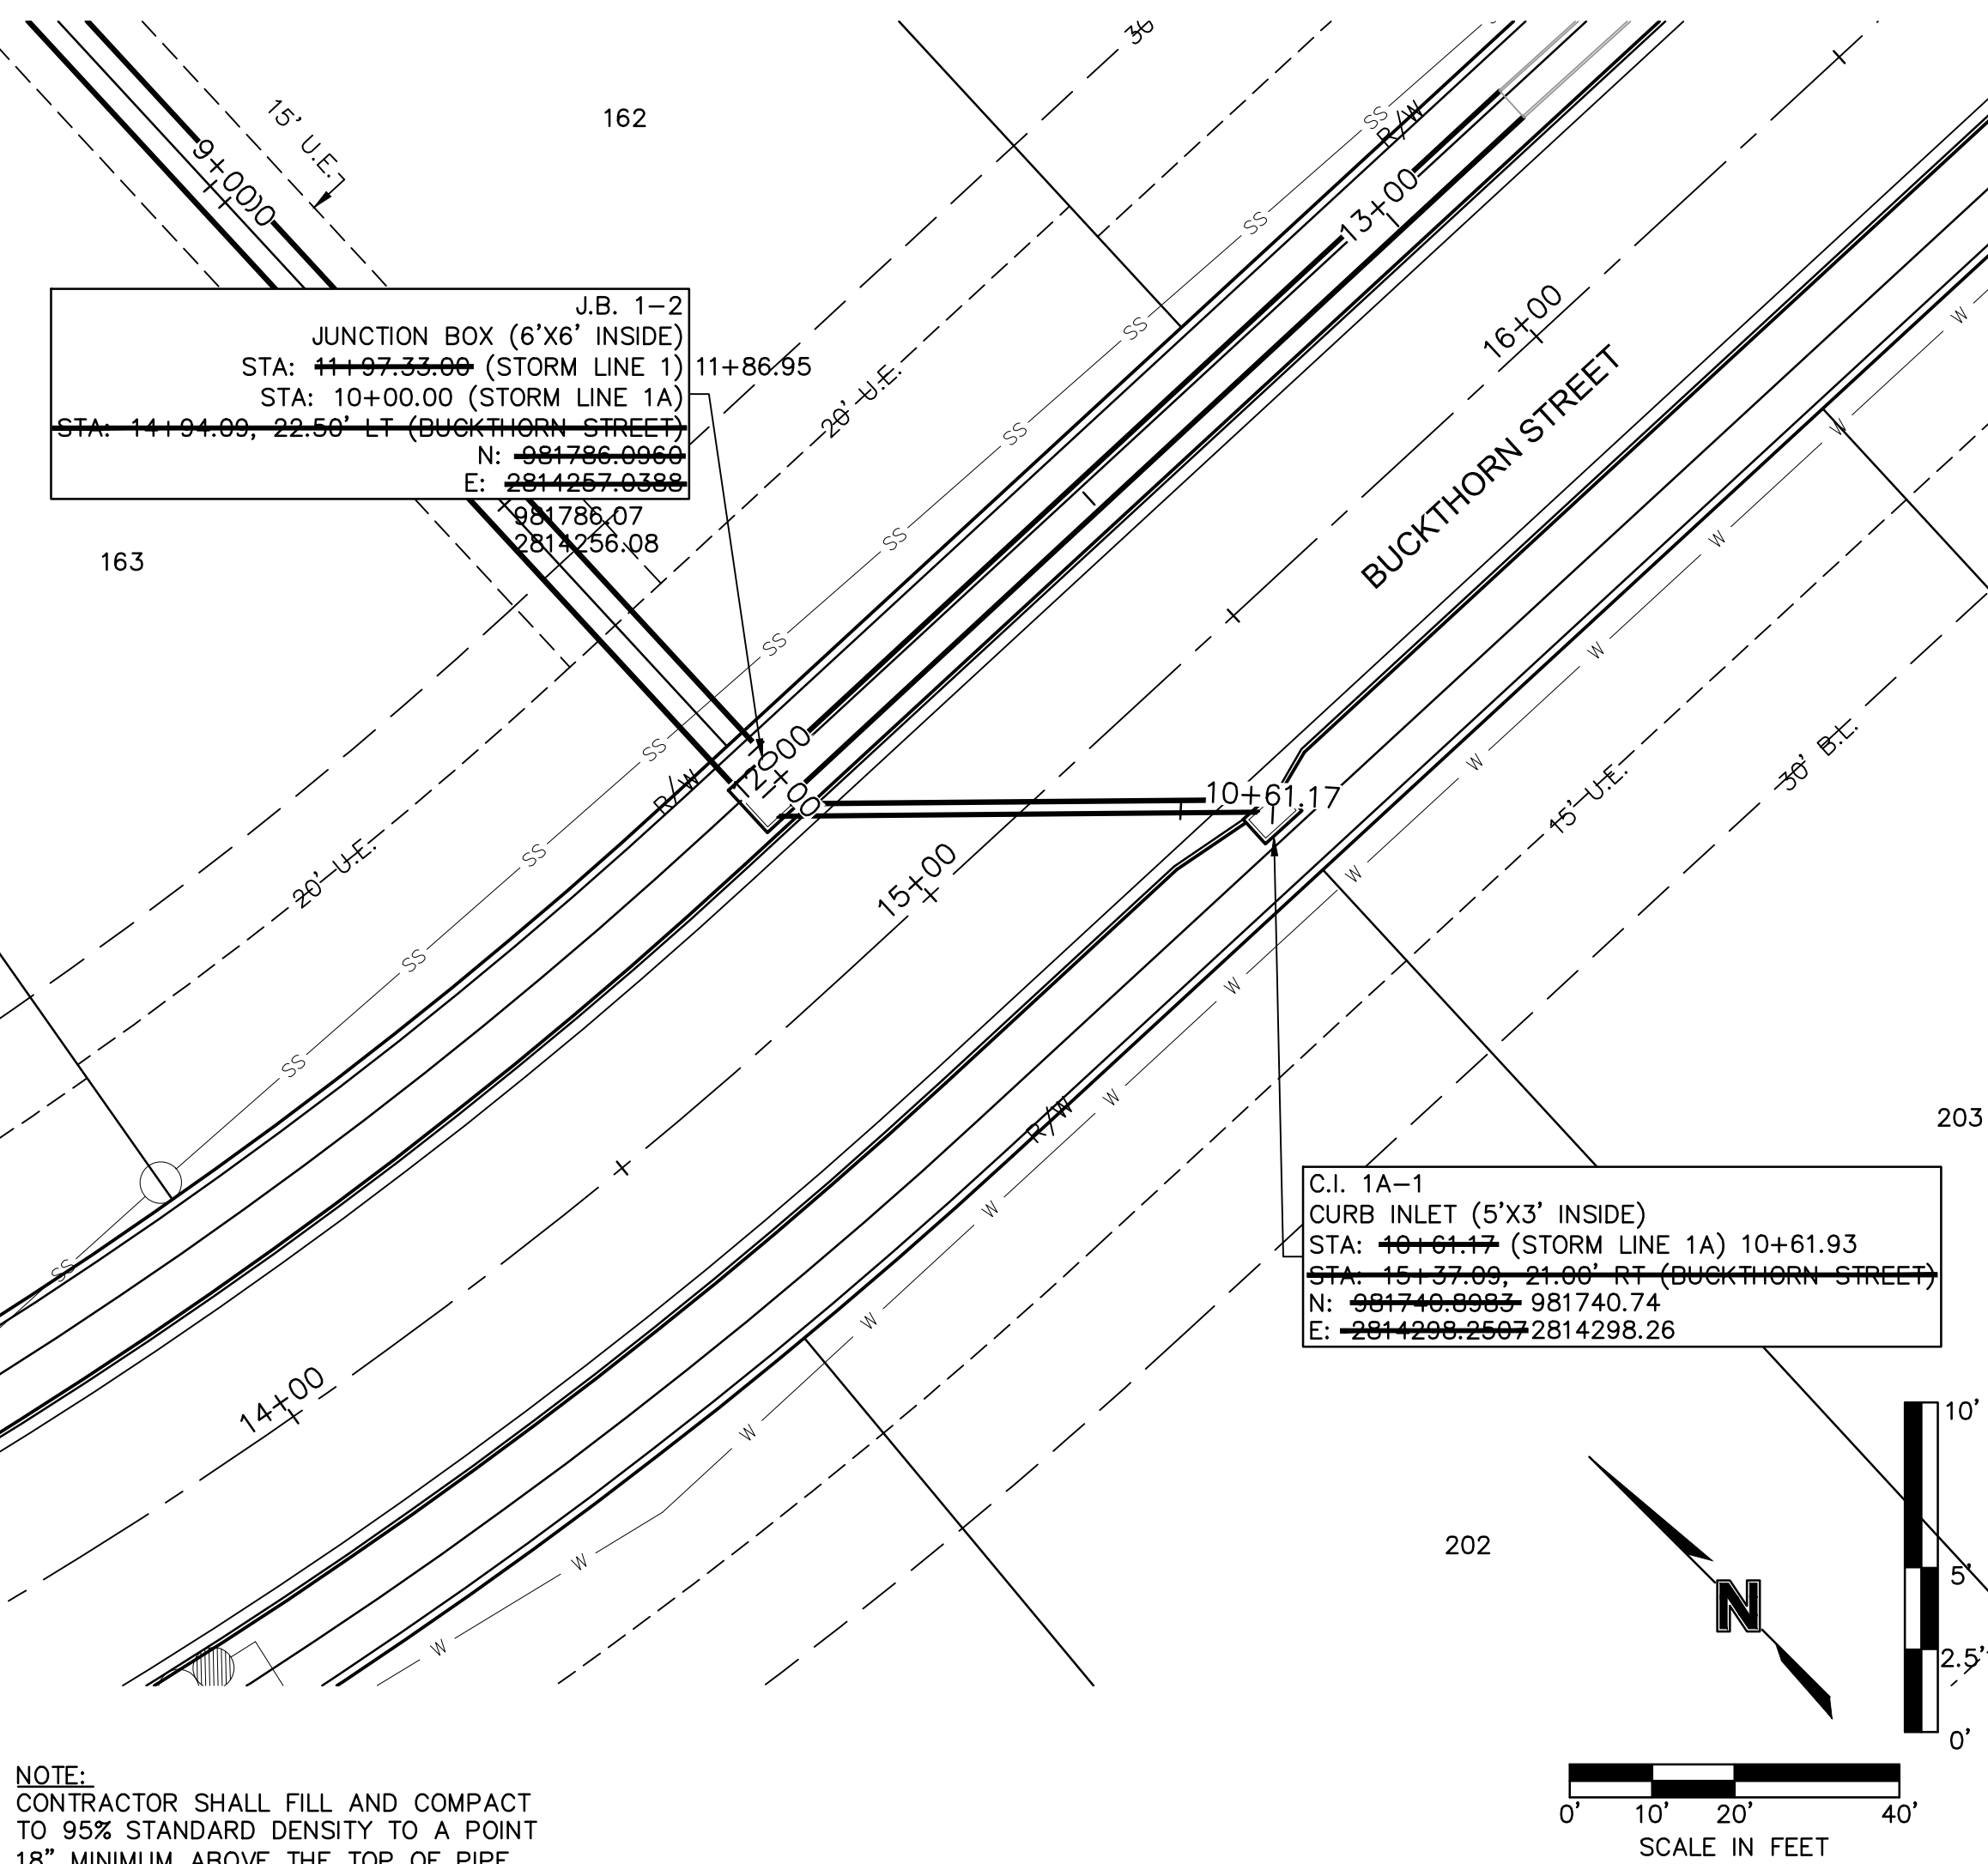


C.I. 1A-1
CURB INLET (5'X3' INSIDE)
STA: 10+61.17 (STORM LINE 1A) 10+61.93
STA: 15+37.09, 21.66' RT (BUCKTHORN STREET)
N: 981746.5082
E: 2814298.2567

STORM LINE 1A (9+75 - 10+75)

Accepted
Record Drawings

These plans have been reviewed for
accuracy and are accepted for basic
conformance to the approved
construction drawings.

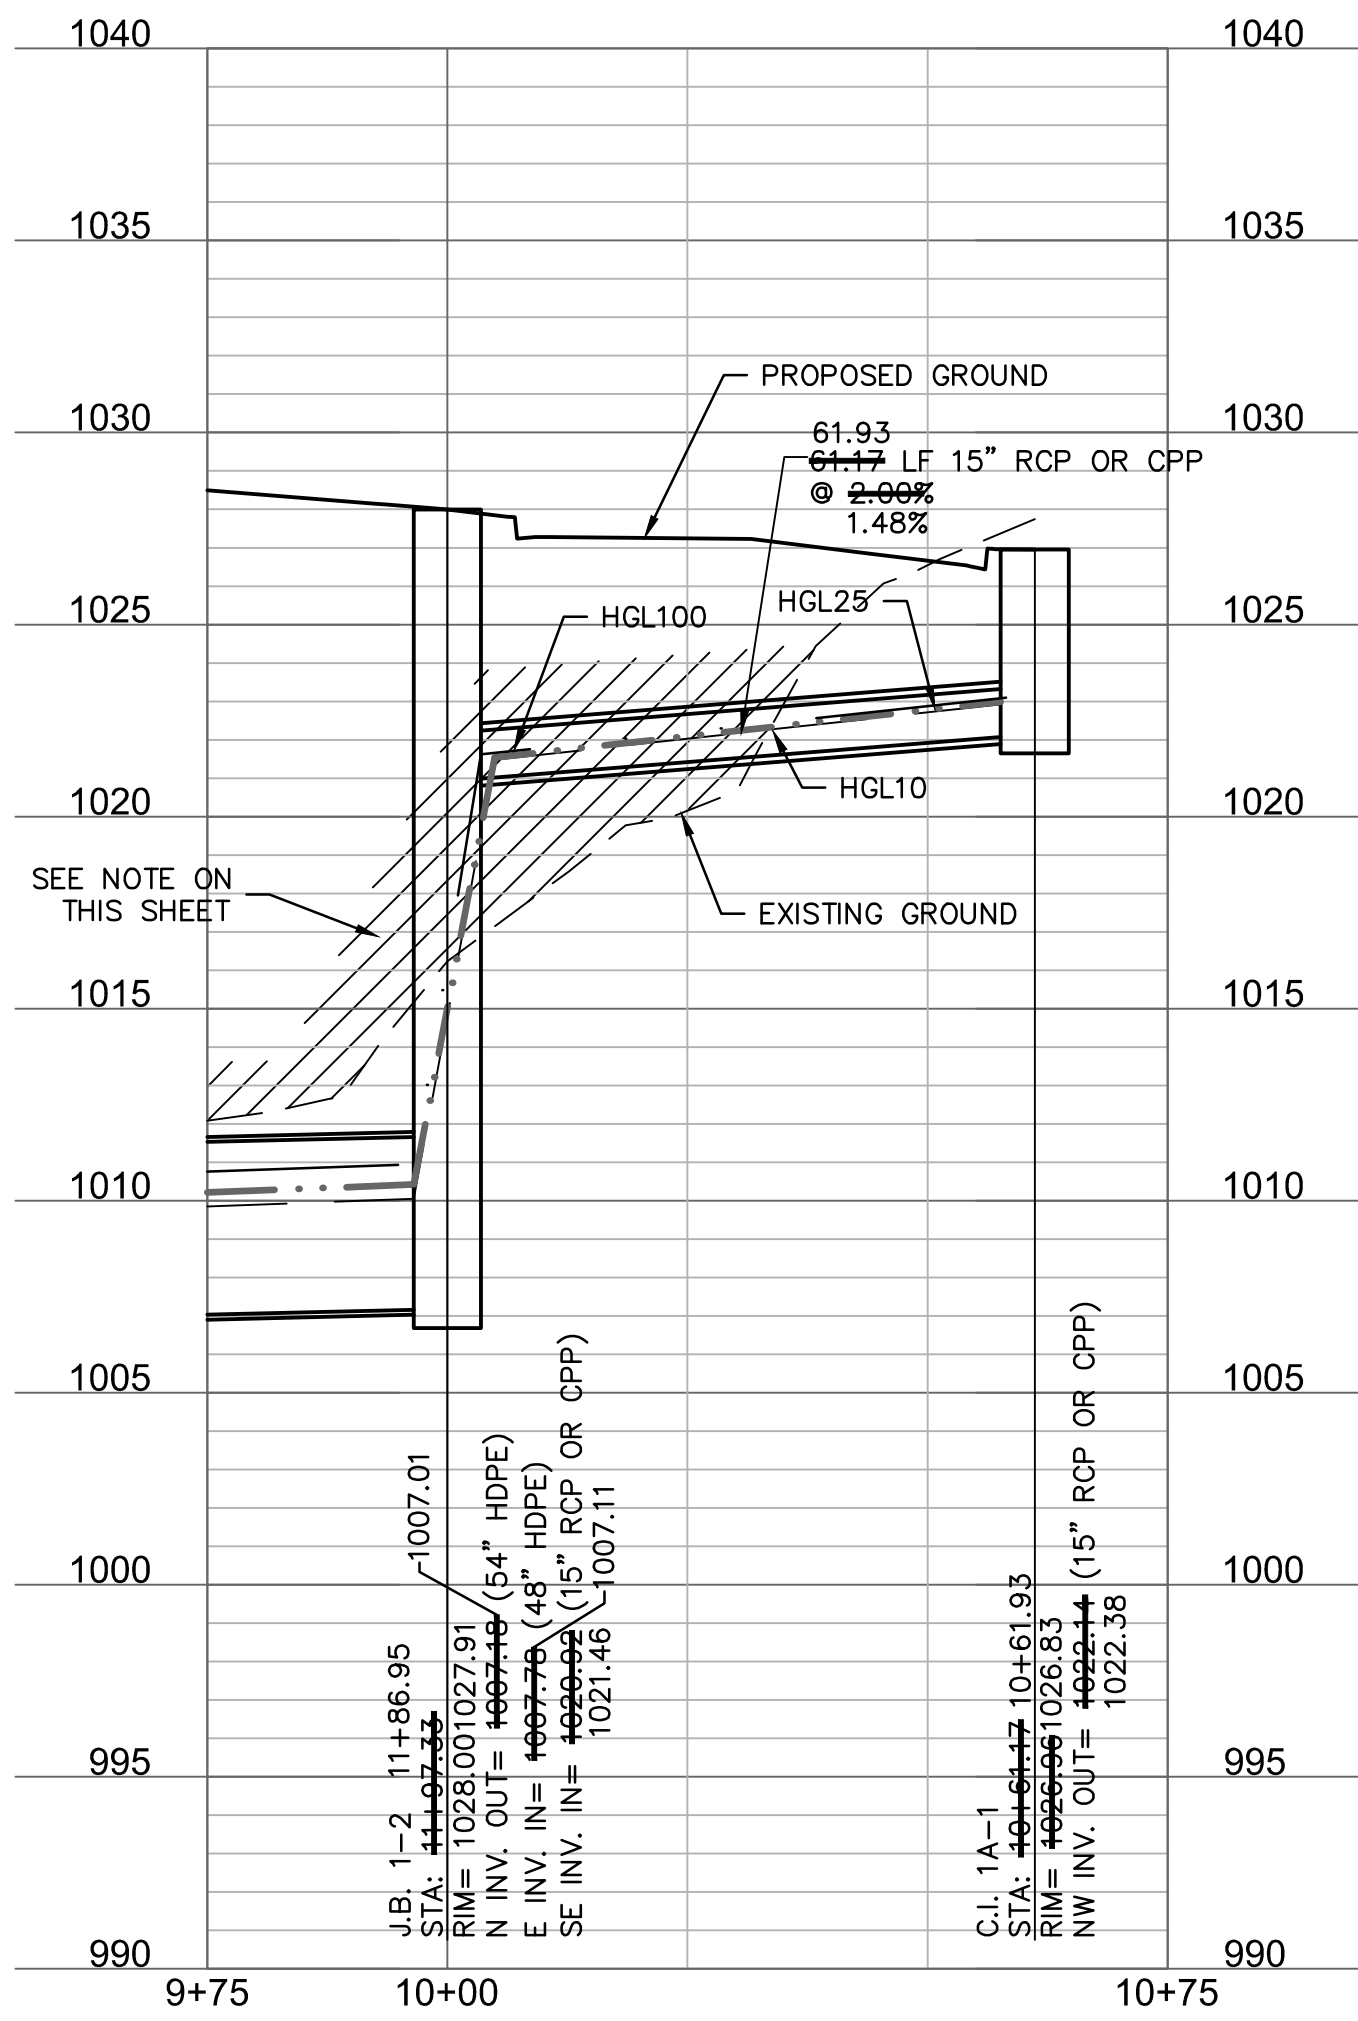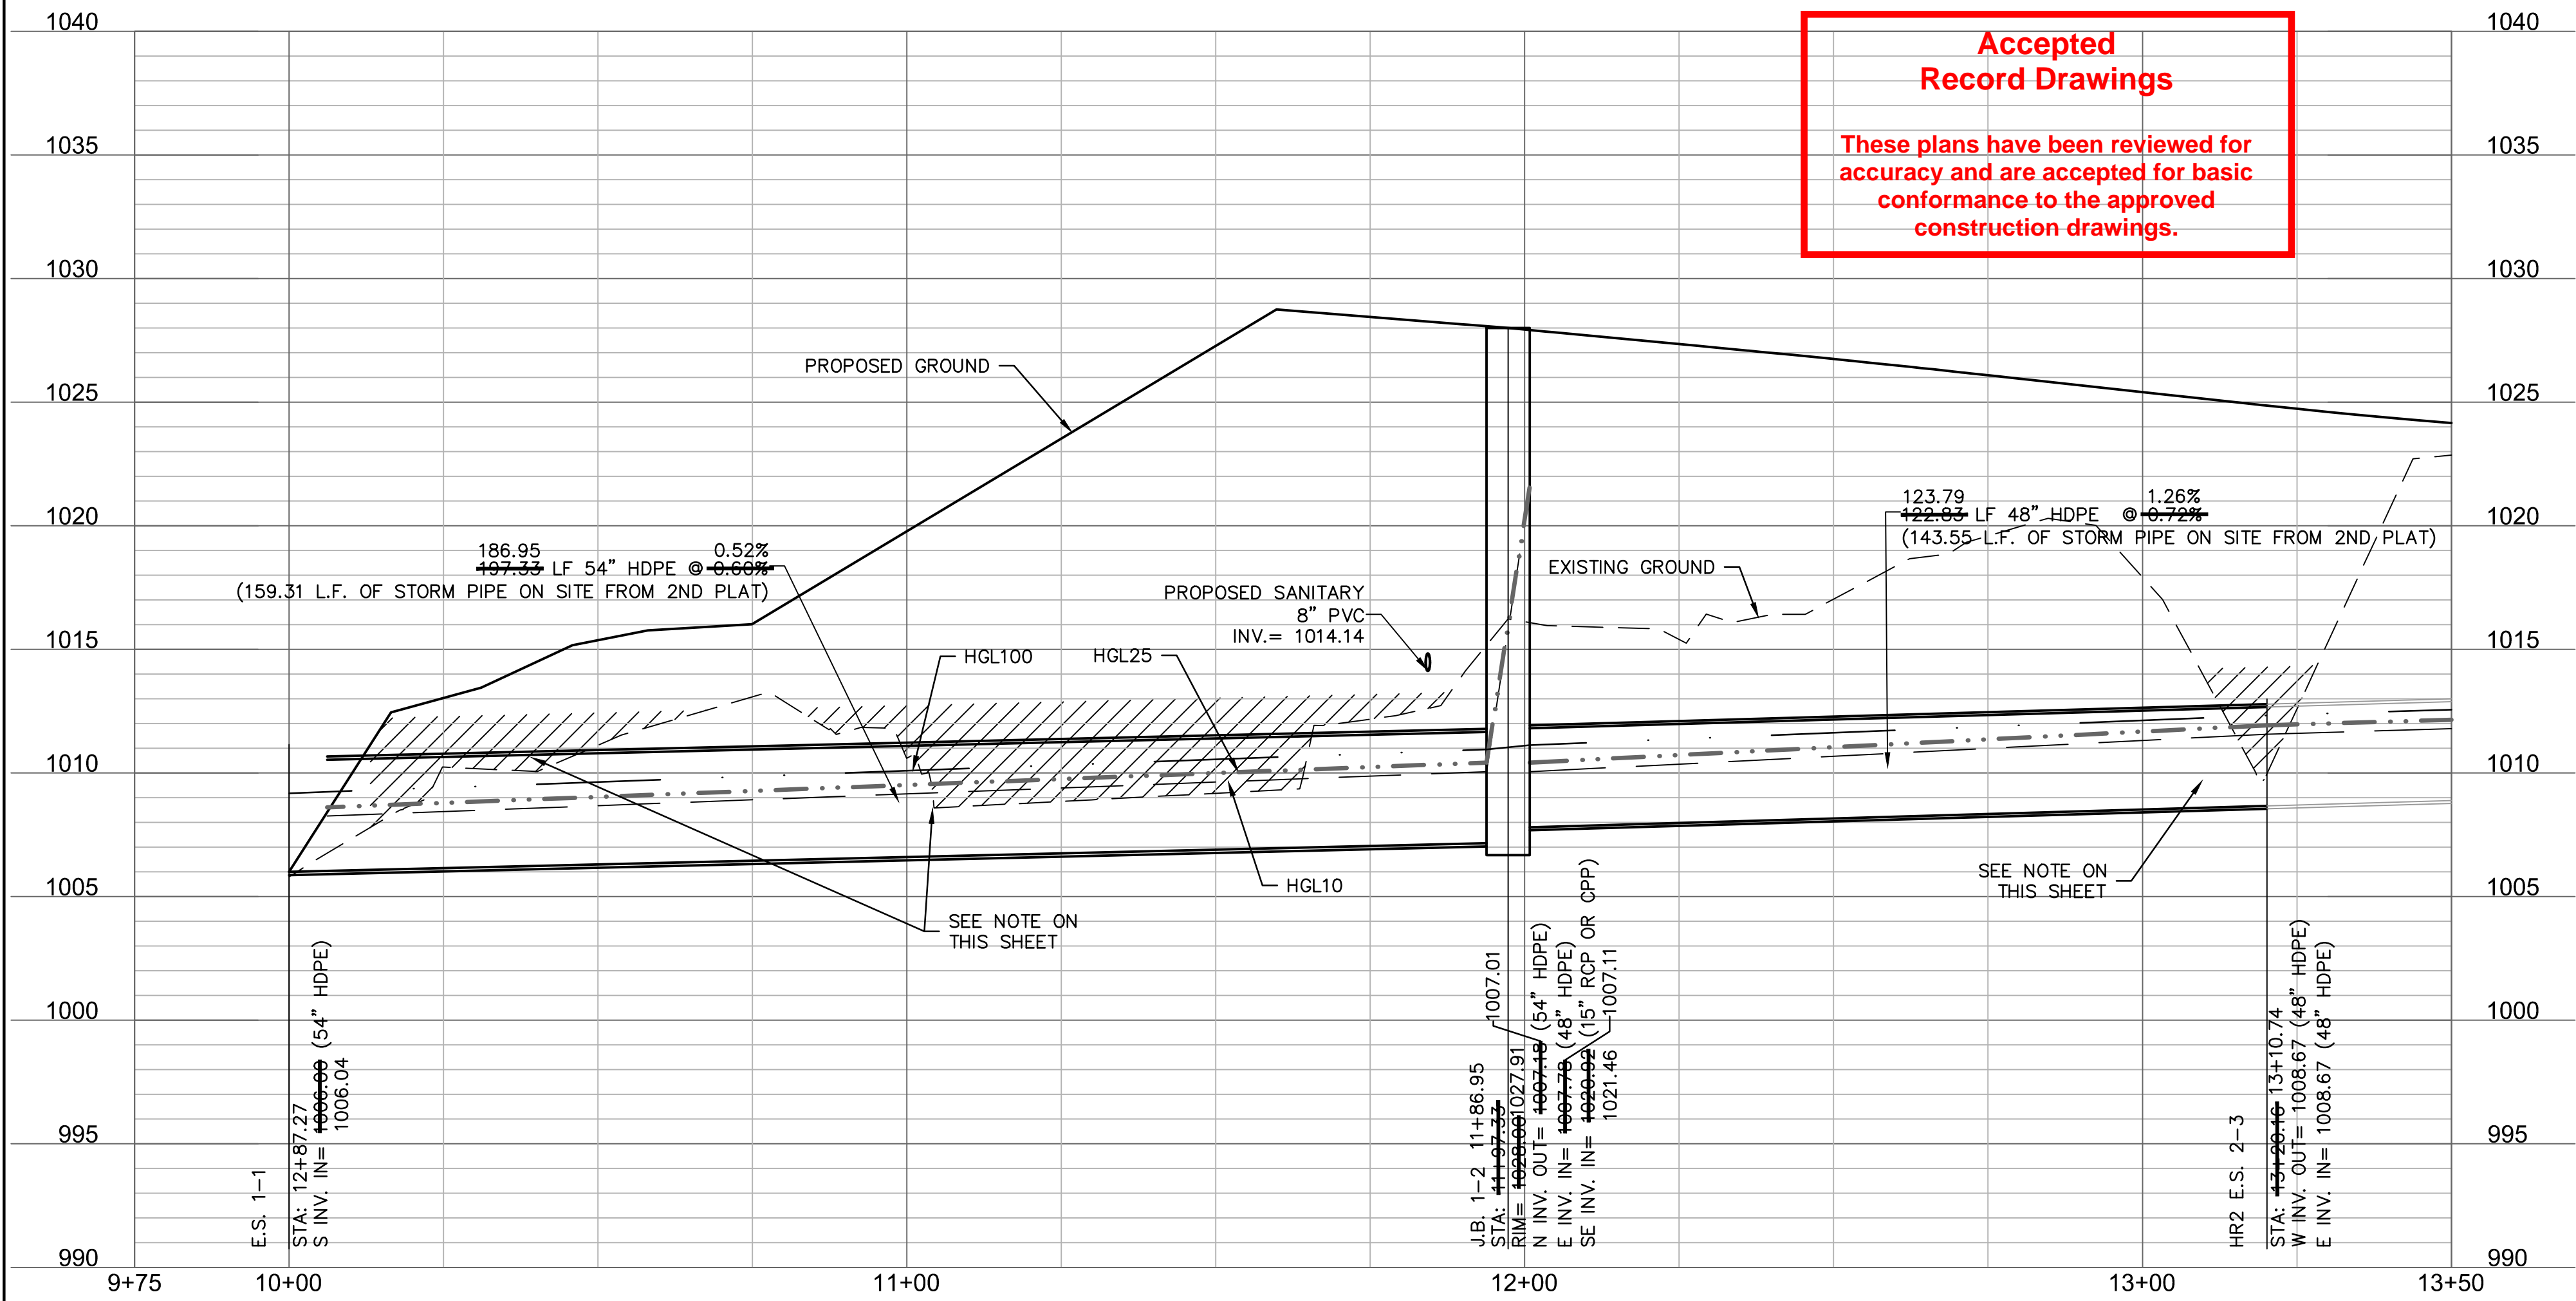

STORM SEWER PLAN & PROFILE (LINE 1 & 1A)
STREET & STORM SEWER PLANS

HAWTHORN RIDGE
THIRD PLAT

LEE'S SUMMIT, MO

2020

drawn by: OLS
checked by: BMW
approved by: BMW
QA/QC by: JES
project no.: A19-1605
drawing no.: C_STM01_A191605
date: 10/02/2020

SHEET
C118



REV. NO.	DATE	REVISIONS DESCRIPTION	BY
1	11/23/2020	REVISED PER CITY COMMENTS	

REVISIONS

olsson

Olsson - Civil Engineering
Missouri Certificate of Authority #001592
1301 Burlington Street
North Kansas City, MO 64116
TEL 816.361.1177
www.olson.com

olsson


Olsson Civil Engineering
Missouri Certificate of Authority #001592
1301 Burlington Street
North Kansas City, MO 64116
TEL 816.361.1177 www.olsson.com

[illegible]

STORM SEWER PLAN & PROFILE (LINE 2) STREET & STORM SEWER PLANS	2020
HAWTHORN RIDGE THIRD PLAT	
LEE'S SUMMIT, MO	


drawn by: _____ OLS
checked by: _____ BMW
approved by: _____ BMW
QA/QC by: _____ JES
project no.: _____ A19-1605
drawing no.: C STM01 A191605
date: _____ 10/02/2020

SHEET
C119

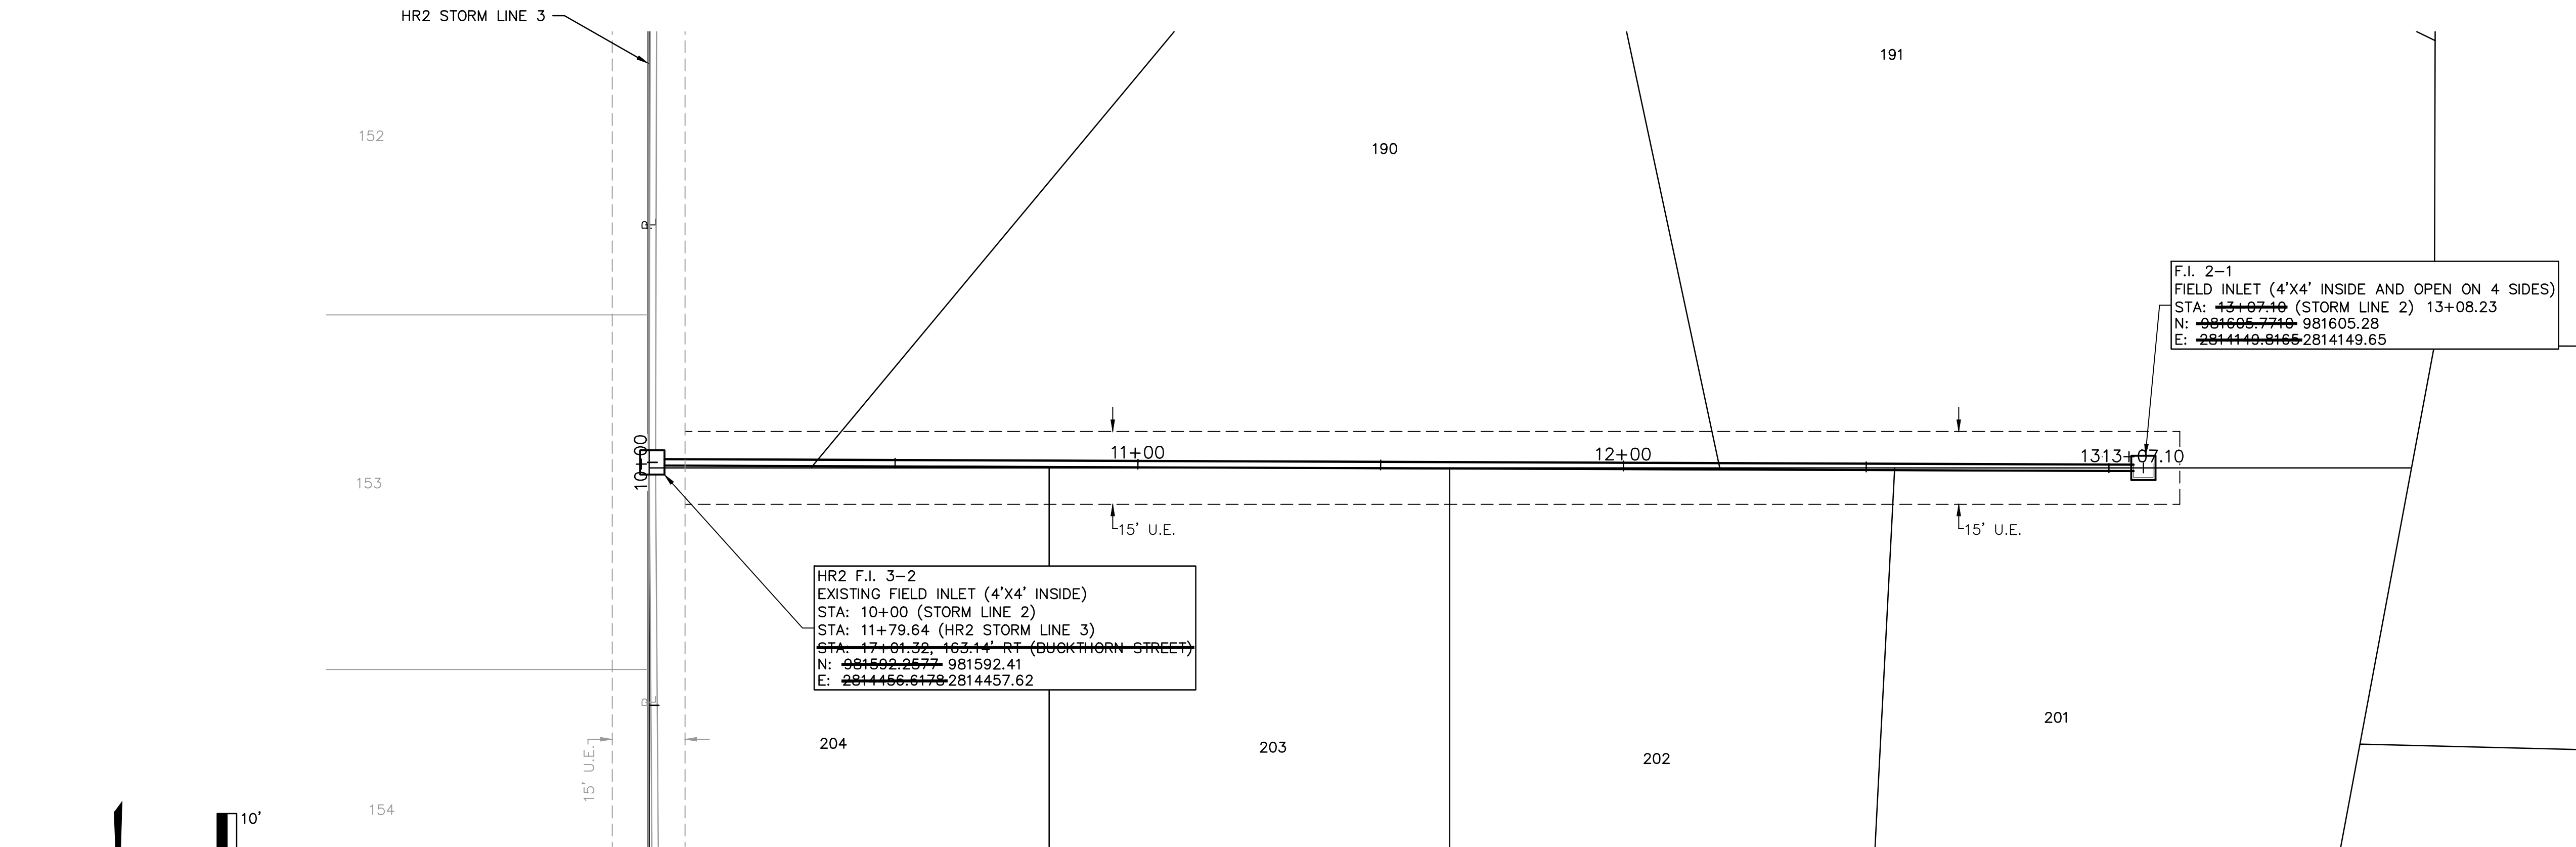

NOTE:
CONTRACTOR SHALL FILL AND COMPACT
TO 95% STANDARD DENSITY TO A POINT
18" MINIMUM ABOVE THE TOP OF PIPE
PRIOR TO EXCAVATION FOR THE PIPE.

STORM LINE 2 (9+75 - 13+25)

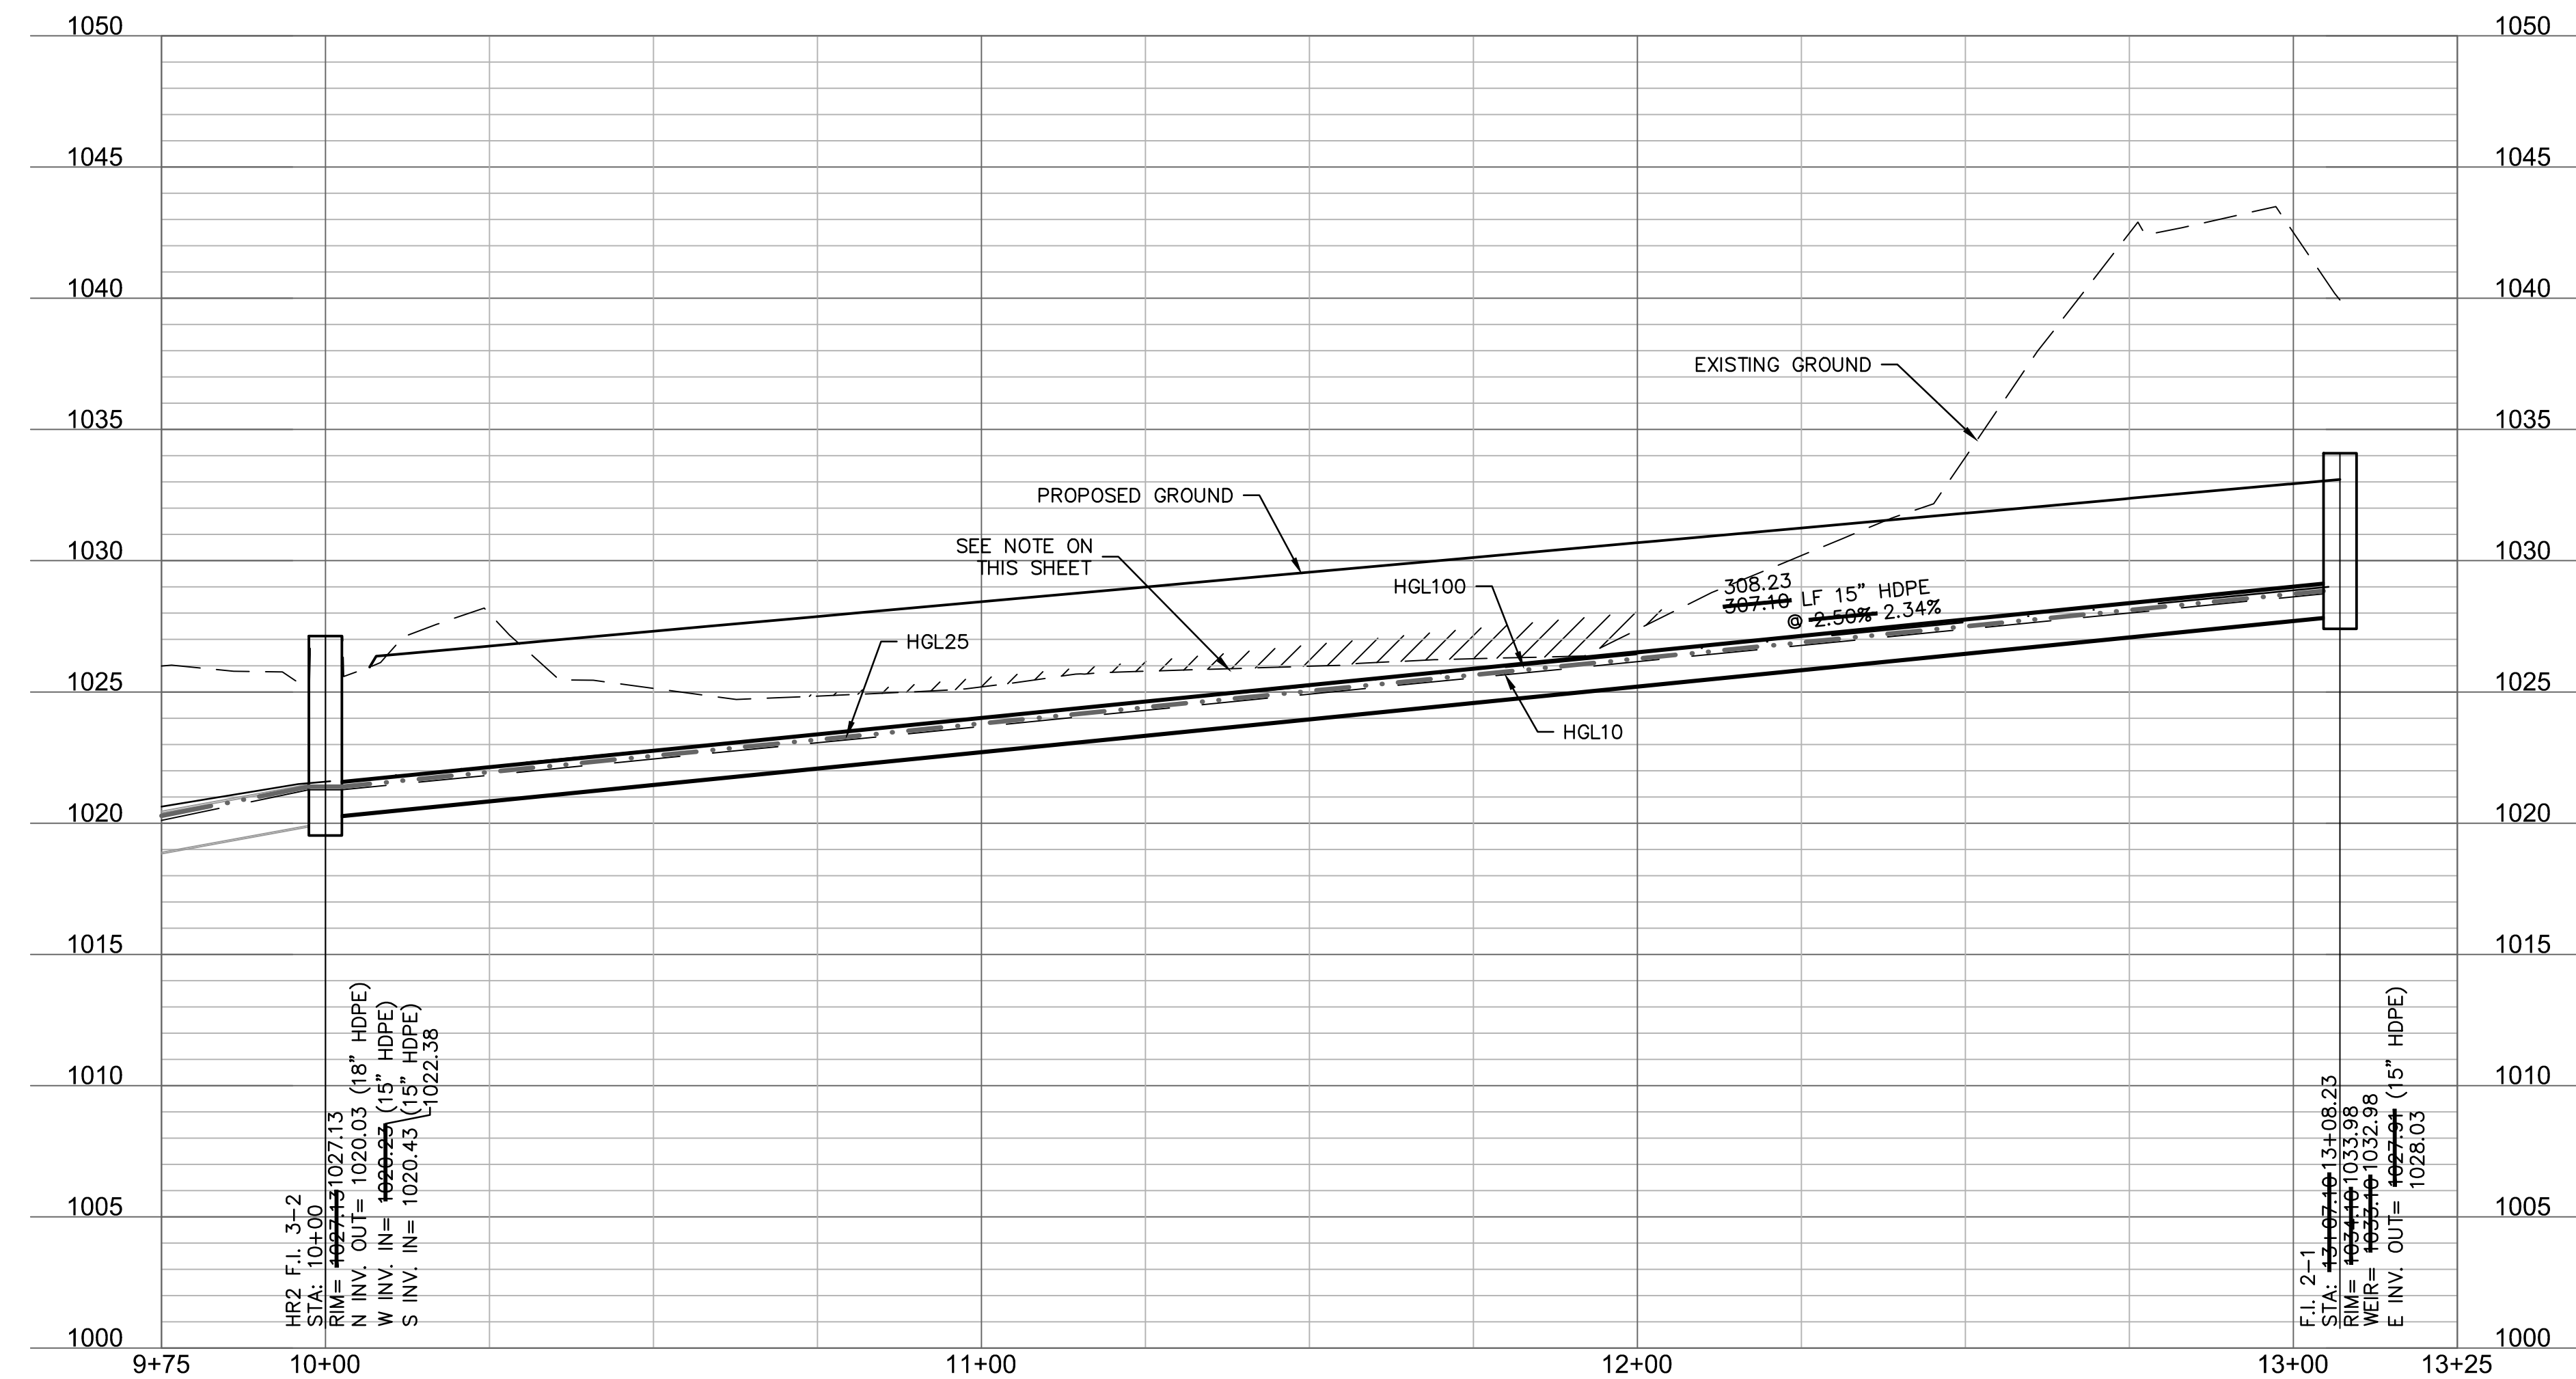

**Accepted
Record Drawings**

These plans have been reviewed for accuracy and are accepted for basic conformance to the approved construction drawings.

DWG: F:\2019\1501-2000\019-1605-A\40-Design\AutoCAD\Final Plans - As-Built\Sheets\GNCA\STREET & STORM\C_STM01_A191605.dwg USER: bworthley
XREFS: C:\BASIC\A191605 C:\XBASE\A191605 C:\PSTRM\A191605 C:\PUTIL\A191605 C:\PTBLK\A191605 C:\PBNDY\A191605
DATE: Jan 18, 2022 3:34pm

olsson



Olsson Civil Engineering
Missouri Certificate of Authority #001592
1301 Burlington Street
North Kansas City, MO 64116
TEL 816.361.1177 www.olsson.com

[illegible]

STORM SEWER PLAN & PROFILE (LINE 3) STREET & STORM SEWER PLANS	2020
HAWTHORN RIDGE THIRD PLAT	
LEE'S SUMMIT, MO	

drawn by: _____ OLS
checked by: _____ BMW
approved by: _____ BMW
QA/QC by: _____ JES
project no.: _____ A19-1605
drawing no.: C STM01 A191605
date: _____ 10/02/2020


SHEET C120

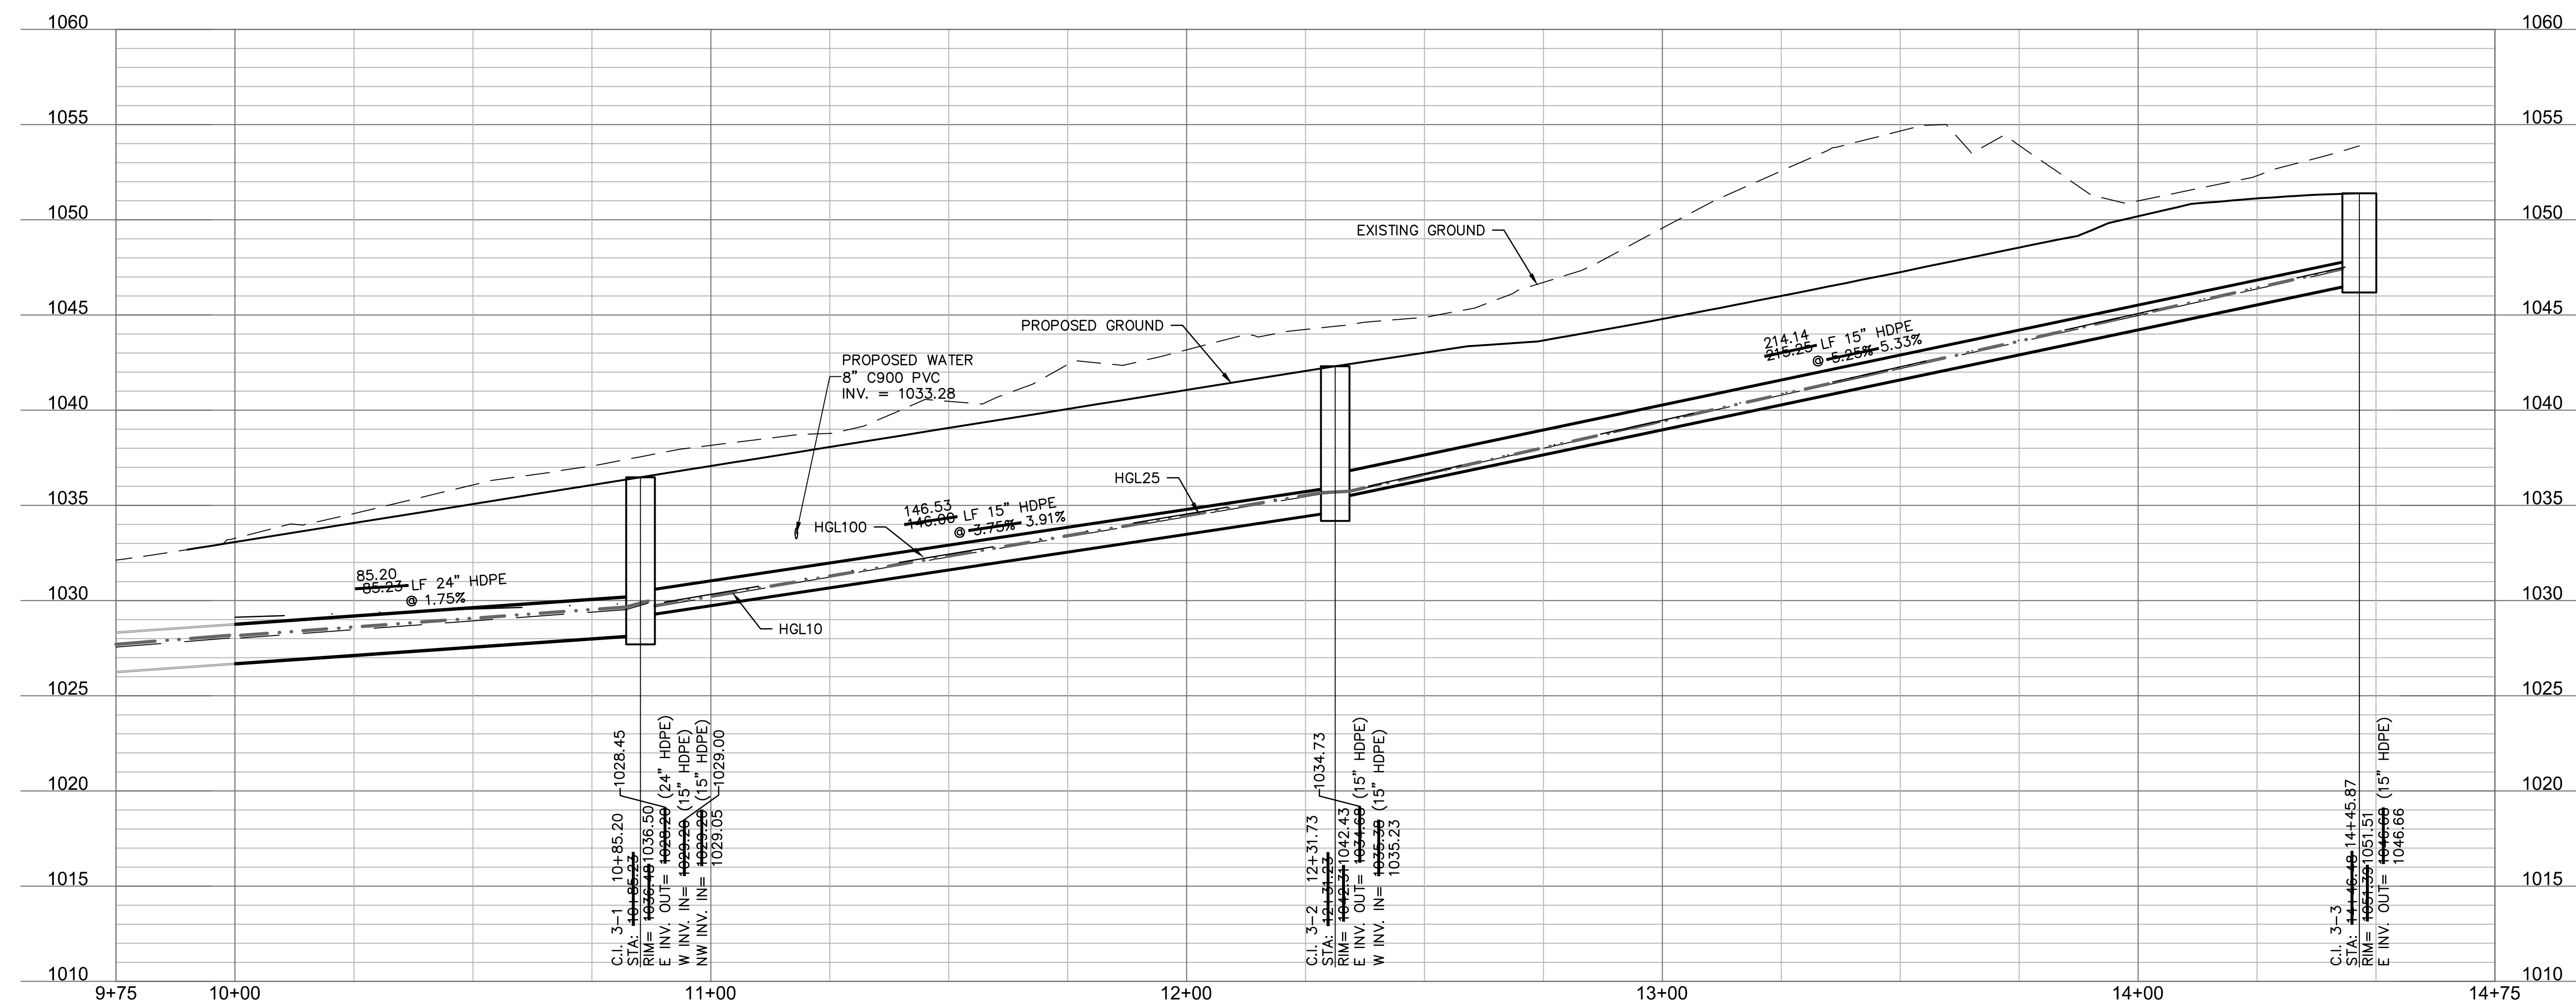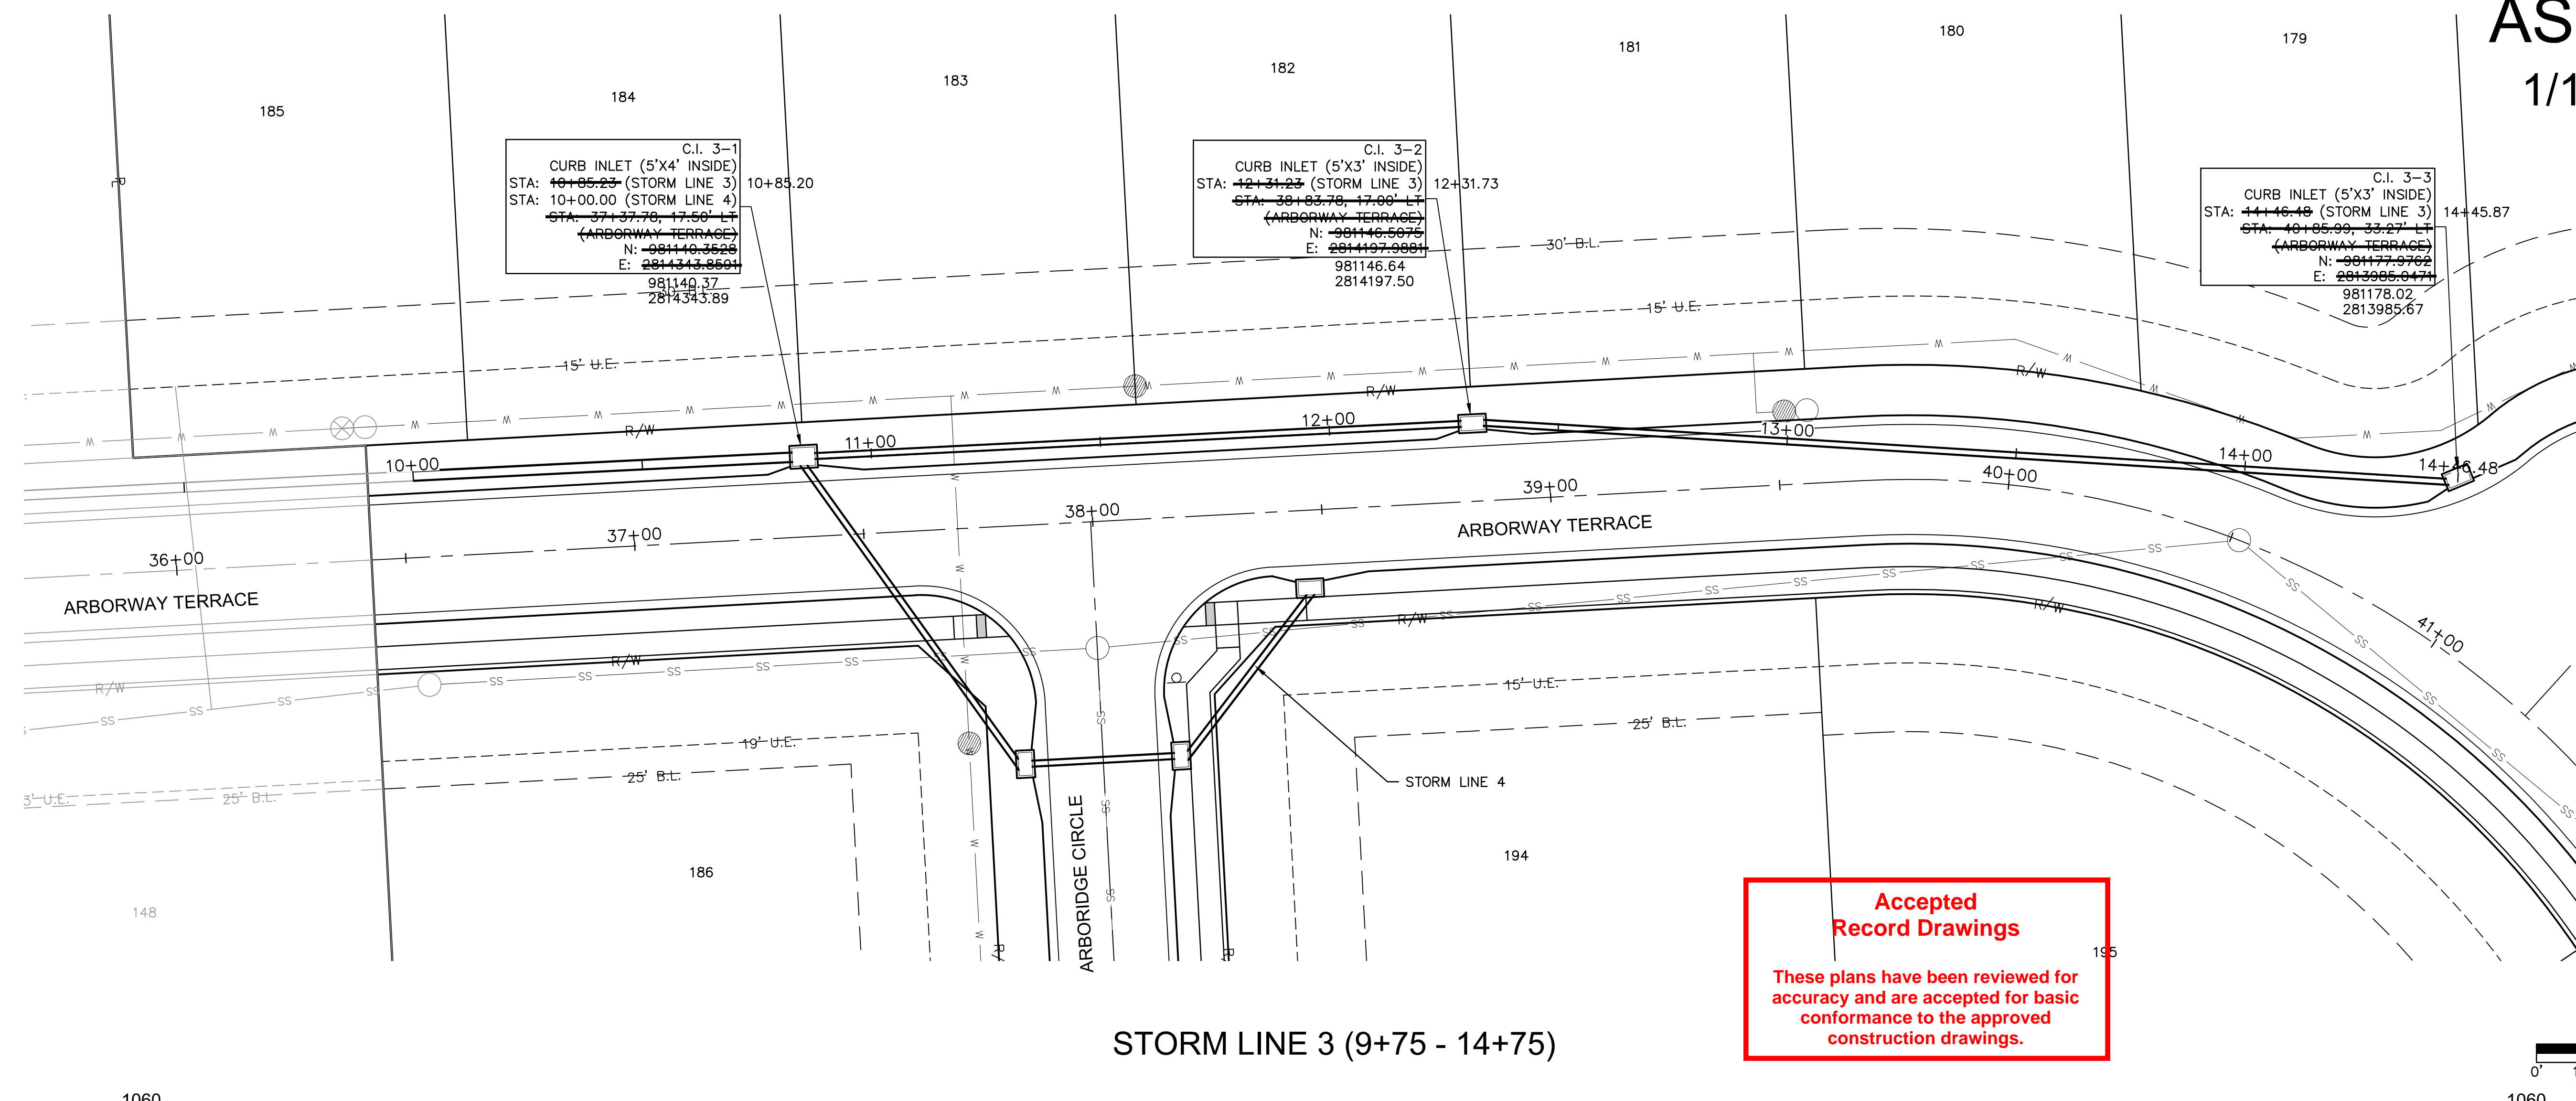

DWG: F:\2019\1501-2000\019-1605-A\40-Design\AutoCAD\Final Plans - As-Built\Sheets\ONCA\STREET & STORM\C_STM01_A191605.dwg USER: bworthley
DATE: Jan 18, 2022 3:34pm XREFS: C:\PBASX_A191605 C:\XBASE_A191605 C:\STRM_A191605 C:\PBLK_A191605 C:\PULL_A191605 C:\PBDY_A191605


olsson

Olsson Civil Engineering
Missouri Certificate of Authority #001592
1301 Burlington Street
North Kansas City, MO 64116
TEL 816.361.1177 www.olsson.com

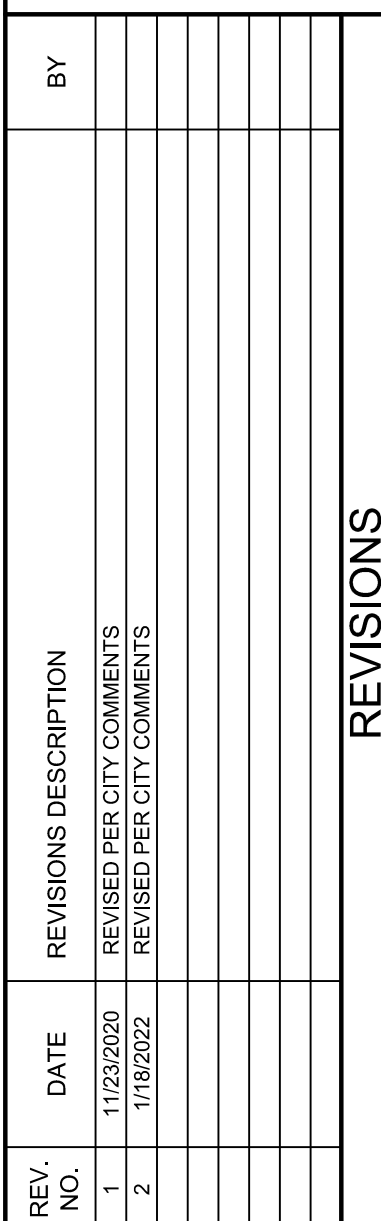

STORM SEWER PLAN & PROFILE (LINE 5) STREET & STORM SEWER PLANS	2020
HAWTHORN RIDGE THIRD PLAT	
LEE'S SUMMIT, MO	

drawn by: _____ OLS
checked by: _____ BMW
approved by: _____ BMW
QA/QC by: _____ JES
project no.: _____ A19-1605
drawing no.: C STM01 A191605
date: _____ 10/02/2020

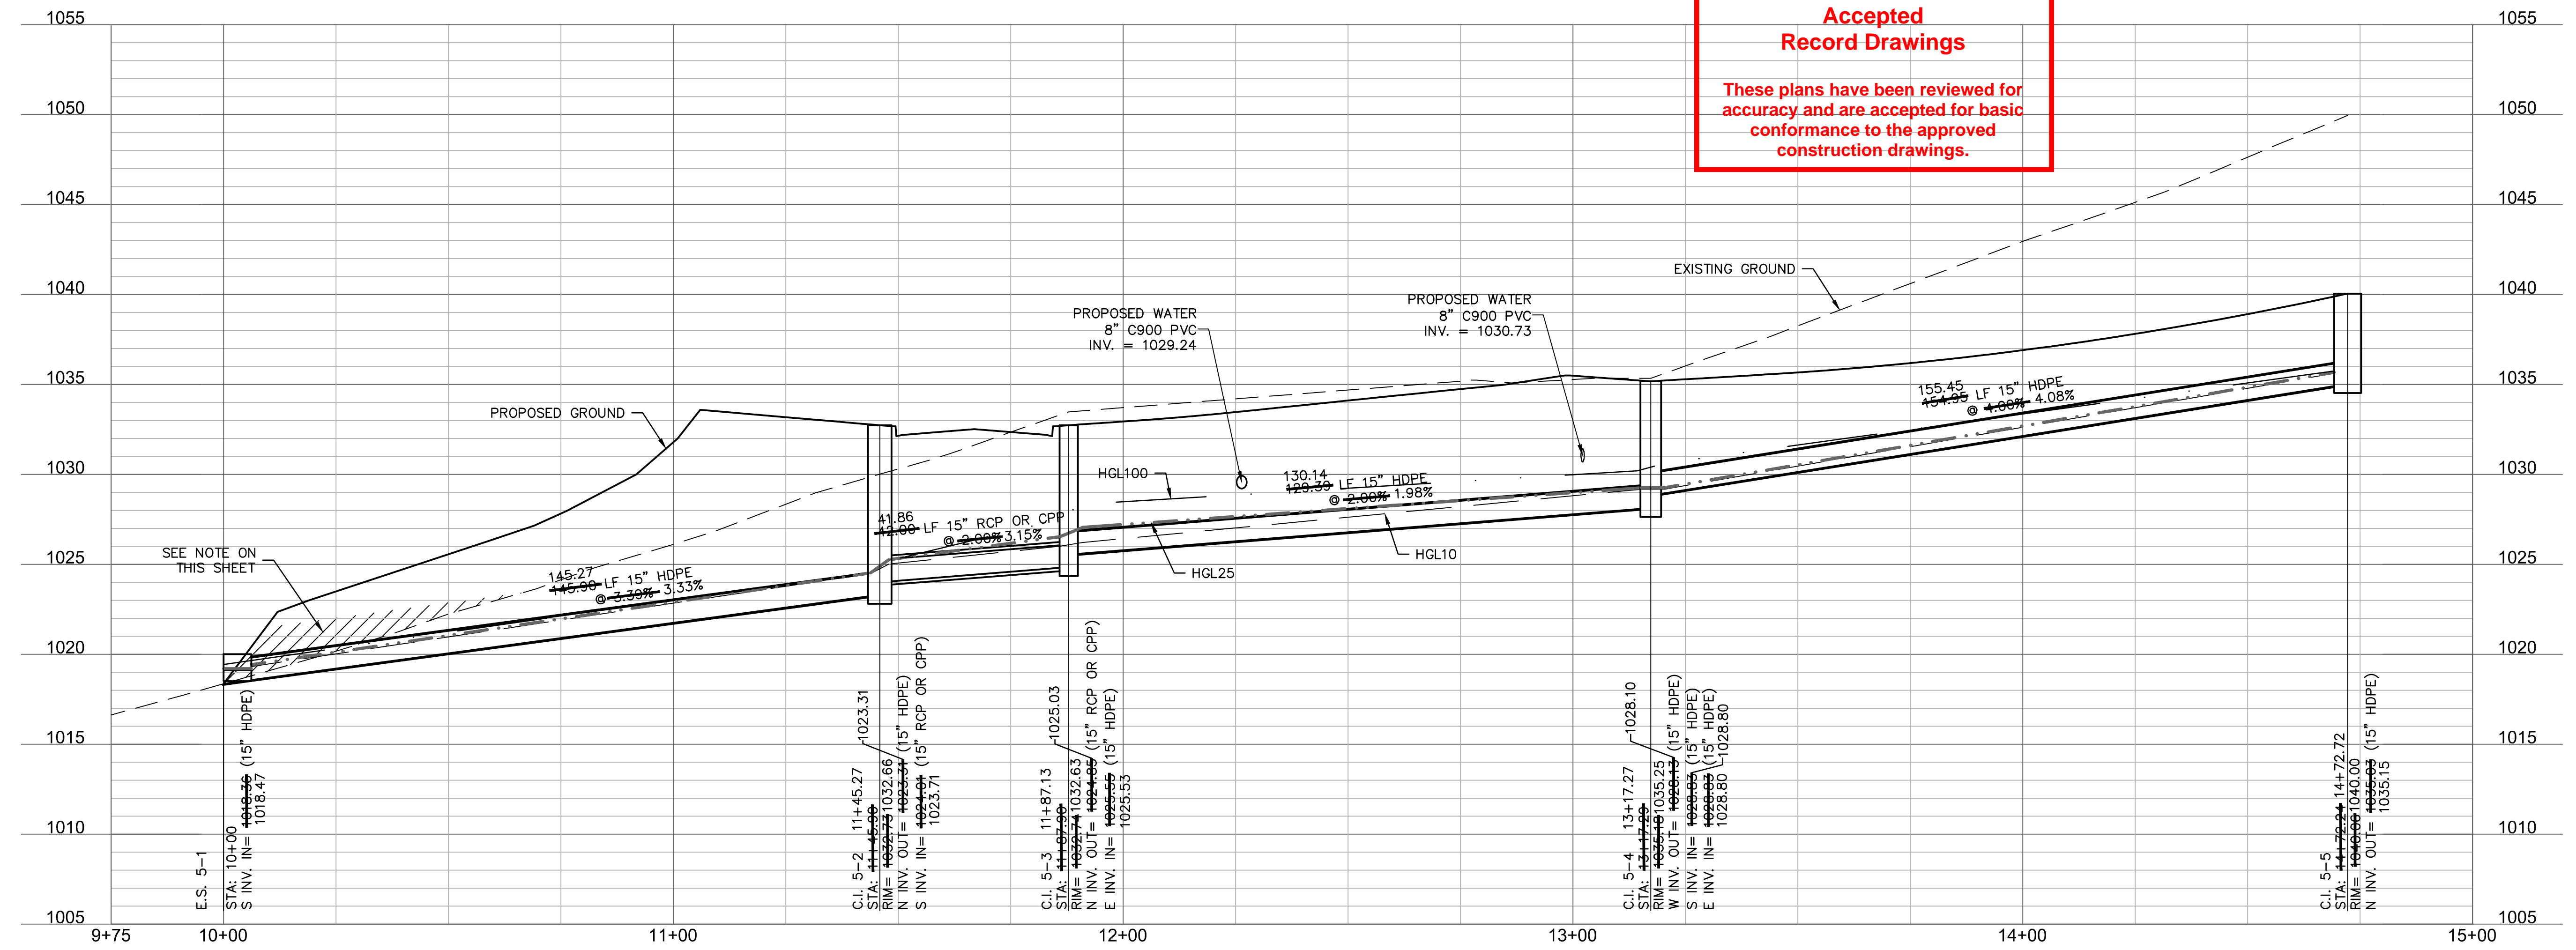



These plans have been reviewed for accuracy and are accepted for basic conformance to the approved construction drawings.

Olsson - Civil Engineering
Missouri Certificate of Authority #001592
1301 Burlington Street
North Kansas City, MO 64116



1

REVISIONS

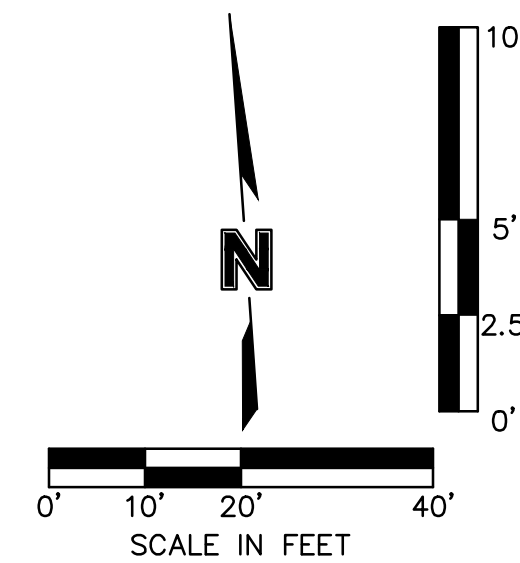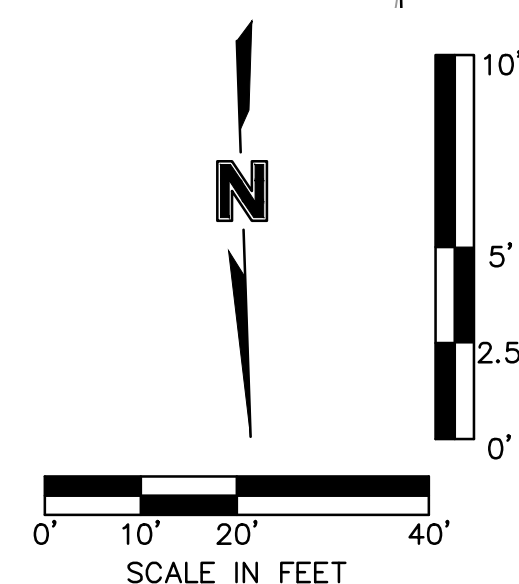[illegible]

ASBUILT
1/18/2022

DWG: F:\2019\1501-2000\019-1605-A\40-Design\AutoCAD\Final Plans - As-Builts\Sheets\GNCV\STREET & STORM\C_STM01_A191605.dwg USER: bworthley
DATE: Jan 18, 2022 3:34pm XREFS: C_PBASE_A191605 C_PBASE_A191605 C_PSTRM_A191605 C_PSTRM_A191605 C_PUTIL_A191605 C_PUTIL_A191605 C_PTBLK_A191605 C_PTBLK_A191605 C_PENDY_A191605 C_PENDY_A191605

USER: bworthley

_A191605.dwg

C:\STORM\C_S

ts\GNCV\STRI

- As-Built's

utoCAD\Final

05-A\40-Des

501-2000\01

DWG: F:/2

DWG: F:\2019\1501-2000\019-1605-A\10-Design\AutoCAD\Final Plans - As-Built\Sheets\GNCA\STREET & STORM\AC_DRN01_A191605.dwg USER: bwerthey C:\PSTRM_A191605
DATE: Jan 18, 2022 3:33pm XREFS: C:\PBLK_A191605 C:\XBASE_A191605

Drainage Area Design Table						
10 Year Return Frequency						
Inlet ID	Drainage Area	C	Tc	i	K	Peak Flow
	(ac)		(min)	(in/hr)		(cfs)
C.I. 1A-1	1.21	0.51	5.00	7.35	1.00	4.54
F.I. 2-1	1.13	0.51	5.00	7.35	1.00	4.24
C.I. 3-1	0.43	0.51	5.00	7.35	1.00	1.61
C.I. 3-2	0.56	0.51	5.00	7.35	1.00	2.10
C.I. 3-3	1.16	0.51	5.00	7.35	1.00	4.35
C.I. 4-1(L)	0.32	0.51	5.00	7.35	1.00	1.20
C.I. 4-1(R)	0.00	0.51	5.00	7.35	1.00	0.00
C.I. 4-1(B)	0.09	0.51	5.00	7.35	1.00	0.34
C.I. 4-1	0.41	0.51	5.00	7.35	1.00	1.54
C.I. 4-2(L)	0.00	0.51	5.00	7.35	1.00	0.00
C.I. 4-2(R)	0.38	0.51	5.00	7.35	1.00	1.43
C.I. 4-2(B)	0.57	0.51	5.00	7.35	1.00	2.14
C.I. 4-2	0.95	0.51	5.00	7.35	1.00	3.56
C.I. 4-3	0.37	0.51	5.00	7.35	1.00	1.39
C.I. 5-2	0.21	0.51	5.00	7.35	1.00	0.79
C.I. 5-3	0.42	0.51	5.00	7.35	1.00	1.58
C.I. 5-4	0.81	0.51	5.00	7.35	1.00	3.04
C.I. 5-5	0.72	0.51	5.00	7.35	1.00	2.70
C.I. 6-1	0.58	0.51	5.00	7.35	1.00	2.18
HR2 F.I. 3-2	1.15	0.51	5.00	7.35	1.00	4.31
HR2 F.I. 3-3	0.52	0.51	5.00	7.35	1.00	1.95

Inlet Design Table													
10 Year Return Frequency													
Inlet ID	Inlet Location	Peak Flow	Upstream Bypass	Total Flow	Clogging Factor	Inlet Capacity	Sag Inlet Capacity (Note 1)	Captured Flow	Bypass Flow	Inlet Efficiency (Note 2)	Gutter Depth	Gutter Spread	Ponding Depth
		(cfs)	(cfs)	(cfs)		(cfs)	(cfs)	(cfs)	(cfs)	(%)	(ft)	(ft)	(ft)
C.I. 1A-1	GRADE	4.54	0.35	4.89	1.00	3.82	3.82	3.82	1.07	78.16%	0.21	9.77	...
F.I. 2-1	SAG	4.24	0.00	4.24	0.80	18.67	14.93	4.24	0.00	100.00%	0.19
C.I. 3-1	GRADE	1.61	1.41	3.02	1.00	1.87	1.87	1.87	1.15	62.03%	0.16	7.78	...
C.I. 3-2	GRADE	2.10	1.31	3.41	1.00	2.00	2.00	2.00	1.41	58.64%	0.16	8.14	...
C.I. 3-3	GRADE	4.35	0.00	4.35	1.00	3.04	3.04	3.04	1.31	69.90%	0.21	10.67	...
C.I. 4-1(L)	SAG	1.20	0.14	7.01	...
C.I. 4-1(R)	SAG	0.00	0.00	0.00	...
C.I. 4-1(B)	SAG	0.34
C.I. 4-1	SAG	1.54	0.00	1.54	0.80	19.40	15.52	1.54	0.00	100.00%
C.I. 4-2(L)	SAG	0.00	0.09	4.34	...
C.I. 4-2(R)	SAG	1.43	0.15	7.48	...
C.I. 4-2(B)	SAG	2.14
C.I. 4-2	SAG	3.56	0.33	3.90	0.80	19.40	15.52	3.90	0.00	100.00%
C.I. 4-3	GRADE	1.39	0.00	1.39	1.00	1.05	1.05	1.05	0.33	76.01%	0.11	5.51	...
C.I. 5-2	GRADE	0.79	0.00	0.79	1.00	0.79	0.79	0.79	0.00	99.69%	0.13	5.83	...
C.I. 5-3	GRADE	1.58	0.90	2.47	1.00	2.37	2.37	2.37	0.10	95.95%	0.19	8.86	...
C.I. 5-4	GRADE	3.04	0.53	3.57	1.00	2.67	2.67	2.67	0.90	74.83%	0.20	9.96	...
C.I. 5-5	GRADE	2.70	0.00	2.70	1.00	2.17	2.17	2.17	0.53	80.31%	0.18	8.97	...
C.I. 6-1	GRADE	2.18	0.00	2.18	1.00	1.82	1.82	1.82	0.35	83.89%	0.17	8.27	...
HR2 F.I. 3-2	SAG	4.31	0.00	4.31	0.80	18.67	14.93	4.31	0.00	100.00%	0.19
HR2 F.I. 3-3	SAG	1.95	0.00	1.95	0.80	18.67	14.93	1.95	0.00	100.00%	0.11

Notes:
1. Inlet capacity at sag location has been reduced by a clogging factor of 0.80, reducing theoretical capacity to 80% capacity, as required per APWA Section 5600.
Both theoretical capacity and reduced capacity are shown.
2. Inlet efficiency shown in the tables is Captured Flow/Total Flow, denoting the actual percentage of flow captured after the capacity has been reduced to 80% of theoretical capacity.

Drainage Area Design Table						
25 Year Return Frequency						
Inlet ID	Drainage Area	C	Tc	i	K	Peak Flow
	(ac)		(min)	(in/hr)		(cfs)
C.I. 1A-1	1.21	0.51	5.00	8.53	1.10	5.79
F.I. 2-1	1.13	0.51	5.00	8.53	1.10	5.41
C.I. 3-1	0.43	0.51	5.00	8.53	1.10	2.06
C.I. 3-2	0.56	0.51	5.00	8.53	1.10	2.68
C.I. 3-3	1.16	0.51	5.00	8.53	1.10	5.55
C.I. 4-1(L)	0.32	0.51	5.00	8.53	1.10	1.53
C.I. 4-1(R)	0.00	0.51	5.00	8.53	1.10	0.00
C.I. 4-1(B)	0.09	0.51	5.00	8.53	1.10	0.43
C.I. 4-1	0.41	0.51	5.00	8.53	1.10	1.96
C.I. 4-2(L)	0.00	0.51	5.00	8.53	1.10	0.00
C.I. 4-2(R)	0.38	0.51	5.00	8.53	1.10	1.82
C.I. 4-2(B)	0.57	0.51	5.00	8.53	1.10	2.73
C.I. 4-2	0.95	0.51	5.00	8.53	1.10	4.55
C.I. 4-3	0.37	0.51	5.00	8.53	1.10	1.77
C.I. 5-2	0.21	0.51	5.00	8.53	1.10	1.00
C.I. 5-3	0.42	0.51	5.00	8.53	1.10	2.01
C.I. 5-4	0.81	0.51	5.00	8.53	1.10	3.88
C.I. 5-5	0.72	0.51	5.00	8.53	1.10	3.45
C.I. 6-1	0.58	0.51	5.00	8.53	1.10	2.78
HR2 F.I. 3-2	1.15	0.51	5.00	8.53	1.10	5.50
HR2 F.I. 3-3	0.52	0.51	5.00	8.53	1.10	2.49

Inlet Design Table													
25 Year Return Frequency													
Inlet ID	Inlet Location	Peak Flow	Upstream Bypass	Total Flow	Clogging Factor	Inlet Capacity	Sag Inlet Capacity (Note 1)	Captured Flow	Bypass Flow	Inlet Efficiency (Note 2)	Gutter Depth	Gutter Spread	Ponding Depth
		(cfs)	(cfs)	(cfs)		(cfs)	(cfs)	(cfs)	(cfs)	(%)	(ft)	(ft)	(ft)
C.I. 1A-1	GRADE	5.79	0.56	6.35	1.00	4.54	4.54	4.54	1.81	71.43%	0.23	10.78	...
F.I. 2-1	SAG	5.41	0.00	5.41	0.80	18.67	14.93	5.41	0.00	100.00%	0.22
C.I. 3-1	GRADE	2.06	2.39	4.44	1.00	2.26	2.26	2.26	2.18	50.84%	0.18	8.99	...
C.I. 3-2	GRADE	2.68	2.02	4.70	1.00	2.31	2.31	2.31	2.39	49.18%	0.18	9.18	...
C.I. 3-3	GRADE	5.55	0.00	5.55	1.00	3.53	3.53	3.53	2.02	63.67%	0.23	11.69	...
C.I. 4-1(L)	SAG	1.53	0.15	7.68	...
C.I. 4-1(R)	SAG	0.00	0.00	0.00	...
C.I. 4-1(B)	SAG	0.43
C.I. 4-1	SAG	1.96	0.00	1.96	0.80	19.40	15.52	1.96	0.00	100.00%
C.I. 4-2(L)	SAG	0.00	0.10	5.13	...
C.I. 4-2(R)	SAG	1.82	0.16	8.19	...
C.I. 4-2(B)	SAG	2.73
C.I. 4-2	SAG	4.55	0.52	5.07	0.80	19.40	15.52	5.07	0.00	100.00%
C.I. 4-3	GRADE	1.77	0.00	1.77	1.00	1.25	1.25	1.25	0.52	70.59%	0.12	6.03	...
C.I. 5-2	GRADE	1.00	0.00	1.00	1.00	1.00	1.00	1.00	0.00	100.00%	0.14	6.39	...
C.I. 5-3	GRADE	2.01	1.49	3.50	1.00	3.22	3.22	3.22	0.28	92.07%	0.22	10.09	...
C.I. 5-4	GRADE	3.88	0.84	4.72	1.00	3.22	3.22	3.22	1.49	68.37%	0.22	11.05	...
C.I. 5-5	GRADE	3.45	0.00	3.45	1.00	2.60	2.60	2.60	0.84	75.58%	0.20	9.83	...
C.I. 6-1	GRADE	2.78	0.00	2.78	1.00	2.22	2.22	2.22	0.56	79.81%	0.18	9.06	...
HR2 F.I. 3-2	SAG	5.50	0.00	5.50	0.80	18.67	14.93	5.50	0.00	100.00%	0.22
HR2 F.I. 3-3	SAG	2.49	0.00	2.49	0.80	18.67	14.93	2.49	0.00	100.00%	0.13

Notes:
1. Inlet capacity at sag location has been reduced by a clogging factor of 0.80, reducing theoretical capacity to 80% capacity, as required per APWA Section 5600.
Both theoretical capacity and reduced capacity are shown.
2. Inlet efficiency shown in the tables is Captured Flow/Total Flow, denoting the actual percentage of flow captured after the capacity has been reduced to 80% of theoretical capacity.

Drainage Area Design Table						
100 Year Return Frequency						
Inlet ID	Drainage Area	C	Tc	i	K	Peak Flow
	(ac)		(min)	(in/hr)		(cfs)
C.I. 1A-1	1.21	0.51	5.00	10.32	1.25	7.96
F.I. 2-1	1.13	0.51	5.00	10.32	1.25	7.44
C.I. 3-1	0.43	0.51	5.00	10.32	1.25	2.83
C.I. 3-2	0.56	0.51	5.00	10.32	1.25	3.69
C.I. 3-3	1.16	0.51	5.00	10.32	1.25	7.63
C.I. 4-1(L)	0.32	0.51	5.00	10.32	1.25	2.11
C.I. 4-1(R)	0.00	0.51	5.00	10.32	1.25	0.00
C.I. 4-1(B)	0.09	0.51	5.00	10.32	1.25	0.59
C.I. 4-1	0.41	0.51	5.00	10.32	1.25	2.70
C.I. 4-2(L)	0.00	0.51	5.00	10.32	1.25	0.00
C.I. 4-2(R)	0.38	0.51	5.00	10.32	1.25	2.50
C.I. 4-2(B)	0.57	0.51	5.00	10.32	1.25	3.75
C.I. 4-2	0.95	0.51	5.00	10.32	1.25	6.25
C.I. 4-3	0.37	0.51	5.00	10.32	1.25	2.43
C.I. 5-2	0.21	0.51	5.00	10.32	1.25	1.38
C.I. 5-3	0.42	0.51	5.00	10.32	1.25	2.76
C.I. 5-4	0.81	0.51	5.00	10.32	1.25	5.33
C.I. 5-5	0.72	0.51	5.00	10.32	1.25	4.74
C.I. 6-1	0.58	0.51	5.00	10.32	1.25	3.82
HR2 F.I. 3-2	1.15	0.51	5.00	10.32	1.25	7.57
HR2 F.I. 3-3	0.52	0.51	5.00	10.32	1.25	3.42

Inlet Design Table													
100 Year Return Frequency													
Inlet ID	Inlet Location	Peak Flow	Upstream Bypass	Total Flow	Clogging Factor	Inlet Capacity	Sag Inlet Capacity (Note 1)	Captured Flow	Bypass Flow	Inlet Efficiency (Note 2)	Gutter Depth	Gutter Spread	Ponding Depth
		(cfs)	(cfs)	(cfs)		(cfs)	(cfs)	(cfs)	(cfs)	(%)	(ft)	(ft)	(ft)
C.I. 1A-1	GRADE	7.96	1.02	8.98	1.00	5.50	5.50	5.50	3.48	61.22%	0.27	12.28	...
F.I. 2-1	SAG	7.44	0.00	7.44	0.80	18.67	14.93	7.44	0.00	100.00%	0.27
C.I. 3-1	GRADE	2.83	4.53	7.36	1.00	2.64	2.64	2.64	4.72	35.82%	0.22	10.87	...
C.I. 3-2	GRADE	3.69	3.46	7.15	1.00	2.62	2.62	2.62	4.53	36.65%	0.22	10.75	...
C.I. 3-3	GRADE	7.63	0.00	7.63	1.00	4.17	4.17	4.17	3.46	54.63%	0.26	13.18	...
C.I. 4-1(L)	SAG	2.11	0.17	8.66	...
C.I. 4-1(R)	SAG	0.00	0.00	0.00	...
C.I. 4-1(B)	SAG	0.59
C.I. 4-1	SAG	2.70	0.00	2.70	0.80	19.40	15.52	2.70	0.00	100.00%
C.I. 4-2(L)	SAG	0.00	0.13	6.34	...
C.I. 4-2(R)	SAG	2.50	0.18	9.23	...
C.I. 4-2(B)	SAG	3.75
C.I. 4-2	SAG	6.25	0.92	7.17	0.80	19.40	15.52	7.17	0.00	100.00%
C.I. 4-3	GRADE	2.43	0.00	2.43	1.00	1.52	1.52	1.52	0.92	62.41%	0.14	6.80	...
C.I. 5-2	GRADE	1.38	0.00	1.38	1.00	1.38	1.38	1.38	0.01	99.56%	0.16	7.20	...
C.I. 5-3	GRADE	2.76	2.84	5.61	1.00	4.73	4.73	4.73	0.88	84.31%	0.26	12.04	...
C.I. 5-4	GRADE	5.33	1.50	6.83	1.00	3.99	3.99	3.99	2.84	58.39%	0.25	12.70	...
C.I. 5-5	GRADE	4.74	0.00	4.74	1.00	3.23	3.23	3.23	1.50	68.26%	0.22	11.07	...
C.I. 6-1	GRADE	3.82	0.00	3.82	1.00	2.80	2.80	2.80	1.02	73.37%	0.20	10.21	...
HR2 F.I. 3-2	SAG	7.57	0.00	7.57	0.80	18.67	14.93	7.57	0.00	100.00%	0.27
HR2 F.I. 3-3	SAG	3.42	0.00	3.42	0.80	18.67	14.93	3.42	0.00	100.00%	0.16


Notes:

1. Inlet capacity at sag location has been reduced by a clogging factor of 0.80, reducing theoretical capacity to 80% capacity, as required per APWA Section 5600.

Both theoretical capacity and reduced capacity are shown.

2. Inlet efficiency shown in the tables is Captured Flow/Total Flow, denoting the actual percentage of flow captured after the capacity has been reduced to 80% of theoretical capacity.

DWG: F:\2019\1501-2000\019-1605-A\10-Design\AutoCAD\Final Plans - As-Built\Sheets\GNCA\STREET & STORM\AC_MDR01_A191605.dwg USER: bwerthley
DATE: Jan 18, 2022 3:35pm XREFS: C:\PTBLK_A191605 C:\PBASE_A191605 C:\PUTIL_A191605 C:\PBNDY_A191605

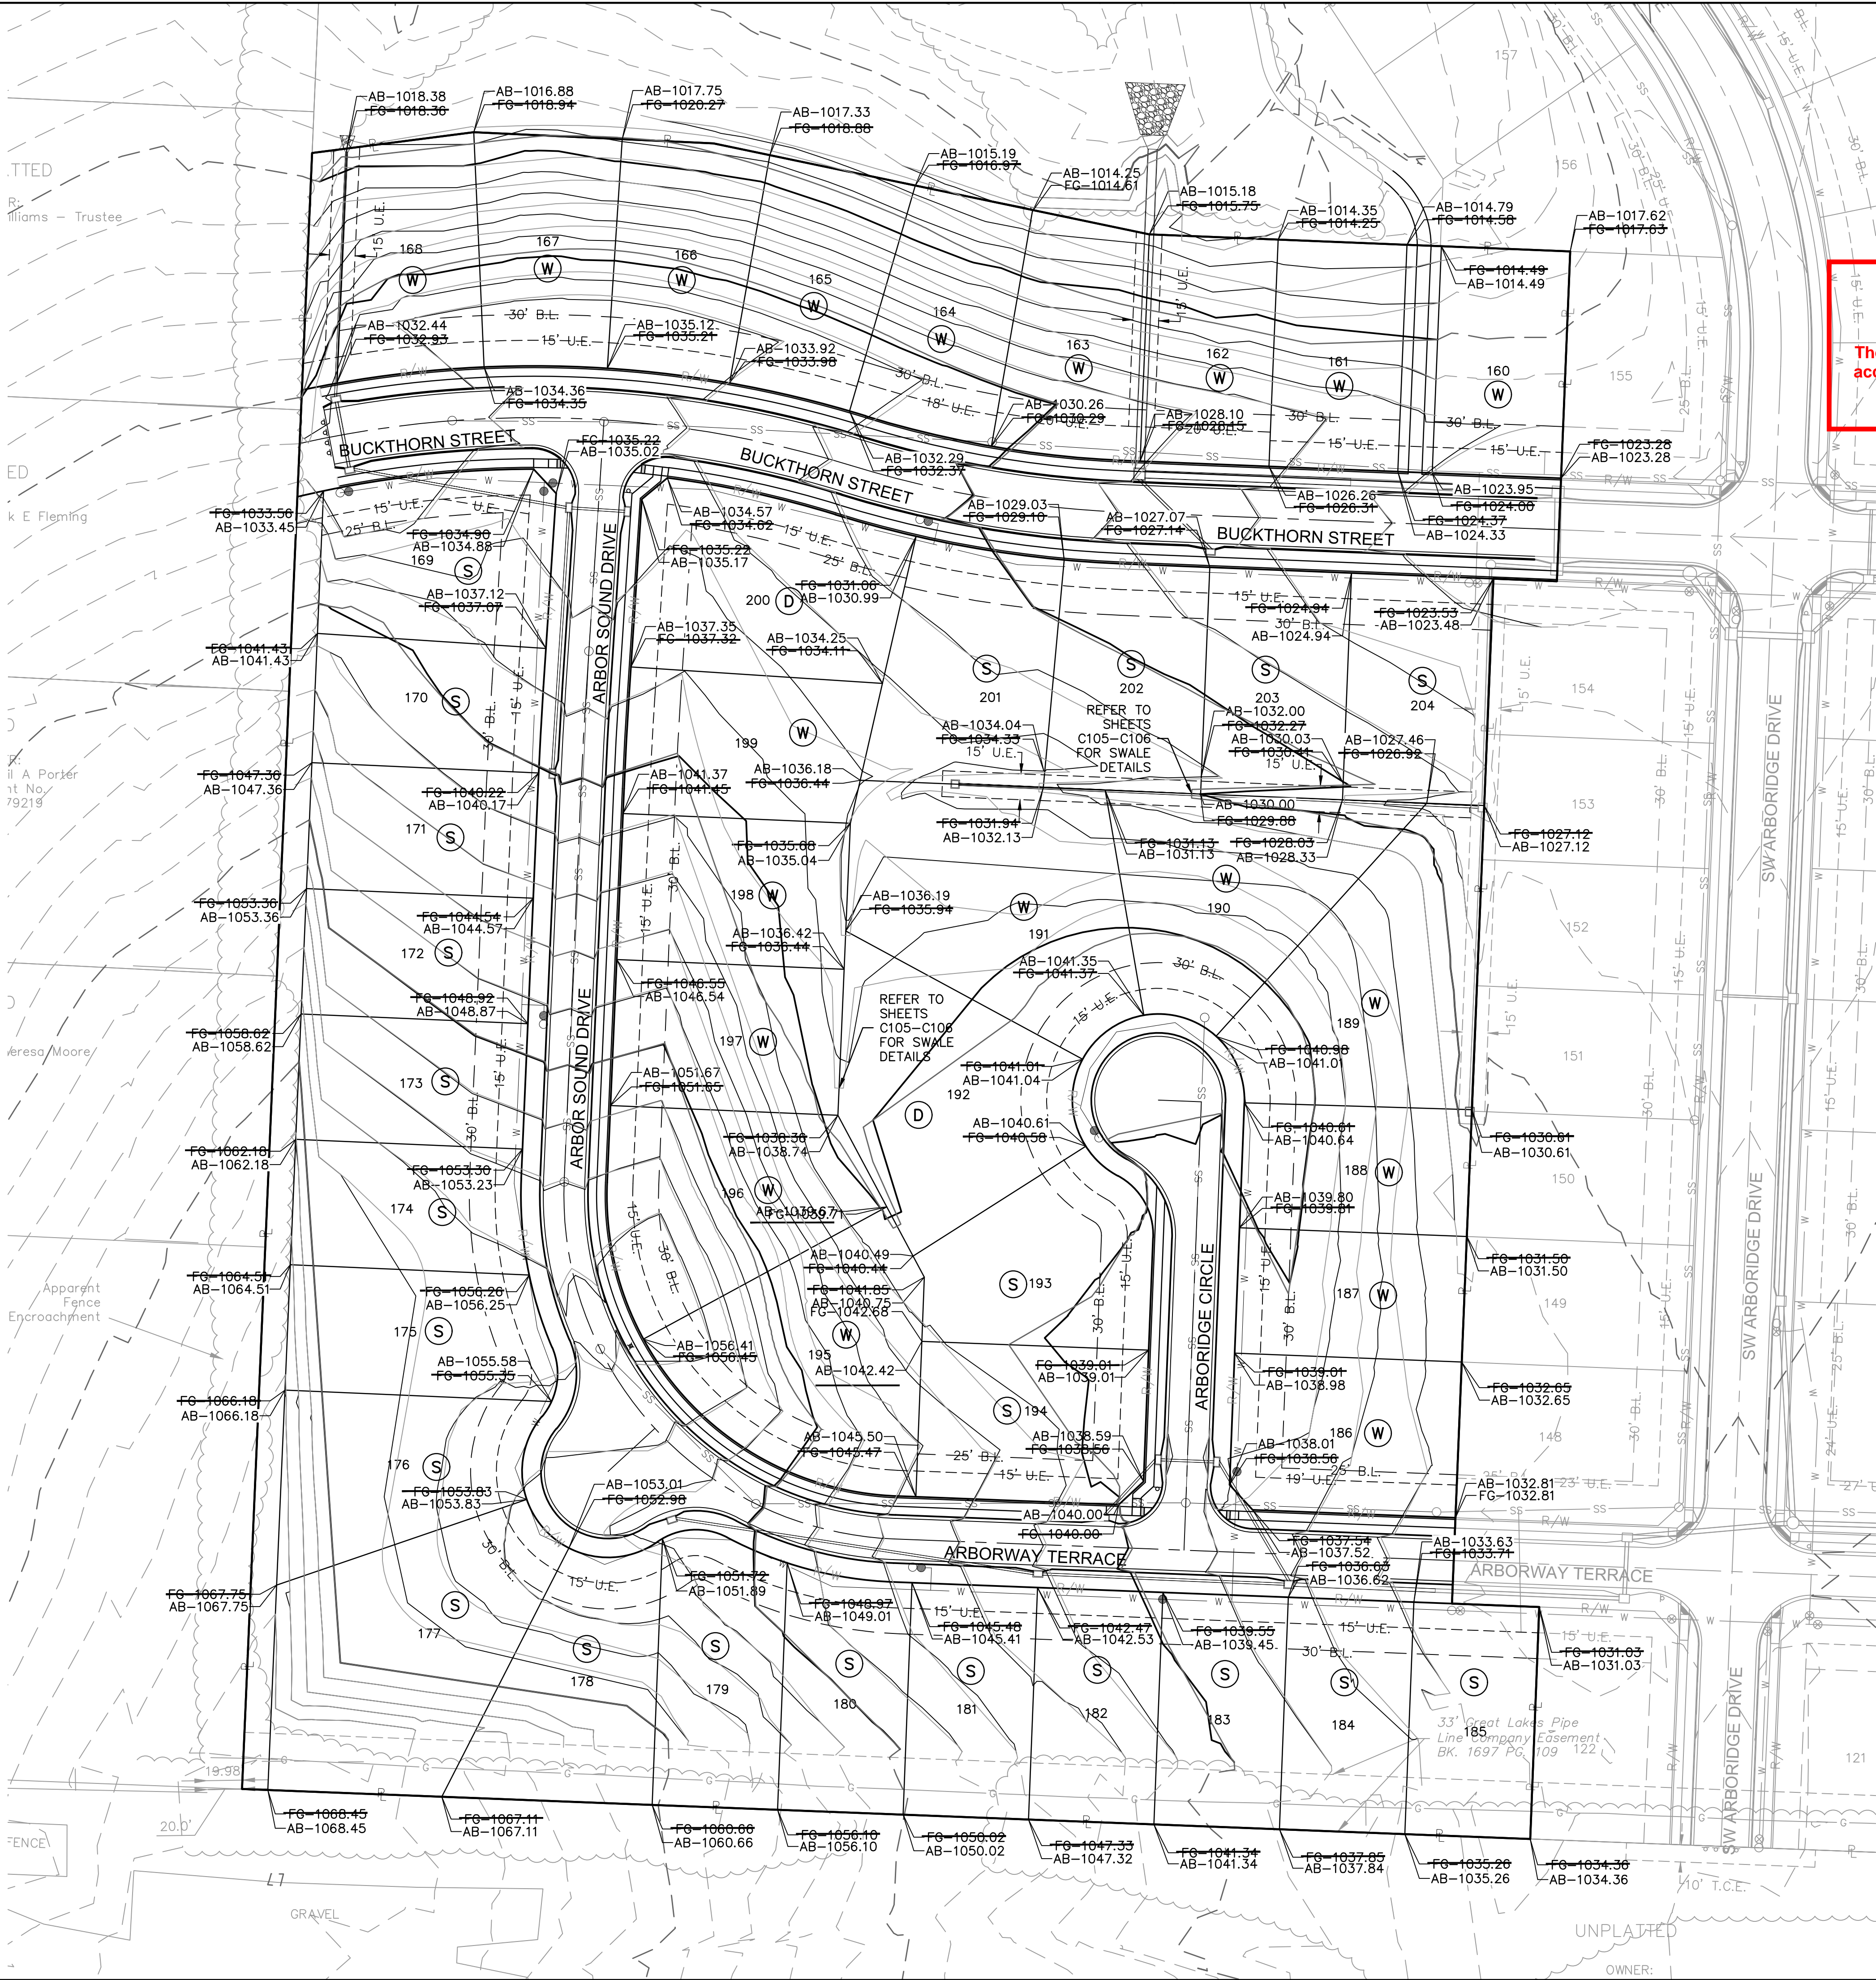

Accepted
Record Drawings

These plans have been reviewed for accuracy and are accepted for basic conformance to the approved construction drawings.

ASBUILT
1/18/2022

LEGEND	
	FINISHED INDEX CONTOURS
	FINISHED INTERMEDIATE CONTOURS

- NOTES:
- MBOE = MINIMUM BUILDING OPENING ELEVATION
FG = FINISHED GRADE
- NOTES:
- INDIVIDUAL LOT OWNERS SHALL NOT CHANGE OR OBSTRUCT THE DRAINAGE FLOW LINES OR PATHS ON THE LOTS, AS SHOWN ON THE MASTER DRAINAGE PLAN, UNLESS SPECIFIC APPLICATION IS MADE AND APPROVED BY THE CITY ENGINEER.
 - PLAT IS LOCATED IN ZONE X, "AREAS OUTSIDE THE 1-PERCENT ANNUAL CHANCE FLOODPLAINS, AREAS OF 1-PERCENT ANNUAL CHANCE SHEET FLOW FLOODING WHERE THE AVERAGE DEPTHS ARE LESS THAN 1 FOOT, AREAS OF 1-PERCENT ANNUAL CHANCE STREAM FLOODING WHERE THE CONTRIBUTING DRAINAGE AREA IS LESS THAN 1 SQUARE MILE, OR AREAS PROTECTED FROM THE 1-PERCENT ANNUAL CHANCE FLOOD BY LEVEES. NO BASE FLOOD ELEVATIONS OR DEPTHS ARE SHOWN WITHIN THIS ZONE"
 - PLAT IS LOCATED OUTSIDE OF ANY REQUIRED BUFFER ZONES FOR NATURAL STREAMS.
 - MBOE ELEVATIONS HAVE BEEN PROVIDED AT EACH LOT CORNER. INTERPOLATION WILL BE ALLOWED BETWEEN THE RIGHT AND LEFT SIDE MBOE'S SHOWN ON THE MASTER DRAINAGE PLAN, DEPENDING ON THE LOCATION OF THE LOWEST OPENING ON THE PROPOSED STRUCTURE.
 - REFER TO SHEET C105-C106 FOR SWALE GRADING DETAILS.
 - DRAINAGE PATHS TO BE CONSTRUCTED BETWEEN EACH OF THE LOTS LABELED AS STANDARD LOTS TO DRAIN WEST.
 - NO BUILDING PERMITS WILL BE ISSUED UNTIL AN AS-GRADED MASTER DRAINAGE PLAN HAS BEEN SUBMITTED TO THE CITY AND APPROVED BY THE CITY.

BASEMENT TYPES

- (S) STANDARD
(W) WALKOUT
(D) DAYLIGHT

Hawthorn Ridge Third Plat Minimum Building Opening Elevation					
Lot	Rear Left MBOE	Rear Right MBOE	Front Left MBOE	Front Right MBOE	As-Built Grading Plan Required
160					
161					
162					
187	1032.64	1033.55	-	-	X
188	1031.75	1032.64	-	-	X
189	1028.66	1031.75	-	-	X
190	1032.33	1028.66	-	-	X
191	1037.46	1032.33	-	-	X
192	1041.76	1037.46	-	-	X
193					X
194					
195	1040.94	1041.65	-	-	X
196	1040.01	1040.94	-	-	X
197	1037.69	1040.01	-	-	X
198	1036.31	1037.69	-	-	X
199	1035.32	1037.20	-	-	X
200	1032.73	1035.32	-	-	X
201					X
202					X
203					X
204					X

X indicates condition applies to the lot.



MBOE's have been provided per lot lines, facing the lot from the street. Interpolation will be allowed between the right and left side MBOE's provided, depending on the location of the lowest opening on the proposed structure.





Olsson - Civil Engineering
Missouri Certificate of Authority #001592
1301 Burlington Street
North Kansas City, MO 64116
TEL 816.361.1177
www.olson.com

BY		REVISIONS	
REV. NO.	REVISIONS DESCRIPTION	DATE	REV. NO.
1	11/23/2020		
2			
3			
drawn by: _____ OLS
checked by: _____ BMW
approved by: _____ BMW
QA/QC by: _____ JES
project no.: _____ A19-1605
drawing no.: C_MDR01_A191605
date: 1/18/2022

SHEET
C125

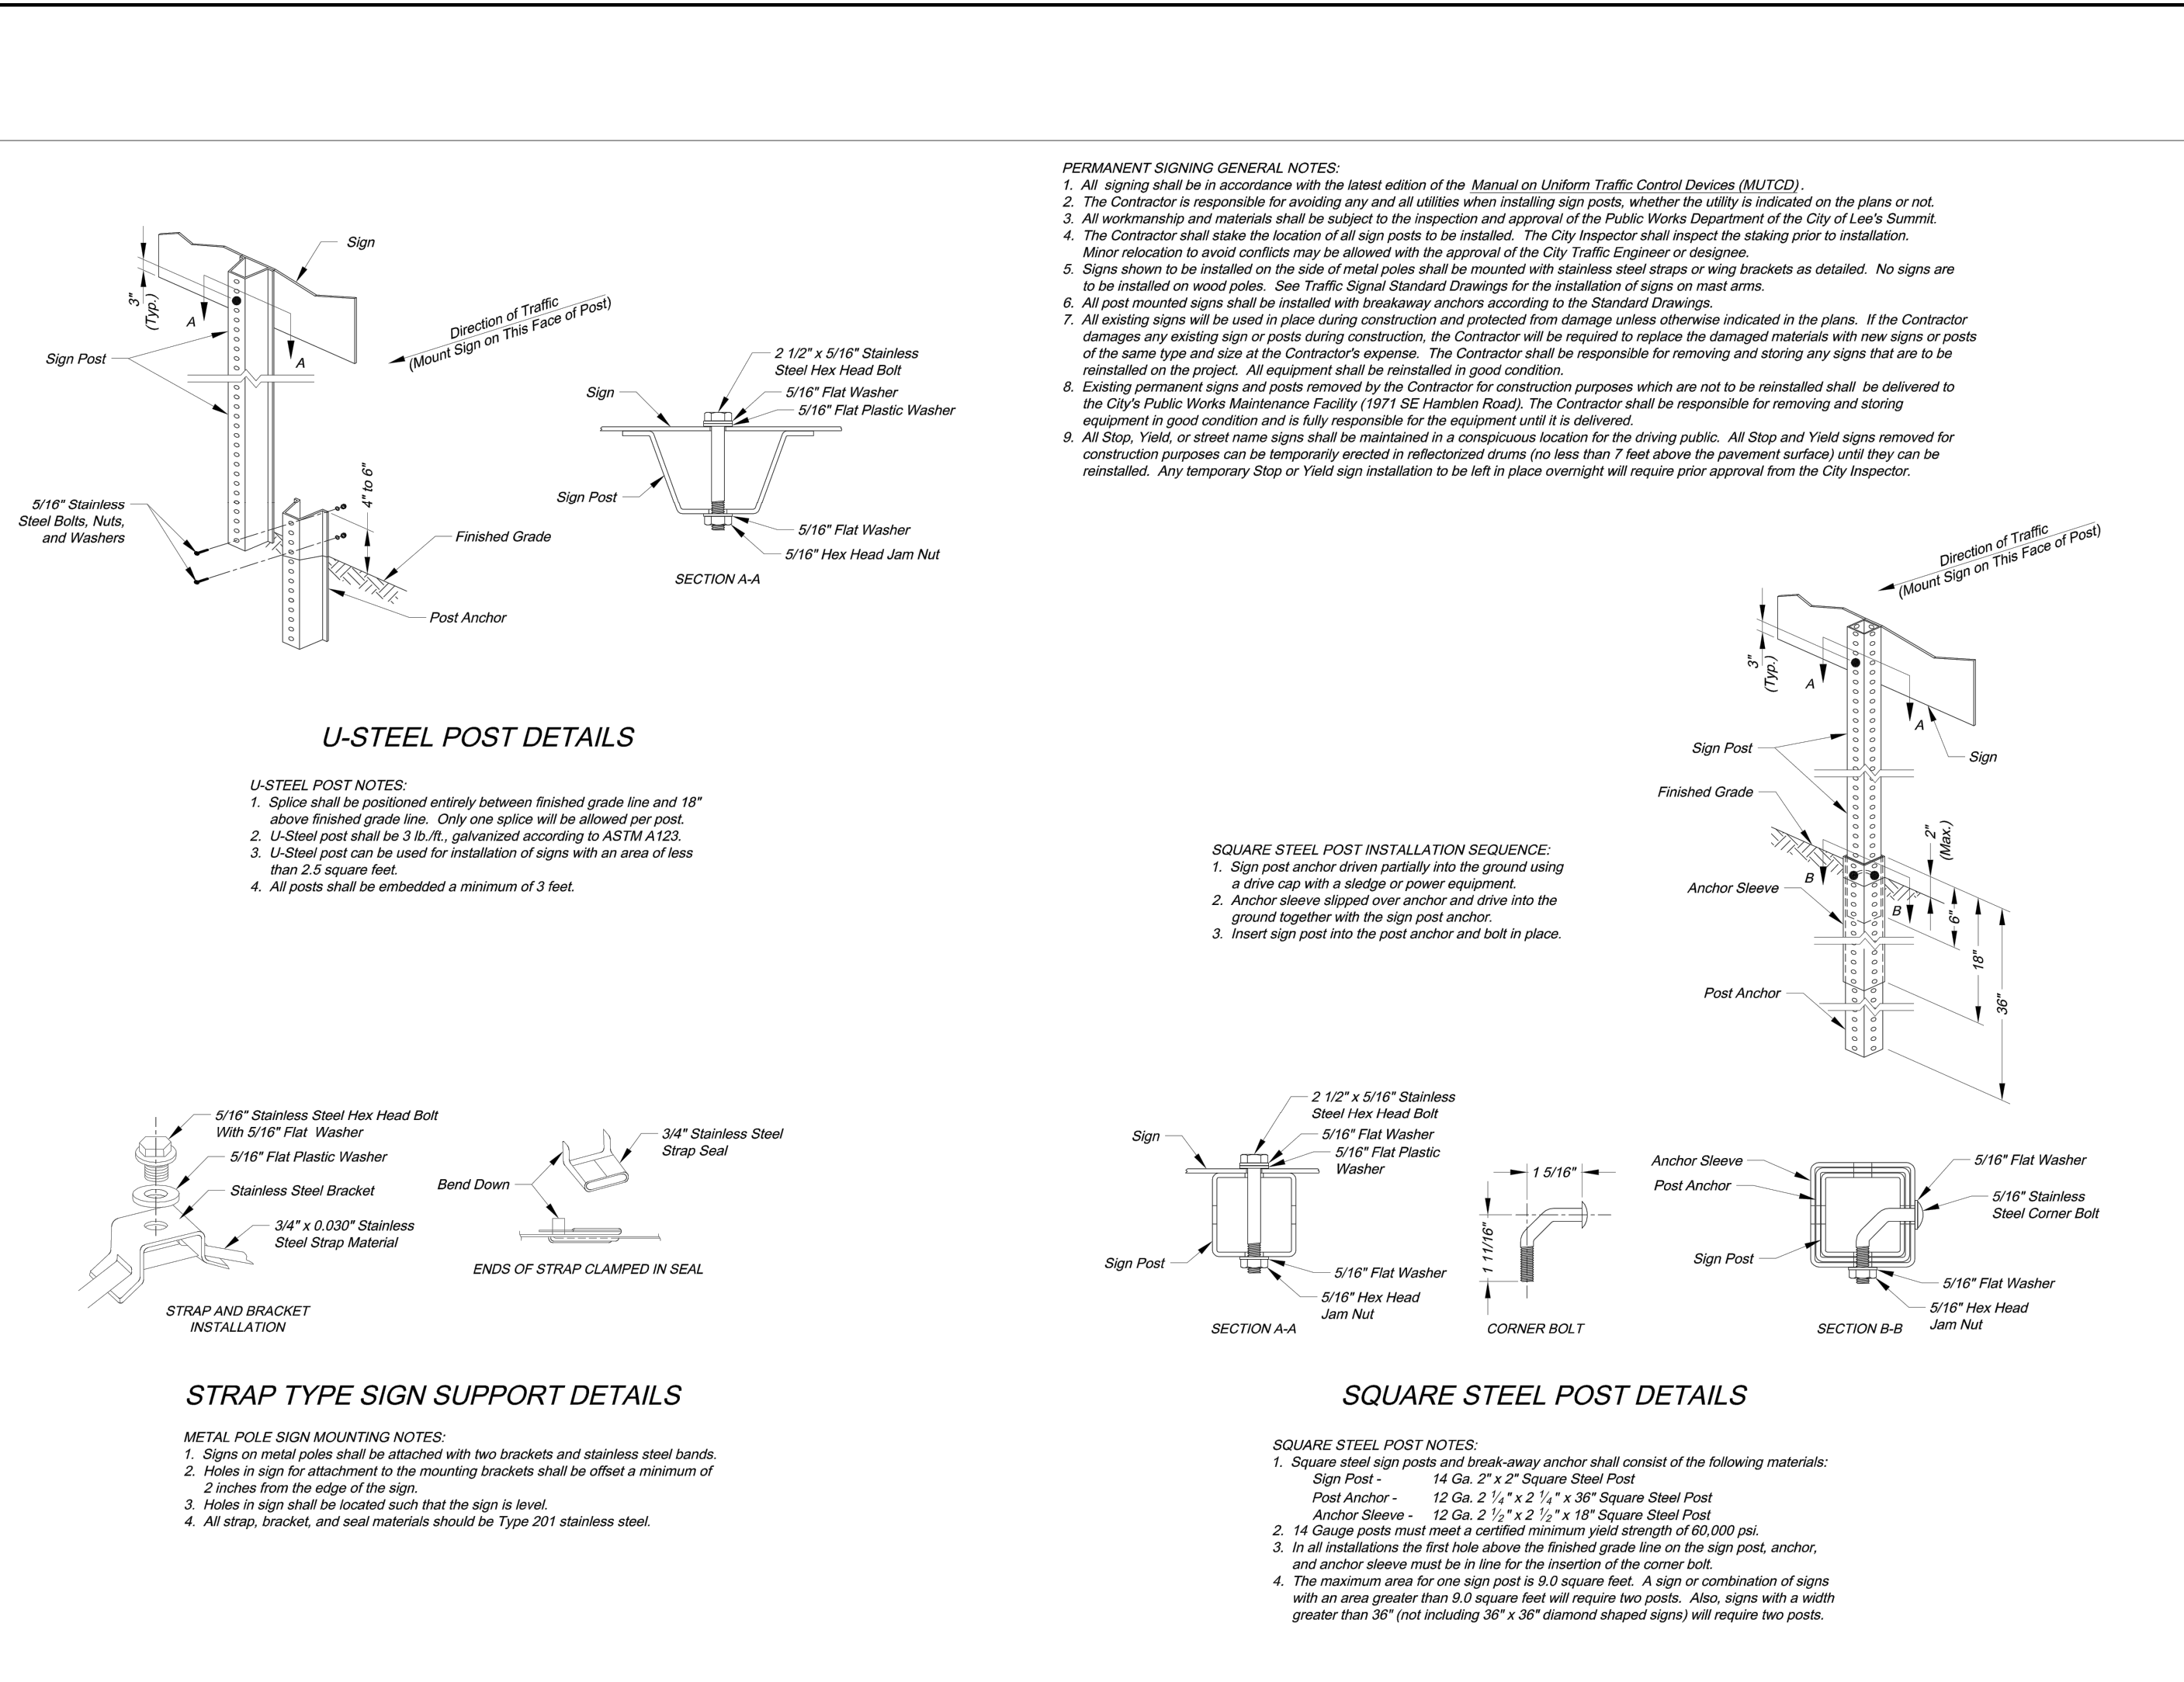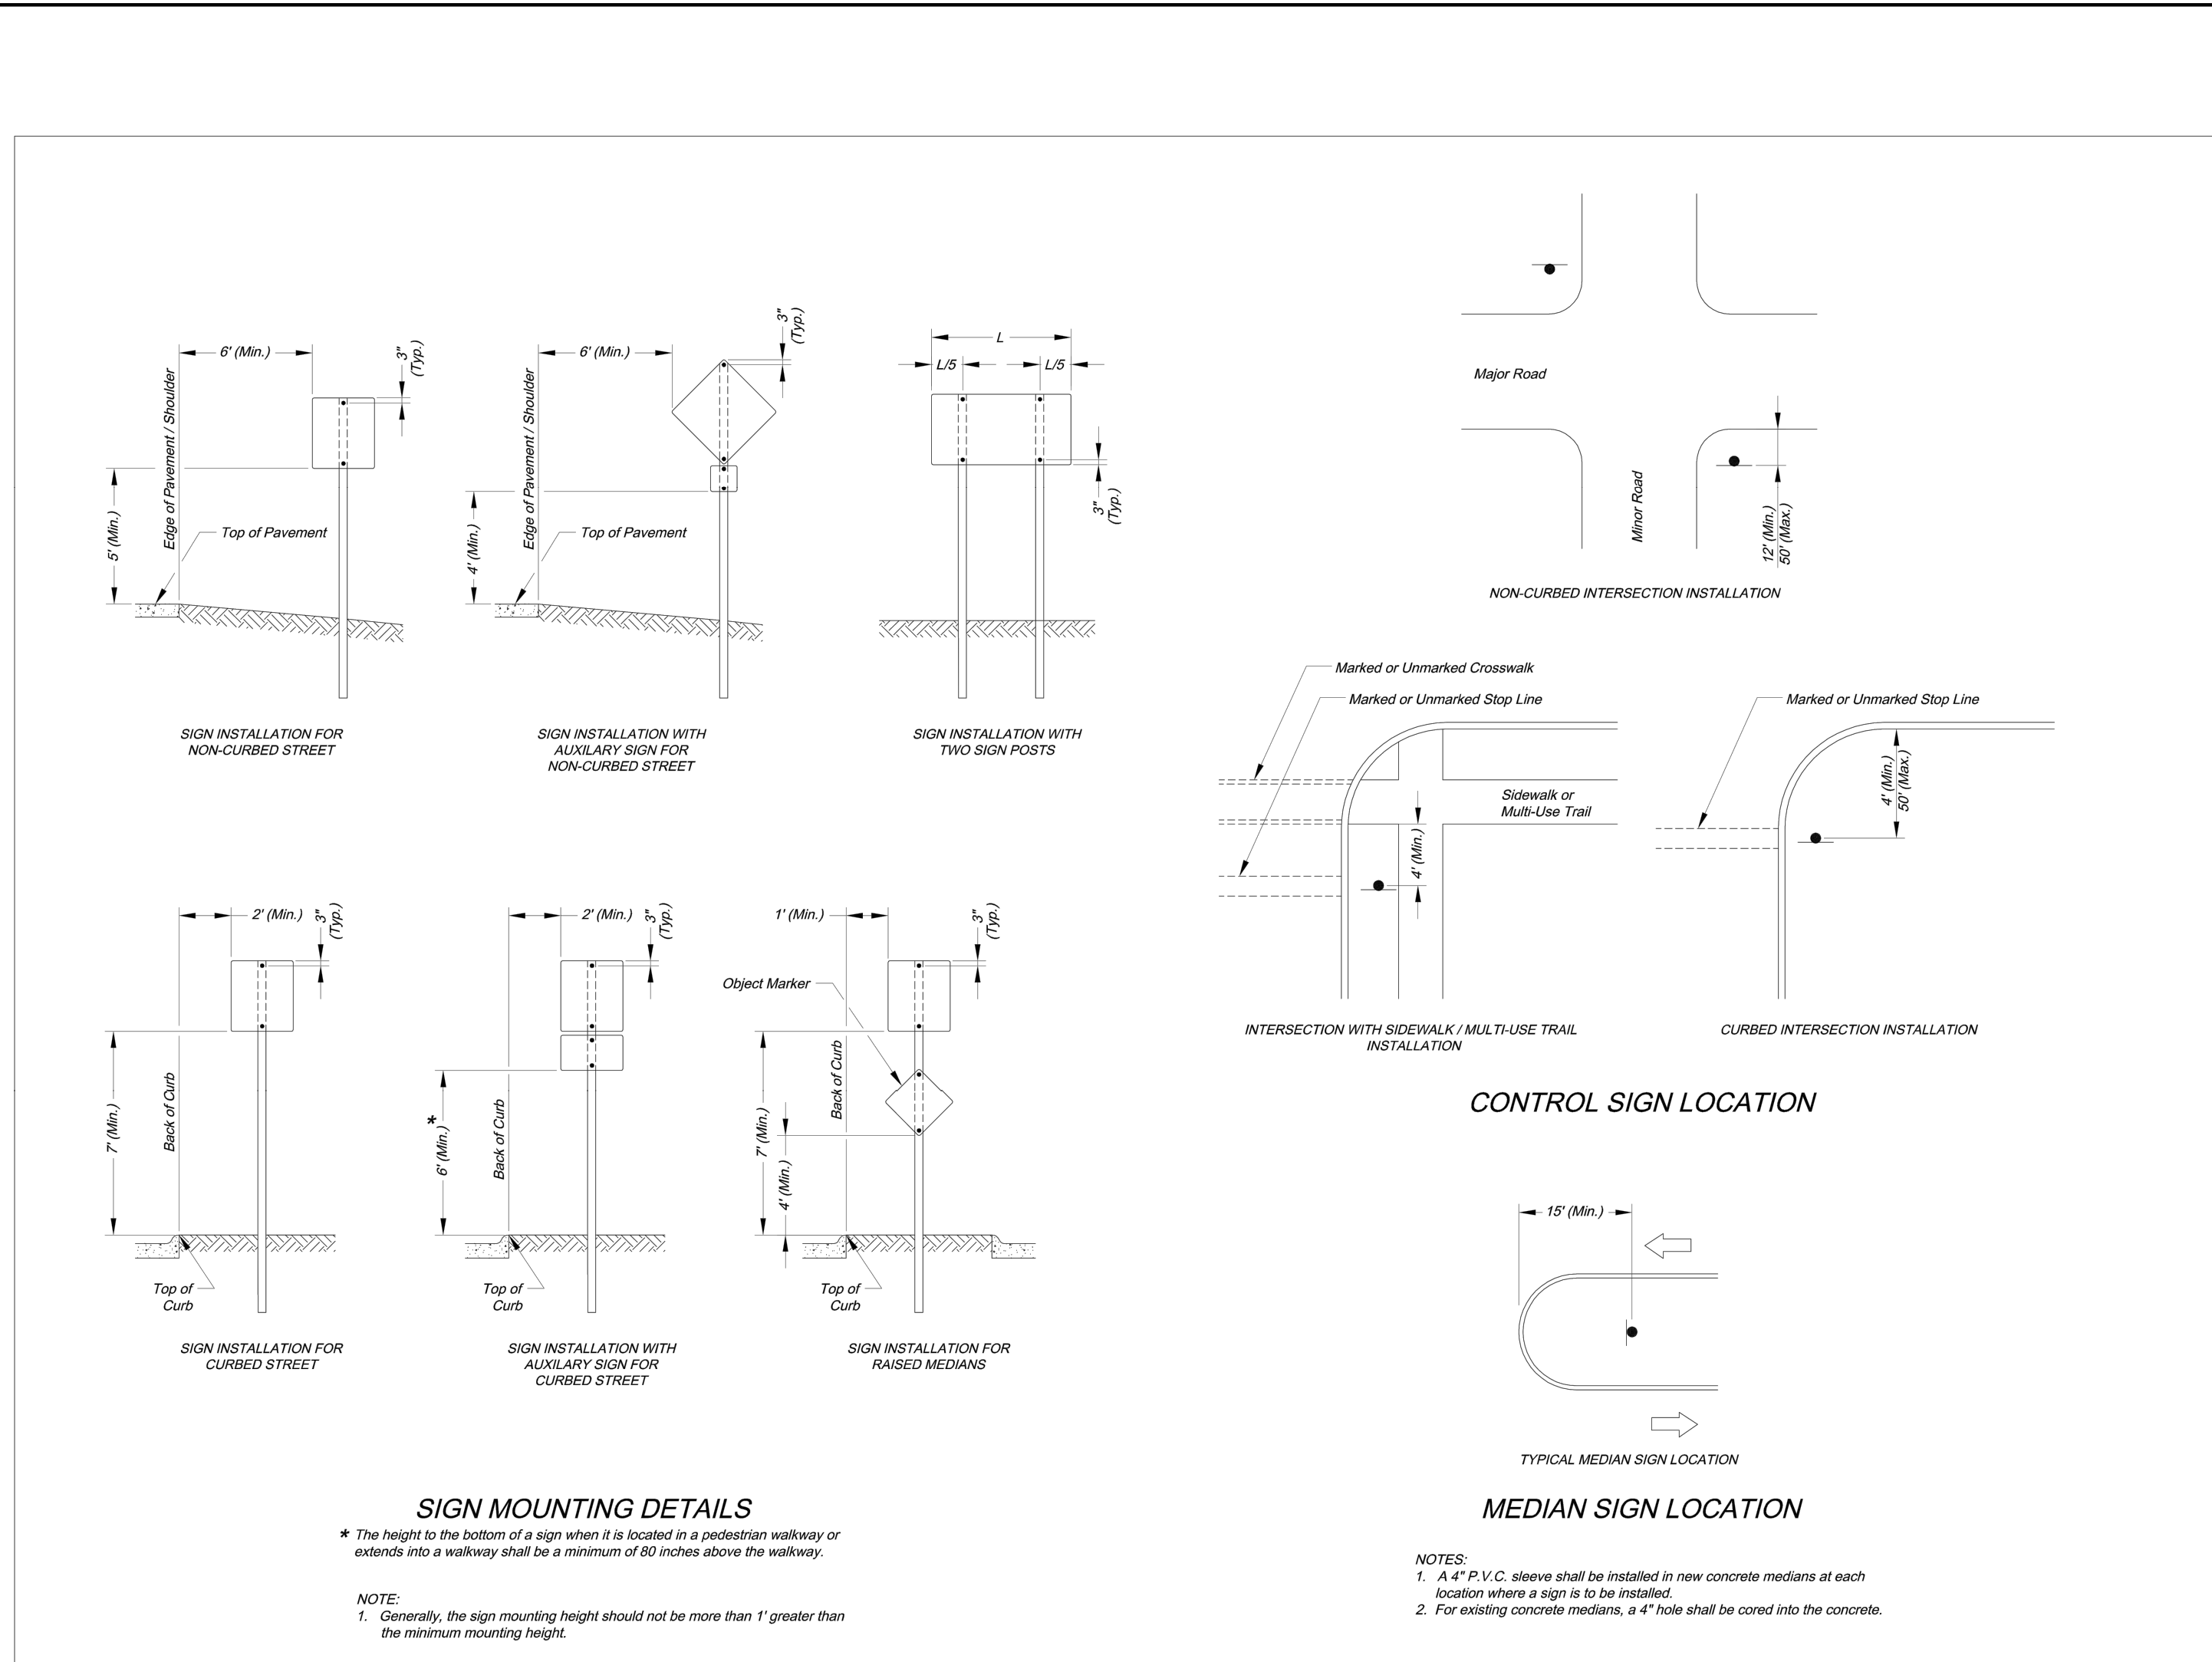

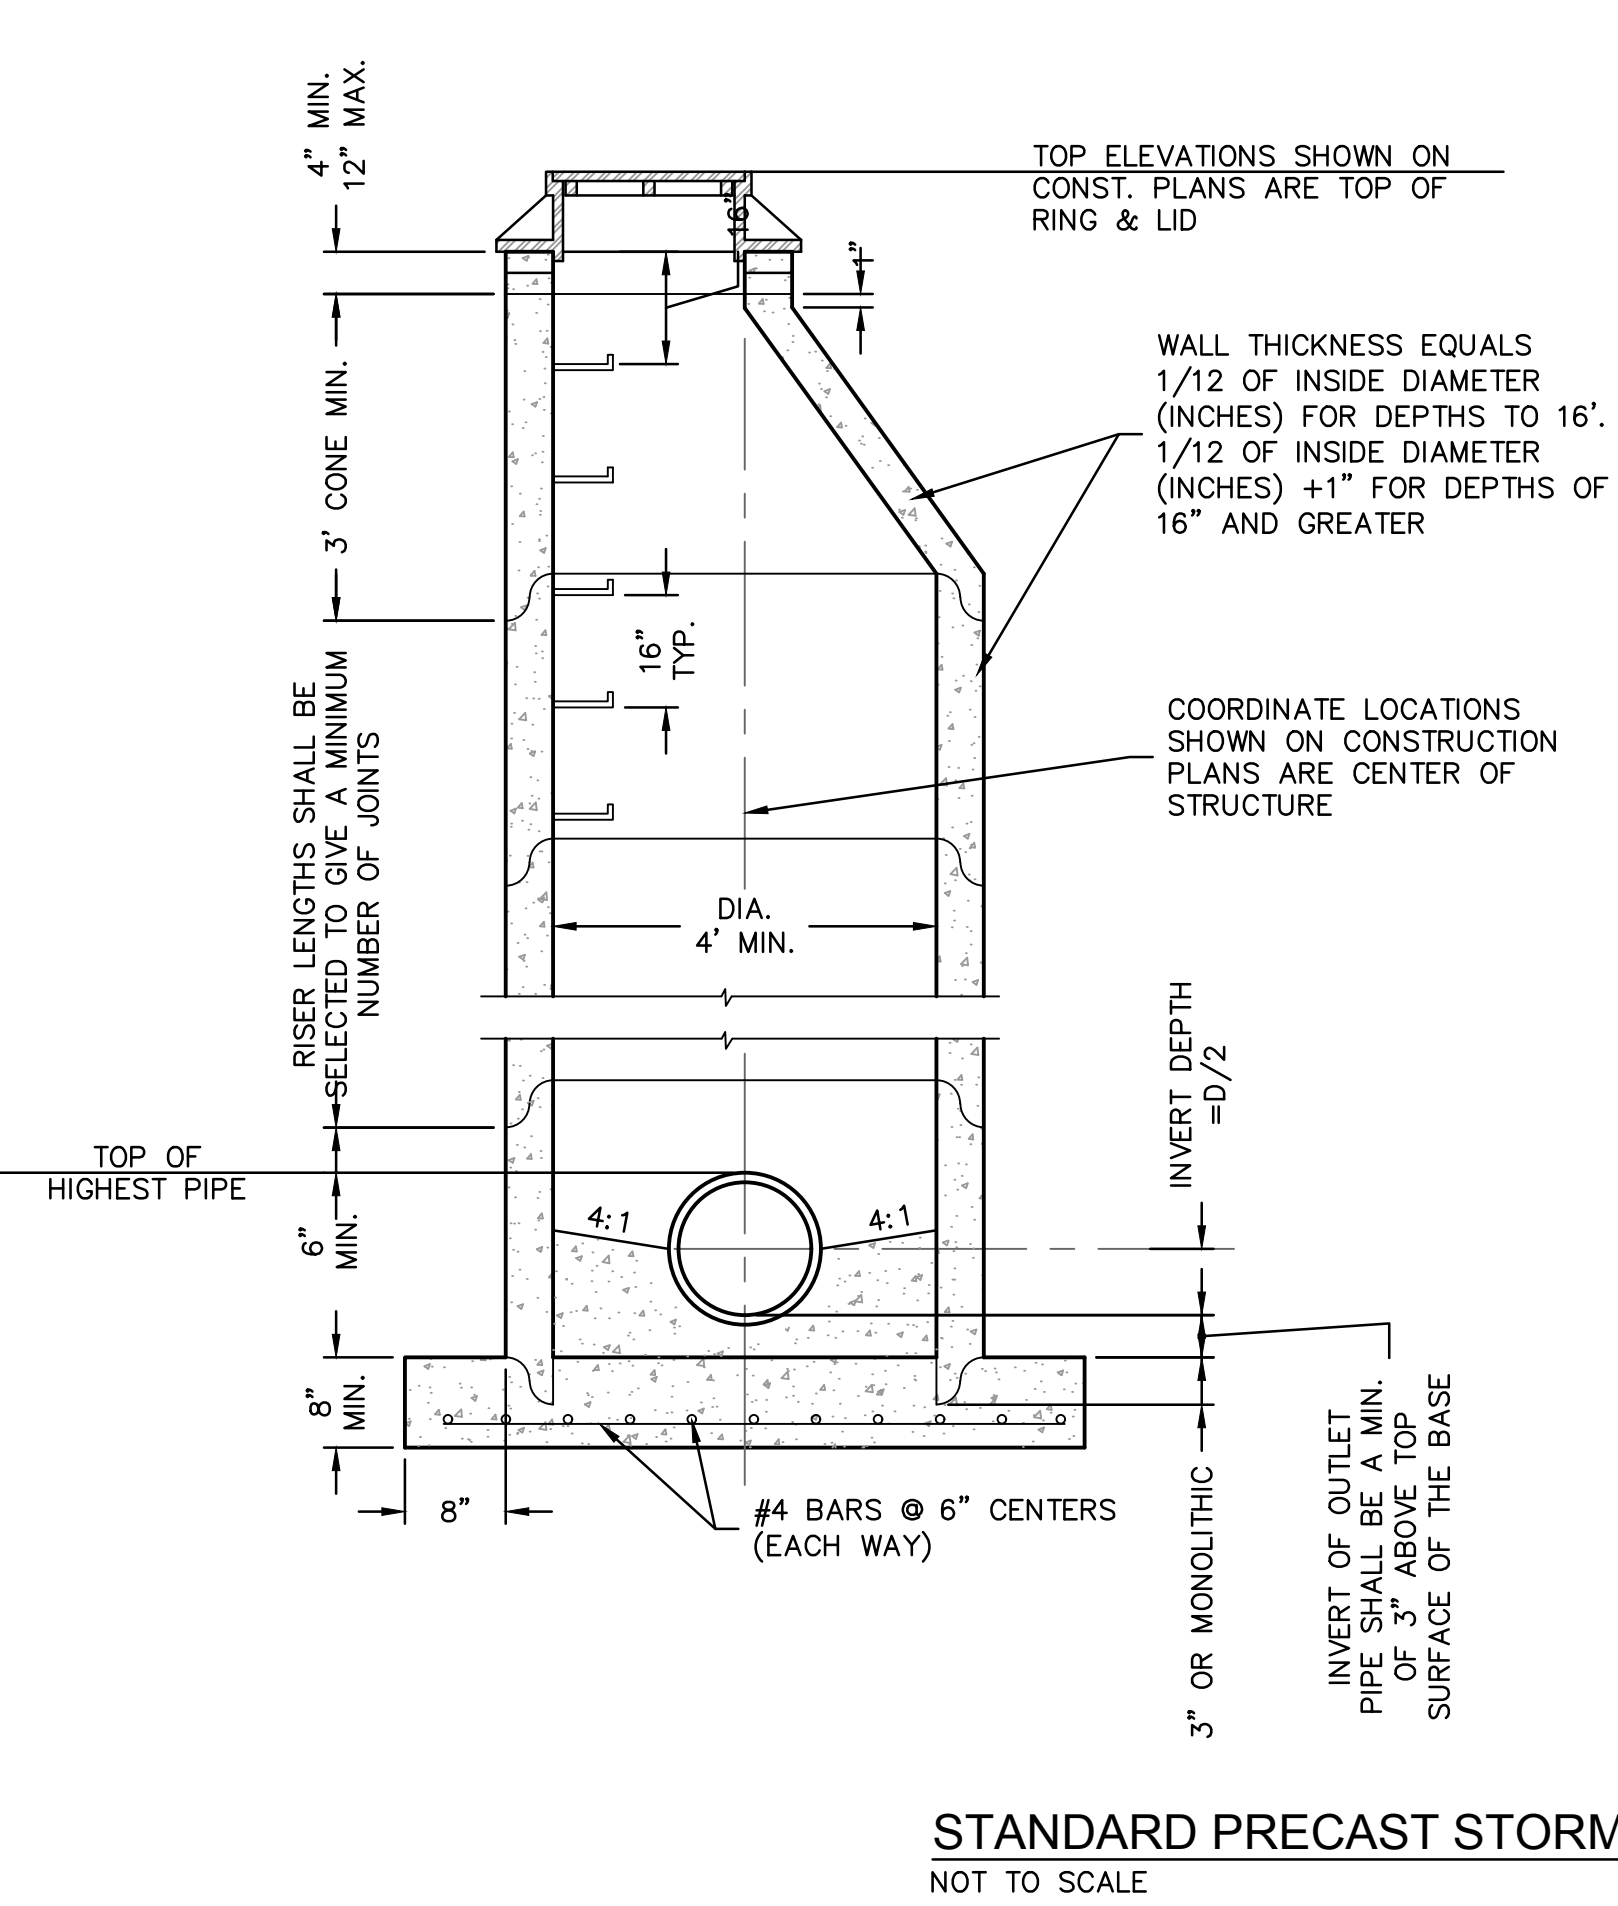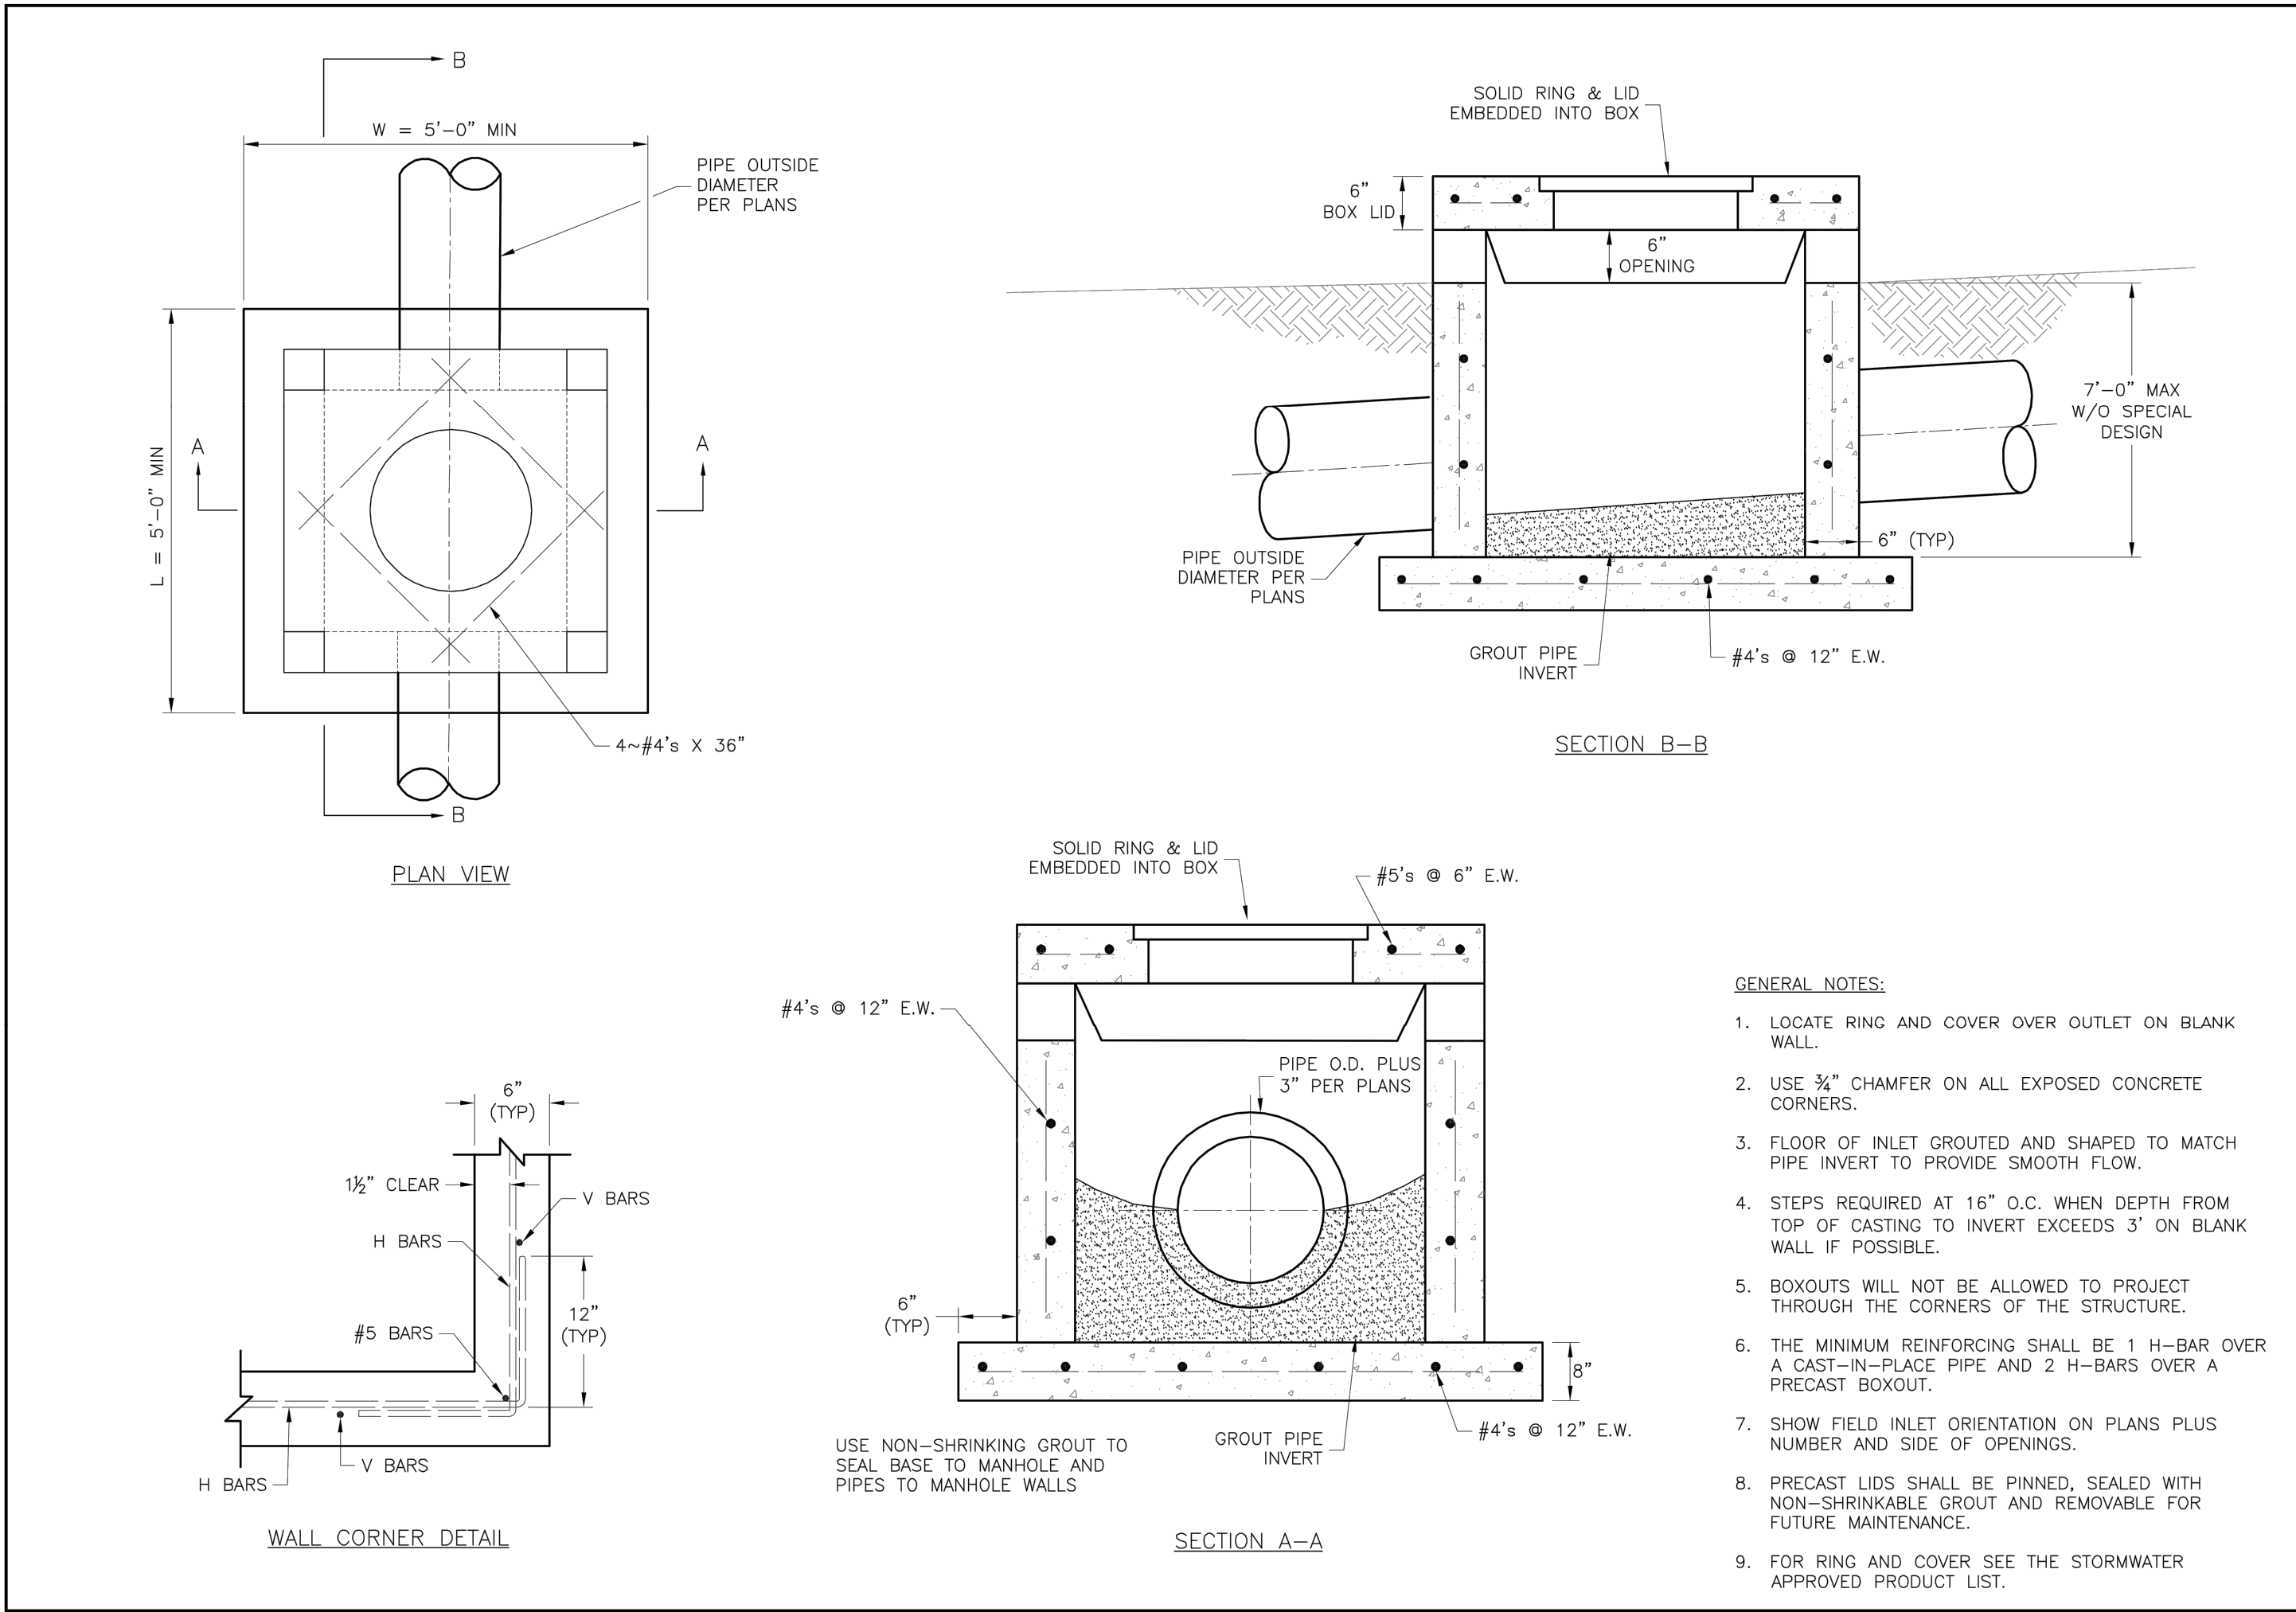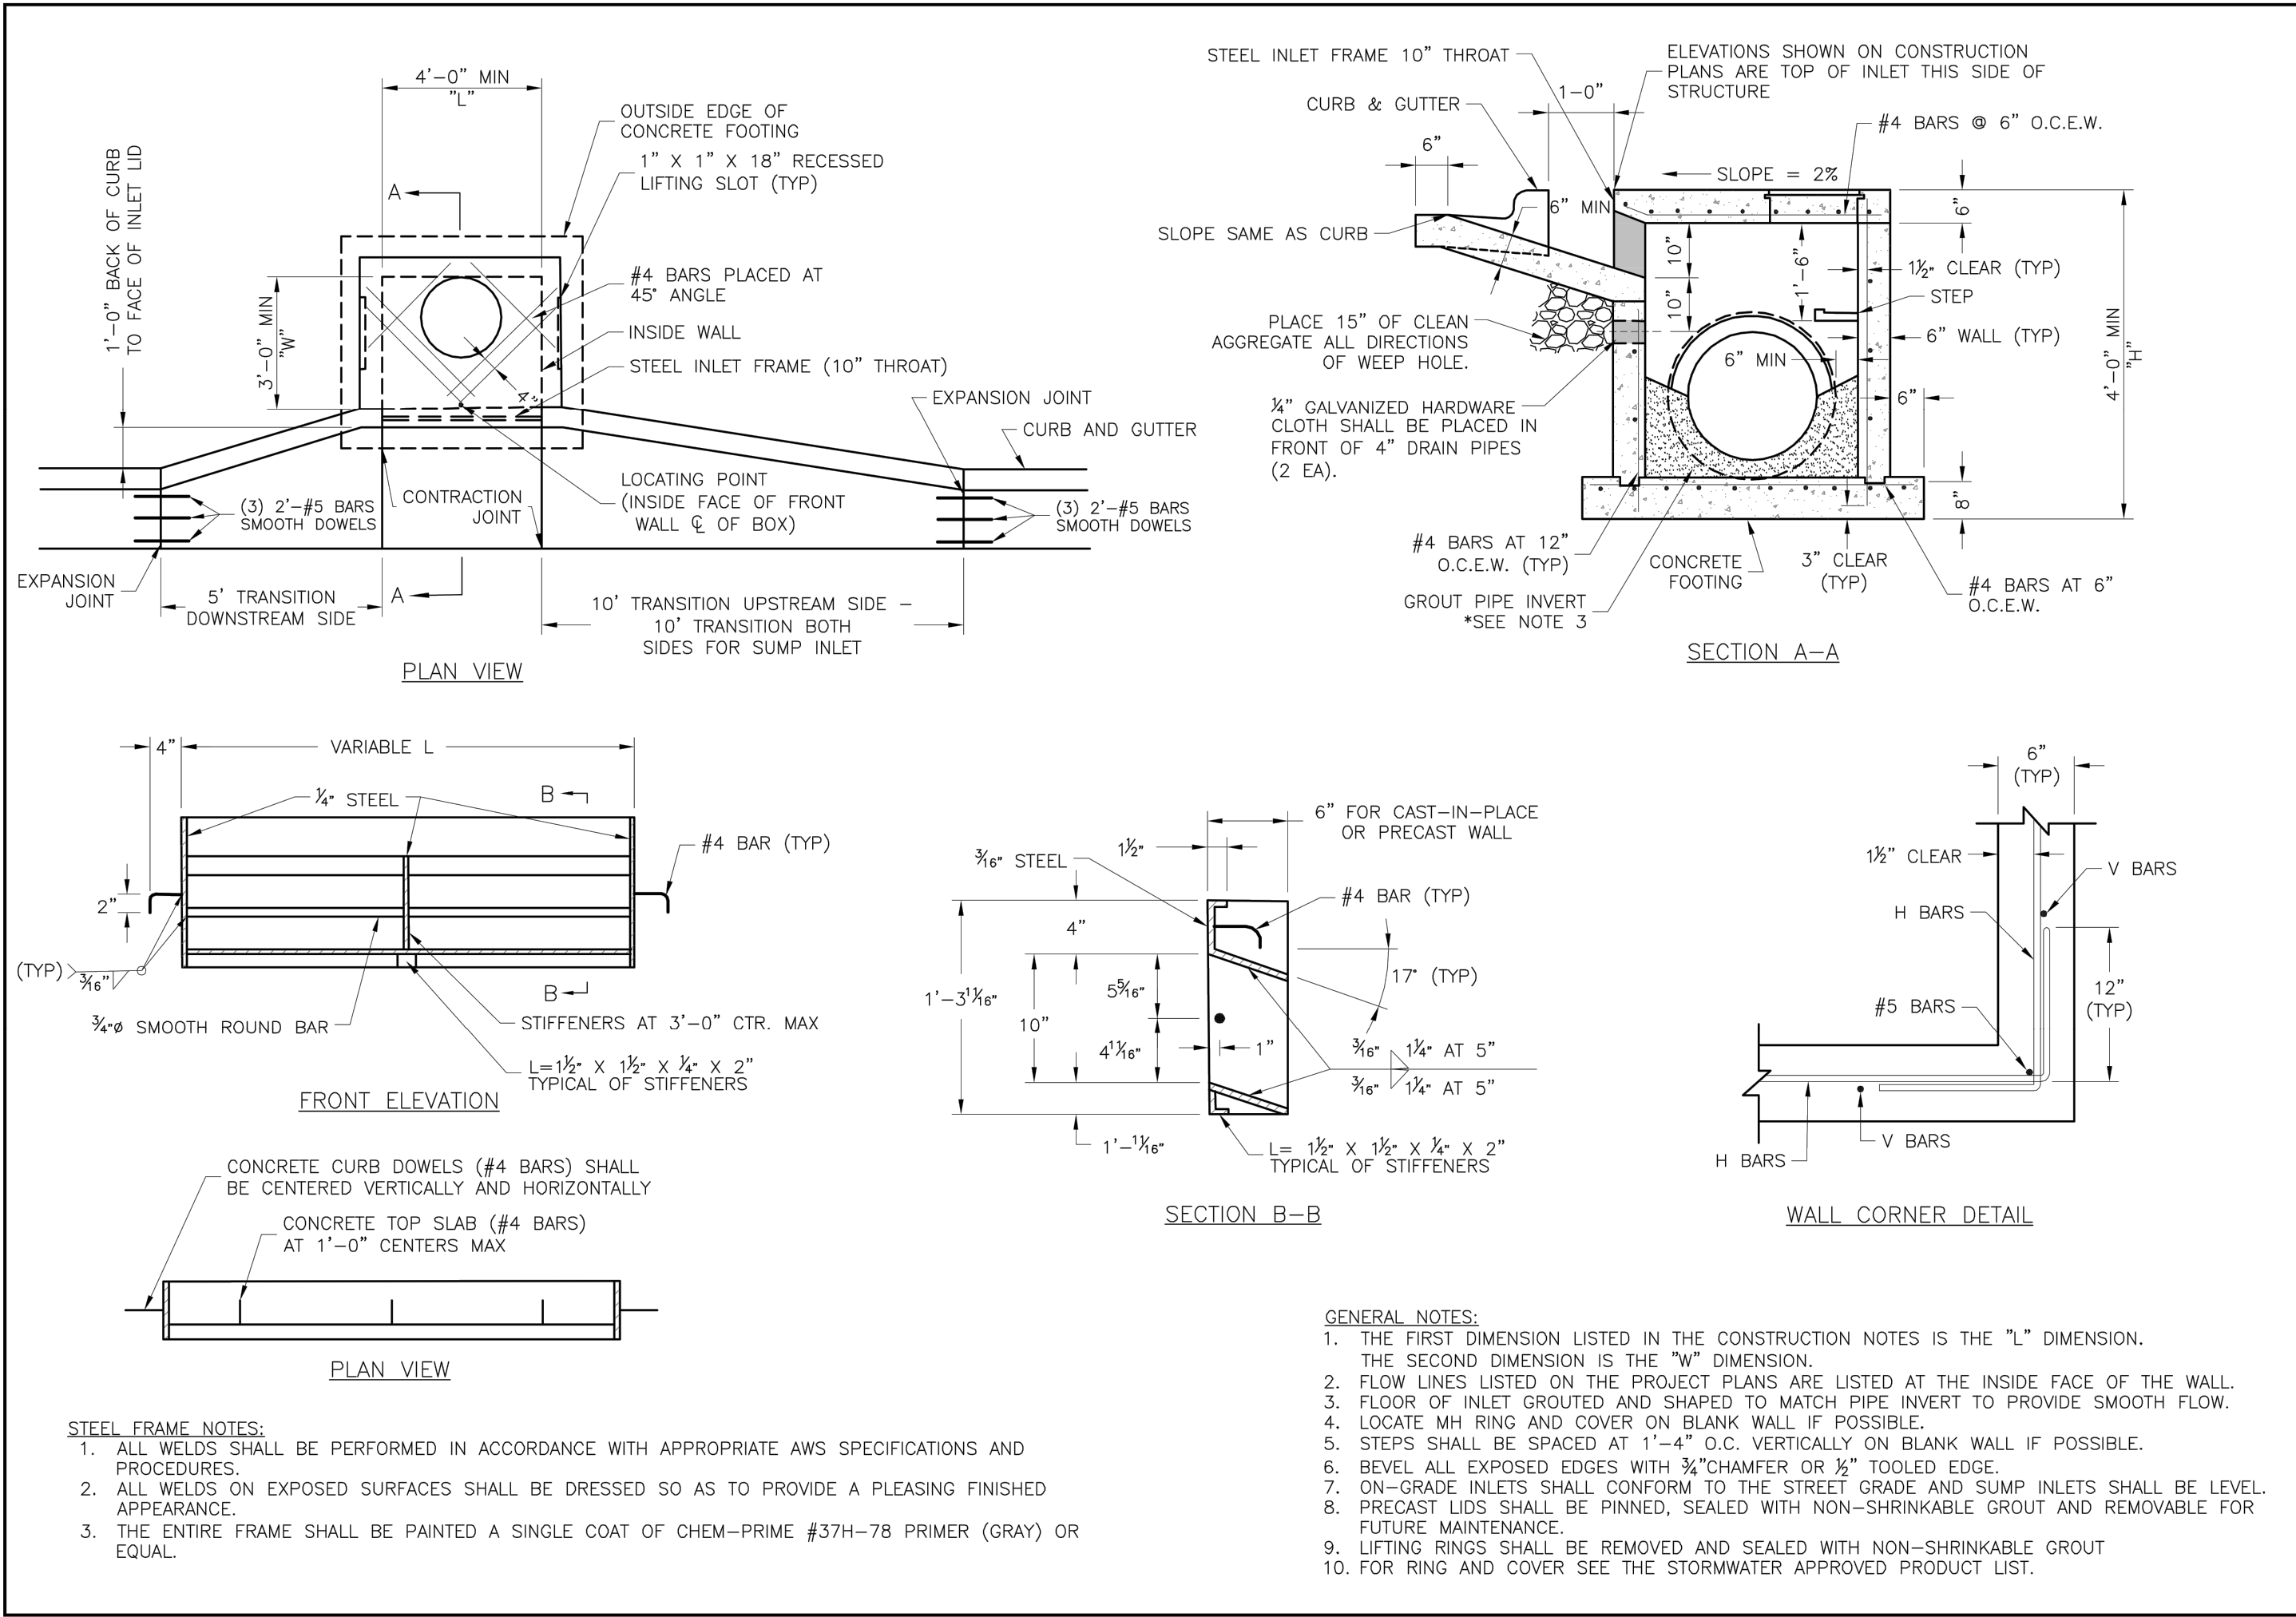
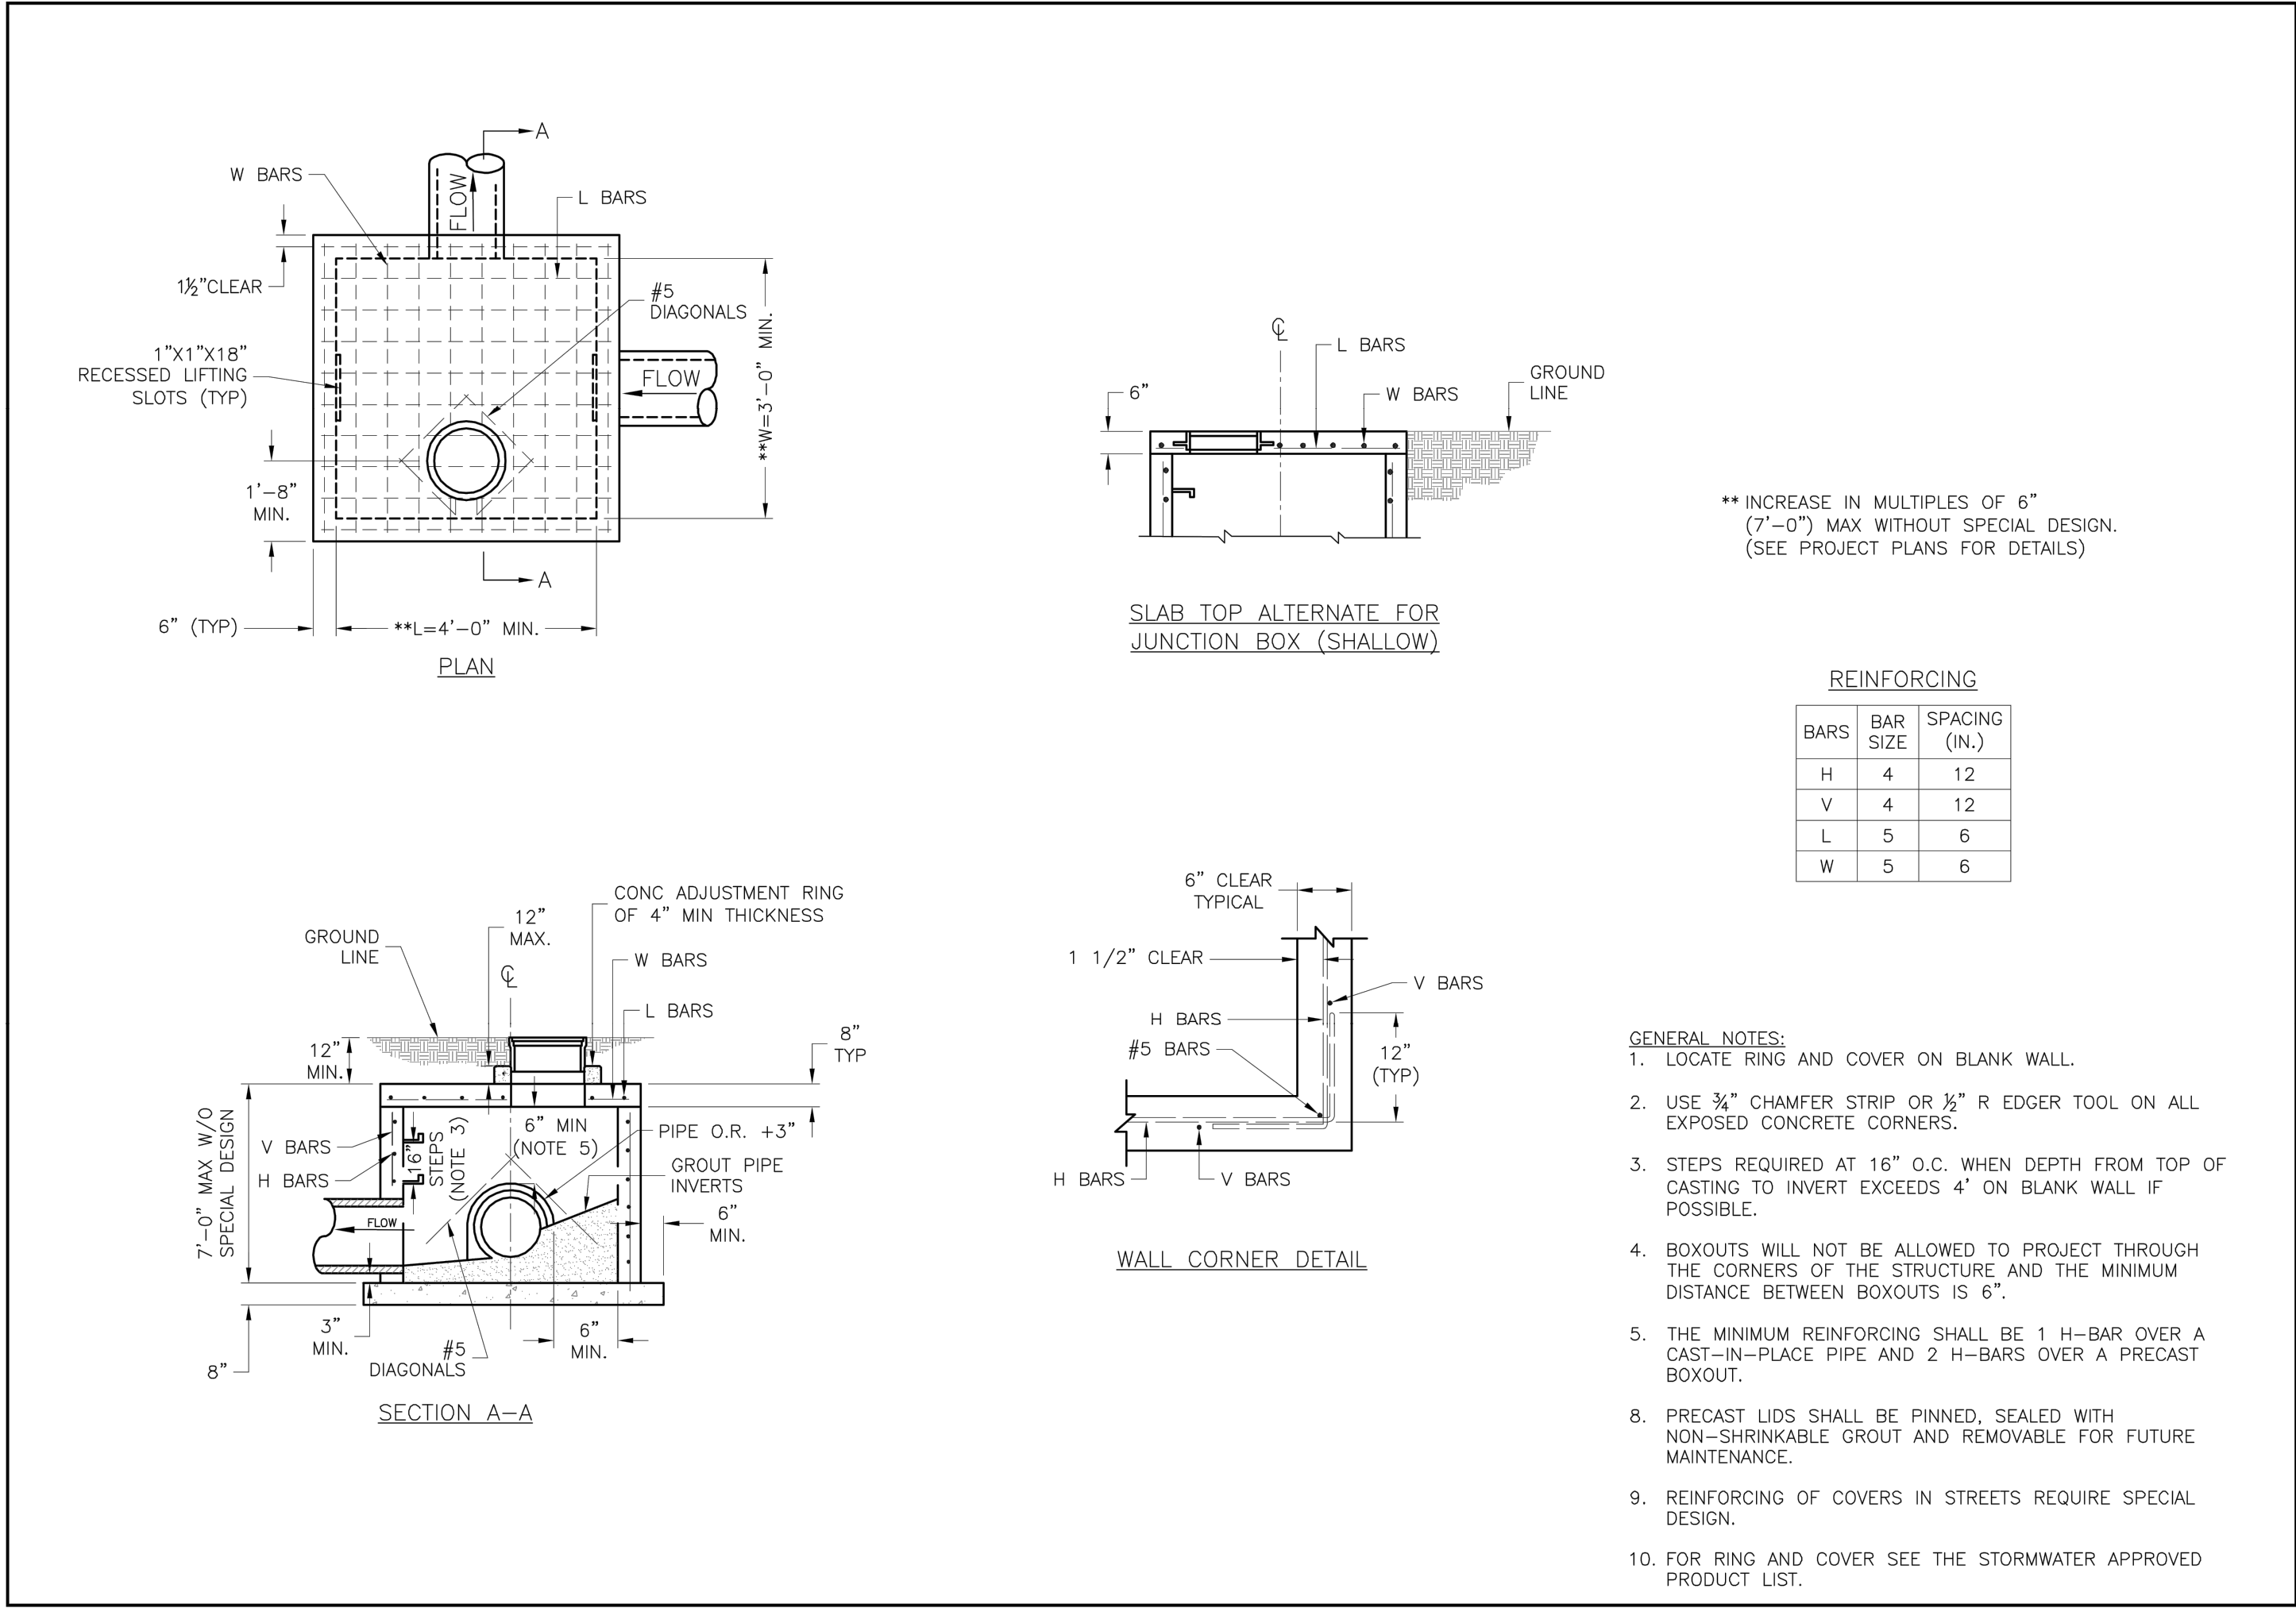


STORM MANHOLE NOTES

1. ALL MANHOLES ARE TO BE PRECAST CONCRETE AND OF ECCENTRIC CONE TYPE UNLESS OTHERWISE SPECIFIED.
2. MANHOLE TOP ADJUSTMENTS SHALL BE ACCOMPLISHED BY THE USE OF CONCRETE ADJUSTMENT RINGS.
3. TOP OF MANHOLE CASTING SHALL BE SET FLUSH AND ON SAME SLOPE AS FINISHED SURFACE OR AS DIRECTED BY THE ENGINEER.
4. REINFORCEMENT IN ALL SECTIONS SHALL EQUAL OR EXCEED A.S.T.M. C-478 SPECIFICATIONS.
5. THE ENGINEER SHALL DESIGNATE MODIFICATIONS FOR MANHOLES WITH SPECIAL DESIGNS.
6. THE INSIDE DIAMETER OF THE MANHOLE SHALL BE 4'-0" FOR PIPE DIAMETERS FROM 12" THRU 24", 5'-0" FOR PIPE DIAMETERS FROM 27" THRU 36", AND 6'-0" FOR PIPE DIAMETERS 42" THRU 48".
7. CLEARANCE TOLERANCE OF PIPE OPENINGS: THE MAXIMUM ALLOWABLE PIPE OPENING ON A HORIZONTAL AXIS SHALL BE THE OUTSIDE DIAMETER OF THE PIPE PLUS 12". THE MAXIMUM ALLOWABLE PIPE OPENING ON VERTICAL AXIS SHALL BE THE OUTSIDE DIAMETER PLUS 8". THE MAXIMUM CLEARANCE BETWEEN THE OUTSIDE SURFACE OF AN INSTALLED PIPE AND THE CONCRETE OF THE MANHOLE SHALL BE 2".
8. INSTALLATION OF PIPE OPENINGS: ALL REQUIRED PIPE OPENINGS SHALL BE PLANT CAST IN MANHOLE UNITS. FIELD ALTERATIONS OF OPENINGS WILL BE PERMITTED PROVIDED WALLS ARE SCORED WITH A MASONRY SAW TO A DEPTH SUFFICIENT TO SEVER REINFORCING STEEL. A CHIPPING HAMMER MAY THEN BE USED TO REMOVE THE CONCRETE. MINIMUM DISTANCE BETWEEN ANY TWO ADJACENT PIPES SHALL BE 2".
9. NO DIRECT PAYMENT FOR SHAPING FLOOR OR CONNECTING PIPES AS SHOWN ON PLANS.
10. RING AND COVER TO BE NEENAH R-1736, CLAY & BAILEY #2008, DEETER # 1316, OR APPROVED EQUAL. (CASTING MAY VARY BY MUNICIPALITY, REFER TO PLANS & CONTRACT DOCUMENTS.)

**Accepted
Record Drawings**

These plans have been reviewed for accuracy and are accepted for basic conformance to the approved construction drawings.

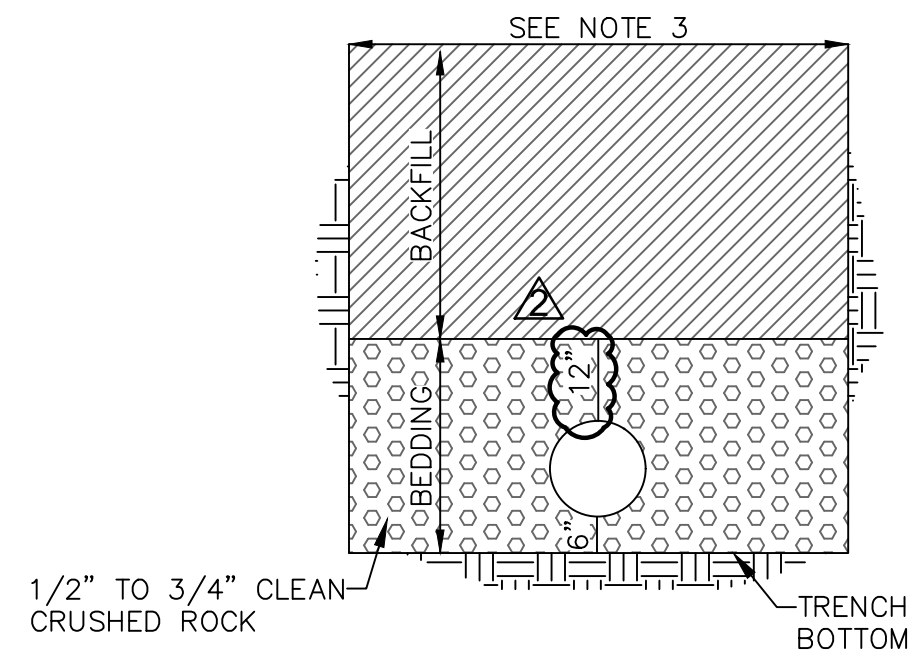
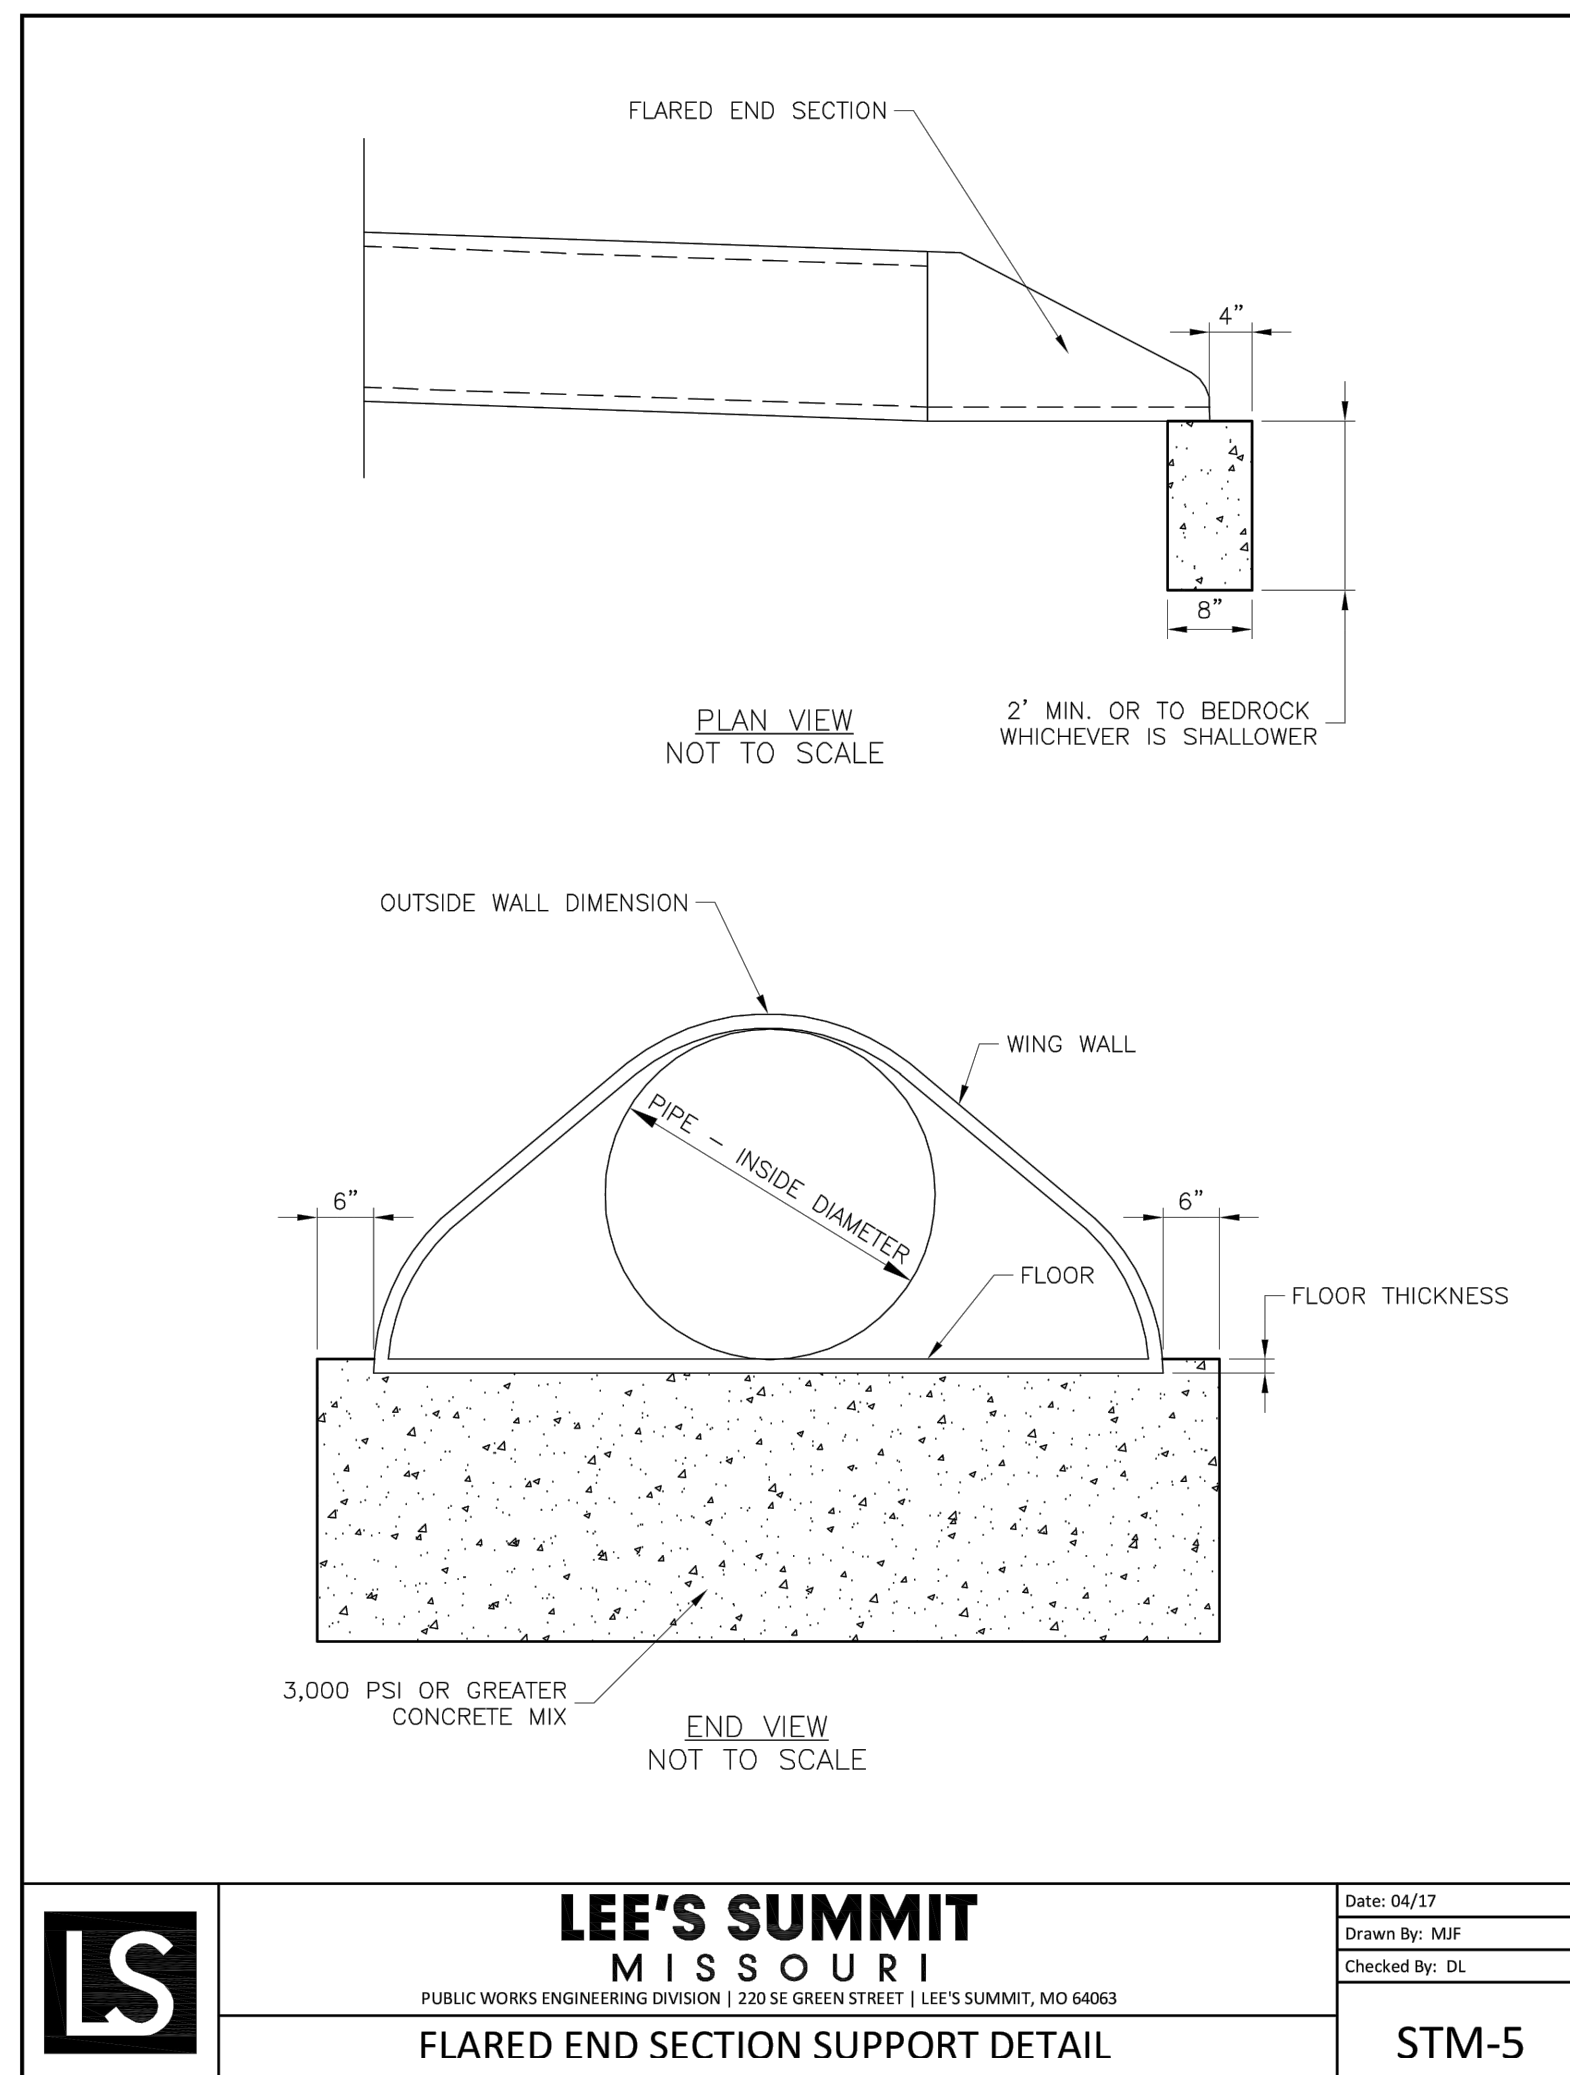


TYPICAL SECTION FOR PLASTIC PIPE
(IN ROCK OR SOIL)

UNDERGROUND PIPE INSTALLATION FOR STORM SEWER LINES

N.T.S.

1. BACKFILL SHALL BE JOG EXCAVATED MATERIAL FREE FROM DEBRIS AND STONES COMPACTED TO 90% OF MAXIMUM DENSITY AT OPTIMUM MOISTURE CONTENT AS DETERMINED BY ASTM D698. BACKFILL UNDER PAVEMENT (EXISTING OR PROPOSED), SHALL BE FLOWABLE FILL.
2. TRENCH BANKS MAY BE CUT BACK ON SLOPES IN ACCORDANCE WITH CURRENT OSHA REGULATIONS, BUT ONLY IN AREAS WHERE THE INCREASED TRENCH WIDTH WILL NOT INTERFERE WITH SURFACE FEATURES. SLOPES MUST NOT EXTEND BELOW TOP OF BEDDING.
3. MINIMUM AND MAXIMUM WIDTHS SHALL BE IN ACCORDANCE WITH PIPE MANUFACTURER'S RECOMMENDATION AS APPROVED ON ENGINEERING PLANS.

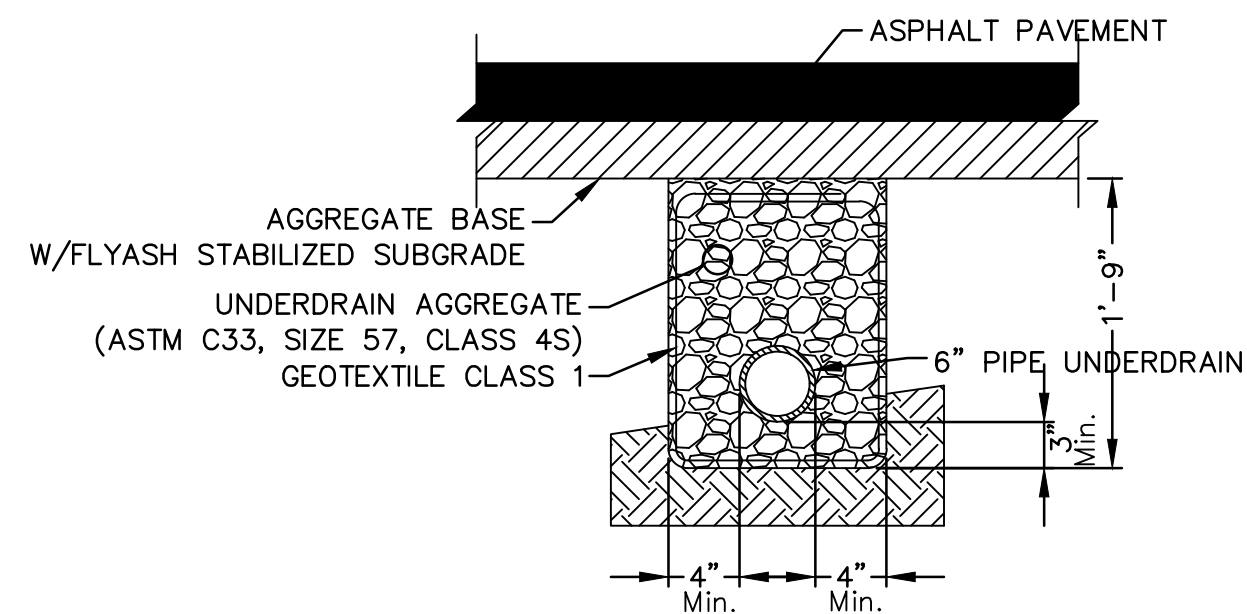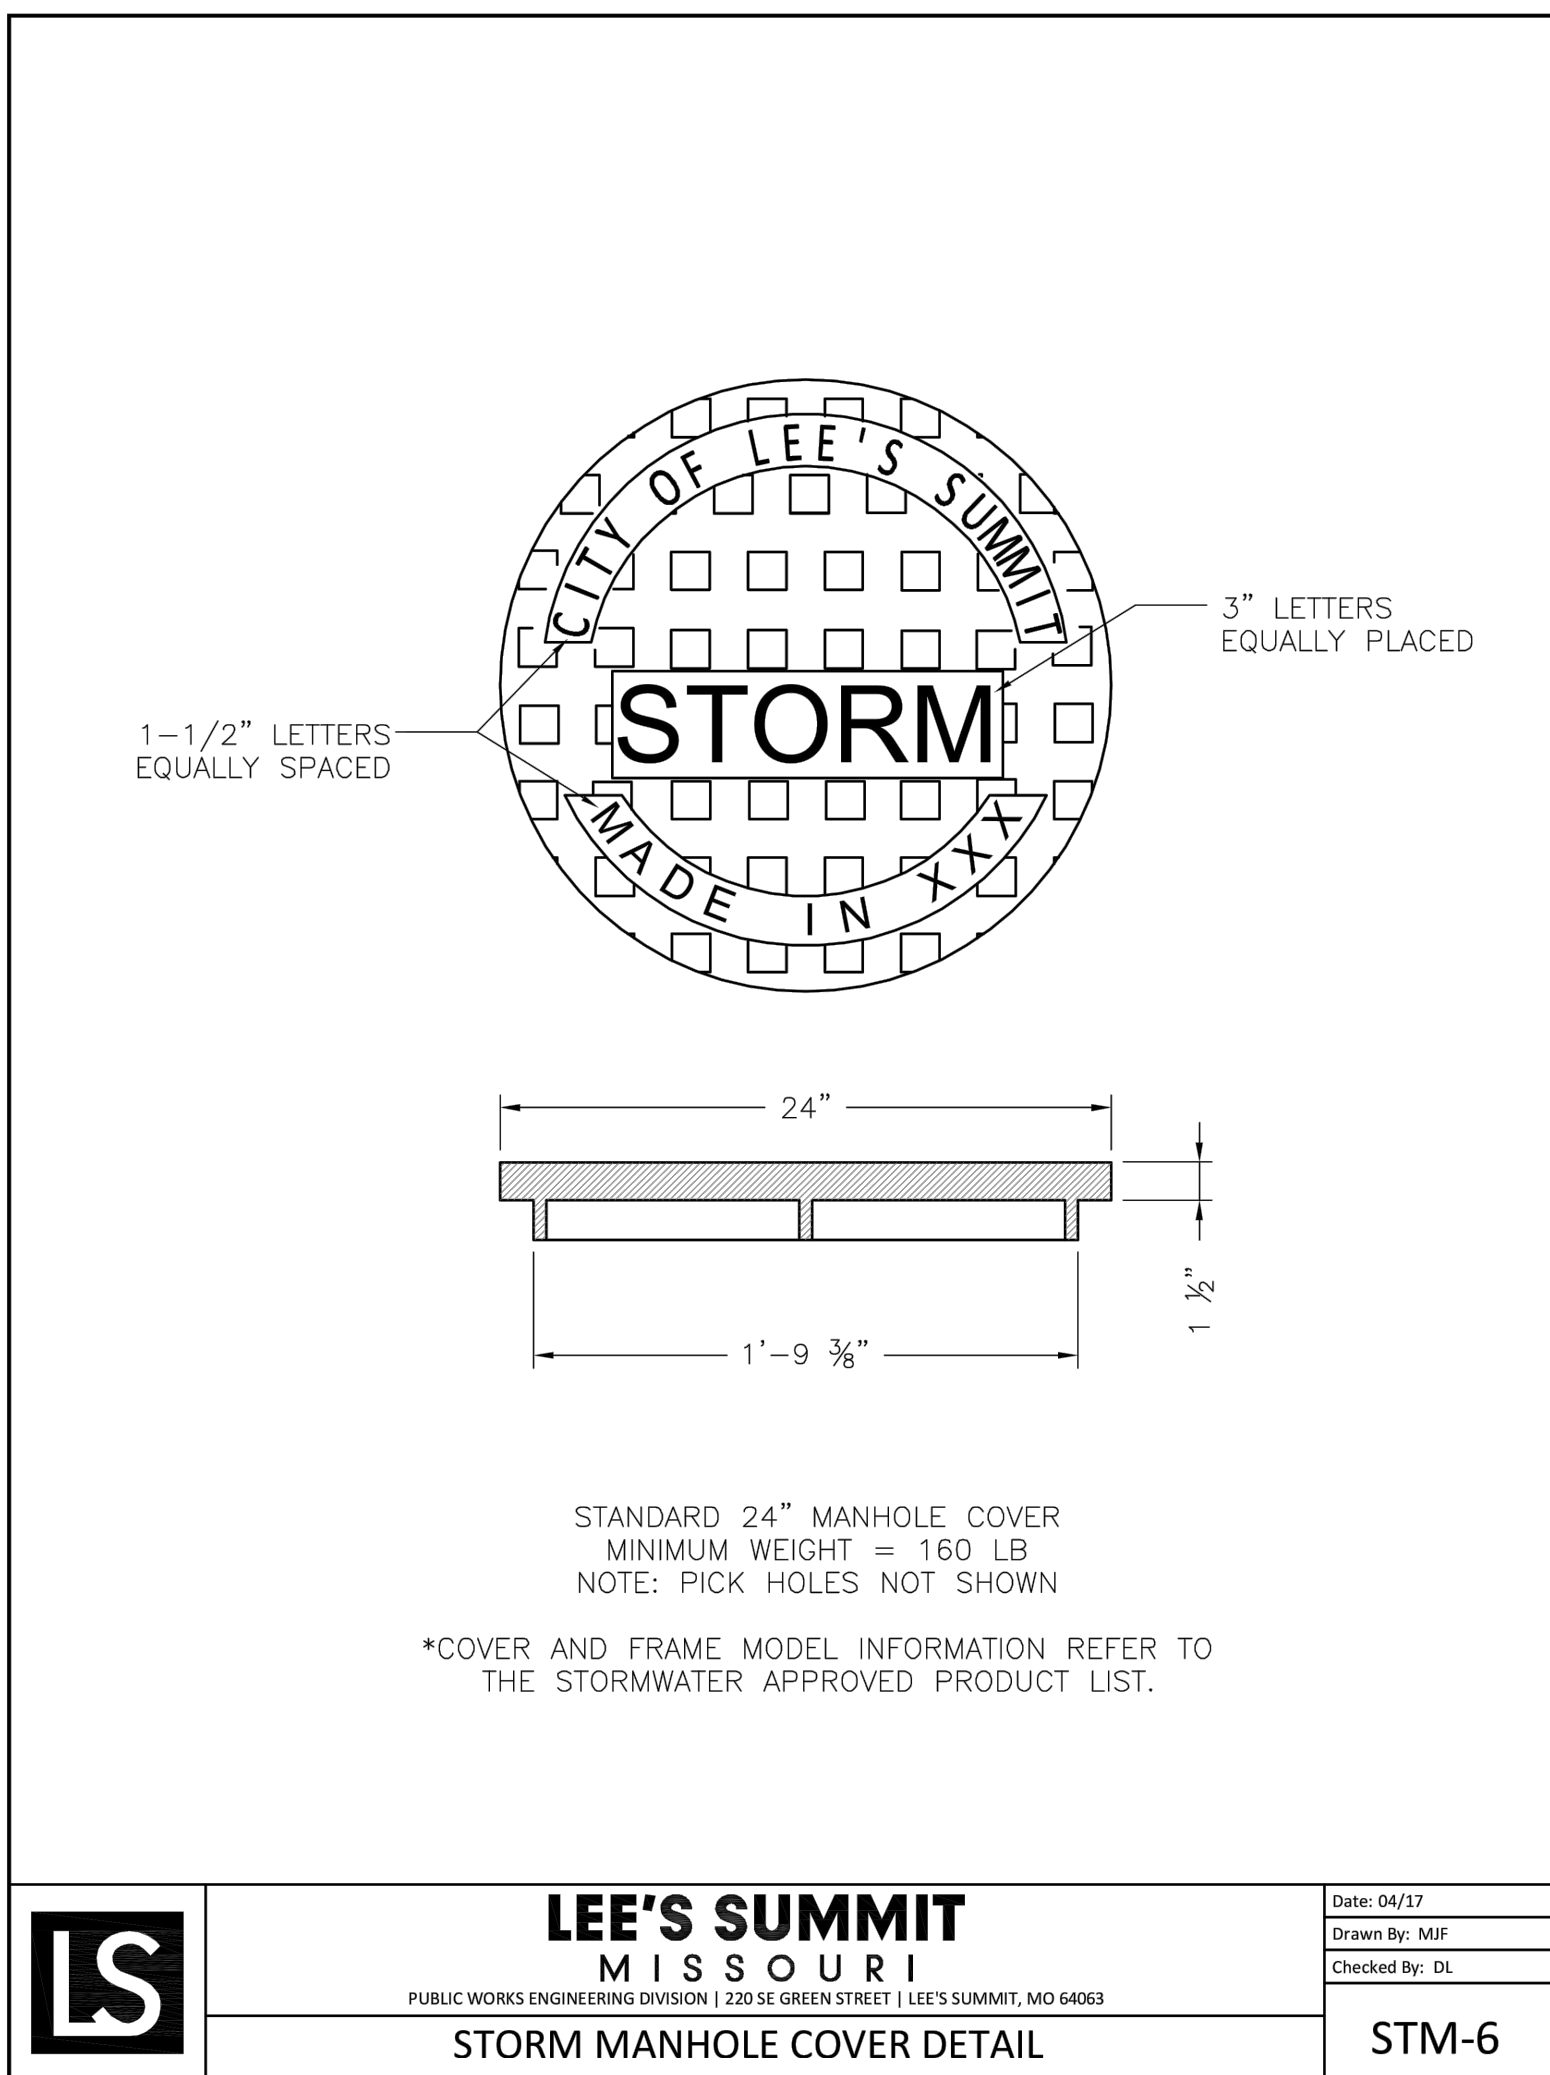


PIPE UNDERDRAIN LATERAL

N.T.S.


NOTES:

- Where Pipe Underdrains are used, all Underdrain Outlet Pipes shall be solid wall with watertight joints. All Outlets Pipes shall be tied into the nearest storm sewer inlets at roadway sag locations as indicated on the street layout.
- All Underdrain Pipes shall be installed at a minimum slope of 1%.
- Underdrain Pipe shall be installed with the perforations placed down.
- Blanket Underdrain Aggregate, Pipe Underdrain Aggregate, Pipe Underdrain, Edge Underdrain and Outlet Pipe shall conform to City of Lee's Summit Specifications.
- Overlap geotextile at top of trench a minimum of 12".

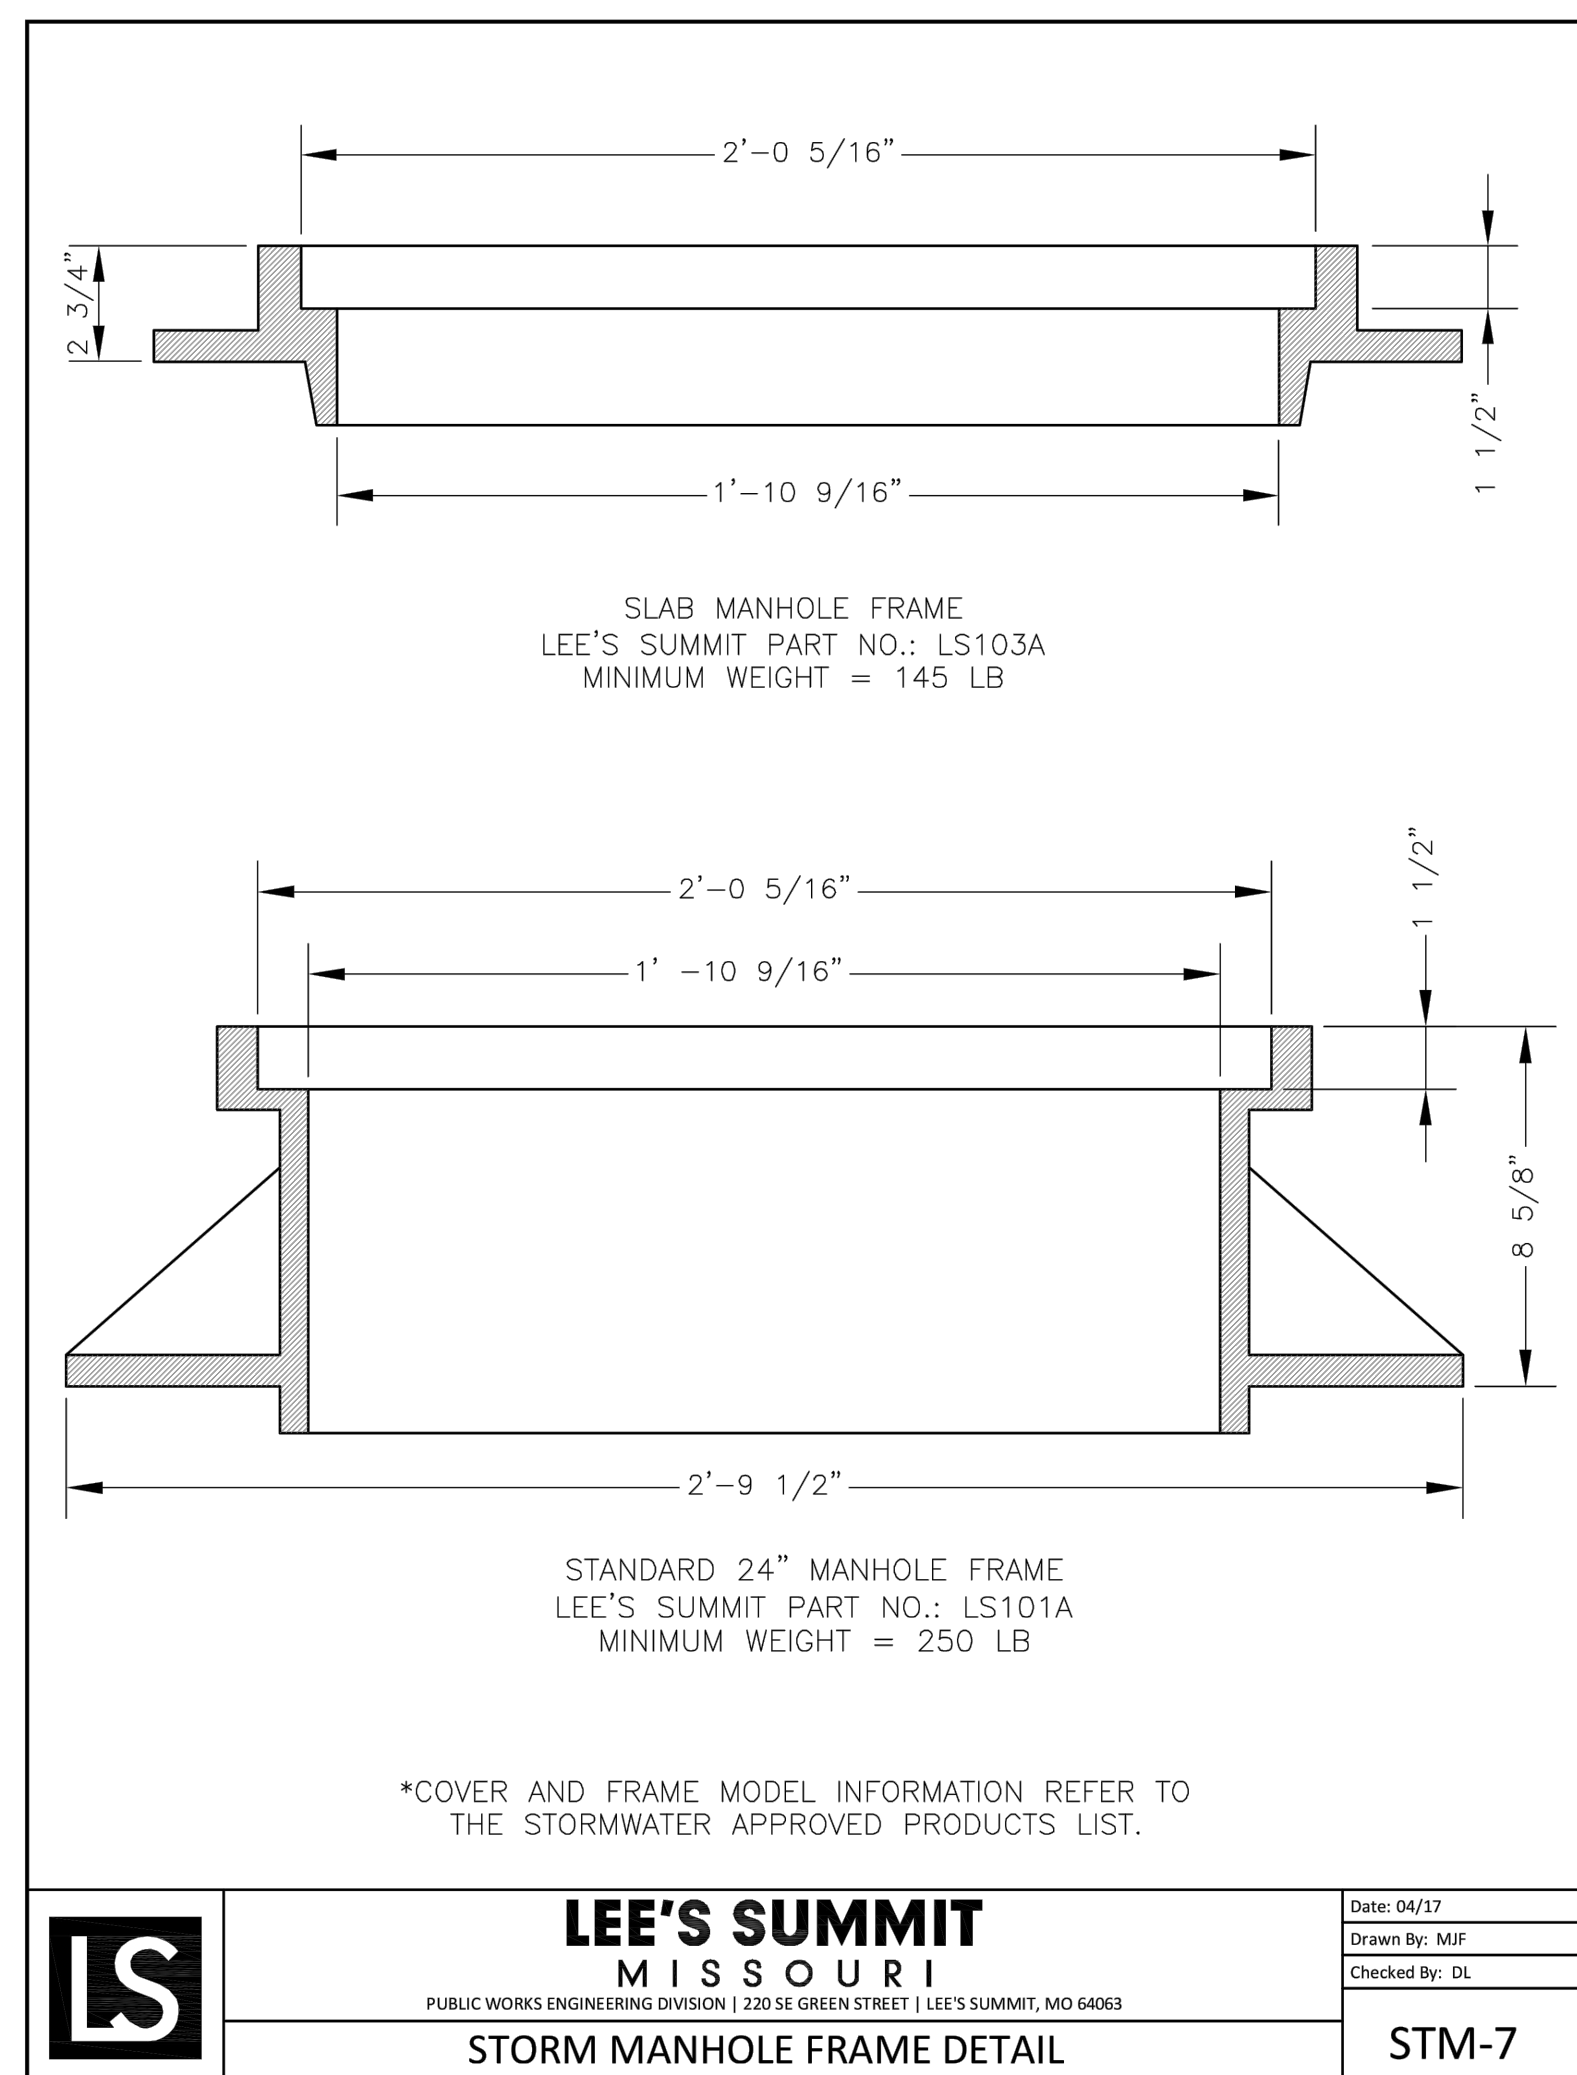

**Accepted
Record Drawings**

These plans have been reviewed for accuracy and are accepted for basic conformance to the approved construction drawings.

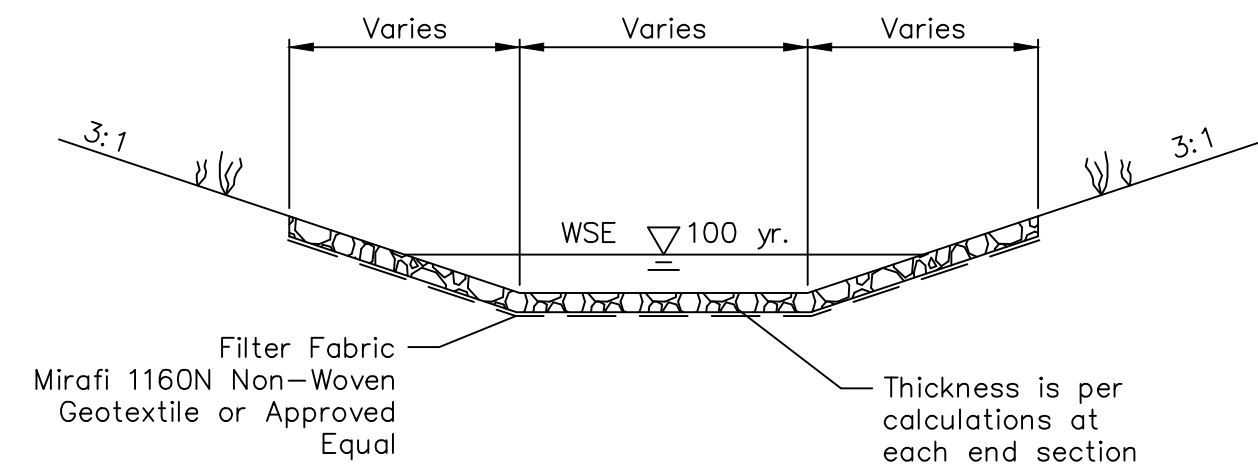

NOTE: DIMENSIONS ARE PER
CALCULATIONS AT EACH END SECTION

RIPRAP DETAIL

N.T.S.

NOT ASBUILT

[illegible]

REVISIONS

2020



LEE'S SUMMIT, MO

STORM SEWER DETAILS STREET & STORM SEWER PLANS

HAWTHORN RIDGE
THIRD PLAT

drawn by: _____ OLS
checked by: _____ BMW
approved by: _____ BMW
QA/QC by: _____ JES
project no.: _____ A19-1605
drawing no.: C DTL01 A191605
date: _____ 10/02/2020

SHEET
C128

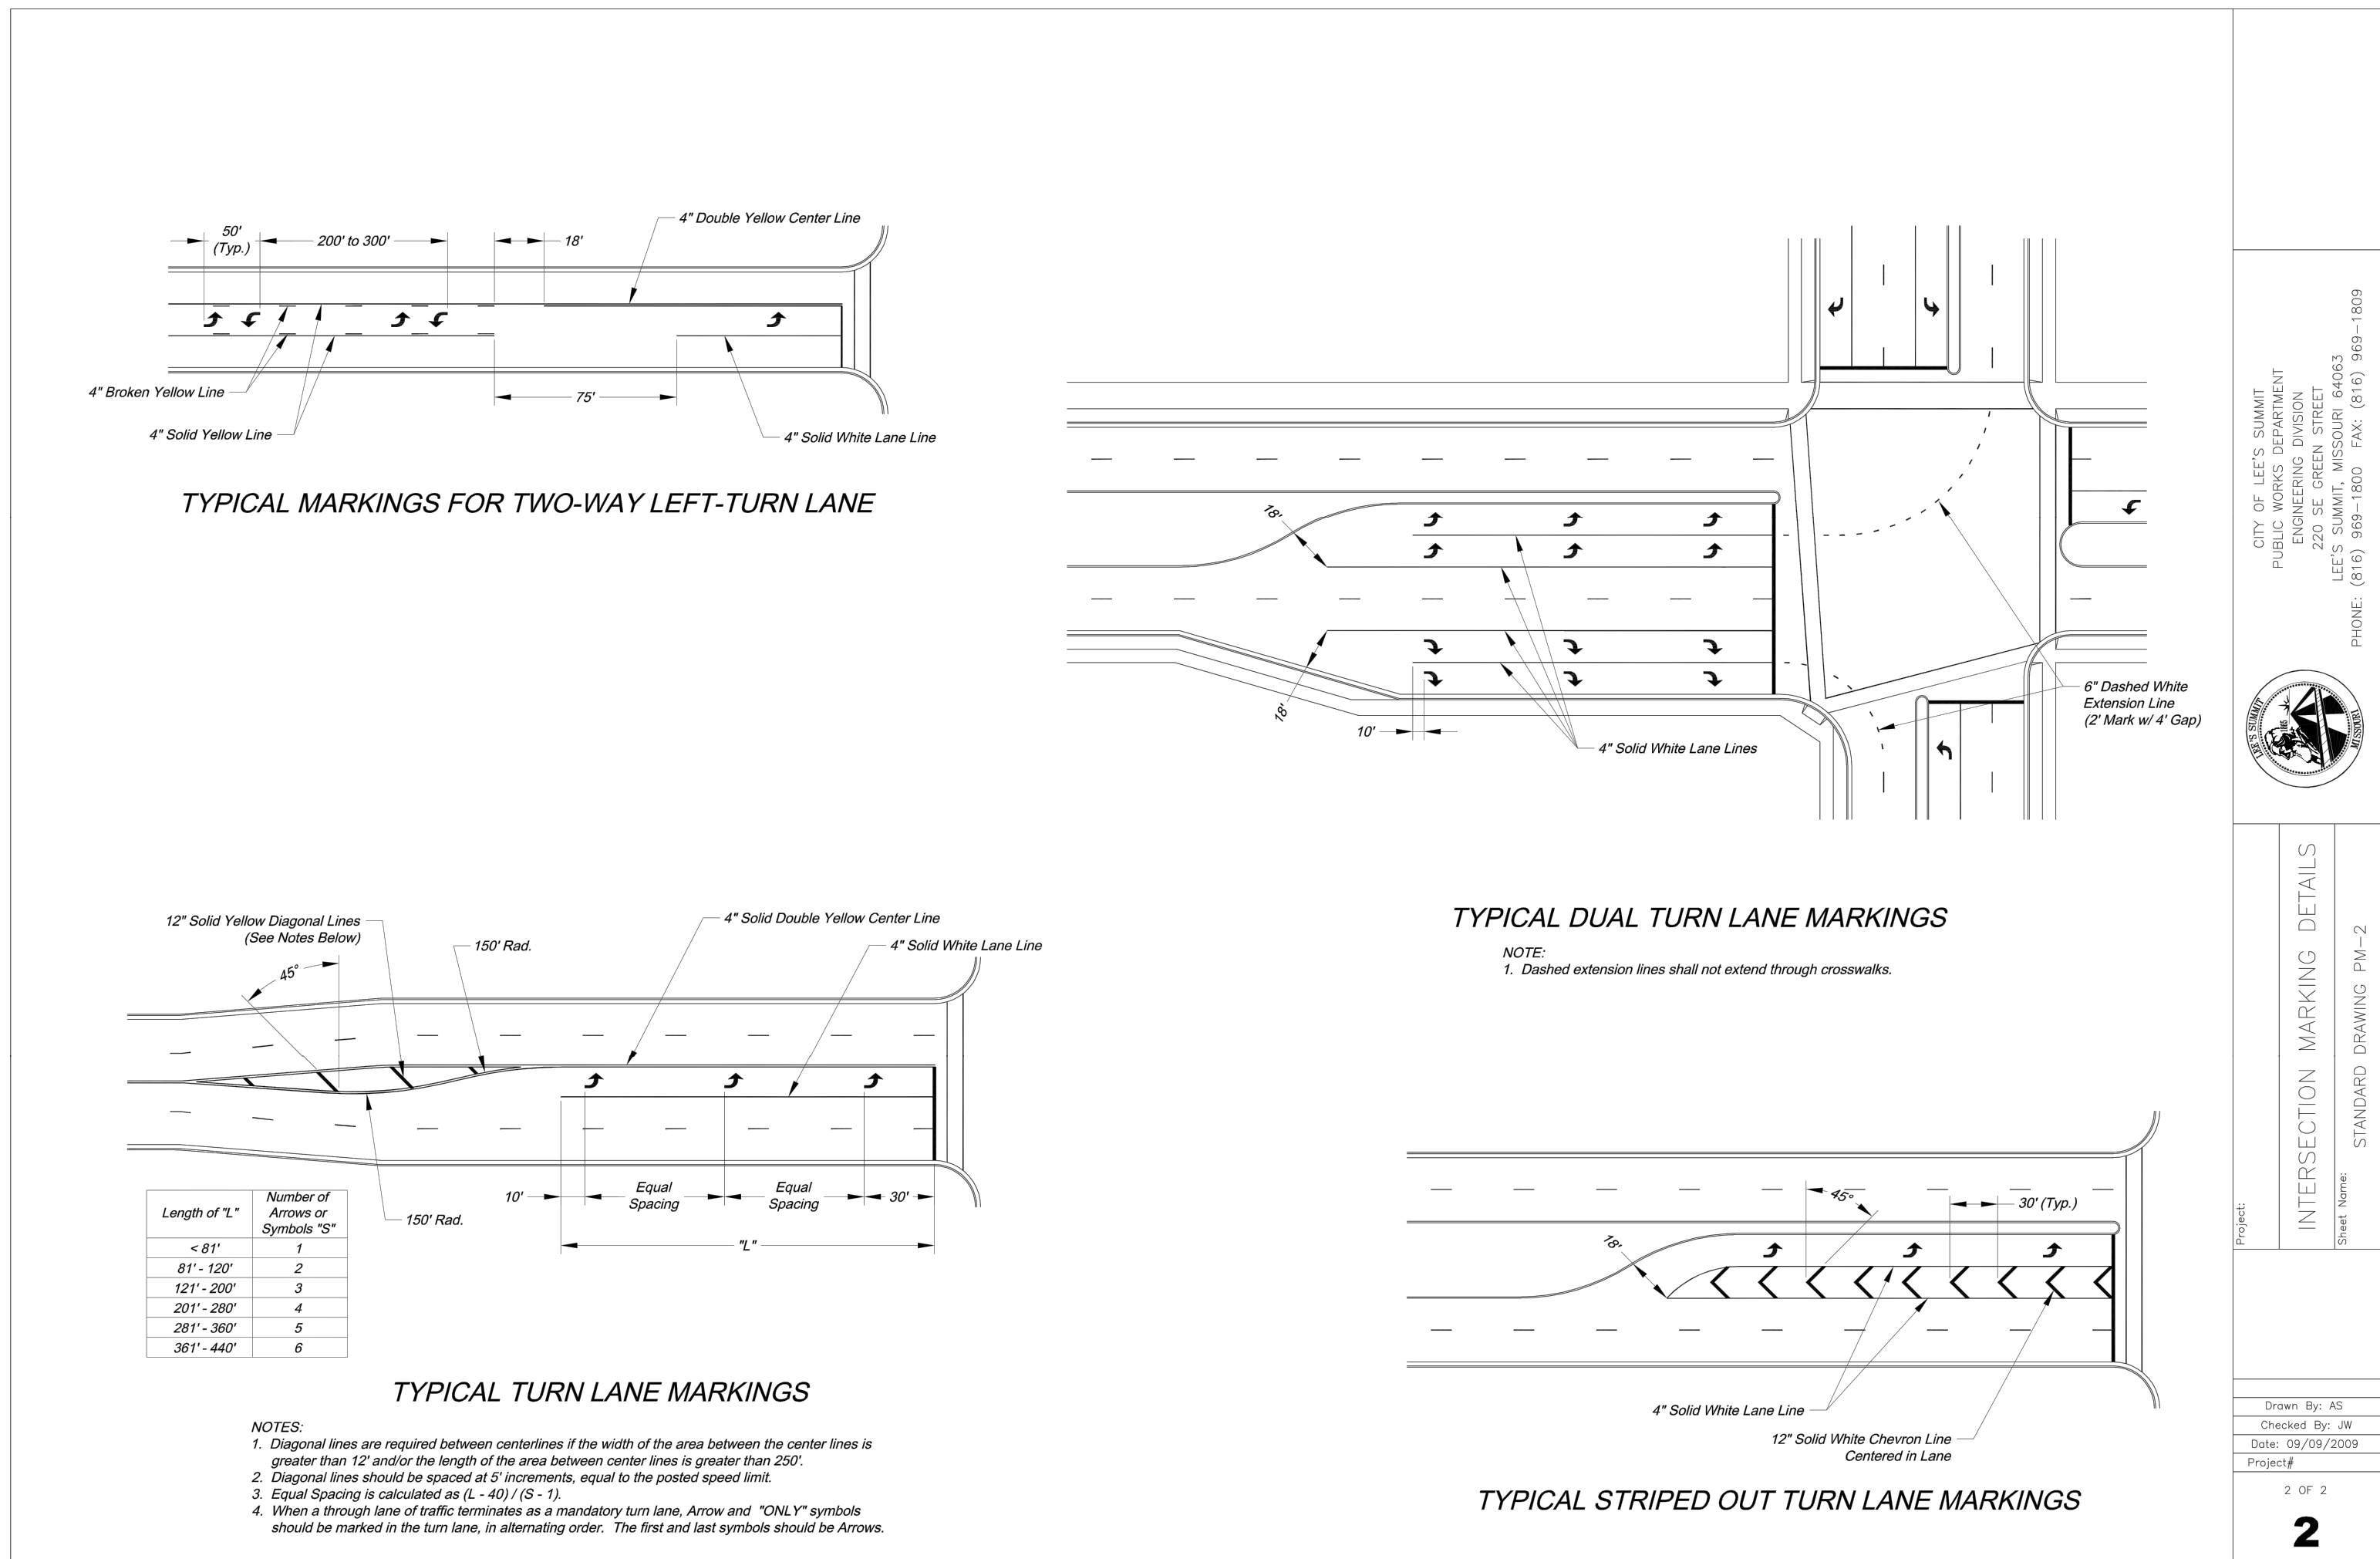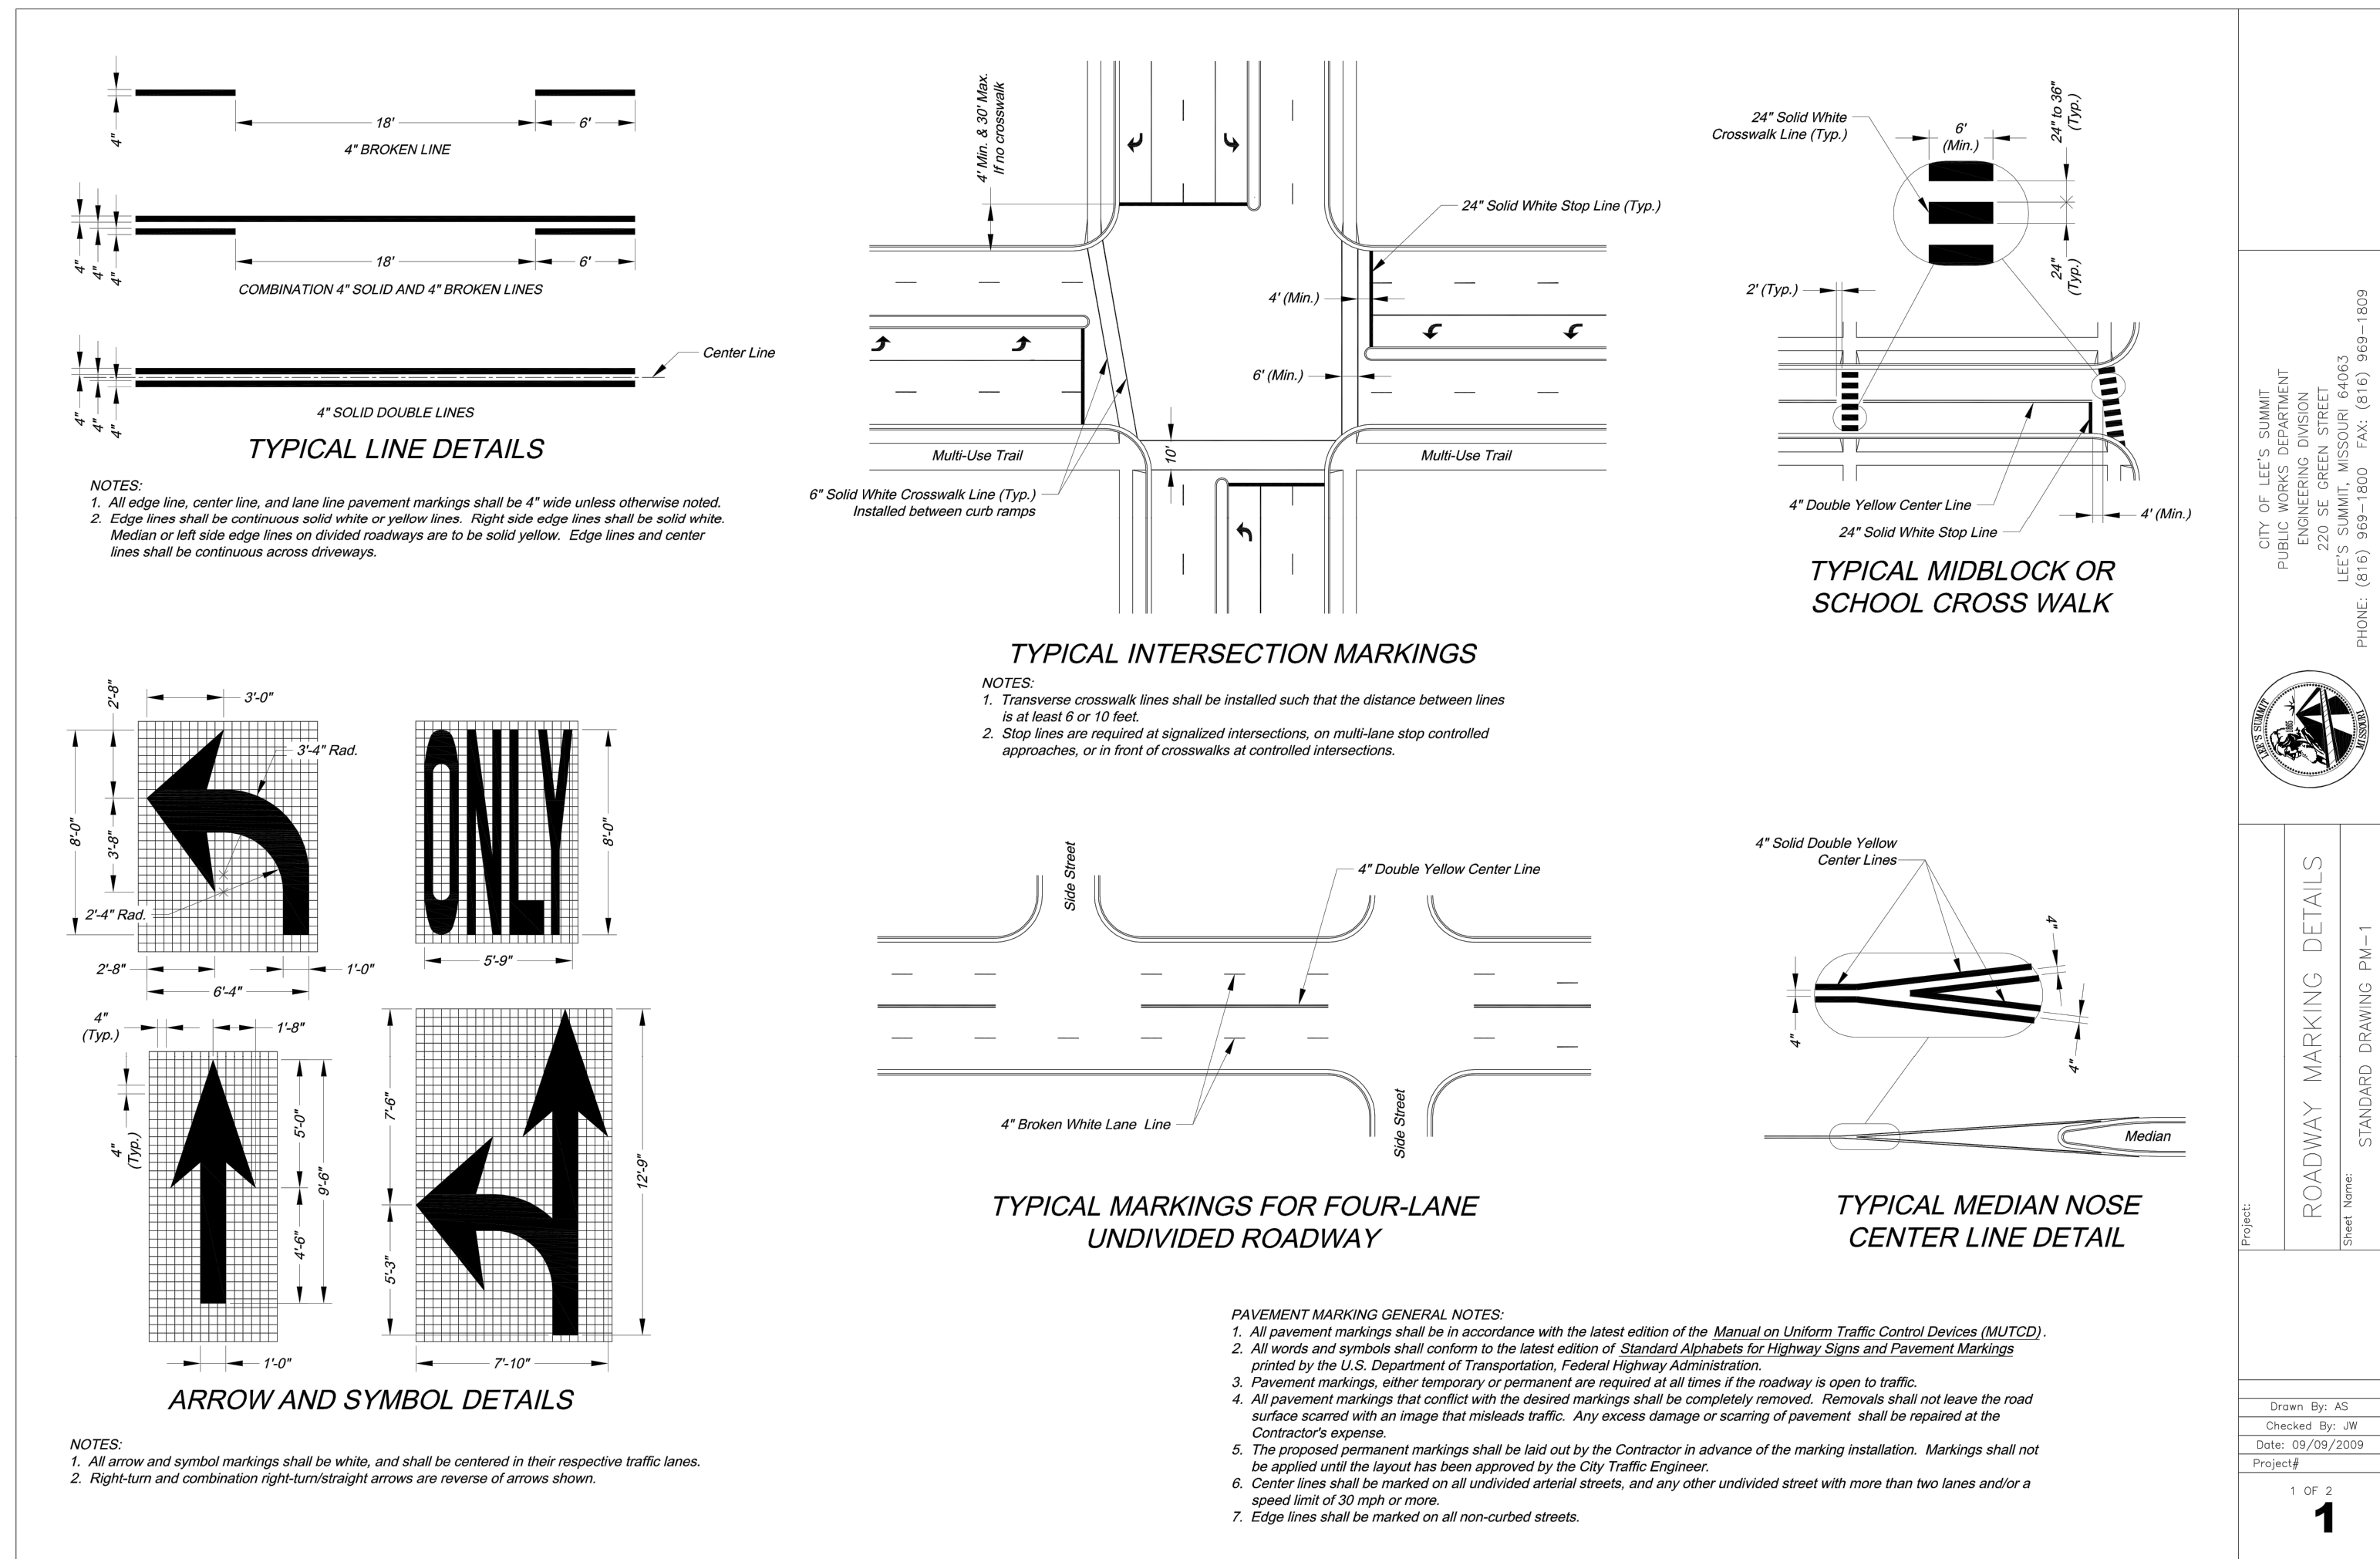

**Accepted
Record Drawings**

These plans have been reviewed for accuracy and are accepted for basic conformance to the approved construction drawings.