


2 Right Elevation

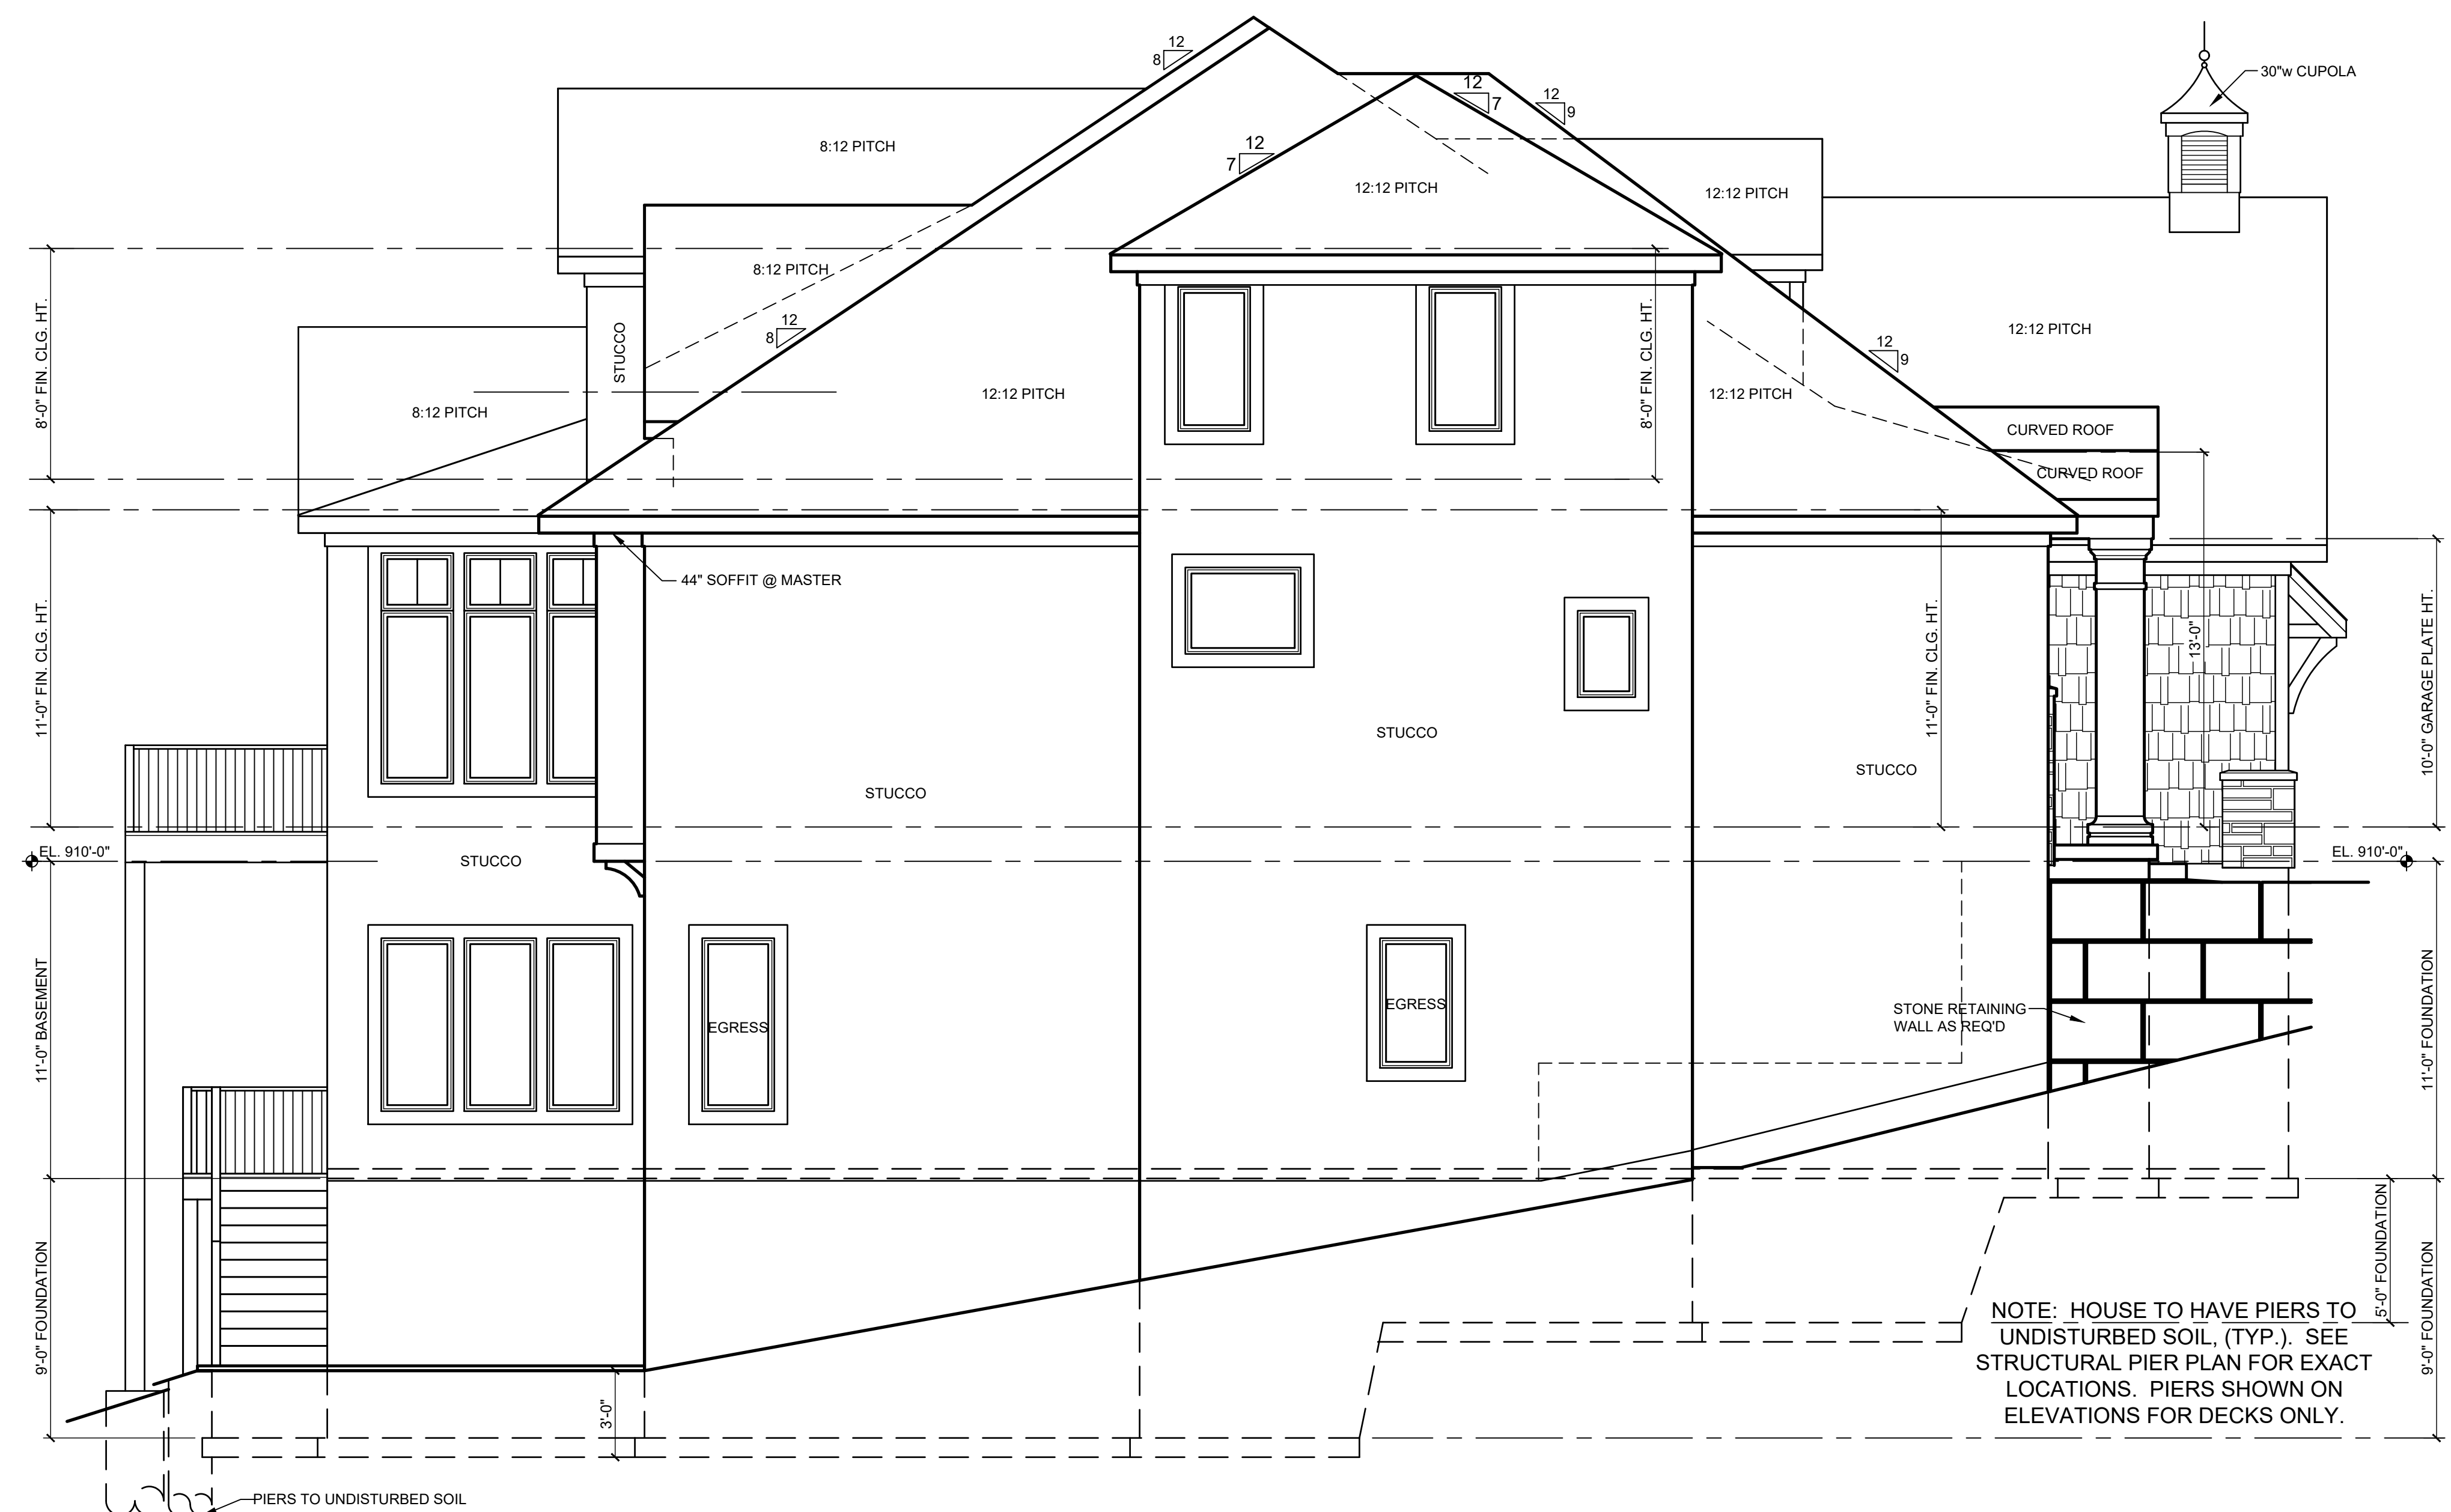

1 Left Elevation

On the far east side of the house, approximately 3' of the uncovered deck is within the 25' rear setback line. As you go west, the part of the deck that is within the 25' setback line reduces. See the plot plan.

SKETCH #2
2/15/22 - Added
red-lines to identify
scope of rear setback
issues.
Bill Steenson



APEX ENGINEERS, INC.
 1625 LOCUST ST
 KANSAS CITY, MO 64108
 816.421.3222
 STRUCTURAL DESIGN REVIEW
 AS ENGINEERING LICENSE:
 992
 URI ENGINEERING LICENSE:
 2003004673


Steenson
Residence

3000 Audubon Lane
Winterset Lot #1451
Lee's Summit, MO

Copyright © 2019-2021 Koehler Building Co., Inc. & FT5, LLC

Koehler Building Co. Inc.
2912 State Line Road
Lawwood, KS 66209
781-343-6565
www.koehlerbuildingco.com

Engineer of Record:
Apex Engineers, Inc.
325 Locust St, Kansas City, MO 64108
16.421.3222

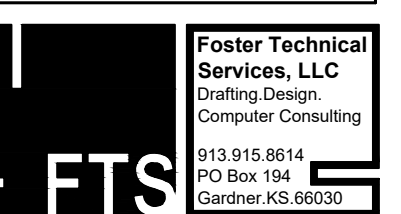

Project Number:	21-011.5
Date:	10.26.2021
Revised:	
Drawn By:	BLF

Sheet Number: A2

Sheet Title: EXTERIOR ELEVATIONS