

-
- Diagram illustrating a 100' x 100' square area with a checkerboard pattern. The horizontal axis is labeled 0, 50, 100. The vertical axis is labeled 0, 10. Text indicates: HORIZ.: 1"=50', VERT.: 1"=10'.





AS-BUILT
DATE 01/28/2022

**RELEASE FOR
CONSTRUCTION
AS NOTED ON PLANS REVIEW
DEVELOPMENT SERVICES
LEE'S SUMMIT, MISSOURI**

04/16/2021

REVISIONS				DRAWING INFO.	
NO.	DESCRIPTION	BY	DATE	DRAWN BY:	GC
1	REVISED PER CITY COMMENT	GC	2/11/21	CHECK BY:	ZM
				LICENSE NO.	PE-2012009232
				DATE:	1/7/2021
				ISSUED FOR:	FOR REVIEW
				JOB NUMBER:	20KCT0058
 COWI NORTH AMERICA, INC. 2020				NO. CCA NO.	000003

CORVBICHT ANDERSON ENGINEERING INC 2020

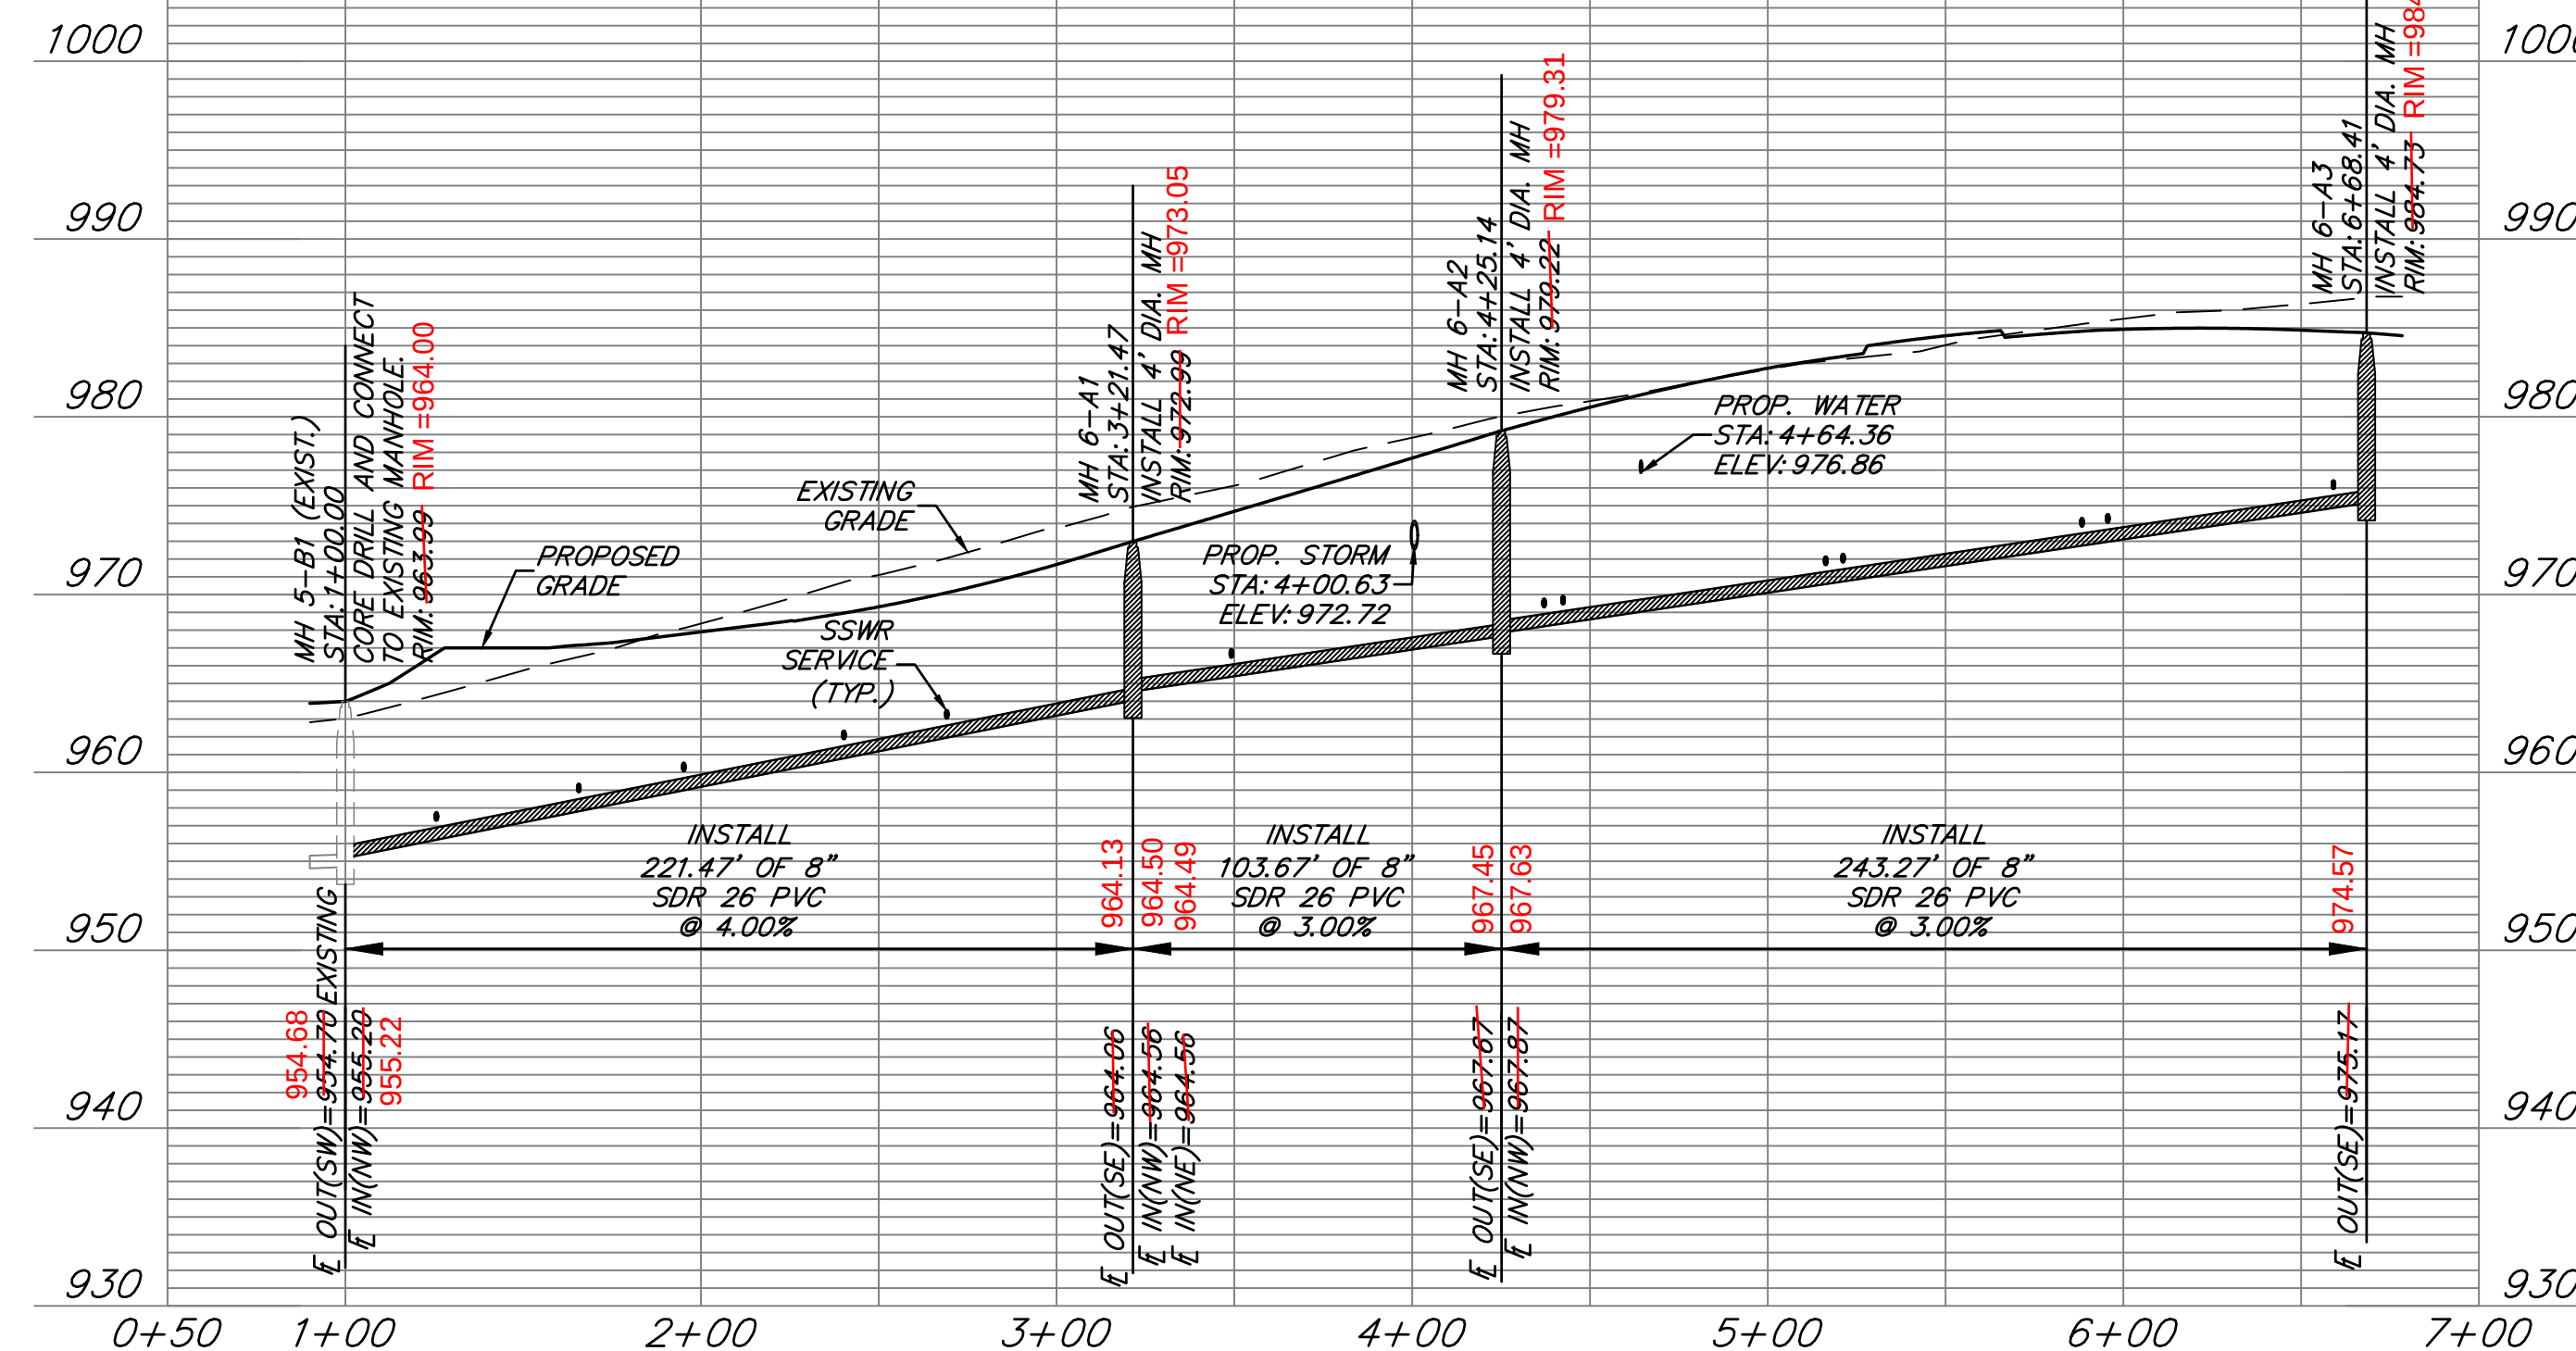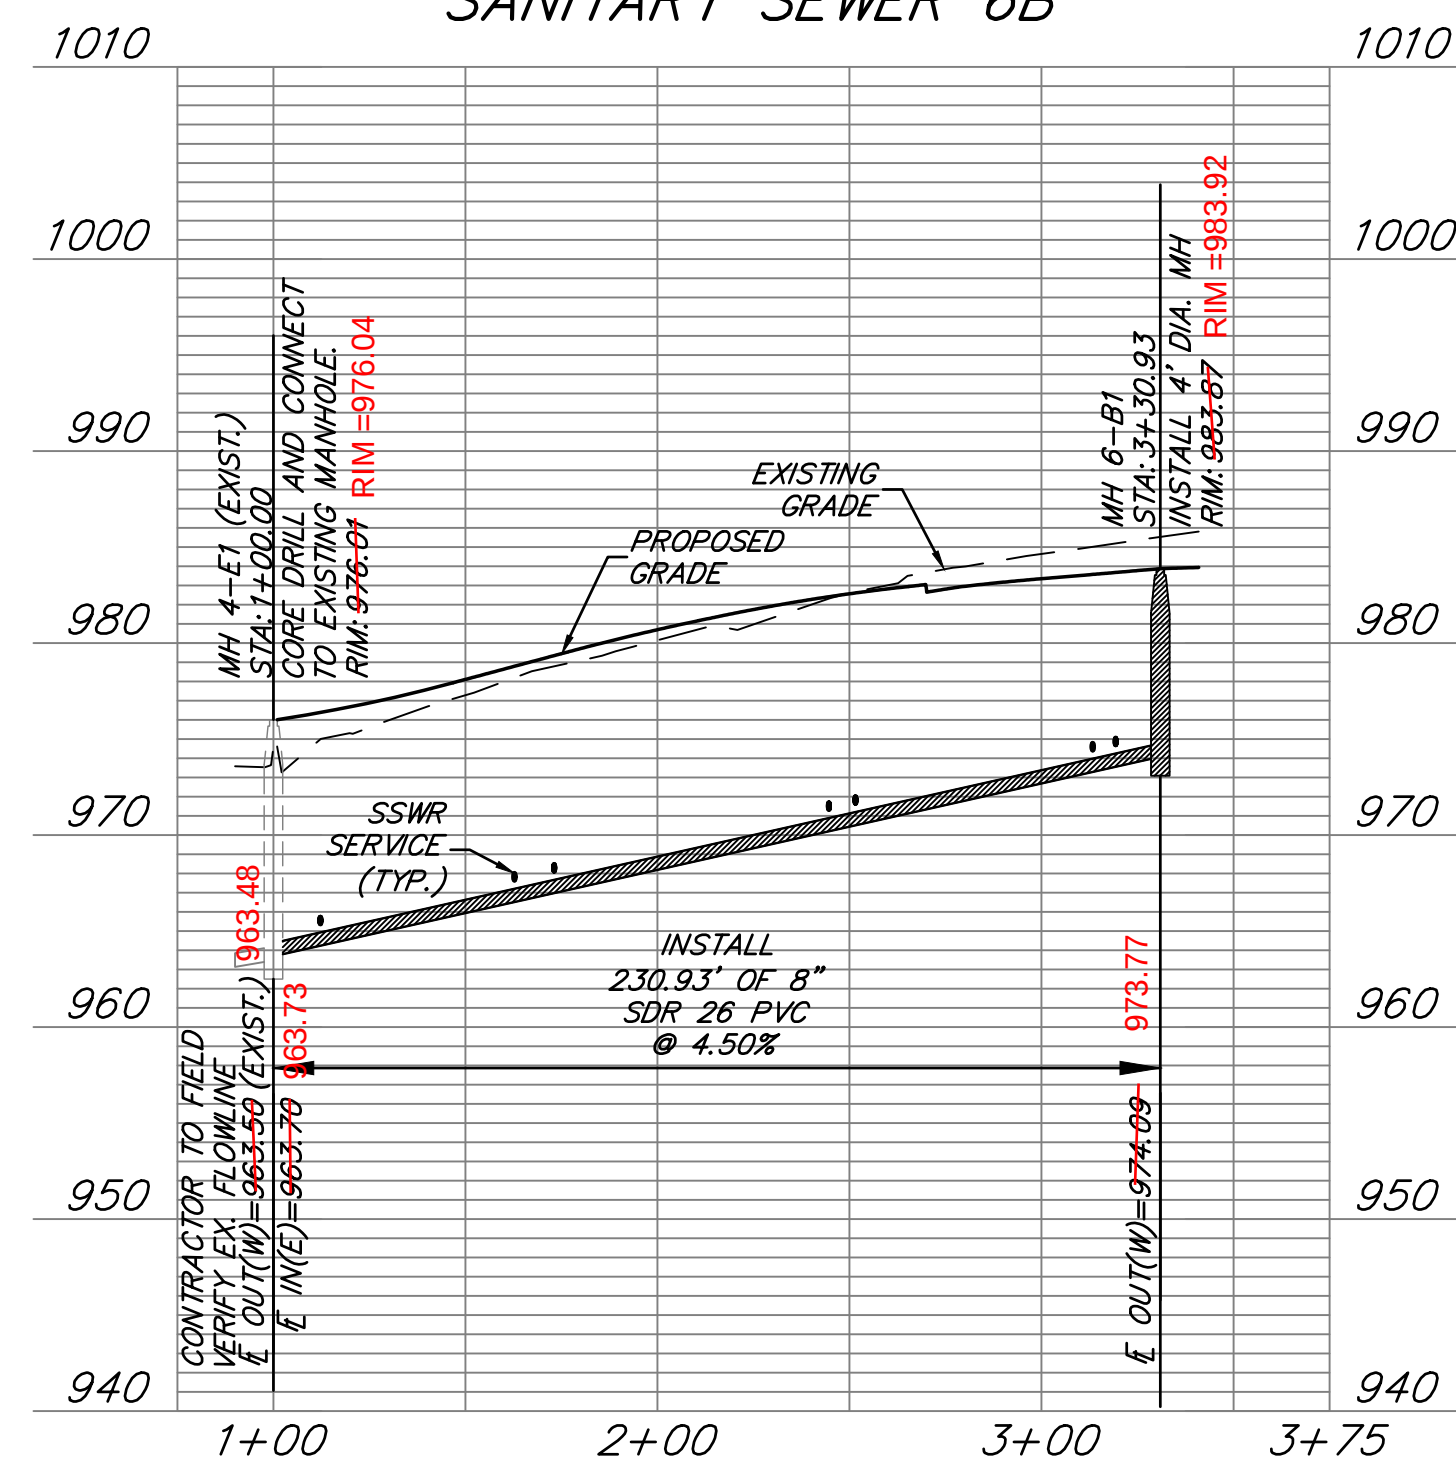

SANITARY SEWER SERVICE				
PIPE NAME	STATION	LENGTH	SLOPE	MSFE
SSS-160	1+25.59	27'	2.00%	957.91+(3.5')
SSS-161	1+95.17	53'	2.00%	961.19+(3.5')
SSS-162	2+69.12	36'	2.00%	963.83+(3.5')
SSS-163	3+49.16	39'	2.00%	967.31+(3.5')
SSS-164	4+37.10	38'	2.00%	970.13+(3.5')
SSS-165	5+16.29	27'	2.00%	972.28+(3.5')
SSS-166	5+95.63	29'	2.00%	974.69+(3.5')
SSS-167	3+13.32	37'	2.00%	975.17+(3.5')
SSS-174	6+59.09	43'	2.00%	976.88+(3.5')
SSS-175	5+88.37	52'	2.00%	974.95+(3.5')
SSS-176	5+21.17	53'	2.00%	972.95+(3.5')
SSS-177	4+42.43	45'	2.00%	970.42+(3.5')
SSS-168	2+44.63	23'	2.00%	971.80+(3.5')
SSS-169	1+73.10	18'	2.00%	968.48+(3.5')
SSS-170	1+12.21	13'	2.00%	965.65+(3.5')
SSS-171	1+62.75	63'	2.00%	968.92+(3.5')
SSS-172	2+51.55	57'	2.00%	972.79+(3.5')
SSS-173	3+19.31	44'	2.00%	975.59+(3.5')
SSS-209	2+40.19	46'	2.00%	962.86+(3.5')
SSS-210	1+65.62	74'	2.00%	960.44+(3.5')

SUMMIT HOMES KC
HIGHLAND MEADOWS - 6TH PLAT

**SANITARY SEWER 6A AND 6B
PLAN & PROFILE**

S10, T47N, R32W

S10, T47N, R32W
 JEFF'S SUMMIT, JACKSON COUNTY, MISSOURI



SHEET NUMBER

C102
3 OF 6