

GENERAL NOTES

1. IT SHALL BE THE CONTRACTOR'S RESPONSIBILITY TO ACQUIRE ALL STATE AND CITY PERMITS, INCLUDING PERMITS REQUIRED BY OTHER GOVERNING BODIES, REQUIRED FOR THE CONSTRUCTION OF THIS PROJECT.

2. PRIOR TO BEGINNING CONSTRUCTION, THE GENERAL CONTRACTOR SHALL BE RESPONSIBLE FOR CONTACTING AND NOTIFYING ALL UTILITY COMPANIES AND SHALL FIELD VERIFY ALL UTILITIES THAT MAY BE ENCOUNTERED. THE INFORMATION SHOWN ON THESE PLANS CONCERNING THE TYPE AND LOCATION OF UNDERGROUND UTILITIES IS NOT GUARANTEED TO BE ACCURATE OR COMPLETE. IN THE EVENT THAT EXISTING UTILITIES ARE CONTACTED, DISRUPTED, OR IN ANY WAY ALTERED, CONTACT THE RESPECTIVE UTILITY COMPANY IMMEDIATELY. IN CASE OF EMERGENCY, DIAL 911.

3. THE CONTRACTOR SHALL PROVIDE EROSION AND SILT PROTECTION AS REQUIRED DURING CONSTRUCTION AND SHALL BE RESPONSIBLE FOR KEEPING EXISTING STREET AND ADJACENT LAND FEATURES AND PROPERTY FREE OF MUD AND SILT. SEE "EROSION CONTROL PLAN" FOR MINIMUM EROSION CONTROL MEASURES REQUIRED BY THESE PLANS. EROSION CONTROLS SHALL BE INSTALLED PRIOR TO THE COMMENCEMENT OF CONSTRUCTION. ONCE CONSTRUCTION BEGINS, THE CONTRACTOR SHALL BE RESPONSIBLE FOR MAINTAINING ALL EROSION CONTROL MEASURES AND SHALL PROMPTLY REPAIR ANY AREA REQUIRING ATTENTION UNTIL SUBSTANTIAL COMPLETION.

4. WARRANTY/DISCLAIMER: THE DESIGNS REPRESENTED IN THESE PLANS ARE IN ACCORDANCE WITH ESTABLISHED PRACTICES OF CIVIL ENGINEERING FOR THE DESIGN FUNCTIONS AND USES INTENDED BY THE OWNER AT THIS TIME. HOWEVER, NEITHER THE ENGINEER NOR ITS PERSONNEL CAN OR DO CERTIFY THESE DESIGNS OR PLANS AS CONSTRUCTED EXCEPT IN THE SPECIFIC CASES WHERE THE ENGINEER OBSERVES AND CONTROLS THE PHYSICAL CONSTRUCTION AND THE CONTINUAL BASIS AT THE SITE.

5. ALL CONSTRUCTION SHALL FOLLOW THE CITY OF LEE'S SUMMIT DESIGN AND CONSTRUCTION MANUAL AS ADOPTED BY ORDINANCE 5013. WHERE DISCREPANCIES EXIST BETWEEN THESE PLANS AND THE DESIGN AND CONSTRUCTION MANUAL, THE DESIGN AND CONSTRUCTION MANUAL SHALL PREVAIL.

6. THE CONTRACTOR SHALL PROVIDE AT LEAST ONE (1) CHEMICALLY TREATED PORTABLE TOILET UNIT, "SATELLITE CORPORATION", OR EQUAL FOR EVERY 20 WORKMEN ON THE JOB SITE. IN NO CASE SHALL LESS THAN ONE (1) BE PROVIDED. THE UNIT(S) SHALL REMAIN ON THE SITE DURING ALL ACTIVE PHASES OF CONSTRUCTION. THE CONTRACTOR SHALL ENFORCE THE USE OF THE PUBLIC VIEW TO THE GREATEST EXTENT PRACTICABLE.

7. ALL AREA TO BE FILLED AND SUBGRADES UNDER PAVEMENTS SHALL BE PROOF-ROLLED WITH A LOADED, RUBBER Tired TRUCK PRIOR TO FILL PLACEMENT OR ROADWAY PAVING OPERATIONS BEGIN. SOFT OR UNSTABLE AREA SHALL BE REMOVED AND REPLACED WITH STRUCTURAL FILL.

8. PRIOR TO BEGINNING CONSTRUCTION, THE CONTRACTOR SHALL OBTAIN A COPY OF AND BECOME FAMILIAR WITH THE GEOTECHNICAL REPORT BY ANDERSON ENGINEERING INC., UNLESS SPECIFICALLY NOTED ON THE PLANS. THE RECOMMENDATIONS IN THE GEOTECHNICAL REPORT ARE HEREBY INCORPORATED INTO THE PROJECT REQUIREMENTS AND SPECIFICATIONS.

9. THE CONTRACTOR SHALL PROVIDE ALL CONSTRUCTION LAYOUT AND STAKING FOR THIS PROJECT.

10. ALL PIPE LENGTHS ARE SHOWN FROM STRUCTURE CENTER TO STRUCTURE CENTER.

11. ALL STRUCTURE STATION AND OFFSET CALLOUTS ARE TO THE CENTER OF STRUCTURE.

12. ALL CURB STATIONS, OFFSETS AND ELEVATIONS ARE TO THE TOP BACK OF CURB UNLESS OTHERWISE NOTED.

13. ALL CONNECTIONS TO EXISTING DRAINAGE STRUCTURES SHALL BE SUBSIDIARY TO NEW DRAINAGE CONSTRUCTION.

14. IT WILL BE THE RESPONSIBILITY OF THE CONTRACTOR TO ENSURE THAT ACCESS TO ALL PROPERTIES IS AVAILABLE DURING CONSTRUCTION OF THE PROJECT.

15. ALL SAW CUTS SHOWN ON THE PLANS SHALL NOT BE PAID FOR DIRECTLY, BUT SHALL BE CONSIDERED SUBSIDIARY TO OTHER ITEMS OF THE CONTRACT. THE DEPTH OF THE CUT SHALL BE FULL DEPTH.

16. EXISTING CONCRETE PAVEMENT AND EXISTING BITUMINOUS PAVEMENT THAT IS REMOVED WILL BECOME THE PROPERTY OF THE CONTRACTOR & DISPOSED OF AT HIS EXPENSE.

17. EXISTING DRAINAGE STRUCTURES THAT ARE REMOVED, INCLUDING END SECTIONS, SHALL BECOME THE PROPERTY OF THE CONTRACTOR UNLESS OTHERWISE NOTED ON THE PLANS.

18. CONTRACTOR SHALL FIELD VERIFY EXISTING PIPE ELEVATIONS.

19. CHANNELS SHALL BE CUT AT BOX CULVERTS (UNLESS OTHERWISE NOTED) TO FLOW LINE ELEVATIONS AND TO A WIDTH OF ONE FOOT OUTSIDE OF EACH OUTSIDE WALL AND WITH SLOPES OF 2 TO 1 PRIOR TO CONSTRUCTION OF THE CULVERT.
20. IT SHALL BE THE CONTRACTOR'S RESPONSIBILITY TO COORDINATE WITH THE UTILITY OWNERS TO LOCATE AND FLAG ALL RELOCATED UNDERGROUND UTILITIES PRIOR TO EXCAVATION TO AVOID DAMAGING THE UTILITIES. THE LOCATIONS SHOWN ON THE PLANS ARE THE ORIGINAL SURVEYED LOCATION, PRIOR TO RELOCATION IN SOME CASES. THE INFORMATION SHOWN IN THESE PLANS CONCERNING TYPE AND LOCATION OF UNDERGROUND UTILITIES IS NOT GUARANTEED TO BE ACCURATE OR ALL-INCLUSIVE. THE CONTRACTOR IS RESPONSIBLE FOR CONTACTING THE UTILITY COMPANIES PROVIDED FOR FIELD LOCATION OF ALL UNDERGROUND FACILITIES PRIOR TO ANY EXCAVATION. THE CONTRACTOR SHALL COORDINATE WITH THE PROPER UTILITY OWNERS DURING CONSTRUCTION OF THE PROPOSED STORM SEWER SYSTEM TO AVOID DAMAGES TO EXISTING FACILITIES. DAMAGE TO ANY FACILITIES WILL BE PAID FOR AT THE CONTRACTOR'S EXPENSE.

21. ALL TREES, SHRUBS, BUSHES, AND BRUSH WITHIN THE GRADING LIMITS SHALL BE REMOVED BY THE CONTRACTOR UNLESS SPECIFICALLY INDICATED TO BE SAVED ON THE PLANS.

22. ALL SIGNS REMOVED BY THE CONTRACTOR SHALL BECOME PROPERTY OF THE CITY, UNLESS NOT DESIRED BY CITY. IF NOT DESIRED BY CITY, CONTRACTOR SHALL REMOVE AND DISPOSE OF SIGNS AT HIS EXPENSE.

23. DRAINAGE STRUCTURES WHICH ARE TO REMAIN, WHETHER EXTENDED OR NOT, SHALL BE CLEANED OUT BY THE CONTRACTOR, AS DIRECTED BY THE CITY.

24. CONTRACTOR SHALL ACCOMPANY A DESIGNATED CITY REPRESENTATIVE DURING A PHOTOGRAPHY & VIDEO TOUR BEFORE ANY CONSTRUCTION BEGINS TO RECORD EXISTING CONDITIONS.

25. THE CONTRACTOR SHALL THOROUGHLY REVIEW AND BECOME FAMILIAR WITH THE PROJECT PLANS, SPECIFICATIONS AND ANY SPECIAL CONDITIONS OF THE CONTRACT DOCUMENTS PRIOR TO BEGINNING CONSTRUCTION OF THIS PROJECT.

26. DRIVEWAYS, SIDEWALKS, PARKING LOTS, YARD LIGHTS, FENCES, SPRINKLER SYSTEMS, UTILITY SERVICE LINE CONNECTIONS, LANDSCAPING, SEPTIC SYSTEMS, AND OTHER AREAS OUTSIDE THE CONSTRUCTION EASEMENTS THAT ARE DAMAGED BY THE CONTRACTOR SHALL BE RESTORED AT HIS EXPENSE TO A CONDITION EQUAL TO OR BETTER THAN EXISTING BEFORE DAMAGE OCCURRED.

27. ALL WORK SHALL BE CONFINED WITHIN THE EASEMENTS AND/OR GRADING LIMITS AS DIRECTED BY THE ENGINEER. ALL TEMPORARY CONSTRUCTION EASEMENTS SHALL BE STAKED BY THE CONTRACTOR PRIOR TO BEGINNING OF CONSTRUCTION. ALL GRADING LIMITS SHOWN ARE APPROXIMATE AND MAY BE EXTENDED OR REDUCED AT THE DIRECTION OF THE ENGINEER.

28. THE CONTRACTOR SHALL PROVIDE ADEQUATE SEDIMENT AND EROSION CONTROL TO PREVENT SEDIMENT AND/OR DEBRIS FROM ENTERING STREETS OPEN TO TRAFFIC THE COMPLETED STORM SEWER SYSTEM, OR YARDS OF ADJACENT RESIDENCES AND BUSINESSES.

29. ALL TEMPORARY TRAFFIC CONTROL SIGNS SHALL BE FABRICATED AND INSTALLED IN ACCORDANCE WITH THE LATEST M.U.T.C.D. THE TRAFFIC CONTROL PLANS SHOWN ARE MINIMUM REQUIREMENTS ONLY AND DO NOT ATTEMPT TO ADDRESS IN DEPTH THE VARIETY OF SITUATIONS THAT MAY OCCUR ONCE CONSTRUCTION BEGINS. THE REQUIREMENTS SHOWN IN NO WAY RELIEVE THE CONTRACTOR OF HIS RESPONSIBILITY FOR SELECTING & IMPLEMENTING THE PROPER DEVICES AND PROCEDURES THAT WILL ASSURE THE SAFETY OF MOTORISTS, PEDESTRIANS, & WORKERS AT ALL TIMES.

30. LABOR, TOOLS, MATERIALS, AND EQUIPMENT REQUIRED FOR TEMPORARY CONNECTIONS TO MAINTAIN POSITIVE DRAINAGE DURING CONSTRUCTION SHALL BE SUBSIDIARY TO OTHER PAY ITEMS.

31. REMOVAL OF EXISTING STRUCTURES SHALL INCLUDE, BUT NOT BE LIMITED TO, THE ITEMS NOTED IN THE PLANS AND IN THE SUMMARY OF QUANTITIES. WORK SHALL BE PAID FOR UNDER BID ITEM "REMOVAL OF EXISTING STRUCTURES". CONTRACTOR WILL DISPOSE OF EXISTING STRUCTURES AT HIS EXPENSE.

32. THE CONTRACTOR WILL BE RESPONSIBLE FOR SUPPORTING AND PROTECTING ALL EXPOSED UTILITIES IN OPEN TRENCHES. WORK SHALL BE SUBSIDIARY TO OTHER PAY ITEMS.

33. CONTRACTOR SHALL FIELD VERIFY THE LOCATION OF THE EXISTING STORM SEWER PIPES AND ADJUST THE PROPOSED FLOWLINE ELEVATIONS, PIPE LENGTHS, AND STRUCTURES AS EACH SECTION OF THE EXISTING DRAINAGE STRUCTURE IS REMOVED AND UNCOVERED.

34. EXCESS MATERIAL SHALL BE THE RESPONSIBILITY OF THE CONTRACTOR FOR DISPOSAL.

35. THE CONTRACTOR SHALL BE RESPONSIBLE FOR SITE SAFETY AT ALL TIMES.

36. CONTRACTOR RESPONSIBLE FOR CONSTRUCTION OF ALL ADA-ACCESSIBLE RAMPS, AS WELL AS ANY SIDEWALK ADJACENT TO TRACTS OR UNPLATTED LAND, AT THE TIME OF INFRASTRUCTURE IMPROVEMENTS.

AS-BUILT

The information provided on this drawing conforms to construction records; it is not intended for construction, implementation or recording purposes; and it is solely based on information provided by others, obtained by my firm). ~~100.00~~ 100.10", ~~1.00%~~ 1.15% slope", or "8-inch ~~UPPE~~ PVC pipe" are all typical examples of revisions that indicate that design data has been replaced with "as-built" information. All other data is as designed and has not been field verified.

Date: 03/24/2022
Certified by: GRC
Title: Project Engineer Firm: Anderson Engineering Inc.

RELEASE FOR
CONSTRUCTION
AS NOTED ON PLANS REVIEW
DEVELOPMENT SERVICES
LEE'S SUMMIT, MISSOURI

04/16/2021

REVISIONS		DRAWING INFO.	
NO.	DESCRIPTION	BY	DATE
1	REVISED PER CITY COMMENT	GC	2/11/21
		CHECK BY:	ZM
		LICENSE NO.	PE-2012009232
		DATE:	1/7/2021
		ISSUED FOR:	FOR REVIEW
2	AS-BUILT DRAWINGS	JOB NUMBER:	20KCT0005
		MO COA NO.	00062

© COPYRIGHT ANDERSON ENGINEERING, INC. 2020

SUMMIT HOMES KC
HIGHLAND MEADOWS - 6TH PLAT

GENERAL NOTES




SHEET NUMBER
C050
2 OF 42

ANDERSON
ENGINEERING
EMPLOYEE OWNED

ENGINEERS • SURVEYORS • LABORATORIES • DRILLING
941 W. 141ST TER • KANSAS CITY, MISSOURI 64145 • PHONE (816) 777-0400
A LICENSED MISSOURI ENGINEERING & SURVEYING CORPORATION - LC 62

S10, T47N, R2W
LEE'S SUMMIT, JACKSON COUNTY, MISSOURI

Feb 11, 2021 - 6:01pm Plotted By: gcale G:\Shared drives\K1010 - Land Development\Projects\102010\20K10005 Highland Meadows - 6th Plat\01 CIVIL\03-DWG\Sheet\STREET AND STORM\20K10005 - SHY - TYPICAL SECTION.dwg Layout: TYPICAL SECTIONS

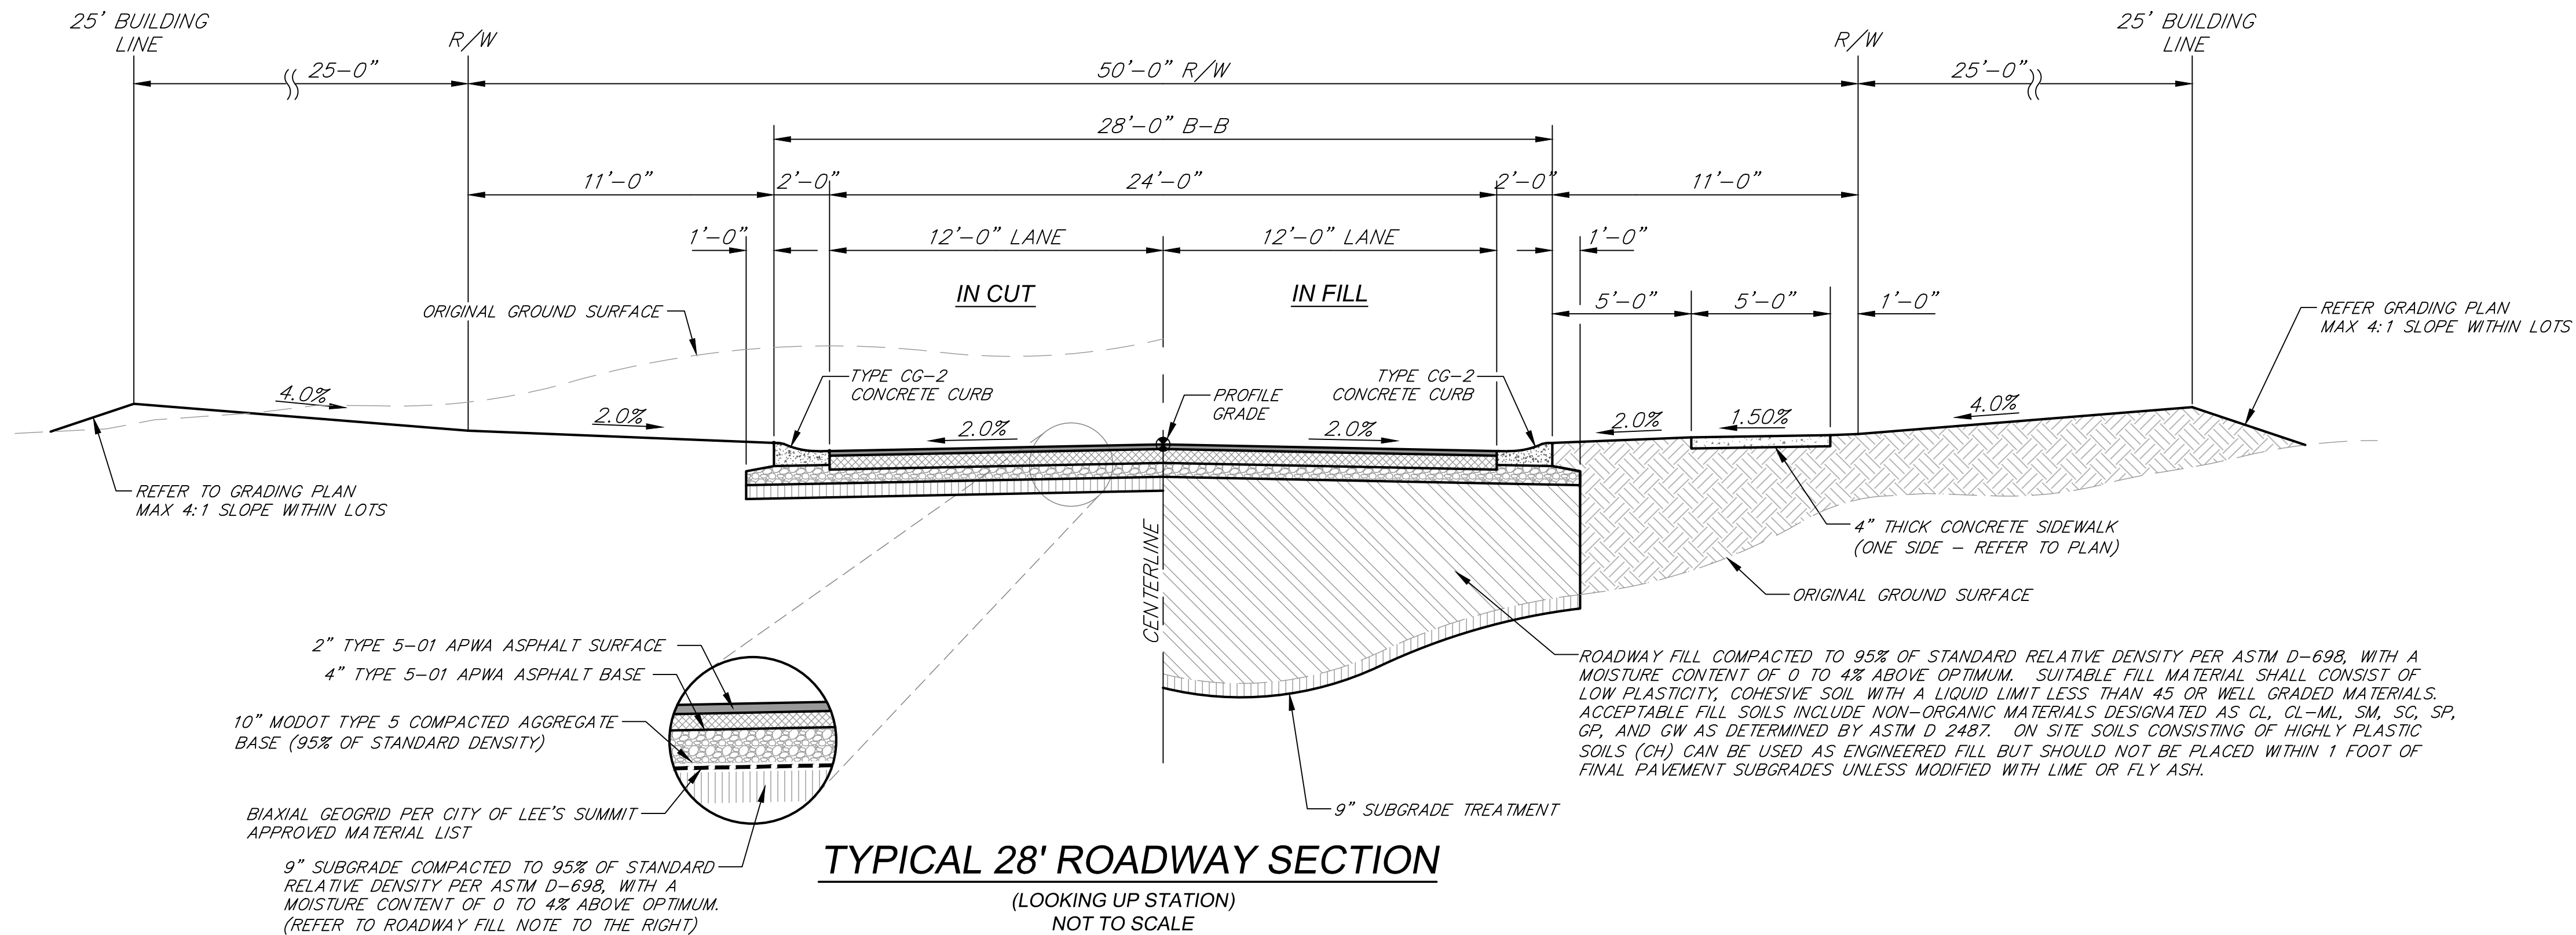


AS-BUILT

The information provided on this drawing conforms to construction records; it is not intended for construction, implementation or recording purposes; and it is solely based on information (provided by others / obtained by my firm) that indicates that design data has been replaced with "as-built" information. All other data is as designed and has not been field verified.

Date: 03/24/2022
Title: Project Engineer

Certified by: GRC
Firm: Anderson Engineering Inc.

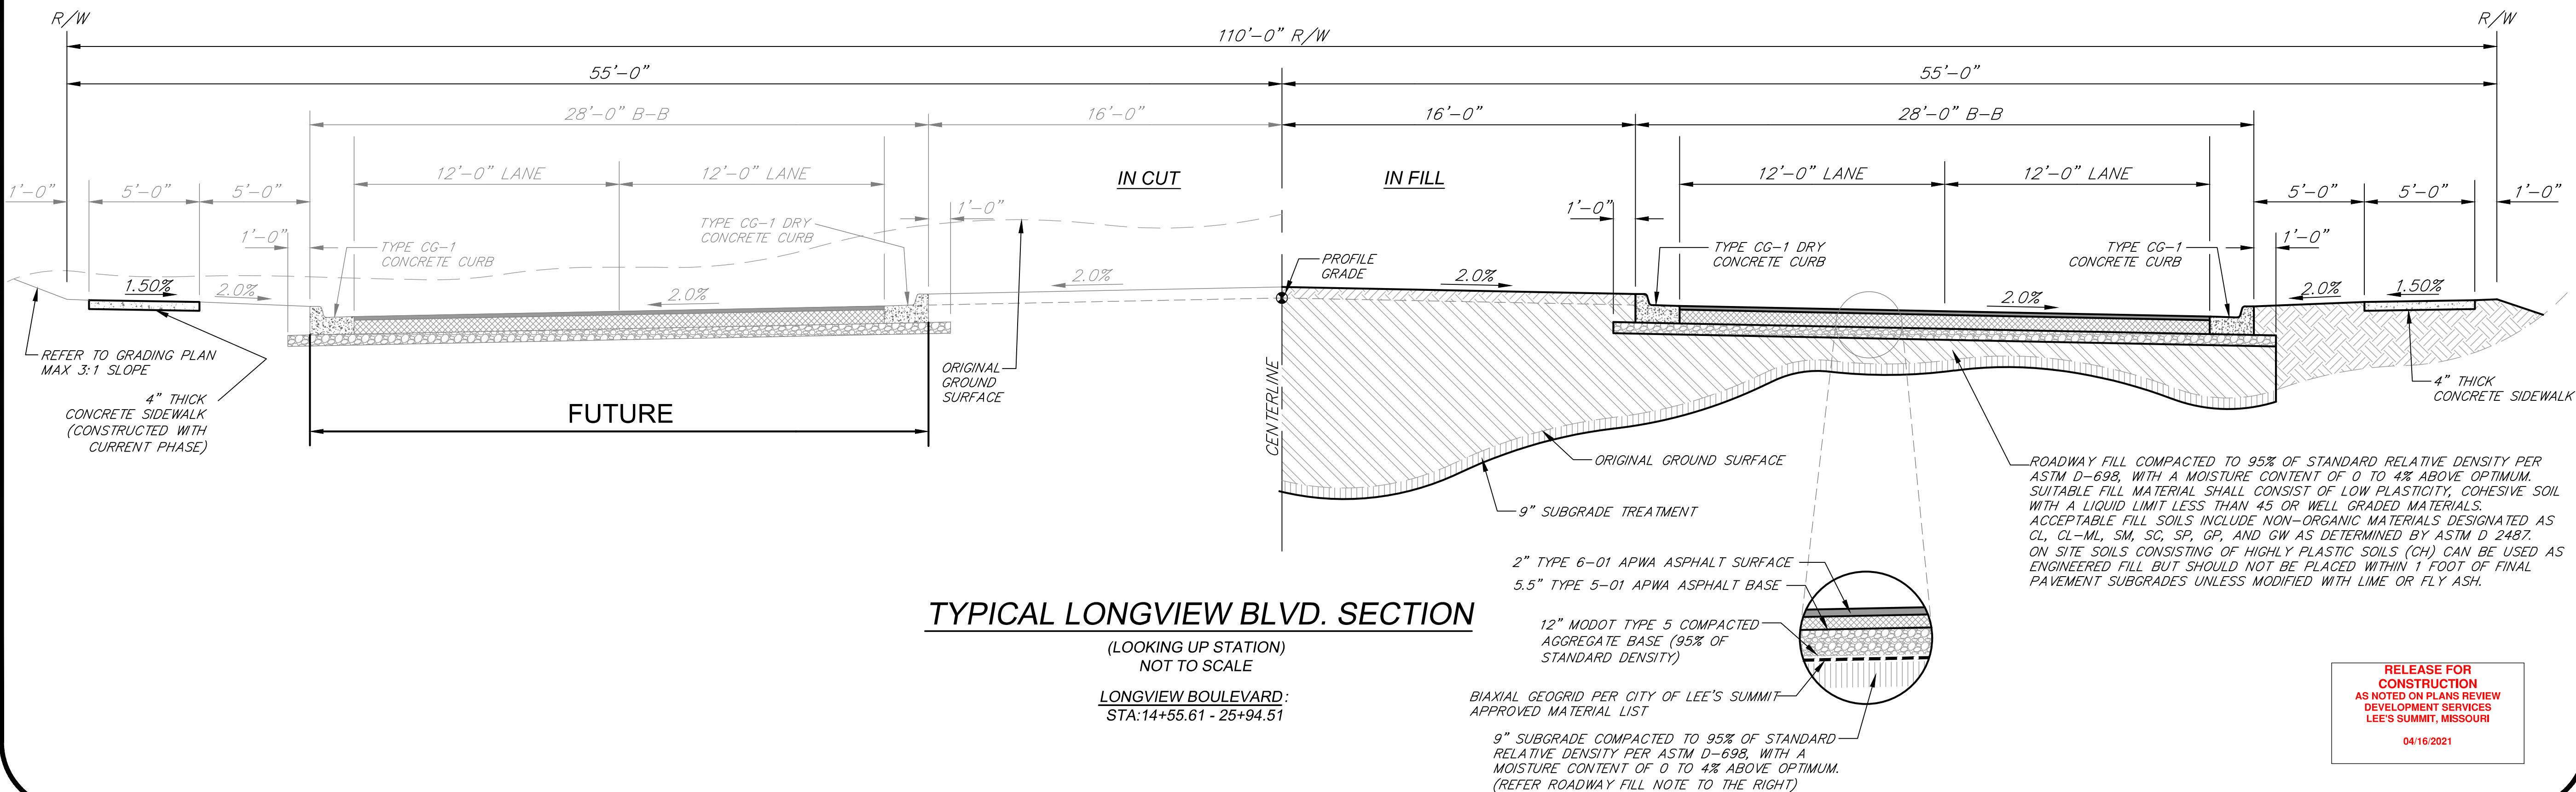

ANDERSON ENGINEERING
EMPLOYEE OWNED

AE

ENGINEERS • SURVEYORS • LABORATORIES • DRILLING
941 W. 141ST TER. • KANSAS CITY, MISSOURI 64145 • PHONE (816) 777-0400
A LICENSED MISSOURI ENGINEERING & SURVEYING CORPORATION - LC 62

DRAWING INFO.		REVISIONS		BY		DATE		DRAWN BY:		CHECK BY:		LICENSE NO.		DATE:		ISSUED FOR:		JOB NUMBER:		MO COA NO.	
NO.	DESCRIPTION	NO.	DESCRIPTION	BY	DATE	BY	DATE	GC	ZM	GC	ZM	GC	ZM	GC	ZM	GC	ZM	GC	ZM	GC	ZM
1	REVISED PER CITY COMMENT	1	REVISED PER CITY COMMENT	GC	2/11/21	GC	2/11/21	GC	2/11/21	GC	2/11/21	GC	2/11/21	GC	2/11/21	GC	2/11/21	GC	2/11/21	GC	2/11/21
2	AS-BUILT DRAWINGS	2	AS-BUILT DRAWINGS	GC	3/16/22	GC	3/16/22	GC	3/16/22	GC	3/16/22	GC	3/16/22	GC	3/16/22	GC	3/16/22	GC	3/16/22	GC	3/16/22

© COPYRIGHT ANDERSON ENGINEERING, INC. 2020


SUMMIT HOMES KC
HIGHLAND MEADOWS - 6TH PLAT

TYPICAL SECTIONS

STATE OF MISSOURI
ZACH A. MYERS
PROFESSIONAL ENGINEER
NUMBER
PE-2012009232
03/14/21

SHEET NUMBER
C101
3 OF 42

Feb 11, 2021 - 6:01pm Plotted By: gac G:\Shared drives\K1010 - Land Development\Projects\2020\20K10058 Highland Meadows - 6th Plat\01 CIVIL\03-DWG\Sheet\STREET AND STORM\20K10058 - SHY - GENERAL LAYOUT.dwg Layout: GENERAL LAYOUT

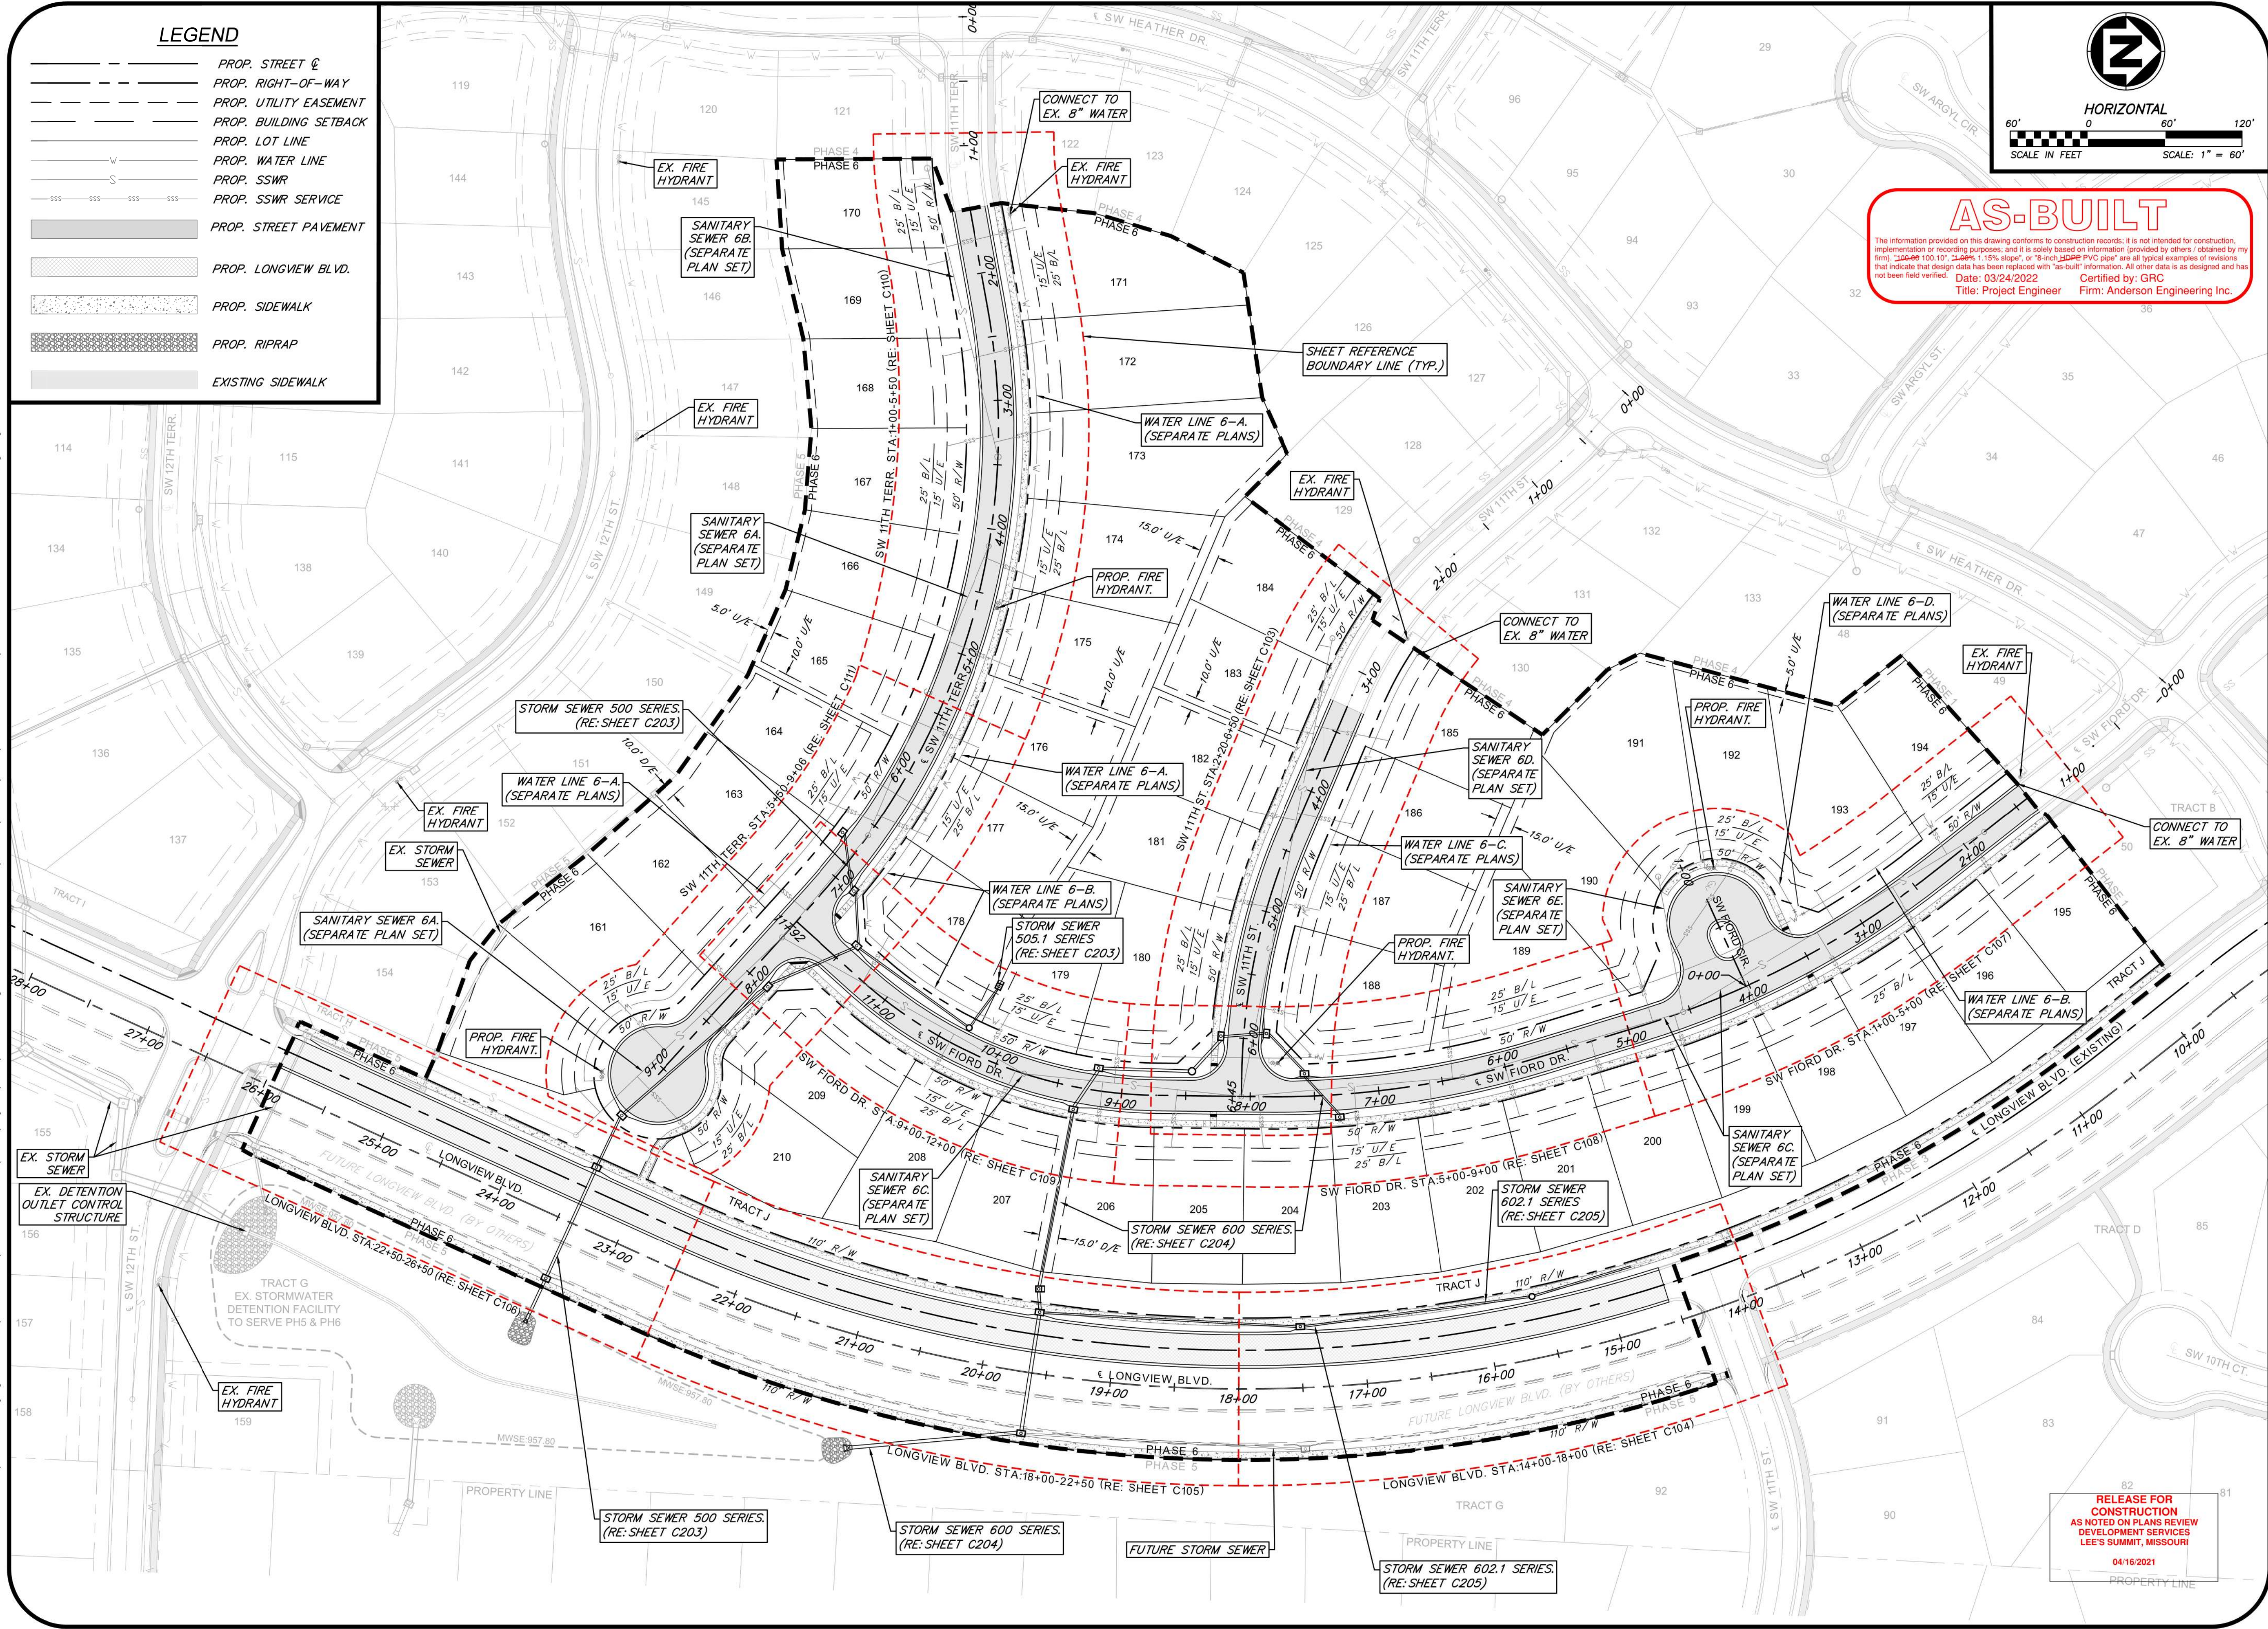



SUMMIT HOMES KC
HIGHLAND MEADOWS - 6TH PLAT

GENERAL LAYOUT

S10, T47N, R32W
LEE'S SUMMIT, JACKSON COUNTY, MISSOURI



SHEET NUMBER
C102
4 OF 42

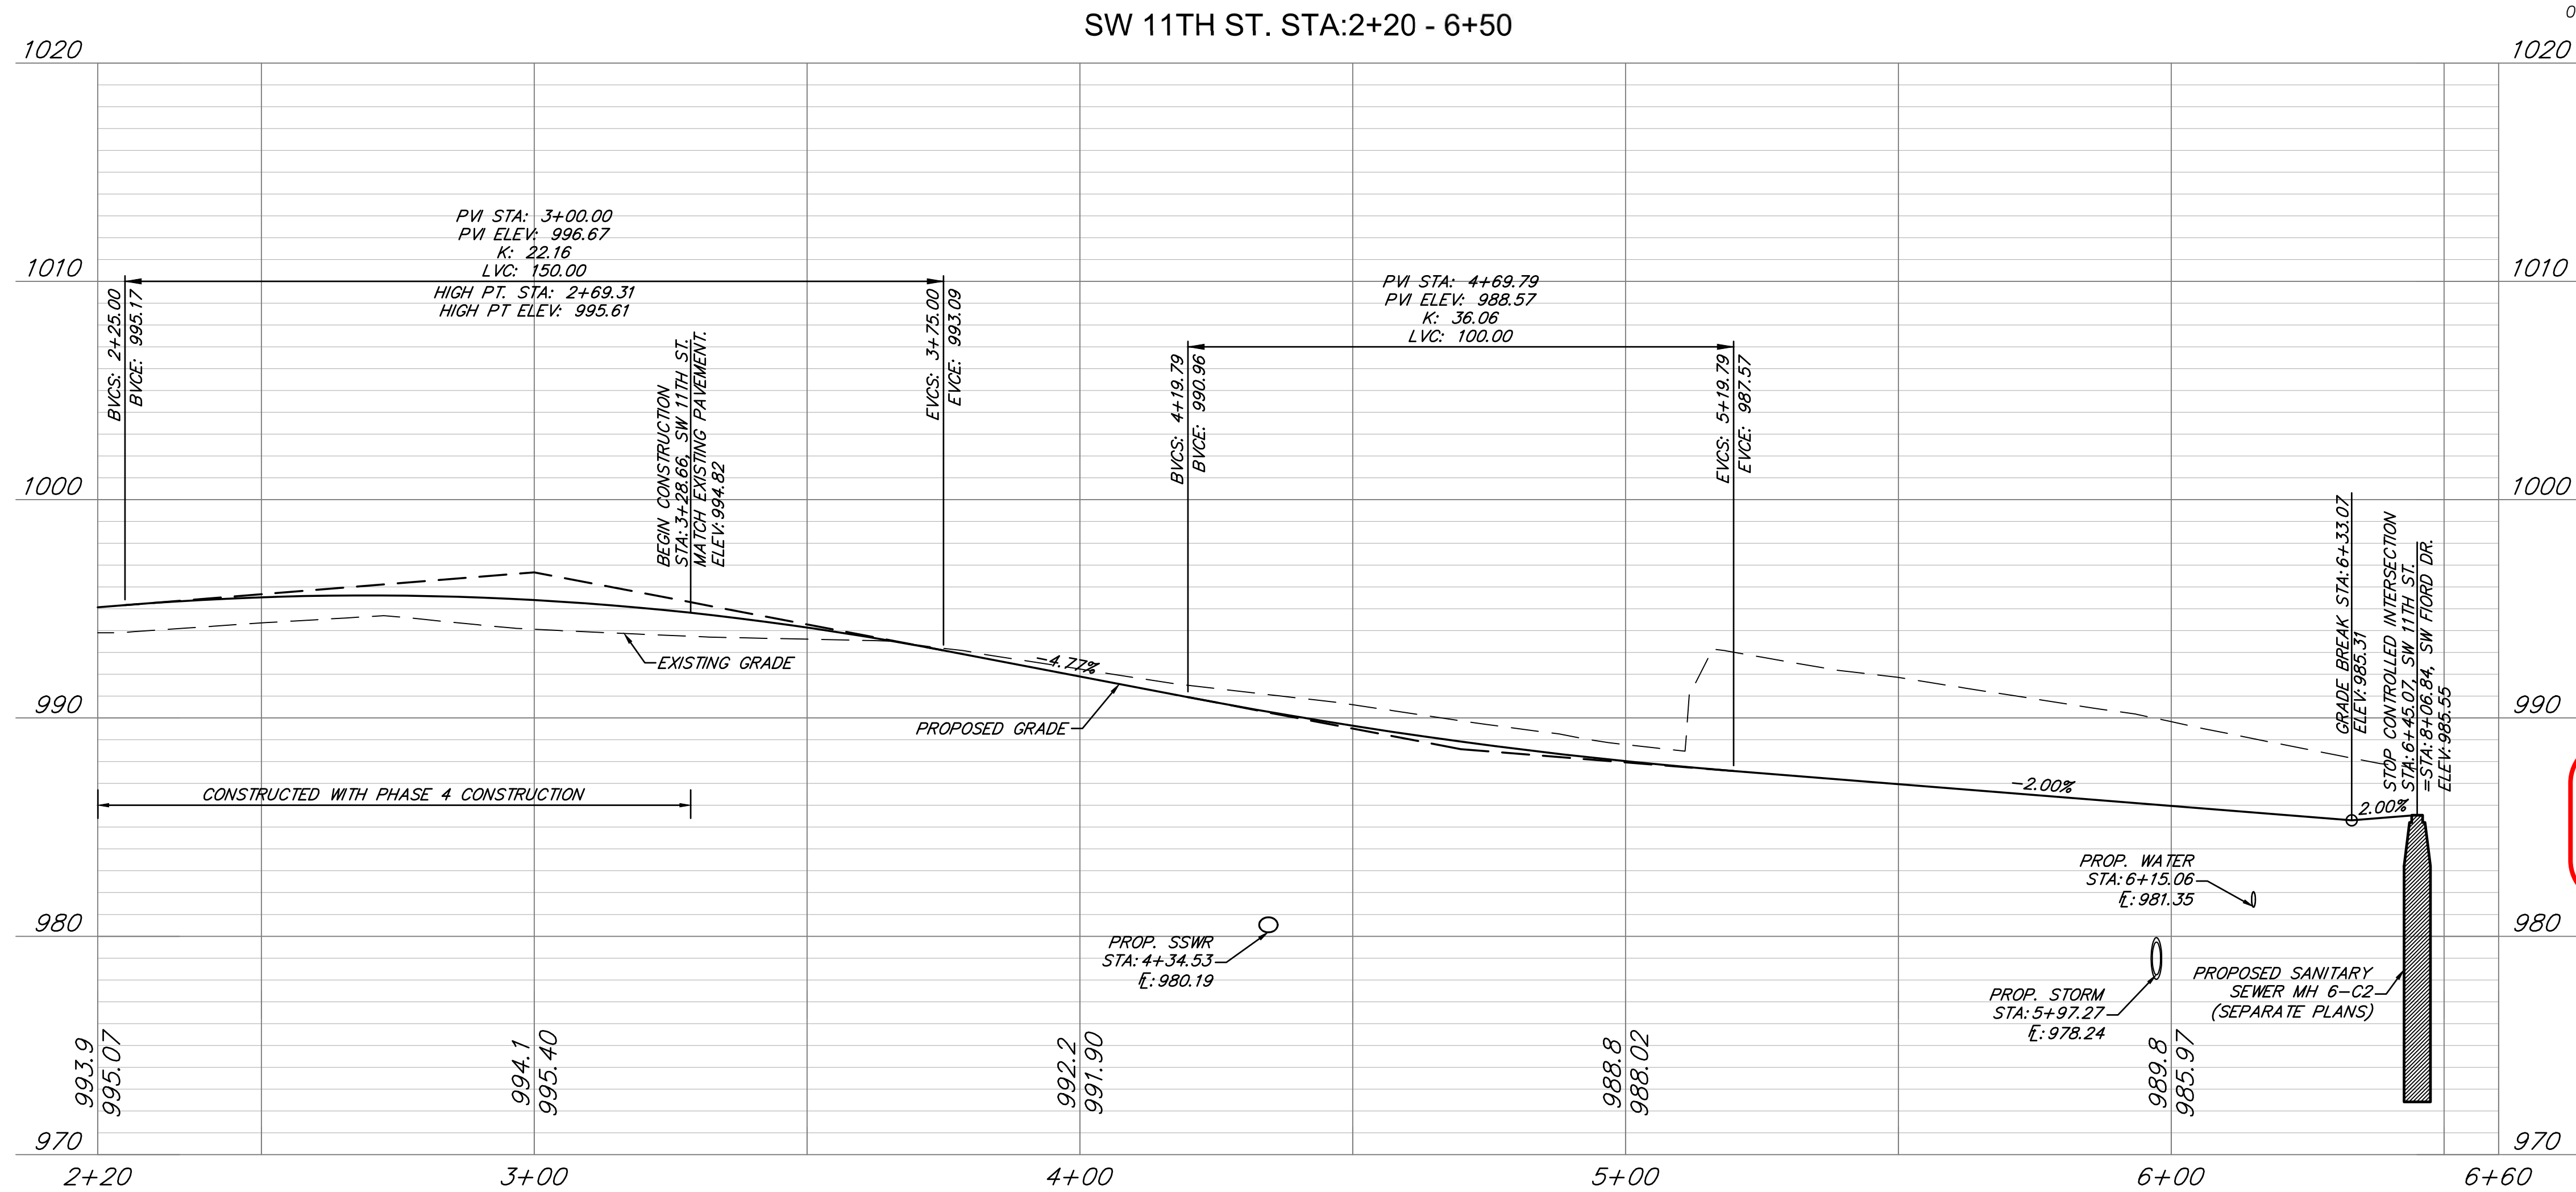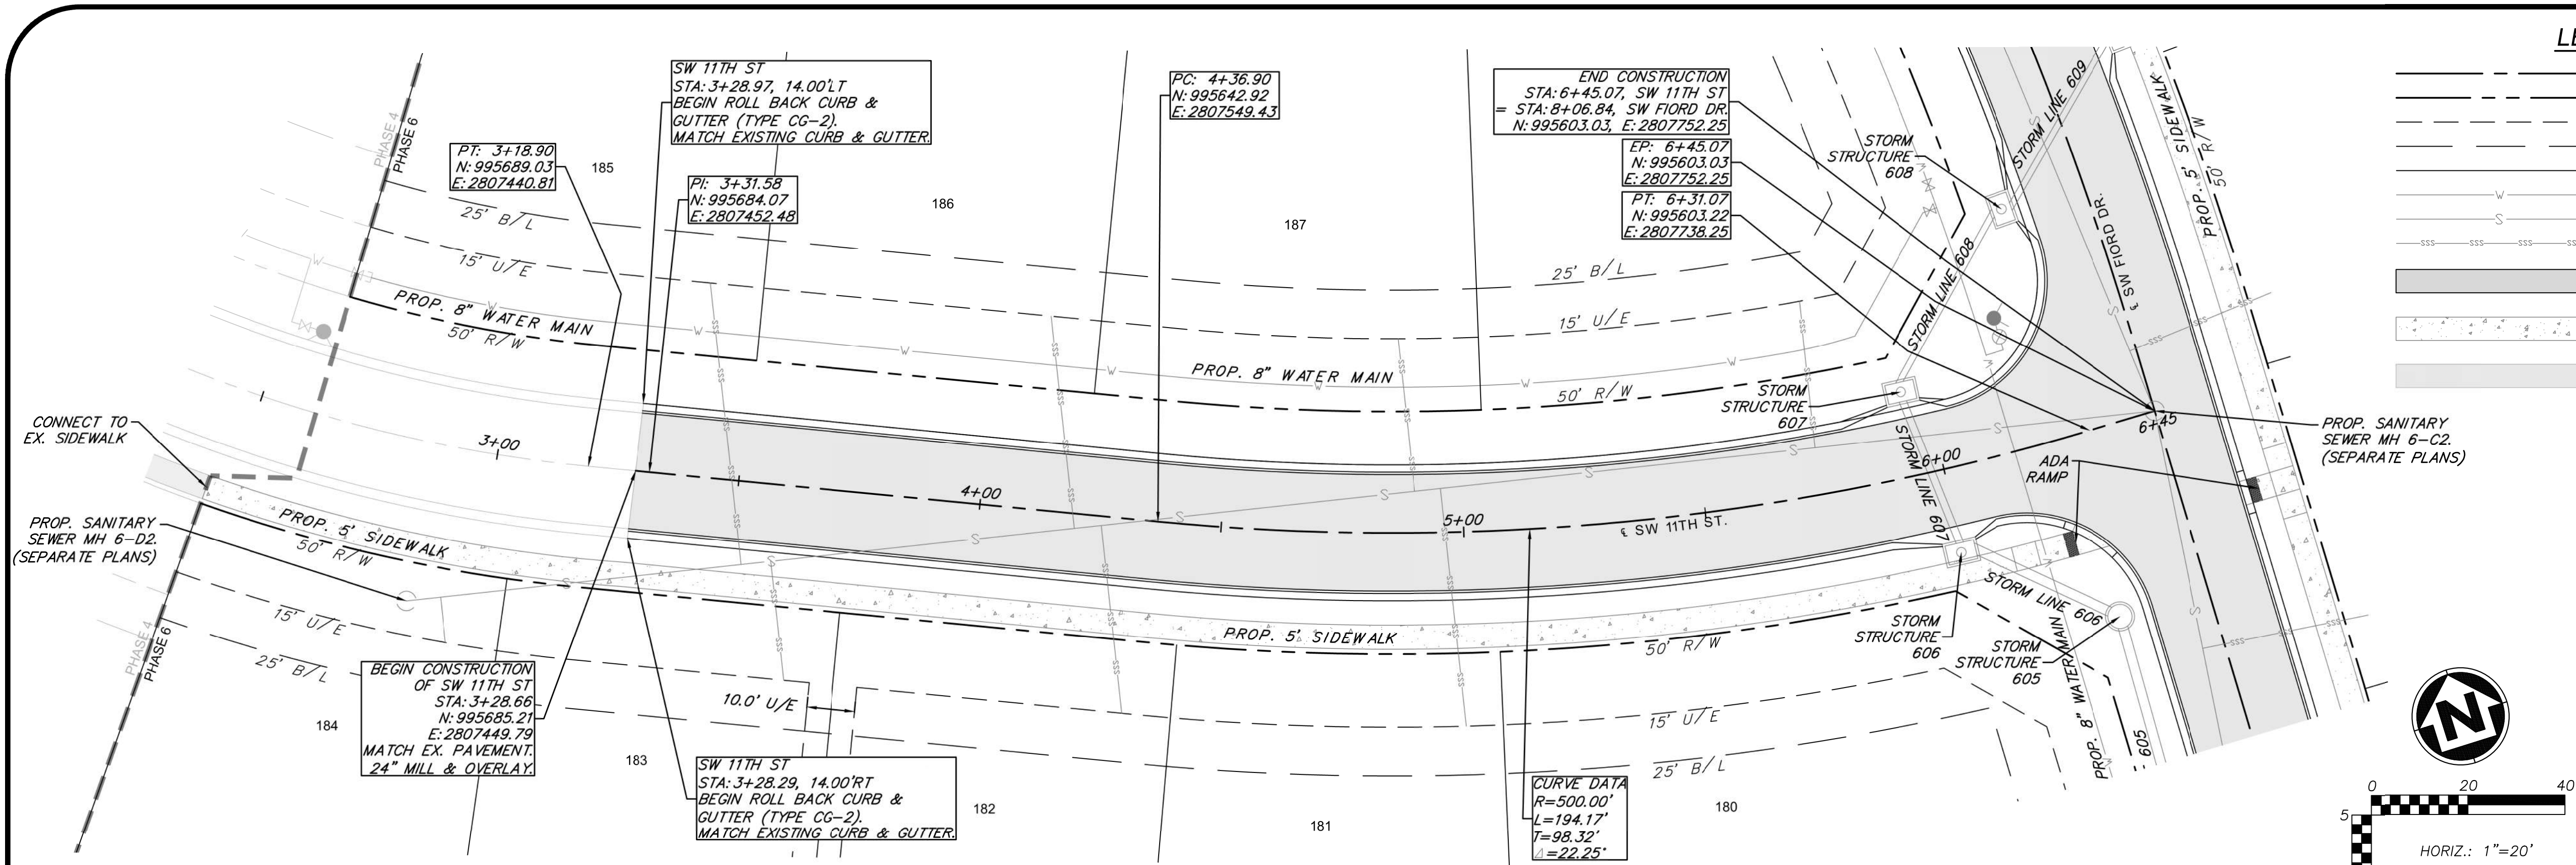

AS-BUILT

The information provided on this drawing conforms to construction records; it is not intended for construction, implementation or recording purposes; and it is solely based on information (provided by others / obtained by my firm) ~~100% 100 100, 110% 1.15% slope, or 8-inch 110% PVC pipe~~ are all typical examples of revisions that indicate that design data has been replaced with "as-built" information. All other data is as designed and has not been field verified.

Date: 03/24/2022 Certified by: GRC
 Title: Project Engineer Firm: Anderson Engineering Inc.

**RELEASE FOR
CONSTRUCTION
AS NOTED ON PLANS REVIEW
DEVELOPMENT SERVICES
LEE'S SUMMIT, MISSOURI
04/16/2021**

REVISIONS				DRAWING INFO.			
NO.	DESCRIPTION	BY	DATE	DRAWN BY:		CHECK BY:	
1	REVISED PER CITY COMMENT	GC	2/11/21	GC		ZM	
				LICENSE NO.		PE-2012006232	
				DATE:		1/7/2021	
2	AS-BUILT DRAWINGS	GC	3/16/22	ISSUED FOR:		FOR REVIEW	
				JOB NUMBER:		20KC10058	
© COPYRIGHT ANDERSON ENGINEERING, INC. 2020				MO COA NO. 000062			

SUMMIT HOMES KC
HIGHLAND MEADOWS - 6TH PLAT

SW 11TH ST. STA. 2+20-6+50
PLAN & PROFILE

S10, T47N, R32W

LEE'S SUMMIT, JACKSON COUNTY, MISSOURI




SHEET NUMBER
C103
5 OF 42



**ANDERSON
ENGINEERING**
EMPLOYEE OWNED

ENGINEERS • SURVEYORS • LABORATORIES • DRILLING
941 W. 141ST TER. • KANSAS CITY, MISSOURI 64145 • PHONE (816) 777-0400
A LICENSED MISSOURI ENGINEERING & SURVEYING CORPORATION - LC 62

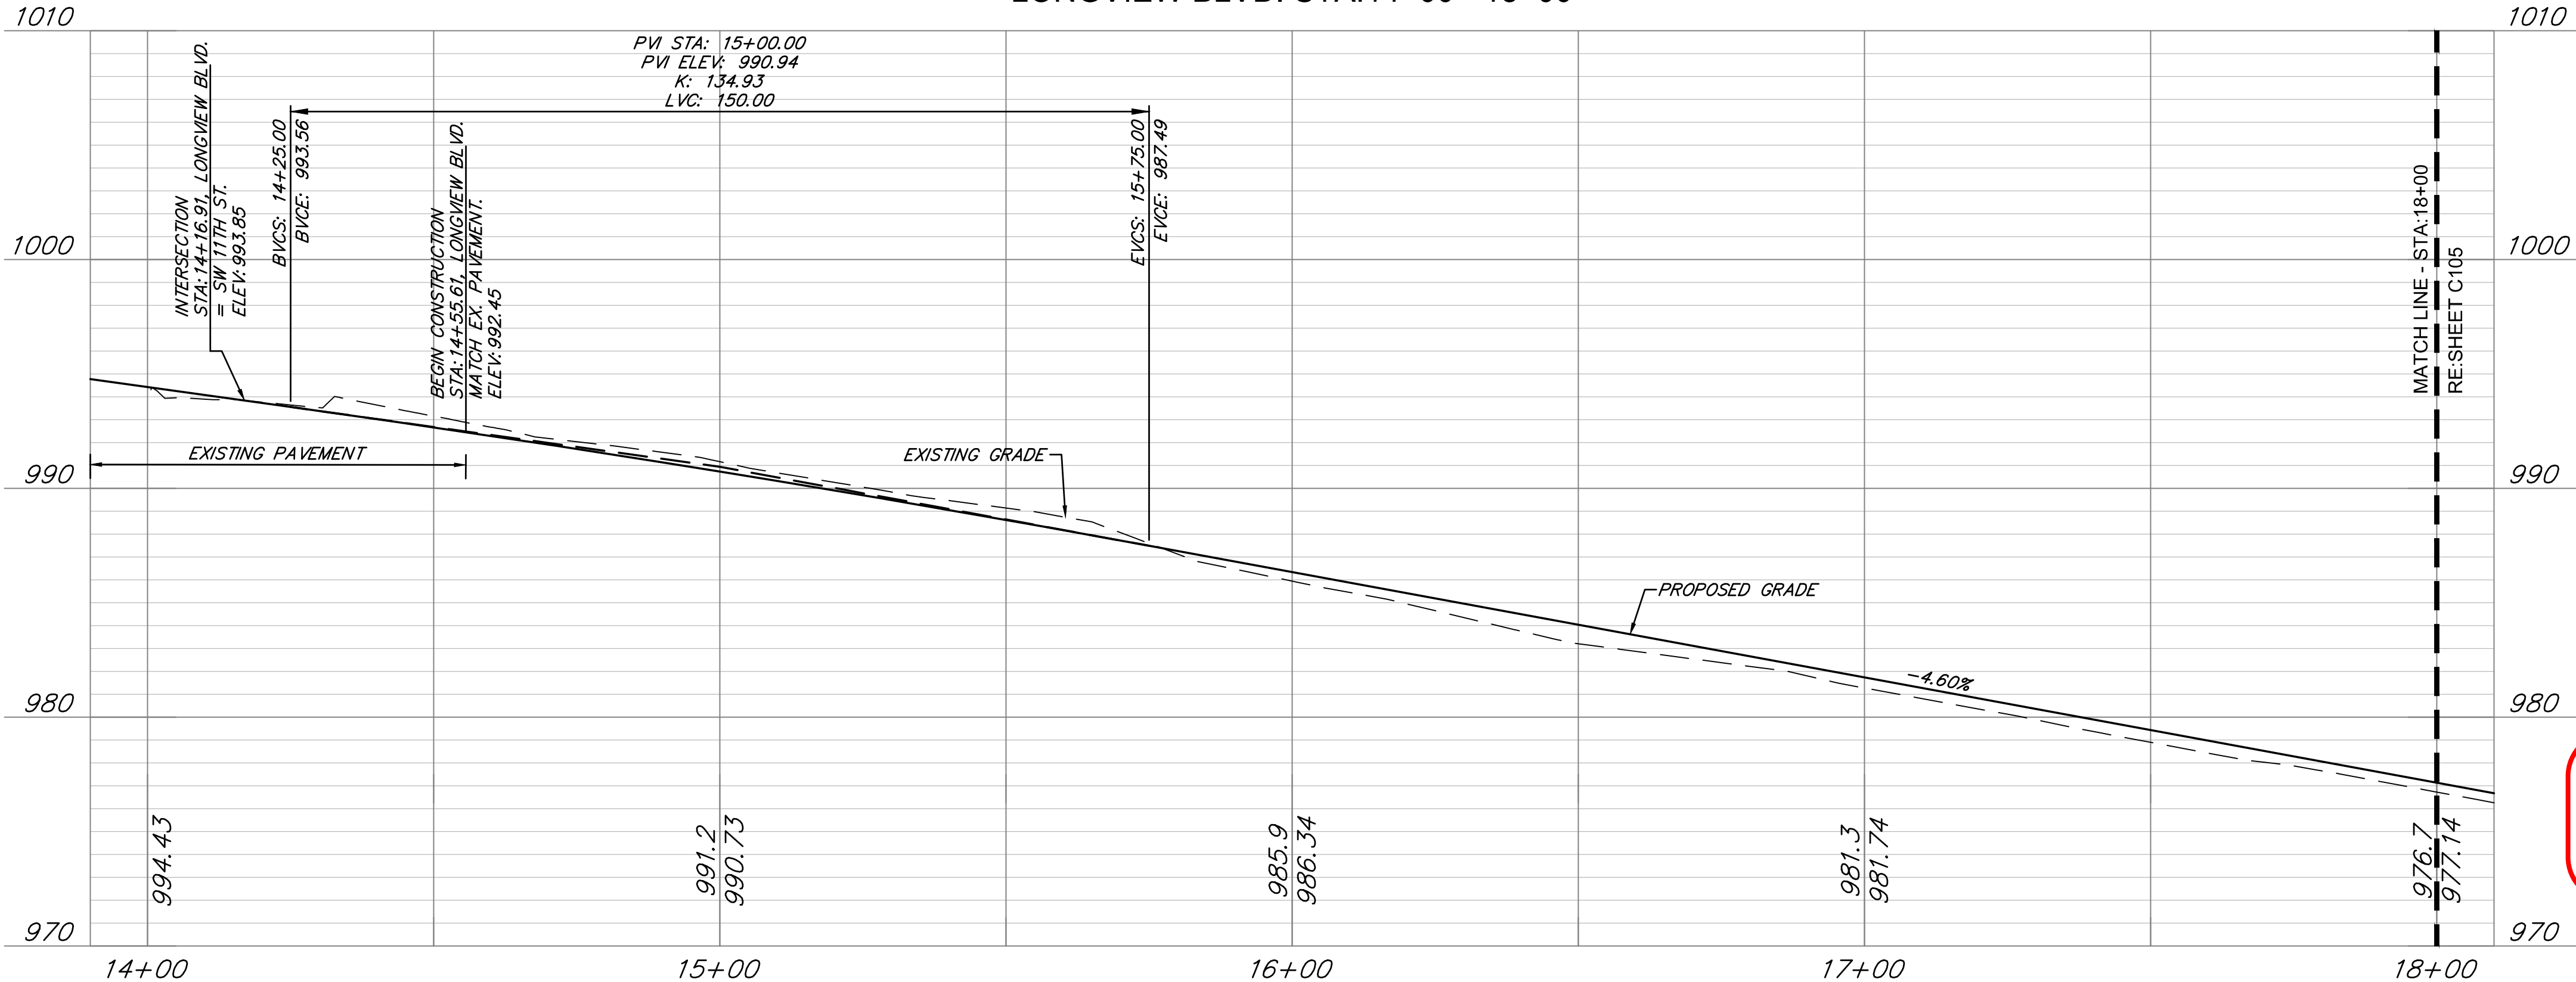

AS-BUILT

The information provided on this drawing conforms to construction records; it is not intended for construction, implementation or recording purposes; and it is solely based on information provided by others / obtained by n firm). ~~100.00~~ 100.10", ~~1.00%~~ 1.15% slope", or "8-inch ~~HDPE~~ PVC pipe" are all typical examples of revisions that indicate that design data has been replaced with "as-built" information. All other data is as designed and has not been field verified.

Date: 03/24/2022 Certified by: GRC
 Title: Project Engineer Firm: Anderson Engineering Inc.

**RELEASE FOR
CONSTRUCTION
AS NOTED ON PLANS REVIEW
DEVELOPMENT SERVICES
LEE'S SUMMIT, MISSOURI**

04/16/2021

SUMMIT HOMES KC
HIGHLAND MEADOWS - 6TH PLAT


LONGVIEW BLVD.

S10. T47N. R32W

LEE'S SUMMIT JACKSON COUNTY MISSOURI




SHEET NUMBER
C104
6 OF 42

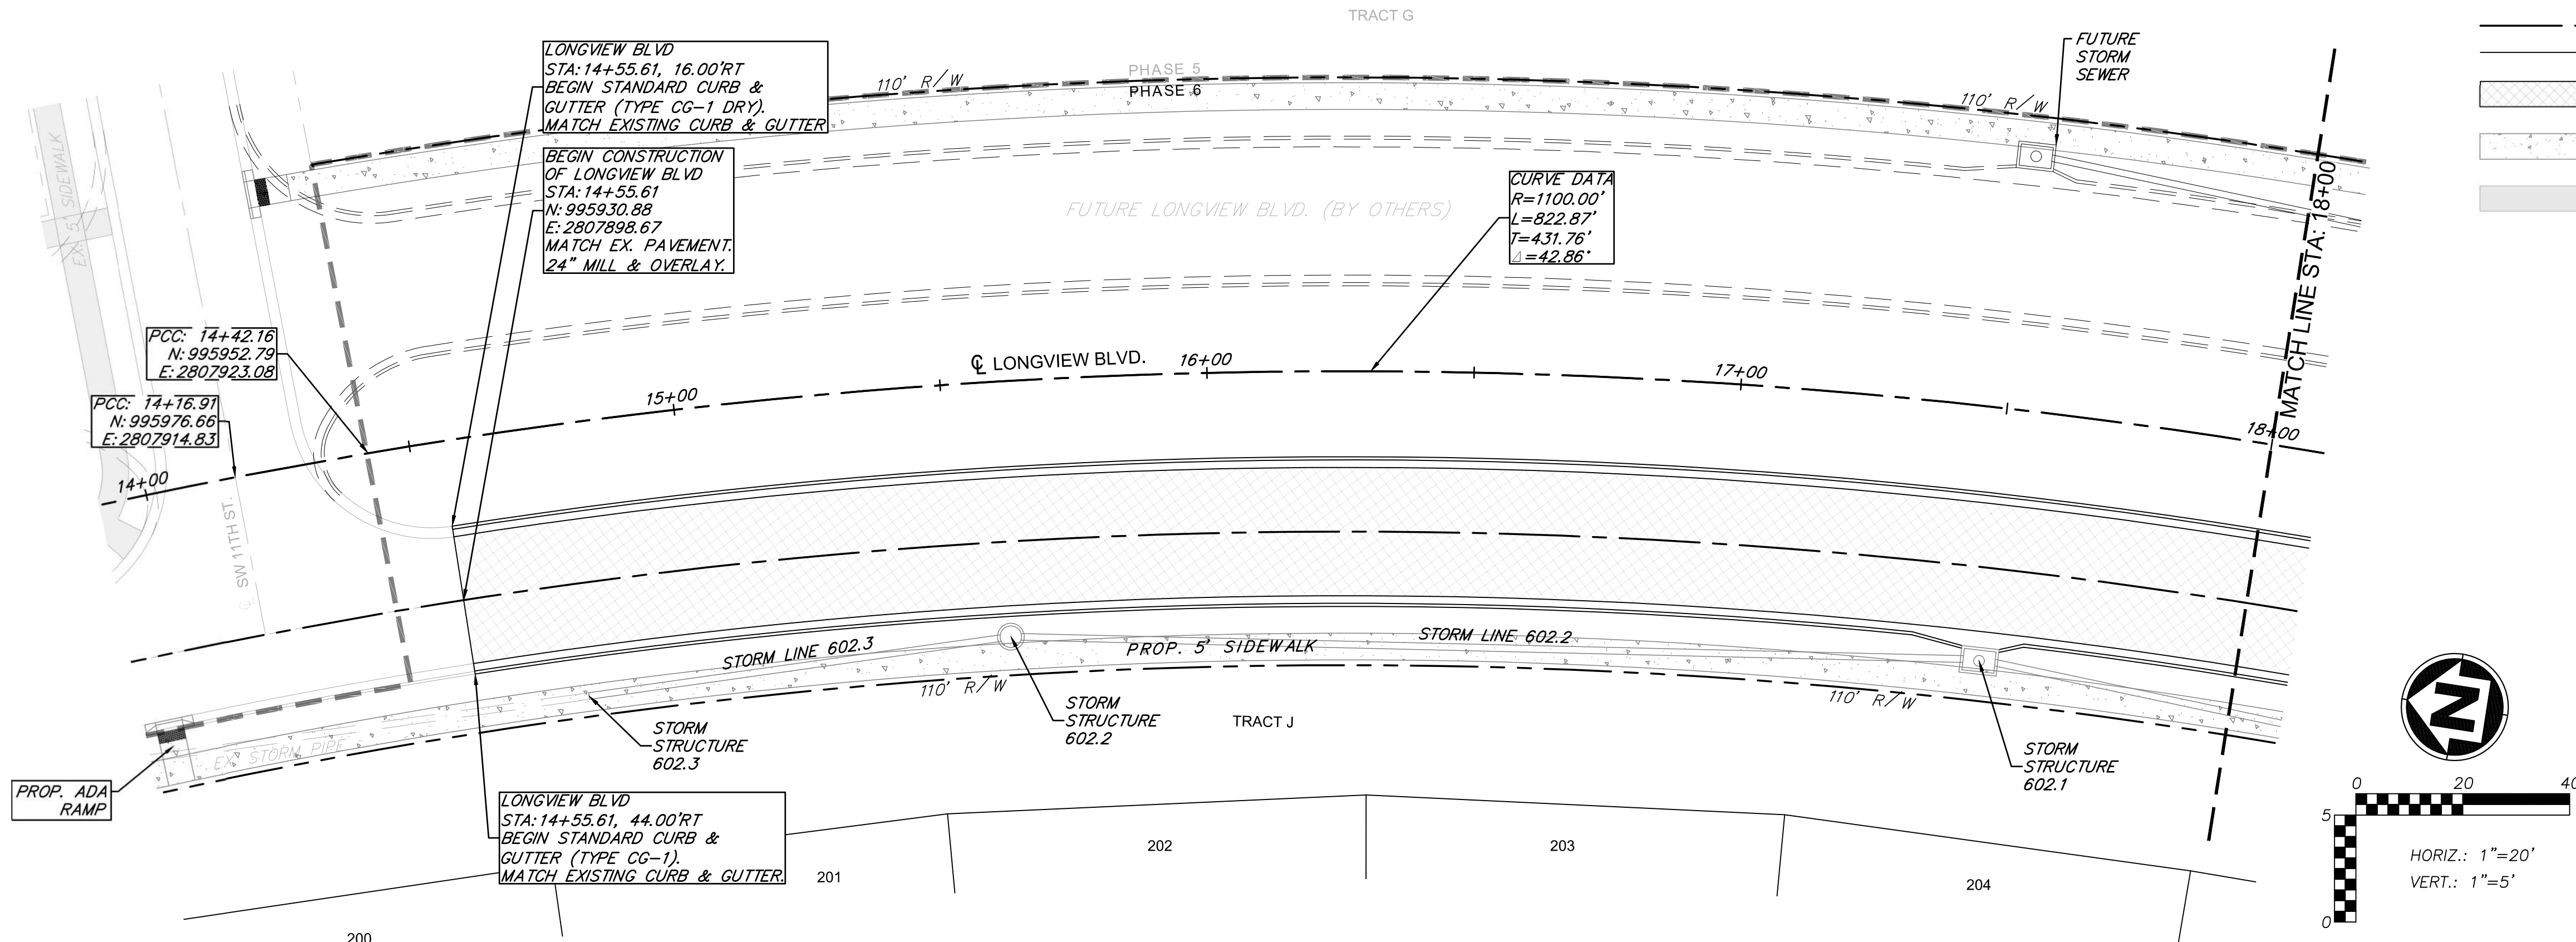

REVISIONS			DRAWING INFO.		
NO.	DESCRIPTION	BY	DATE	DRAWN BY:	
1	REVISED PER CITY COMMENT	GC	2/11/21	CHECK BY:	ZM
				LICENSE NO.	PE-2012006232
				DATE:	1/7/2021
2	AS-BUILT DRAWINGS	GC	3/16/22	ISSUED FOR:	FOR REVIEW
				JOB NUMBER:	20KC10558
© COPYRIGHT ANDERSON ENGINEERING, INC. 2020				MO COA NO.	000062


© COPYRIGHT ANDERSON ENGINEERING INC 2020

Feb 11, 2021 -- 6:03pm Plotted By: gscate G:\Shared drives\KCTO - Land Development\Projects\2020\20KCI0058 Highland Meadows - 6th Plat\01 CIVIL\03-DWG\Sheet\STREET AND STORM P&P.dwg Layout: LONGVIEW BLVD. STA. 18+00 - 22+50

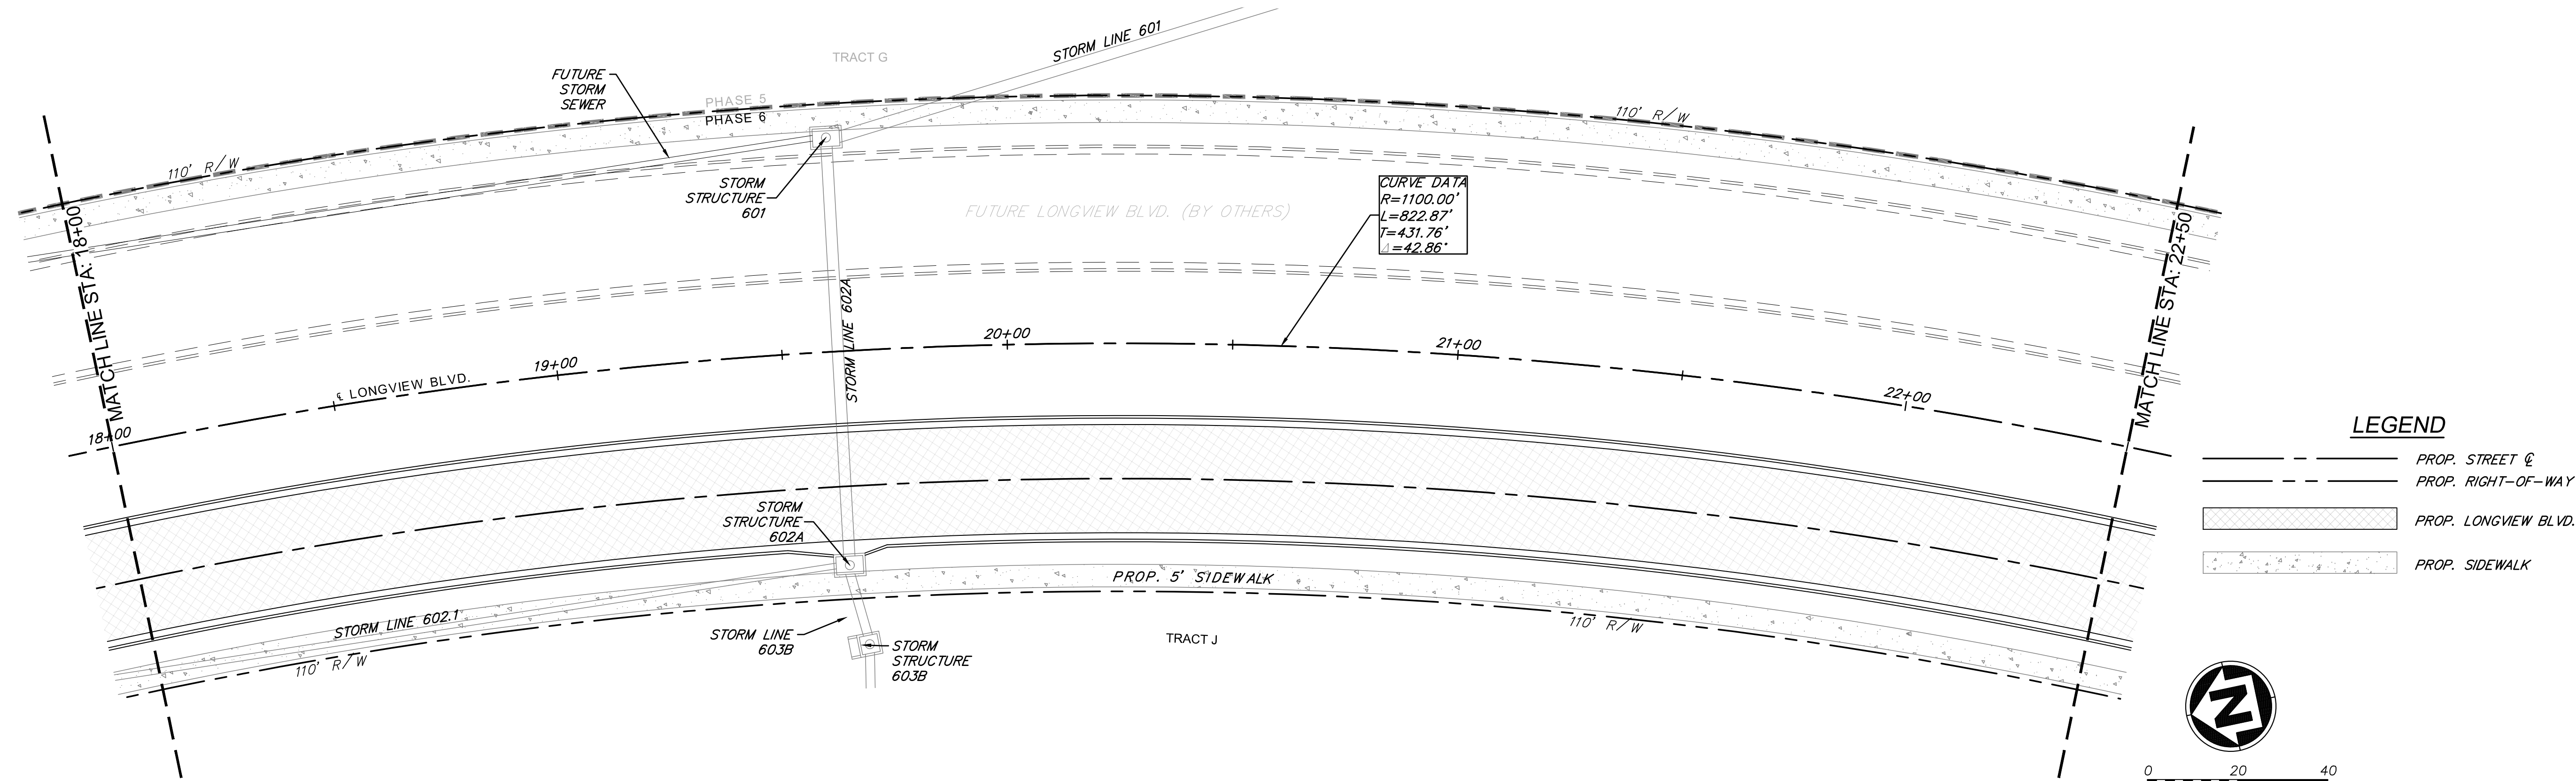

LEGEND

- PROP. STREET C
- PROP. RIGHT-OF-WAY
- PROP. LONGVIEW BLVD.
- PROP. SIDEWALK

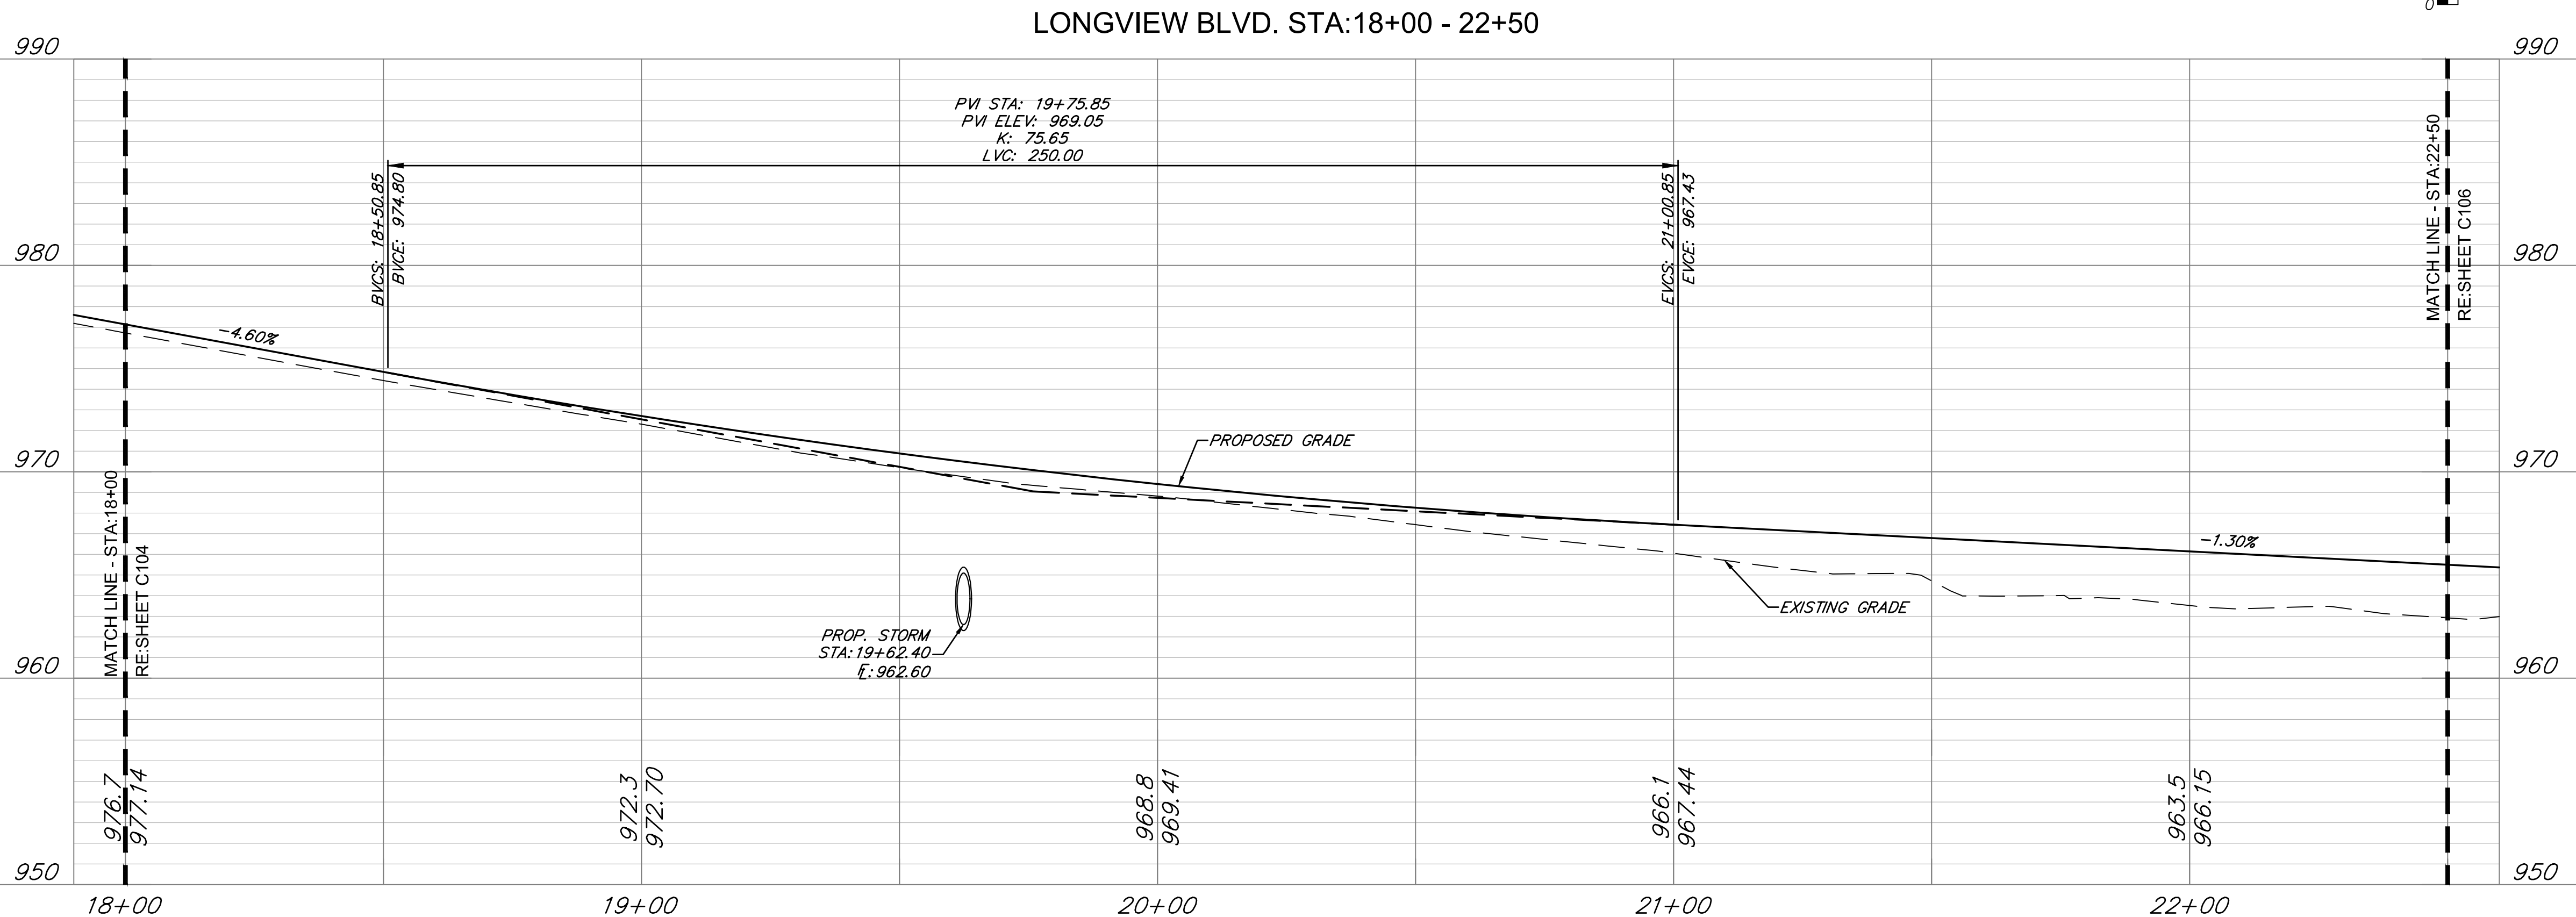

AS-BUILT

This information provided on this drawing conforms to construction records; it is not intended for construction. Any use of this information for construction purposes is at the user's risk. The user shall verify all dimensions and elevations before construction. The user shall indicate the design data has been replaced with "as-built" information. All other data is as designed and has not been field verified.

Date: 03/24/2022 Certified by: GRC Title: Project Engineer Firm: Anderson Engineering Inc.

RELEASE FOR
CONSTRUCTION
AS NOTED ON PLANS REVIEW
DEVELOPMENT SERVICES
LEE'S SUMMIT, MISSOURI

04/16/2021

REVISIONS		DRAWING INFO.	
NO.	DESCRIPTION	BY	DATE
1	REVISED PER CITY COMMENT	GC	2/11/21
2	AS-BUILT DRAWINGS	GC	3/16/22
		CHECK BY:	ZM
		LICENSE NO.	PE-2012009232
		DATE:	1/7/2021
		ISSUED FOR:	FOR REVIEW
		JOB NUMBER:	20KCI0058
		MO COA NO.	000062

SUMMIT HOMES KC
HIGHLAND MEADOWS - 6TH PLAT

LONGVIEW BLVD. STA. 18+00-22+50
PLAN & PROFILE



S10, T47N, R32W
LEE'S SUMMIT, JACKSON COUNTY, MISSOURI



SHEET NUMBER
C105
7 OF 42

ANDERSON ENGINEERING
EMPLOYEE OWNED

ENGINEERS • SURVEYORS • LABORATORIES • DRILLING
941 W. 141ST TER. • KANSAS CITY, MISSOURI 64145 • PHONE (816) 777-0400
A LICENSED MISSOURI ENGINEERING & SURVEYING CORPORATION - LC 62

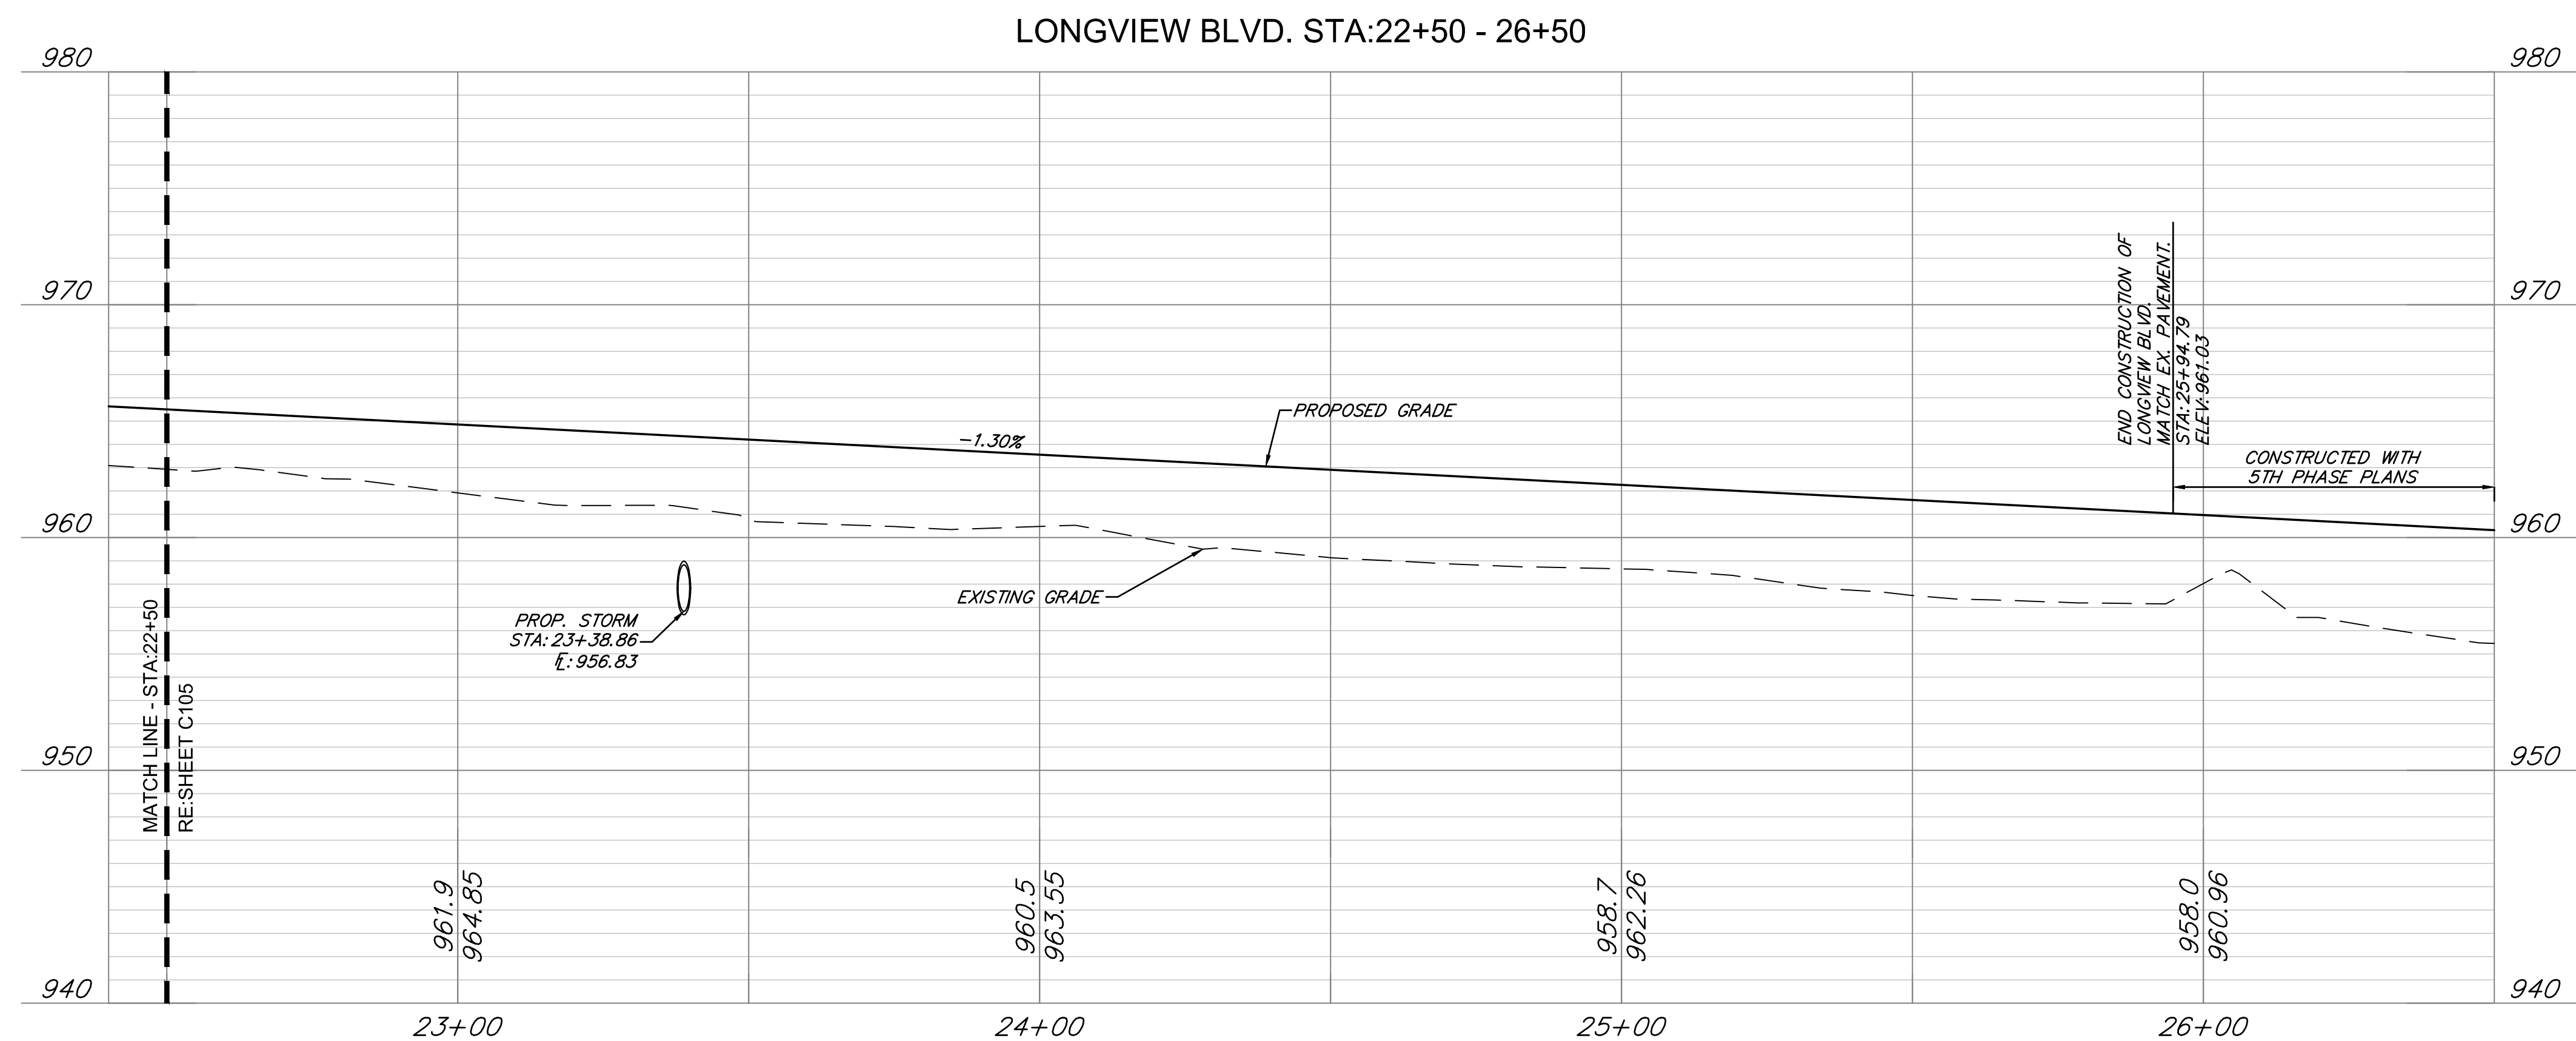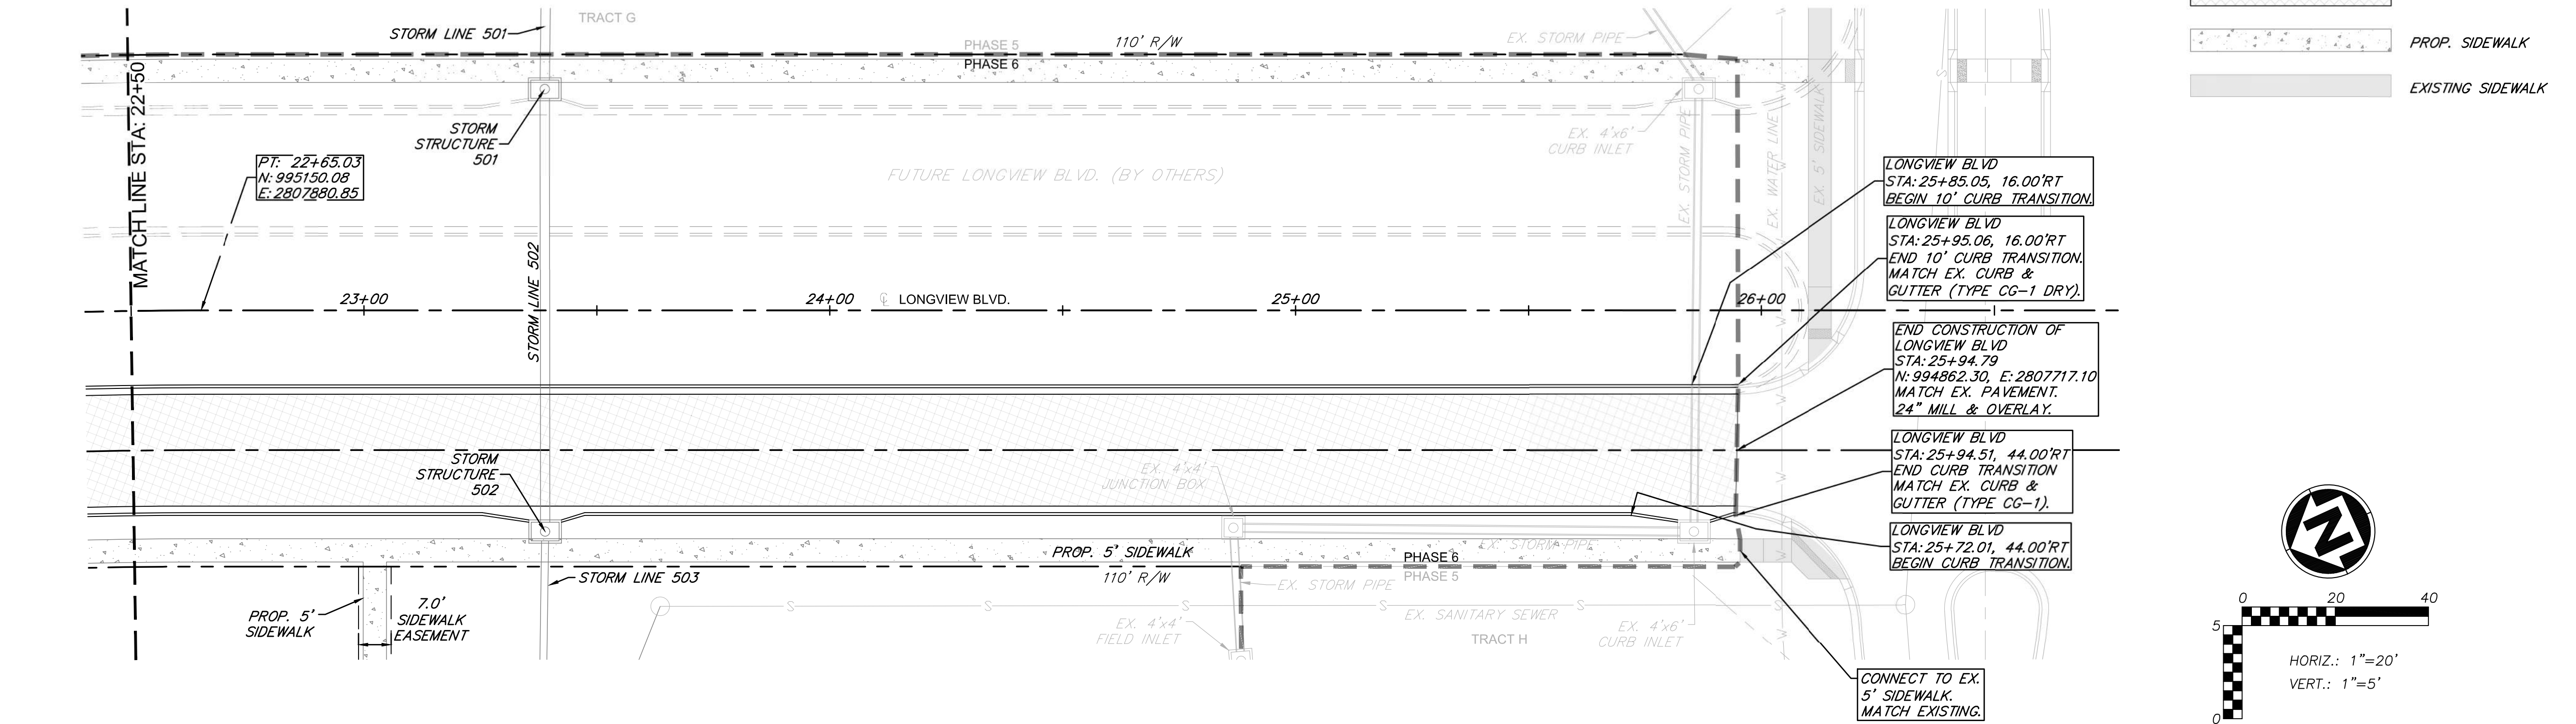

AS-BUILT

The information provided on this drawing conforms to construction records; it is not intended for construction, implementation or recording purposes; and it is solely based on information provided by others / obtained by my firm). ~~100.00~~ 100.10, ~~1.00%~~ 1.15% slope, and 8-inch ~~HDPE~~ PVC pipe" are all typical examples of revisions that indicate that design data has been replaced with "as-built" information. All other data is as designed and has not been field verified.

Date: 03/24/2022 Certified by: GRC
Title: Project Engineer Firm: Anderson Engineering Inc.

**RELEASE FOR
CONSTRUCTION
AS NOTED ON PLANS REVIEW
DEVELOPMENT SERVICES
LEE'S SUMMIT, MISSOURI**

04/16/2021

SUMMIT HOMES KC
HIGHLAND MEADOWS - 6TH PLAT

LONGVIEW BLVD.
STA.22+50-26+50 PLAN & PROFILE

S10, T47N, R32W
LEE'S SUMMIT, JACKSON COUNTY, MISSOURI



SHEET NUMBER
C106
8 OF 42


REVISIONS				DRAWING INFO.	
NO.	DESCRIPTION	BY	DATE	DRAWN BY:	GC
1	REVISED PER CITY COMMENT	GC	2/11/21	CHECK BY:	ZM
				LICENSE NO.	PE-2012069232
				DATE:	1/7/2021
2	AS-BUILT DRAWINGS	GC	3/16/22	ISSUED FOR:	FOR REVIEW
				JOB NUMBER:	20KC10038
				MO COA NO.	000062





**ANDERSON
ENGINEERING**
EMPLOYEE OWNED

ENGINEERS • SURVEYORS • LABORATORIES • DRILLING
941 W. 14TH TER. • KANSAS CITY, MISSOURI 64145 • PHONE (816) 777-4000
A LICENSED MISSOURI ENGINEERING & SURVEYING CORPORATION - LG 62


Feb 11, 2021 -- 6:04pm Plotted By: gacite G:\Shared drives\VC10 - Land Development\Projects\2020\20K10058 Highland Meadows - 6th Plat\01 CIVIL\03-DWG\Sheet\STREET AND STORM\20K10058 - SH1T - STREET P&P.dwg Layout: SW FIORD DR. STA. 1+00 - 5+00

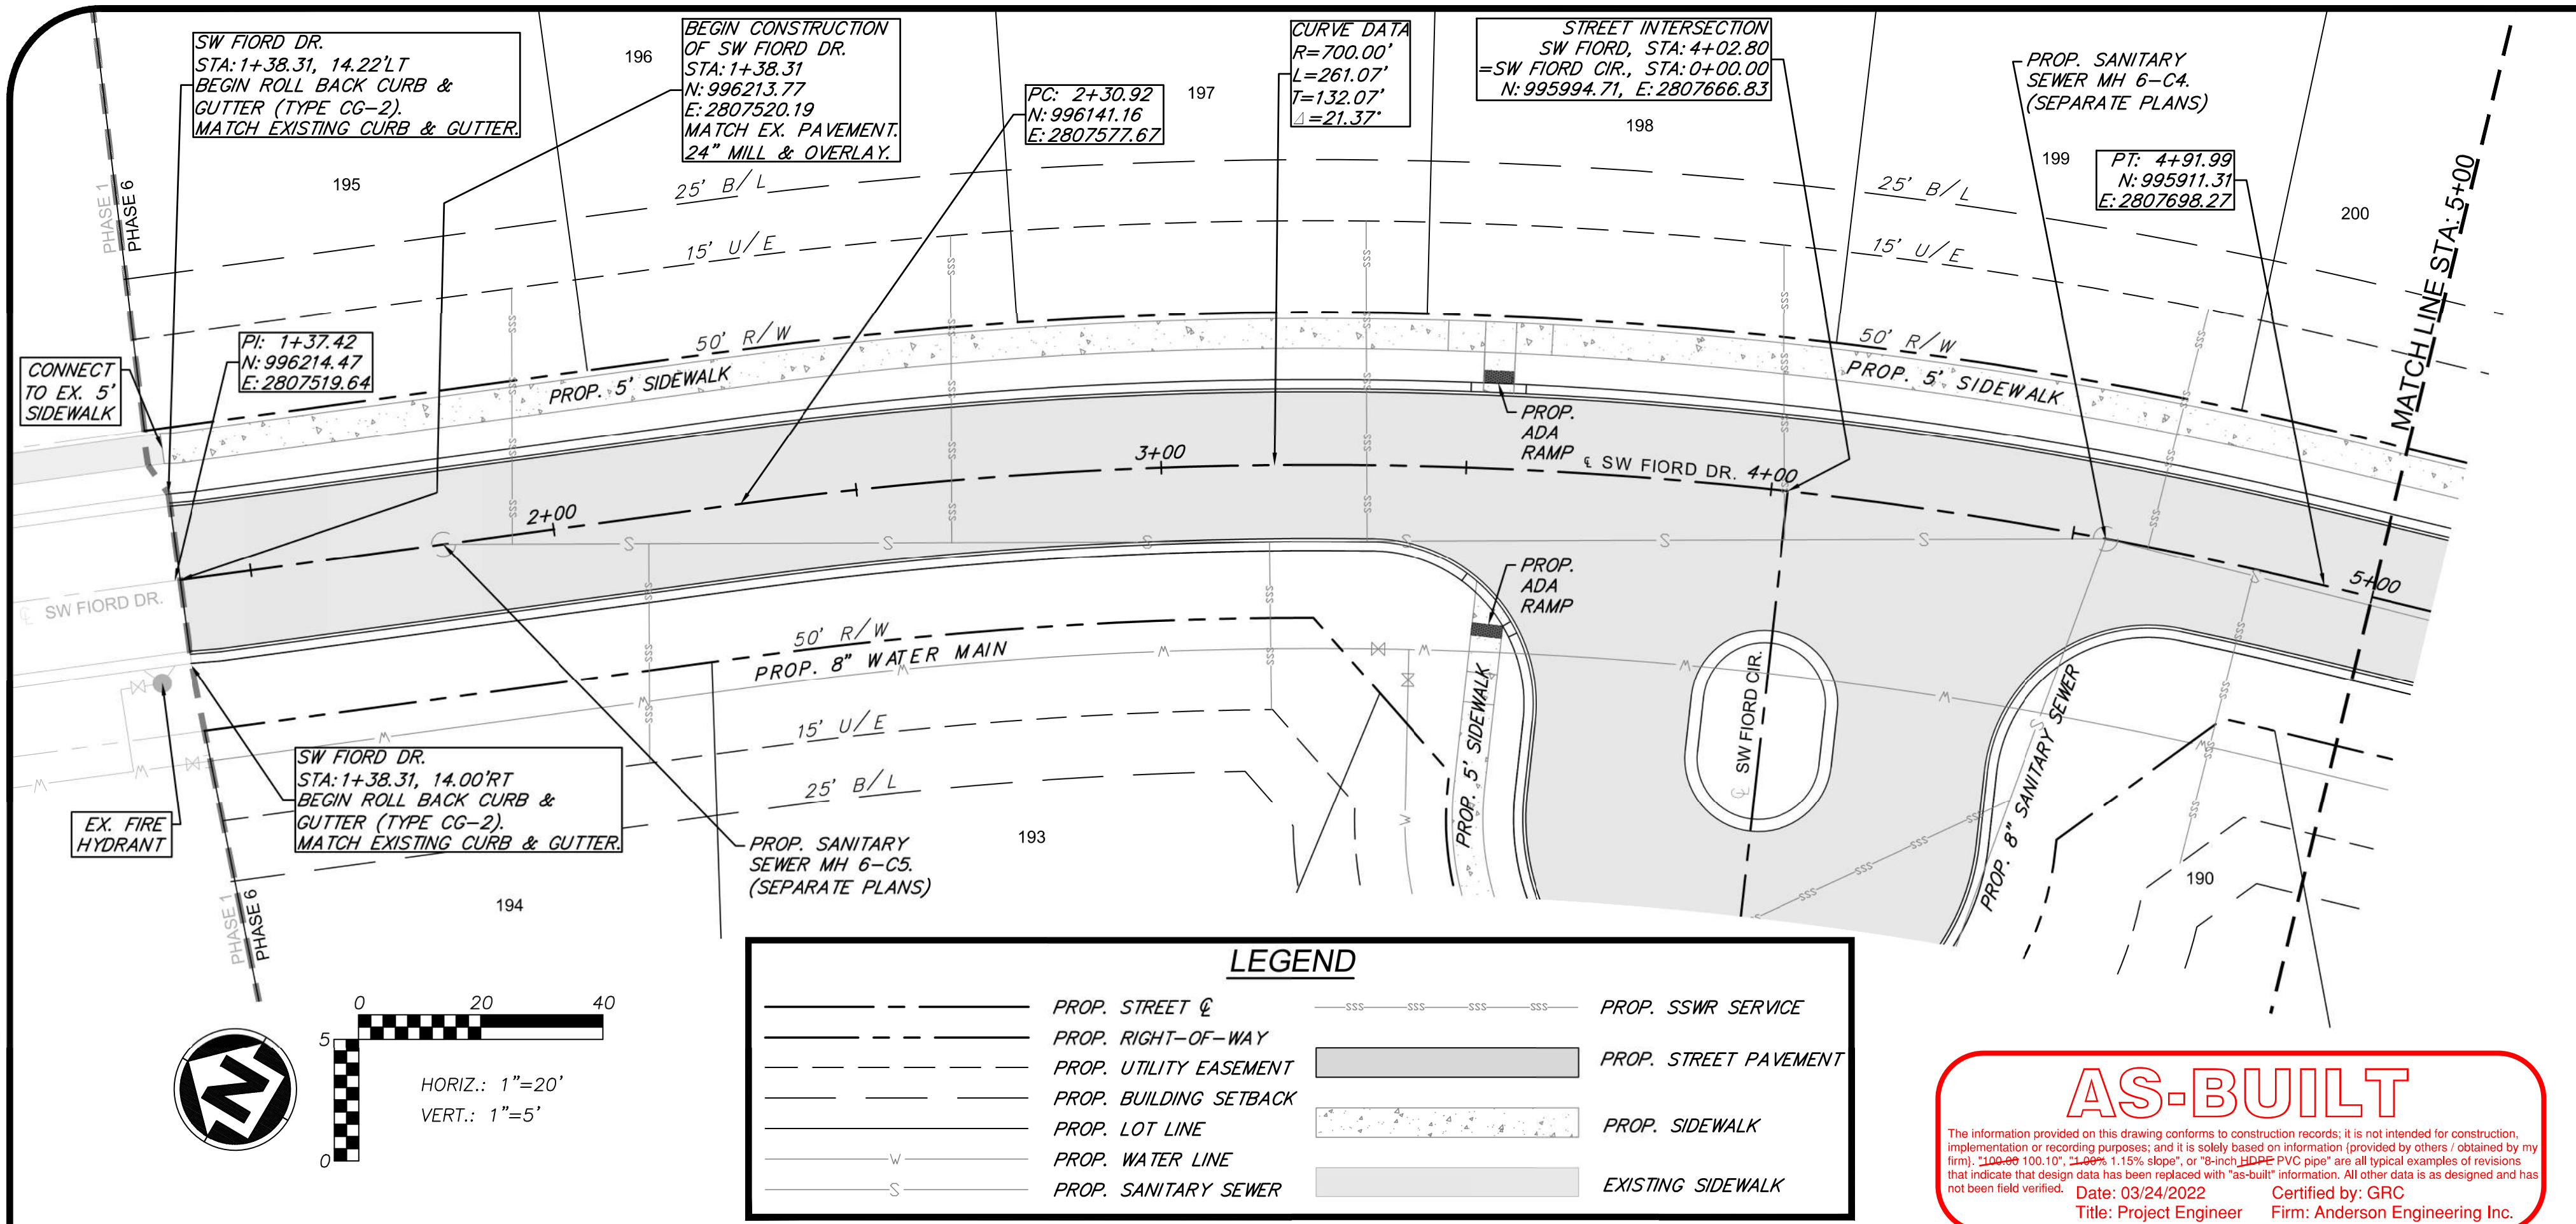

SW FIORD DR. STA: 1+00-5+00

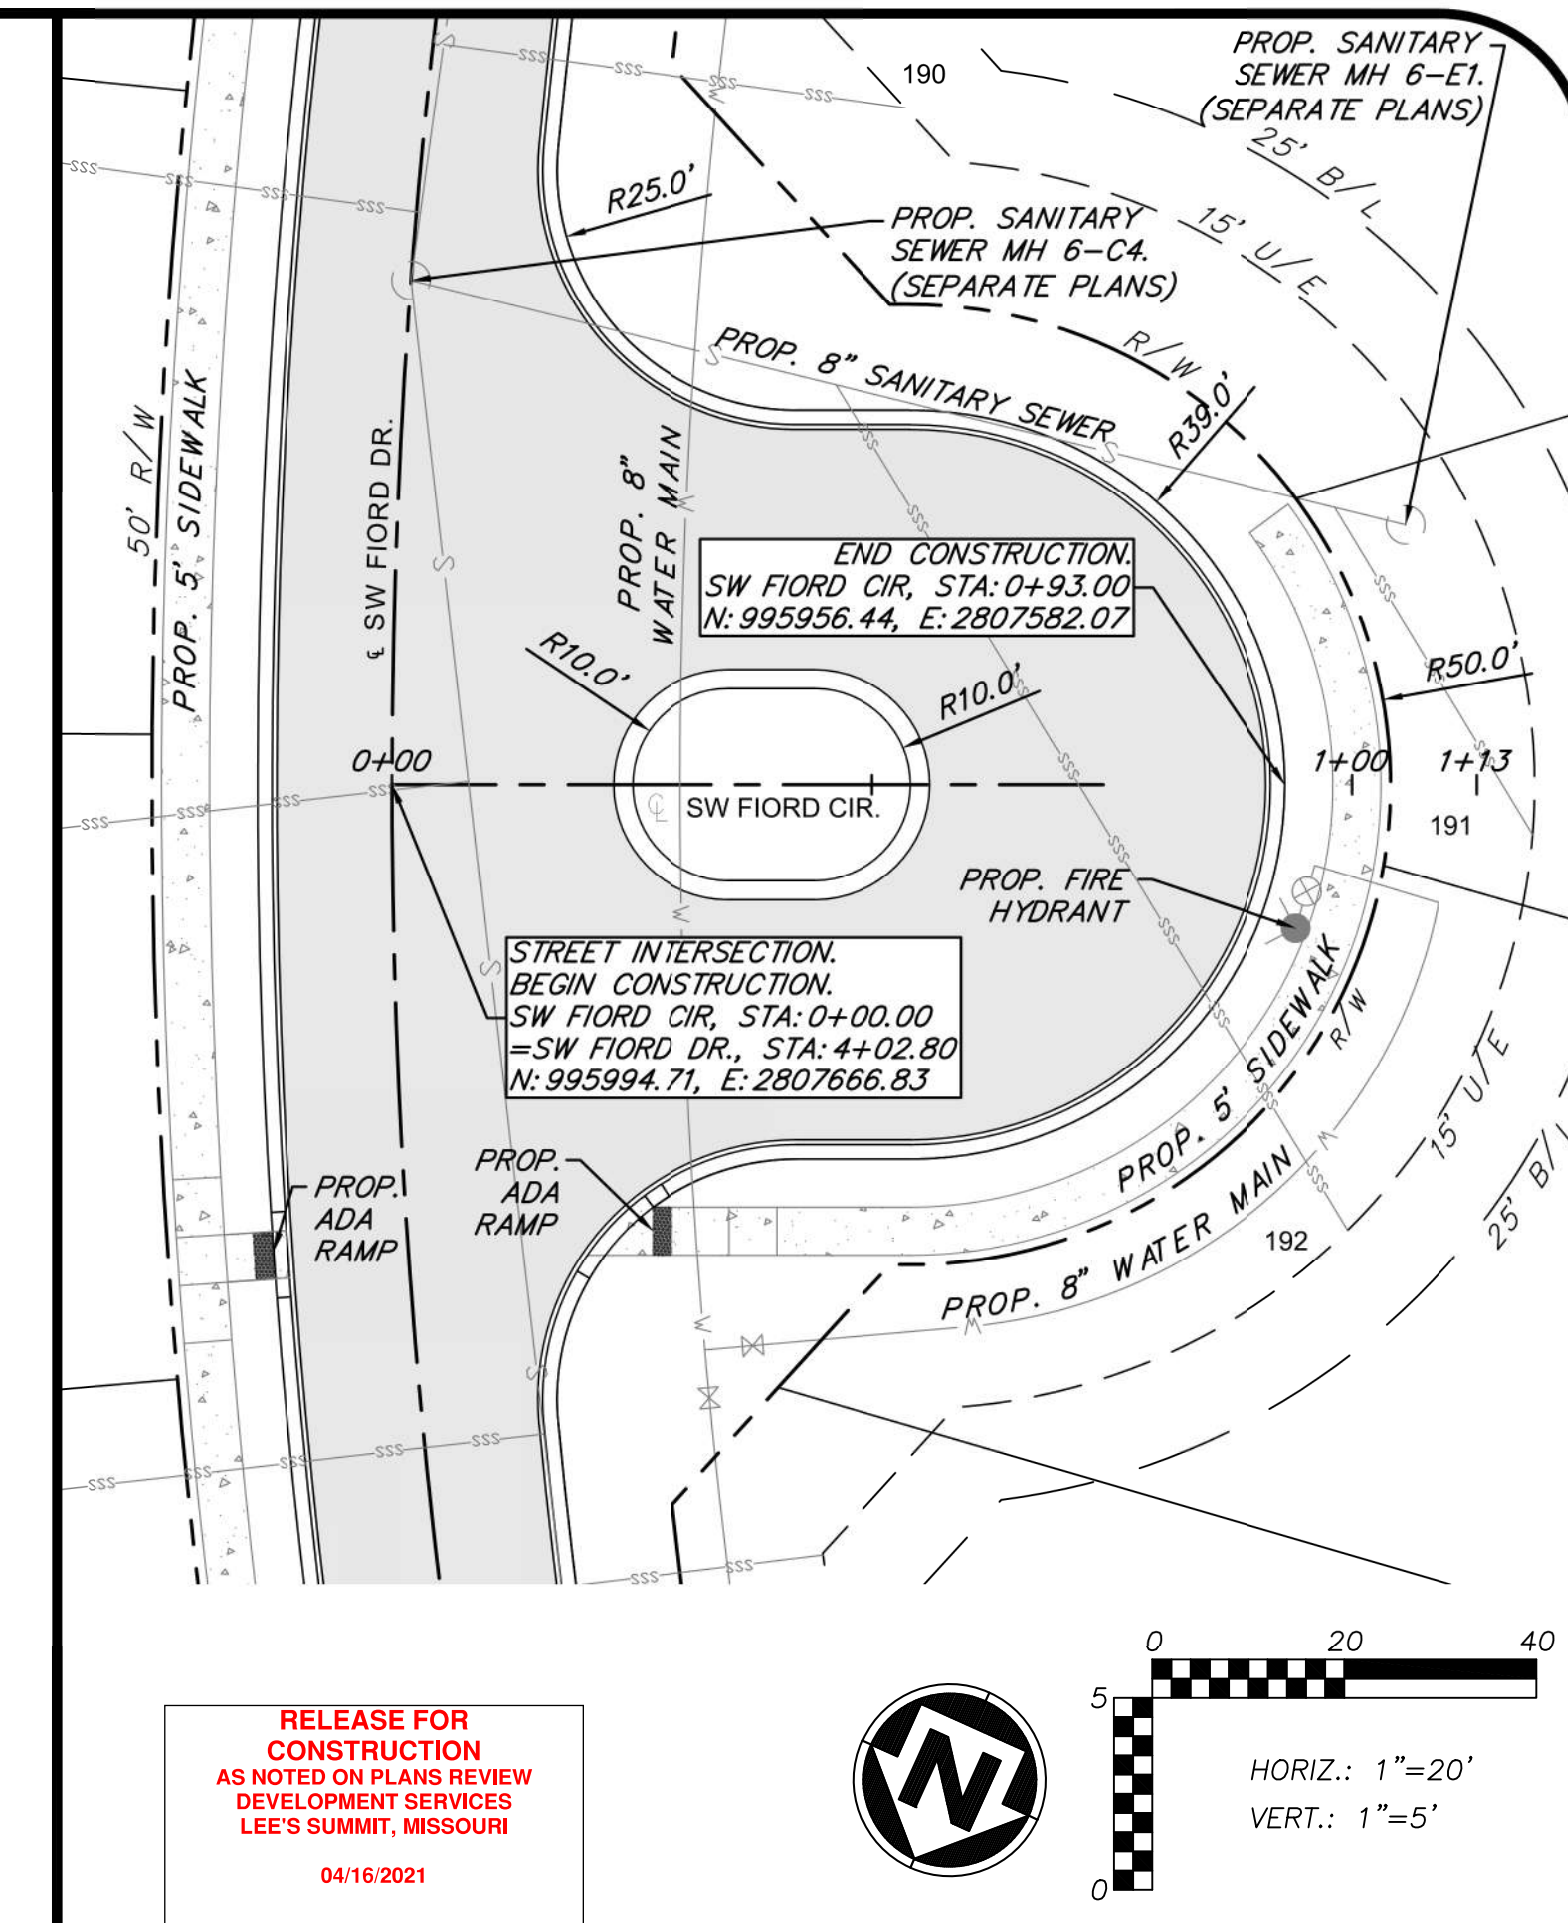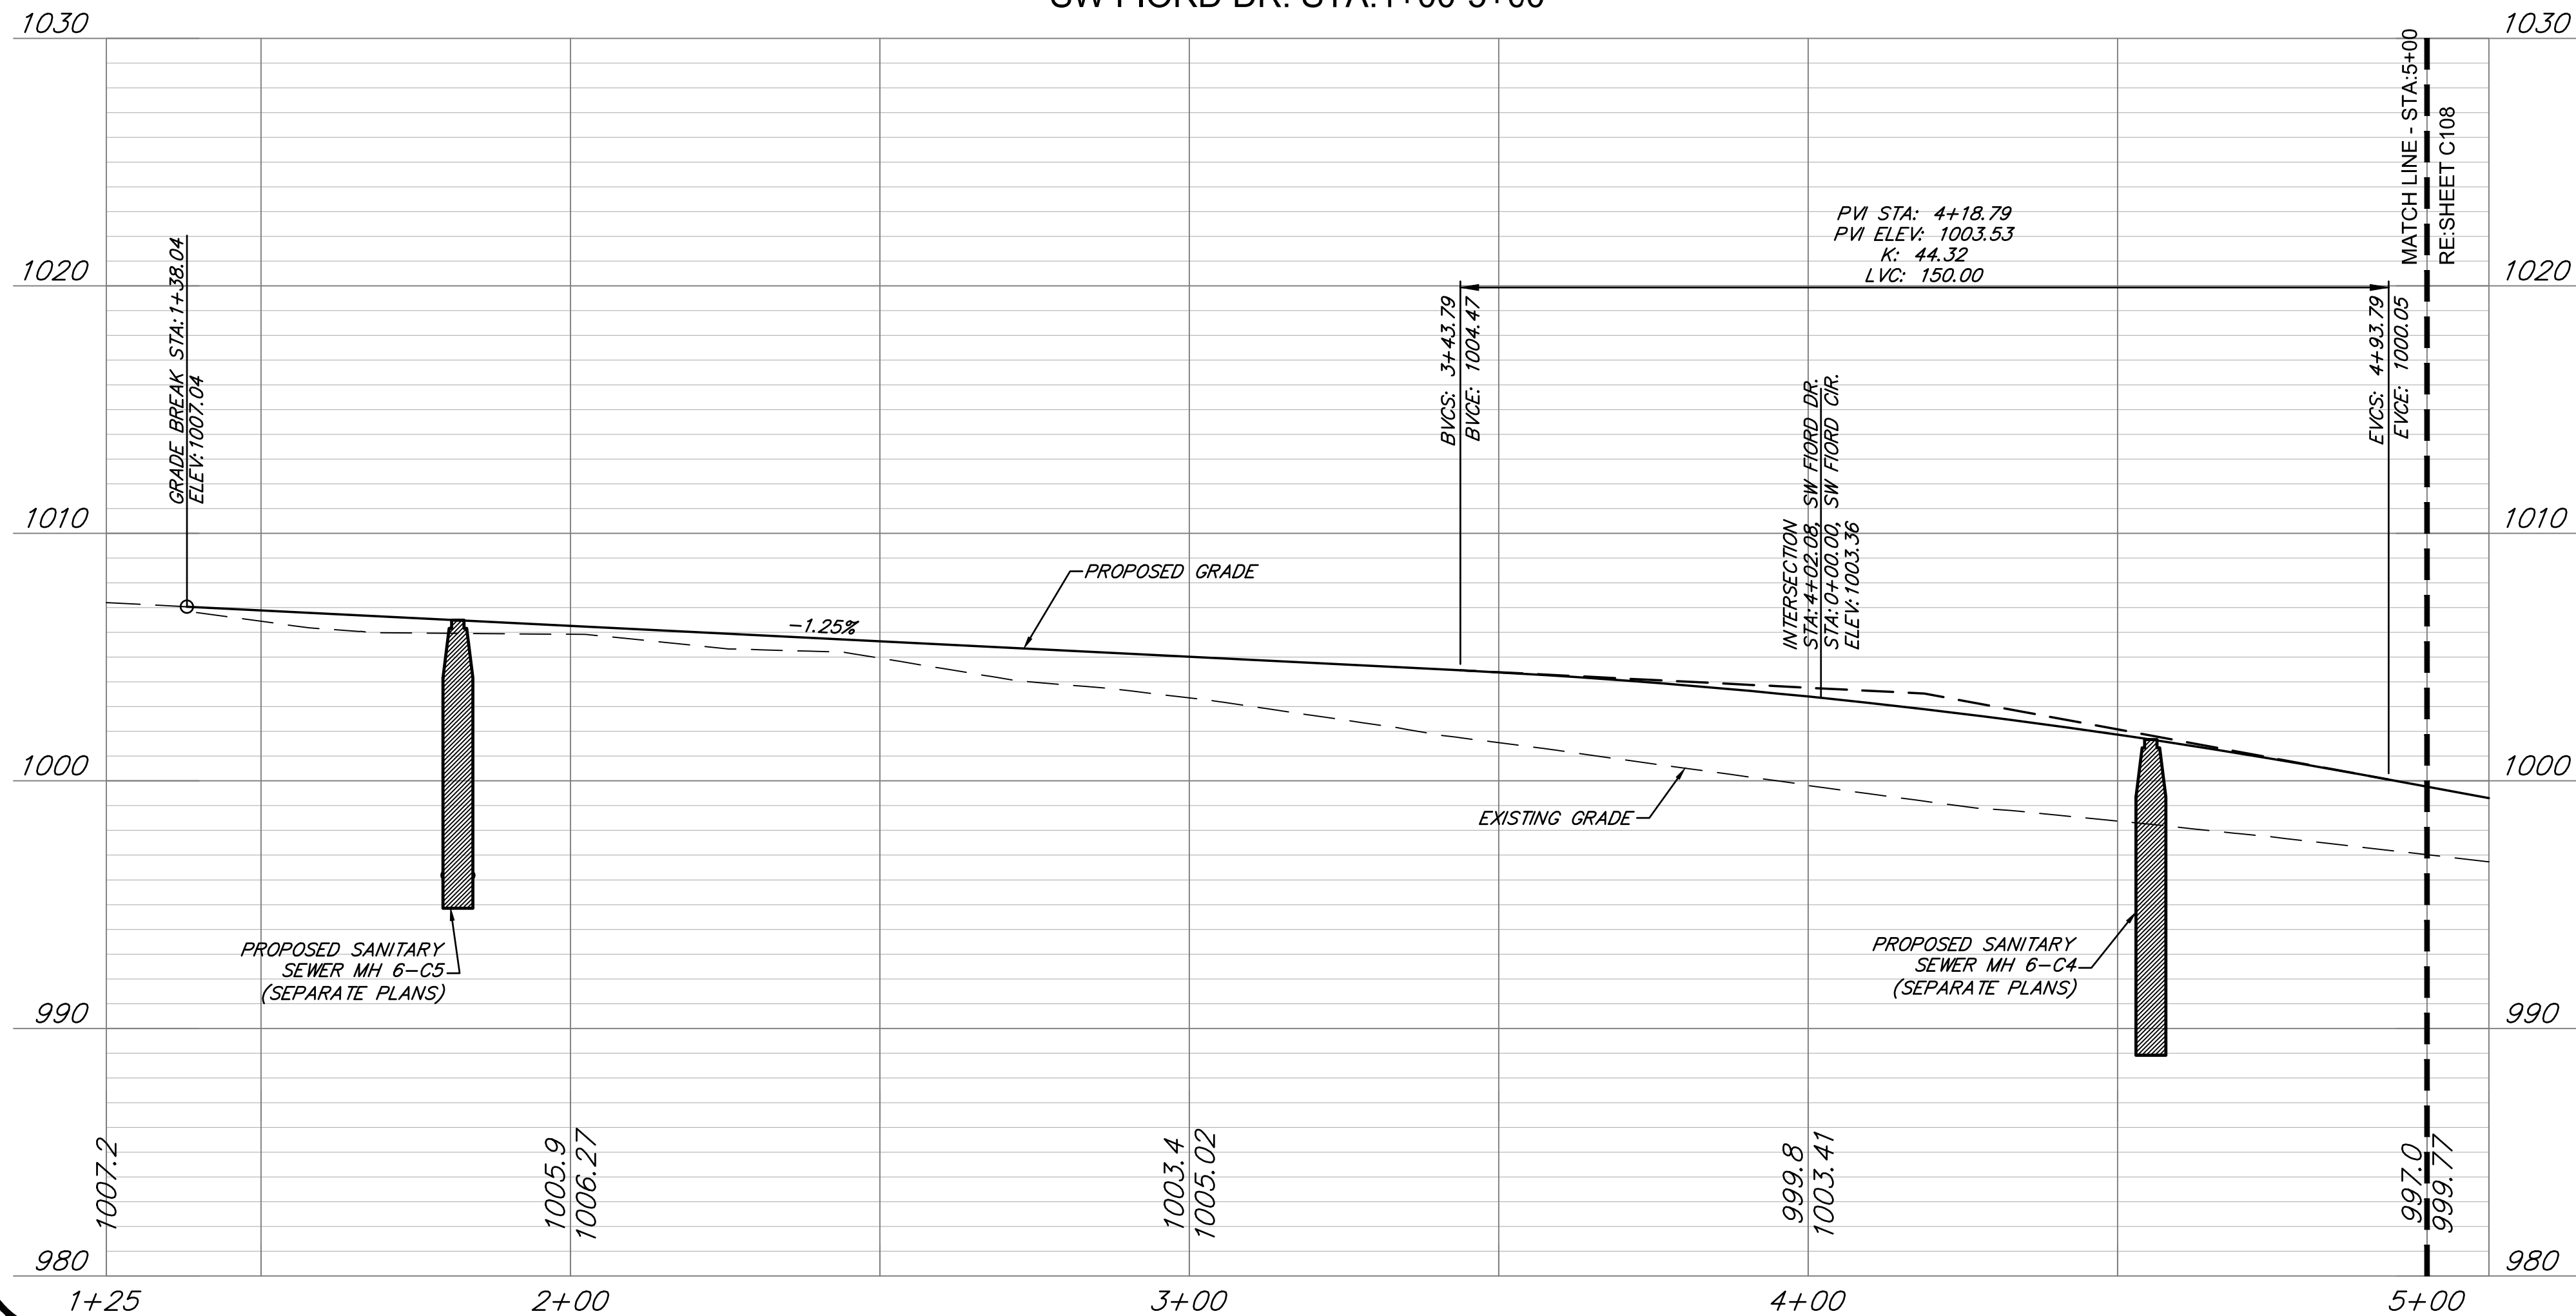

SW FIORD CIR.

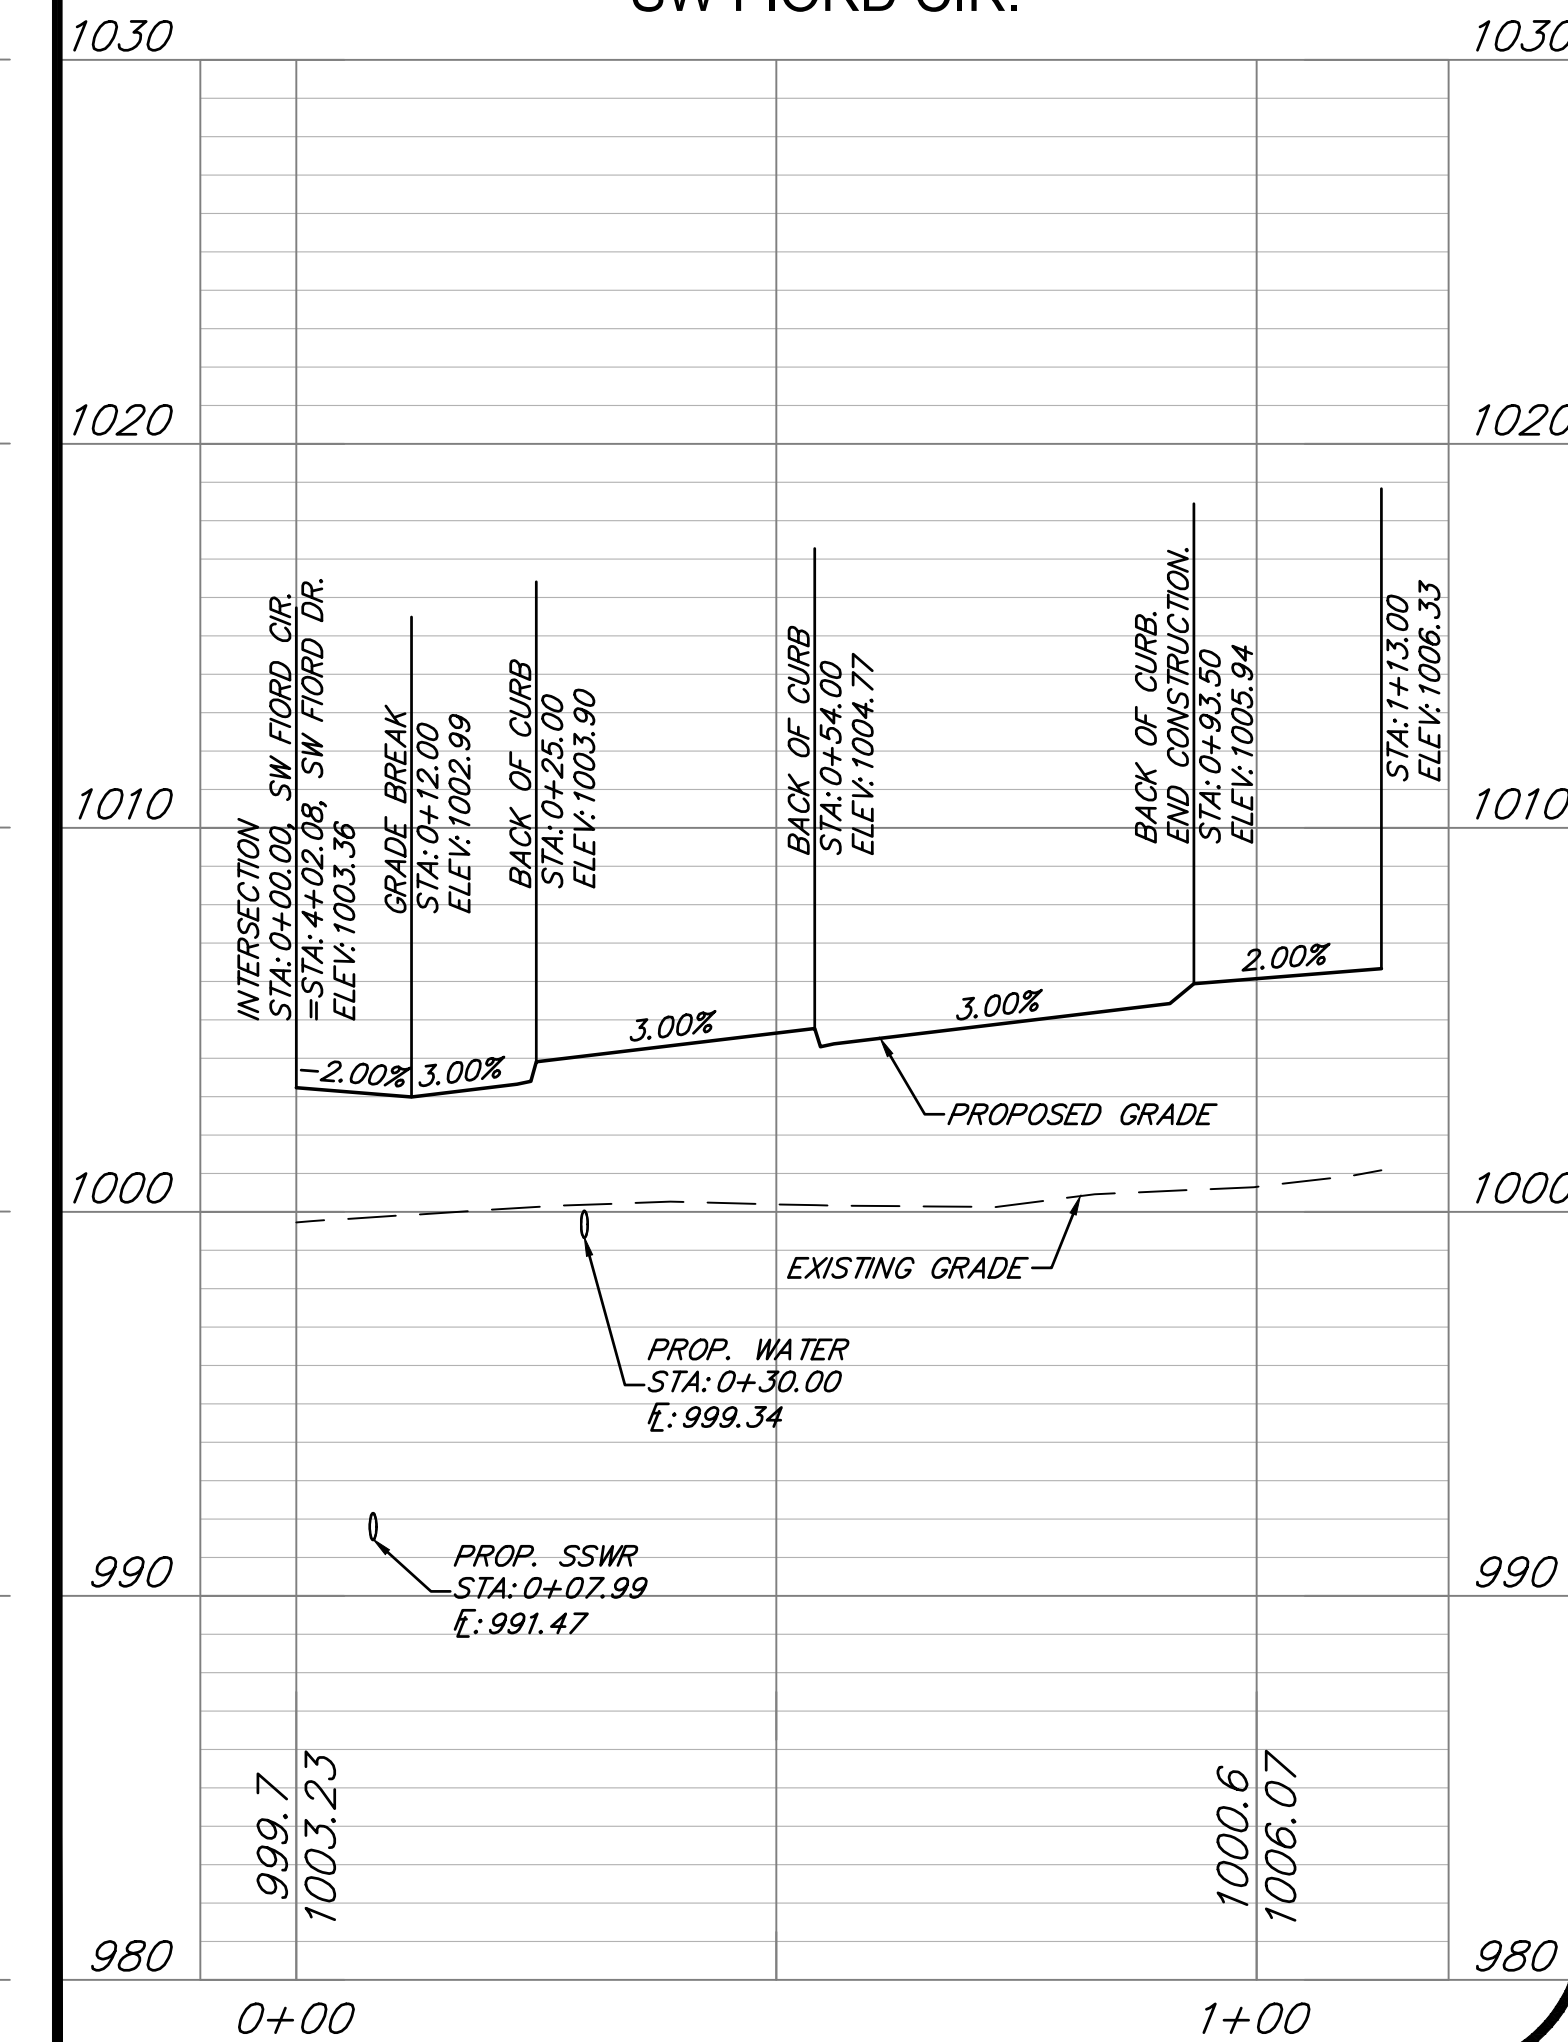

ANDERSON ENGINEERING
EMPLOYEE OWNED

AE

ENGINEERS • SURVEYORS • LABORATORIES • DRILLING
941 W. 141ST TER • KANSAS CITY, MISSOURI 64145 • PHONE (816) 777-0400
A LICENSED MISSOURI ENGINEERING & SURVEYING CORPORATION - LC 82

REVISIONS		DRAWING INFO.	
NO.	DESCRIPTION	BY	DATE
1	REVISED PER CITY COMMENT	GC	2/11/21
2	AS-BUILT DRAWINGS	GC	3/16/22
		CHECK BY:	ZM
		LICENSE NO.	PE-2012009232
		DATE:	1/7/2021
		ISSUED FOR:	FOR REVIEW
		JOB NUMBER:	20K10058
		MO COA NO.	000062

SUMMIT HOMES KC
HIGHLAND MEADOWS - 6TH PLAT



SW FIORD DR. STA: 1+00-5+00 &
SW FIORD CIR. PLAN & PROFILE

S10, T47N, R32W
LEE'S SUMMIT, JACKSON COUNTY, MISSOURI

STATE OF MISSOURI
ZACH A. MYERS
NUMBER
PE-2012009232
2/11/21
PROFESSIONAL ENGINEER


SHEET NUMBER
C107
9 OF 42

Feb 11, 2021 - 6:04pm Plotted By: gacate G:\Shared drives\VC10 - Land Development\Projects\2020\20K10058 Highland Meadows - 6th Plat\01 CIVIL\03-DWG\Sheet\STREET AND STORM\20K10058 - SH1 - STREET P&P.dwg Layout: SW FIORD DR. STA. 5+00 - 9+00

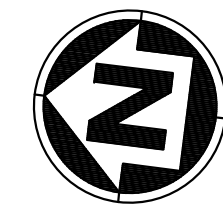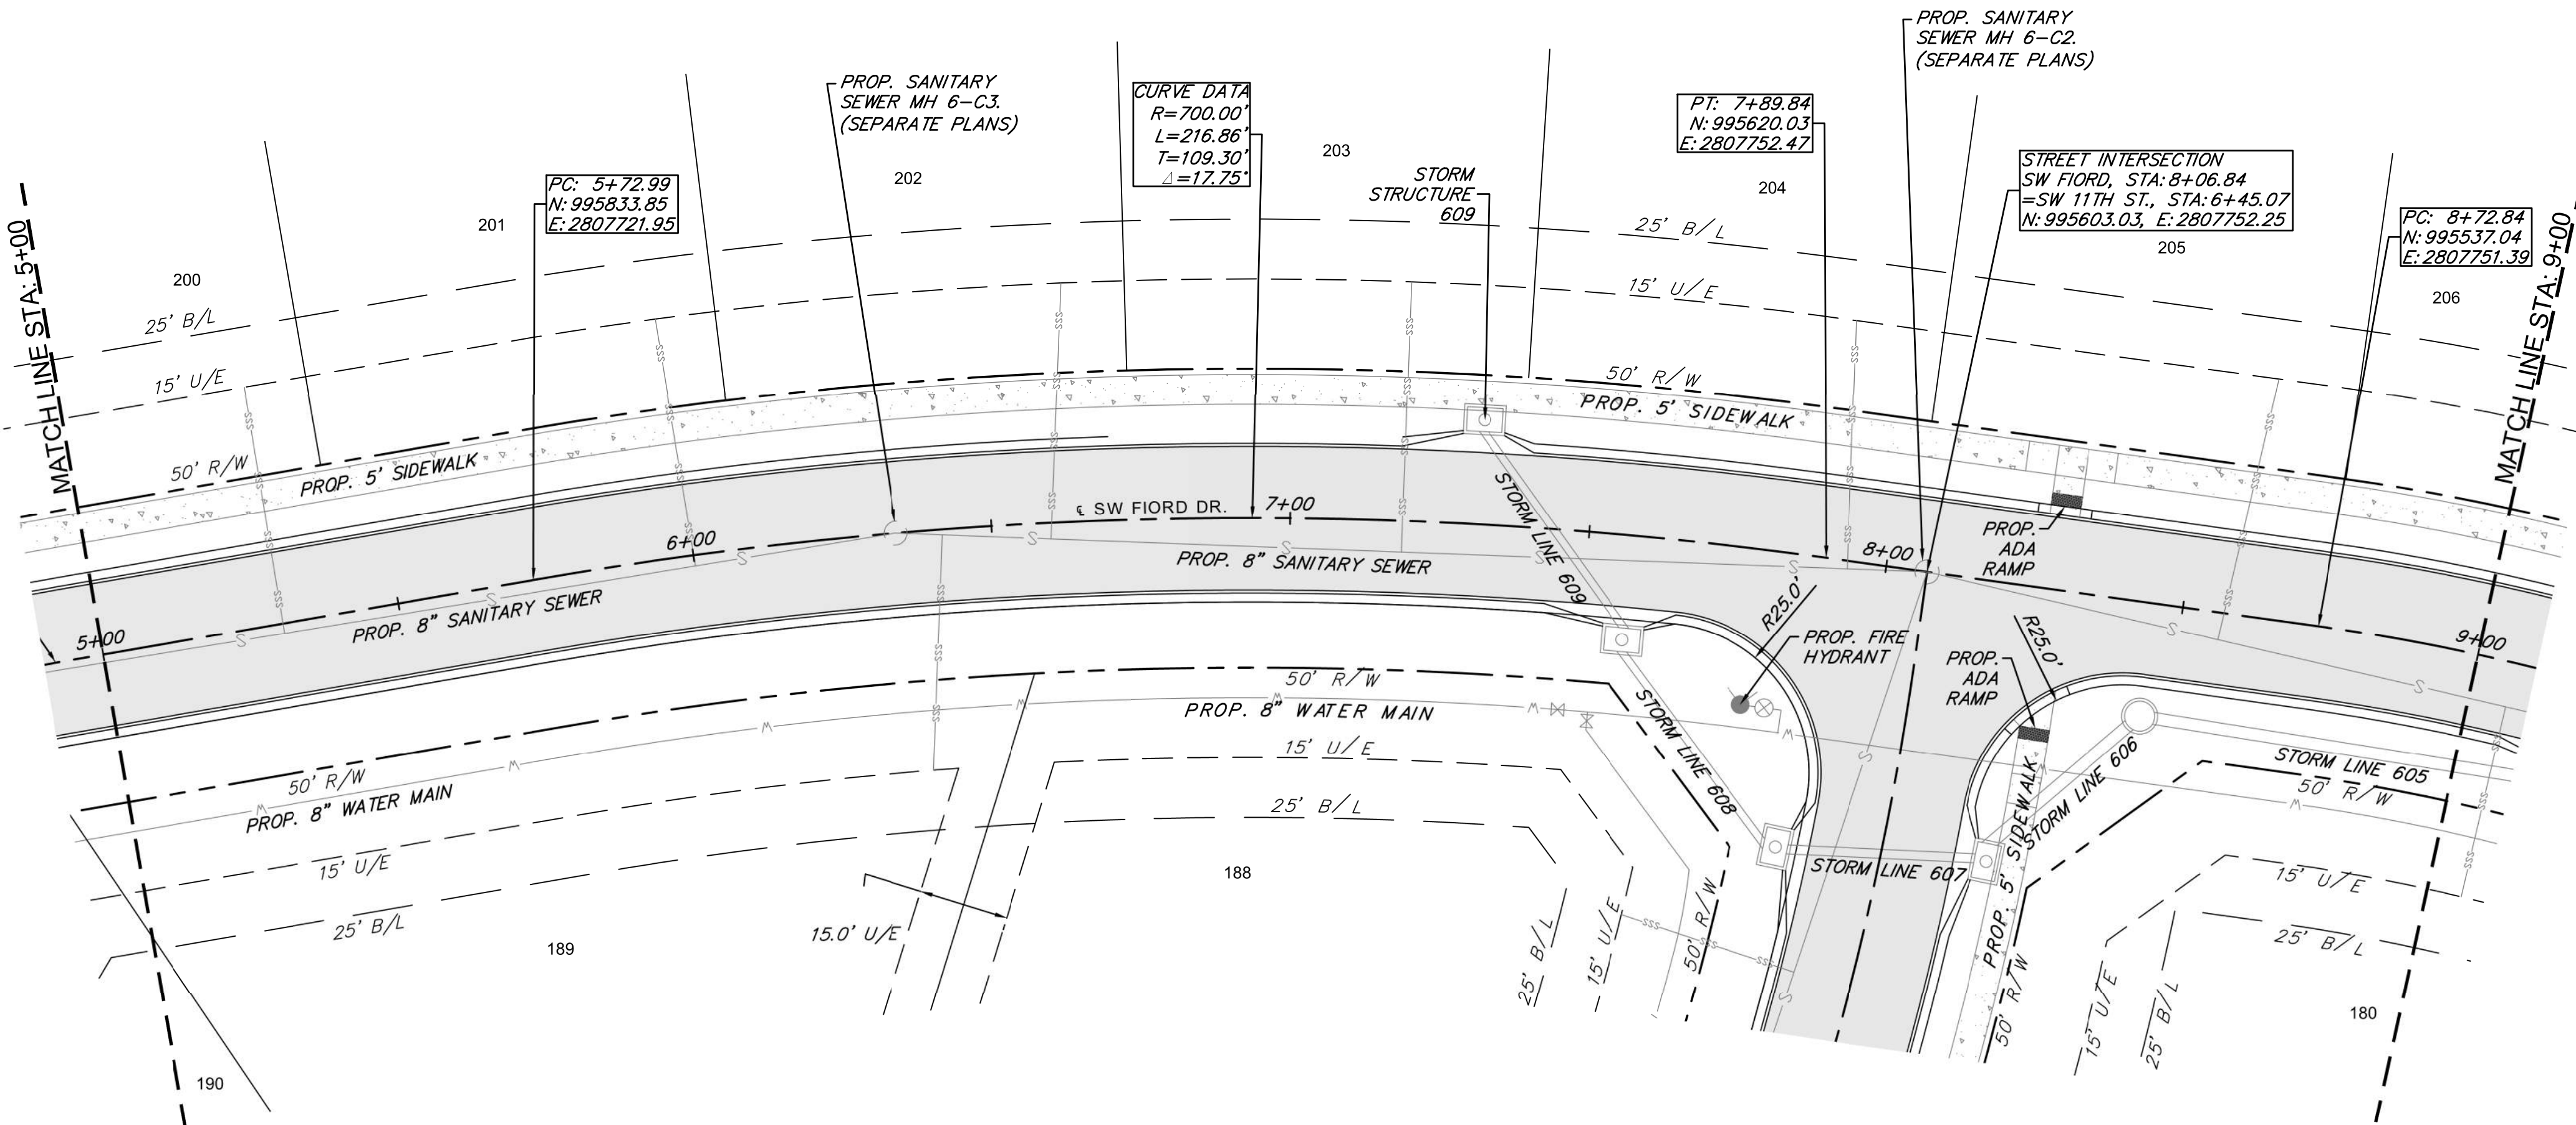

HORIZ.: 1"=20'
VERT.: 1"=5'

SW FIORD DR. STA: 5+00 - 9+00

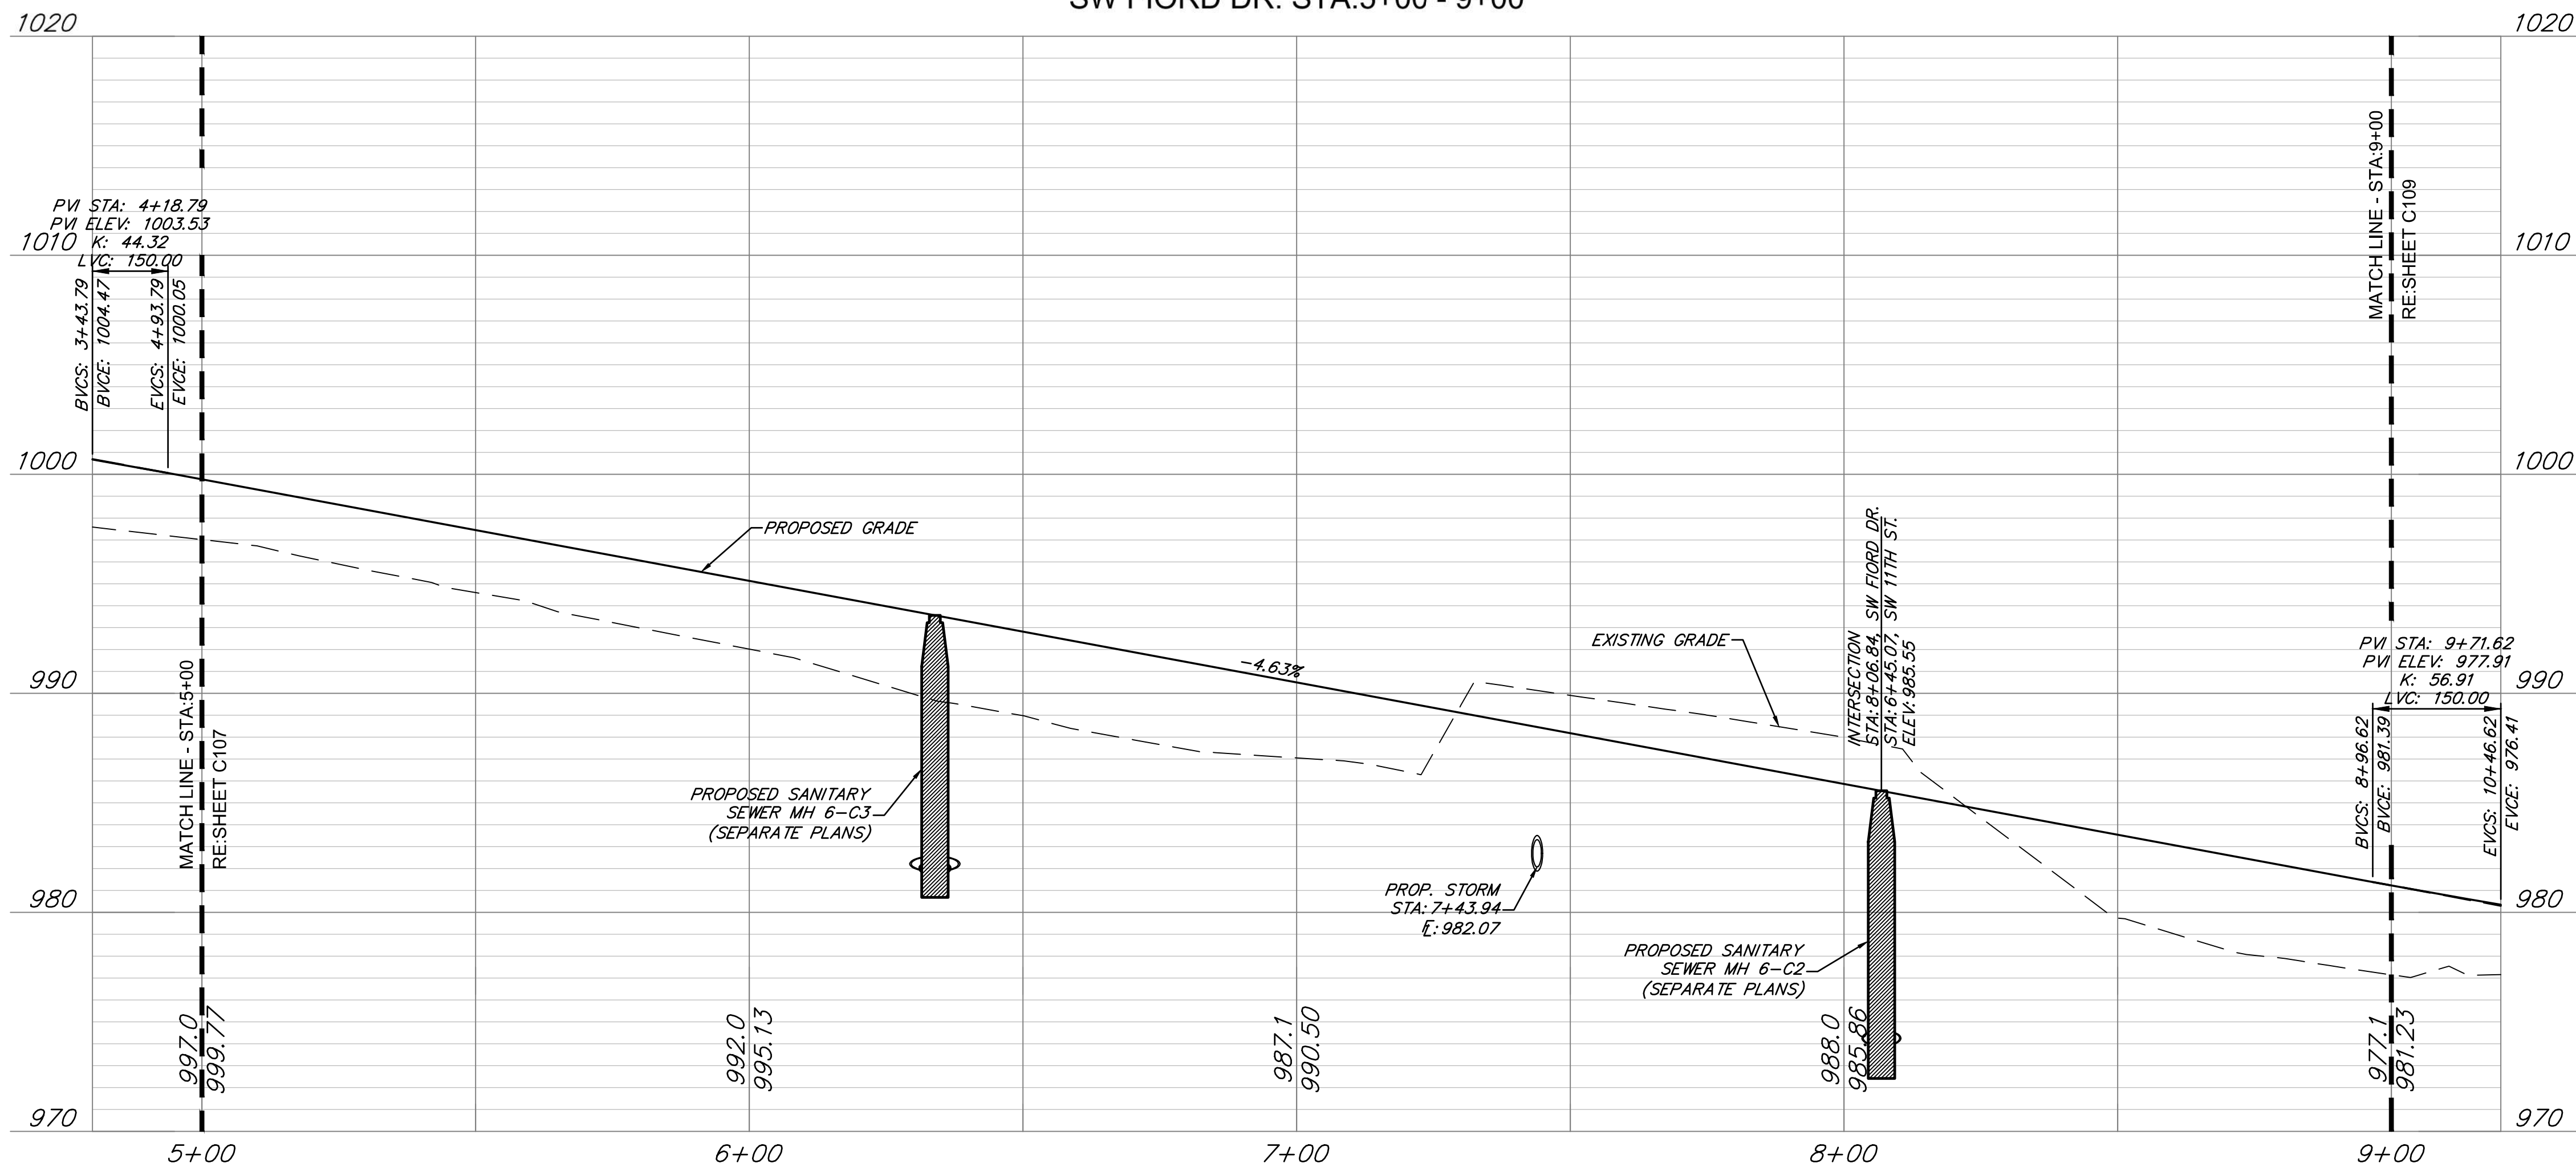

AS-BUILT

The information provided on this drawing conforms to construction records. It is not intended for construction. Any use of this drawing for construction purposes is at the user's risk. The user assumes all liability for any errors or omissions. This drawing is not to be used for any other purpose without the written consent of Anderson Engineering Inc. All other data is as designed and has not been field verified.

Date: 03/24/2022
Title: Project Engineer
Firm: Anderson Engineering Inc.

RELEASE FOR
CONSTRUCTION
AS NOTED ON PLANS REVIEW
DEVELOPMENT SERVICES
LEE'S SUMMIT, MISSOURI
04/16/2021

LEGEND

- PROPOSED STREET &
- PROPOSED RIGHT-OF-WAY
- PROPOSED UTILITY EASEMENT
- PROPOSED BUILDING SETBACK
- PROPOSED LOT LINE
- PROPOSED WATER LINE
- PROPOSED SSWR
- PROPOSED SSWR SERVICE
- PROPOSED STREET PAVEMENT
- PROPOSED SIDEWALK

ANDERSON ENGINEERING
EMPLOYEE OWNED

ENGINEERS • SURVEYORS • LABORATORIES • DRILLING
941 W. 141ST TER • KANSAS CITY, MISSOURI 64145 • PHONE (816) 777-0400
A LICENSED MISSOURI ENGINEERING & SURVEYING CORPORATION - LC 62

REVISIONS		DRAWING INFO.	
NO.	DESCRIPTION	BY	DATE
1	REVISED PER CITY COMMENT	GC	2/11/21
		CHECK BY:	ZM
		LICENSE NO.	PE-2012009232
		DATE:	1/7/2021
		ISSUED FOR:	FOR REVIEW
2	AS-BUILT DRAWINGS	GC	3/16/22
		JOB NUMBER:	20K10058
		MO COA NO.	00062



SUMMIT HOMES KC
HIGHLAND MEADOWS - 6TH PLAT

SW FIORD DR. STA: 5+00-9+00
PLAN & PROFILE

S10, T47N, R32W
LEE'S SUMMIT, JACKSON COUNTY, MISSOURI



SHEET NUMBER
C108
10 OF 42

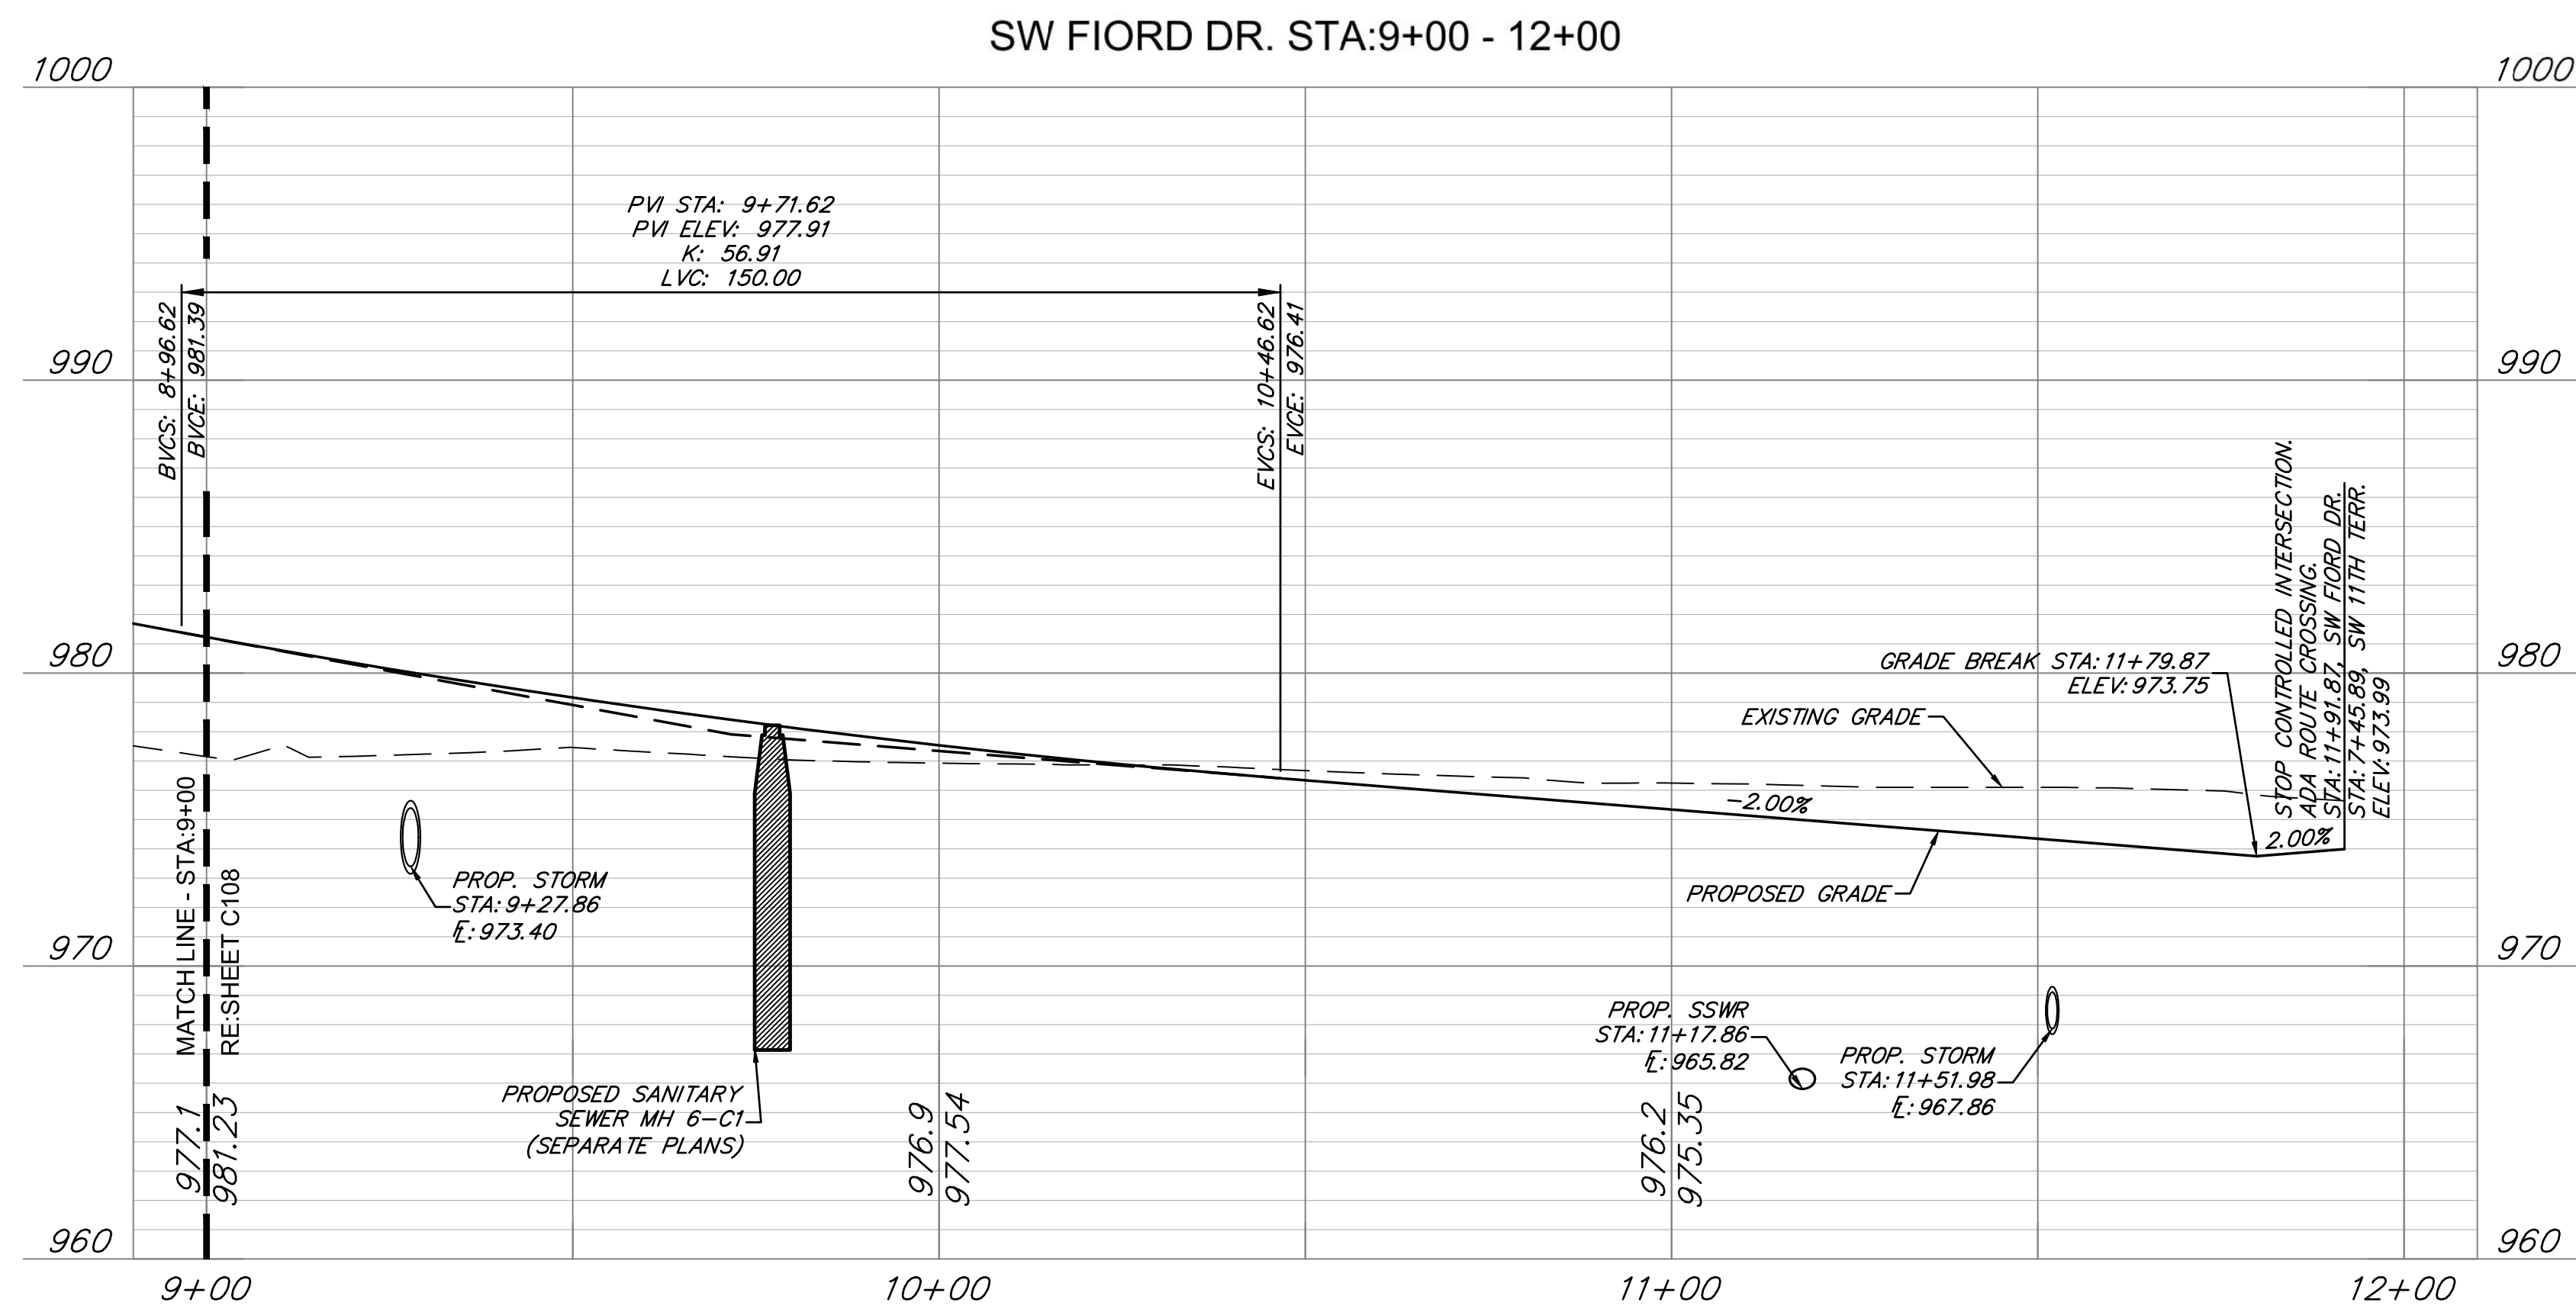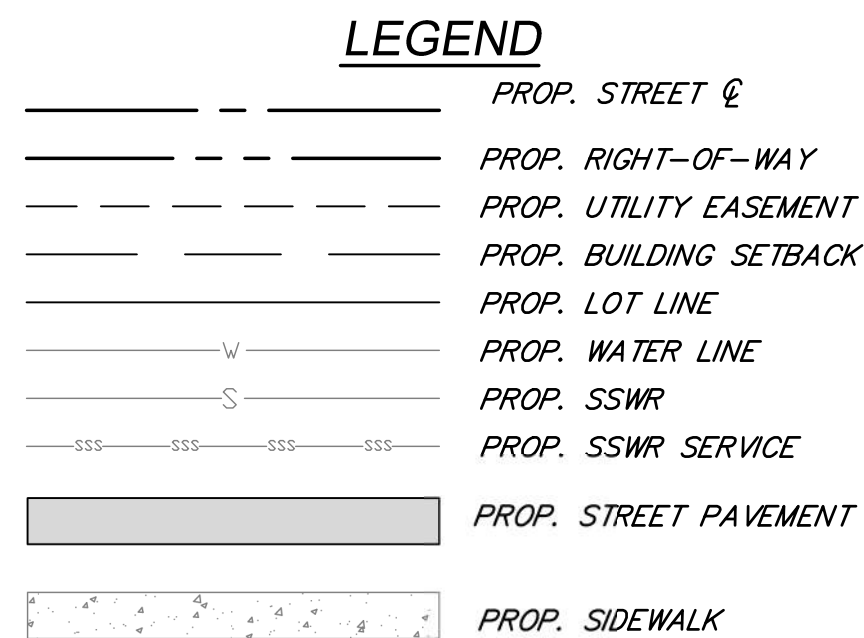

The information provided on this drawing conforms to construction records; it is not intended for construction, implementation or recording purposes, and it is solely based on information (provided by others / obtained by my firm). "100.00 100.10", "1.00% 1.15% slope", or "8-inch HDPE PVC pipe" are all typical examples of revisions that indicate that design data has been replaced with "as-built" information. All other data is as designed and has not been field verified.

Date: 03/24/2022 Certified by: GRC
 Title: Project Engineer Firm: Anderson Engineering Inc.

04/16/2021



SUMMIT HOMES KC
HIGHLAND MEADOWS - 6TH PLAT

SW FIORD DR. STA. 9+00-12+00
PLAN & PROFILE

S10, T47N, R32W
LEE'S SUMMIT, JACKSON COUNTY, MISSOURI



C109
11 OF 42

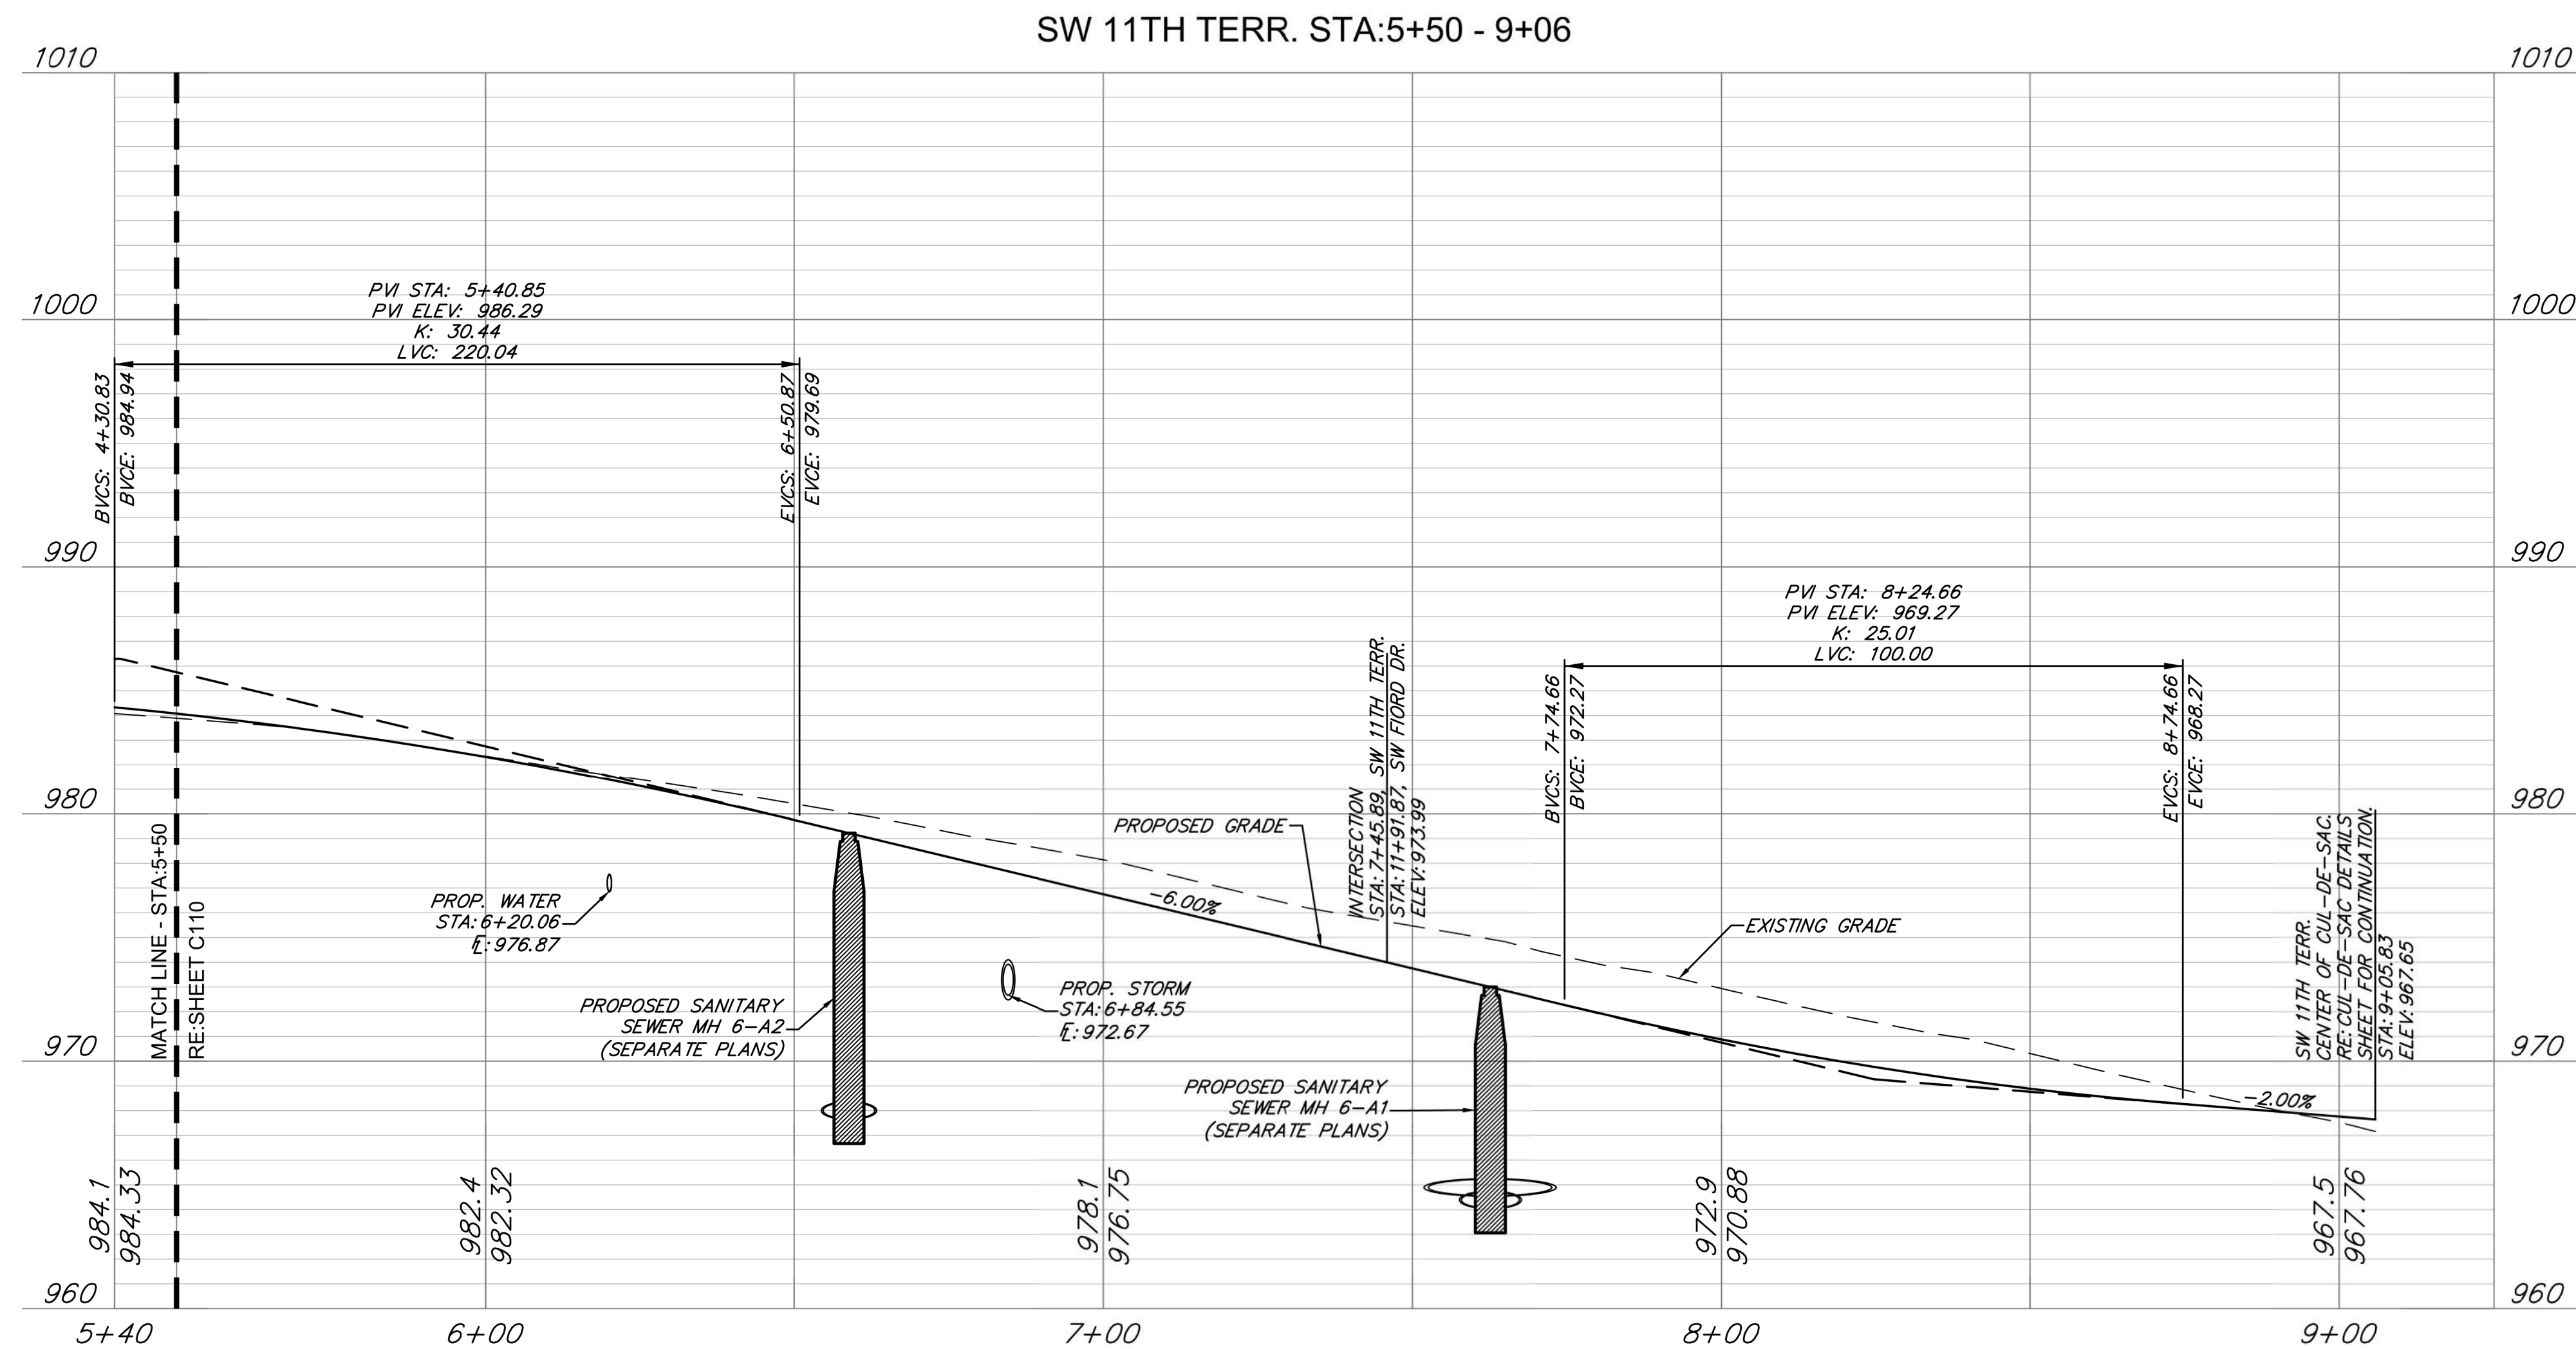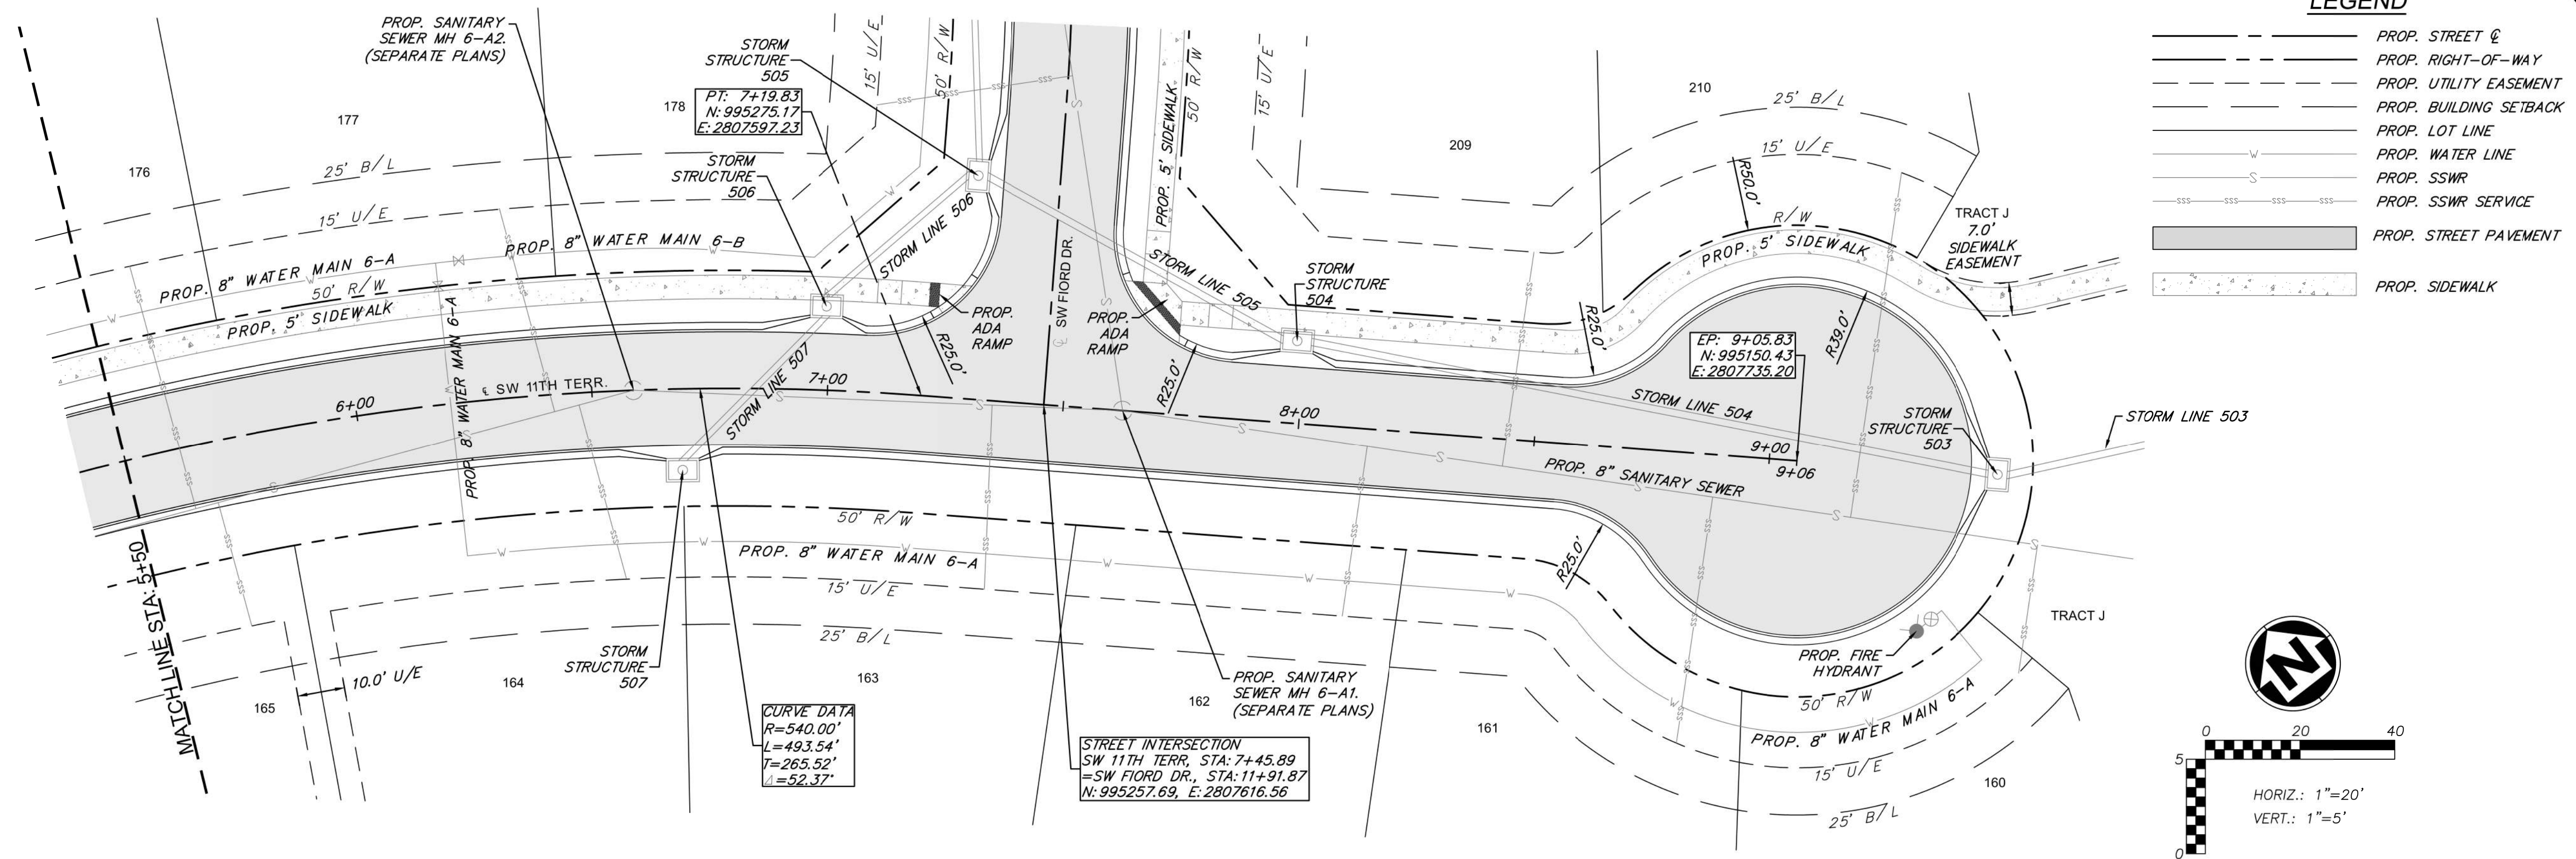

AS-BUILT

The information provided on this drawing conforms to construction records; it is not intended for construction, implementation or recording purposes; and it is solely based on information provided by others / obtained by my firm). ~~100%~~ 100, 10%, ~~1.00%~~ 1.15% slope, or "8-inch ~~HDP~~ PVC pipe" are all typical examples of revisions that indicate that design data has been replaced with "as-built" information. All other data is as designed and has not been field verified.

Date: 03/24/2022 Certified by: GRC
Title: Project Engineer Firm: Anderson Engineering Inc.


**RELEASE FOR
CONSTRUCTION
AS NOTED ON PLANS REVIEW
DEVELOPMENT SERVICES
LEE'S SUMMIT, MISSOURI**

04/16/2021

SW 11TH TERR, STA.5+50-9+06
PLAN & PROFILE

SW 11TH TERR. STA. 5+50-9+06
PLAN & PROFILE

310, 147N, R32W
LEE'S SUMMIT, JACKSON COUNTY, MISSOURI

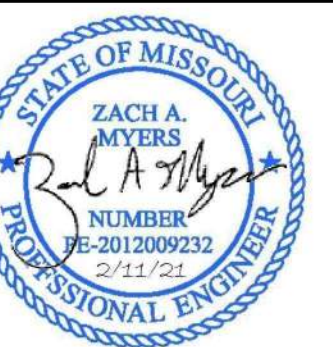

SHEET NUMBER

C111
3 OF 42

Feb 11, 2021 - 6:06pm Plotted By: gscite G:\Shared drives\VC10 - Land Development\Projects\2020\20K10058 Highland Meadows - 6th Plat\01 CIV\03-DWG\Sheet\STREET AND STORM\20K10058 - SH1 - SIGNAGE.dwg Layout: STREET SIGNAGE PLAN

PERMANENT SIGNING GENERAL NOTES:

- ALL SIGNING SHALL BE IN ACCORDANCE WITH THE LATEST EDITION OF THE MANUAL ON UNIFORM TRAFFIC CONTROL DEVICES (MUTCD).
- THE CONTRACTOR IS RESPONSIBLE FOR AVOIDING ANY AND ALL UTILITIES WHEN INSTALLING SIGN POSTS, WHETHER THE UTILITY IS INDICATED ON THE PLANS OR NOT.
- ALL WORKMANSHIP AND MATERIALS SHALL BE SUBJECT TO THE INSPECTION AND APPROVAL OF THE PUBLIC WORKS DEPARTMENT OF THE CITY OF LEE'S SUMMIT.
- THE CONTRACTOR SHALL STAKE THE LOCATION OF ALL SIGN POSTS TO BE INSTALLED. THE CITY INSPECTOR SHALL INSPECT THE STAKING PRIOR TO INSTALLATION. MINOR RELOCATION TO AVOID CONFLICTS MAY BE ALLOWED WITH THE APPROVAL OF THE CITY TRAFFIC ENGINEER OR DESIGNEE.
- SIGNS SHOWN TO BE INSTALLED ON THE SIDE OF METAL POLES SHALL BE MOUNTED WITH STAINLESS STEEL STRAPS OR WING BRACKETS AS DETAILED. NO SIGNS ARE TO BE INSTALLED ON WOOD POLES. SEE TRAFFIC SIGNAL STANDARD DRAWINGS FOR THE INSTALLATION OF SIGNS ON MAST ARMS.
- ALL POST MOUNTED SIGNS SHALL BE INSTALLED WITH BREAKAWAY ANCHORS ACCORDING TO STANDARD DRAWINGS.
- ALL EXISTING SIGNS WILL BE USED IN PLACE DURING CONSTRUCTION AND PROTECTED FROM DAMAGE UNLESS OTHERWISE INDICATED ON PLANS. IF THE CONTRACTOR DAMAGES ANY EXISTING SIGN OR POSTS DURING CONSTRUCTION, THE CONTRACTOR WILL BE RESPONSIBLE FOR REMOVING AND STORING ANY SIGNS THAT ARE TO BE REINSTALLED ON THE PROJECT. ALL EQUIPMENT SHALL BE REINSTALLED IN GOOD CONDITION.
- EXISTING PERMANENT SIGNS AND POSTS REMOVED BY THE CONTRACTOR FOR CONSTRUCTION PURPOSES WHICH ARE NOT TO BE REINSTALLED SHALL BE DELIVERED TO THE CITY'S PUBLIC WORKS MAINTENANCE FACILITY (1971 SE HAMLEN ROAD). THE CONTRACTOR SHALL BE RESPONSIBLE FOR REMOVING AND STORING EQUIPMENT IN GOOD CONDITION AND IS FULLY RESPONSIBLE FOR THE EQUIPMENT UNTIL IT IS DELIVERED.
- ALL STOP, YIELD, OR STREET NAME SIGNS SHALL BE MAINTAINED IN A CONSPICUOUS LOCATION FOR THE DRIVING PUBLIC. ALL STOP AND YIELD SIGNS REMOVED FOR CONSTRUCTION PURPOSES CAN BE TEMPORARILY ERRECTED IN REFLECTORIZED DRUMS (NO LESS THAN 7 FEET ABOVE THE PAVEMENT SURFACE) UNTIL THEY CAN BE REINSTALLED. ANY TEMPORARY STOP OR YIELD SIGN INSTALLED TO BE LEFT IN PLACE OVERNIGHT WILL REQUIRE PRIOR APPROVAL FROM THE CITY INSPECTOR.



HORIZONTAL
60' 0 60' 120'
SCALE IN FEET SCALE: 1" = 60'


ALL SIGNAGE SHALL COMPLY WITH THE CITY OF LEE'S SUMMIT STANDARD DETAILS AND SPECIFICATIONS PER SECTION 3000 OF THE DESIGN AND CONSTRUCTION MANUAL. REFER TO DETAILS SHEET C410 AND C411.

LEGEND

- TYPICAL 28' ROADWAY PAVEMENT SECTION
- LONGVIEW BLVD. PAVEMENT SECTION
- 5' CONCRETE SIDEWALK
- RIPRAP OUTLET STABILIZATION
- RIGHT-OF-WAY
- ROAD CENTERLINE

AS-BUILT

The information provided on this drawing conforms to construction records; it is not intended for construction, implementation or recording purposes; and it is solely based on information provided by others / obtained by my firm. "AS-BUILT" information is not intended for construction, implementation or recording purposes. All other data is as designed and has not been field verified. Date: 03/24/2022 Certified by: GRC
Title: Project Engineer Firm: Anderson Engineering Inc.

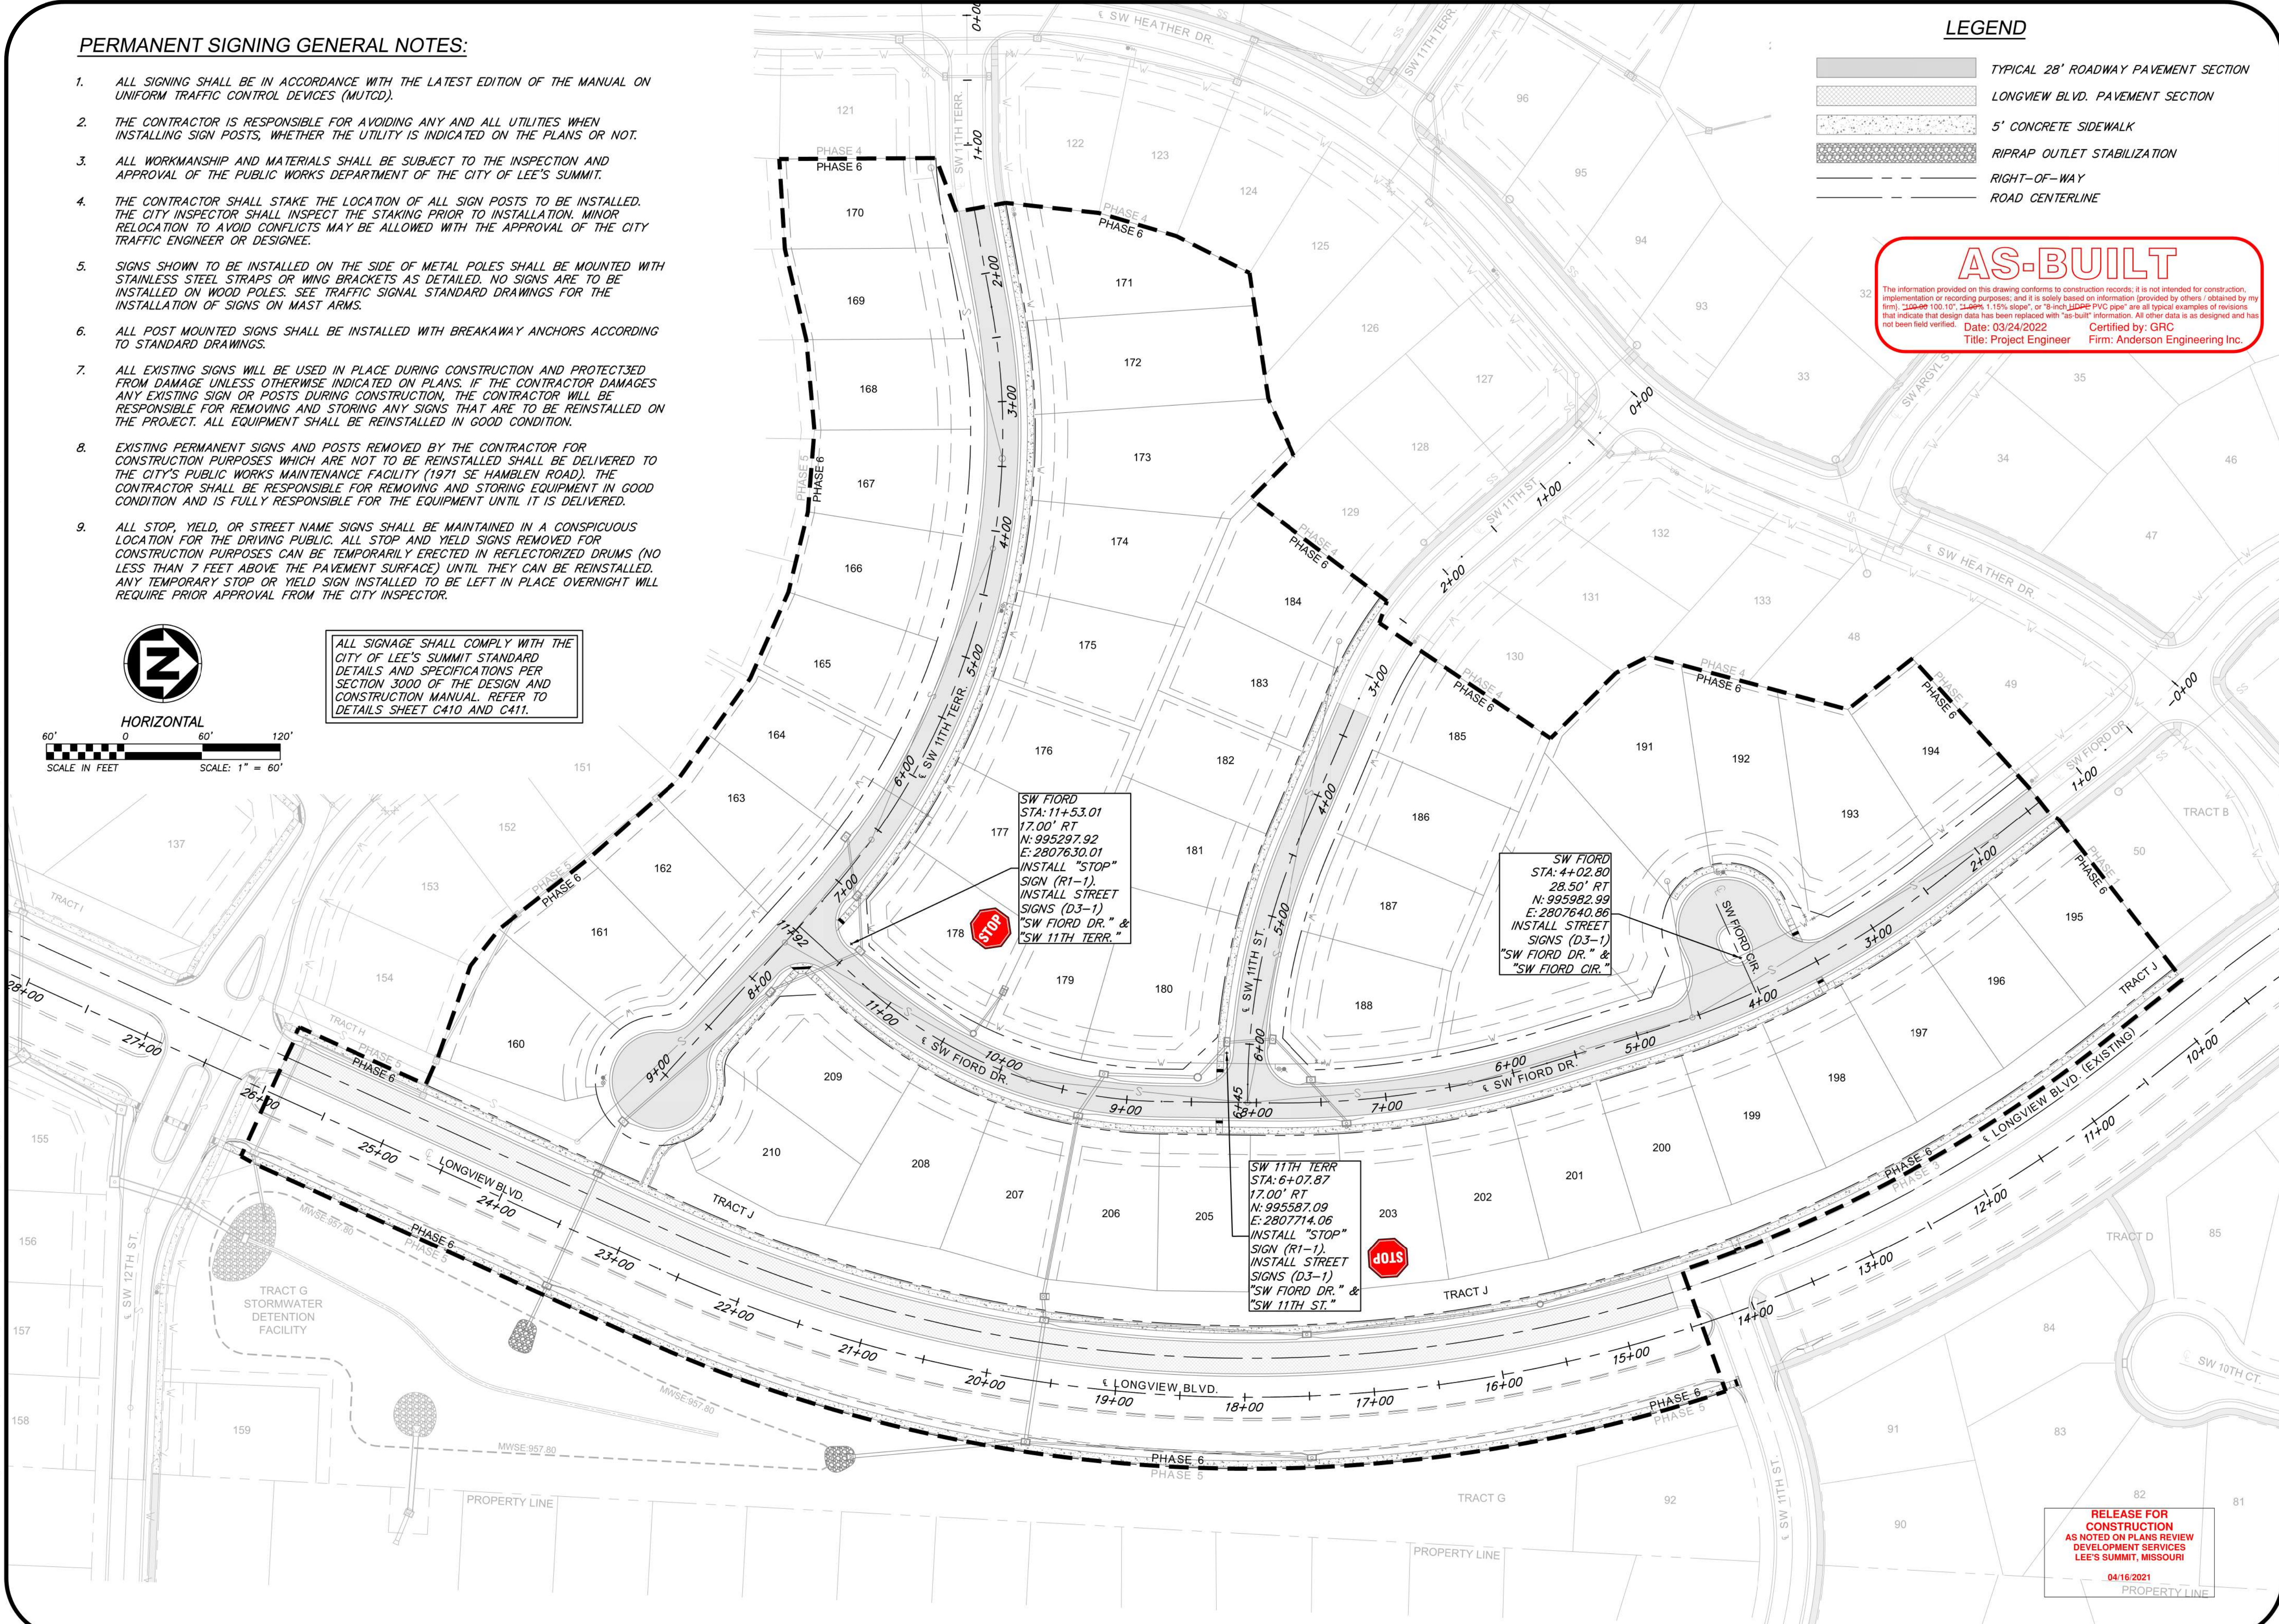

SW FIORD
STA: 11+53.01
17.00' RT
N: 995297.92
E: 2807630.01
INSTALL "STOP"
SIGN (R1-1).
INSTALL STREET
SIGNS (D3-1)
"SW FIORD DR." &
"SW 11TH TERR."

SW FIORD
STA: 4+02.80
28.50' RT
N: 995982.99
E: 2807640.86
INSTALL STREET
SIGNS (D3-1)
"SW FIORD DR." &
"SW FIORD CIR."

SW 11TH TERR
STA: 6+07.87
17.00' RT
N: 995587.09
E: 2807714.06
INSTALL "STOP"
SIGN (R1-1).
INSTALL STREET
SIGNS (D3-1)
"SW FIORD DR." &
"SW 11TH ST."

RELEASE FOR
CONSTRUCTION
AS NOTED ON PLANS REVIEW
DEVELOPMENT SERVICES
LEE'S SUMMIT, MISSOURI
04/16/2021
PROPERTY LINE

SUMMIT HOMES KC
HIGHLAND MEADOWS - 6TH PLAT

STREET SIGNAGE PLAN



SHEET NUMBER
C112
14 OF 42

REVISIONS		DRAWING INFO.	
NO.	DESCRIPTION	BY	DATE
1	REVISED PER CITY COMMENT	GC	2/11/21
2	AS-BUILT DRAWINGS	GC	3/16/22
		CHECK BY:	DATE:
		ZM	1/7/2021
		LICENSE NO.	ISSUED FOR:
		PE-2012009232	FOR REVIEW
		JOB NUMBER:	MO COA NO.
		20K10058	00062


© COPYRIGHT ANDERSON ENGINEERING, INC. 2020
S10, T47N, R22W
LEE'S SUMMIT, JACKSON COUNTY, MISSOURI

**ANDERSON
ENGINEERING**
EMPLOYEE OWNED

AE

ENGINEERS • SURVEYORS • LABORATORIES • DRILLING
941 W. 141ST TER • KANSAS CITY, MISSOURI 64145 • PHONE (816) 777-0400
A LICENSED MISSOURI ENGINEERING & SURVEYING CORPORATION - LC 82

Feb 11, 2021 - 6:07pm Plotted By: gscate G:\Shared drives\VC10 - Land Development\Projects\2020\20KCI0058 Highland Meadows - 6th Plat\01 CIVIL\03-DWG\Sheet\STREET AND STORM\20KCI0058 - SH1 - GRADING.dwg Layout: GRADING PLAN

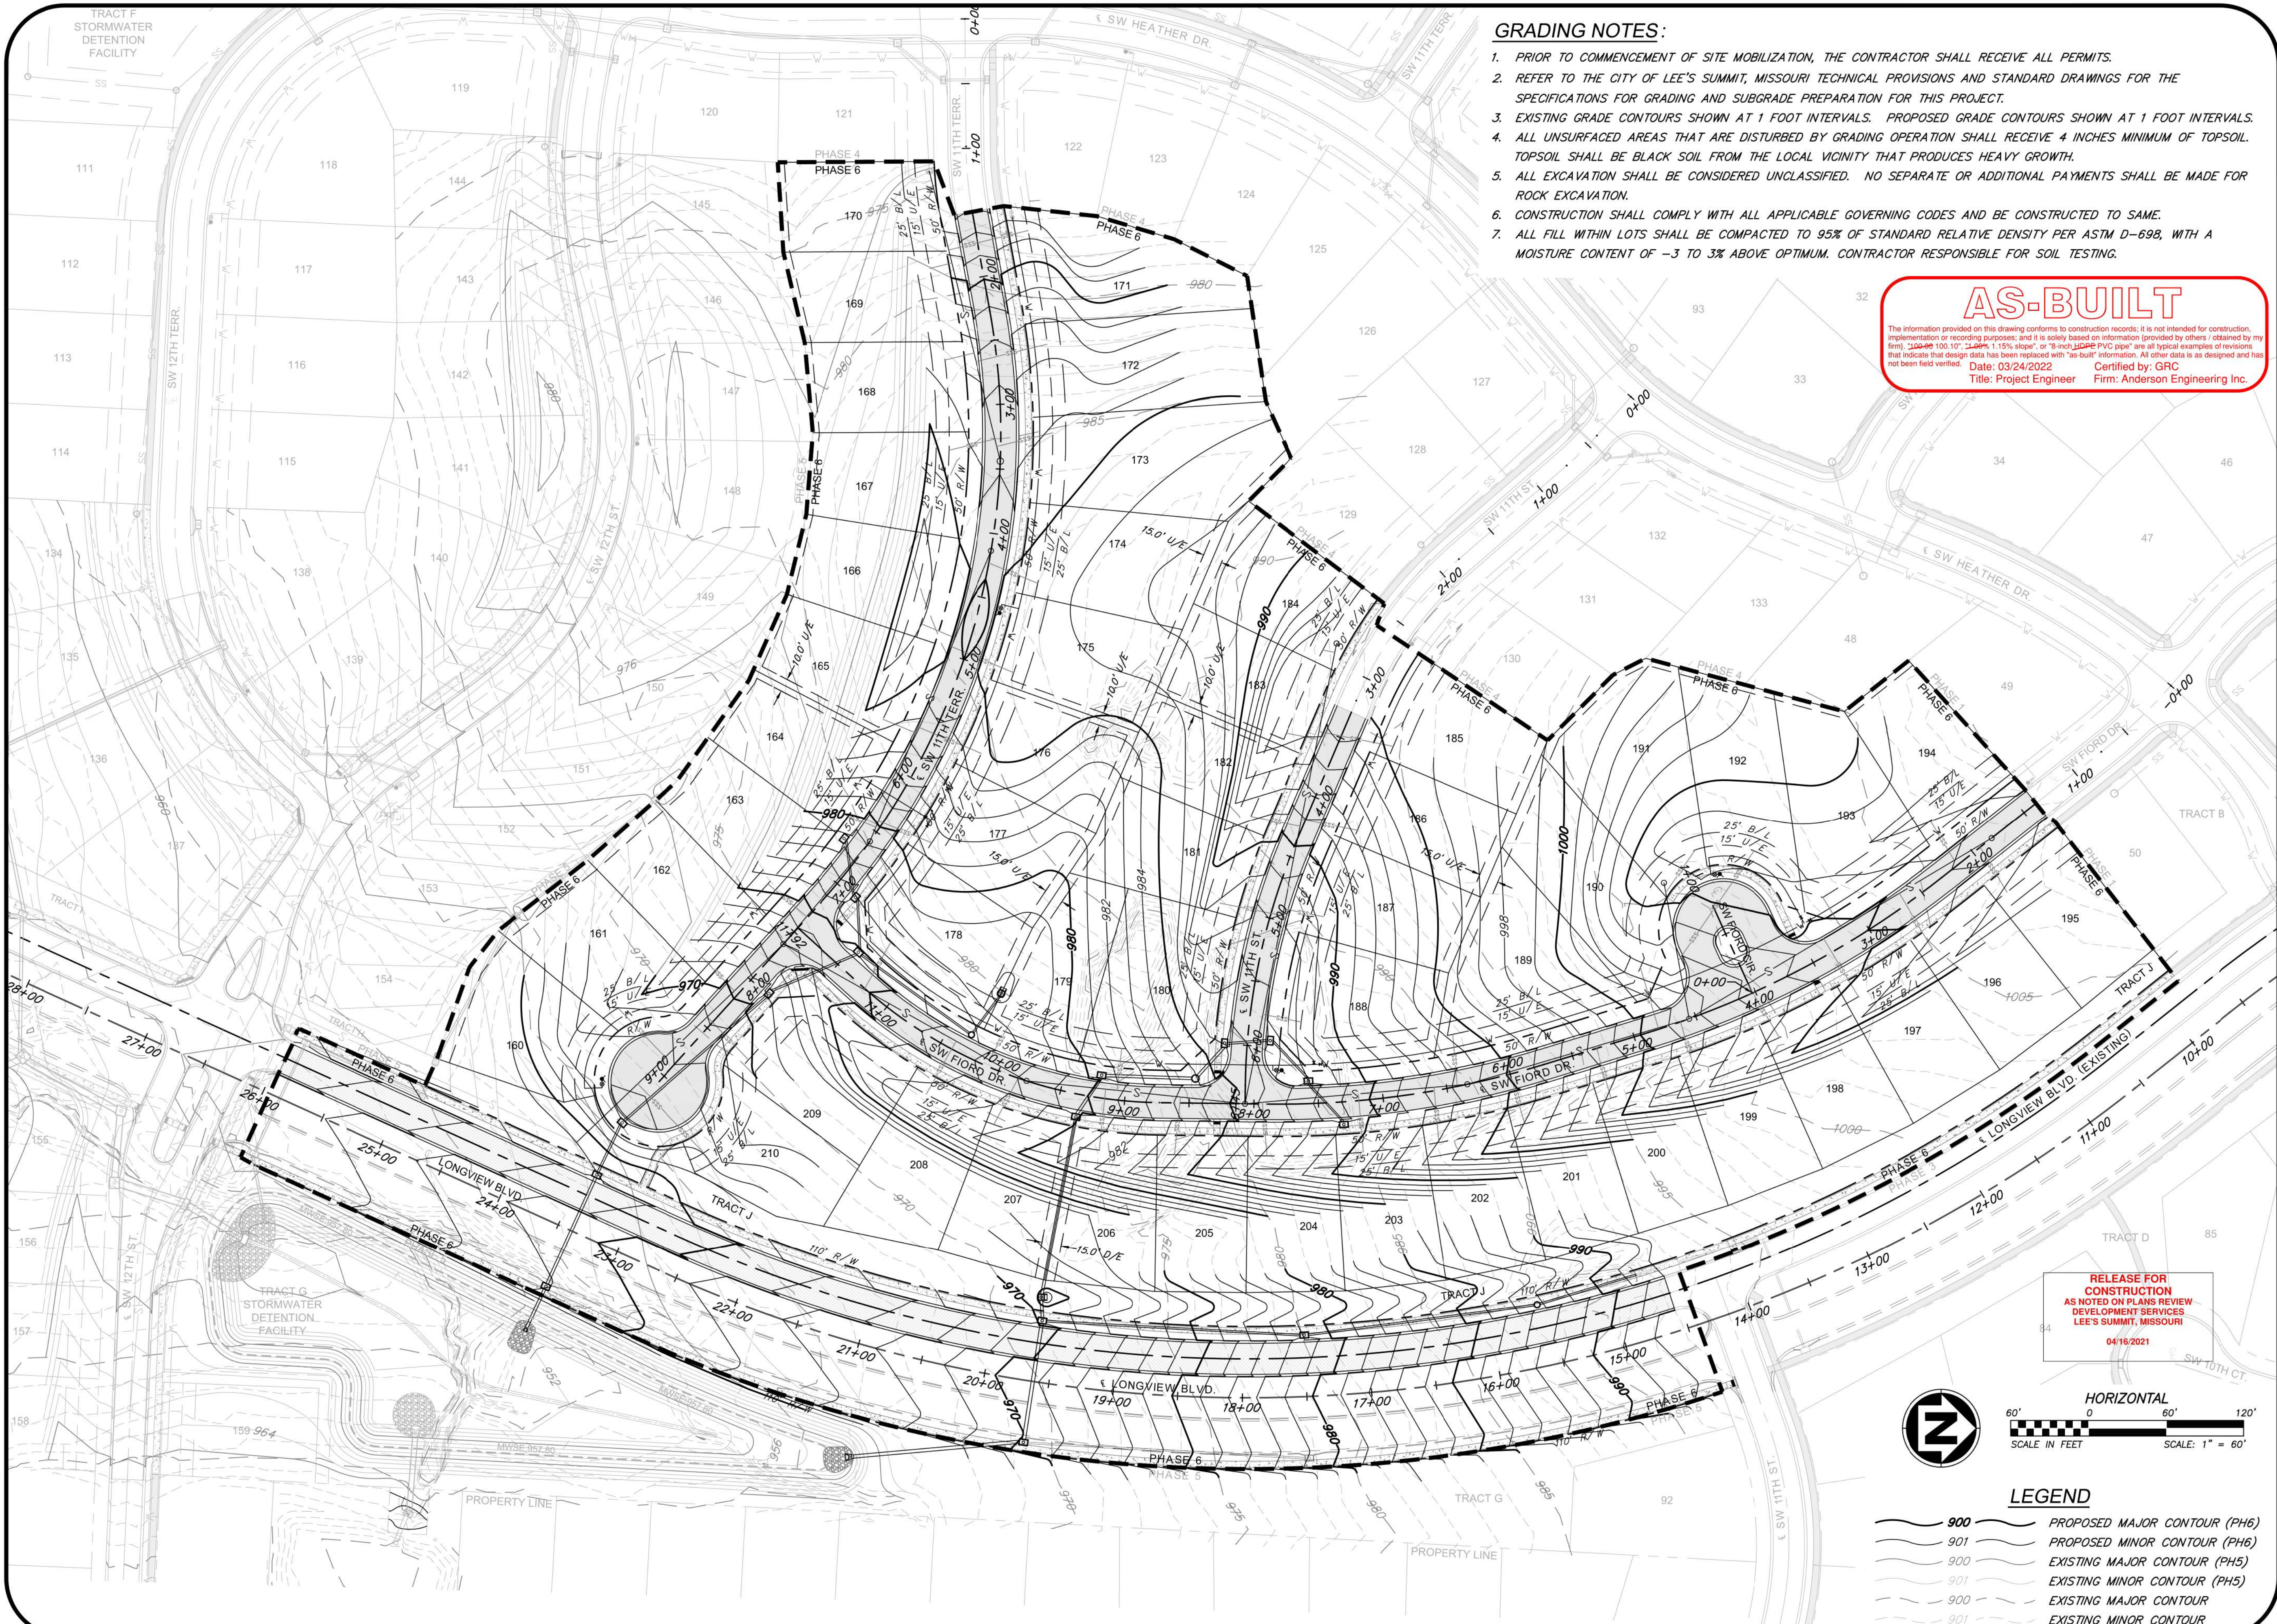

GRADING NOTES:

1. PRIOR TO COMMENCEMENT OF SITE MOBILIZATION, THE CONTRACTOR SHALL RECEIVE ALL PERMITS.
2. REFER TO THE CITY OF LEE'S SUMMIT, MISSOURI TECHNICAL PROVISIONS AND STANDARD DRAWINGS FOR THE SPECIFICATIONS FOR GRADING AND SUBGRADE PREPARATION FOR THIS PROJECT.
3. EXISTING GRADE CONTOURS SHOWN AT 1 FOOT INTERVALS. PROPOSED GRADE CONTOURS SHOWN AT 1 FOOT INTERVALS.
4. ALL UNSURFACED AREAS THAT ARE DISTURBED BY GRADING OPERATION SHALL RECEIVE 4 INCHES MINIMUM OF TOPSOIL. TOPSOIL SHALL BE BLACK SOIL FROM THE LOCAL VICINITY THAT PRODUCES HEAVY GROWTH.
5. ALL EXCAVATION SHALL BE CONSIDERED UNCLASSIFIED. NO SEPARATE OR ADDITIONAL PAYMENTS SHALL BE MADE FOR ROCK EXCAVATION.
6. CONSTRUCTION SHALL COMPLY WITH ALL APPLICABLE GOVERNING CODES AND BE CONSTRUCTED TO SAME.
7. ALL FILL WITHIN LOTS SHALL BE COMPACTED TO 95% OF STANDARD RELATIVE DENSITY PER ASTM D-698, WITH A MOISTURE CONTENT OF -3 TO 3% ABOVE OPTIMUM. CONTRACTOR RESPONSIBLE FOR SOIL TESTING.

AS-BUILT

The information provided on this drawing conforms to construction records; it is not intended for construction, implementation or recording purposes; and it is solely based on information provided by others / obtained by my firm. "AS-BUILT" drawings are all typical examples of revisions that indicate that design data has been replaced with "as-built" information. All other data is as designed and has not been field verified.
Date: 03/24/2022
Title: Project Engineer
Certified by: GRC
Firm: Anderson Engineering Inc.

REVISIONS		DRAWING INFO.	
NO.	DESCRIPTION	BY	DATE
1	REVISED PER CITY COMMENT	GC	2/11/21
2	AS-BUILT DRAWINGS	GC	3/16/22

NO.	DRAWN BY:	GC
CHECK BY:	ZM	
LICENSE NO.	PE-2012009232	
DATE:	1/7/2021	
ISSUED FOR:	FOR REVIEW	
JOB NUMBER:	20KCI0058	
MO COA NO.	00062	

© COPYRIGHT ANDERSON ENGINEERING, INC. 2020


SUMMIT HOMES KC
HIGHLAND MEADOWS - 6TH PLAT

GRADING PLAN

S10, T47N, R32W
LEE'S SUMMIT, JACKSON COUNTY, MISSOURI



SHEET NUMBER
C113
15 OF 42

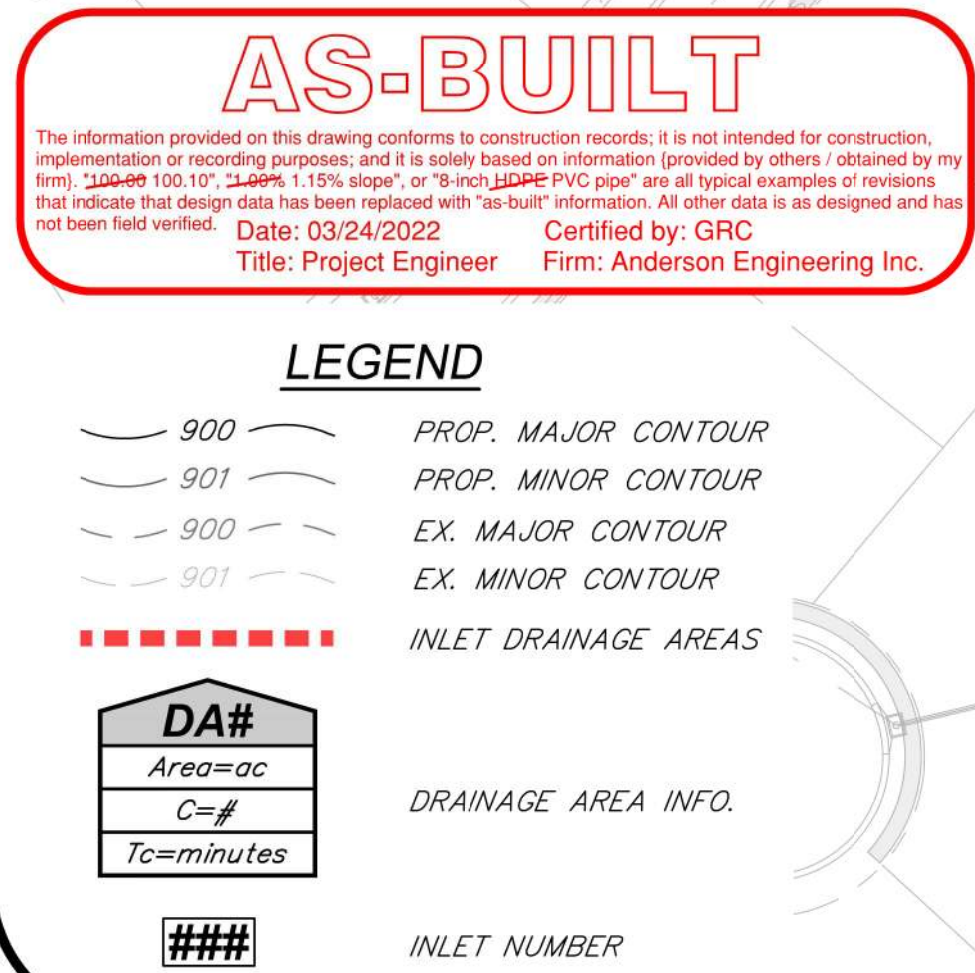

SUMMIT HOMES KC
HIGHLAND MEADOWS - 6TH PLAT

DRAINAGE AREA PLAN


SHEET NUMBER

C201

16 OF 42

S10, T47N, R32W

LEE'S SUMMIT, JACKSON COUNTY, MISSOURI




STORM SEWER DRAINAGE CALCULATIONS:

10-YEAR			HYDROLOGY																			HYDRAULICS																			GUTTER/INLET DESIGN						
Line No.	Inlet ID	Downstream Line No.	Drainage Area	Runoff Coefficient	Local CxA	System CxA	Tc	Local Intensity	System Intensity	Incremental Flow	Total Runoff	Line No.	Line	U/S Ground Elev.	U/S Invert	D/S Invert	Length	Slope	Size	n	Capacity Full	Total Runoff	Velocity	Velocity Out	HGLUp	HGLDn	Line ID	Local Q	QBypass	Gutter Slope	Gutter Spread	Gutter Width															
			(ac)	(C)			(min)	(in/hr)	(in/hr)	(cfs)	(cfs)			(ft)	(ft)	(ft)	(ft)	(%)	(in)		(cfs)	(cfs)	(ft/s)	(ft/s)	(ft)	(ft)		(cfs)	(cfs)	(ft/ft)	(ft)	(ft)															
1	601	Outfall	0.29	0.51	0.15	0.15	8.5	7.24	6.36	1.07	28.36	1	LINE 601	969.92	961.32	958.14	131.62	2.42	30	0.013	64.84	28.36	10.10	12.76	963.43	959.49	LINE 601	1.07	0.00	0.013	5.71	2.00															
2	602A	1	0.29	0.51	0.15	0.15	8.2	7.24	6.42	1.07	27.68	2	LINE 602A	970.19	962.99	962.12	95.00	0.92	30	0.013	41.01	27.68	8.16	8.97	964.86	963.62	LINE 602A	1.07	0.00	0.013	5.71	2.00															
3	602.1	2	1.13	0.51	0.58	0.58	7.3	7.24	6.64	4.17	6.03	3	LINE 602.1	979.08	973.48	963.34	202.76	5.00	18	0.012	25.44	6.03	4.42	3.72	974.66	964.86	LINE 602.1	2.96	1.21	0.013	10.38	2.00															
4	602.2	3	0.00	0.00	0.00	0.00	5.7	0.00	7.05	0.00	2.34	4	LINE 602.2	987.84	981.64	973.58	181.23	4.45	15	0.012	14.15	2.34	4.92	5.91	982.23	974.66	LINE 602.2															
5	602.3	4	0.65	0.51	0.33	0.33	5.0	7.24	7.24	2.40	2.40	5	LINE 602.3	989.41	987.98	982.11	79.70	7.37	15	0.012	18.97	2.40	7.27	10.58	988.60	982.42	LINE 602.3															
6	602B	2	1.04	0.51	0.53	0.53	6.2	7.24	6.90	3.84	22.50	6	LINE 602B	968.91	963.86	963.29	18.00	3.16	24	0.012	34.65	22.49	9.21	10.48	965.62	964.86	LINE 602B	3.84															
7	603	6	0.40	0.51	0.20	0.20	5.8	7.24	7.01	1.48	19.13	7	LINE 603	979.99	971.99	964.21	142.00	5.48	24	0.012	57.46	19.12	8.52	9.82	973.81	965.62	LINE 603	2.72	0.88	0.013	9.76	2.00															
8	604	7	0.33	0.51	0.17	0.17	5.7	7.24	7.04	1.22	17.77	8	LINE 604	980.54	973.63	972.47	37.71	3.08	24	0.013	42.32	17.77	8.66	10.37	975.58	973.81	LINE 604	3.83	2.98	0.013	12.64	2.00															
9	605	8	0.00	0.00	0.00	0.00	5.5	0.00	7.10	0.00	16.74	9	LINE 605	983.99	975.19	974.04	73.00	1.58	24	0.012	24.50	16.74	7.57	8.39	976.76	975.77	LINE 605															
10	606	9	0.64	0.51	0.33	0.33	5.4	7.24	7.14	2.36	16.81	10	LINE 606	986.20	976.75	975.79	35.29	2.72	24	0.012	42.47	16.81	8.92	11.07	978.33	976.76	LINE 606	1.72	0.64	0.020	7.44	2.00															
11	607	10	1.28	0.51	0.65	0.65	5.3	7.24	7.16	4.73	14.53	11	LINE 607	986.64	978.94	977.15	35.33	5.07	18	0.013	23.50	14.53	10.20	11.92	980.51	978.33	LINE 607	2.50	2.23	0.020	10.00	2.00															
12	608	11	1.46	0.51	0.74	0.74	5.2	7.24	7.18	5.39	9.89	12	LINE 608	988.04	980.29	979.44	43.04	1.97	15	0.012	9.89	9.89	8.71	9.18	981.66	980.64	LINE 608	2.67	2.72	0.020	10.55	2.00															
13	609	12	1.24	0.51	0.63	0.63	5.0	7.24	7.24	4.58	4.58	13	LINE 609	989.30	983.10	980.94	43.36	4.98	15	0.013	14.45	4.58	5.87	6.70	984.02	981.66	LINE 609	2.46	2.12	0.020	9.87	2.00															
14	501	Outfall	0.50	0.51	0.26	0.26	7.3	7.24	6.62	1.85	16.78	14	LINE 501	963.85	954.85	952.65	35.12	6.26	24	0.013	59.74	16.78	11.54	16.32	956.62	953.42	LINE 501	1.75	0.09	0.013	7.34	2.00															
15	502	14	1.24	0.51	0.63	0.63	7.0	7.24	6.70	4.58	15.28	15	LINE 502	963.94	957.94	955.50	95.00	2.44	24	0.012	38.78	15.28	8.25	10.04	959.43	956.62	LINE 502	3.11	1.47	0.013	10.78	2.00															
16	503	15	0.88	0.51	0.45	0.45	6.9	7.24	6.73	3.25	11.09	16	LINE 503	966.82	958.82	958.39	44.61	2.72	18	0.012	11.43	11.09	7.15	7.37	960.24	959.71	LINE 503	6.41															
17	504	16	0.50	0.51	0.26	0.26	6.3	7.24	6.87	1.85	8.23	17	LINE 504	971.10	965.75	959.32	151.01	4.92	18	0.013	21.24	8.23	7.42	8.96	966.76	960.24	LINE 504	2.11	2.92	0.060	8.14	2.00															
18	505	17	0.31	0.51	0.16	0.16	6.1	7.24	6.93	1.14	6.54	18	LINE 505	975.28	968.53	965.95	76.10	3.39	15	0.013	11.18	6.54	7.76	9.46	969.46	966.84	LINE 505	2.33	1.79	0.020	9.45	2.00															
19	506	18	0.46	0.51	0.23	0.23	5.8	7.24	7.01	1.70	2.79	19	LINE 506	977.07	971.57	968.98	42.38	5.85	15	0.012	17.13	2.79	4.91	5.65	972.14	969.46	LINE 506	1.19	0.51	0.060	4.90	2.00															
20	507	19	0.32	0.51	0.16	0.16	5.0	7.24	7.24	1.18	1.18	20	LINE 507	978.80	973.30	972.07	46.24	2.66	15	0.013	11.20	1.18	4.55	5.92	973.79	972.24	LINE 507	0.95	0.24	0.060	4.02	2.00															
21	505.1	18	0.00	0.00	0.00	0.00	5.3	0.00	7.15	0.00	2.77	21	LINE 505.1	976.72	969.42	969.09	107.92	0.31	15	0.012	4.95	2.77	4.14	4.14	970.14	969.60	LINE 505.1															
22	505.2	21	0.76	0.51	0.39	0.39	5.0	7.24	7.24	2.81	2.81	22	LINE 505.2	977.13	970.13	969.92	39.58	0.53	15	0.012	4.97	2.81	4.16	4.17	970.85	970.64	LINE 505.2	2.81															

100-YEAR			HYDROLOGY																			HYDRAULICS																			GUTTER/INLET DESIGN						
Line No.	Inlet ID	Downstream Line No.	Drainage Area	Runoff Coefficient	Local CxA	System CxA	Tc	Local Intensity	System Intensity	Incremental Flow	Total Runoff	Line No.	Line	U/S Ground Elev.	U/S Invert	D/S Invert	Length	Slope	Size	n	Capacity Full	Total Runoff	Velocity	Velocity Out	HGLUp	HGLDn	Line ID	Local Q	QBypass	Gutter Slope	Gutter Spread	Gutter Width															
			(ac)	(C)			(min)	(in/hr)	(in/hr)	(cfs)	(cfs)			(ft)	(ft)	(ft)	(ft)	(%)	(in)		(cfs)	(cfs)	(ft/s)	(ft/s)	(ft)	(ft)		(cfs)	(cfs)	(ft/ft)	(ft)	(ft)															
1	601	Outfall	0.29	0.51	0.15	0.15	7.6	9.83	9.01	1.45	40.22	1	LINE 601	969.92	961.32	958.14	131.62	2.42	30	0.013	64.84	40.22	9.02	9.02	963.75	960.46	LINE 601	1.44	0.01	0.013	6.59	2.00															
2	602A	1	0.29	0.51	0.15	0.15	7.4	9.83	9.07	1.45	39.14	2	LINE 602A	970.19	962.99	962.12	95.00	0.92	30	0.013	41.01	39.14	9.18	9.51	965.18	964.07	LINE 602A	1.44	0.01	0.013	6.59	2.00															
3	602.1	2	1.13	0.51	0.58	0.58	6.7	9.83	9.28	5.67	8.43	3	LINE 602.1	979.08	973.48	963.34	202.76	5.00	18	0.012	25.44	8.43	5.35	4.77	974.83	965.18	LINE 602.1	3.49	2.18	0.013	11.75	2.00															
4	602.2	3	0.00	0.00	0.00	0.00	5.5	0.00	9.66	0.00	3.20	4	LINE 602.2	987.84	981.64	973.58	181.23	4.45	15	0.012	14.15	3.20	4.81	5.24	982.34	974.83	LINE 602.2															
5	602.3	4	0.65	0.51	0.33	0.33	5.0	9.83	9.83	3.26	3.26	5	LINE 602.3	989.41	987.98	982.11	79.70	7.37	15	0.012	18.97	3.26	7.98	11.56	988.71	982.47	LINE 602.3															
6	602B	2	1.04	0.51	0.53	0.53	5.9	9.83	9.53	5.22	31.06	6	LINE 602B	968.91	963.86	963.29	18.00	3.16	24	0.012	34.65	31.06	10.81	11.47	965.81	965.18	LINE 602B	5.22															
7	603	6	0.40	0.51	0.20	0.20	5.6	9.83	9.63	2.01	26.27	7	LINE 603	979.99	971.99	964.21	142.00	5.48	24	0.012	57.46	26.27	10.12	11.39	974.03	965.81	LINE 603	3.39	1.98	0.013	11.49	2.00															
8	604	7	0.33	0.51	0.17	0.17	5.5	9.83	9.66	1.65	24.37	8	LINE 604	980.54	973.63	972.47	37.71	3.08	24	0.013	42.32	24.37	9.88	11.37	975.80	974.03	LINE 604	4.75	5.82	0.013	15.04	2.00															
9	605	8	0.00	0.00	0.00	0.00	5.3	0.00	9.71	0.00	22.89	9	LINE 605	983.99	975.19	974.04	73.00	1.58	24	0.012	24.50	22.89	8.45	8.86	976.99	976.09	LINE 605															
10	606	9	0.64	0.51	0.33	0.33	5.3	9.83	9.74	3.21	22.95	10	LINE 606	986.20	976.75	975.79	35.29	2.72	24	0.012	42.47	22.95	9.85	11.64	978.55	976.99	LINE 606	2.04	1.17	0.020	8.50	2.00															
11	607	10	1.28	0.																																											

Feb 11, 2021 - 6:08pm Plotted By: gscate G:\Shared drives\VC10 - Land Development\Projects\2020\20K10058 Highland Meadows - 6th Plat\01 CIV\3-DWG\Sheet\STREET AND STORM\20K10058 - SH1 - STORM PIP.dwg Layout: STORM SEWER 602.1 SERIES PLAN & PROFILE


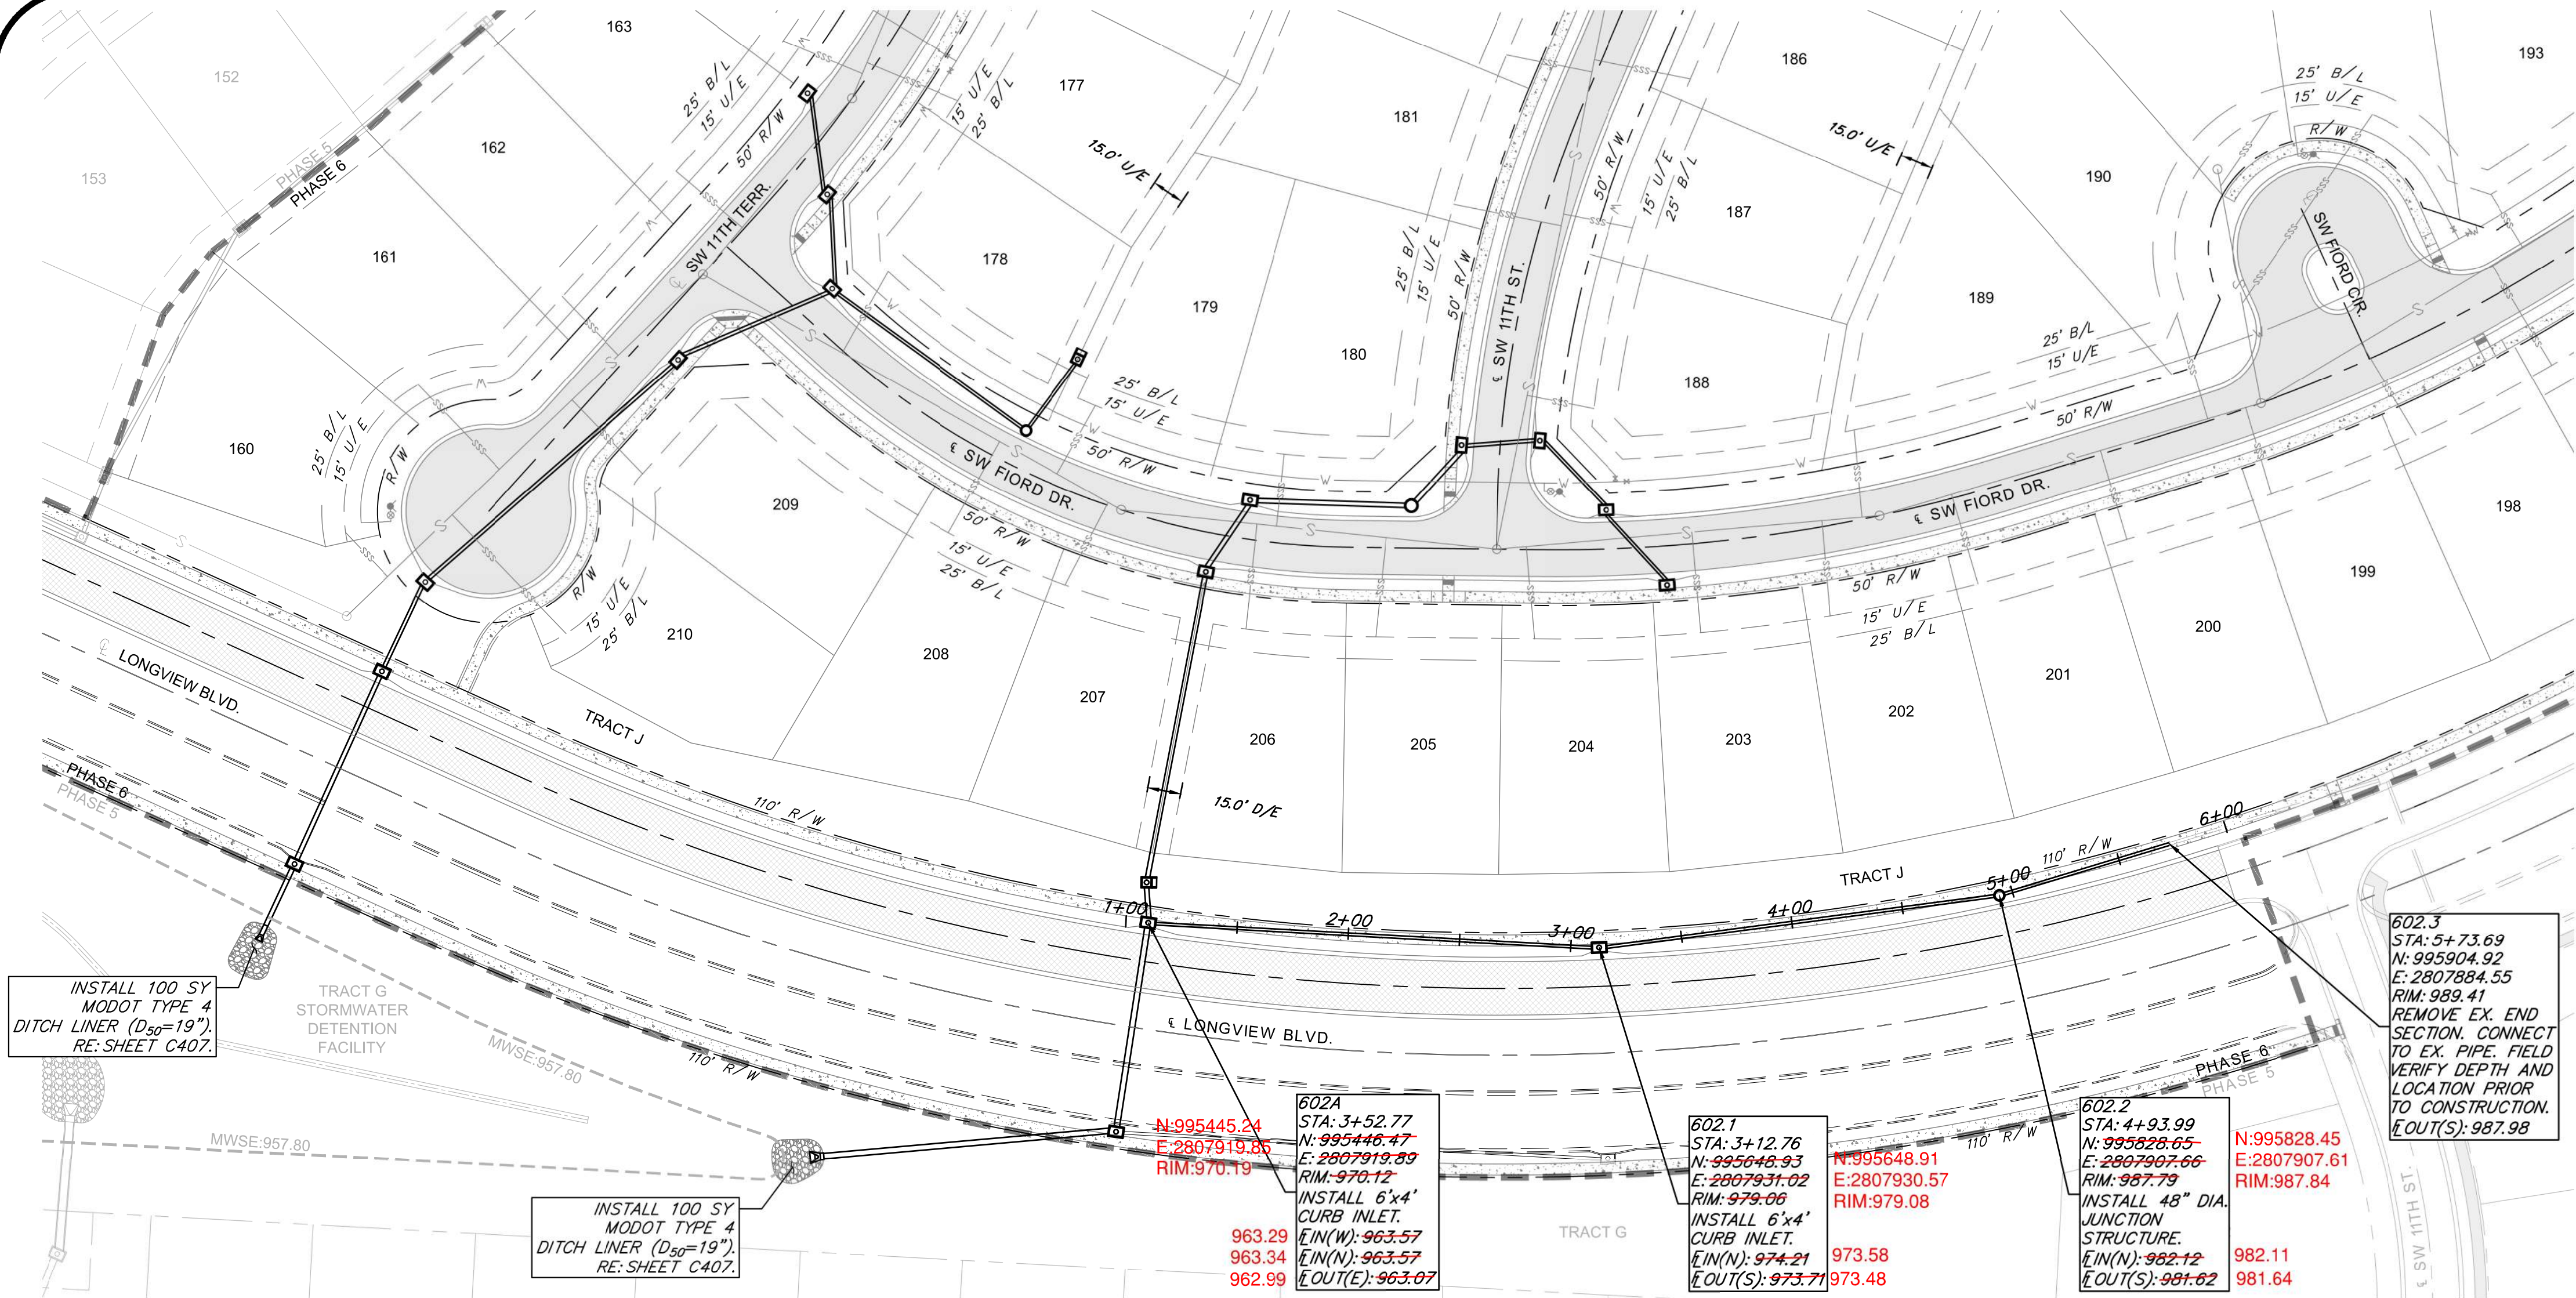


LEGEND

RIP RAP
FILL PRIOR TO PIPE INSTALLATION

- STORM PIPE AND STRUCTURES:**
- HDPE PIPE SHALL CONFORM TO ASTM F2306. JOINTS SHALL BE INTEGRAL BELL AND SPIGOT WITH RUBBER GASKETS. JOINTS SHALL BE WATER TIGHT AS DEMAND BY ASTM F2306.
 - CONCRETE PIPE SHALL CONFORM TO ASTM C76, CLASS III, WALL TYPE B. JOINTS SHALL BE TONGUE-IN-GROOVE WITH PREFORMED, FLEXIBLE SEALANTS AND SHALL CONFORM TO ASTM C990.
 - PROPOSED CURB INLETS AND JUNCTION BOXES SHALL CONFORM TO THE CITY OF LEE'S SUMMIT STANDARD DETAILS.

- GENERAL NOTES:**
- COORDINATES AT TOP ELEVATIONS SHOWN ARE LOCATED AT CENTER OF STRUCTURES. ROAD OFFSETS AREA AT INSIDE FACE OF CURB INLETS, AND AT CENTER OF MANHOLES AND JUNCTIONS BOXES.
 - PIPE LENGTHS INDICATED ARE FROM CENTER OF STRUCTURE TO CENTER OF STRUCTURE.
 - INSIDE FRONT FACE OF CURB INLETS SHALL BE LOCATED 1.5 FEET BEHIND BACK OF CURB. STRUCTURE SHALL BE PARALLEL WITH CURB ALIGNMENT.
 - TOP ELEVATION OF CURB INLETS SHALL BE SLOPED TO CONFORM TO GRADE OF STREET.
 - WATER MAINS AND STORM SEWERS SHALL HAVE AT LEAST 3' OF CLEAR HORIZONTAL SEPARATION.
 - CONTROLLED FILL: PRIOR TO INSTALLATION OF STORM SEWER PIPING IN FILL AREAS, FILL SHALL BE PLACED AND COMPACTED TO A MINIMUM 95% OF STANDARD PROCTOR DENSITY PER ASTM D 698 TO A MINIMUM DEPTH OF 2 FEET ABOVE THE TOP OF PIPE.

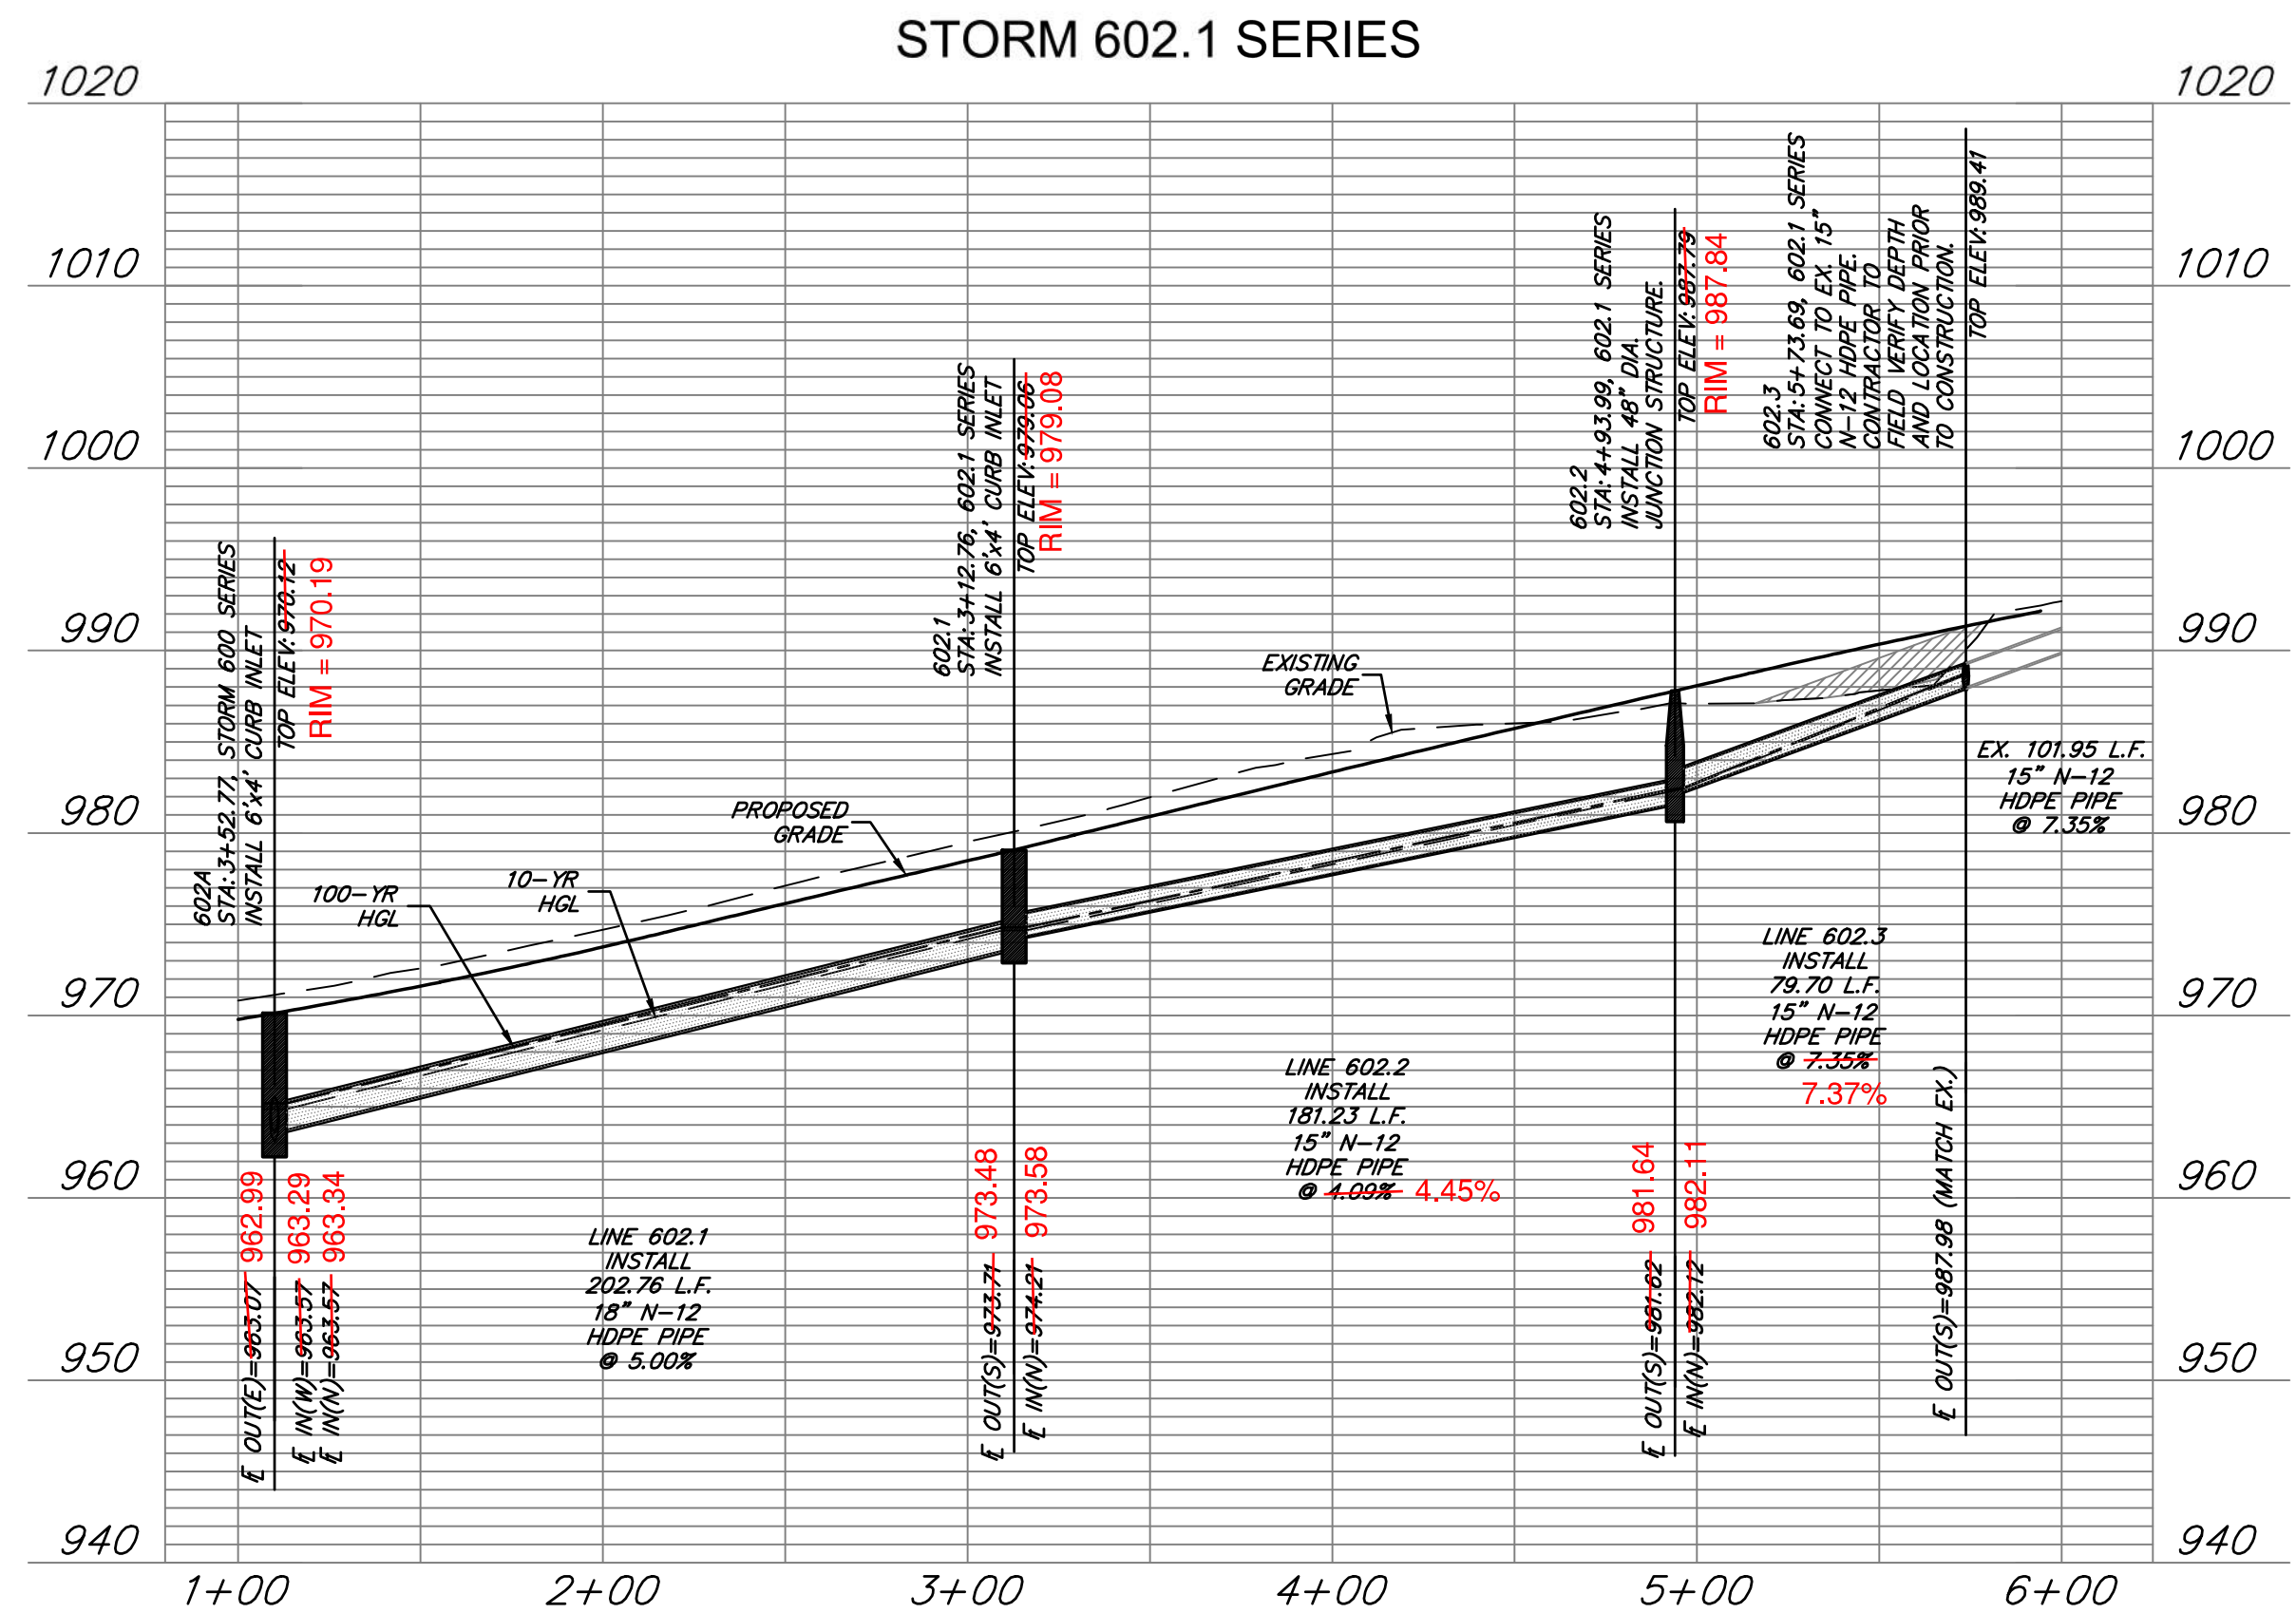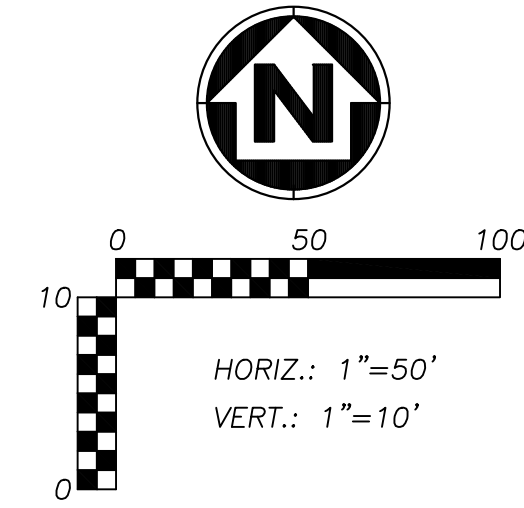

AS-BUILT

The information provided on this drawing conforms to construction records; it is not intended for construction, implementation or recording purposes, and it is solely based on information provided by others / obtained by my firm. (100'± 100.10', 1.00%± 1.15% slope), or "8-inch HDPE PVC pipe" are all typical examples of revisions that indicate that design data has been replaced with "as-built" information. All other data is as designed and has not been field verified.

Date: 03/24/2022
Title: Project Engineer
Certified by: GRC
Firm: Anderson Engineering Inc.

RELEASE FOR CONSTRUCTION
AS NOTED ON PLANS REVIEW
DEVELOPMENT SERVICES
LEE'S SUMMIT, MISSOURI
04/16/2021

ANDERSON ENGINEERING
EMPLOYEE OWNED

ENGINEERS • SURVEYORS • LABORATORIES • DRILLING
941 W. 141ST TER • KANSAS CITY, MISSOURI 64145 • PHONE (816) 777-0400
A LICENSED MISSOURI ENGINEERING & SURVEYING CORPORATION - LC 62

DRAWING INFO.		REVISIONS		BY		DATE		DRAWN BY:		CHECK BY:	
NO.	DESCRIPTION	NO.	DESCRIPTION	NO.	DESCRIPTION	NO.	DESCRIPTION	NO.	DESCRIPTION	NO.	DESCRIPTION
1	REVISED PER CITY COMMENT	1	REVISED PER CITY COMMENT	GC	2/11/21	GC	2/11/21	GC	2/11/21	GC	2/11/21
2	AS-BUILT DRAWINGS	2	AS-BUILT DRAWINGS	GC	3/16/22	GC	3/16/22	GC	3/16/22	GC	3/16/22

SUMMIT HOMES KC
HIGHLAND MEADOWS - 6TH PLAT

**STORM SEWER 602.1 SERIES
PLAN & PROFILE**

S10, T47N, R2W
LEE'S SUMMIT, JACKSON COUNTY, MISSOURI

STATE OF MISSOURI
ZACH A. MYERS
Professional Engineer
NUMBER 2012009232
2/14/21

SHEET NUMBER
C205
20 OF 42

Feb 11, 2021 - 6:08pm Plotted By: gscite G:\Shared drives\KC10 - Land Development\Projects\2020\20K10058 Highland Meadows - 6th Plat\01 CIVIL\03-DWG\Sheet\STREET AND STORM\20K10058 - SVTS - EROSION.dwg Layout: PRE-CLEARING EROSION CONTROL PLAN

EROSION CONTROL MAINTENANCE:

ALL MEASURES STATED ON THIS SITE MAP, AND IN THE STORM WATER POLLUTION PREVENTION PLAN, SHALL BE MAINTAINED IN FULLY FUNCTIONAL CONDITION UNTIL NO LONGER REQUIRED FOR A COMPLETED PHASE OF WORK OR FINAL STABILIZATION OF THE SITE. ALL EROSION AND SEDIMENTATION CONTROL MEASURES SHALL BE CHECKED BY A QUALIFIED PERSON IN ACCORDANCE WITH THE CONTRACT DOCUMENTS OR THE APPLICABLE PERMIT, WHICHEVER IS MORE STRINGENT, AND REPAIRED IN ACCORDANCE WITH THE FOLLOWING:

- AT A MINIMUM, THE CONTRACTOR SHALL FOLLOW THE REQUIREMENTS FOR GOOD HOUSEKEEPING, SPILL CONTROL AND EROSION AND SEDIMENT CONTROL AS SPECIFIED IN THE KANSAS CITY METROPOLITAN CHAPTER OF THE AMERICAN PUBLIC WORKS ASSOCIATION SECTION 2150.
- INLET PROTECTION DEVICES AND BARRIERS SHALL BE REPAIRED OR REPLACED IF THEY SHOW SIGNS OF UNDERMINING OR DETERIORATION.
- ALL SEEDED AREAS SHALL BE CHECKED REGULARLY TO SEE THAT A GOOD STAND IS MAINTAINED. AREAS SHOULD BE FERTILIZED, WATERED, AND RESEED AS NEEDED.
- SILT FENCES SHALL BE REPAIRED TO THEIR ORIGINAL CONDITIONS IF DAMAGED. SEDIMENT SHALL BE REMOVED FROM THE SILT FENCES WHEN IT REACHES ONE-HALF THE HEIGHT OF THE SILT FENCE.
- THE CONSTRUCTION EXITS SHALL BE MAINTAINED IN A CONDITION WHICH WILL PREVENT TRACKING OR FLOW OF MUD ONTO PUBLIC RIGHTS-OF-WAY. THIS MAY REQUIRE PERIODIC TOP DRESSING OF THE CONSTRUCTION EXITS AS CONDITIONS DEMAND.
- THE TEMPORARY PARKING AND STORAGE AREA SHALL BE KEPT IN GOOD CONDITION (SUITABLE FOR PARKING AND STORAGE). THIS MAY REQUIRE PERIODIC TOP DRESSING OF THE TEMPORARY PARKING AREA AS CONDITIONS DEMAND.
- DRAINAGE SWALES WITH SLOPES STEEPER THAN 15% SHALL BE INSPECTED AFTER EACH RAINFALL EVENT. THESE CHANNELS AND SLOPES SHOULD BE TREATED WITH EROSION FABRIC. IF THE CHANNELS OR SLOPES SHOW ANY SIGN OF FAILURE, COORDINATE WITH THE ENGINEER TO DEVELOP A PLAN TO RE-STABILIZE THE FAILED AREA.

SEQUENCE OF CONSTRUCTION:

SITE IMPROVEMENTS CONSIST OF CLEARING VEGETATION AND MASS GRADING OPERATIONS. WORK SHALL BE CONDUCTED AS FOLLOWS:

- INSTALL CONSTRUCTION VEHICLE ENTRANCE/EXIT AND PERIMETER SILT FENCE AND/OR TEMPORARY ROCK DIVERSION BERM. INSTALL INLET PROTECTION AROUND ANY EXISTING STORM INLETS IN THE VICINITY.
- CLEAR ANY TREES, VEGETATION, AND DEBRIS WHERE PHASE I GRADING OPERATIONS WILL BE COMPLETED. ONLY REMOVE THOSE TREES NECESSARY TO ACCOMPLISH GRADING ACTIVITIES AS SHOWN ON PLAN.
- INSTALL SILT FENCE AT TOE OF SLOPE ALONG PERIMETER OF PHASE I AREAS AND SLOPE INTERRUPTS AS NECESSARY TO PREVENT MUD AND SILT FROM RUNNING LONG DISTANCES ACROSS THE SITE. PHASE II ACTIVITIES CANNOT BEGIN UNTIL PHASE I IS COMPLETED.
- CLEAR REMAINING TREES AND VEGETATION WHERE PHASE II GRADING OPERATIONS WILL BE COMPLETED. ONLY REMOVE THOSE TREES NECESSARY TO ACCOMPLISH GRADING ACTIVITIES AS SHOWN ON PLAN.
- AS GRADING OPERATIONS ARE COMPLETED, AREAS TO REMAIN INACTIVE FOR MORE THAN 14 DAYS SHALL BE STABILIZED WITH SEED AND COMPOST MULCH AND/OR STEEP SLOPE PROTECTION. SEE INTERMEDIATE EROSION CONTROL PLAN (C302).

FEMA NOTES:

THE SUBJECT PROPERTY IS DETERMINED TO BE OUTSIDE THE 0.2% ANNUAL CHANCE FLOODPLAIN ACCORDING TO MAP ITEM NUMBER: 2903SC0418C. EFFECTIVE DATE: 1/20/2017

GENERAL NOTES:

ALL MEASURES STATED ON THIS SITE MAP, AND IN THE STORM WATER POLLUTION PREVENTION PLAN, SHALL BE MAINTAINED IN FULLY FUNCTIONAL CONDITION UNTIL NO LONGER REQUIRED FOR A COMPLETED PHASE OF WORK OR FINAL STABILIZATION OF THE SITE. ALL EROSION AND SEDIMENTATION CONTROL MEASURES SHALL BE CHECKED BY A QUALIFIED PERSON IN ACCORDANCE WITH THE CONTRACT DOCUMENTS OR THE APPLICABLE PERMIT, WHICHEVER IS MORE STRINGENT, AND REPAIRED IN ACCORDANCE WITH THE FOLLOWING:

- AT A MINIMUM, THE CONTRACTOR SHALL FOLLOW THE REQUIREMENTS FOR GOOD HOUSEKEEPING, SPILL CONTROL AND EROSION AND SEDIMENT CONTROL AS SPECIFIED IN THE KANSAS CITY METROPOLITAN CHAPTER OF THE AMERICAN PUBLIC WORKS ASSOCIATION SECTION 2150.
- INLET PROTECTION DEVICES AND BARRIERS SHALL BE REPAIRED OR REPLACED IF THEY SHOW SIGNS OF UNDERMINING OR DETERIORATION.
- ALL SEEDED AREAS SHALL BE CHECKED REGULARLY TO SEE THAT A GOOD STAND IS MAINTAINED. AREAS SHOULD BE FERTILIZED, WATERED, AND RESEED AS NEEDED.
- SILT FENCES SHALL BE REPAIRED TO THEIR ORIGINAL CONDITIONS IF DAMAGED. SEDIMENT SHALL BE REMOVED FROM THE SILT FENCES WHEN IT REACHES ONE-HALF THE HEIGHT OF THE SILT FENCE.
- THE CONSTRUCTION EXITS SHALL BE MAINTAINED IN A CONDITION WHICH WILL PREVENT TRACKING OR FLOW OF MUD ONTO PUBLIC RIGHTS-OF-WAY. THIS MAY REQUIRE PERIODIC TOP DRESSING OF THE CONSTRUCTION EXITS AS CONDITIONS DEMAND.
- THE TEMPORARY PARKING AND STORAGE AREA SHALL BE KEPT IN GOOD CONDITION (SUITABLE FOR PARKING AND STORAGE). THIS MAY REQUIRE PERIODIC TOP DRESSING OF THE TEMPORARY PARKING AREA AS CONDITIONS DEMAND.
- DRAINAGE SWALES WITH SLOPES STEEPER THAN 15% SHALL BE INSPECTED AFTER EACH RAINFALL EVENT. THESE CHANNELS AND SLOPES SHOULD BE TREATED WITH EROSION FABRIC. IF THE CHANNELS OR SLOPES SHOW ANY SIGN OF FAILURE, COORDINATE WITH THE ENGINEER TO DEVELOP A PLAN TO RE-STABILIZE THE FAILED AREA.

GENERAL EROSION CONTROL NOTES:

- THE STORMWATER POLLUTION PREVENTION PLAN IS COMPRISED OF THIS DRAWING ("EROSION CONTROL"), THE STANDARD DETAILS, ATTACHMENTS INCLUDED IN SPECIFICATIONS ("SWPPP"), PLUS THE PERMIT AND ALL SUBSEQUENT REPORTS AND RELATED DOCUMENTS.
- ALL CONTRACTORS AND SUBCONTRACTORS INVOLVED WITH STORMWATER POLLUTION PREVENTION SHALL OBTAIN A COPY OF THE STORM WATER POLLUTION PREVENTION PLAN AND THE STATE OR NATIONAL POLLUTANT DISCHARGE ELIMINATION SYSTEM GENERAL PERMIT (NPDES PERMIT) AND BECOME FAMILIAR WITH THEIR CONTENTS.
- CONTRACTOR SHALL IMPLEMENT BEST MANAGEMENT PRACTICES AS REQUIRED BY THE SWPPP. ADDITIONAL BEST MANAGEMENT PRACTICES SHALL BE IMPLEMENTED AS DICTATED BY CONDITIONS AT NO ADDITIONAL COST OF OWNER THROUGHOUT ALL PHASES OF CONSTRUCTION.
- BEST MANAGEMENT PRACTICES (BMP'S) AND CONTROLS SHALL CONFORM TO FEDERAL, STATE, OR LOCAL REQUIREMENTS OR MANUAL OF PRACTICES, AS APPLICABLE. CONTRACTOR SHALL IMPLEMENT ADDITIONAL CONTROLS AS DIRECTED BY PERMITTING AGENCY OR OWNER.
- SITE MAP MUST CLEARLY DELINEATE ALL STATE WATERS. PERMITS FOR ANY CONSTRUCTION ACTIVITY IMPACTING STATE WATERS OR REGULATED WETLANDS MUST BE MAINTAINED ON SITE AT ALL TIMES.
- CONTRACTOR SHALL MINIMIZE CLEARING TO THE MAXIMUM EXTENT PRACTICAL OR AS REQUIRED BY THE GENERAL PERMIT.
- GENERAL CONTRACTOR SHALL DENOTE ON PLAN THE TEMPORARY PARKING AND STORAGE AREA WHICH SHALL ALSO BE USED AS THE EQUIPMENT MAINTENANCE AND CLEANING AREA, EMPLOYEE PARKING AREA, AND AREA FOR LOCATING PORTABLE FACILITIES, OFFICE TRAILERS, AND TOILET FACILITIES.
- ALL WASH WATER (CONCRETE TRUCKS, VEHICLE CLEANING, EQUIPMENT CLEANING, ETC.) SHALL BE DETAINED AND PROPERLY TREATED OR DISPOSED.
- SUFFICIENT OIL AND GREASE ABSORBING MATERIALS AND FLotation BOOMS SHALL BE MAINTAINED ON SITE OR READILY AVAILABLE TO CONTAIN AND CLEAN-UP FUEL OR CHEMICAL SPILLS AND LEAKS.
- DUST ON THE SITE SHALL BE CONTROLLED. THE USE OF MOTOR OILS AND OTHER PETROLEUM BASED OR TOXIC LIQUIDS FOR DUST SUPPRESSION OPERATIONS IS PROHIBITED.
- RUBBISH, TRASH, GARBAGE, LITTER, OR OTHER SUCH MATERIALS SHALL BE DEPOSITED INTO SEALED CONTAINERS. MATERIALS SHALL BE PREVENTED FROM LEAVING THE PREMISES THROUGH THE ACTION OF WIND OR STORMWATER DISCHARGE INTO DRAINAGE DITCHES OR WATERS OF THE STATE.
- ALL STORM WATER POLLUTION PREVENTION MEASURES PRESENTED ON THIS SITE MAP, AND IN THE STORM WATER POLLUTION PREVENTION PLAN, SHALL BE INITIATED AS SOON AS PRACTICABLE.
- DISTURBED PORTIONS OF THE SITE WHERE CONSTRUCTION ACTIVITY WILL BE STOPPED FOR AT LEAST 7 DAYS SHALL BE TEMPORARILY SEEDDED. THESE AREAS SHALL BE SEEDDED NO LATER THAN 14 DAYS FROM THE LAST CONSTRUCTION ACTIVITY OCCURRING IN THESE AREAS.
- DISTURBED PORTIONS OF THE SITE WHERE CONSTRUCTION ACTIVITY HAS PERMANENTLY STOPPED SHALL BE STABILIZED. THESE AREAS SHALL BE STABILIZED NO LATER THAN 21 DAYS AFTER THE LAST CONSTRUCTION ACTIVITY OCCURRING IN THESE AREAS. STABILIZATION MAY CONSIST OF SEED, SOO, ROCK, PAVEMENT, STRUCTURE OR OTHER NON-ERODIBLE COVER.
- IF THE ACTION OF VEHICLES TRAVELING OVER THE GRAVEL CONSTRUCTION ENTRANCES IS NOT SUFFICIENT TO REMOVE THE MAJORITY OF DIRT OR MUD, THEN THE TIRES MUST BE WASHED BEFORE THE VEHICLES ENTER A PUBLIC ROAD. IF WASHING IS USED, PROVISIONS MUST BE MADE TO INTERCEPT THE WASH WATER AND TRAP THE SEDIMENT BEFORE IT IS CARRIED OFF THE SITE. ONLY USE INGRESS/EGRESS LOCATIONS AS PROVIDED.
- ALL MATERIALS SPILLED, DROPPED, WASHED, OR TRACKED FROM VEHICLES ONTO ROADWAYS OR INTO STORM DRAINS MUST BE REMOVED IMMEDIATELY.
- CONTRACTORS OR SUBCONTRACTORS WILL BE RESPONSIBLE FOR REMOVING SEDIMENT IN THE DETENTION POND AND ANY SEDIMENT THAT MAY HAVE COLLECTED IN THE STORM SEWER DRAINAGE SYSTEMS IN CONJUNCTION WITH THE STABILIZATION OF THE SITE.
- ON-SITE & OFFSITE SOIL STOCKPILE AND BORROW AREAS SHALL BE PROTECTED FROM EROSION AND SEDIMENTATION THROUGH IMPLEMENTATION OF BEST MANAGEMENT PRACTICES. STOCKPILE AND BORROW AREA LOCATIONS SHALL BE NOTED ON THE SITE MAP AND PERMITTED IN ACCORDANCE WITH GENERAL PERMIT REQUIREMENTS.
- SLOPES CONSISTING OF TOPSOIL, CLAY, OR SILT SHALL BE LEFT IN A ROUGHENED CONDITION DURING THE GRADING PHASE TO REDUCE RUNOFF VELOCITIES AND EROSION.
- DUE TO THE GRADE CHANGES DURING THE DEVELOPMENT OF THE PROJECT, THE CONTRACTOR SHALL BE RESPONSIBLE FOR ADJUSTING THE EROSION AND SEDIMENT CONTROL MEASURES (SILT FENCES, ETC.) TO PREVENT EROSION AND POLLUTANT DISCHARGE.
- CONTRACTOR RESPONSIBLE FOR MAINTAINING POSITIVE DRAINAGE. PONDING OF WATER WILL NOT BE ALLOWED ON SITE. IF NECESSARY, CONTRACTOR TO PROVIDE TEMPORARY SWALES OR PUMPING IN LOW POINT SUMP CONDITIONS UNTIL THE INSTALLATION OF STORM SEWER.

GRADING NOTES:

- ALL TREES OUTSIDE OF LIMITS OF DISTURBANCE SHALL REMAIN. ONLY THOSE TREES WITHIN LIMITS OF DISTURBANCE THAT ARE IN THE AREA TO BE GRADED SHALL BE REMOVED.
- ALL TOPSOIL, VEGETATION, ROOT STRUCTURES, AND DELETERIOUS MATERIALS SHALL BE STRIPPED FROM THE GRADED SURFACE PRIOR TO THE PLACEMENT OF EMBANKMENTS. CONTRACTOR SHALL OBTAIN THE ON-SITE GEOTECHNICAL REPRESENTATIVE'S ACCEPTANCE OF THE EXISTING GROUND SURFACE MATERIALS AND THE PROPOSED FILL MATERIAL PRIOR TO THE PLACEMENT OF FILL.
- ALL PROPOSED CONTOUR LINES AND SPOT ELEVATIONS SHOWN ARE FINISH GROUND ELEVATIONS. CONTRACTOR SHALL ACCOUNT FOR PAVEMENT DEPTHS, BUILDING PADS, TOPSOIL, ETC. WHEN GRADING THE SITE.
- ALL DISTURBED AREAS THAT SHALL BE FINISH GRADED WITH A MINIMUM OF FINISHED GRADES SHALL NOT BE STEEPER THAN 3:1.
- FINISHED GRADES SHALL NOT BE STEEPER THAN 3:1.
- ALL GRADING WORK SHALL BE CONSIDERED UNCLASSIFIED. NO ADDITIONAL PAYMENTS SHALL BE MADE FOR ROCK EXCAVATION. CONTRACTOR SHALL SATISFY HIMSELF AS TO ANY ROCK EXCAVATION REQUIRED TO ACCOMPLISH THE IMPROVEMENTS SHOWN HEREON.

ACERAGE SUMMARY:

TOTAL DISTURBED AREA = 14.9 AC

KCAPWA REFERENCE DETAILS:

- ESC-01 CONSTRUCTION ENTRANCE & CONCRETE WASHOUT
- ESC-02 EROSION CONTROL BLANKET & TURF REINFORCEMENT MATS
- ESC-03 SILT FENCE
- ESC-05 TEMPORARY DIVERSION BERM
- ESC-06 CURB INLET PROTECTION
- ESC-07 AREA INLET PROTECTION
- ESC-10 ROCK CHECK DAM
- ESC-14 OUTLET PROTECTION

RELEASE FOR CONSTRUCTION AS NOTED ON PLANS REVIEW DEVELOPMENT SERVICES LEE'S SUMMIT, MISSOURI 04/16/2021

LEGEND

- 900 EX. MAJOR CONTOUR (PH5)
- 901 EX. MINOR CONTOUR (PH5)
- 900 EX. MAJOR CONTOUR
- 901 EX. MINOR CONTOUR
- LIMITS OF DISTURBANCE
- INLET PROTECTION (ESC-06 OR ESC-07)
- OUTLET PROTECTION (ESC-14)
- SILT FENCE (ESC-03)
- STEEP SLOPE PROTECTION (ESC-02)
- TEMP. DIVERSION BERM (ESC-05)
- ROCK CHECK DAM (ESC-10)
- STORMWATER RUNOFF DIRECTION

AS-BUILT

The information provided on this drawing conforms to construction records; it is not intended for construction, implementation or recording purposes; and it is solely based on information provided by others / obtained by my firm. I warrant 100, 10' 1" 15% slope, or 8-inch diameter PVC pipe" are all typical examples of revisions that indicate that design data has been replaced with "as-built" information. All other data is as designed and has not been field verified. Date: 03/24/2022 Certified by: GRC Title: Project Engineer Firm: Anderson Engineering Inc.

CONTRACTOR TO ENSURE STEEP SLOPES FROM PH5 CONSTRUCTION ARE STABILIZED WITH STEEP SLOPE STABILIZATION (ESC-02). CONTRACTOR TO MAINTAIN BASIN AND CLEAN SEDIMENT DEPOSITS PER PH5 CONSTRUCTION REQUIREMENTS.

ANDERSON ENGINEERING
EMPLOYEE OWNED

ENGINEERS • SURVEYORS • LABORATORIES • DRILLING
941 W. 141ST TER • KANSAS CITY, MISSOURI 64145 • PHONE (816) 777-0400
A LICENSED MISSOURI ENGINEERING & SURVEYING CORPORATION - LIC. 62

DRAWING/REVISION INFO					
NO.	DESCRIPTION	BY	DATE	DRAWN BY:	CHECK BY:
1	REVISED PER CITY COMMENT	GC	2/11/21	GC	ZM
				PE-2012009232	
				1/7/2021	
				FOR REVIEW	
2	AS-BUILT DRAWINGS	GC	3/16/22	20K10058	
				JOB NUMBER:	
				MO COA NO.	00062

SUMMIT HOMES KC
HIGHLAND MEADOWS - 6TH PLAT

PRE-CLEARING EROSION CONTROL PLAN

S10, T47N, R22W
LEE'S SUMMIT, JACKSON COUNTY, MISSOURI

STATE OF MISSOURI
ZACH A. MYERS
PROFESSIONAL ENGINEER
NUMBER
PE-2012009232

SHEET NUMBER
C301
21 OF 42

6: \Shared drives\KC10 - Land Development\Projects\2020\20KCT0058 Highland Meadows - 6th Plot\01 CIV\03-DWG\Sheet\STREET AND STORM\20KCT0058 - SHTS - EROSION.dwg
 Plotted By: gaste
 6:17pm
 Feb 11, 2021
 Layout: INTERMEDIATE EROSION CONTROL PLAN

7. AT A MINIMUM, THE CONTRACTOR SHALL FOLLOW THE REQUIREMENTS FOR GOOD HOUSEKEEPING, SPILL CONTROL AND EROSION AND SEDIMENT CONTROL AS SPECIFIED IN THE KANSAS CITY METROPOLITAN CHAPTER OF THE AMERICAN PUBLIC WORKS ASSOCIATION SECTION 2150.

- SEQUENCE OF CONSTRUCTION:

1. FINISH ANY MASS GRADING AND/OR STEEP SLOPE STABILIZATION ACTIVITIES THAT WERE NOT COMPLETED IN PHASE I.

- FEMA NOTES:

THE SUBJECT PROPERTY
IS DETERMINED TO BE
OUTSIDE THE 0.2%
ANNUAL CHANCE
FLOODPLAIN ACCORDING
TO MAP ITEM NUMBER:
29095C0418G.
EFFECTIVE DATE:
1/20/2017

ALL MEASURES STATED ON THIS SITE MAP, AND IN THE STORM WATER POLLUTION PREVENTION PLAN, SHALL BE MAINTAINED IN FULLY FUNCTIONAL CONDITION UNTIL NO LONGER REQUIRED FOR A COMPLETED PHASE OF WORK OR FINAL STABILIZATION OF THE SITE. ALL EROSION AND SEDIMENTATION CONTROL MEASURES SHALL BE CHECKED BY A QUALIFIED PERSON IN ACCORDANCE WITH THE CONTRACT DOCUMENTS OR THE APPLICABLE PERMIT, WHICHEVER IS MORE STRINGENT, AND REPAIRED IN ACCORDANCE WITH THE FOLLOWING:

- CONTRACTOR TO ENSURE STEEP SLOPES FROM PH5 CONSTRUCTION ARE STABILIZED WITH STEEP SLOPE STABILIZATION (ESC-02). CONTRACTOR TO MAINTAIN BASIN AND CLEAN SEDIMENT DEPOSITS PER PH5 CONSTRUCTION REQUIREMENTS.

1. THE STORMWATER POLLUTION PREVENTION PLAN IS COMPRISED OF THIS DRAWING ("EROSION CONTROL"), THE STANDARD DETAILS, ATTACHMENTS INCLUDED IN SPECIFICATIONS ("SWPPP"), PLUS THE PERMIT AND ALL SUBSEQUENT REPORTS AND RELATED DOCUMENTS.
2. ALL CONTRACTORS AND SUBCONTRACTORS INVOLVED WITH STORMWATER POLLUTION PREVENTION SHALL OBTAIN A COPY OF THE STORM WATER POLLUTION PREVENTION PLAN AND THE STATE OR NATIONAL POLLUTANT DISCHARGE ELIMINATION SYSTEM GENERAL PERMIT (NPDES PERMIT) AND BECOME FAMILIAR WITH THEIR CONTENTS.
3. CONTRACTOR SHALL IMPLEMENT BEST MANAGEMENT PRACTICES AS REQUIRED BY THE SWPPP. ADDITIONAL BEST MANAGEMENT PRACTICES SHALL BE IMPLEMENTED AS DICTATED BY CONDITIONS AT NO ADDITIONAL COST OF OWNER THROUGHOUT ALL PHASES OF CONSTRUCTION.
4. BEST MANAGEMENT PRACTICES (BMP'S) AND CONTROLS SHALL CONFORM TO FEDERAL, STATE, OR LOCAL REQUIREMENTS OR MANUAL OR POLICE, AS APPLICABLE. CONTRACTOR SHALL IMPLEMENT ADDITIONAL CONTROLS AS DIRECTED BY PERMITTING AGENCY OR OWNER.
5. SITE MAP MUST CLEARLY DELINEATE ALL STATE WATERS. PERMITS FOR ANY CONSTRUCTION ACTIVITY IMPACTING STATE WATERS OR REGULATED WETLANDS MUST BE MAINTAINED ON SITE AT ALL TIMES.
6. CONTRACTOR SHALL MINIMIZE CLEARING TO THE MAXIMUM EXTENT PRACTICAL OR AS REQUIRED BY THE GENERAL PERMIT.
7. GENERAL CONTRACTOR SHALL DENOTE ON PLAN THE TEMPORARY PARKING AND STORAGE AREA WHICH SHALL ALSO BE USED AS THE EQUIPMENT MAINTENANCE AND CLEANING AREA, EMPLOYEE PARKING AREA, AND AREA FOR LOCATING PORTABLE FACILITIES, OFFICE, TRAILERS, AND TOILET FACILITIES.
8. ALL WASH WATER (CONCRETE TRUCKS, VEHICLE CLEANING, EQUIPMENT CLEANING ETC.) SHALL BE DETAINED AND PROPERLY TREATED OR DISPOSED.
9. SUFFICIENT OIL AND GREASE ABSORBING MATERIALS AND FLotation BOOMS SHALL BE MAINTAINED ON SITE OR READILY AVAILABLE TO CONTAIN AND CLEAN-UP FUEL OR CHEMICAL SPILLS AND LEAKS.
10. DUST ON THE SITE SHALL BE CONTROLLED. THE USE OF MOTOR OILS AND OTHER PETROLEUM BASED OR TOXIC LIQUIDS FOR DUST SUPPRESSION OPERATIONS IS PROHIBITED.
11. RUBBISH, TRASH, GARBAGE, LITTER, OR OTHER SUCH MATERIALS SHALL BE DEPOSITED INTO SEALED CONTAINERS. MATERIALS SHALL NOT BE BLASTED FROM THE SITE. MATERIALS SHALL NOT BE BLOWN BY WIND OR STORMWATER DISCHARGE INTO DRAINAGE DITCHES OR WATERS OF THE STATE.

1. ALL TREES OUTSIDE OF LIMITS OF DISTURBANCE SHALL REMAIN. ONLY THOSE TREES WITHIN LIMITS OF DISTURBANCE THAT ARE IN THE AREA TO BE GRADED SHALL BE REMOVED.

2. ALL TOPSOIL, VEGETATION, ROOT STRUCTURES, AND DELETERIOUS MATERIALS SHALL BE STRIPPED FROM THE GROUND SURFACE PRIOR TO THE PLACEMENT OF EMBANKMENTS. CONTRACTOR SHALL OBTAIN THE ON-SITE GEOTECHNICAL REPRESENTATIVE'S ACCEPTANCE OF THE EXISTING GROUND SURFACE MATERIALS AND THE PROPOSED FILL MATERIAL PRIOR TO THE PLACEMENT OF FILL.

3. ALL PROPOSED CONTOUR LINES AND SPOT ELEVATIONS SHOWN ARE FINISH GROUND ELEVATIONS. CONTRACTOR SHALL ACCOUNT FOR PAVEMENT DEPTHS, BUILDING PADDS, TOPSOIL, ETC. WHEN GRADING THE SITE.

4. ALL DISTURBED AREAS THAT SHALL BE FINISH GRADED WITH A MINIMUM OF FOUR INCHES OF TOPSOIL.

5. FINISHED GRADES SHALL NOT BE STEEPER THAN 3:1.

6. ALL GRADING WORK SHALL BE CONSIDERED UNCLASSIFIED. NO ADDITIONAL PAYMENTS SHALL BE MADE FOR ROCK EXCAVATION. CONTRACTOR SHALL SATISFY HIMSELF AS TO ANY ROCK EXCAVATION REQUIRED TO ACCOMPLISH THE IMPROVEMENTS SHOWN HEREON.

TOTAL DISTURBED AREA = 14.9 AC

ESC-01 CONSTRUCTION ENTRANCE & CONCRETE WASHOUT
ESC-02 EROSION CONTROL BLANKET & TURF REINFORCEMENT MATS
ESC-03 SILT FENCE
ESC-05 TEMPORARY ROCK DIVERSION BERM
ESC-06 CURB INLET PROTECTION
ESC-07 AREA INLET PROTECTION
ESC-10 ROCK DITCH CHECKS
ESC-14 OUTLET PROTECTION

The diagram illustrates various erosion control measures, each associated with a specific RMP code. The measures are represented by icons and text labels:

- PROP. STORM DRAIN**: Represented by a dashed line with a series of small circles.
- PROP. MAJOR CONTOUR (PH6)**: Represented by a dashed line with a series of small circles.
- PROP. MINOR CONTOUR (PH6)**: Represented by a dashed line with a series of small circles.
- EX. MAJOR CONTOUR**: Represented by a dashed line with a series of small circles.
- EX. MINOR CONTOUR**: Represented by a dashed line with a series of small circles.
- EX. MAJOR CONTOUR (PH5)**: Represented by a dashed line with a series of small circles.
- EX. MINOR CONTOUR (PH5)**: Represented by a dashed line with a series of small circles.
- LIMITS OF DISTURBANCE**: Represented by a solid line with a series of small circles.
- INLET PROTECTION (ESC-06 OR ESC-07)**: Represented by a circular structure with a grid pattern.
- OUTLET PROTECTION (ESC-14)**: Represented by a circular structure with a grid pattern.
- SILT FENCE (ESC-03)**: Represented by a series of small, pointed structures.
- STEEP SLOPE PROTECTION (ESC-02)**: Represented by a rectangular structure.



**ANDERSON
ENGINEERING**
EMPLOYEE OWNED

ENGINEERS • SURVEYORS • LABORATORIES • DRILLING
2941 W. 141ST TER. • KANSAS CITY, MISSOURI 64145 • PHONE (816) 777-0400
A LICENSED MISSOURI ENGINEERING & SURVEYING CORPORATION - LC # 0000000000

REVIEWS			DRAWING UNKINFO.		
NO.	DESCRIPTION	BY	DATE	DRAWN BY:	GC
1	REVISED PER CITY COMMENT	GC	2/11/21	CHECK BY:	ZM
				LICENSE NO.	PE-2012009232
				DATE:	1/7/2021
2	AS-BUILT DRAWINGS	GC	3/16/22	ISSUED FOR:	FOR REVIEW
				JOB NUMBER:	20KCC0058
© COPYRIGHT ANDERSON ENGINEERING, INC. 2020				MO COA NO.	000462

© COPYRIGHT ANDERSON ENGINEERING, INC. 2020

SUMMIT HOMES KC
HIGHLAND MEADOWS - 6TH PLAT

INTERMEDIATE EROSION CONTROL PLAN

S10, T47N, R32W
LEE'S SUMMIT, JACKSON COUNTY, MISSOURI



SHEET NUMBER

C302
22 OF 42

GENERAL NOTES:

ALL MEASURES STATED ON THIS SITE MAP, AND IN THE STORM WATER POLLUTION PREVENTION PLAN, SHALL BE MAINTAINED IN FULLY FUNCTIONAL CONDITION UNTIL NO LONGER REQUIRED FOR A COMPLETED PHASE OF WORK OR FINAL STABILIZATION OF THE SITE. ALL EROSION AND SEDIMENTATION CONTROL MEASURES SHALL BE CHECKED BY A QUALIFIED PERSON IN ACCORDANCE WITH THE CONTRACT DOCUMENTS OR THE APPLICABLE PERMIT, WHICHEVER IS MORE STRINGENT, AND REPAIRED IN ACCORDANCE WITH THE FOLLOWING:

1. AT A MINIMUM, THE CONTRACTOR SHALL FOLLOW THE REQUIREMENTS FOR GOOD HOUSEKEEPING, SPILL CONTROL AND EROSION AND SEDIMENT CONTROL AS SPECIFIED IN THE KANSAS CITY METROPOLITAN CHAPTER OF THE AMERICAN PUBLIC WORKS ASSOCIATION SECTION 2150.
2. INLET PROTECTION DEVICES AND BARRIERS SHALL BE REPAIRED OR REPLACED IF THEY SHOW SIGNS OF UNDERMINING OR DETERIORATION.
3. ALL SEEDED AREAS SHALL BE CHECKED REGULARLY TO SEE THAT A GOOD STAND IS MAINTAINED. AREAS SHOULD BE FERTILIZED, WATERED, AND RESEED AS NEEDED.
4. SILT FENCES SHALL BE REPAIRED TO THEIR ORIGINAL CONDITIONS IF DAMAGED. SEDIMENT SHALL BE REMOVED FROM THE SILT FENCES WHEN IT REACHES ONE-HALF THE HEIGHT OF THE SILT FENCE.
5. THE CONSTRUCTION EXITS SHALL BE MAINTAINED IN A CONDITION WHICH WILL PREVENT TRUCKING OR FLOW OF MUD ONTO PUBLIC RIGHTS-OF-WAY. THIS MAY REQUIRE PERIODIC TOP DRESSING OF THE CONSTRUCTION EXITS AS CONDITIONS DEMAND.
6. THE TEMPORARY PARKING AND STORAGE AREA SHALL BE KEPT IN GOOD CONDITION (SUITABLE FOR PARKING AND STORAGE). THIS MAY REQUIRE PERIODIC TOP DRESSING OF THE TEMPORARY PARKING AREA AS CONDITIONS DEMAND.
7. DRAINAGE SWALES WITH SLOPES STEEPER THAN 15% SHALL BE INSPECTED AFTER EACH RAINFALL EVENT. THESE CHANNELS AND SLOPES SHOULD BE TREATED WITH EROSION FABRIC. IF THE CHANNELS OR SLOPES SHOW ANY SIGN OF FAILURE, COORDINATE WITH THE ENGINEER TO DEVELOP A PLAN TO RE-STABILIZE THE FAILED AREA.

1. REMOVE CONSTRUCTION ENTRANCE/EXIT AS ROAD IS PAVED.
2. PAVE ROADS AND REQUIRED SIDEWALKS ADJACENT TO TRACTS. ADJUST SILT FENCE AND SLOPE INTERRUPTS AS NECESSARY TO PREVENT MUD AND SILT FROM FLOWING LONG DISTANCES.
3. SEED AND/OR SOD ALL DISTURBED AREAS AND MAINTAIN UNTIL VEGETATIVE COVER HAS REACHED A MINIMUM OF 70% OF THE TOTAL DISTURBED AREAS.
4. AS VEGETATION REACHES MINIMUM ESTABLISHED AREA OF 70% OF THE DISTURBED AREA, SILT FENCE AND SLOPE INTERRUPTION DEVICES (INCLUDING DIVERSION BERM) SHALL BE REMOVED.
5. AS ALL DISTURBED AREAS ARE STABILIZED WITH VEGETATIVE COVER, STORM SEWER INLET PROTECTION SHALL BE REMOVED UPON CITY INSPECTION AND APPROVAL. CLOSE OUT EROSION AND SEDIMENT CONTROL PROCESS PER MDNR REQUIREMENTS.

THE SUBJECT PROPERTY
IS DETERMINED TO BE
OUTSIDE THE 0.2%
ANNUAL CHANCE
FLOODPLAIN ACCORDING
TO MAP ITEM NUMBER:
29095C0418G.
EFFECTIVE DATE:
1/20/2017

1. THE STORMWATER POLLUTION PREVENTION PLAN IS COMPRISED OF THIS DRAWING ("EROSION CONTROL"), THE STANDARD DETAILS, ATTACHMENTS INCLUDED IN SPECIFICATIONS ("SWPPP"), PLUS THE PERMIT AND ALL SUBSEQUENT REPORTS AND RELATED DOCUMENTS.
2. ALL CONTRACTORS AND SUBCONTRACTORS INVOLVED WITH STORMWATER POLLUTION PREVENTION SHALL OBTAIN A COPY OF THE STORM WATER POLLUTION PREVENTION PLAN AND THE STATE OR NATIONAL POLLUTANT DISCHARGE ELIMINATION SYSTEM GENERAL PERMIT (NPDES PERMIT) AND BECOME FAMILIAR WITH THEIR CONTENTS.
3. CONTRACTOR SHALL IMPLEMENT BEST MANAGEMENT PRACTICES AS REQUIRED BY THE SWPPP. ADDITIONAL BEST MANAGEMENT PRACTICES SHALL BE IMPLEMENTED AS DICTATED BY CONDITIONS AT NO ADDITIONAL COST OF OWNER THROUGHOUT ALL PHASES OF CONSTRUCTION.
4. BEST MANAGEMENT PRACTICES (BMP'S) AND CONTROLS SHALL CONFORM TO FEDERAL, STATE OR LOCAL REQUIREMENTS OR MANUAL OF PRACTICE, AS APPLICABLE. CONTRACTOR SHALL IMPLEMENT ADDITIONAL CONTROLS AS DIRECTED BY PERMITTING AGENCY OR OWNER.
5. SITE MAP MUST CLEARLY DELINEATE ALL STATE WATERS, PERMITS FOR ANY CONSTRUCTION ACTIVITY IMPACTING STATE WATERS OR REGULATED WETLANDS MUST BE MAINTAINED ON SITE AT ALL TIMES.
6. CONTRACTOR SHALL MINIMIZE CLEARING TO THE MAXIMUM EXTENT PRACTICAL OR AS REQUIRED BY THE GENERAL PERMIT.
7. GENERAL CONTRACTOR SHALL DENOTE ON PLAN THE TEMPORARY PARKING AND STORAGE AREA WHICH SHALL ALSO BE USED AS THE EXISTING MAINTENANCE AND LEAVING AREA, EMPLOYEE PARKING AREA, AND AREA FOR LOCATING PORTABLE FACILITIES, OFFICE TRAILERS, AND TOILET FACILITIES.
8. ALL WASH WATER (CONCRETE TRUCKS, VEHICLE CLEANING, EQUIPMENT CLEANING, ETC.) SHALL BE DETAINED AND PROPERLY TREATED OR DISPOSED.
9. SUFFICIENT OIL AND GREASE ABSORBING MATERIALS AND FLOATATION BOOMS SHALL BE MAINTAINED ON SITE OR READILY AVAILABLE TO CONTAIN AND CLEAN-UP FUEL OR CHEMICAL SPILLS AND LEAKS.
10. DUST ON THE SITE SHALL BE CONTROLLED. THE USE OF MOTOR OIL AND OTHER PETROLEUM BASED OR TOXIC LIQUIDS FOR DUST SUPPRESSION OPERATIONS IS PROHIBITED.
11. RUBBISH, TRASH, GARBAGE, LITTER, OR OTHER SUCH MATERIALS SHALL BE DEPOSITED INTO SEALED CONTAINERS. MATERIALS SHALL BE PROPERLY STORED TO PREVENT THEMSELVES THROUGH THE ACTION OF WIND OR STORMWATER DISCHARGE INTO DRAINAGE DITCHES OR WATERS OF THE STATE.

12. ALL STORM WATER POLLUTION PREVENTION MEASURES PRESENTED ON THIS SITE MAP, AND IN THE STORM WATER POLLUTION PREVENTION PLAN, SHALL BE INITIATED AS SOON AS PRACTICABLE.
13. DISTURBED PORTIONS OF THE SITE WHERE CONSTRUCTION ACTIVITY WILL BE STOPPED FOR AT LEAST 7 DAYS, SHALL BE TEMPORARILY SEEDED. THESE AREAS SHALL BE SEEDED NO LATER THAN 14 DAYS FROM THE LAST CONSTRUCTION ACTIVITY OCCURRING IN THESE AREAS.
14. DISTURBED PORTIONS OF THE SITE WHERE CONSTRUCTION ACTIVITY HAS PERMANENTLY STOPPED SHALL BE STABILIZED. THESE AREAS SHALL BE STABILIZED NO LATER THAN 21 DAYS AFTER THE LAST CONSTRUCTION ACTIVITY OCCURRING IN THESE AREAS. STABILIZATION MAY CONSIST OF SEED, SOD, ROCK, PAVEMENT, STRUCTURE OR OTHER NON-ERODIBLE COVER.
15. IF THE ACTION OF VEHICLES TRAVELING OVER THE GRAVEL CONSTRUCTION ENTRANCES IS NOT SUFFICIENT TO REMOVE THE MAJORITY OF DIRT OR MUD, THEN THE TIRES MUST BE WASHED BEFORE THE VEHICLES ENTER A PUBLIC ROAD. IF WASHING IS USED, PROVISIONS MUST BE MADE TO INTERCEPT THE WASH WATER AND TRAP THE SEDIMENT BEFORE IT IS CARRIED OFF THE SITE. ONLY USE INGRESS/EGRESS LOCATIONS AS PROVIDED.
16. ALL MATERIALS SPILLED, DROPPED, WASHED, OR TRACKED FROM VEHICLES ONTO ROADWAYS OR INTO STORM DRAINS MUST BE REMOVED IMMEDIATELY.
17. CONTRACTORS OR SUBCONTRACTORS WILL BE RESPONSIBLE FOR REMOVING SEDIMENT IN THE DETENTION POND AND ANY SEDIMENT THAT MAY HAVE COLLECTED IN THE STORM SEWER DRAINAGE SYSTEMS IN CONJUNCTION WITH THE STABILIZATION OF THE SITE.
18. ON-SITE & OFFSITE SOIL STOCKPILE AND BORROW AREAS SHALL BE PROTECTED FROM EROSION AND SEDIMENTATION THROUGH IMPLEMENTATION OF BEST MANAGEMENT PRACTICES. STOCKPILE AND BORROW AREA LOCATIONS SHALL BE NOTED ON THE SITE MAP AND PERMITTED IN ACCORDANCE WITH GENERAL PERMIT REQUIREMENTS.
19. SLOPES CONSISTING OF TOPSOIL, CLAY, OR SILT SHALL BE LEFT IN A ROUGHENED CONDITION DURING THE GRADING PHASE TO REDUCE RUNOFF VELOCITIES AND EROSION.
20. DUE TO THE GRADE CHANGES DURING THE DEVELOPMENT OF THE PROJECT, THE CONTRACTOR SHALL BE RESPONSIBLE FOR ADJUSTING THE EROSION AND SEDIMENT CONTROL MEASURES (SILT FENCES, ETC.) TO PREVENT EROSION AND POLLUTANT DISCHARGE.
21. CONTRACTOR RESPONSIBLE FOR MAINTAINING POSITIVE DRAINAGE. PONDING OF WATER WILL NOT BE ALLOWED ON SITE. IF NECESSARY, CONTRACTOR TO PROVIDE TEMPORARY SWALES OR PUMPING IN LOW POINT SUMP CONDITIONS UNTIL THE INSTALLATION OF STORM SEWER.

1. ALL TREES OUTSIDE OF LIMITS OF DISTURBANCE SHALL REMAIN. ONLY THOSE TREES WITHIN LIMITS OF DISTURBANCE THAT ARE IN THE AREA TO BE GRADED SHALL BE REMOVED.

2. ALL TOPSOIL, VEGETATION, ROOT STRUCTURES, AND DELETERIOUS MATERIALS SHALL BE STRIPPED FROM THE GROUND SURFACE PRIOR TO THE PLACEMENT OF EMBANKMENTS. CONTRACTOR SHALL OBTAIN THE ON-SITE GEOTECHNICAL REPRESENTATIVE'S ACCEPTANCE OF THE EXISTING GROUND SURFACE MATERIALS AND THE PROPOSED FILL MATERIAL PRIOR TO THE PLACEMENT OF FILL.

3. ALL PROPOSED CONTOUR LINES AND SPOT ELEVATIONS SHOWN ARE FINISH GROUND ELEVATIONS. CONTRACTOR SHALL ACCOUNT FOR PAVEMENT DEPTHS, BUILDING PADS, TOPSOIL, ETC. WHEN GRADING THE SITE.

4. ALL DISTURBED AREAS THAT SHALL BE FINISH GRADED WITH A MINIMUM OF FOUR INCHES OF TOPSOIL.

5. FINISHED GRADES SHALL NOT BE STEEPER THAN 3:1.

6. ALL GRADING WORK SHALL BE CONSIDERED UNCLASSIFIED. NO ADDITIONAL PAYMENTS SHALL BE MADE FOR ROCK EXCAVATION. CONTRACTOR SHALL SATISFY HIMSELF AS TO ANY ROCK EXCAVATION REQUIRED TO ACCOMPLISH THE IMPROVEMENTS SHOWN HEREON.

TOTAL DISTURBED AREA = 14.9 AC

REVISIONS			DRAWING INFO.	
NO.	DESCRIPTION	BY	DATE	
1	REVISED PER CITY COMMENT	GC	2/11/21	DRAWN BY: GC
				CHECK BY: ZM
				LICENSE NO. PE-2012009232
				DATE: 1/7/2021
2	AS-BUILT DRAWINGS	GC	3/16/22	ISSUED FOR: FOR REVIEW
				JOB NUMBER: 20KCC10058
© COPYRIGHT ANDERSON ENGINEERING, INC. 2020				MO COA NO. 0000602

© COPYRIGHT ANDERSON ENGINEERING INC. 2020

SUMMIT HOMES KC
HIGHLAND MEADOWS - 6TH PLAT


FINAL STABILIZATION EROSION CONTROL PLAN

S10, T47N, R32W
LEE'S SUMMIT, JACKSON COUNTY, MISSOURI





SHEET NUMBER

C303
23 OF 42

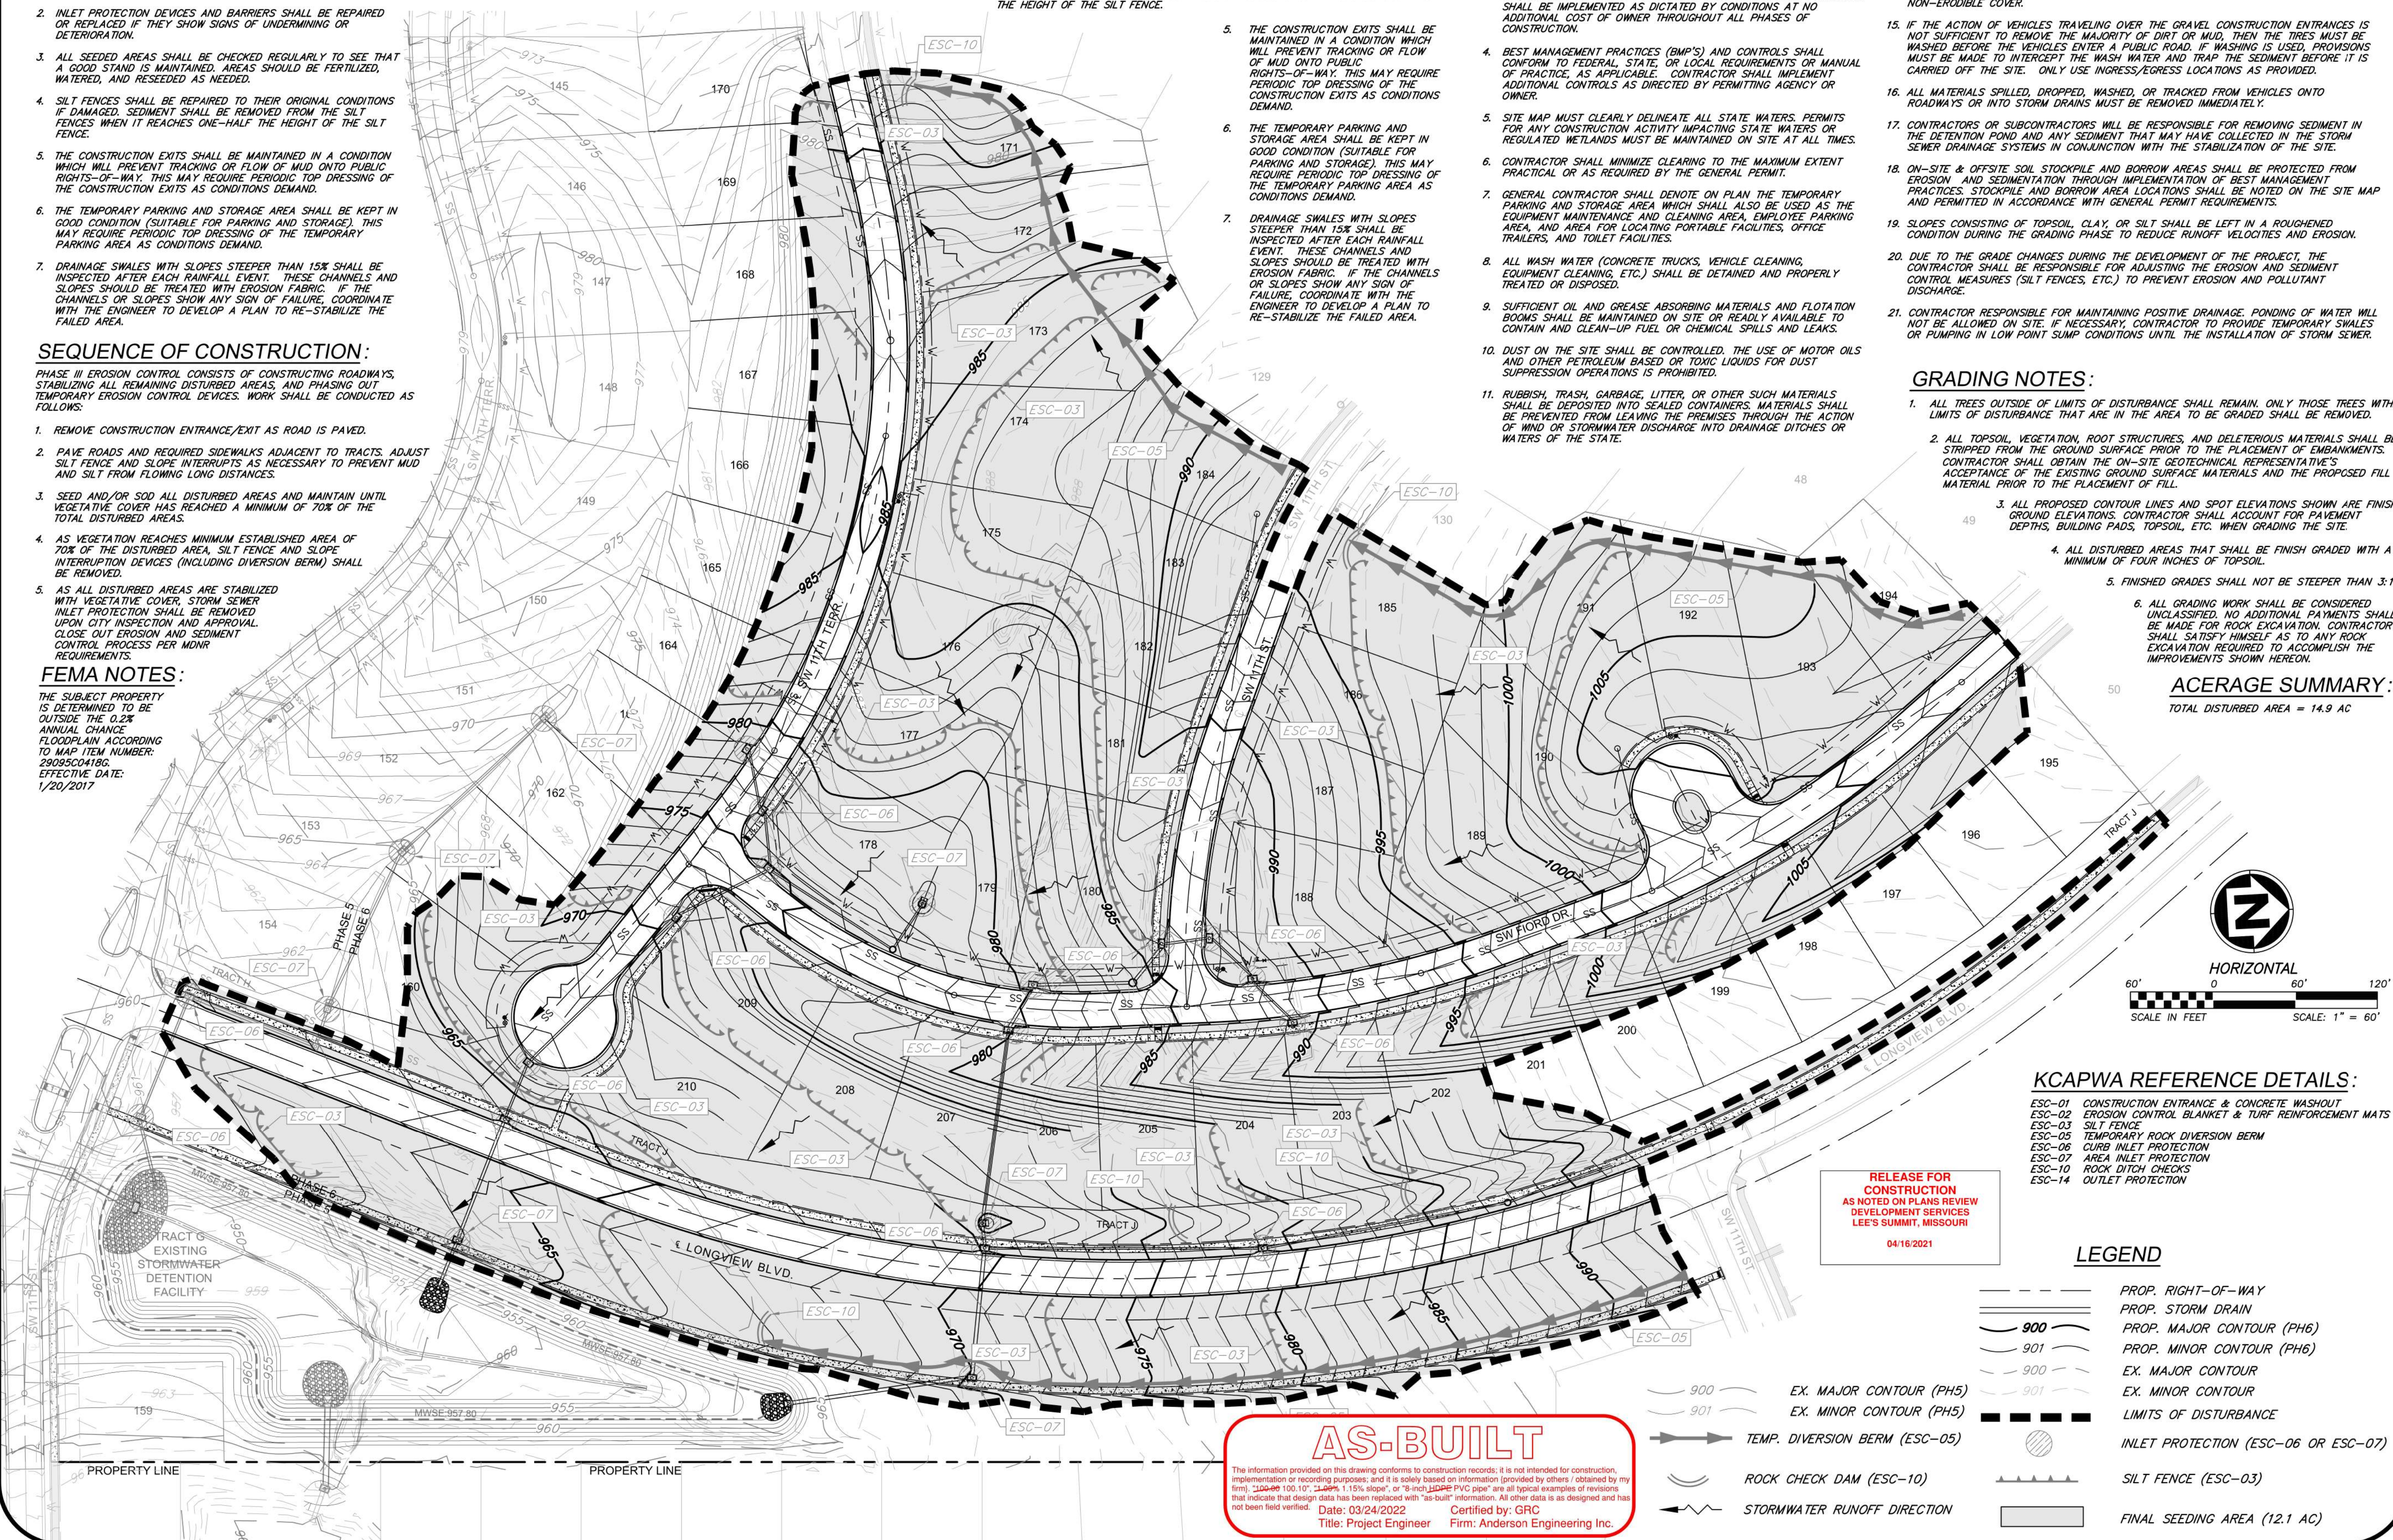


Feb 11, 2021 - 6:10pm Plotted By: gacite G:\Shared drives\KCTO - Land Development\Projects\2020\20KCI0058 Highland Meadows - 6th Plat\01 CIVIL\03-DWG\Sheet\STREET AND STORM\20KCI0058 - SH1 - INTERSECTION DETAILS.dwg Layout: INTERSECTION DETAILS

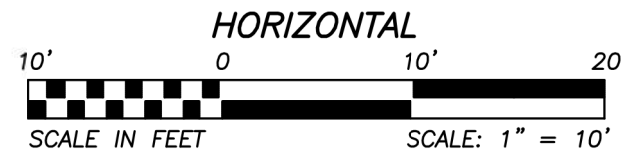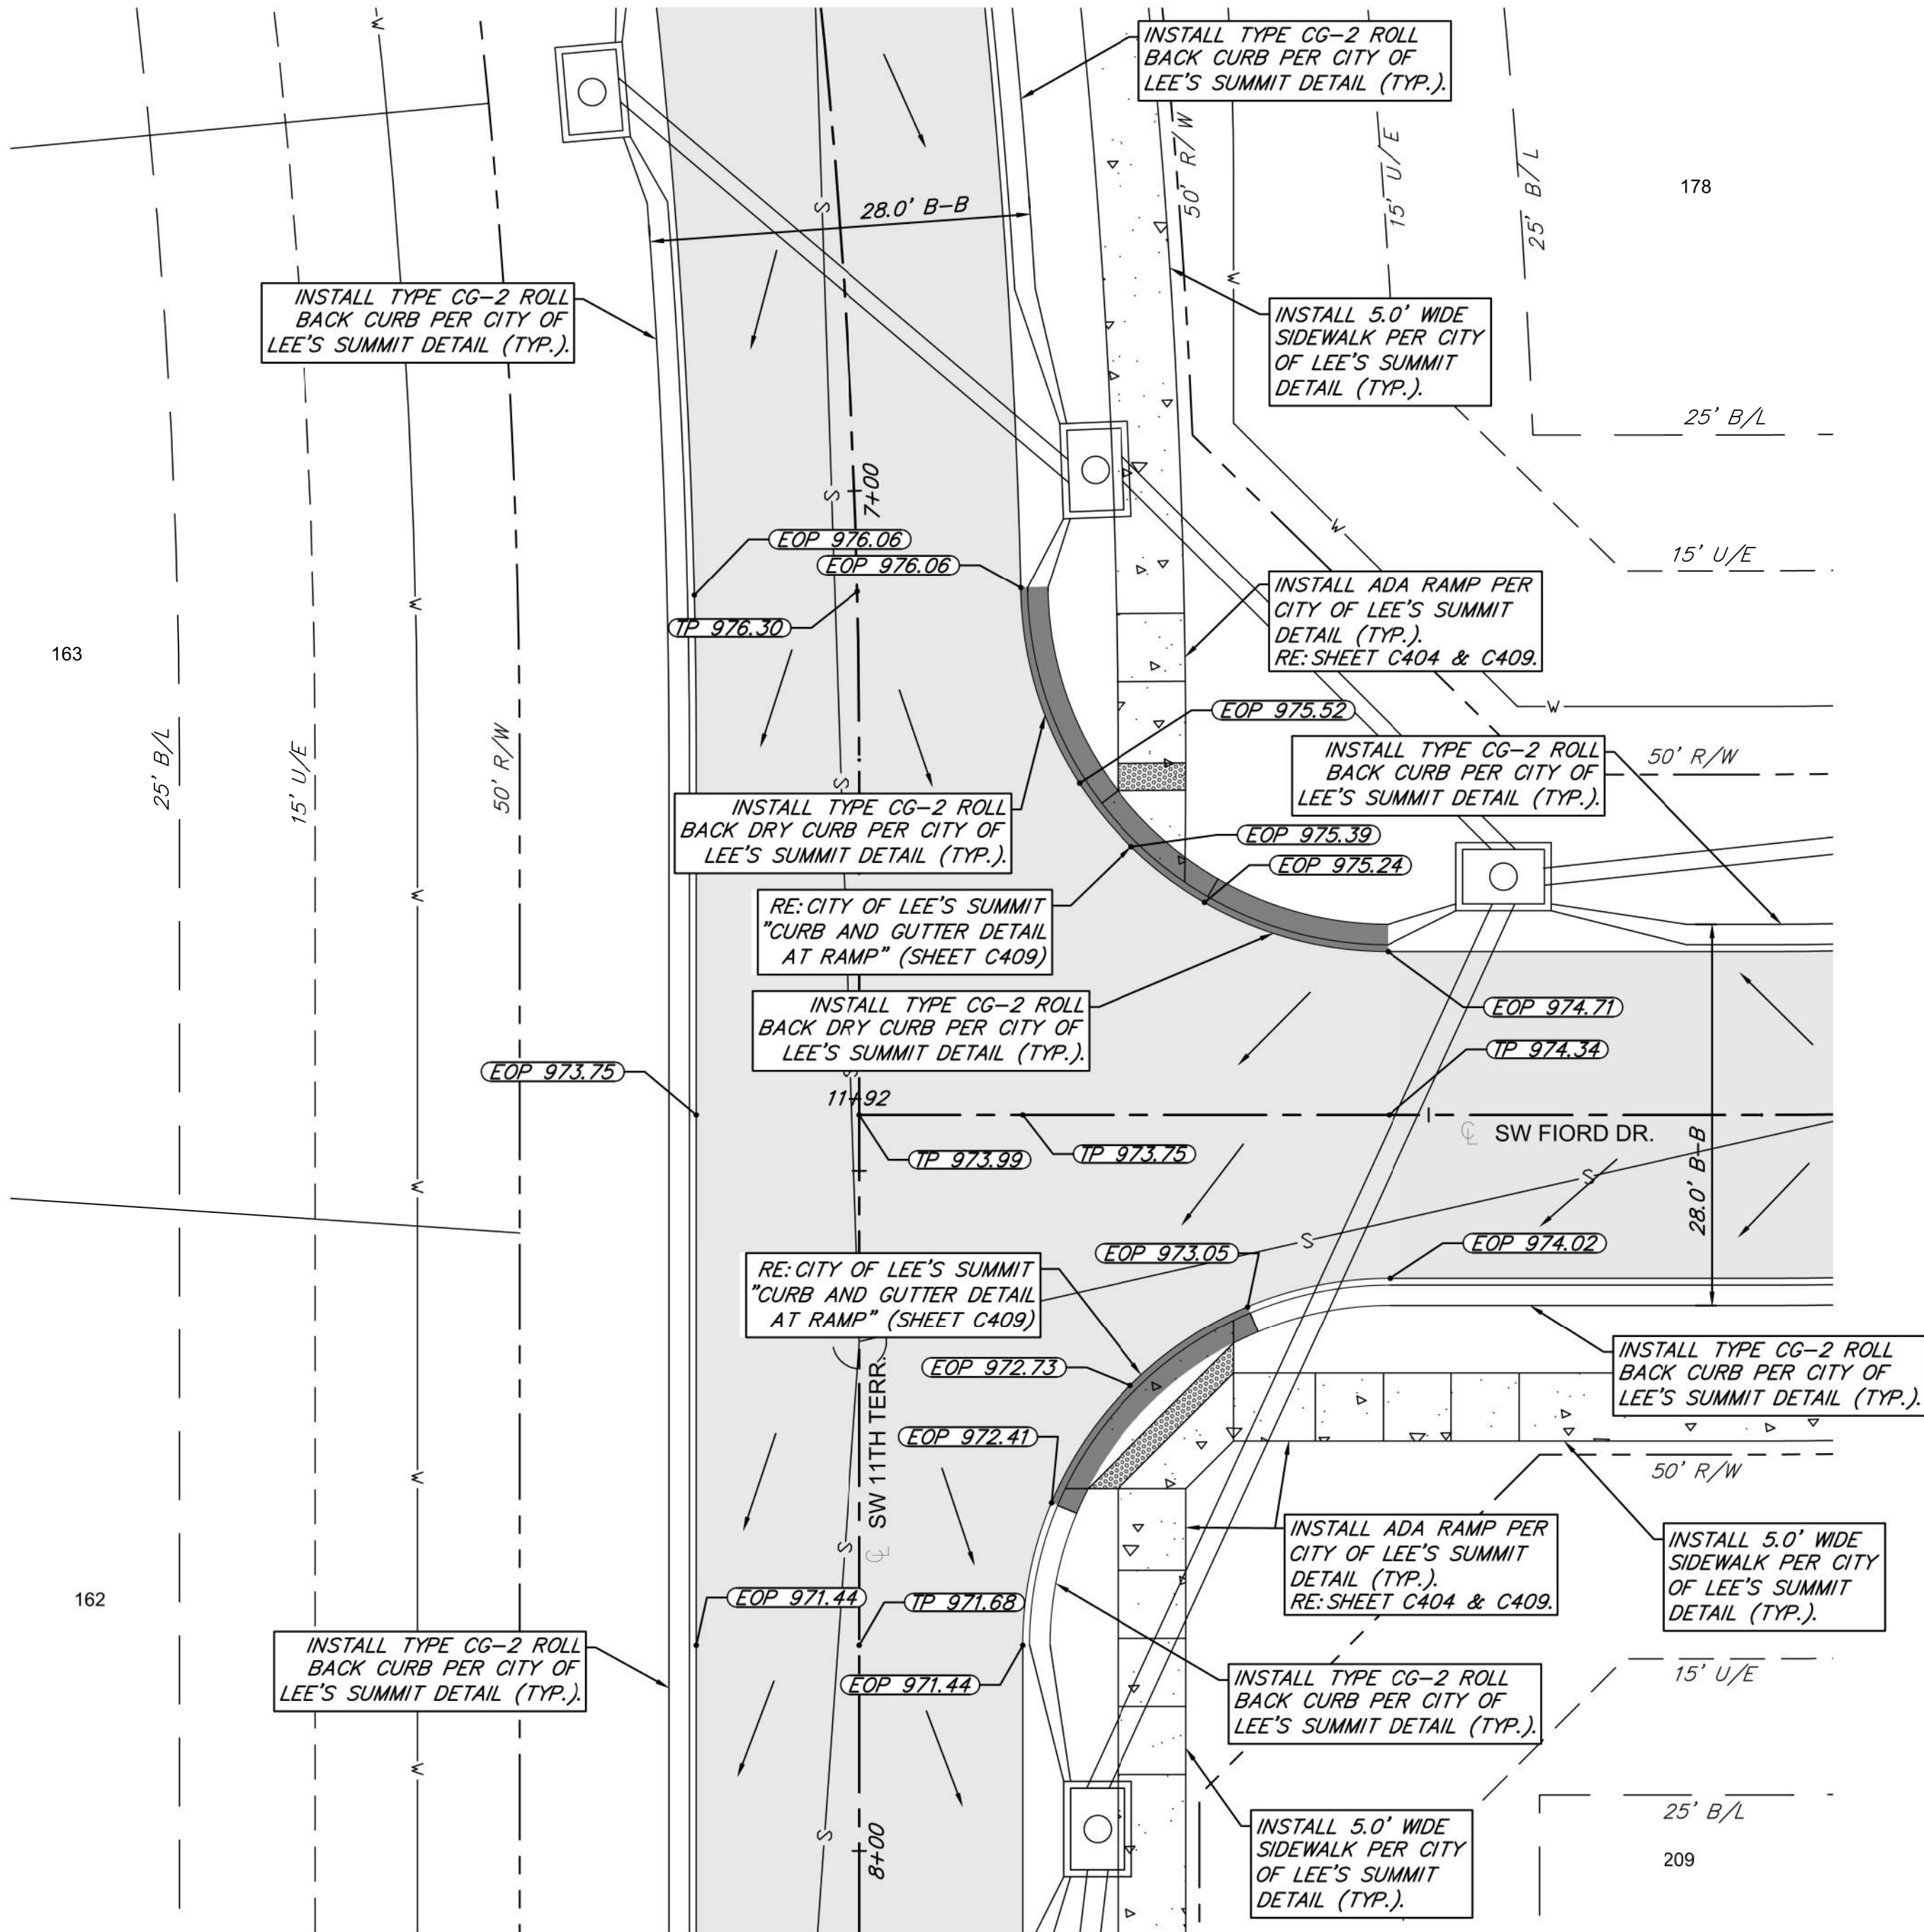



INTERSECTION OF SW 11TH TERRACE & SW FIORD DRIVE

LEGEND

---	PROP. STREET &	→	SLOPE DIRECTION	EOP = EDGE OF PAVEMENT
---	PROP. RIGHT-OF-WAY	---	PROP. STREET PAVEMENT	TP = TOP OF PAVEMENT
---	PROP. UTILITY EASEMENT	---	PROP. 5' SIDEWALK	TS = TOP OF SIDEWALK
---	PROP. BUILDING SETBACK	---	PROP. 5' SIDEWALK	B-B = BACK OF CURB TO BACK OF CURB
---	PROP. LOT LINE	---	PROP. 5' SIDEWALK	TYP = TYPICAL
---	PROP. WATER LINE	---	PROP. 5' SIDEWALK	
---	PROP. SANITARY SEWER	---	PROP. 5' SIDEWALK	
---	PROP. SANITARY SEWER	---	PROP. 5' SIDEWALK	

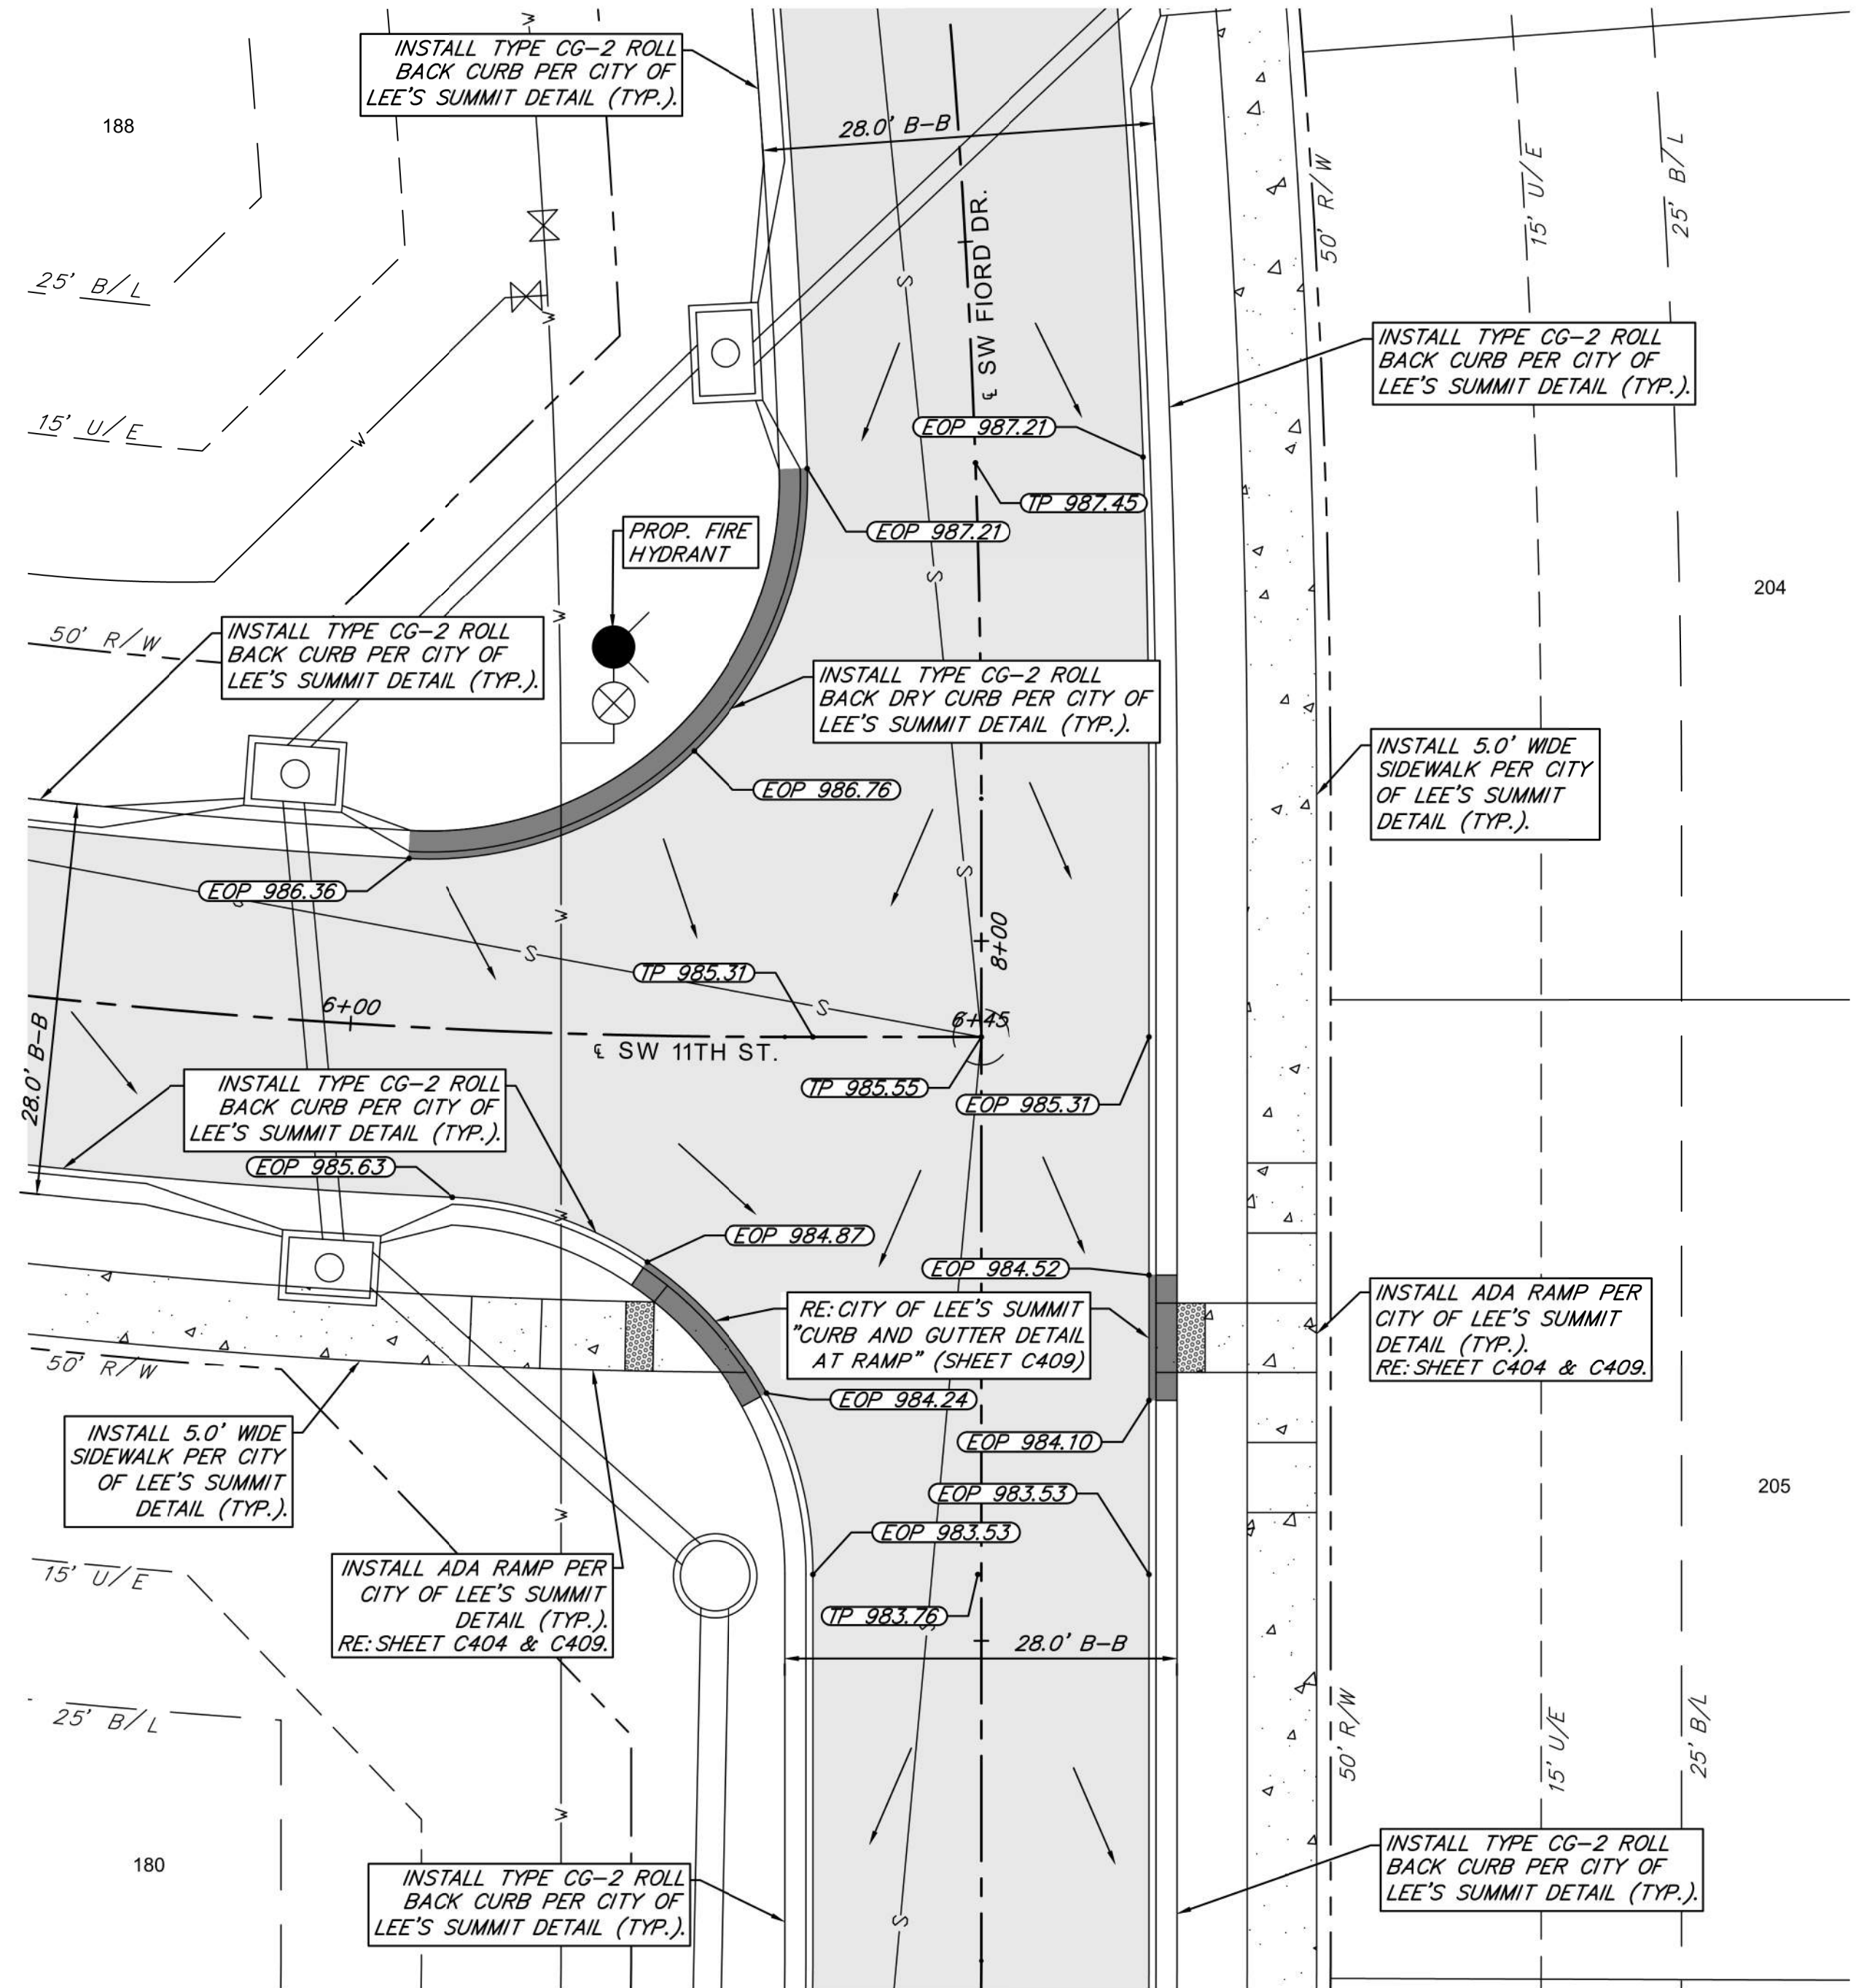

Feb 11, 2021 - 6:10pm Plotted By: gacite G:\Shared drives\KCTO - Land Development\Projects\2020\20K10058 Highland Meadows - 6th Plat\01 CIVIL\03-DWG\Sheet\STREET AND STORM\20K10058 - SH1T - INTERSECTION DETAILS.dwg Layout: CUL-DE-SAC DETAILS

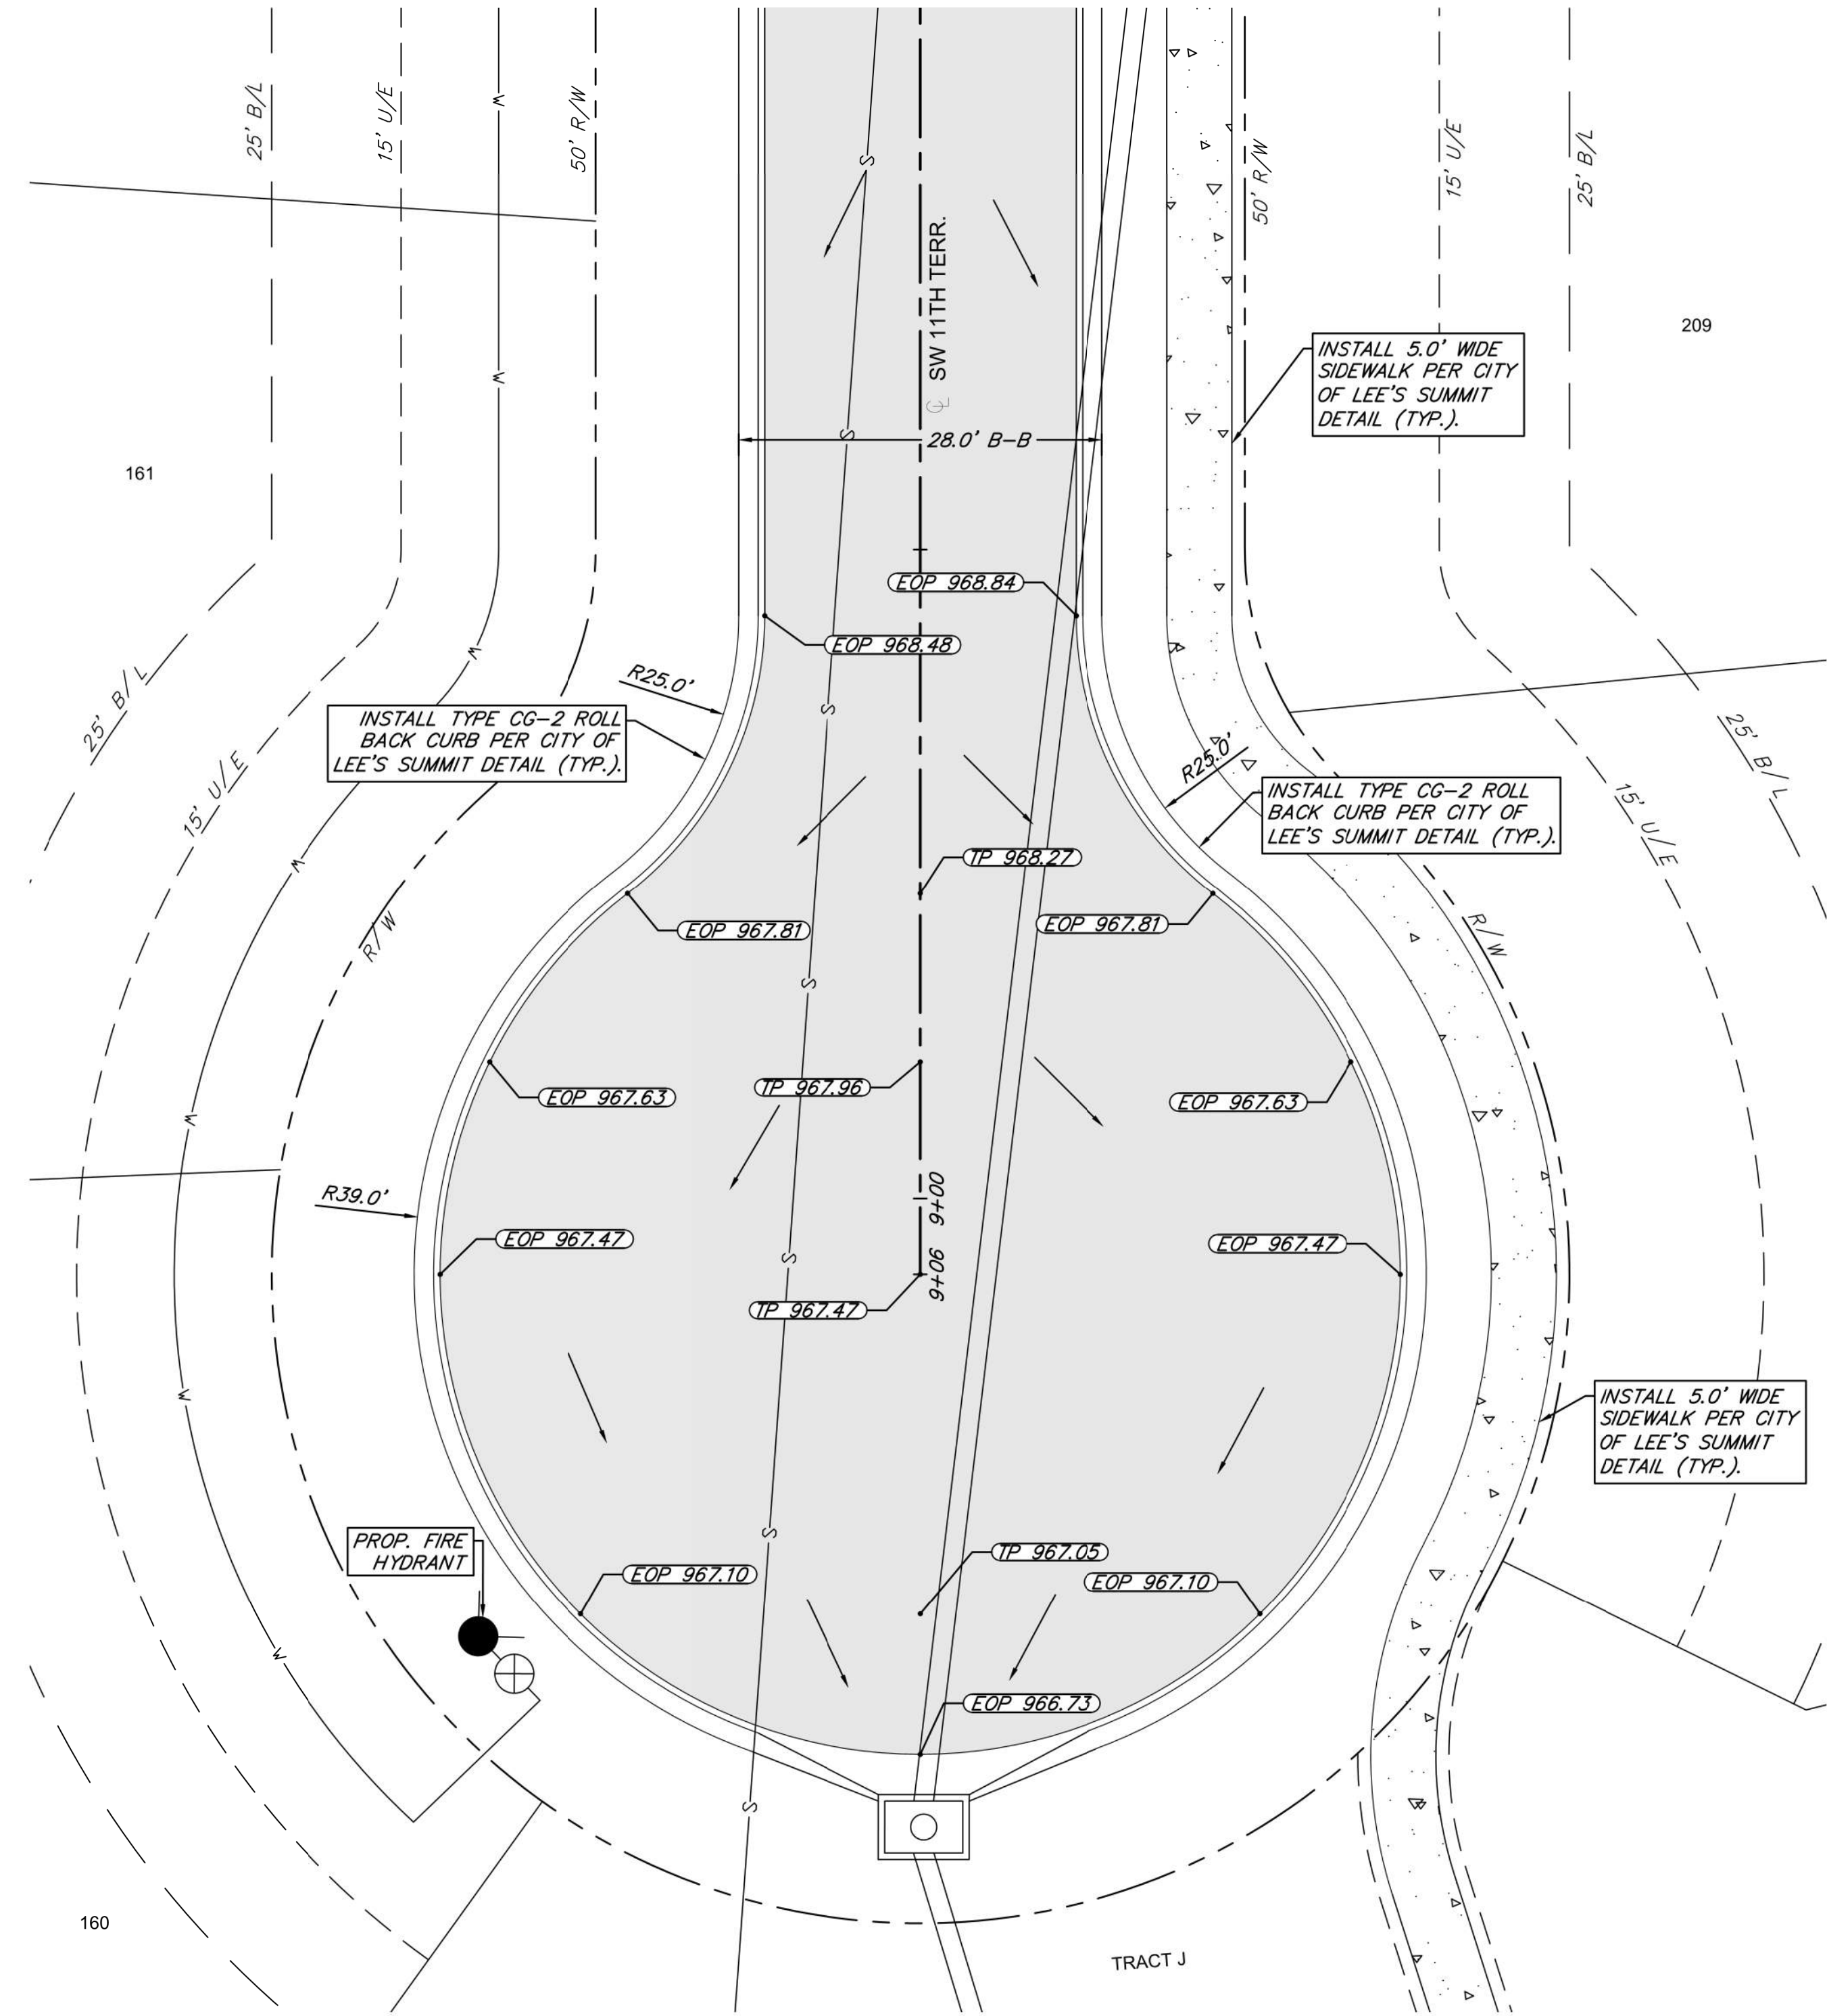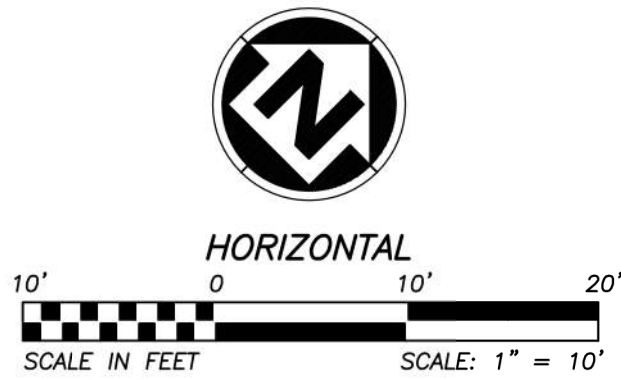

CUL-DE-SAC OF SW 11TH TERRACE

AS-BUILT


The information provided on this drawing conforms to construction records; it is not intended for construction, implementation or recording purposes, and it is solely based on information provided by others / obtained by my firm. ~~2020-09-10~~ 100.10' ± 4.66% 1.15% slope, or 8-inch LDPE PVC pipe are all typical examples of revisions that indicate that design data has been replaced with "as-built" information. All other data is as designed and has not been field verified.

Date: 03/24/2022
Title: Project Engineer

Certified by: GRC
Firm: Anderson Engineering Inc.

LEGEND

	PROP. STREET C		SLOPE DIRECTION	EOP = EDGE OF PAVEMENT
	PROP. RIGHT-OF-WAY		PROP. STREET PAVEMENT	TP = TOP OF PAVEMENT
	PROP. UTILITY EASEMENT		PROP. 5' SIDEWALK	TS = TOP OF SIDEWALK
	PROP. BUILDING SETBACK		DRY CURB & GUTTER	B-B = BACK OF CURB TO BACK OF CURB
	PROP. LOT LINE			TYP = TYPICAL
	PROP. WATER LINE			
	PROP. SANITARY SEWER			

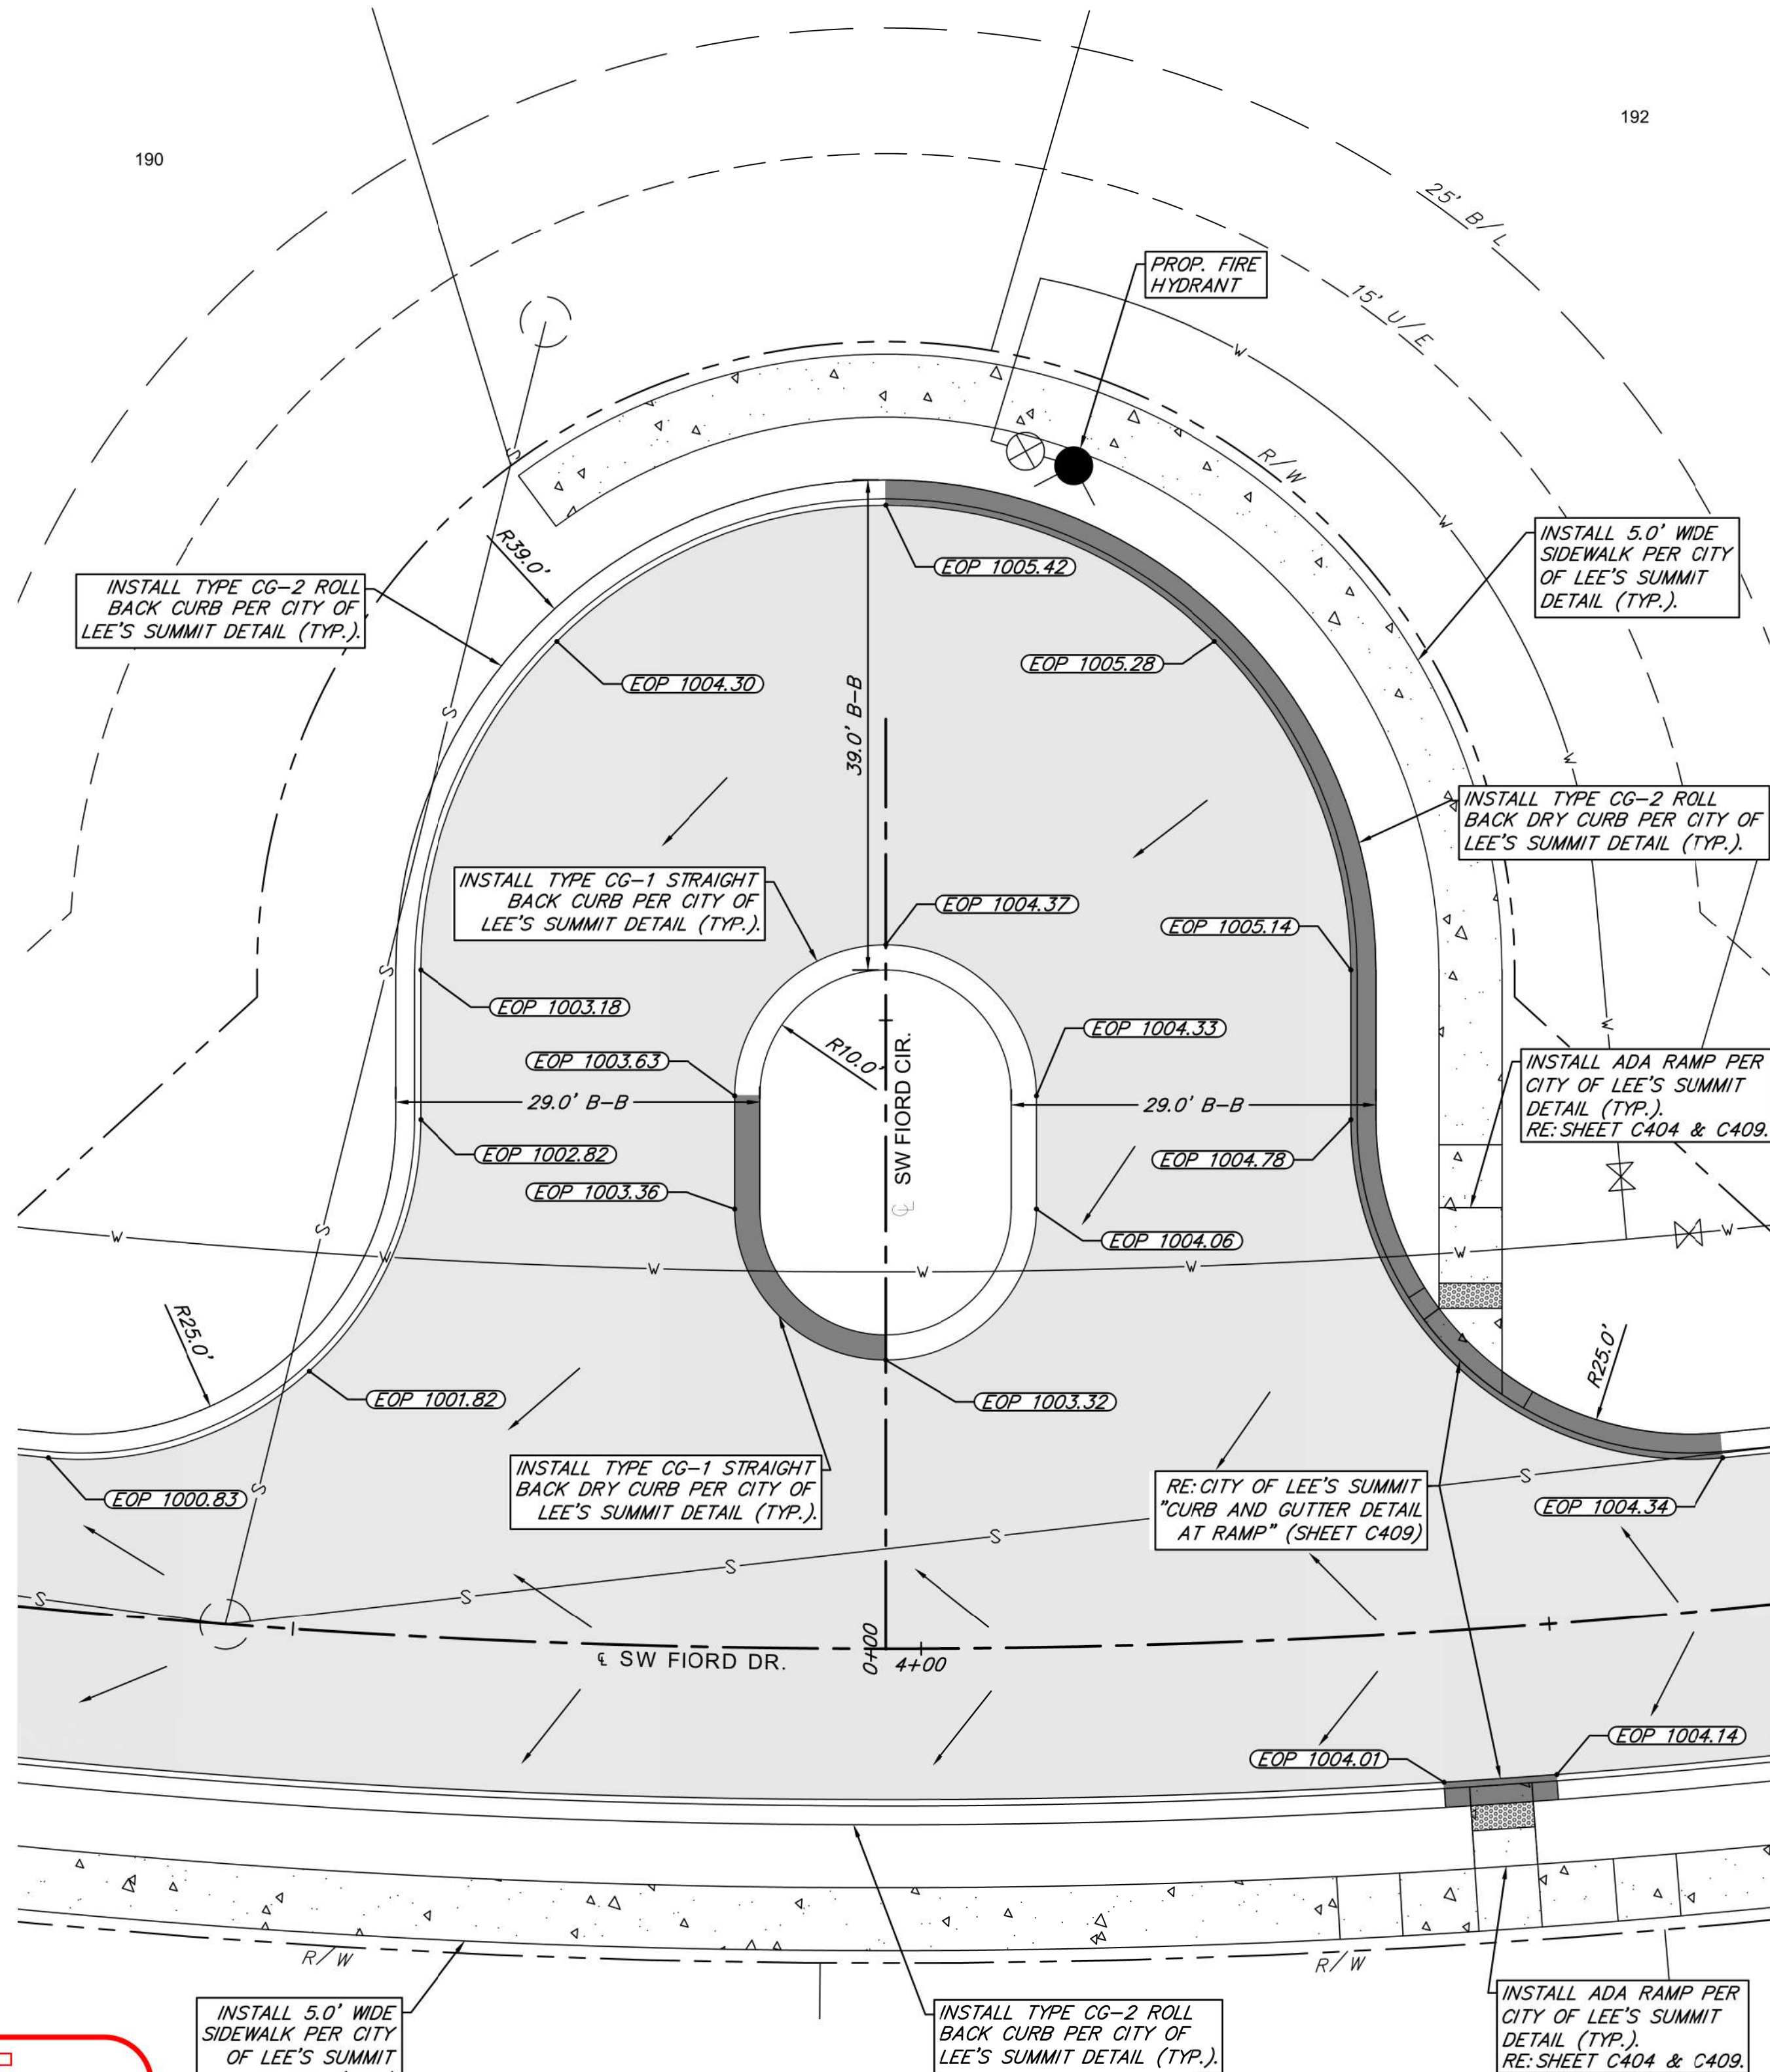

CUL-DE-SAC OF SW FIORD CIRCLE

RELEASE FOR
CONSTRUCTION
AS NOTED ON PLANS REVIEW
DEVELOPMENT SERVICES
LEE'S SUMMIT, MISSOURI

04/16/2021

SUMMIT HOMES KC
HIGHLAND MEADOWS - 6TH PLAT

CUL-DE-SAC DETAILS



SHEET NUMBER
C402
25 OF 42

REVISIONS		DRAWING INFO.	
NO.	DESCRIPTION	BY	DATE
1	REVISED PER CITY COMMENT	GC	2/11/21
2	AS-BUILT DRAWINGS	GC	3/16/22

DRAWN BY:	GC	CHECK BY:	ZM
LICENSE NO.	PE-2012009232	DATE:	1/7/2021
ISSUED FOR:	FOR REVIEW	JOB NUMBER:	20K10058
MO COA NO.	00062		


© COPYRIGHT ANDERSON ENGINEERING, INC. 2020

ANDERSON ENGINEERING
EMPLOYEE OWNED


AE

ENGINEERS • SURVEYORS • LABORATORIES • DRILLING
941 W. 141ST TER • KANSAS CITY, MISSOURI 64145 • PHONE (816) 777-0400
A LICENSED MISSOURI ENGINEERING & SURVEYING CORPORATION - LC 62


Feb 11, 2021 - 6:10pm Plotted By: gac G:\Shared drives\KCTO - Land Development\Projects\2020\20K10058 Highland Meadows - 6th Plat\01 CIVIL\03-DWG\Sheet\STREET AND STORM\20K10058 - SHY - INTERSECTION DETAILS.dwg Layout: MATCH EXISTING PAVEMENT DETAILS

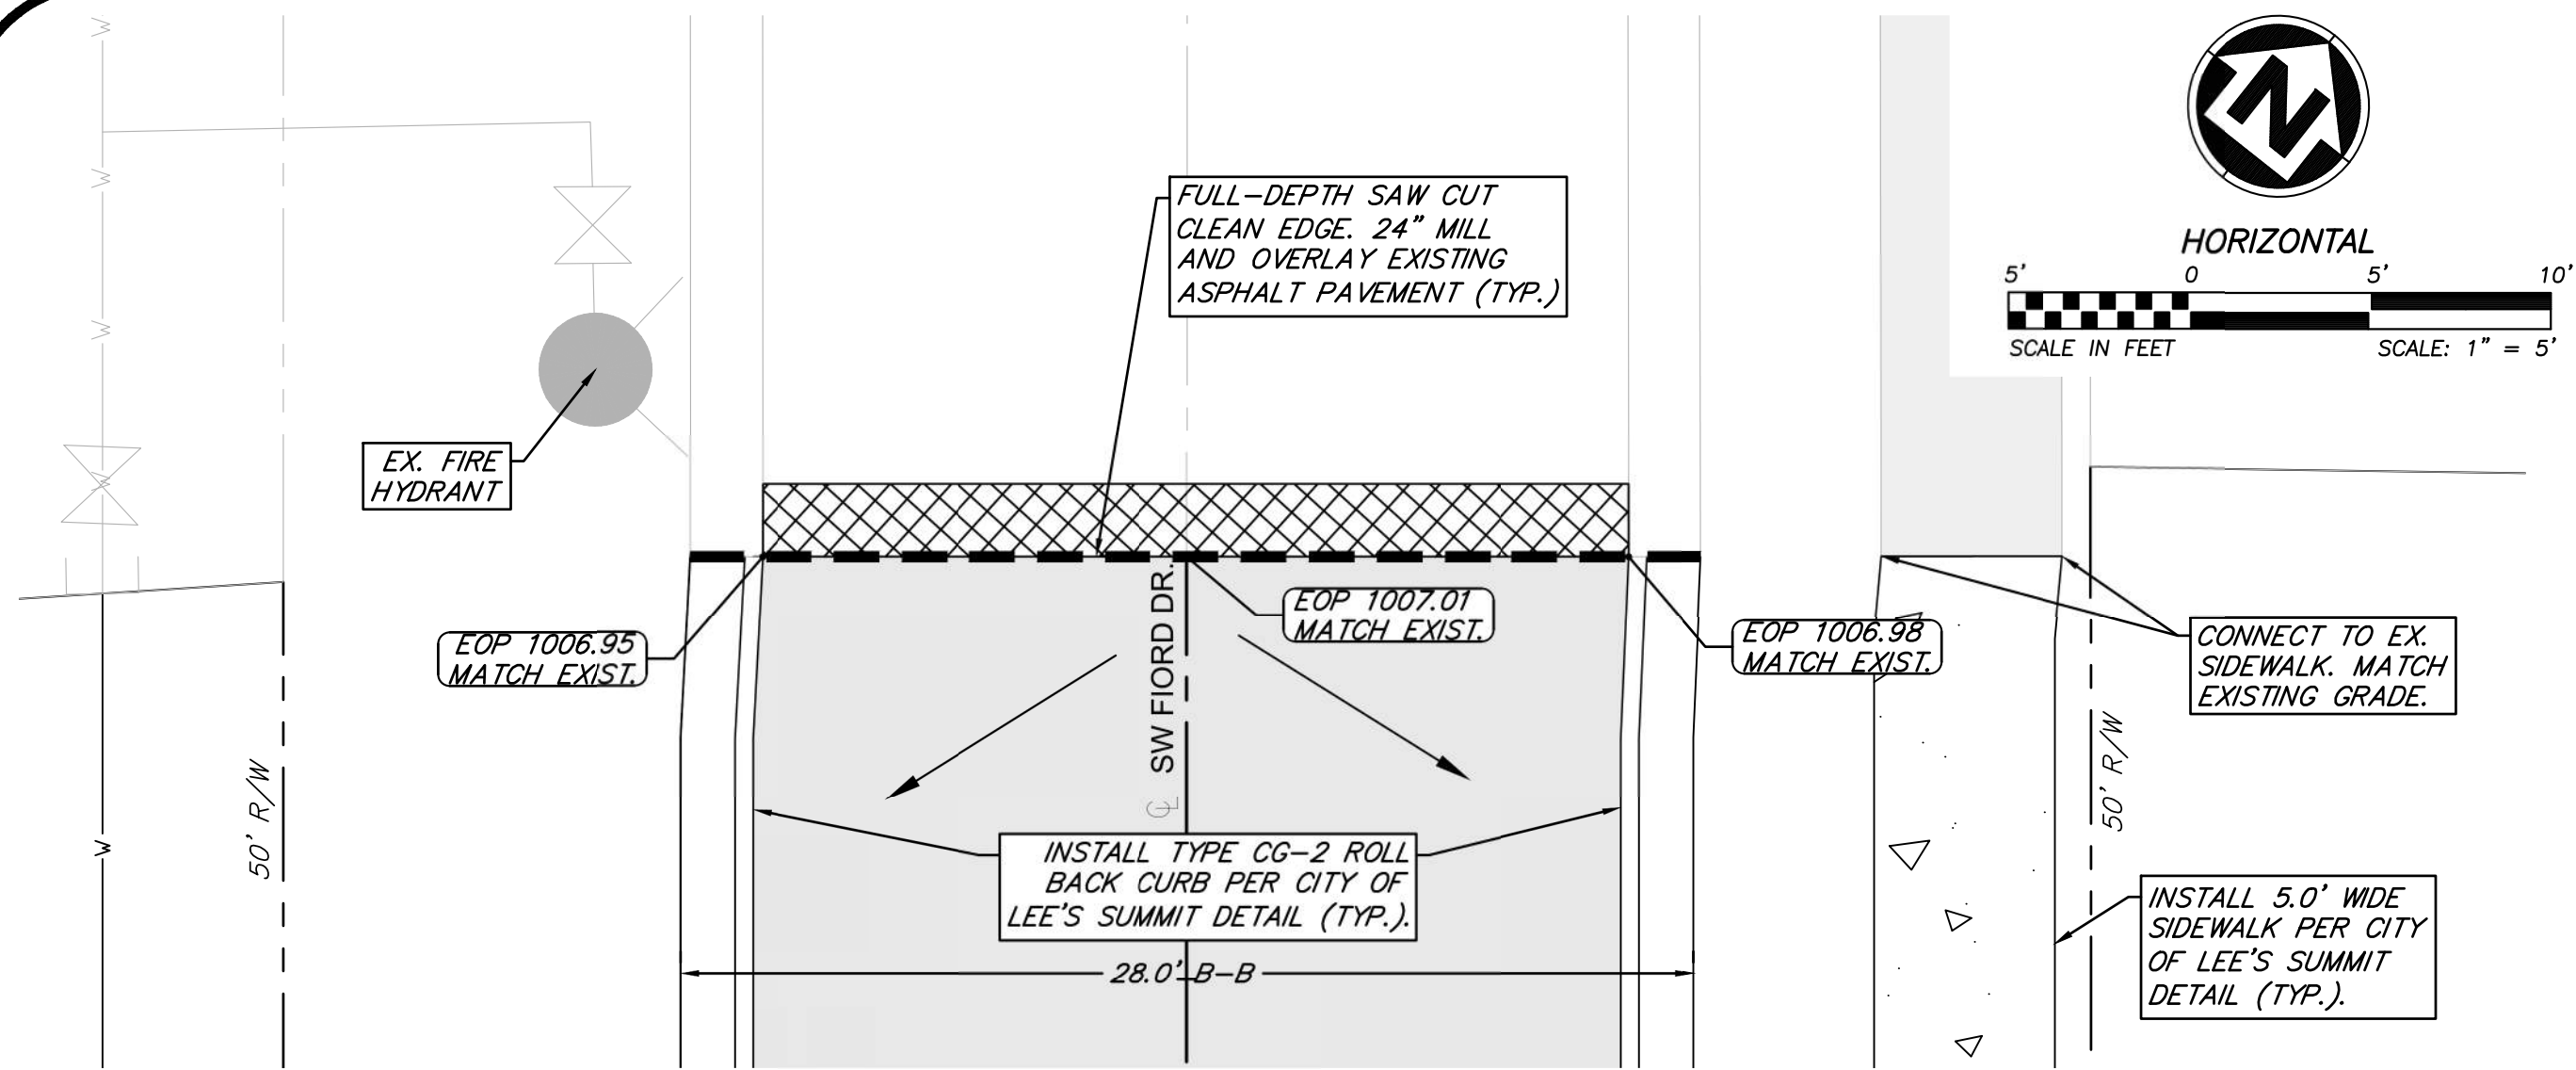


CONNECTION AT SW FIORD DRIVE

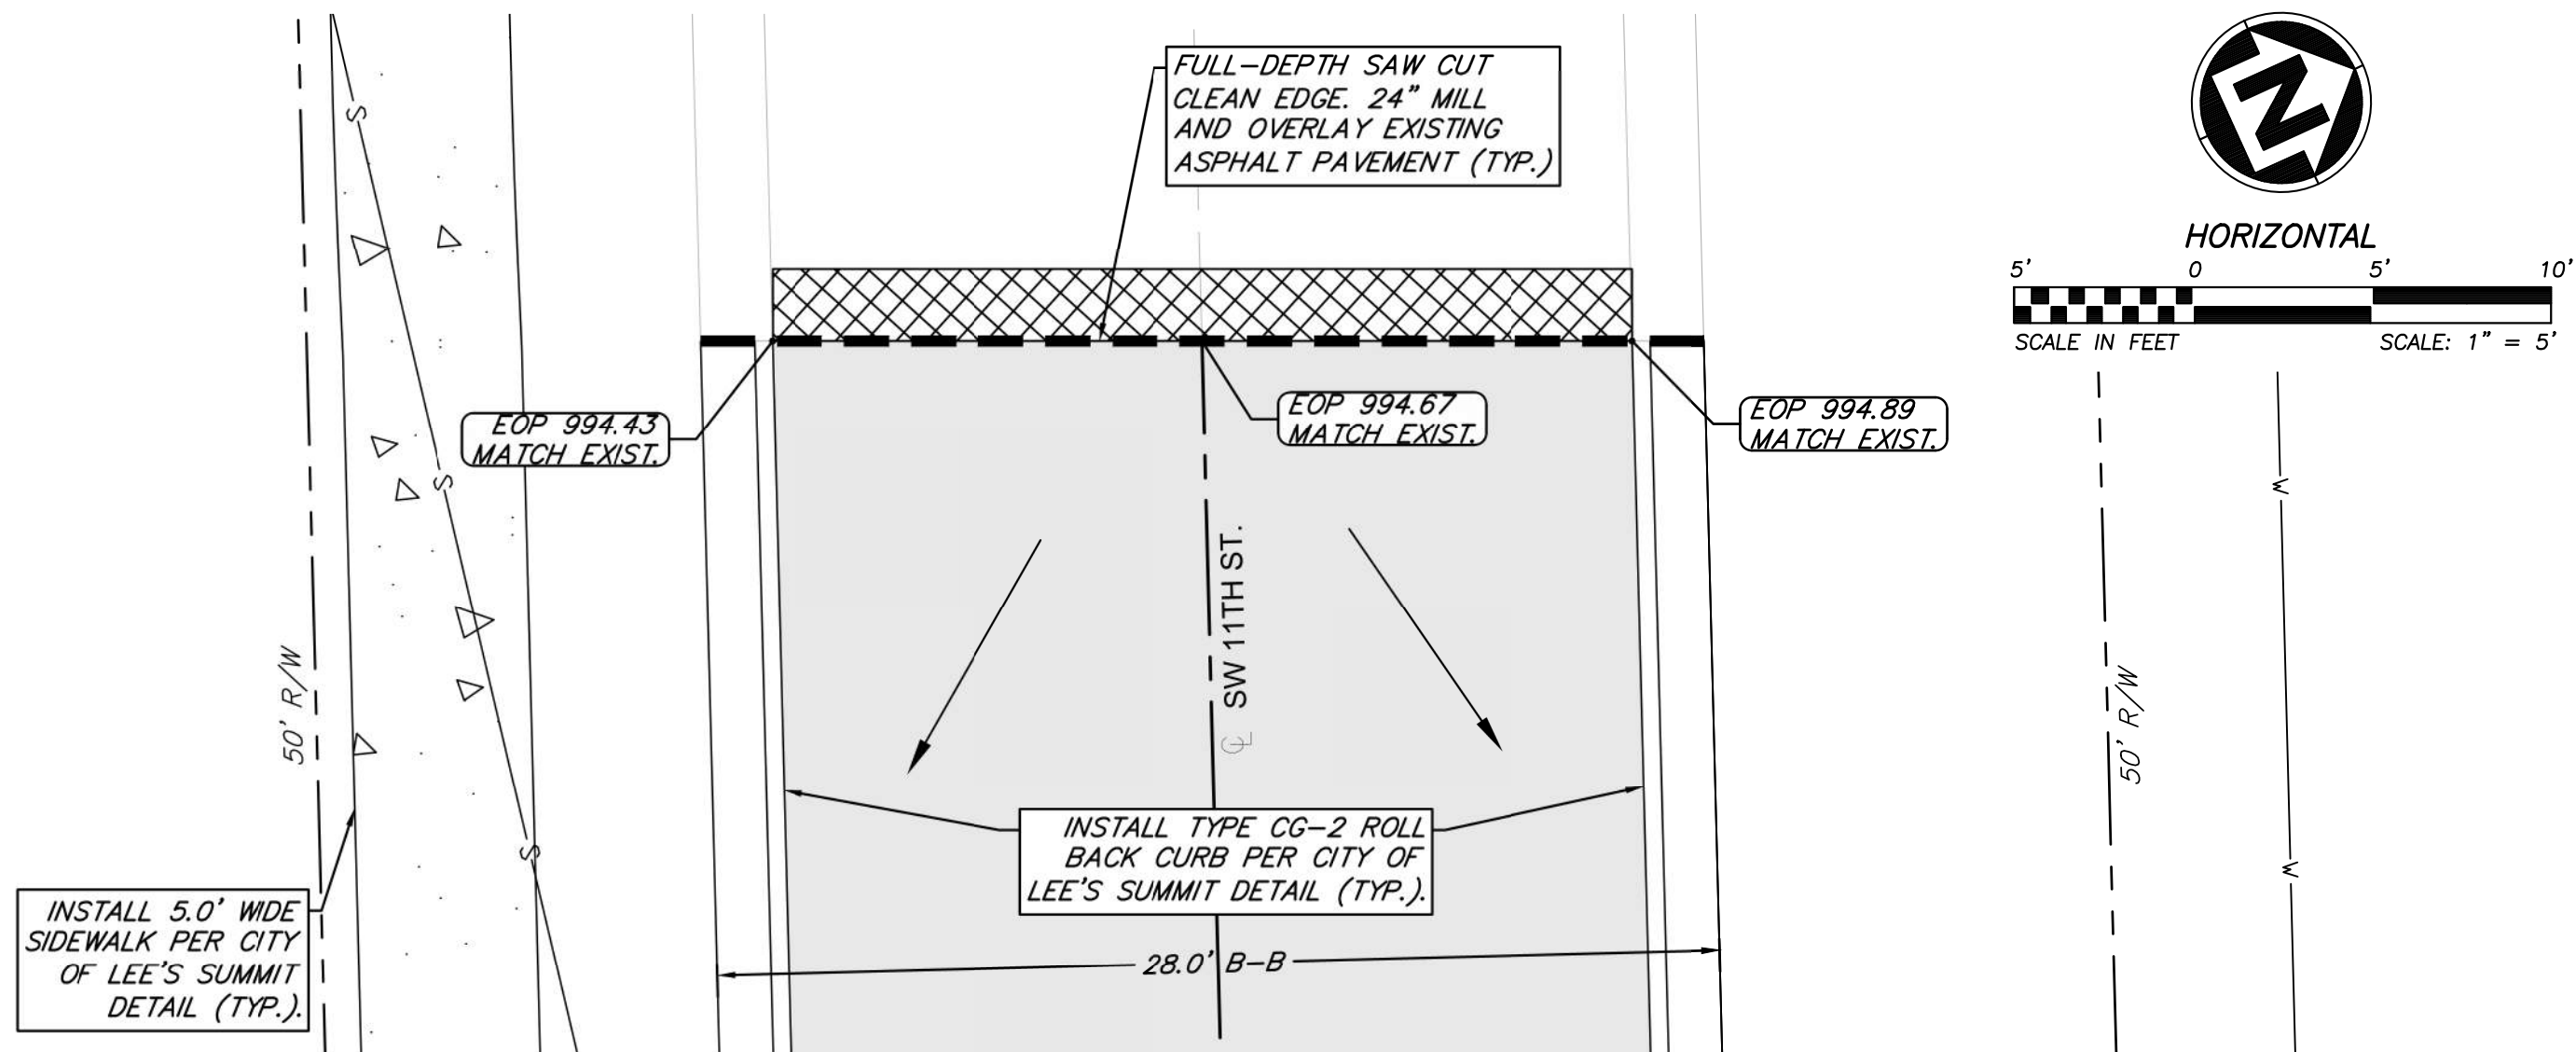


CONNECTION AT SW 11TH STREET

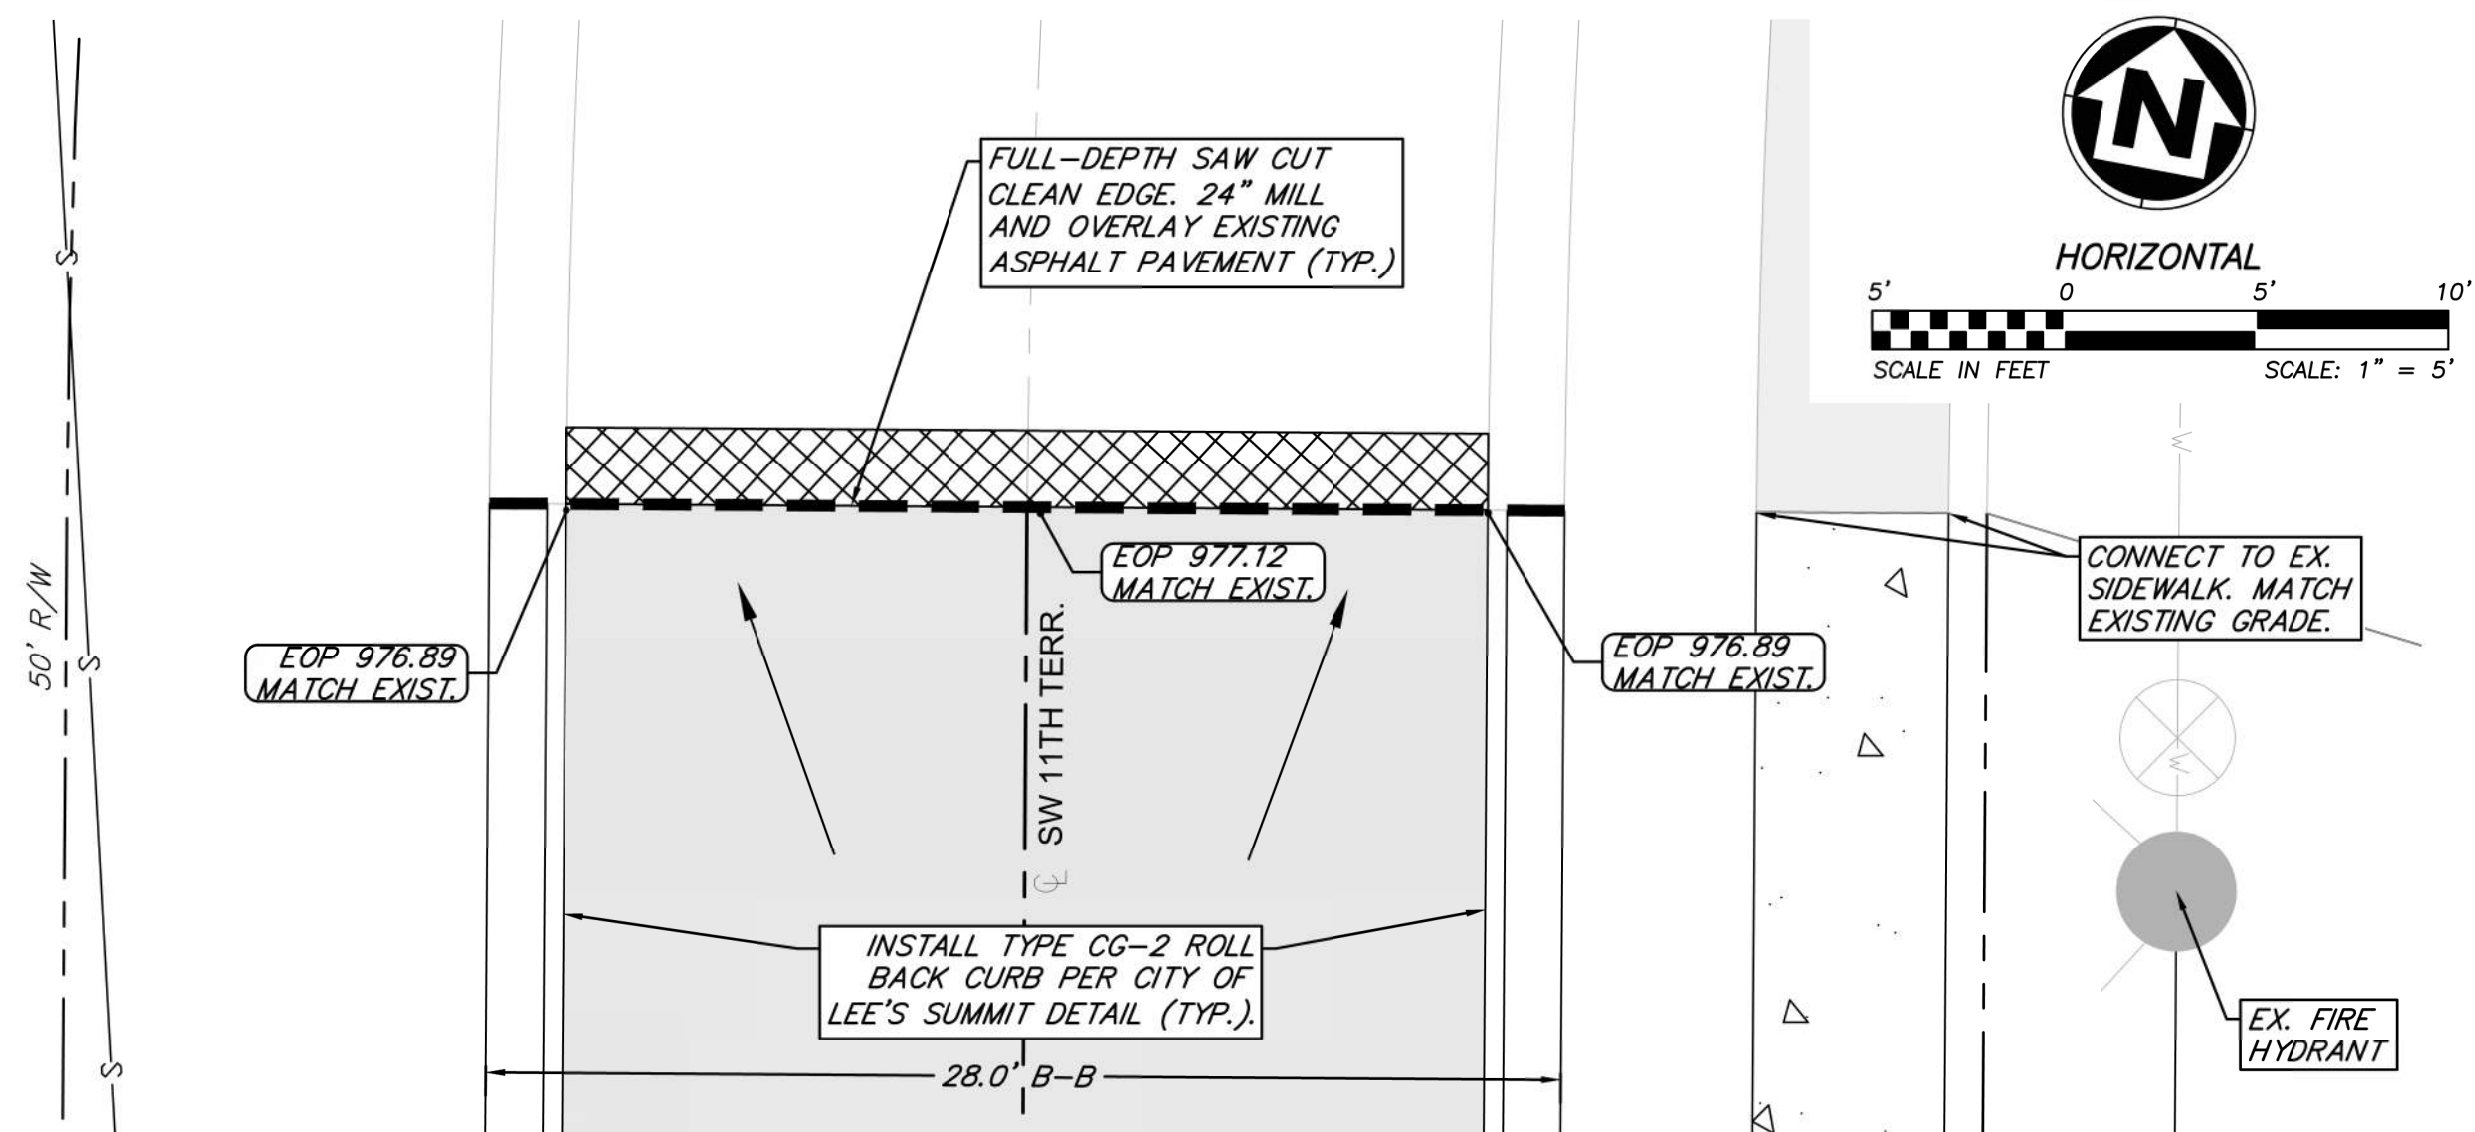


CONNECTION AT SW 11TH TERRACE

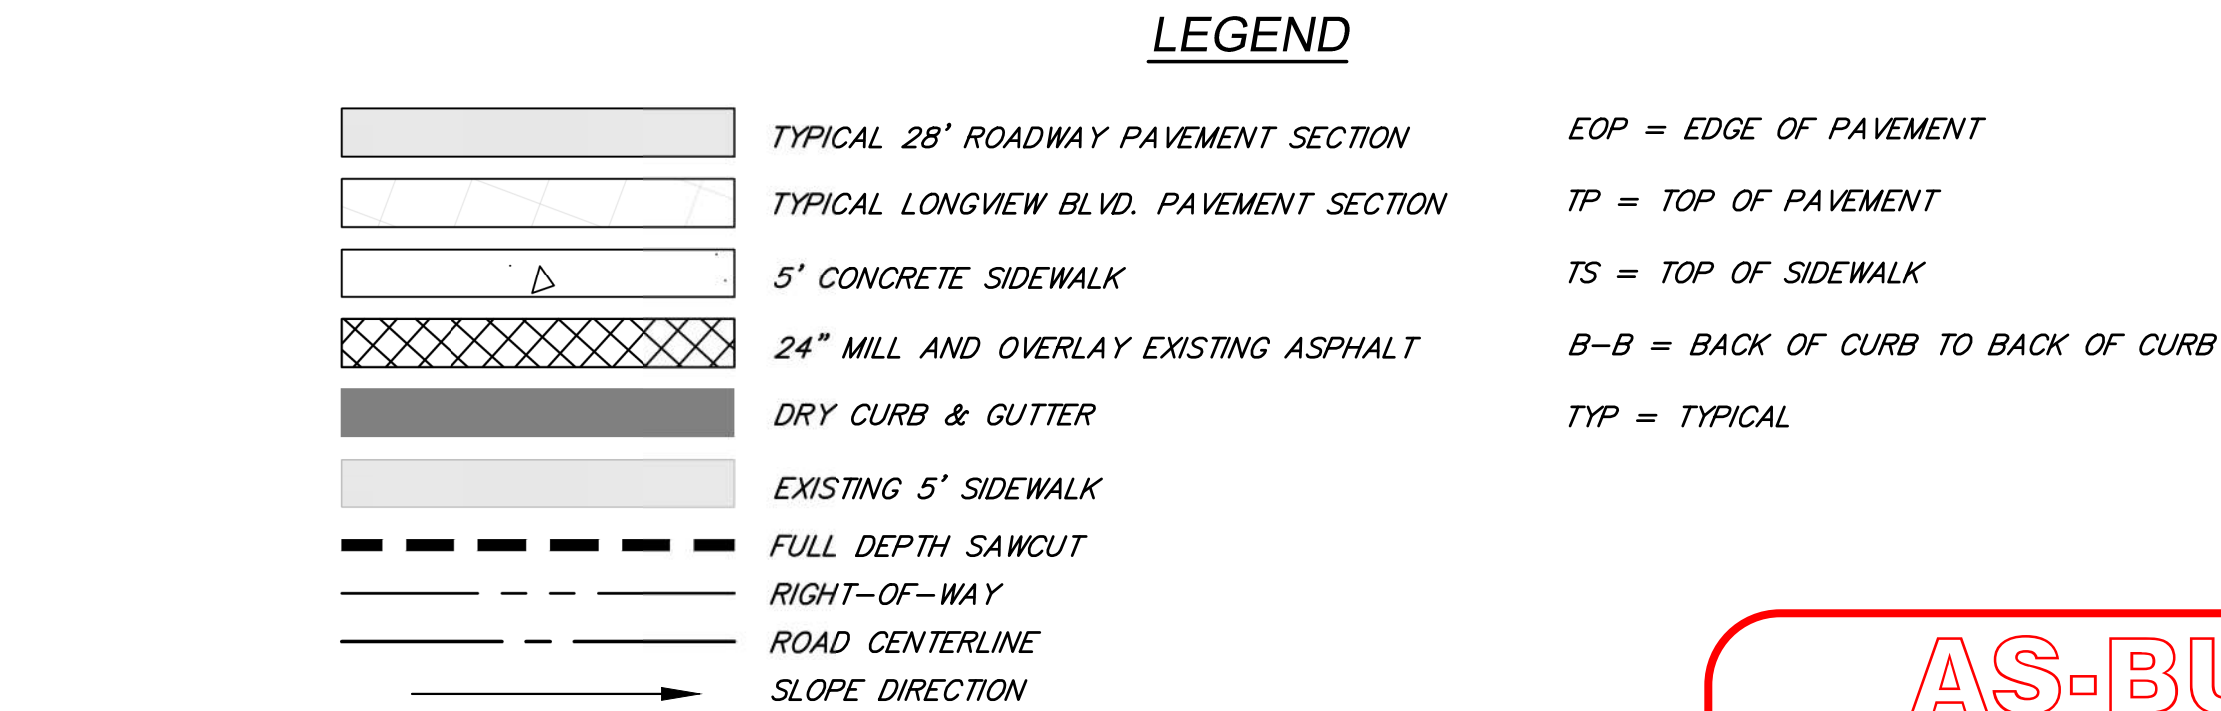

AS-BUILT
The information provided on this drawing conforms to construction records; it is not intended for construction, implementation or recording purposes; and it is solely based on information provided by others / obtained by my firm(s). 2400-psi (100 10\"/>

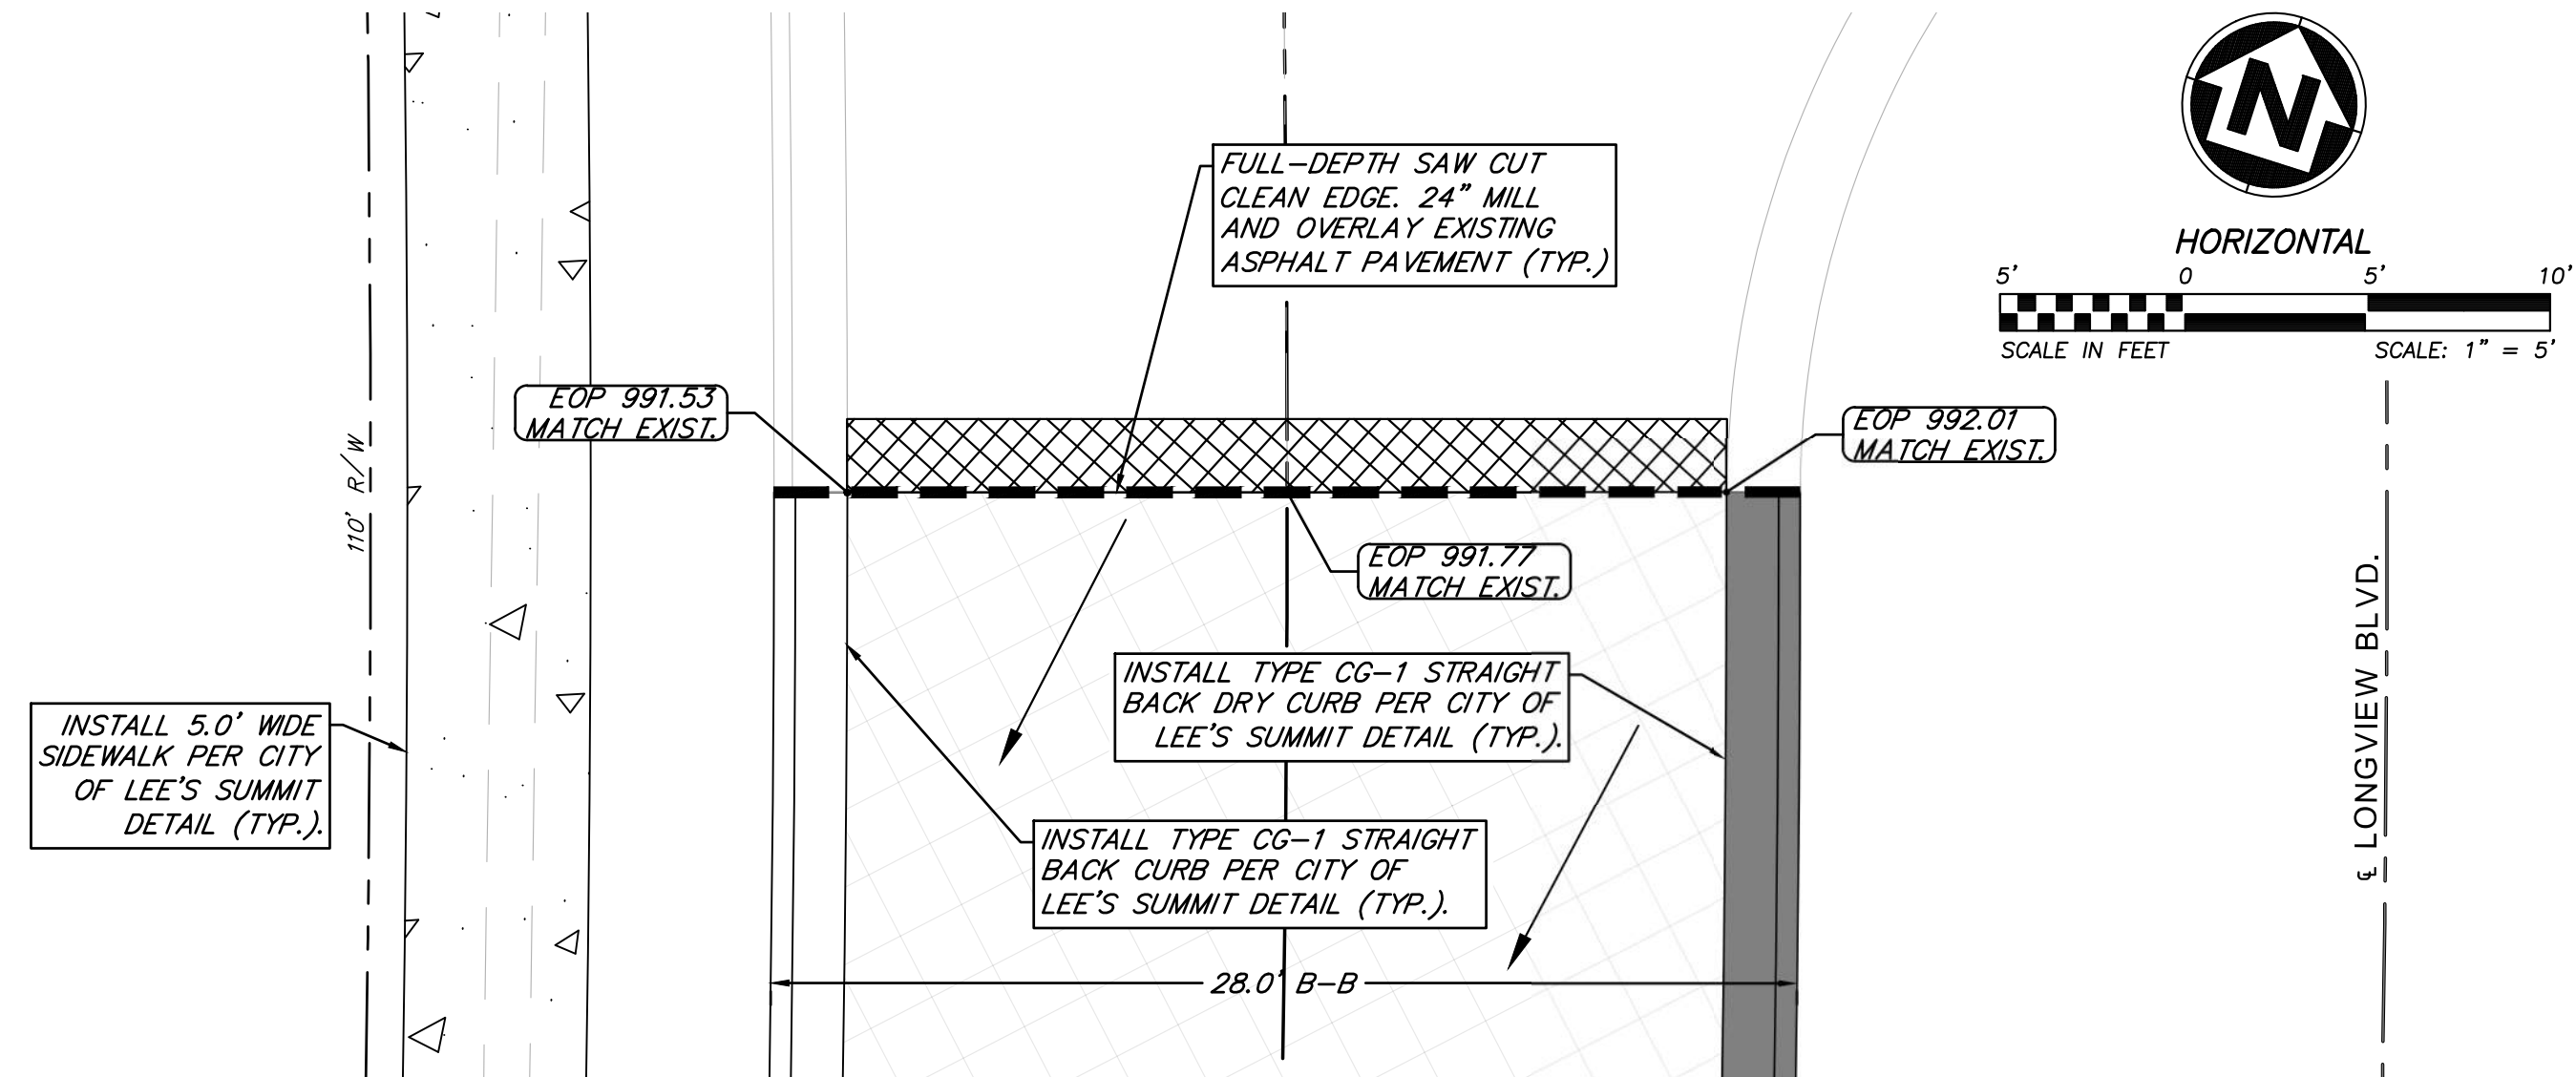

CONNECTION AT INTERSECTION OF LONGVIEW BLVD. & SW 11TH STREET

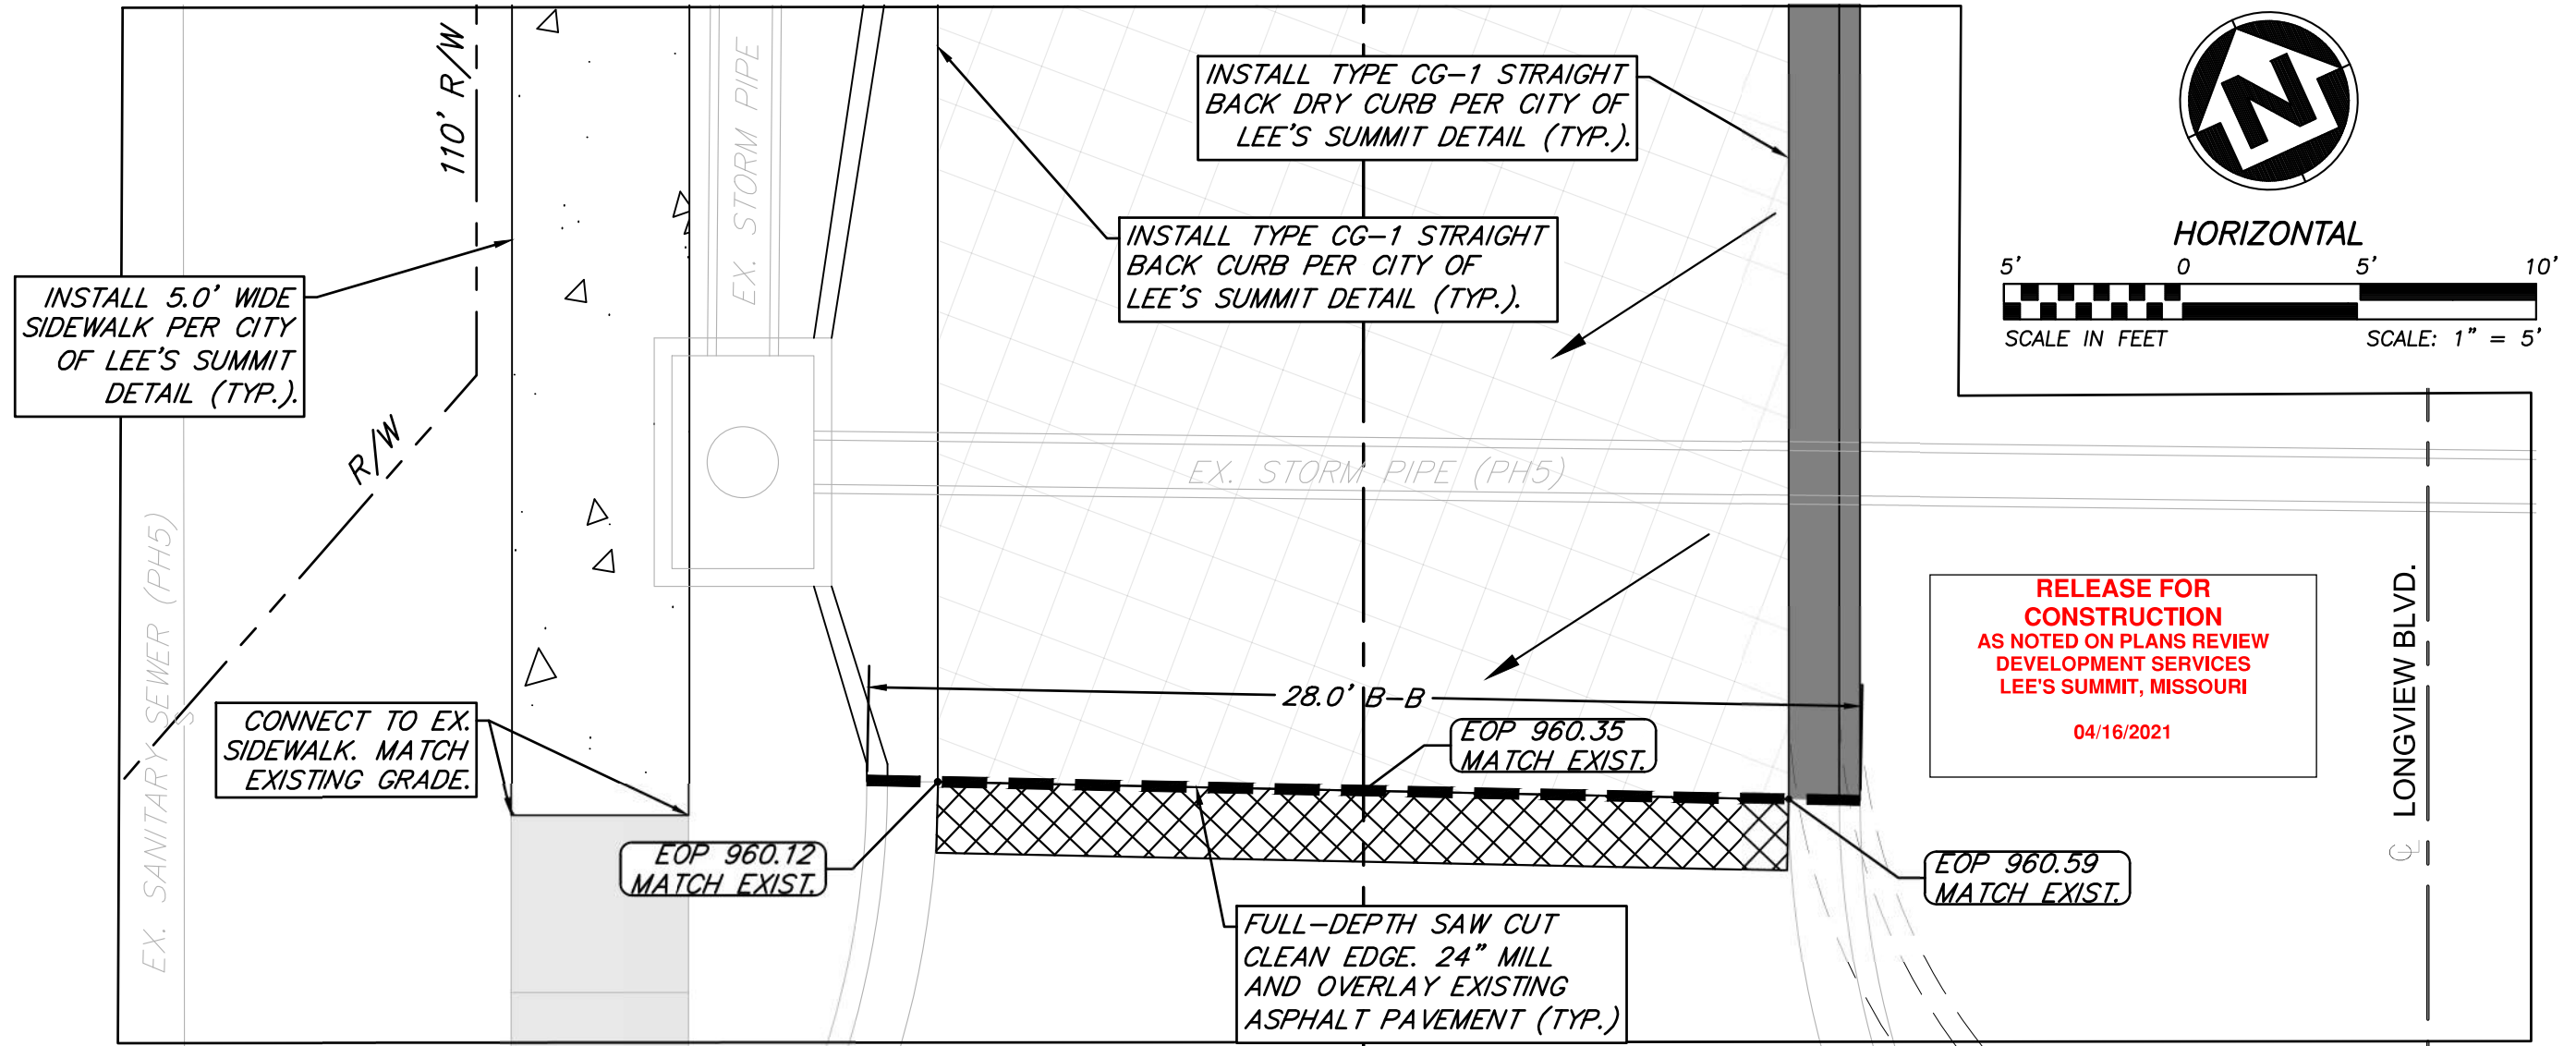

CONNECTION AT INTERSECTION OF LONGVIEW BLVD. & SW 12TH STREET










ANDERSON ENGINEERING
EMPLOYEE OWNED
ENGINEERS • SURVEYORS • LABORATORIES • DRILLING
941 W. 141ST TER • KANSAS CITY, MISSOURI 64145 • PHONE (816) 777-0400
A LICENSED MISSOURI ENGINEERING & SURVEYING CORPORATION - LC 62

DRAWING INFO.		REVISIONS		NO.	
BY	DATE	DESCRIPTION	BY	DATE	NO.
GC	2/11/21	1	GC	2/11/21	1
CHECK BY:		REVISED PER CITY COMMENT	CHECK BY:		
DATE:			DATE:		
ISSUED FOR:			ISSUED FOR:		
JOB NUMBER:			JOB NUMBER:		
MO COA NO.			MO COA NO.		

SUMMIT HOMES KC
HIGHLAND MEADOWS - 6TH PLAT
MATCH EXISTING
PAVEMENT DETAILS
S10, T47N, R32W
LEE'S SUMMIT, JACKSON COUNTY, MISSOURI

STATE OF MISSOURI
ZACH A. MYERS
PROFESSIONAL ENGINEER
NUMBER 2012009232
2/14/21
SHEET NUMBER
C403
26 OF 42

Feb 11, 2021 - 6:10pm Plotted By: gac G:\Shared drives\KCTO - Land Development\Projects\2020\20K10058 Highland Meadows - 6th Plat\01 CIVIL\03-DWG\Sheet\STREET AND STORM\20K10058 - SHY - INTERSECTION DETAILS.dwg Layout: ADA RAMP PLAN

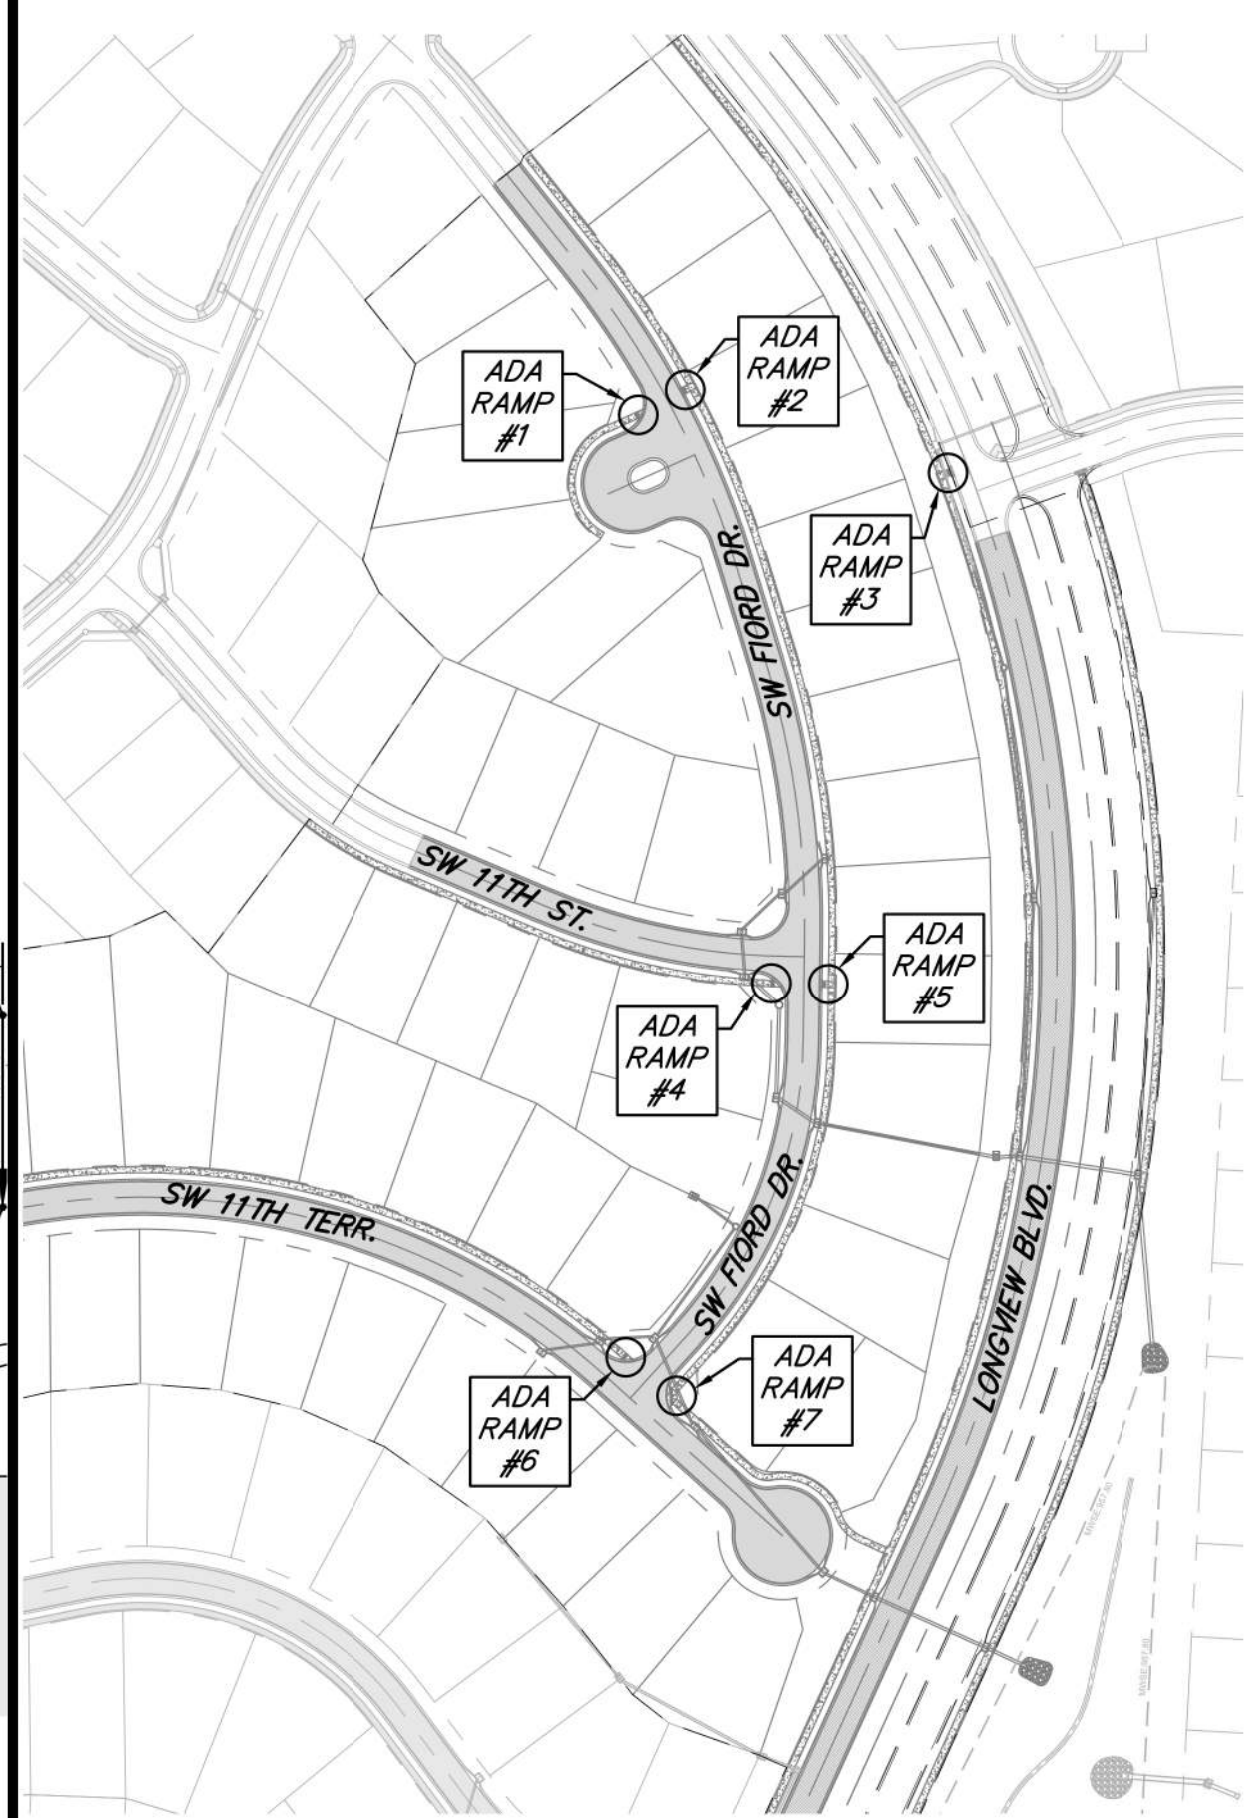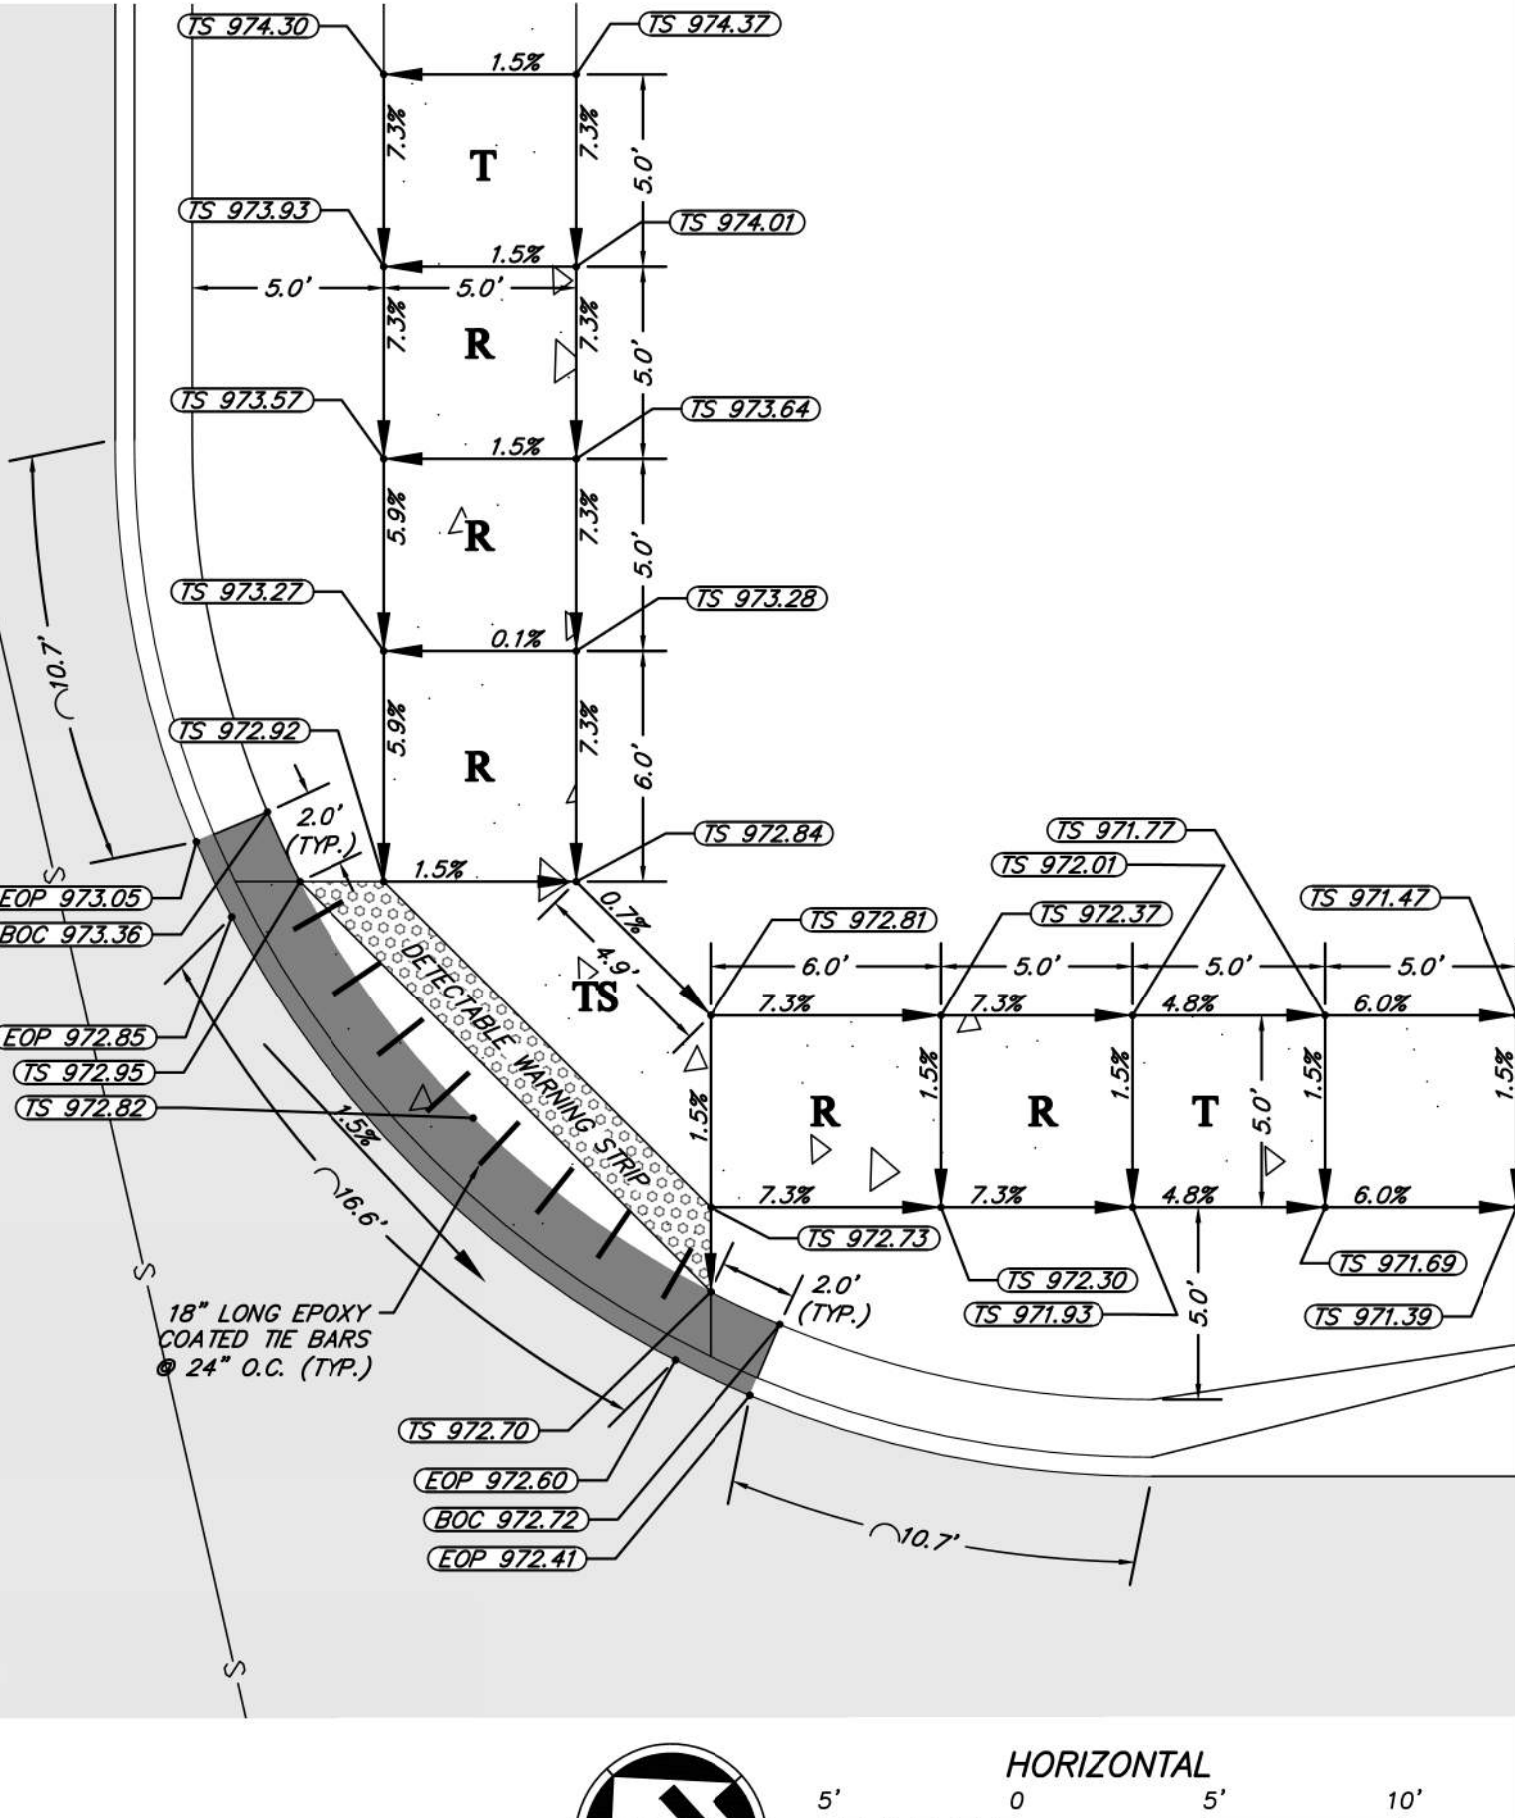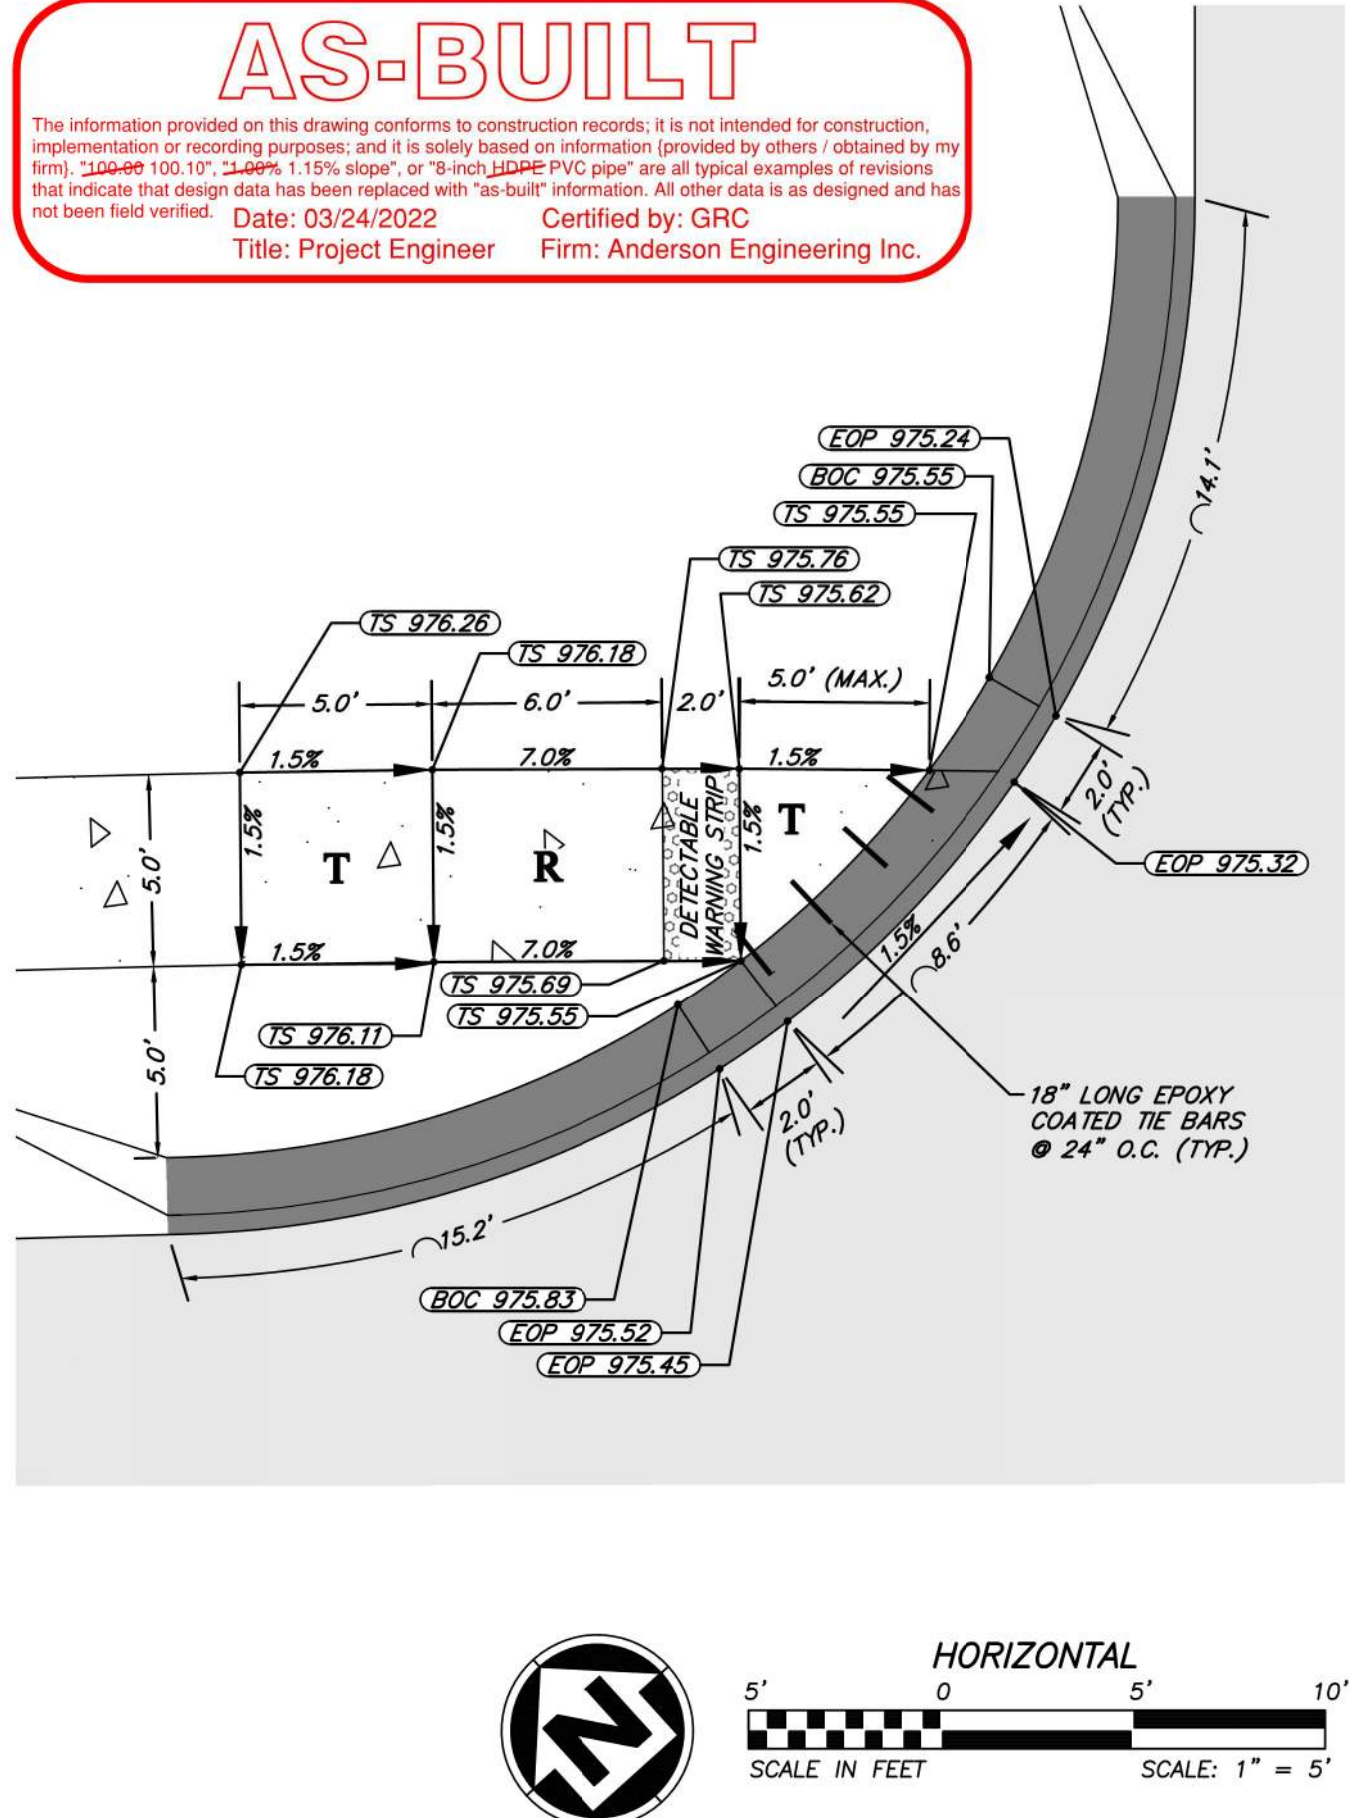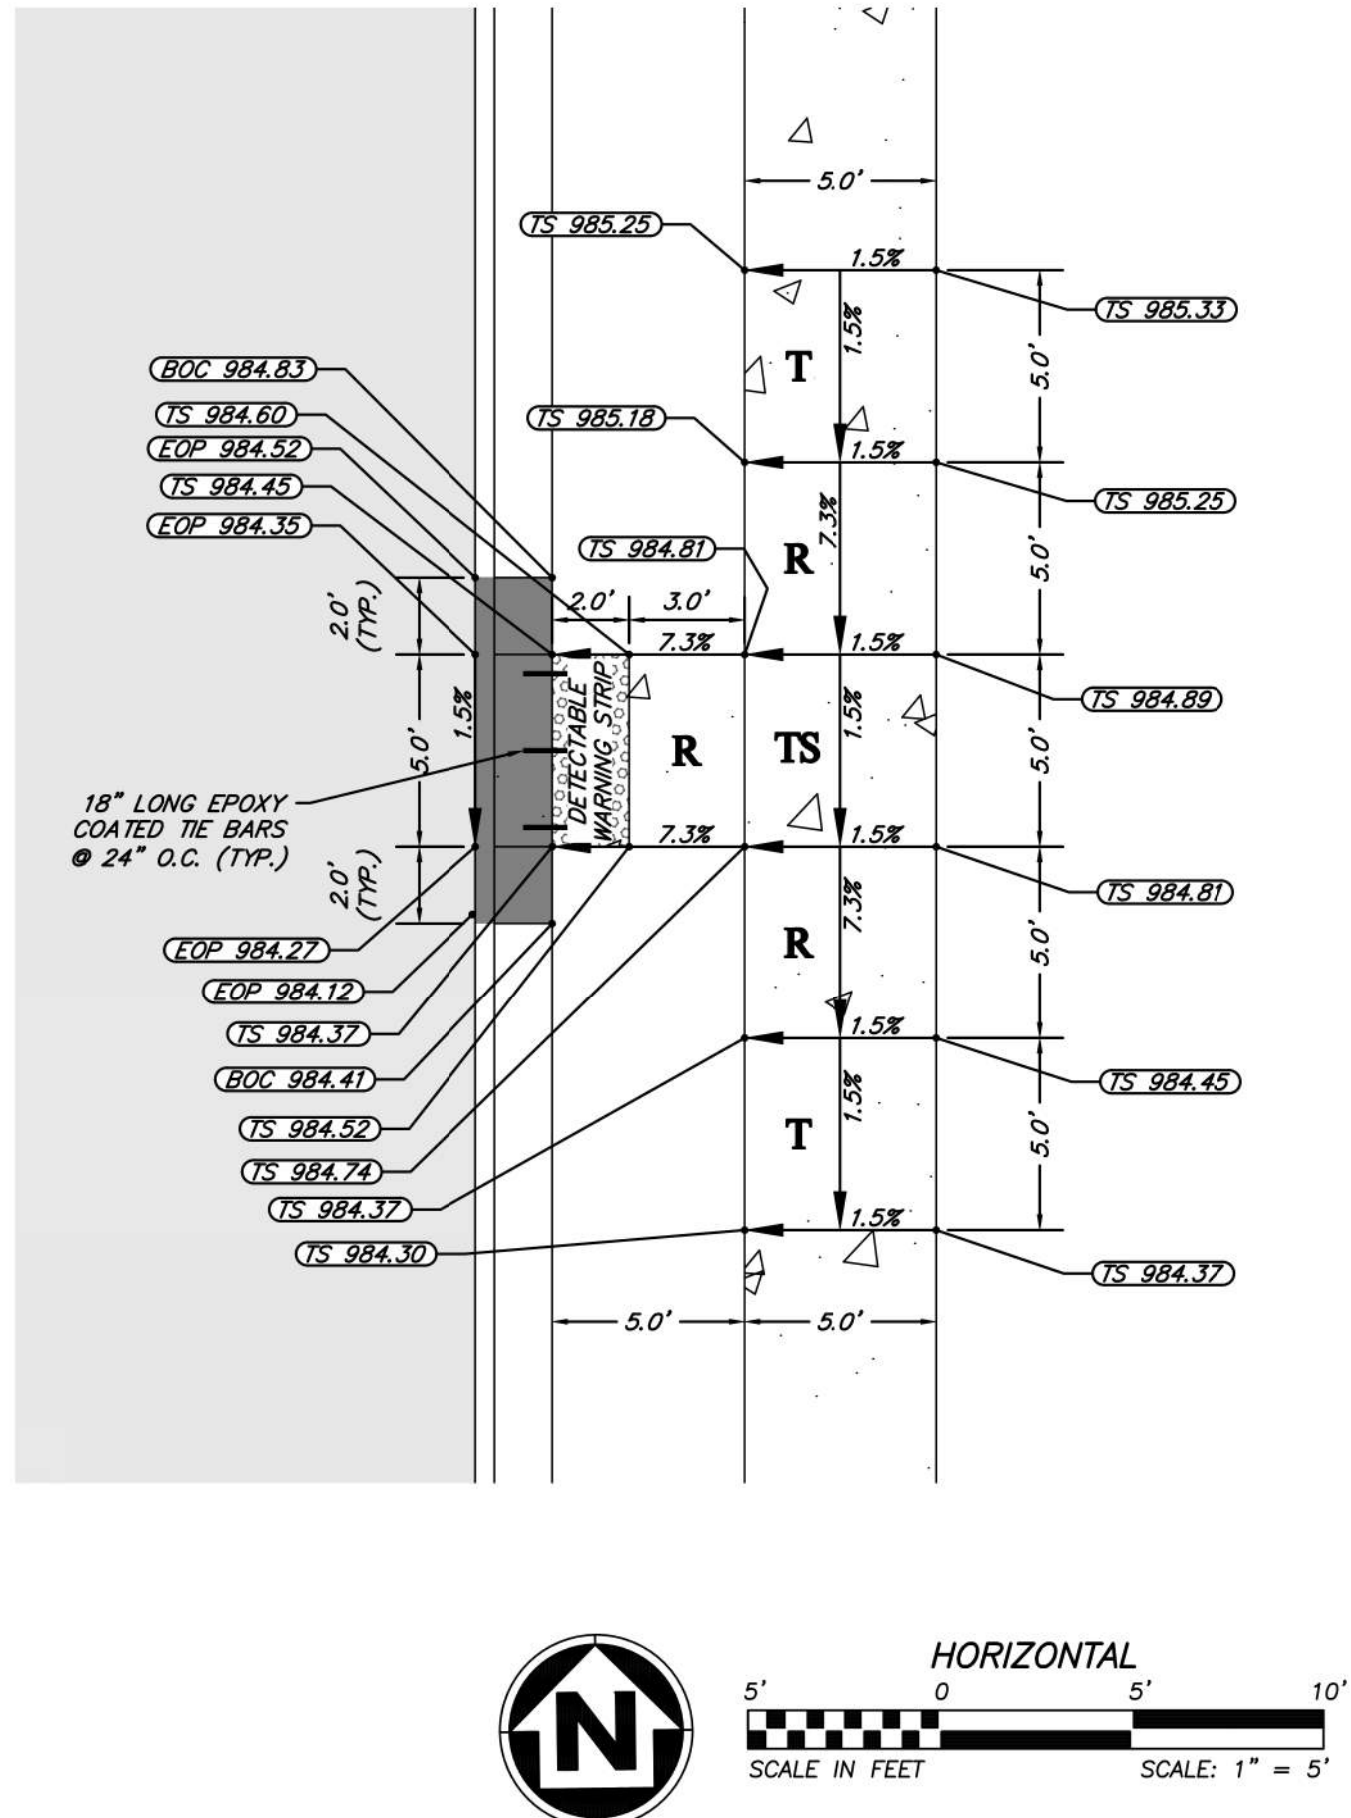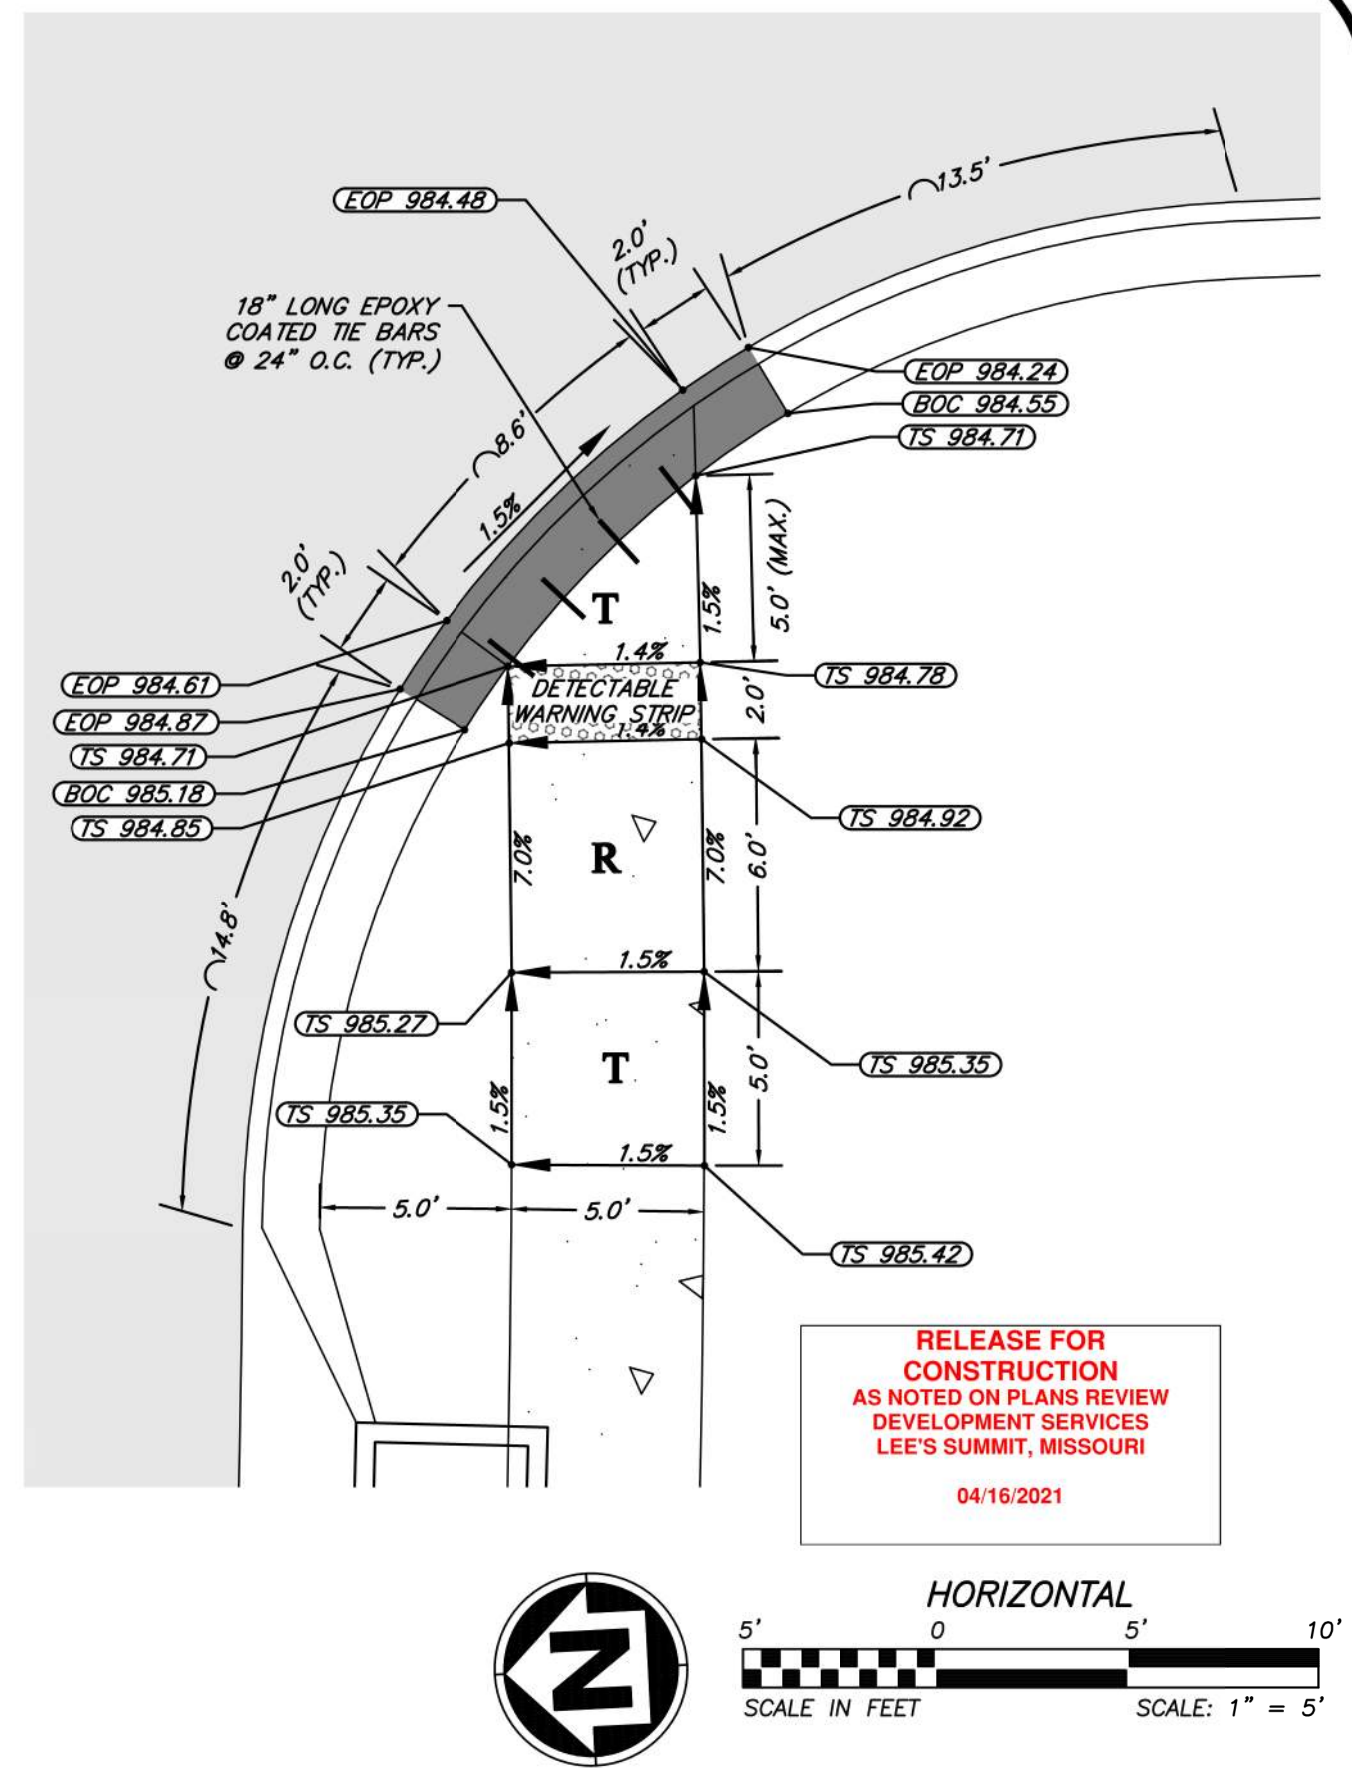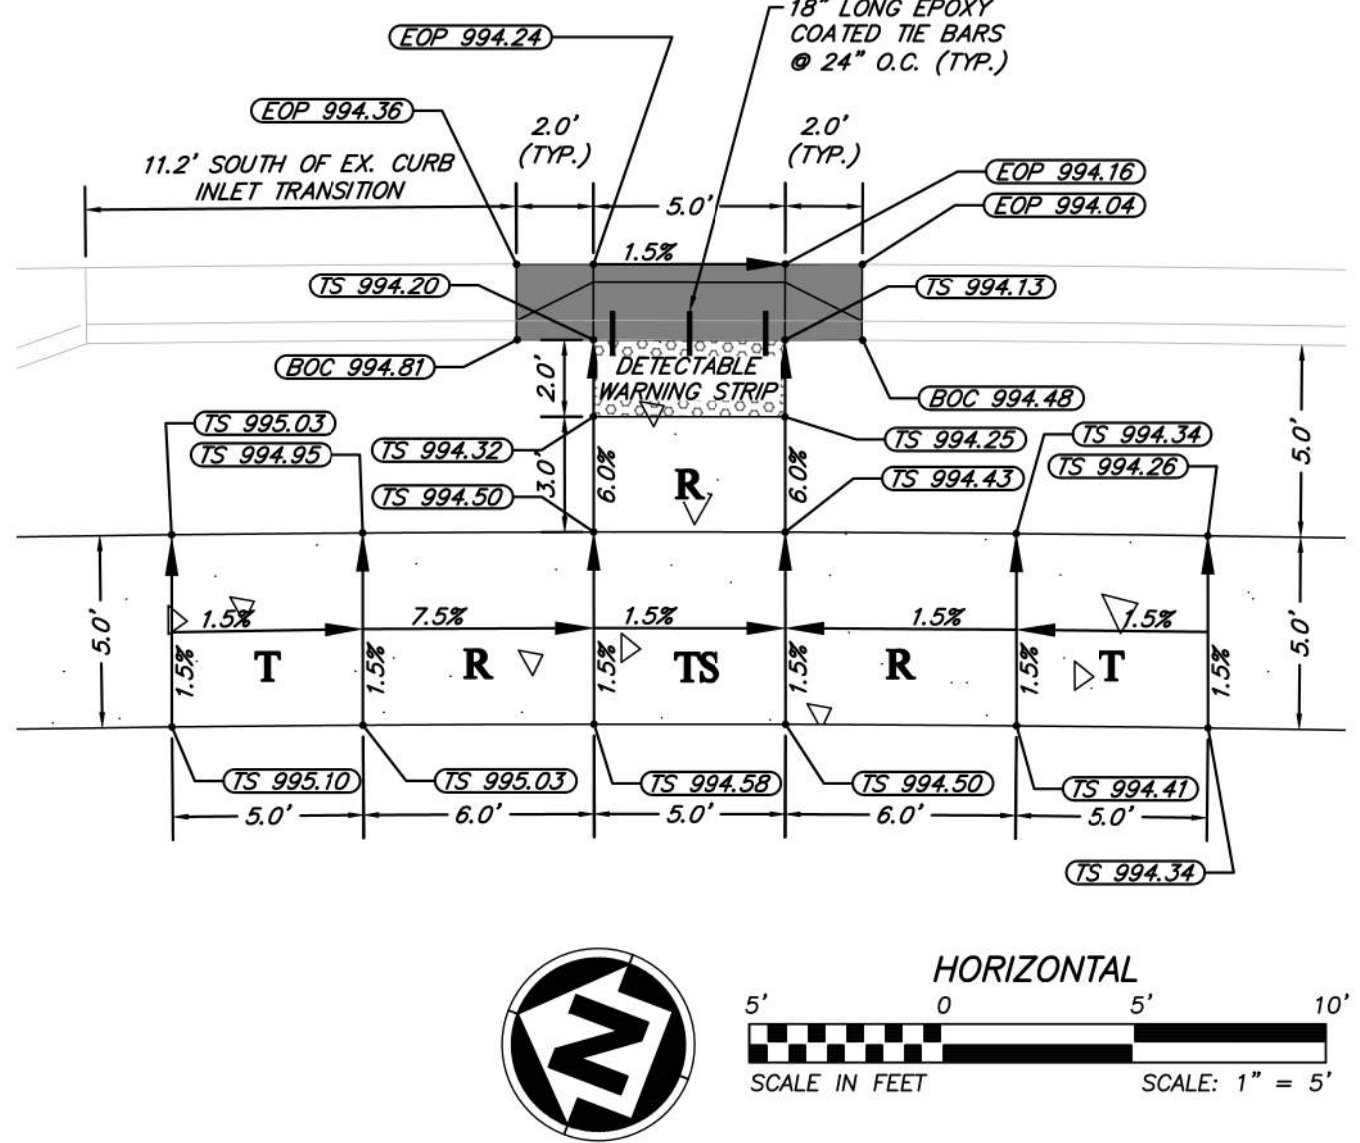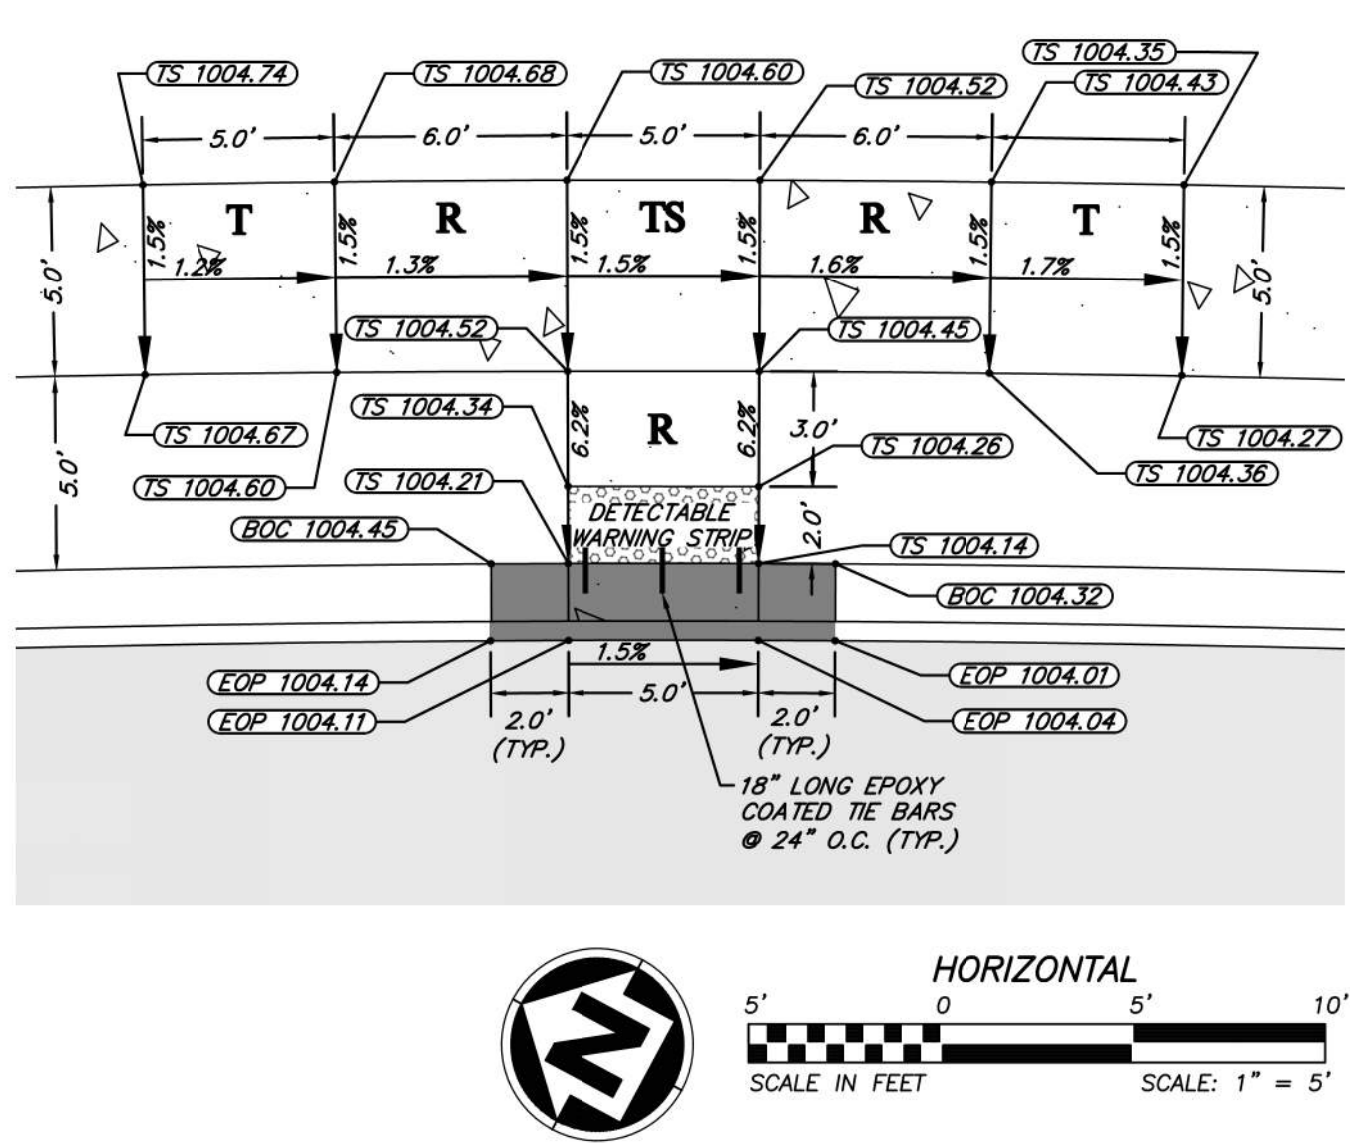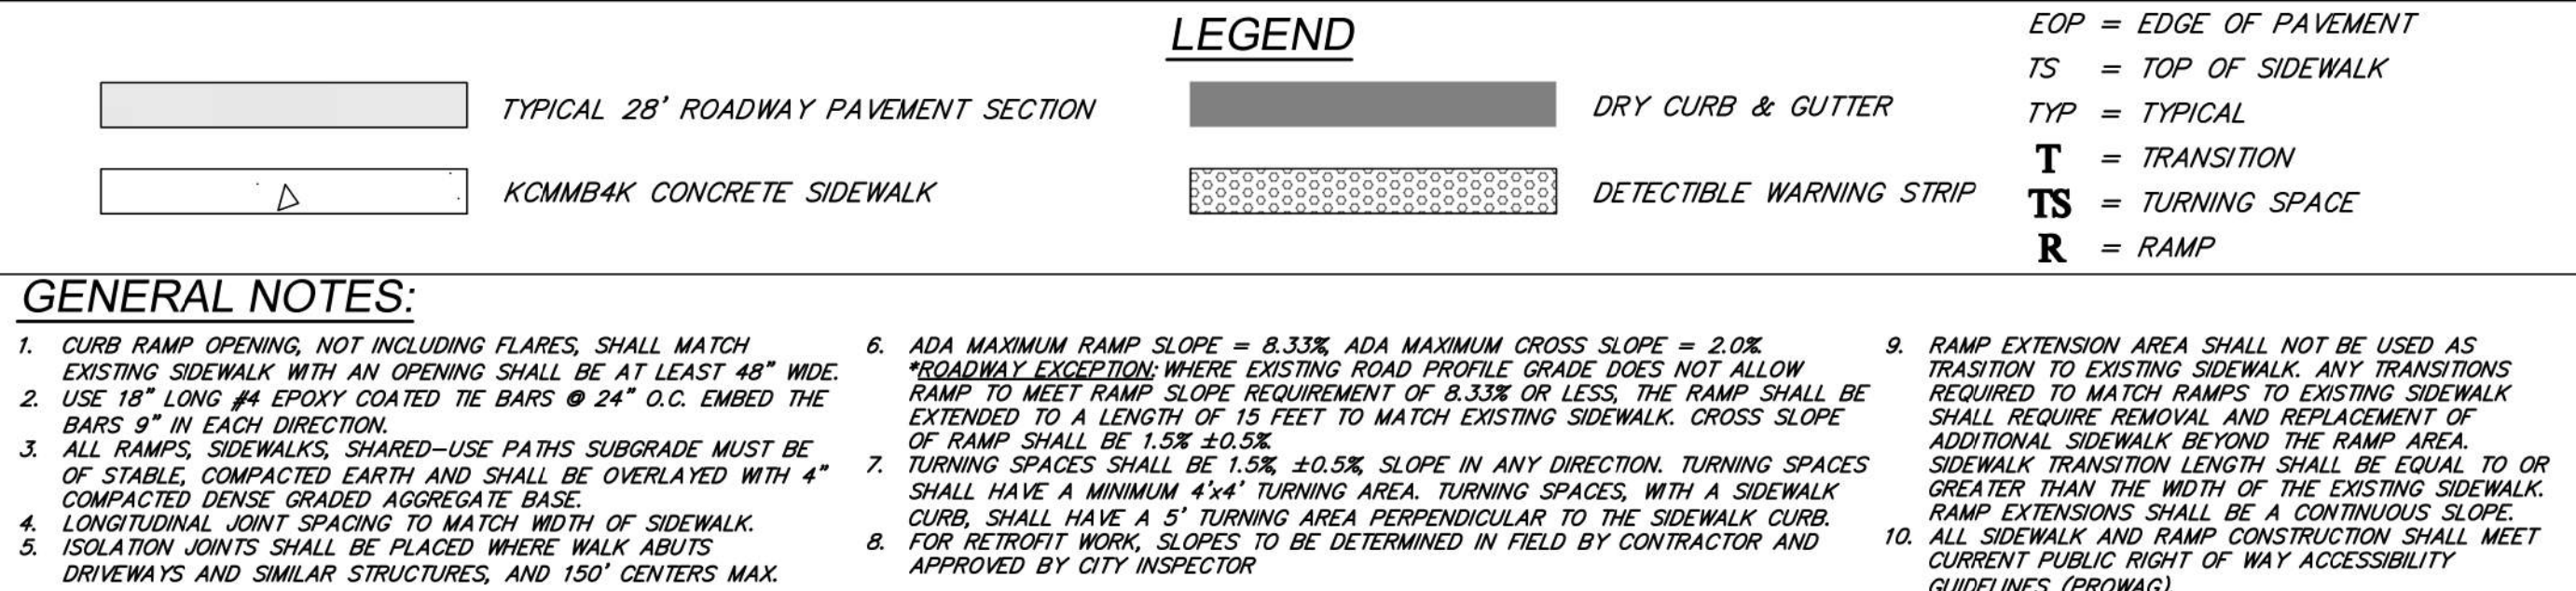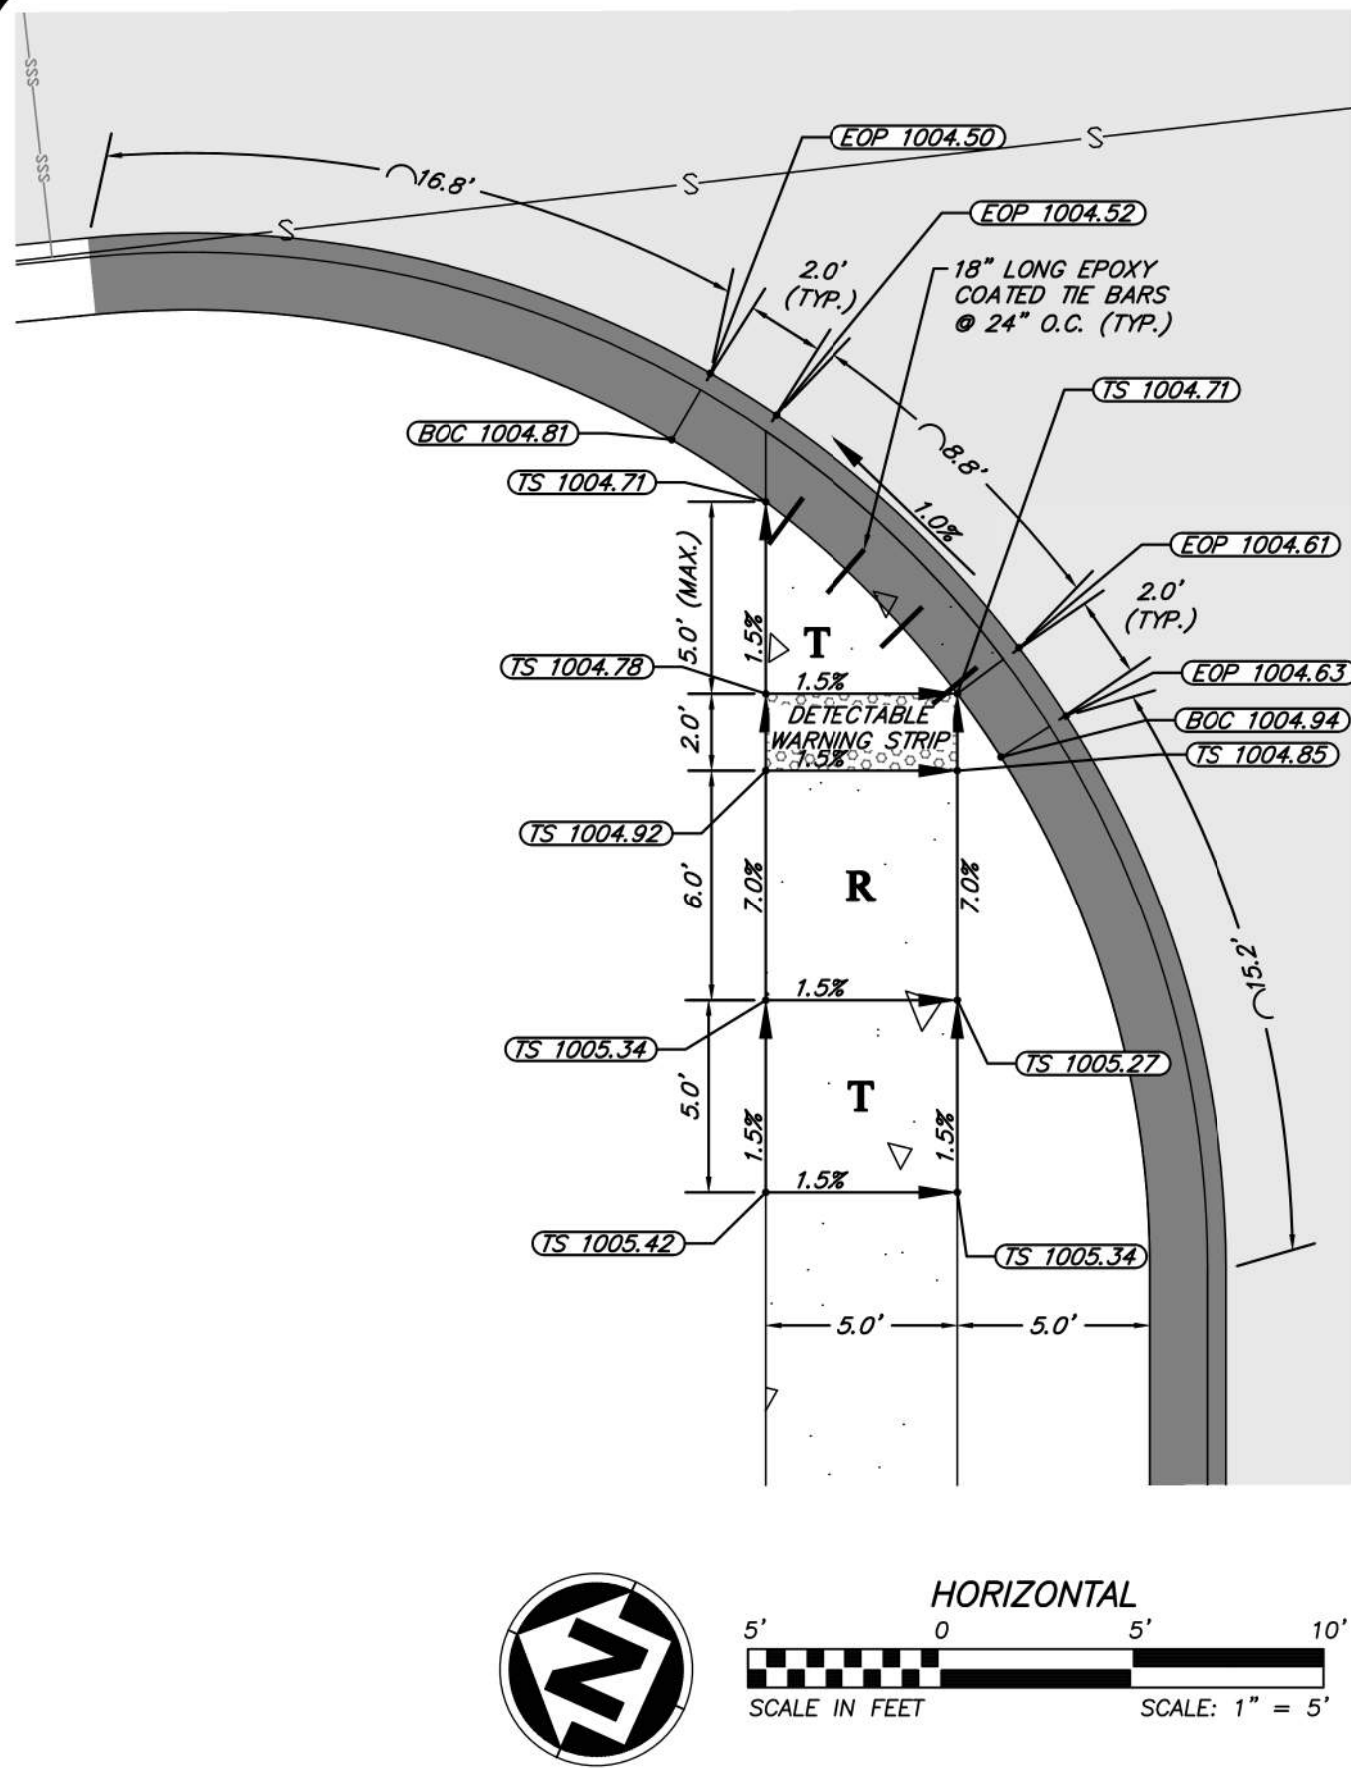

ANDERSON ENGINEERING
EMPLOYEE OWNED

ENGINEERS • SURVEYORS • LABORATORIES • DRILLING
941 W. 141ST TER • KANSAS CITY, MISSOURI 64145 • PHONE (816) 777-0400
A LICENSED MISSOURI ENGINEERING & SURVEYING CORPORATION - LC 62

DRAWING INFO.	
NO.	DESCRIPTION
1	REVISED PER CITY COMMENT
2	AS-BUILT DRAWINGS

BY	DATE	DRAWN BY:	CHECK BY:
GC	2/11/21	GC	ZM

LICENSE NO.	DATE	ISSUED FOR:	JOB NUMBER:	MO COA NO.
PE-2012009232	1/7/2021	FOR REVIEW	20K10058	00062

© COPYRIGHT ANDERSON ENGINEERING, INC. 2020

SUMMIT HOMES KC
HIGHLAND MEADOWS - 6TH PLAT









ADA RAMP PLAN

STATE OF MISSOURI
ZACH A. MYERS
REGISTERED PROFESSIONAL ENGINEER
NUMBER PE-2012009232
2/11/21

SHEET NUMBER
C404
27 OF 42

LEE'S SUMMIT, JACKSON COUNTY, MISSOURI
S10, T47N, R32W

Feb 11, 2021 - 6:11pm Plotted By: gsc G:\Shared drives\K1010 - Land Development\Projects\2020\20K100058 Highland Meadows - 6th Plat\01 CIVIL\03-DWG\Sheet\STREET AND STORM\20K100058 - SHY - INTERSECTION DETAILS.dwg Layout: ADA RAMP CROSS SECTIONS

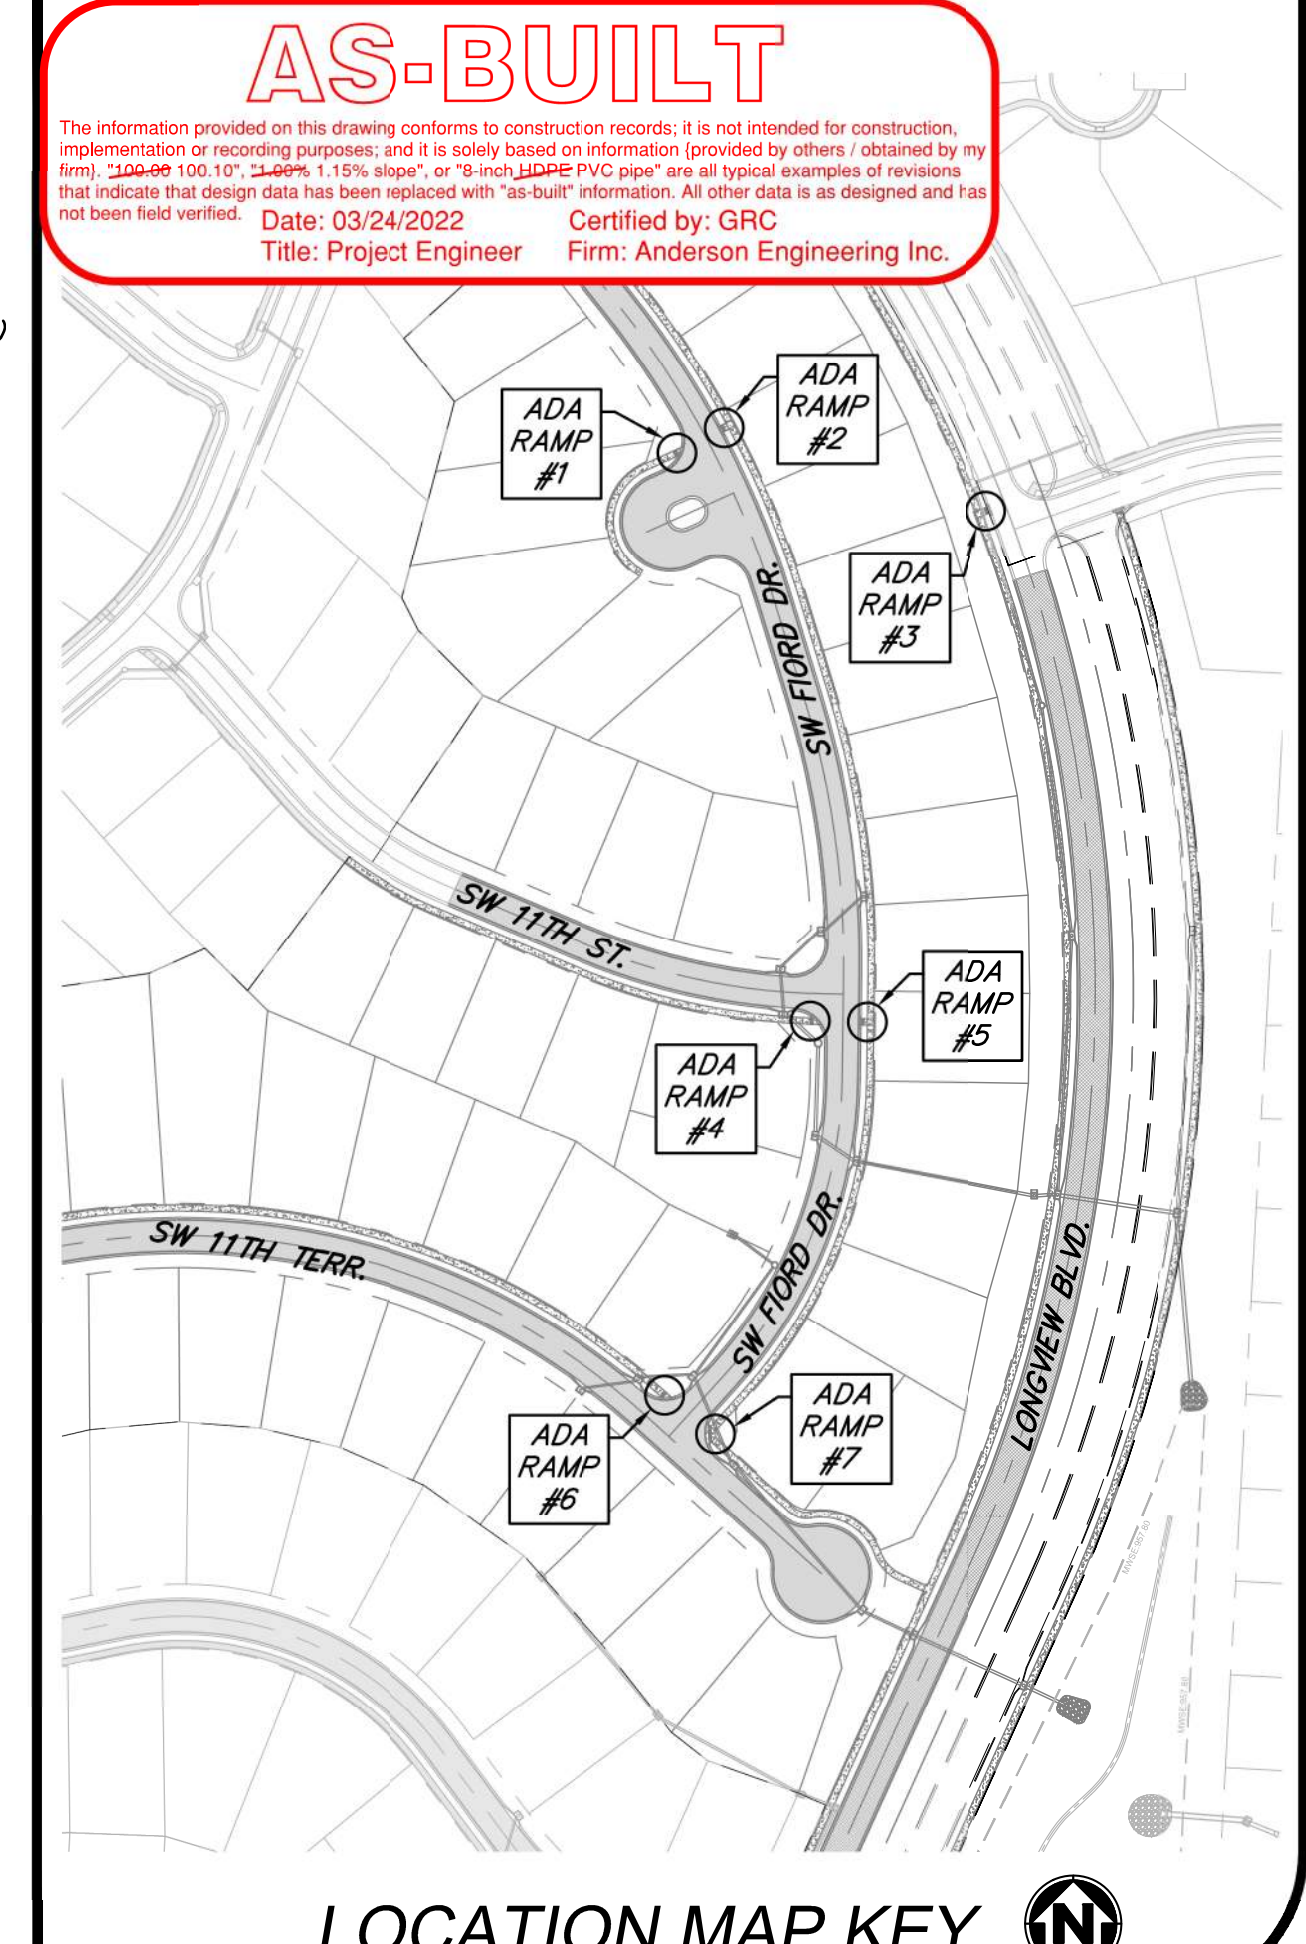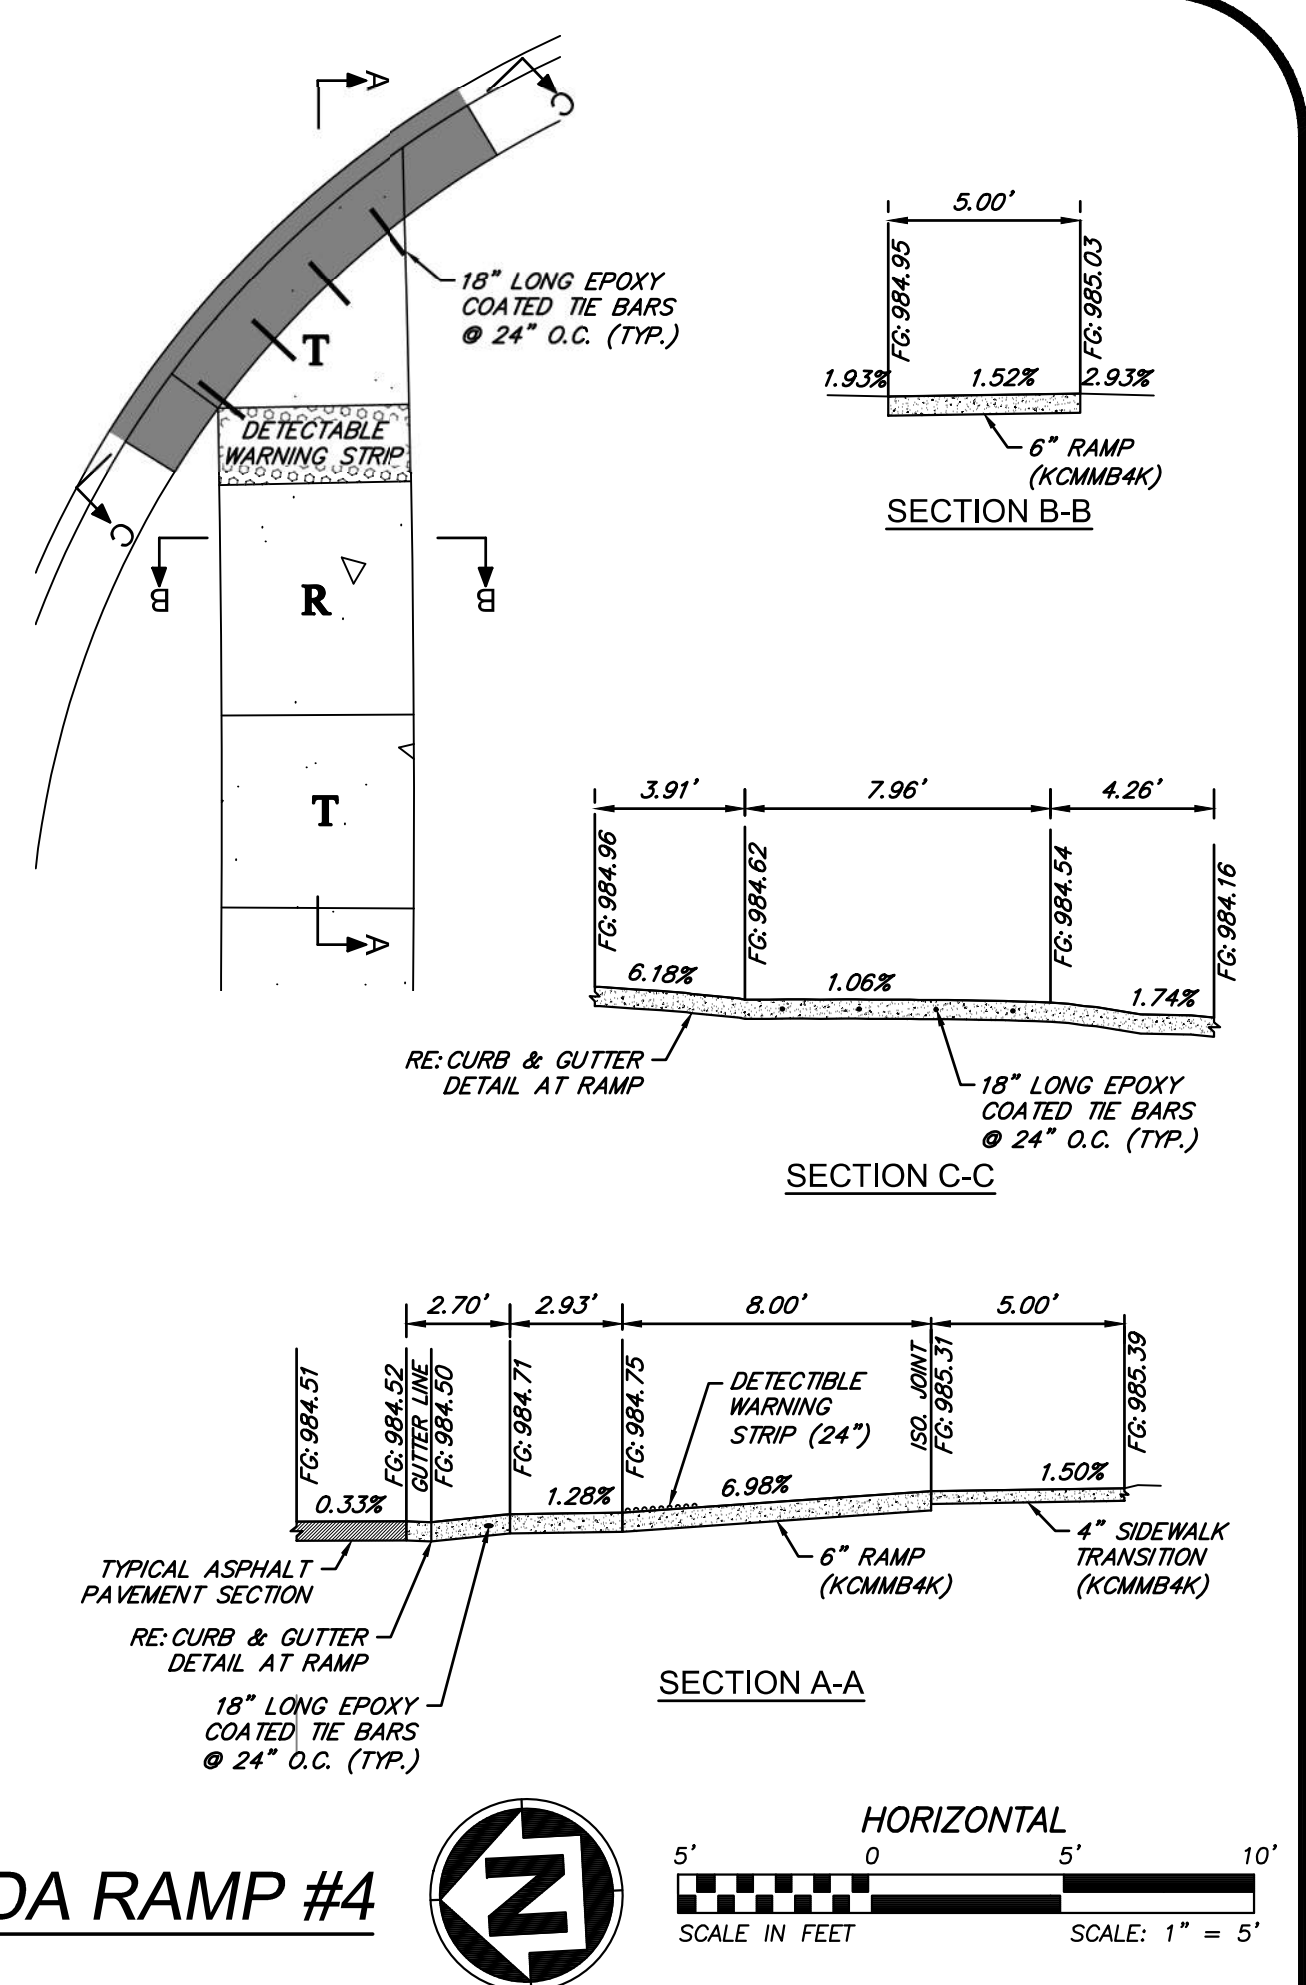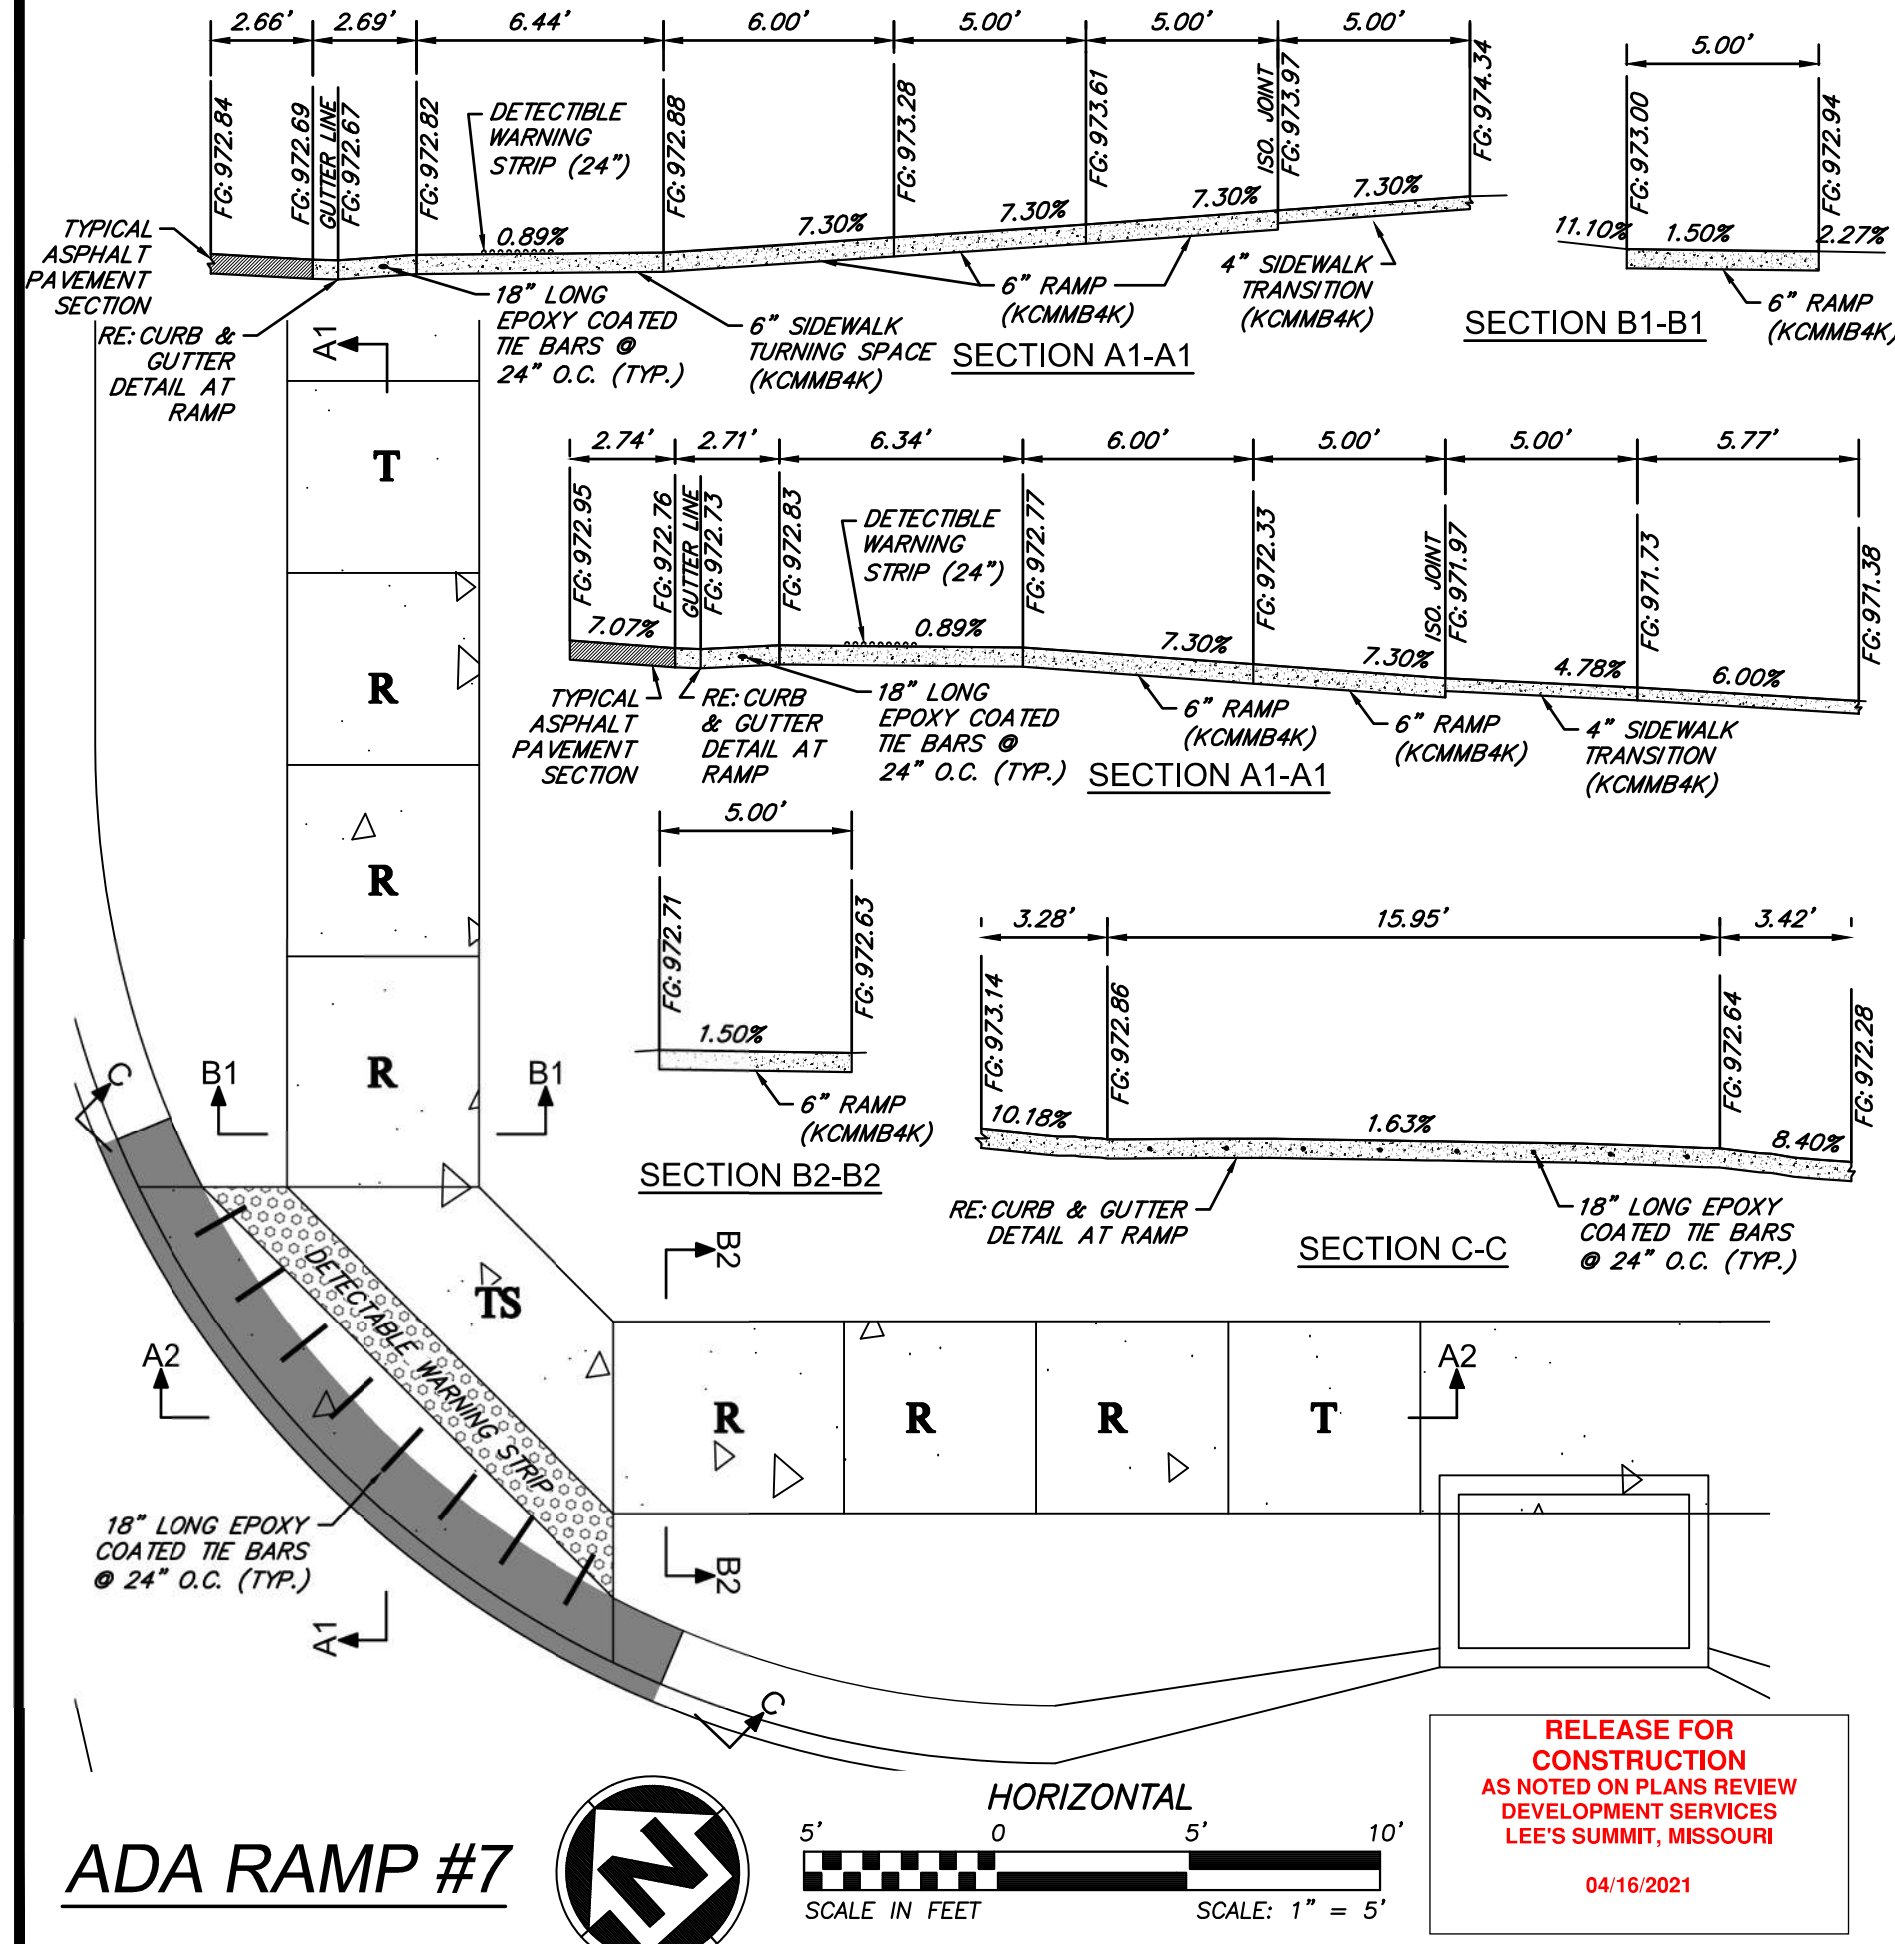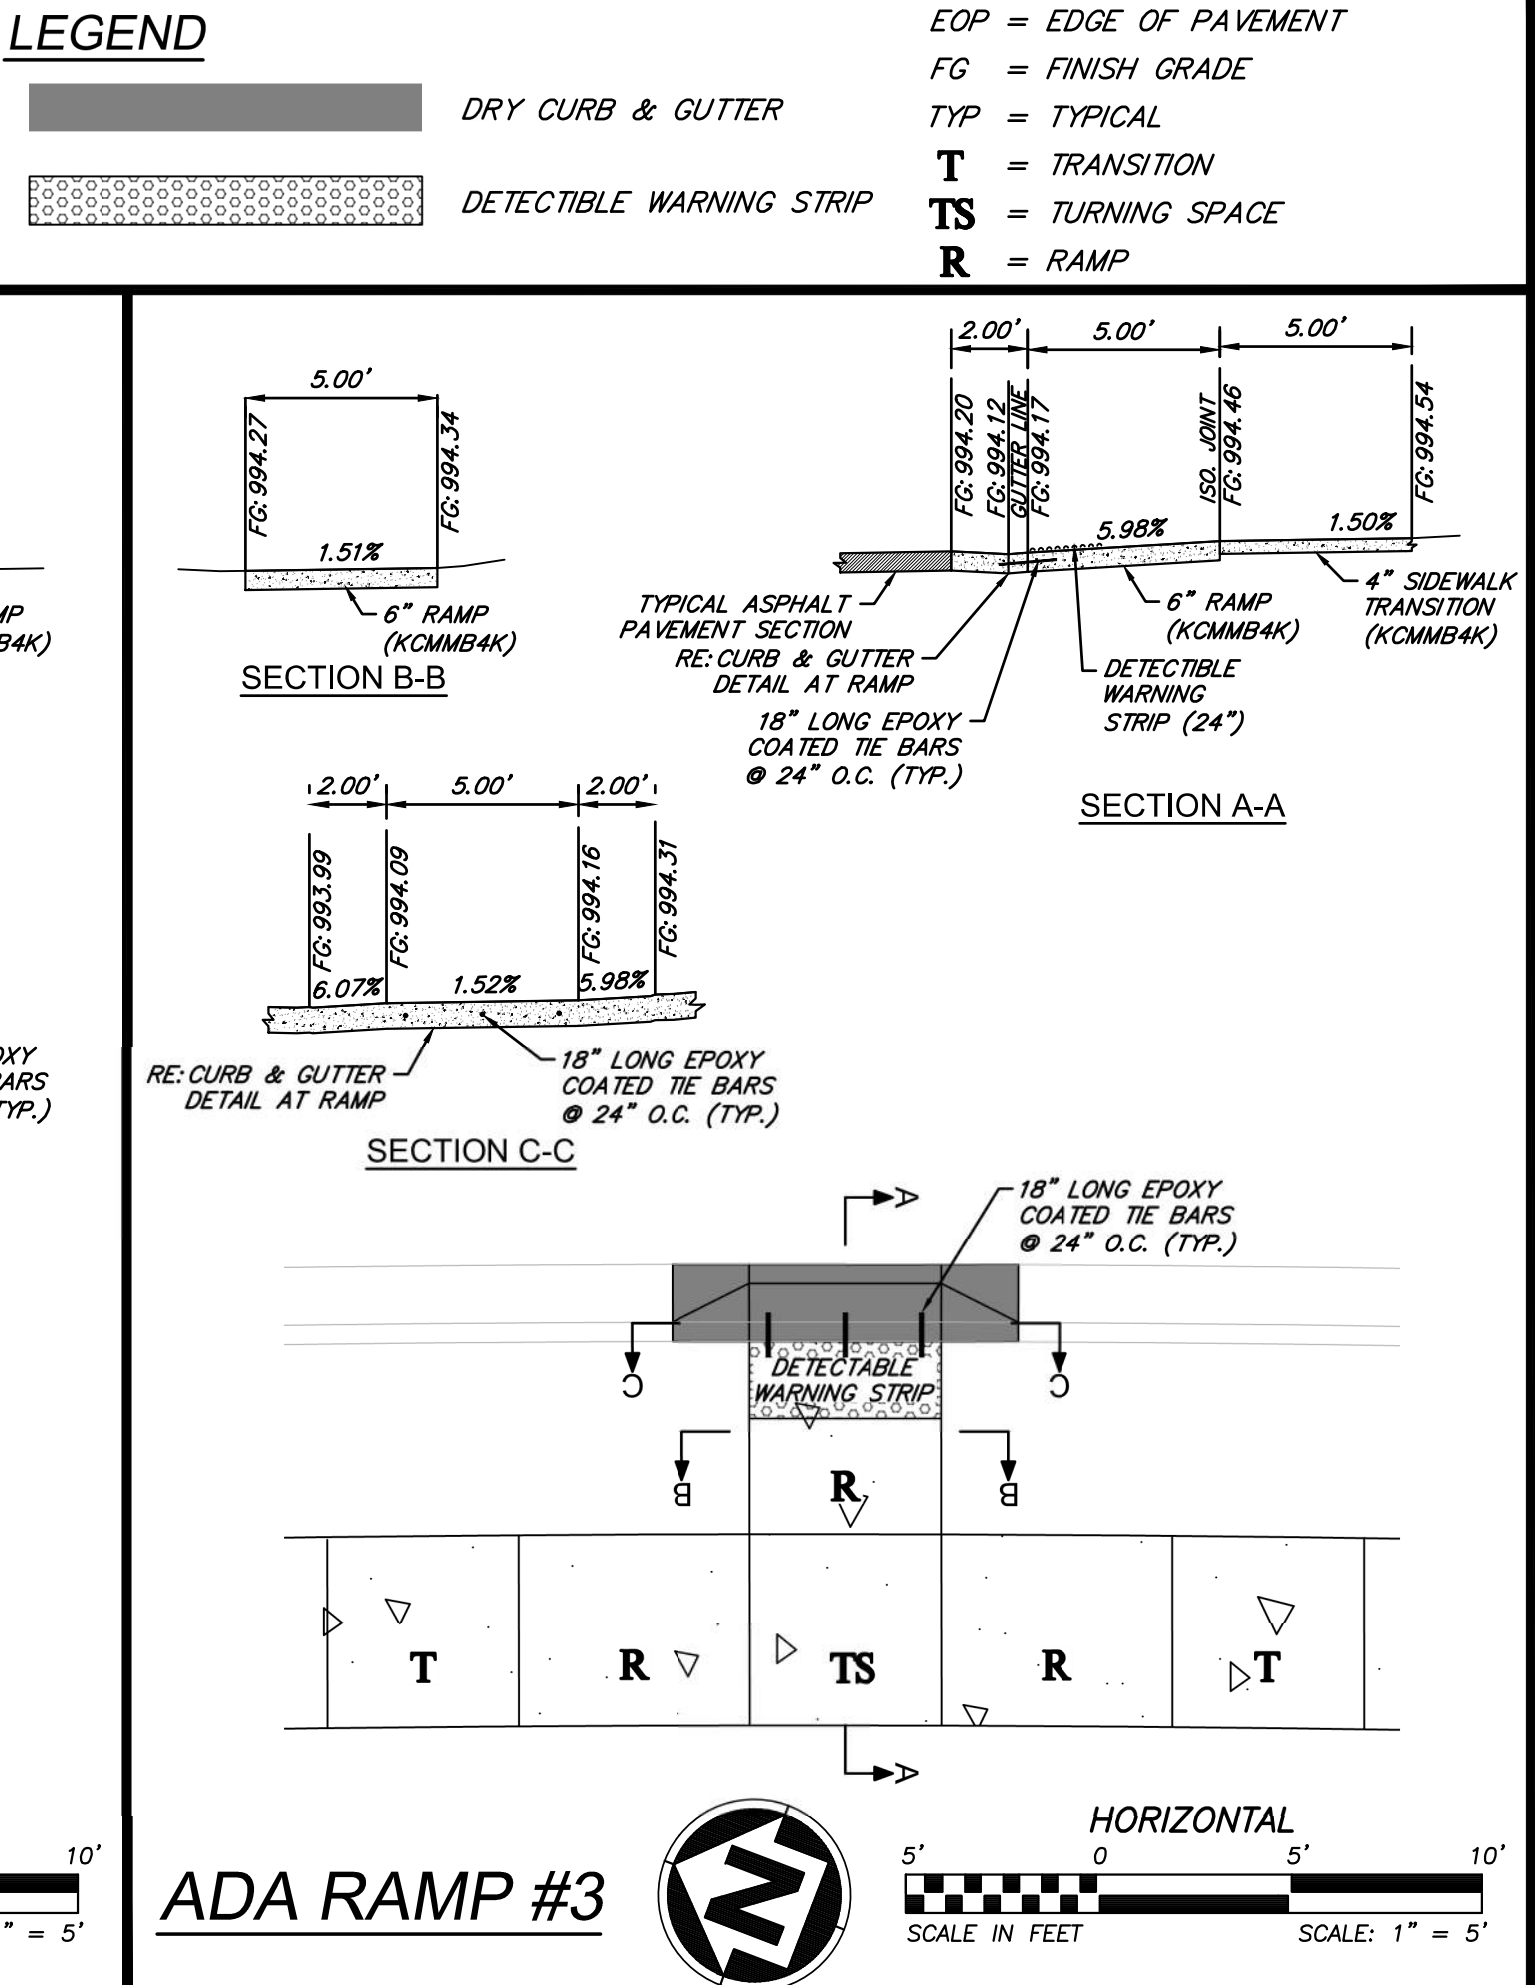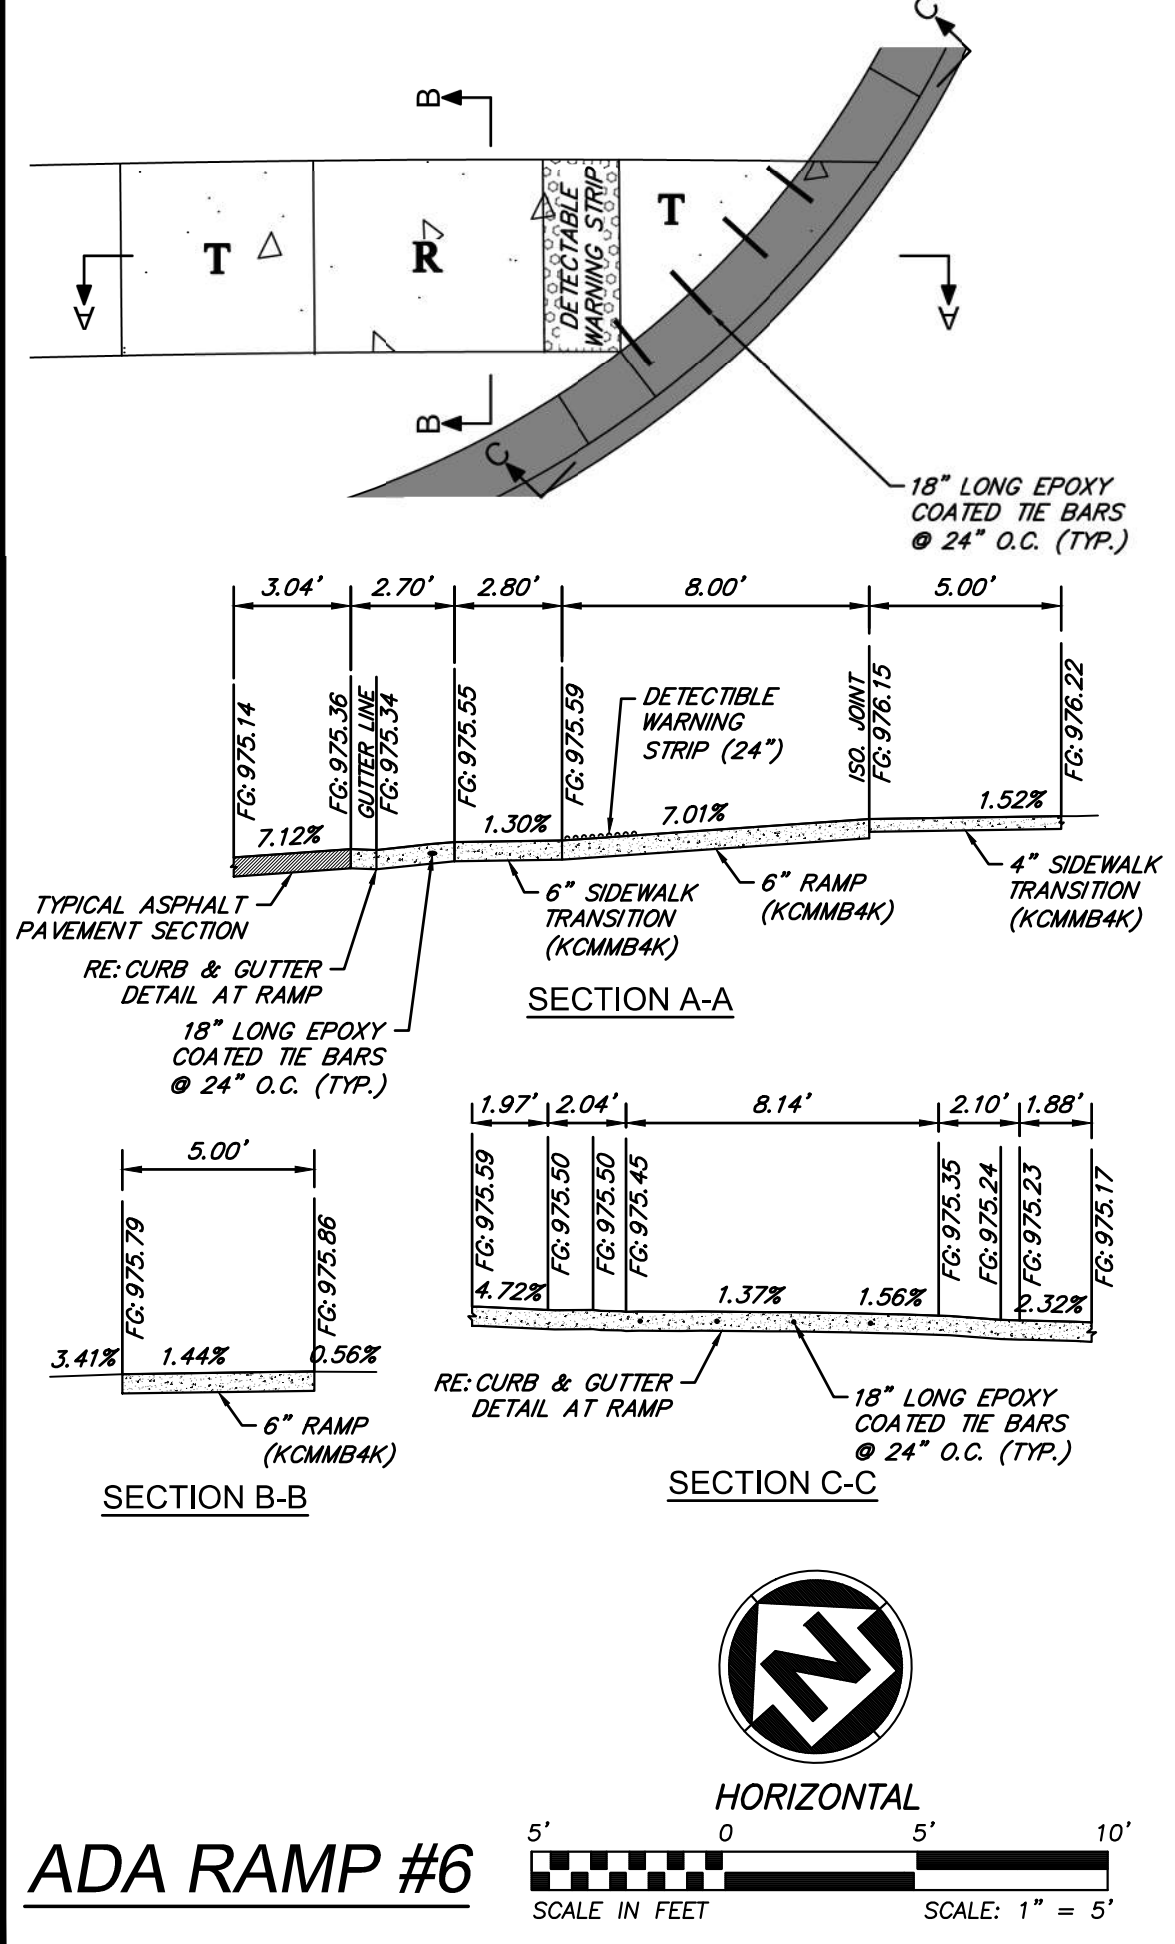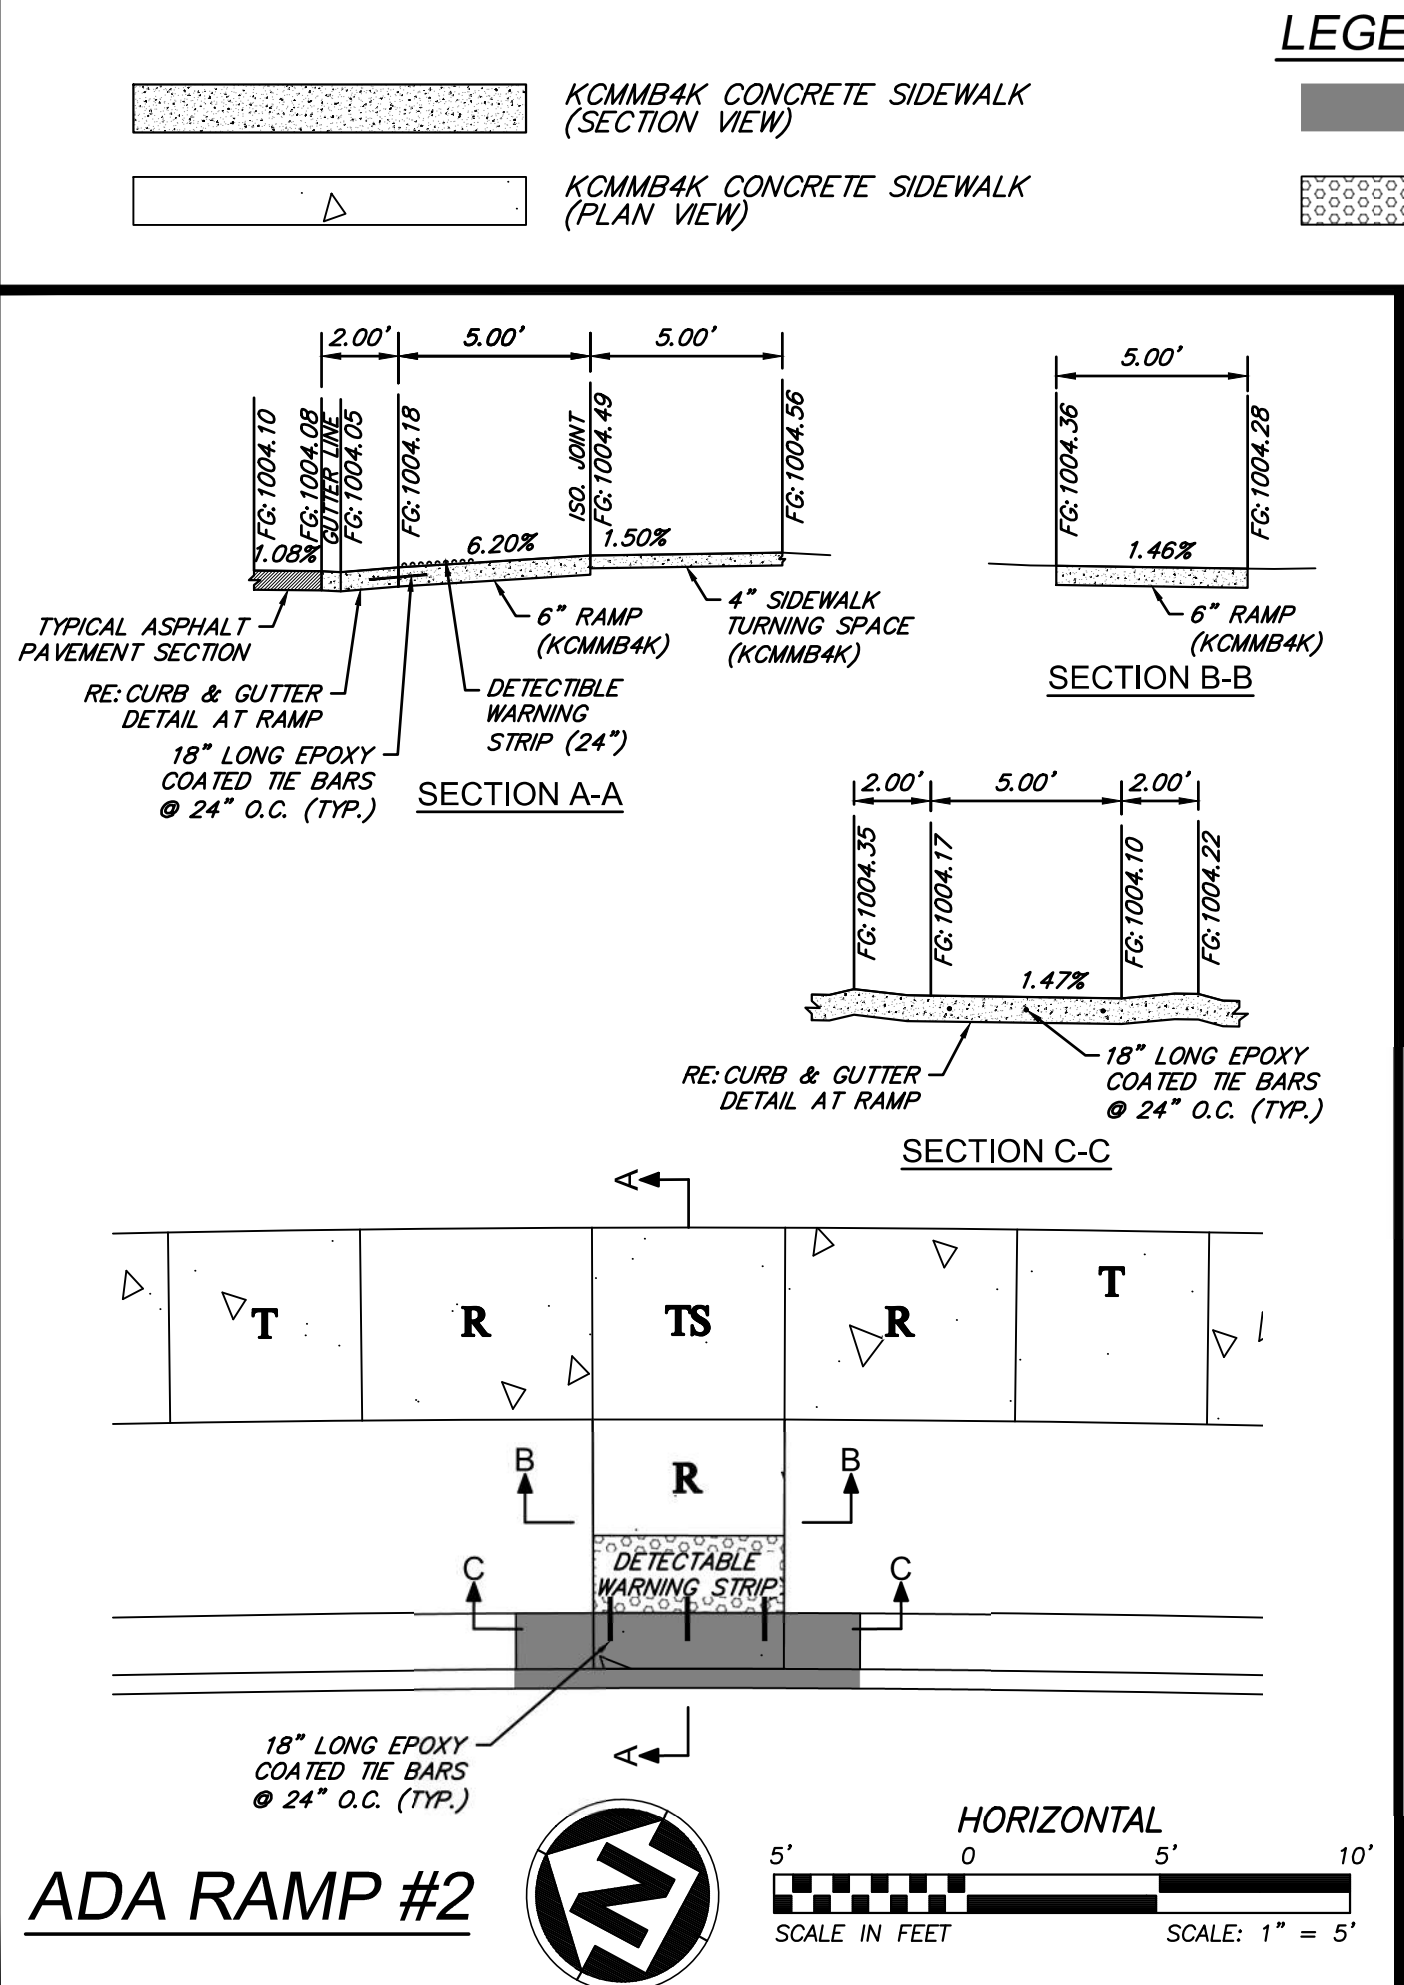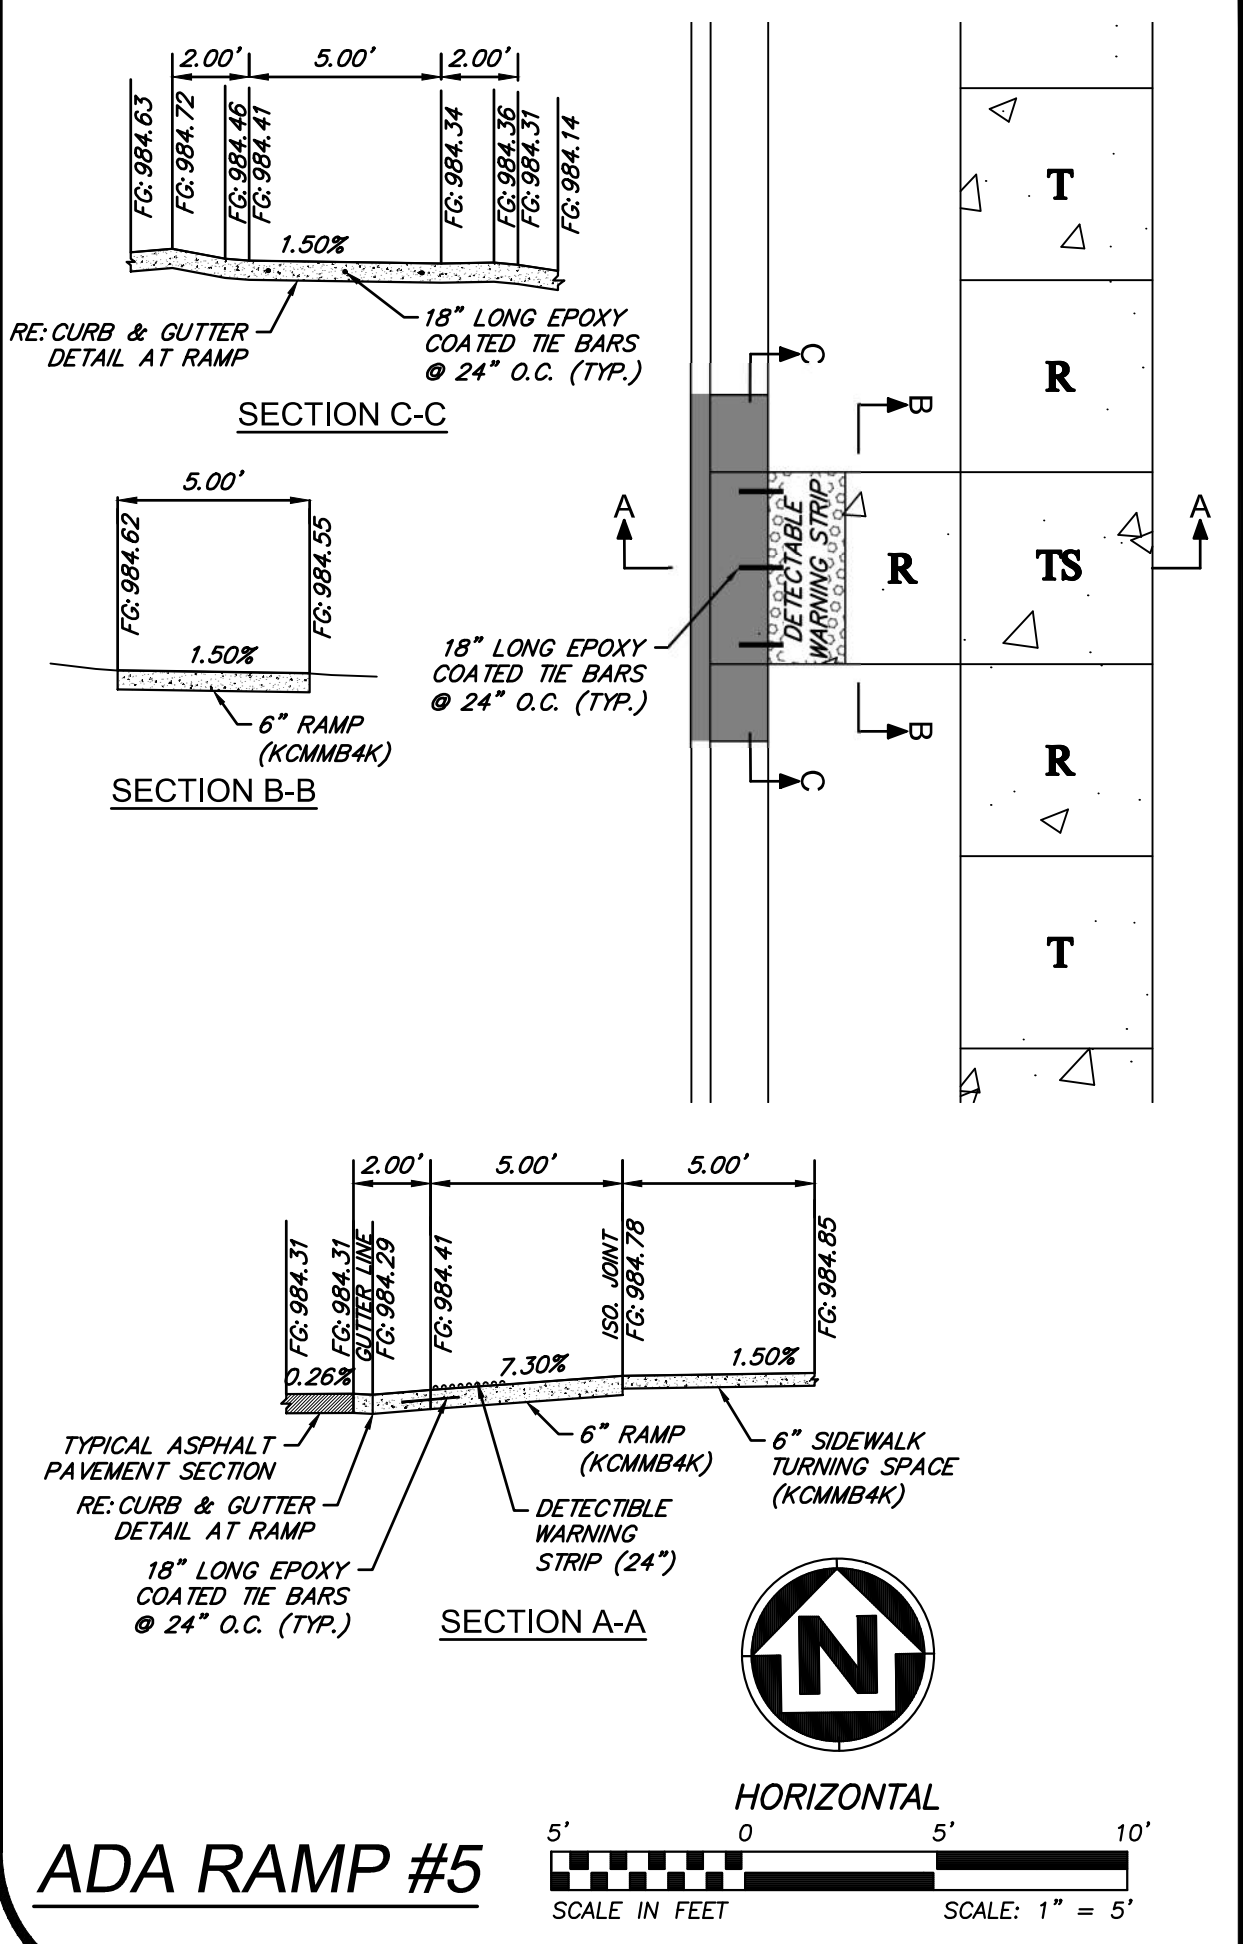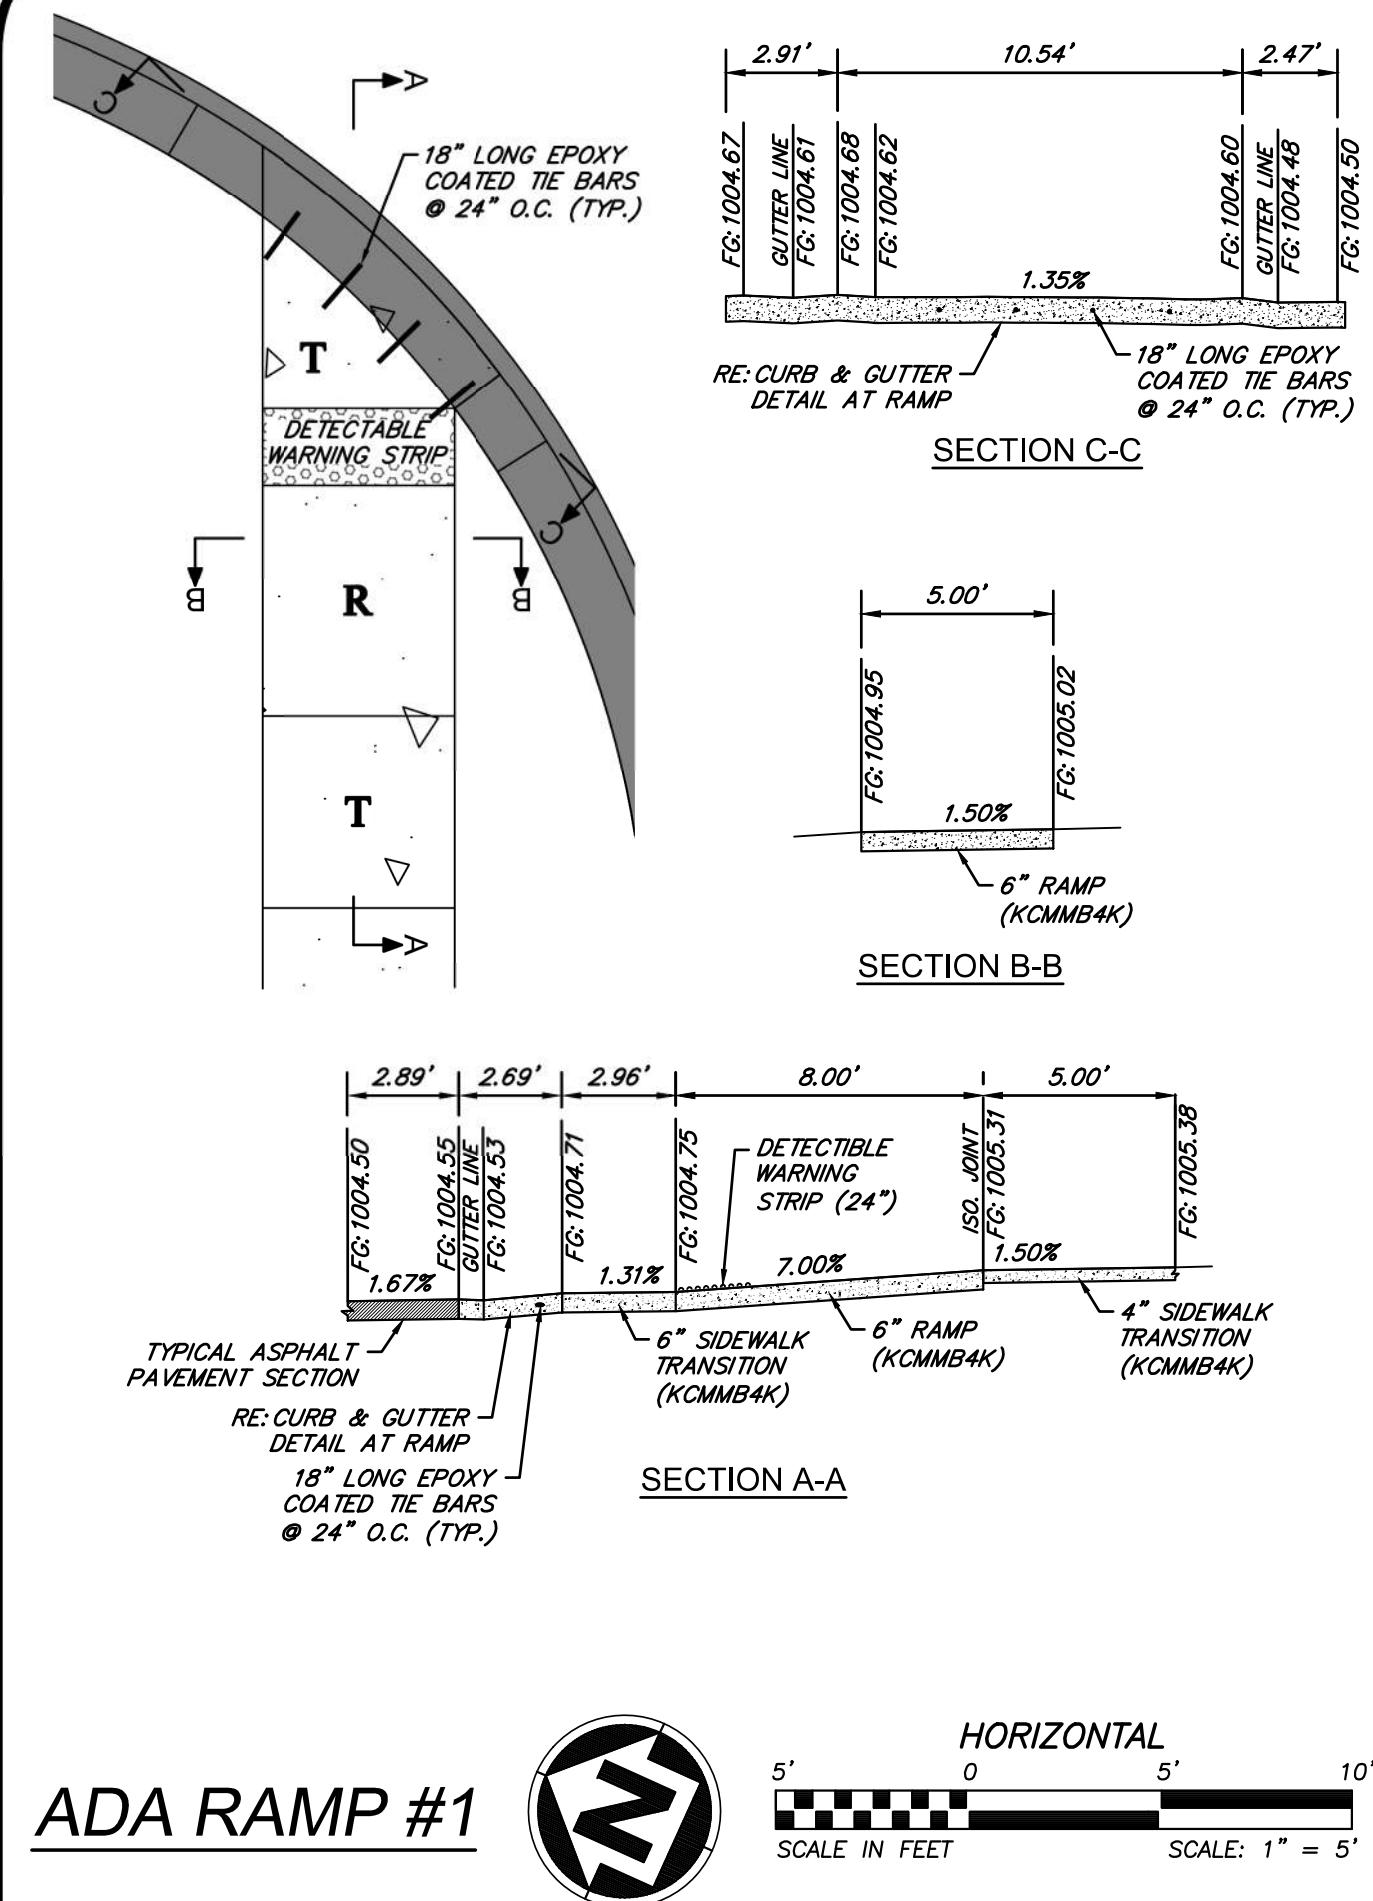

LEGEND

- KCMB4K CONCRETE SIDEWALK (SECTION VIEW)
- KCMB4K CONCRETE SIDEWALK (PLAN VIEW)
- DRY CURB & GUTTER
- DETECTABLE WARNING STRIP

EOP = EDGE OF PAVEMENT
FG = FINISH GRADE
TYP = TYPICAL
T = TRANSITION
TS = TURNING SPACE
R = RAMP

AS-BUILT

The information provided on this drawing conforms to construction records; it is not intended for construction, implementation or recording purposes, and it is solely based on information (provided by others / obtained by my firm), (scale 100' = 1\"/>

RELEASE FOR CONSTRUCTION
AS NOTED ON PLANS REVIEW
DEVELOPMENT SERVICES
LEE'S SUMMIT, MISSOURI
04/16/2021

ANDERSON ENGINEERING
EMPLOYEE OWNED

ENGINEERS • SURVEYORS • LABORATORIES • DRILLING
941 W. 141ST TER. • KANSAS CITY, MISSOURI 64145 • PHONE (816) 777-0400
A LICENSED MISSOURI ENGINEERING & SURVEYING CORPORATION - LC 62

REVISIONS		DRAWING INFO.	
NO.	DESCRIPTION	BY	DATE
1	REVISED PER CITY COMMENT	GC	2/11/21
2		CHECK BY:	ZM
		DATE:	1/7/2021
		LICENSE NO.	FE-2012009232
		ISSUED FOR:	FOR REVIEW
		JOB NUMBER:	20K100058
		MO COA NO.	000062




SUMMIT HOMES KC
HIGHLAND MEADOWS - 6TH PLAT

ADA RAMP CROSS SECTIONS

SHEET NUMBER
C405
28 OF 42

STATE OF MISSOURI
ZACH A. MYERS
PROFESSIONAL ENGINEER
NUMBER FE-2012009232
EXPIRATION DATE 12/31/2023

S10, T47N, R22W
LEE'S SUMMIT, JACKSON COUNTY, MISSOURI

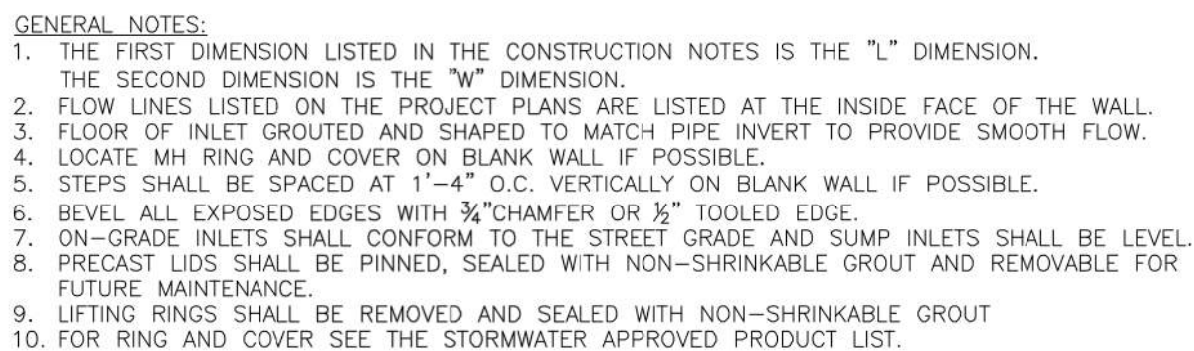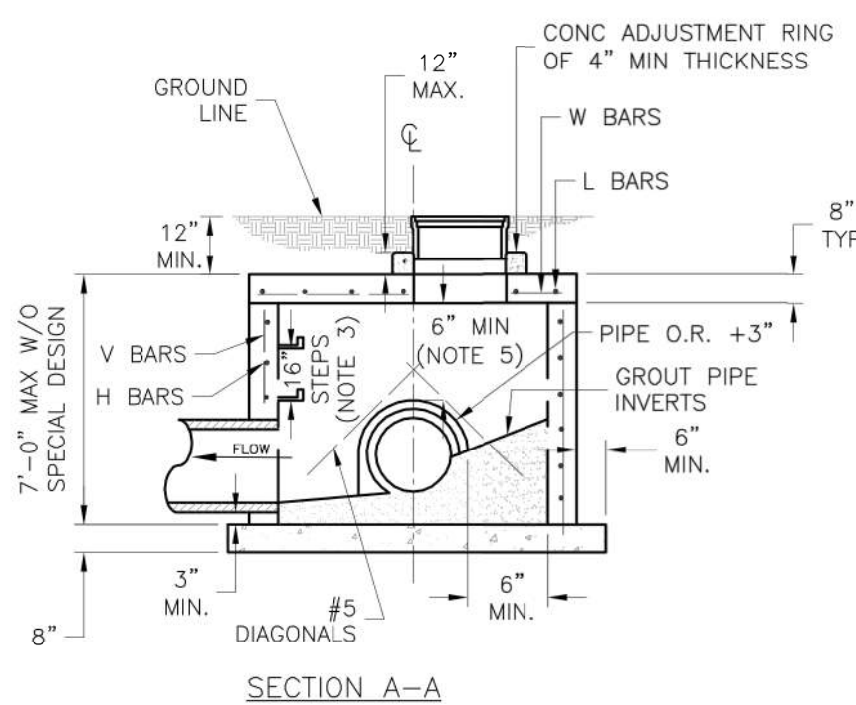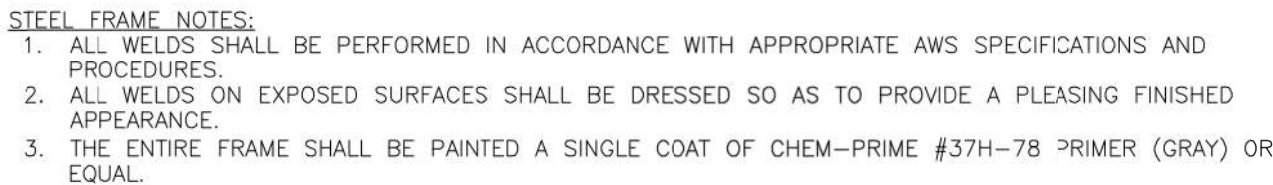


GENERAL NOTES:

1. LOCATE RING AND COVER ON BLANK WALL.
2. USE $\frac{3}{4}$ " CHAMFER STRIP OR $\frac{1}{2}$ " R EDGER TOOL ON ALL EXPOSED CONCRETE CORNERS.
3. STEPS REQUIRED AT 16' O.C. WHEN DEPTH FROM TOP OF CASTING TO INVERT EXCEEDS 4' ON BLANK WALL IF POSSIBLE.
4. BOXOUTS WILL NOT BE ALLOWED TO PROJECT THROUGH THE CORNERS OF THE STRUCTURE AND THE MINIMUM DISTANCE BETWEEN BOXOUTS IS 6".
5. THE MINIMUM REINFORCEMENT SHALL BE 1 H-BAR OVER A CAST-IN-PLACE PIPE AND 2 H-BARS OVER A PRECAST BOXOUT.
6. PRECAST LIDS SHALL BE PINNED, SEALED WITH NON-SHRINKABLE GROUT AND REMOVABLE FOR FUTURE MAINTENANCE.
9. REINFORCING OF COVERS IN STREETS REQUIRE SPECIAL DESIGN.
10. FOR RING AND COVER SEE THE STORMWATER APPROVED PRODUCT LIST.



*COVER AND FRAME MODEL INFORMATION REFER TO THE STORMWATER APPROVED PRODUCT LIST.

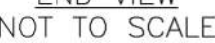

**RELEASE FOR
CONSTRUCTION
AS NOTED ON PLANS REVIEW
DEVELOPMENT SERVICES
LEE'S SUMMIT, MISSOURI**

04/16/2021

© COPYRIGHT ANDERSON ENGINEERING, INC. 2020

STORM SEWER DETAILS

S10. T47N. R32W




ENGINEERS • SURVEYORS • LABORATORIES • DRILLING
941 W. 141ST TER. • KANSAS CITY, MISSOURI 64145 • PHONE (816) 777-0400
A LICENSED MISSOURI ENGINEERING & SURVEYING CORPORATION - LC 618

BEDDING
1/2"-3/4" CLEAN AGGREGATE, HAND TAMPED OR MECHANICALLY COMPACTED IN MAX. 4" LIFTS

INITIAL BACKFILL
-UNDER PAVED AREAS OR WITHIN 4' HORIZONTAL OF PAVED AREAS
1/2"-3/4" CLEAN AGGREGATE, HAND TAMPED OR MECHANICALLY COMPACTED IN MAX. 4" LIFTS
-UNDER OPEN AREAS
1/2"-3/4" CLEAN AGGREGATE, HAND TAMPED OR MECHANICALLY COMPACTED IN MAX. 4" LIFTS

FINAL BACKFILL
-UNDER PAVED AREAS OR WITHIN 4' HORIZONTAL OF PAVED AREAS
ON-SITE OR IMPORTED MATERIAL FREE OF MUCK, FROZEN MATERIAL, EXCESS MOISTURE, ORGANICS, TOPSOIL, RUBBISH, CONSTRUCTION DEBRIS, ROCK OR BRICK LARGER THAN 8", COMPACTED TO 95% OF STANDARD DENSITY PER ASTM D-698
-UNDER OPEN AREAS
ON-SITE OR IMPORTED MATERIAL FREE OF MUCK, FROZEN MATERIAL, EXCESS MOISTURE, ORGANICS, TOPSOIL, RUBBISH, CONSTRUCTION DEBRIS, ROCK OR BRICK LARGER THAN 8", COMPACTED TO 90% OF STANDARD DENSITY PER ASTM D-698

BEDDING DEPTH BELOW PIPE		
PIPE DIAMETER	IN SOIL	IN ROCK
24" AND LESS	4"	6"
27" THRU 60"	4"	9"

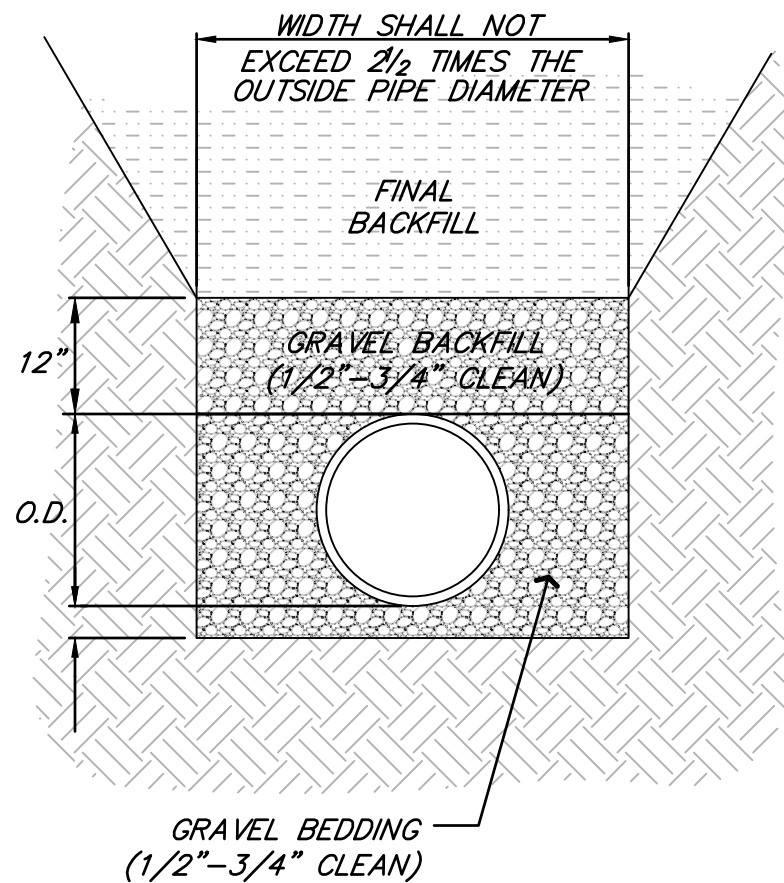


PIPE BEDDING DETAIL
NOT TO SCALE

AS-BUILT

The information provided on this drawing conforms to construction records; it is not intended for construction, implementation or recording purposes; and it is solely based on information (provided by others / obtained by my firm). "As-Built" 100-10" 1/4" slope" or "8-inch 1/4" slope PVC pipe" are all typical examples of revisions that indicate that design data has been replaced with "as-built" information. All other data is as designed and has not been field verified.
Date: 03/24/2022 Certified by: GRC
Title: Project Engineer Firm: Anderson Engineering Inc.

RELEASE FOR
CONSTRUCTION
AS NOTED ON PLANS REVIEW
DEVELOPMENT SERVICES
LEE'S SUMMIT, MISSOURI
04/16/2021

RIPRAP DETAILS
NOT TO SCALE

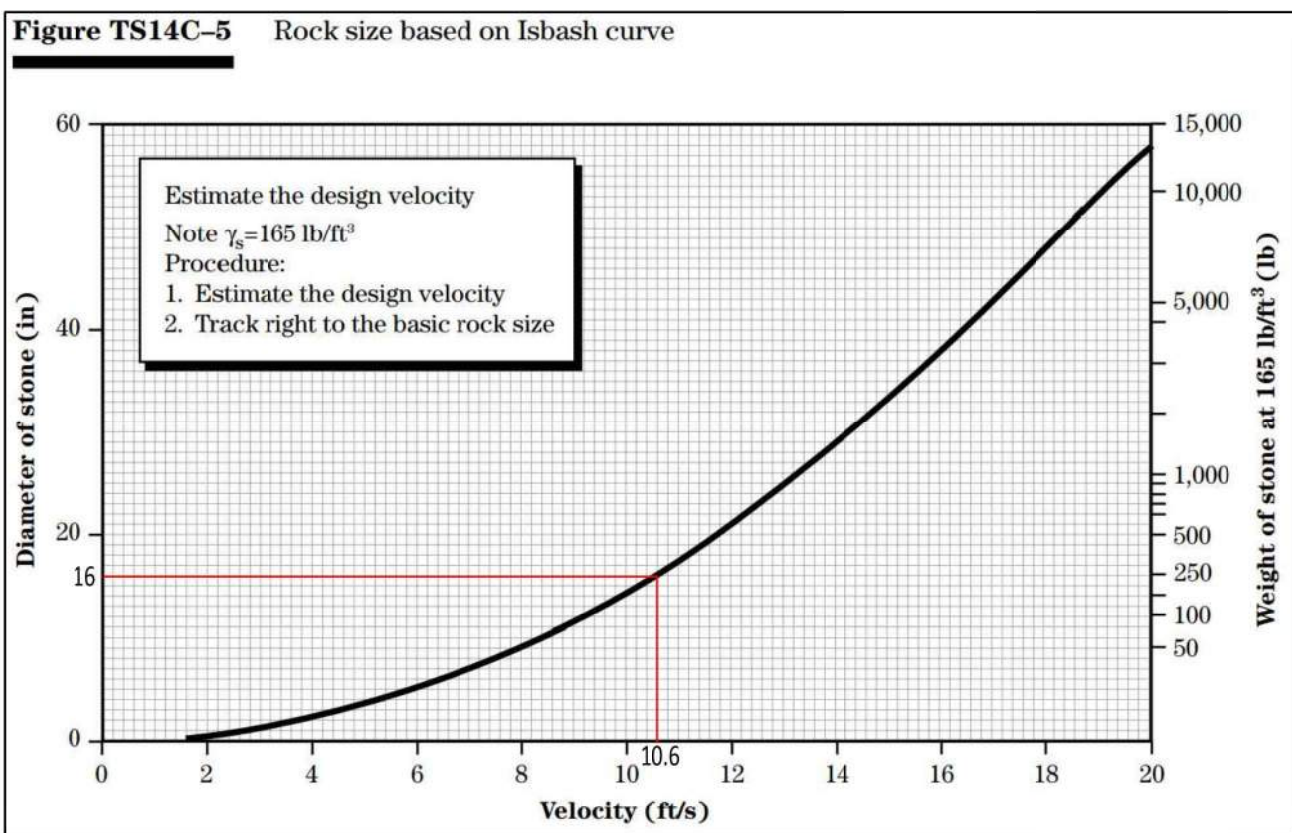

MAXIMUM 100-YR OUTLET VELOCITY PER DRAINAGE CALCULATIONS (SHEET C202) ≈ 10.6 FT/S.

PER TABLE ABOVE, 10.6 FT/S = 14.5" STONE.

16" STONE X 1.2 SAFETY FACTOR = 19" STONE

19" STONE ≈ MoDOT TYPE 4 DITCH LINER SPECIFICATION

"TYPE 4 ROCK DITCH LINER SHALL CONSIST OF MATERIAL WITH A PREDOMINANT ROCK SIZE OF 19 INCHES, A MAXIMUM ROCK SIZE OF 28 INCHES AND A GRADATION SUCH THAT NO MORE THAN 15% WILL BE LESS THAN 6 INCHES" PER SECTION 609.60.2.4 OF THE 2018 MISSOURI STANDARD SPECIFICATIONS FOR HIGHWAY CONSTRUCTION.

RIP-RAP NOTES:

1. ROCK TO BE USED FOR RIP-RAP SHALL CONSIST OF INDIVIDUAL ROCK FRAGMENTS THAT ARE DENSE, SOUND, AND RESISTANT TO ABRASION. THE ROCK SHALL BE FREE OF CRACKS, SEAMS, AND OTHER DEFECTS THAT WOULD TEND TO INCREASE THE DESTRUCTION OF THE INDIVIDUAL ROCK FRAGMENTS DUE TO WATER AND FRONT ACTION. REFER APWA SECTION 2600.



2. RIP-RAP SHALL HAVE A MINIMUM THICKNESS OF 24" AT ALL LOCATIONS SHOWN ON THE PLANS. RIP-RAP SHALL BE PLACED ON GEOTEXTILE FABRIC AS SHOWN IN THE DETAIL.

3. 24" THICK RIP-RAP SHALL BE WELL-GRADED ($D_{50} = 19"$) AND CONFORM TO THE TABLE BELOW:

PERCENT LIGHTER	WEIGHT, LBS.
100	700
85-95	525
30-50	175
0-15	50


4. A SAMPLE OF ALL ROCK TO BE PLACED SHALL BE SET ASIDE AT A QUARRY CHOSEN BY THE CONTRACTOR. THE ENGINEER WILL VISIT THE QUARRY TO VISUALLY INSPECT THE ROCK PRIOR TO DELIVERY.

5. VISUAL OBSERVATION AND TEST SHALL DETERMINE THE ACCEPTABILITY OF THE ROCK USED FOR RIP-RAP. IN GENERAL, LEDGE ROCK USED FOR DUMPED RIP-RAP MATERIALS SHALL MEET THE FOLLOWING REQUIREMENTS WHEN TESTED BY THE SPECIFIED PROCEDURES.

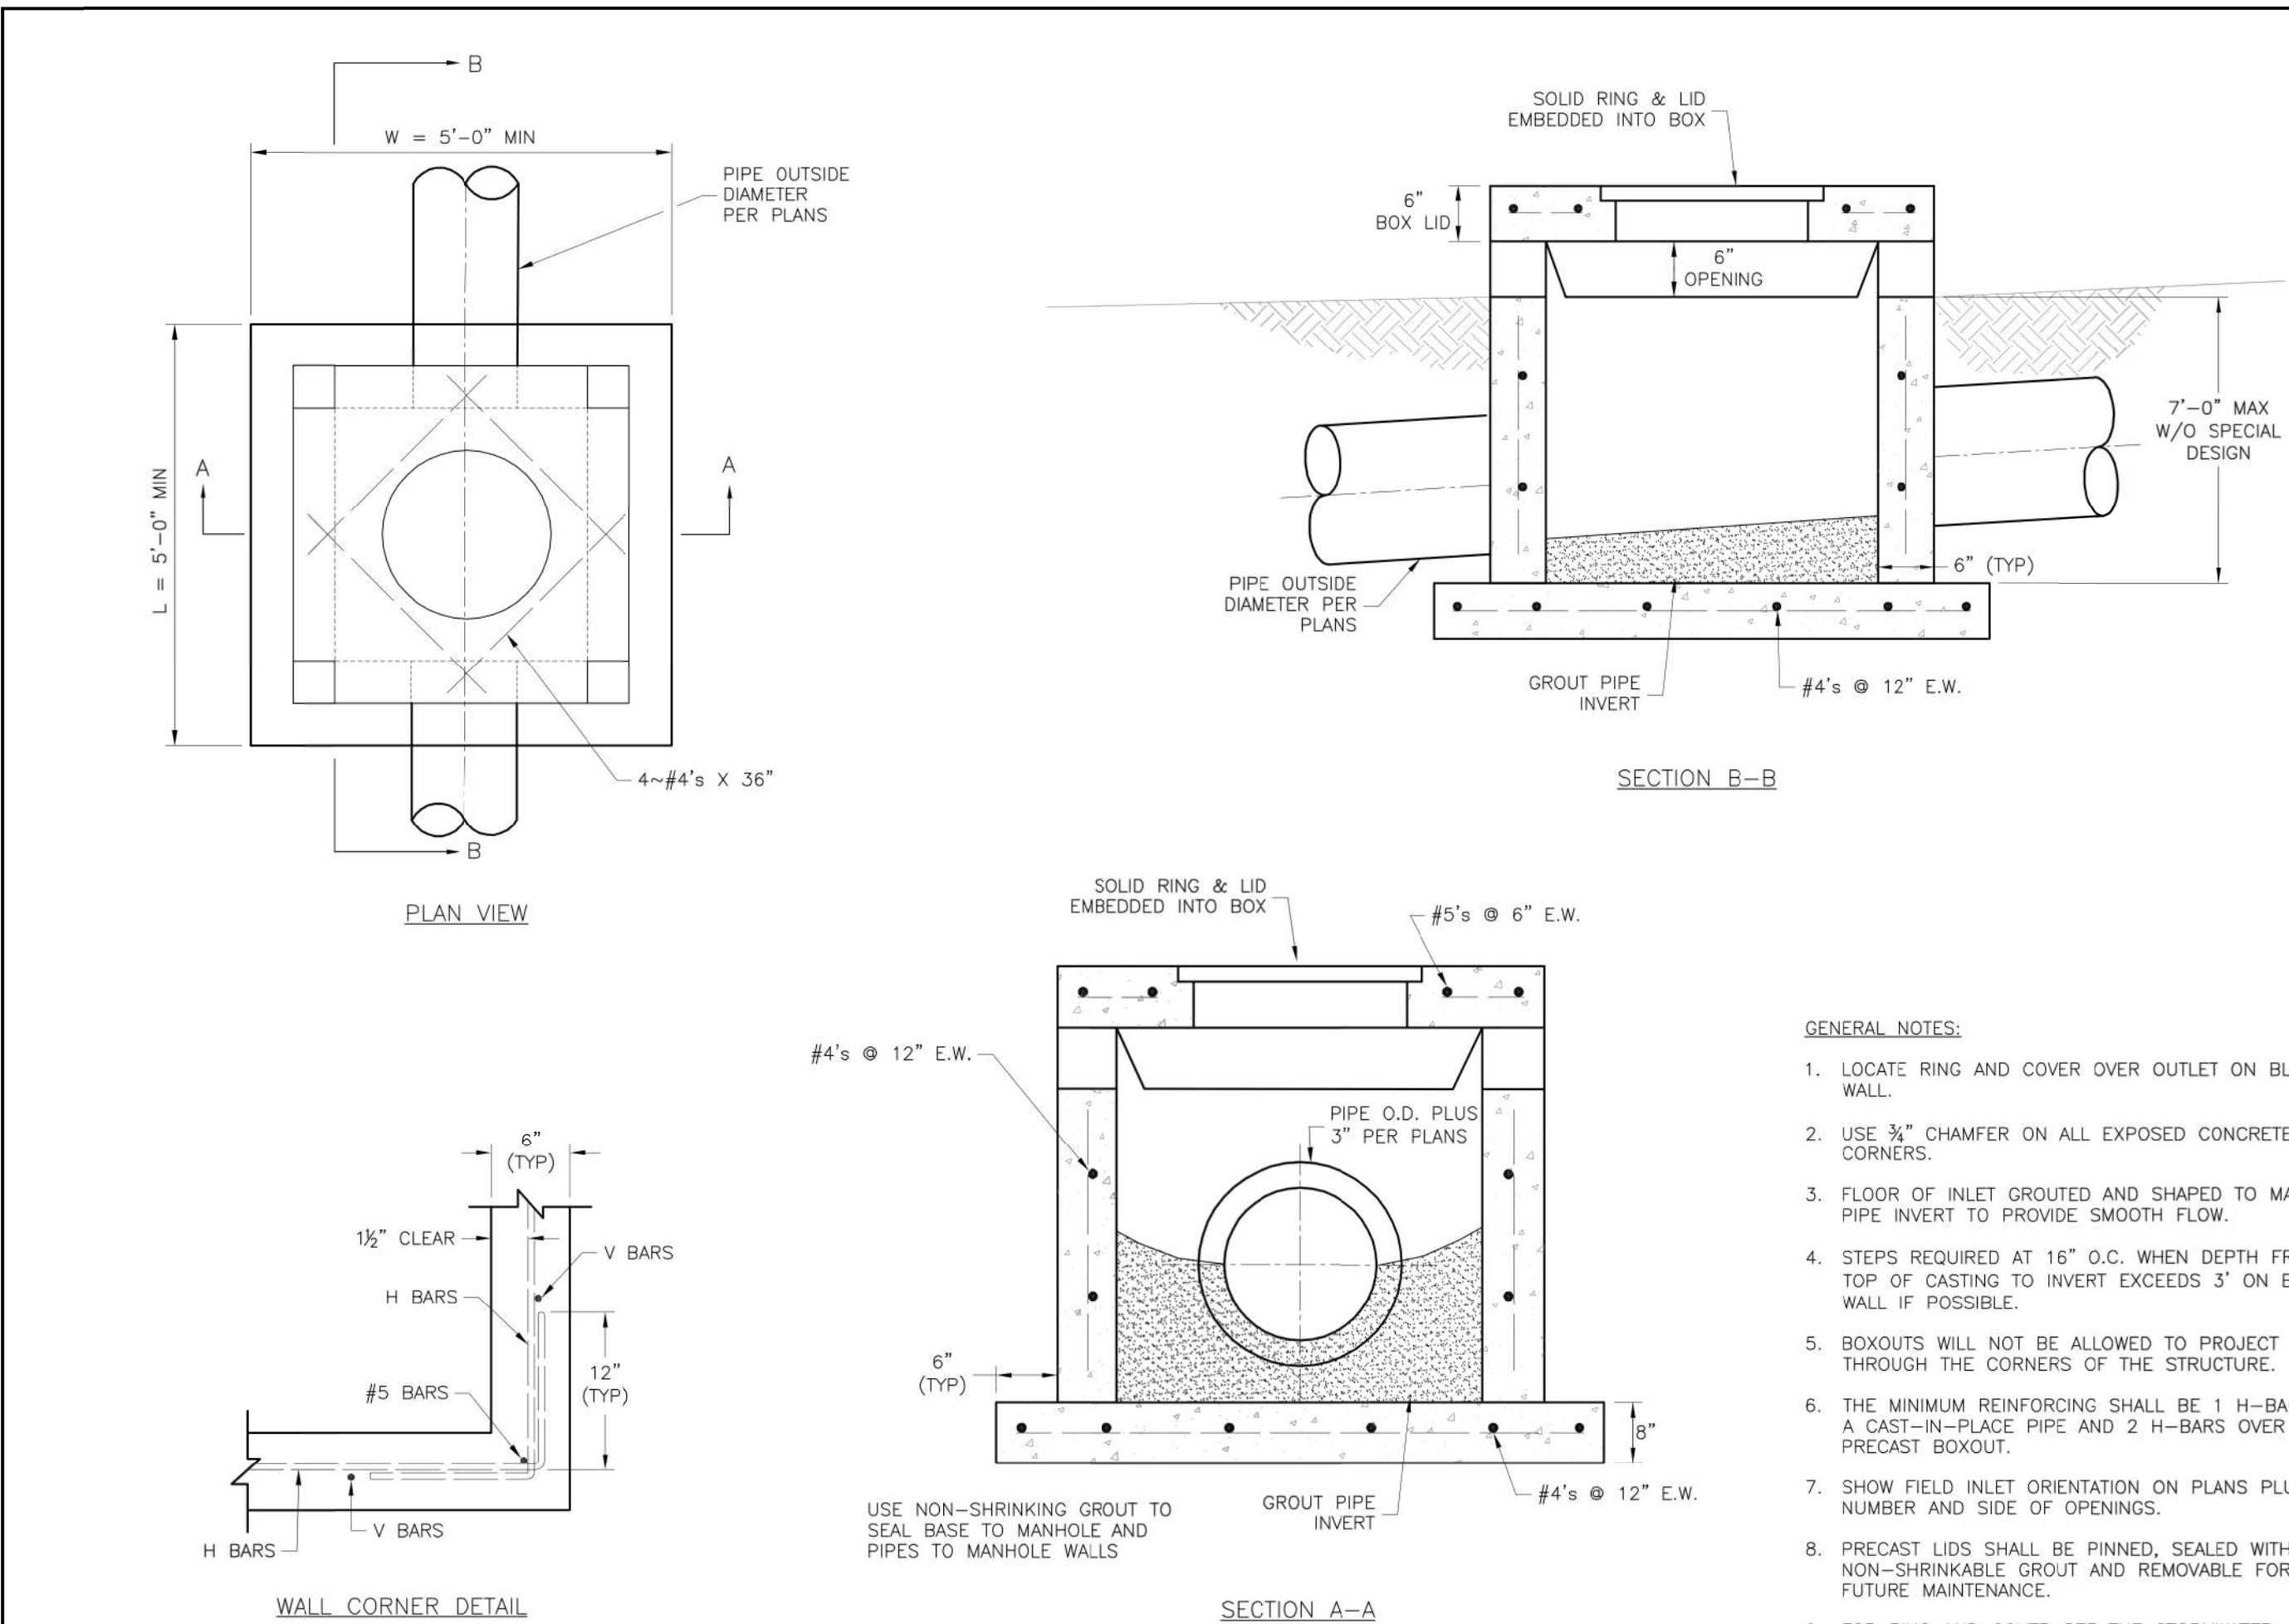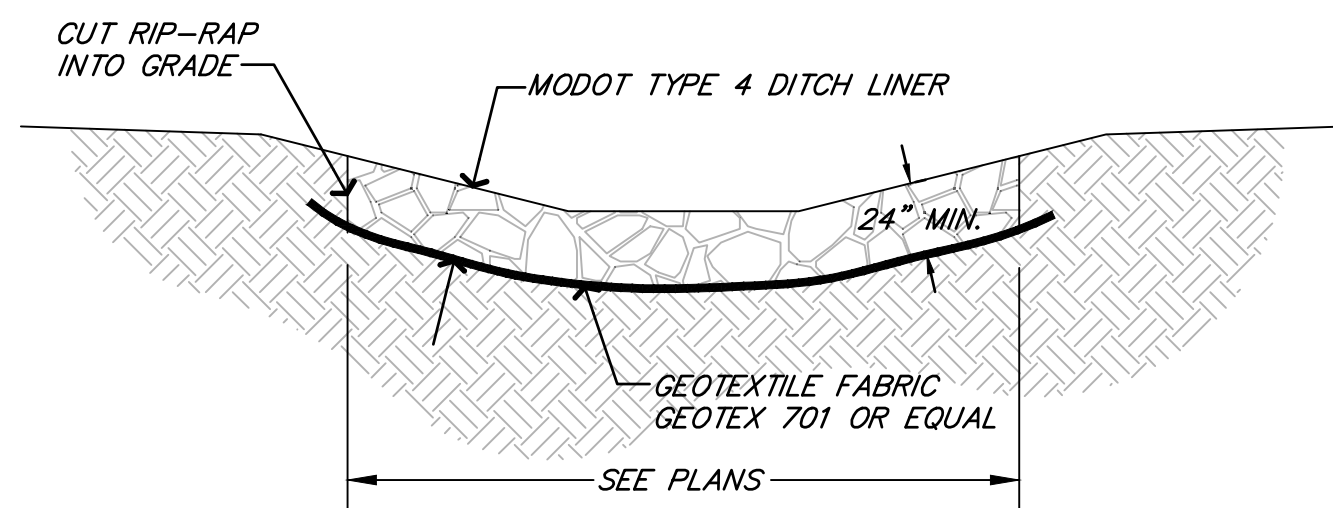

GENERAL NOTES:

1. LOCATE RING AND COVER OVER OUTLET ON BLANK WALL.
2. USE 3/4" CHAMFER ON ALL EXPOSED CONCRETE CORNERS.
3. FLOOR OF INLET GROUDED AND SHAPED TO MATCH PIPE INVERT TO PROVIDE SMOOTH FLOW.
4. STEPS REQUIRED AT 16" O.C. WHEN DEPTH FROM TOP OF CASTING TO INVERT EXCEEDS 3' ON BLANK WALL IF POSSIBLE.
5. BOXOUTS WILL NOT BE ALLOWED TO PROJECT THROUGH THE CORNERS OF THE STRUCTURE.
6. THE MINIMUM REINFORCING SHALL BE 1 H-BAR OVER A CAST-IN-PLACE PIPE AND 2 H-BARS OVER A PRECAST BOXOUT.
7. SHOW FIELD INLET ORIENTATION ON PLANS PLUS NUMBER AND SIDE OF OPENINGS.
8. PRECAST LIDS SHALL BE PINNED, SEALED WITH NON-SHRINKABLE GROUT AND REMOVABLE FOR FUTURE MAINTENANCE.
9. FOR RING AND COVER SEE THE STORMWATER APPROVED PRODUCT LIST.

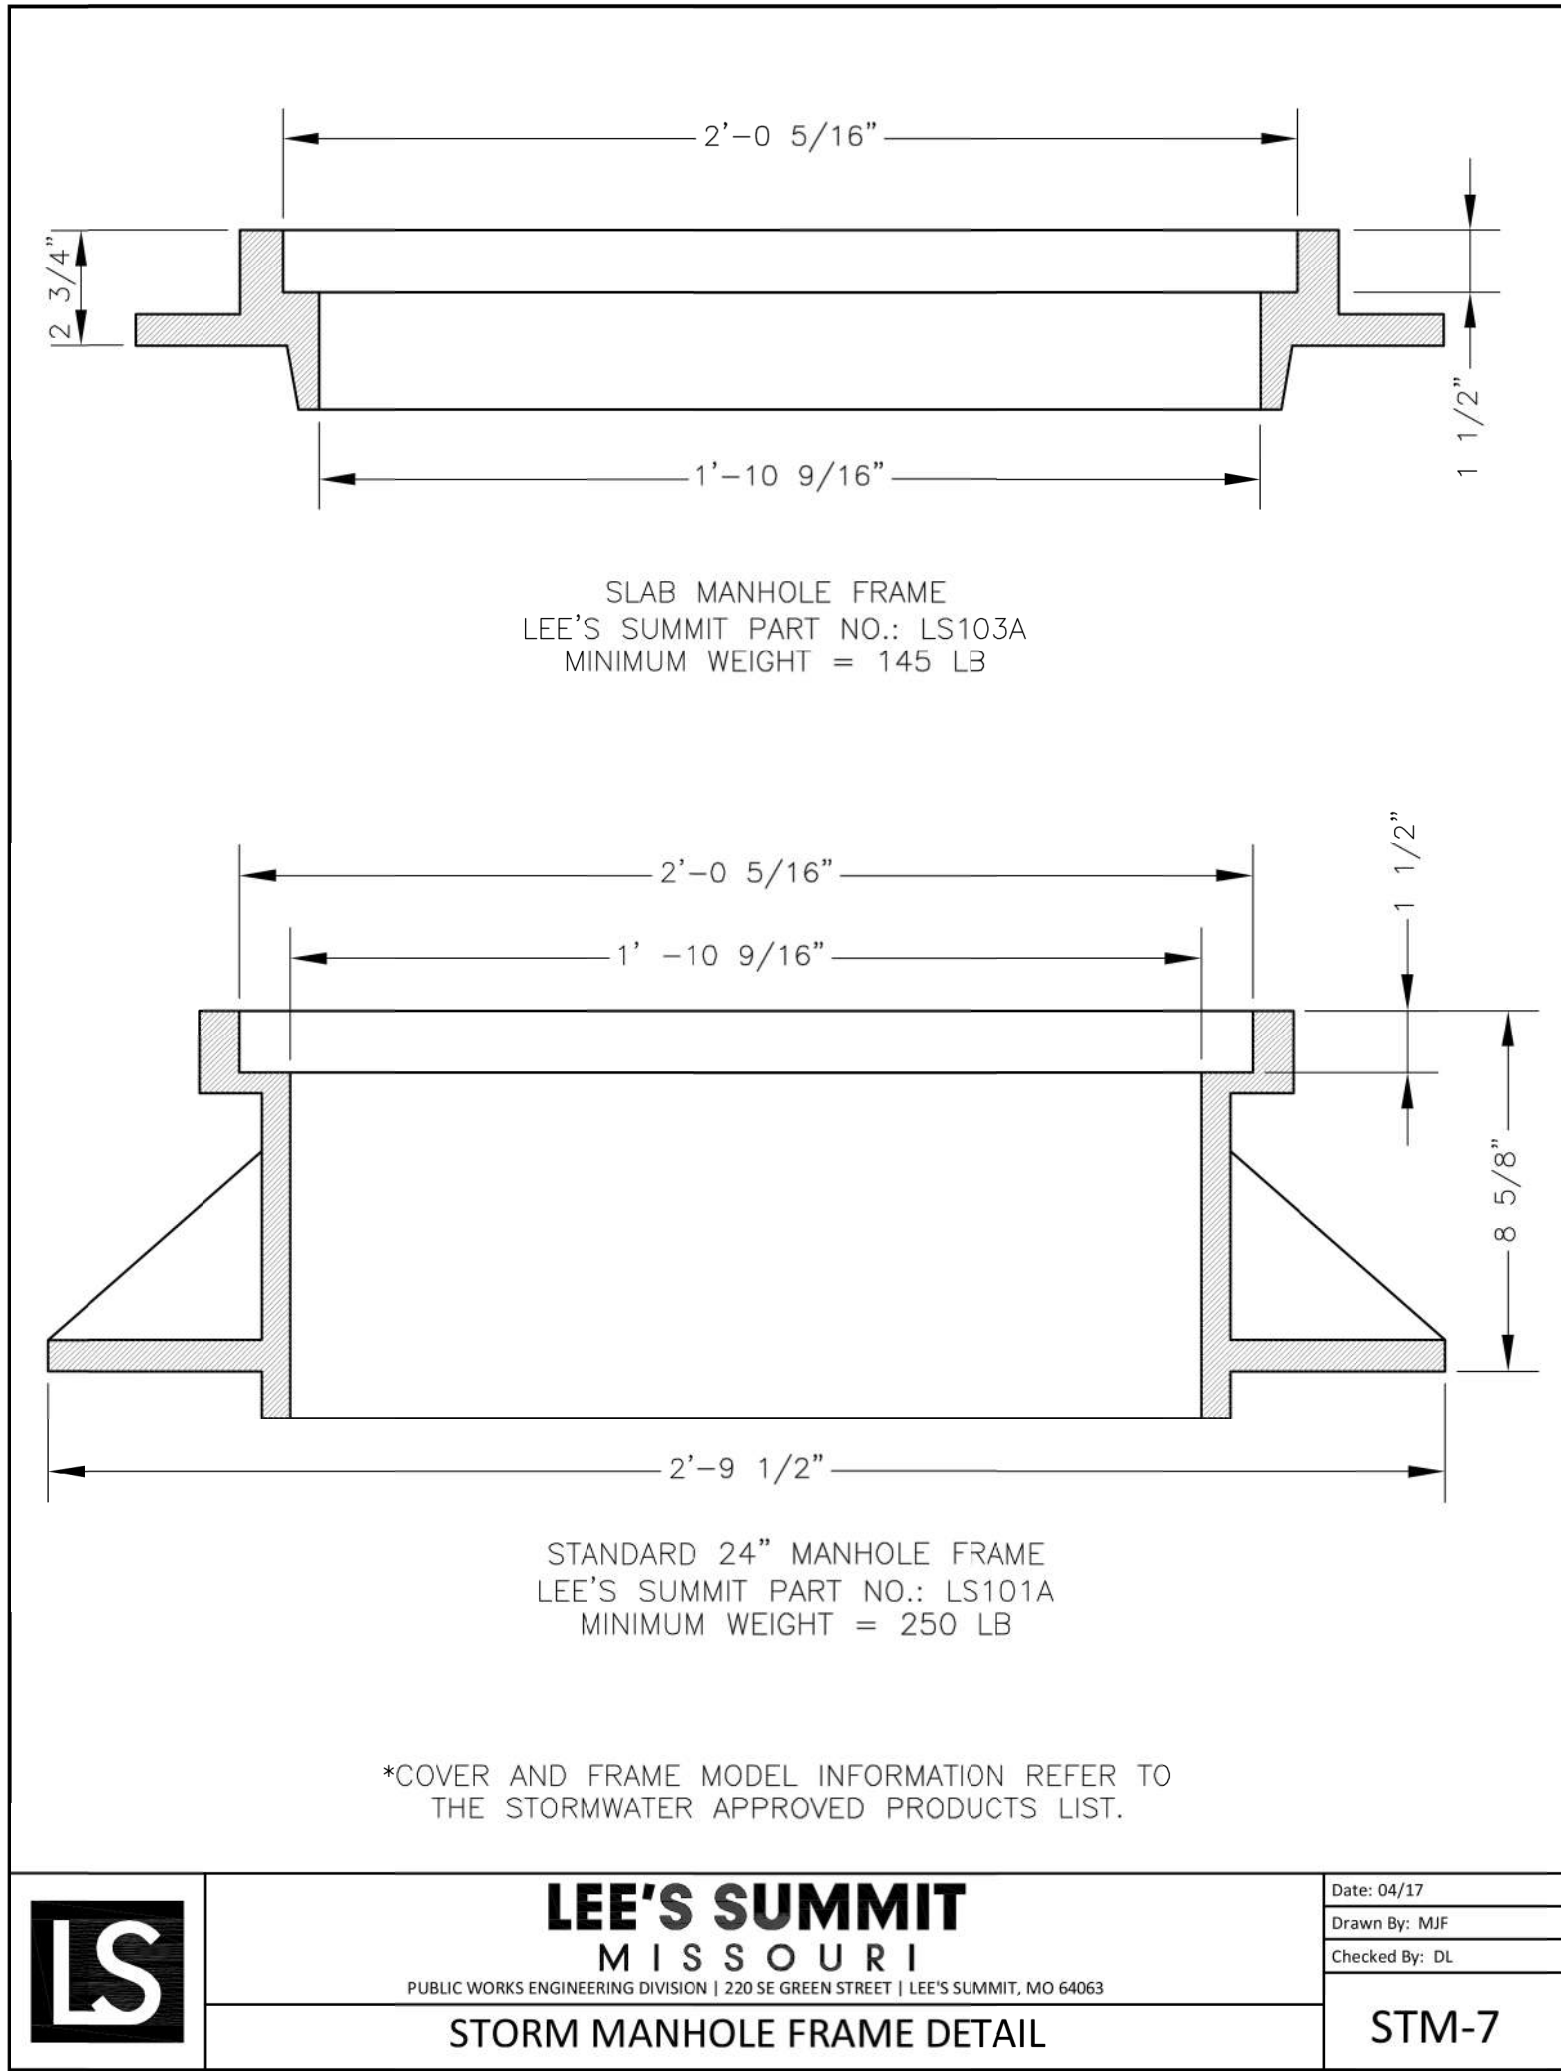

LEE'S SUMMIT
MISSOURI

PUBLIC WORKS ENGINEERING DIVISION | 220 SE GREEN STREET | LEE'S SUMMIT, MO 64063

STORM MANHOLE FRAME DETAIL

Date: 04/17

Drawn By: MJF

Checked By: DL

STM-7

SUMMIT HOMES KC
HIGHLAND MEADOWS - 6TH PLAT

STORM SEWER DETAILS (2)





SHEET NUMBER
C407
30 OF 42

ANDERSON ENGINEERING
EMPLOYEE OWNED

ENGINEERS • SURVEYORS • LABORATORIES • DRILLING
941 W. 141ST TER • KANSAS CITY, MISSOURI 64145 • PHONE (816) 777-0400
A LICENSED MISSOURI ENGINEERING & SURVEYING CORPORATION - LC 62

REVISIONS		DRAWING INFO.	
NO.	DESCRIPTION	BY	DATE
1	REVISED PER CITY COMMENT	GC	2/11/21
2	AS-BUILT DRAWINGS	GC	3/16/22
		CHECK BY:	ZM
		LICENSE NO.	PE-2012009232
		DATE:	1/7/2021
		ISSUED FOR:	FOR REVIEW
		JOB NUMBER:	20K1C0058
		MO COA NO.	00062

© COPYRIGHT ANDERSON ENGINEERING, INC. 2020

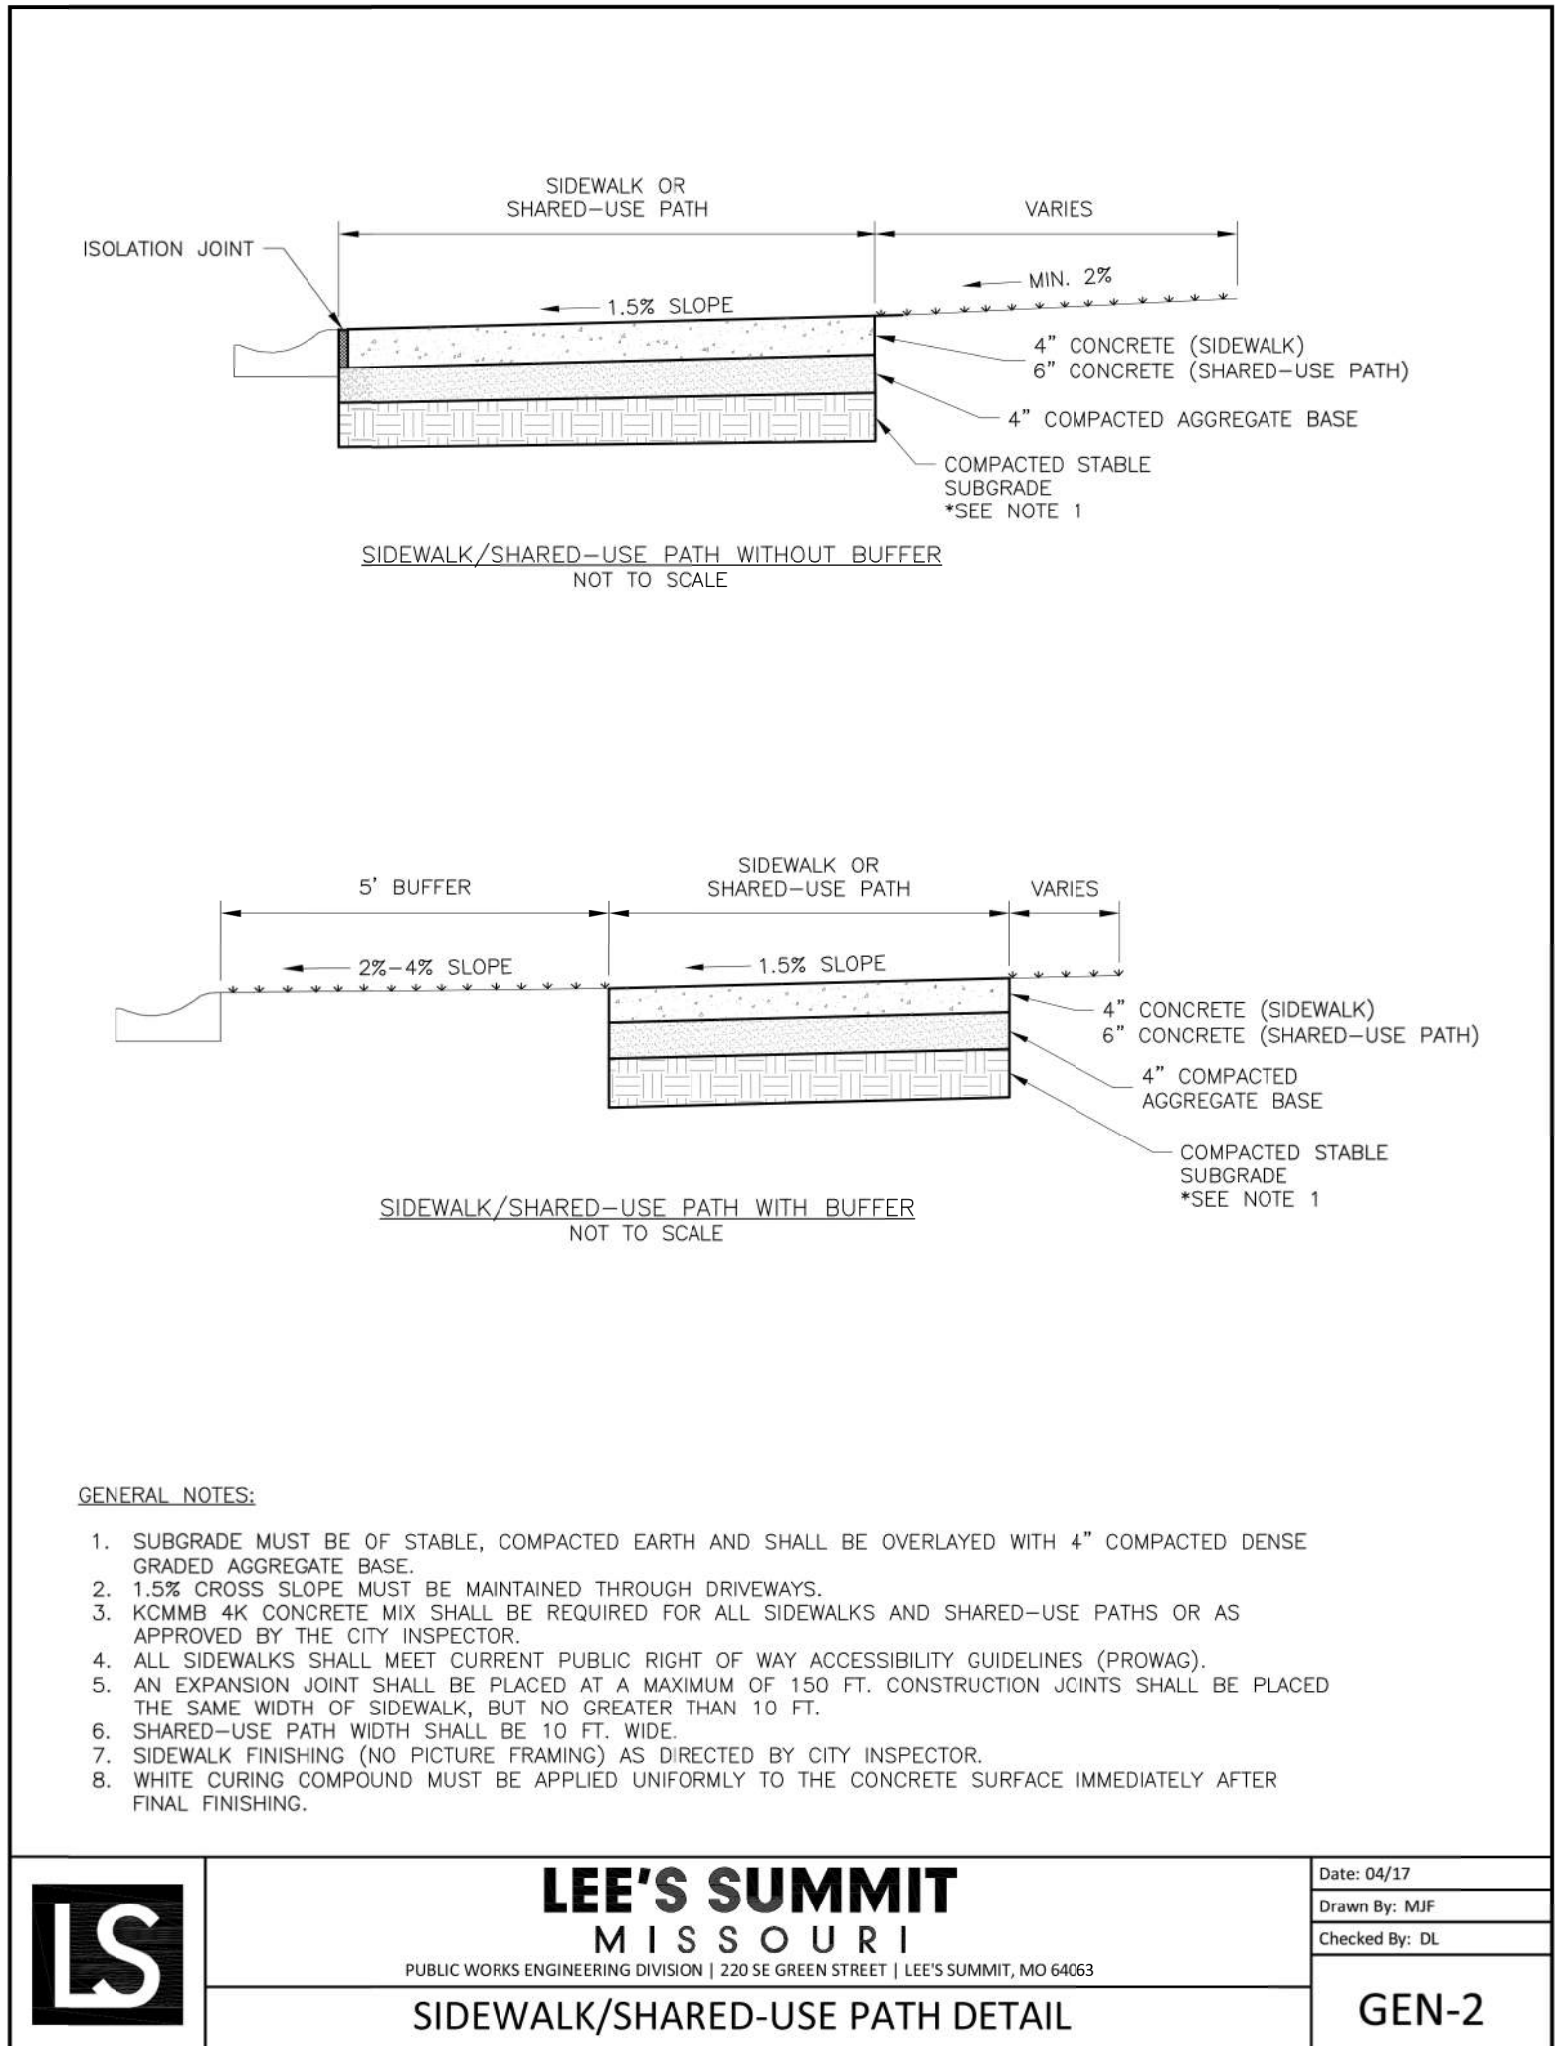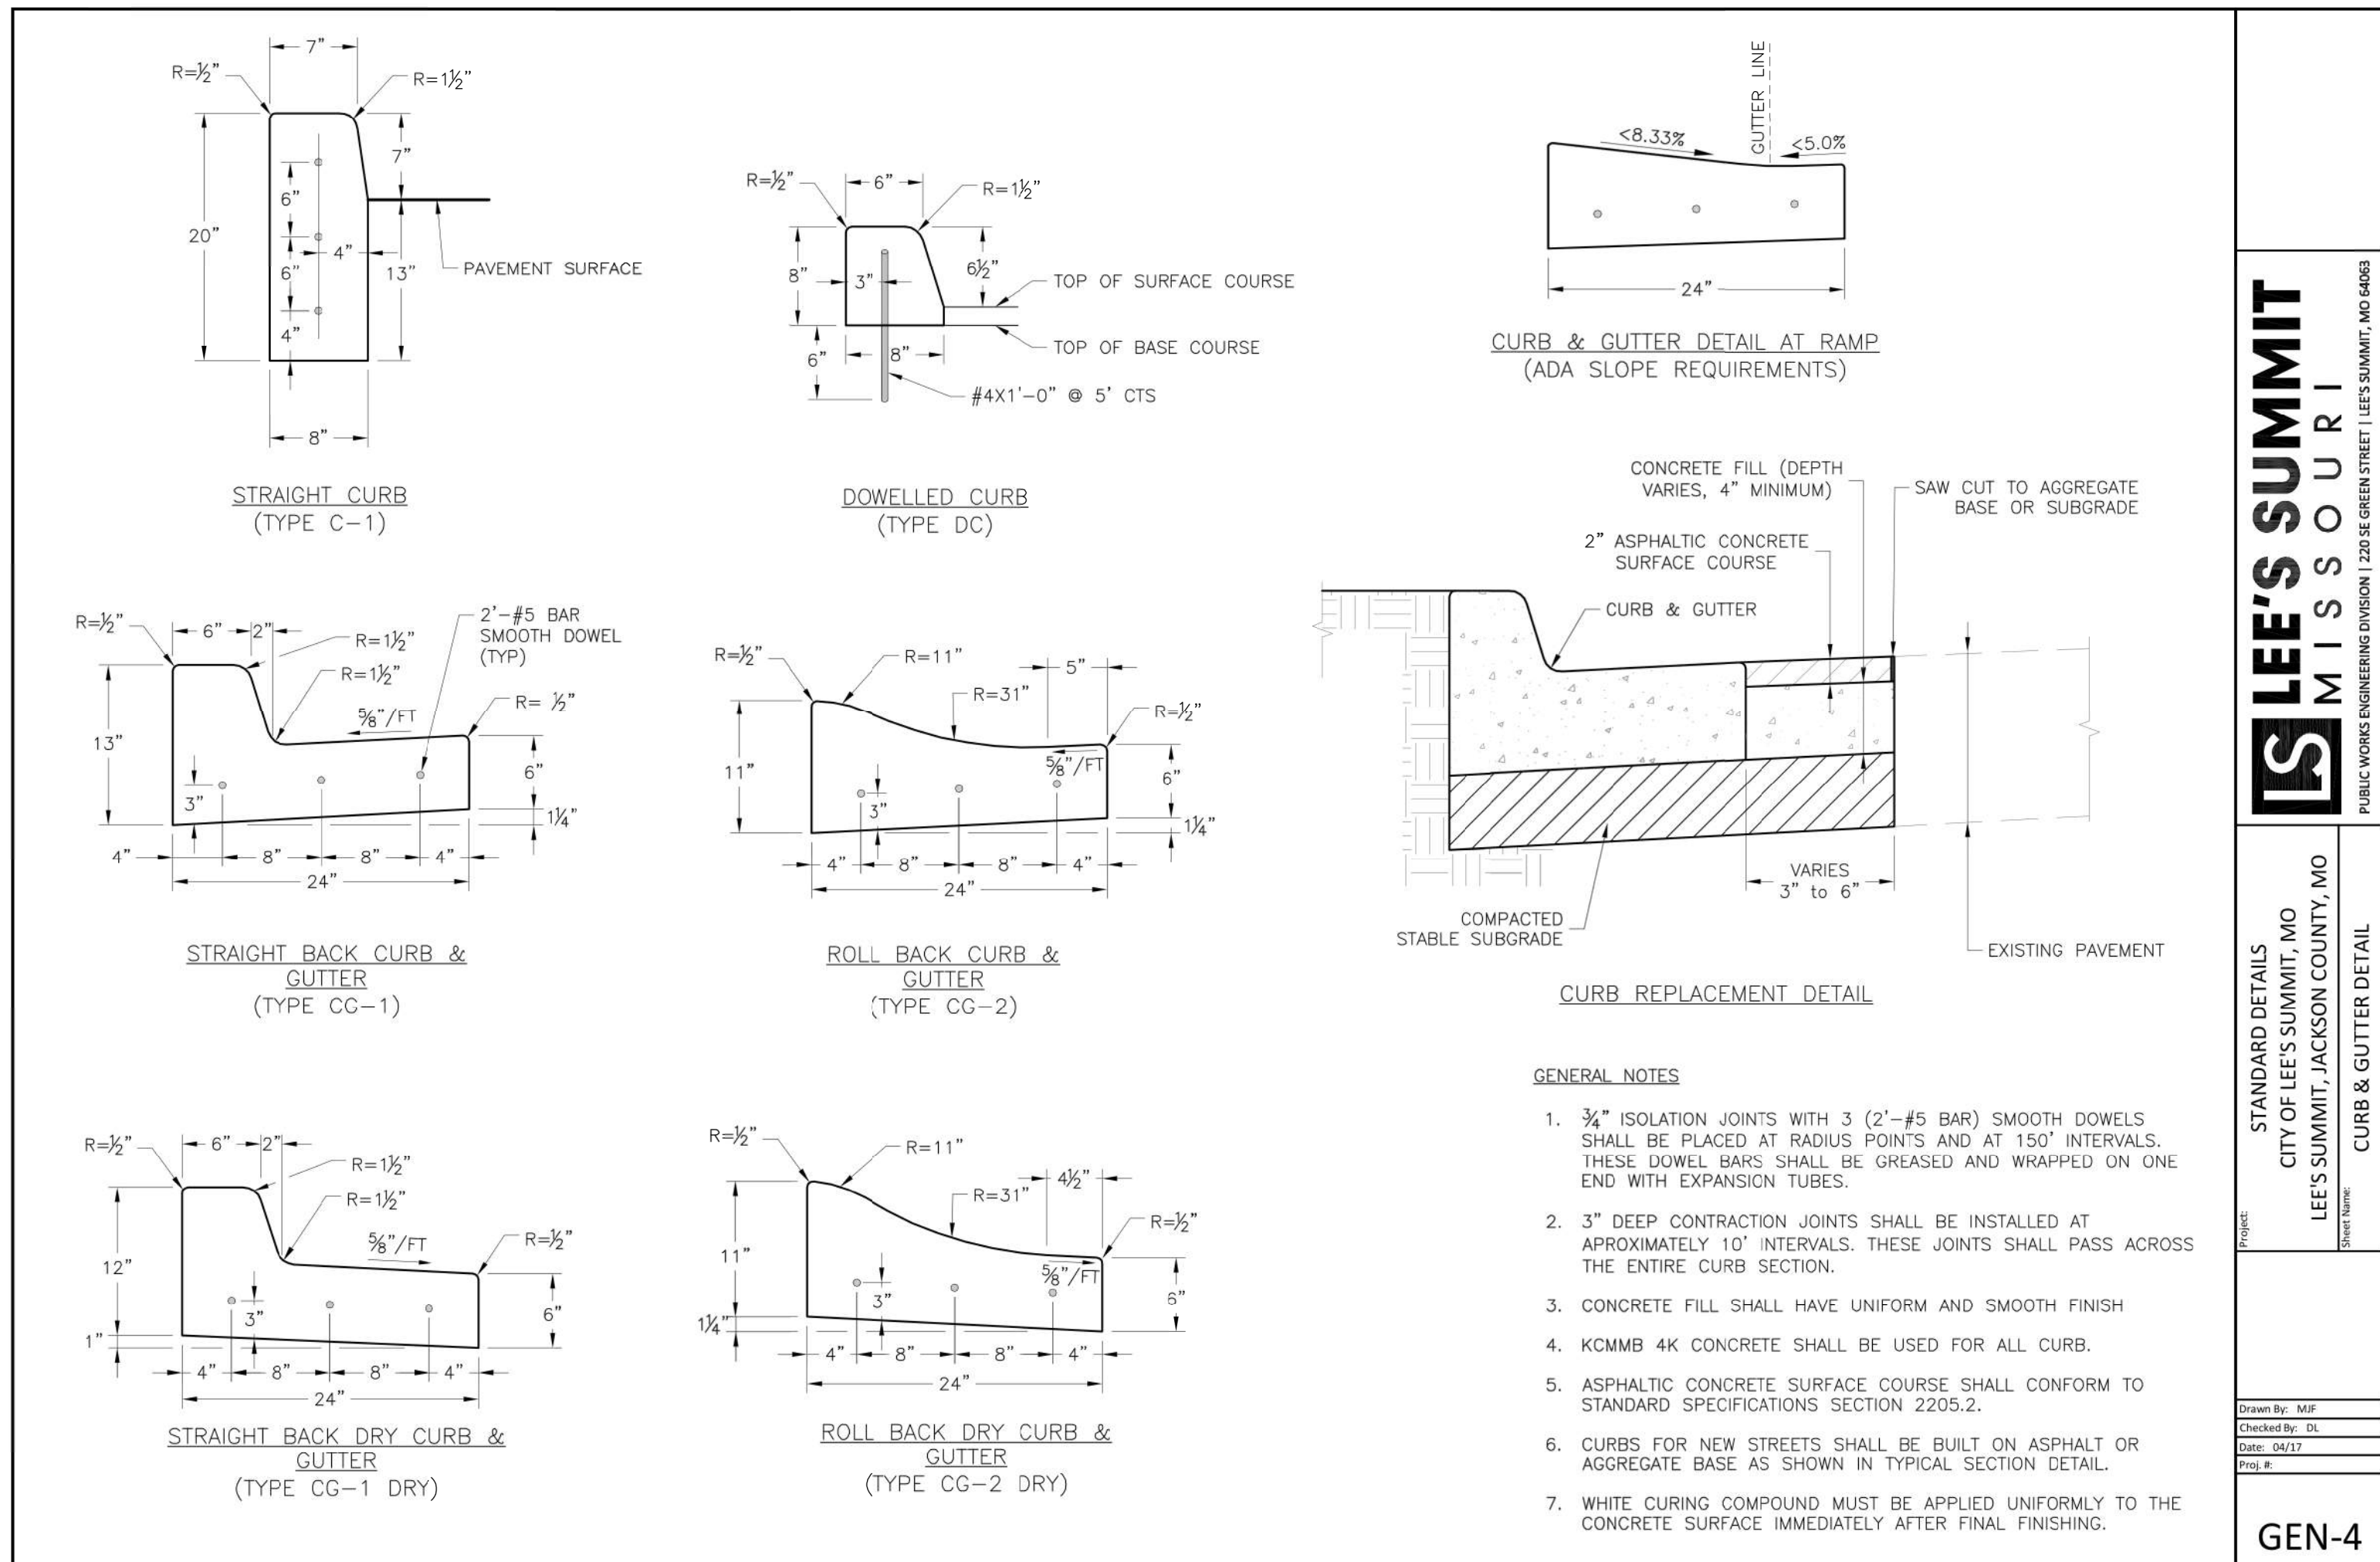

AS-BUILT

The information provided on this drawing conforms to construction records; it is not intended for construction, implementation or recording purposes; and it is solely based on information provided by others (obtained by my firm). ~~100% 100.10%; 1.00%, 1.15% slope~~, or "8-inch HDPE PVC pipe" are all typical examples of revisions that indicate that design data has been replaced with "as-built" information. All other data is as designed and has not been field verified.

Date: 03/24/2022 Certified by: GRC
 Title: Project Engineer Firm: Anderson Engineering Inc.

**RELEASE FOR
CONSTRUCTION
AS NOTED ON PLANS REVIEW
DEVELOPMENT SERVICES
LEE'S SUMMIT, MISSOURI**

04/16/2021



**ANDERSON
ENGINEERING**
EMPLOYEE OWNED


ENGINEERS • SURVEYORS • LABORATORIES • DRILLING
941 W. 141ST TER. • KANSAS CITY, MISSOURI 64145 • PHONE (816) 777-0400
A LICENSED MISSOURI ENGINEERING & SURVEYING CORPORATION - LC 62

REVISIONS			DRAWING INFO.			
NO.	DESCRIPTION	BY	DATE	DRAWN BY:	GC	
1	REVISED PER CITY COMMENT	GC	2/11/21	CHECK BY:	ZM	
				LICENSE NO.	PE-2012009232	
				DATE:	1/7/2021	
2	AS-BUILT DRAWINGS	GC	3/16/22	ISSUED FOR:	FOR REVIEW	
				JOB NUMBER:	20CK10058	
© COPYRIGHT ANDERSON ENGINEERING, INC. 2020				MO COA NO.	000062	

SUMMIT HOMES KC
HIGHLAND MEADOWS - 6TH PLAT

CURB & SIDEWALK DETAILS


S10, T47N, R32W
LEE'S SUMMIT, JACKSON COUNTY, MISSOURI

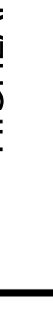


SHEET NUMBER

C408

31 OF 42

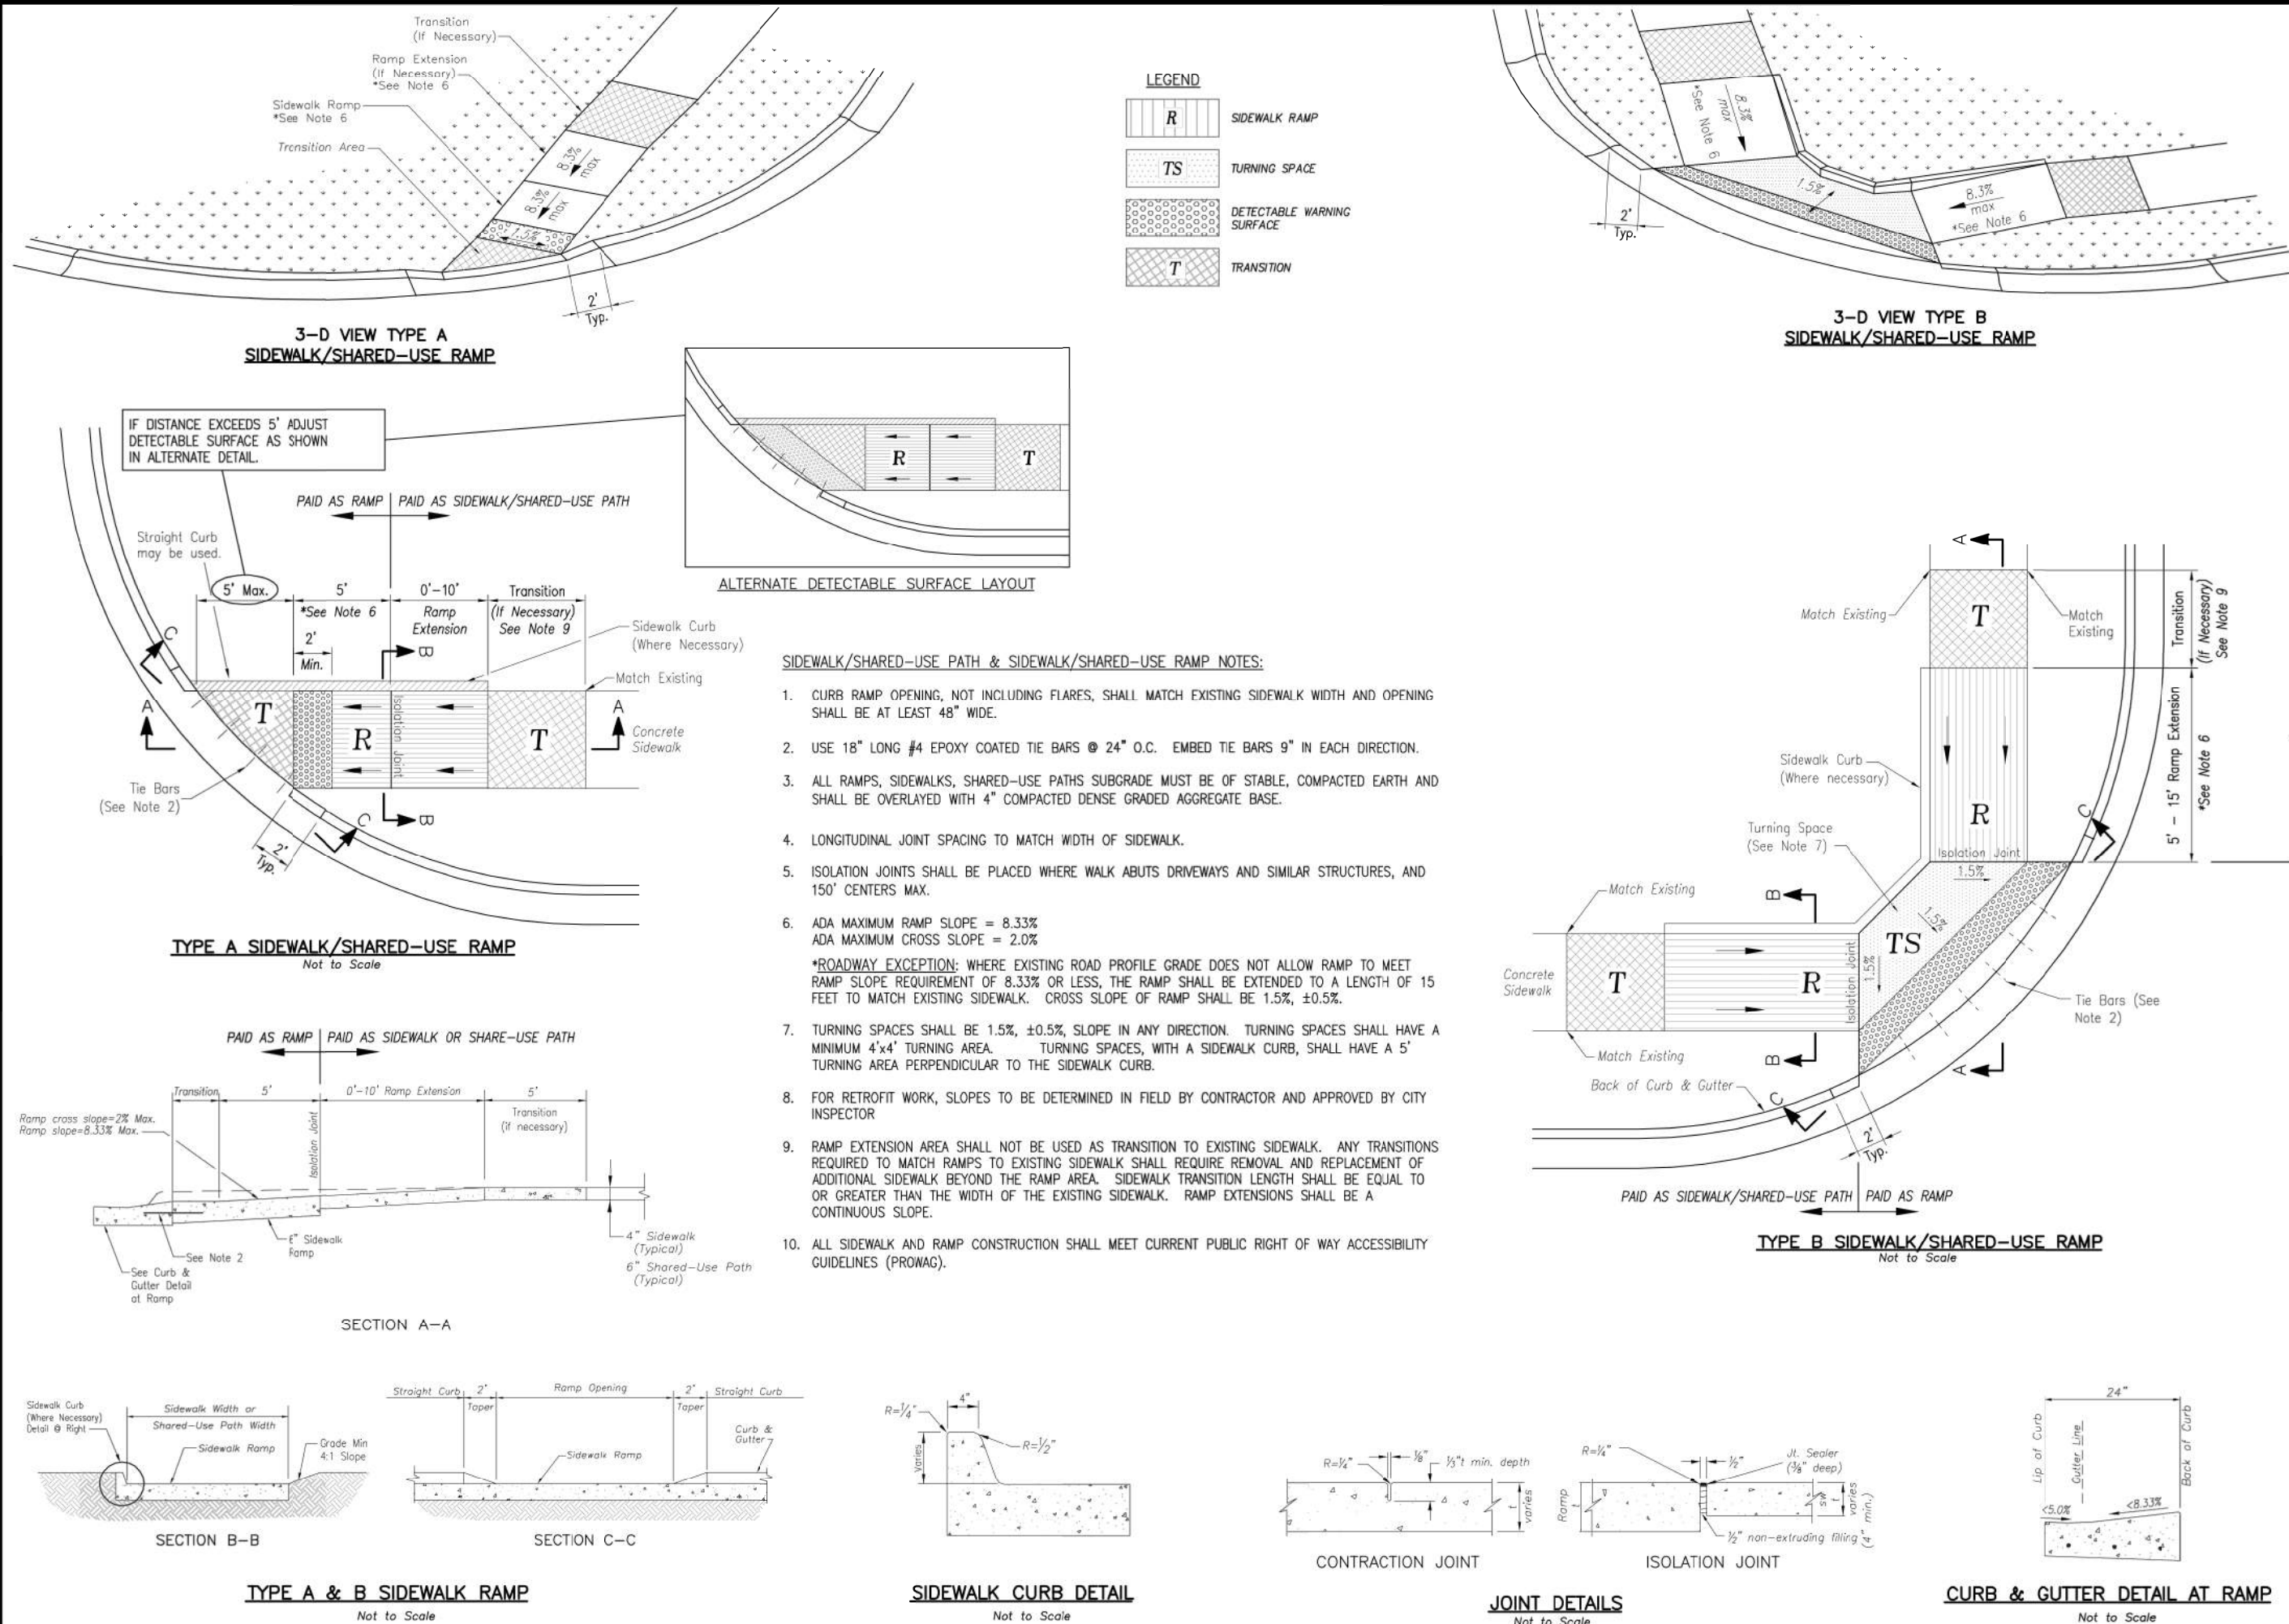

Project:	STANDARD DETAILS
City:	CITY OF LEE'S SUMMIT, MO
Sheet Name:	LEE'S SUMMIT, JACKSON COUNTY, MO
Sheet:	ADA RAMP RETROFIT DETAIL
Drawn By:	MMB
Checked By:	DL
Date:	04/17
Proj. #:	
GEN-3A	

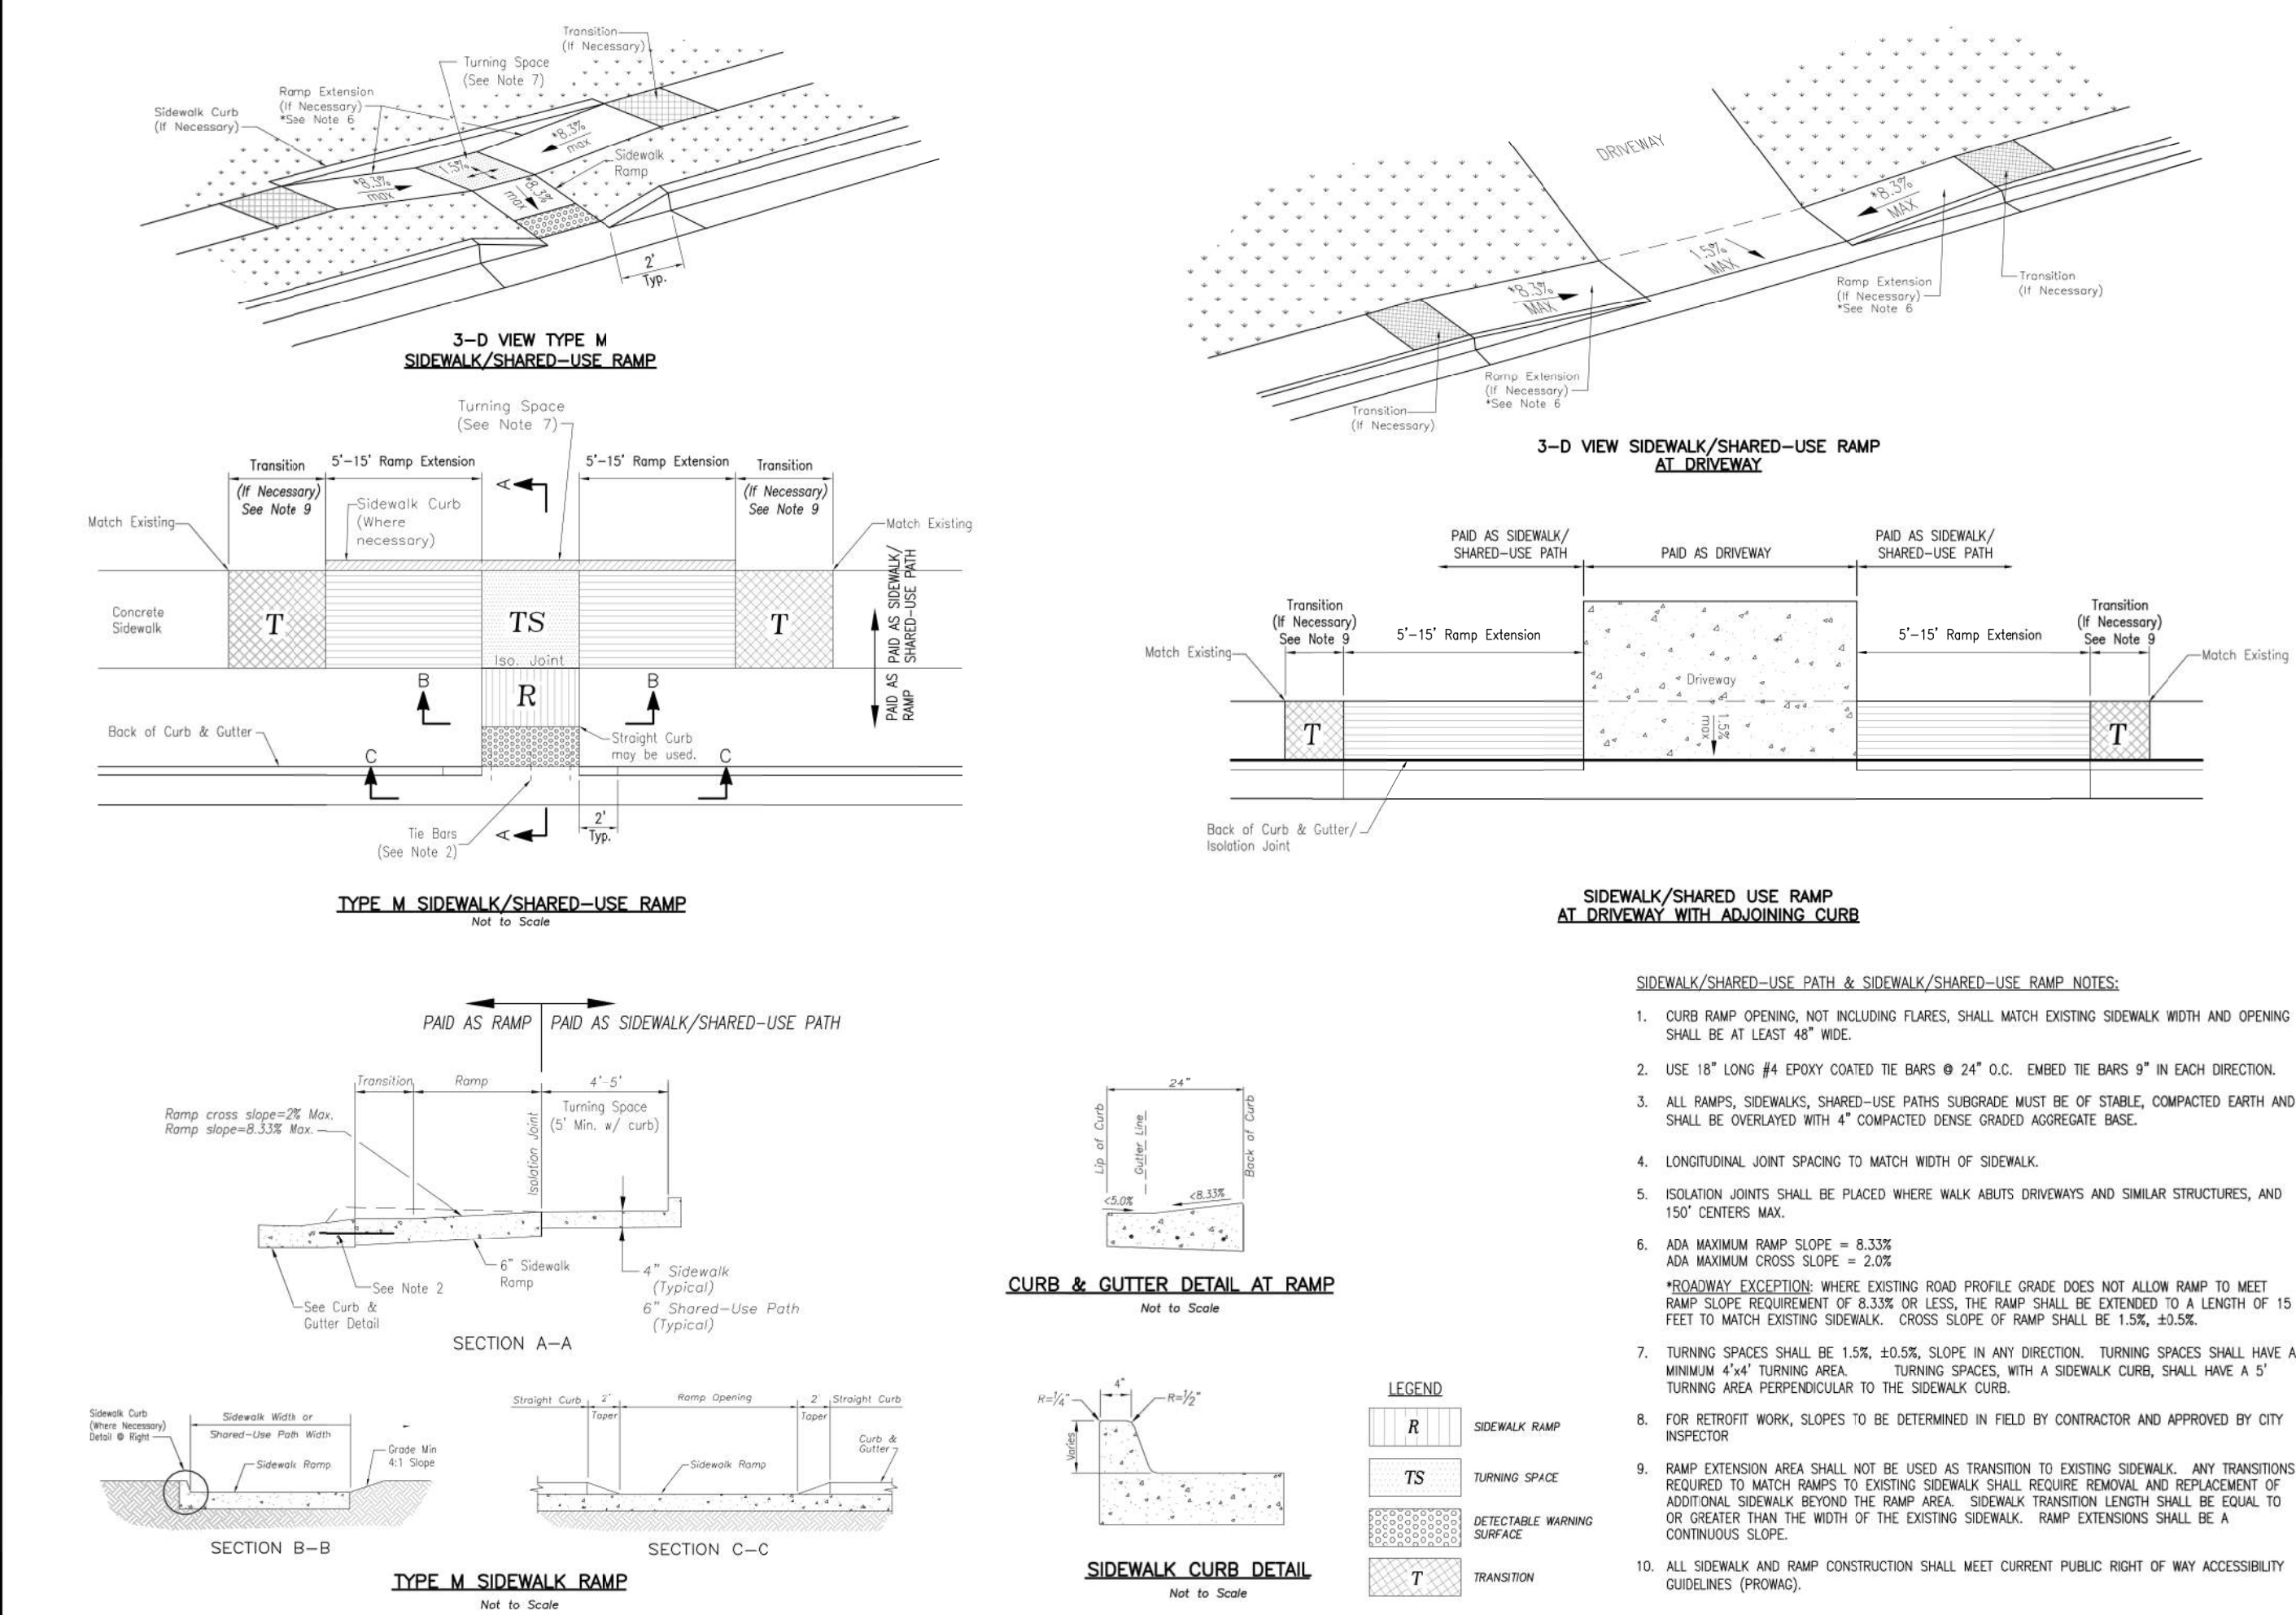

Project:	STANDARD DETAILS
City:	CITY OF LEE'S SUMMIT, MO
Sheet Name:	LEE'S SUMMIT, JACKSON COUNTY, MO
Sheet:	ADA RAMP RETROFIT DETAIL
Drawn By:	MMB
Checked By:	DL
Date:	04/17
Proj. #:	
GEN-3B	

AS-BUILT

The information provided on this drawing conforms to construction records; it is not intended for construction, implementation or recording purposes; and it is solely based on information provided by others / obtained by my firm. *DO NOT SCALE. 100' = 1" (1.15% slope) or 8-inch diameter PVC pipe are all typical examples of revisions that indicate that design data has been replaced with "as-built" information. All other data is as designed and has not been field verified.

Date: 03/24/2022
Title: Project Engineer
Firm: Anderson Engineering Inc.

Certified by: GRC
04/16/2021

RELEASE FOR CONSTRUCTION
AS NOTED ON PLANS REVIEW
DEVELOPMENT SERVICES
LEE'S SUMMIT, MISSOURI
04/16/2021

ANDERSON ENGINEERING
EMPLOYEE OWNED

ENGINEERS • SURVEYORS • LABORATORIES • DRILLING
941 W. 141ST TER • KANSAS CITY, MISSOURI 64145 • PHONE (816) 777-0400
A LICENSED MISSOURI ENGINEERING & SURVEYING CORPORATION - LC 62

REVISIONS		DRAWING INFO.	
NO.	DESCRIPTION	BY	DATE
1	REVISED PER CITY COMMENT	GC	2/11/21
2	AS-BUILT DRAWINGS	GC	3/16/22
		CHECK BY:	ZM
		LICENSE NO.	PE-2012009232
		DATE:	1/7/2021
		ISSUED FOR:	FOR REVIEW
		JOB NUMBER:	20KCI00058
		MO COA NO.	00062

© COPYRIGHT ANDERSON ENGINEERING, INC. 2020

SUMMIT HOMES KC
HIGHLAND MEADOWS - 6TH PLAT

ADA RAMP DETAILS

S10, T47N, R2W
LEE'S SUMMIT, JACKSON COUNTY, MISSOURI

STATE OF MISSOURI
ZACH A. MYERS
PROFESSIONAL ENGINEER
NUMBER
PE-2012009232
03/14/2021

SHEET NUMBER
C409
32 OF 42

Feb 11, 2021 -- 6:11pm Plotted By: gcale G:\Shared drives\K1010 - Land Development\Projects\2020\20K100058 Highland Meadows - 6th Plat\01 CIVIL\03-DWG\Sheet\STREET AND STORM\20K100058 - SHY - SIGNAGE.dwg Layout: STREET NAME SIGN DETAILS

AS-BUILT

The information provided on this drawing conforms to construction records; it is not intended for construction, implementation or recording purposes; and it is solely based on information provided by others obtained by my firm. ~~100-00~~ 100.10', 1.00% 1.15% slope", or 8-inch HDPE PVC pipe" are all typical examples of revisions that indicate that design data has been replaced with "as-built" information. All other data is as designed and has not been field verified. Date: 03/24/2022 Certified by: GPC Title: Project Engineer Firm: Anderson Engineering Inc.


STANDARD ABBREVIATION LISTS

Named Streets	
Avenue	AVE
Boulevard	BLVD
Circle	CIR
Creek	CR
Court	CT
Crossing	XING
Drive	DR
Highway	HWY
Lane	LN
Parkway	PKWY
Place	PL
Road	RD
Street	ST
Terrace	TER
Trail	TRL
Way	WAY

Numbered Streets	
First	ST
Second	ND
Third	RD
Fourth to Tenth	TH

STREET NAME SIGN QUANTITIES


Sign Designation	Sign Size	Sign Area (Sq. Ft.)	Number	Quantity (Sq. Ft.)
D3-1 (SP-1)	9" x 30"	1.875	3	5.625
D3-1 (SP-2)	9" x 30"	1.875	1	1.875
D3-1 (SP-3)	9" x 30"	1.875	1	1.875
D3-1 (SP-4)	9" x 30"	1.875	1	1.875
D3-1 (SP-5)	9" x			
D3-1 (SP-6)	9" x			

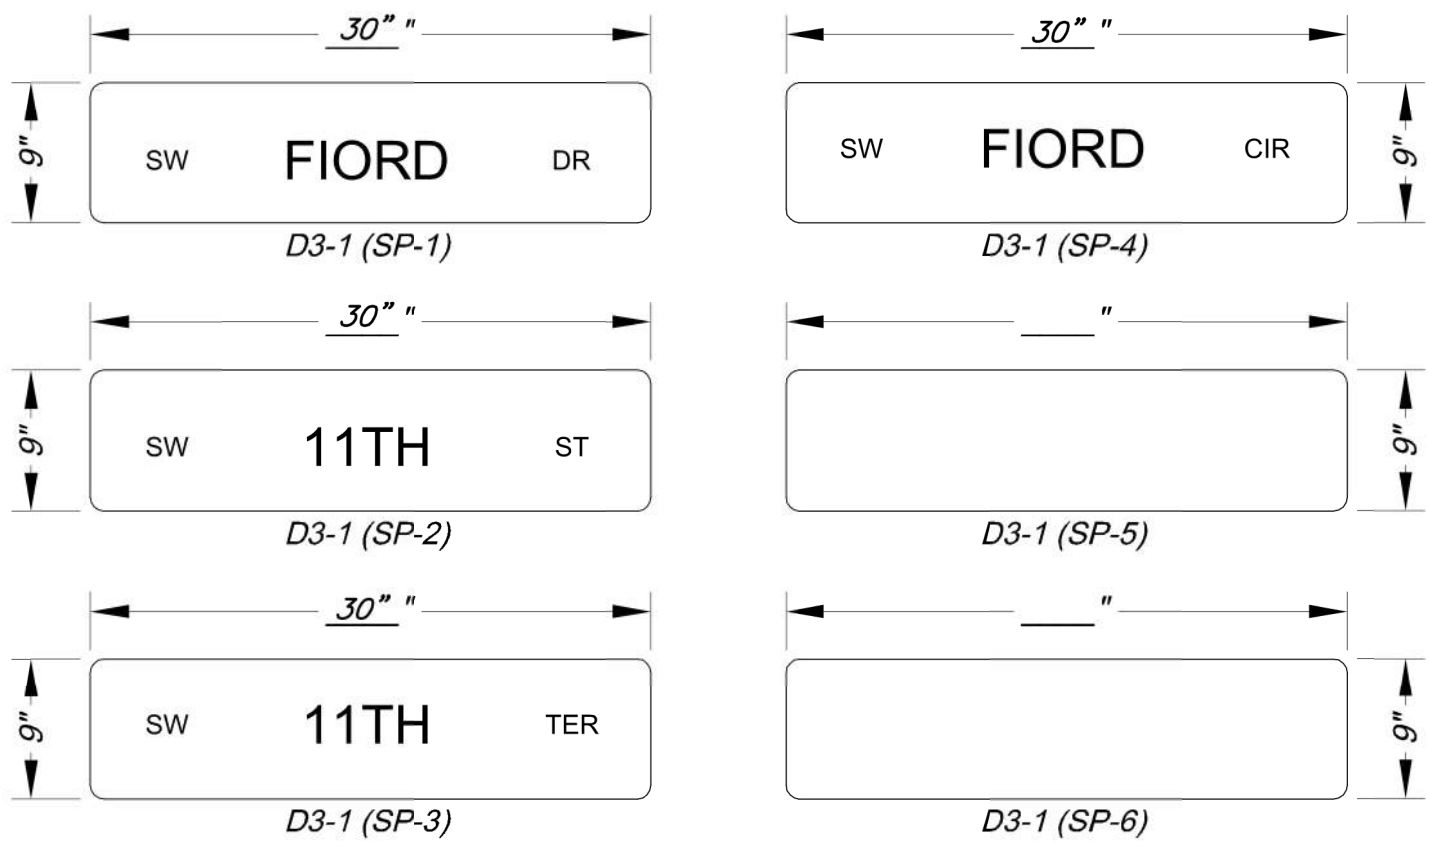

PROJECT SIGN DETAILS


STREET NAME SIGN BLANK DETAILS

For Mounting on Square Steel Posts

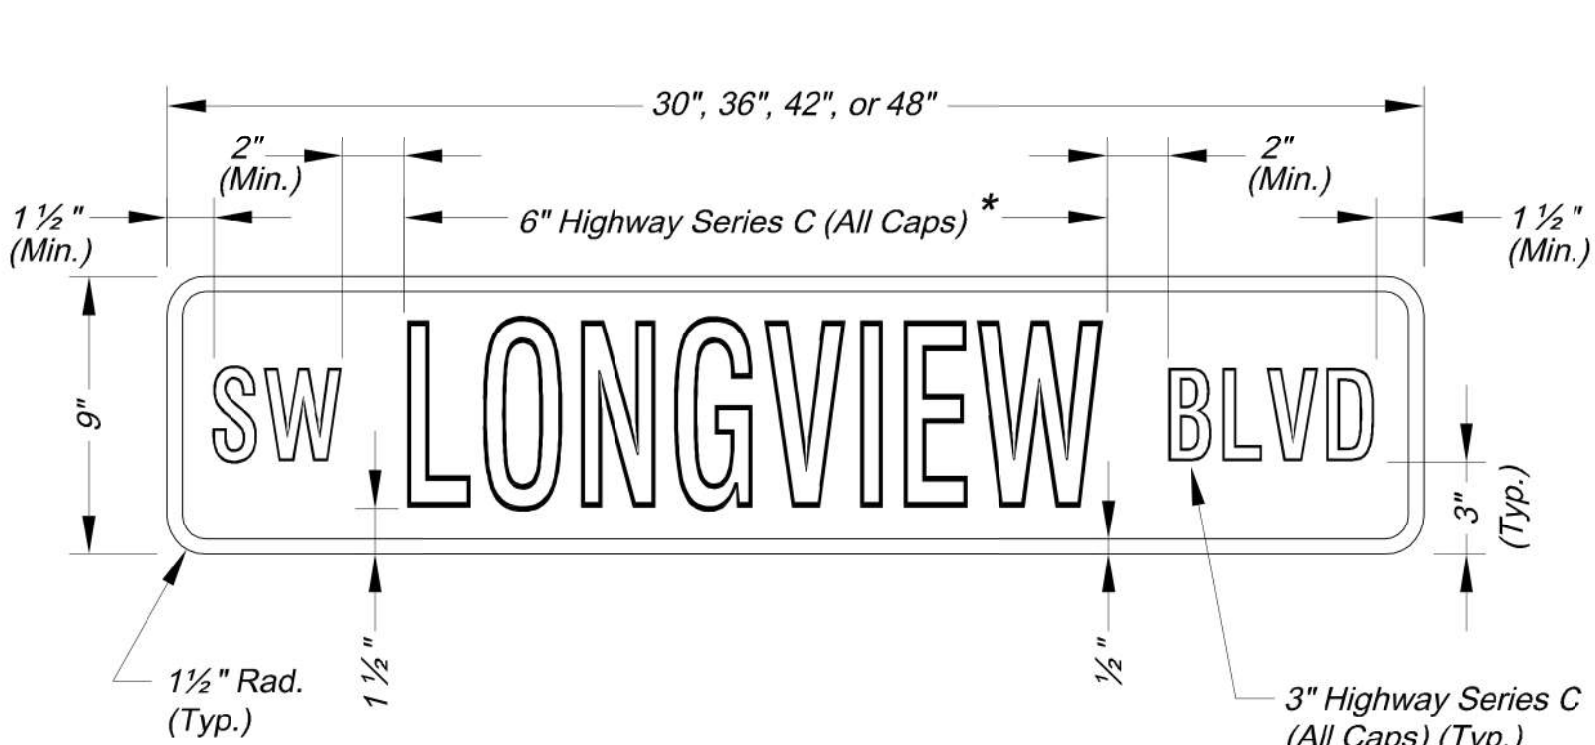


NAMED STREET NAME SIGN DETAIL


* Use Highway Series B (All Caps) in lieu of series C if necessary to fit text on a 36" sign blank.

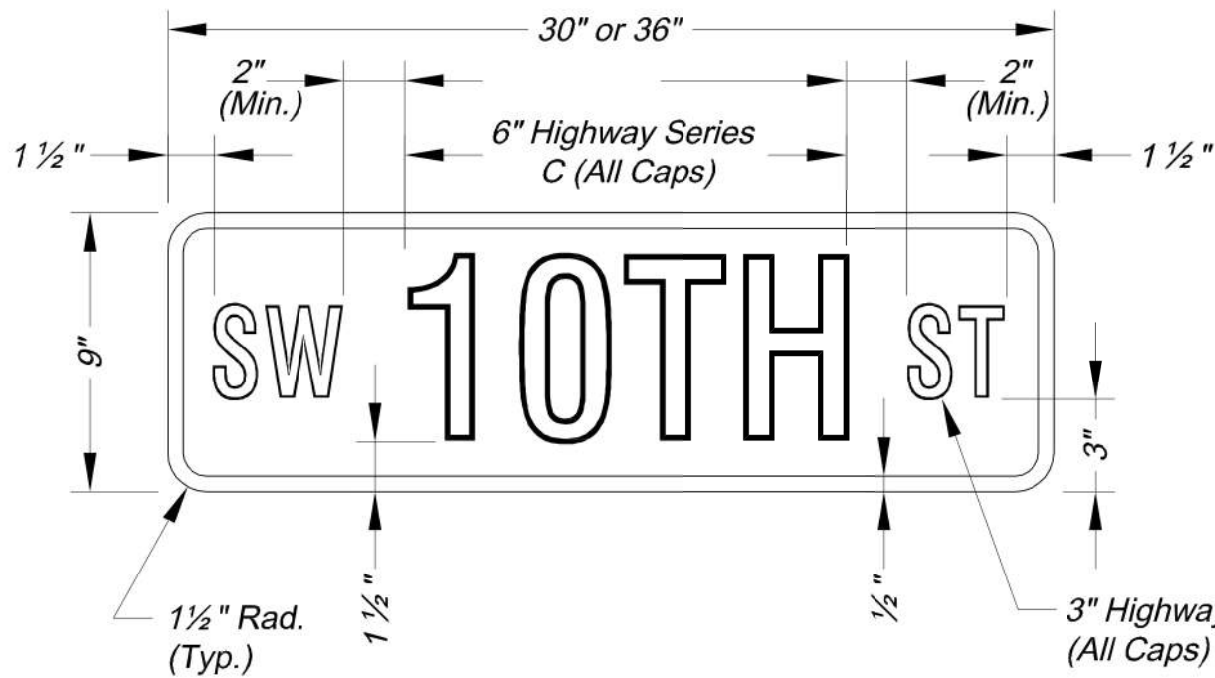

NUMBERED STREET NAME SIGN DETAIL

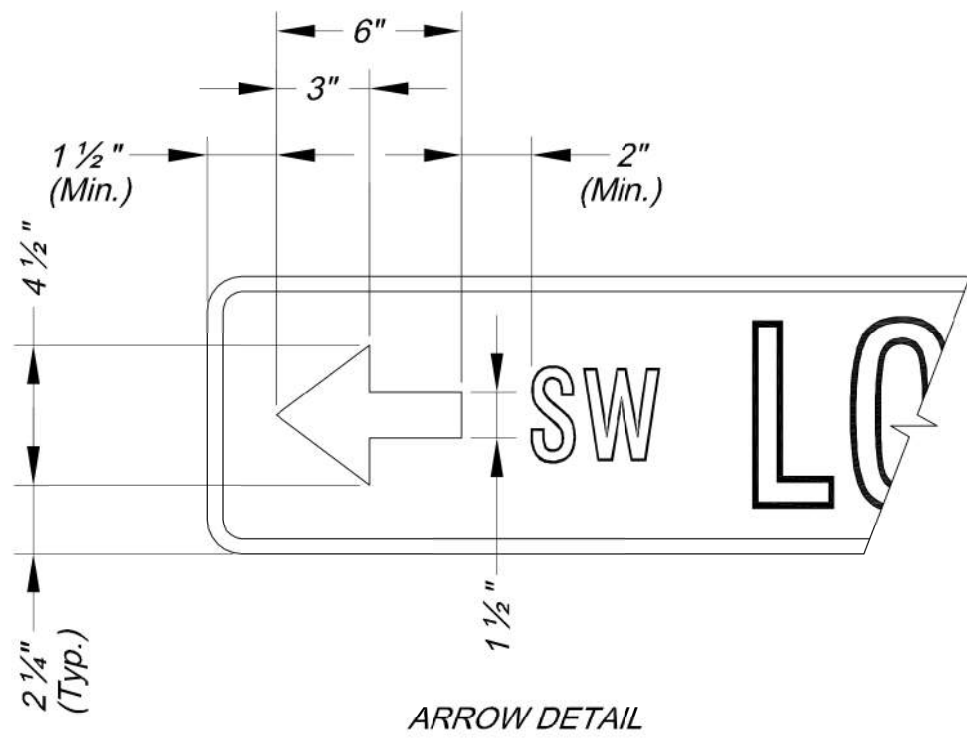

ARROW DETAIL

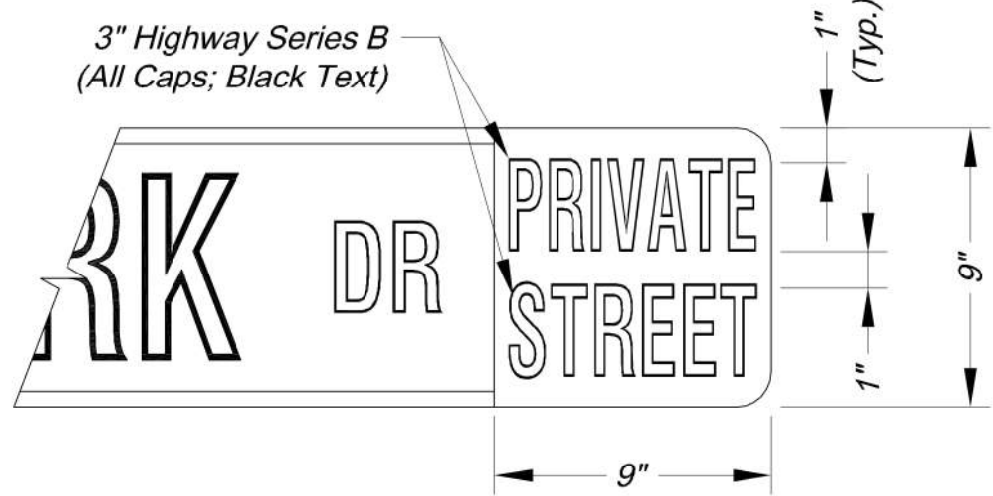


PRIVATE STREET TAG DETAIL

NOTES:

- For all street name signs, the legend shall be white and the background shall be green.
- Arrows shall be added to street name signs where the name of a street changes at an intersection. Street name signs with arrows are to be installed on each side of the intersection to indicate the change in names. Arrows shall be white.
- The "PRIVATE STREET" tag should be added to the end of street name signs to indicate where a street that is outside the right-of-way intersects a public street. The background for the "PRIVATE STREET" tag shall be yellow.

STREET NAME SIGN FACE DETAILS

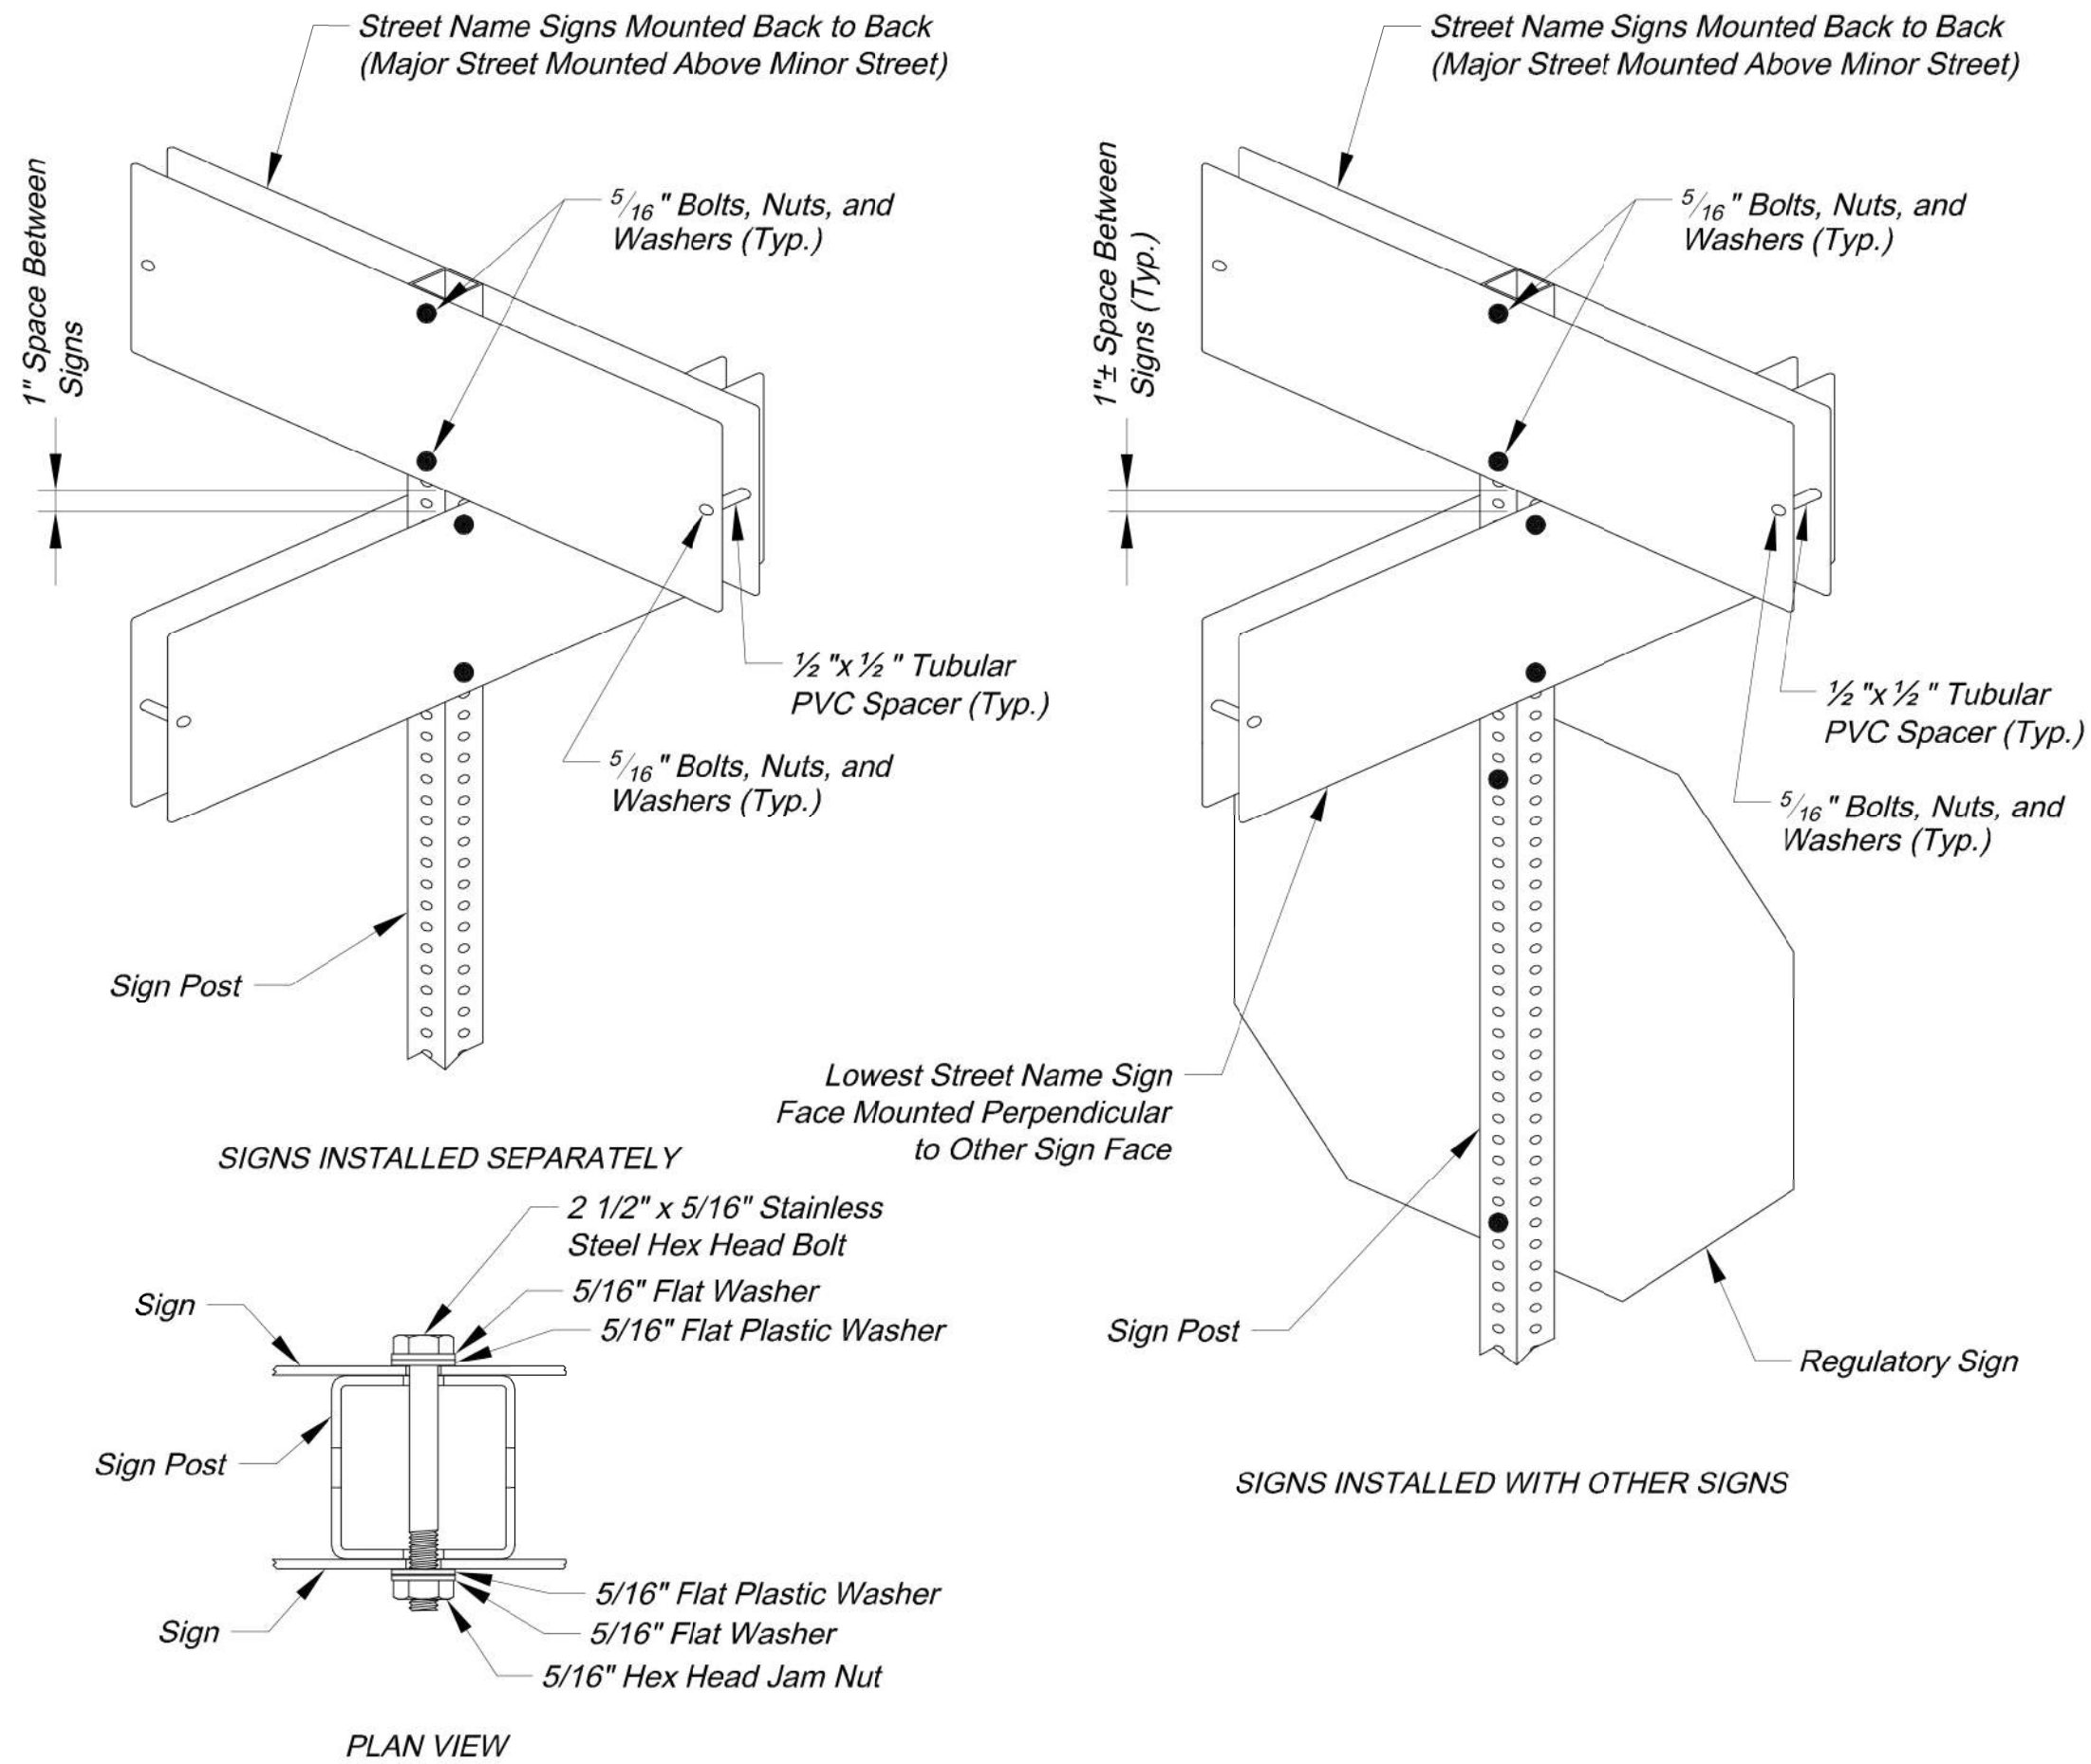

SQUARE STEEL POST MOUNTING DETAILS

NOTES:

- Wing bracket shall be an L-shaped cantilever of T-beam rigid frame 380-3 aluminum alloy construction.
- Mount each wing bracket to metal pole using two 3/4" wide stainless steel straps.
- One wing bracket shall be installed per each sign. Cross brackets are not allowed.

WING BRACKET MOUNTING DETAILS

CITY OF LEE'S SUMMIT
PUBLIC WORKS DEPARTMENT
ENGINEERING DIVISION
220 SE GREEN STREET
LEE'S SUMMIT, MISSOURI 64063
PHONE: (816) 969-1800 FAX: (816) 969-1809



STREET NAME SIGN DETAILS
STANDARD DRAWING SN-3

Project:
Sheet Name:
Drawn By: AS
Checked By: JW
Date: 08/26/2009
Project#

3 OF 3

3

ANDERSON ENGINEERING
EMPLOYEE OWNED
ENGINEERS • SURVEYORS • LABORATORIES • DRILLING
941 W. 141ST TER • KANSAS CITY, MISSOURI 64145 • PHONE (816) 777-0400
A LICENSED MISSOURI ENGINEERING & SURVEYING CORPORATION - LC 62

REVISIONS		DRAWING INFO.	
NO.	DESCRIPTION	BY	DATE
1	REVISED PER CITY COMMENT	GC	2/11/21
2	AS-BUILT DRAWINGS	GC	3/16/22


GC	2/11/21	PE-2012009232	1/7/2021	FOR REVIEW	20K100058	000062
JOB NUMBER:	ISSUED FOR:	DATE:	LICENSE NO.:	CHECK BY:	DRAWN BY:	MO COA NO.:

SUMMIT HOMES KC
HIGHLAND MEADOWS - 6TH PLAT
STREET NAME SIGN DETAILS
S10, T47N, R32W
LEE'S SUMMIT, JACKSON COUNTY, MISSOURI




SHEET NUMBER
C411
34 OF 42


6:12pm Plotted By: gsc Feb 11, 2021 -- 6:12pm Plotted By: gsc G:\Shared drives\KCTO - Land Development\Projects\2020\20KCI0058 Highland Meadows - 6th Plat\01 CIVIL\03-DWG\Sheet\STREET AND STORM\20KCI0058 - SH1 - DETAILS.dwg Layout: CONSTRUCTION ENTRANCE DETAILS

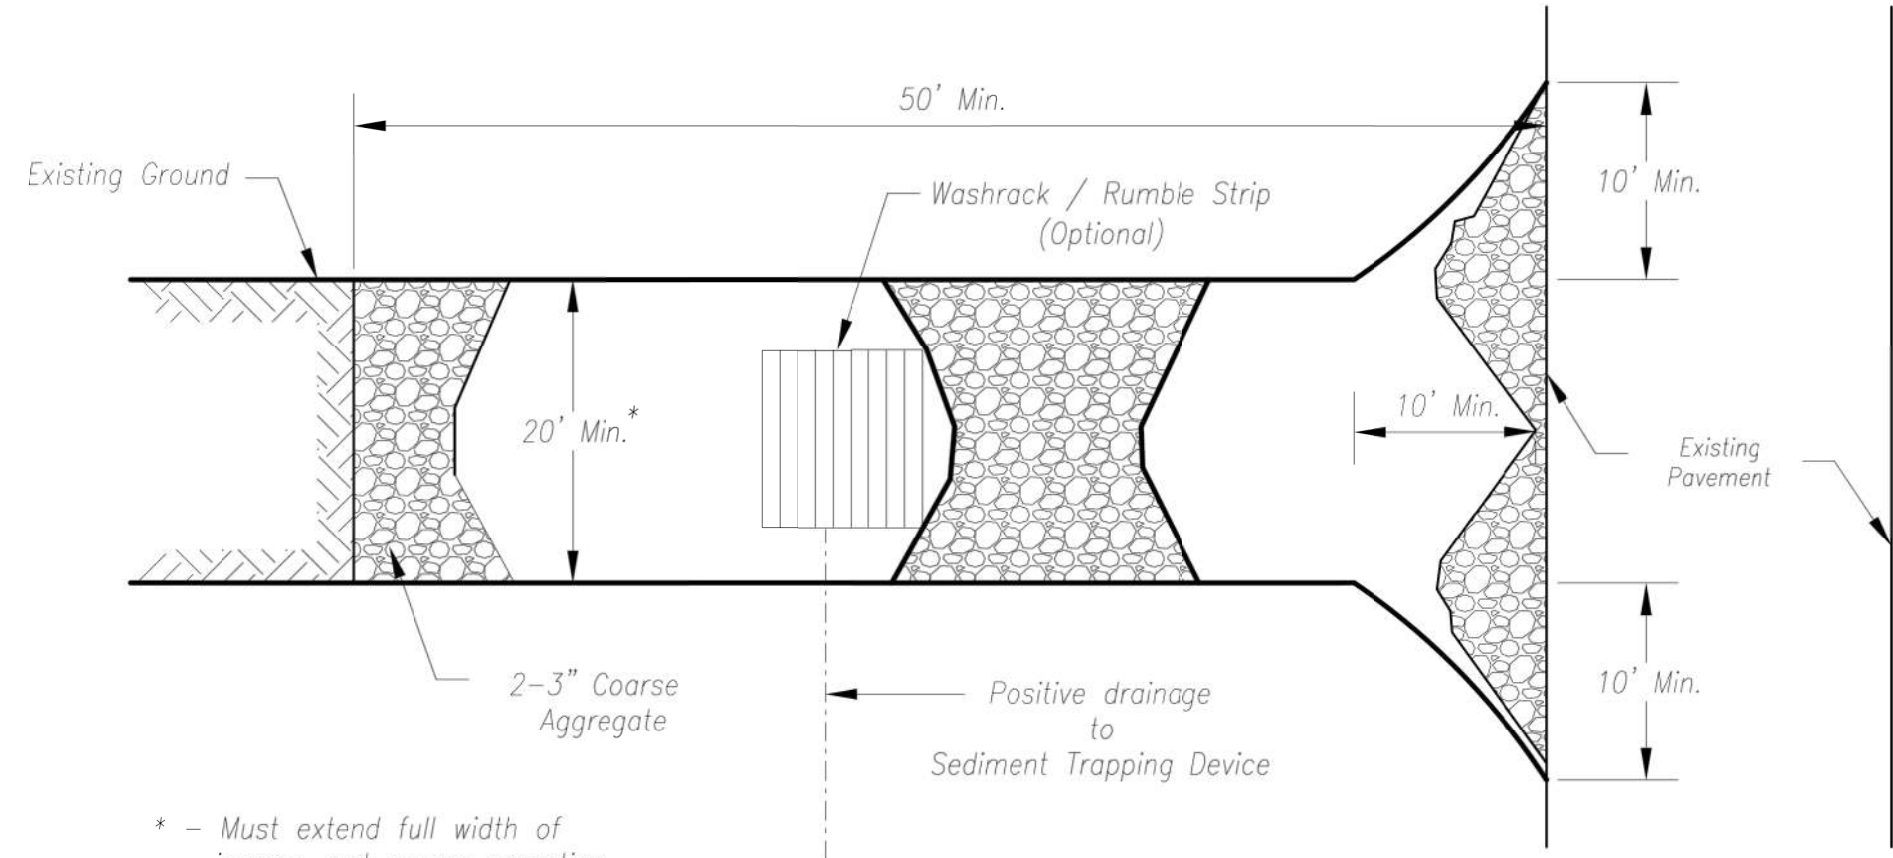

Plan View
Not to Scale

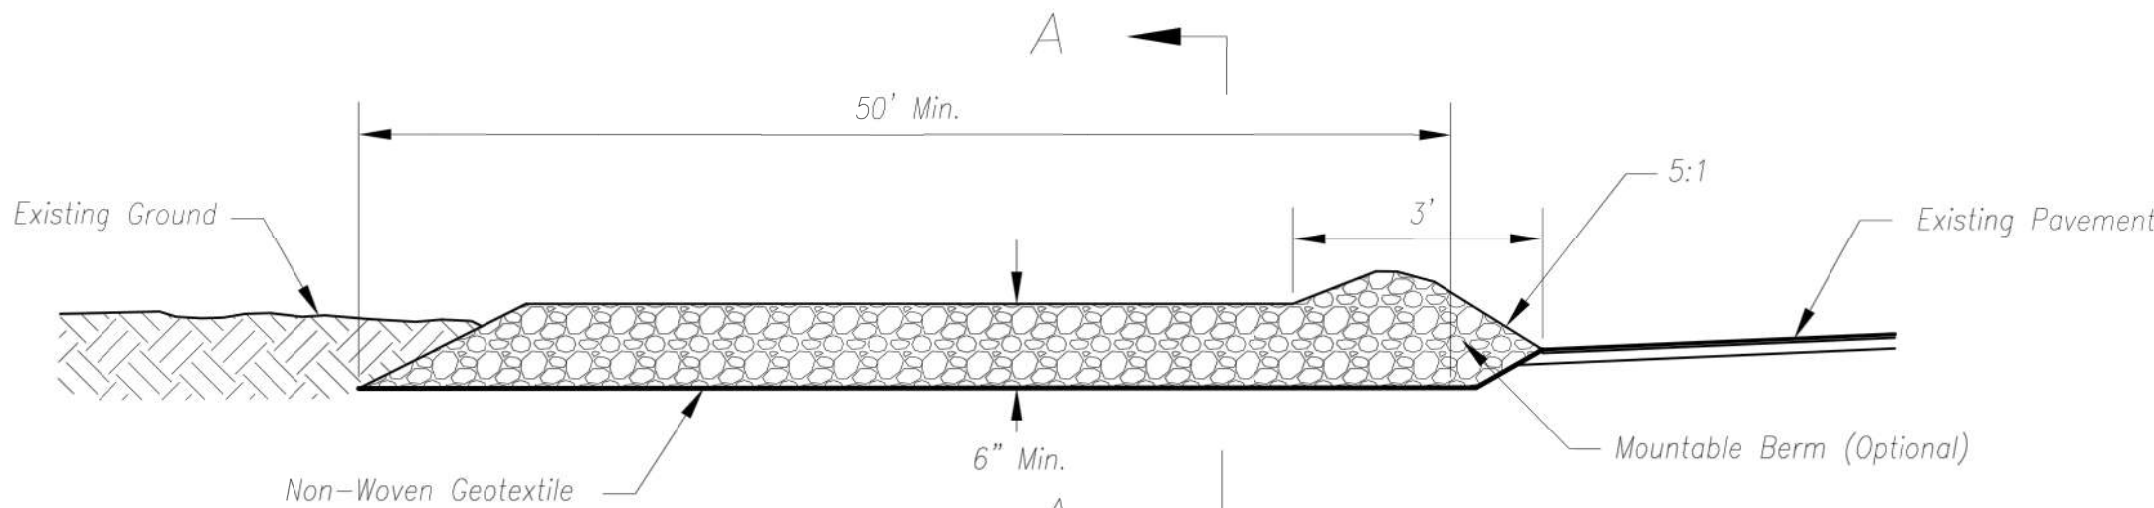

Side Elevation
Not to Scale

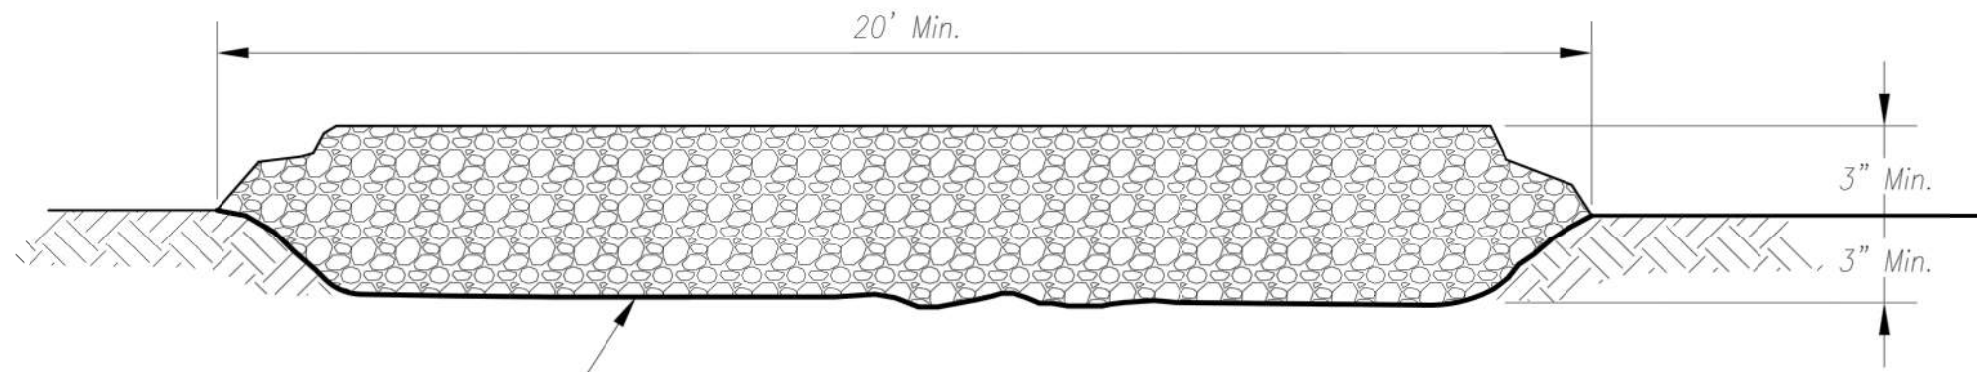

Section A-A
Not to Scale

Notes for Construction Entrance:

1. Avoid locating on steep slopes, at curves on public roads, or downhill of disturbed area.
2. Remove all vegetation and other unsuitable material from the foundation area, grade, and crown for positive drainage.
3. If slope towards the public road exceeds 2%, construct a 6- to 8-inch high ridge with 3H:1V side slopes across the foundation approximately 15 feet from the edge of the public road to divert runoff from it.
4. Install pipe under the entrance if needed to maintain drainage ditches along public roads.
5. Place stone to dimensions and grade as shown on plans. Leave surface sloped for drainage.
6. Divert all surface runoff and drainage from the entrance to a sediment control device.
7. If conditions warrant, place geotextile fabric on the graded foundation to improve stability.

Maintenance for Construction Entrance:

1. Reshape entrance as needed to maintain function and integrity of installation. Top dress with clean aggregate as needed.


CONSTRUCTION ENTRANCE

Notes for Concrete Washout:

1. Concrete washout areas shall be installed prior to any concrete placement on site.
2. Concrete washout area shall include a flat subsurface pit sized relative to the amount of concrete to be placed on site. The slopes leading out of the subsurface pit shall be 3:1. The vehicle tracking pad shall be sloped towards the concrete washout area.
3. Vehicle tracking control is required at the access point to all concrete washout areas.
4. Signs shall be placed at the construction site entrance, washout area and elsewhere as necessary to clearly indicate the location(s) of the concrete washout area(s) to operators of concrete truck and pump rigs.
5. A one-piece impervious liner may be required along the bottom and sides of the subsurface pit in sandy or gravelly soils.

Maintenance for Concrete Washout:

1. Concrete washout materials shall be removed once the materials have filled the washout to approximately 75% full.
2. Concrete washout areas shall be enlarged as necessary to maintain capacity for wasted concrete.
3. Concrete washout water, wasted pieces of concrete and all other debris in the subsurface pit shall be transported from the job site in a water-tight container and disposed of properly.
4. Concrete washout areas shall remain in place until all concrete for the project is placed.
5. When concrete washout areas are removed, excavations shall be filled with suitable compacted backfill and topsoil, any disturbed areas associated with the installation, maintenance, and/or removal of the concrete washout areas shall be stabilized.

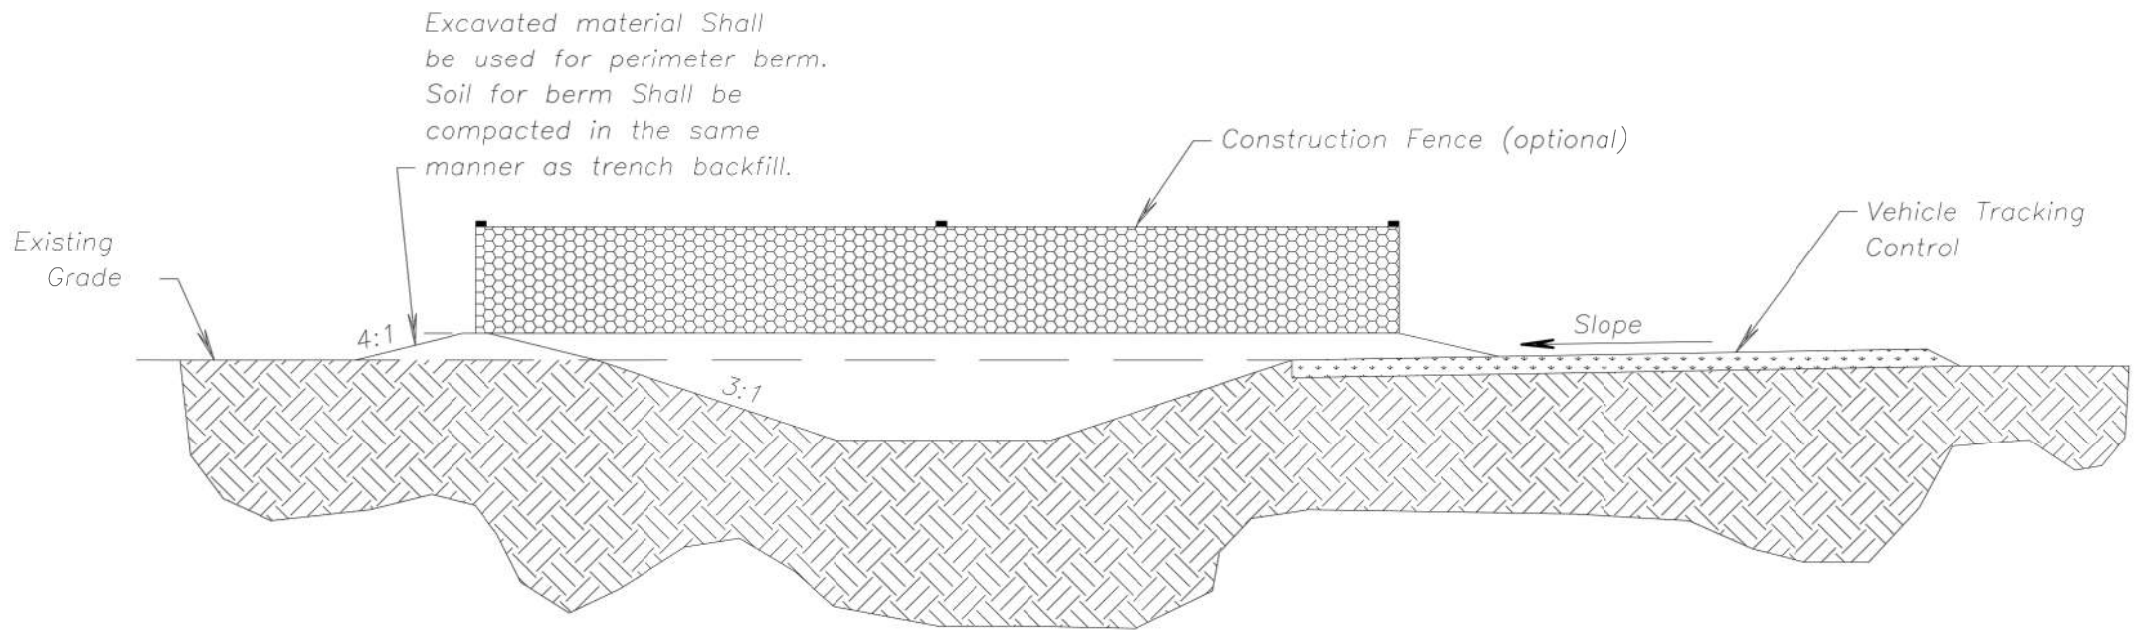

CONCRETE WASHOUT

RELEASE FOR
CONSTRUCTION
AS NOTED ON PLANS REVIEW
DEVELOPMENT SERVICES
LEE'S SUMMIT, MISSOURI
04/16/2021

AS-BUILT

The information provided on this drawing conforms to construction records; it is not intended for construction, implementation or recording purposes, and it is solely based on information provided by others / obtained by my firm. ~~1.00-00 100.10'~~ 1.00-00 1.15% slope, or "8-inch ~~1.00-00 100.10'~~ PVC pipe" are all typical examples of revisions that indicate that design data has been replaced with "as-built" information. All other data is as designed and has not been field verified.
Date: 03/24/2022 Certified by: GRC
Title: Project Engineer Firm: Anderson Engineering Inc.

Construction Entrance modified from 2015 Overland Park Standard Details for Erosion and Sediment Control; Concrete Washout modified from 2009 City of Great Bend Standard Drawings.

AMERICAN PUBLIC WORKS ASSOCIATION



KANSAS CITY
METRO CHAPTER

CONSTRUCTION ENTRANCE
AND CONCRETE WASHOUT

STANDARD DRAWING
NUMBER ESC-OI
ADOPTED:
10/24/2016

SUMMIT HOMES KC
HIGHLAND MEADOWS - 6TH PLAT

CONSTRUCTION ENTRANCE
DETAILS

S10, T47N, R32W
LEE'S SUMMIT, JACKSON COUNTY, MISSOURI



SHEET NUMBER
C501
35 OF 42




ENGINEERS • SURVEYORS • LABORATORIES • DRILLING
941 W. 141ST TER • KANSAS CITY, MISSOURI 64145 • PHONE (816) 777-0400
A LICENSED MISSOURI ENGINEERING & SURVEYING CORPORATION - LC 62

REVISIONS		DRAWING INFO.	
NO.	DESCRIPTION	BY	DATE
1	REVISED PER CITY COMMENT	GC	2/11/21
2	AS-BUILT DRAWINGS	GC	3/16/22
		CHECK BY:	ZM
		LICENSE NO.	PE-2012009232
		DATE:	1/7/2021
		ISSUED FOR:	FOR REVIEW
		JOB NUMBER:	20KCI0058
		MO COA NO.	00062


© COPYRIGHT ANDERSON ENGINEERING, INC. 2020

Feb 11, 2021 - 6:12pm Plotted By: gacite G:\Shared drives\KCTD - Land Development\Projects\2020\20K100058 Highland Meadows - 6th Plat\01 CIVIL\03-DWG\Sheet\STREET AND STORM\20K100058 - SHY - DETAILS.dwg Layout: STEEP SLOPE PROTECTION DETAILS

Longitudinal Seam

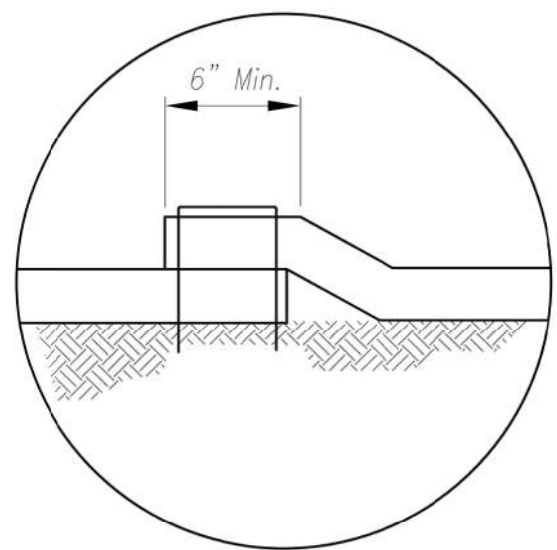

Anchor Slot

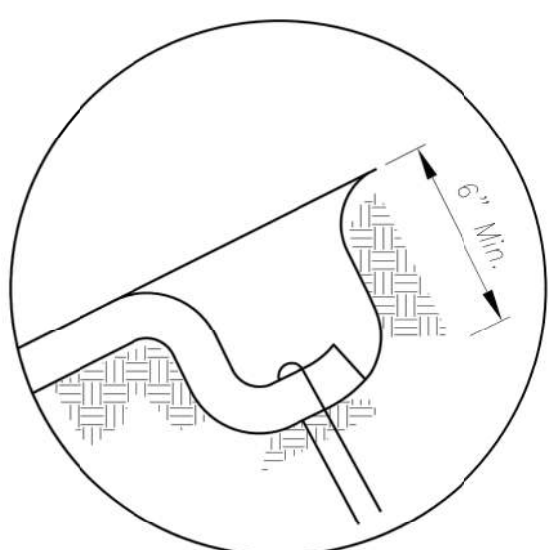


General Notes:

1. APWA Specifications 2150 and Design Guidance 5100 shall be referenced to select type of blanket or mat to be used.
2. Typical anchors and pattern/spacing shall be installed according to the manufacturers instructions.
3. LONGITUDINAL SEAMS: The edges of the blanket or mat should overlap each other a minimum of 6 inches, with anchors catching the edges of both blankets.


Maintenance:

1. Torn or degraded product shall be repaired or replaced, unless such degradation is within the functional longevity specified by the manufacturer.
2. Edges or seams that are loose or frayed shall be secured.


Splice Seam

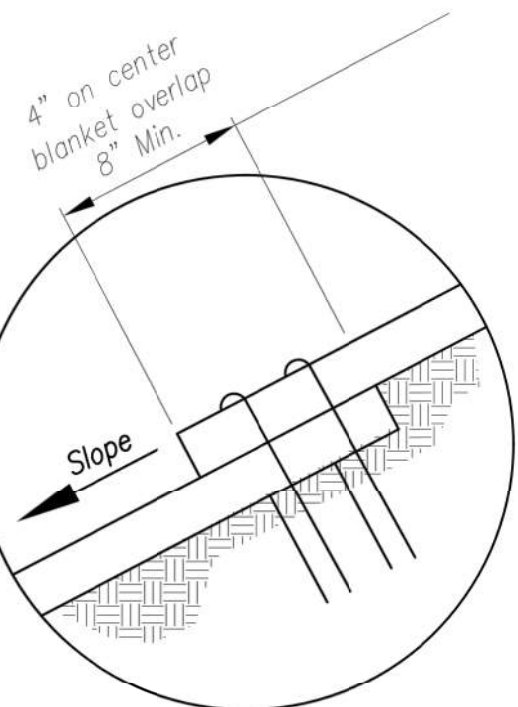

Longitudinal Seam

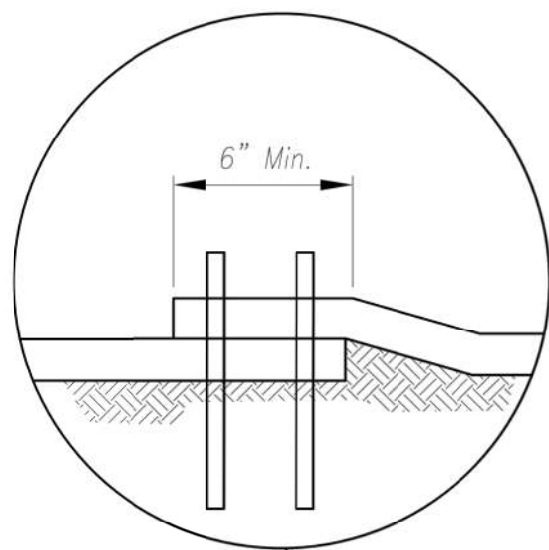


Anchor Fold

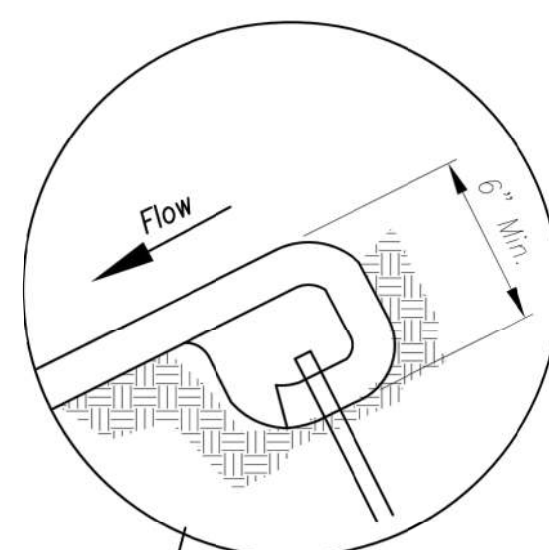


Notes for Installation in Channels:

1. Erosion Control Blankets and TRMs shall be laid in the direction of the flow, with the first course at the centerline of channel, where applicable. In order for the mat to be in contact with the soil, lay the mat loosely, avoiding stretching.
2. ANCHOR FOLD: The top of the mat should be folded under, buried and secured with wood or other approved anchors placed 6 inches apart. The top edge of the mat should be buried in a slot 6 inches wide x 6 inches deep, anchored in the bottom of the slot, backfilled, and the mat folded over the top as shown in detail.
3. SPLICE SEAM: When splices are necessary, overlap end a minimum of 12 inches in direction of water flow. Stagger splice seams.
4. CHECK SLOTS: Establish check slots transverse to slope every 30 feet. The slots should be 6 inches wide x 6 inches deep. The mat shall be cut to a length 12 inches beyond the slot. The top of the downstream mat shall be slotted in, secured and buried similar to the edge anchor fold. The upstream mat shall then cover the slot and be anchored as shown.
5. EDGE ANCHORS: Lay outside edge of mat into trench at top of the slope and anchor.
6. TERMINUS: The bottom edge of the mat shall be anchored.


Installation on Slopes

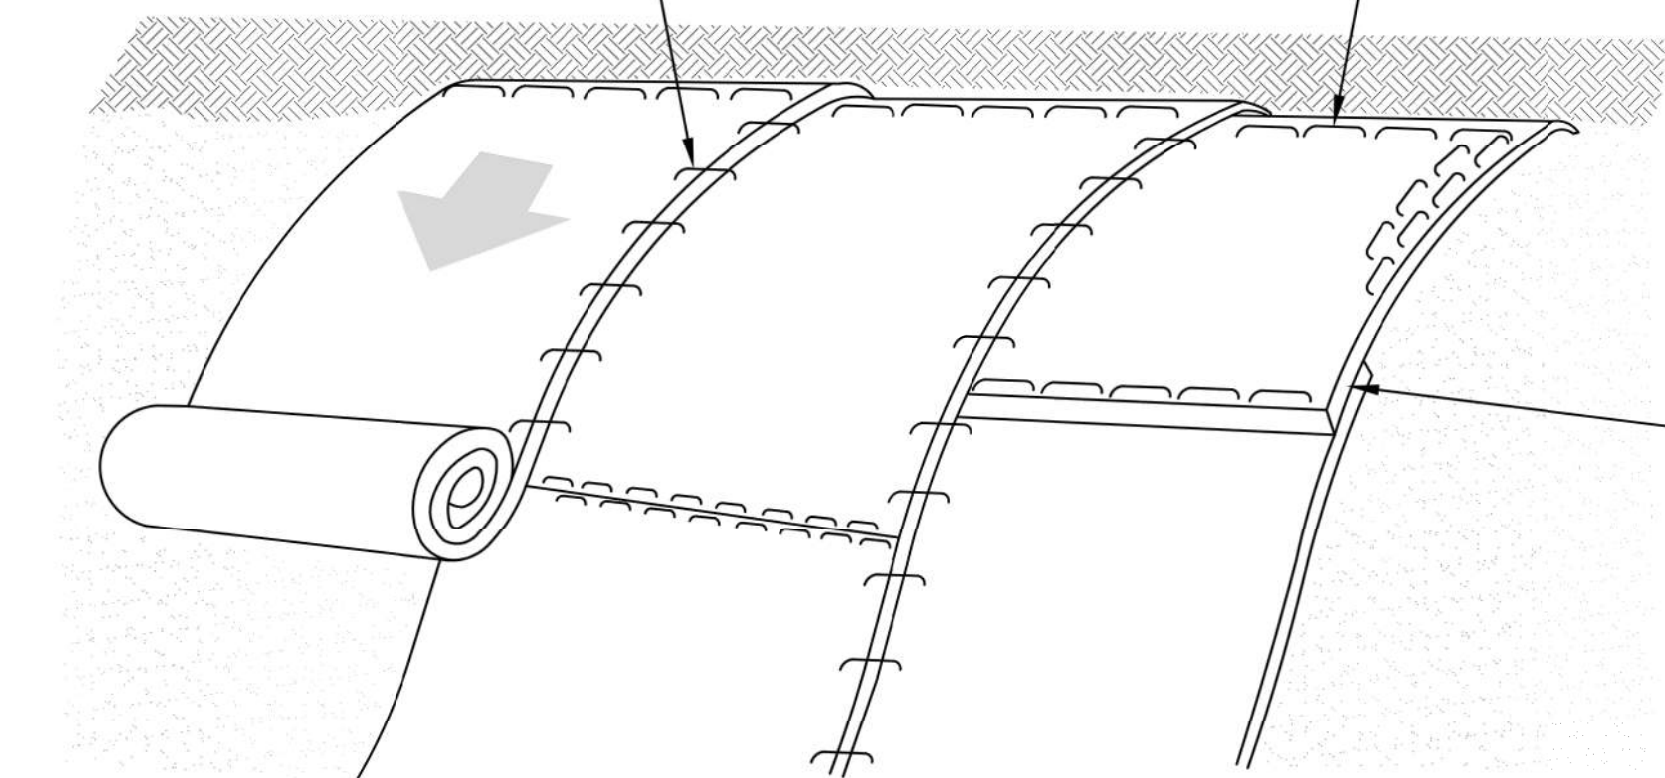


Splice Seam

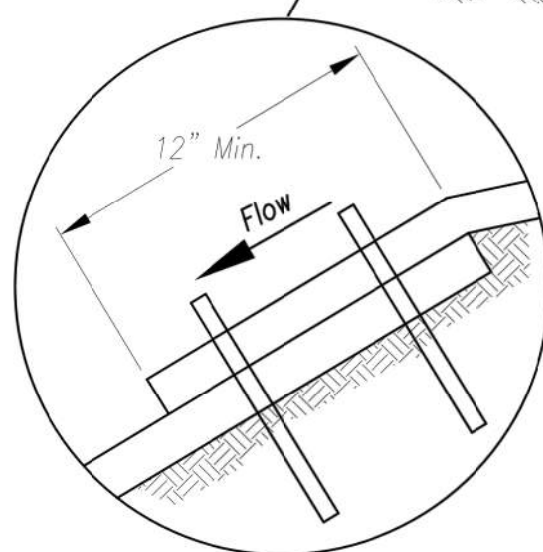


Edge Anchor

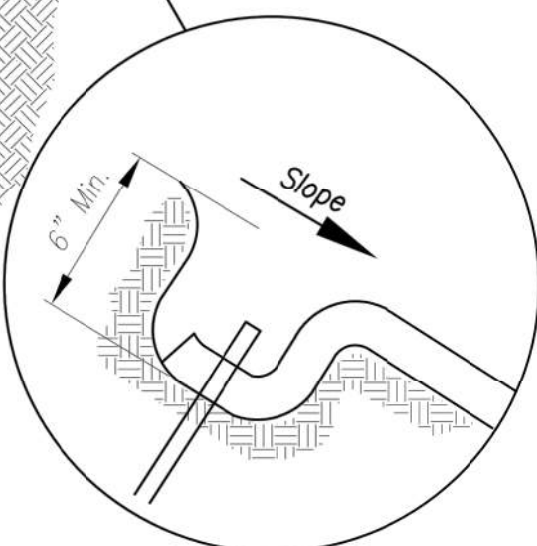

Trapezoidal Channel

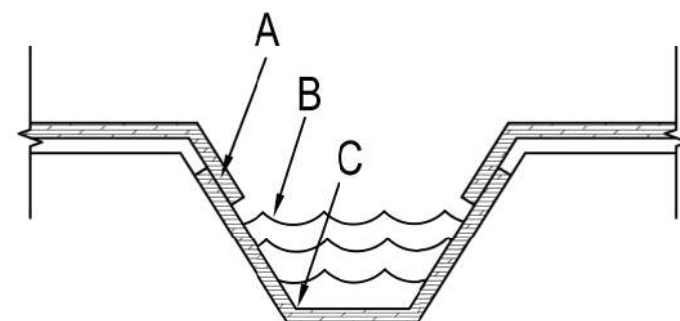

V Channel

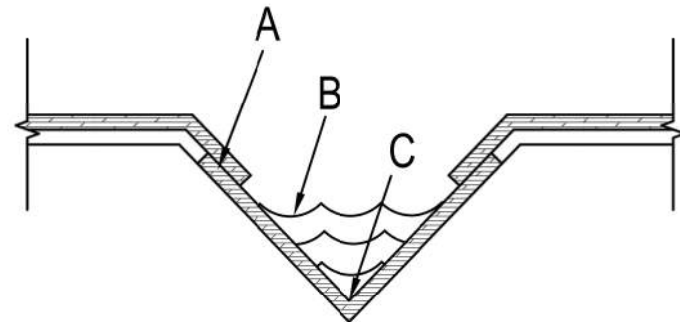


Critical Points:

- A - Overlaps and seams;
B - Projected water line;
C - Channel bottom / side slope vertices;

Partial Box Culvert Plan

Not to Scale

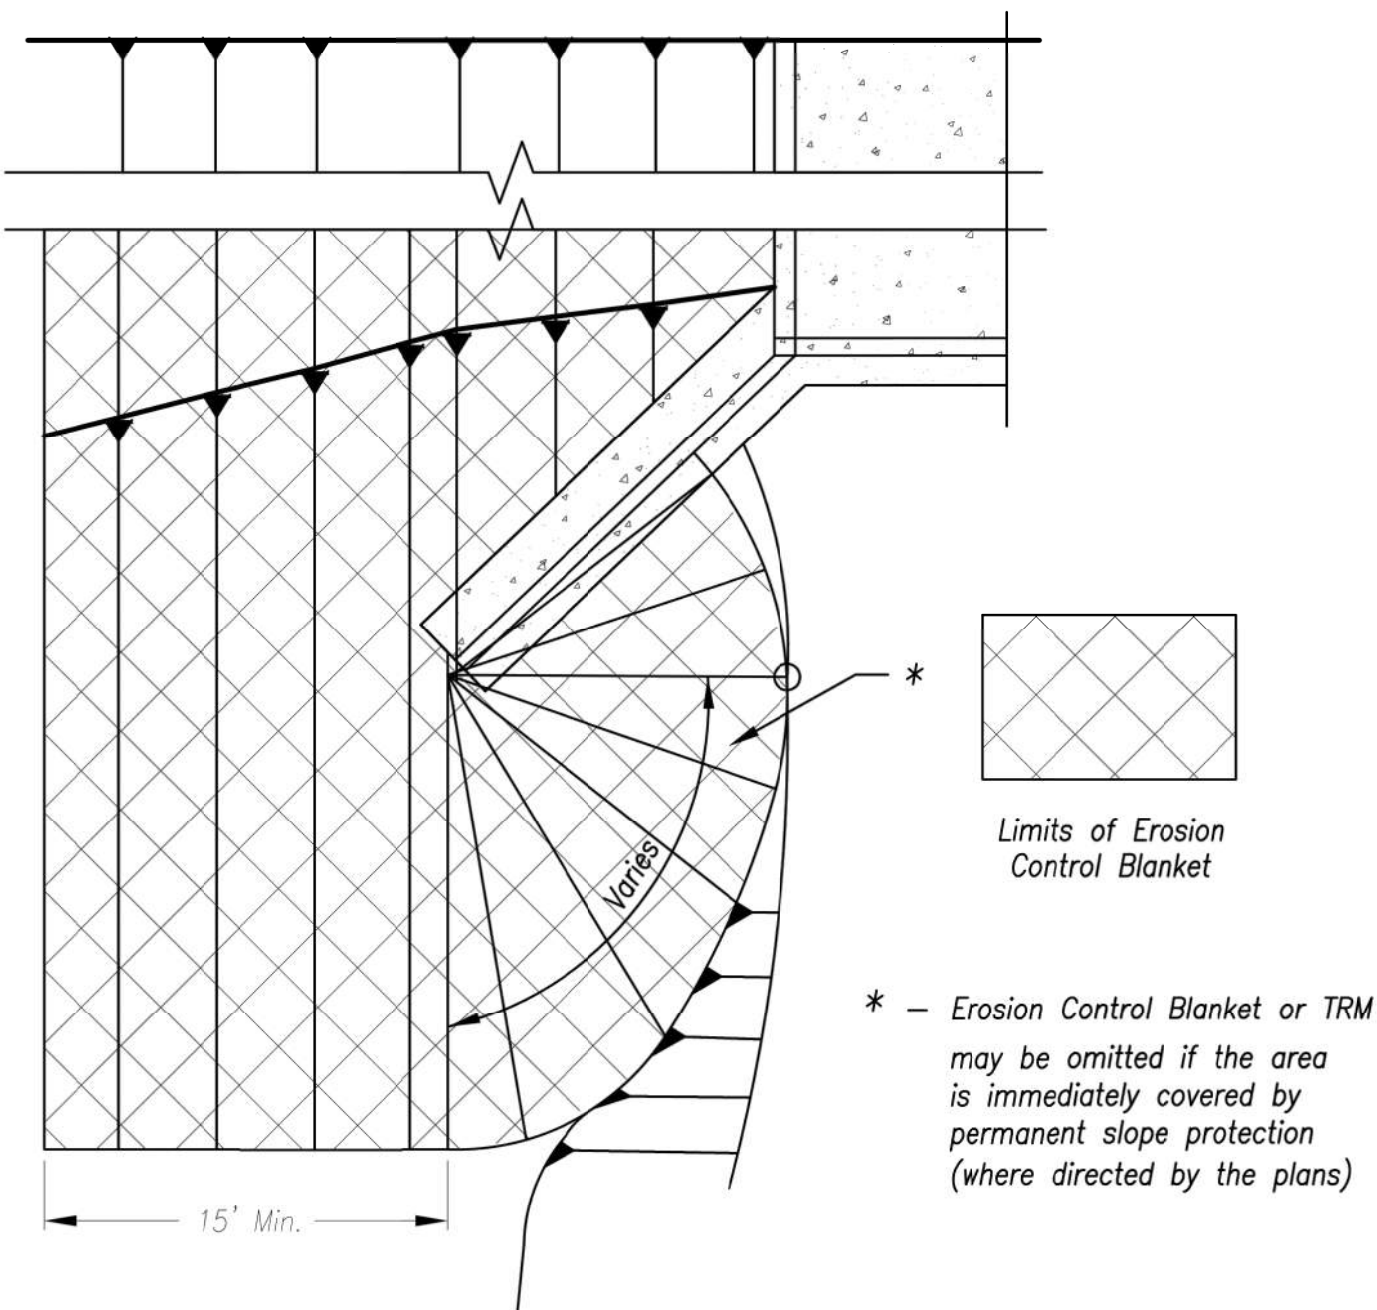

Installation Around Culvert Slope

Notes for Installation on Slopes:

1. Erosion Control Blankets and TRMs shall be laid in the direction of the slope. In order for blanket to be in contact with the soil, lay blanket loosely, avoiding stretching.
2. ANCHOR SLOTS: The top of the blanket should be "slotted in" at the top of the slope and anchored in place with anchors 6 inches apart. The slots should be 6 inches wide x 6 inches deep with the blanket anchored in the bottom of the slot, then backfilled, tamped and seeded.
3. SPLICE SEAM: When splices are necessary, overlap end a minimum of 8 inches in direction of water flow. Stagger splice seams.
4. TERMINAL FOLD: The bottom edge of the blanket shall be turned under a minimum of 4 inches, then anchored in place with anchors 9 inches apart.

AS-BUILT

The information provided on this drawing conforms to construction records; it is not intended for construction, implementation or recording purposes; and it is solely based on information provided by others / obtained by my firm. 24x48 100' 10' 2.4x48 1.15% slope, or 18 inch 24x48 PVC pipe are all typical examples of revisions that indicate that design data has been replaced with "as-built" information. All other data is as designed and has not been field verified.
Date: 03/24/2022
Title: Project Engineer
Certified by: GRC
Firm: Anderson Engineering Inc.

RELEASE FOR CONSTRUCTION
AS NOTED ON PLANS REVIEW
DEVELOPMENT SERVICES
LEE'S SUMMIT, MISSOURI
04/16/2021

Modified from 2015 Overland Park Standard Details for Erosion and Sediment Control.

AMERICAN PUBLIC WORKS ASSOCIATION



KANSAS CITY
METRO CHAPTER

EROSION CONTROL BLANKETS
AND TURF REINFORCEMENT MATS

STANDARD DRAWING
NUMBER ESC-02
ADOPTED:
10/24/2016

ANDERSON
ENGINEERING
EMPLOYEE OWNED

ENGINEERS • SURVEYORS • LABORATORIES • DRILLING
941 W. 141ST TER. • KANSAS CITY, MISSOURI 64145 • PHONE (816) 777-0400
A LICENSED MISSOURI ENGINEERING & SURVEYING CORPORATION - LC 62

REVISIONS		DRAWING INFO.	
NO.	DESCRIPTION	BY	DATE
1	REVISED PER CITY COMMENT	GC	2/11/21
2	AS-BUILT DRAWINGS	GC	3/16/22
		CHECK BY:	ZM
		LICENSE NO.	PE-2012009232
		DATE:	1/7/2021
		ISSUED FOR:	FOR REVIEW
		JOB NUMBER:	20K100058
		MO COA NO.	000062

SUMMIT HOMES KC
HIGHLAND MEADOWS - 6TH PLAT


STEEP SLOPE PROTECTION
DETAILS

S10, T47N, R32W
LEE'S SUMMIT, JACKSON COUNTY, MISSOURI



SHEET NUMBER
C502
36 OF 42


Feb 11, 2021 -- 6:12pm Plotted By: gacite G:\Shared drives\KCTO - Land Development\Projects\2020\20K10058 Highland Meadows - 6th Plat\01 CIVIL\03-DWG\Sheet\STREET AND STORM\20K10058 - SHY - DETAILS.dwg Layout: SILT FENCE DETAILS

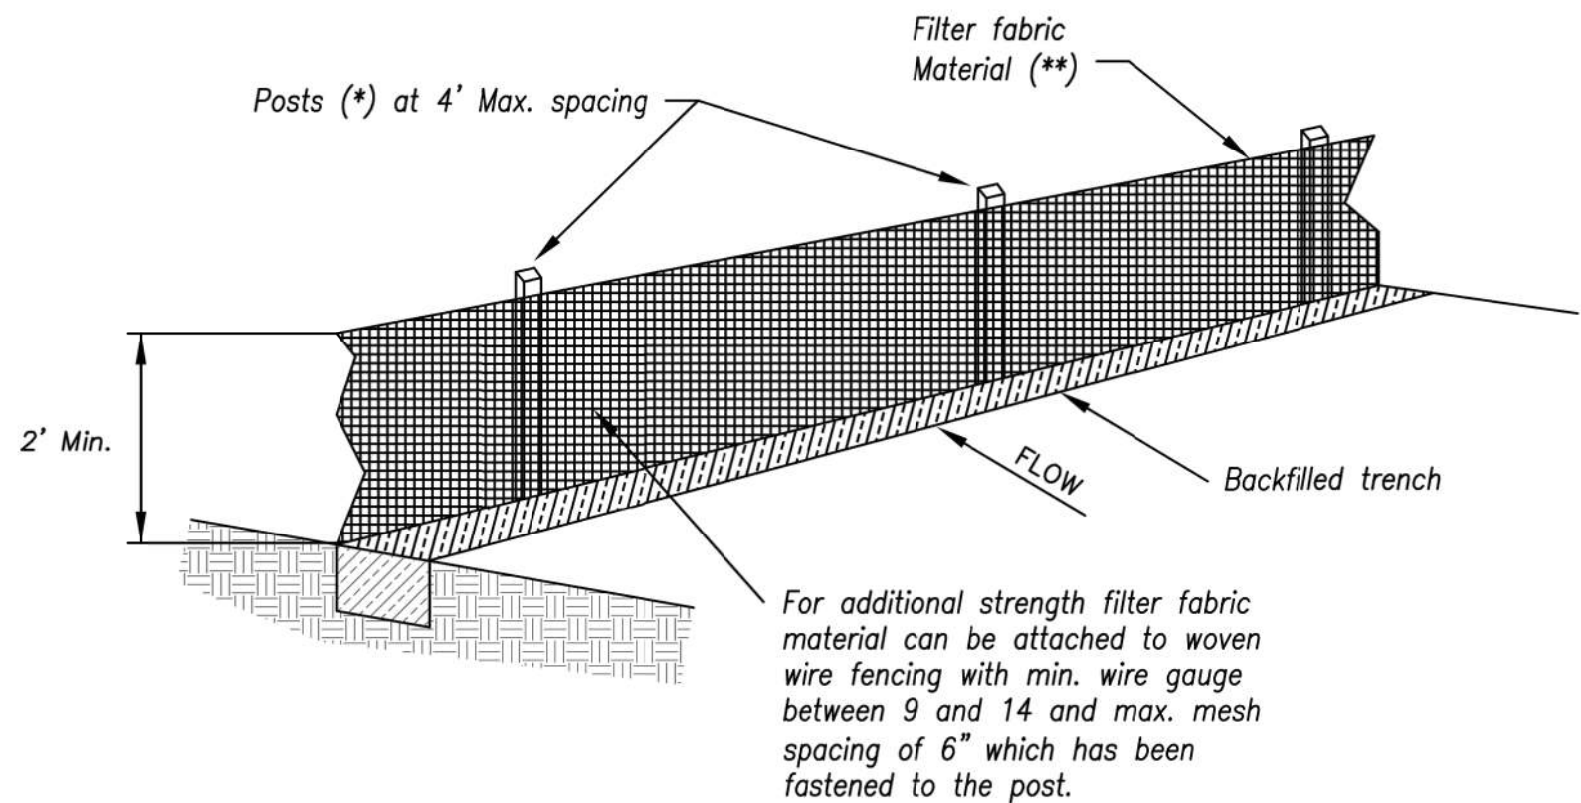

- (*) POSTS
- MIN. LENGTH 4'
 - HARDWOOD 1 3/8" x 1 3/8"
 - NO.2 SOUTHERN PINE 2 5/8" x 2 5/8"
 - STEEL 1.33 LB/FT

(**) - Geotextile Fabric shall meet the requirements of AASHTO M288

SILT FENCE DETAILS
Not to Scale

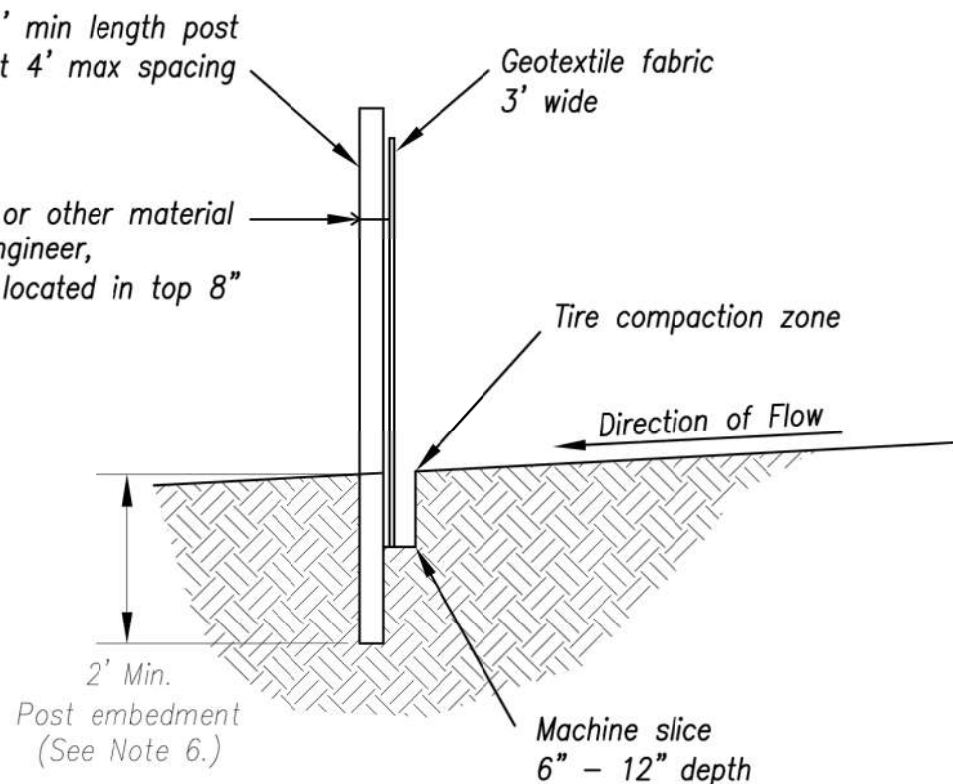

Notes:

1. In order to contain water, the ends of the silt fence must be turned uphill (Figure A).
2. Long perimeter runs of silt fence must be limited to 100'. Runs should be broken up into several smaller segments to minimize water concentrations (Figure A).
3. Long slopes should be broken up with intermediate rows of silt fence to slow runoff velocities.
4. Attach fabric to upstream side of post.
5. Install posts a minimum of 2' into the ground.
6. Trenching will only be allowed for small or difficult installation, where slicing machine cannot be reasonably used.

Maintenance:

1. Remove and dispose of sediment deposits when the deposit approaches 1/2 the height of silt fence.
2. Repair as necessary to maintain function and structure.

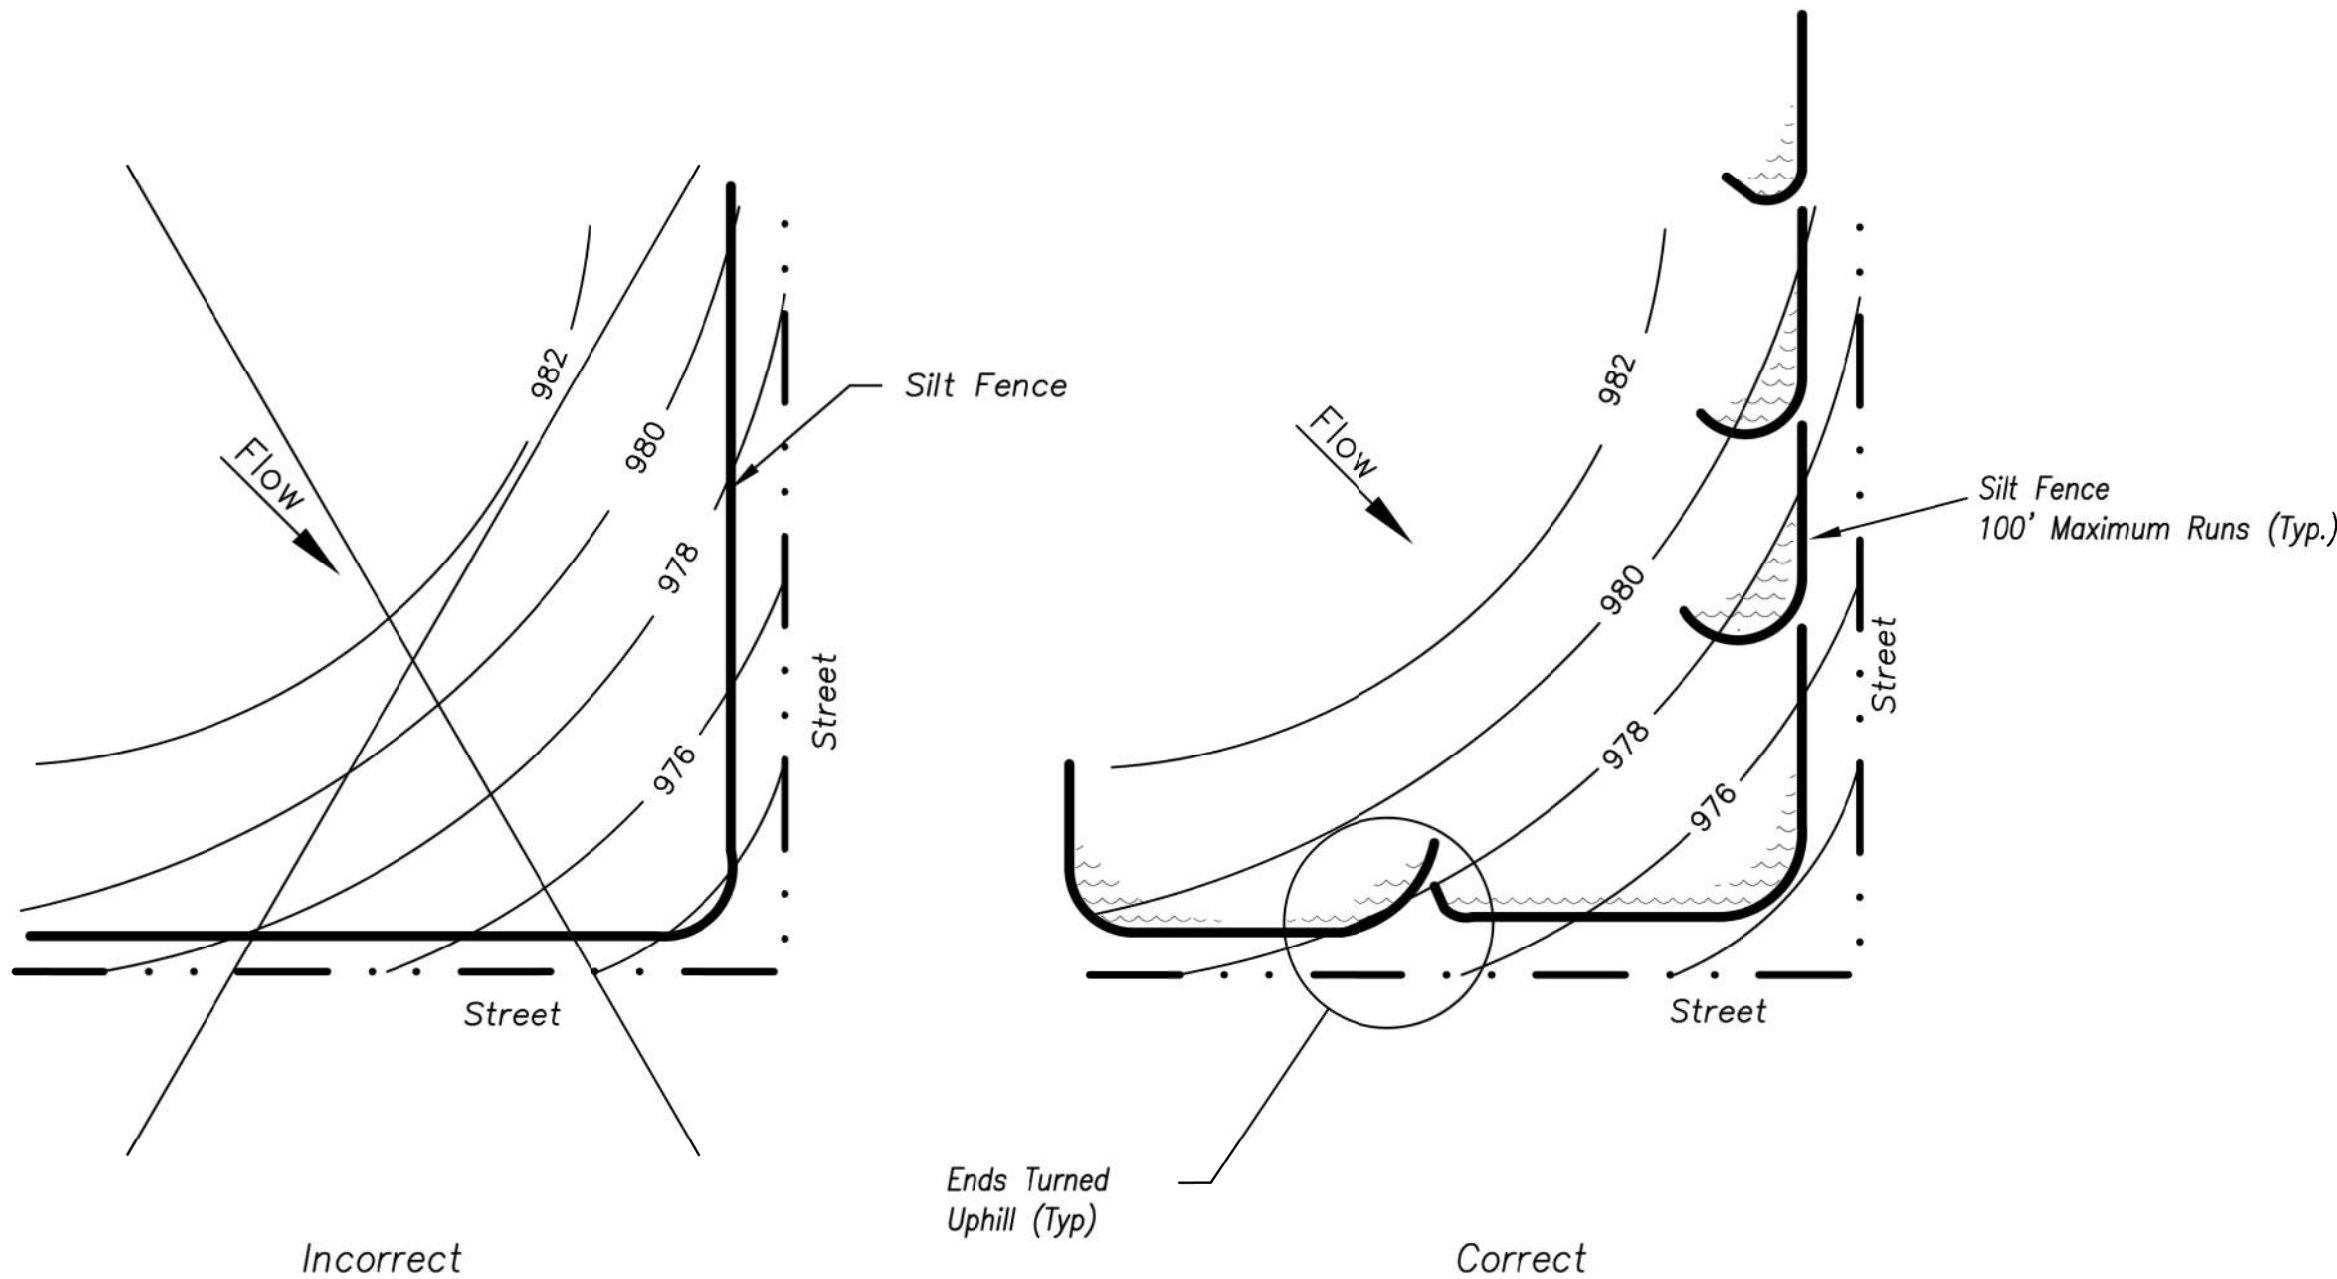


Figure A


SILT FENCE LAYOUT
Not to Scale

AS-BUILT

The information provided on this drawing conforms to construction records; it is not intended for construction, implementation or recording purposes; and it is solely based on information provided by others / obtained by my firm. "As-Built" 100' 10", "As-Built" 1.15% slope" or "As-Built" 1.15% slope" are all typical examples of revisions that indicate that design data has been replaced with "as-built" information. All other data is as designed and has not been field verified.
Date: 03/24/2022 Certified by: GRC
Title: Project Engineer Firm: Anderson Engineering Inc.

RELEASE FOR
CONSTRUCTION
AS NOTED ON PLANS REVIEW
DEVELOPMENT SERVICES
LEE'S SUMMIT, MISSOURI
04/16/2021

Modified from 2015 Overland Park Standard Details
for Erosion and Sediment Control.

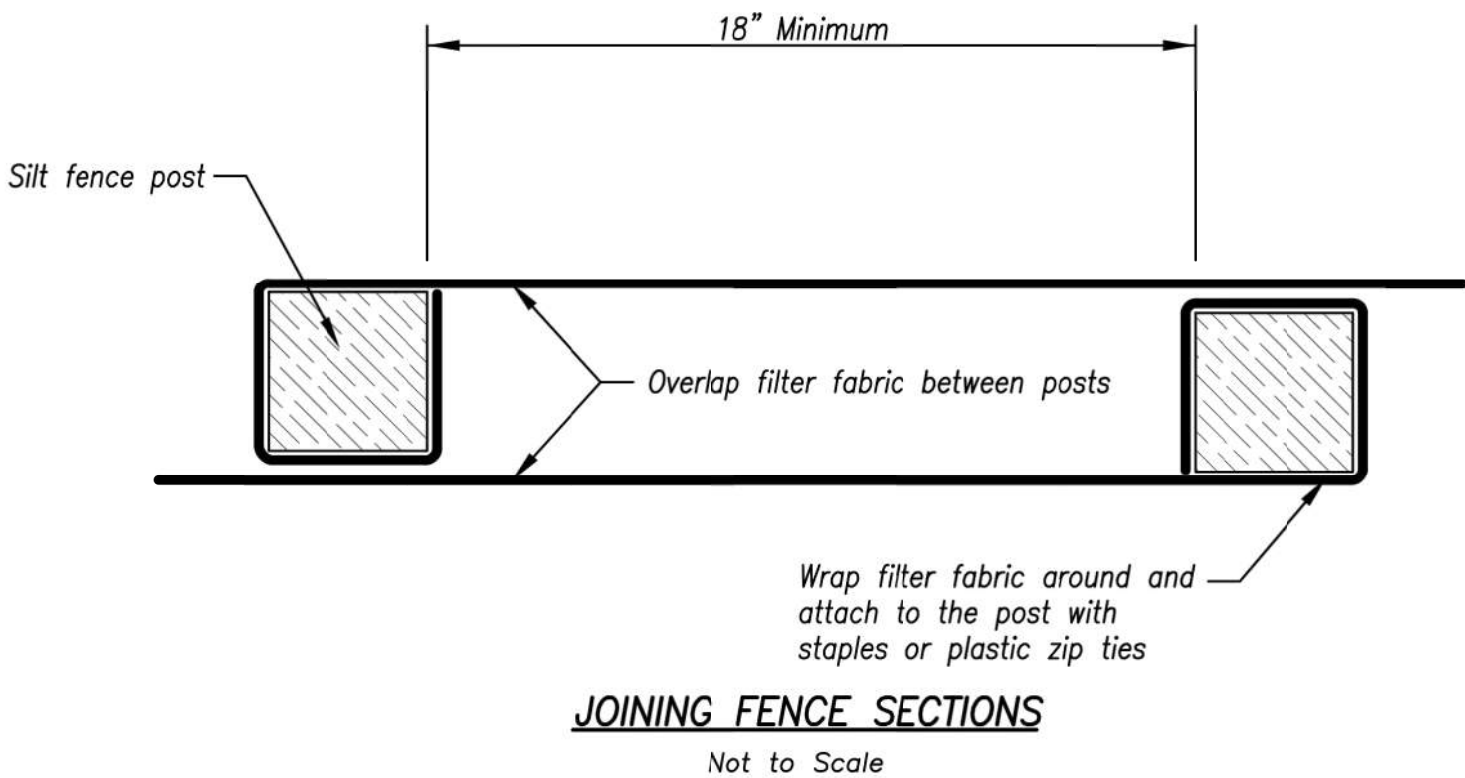

AMERICAN PUBLIC WORKS ASSOCIATION



KANSAS CITY
METRO CHAPTER

SILT FENCE

STANDARD DRAWING
NUMBER ESC-03
ADOPTED:
10/24/2016

SUMMIT HOMES KC
HIGHLAND MEADOWS - 6TH PLAT

SILT FENCE DETAILS





SHEET NUMBER
C503
37 OF 42

**ANDERSON
ENGINEERING**
EMPLOYEE OWNED


ENGINEERS • SURVEYORS • LABORATORIES • DRILLING
941 W. 141ST TER • KANSAS CITY, MISSOURI 64145 • PHONE (816) 777-0400
A LICENSED MISSOURI ENGINEERING & SURVEYING CORPORATION - LC 62

REVISIONS		DRAWING INFO.	
NO.	DESCRIPTION	BY	DATE
1	REVISED PER CITY COMMENT	GC	2/11/21
2	AS-BUILT DRAWINGS	GC	3/16/22
DRAWN BY: GC		CHECK BY: ZM	
LICENSE NO. PE-2012009232		DATE: 1/7/2021	
ISSUED FOR: FOR REVIEW		JOB NUMBER: 20K10058	
MO COA NO. 000062		© COPYRIGHT ANDERSON ENGINEERING, INC. 2020	


Feb 11, 2021 -- 6:12pm Plotted By: gacite G:\Shared drives\KCT10 - Land Development\Projects\2020\20K100058 Highland Meadows - 6th Plat\01 CIVIL\03-DWG\Sheet\STREET AND STORM\20K100058 - SHY - DETAILS.dwg Layout: CURB INLET PROTECTION DETAILS

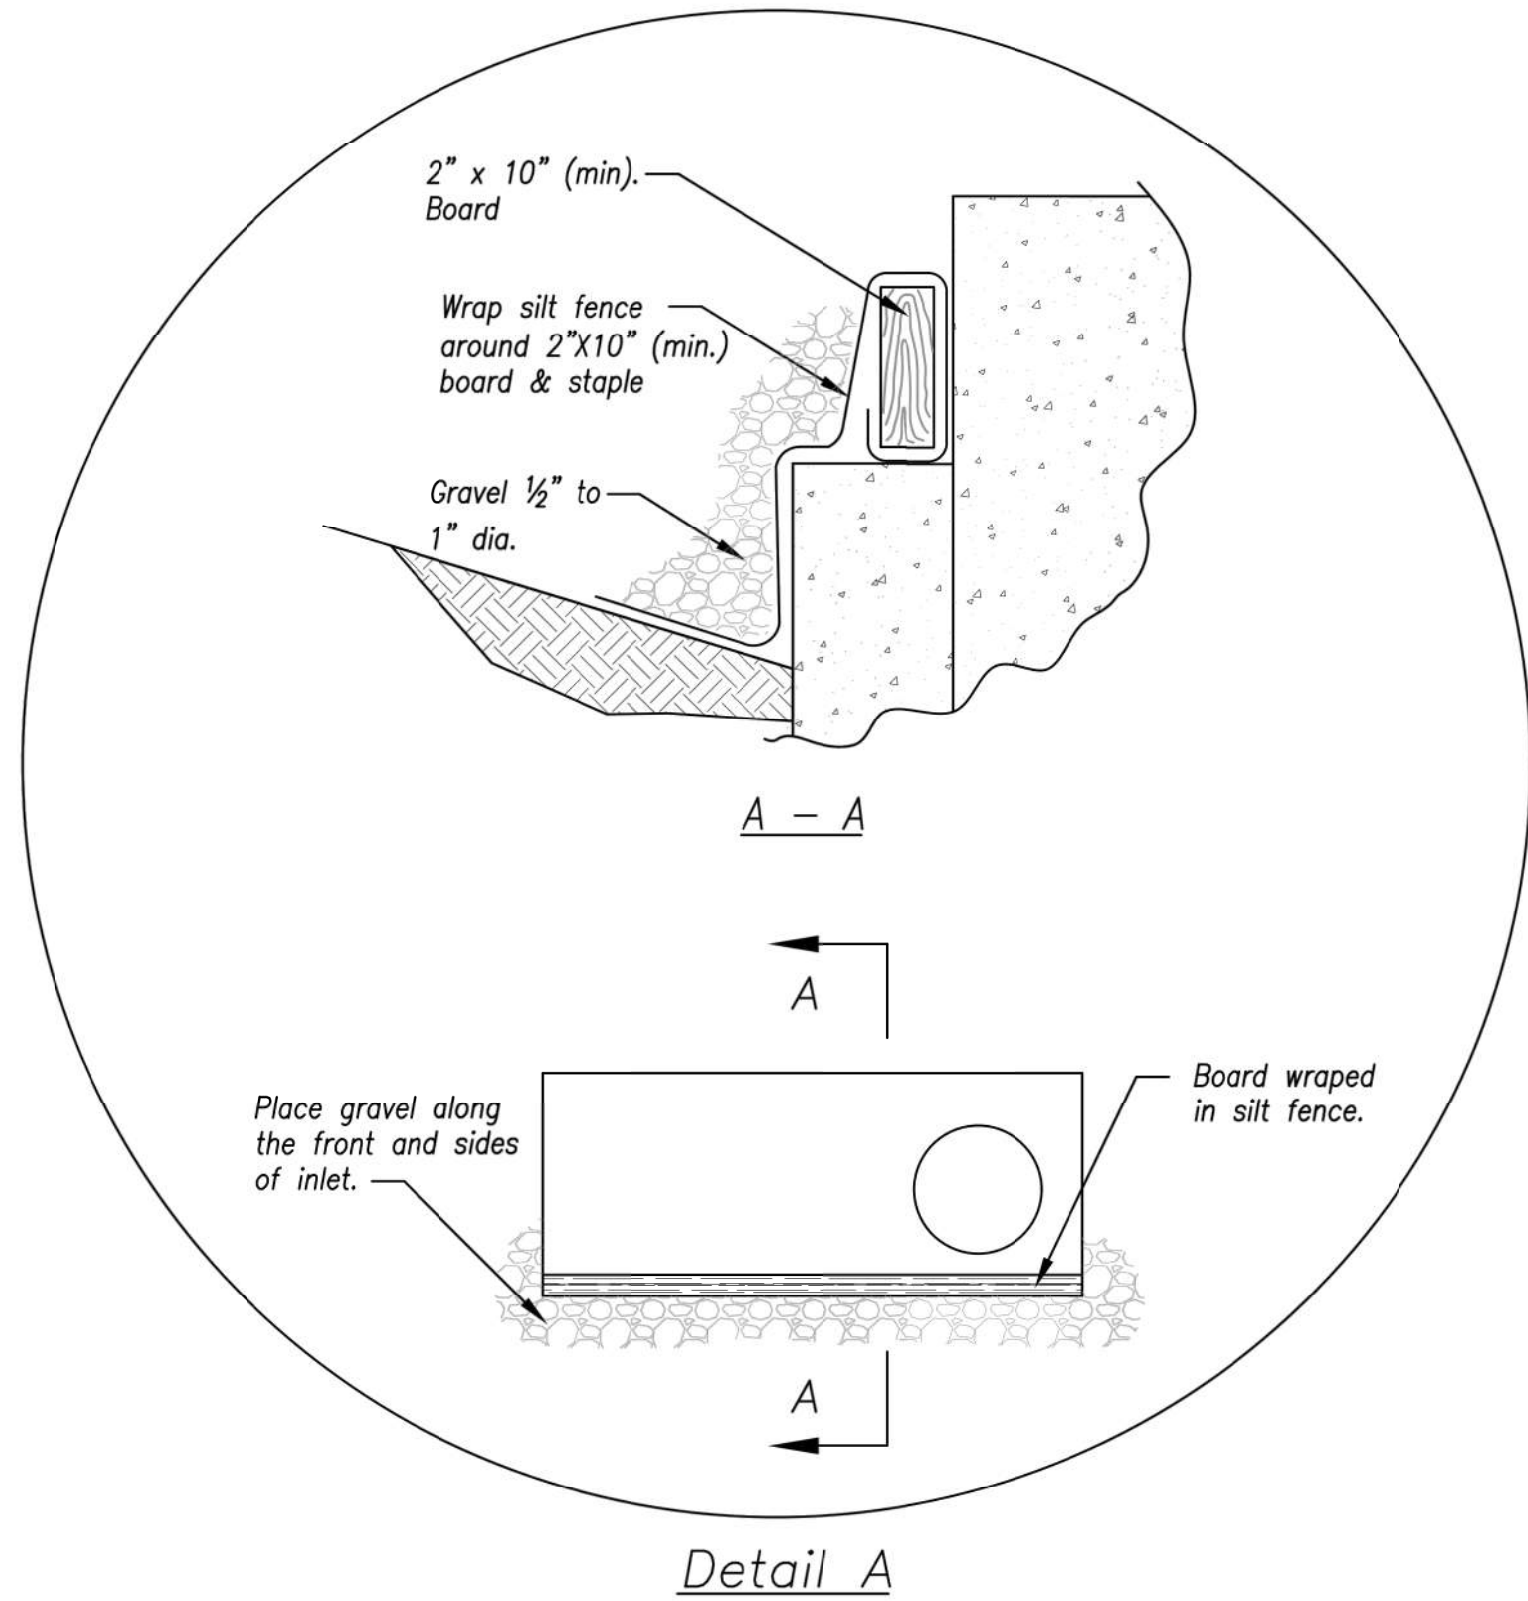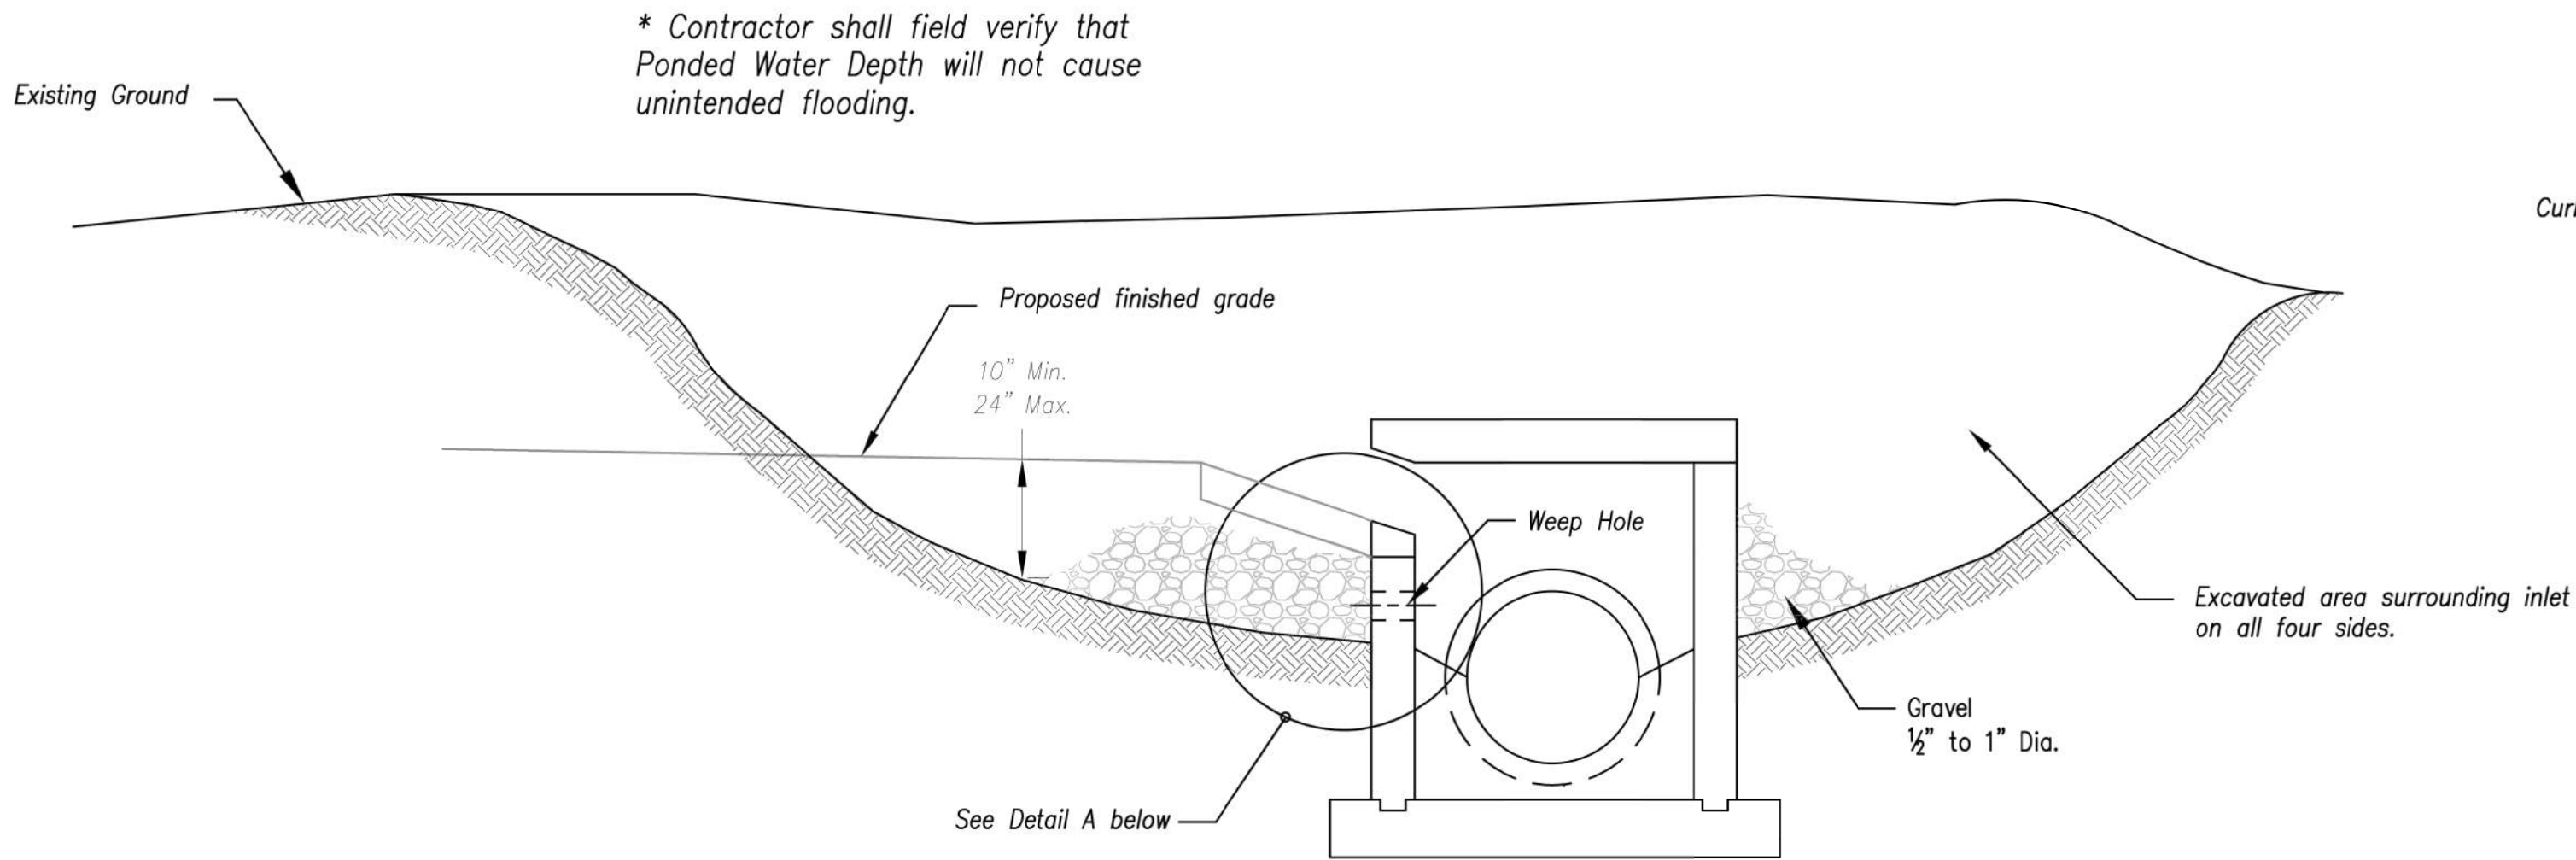

EARLY STAGE CURB INLET
(Open Box and Prior to Pouring Curb and Inlet Throat)

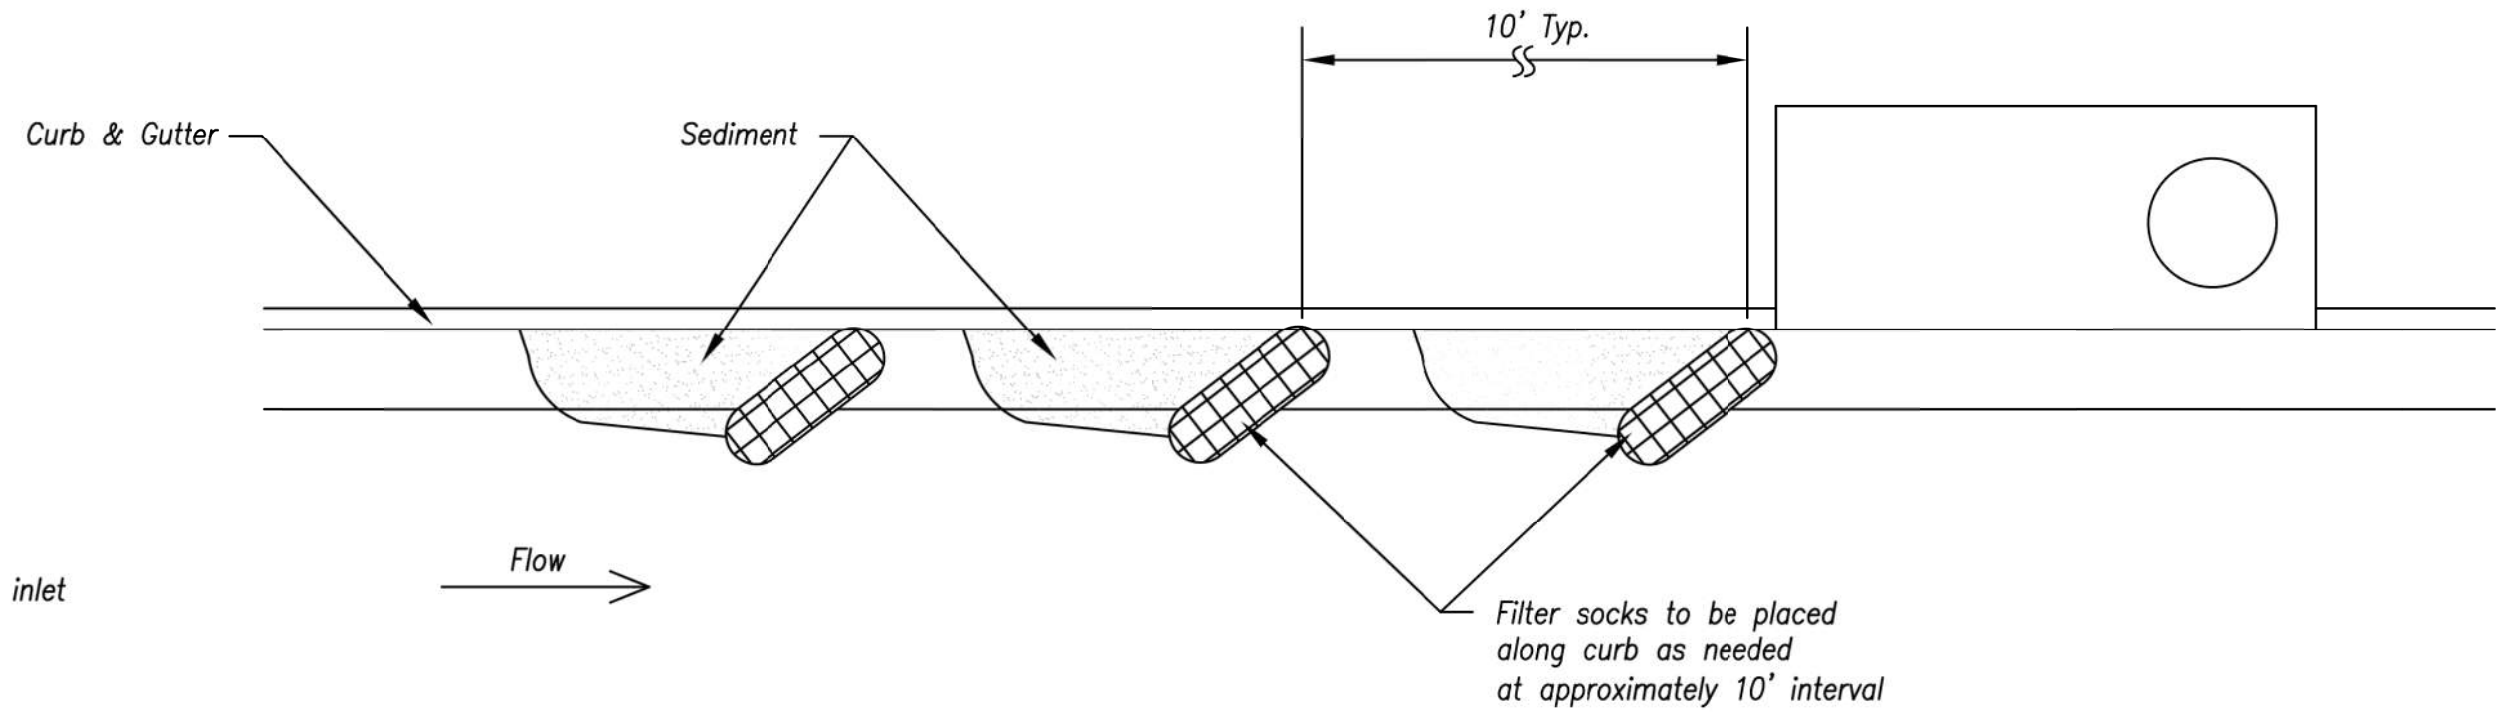

On Grade Curb Inlet Protection

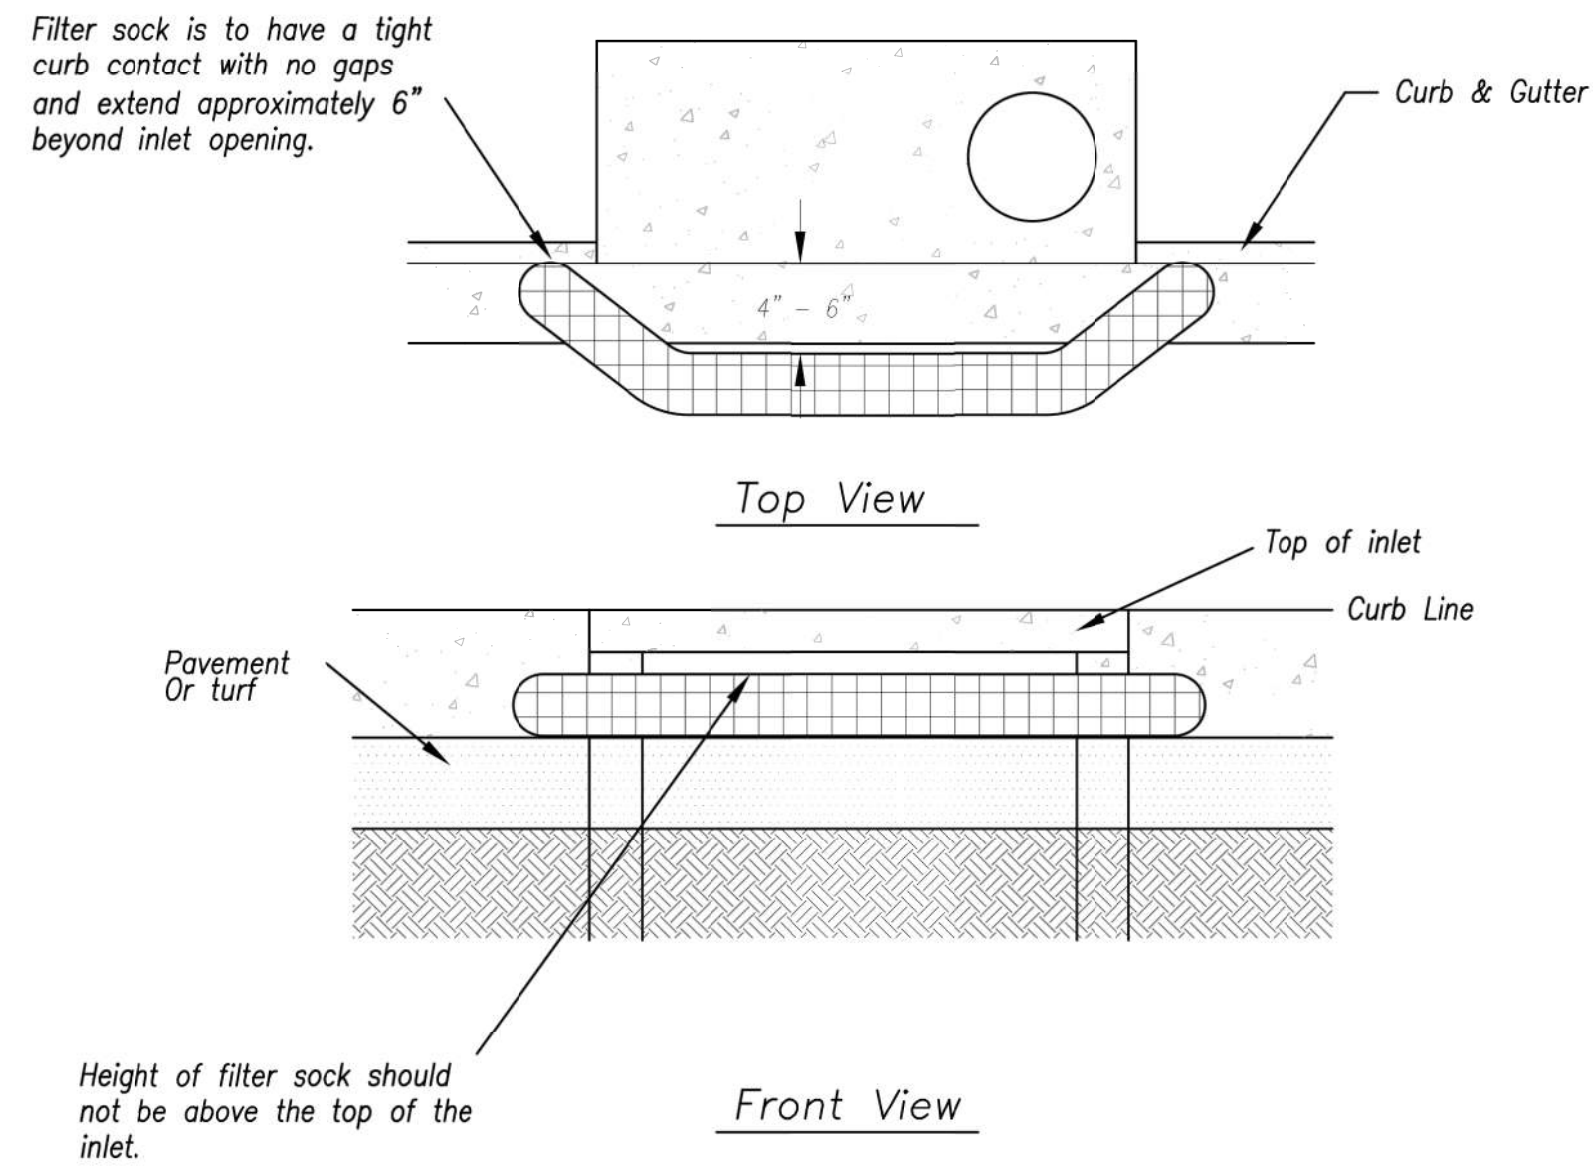

Sump Inlet Sediment Filter

Notes:

1. Immediately following inlet construction and prior to construction of curb and inlet throat, protect inlet opening by installing 2" X 10" (min.) board wrapped in silt fence. Structures shall have excavated storage area on all four sides to allow settling of sediment (Early Stage Curb Inlet).
2. When inlet is completed and curb poured, filter socks or approved equal should be used (Late Stage Curb Inlet). Straw wattles are not approved for curb inlet use.
3. Contractor to field verify ponding water shall not create a traffic hazard.

Maintenance:


1. Remove deposited sediment from excavated storage areas when available storage has been reduced by 20%.
2. Remove deposited sediment from filter socks or similar when any accumulation of sediment is visible.
3. Repair or replace as necessary to maintain function and integrity of installation.

LATE STAGE CURB INLET
(After Pouring Curb and Inlet Throat)

RELEASE FOR
CONSTRUCTION
AS NOTED ON PLANS REVIEW
DEVELOPMENT SERVICES
LEE'S SUMMIT, MISSOURI
04/16/2021



Modified from 2015 Overland Park Standard Details for Erosion and Sediment Control.

AMERICAN PUBLIC WORKS ASSOCIATION	
	KANSAS CITY METRO CHAPTER
CURB INLET PROTECTION	STANDARD DRAWING NUMBER ESC-06 ADOPTED: 10/24/2016

ANDERSON ENGINEERING
EMPLOYEE OWNED

ENGINEERS • SURVEYORS • LABORATORIES • DRILLING
941 W. 141ST TER. • KANSAS CITY, MISSOURI 64145 • PHONE (816) 777-0400
A LICENSED MISSOURI ENGINEERING & SURVEYING CORPORATION - LC 62

REVISIONS		DRAWING INFO.	
NO.	DESCRIPTION	BY	DATE
1	REVISED PER CITY COMMENT	GC	2/11/21
2	AS-BUILT DRAWINGS	GC	3/16/22
DRAWN BY: GC		CHECK BY: ZM	
LICENSE NO. PE-2012009232		DATE: 1/7/2021	
ISSUED FOR: FOR REVIEW		JOB NUMBER: 20K100058	
MO COA NO. 000062		© COPYRIGHT ANDERSON ENGINEERING, INC. 2020	

SUMMIT HOMES KC
HIGHLAND MEADOWS - 6TH PLAT


CURB INLET PROTECTION
DETAILS

S10, T47N, R32W
LEE'S SUMMIT, JACKSON COUNTY, MISSOURI




SHEET NUMBER
C504
38 OF 42

Feb 11, 2021 -- 6:12pm Plotted By: gacite G:\Shared drives\KCTO - Land Development\Projects\2020\20K10058 Highland Meadows - 6th Plat\01 CIVIL\03-DWG\Sheet\STREET AND STORM\20K10058 - SHY - DETAILS.dwg Layout: AREA INLET PROTECTION DETAILS

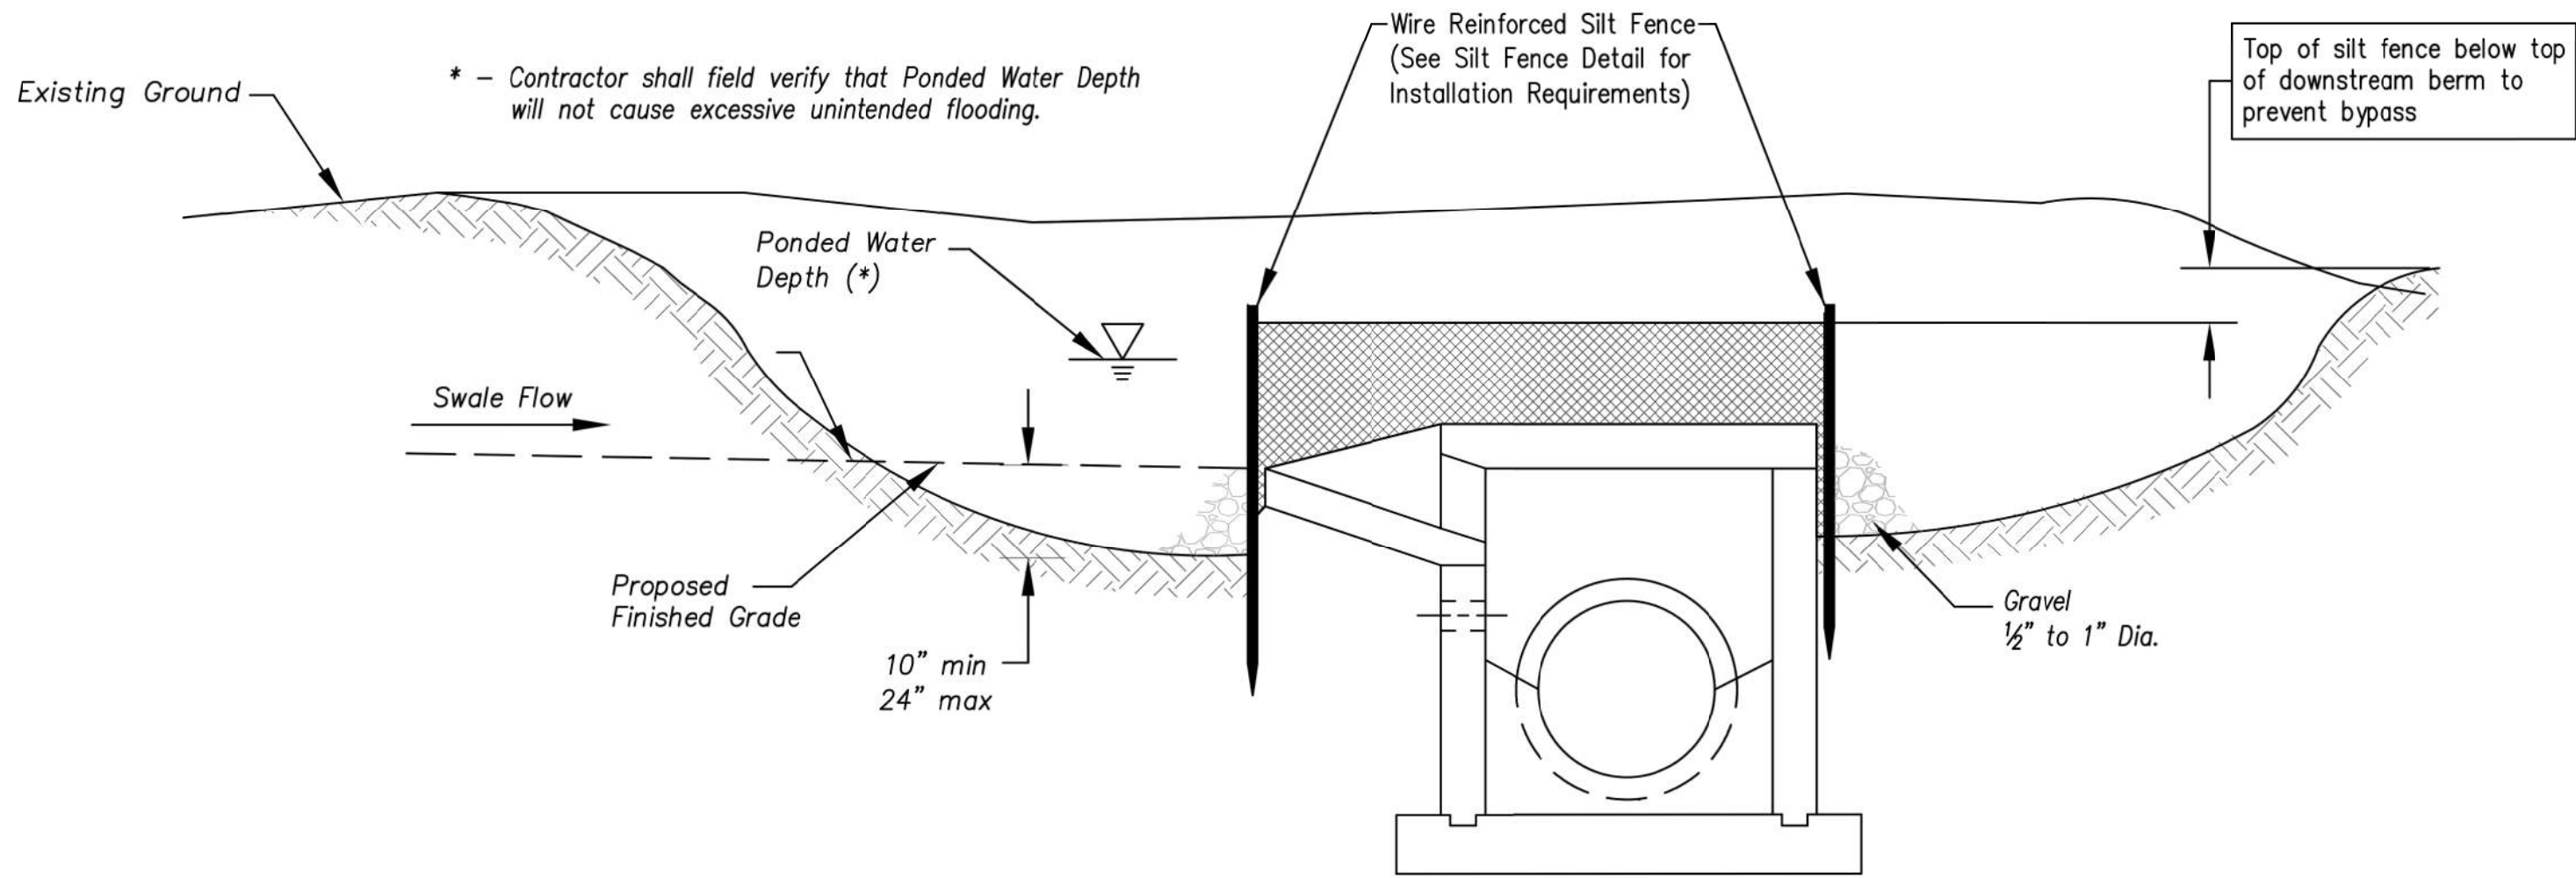


Section A-A
Not to Scale

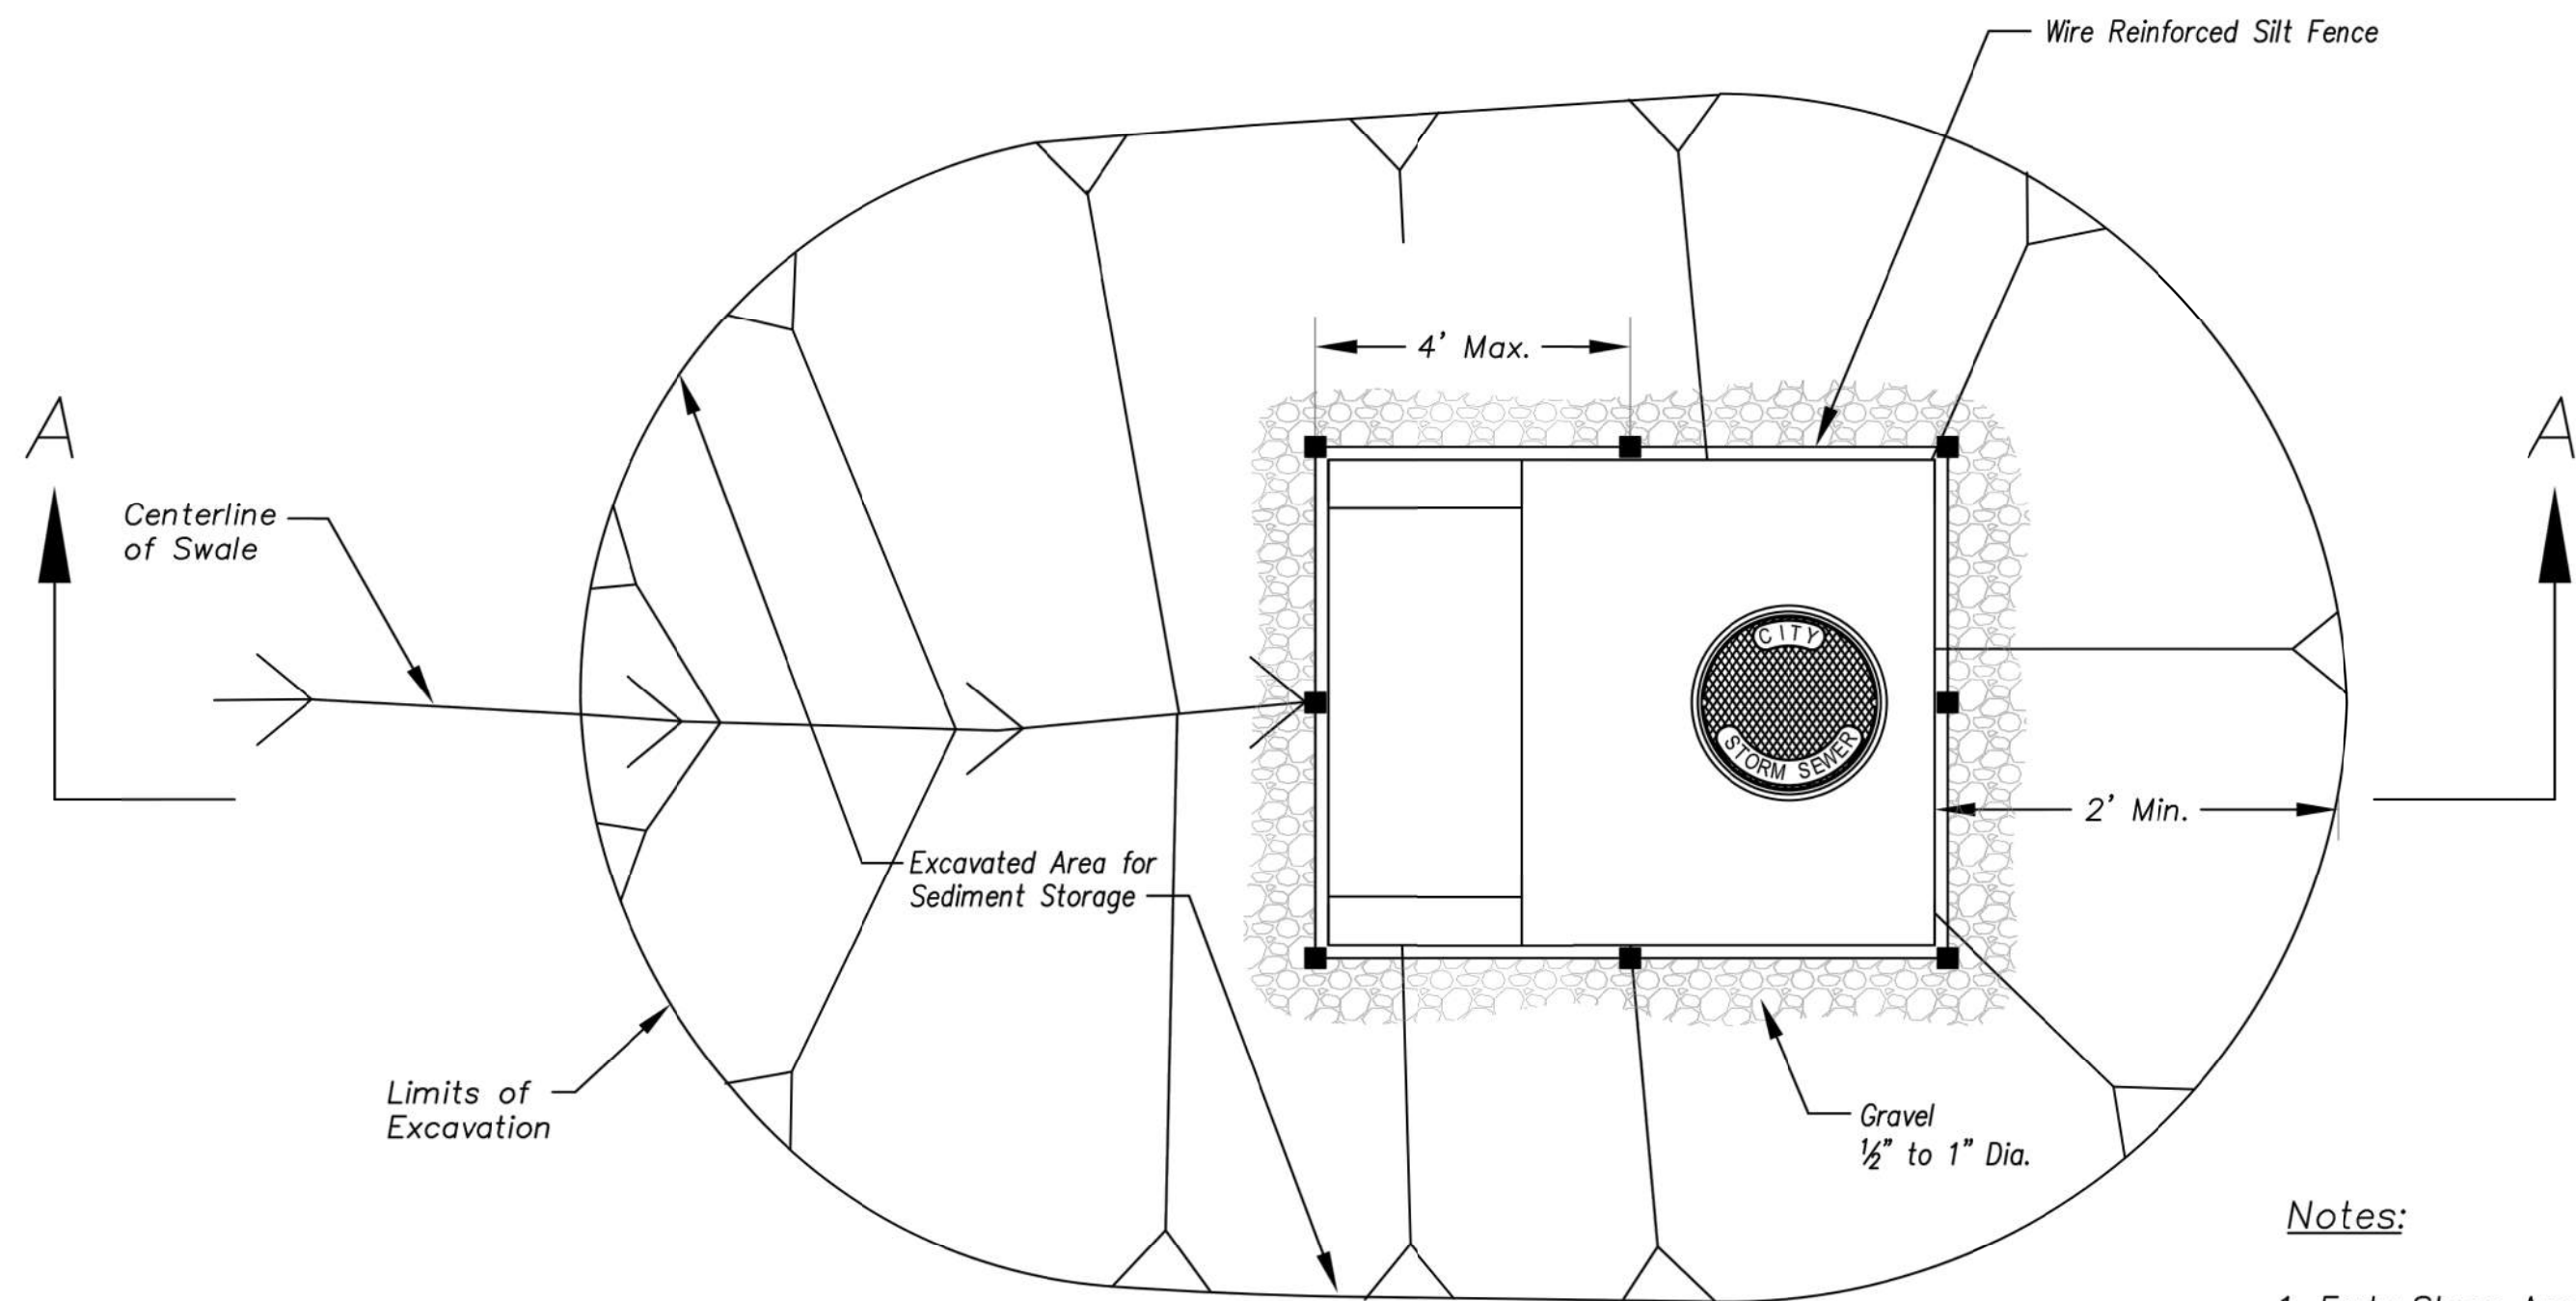


EARLY STAGE AREA INLET
(All open boxes and inlets not at final grade)

Notes:

1. Early Stage Area Inlet Sediment Barrier to be installed immediately after inlet or junction box is constructed.
2. Silt fence shall remain in place until excavated area is removed and Late Stage Area Inlet is being installed.
3. Backfill excavated area ONLY after final grading of the site. Stabilization of the site is to immediately follow.
4. Wire reinforced silt fence may be used in place of silt fence attached to wood frame.

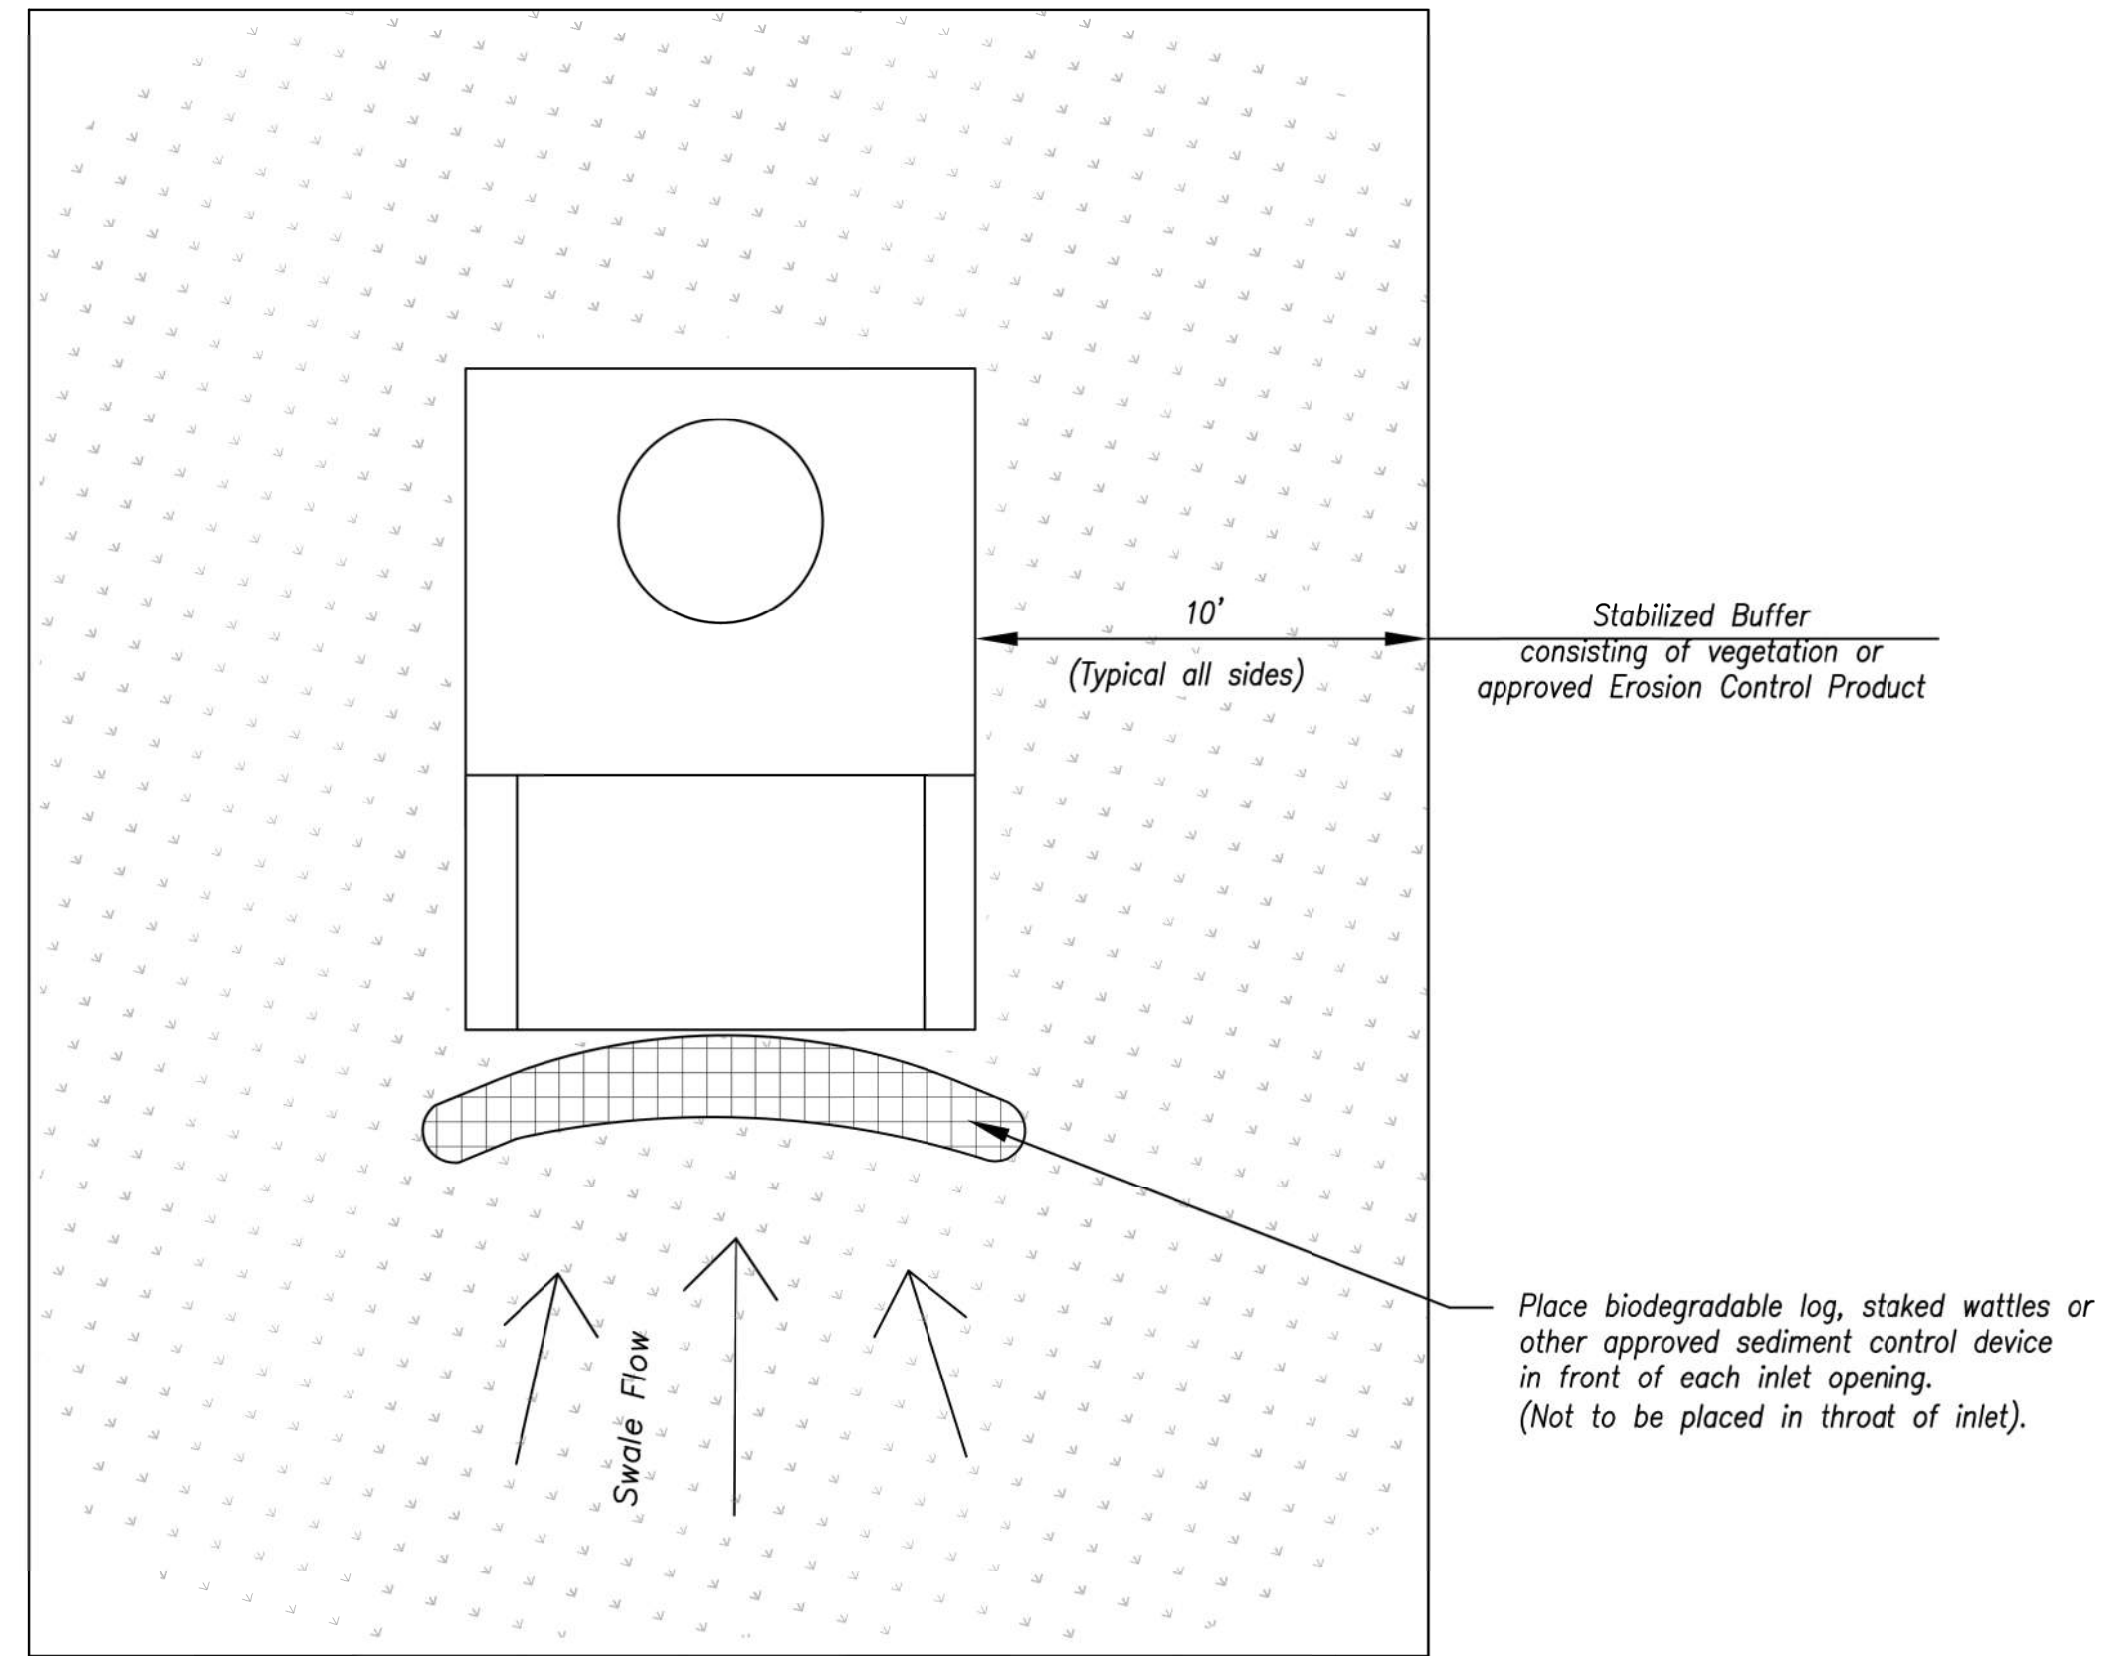

Plan
Not to Scale

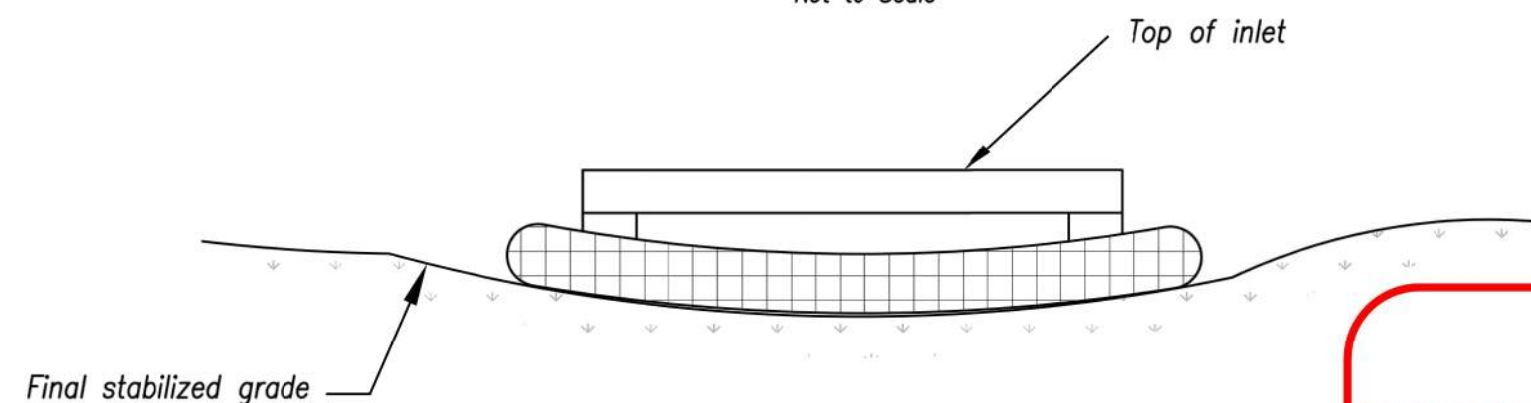

Front View

LATE STAGE AREA INLET
(Area inlets at final grade and existing inlets)

Maintenance:

1. Remove deposited sediment from excavated storage areas when available storage has been reduced by 20%.
2. Remove deposited sediment from filter socks or similar when any accumulation of sediment is visible.
3. Repair or replace as necessary to maintain function and integrity of installation.


RELEASE FOR CONSTRUCTION
AS NOTED ON PLANS REVIEW
DEVELOPMENT SERVICES
LEE'S SUMMIT, MISSOURI
04/16/2021

AS-BUILT
The information provided on this drawing conforms to construction records; it is not intended for construction, implementation or recording purposes; and it is solely based on information provided by others / obtained by my firm). ~~1.0000~~ 100.10', ~~1.0000~~ 1.15% slope", or "8-inch ~~1.0000~~ 1.15% slope", or "8-inch ~~1.0000~~ 1.15% slope" are all typical examples of revisions that indicate that design data has been replaced with "as-built" information. All other data is as designed and has not been field verified.
Date: 03/24/2022 Certified by: GRC
Title: Project Engineer Firm: Anderson Engineering Inc.

Modified from 2015 Overland Park Standard Details
for Erosion and Sediment Control.

AMERICAN PUBLIC WORKS ASSOCIATION

Kansas City Metro Chapter



AMERICAN PUBLIC WORKS ASSOCIATION

KANSAS CITY METRO CHAPTER

STANDARD DRAWING
NUMBER ESC-07
ADOPTED:
10/24/2016

AREA INLET AND
JUNCTION BOX PROTECTION

ANDERSON ENGINEERING

EMPLOYEE OWNED



ENGINEERS • SURVEYORS • LABORATORIES • DRILLING
941 W. 141ST TER • KANSAS CITY, MISSOURI 64145 • PHONE (816) 777-0400
A LICENSED MISSOURI ENGINEERING & SURVEYING CORPORATION - LC 62

REVISIONS		DRAWING INFO.	
NO.	DESCRIPTION	BY	DATE
1	REVISED PER CITY COMMENT	GC	2/11/21
2	AS-BUILT DRAWINGS	GC	3/16/22
		CHECK BY:	ZM
		LICENSE NO.	PE-2012009232
		DATE:	1/7/2021
		ISSUED FOR:	FOR REVIEW
		JOB NUMBER:	20K10058
		MO COA NO.	00062

SUMMIT HOMES KC
HIGHLAND MEADOWS - 6TH PLAT

AREA INLET PROTECTION
DETAILS

S10, T47N, R32W
LEE'S SUMMIT, JACKSON COUNTY, MISSOURI

STATE OF MISSOURI


ZACH A. MYERS

NUMBER
PE-2012009232

PROFESSIONAL ENGINEER

SHEET NUMBER
C505
39 OF 42

G:\Shared drives\K10 - Land Development\Projects\2020\20K10058 Highland Meadows - 6th Plat\01 CIVIL\03-DWG\Sheet\STREET AND STORM\20K10058 - SH1 - DETAILS.dwg Layout: ROCK DITCH CHECK DETAILS
Feb 11, 2021 - 6:12pm Plotted By: gacile

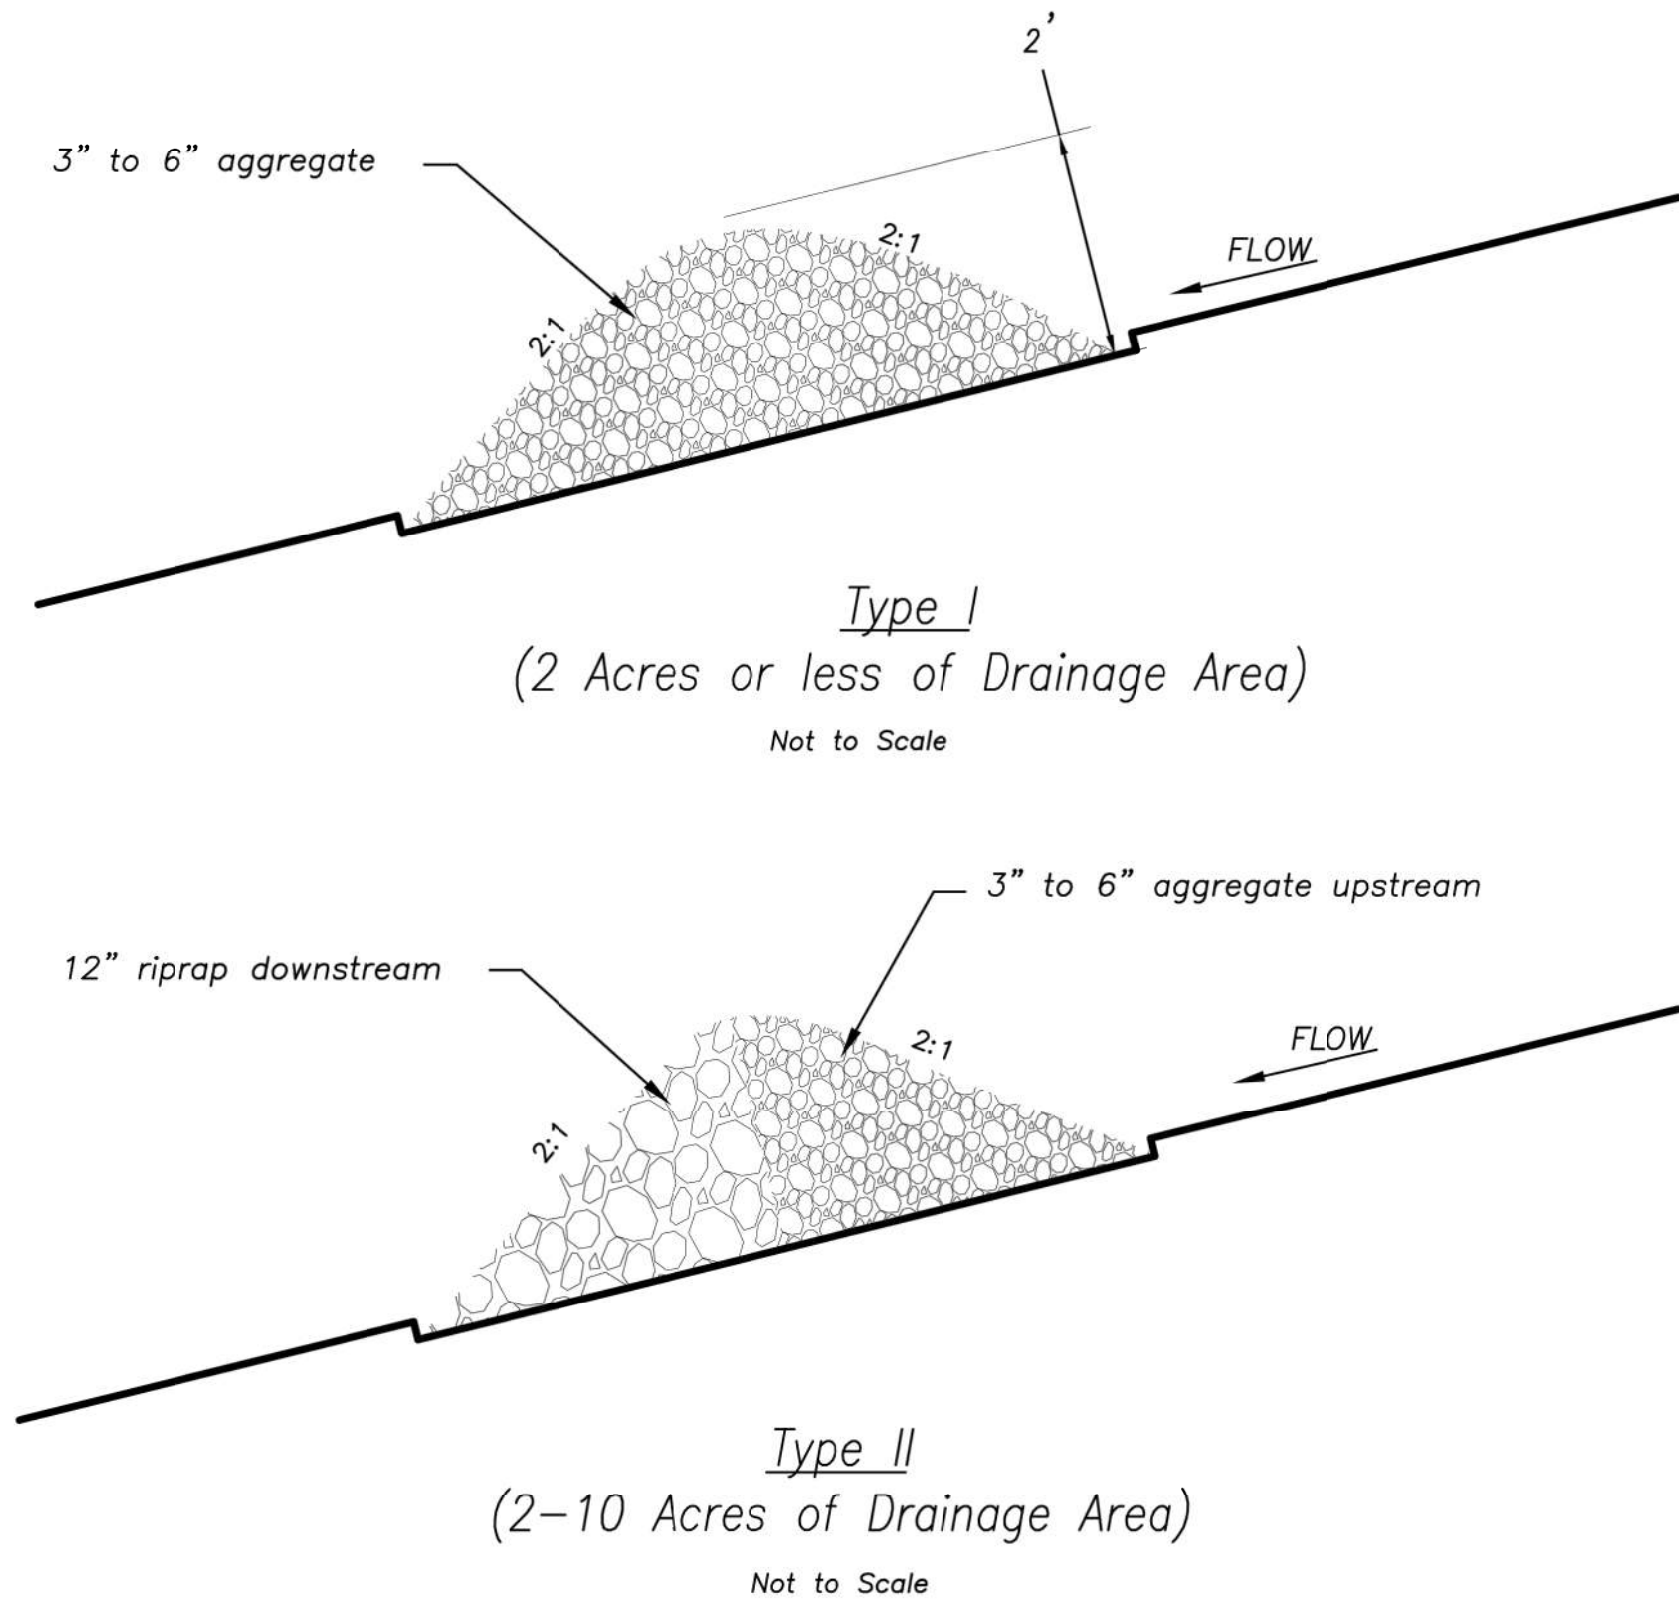


ROCK DITCH CHECK

Temporary Rock Ditch Check Spacing

Ditch Centerline Slope (%)	Spacing Interval (Feet)
5.0	60
6.0	50
7.0	43
8.0	36
9.0	33
10.0	29

Note: Use this spacing only for Rock Ditch Checks.

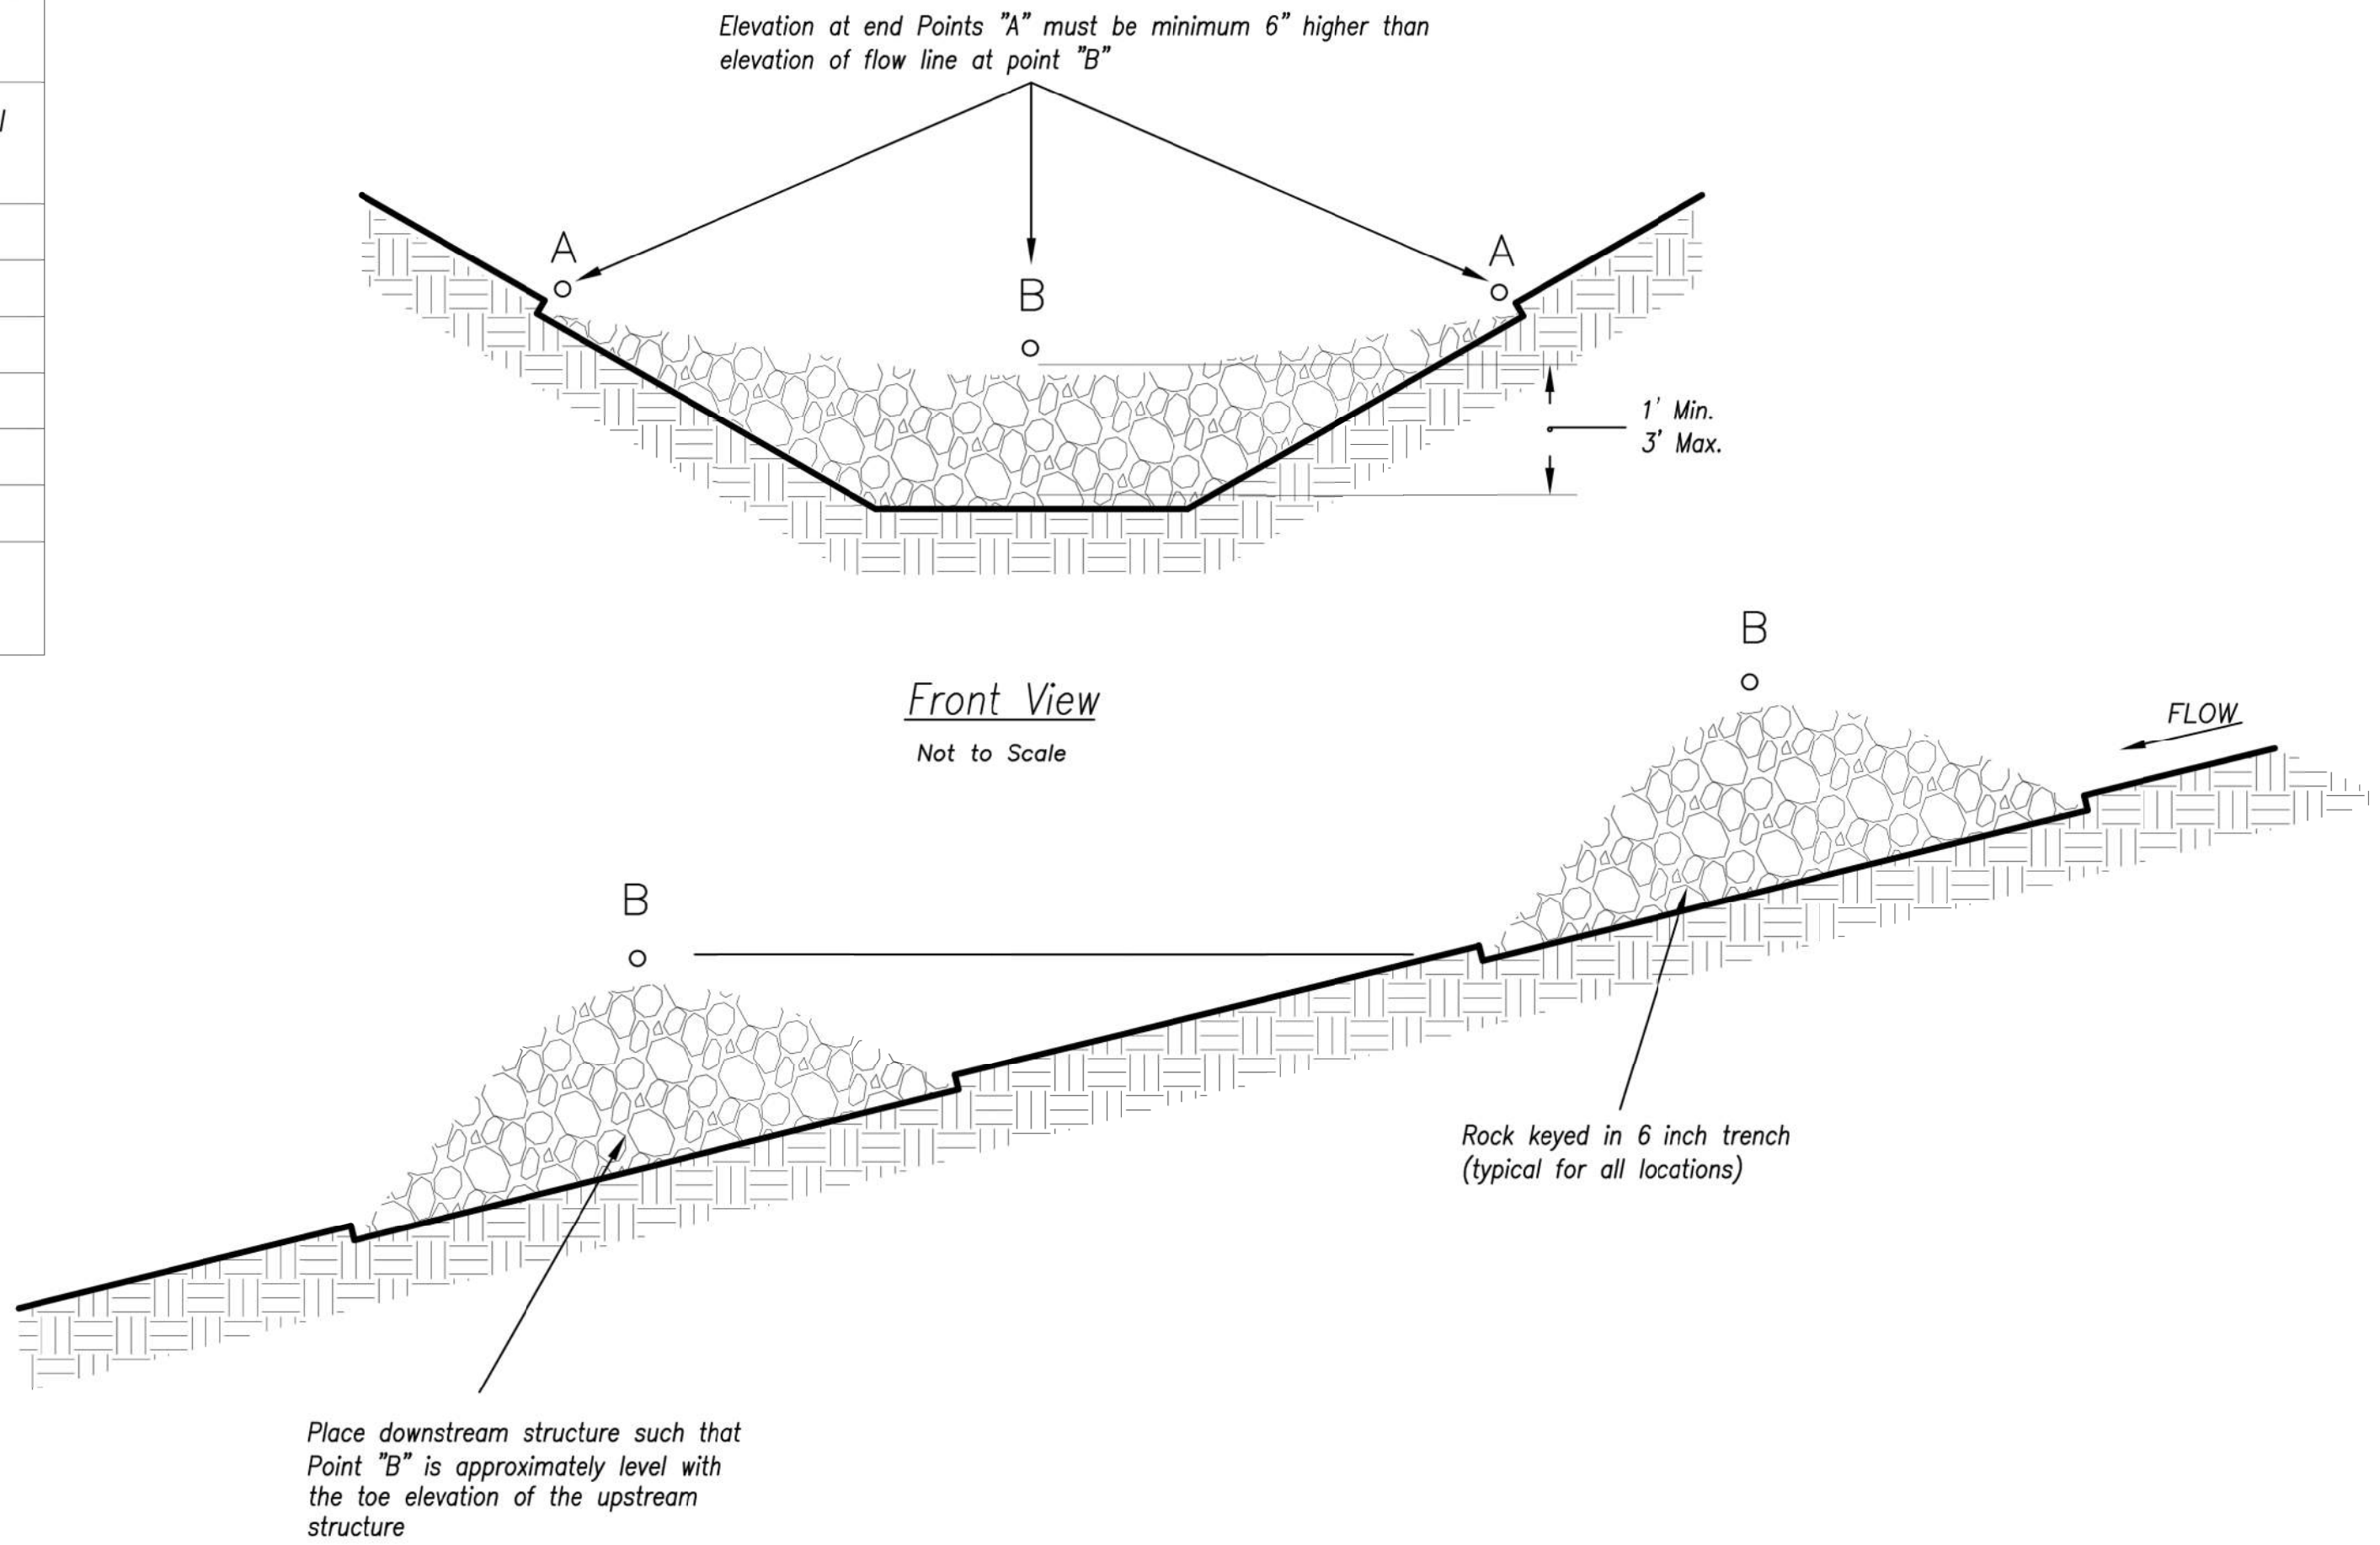

Spacing Between Check Dams (all types)

Not to Scale

Notes:

1. Rock check dams shall be used only for drainage areas less than 10 acres unless approved by the City Engineer.
2. Use rock checks only in situations where the ditch slope exceeds 6%.

Maintenance:


1. Remove and dispose of sediment deposits when the deposit approaches 1/2 the height of the ditch check.
2. Replace and reshape as necessary to maintain function and integrity of installation.

Modified from 2015 Overland Park Standard Details for Erosion and Sediment Control.



AMERICAN PUBLIC WORKS ASSOCIATION

Kansas City Metro Chapter



AMERICAN PUBLIC WORKS ASSOCIATION

KANSAS CITY METRO CHAPTER

STANDARD DRAWING NUMBER ESC-10 ADOPTED: 10/24/2016

ROCK DITCH CHECKS

ANDERSON ENGINEERING

EMPLOYEE OWNED



ENGINEERS • SURVEYORS • LABORATORIES • DRILLING
941 W. 141ST TER • KANSAS CITY, MISSOURI 64145 • PHONE (816) 777-0400
A LICENSED MISSOURI ENGINEERING & SURVEYING CORPORATION - LC 62

REVISIONS		DRAWING INFO.	
NO.	DESCRIPTION	BY	DATE
1	REVISED PER CITY COMMENT	GC	2/11/21
2	AS-BUILT DRAWINGS	GC	3/16/22
		DRAWN BY:	GC
		CHECK BY:	ZM
		LICENSE NO.	PE-2012009232
		DATE:	1/7/2021
		ISSUED FOR:	FOR REVIEW
		JOB NUMBER:	20K10058
		MO COA NO.	00062

© COPYRIGHT ANDERSON ENGINEERING, INC. 2020

SUMMIT HOMES KC
HIGHLAND MEADOWS - 6TH PLAT


ROCK DITCH CHECK DETAILS

S10, T47N, R32W
LEE'S SUMMIT, JACKSON COUNTY, MISSOURI



SHEET NUMBER
C506
40 OF 42

Feb 11, 2021 -- 6:12pm Plotted By: gscite G:\Shared drives\KCTO - Land Development\Projects\2020\20K10058 Highland Meadows - 6th Plat\01 CIVIL\03-DWG\Sheet\STREET AND STORM\20K10058 - SHY - DETAILS.dwg Layout: DIVERSION BERM DETAILS

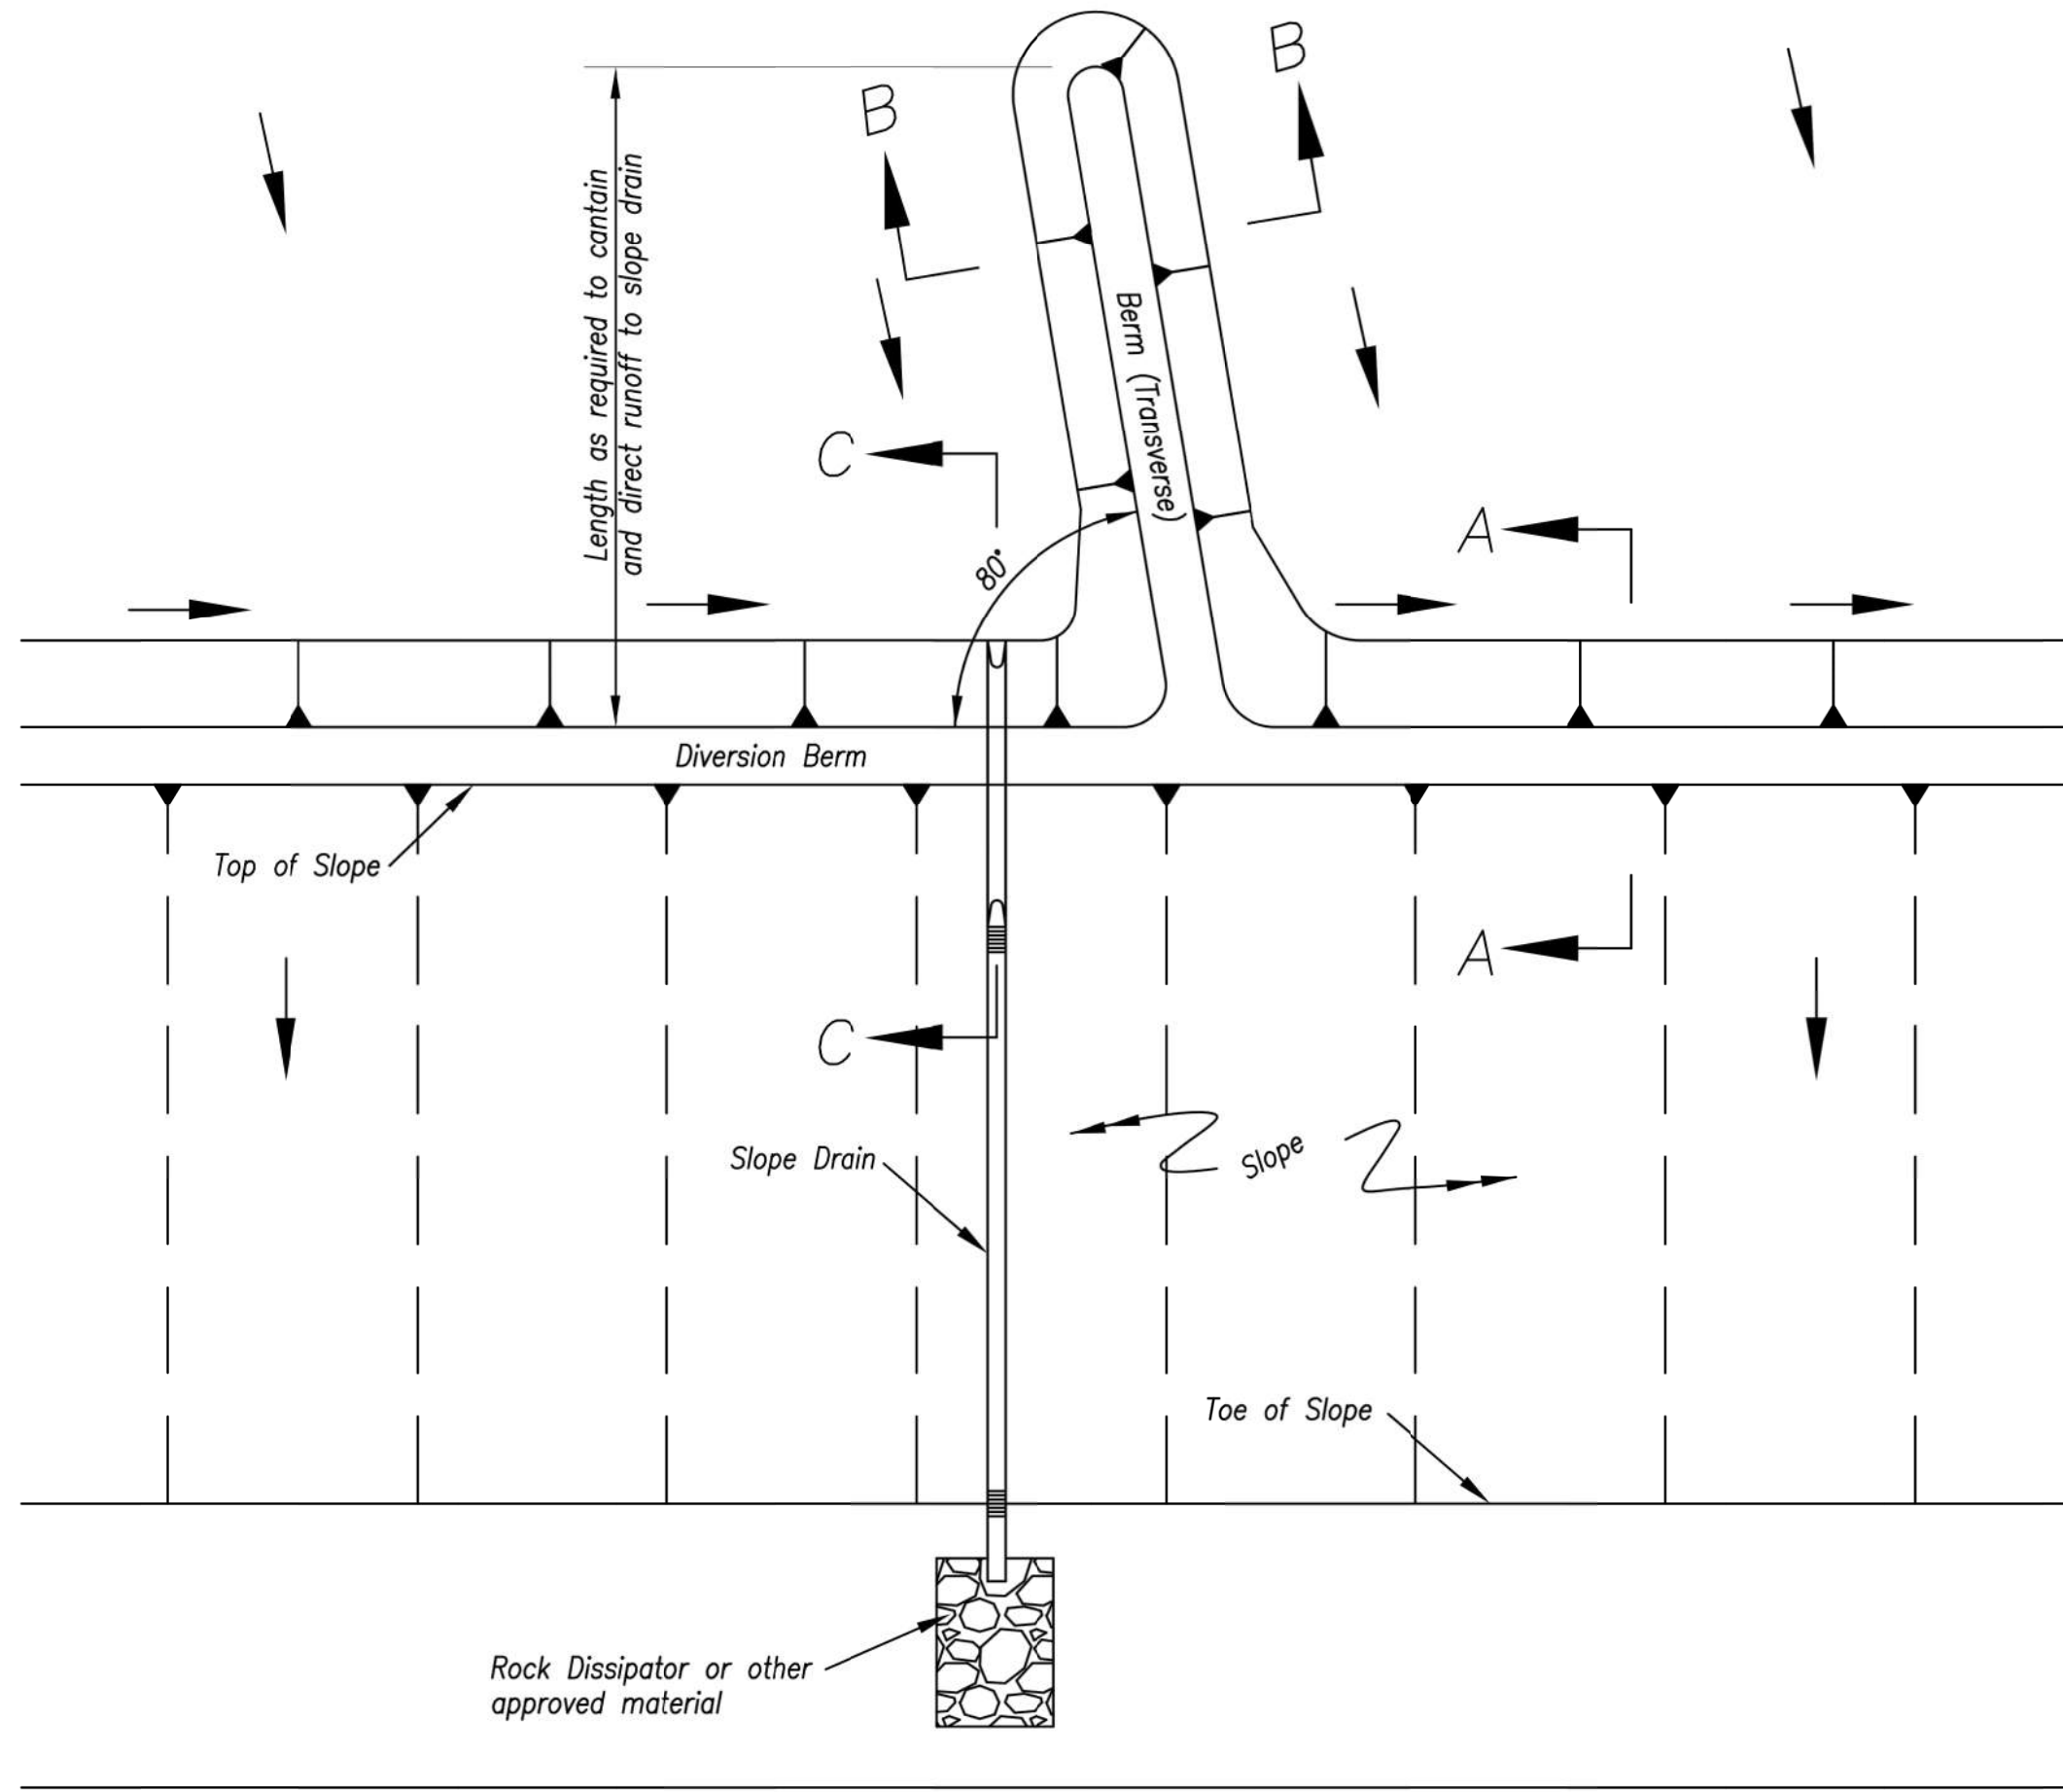

TYPICAL PLAN VIEW OF DIVERSION BERM AND SLOPE DRAIN

Notes for Diversion Berm:

1. Slope drains are optional, but may be required by the engineer if the berm is at the top of a steep slope.
2. Diversion berms must be installed as a first step in the land-disturbing activity and must be functional prior to upslope land disturbance.
3. The berm should be adequately compacted to prevent failure.
4. Temporary or permanent seeding and mulch shall be applied to the berm immediately following its construction.
5. Place the berm so to minimize damages by construction operations and traffic.
6. The berm must discharge to a temporary sediment trap or stabilized area.
7. All trees, brush, stumps, obstructions and other objectionable material shall be removed and disposed of so as not to interfere with the proper functioning of diversion.
8. The diversion shall be excavated or shaped to line, grade and cross-section as required to meet the criteria specified herein, free of irregularities which will impede flow.
9. Fills shall be compacted as needed to prevent unequal settlement that would cause damage in the completed diversion. Fill shall be composed of soil which is free from excessive organic debris, rocks or other objectionable materials.

Maintenance:


1. Berm shall be reshaped, compacted, and stabilized as necessary to maintain its function.
2. Breaches in the berm shall be repaired immediately.

Notes for Slope Drain:



1. Slope Drain and Diversion Berm may be used on either project foreslopes or project backslopes.
2. Discharge of Slope Drains shall be into stabilized ditch or area, or into Sediment Basin.
3. Pipe shall be secured in place as approved by Engineer.

Maintenance:

1. Accumulation of any visible sediment at the inlet and outlet shall be removed promptly.
2. Outlet conditions shall be repaired if scour is observed. Leaking or damaged section of pipe shall be repaired immediately.
3. Barriers directing water to the inlet shall be monitored for continuity and effectiveness.

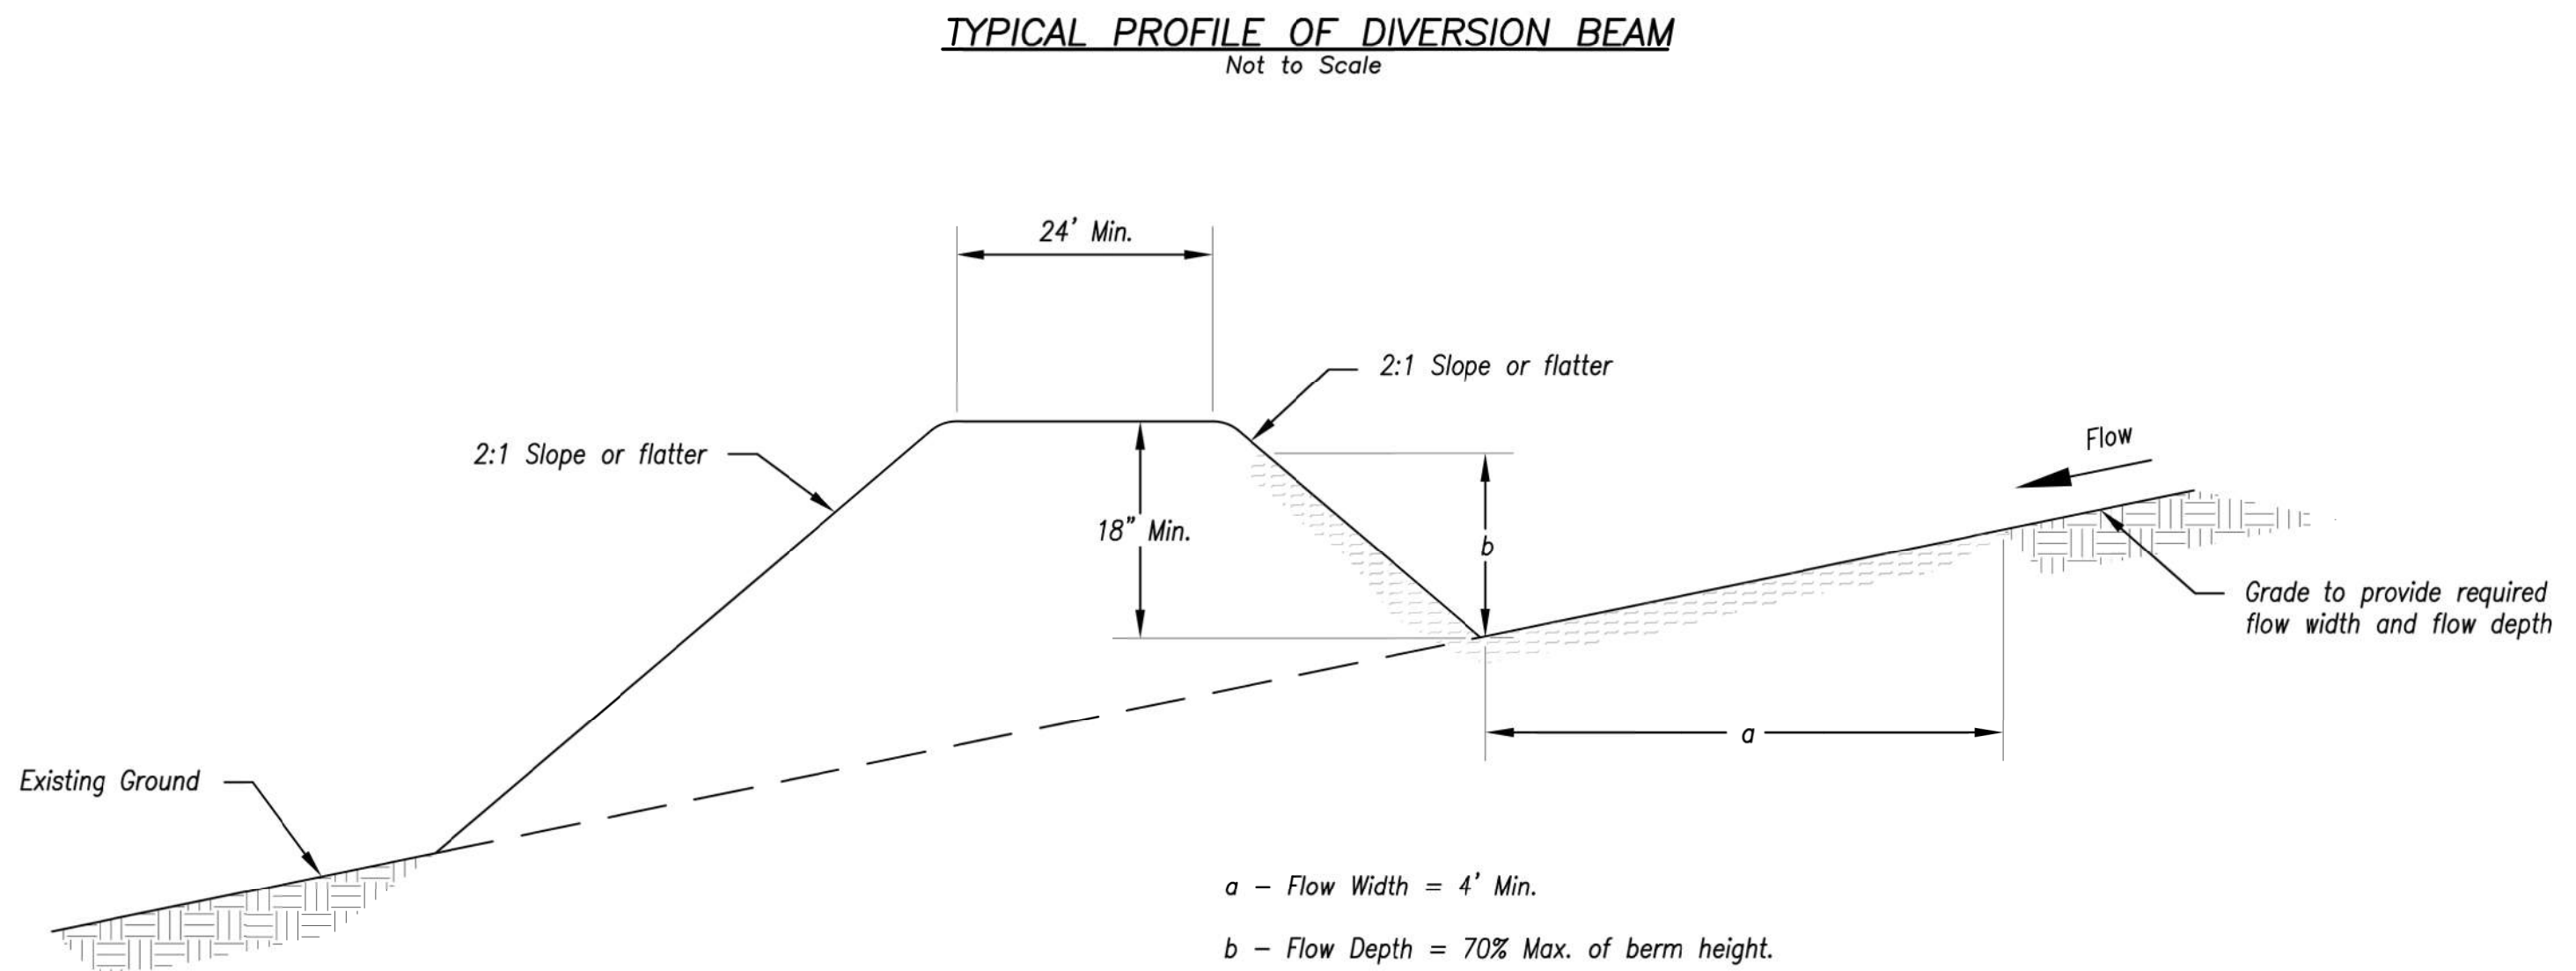

TYPICAL PROFILE OF DIVERSION BERM

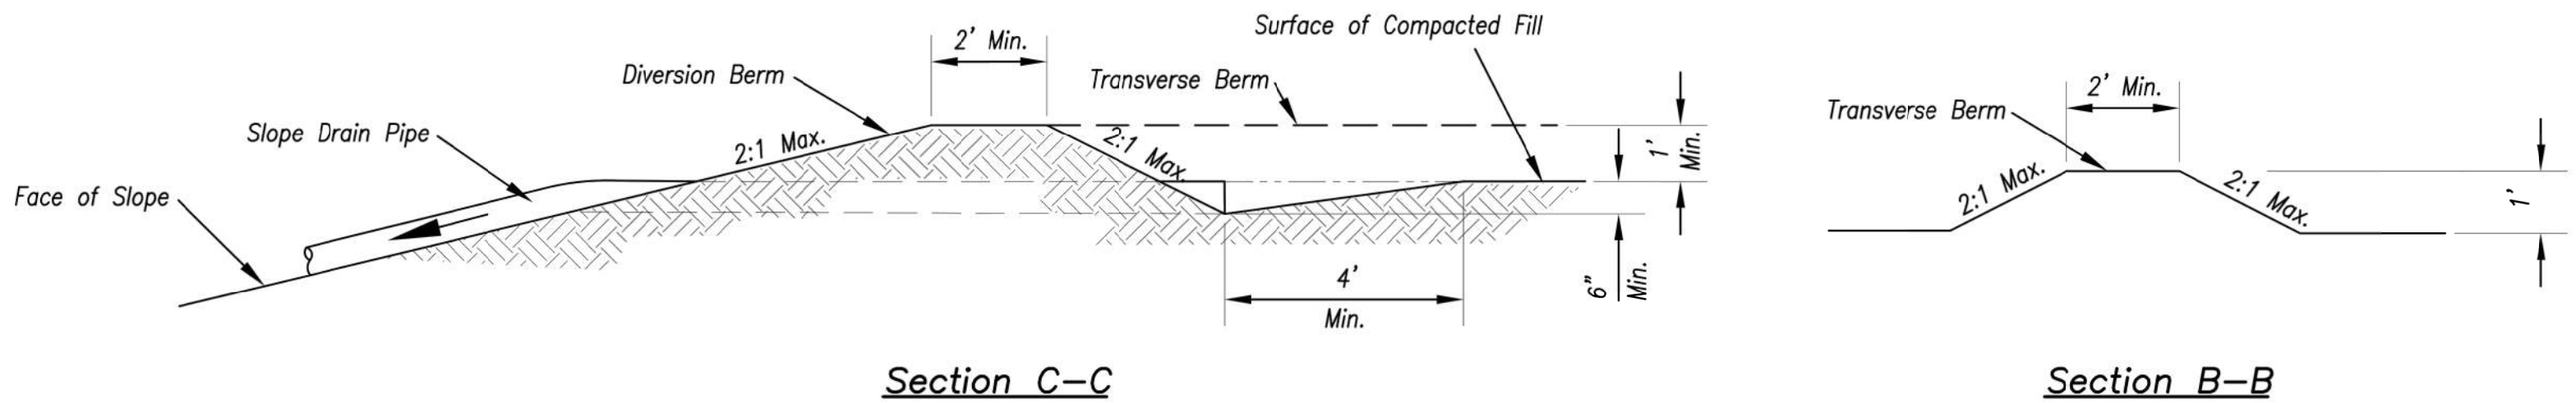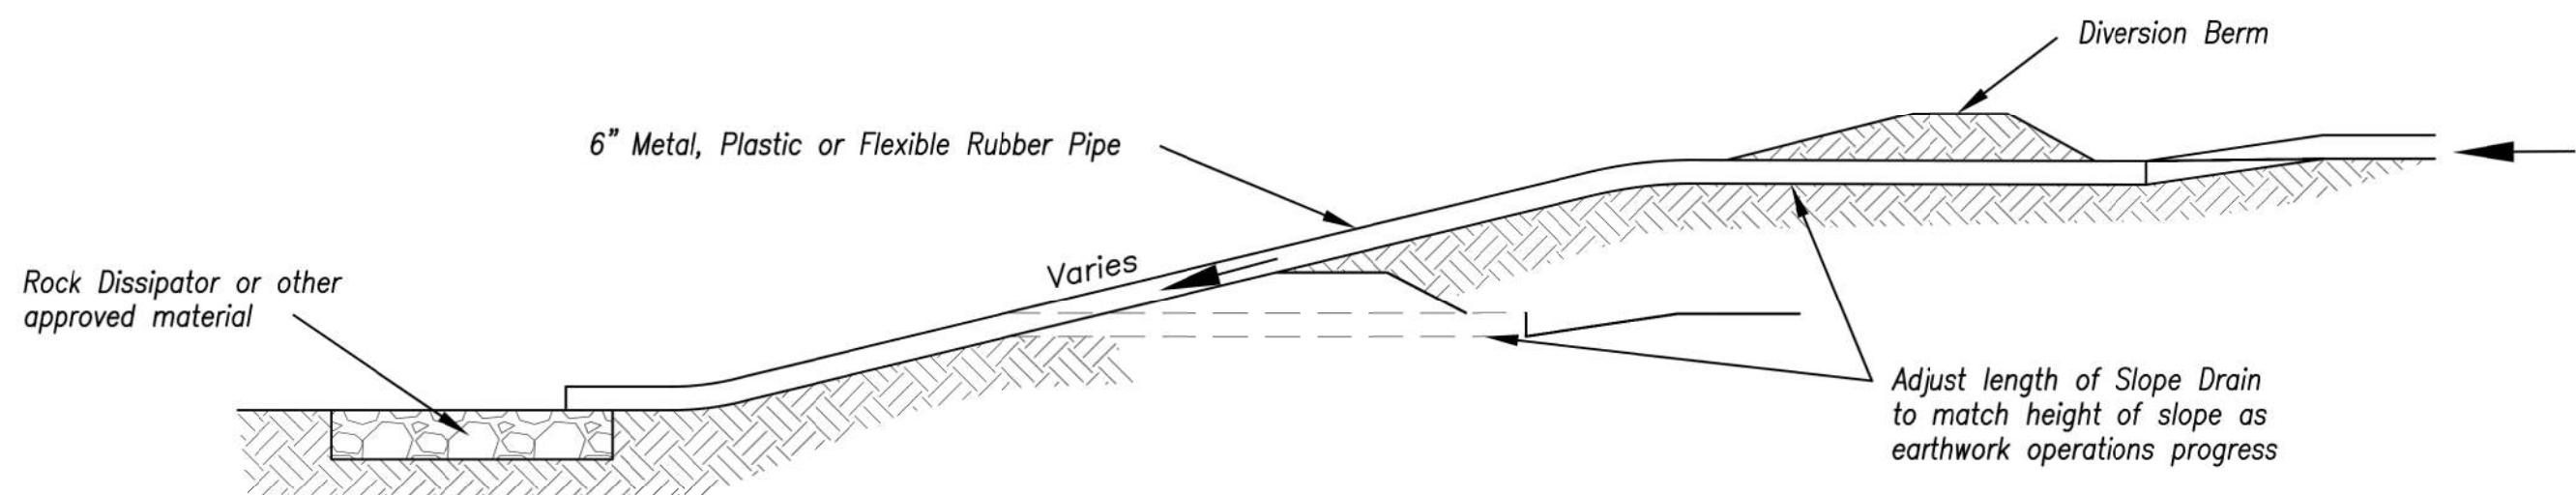

Section C-C

Section B-B


TYPICAL PROFILE OF DIVERSION BERM WITH SLOPE DRAIN



Modified from 2015 Overland Park Standard Details for Erosion and Sediment Control.

AMERICAN PUBLIC WORKS ASSOCIATION

Kansas City Metro Chapter



AMERICAN PUBLIC WORKS ASSOCIATION

KANSAS CITY METRO CHAPTER

STANDARD DRAWING NUMBER ESC-05

ADOPTED: 10/24/2016

DIVERSION BERMS AND SLOPE DRAINS

ANDERSON ENGINEERING

EMPLOYEE OWNED

ENGINEERS • SURVEYORS • LABORATORIES • DRILLING

941 W. 141ST TER. • KANSAS CITY, MISSOURI 64145 • PHONE (816) 777-0400

A LICENSED MISSOURI ENGINEERING & SURVEYING CORPORATION - LC 62

REVISIONS		DRAWING INFO.	
NO.	DESCRIPTION	BY	DATE
1	REVISED PER CITY COMMENT	GC	2/11/21
2	AS-BUILT DRAWINGS	GC	3/16/22
		CHECK BY:	ZM
		LICENSE NO.	PE-2012009232
		DATE:	1/7/2021
		ISSUED FOR:	FOR REVIEW
		JOB NUMBER:	20K10058
		MO COA NO.	00062

SUMMIT HOMES KC

HIGHLAND MEADOWS - 6TH PLAT

DIVERSION BERM DETAILS

S10, T47N, R32W

LEE'S SUMMIT, JACKSON COUNTY, MISSOURI

STATE OF MISSOURI

ZACH A. ANYERS

PROFESSIONAL ENGINEER


NUMBER PE-2012009232

SHEET NUMBER


C507

41 OF 42


Feb 11, 2021 -- 6:12pm Plotted By: gscite G:\Shared drives\KCTO - Land Development\Projects\2020\20K10058 Highland Meadows - 6th Plat\01 CIVIL\03-DWG\Sheet\STREET AND STORM\20K10058 - SHY - DETAILS.dwg Layout: OUTLET PROTECTION DETAILS

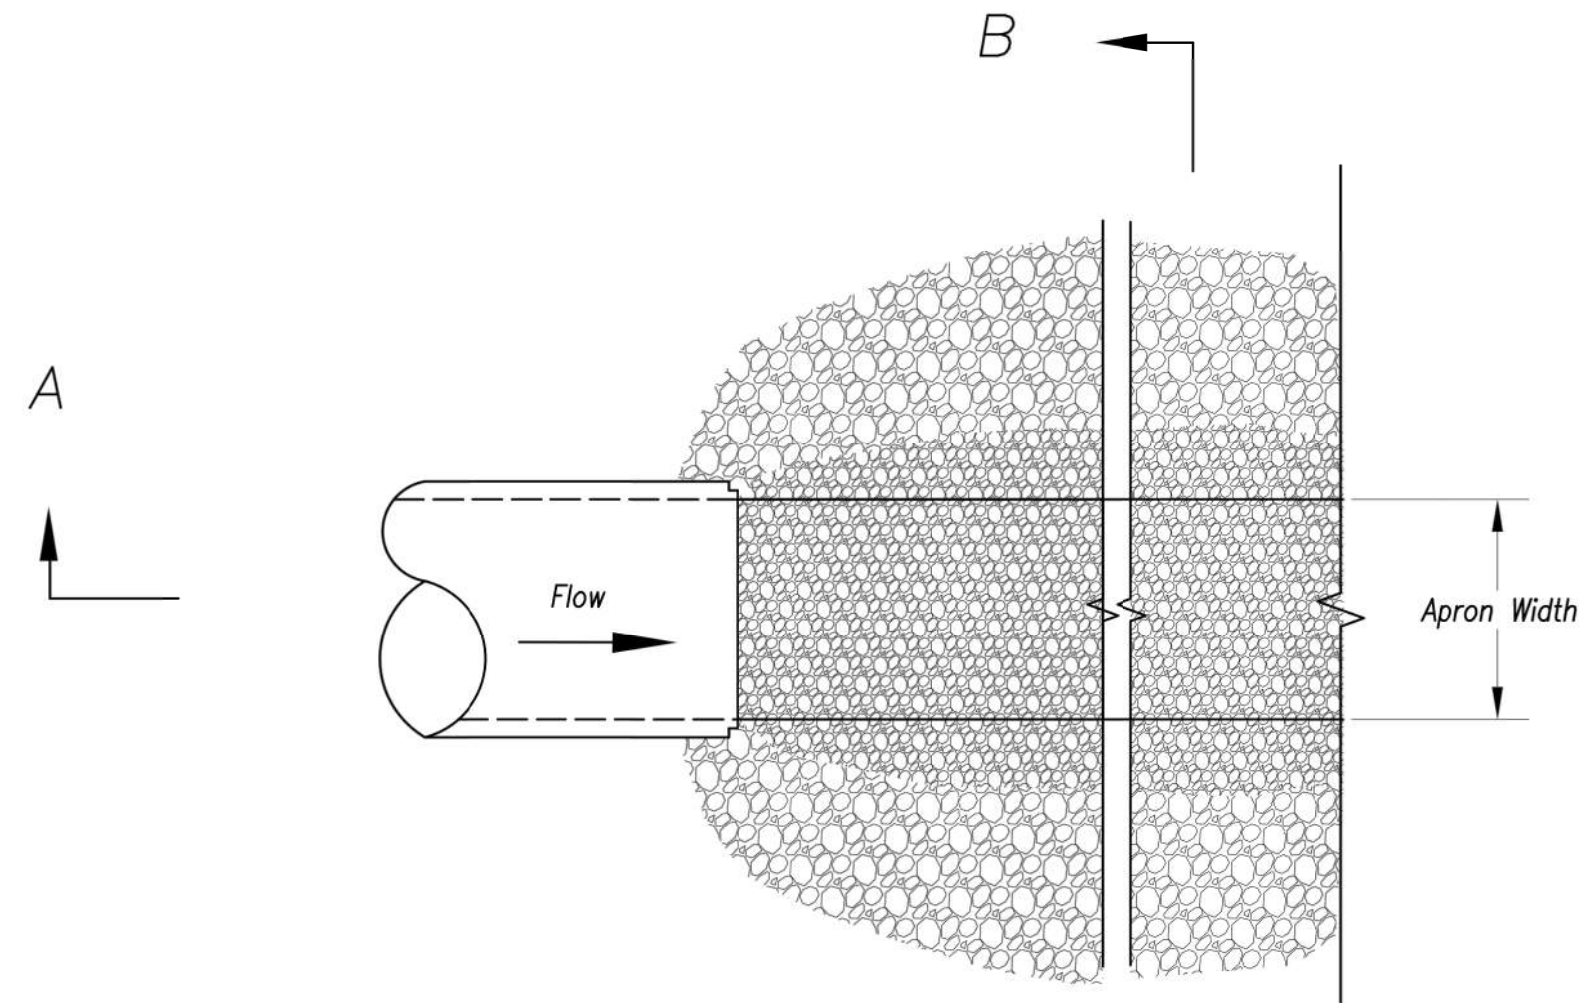

Plan View
Not to Scale

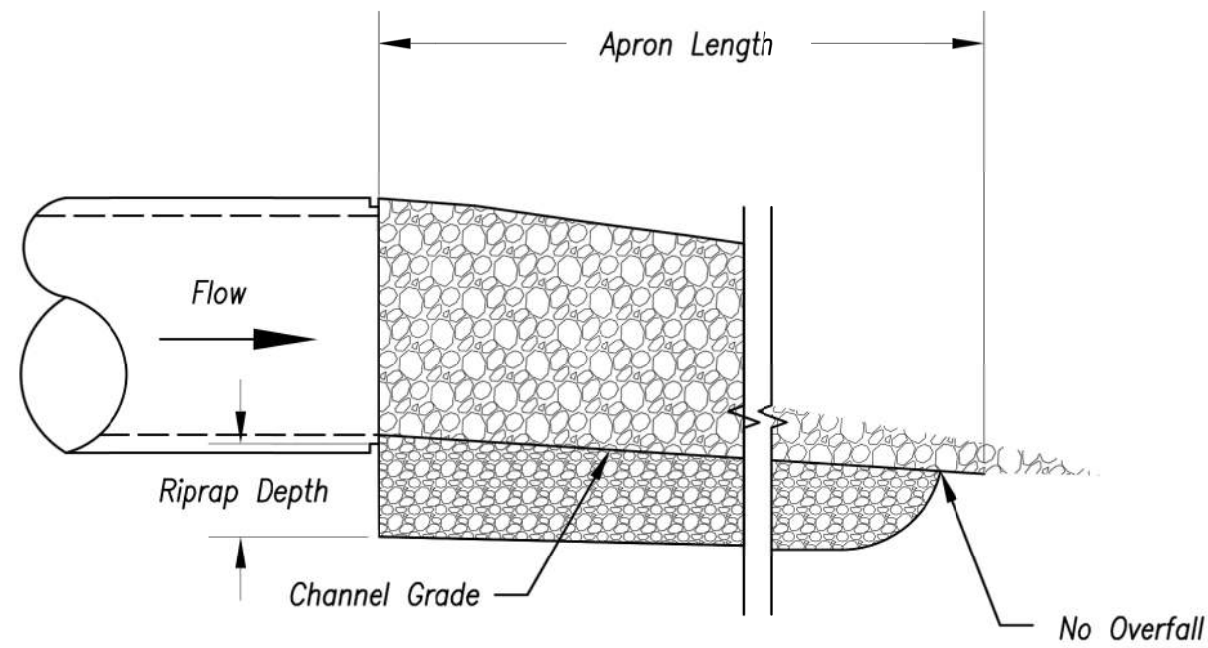


Section A-A
Not to Scale

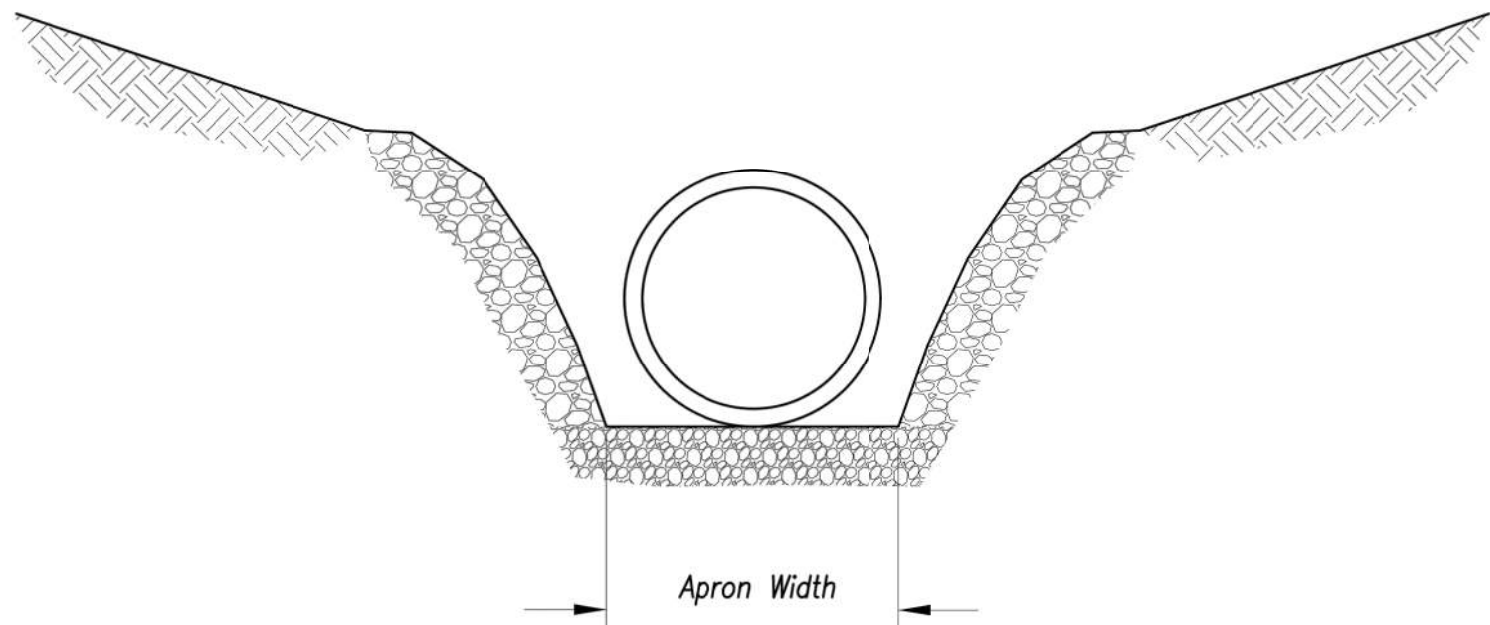


Section B-B
Not to Scale

OUTLET PROTECTION W/O END SECTION

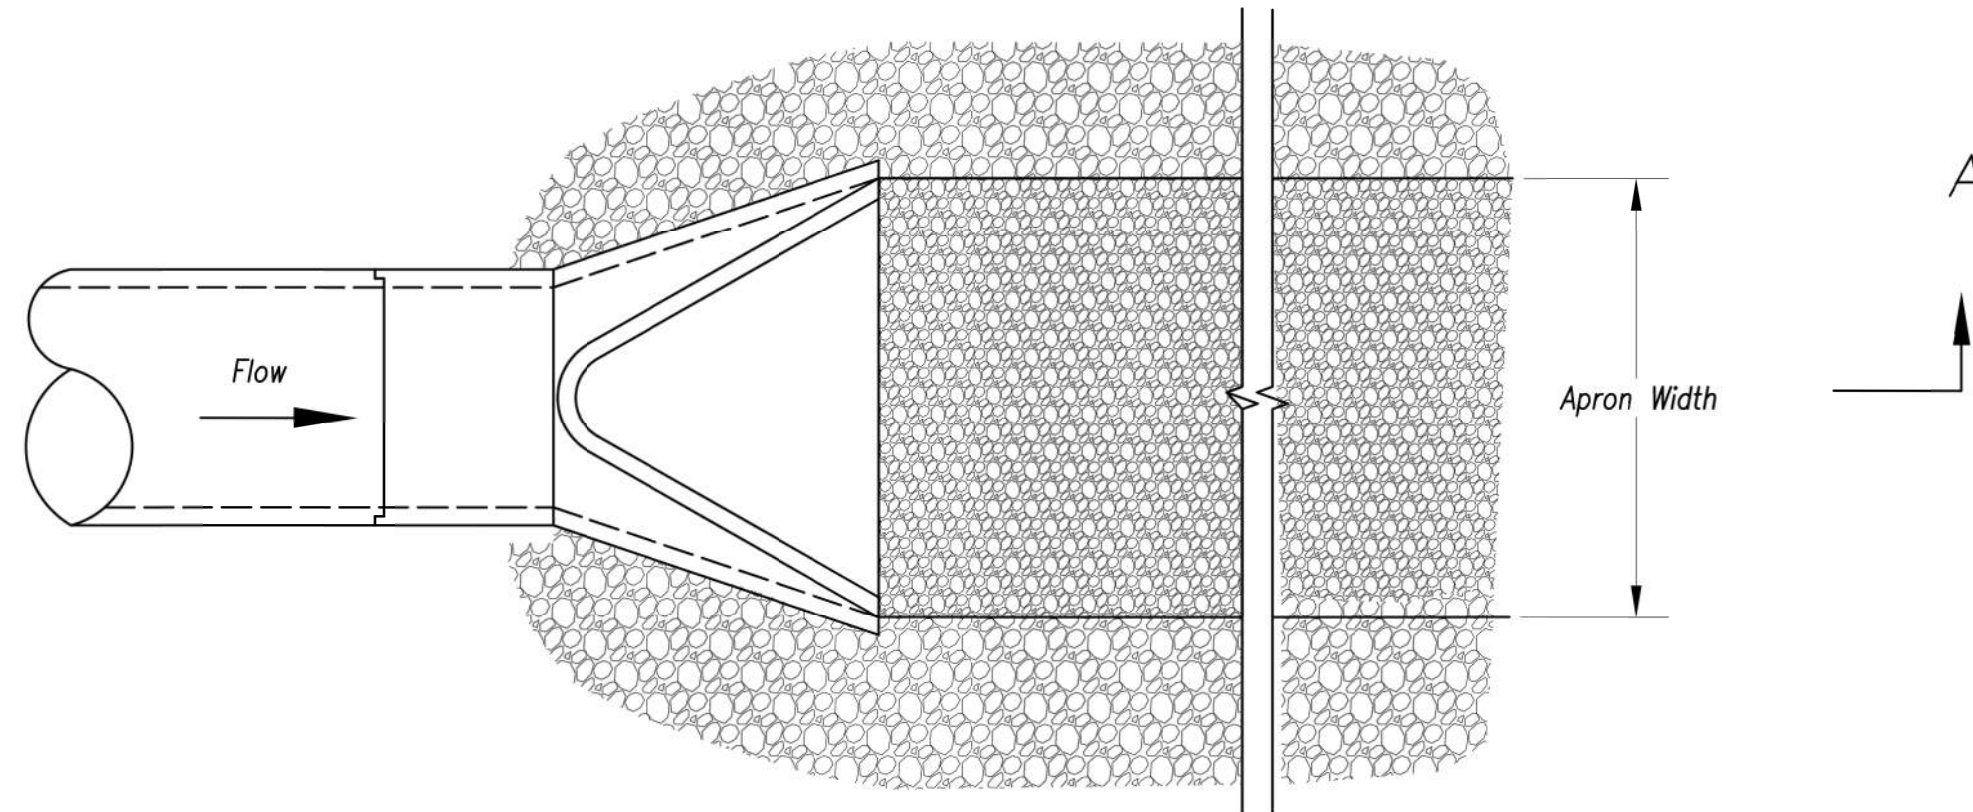

Plan View
Not to Scale

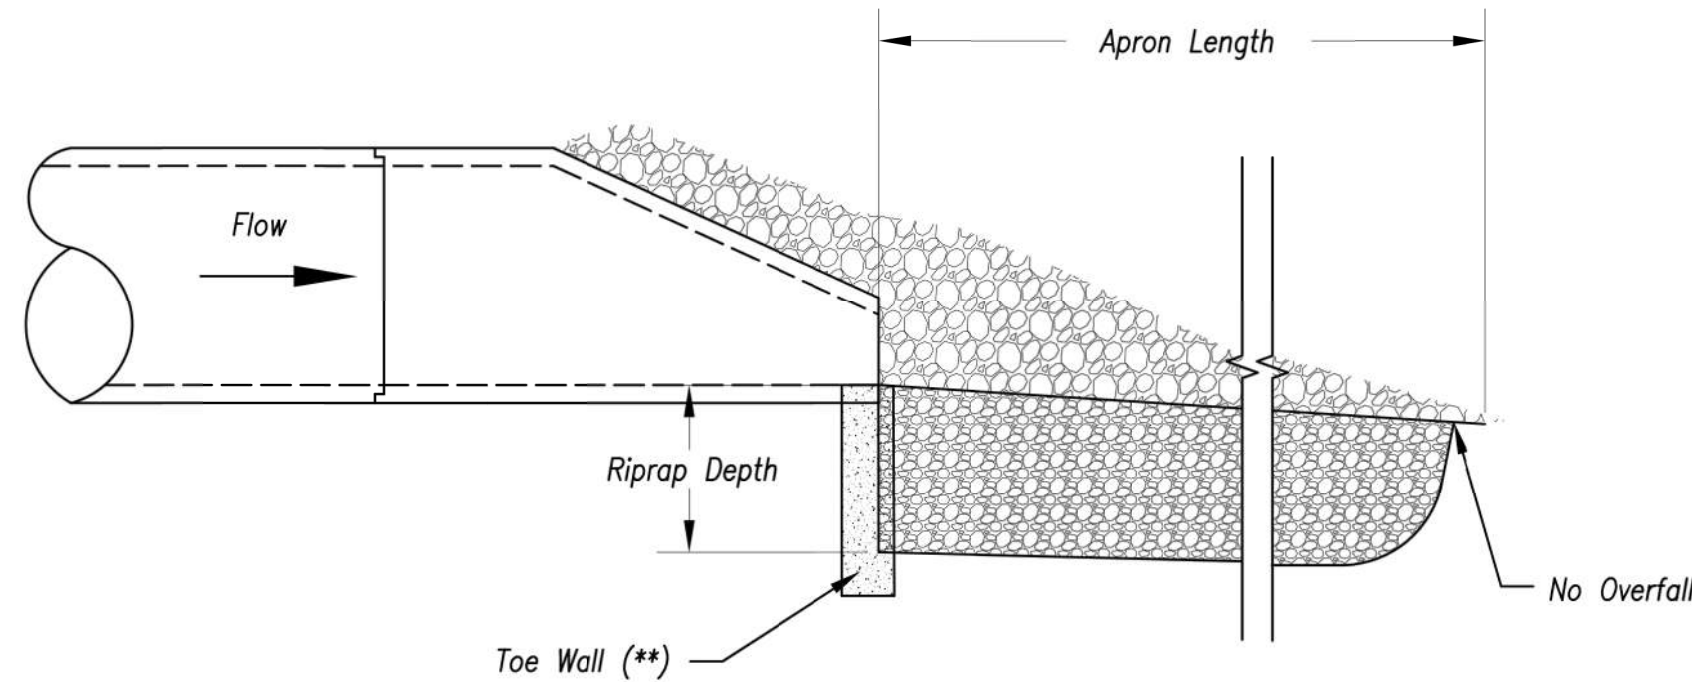

Section A-A
Not to Scale

OUTLET PROTECTION WITH END SECTION

Notes:

1. Rock all sides steeper than 3:1.
2. Stabilize all disturbed areas downstream of outlet to the limits of disturbance.
3. Alternative outlet protection and slope stabilization measures may be used with approval by the Engineer.
4. Install riprap apron so that it is no higher than flowline of pipe.
5. Reference APWA Specification 2650 for rock type, size, and placement.

AS-BUILT

The information provided on this drawing conforms to construction records; it is not intended for construction, implementation or recording purposes, and it is solely based on information provided by others / obtained by my firm). "100% 100' 10" 1.15% slope", or "8-inch 100' 10" 1.15% slope" are all typical examples of revisions that indicate that design data has been replaced with "as-built" information. All other data is as designed and has not been field verified. Date: 03/24/2022 Certified by: GRC Title: Project Engineer Firm: Anderson Engineering Inc.

RELEASE FOR CONSTRUCTION AS NOTED ON PLANS REVIEW DEVELOPMENT SERVICES LEE'S SUMMIT, MISSOURI 04/16/2021

AMERICAN PUBLIC WORKS ASSOCIATION



KANSAS CITY METRO CHAPTER

OUTLET PROTECTION

STANDARD DRAWING
NUMBER ESC-14
ADOPTED:
10/24/2016

Modified from 2015 Overland Park Standard Details for Erosion and Sediment Control.



ENGINEERS • SURVEYORS • LABORATORIES • DRILLING
941 W. 141ST TER • KANSAS CITY, MISSOURI 64145 • PHONE (816) 777-0400
A LICENSED MISSOURI ENGINEERING & SURVEYING CORPORATION - LC 62

REVISIONS		DRAWING INFO.	
NO.	DESCRIPTION	BY	DATE
1	REVISED PER CITY COMMENT	GC	2/11/21
2	AS-BUILT DRAWINGS	GC	3/16/22
		CHECK BY:	ZM
		LICENSE NO.	PE-2012009232
		DATE:	1/7/2021
		ISSUED FOR:	FOR REVIEW
		JOB NUMBER:	20K10058
		MO COA NO.	00062

© COPYRIGHT ANDERSON ENGINEERING, INC. 2020

SUMMIT HOMES KC
HIGHLAND MEADOWS - 6TH PLAT

OUTLET PROTECTION
DETAILS

S10, T47N, R32W
LEE'S SUMMIT, JACKSON COUNTY, MISSOURI



SHEET NUMBER
C508
42 OF 42