


Feb 11, 2021 - 2:55pm Plotted By: gacite G:\Shared drives\VC10 - Land Development\Projects\2020\20K10058 Highland Meadows - 6th Plat\01 C101 [03-DWG]Sheet\SANITARY SEWER\20K10058 - SH1 - GENERAL LAYOUT.dwg Layout: GENERAL LAYOUT

LEGEND

- PROP. STREET C
- PROP. RIGHT-OF-WAY
- PROP. UTILITY EASEMENT
- PROP. BUILDING SETBACK
- PROP. LOT LINE
- PROP. WATER LINE
- PROP. SSWR
- PROP. SSWR SERVICE
- PROP. STREET PAVEMENT
- PROP. LONGVIEW BLVD.
- PROP. SIDEWALK
- PROP. RIPRAP
- EXISTING SIDEWALK

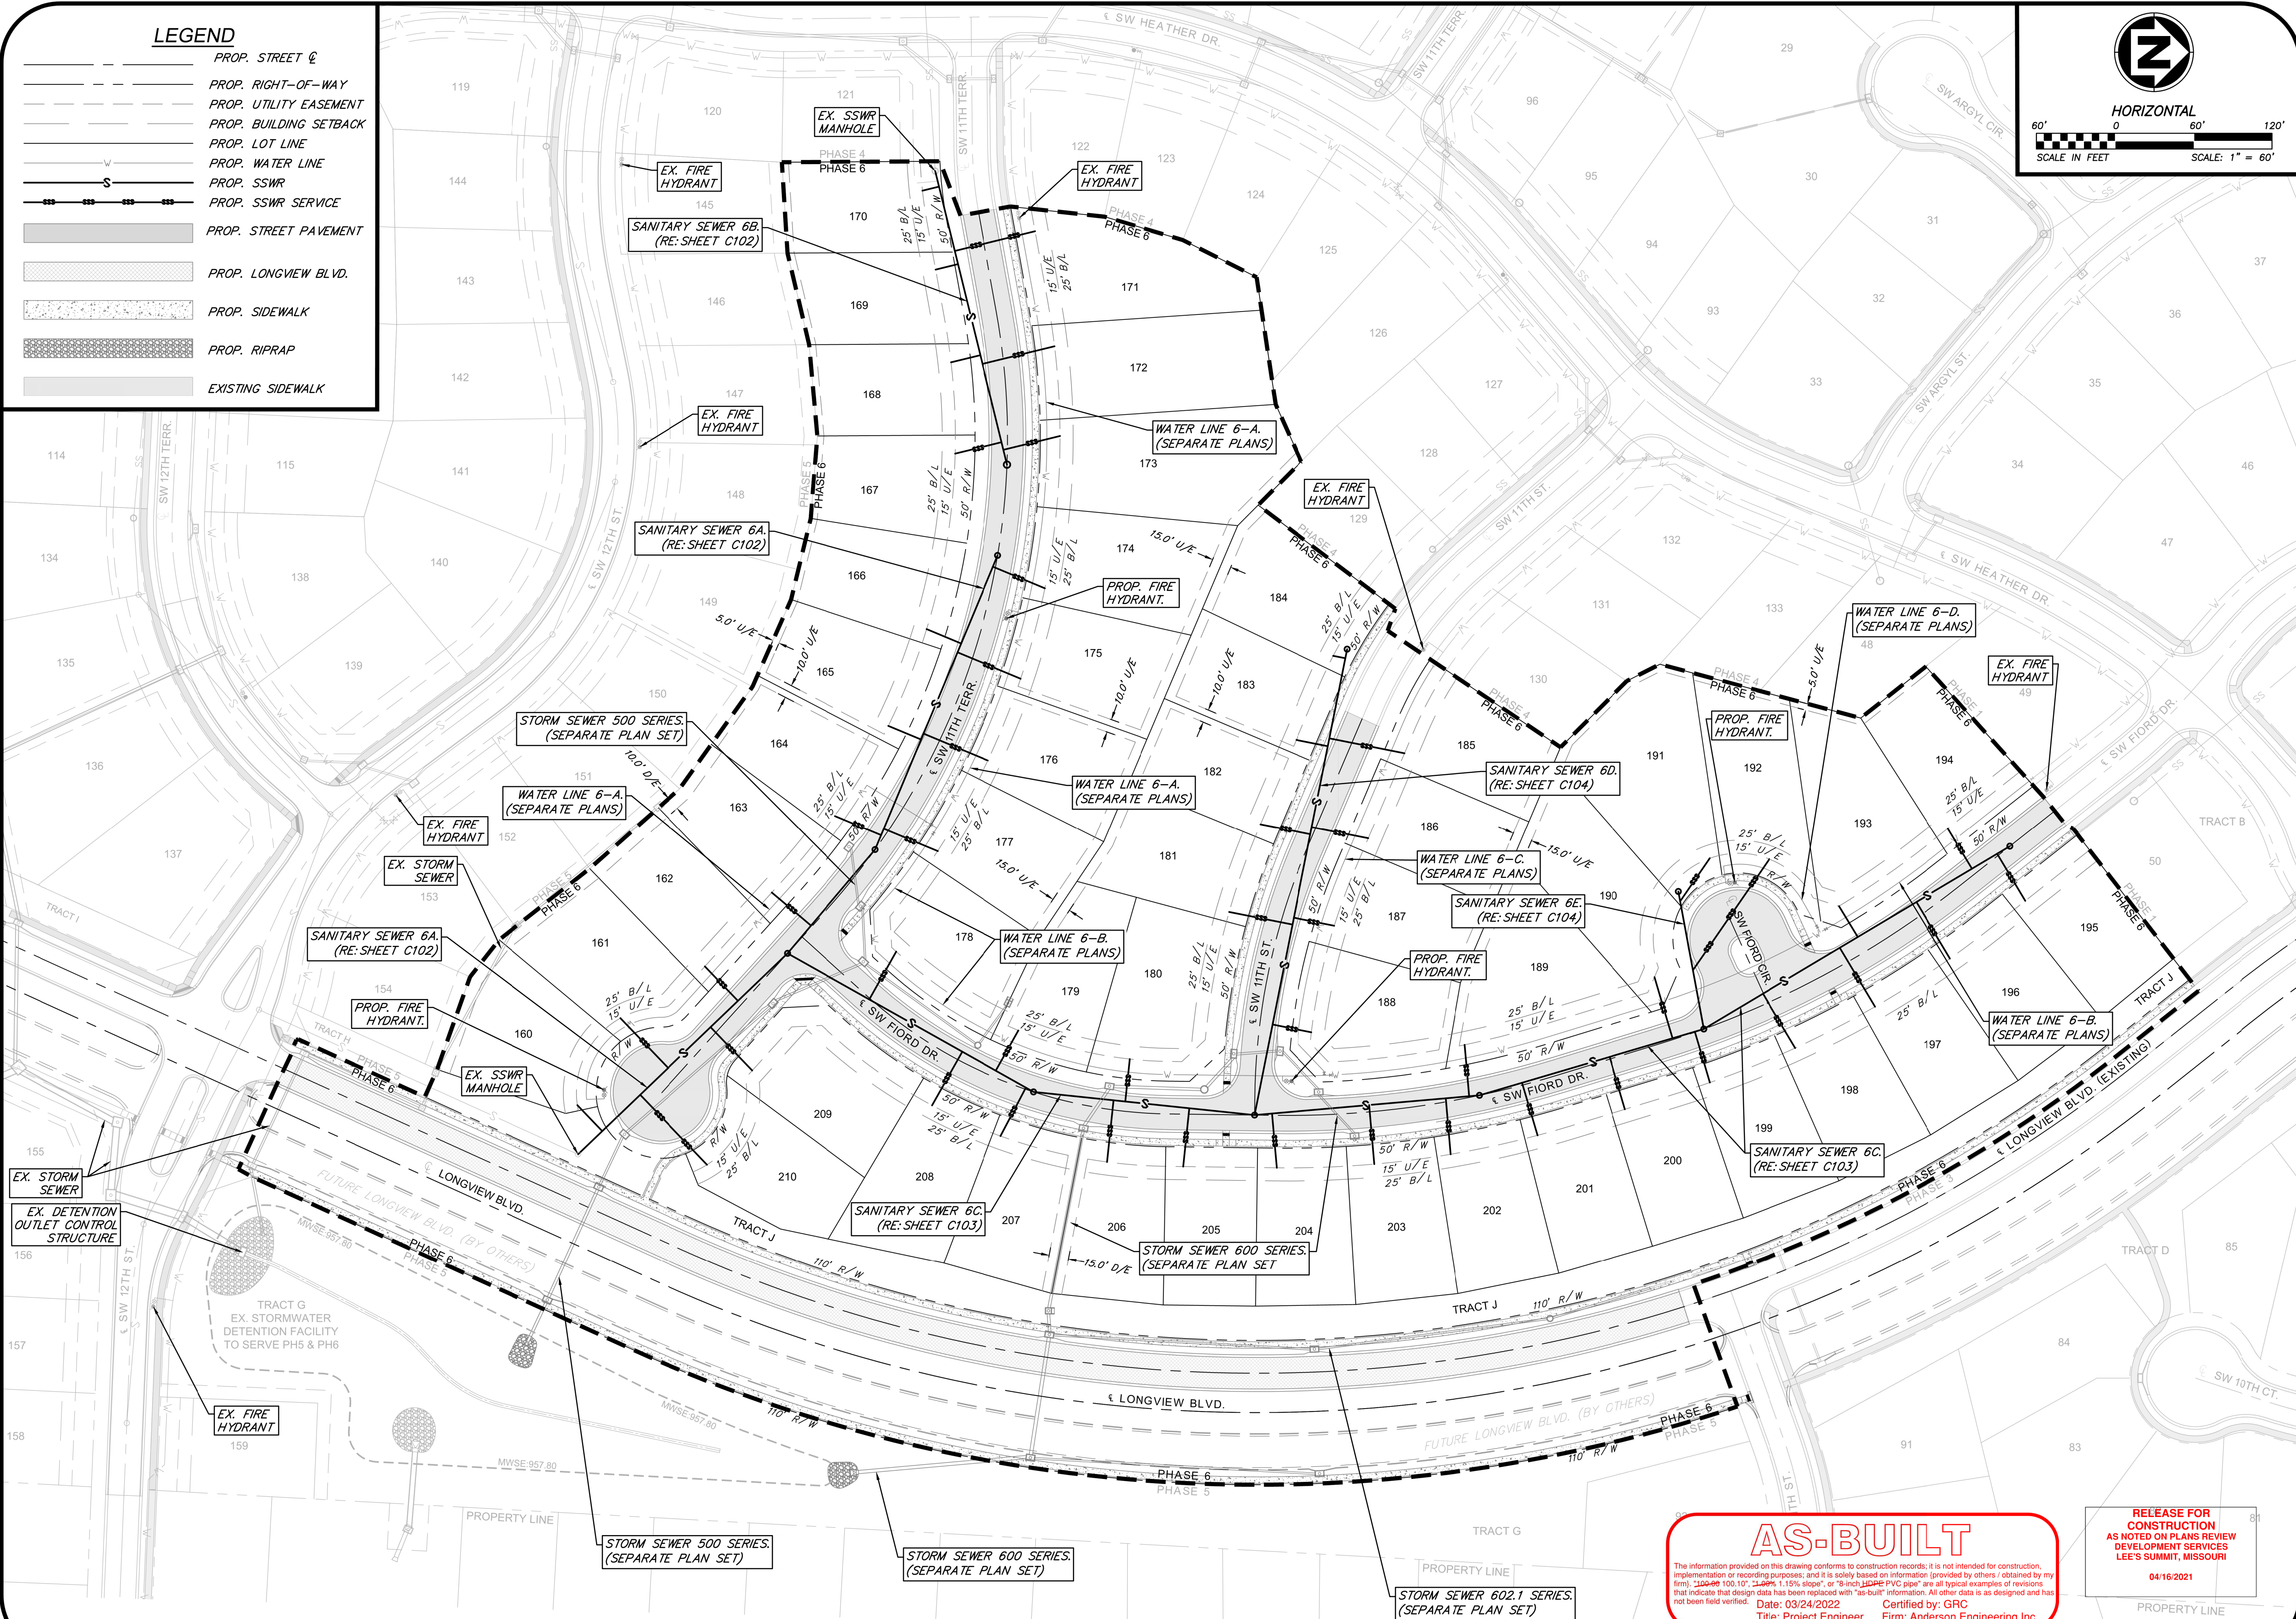

HORIZONTAL
0 60' 120'
SCALE IN FEET SCALE: 1" = 60'

ANDERSON ENGINEERING
EMPLOYEE OWNED

AE

ENGINEERS • SURVEYORS • LABORATORIES • DRILLING
941 W. 141ST TER • KANSAS CITY, MISSOURI 64145 • PHONE (816) 777-0400
A LICENSED MISSOURI ENGINEERING & SURVEYING CORPORATION - LC 62

REVISIONS		DRAWING INFO.	
NO.	DESCRIPTION	BY	DATE
1	REVISED PER CITY COMMENT	GC	2/11/21
2	AS-BUILT DRAWINGS	GC	3/24/22
		CHECK BY:	ZM
		LICENSE NO.	PE-2012009232
		DATE:	1/7/2021
		ISSUED FOR:	FOR REVIEW
		JOB NUMBER:	20K10058
		MO COA NO.	000062

SUMMIT HOMES KC
HIGHLAND MEADOWS - 6TH PLAT

GENERAL LAYOUT

S10, T47N, R22W
LEE'S SUMMIT, JACKSON COUNTY, MISSOURI






SHEET NUMBER
C101
2 OF 6

AS-BUILT


The information provided on this drawing conforms to construction records; it is not intended for construction, implementation or recording purposes; and it is solely based on information provided by others / obtained by my firm. "150-lb 100-10" 24-lb 1.15% slope" or "8-inch 150-lb PVC pipe" are all typical examples of revisions that indicate that design data has been replaced with "as-built" information. All other data is as designed and has not been field verified.
Date: 03/24/2022 Certified by: GRC
Title: Project Engineer Firm: Anderson Engineering Inc.

RELEASE FOR CONSTRUCTION
AS NOTED ON PLANS REVIEW
DEVELOPMENT SERVICES
LEE'S SUMMIT, MISSOURI
04/16/2021

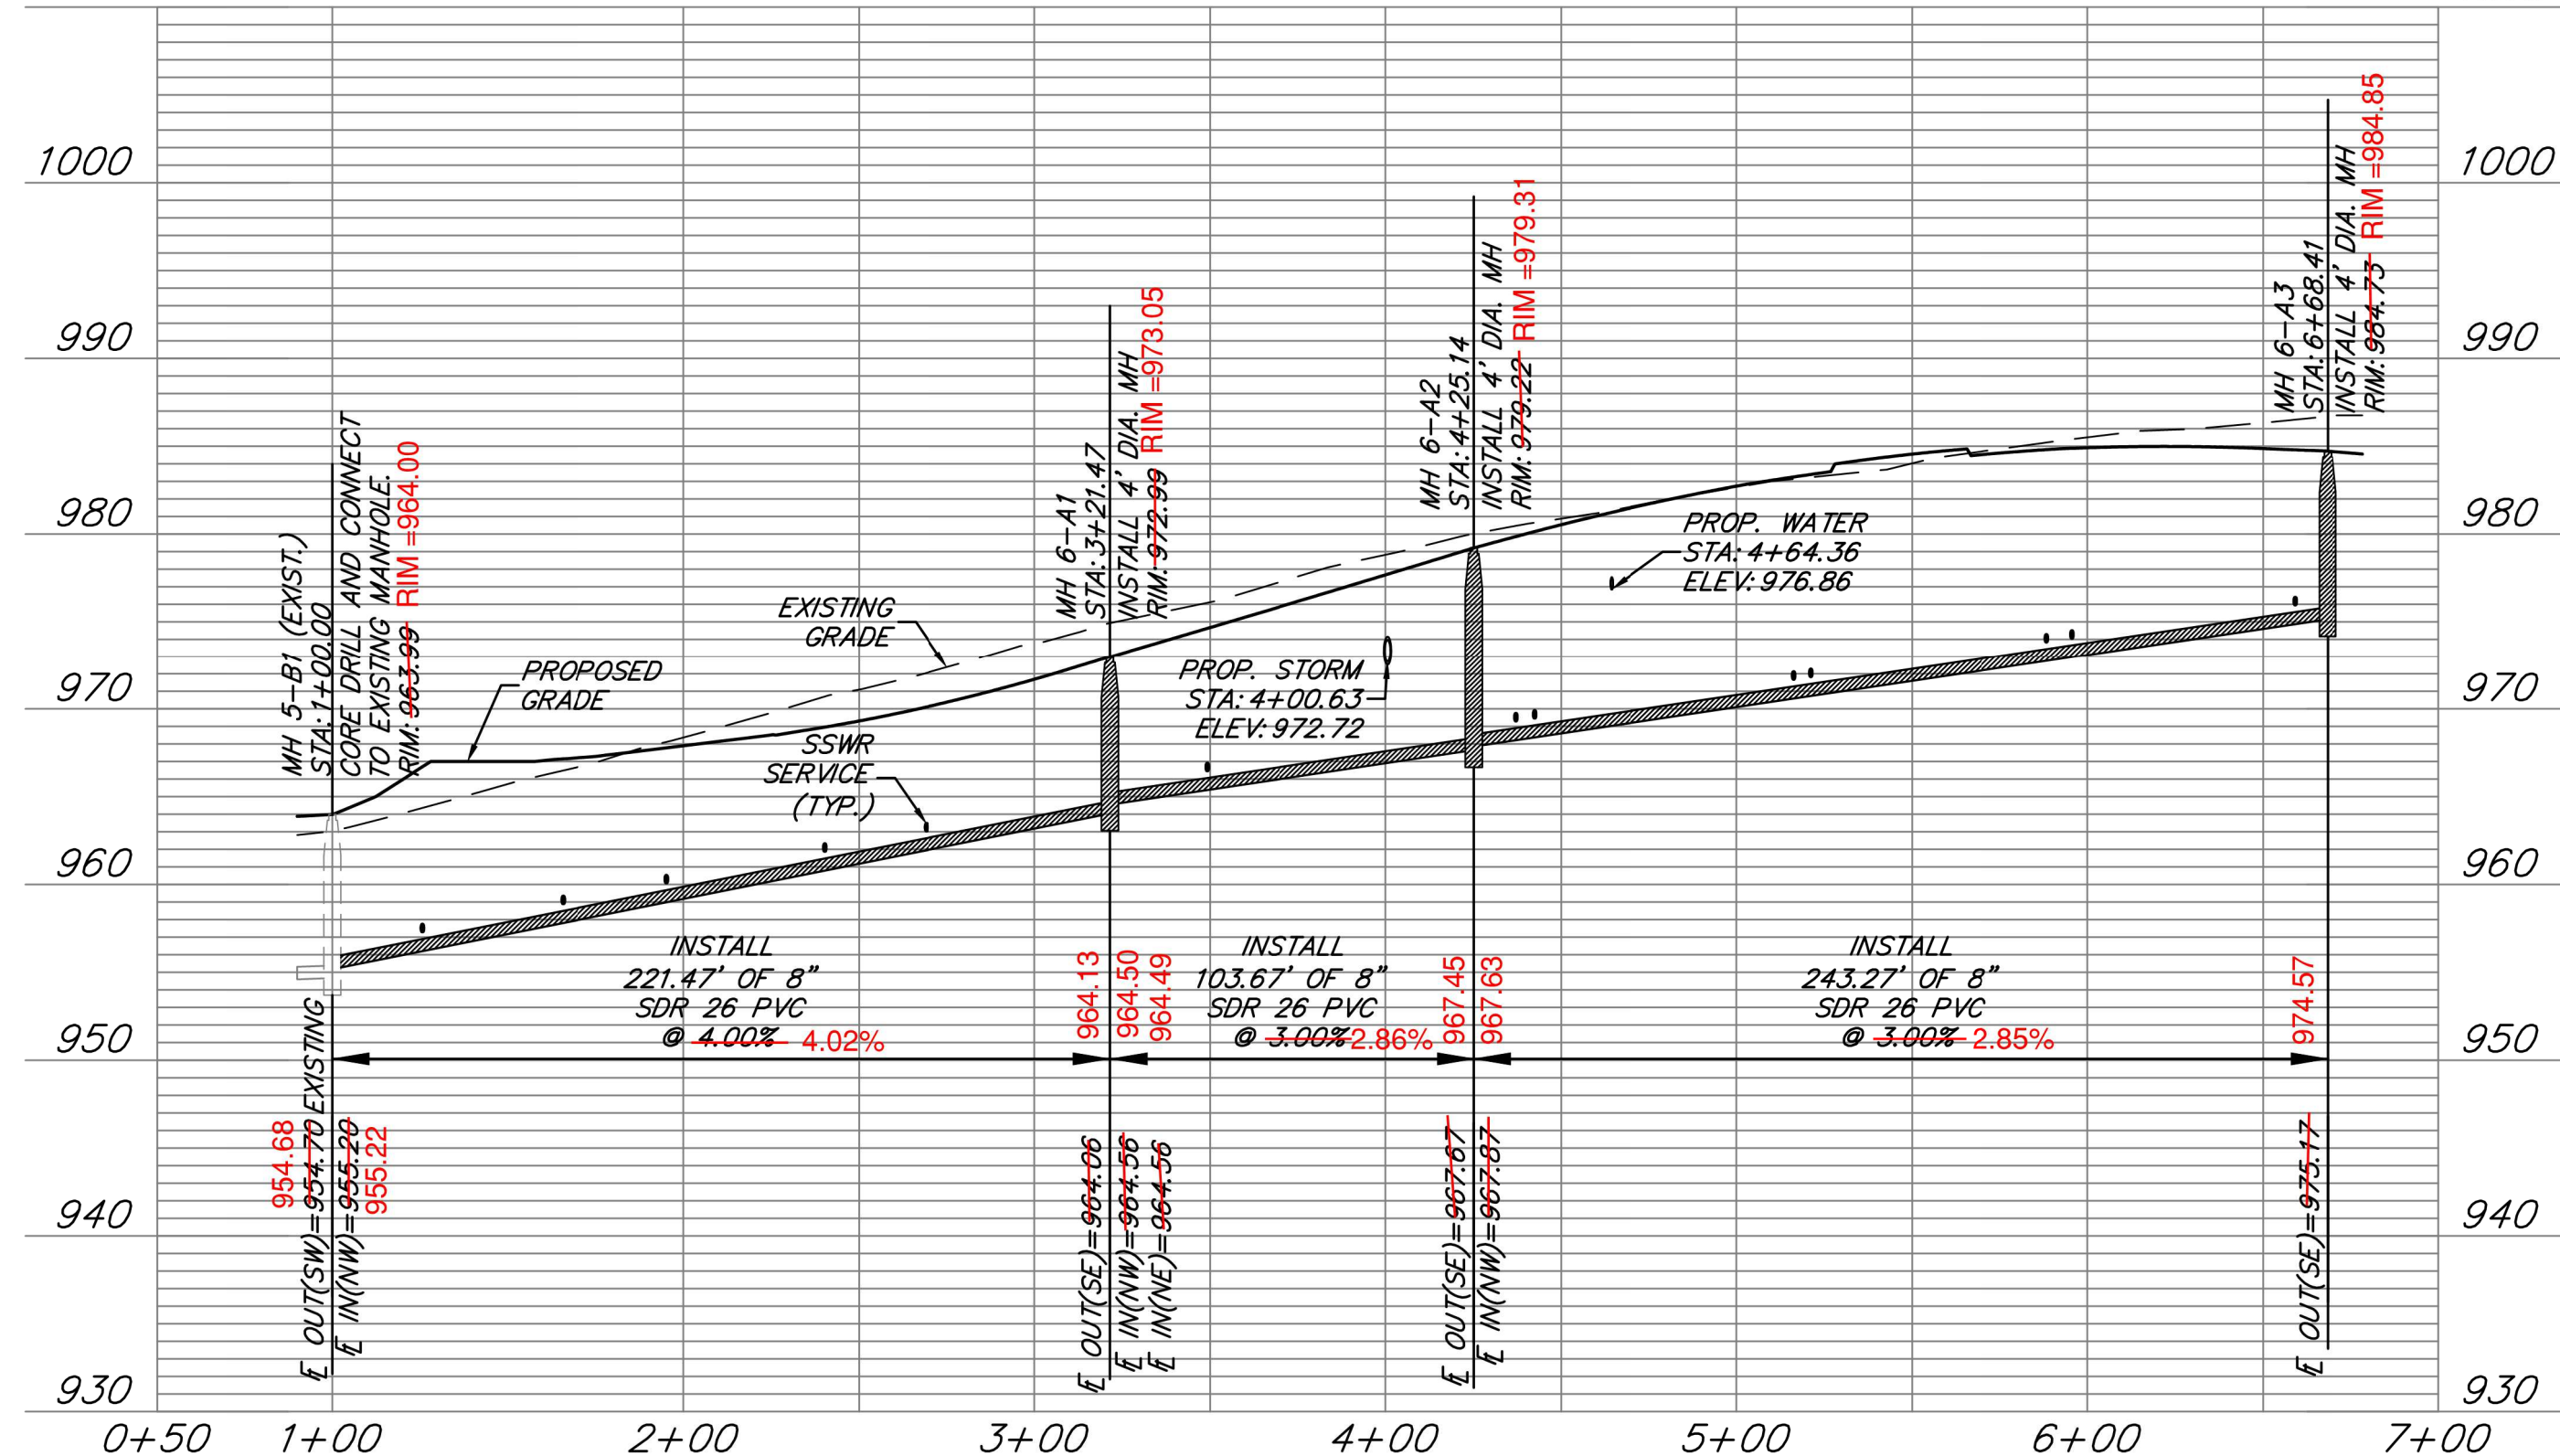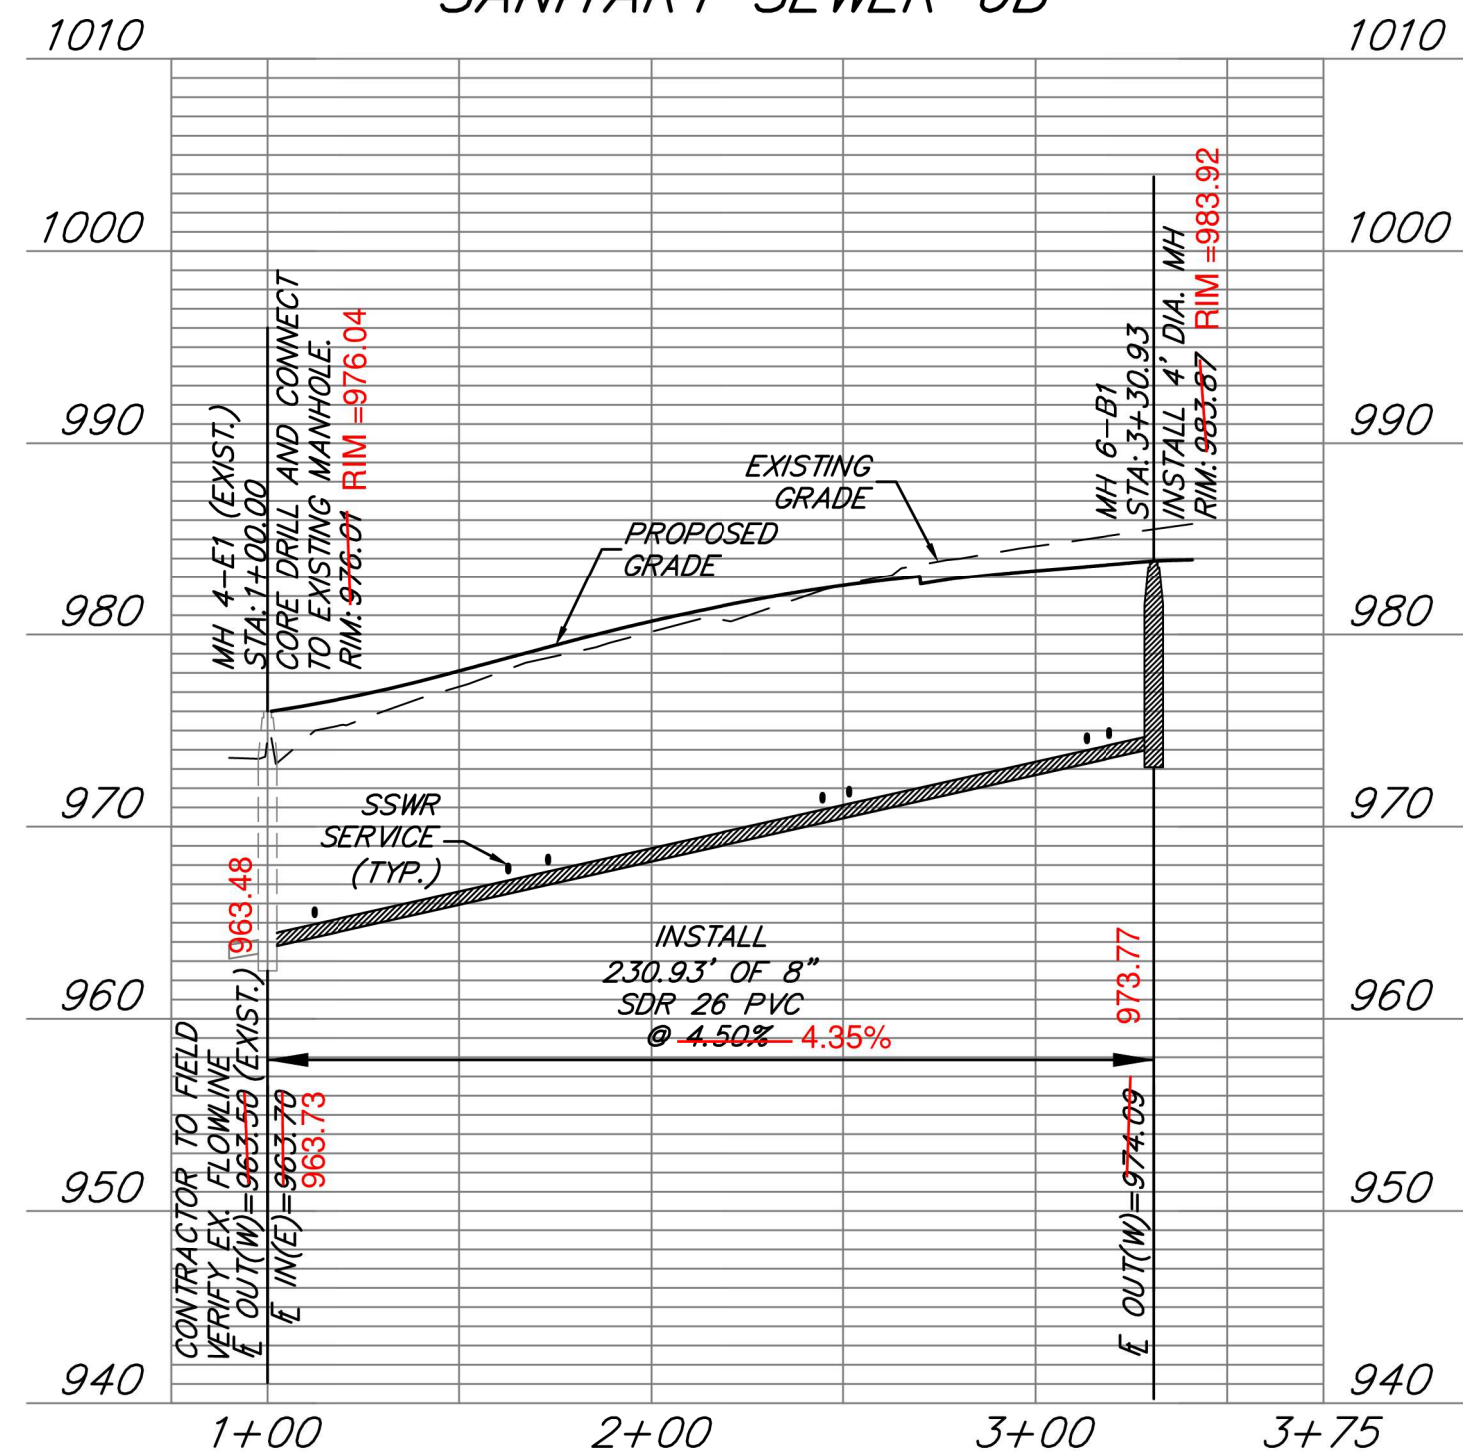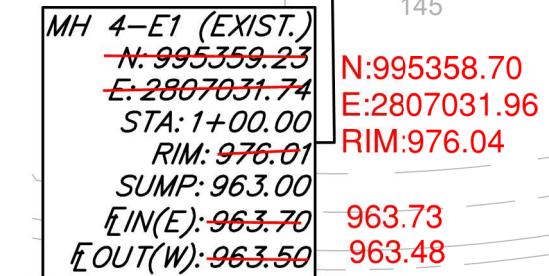

1. PROPOSED MANHOLES SHALL CONFORM TO THE CITY OF LEE'S SUMMIT STANDARD DETAIL.

1. ALL WORK IN PUBLIC EASEMENTS AND RIGHT-OF-WAY AND ALL EROSION CONTROL WORK MUST COMPLY WITH THE LATEST EDITION OF THE TECHNICAL PROVISIONS & STANDARD DRAWINGS FOR ROADS AND SEWERS, OF LEE'S SUMMIT, MISSOURI.
2. WATER MAINS AND SANITARY SEWER MAINS/STRUCTURES SHALL HAVE AT LEAST 10' OF HORIZONTAL SEPARATION FROM EDGE OF WATER PIPE TO EDGE OF SEWER PIPE OR SEWER STRUCTURE.
3. WATER MAINS AND SANITARY SEWERS SHALL HAVE AT LEAST 18" OF VERTICAL SEPARATION FROM EDGE OF PIPE TO EDGE OF PIPE. THE CROSSING SHALL BE ARRANGED SO THAT THE SEWER JOINTS WILL BE EQUIDISTANT AND AS FAR AS POSSIBLE FORM THE WATER MAIN JOINTS.
4. ALL SANITARY SEWER LATERALS SHALL HAVE A TRENCH CHECK, CONSISTING OF FLOWABLE BACKFILL INSTALLED DURING CONSTRUCTION. TRENCH CHECK SHALL EXTEND TO BOTTOM OF TRENCH, TO WIDTH OF TRENCH TO 12 INCHES ABOVE PIPE, AND A MINIMUM LENGTH OF 12 INCHES. TRENCH CHECK SHALL BE LOCATED AT LEAST 5 FEET FROM SANITARY SEWER MAIN.
5. ALL SANITARY SEWER LATERALS SHALL BE 4" PVC AND MAINTAIN A MINIMUM 2.0% SLOPE. REFER TO SANITARY SEWER DETAILS SHEET FOR BUILDING CONNECTION AND RISER DETAILS.

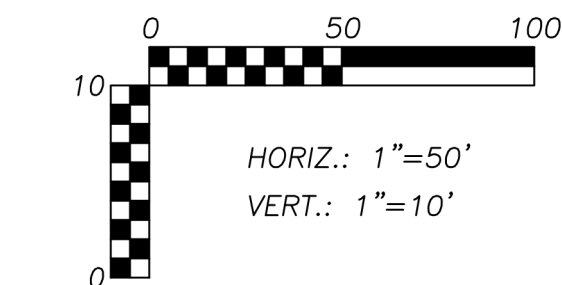

The information provided on this drawing conforms to construction records; it is not intended for construction, implementation or recording purposes; and it is solely based on information provided by others / obtained by my firm. ~~100% 100.10% 1.00% 1.15% slope, or "8-inch HDPE PVC pipe"~~ are all typical examples of revisions that indicate that design data has been replaced with "as-built" information. All other data is as designed and has not been field verified.

Date: 03/24/2022 Certified by: GRC
 Title: Project Engineer Firm: Anderson Engineering Inc.

**RELEASE FOR
CONSTRUCTION
AS NOTED ON PLANS REVIEW
DEVELOPMENT SERVICES
LEE'S SUMMIT, MISSOURI
04/16/2021**

REVIEWS			DRAWING INFO.	
NO.	DESCRIPTION	BY	DATE	
1	REVISED PER CITY COMMENT	GC	2/11/21	DRAWN BY: GC
2.	AS-BUILT DRAWINGS	GC	3/24/22	CHECK BY: ZM
				LICENSE NO. PE-2012089232
				DATE: 1/7/2021
				ISSUED FOR: FOR REVIEW
				JOB NUMBER: 20KCI10058
				MO COA NO. 000062

© COPYRIGHT ANDERSON ENGINEERING, INC. 2020

SUMMIT HOMES KC
HIGHLAND MEADOWS - 6TH PLAT

SANITARY SEWER 6A AND 6B
PLAN & PROFILE


S10, T47N, R32W

S10, 147N, R32W
LEE'S SUMMIT, JACKSON COUNTY, MISSOURI



C102
3 OF 6

Feb 11, 2021 - 2:56pm Plotted By: gpc
G:\Shared drives\VCIO - Land Development\Projects\2020\20K10058 Highland Meadows - 6th Plat\01 CIV\03-DWG\Sheet\SANITARY SEWER 6C PLAN & PROFILE Layout SANITARY SEWER 6C PLAN & PROFILE

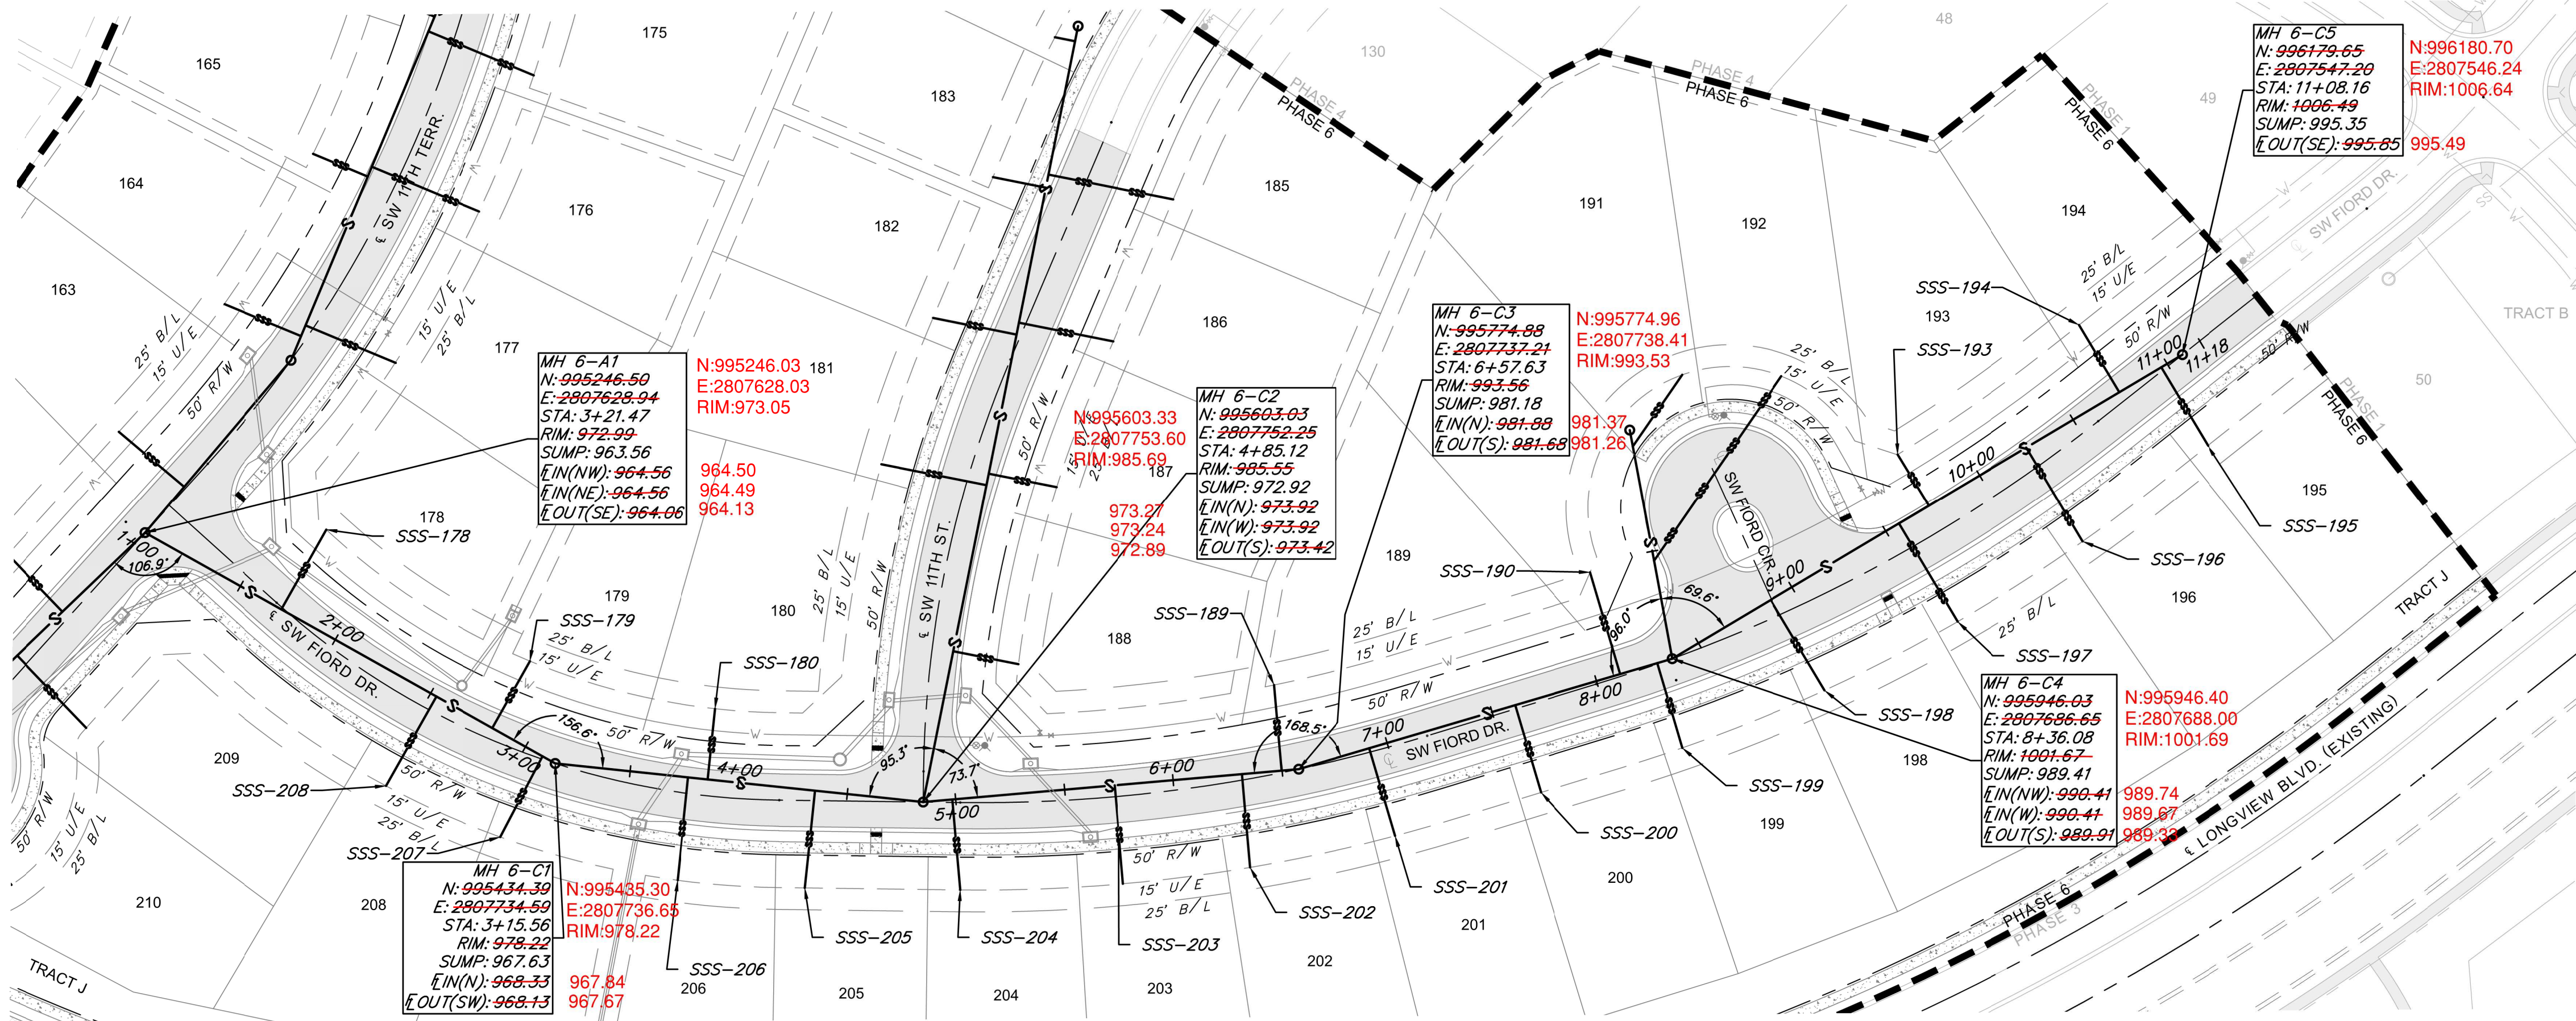


MANHOLE STRUCTURE NOTE:

1. PROPOSED MANHOLES SHALL CONFORM TO THE CITY OF LEE'S SUMMIT STANDARD DETAIL.

GENERAL NOTES:


1. ALL WORK IN PUBLIC EASEMENTS AND RIGHT-OF-WAY AND ALL EROSION CONTROL WORK MUST COMPLY WITH THE LATEST EDITION OF THE TECHNICAL PROVISIONS & STANDARD DRAWINGS FOR ROADS AND SEWERS, OF LEE'S SUMMIT, MISSOURI.
2. WATER MAINS AND SANITARY SEWER MAINS/STRUCTURES SHALL HAVE AT LEAST 10' OF HORIZONTAL SEPARATION FROM EDGE OF WATER PIPE TO EDGE OF SEWER PIPE OR SEWER STRUCTURE.
3. WATER MAINS AND SANITARY SEWERS SHALL HAVE AT LEAST 18" OF VERTICAL SEPARATION FROM EDGE OF PIPE TO EDGE OF PIPE. THE CROSSING SHALL BE ARRANGED SO THAT THE SEWER JOINTS WILL BE EQUIDISTANT AND AS FAR AS POSSIBLE FORM THE WATER MAIN JOINTS.
4. ALL SANITARY SEWER LATERALS SHALL HAVE A TRENCH CHECK, CONSISTING OF FLOWABLE BACKFILL INSTALLED DURING CONSTRUCTION. TRENCH CHECK SHALL EXTEND TO BOTTOM OF TRENCH, TO WIDTH OF TRENCH TO 12 INCHES ABOVE PIPE, FOR A MINIMUM LENGTH OF 12 INCHES. TRENCH CHECK SHALL BE LOCATED AT LEAST 5 FEET FROM SANITARY SEWER MAIN.
5. ALL SANITARY SEWER LATERALS SHALL BE 4" PVC AND MAINTAIN A MINIMUM 2.0% SLOPE. REFER TO SANITARY SEWER DETAILS SHEET FOR BUILDING CONNECTION AND RISER DETAILS.

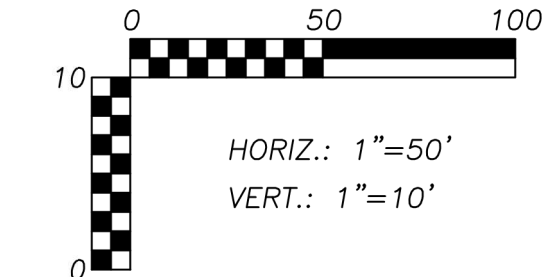

AS-BUILT

The information provided on this drawing conforms to construction records; it is not intended for construction, implementation or recording purposes, and it is solely based on information provided by others (obtained by my firm). "AS-BUILT" 100' 10" 1:400, 1:150 slope, or 3/4 inch JUDGE PVC pipe are all typical examples of revisions that indicate that design data has been replaced with "as-built" information. All other data is as designed and has not been field verified.
Date: 03/24/2022 Certified by: GRC
Title: Project Engineer Firm: Anderson Engineering Inc.

SANITARY SEWER 6C

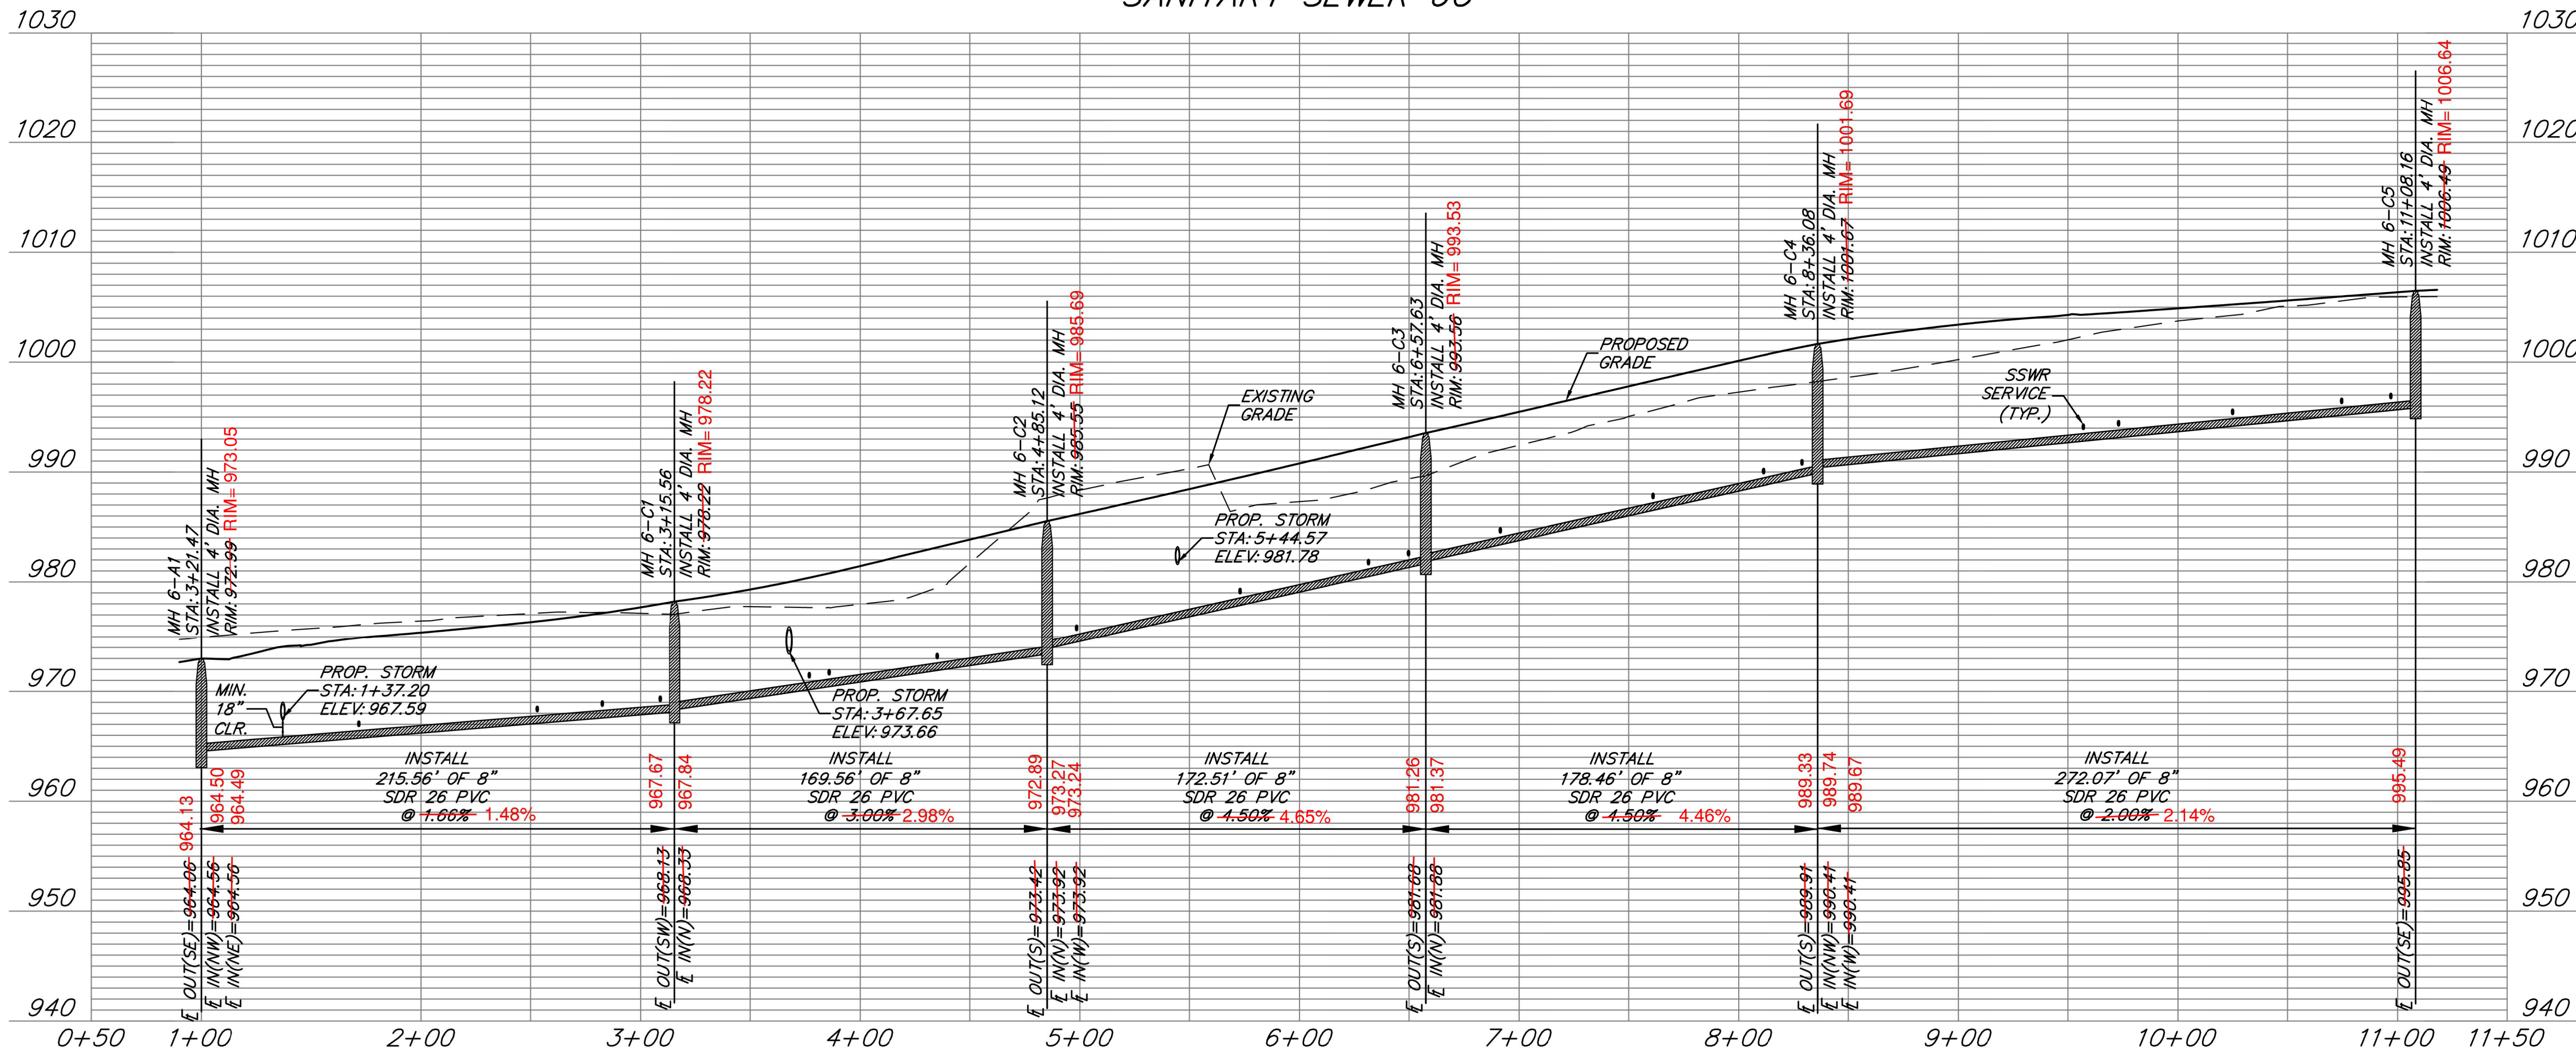

Sewer laterals were constructed per plan as indicated by Redford Construction

SANITARY SEWER SERVICE				
PIPE NAME	STATION	LENGTH	SLOPE	MSFE
SSS-202	6+31.56	43'	2.00%	982.50+(3.5')
SSS-203	5+72.98	45'	2.00%	979.91+(3.5')
SSS-204	4+98.48	42'	2.00%	976.49+(3.5')
SSS-205	4+35.16	45'	2.00%	973.95+(3.5')
SSS-206	3+76.82	47'	2.00%	972.25+(3.5')
SSS-178	1+71.73	42'	2.00%	967.72+(3.5')
SSS-179	2+82.56	35'	2.00%	969.42+(3.5')
SSS-189	6+49.75	39'	2.00%	983.25+(3.5')
SSS-190	8+11.25	49'	2.00%	990.90+(3.5')
SSS-193	9+72.97	28'	2.00%	994.83+(3.5')
SSS-194	10+74.56	36'	2.00%	997.03+(3.5')
SSS-195	10+96.89	42'	2.00%	997.60+(3.5')
SSS-180	3+85.84	33'	2.00%	972.22+(3.5')
SSS-196	10+25.02	50'	2.00%	996.33+(3.5')
SSS-197	9+56.99	52'	2.00%	995.01+(3.5')
SSS-198	8+91.89	44'	2.00%	993.90+(3.5')
SSS-199	8+28.94	40'	2.00%	991.53+(3.5')
SSS-200	7+61.05	42'	2.00%	988.50+(3.5')
SSS-201	6+91.43	42'	2.00%	985.37+(3.5')
SSS-207	3+08.89	42'	2.00%	969.99+(3.5')
SSS-208	2+53.01	47'	2.00%	969.17+(3.5')

RELEASE FOR CONSTRUCTION
AS NOTED ON PLANS REVIEW
DEVELOPMENT SERVICES
LEE'S SUMMIT, MISSOURI
04/16/2021

ANDERSON ENGINEERING
EMPLOYEE OWNED

ENGINEERS • SURVEYORS • LABORATORIES • DRILLING
941 W. 141ST TER • KANSAS CITY, MISSOURI 64145 • PHONE (816) 777-0400
A LICENSED MISSOURI ENGINEERING & SURVEYING CORPORATION - LC 62

DRAWING INFO.				
NO.	DESCRIPTION	DATE	DRAWN BY:	CHECK BY:
1	REVISED PER CITY COMMENT	2/11/21	GC	ZM
2	AS-BUILT DRAWINGS	3/24/22	GC	GC
		DATE:	ISSUED FOR:	FOR REVIEW
		JOB NUMBER:	20K10058	
		MO COA NO.:	00062	

© COPYRIGHT ANDERSON ENGINEERING, INC. 2020

SUMMIT HOMES KC
HIGHLAND MEADOWS - 6TH PLAT

SANITARY SEWER 6C PLAN & PROFILE

S10, T47N, R22W
LEE'S SUMMIT, JACKSON COUNTY, MISSOURI

STATE OF MISSOURI
ZACH A. MYERS
REGISTERED PROFESSIONAL ENGINEER
NUMBER: PE-2012009232
2/11/21

SHEET NUMBER
C103
4 OF 6

Sanitary Sewer Profile Diagram

Vertical Axis (Elevation): 940 to 1020 feet.

Horizontal Axis (Stationing): 0+50 to 5+00.

Key Features and Data:

- Manhole 6-C2 (Station 1+00):**
 - INSTALL 4" DIA. MH
 - STA: 1+00.12
 - RIM: 985.65
 - RIM = 985.69
- Proposed Water Line:**
 - STA: 1+20.51
 - ELEV: 981.61
- Proposed Storm Line:**
 - STA: 1+39.14
 - ELEV: 978.63
- Minimum Clearance:** 18" CLR.
- SSWR Service (Typ.)**
- Manhole 6-D1 (Station 4+53.27):**
 - INSTALL 4" DIA. MH
 - STA: 4+53.27
 - RIM: 984.24
 - RIM = 984.32
- Proposed Sewer Line Details:**
 - 362.53' OF 8" SDR 26 PVC
 - 3.00% to 3.21%
- Elevation Data at Station 1+00:**
 - E. OUT(S) = 973.42
 - E. IN(S) = 973.27
 - E. IN(W) = 973.24
- Elevation Data at Station 4+53.27:**
 - E. OUT(E) = 984.80
 - E. IN(E) = 984.86

Profile view of a sewer line showing existing and proposed grades, manhole details, and elevations.

Left Manhole (Station 0+50):

- MH 6-CA
- INSTALL 4" DIA. MH
- RIM: 1000.67
- RIM = 1001.69
- ℓ OUT(S) = 999.91
- ℓ IN(W) = 990.47
- ℓ IN(W) = 990.47

Right Manhole (Station 2+00):

- MH 6-EI
- INSTALL 4" DIA. MH
- STA: 2+06.87
- RIM: 1005.43
- RIM = 1005.31
- ℓ OUT(E) = 993.64
- 993.35

Proposed Grade and Slope:

- PROPOSED GRADE
- EXISTING GRADE
- PROP. WATER STA: 1+30.44 ELEV: 997.88
- SSWR SERVICE (TYP.)
- INSTALL 106.67' OF 8" SDR 26 PVC @ 3.00% 3.45%

Elevations (Left to Right):

- 1030
- 1020
- 1010
- 1000
- 990
- 980
- 970
- 960


Stationing (Bottom):

- 0+50
- 1+00
- 2+00
- 2+50

REVIEWS				DRAWING INFO.	
NO.	DESCRIPTION	BY	DATE	DRAWN BY:	
1	REVISED PER CITY COMMENT	GC	2/11/21	CHECK BY:	ZM
2.	AS-BUILT DRAWINGS	GC	3/24/22	LICENSE NO.	PE-2012089232
				DATE:	1/7/2021
				ISSUED FOR:	FOR REVIEW
				JOB NUMBER:	20KCI 0058
				MO COA NO.	000062

© COPYRIGHT ANDERSON ENGINEERING, INC. 2020

SANTITARY SEWER 6D AND 6E
PLAN & PROFILE

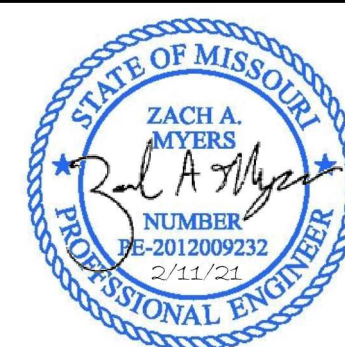

C104
5 OF 6

S10, 147N, R32W
LEE'S SUMMIT, JACKSON COUNTY, MISSOURI

The information provided on this drawing conforms to construction records; it is not intended for construction, implementation or recording purposes; and it is solely based on information provided by others / obtained by my firm). ~~100.00~~ 100.10, ~~1.00%~~ 1.15% slope", or "8-inch ~~ADPE~~ PVC pipe" are all typical examples of revisions that indicate that design data has been replaced with "as-built" information. All other data is as designed and has not been field verified.

Date: 03/24/2022 Certified by: GRC
Title: Project Engineer Firm: Anderson Engineering Inc.

04/16/2023

