



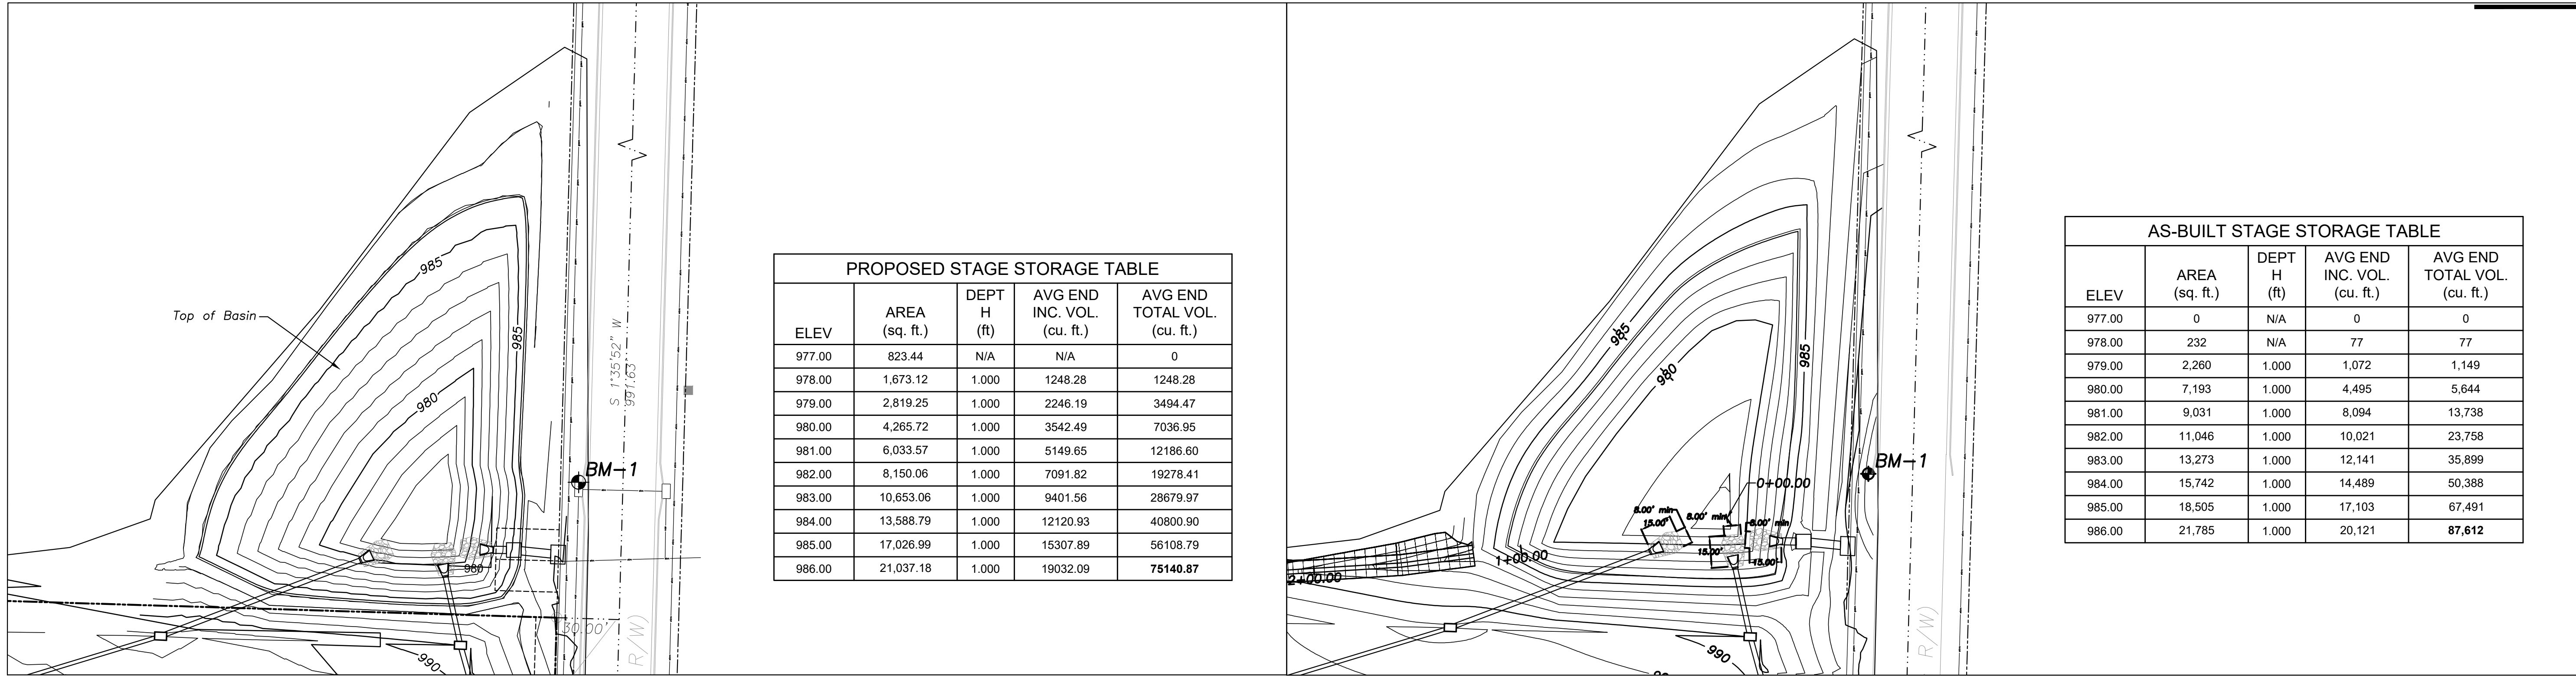

PROPOSED STAGE STORAGE TABLE				
ELEV	AREA (sq. ft.)	DEPT H (ft)	AVG END INC. VOL. (cu. ft.)	AVG END TOTAL VOL. (cu. ft.)
977.00	823.44	N/A	N/A	0
978.00	1,673.12	1.000	1248.28	1248.28
979.00	2,819.25	1.000	2246.19	3494.47
980.00	4,265.72	1.000	3542.49	7036.95
981.00	6,033.57	1.000	5149.65	12186.60
982.00	8,150.06	1.000	7091.82	19278.41
983.00	10,653.06	1.000	9401.56	28679.97
984.00	13,588.79	1.000	12120.93	40800.90
985.00	17,026.99	1.000	15307.89	56108.79
986.00	21,037.18	1.000	19032.09	75140.87

AS-BUILT STAGE STORAGE TABLE				
ELEV	AREA (sq. ft.)	DEPT H (ft)	AVG END INC. VOL. (cu. ft.)	AVG END TOTAL VOL. (cu. ft.)
977.00	0	N/A	0	0
978.00	232	N/A	77	77
979.00	2,260	1.000	1,072	1,149
980.00	7,193	1.000	4,495	5,644
981.00	9,031	1.000	8,094	13,738
982.00	11,046	1.000	10,021	23,758
983.00	13,273	1.000	12,141	35,899
984.00	15,742	1.000	14,489	50,388
985.00	18,505	1.000	17,103	67,491
986.00	21,785	1.000	20,121	87,612

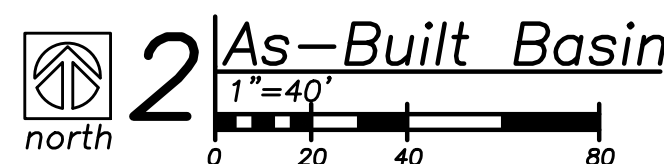

Linetypes

---	sanitary main
---	sanitary service
---	storm sewer (existing)
---	storm sewer (solid wall, proposed)
---	storm sewer (solid wall, proposed)
---	storm sewer (perforated, proposed)
---	water main
---	water service (fire)
---	water service (domestic)
---	water service (irrigation)
---	natural gas main
---	natural gas service schematic
---	underground primary electric
---	underground secondary electric
---	overhead electric
---	underground cable/phone/data
---	underground cable/phone/data service
---	fence-chainlink
---	fence-wood
---	fence-barbed wire
---	treeline

Symbols

⊙	sanitary manhole
⊙	service cleanout
⊙	force main release valve
⊙	rectangular structure
⊙	circular structure
⊙	fire hydrant
⊙	water valve
⊙	water meter
⊙	backflow preventer
⊙	natural gas meter
⊙	service transformer (pad mount)
⊙	primary switch gear
⊙	light pole
⊙	cable/phone/data junction box
⊙	street light
⊙	pedestrian street light
⊙	electric pole
⊙	guy wire
⊙	end section

Local Benchmarks:

BM-1: Storm Structure, Manhole Cover
Elevation: 983.62'
N: 1013823.1758
E: 2827361.8695

BM-2: Storm Structure, Manhole Cover
Elevation: 1001.21'
N: 1013384.7454
E: 2827199.0101

Grading Legend


---	existing minor contour
---	existing major contour
---	proposed minor contour
---	proposed major contour

Utility Legend

---	existing
---	proposed

Property Legend

---	right of way
---	property lines
---	easements
---	setbacks

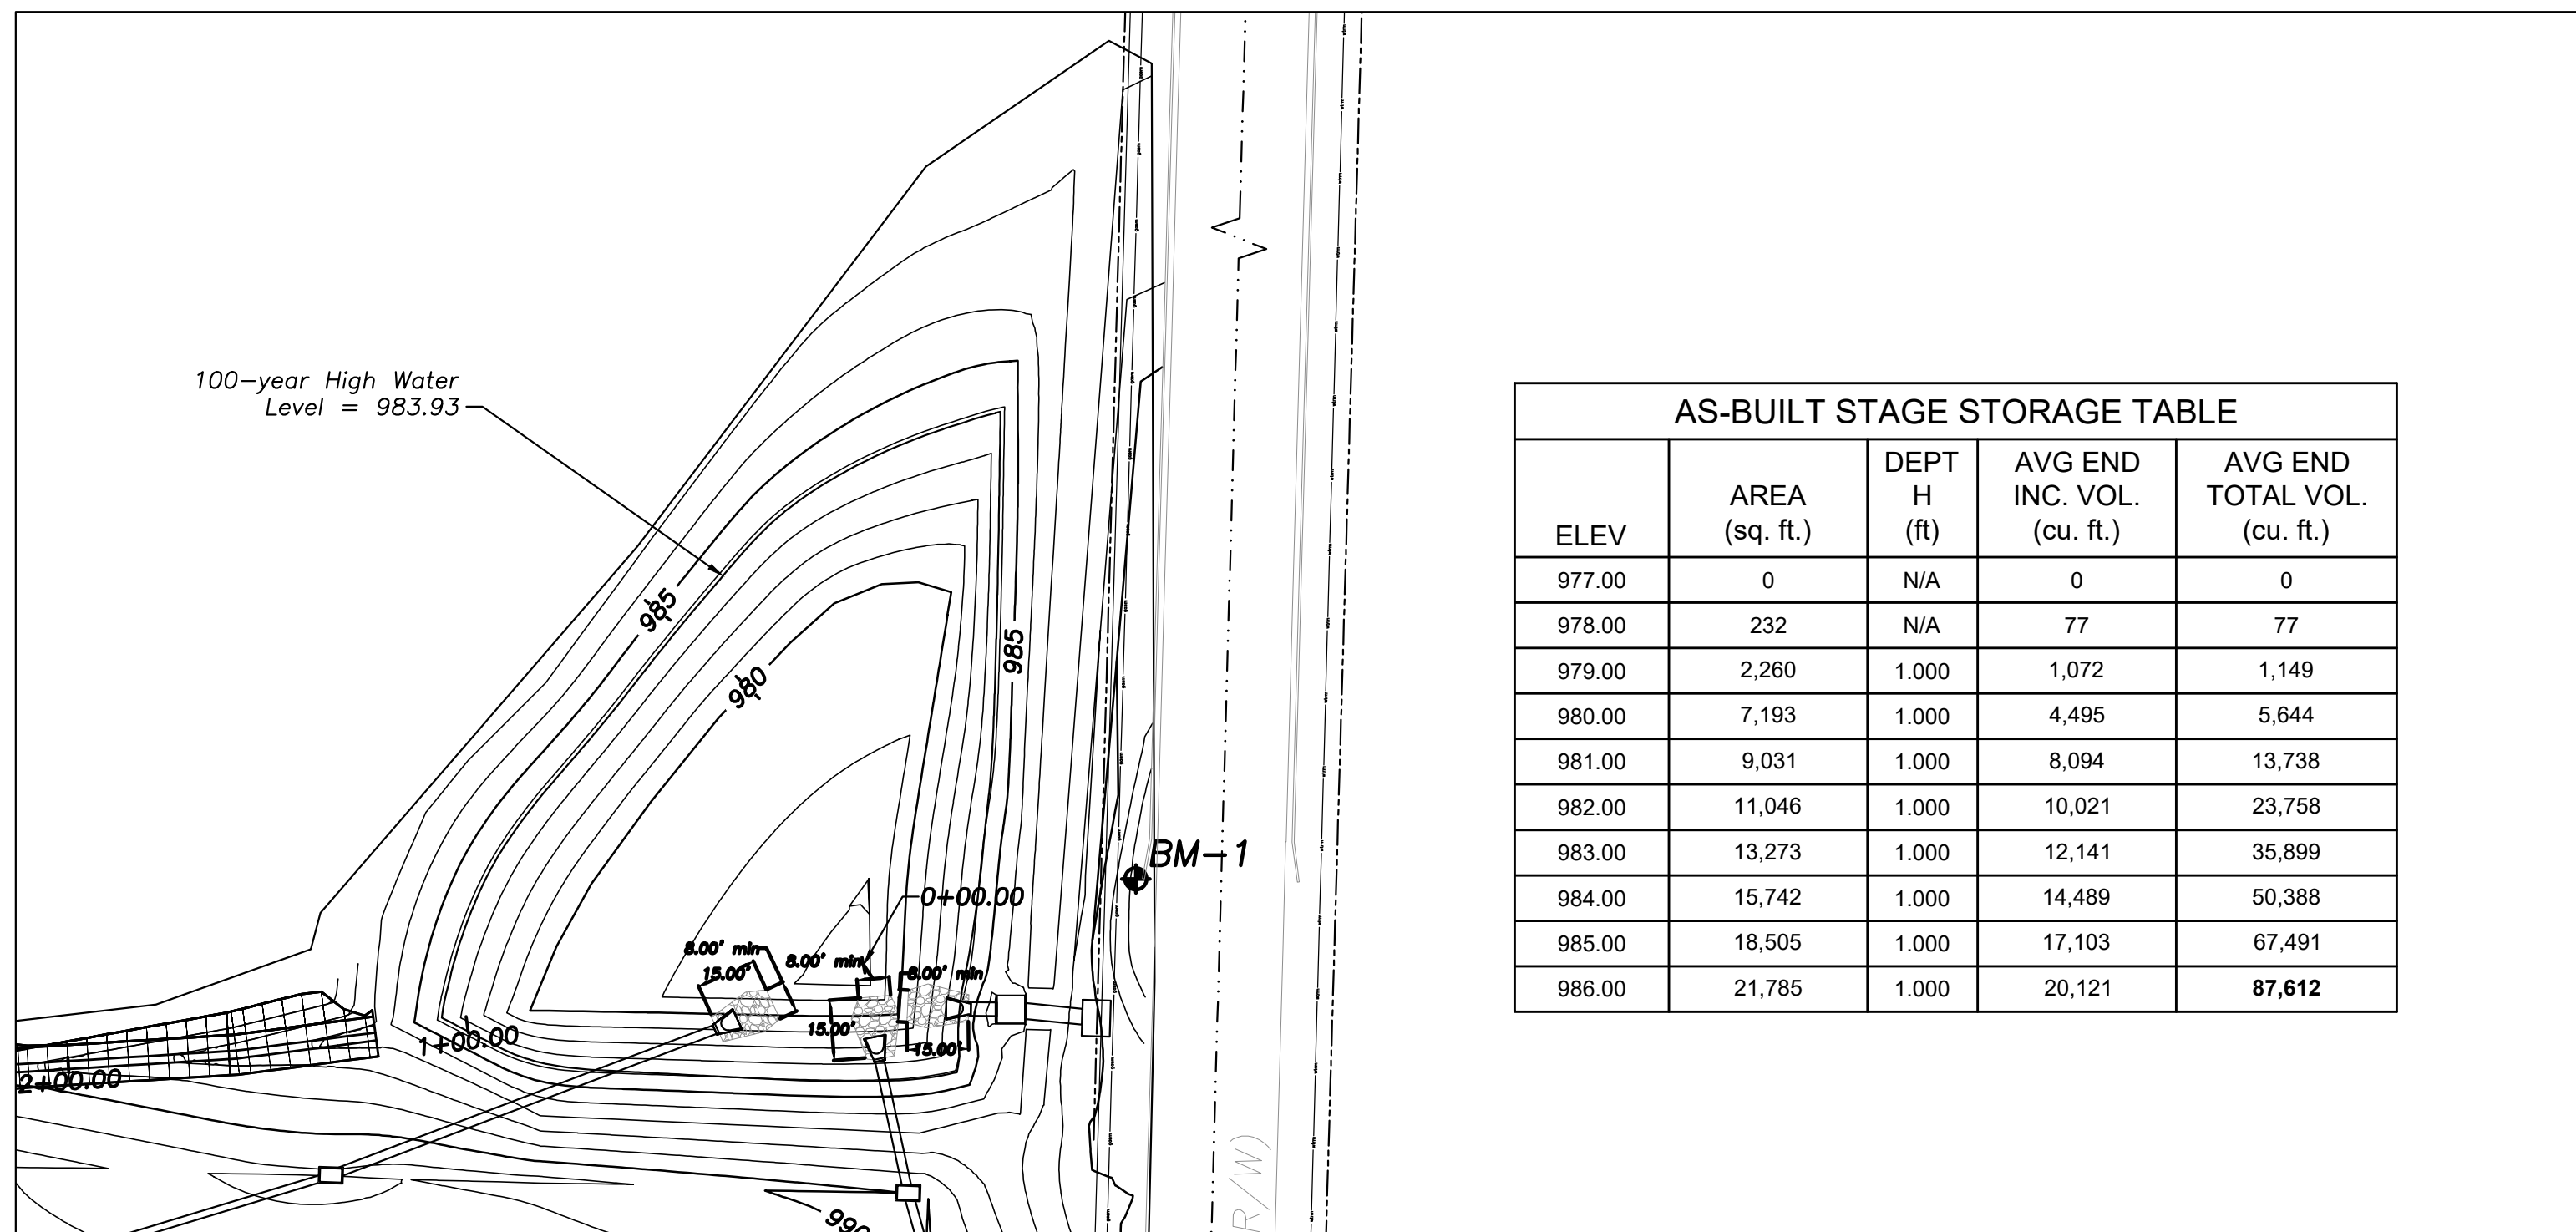

AS-BUILT STAGE STORAGE TABLE				
ELEV	AREA (sq. ft.)	DEPT H (ft)	AVG END INC. VOL. (cu. ft.)	AVG END TOTAL VOL. (cu. ft.)
977.00	0	N/A	0	0
978.00	232	N/A	77	77
979.00	2,260	1.000	1,072	1,149
980.00	7,193	1.000	4,495	5,644
981.00	9,031	1.000	8,094	13,738
982.00	11,046	1.000	10,021	23,758
983.00	13,273	1.000	12,141	35,899
984.00	15,742	1.000	14,489	50,388
985.00	18,505	1.000	17,103	67,491
986.00	21,785	1.000	20,121	87,612

