


WATER LINE GENERAL LAYOUT
SCALE: 1" = 20'

NOTE:
WATER MAINS SHALL NOT EXCEED
7 FEET IN DEPTH AS MEASURED
TO THE TOP OF THE PIPE.

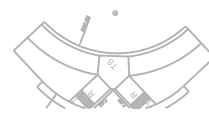


**Accepted
Record Drawings**

These plans have been reviewed for accuracy and are accepted for basic conformance to the approved construction drawings.

RECORD DRAWING
The information provided on this drawing conforms to construction records; it is not intended for construction, implementation or recording purposes; and it is solely based on information obtained by my firm.

"100-00 100.10", "4-00% 1.15% slope", or "8-inch HDPE-PVC pipe" are all typical examples of revisions that indicate that design data has been replaced with "as-built" information. All other data is as designed and has not been field verified.

Date: 6/2/2022
Certified by: Matthew J. Schlicht
Title: Engineer
Firm: Engineering Solutions

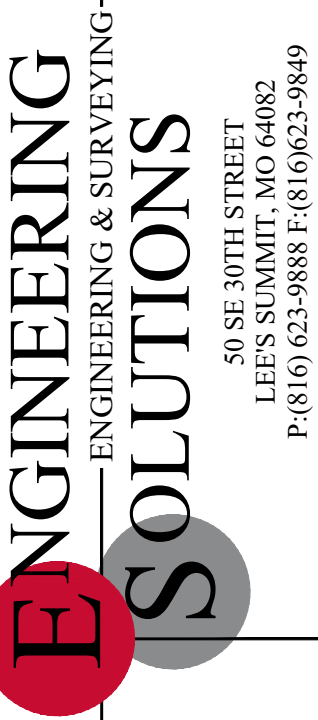


Professional Registration
Missouri
Engineering 2005002186-D
Surveying 2005008319-D
Kansas
Engineering E-1695
Surveying LS-218
Oklahoma
Engineering 6254
Nebraska
Engineering CA2821

PARK RIDGE 8TH PLAT
Section 9, Township 48 North, Range 31 West
Lee's Summit, Jackson County, Missouri




Project: PARK RIDGE
Issue Date: March 17, 2021

**Water Line General Layout
PARK RIDGE 8TH PLAT**
Section 9, Township 48 North, Range 31 West
Lee's Summit, Jackson County, Missouri

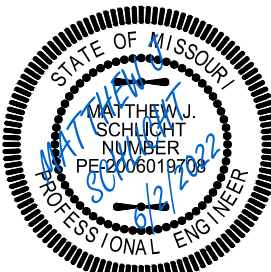



Matthew J. Schlicht
MO PE 0006019708
KS PE 19071
OK PE 25226
NE PE E-14335

REVISIONS
6/2/2022 As-Built

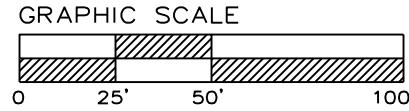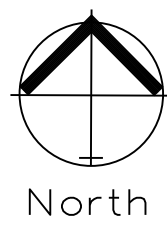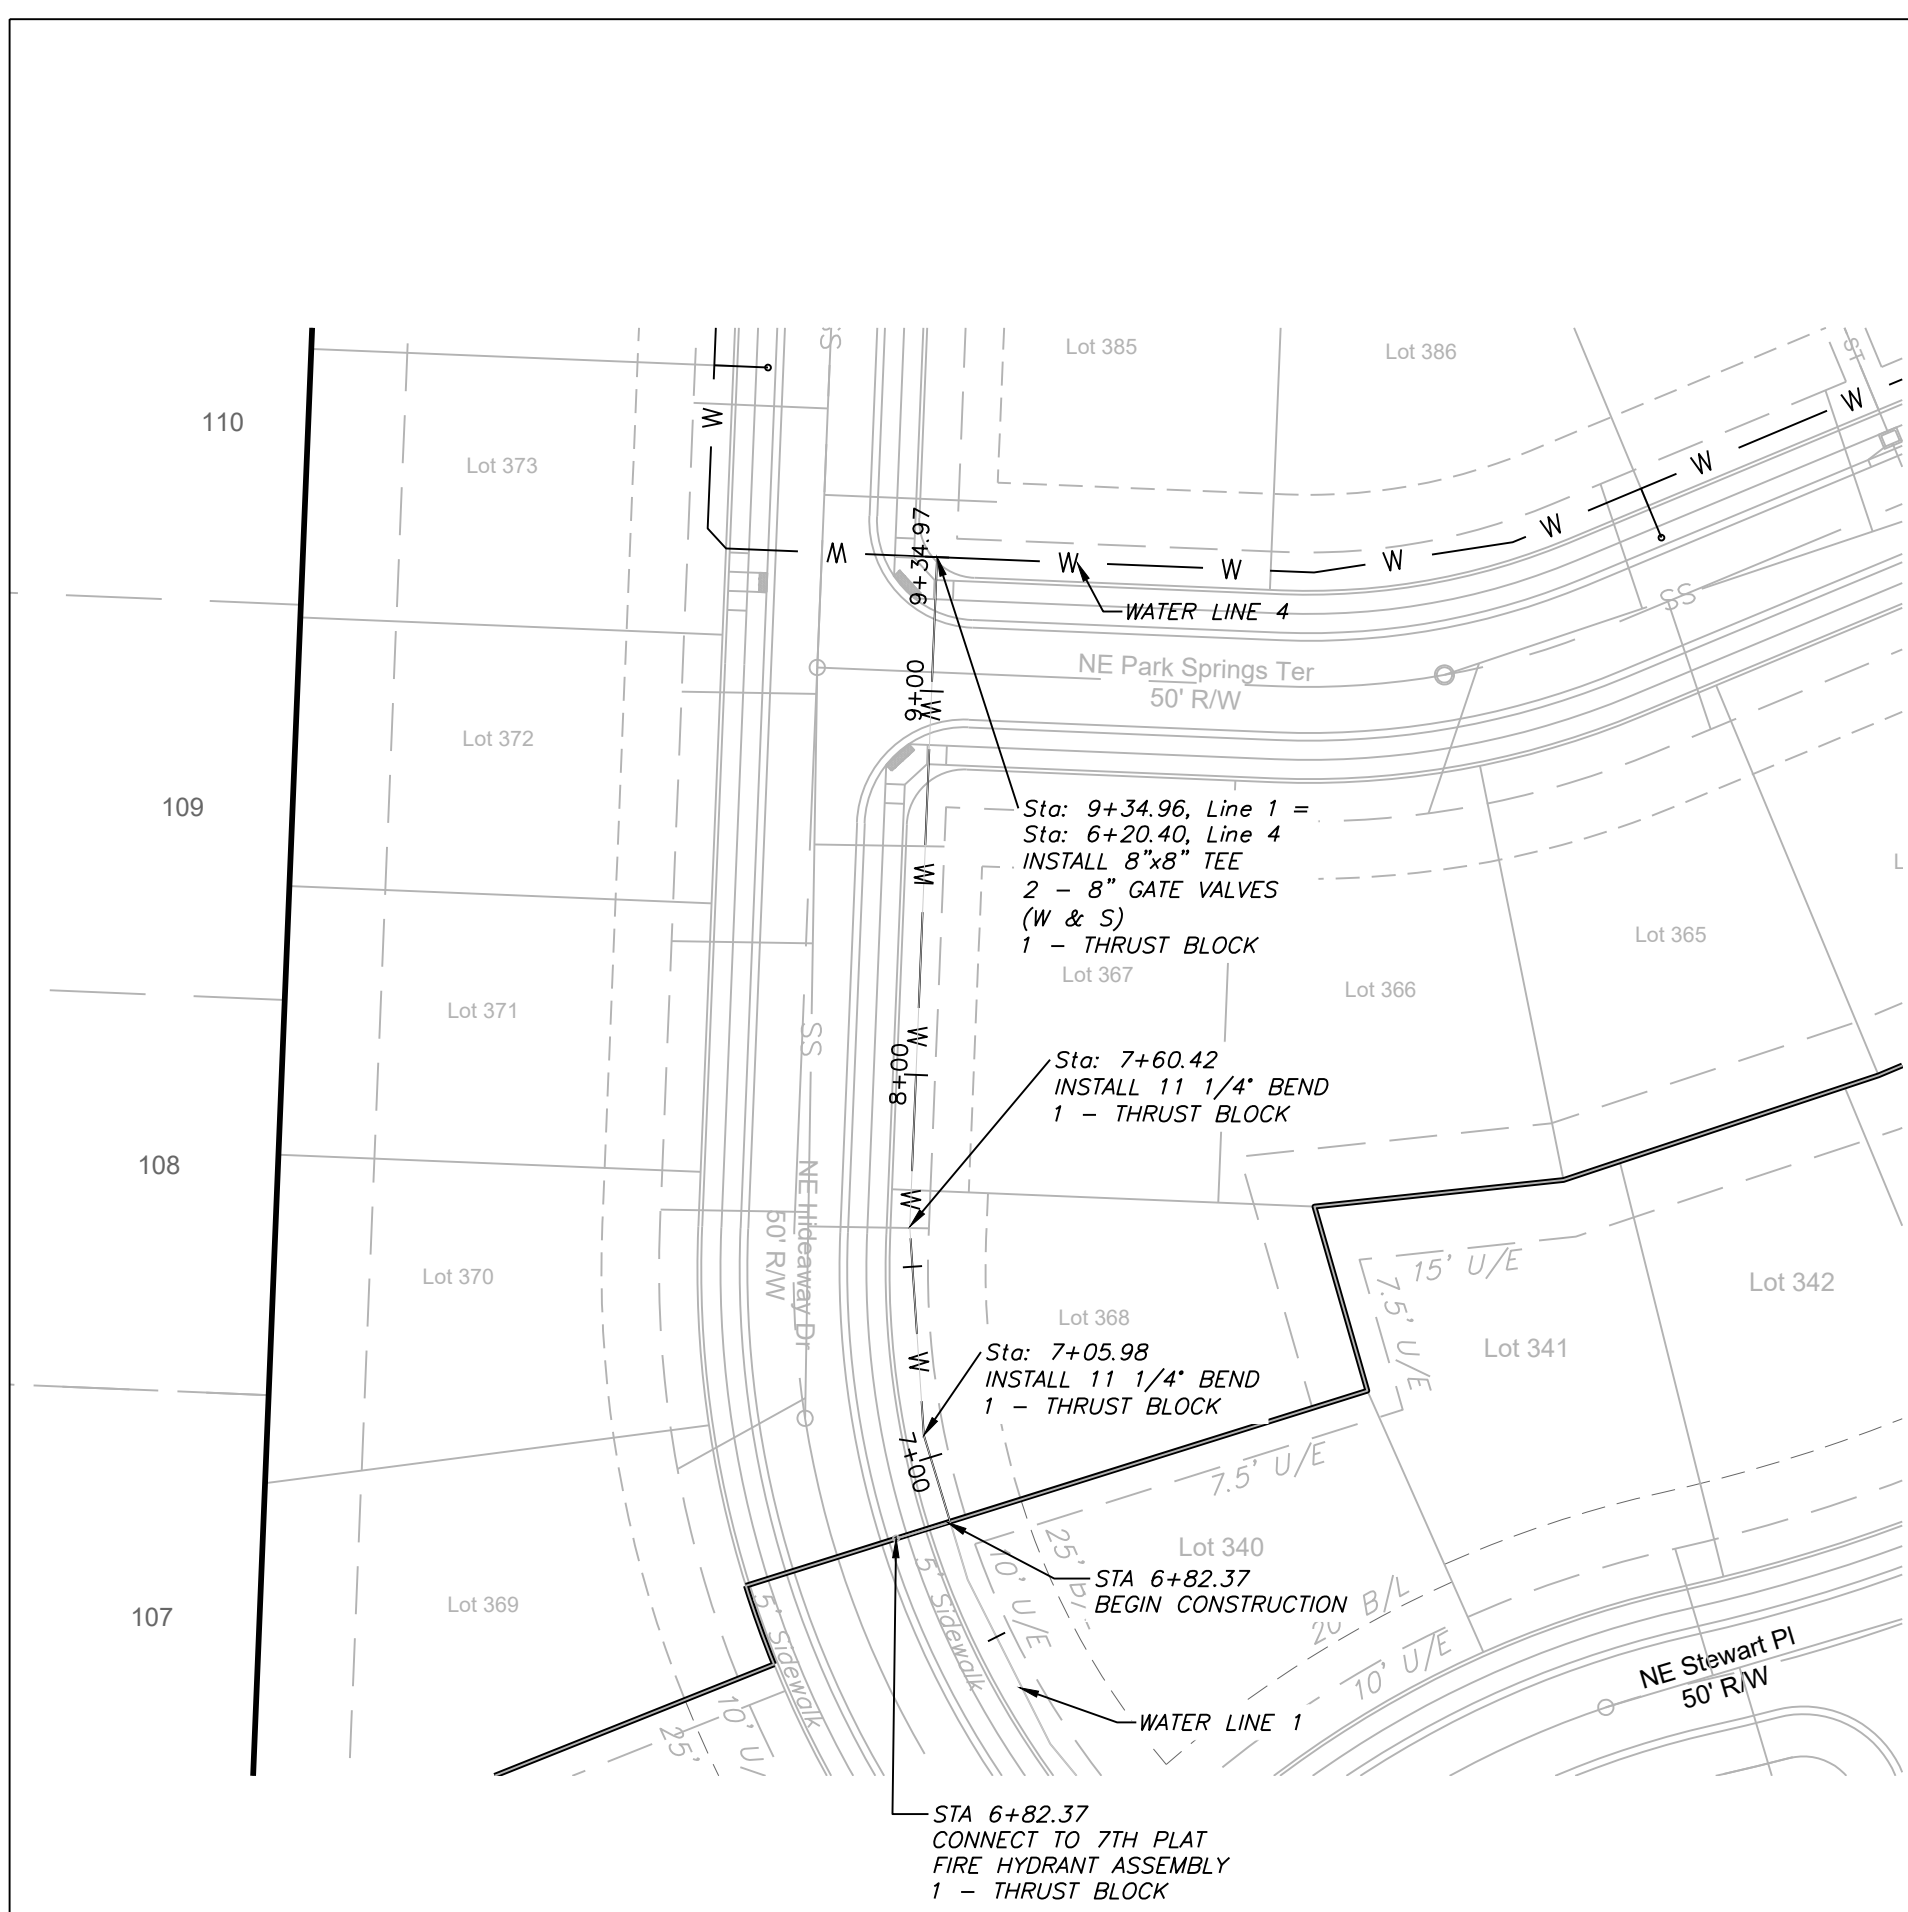

WATER PLAN & PROFILE
SCALE: 1" = 50'

Note:
Compacted Fill shall be placed to a minimum 18" above the top of the pipe prior to installation.

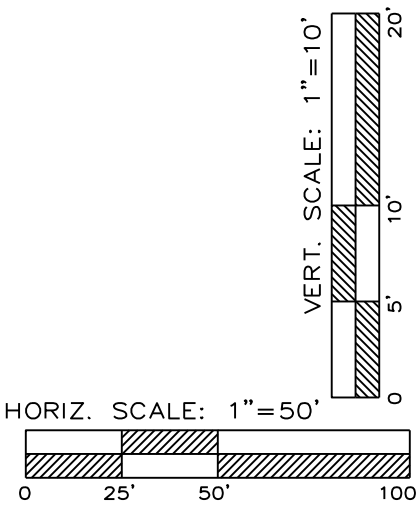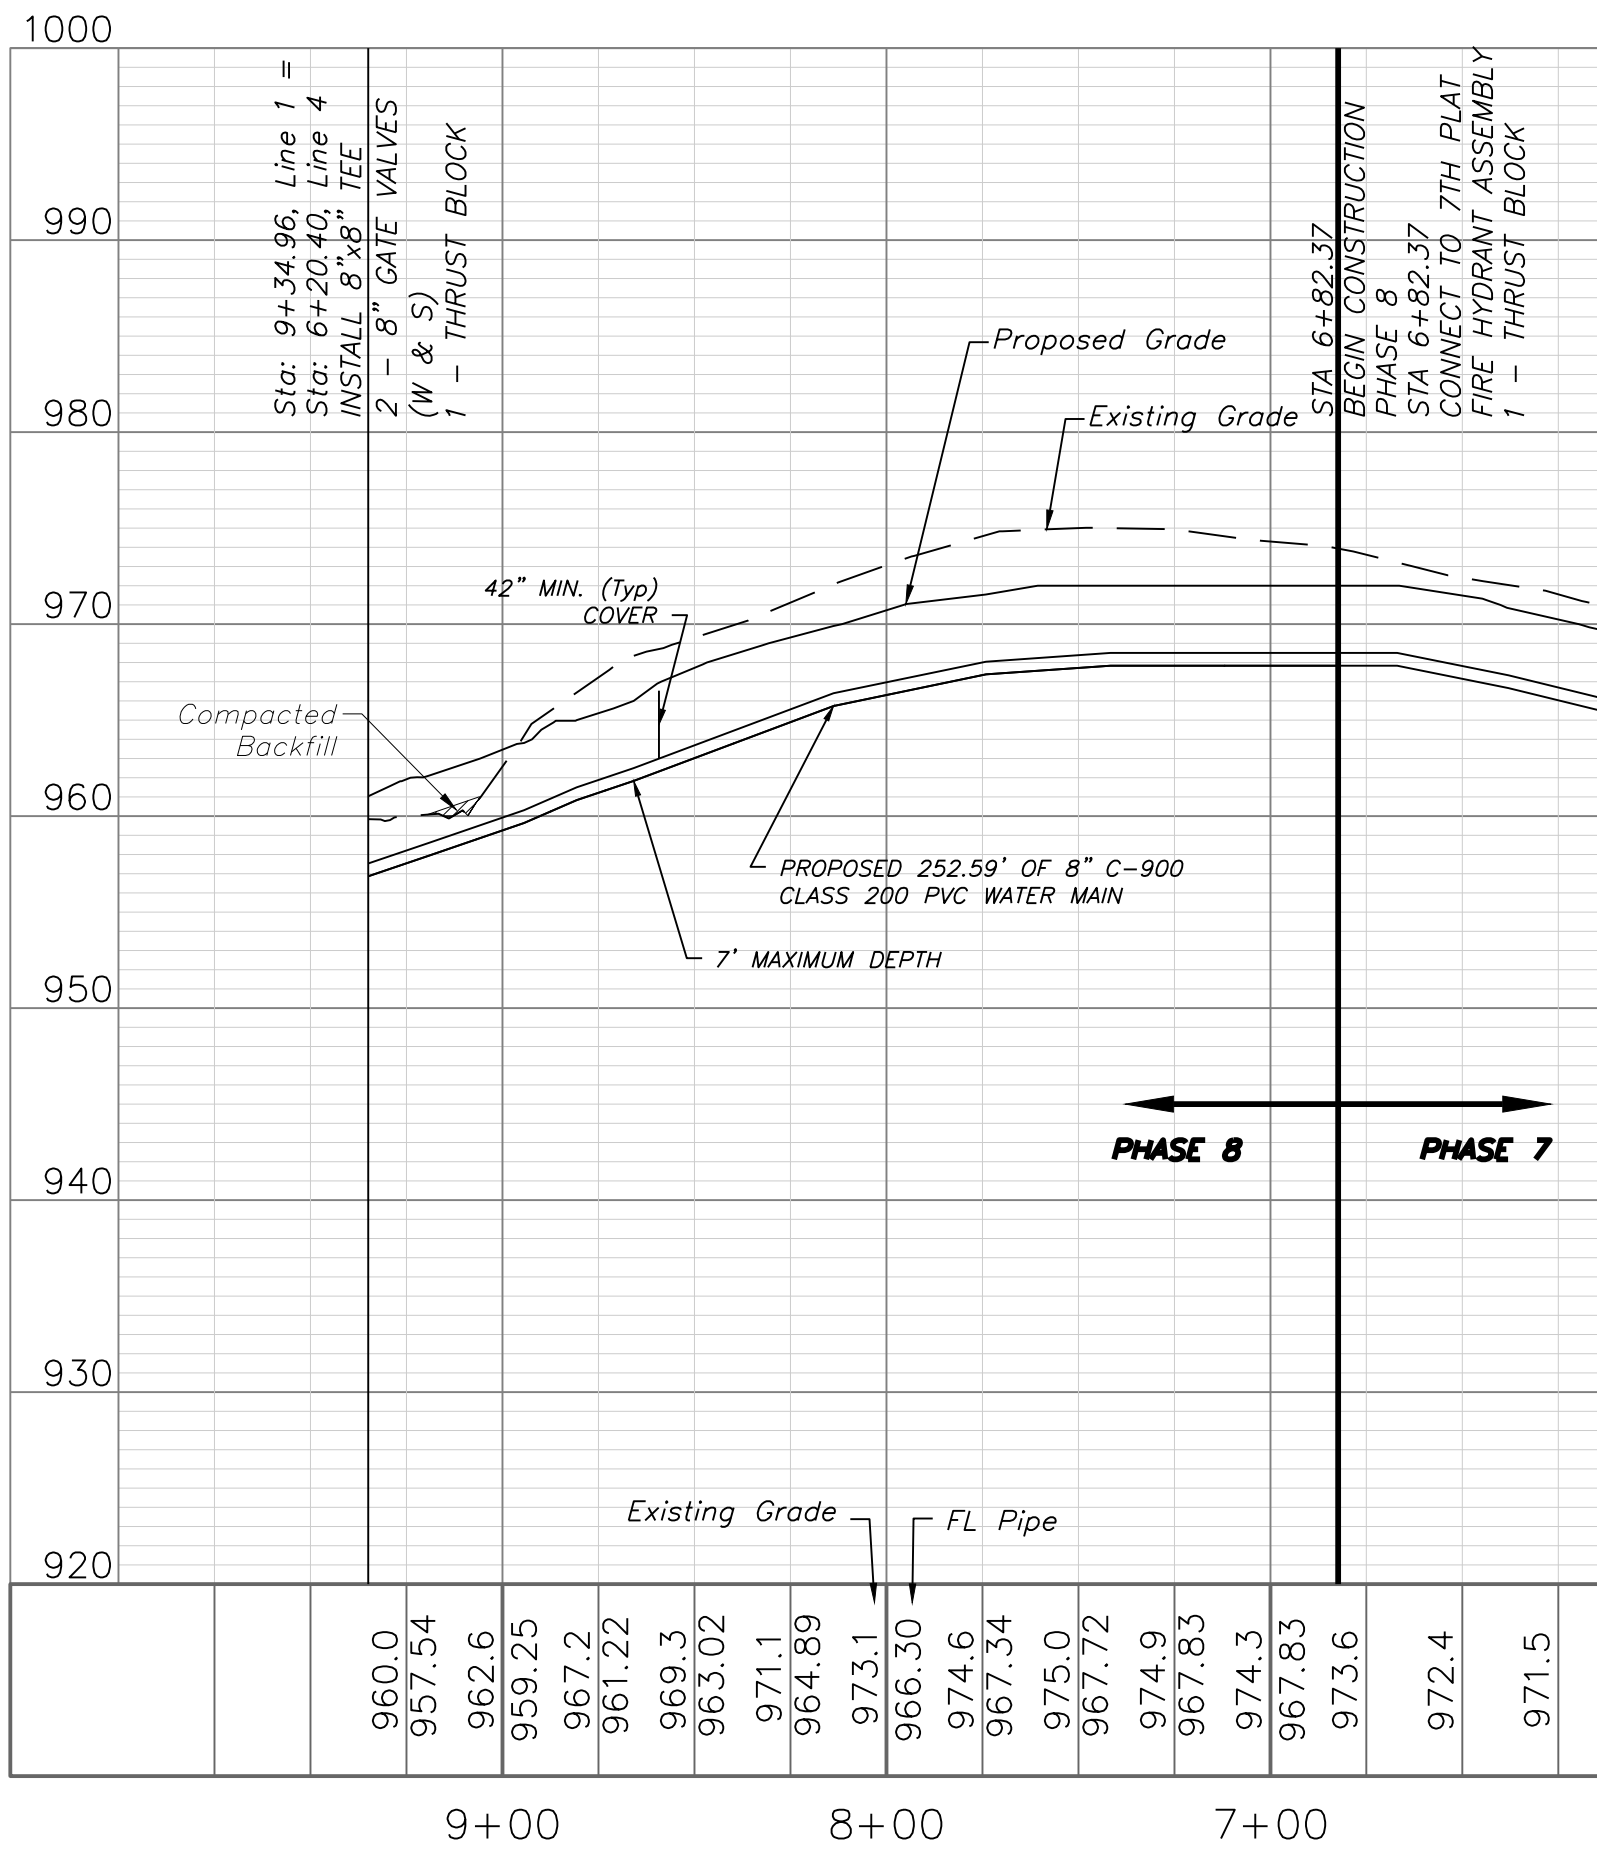

Accepted
Record Drawings

These plans have been reviewed for accuracy and are accepted for basic conformance to the approved construction drawings.

RECORD DRAWING
The information provided on this drawing conforms to construction records; it is not intended for construction, implementation or recording purposes; and it is solely based on information obtained by my firm.

"400-00 100.10", "4-00% 1.15% slope", or "8-inch HDPE-PVC pipe" are all typical examples of revisions that indicate that design data has been replaced with "as-built" information. All other data is as designed and has not been field verified.

Date: 6/2/2022
Certified by: Matthew J. Schlicht
Title: Engineer
Firm: Engineering Solutions


ENGINEERING SOLUTIONS
ENGINEERING & SURVEYING
50 SE 30TH STREET
LEE'S SUMMIT, MO 64082
P: (816) 623-9888 F: (816) 623-9849

Professional Registration
Missouri
Engineering 2005002186-D
Surveying 2005008319-D
Kansas
Engineering E-1685
Surveying LS-218
Oklahoma
Engineering 6254
Nebraska
Engineering CA2821

PARK RIDGE 8TH PLAT
Section 9, Township 48 North, Range 31 West
Lee's Summit, Jackson County, Missouri


Project: PARK RIDGE
Issue Date: March 17, 2021

Water Main Plan and Profile, Line 2
PARK RIDGE 8TH PLAT
Section 9, Township 48 North, Range 31 West
Lee's Summit, Jackson County, Missouri

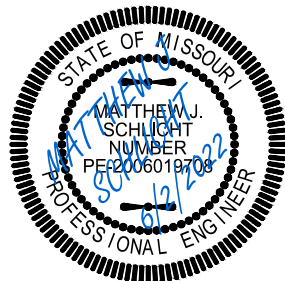

Matthew J. Schlicht
MO PE 2006019708
KS PE 19071
OK PE 25226
NE PE E-14335

REVISIONS	
6/2/2022	As-Built

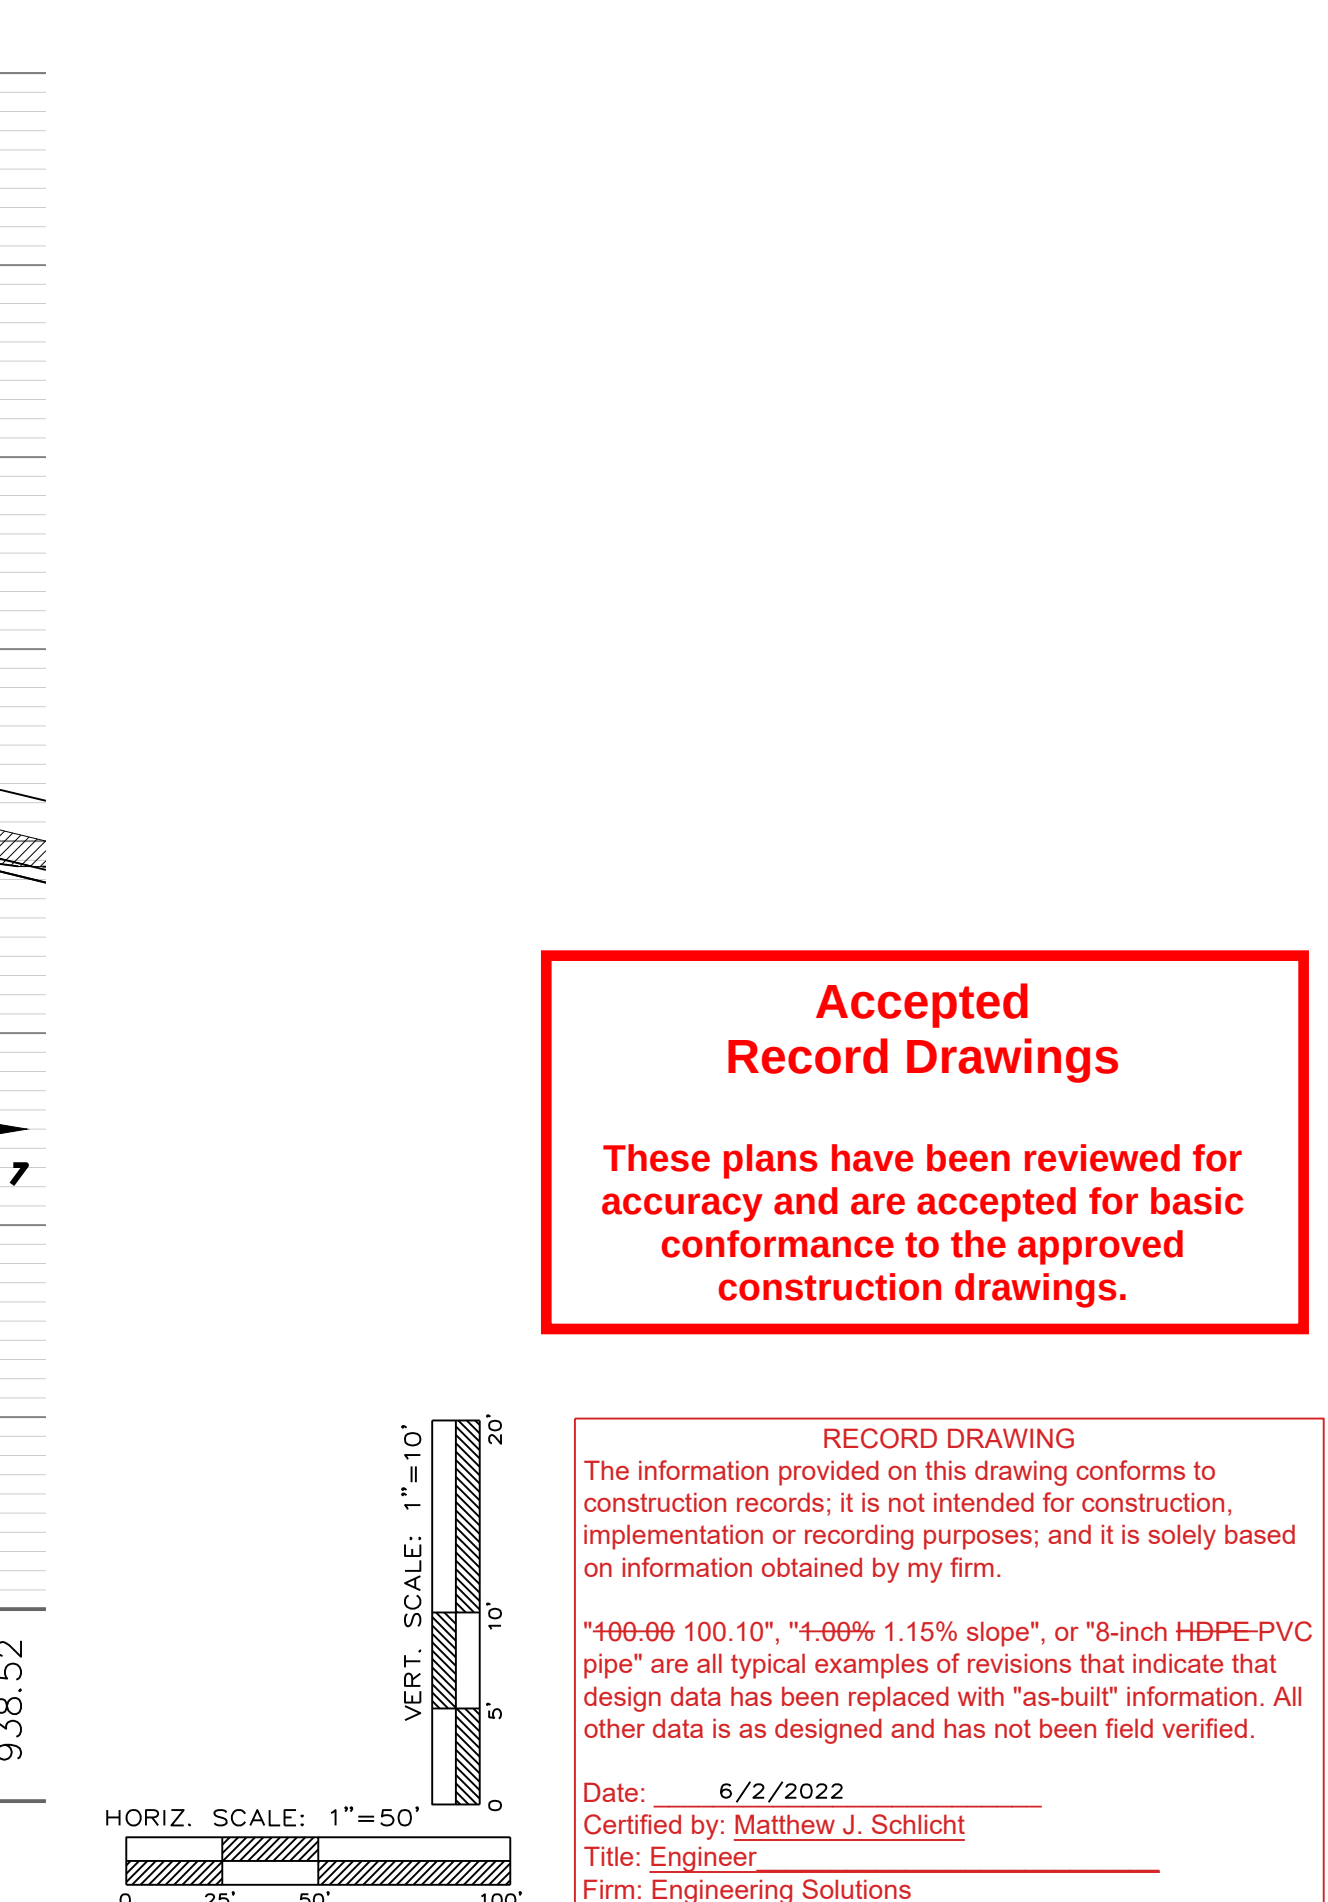

ENGINEERING SOLUTIONS

ENGINEERING & SURVEYING

50 SE 30TH STREET
LEE'S SUMMIT, MO 64082
P: (816) 623-9888 F: (816) 623-9849

Professional Registration
Missouri
Engineering 2005002186-D
Surveying 2005003519-D

Kansas
Engineering E-1695
Surveying LS-218
Oklahoma
Engineering 6254
Nebraska
Engineering CA2821

PROJECT: PARK RIDGE

ISSUE DATE: March 17, 2021

PARK RIDGE 8TH PLAT

Section 9, Township 48 North, Range 31 West

Lee's Summit, Jackson County, Missouri

Water Main Plan and Profile, Line 2

PARK RIDGE 8TH PLAT

Section 9, Township 48 North, Range 31 West

Lee's Summit, Jackson County, Missouri

PROJECT: PARK RIDGE

ISSUE DATE: March 17, 2021

PARK RIDGE 8TH PLAT

Section 9, Township 48 North, Range 31 West

Lee's Summit, Jackson County, Missouri










Matthew J. Schlicht
MO PE 2006019708
KS PE 19071
OK PE 25226
NE PE E-14335

REVISIONS

6/2/2022 As-Built

REV. 2/17/2022
Revised FH Location

C. 503

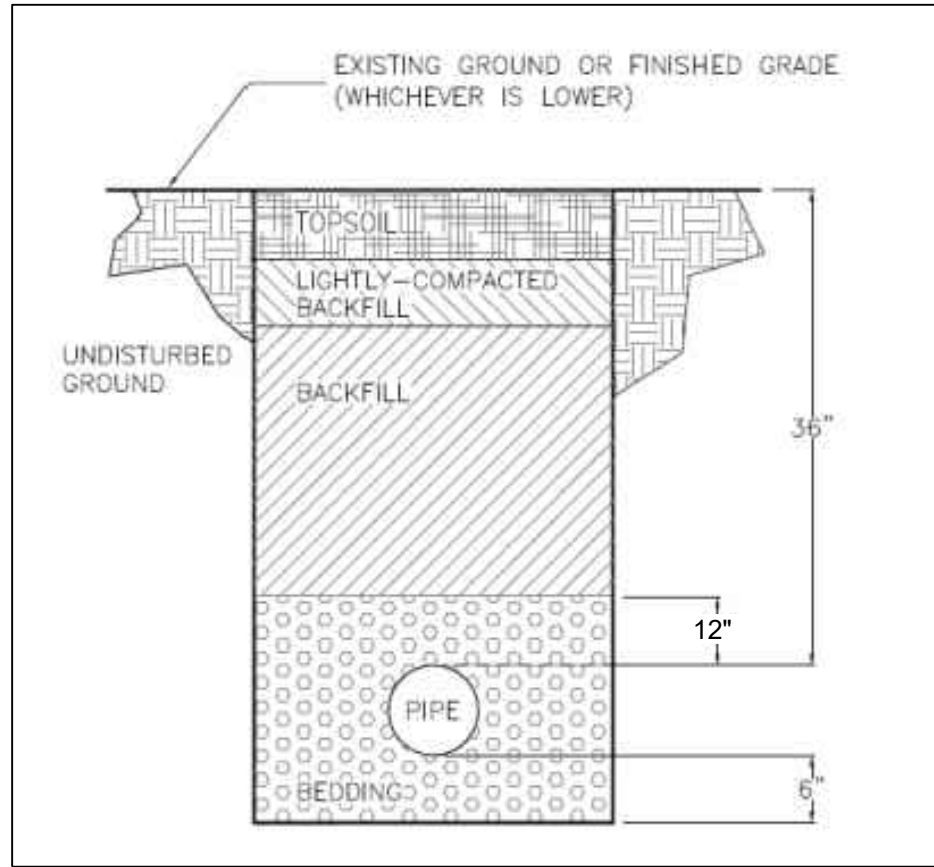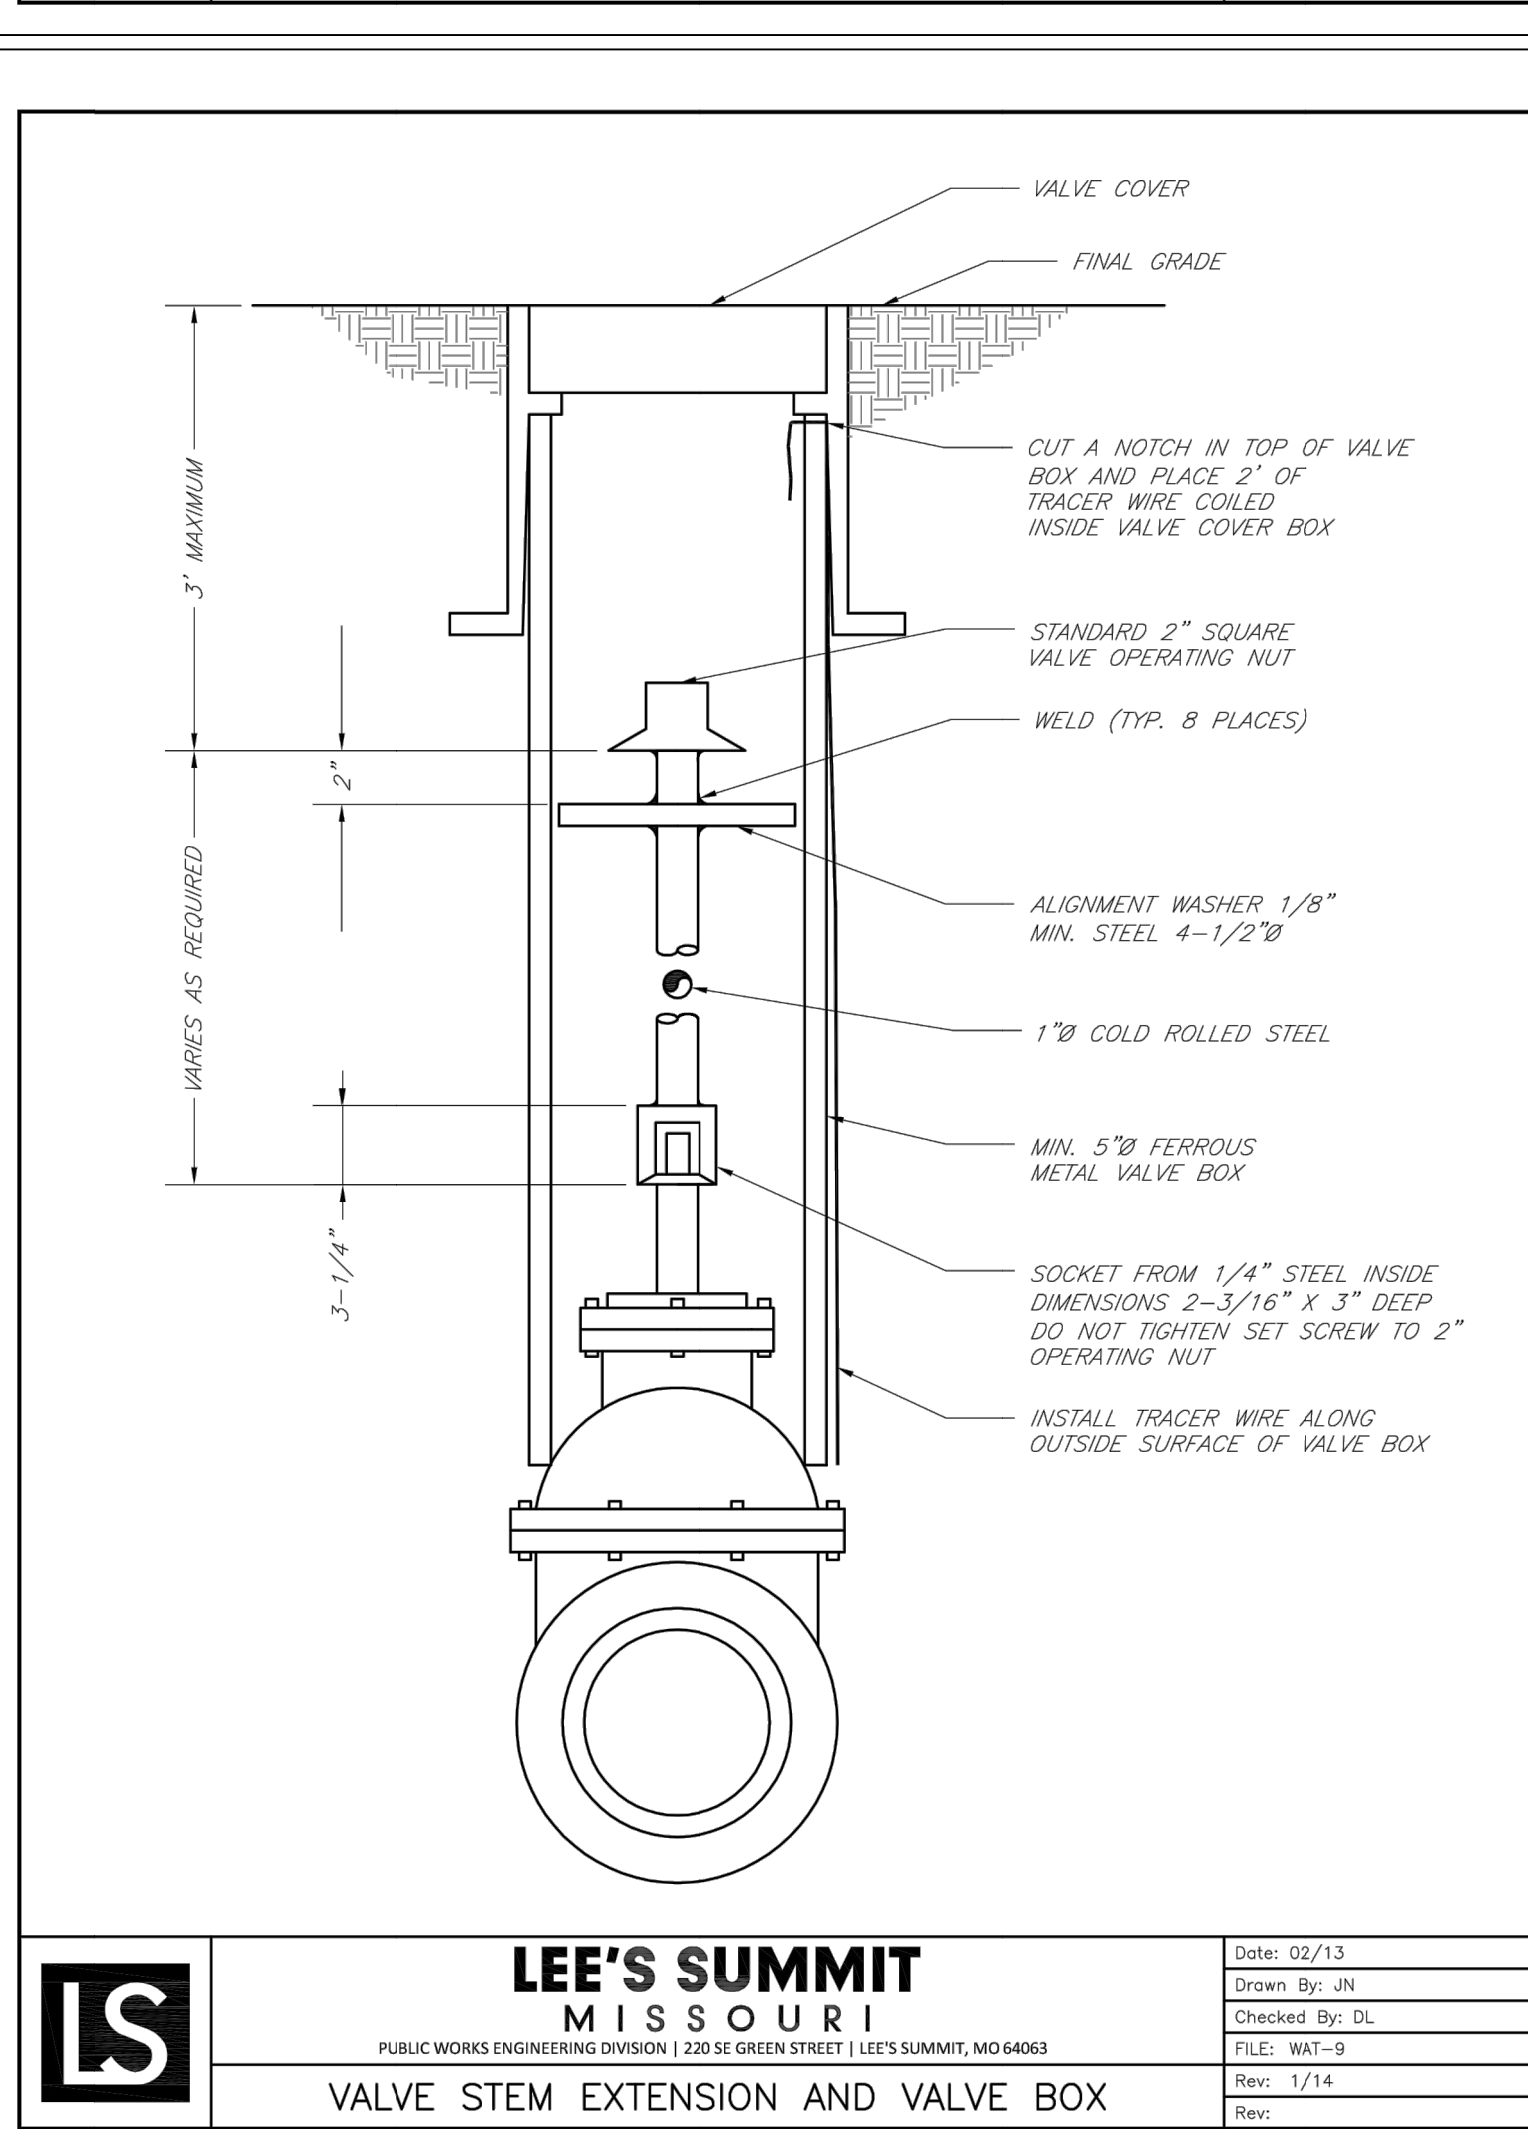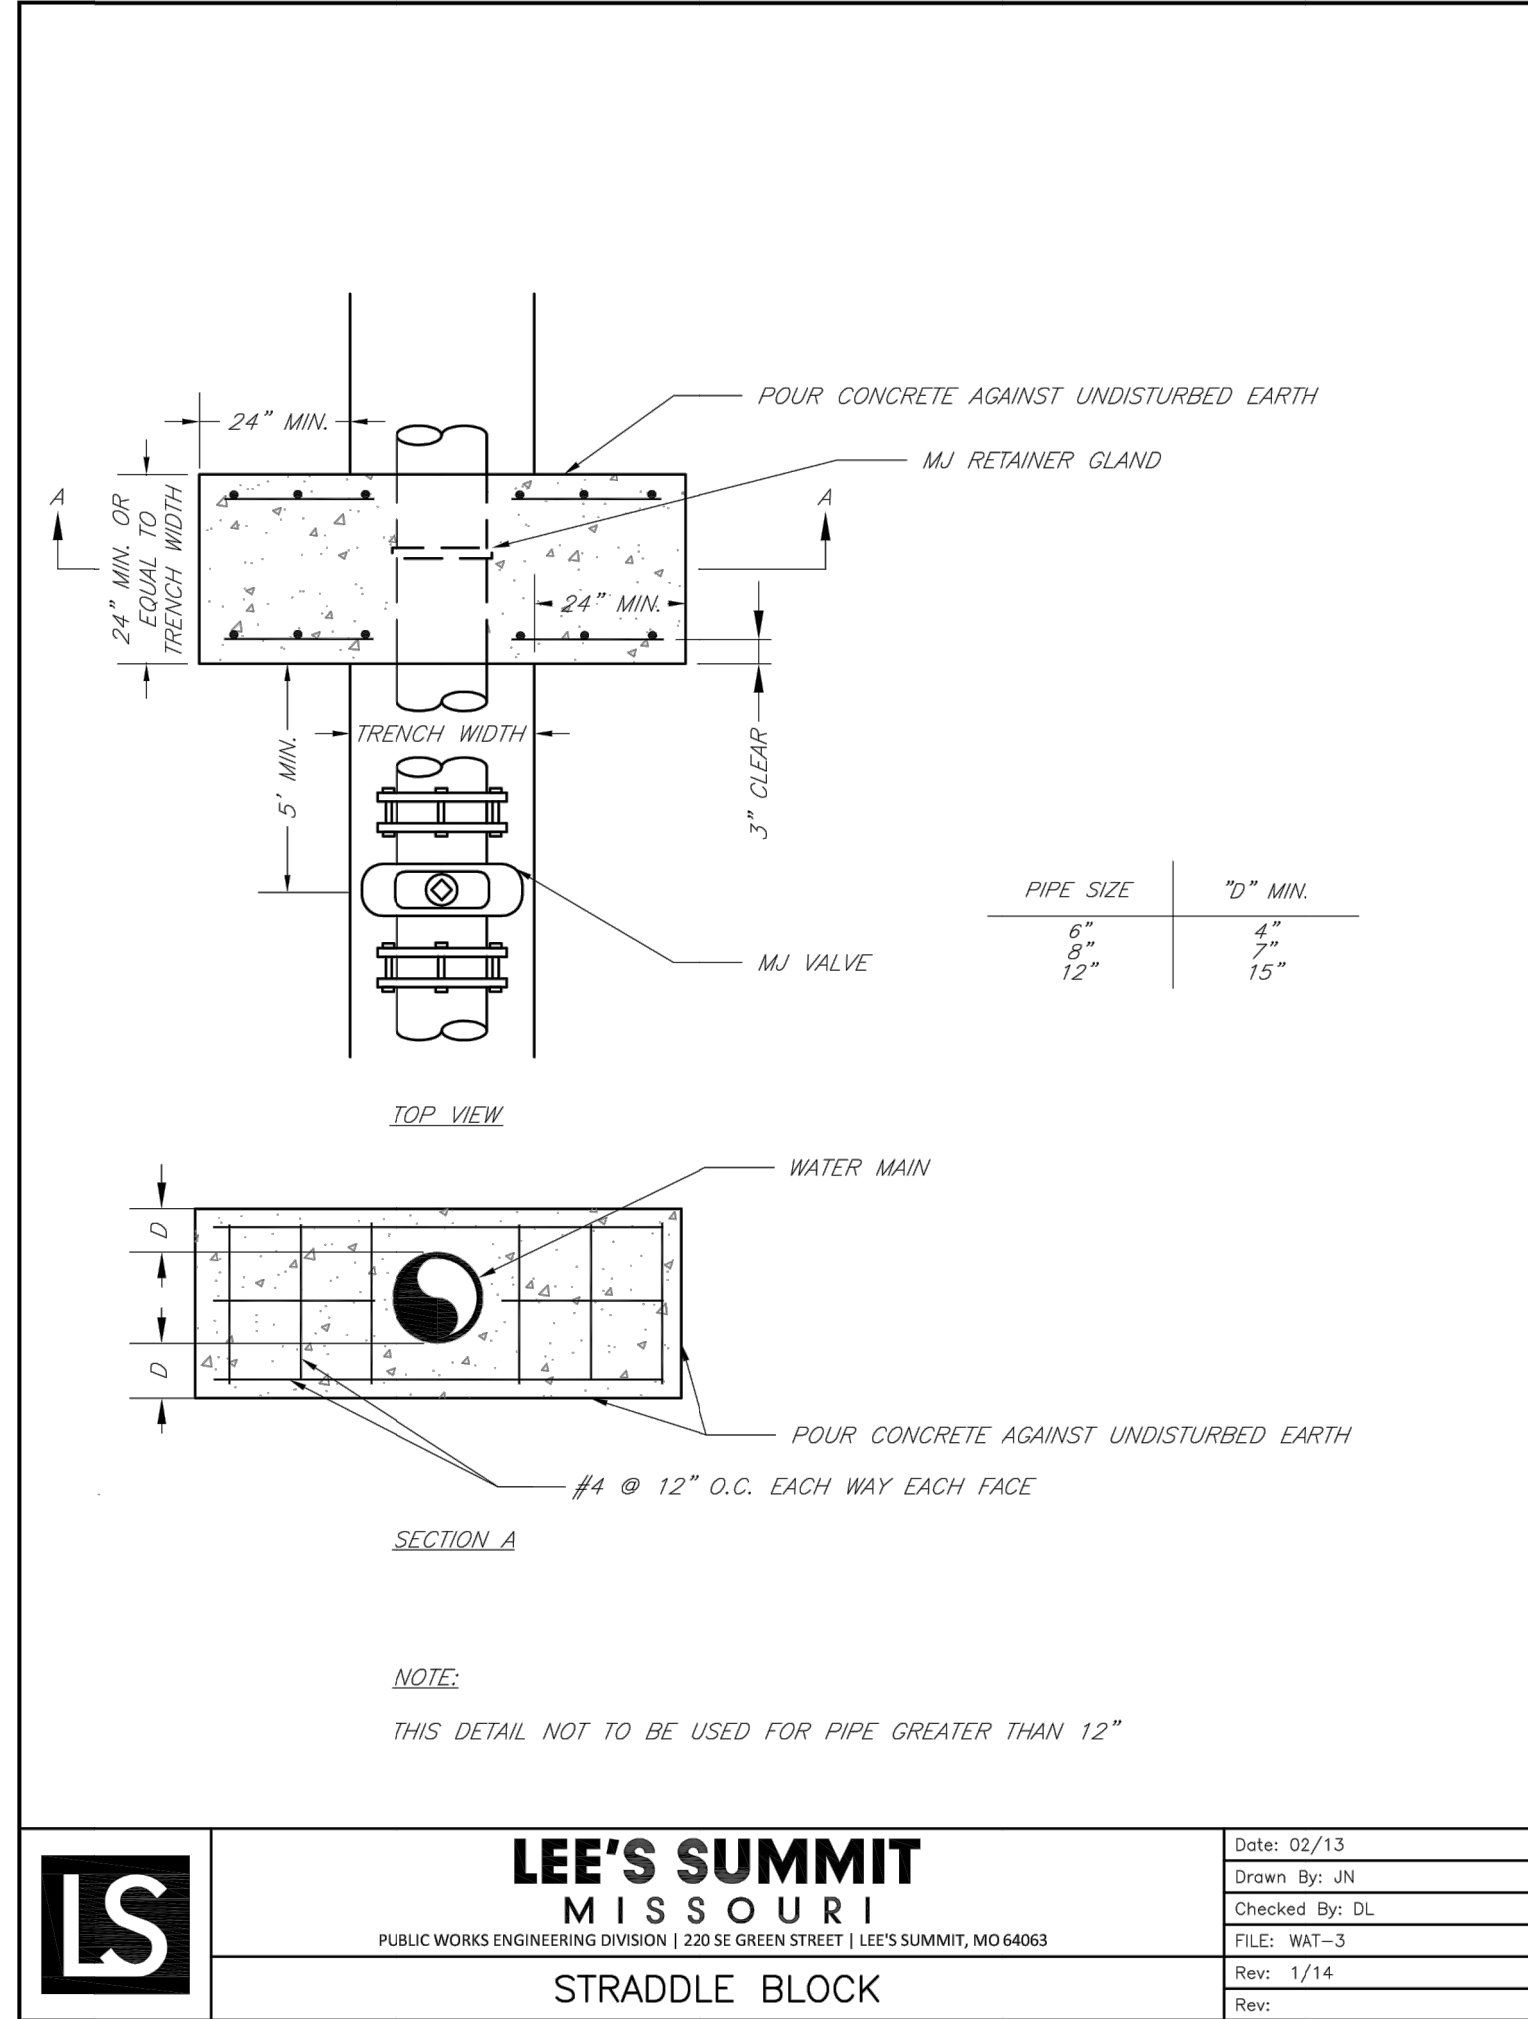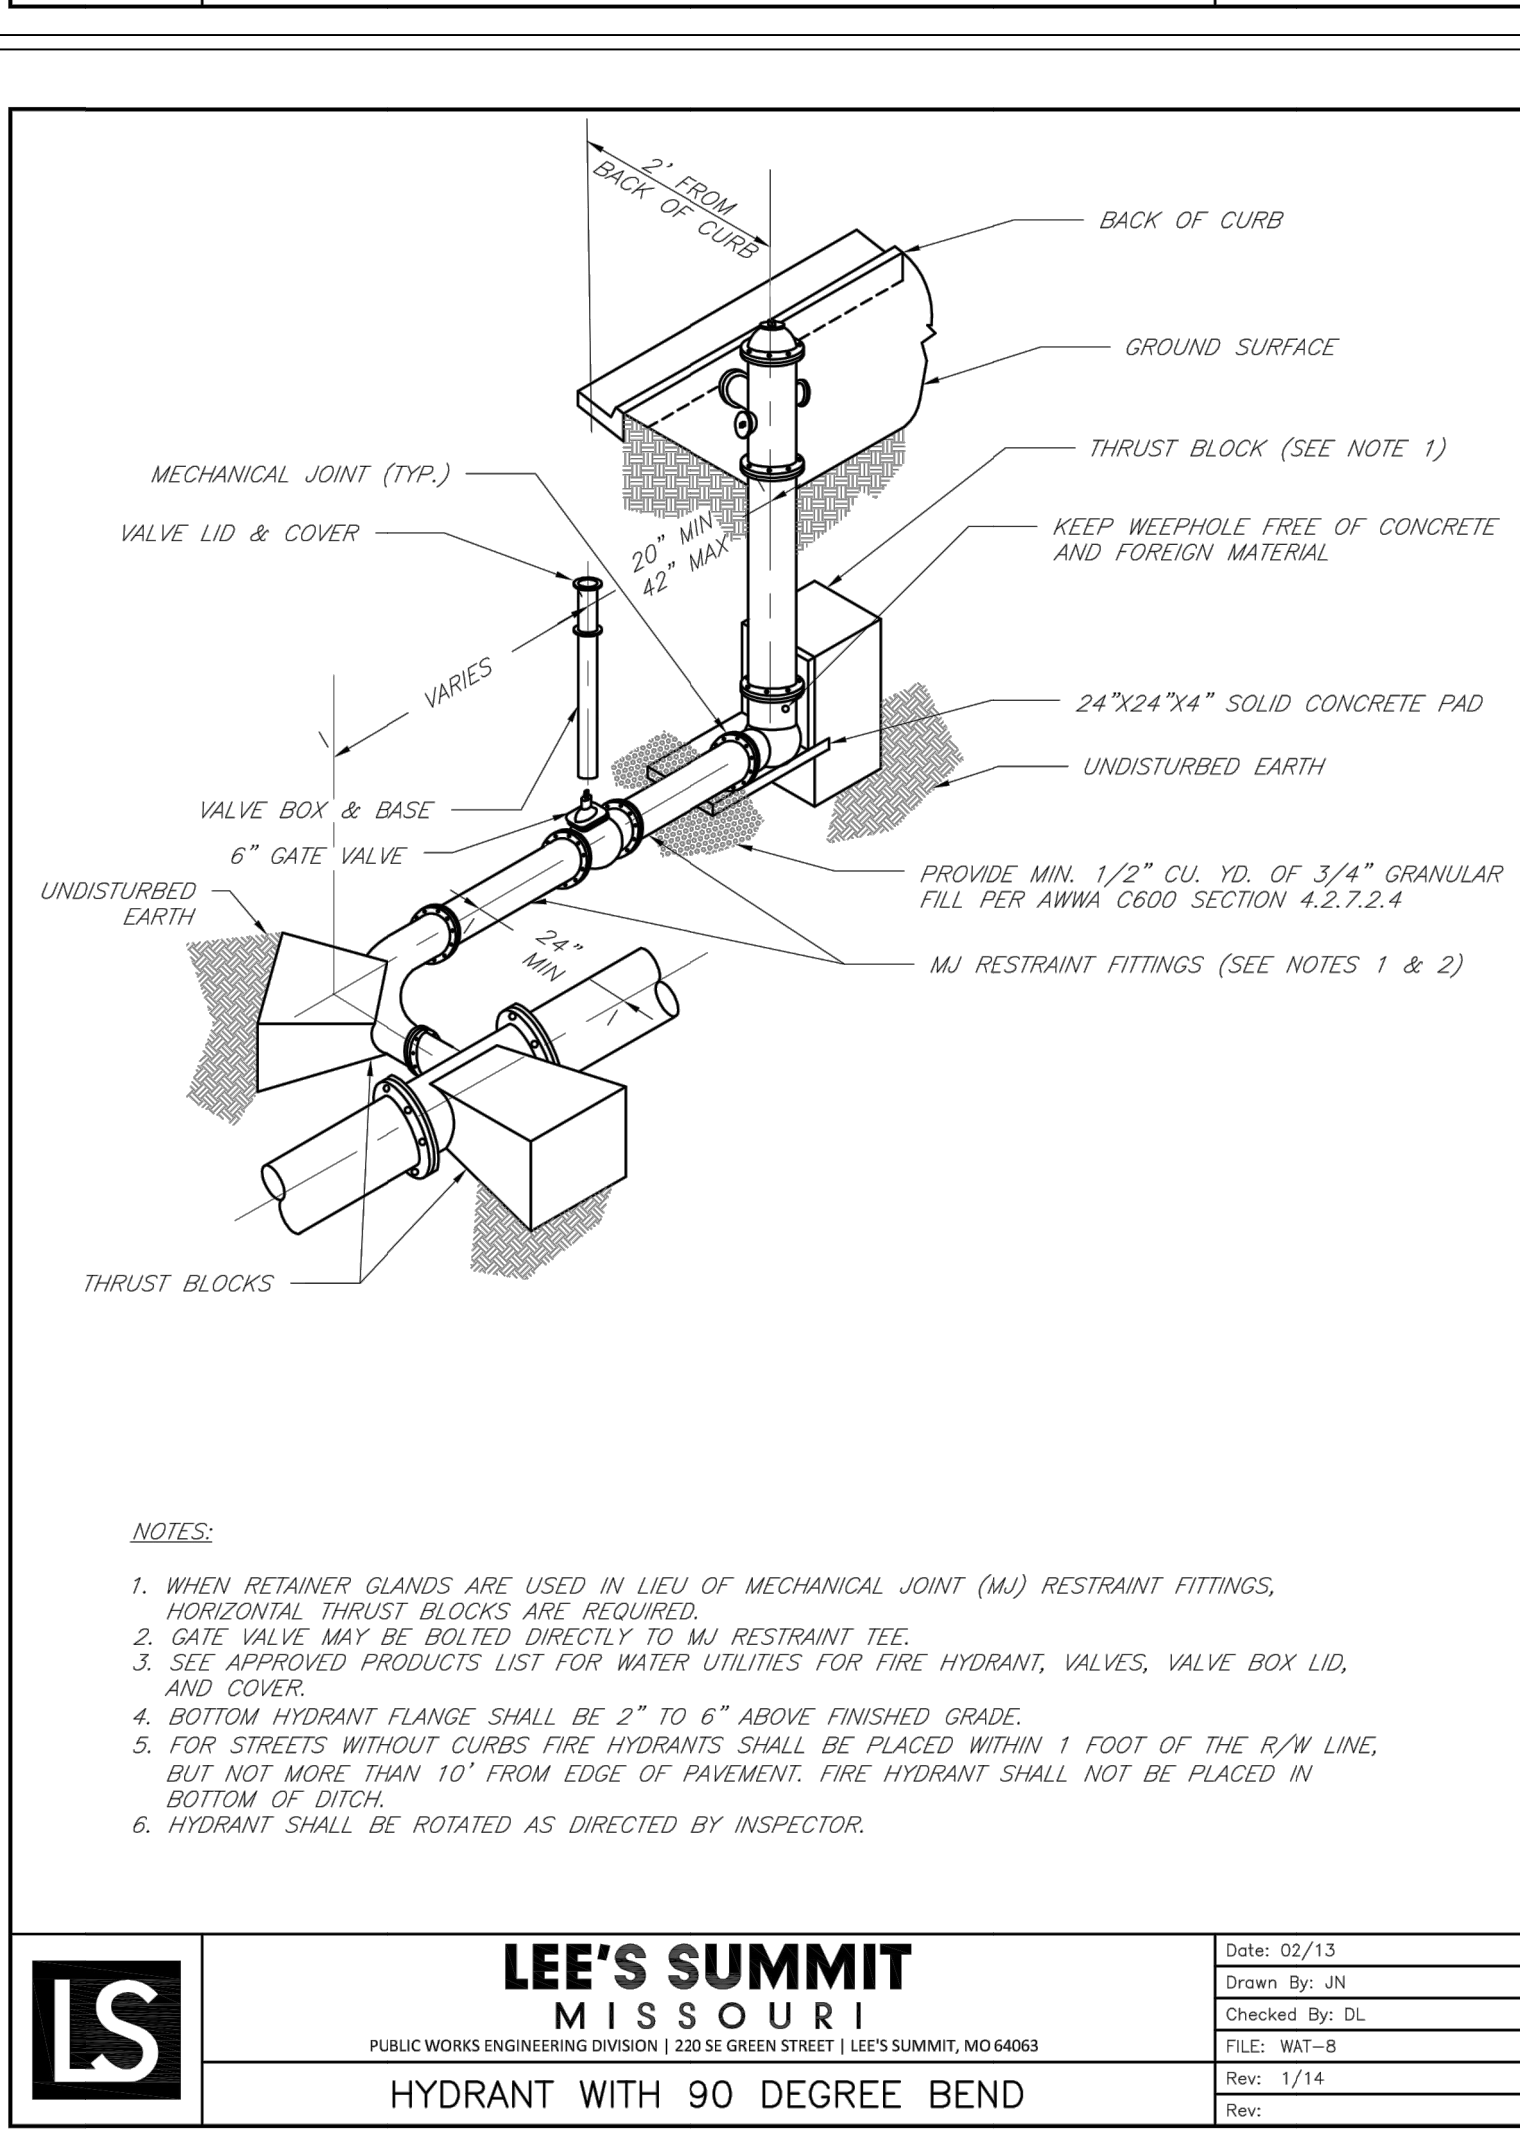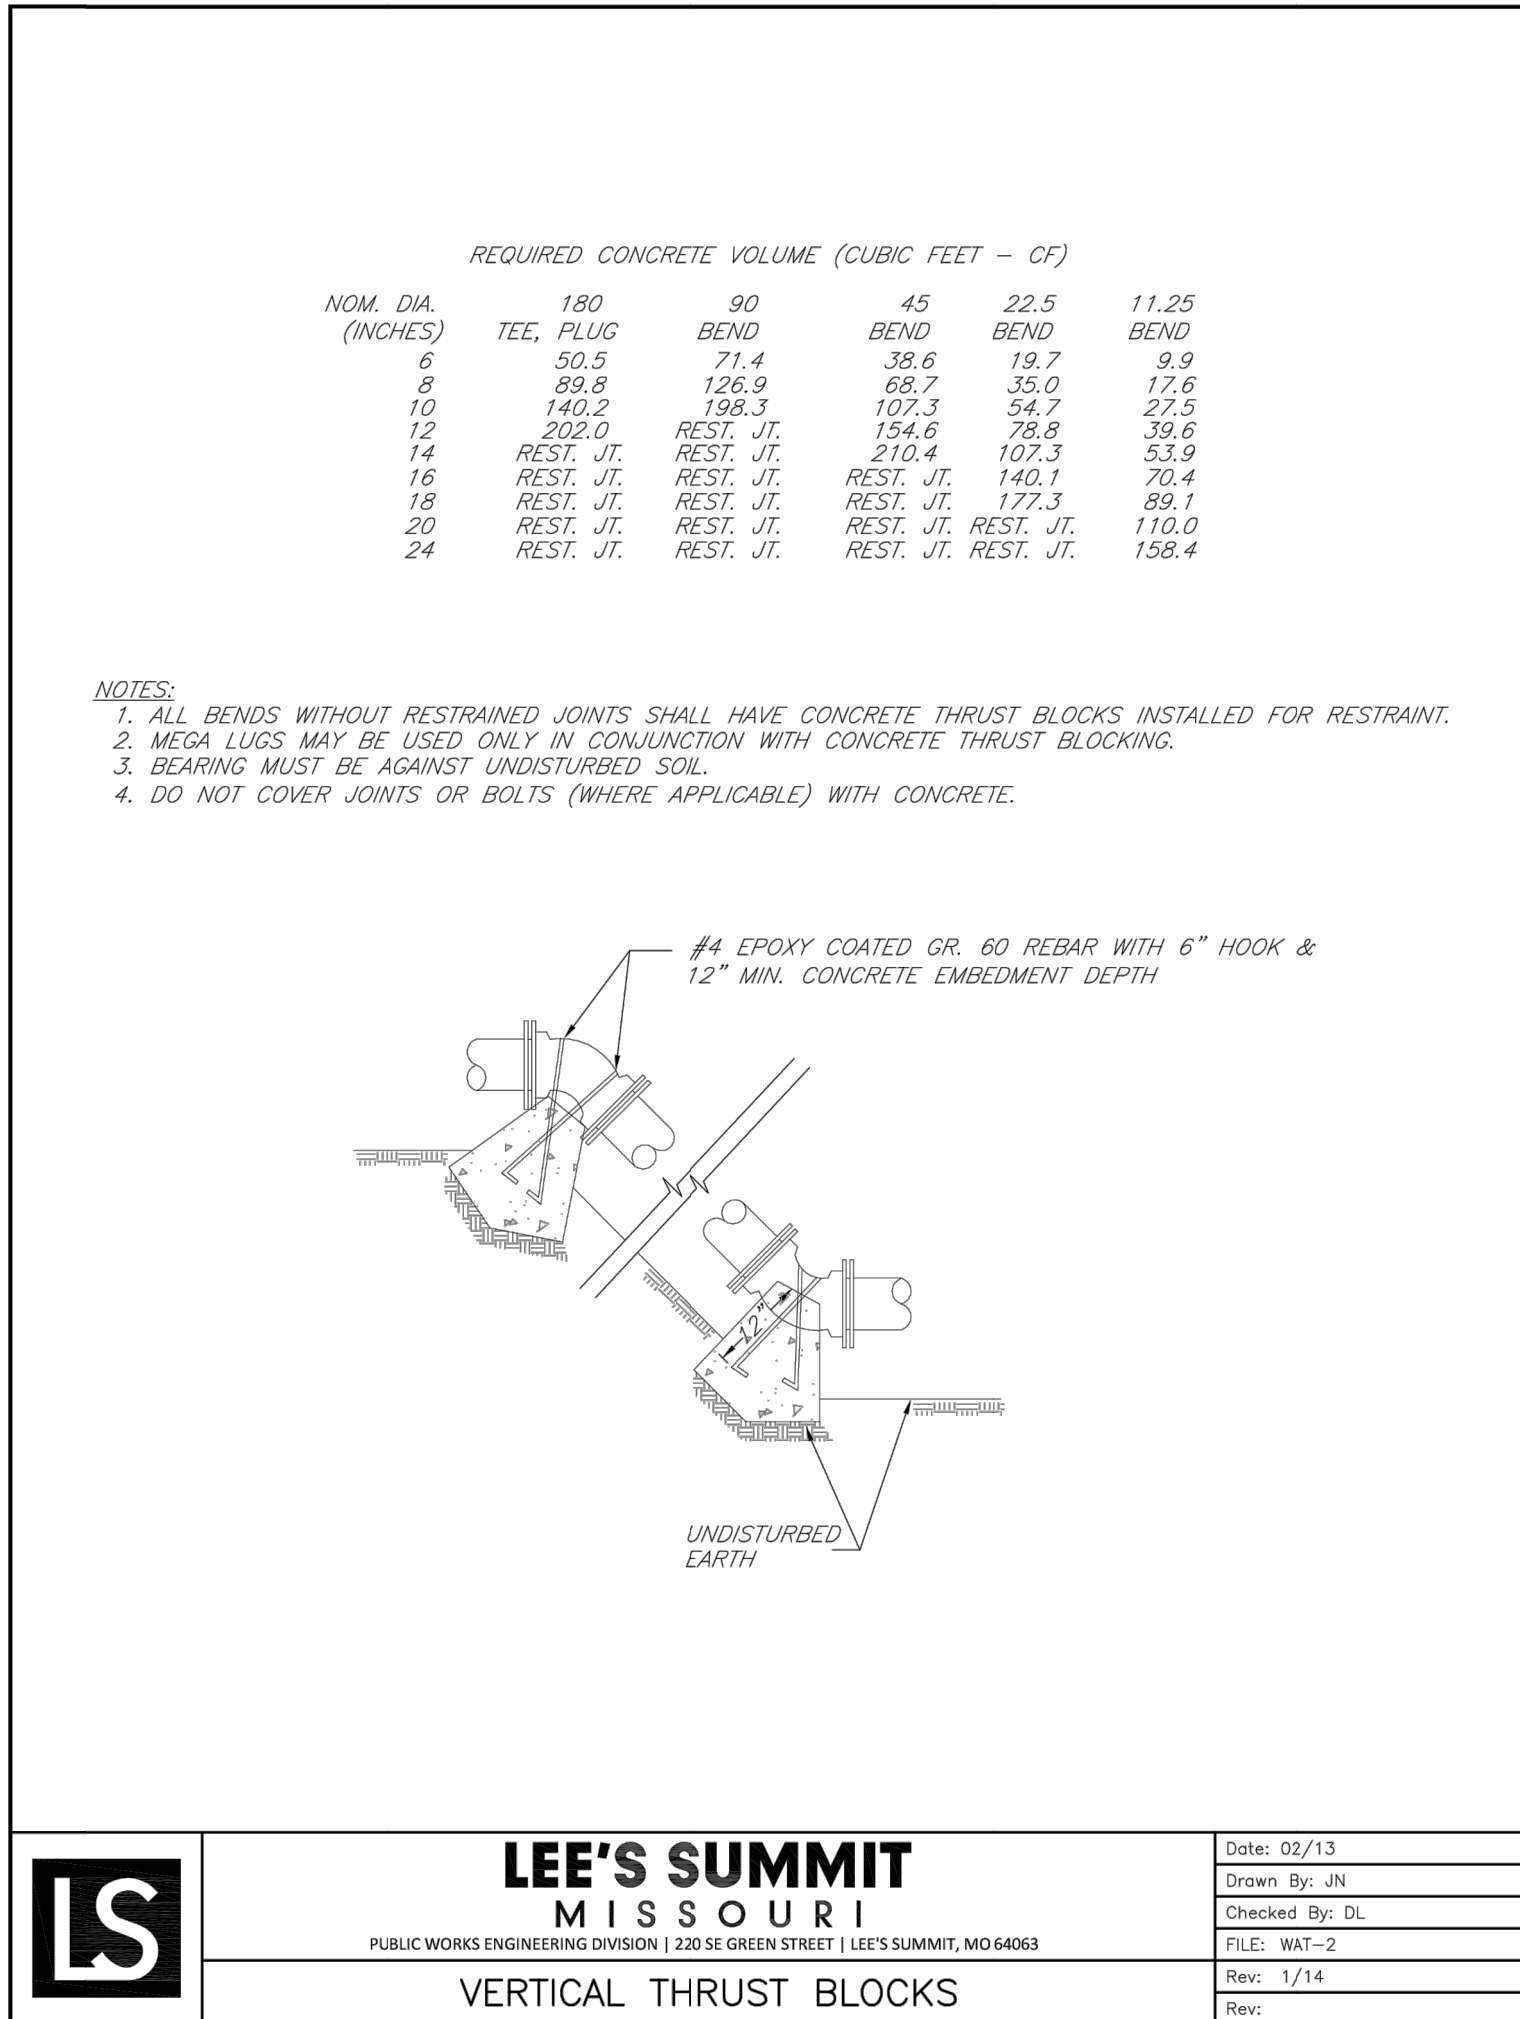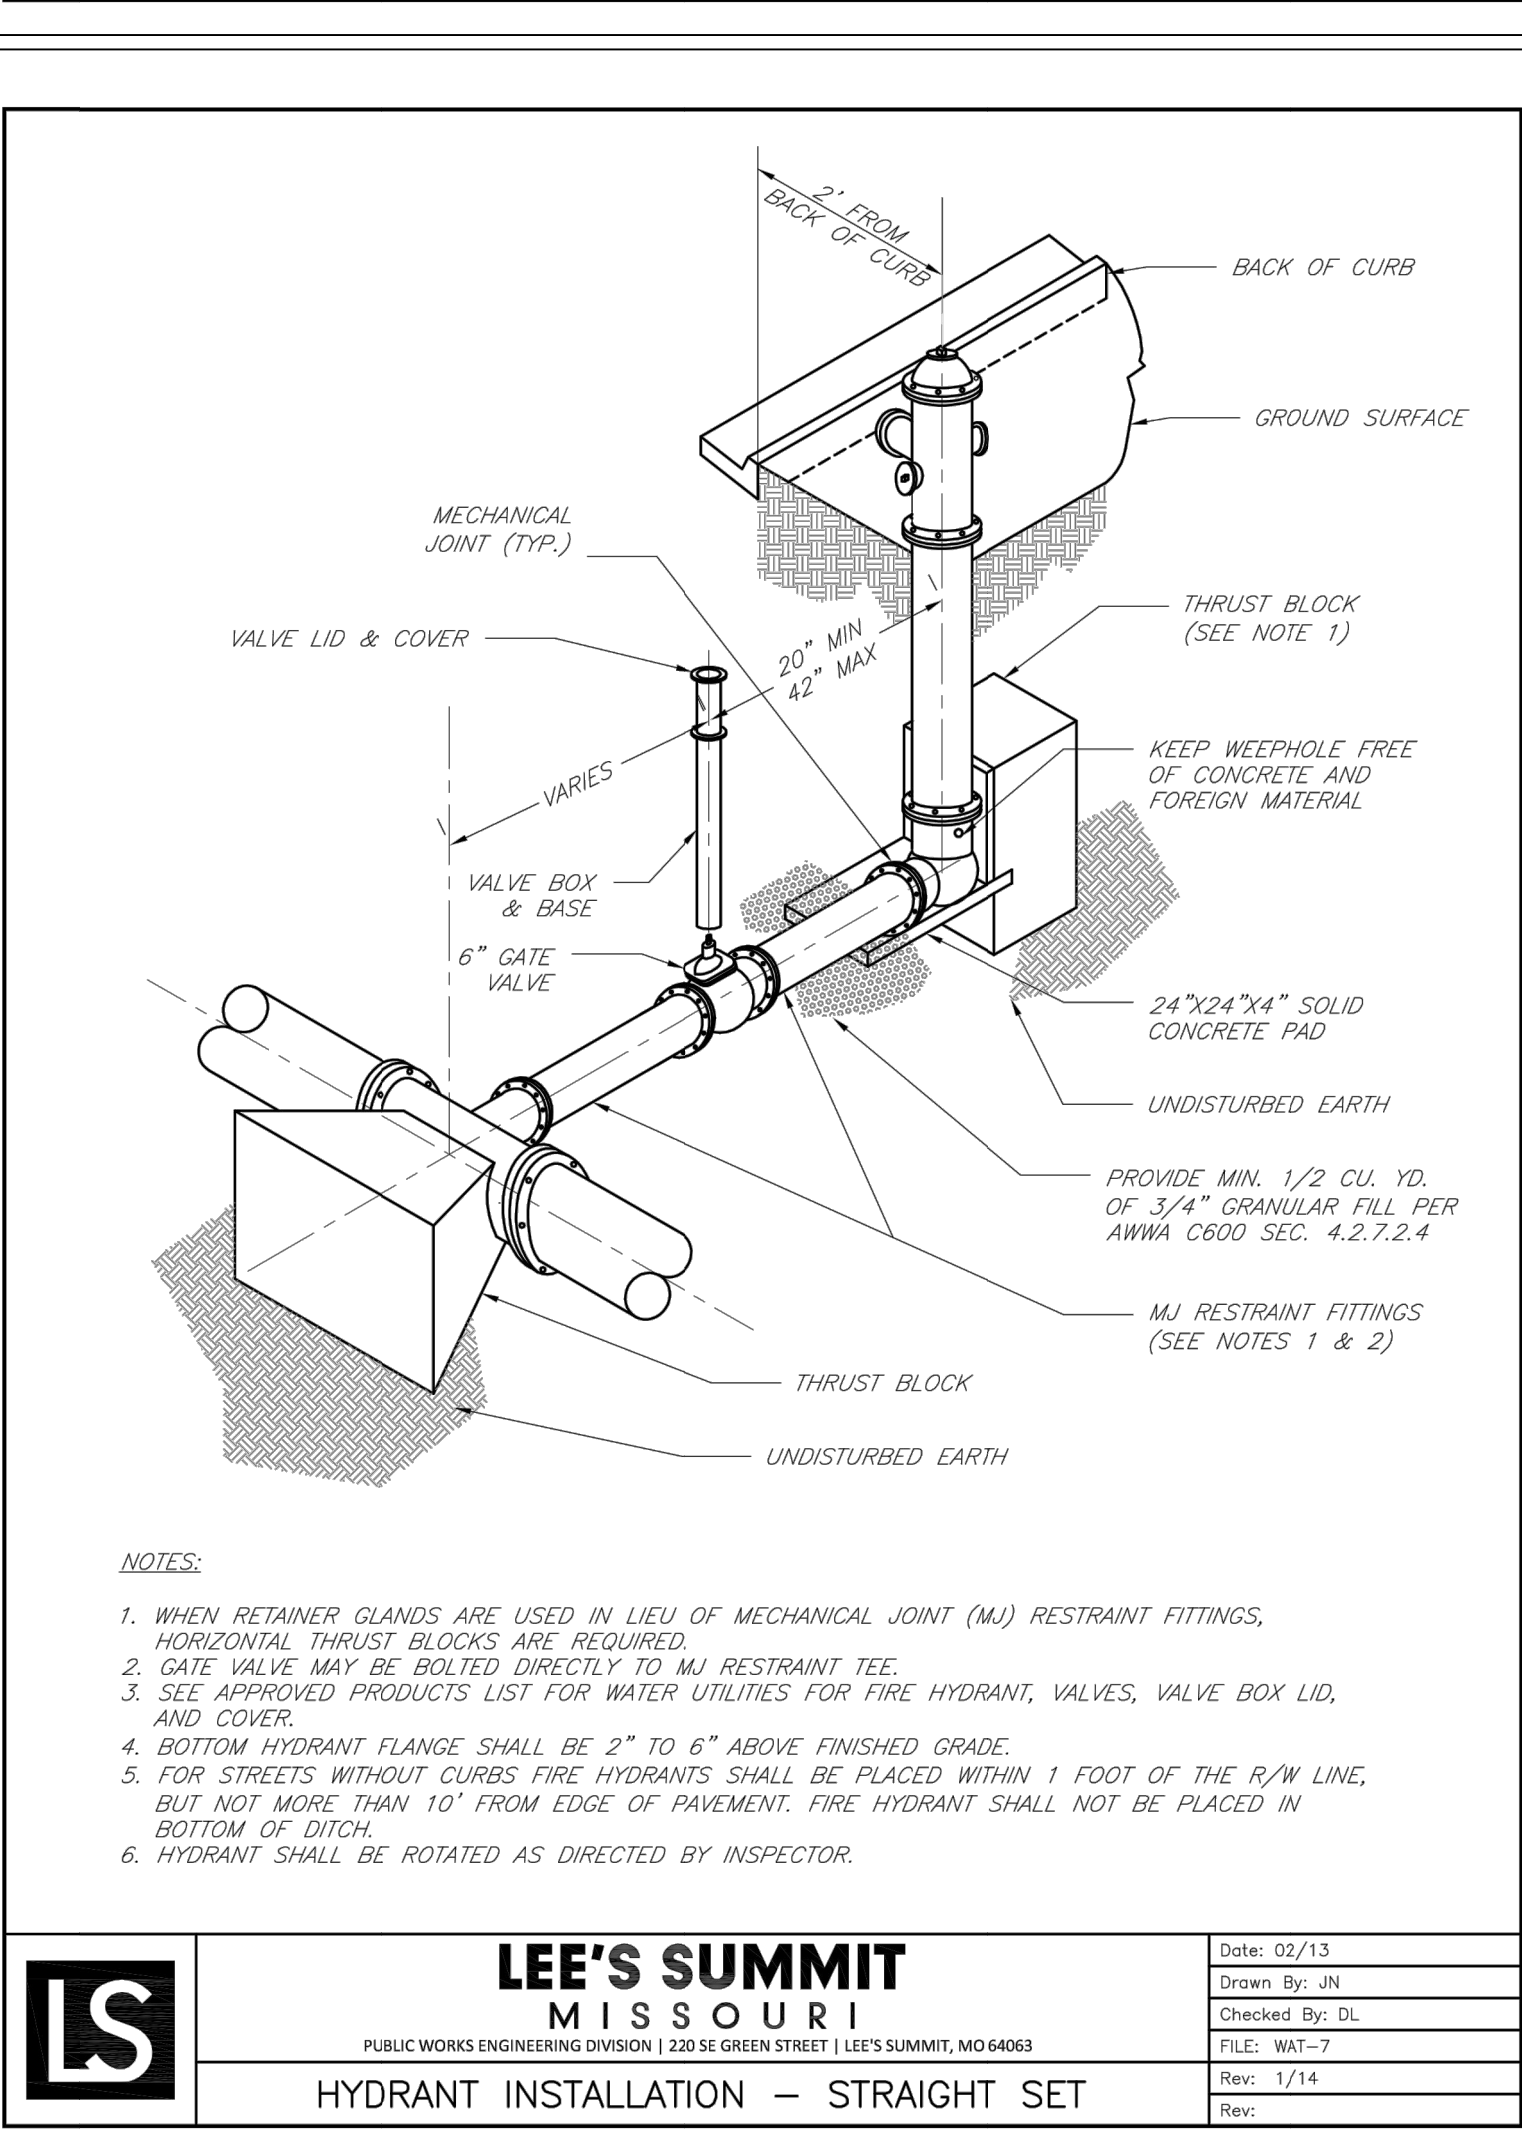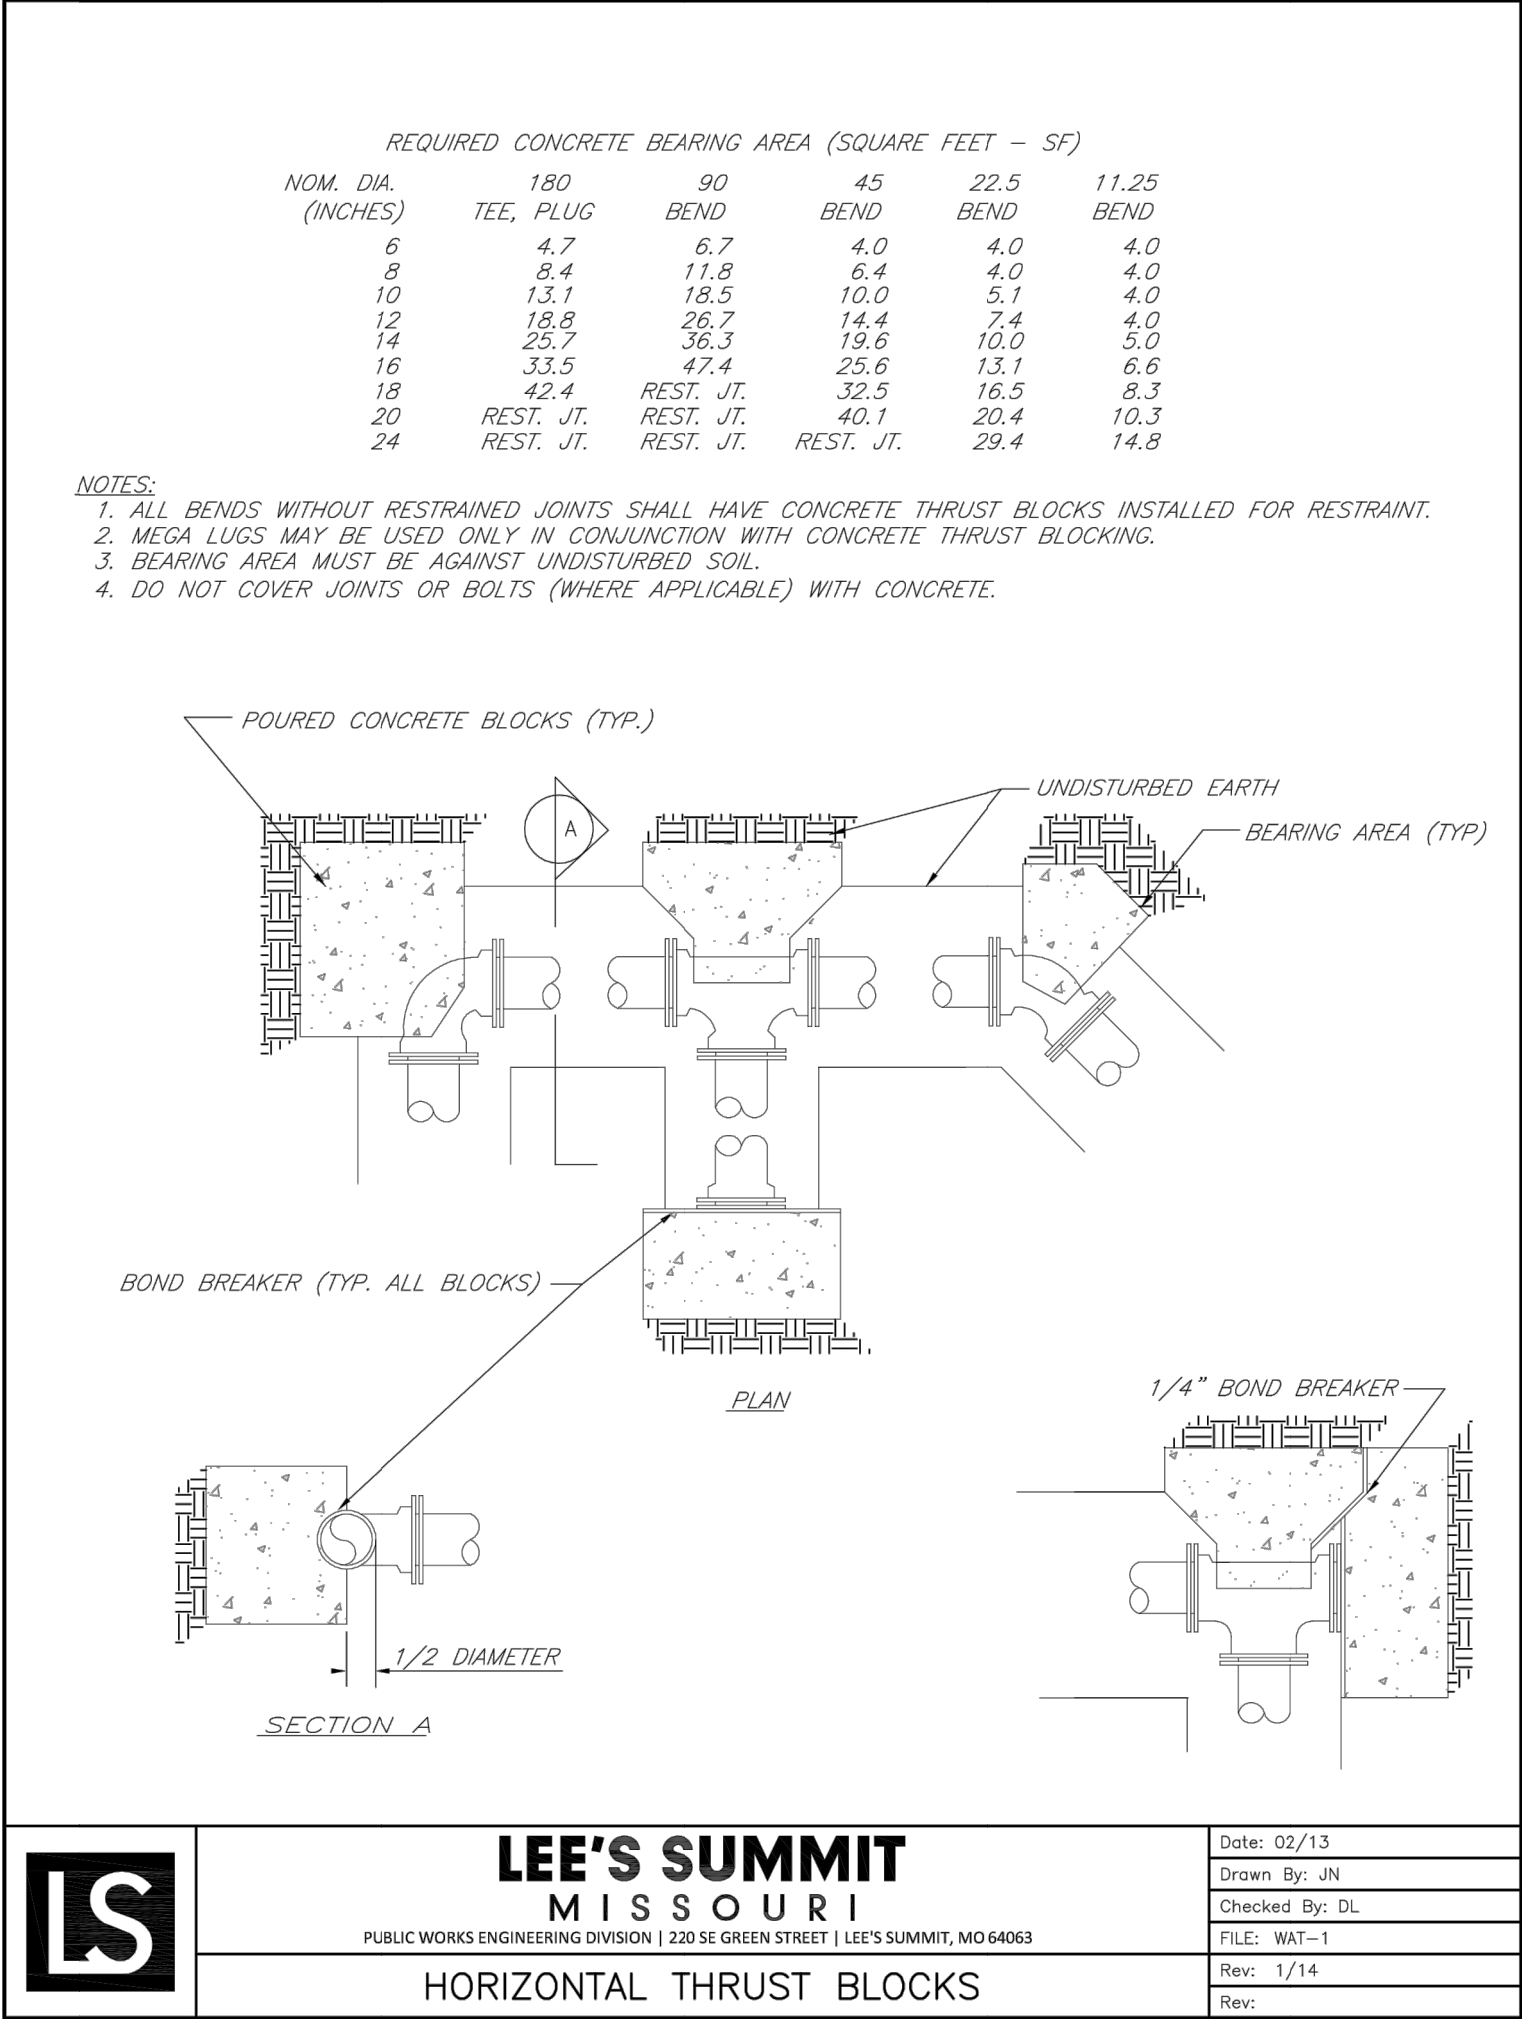

TRENCH AND BACKFILL DETAIL
N.T.S.

Accepted
Record Drawings

These plans have been reviewed for accuracy and are accepted for basic conformance to the approved construction drawings.

RECORD DRAWING
The information provided on this drawing conforms to construction records; it is not intended for construction, implementation or recording purposes; and it is solely based on information obtained by my firm.

"100-00 100.10", "4-00% 1.15% slope", or "8-inch HDPE-PVC pipe" are all typical examples of revisions that indicate that design data has been replaced with "as-built" information. All other data is as designed and has not been field verified.

Date: 6/2/2022
Certified by: Matthew J. Schlicht
Title: Engineer
Firm: Engineering Solutions