


SITE PLAN
SCALE: 1" = 50'

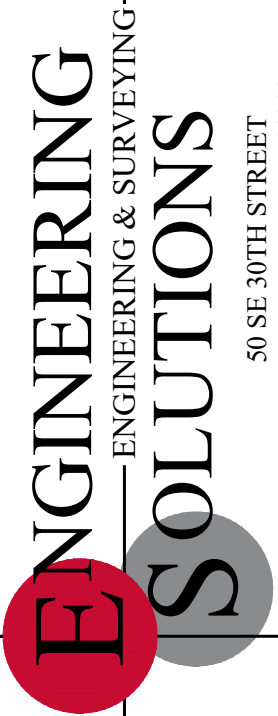


Professional Registration
Missouri
Engineering 2005002186-D
Surveying 2005008319-D
Kansas
Engineering E-1695
Surveying L-S-218
Oklahoma
Engineering 6254
Nebraska
Engineering CA2821

PARK RIDGE 8TH PLAT
Section 9, Township 48 North, Range 31 West
Lee's Summit, Jackson County, Missouri

Project: PARK RIDGE
Issue Date:
March 17, 2021

Site Plan
PARK RIDGE 8TH PLAT
Section 9, Township 48 North, Range 31 West
Lee's Summit, Jackson County, Missouri

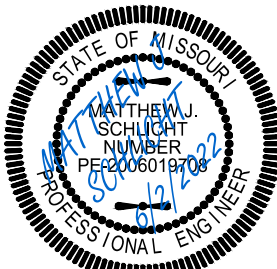

Matthew J. Schlicht
MO PE 2006019708
KS PE 19071
OK PE 25226
NE PE E-14335

REVISIONS
6/2/2022 As-Built

C.100




Accepted
Record Drawings

These plans have been reviewed for
accuracy and are accepted for basic
conformance to the approved
construction drawings.

RECORD DRAWING
The information provided on this drawing conforms to
construction records; it is not intended for construction,
implementation or recording purposes; and it is solely based
on information obtained by my firm.



"400-00 100.10", "4-00% 1.15% slope", or "8-inch HDPE-PVC
pipe" are all typical examples of revisions that indicate that
design data has been replaced with "as-built" information. All
other data is as designed and has not been field verified.

Date: 6/2/2022
Certified by: Matthew J. Schlicht
Title: Engineer
Firm: Engineering Solutions

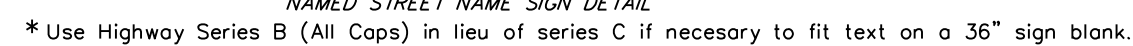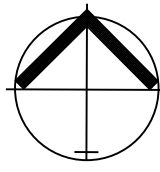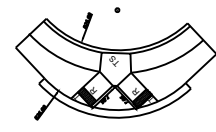

* The height to the bottom of a sign when it is located in a pedestrian walkway or extends into a walkway shall be a minimum of 80 inches above the walkway.

Date: 6/2/2022
 Certified by: Matthew J. Schlicht
 Title: Engineer
 Firm: Engineering Solutions

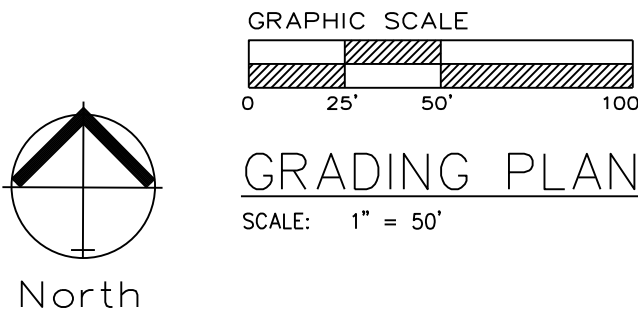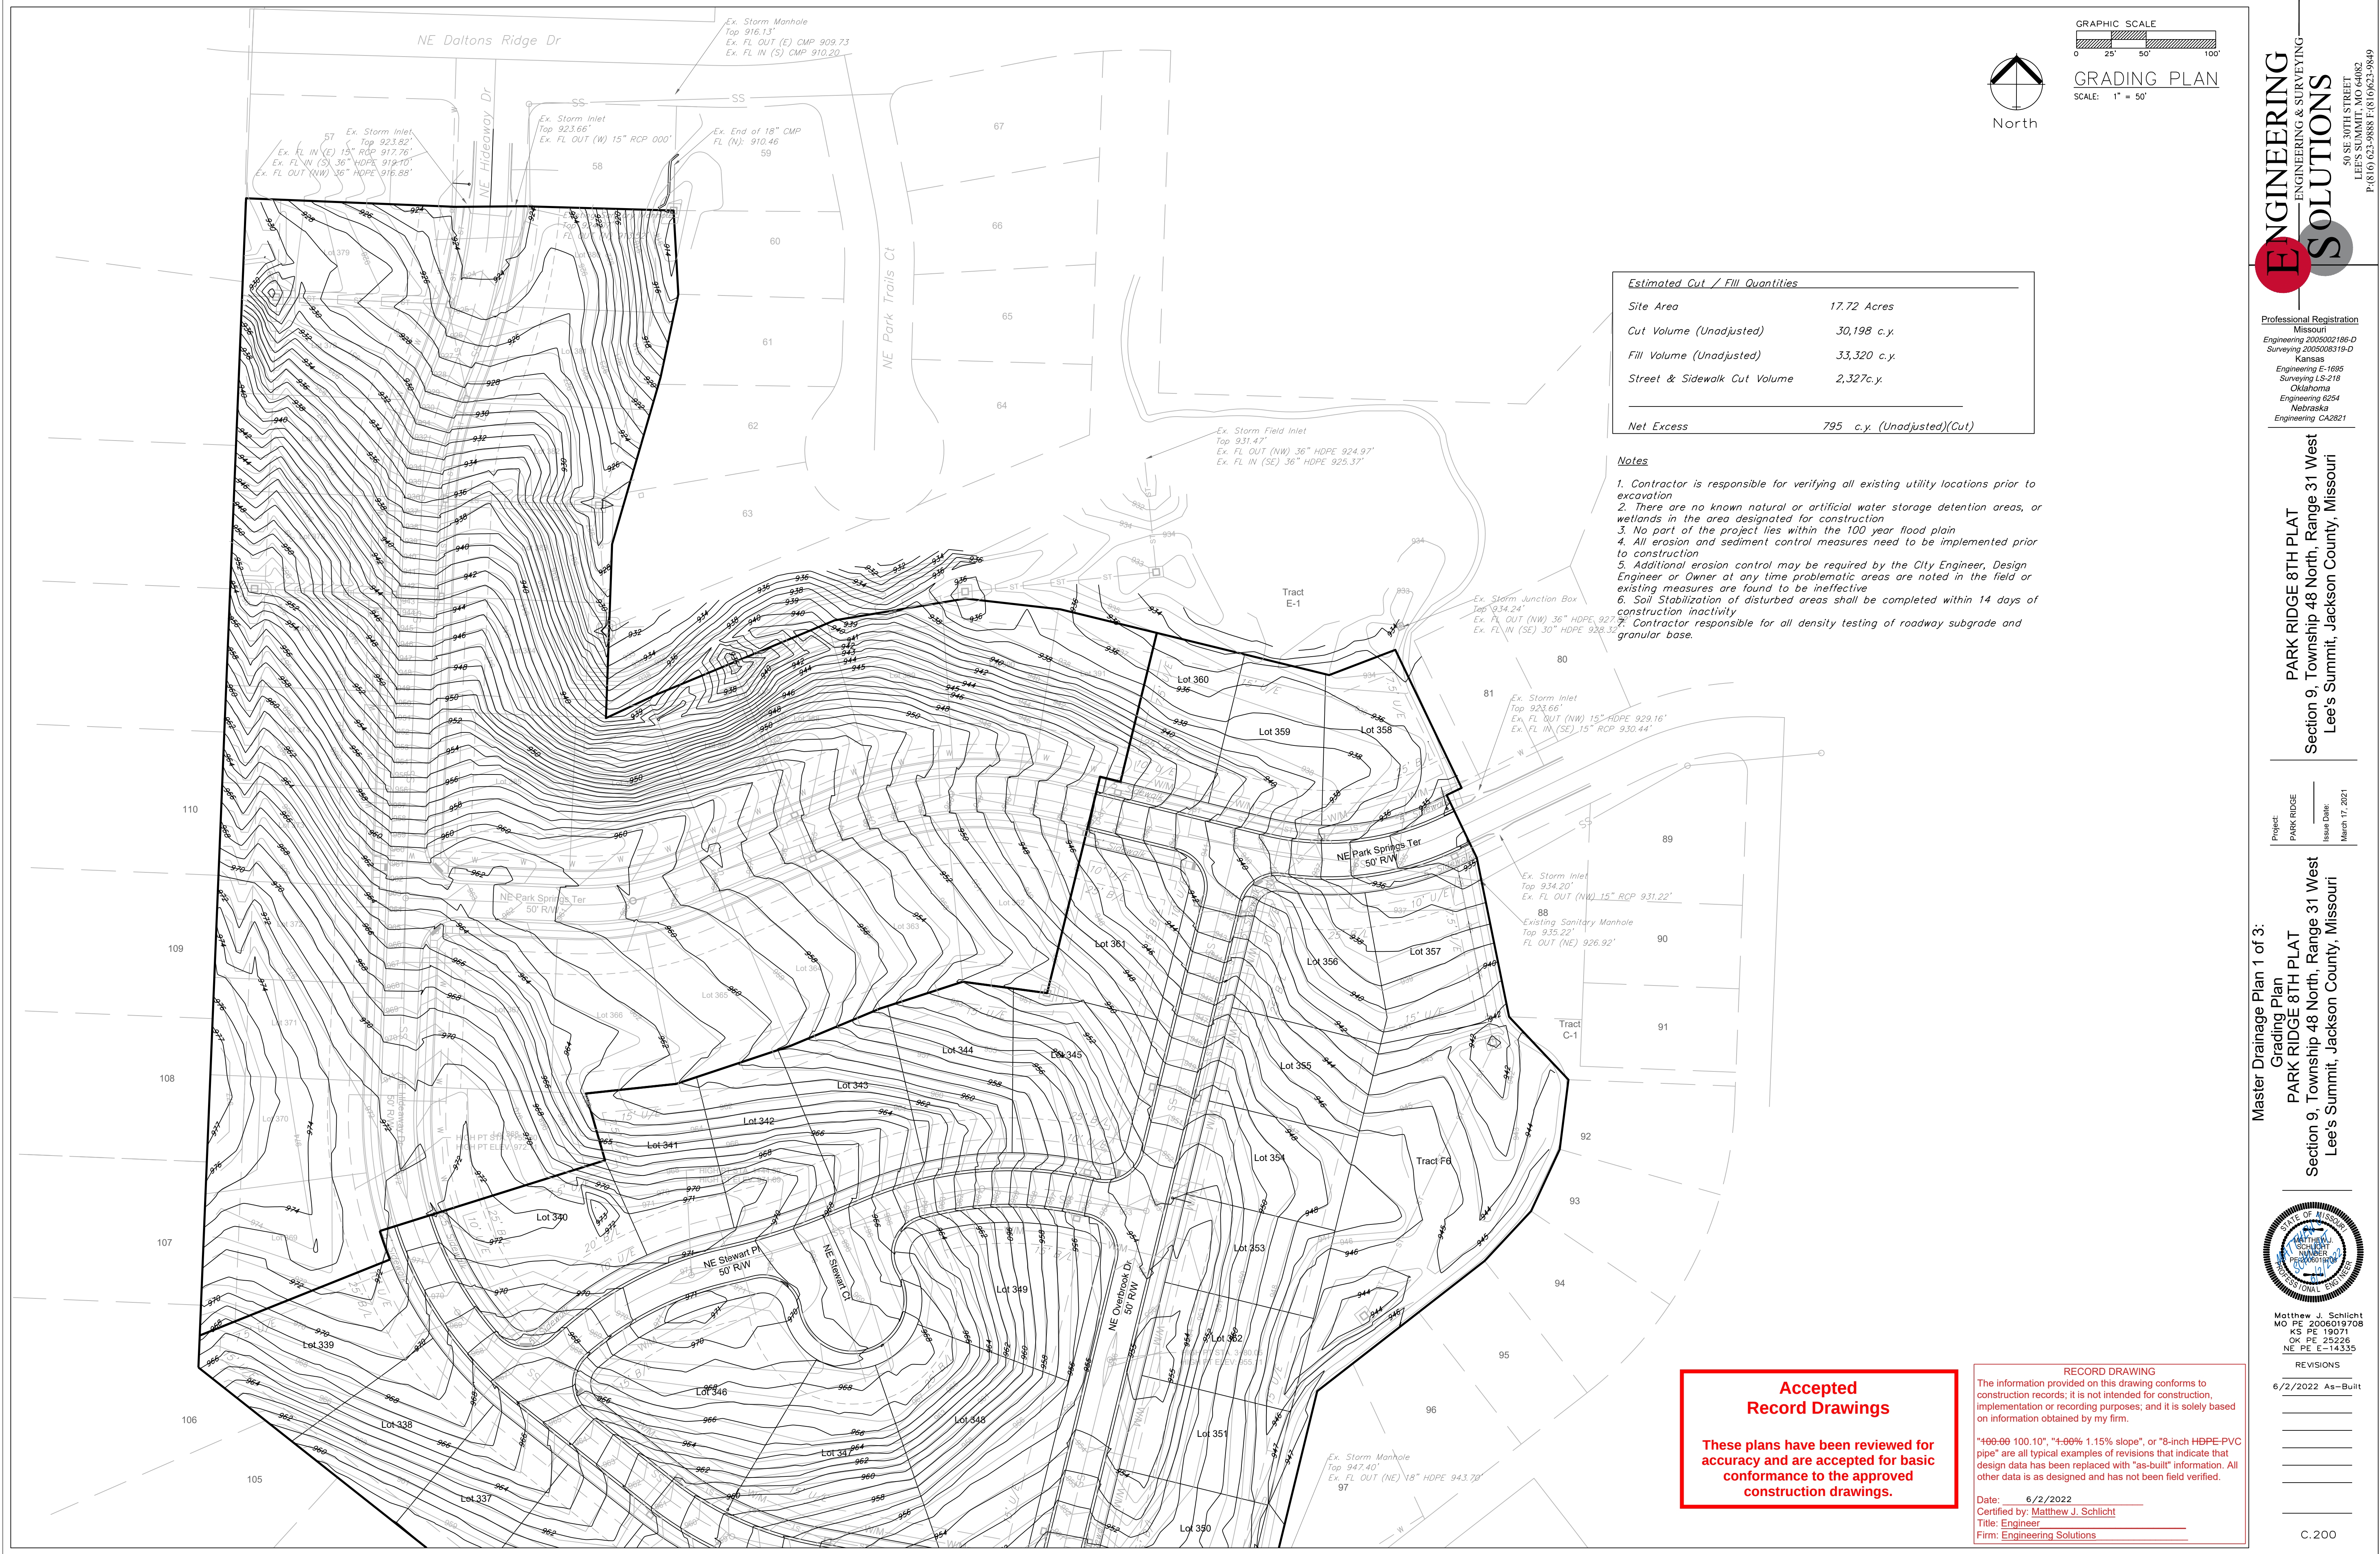

Estimated Cut / Fill Quantities	
Site Area	17.72 Acres
Cut Volume (Unadjusted)	30,198 c.y.
Fill Volume (Unadjusted)	33,320 c.y.
Street & Sidewalk Cut Volume	2,327c.y.
Net Excess	795 c.y. (Unadjusted)(Cut)

- Notes**
1. Contractor is responsible for verifying all existing utility locations prior to excavation
 2. There are no known natural or artificial water storage detention areas, or wetlands in the area designated for construction
 3. No part of the project lies within the 100 year flood plain
 4. All erosion and sediment control measures need to be implemented prior to construction
 5. Additional erosion control may be required by the City Engineer, Design Engineer or Owner at any time problematic areas are noted in the field or existing measures are found to be ineffective
 6. Soil Stabilization of disturbed areas shall be completed within 14 days of construction inactivity
 7. Contractor responsible for all density testing of roadway subgrade and granular base.

**Accepted
Record Drawings**

These plans have been reviewed for accuracy and are accepted for basic conformance to the approved construction drawings.

RECORD DRAWING
The information provided on this drawing conforms to construction records; it is not intended for construction, implementation or recording purposes; and it is solely based on information obtained by my firm.

"100-00 100.10", "4-00% 1.15% slope", or "8-inch HDPE-PVC pipe" are all typical examples of revisions that indicate that design data has been replaced with "as-built" information. All other data is as designed and has not been field verified.

Date: 6/2/2022
Certified by: Matthew J. Schlicht
Title: Engineer
Firm: Engineering Solutions

ENGINEERING SOLUTIONS
ENGINEERING & SURVEYING
50 SE 30TH STREET
LEE'S SUMMIT, MO 64082
P: (816) 623-9888 F: (816) 623-9849

Professional Registration
Missouri
Engineering 2005002186-D
Surveying 2005008319-D
Kansas
Engineering E-1695
Surveying LS-218
Oklahoma
Engineering 6254
Nebraska
Engineering CA2821


Project: PARK RIDGE
Issue Date: March 17, 2021

Master Drainage Plan 1 of 3:
Grading Plan
PARK RIDGE 8TH PLAT
Section 9, Township 48 North, Range 31 West
Lee's Summit, Jackson County, Missouri

Matthew J. Schlicht
MO PE 2006019708
KS PE 19071
OK PE 25226
NE PE E-14335

REVISIONS
6/2/2022 As-Built

C. 200

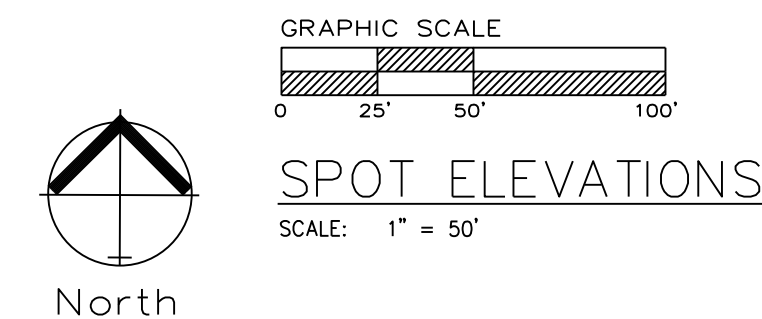

Lot Number	Basement Type	MBOE
362	Full	952.20
363	Full	
364	Full	
365	Full	
366	Full	
367	Full	
368	Full	
369	Daylight	
370	Full	
371	Full	
372	Full	
373	Full	
374	Full	
375	Full	
376	Full	
377	Full	
378	Full	
379	Full	
380	Walkout	
381	Walkout	
382	Walkout	
383	Walkout	
384	Walkout	
385	Walkout	
386	Walkout	
387	Walkout	
388	Walkout	
389	Walkout	
390	Walkout	
391	Walkout	

ENGINEERING
—ENGINEERING & SURVEYING—
SOLUTIONS

50 SE. 30TH STREET
LEES SUMMIT, MO 64082
PH (816) 621-9888 F (816) 623-9849


Professional Registration
Missouri
Engineering 2005002186-D
Surveying 2005003119-D
Kansas
Engineering E-1895
Surveying LS-218
Oklahoma
Engineering 6254
Nebraska
Engineering CA2821

PARK RIDGE 8TH PLAT
Section 9, Township 48 North, Range 31 West
Lee's Summit, Jackson County, Missouri

Project:
PARK RIDGE

Issue Date:
March 17, 2021

Master Drainage Plan 2 of 3:
Spot Elevations
PARK RIDGE 8TH PLAT
Section 9, Township 48 North, Range 31 West
Lee's Summit, Jackson County, Missouri

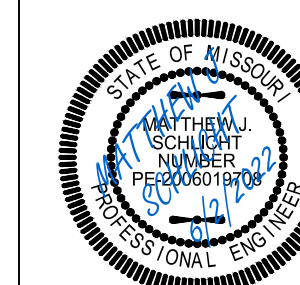

Matthew J. Schlie
MO PE 20060197
KS PE 19071
OK PE 25226
NE PE E-1433

REVISIONS

6/2/2022 As-Bu

C.201

Accepted
Record Drawings

These plans have been reviewed for accuracy and are accepted for basic conformance to the approved construction drawings.

RECORD DRAWING

The information provided on this drawing conforms to construction records; it is not intended for construction, implementation or recording purposes; and it is solely based on information obtained by my firm.



"400-60 100.10", "t-00% 1.5% slope", or "8-inch HDPE-PV pipe" are all typical examples of revisions that indicate that design data has been replaced with "as-built" information. All other data is as designed and has not been field verified.

Date: 6/2/2022



Certified by: Matthew J. Schlicht

Title: Engineer

Firm: Engineering Solutions

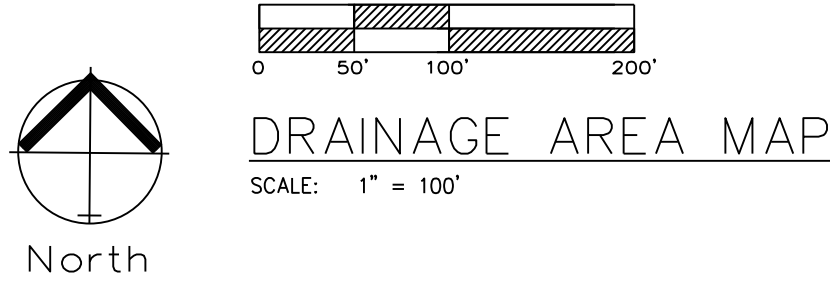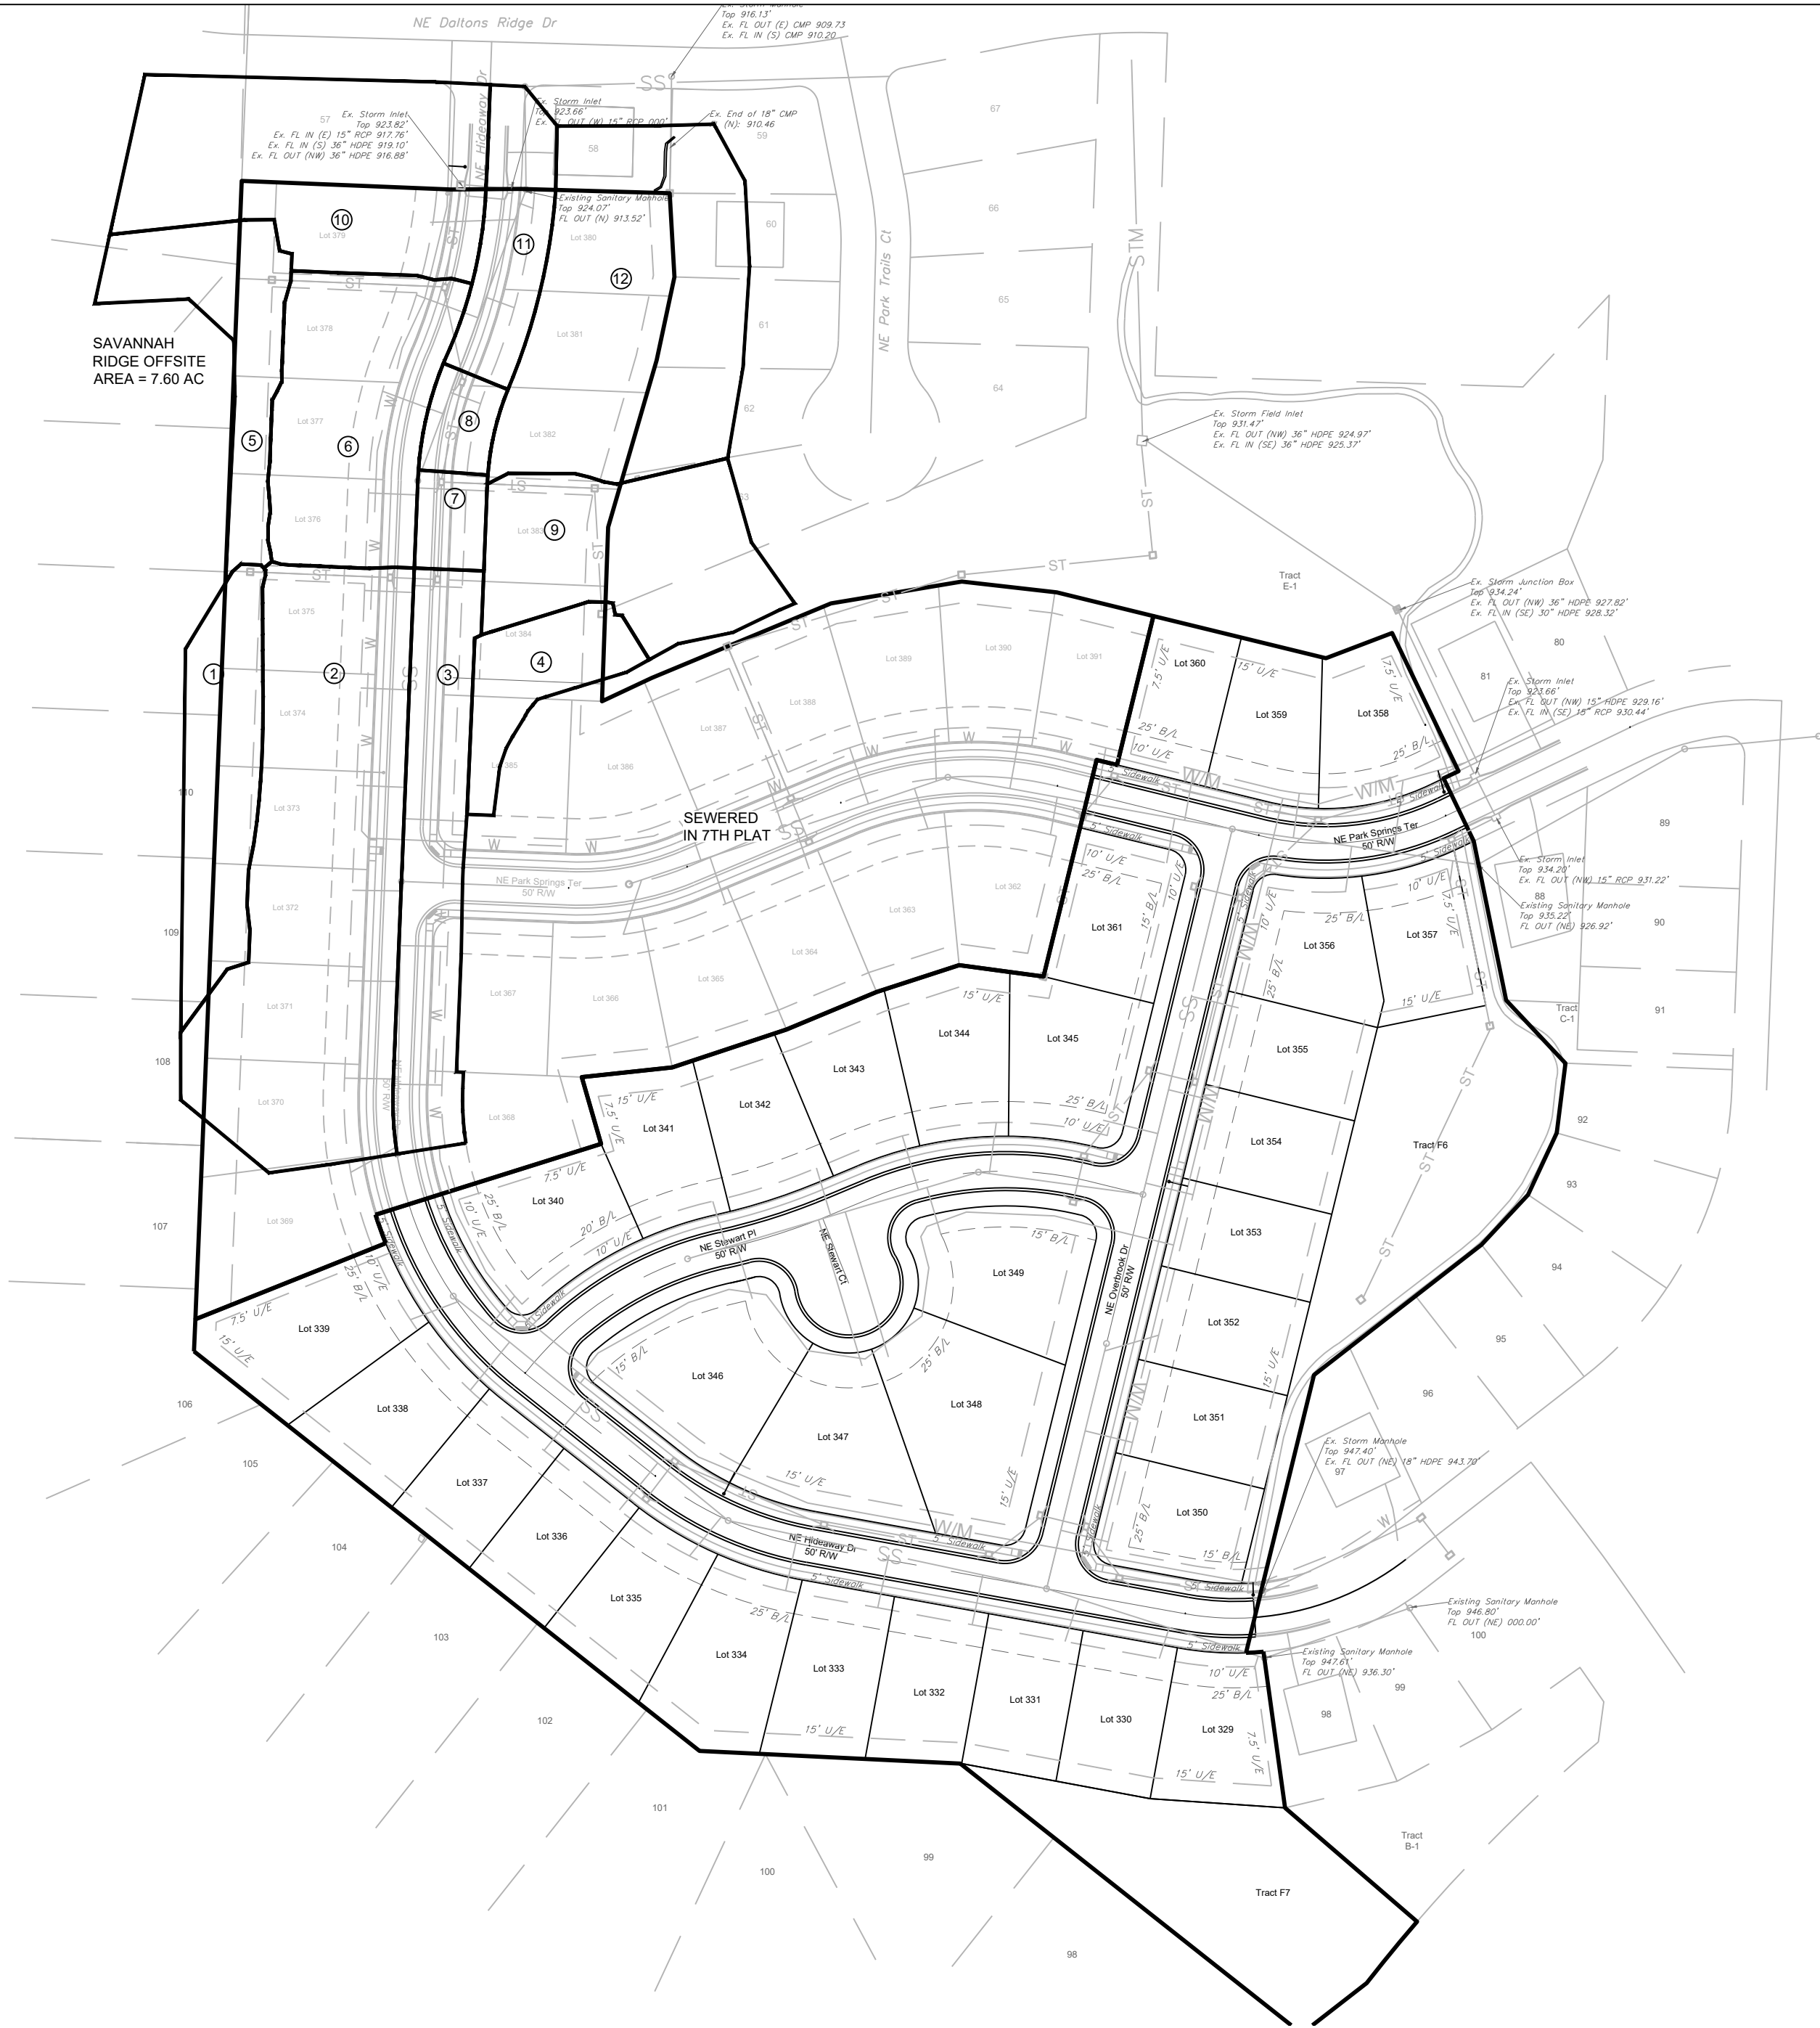

APWA STORM DRAINAGE "TC" COMPUTATIONS FOR : PARK RIDGE 8TH PLAT																											
yellow areas are self computing overwrite if necessary				Surface types:		Asph/Conc/Bus/Com		Dirt		Grass/Park		Lake		MultFam		SnglFam		Undev		Other							
				SURFACE CODES		A		B		D		G		L		M		S		U		Z					
				"C" Values		0.90		0.87		0.60		0.30		0.90		0.66		0.51		0.3							
				TOTAL WATERSHED																		TC COMPUTATION					

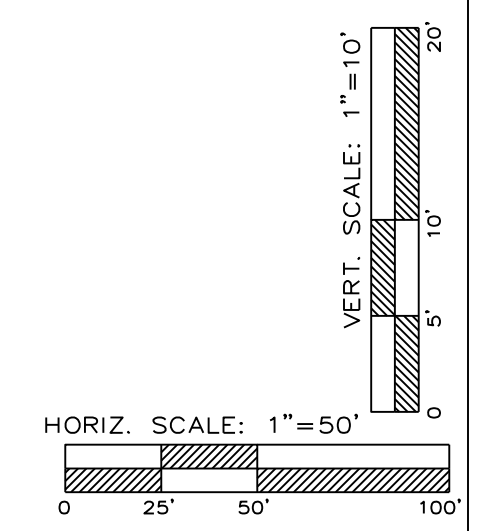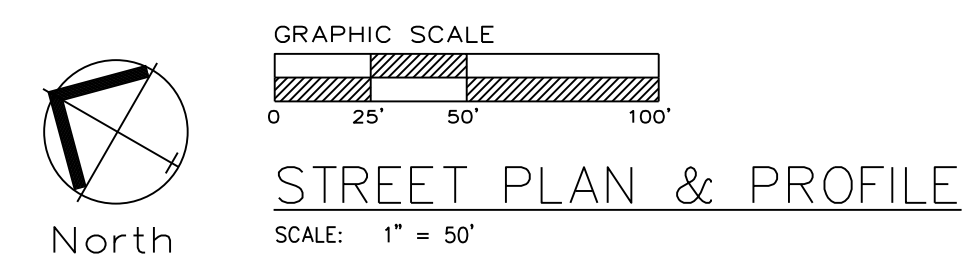

RECORD DRAWING

The information provided on this drawing conforms to construction records it is not intended for construction, implementation or recording purposes; and it is solely based on information obtained by my firm.

"400-00 100.10, "4-00% 1.15% slope", or 8-inch HDPE-PVC pipe" are all typical examples of revisions that indicate that design data has been replaced with "as-built" information. All other data is as designed and has not been field verified.

Date: 6/2/2022

Certified by: Matthew J. Schlicht



Title: Engineer

Firm: Engineering Solutions



NE PARK SPRINGS TERRACE

Revised street name.

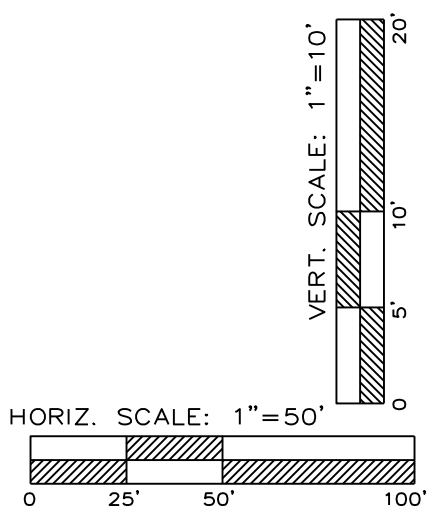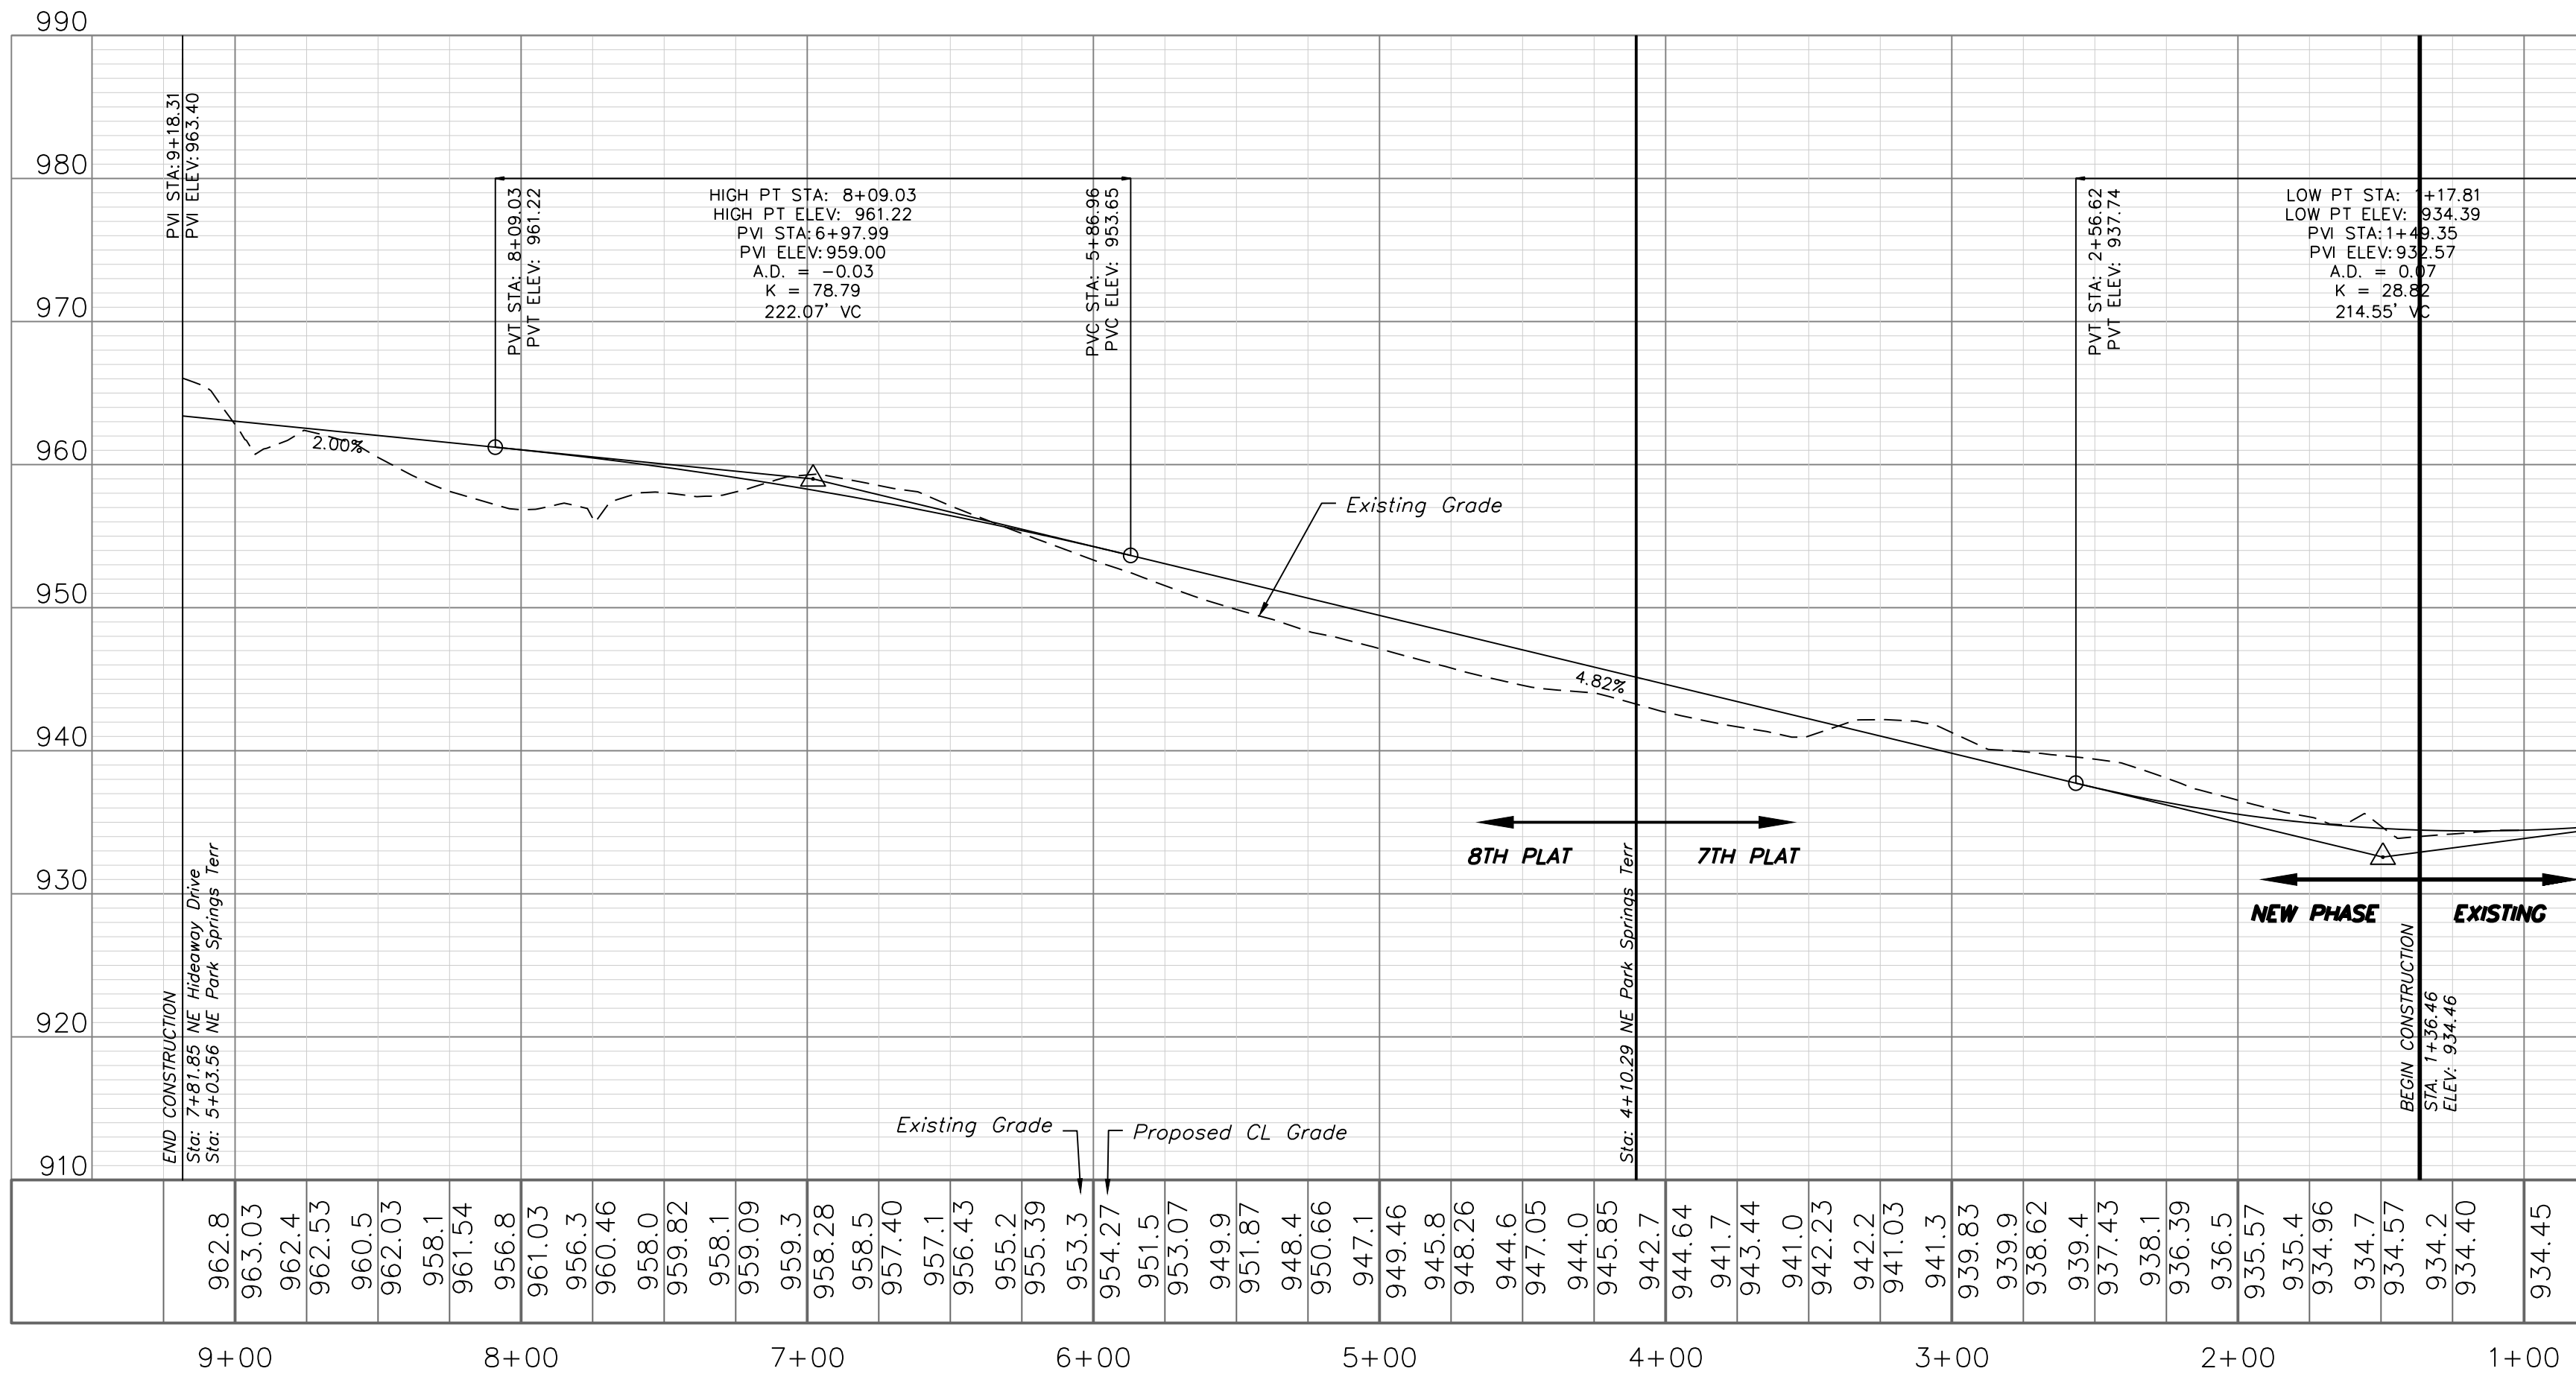


**Accepted
Record Drawings**

These plans have been reviewed for accuracy and are accepted for basic conformance to the approved construction drawings.

RECORD DRAWING
The information provided on this drawing conforms to construction records; it is not intended for construction, implementation or recording purposes; and it is solely based on information obtained by my firm.

Date: 6/2/2022
Certified by: Matthew J. Schlicht
Title: Engineer
Firm: Engineering Solutions

"400-00 100.10", "4-00% 1.15% slope", or "8-inch HDPE-PVC pipe" are all typical examples of revisions that indicate that design data has been replaced with "as-built" information. All other data is as designed and has not been field verified.

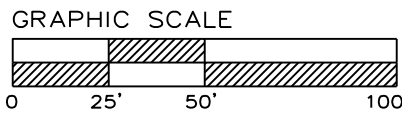

STREET PLAN & PROFILE
SCALE: 1" = 50'




Professional Registration
Missouri
Engineering 2005002186-D
Surveying 2005008319-D
Kansas
Engineering E-1685
Surveying LS-218
Oklahoma
Engineering 6254
Nebraska
Engineering CA2821

PARK RIDGE 8TH PLAT
Section 9, Township 48 North, Range 31 West
Lee's Summit, Jackson County, Missouri



Project: PARK RIDGE
Issue Date: March 17, 2021

Street Plan and Profile
PARK RIDGE 8TH PLAT
Section 9, Township 48 North, Range 31 West
Lee's Summit, Jackson County, Missouri

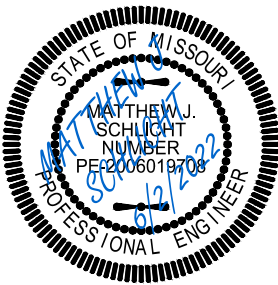

Matthew J. Schlicht
MO PE 2006019708
KS PE 19071
OK PE 25226
NE PE E-14335

REVISIONS
6/2/2022 As-Built

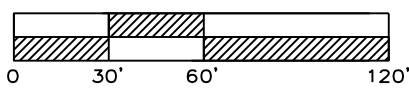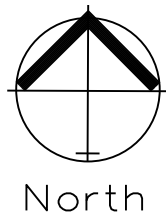

STORM SEWER GENERAL LAYOUT

SCALE: 1" = 60'




Professional Registration
Missouri
Engineering 2005002186-D
Surveying 2005008319-D
Kansas
Engineering E-1695
Surveying LS-218
Oklahoma
Engineering 6254
Nebraska
Engineering CA2821

PARK RIDGE 8TH PLAT
Section 9, Township 48 North, Range 31 West
Lee's Summit, Jackson County, Missouri

Project: PARK RIDGE
Issue Date: March 17, 2021

Storm Sewer General Layout
PARK RIDGE 8TH PLAT
Section 9, Township 48 North, Range 31 West
Lee's Summit, Jackson County, Missouri

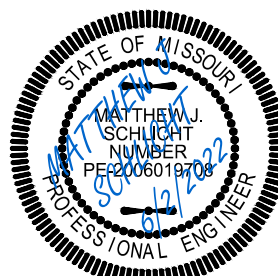

Matthew J. Schlicht
MO PE 2006019708
KS PE 19071
OK PE 25226
NE PE E-1-14335

REVISIONS	
6/2/2022	As-Built

C. 300

**Accepted
Record Drawings**



These plans have been reviewed for accuracy and are accepted for basic conformance to the approved construction drawings.

RECORD DRAWING
The information provided on this drawing conforms to construction records; it is not intended for construction, implementation or recording purposes; and it is solely based on information obtained by my firm.


"400-00 100.10", "4-00% 1.15% slope", or "8-inch HDPE-PVC pipe" are all typical examples of revisions that indicate that design data has been replaced with "as-built" information. All other data is as designed and has not been field verified.

Date: 6/2/2022
Certified by: Matthew J. Schlicht
Title: Engineer
Firm: Engineering Solutions




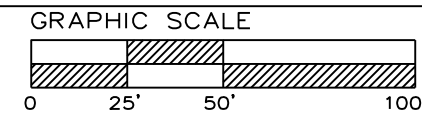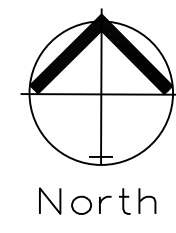

STORM SEWER PLAN & PROFILE
SCALE: 1" = 50'

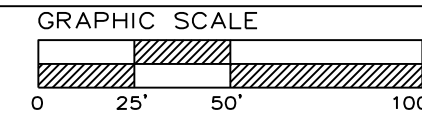


STORM SEWER PLAN & PROFILE
SCALE: 1" = 50'

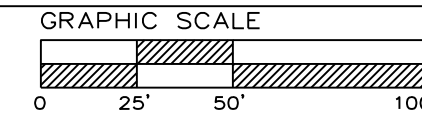



STORM SEWER PLAN & PROFILE
SCALE: 1" = 50'

Note:


Compacted Fill shall be placed to a minimum 18" above the top of the pipe prior to installation.

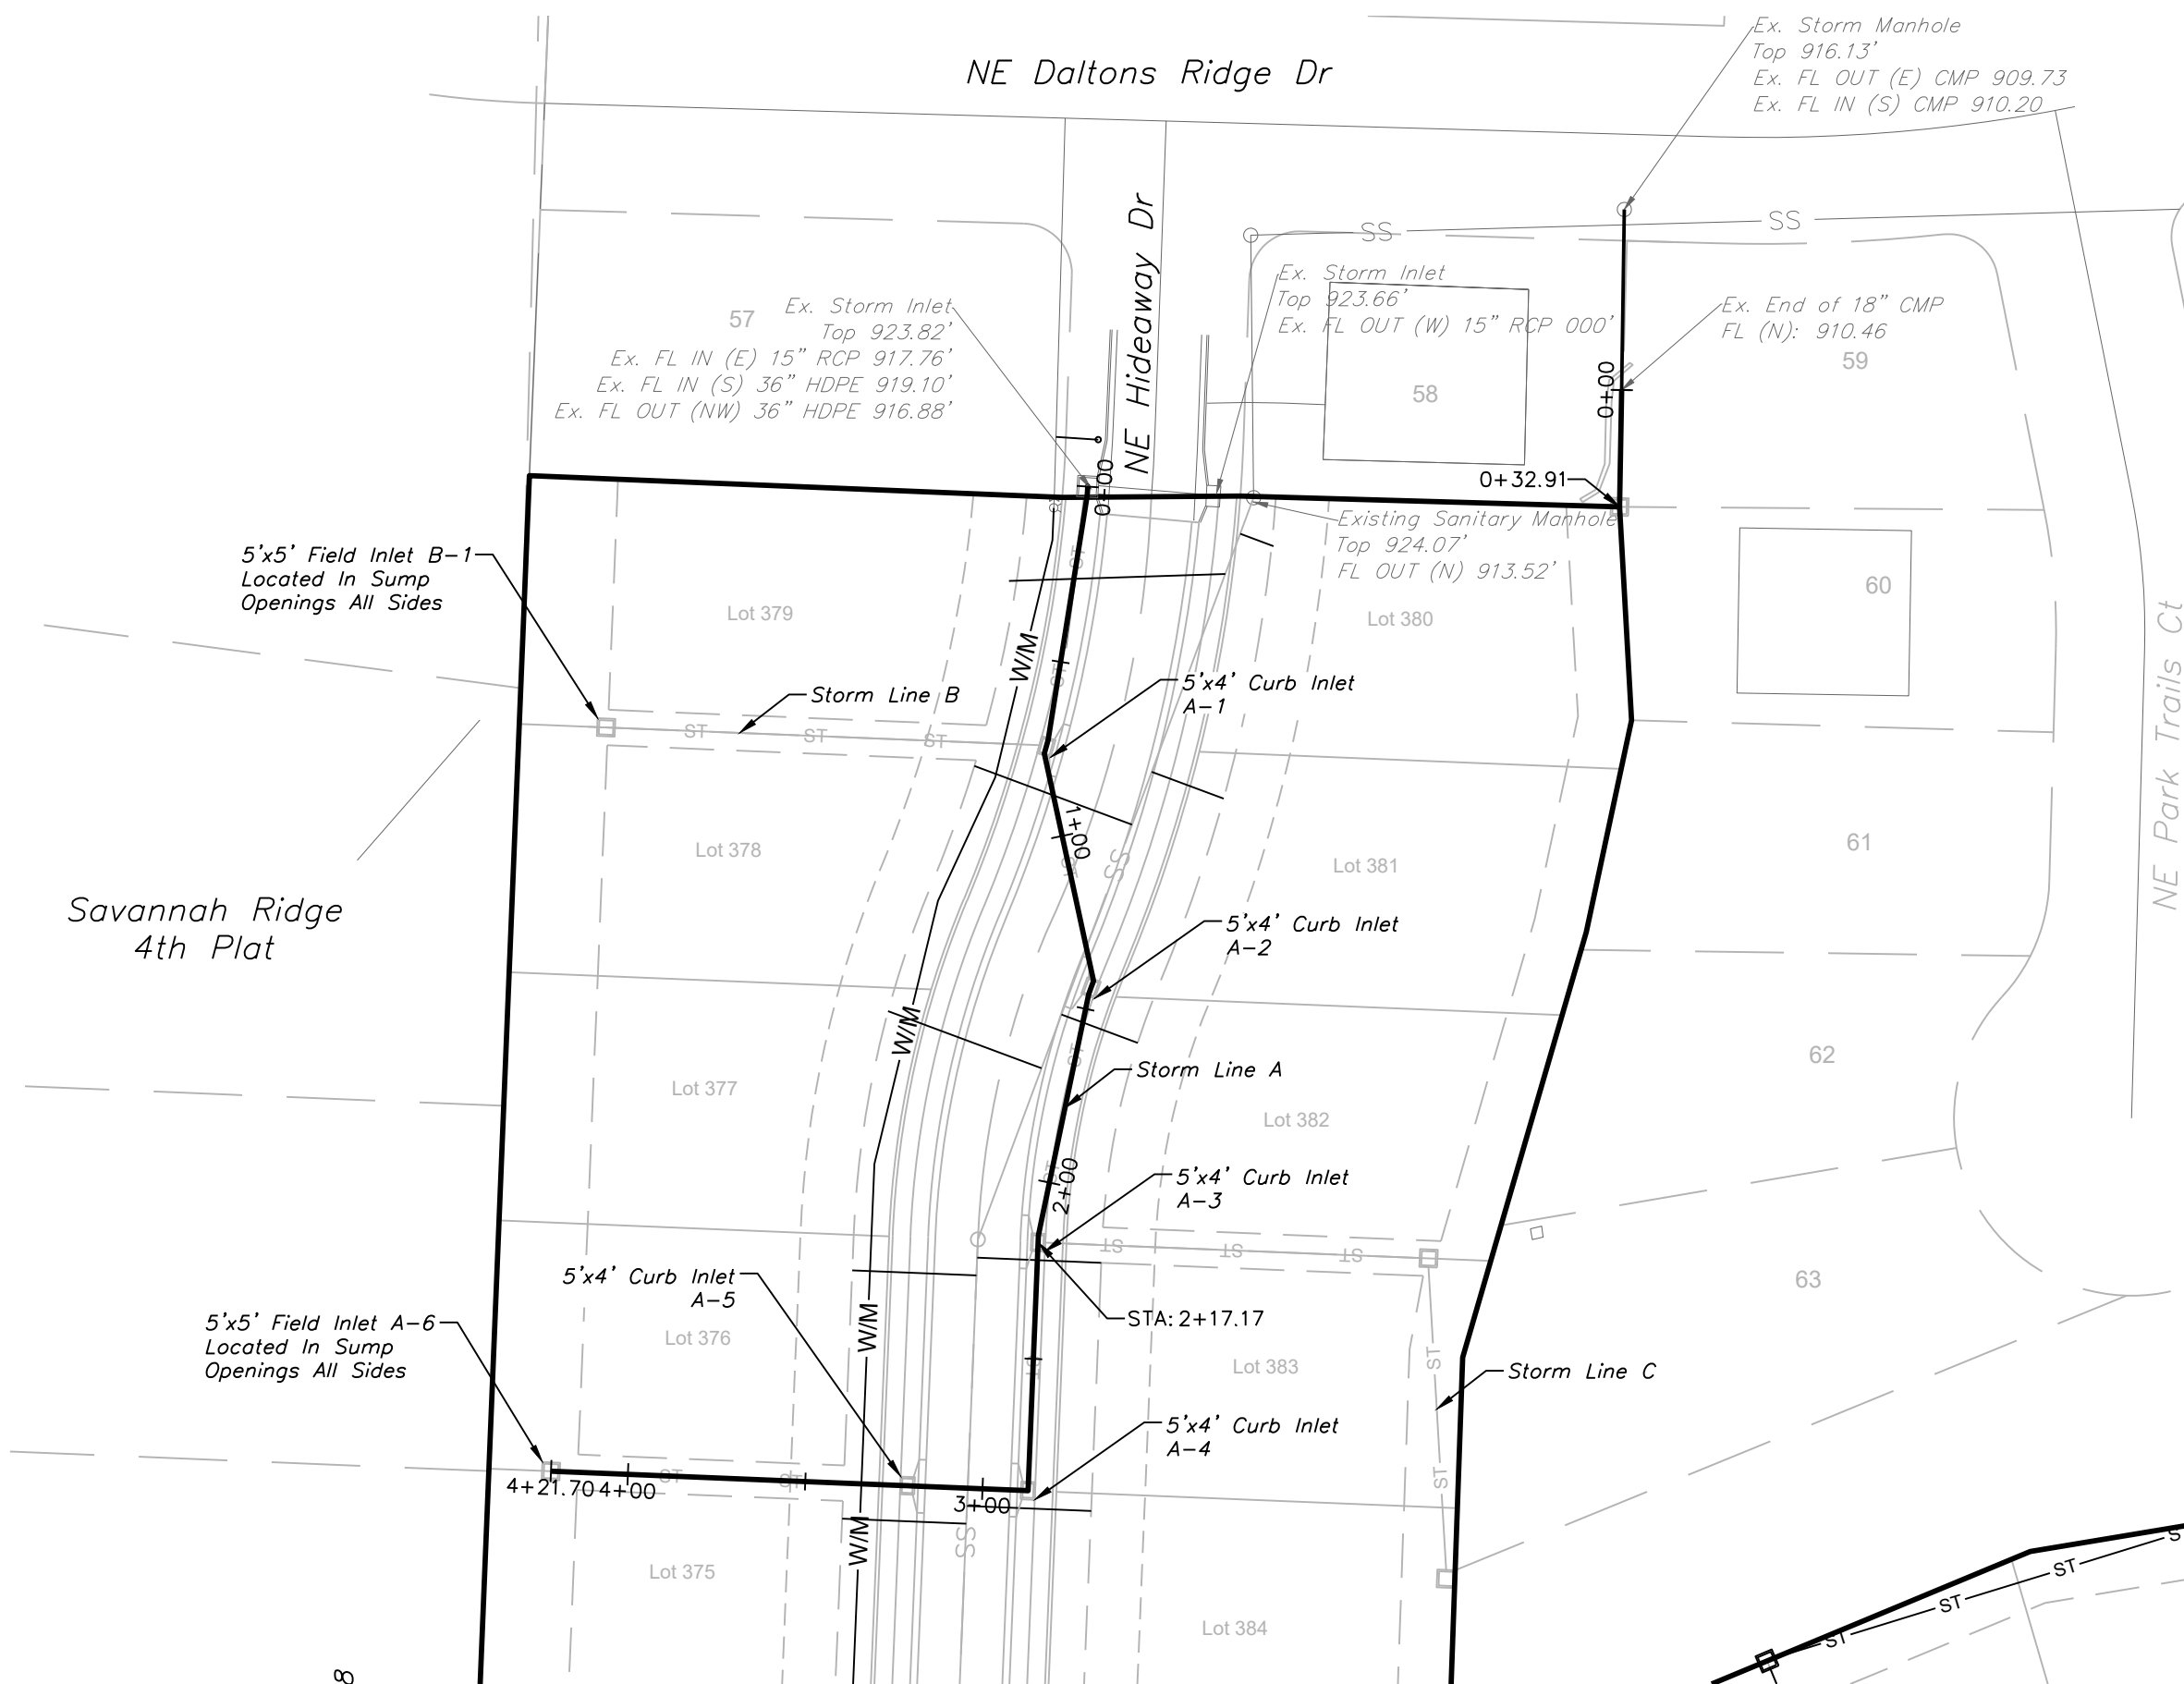


STORM LINE A

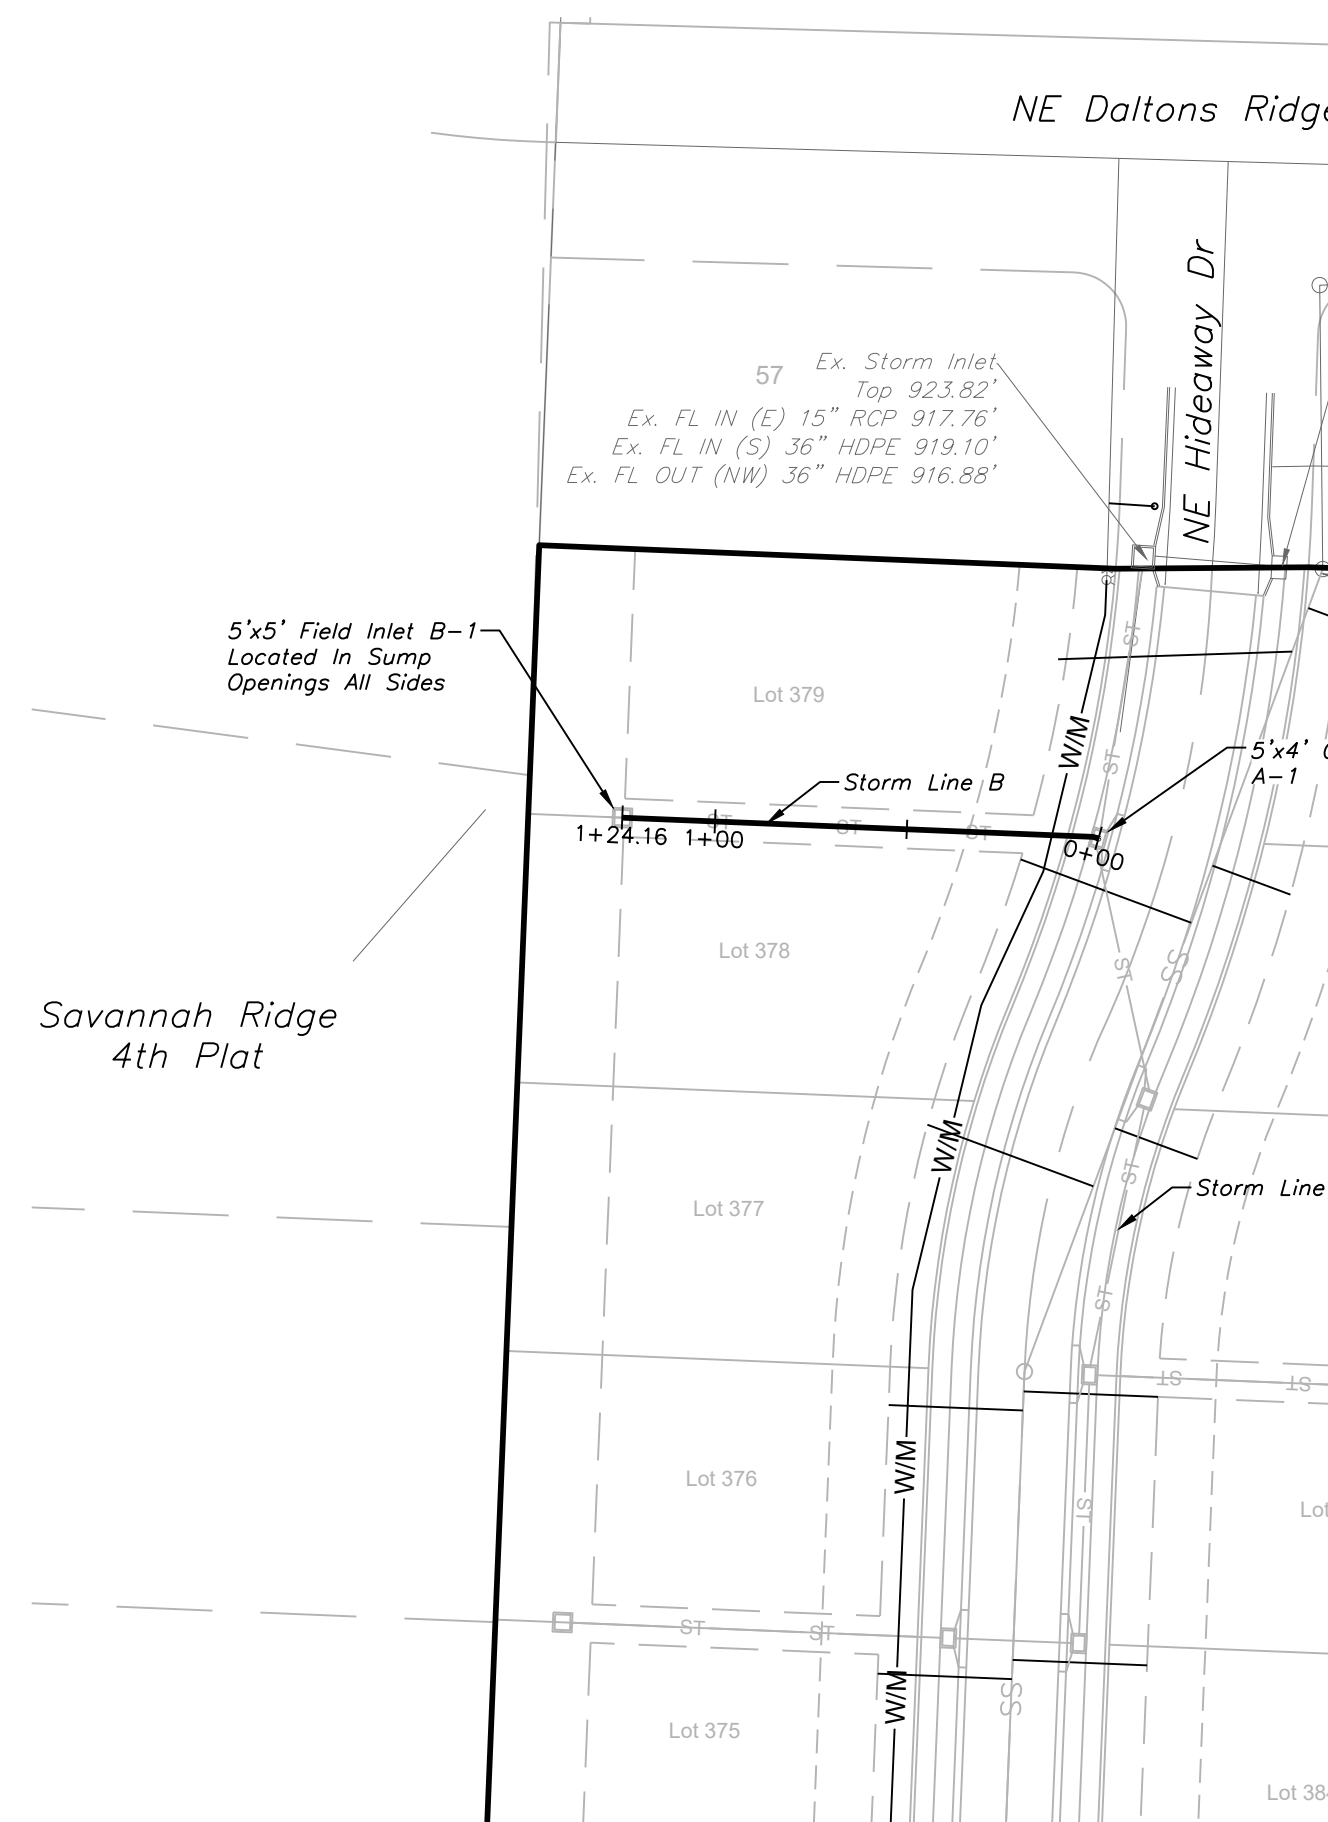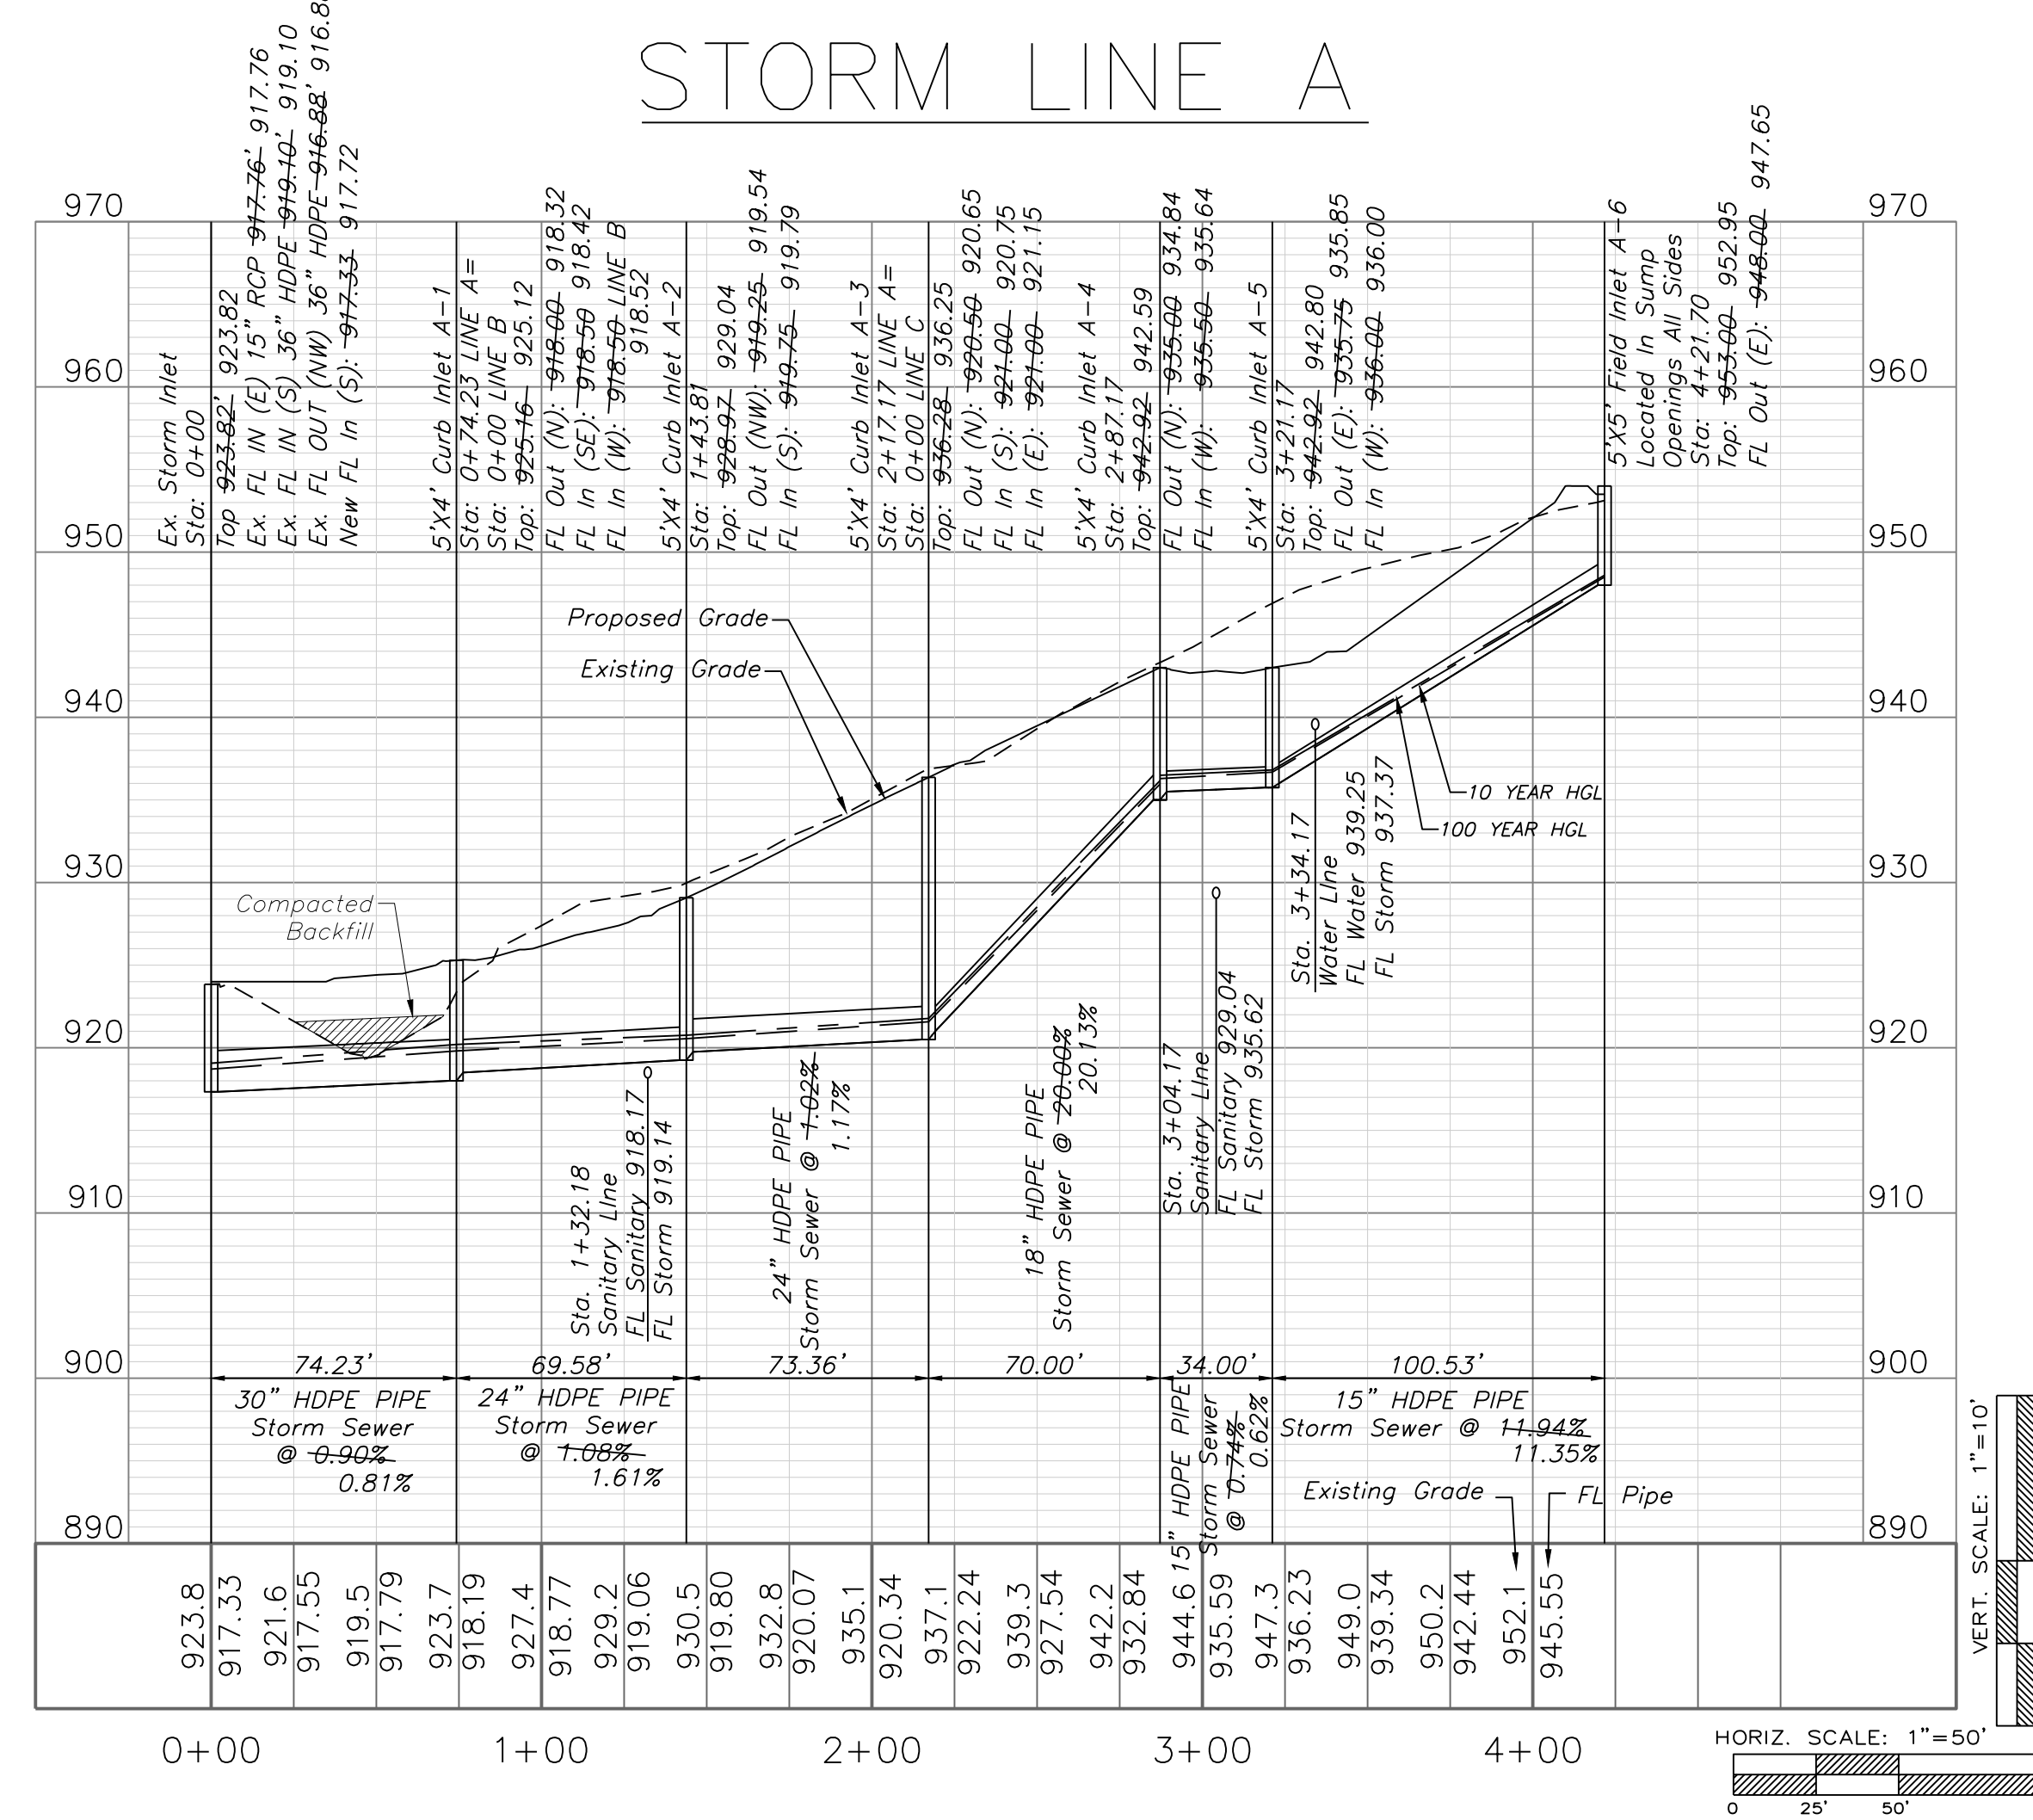

STORM LINE B

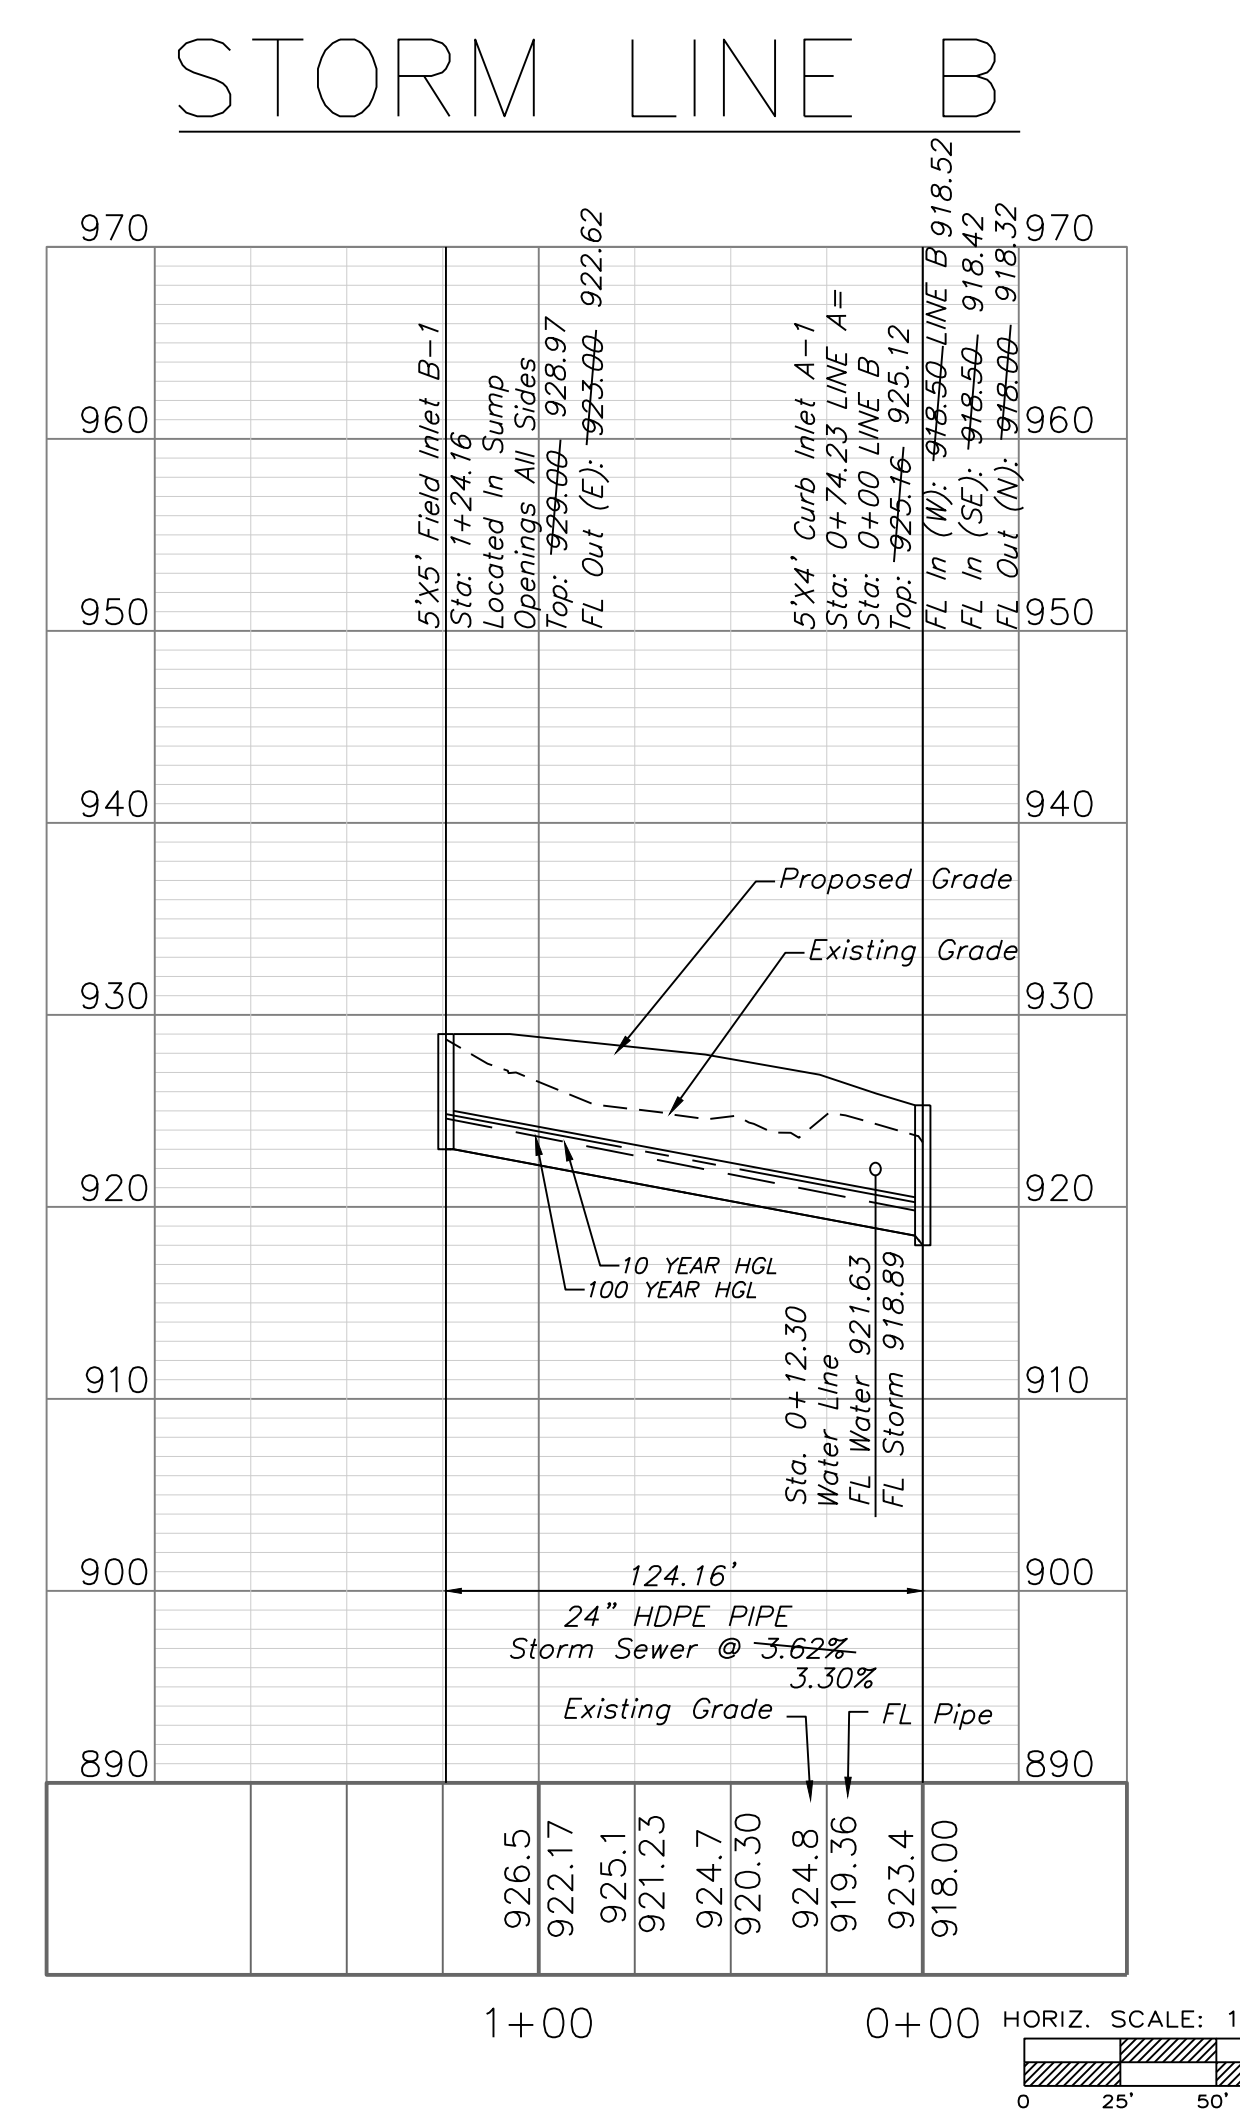

STORM LINE C

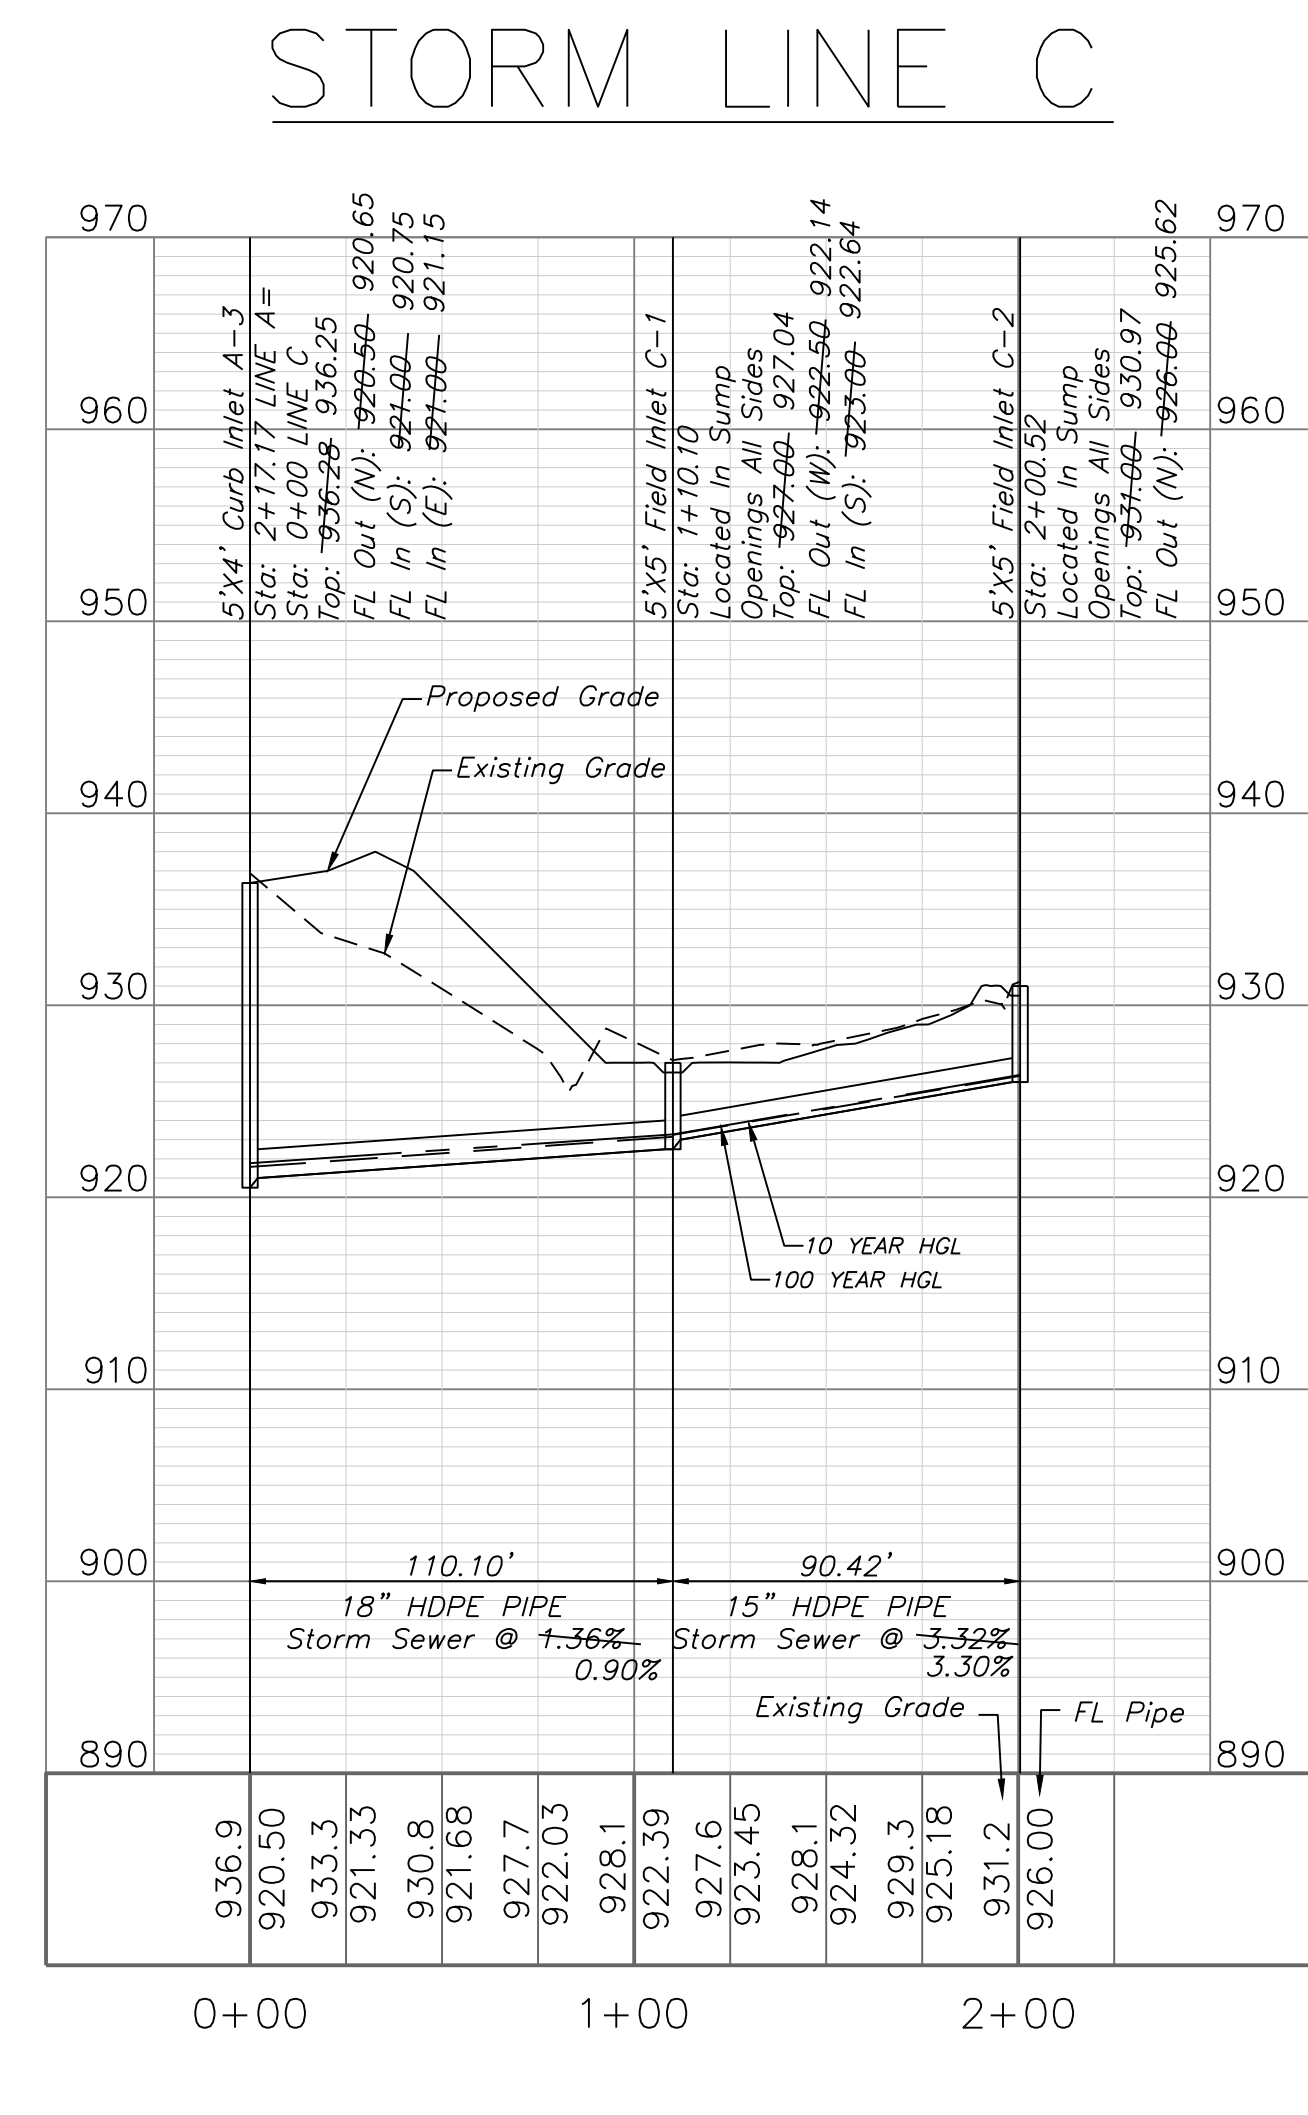

**Accepted
Record Drawings**

These plans have been reviewed for accuracy and are accepted for basic conformance to the approved construction drawings.

RECORD DRAWING

The information provided on this drawing conforms to construction records; it is not intended for construction, implementation or recording purposes; and it is solely based on information obtained by my firm.

"400-00 100.10", "4+00% 1.15% slope", or "8-inch HDPE-PVC pipe" are all typical examples of revisions that indicate that design data has been replaced with "as-built" information. All other data is as designed and has not been field verified.

Date: 6/2/2022
Certified by: Matthew J. Schlicht
Title: Engineer
Firm: Engineering Solutions




Professional Registration
Missouri
Engineering 2005002186-D
Surveying 200500319-D
Kansas
Engineering E-1695
Surveying LS-218
Oklahoma
Engineering 6254
Nebraska
Engineering CA2821

PARK RIDGE 8TH PLAT
Section 9, Township 48 North, Range 31 West
Lee's Summit, Jackson County, Missouri

Project:
PARK RIDGE
Issue Date:
March 17, 2021

Storm Sewer Plan and Profile
PARK RIDGE 8TH PLAT
Section 9, Township 48 North, Range 31 West
Lee's Summit, Jackson County, Missouri


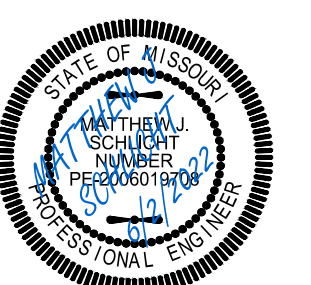


Matthew J. Schlicht
MO PE 2006019708
KS PE 19071
OK PE 25226
NE PE E-1-143355

REVISIONS
6/2/2022 As-Built


Note:

Compacted Fill shall be placed to a minimum 18" above the top of the pipe prior to installation.

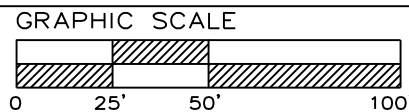
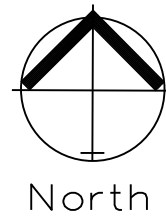


STORM SEWER PLAN & PROFILE

SCALE: 1" = 50'

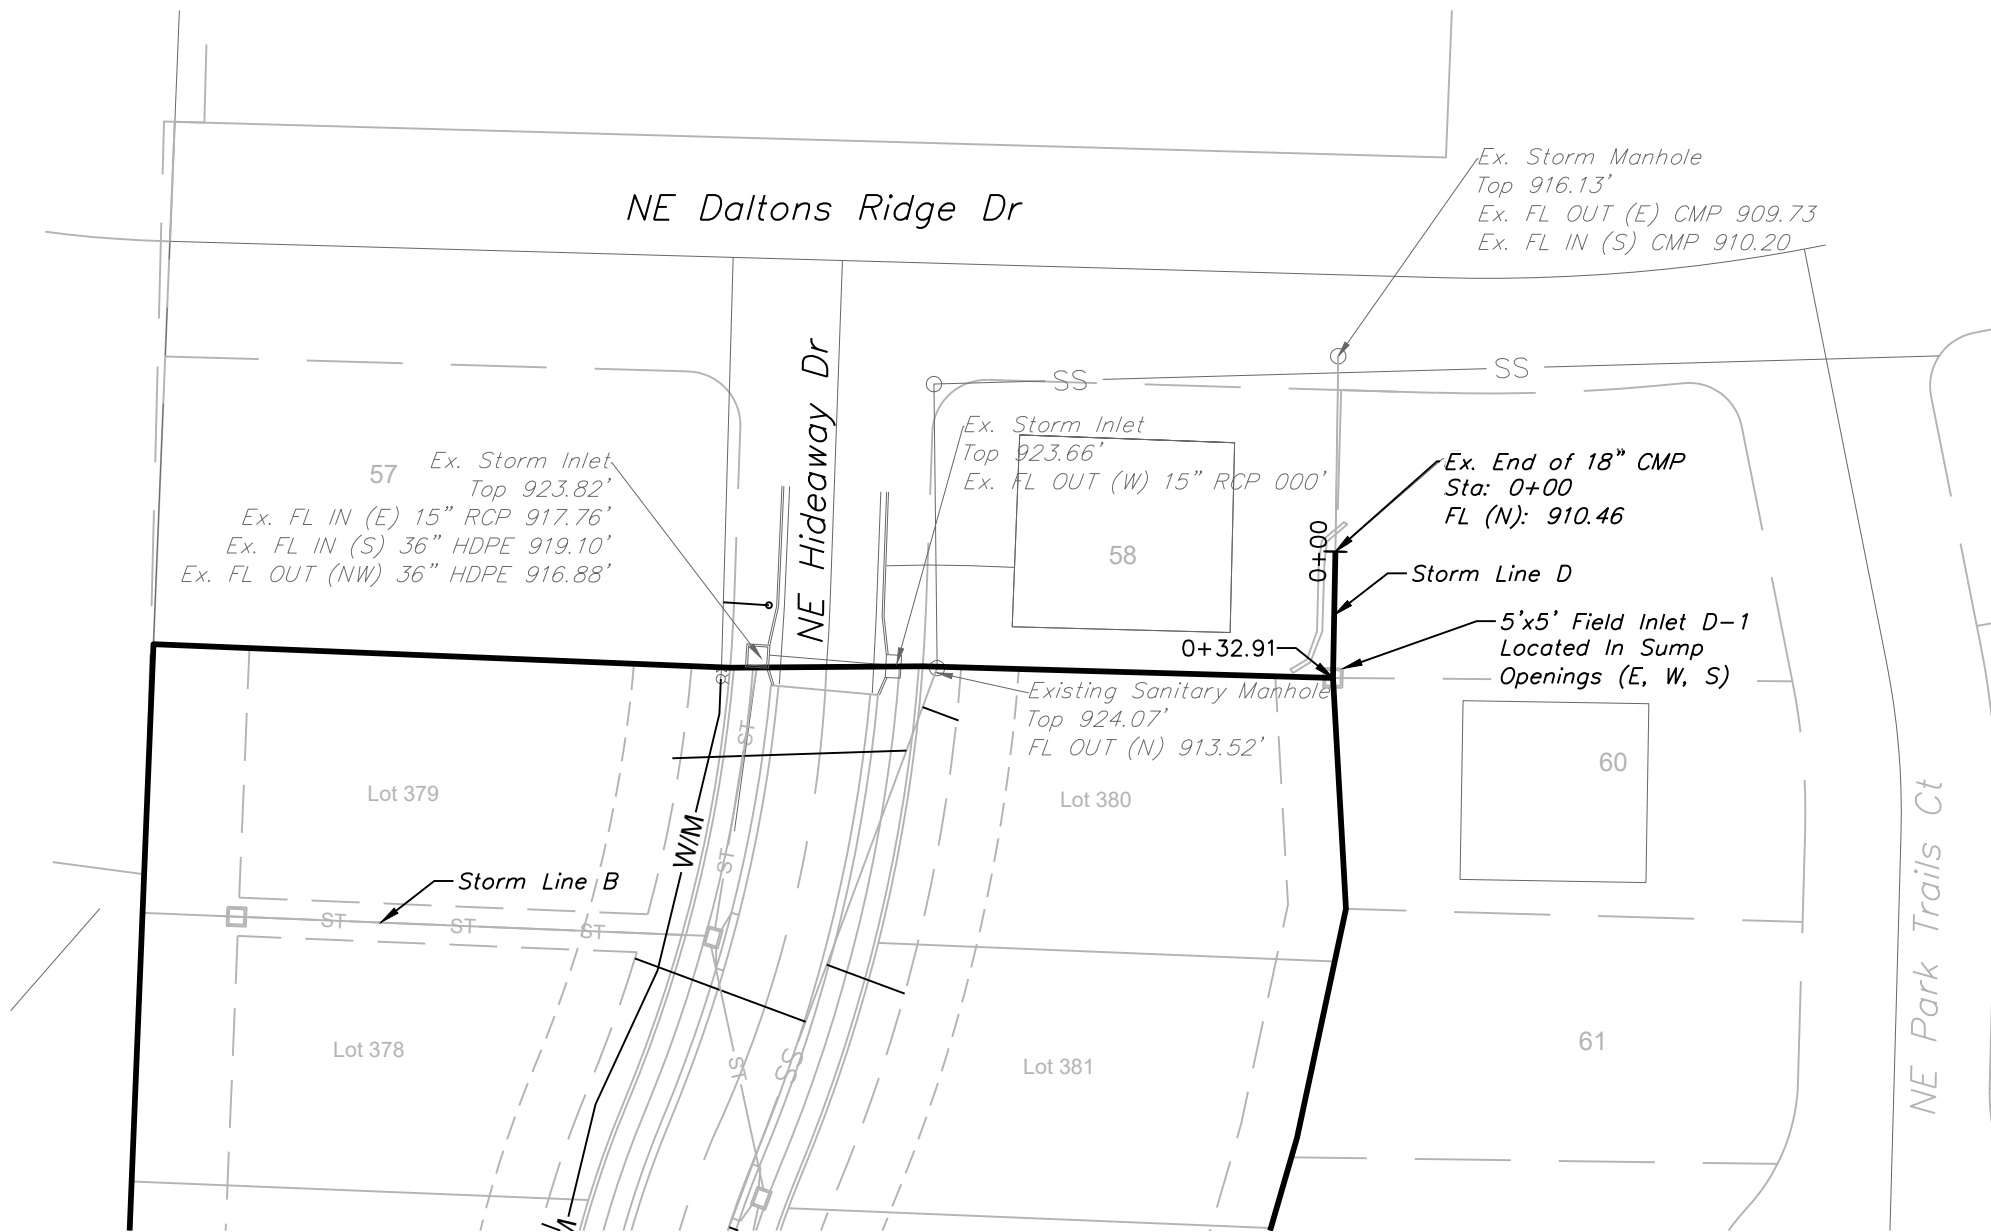

STORM LINE D

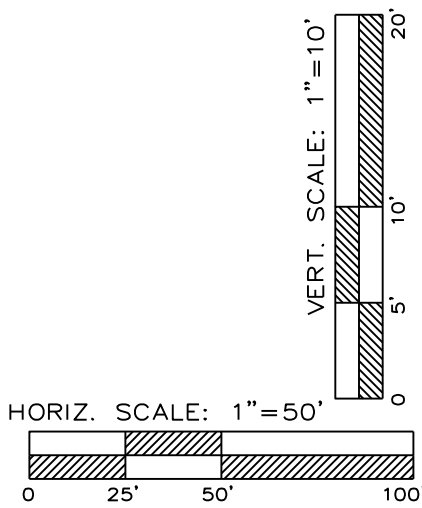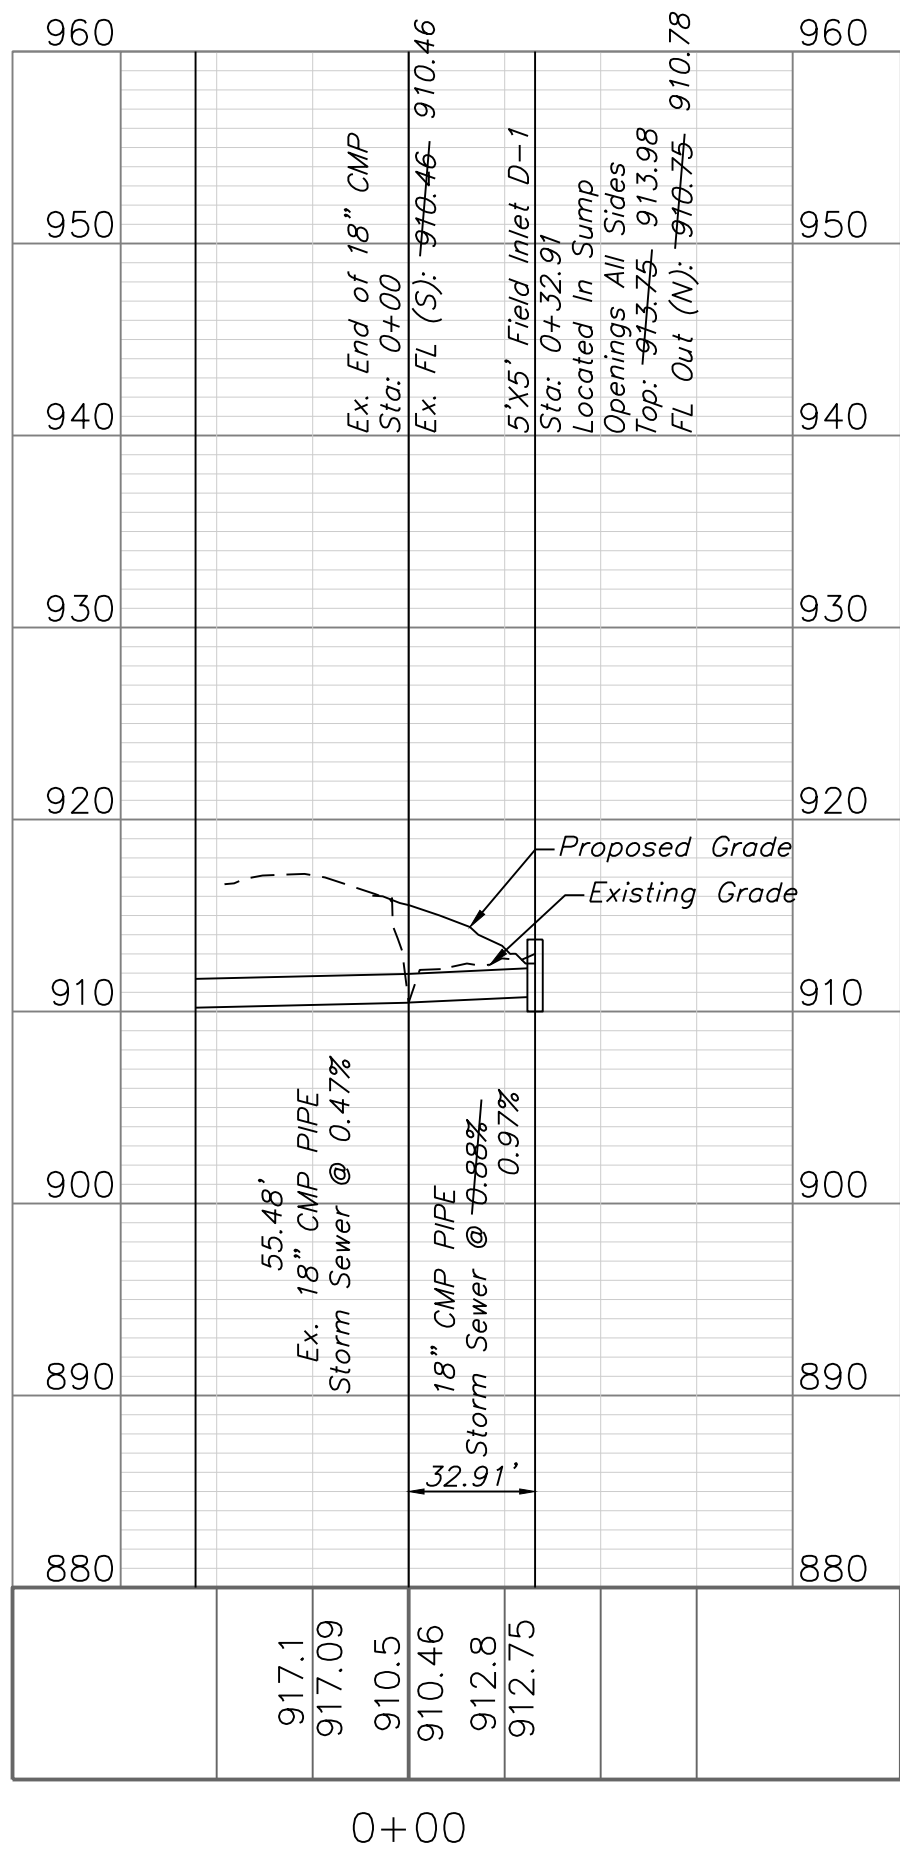

Accepted Record Drawings


These plans have been reviewed for accuracy and are accepted for basic conformance to the approved construction drawings.

RECORD DRAWING

The information provided on this drawing conforms to construction records; it is not intended for construction, implementation or recording purposes; and it is solely based on information obtained by my firm.

"400-00 100.10", "4-00% 1.15% slope", or "8-inch HDPE-PVC pipe" are all typical examples of revisions that indicate that design data has been replaced with "as-built" information. All other data is as designed and has not been field verified.

Date: 6/2/2022
Certified by: Matthew J. Schlicht
Title: Engineer
Firm: Engineering Solutions

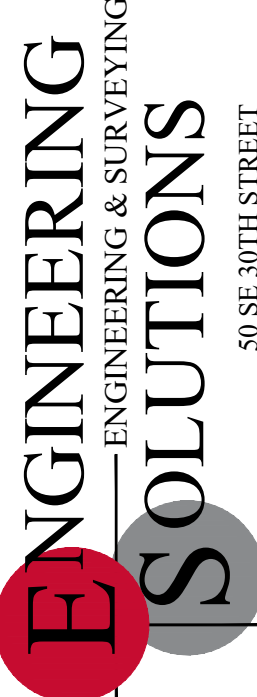


Professional Registration
Missouri
Engineering 2005002186-D
Surveying 2005008319-D
Kansas
Engineering E-1695
Surveying LS-218
Oklahoma
Engineering 6254
Nebraska
Engineering CA2821

PARK RIDGE 8TH PLAT
Section 9, Township 48 North, Range 31 West
Lee's Summit, Jackson County, Missouri

Project:
PARK RIDGE
Issue Date:
March 17, 2021

Storm Sewer Plan and Profile
PARK RIDGE 8TH PLAT
Section 9, Township 48 North, Range 31 West
Lee's Summit, Jackson County, Missouri

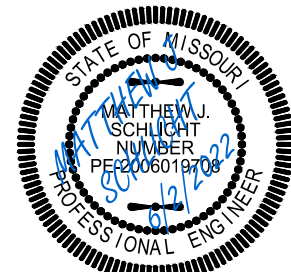

Matthew J. Schlicht
MO PE 2006019708
KS PE 19071
OK PE 25226
NE PE E-114335

REVISIONS

6/2/2022 As-Built

10-YEAR INLET																						
D.S. Str.	Str. No.	Area (ac)	InletTime (min)	Int. (in/hr)	RunoffCoeff. (C)	Q=CIA (cfs)	Q Carry-over (cfs)	QCaptured (cfs)	QBypassed (cfs)	JunctType	CurbHeight (in)	CurbLength (ft)	GutterSlope (ft/ft)	GutterWidth (ft)	CrossSlope, Sw (ft/ft)	CrossSlope, Sx (ft/ft)	InletDepth (ft)	BypassDepth (ft)	BypassSpread (ft)	GutterDepth (ft)	GutterSpread (ft)	Bypass Str. No.
EX	A-1	0.55	5.5	7.10	0.51	1.99	3.09	0.94	4.14	Curb	10	5	0.048	2	0.05	0.02	0.23	0.22	7.85	0.23	8.58	Offsite
A-1	A-2	0.08	5.2	7.18	0.51	0.29	1	0.39	0.9	Curb	10	5	0.095	2	0.05	0.02	0.13	0.12	2.9	0.13	3.69	Offsite
A-2	A-3	0.08	5.2	7.18	0.51	0.29	1.11	0.41	1	Curb	10	5	0.095	2	0.05	0.02	0.14	0.12	3.12	0.14	3.89	A-2
A-3	A-4	0.44	6.3	6.88	0.51	1.54	0	0.43	1.11	Curb	10	5	0.095	2	0.05	0.02	0.14	0.13	3.36	0.14	4.11	A-3
A-4	A-5	1.15	8.1	6.44	0.51	3.78	0	0.69	3.09	Curb	10	5	0.095	2	0.05	0.02	0.19	0.18	5.89	0.19	6.47	A-1
A-5	A-6	0.34	6.0	6.96	0.51	1.21	0	1.21	0	Dp-Curb	6	20	Sag		0.02	0.02	0.07	n/a	n/a	0.07	3.69	Sag
A-1	B-1	7.91	15.0	5.21	0.51	21.01	0	21.01	0	Dp-Curb	6	20	Sag		0.02	0.02	0.5	n/a	n/a	0.5	24.83	Sag
A-3	C-1	0.50	5.7	7.04	0.51	1.80	0	1.8	0	Dp-Curb	6	20	Sag		0.02	0.02	0.1	n/a	n/a	0.1	4.81	Sag
C-1	C-2	0.19	5.3	7.15	0.51	0.69	0	0.69	0	Dp-Curb	6	20	Sag		0.02	0.02	0.05	n/a	n/a	0.05	2.55	Sag
EX	D-1	0.86	6.1	6.93	0.51	3.04	0	3.04	0	Dp-Curb	6	20	Sag		0.02	0.02	0.14	n/a	n/a	0.14	6.84	Sag

10-YEAR PIPE																						
D.S. Str.	U.S. Str.	LineLength (ft)	Incr.Area (ac)	TotalArea (ac)	RunoffCoeff. (C)	IncrC x A	TotalC x A	InletTime (min)	TimeConc (min)	RnfallInt (in/hr)	TotalRunoff (cfs)	TotalFlow (cfs)	CapacFull (cfs)	Veloc (ft/s)	PipeSize (in)	PipeSlope (%)	Inv ElevDn (ft)	Inv ElevUp (ft)	HGLDn (ft)	HGLUp (ft)	Grnd/RimDn (ft)	Grnd/RimUp (ft)
EX	A-1	74.23	0.55	11.24	0.51	0.28	5.73	5.5	15.2	5.2	29.66	29.66	50.65	9.16	30	0.90	917.33	918.00	918.71	919.85	923.82	925.16
A-1	A-2	69.58	0.08	2.78	0.51	0.04	1.42	5.2	8.5	6.3	8.99	8.99	35.25	4.61	24	1.44	918.50	919.50	919.85	920.57	925.16	928.97
A-2	A-3	73.36	0.08	2.70	0.51	0.04	1.38	5.2	8.3	6.4	8.79	8.79	29.73	6.24	24	1.02	919.75	920.50	920.57	921.56	928.97	936.28
A-3	A-4	70.00	0.44	1.93	0.51	0.22	0.98	6.3	8.2	6.4	6.32	6.32	61.05	7.90	18	20.00	921.00	935.00	921.56	935.97	936.28	942.92
A-4	A-5	34.00	1.15	1.49	0.51	0.59	0.76	8.1	8.1	6.4	4.89	4.89	7.20	5.75	15	0.74	935.50	935.75	936.26	936.65	942.92	942.92
A-5	A-6	100.53	0.34	0.34	0.51	0.17	0.17	6.0	6.0	7.0	1.21	1.21	29.00	2.54	15	11.94	936.00	948.00	936.65	948.43	942.92	953.00
A-1	B-1	124.16	7.91	7.91	0.51	4.03	4.03	15.0	15.0	5.2	21.01	21.01	55.98	8.45	24	3.62	918.50	923.00	919.85	924.64	925.16	929.00
A-3	C-1	110.10	0.50	0.69	0.51	0.26	0.35	5.7	5.7	7.0	2.48	2.48	15.93	3.97	18	1.36	921.00	922.50	921.56	923.10	936.28	927.00
C-1	C-2	90.42	0.19	0.19	0.51	0.10	0.10	5.3	5.3	7.2	0.69	0.69	15.29	4.52	15	3.32	923.00	926.00	923.18	926.33	927.00	931.00
EX	D-1	88.65	0.86	0.86	0.51	0.44	0.44	6.1	6.1	6.9	3.04	3.04	7.40	4.04	18	0.50	909.92	910.36	910.58	911.03	913.00	913.00

100-YEAR INLET																						
D.S. Str.	Str. No.	Area	InletTime	Int.	RunoffCoeff.	Q=CIA	Q Carry-over	QCaptured	QBypassed	JunctType	CurbHeight	CurbLength	GutterSlope	GutterWidth	CrossSlope, Sw	CrossSlope, Sx	InletDepth	BypassDepth	BypassSpread	GutterDepth	GutterSpread	BypassLine No.
		(ac)	(min)	(in/hr)	(C)	(cfs)	(cfs)	(cfs)	(cfs)		(in)	(ft)	(ft/ft)	(ft)	(ft/ft)	(ft/ft)	(ft)	(ft)	(ft)	(ft)	(ft)	
EX	A-1	0.55	5.5	9.66	0.51	2.71	4.39	1.12	5.98	Curb	10	5	0.048	2	0.05	0.02	0.26	0.24	9.19	0.26	9.87	Offsite
A-1	A-2	0.08	5.2	9.76	0.51	0.40	1.5	0.48	1.42	Curb	10	5	0.095	2	0.05	0.02	0.15	0.14	3.91	0.15	4.61	Offsite
A-2	A-3	0.08	5.2	9.76	0.51	0.40	1.6	0.5	1.5	Curb	10	5	0.095	2	0.05	0.02	0.15	0.14	4.04	0.15	4.73	A-2
A-3	A-4	0.44	6.3	9.40	0.51	2.11	0	0.51	1.6	Curb	10	5	0.095	2	0.05	0.02	0.16	0.14	4.19	0.16	4.87	A-3
A-4	A-5	1.15	8.1	8.86	0.51	5.20	0	0.81	4.39	Curb	10	5	0.095	2	0.05	0.02	0.21	0.2	6.93	0.21	7.47	A-1
A-5	A-6	0.34	6.0	9.49	0.51	1.65	0	1.65	0	Dp-Curb	6	20	Sag		0.02	0.02	0.09	n/a	n/a	0.09	4.54	Sag
A-1	B-1	7.91	15.0	7.30	0.51	29.45	0	29.45	0	Dp-Curb	6	20	Sag		0.02	0.02	0.62	n/a	n/a	0.62	31.11	Sag
A-3	C-1	0.50	5.7	9.59	0.51	2.45	0	2.45	0	Dp-Curb	6	20	Sag		0.02	0.02	0.12	n/a	n/a	0.12	5.92	Sag
C-1	C-2	0.19	5.3	9.73	0.51	0.94	0	0.94	0	Dp-Curb	6	20	Sag		0.02	0.02	0.06	n/a	n/a	0.06	3.13	Sag
EX	D-1	0.86	6.1	9.46	0.51	4.15	0	4.15	0	Dp-Curb	6	20	Sag		0.02	0.02	0.17	n/a	n/a	0.17	8.42	Sag

100-YEAR PIPE																						
D.S. Str.	U.S. Str.	LineLength (ft)	Incr.Area (ac)	TotalArea (ac)	RunoffCoeff. (C)	IncrC x A	TotalC x A	InletTime (min)	TimeConc (min)	RnfallInt (in/hr)	TotalRunoff (cfs)	TotalFlow (cfs)	CapacFull (cfs)	Veloc (ft/s)	PipeSize (in)	PipeSlope (%)	Inv ElevDn (ft)	Inv ElevUp (ft)	HGLDn (ft)	HGLUp (ft)	Grnd/RimDn (ft)	Grnd/RimUp (ft)
EX	A-1	74.23	0.55	11.24	0.51	0.28	5.73	5.5	15.2	7.3	41.64	41.64	50.65	10.37	30	0.90	917.33	918.00	919.06	920.16	923.82	925.16
A-1	A-2	69.58	0.08	2.78	0.51	0.04	1.42	5.2	8.5	8.7	12.40	12.40	35.25	5.18	24	1.44	918.50	919.50	920.16	920.76	925.16	928.97
A-2	A-3	73.36	0.08	2.70	0.51	0.04	1.38	5.2	8.3	8.8	12.11	12.11	29.73	6.72	24	1.02	919.75	920.50	920.76	921.75	928.97	936.28
A-3	A-4	70.00	0.44	1.93	0.51	0.22	0.98	6.3	8.2	8.8	8.70	8.70	61.05	7.94	18	20.00	921.00	935.00	921.75	936.14	936.28	942.92
A-4	A-5	34.00	1.15	1.49	0.51	0.59	0.76	8.1	8.1	8.9	6.73	6.73	7.20	6.41	15	0.74	935.50	935.75	936.46	936.79	942.92	942.92
A-5	A-6	100.53	0.34	0.34	0.51	0.17	0.17	6.0	6.0	9.5	1.65	1.65	29.00	2.76	15	11.94	936.00	948.00	936.79	948.51	942.92	953.00
A-1	B-1	124.16	7.91	7.91	0.51	4.03	4.03	15.0	15.0	7.3	29.45	29.45	55.98	10.13	24	3.62	918.50	923.00	920.16	924.85	925.16	929.00
A-3	C-1	110.10	0.50	0.69	0.51	0.26	0.35	5.7	5.7	9.6	3.38	3.38	15.93	4.00	18	1.36	921.00	922.50	921.75	923.20	936.28	927.00
C-1	C-2	90.42	0.19	0.19	0.51	0.10	0.10	5.3	5.3	9.7	0.94	0.94	15.29	4.94	15	3.32	923.00	926.00	923.21	926.38	927.00	931.00
EX	D-1	88.65	0.86	0.86	0.51	0.44	0.44	6.1	6.1	9.5	4.15	4.15	7.40	4.31	18	0.50	909.92	910.36	910.72	911.16	913.00	913.00

Accepted
Record Drawings

These plans have been reviewed for
accuracy and are accepted for basic
conformance to the approved
construction drawings.


RECORD DRAWING

The information provided on this drawing conforms to
construction records; it is not intended for construction,
implementation or recording purposes; and it is solely based
on information obtained by my firm.

"400-00 100, 10", "4-00% 1.15% slope", or "8-inch HDPE-PVC
pipe" are all typical examples of revisions that indicate that
design data has been replaced with "as-built" information. All
other data is as designed and has not been field verified.

Date: 6/2/2022
Certified by: Matthew J. Schlicht
Title: Engineer
Firm: Engineering Solutions

Storm Sewer Tables 10 and 100 Year
PARK RIDGE 8TH PLAT
Section 9, Township 48 North, Range 31 West
Lee's Summit, Jackson County, Missouri

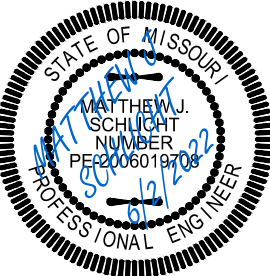

Matthew J. Schlicht
MO PE 2006019708
KS PE 19071
OK PE 25226
NE PE E-114335






REVISIONS

6/2/2022 As-Built

Professional Registration
Missouri
Engineering 2005002186-D
Surveying 2005008319-D
Kansas
Engineering E-1695
Surveying LS-218
Oklahoma
Engineering E254
Nebraska
Engineering CA2821

PARK RIDGE 8TH PLAT
Section 9, Township 48 North, Range 31 West
Lee's Summit, Jackson County, Missouri

Project: PARK RIDGE
Issue Date: March 17, 2021

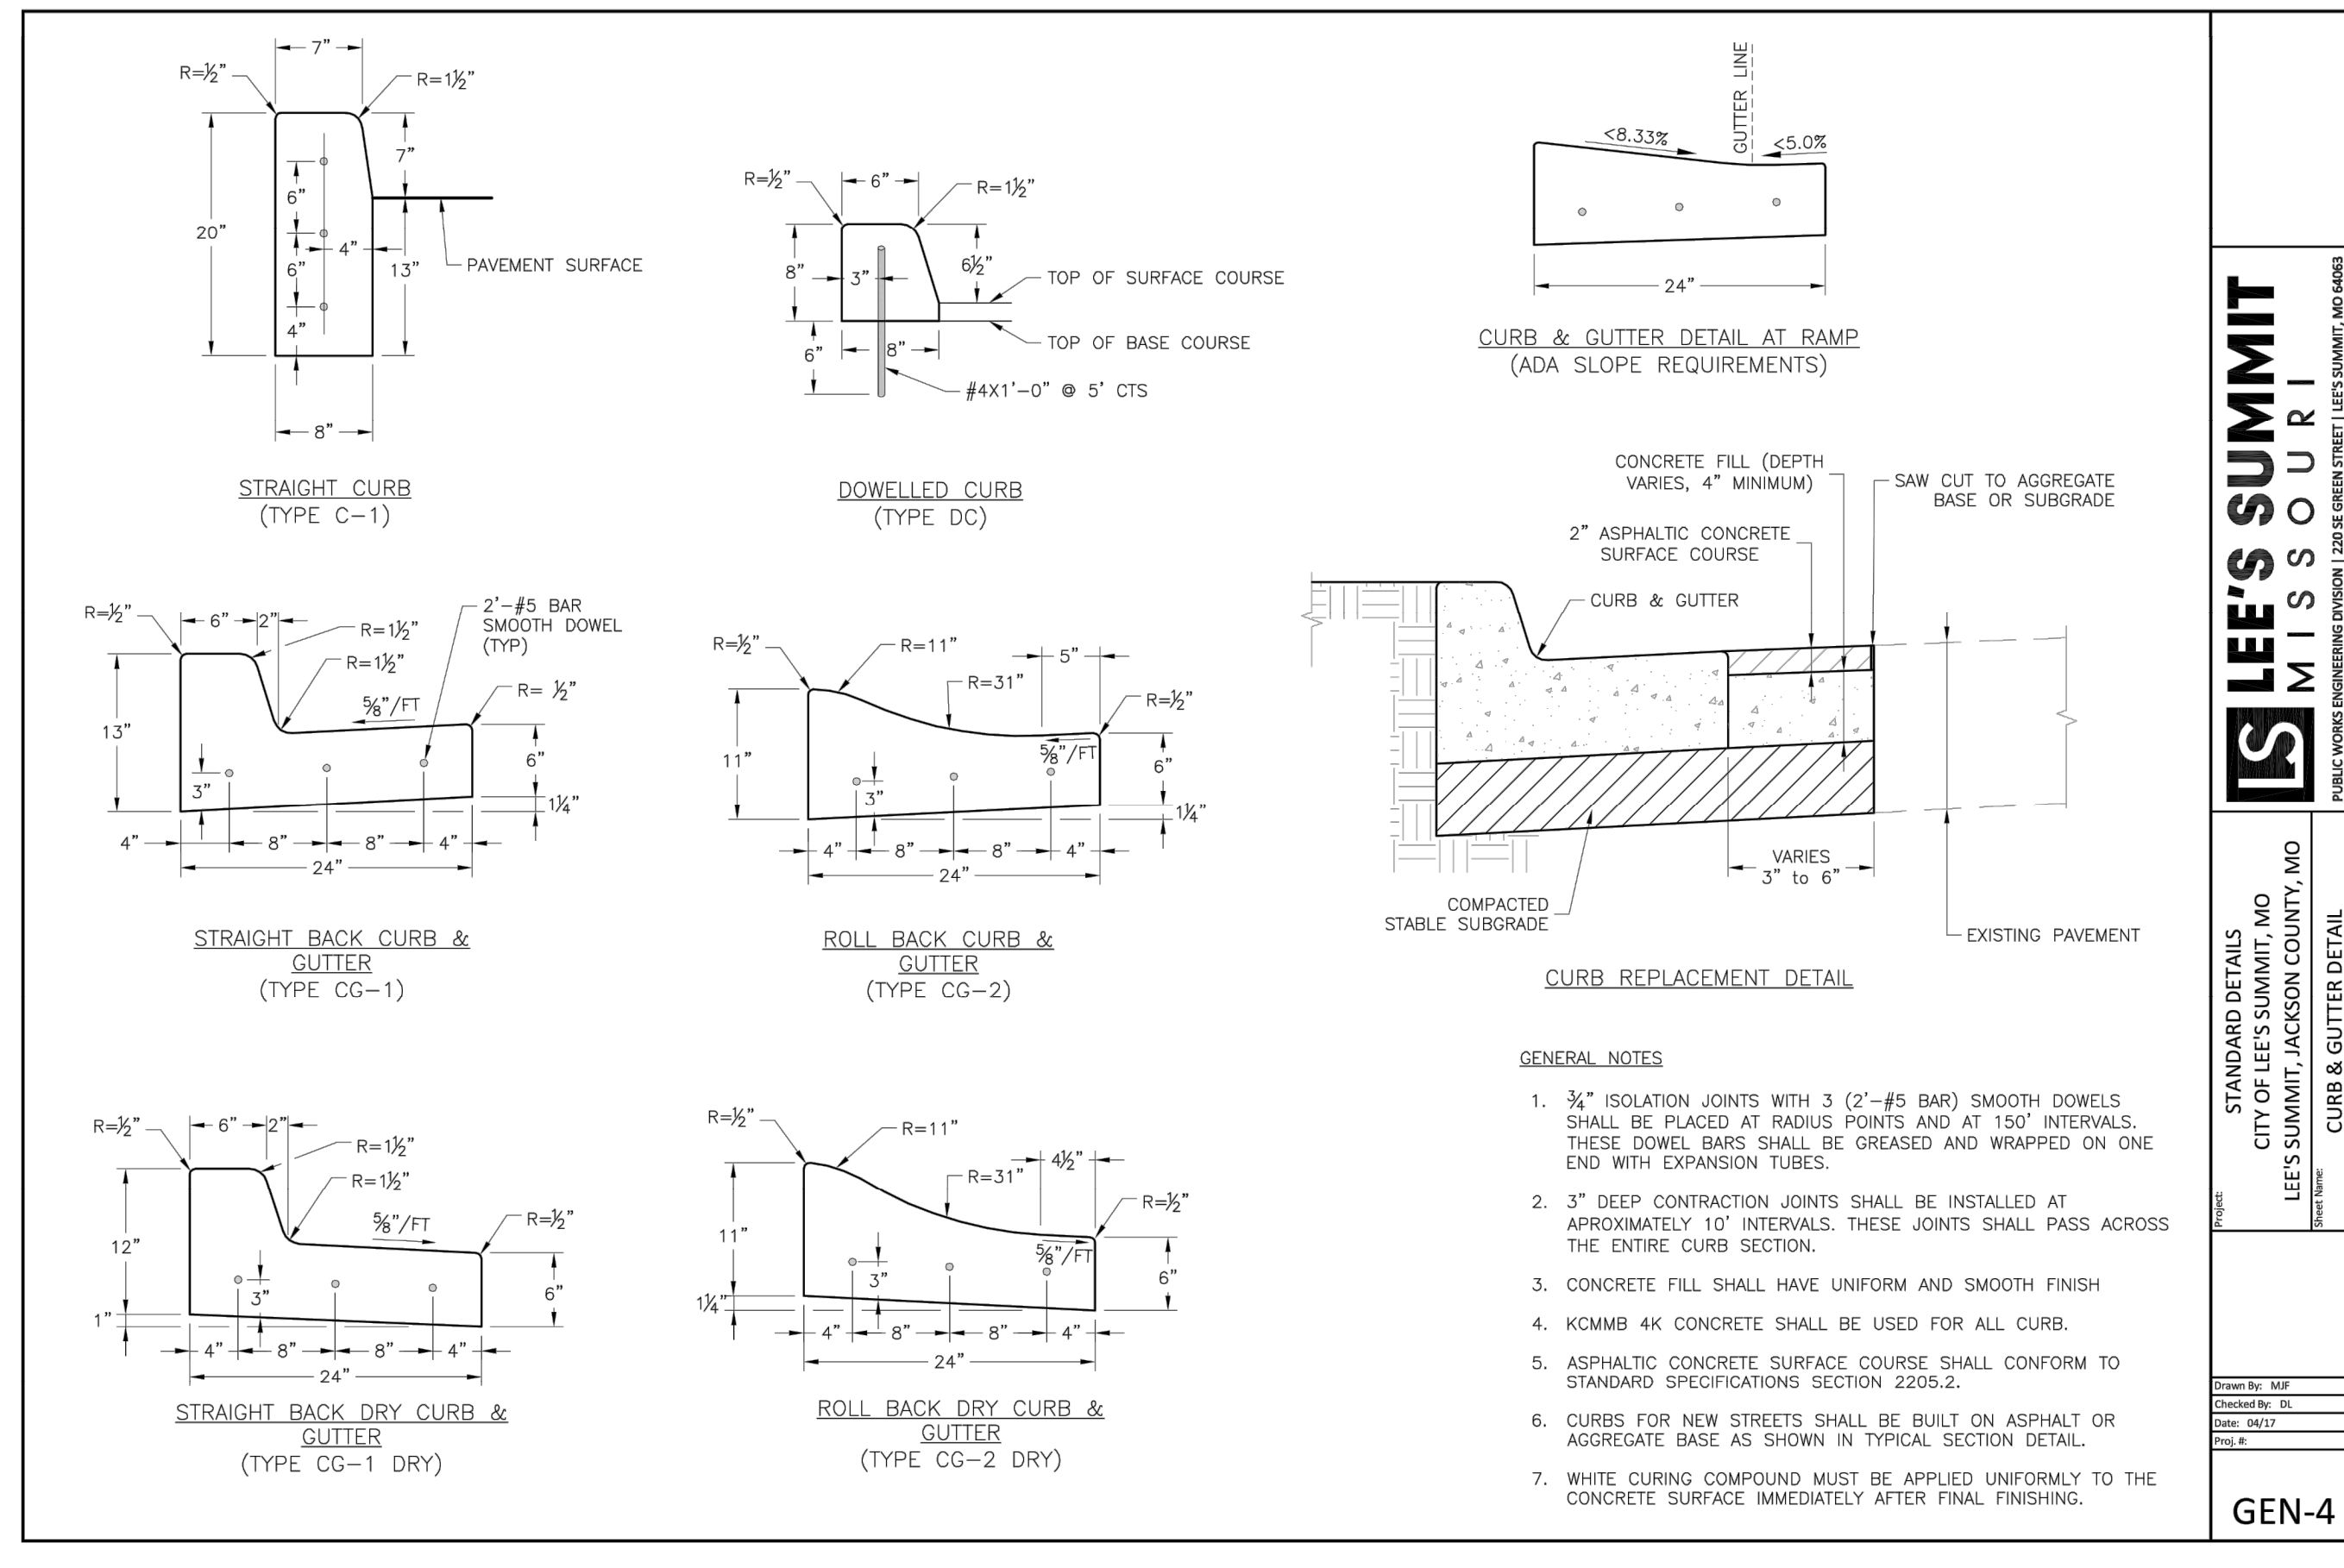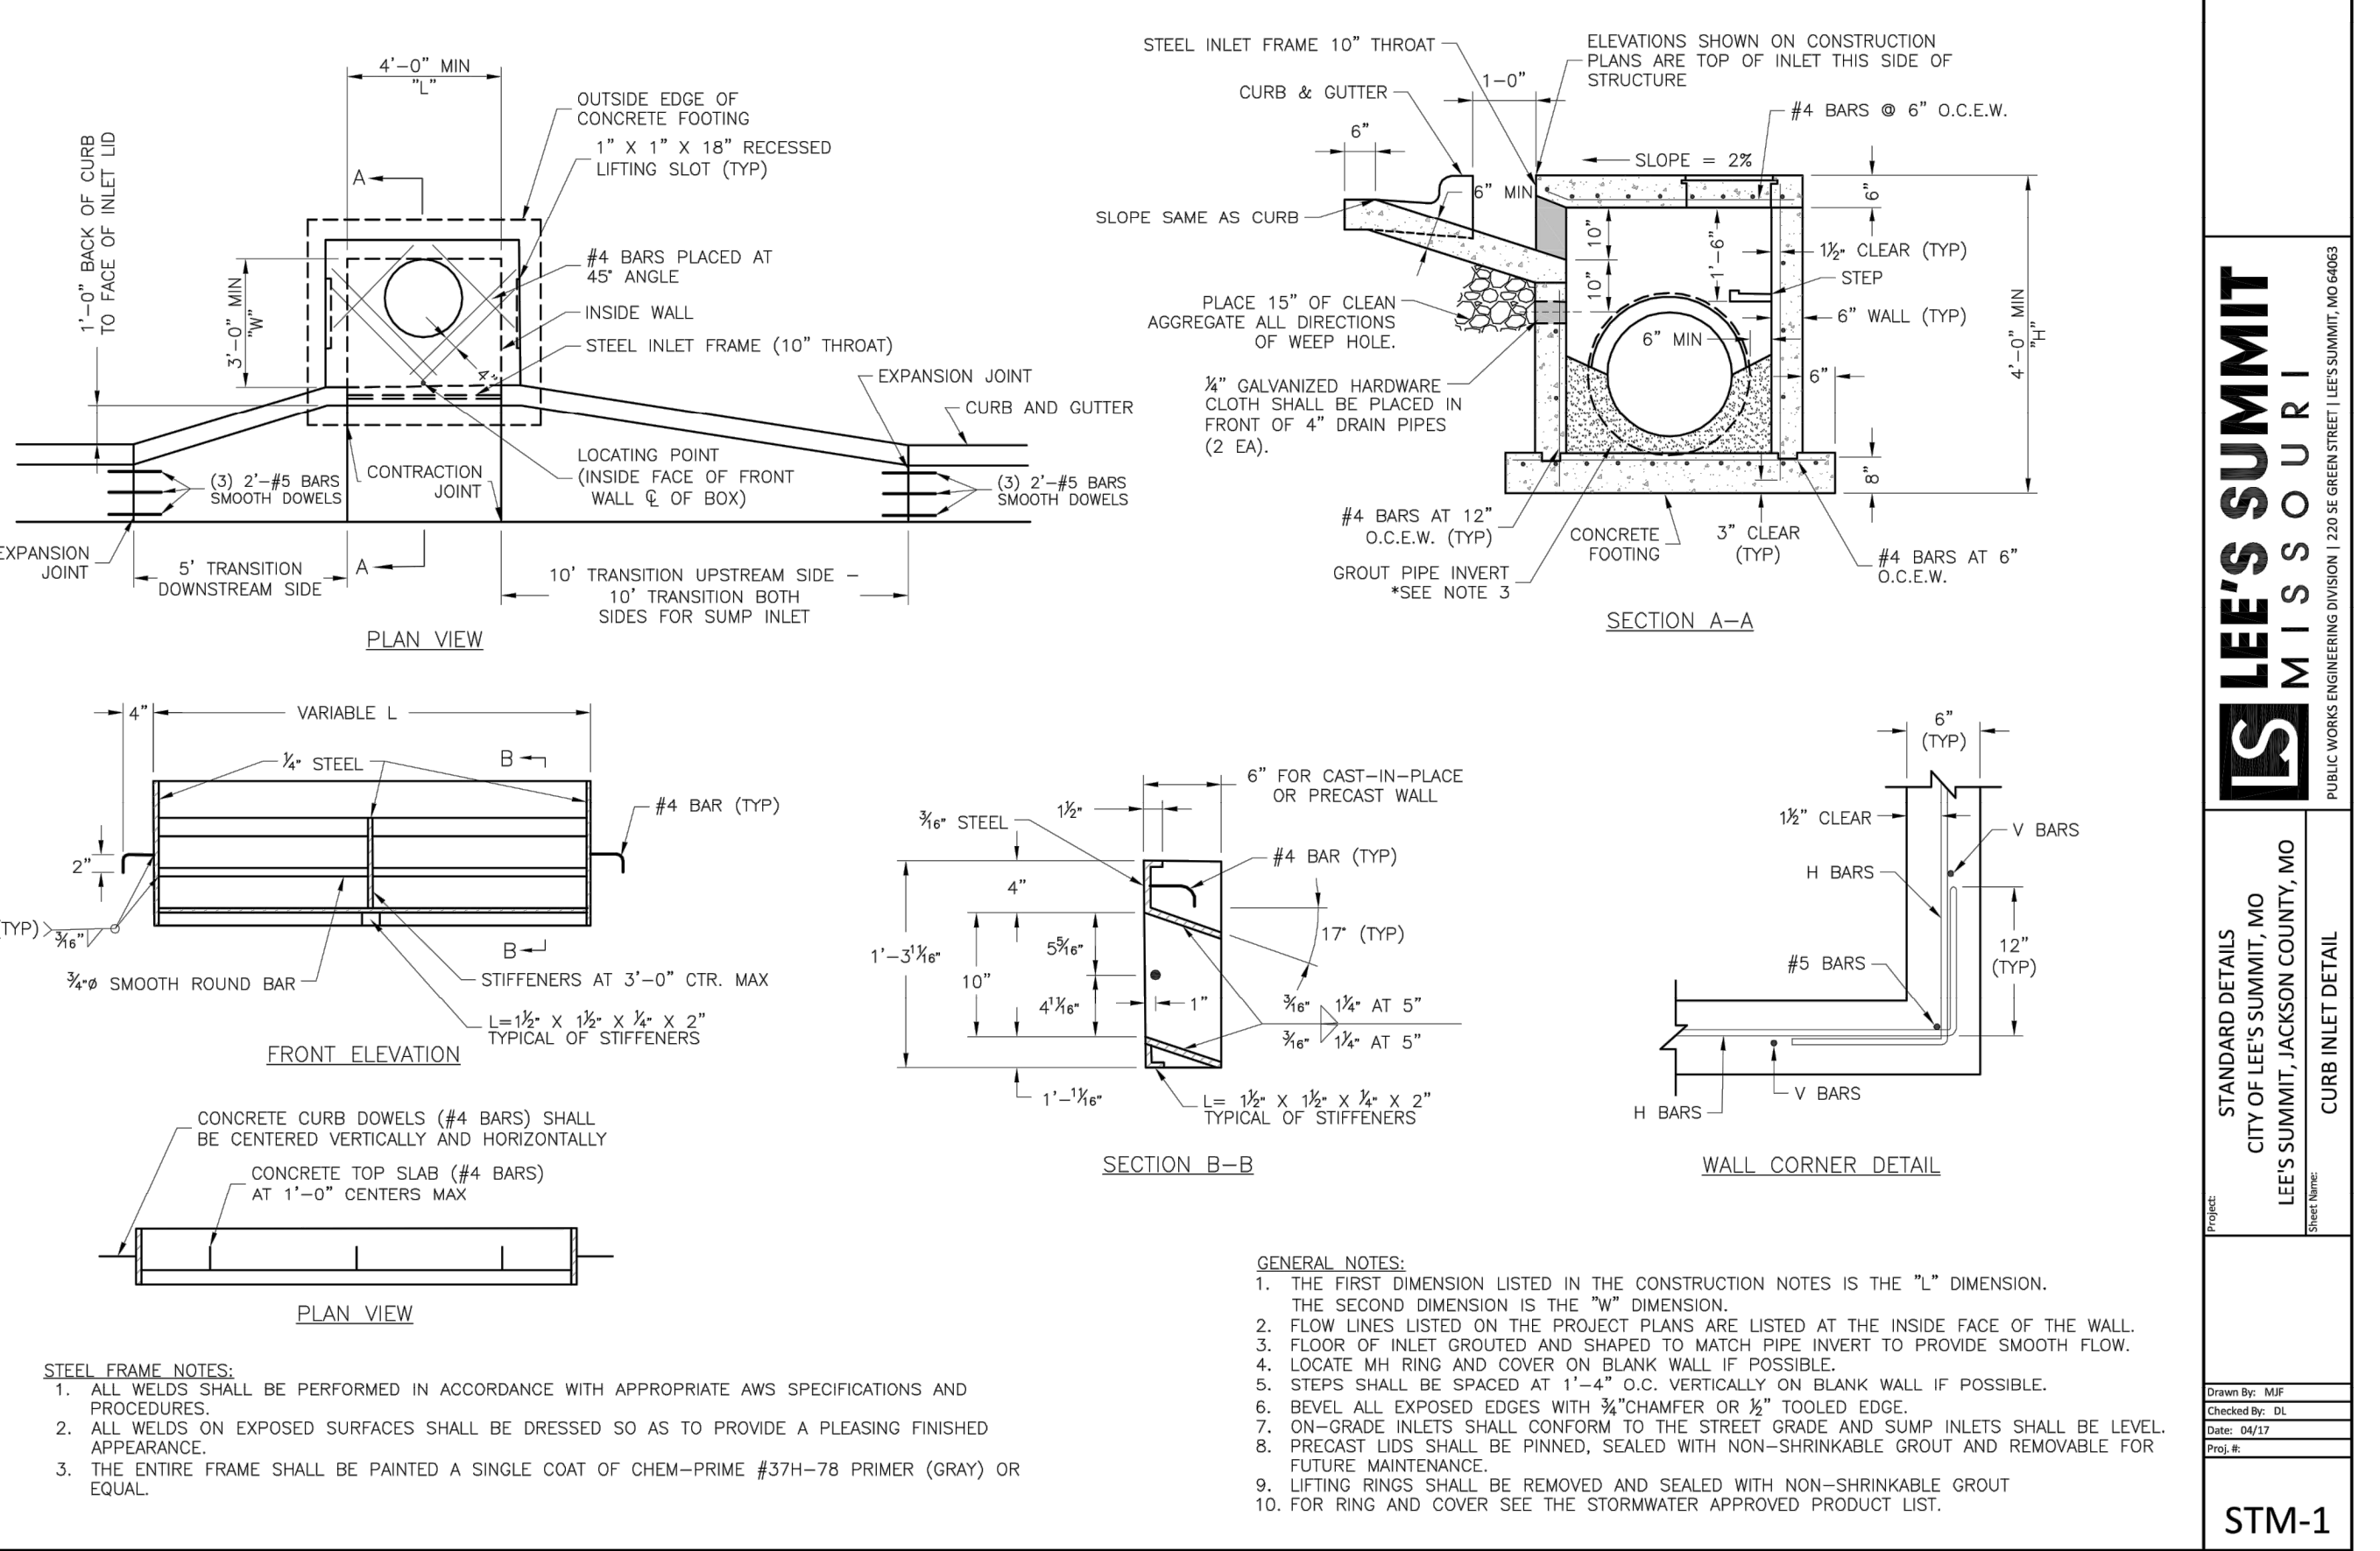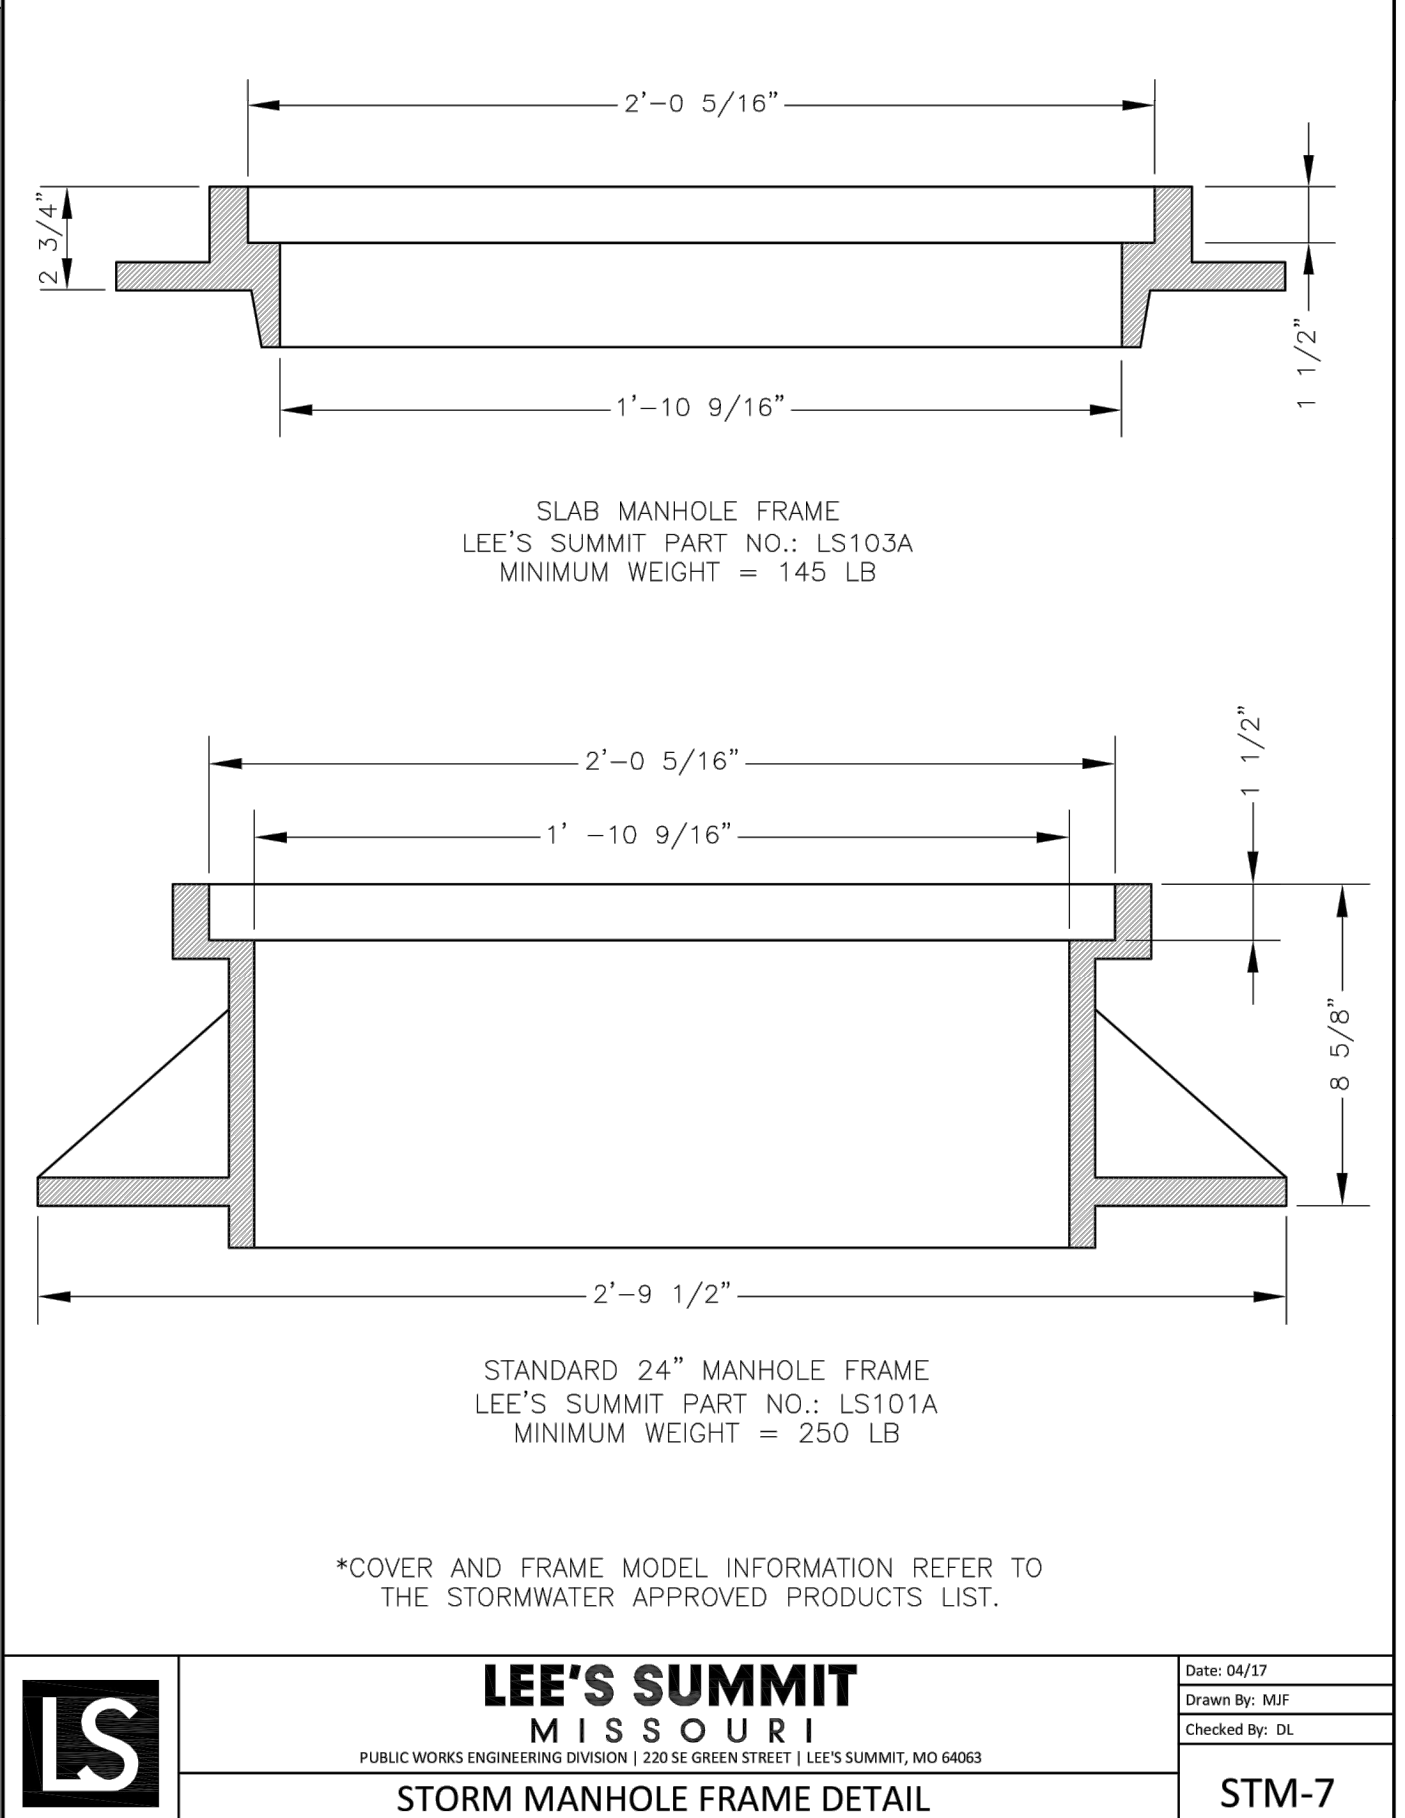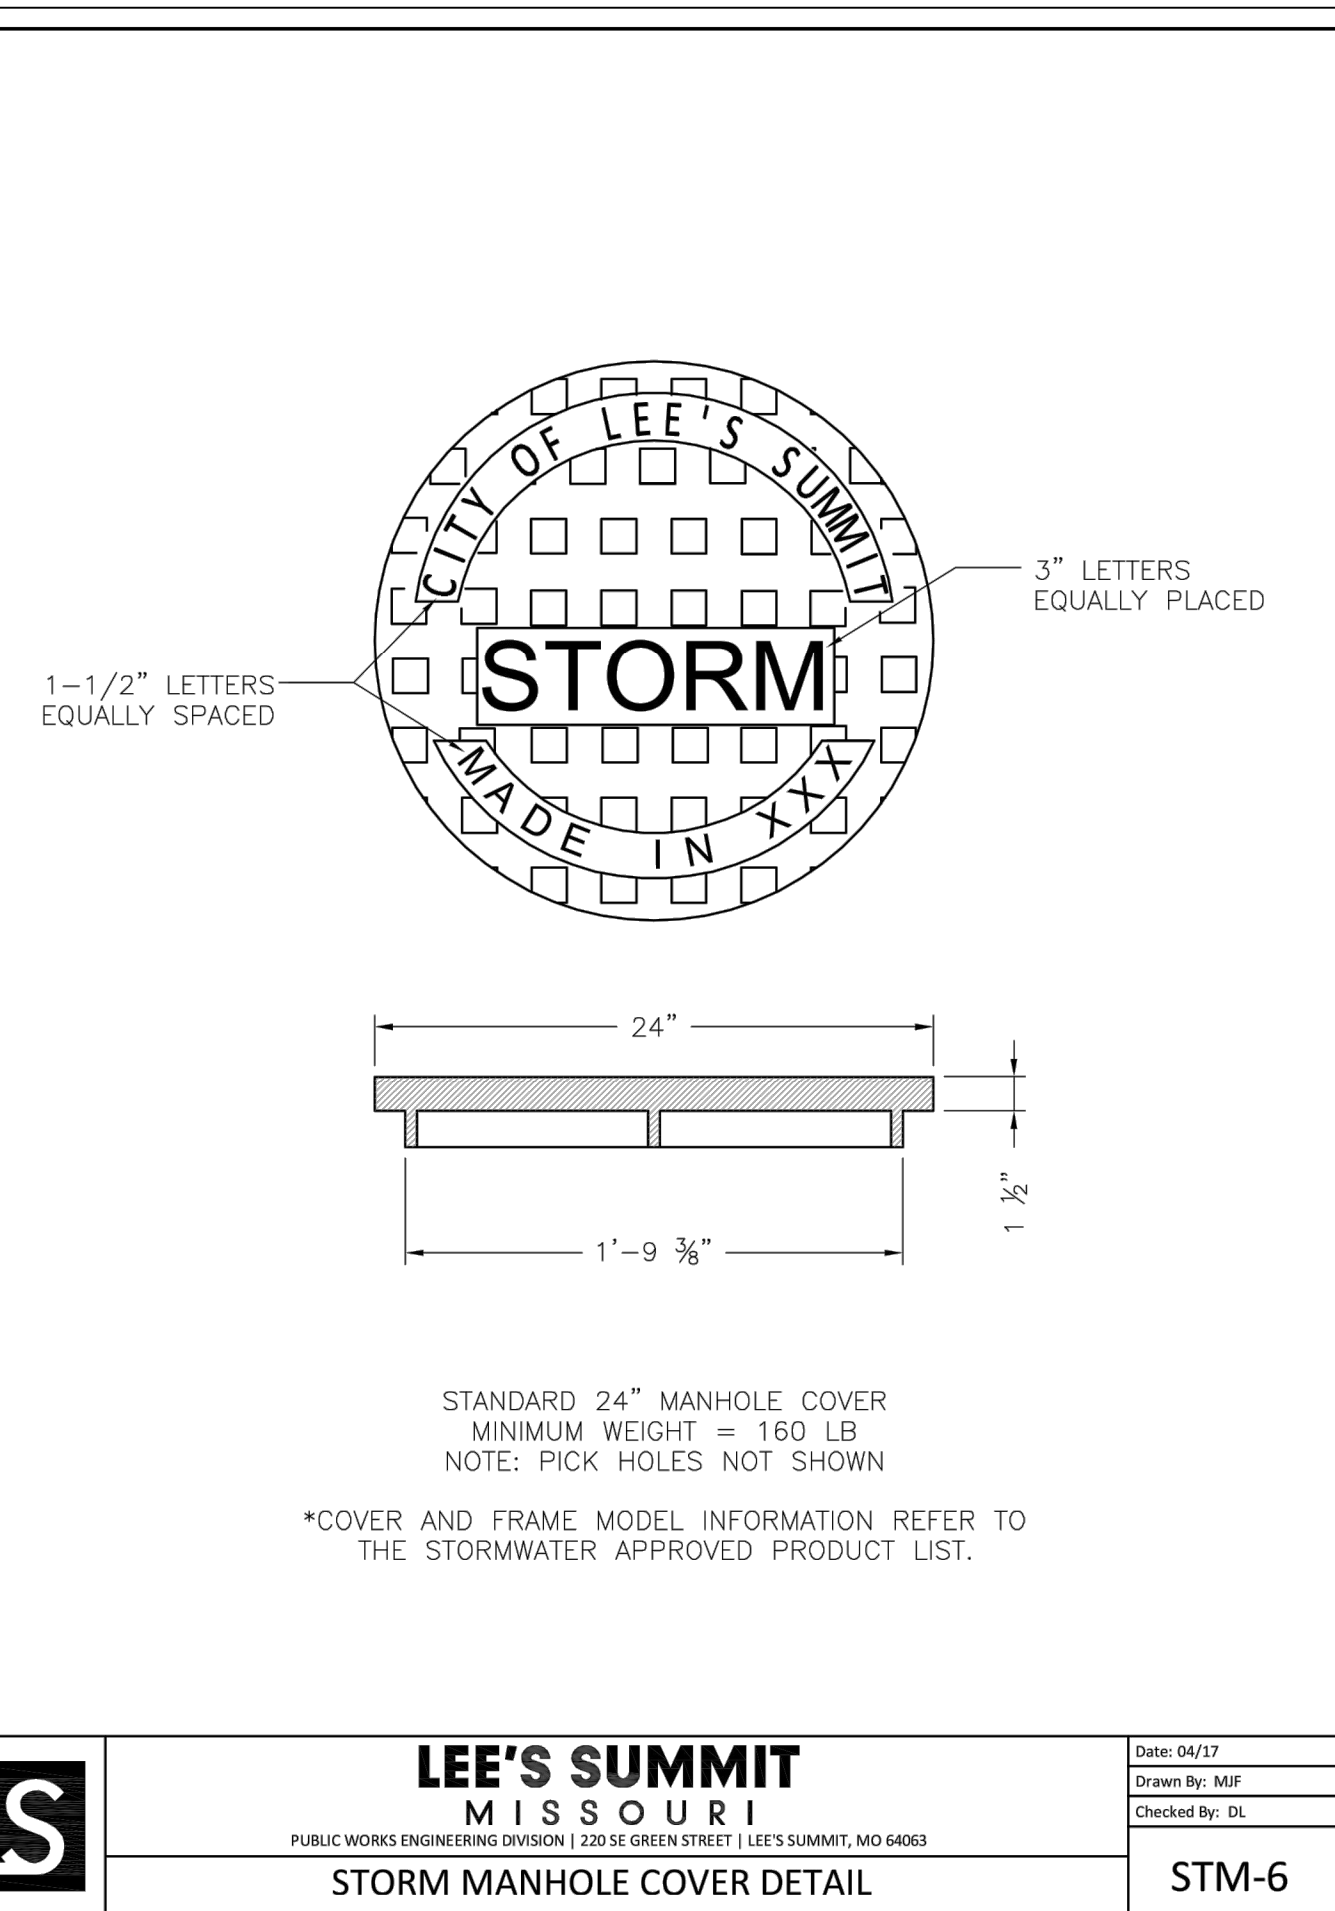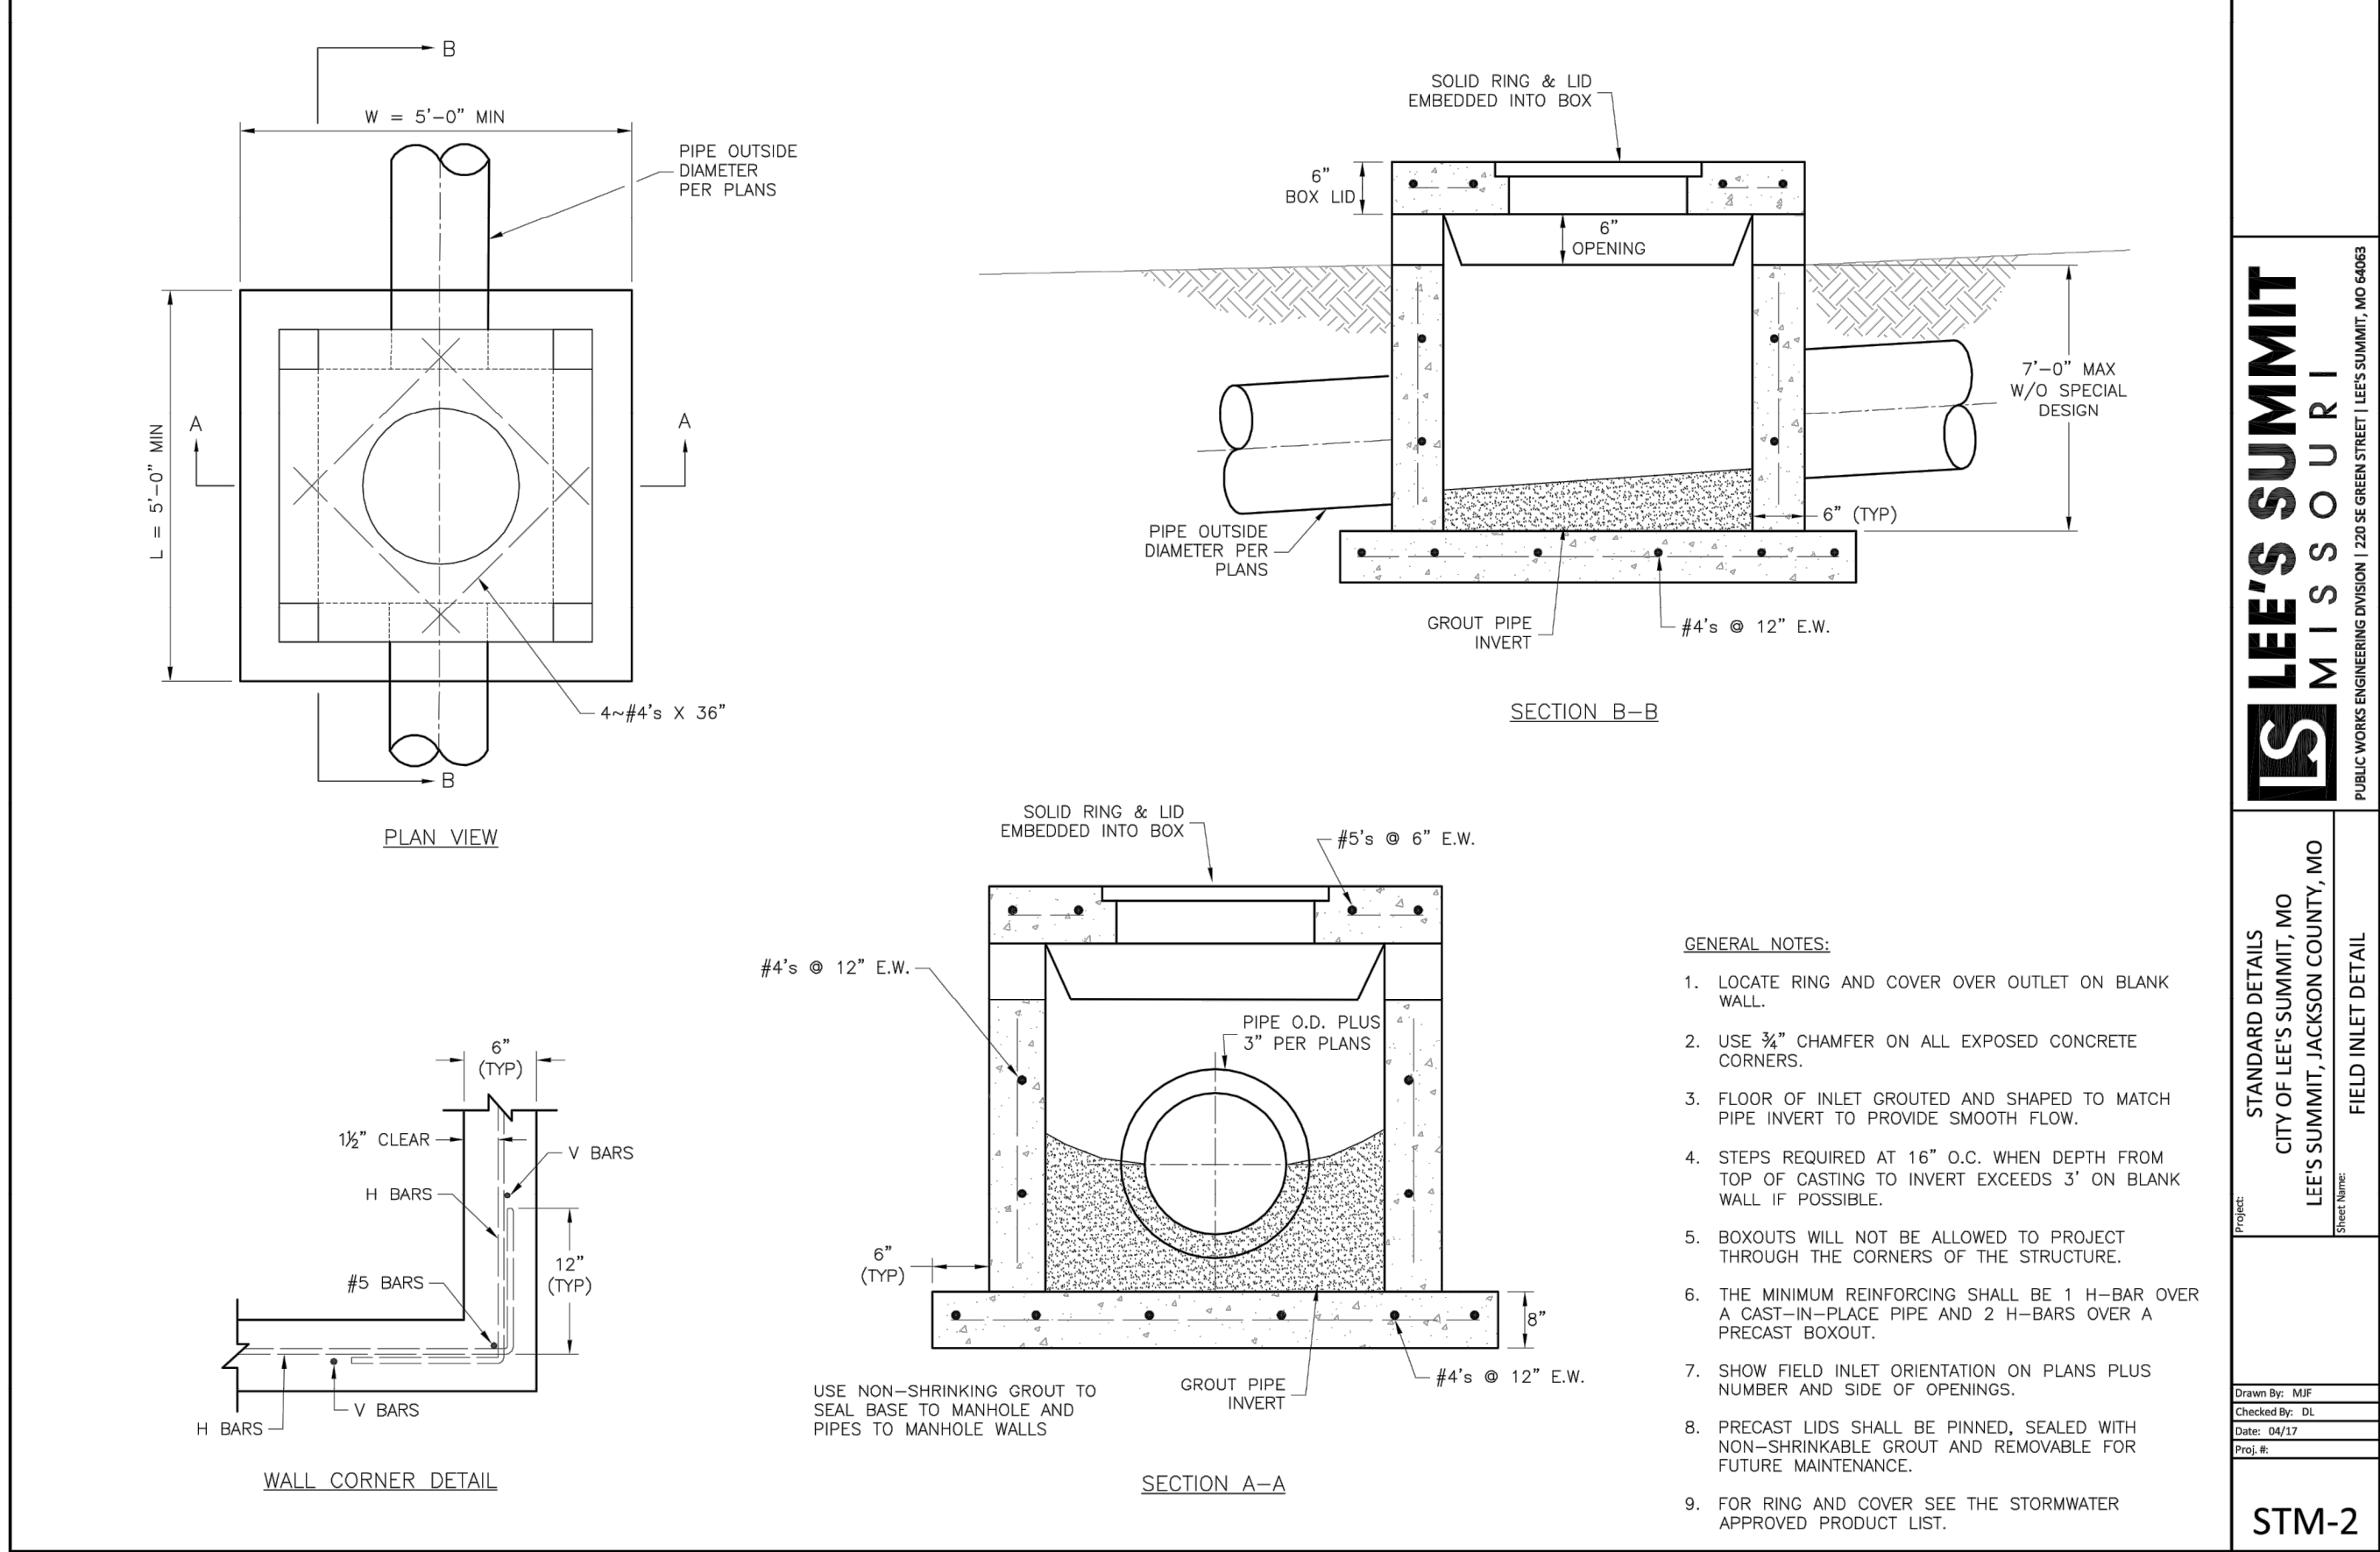

Accepted Record Drawings


These plans have been reviewed for accuracy and are accepted for basic conformance to the approved construction drawings.

RECORD DRAWING


The information provided on this drawing conforms to construction records; it is not intended for construction, implementation or recording purposes; and it is solely based on information obtained by my firm.

"100-00 100.10", "4-00% 1.15% slope", or "8-inch HDPE-PVC pipe" are all typical examples of revisions that indicate that design data has been replaced with "as-built" information. All other data is as designed and has not been field verified.

Date: 6/2/2022
Certified by: Matthew J. Schlicht
Title: Engineer
Firm: Engineering Solutions

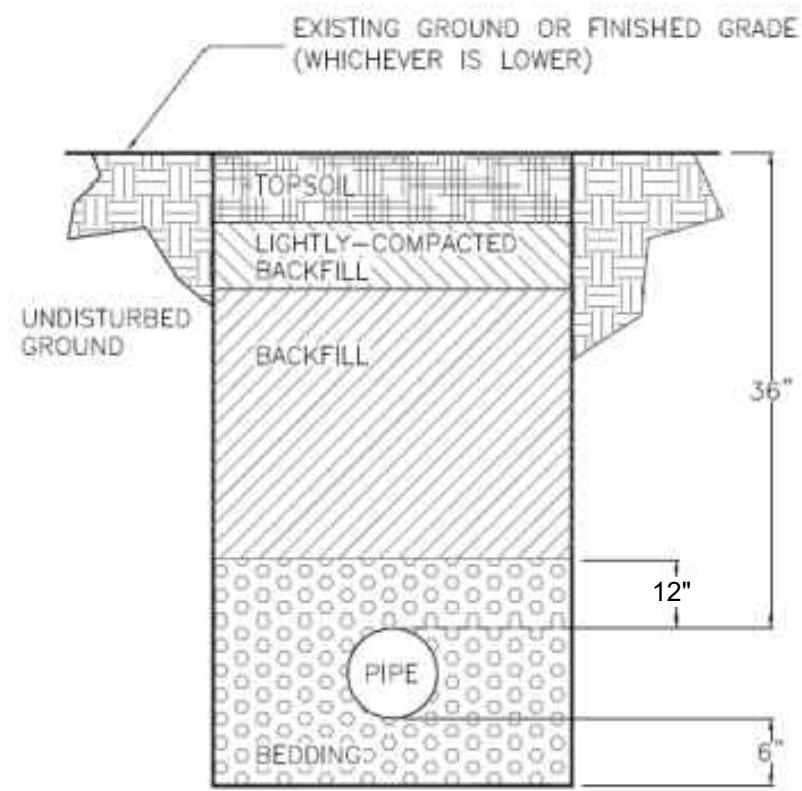

TRENCH AND BACKFILL DETAIL
N.T.S.

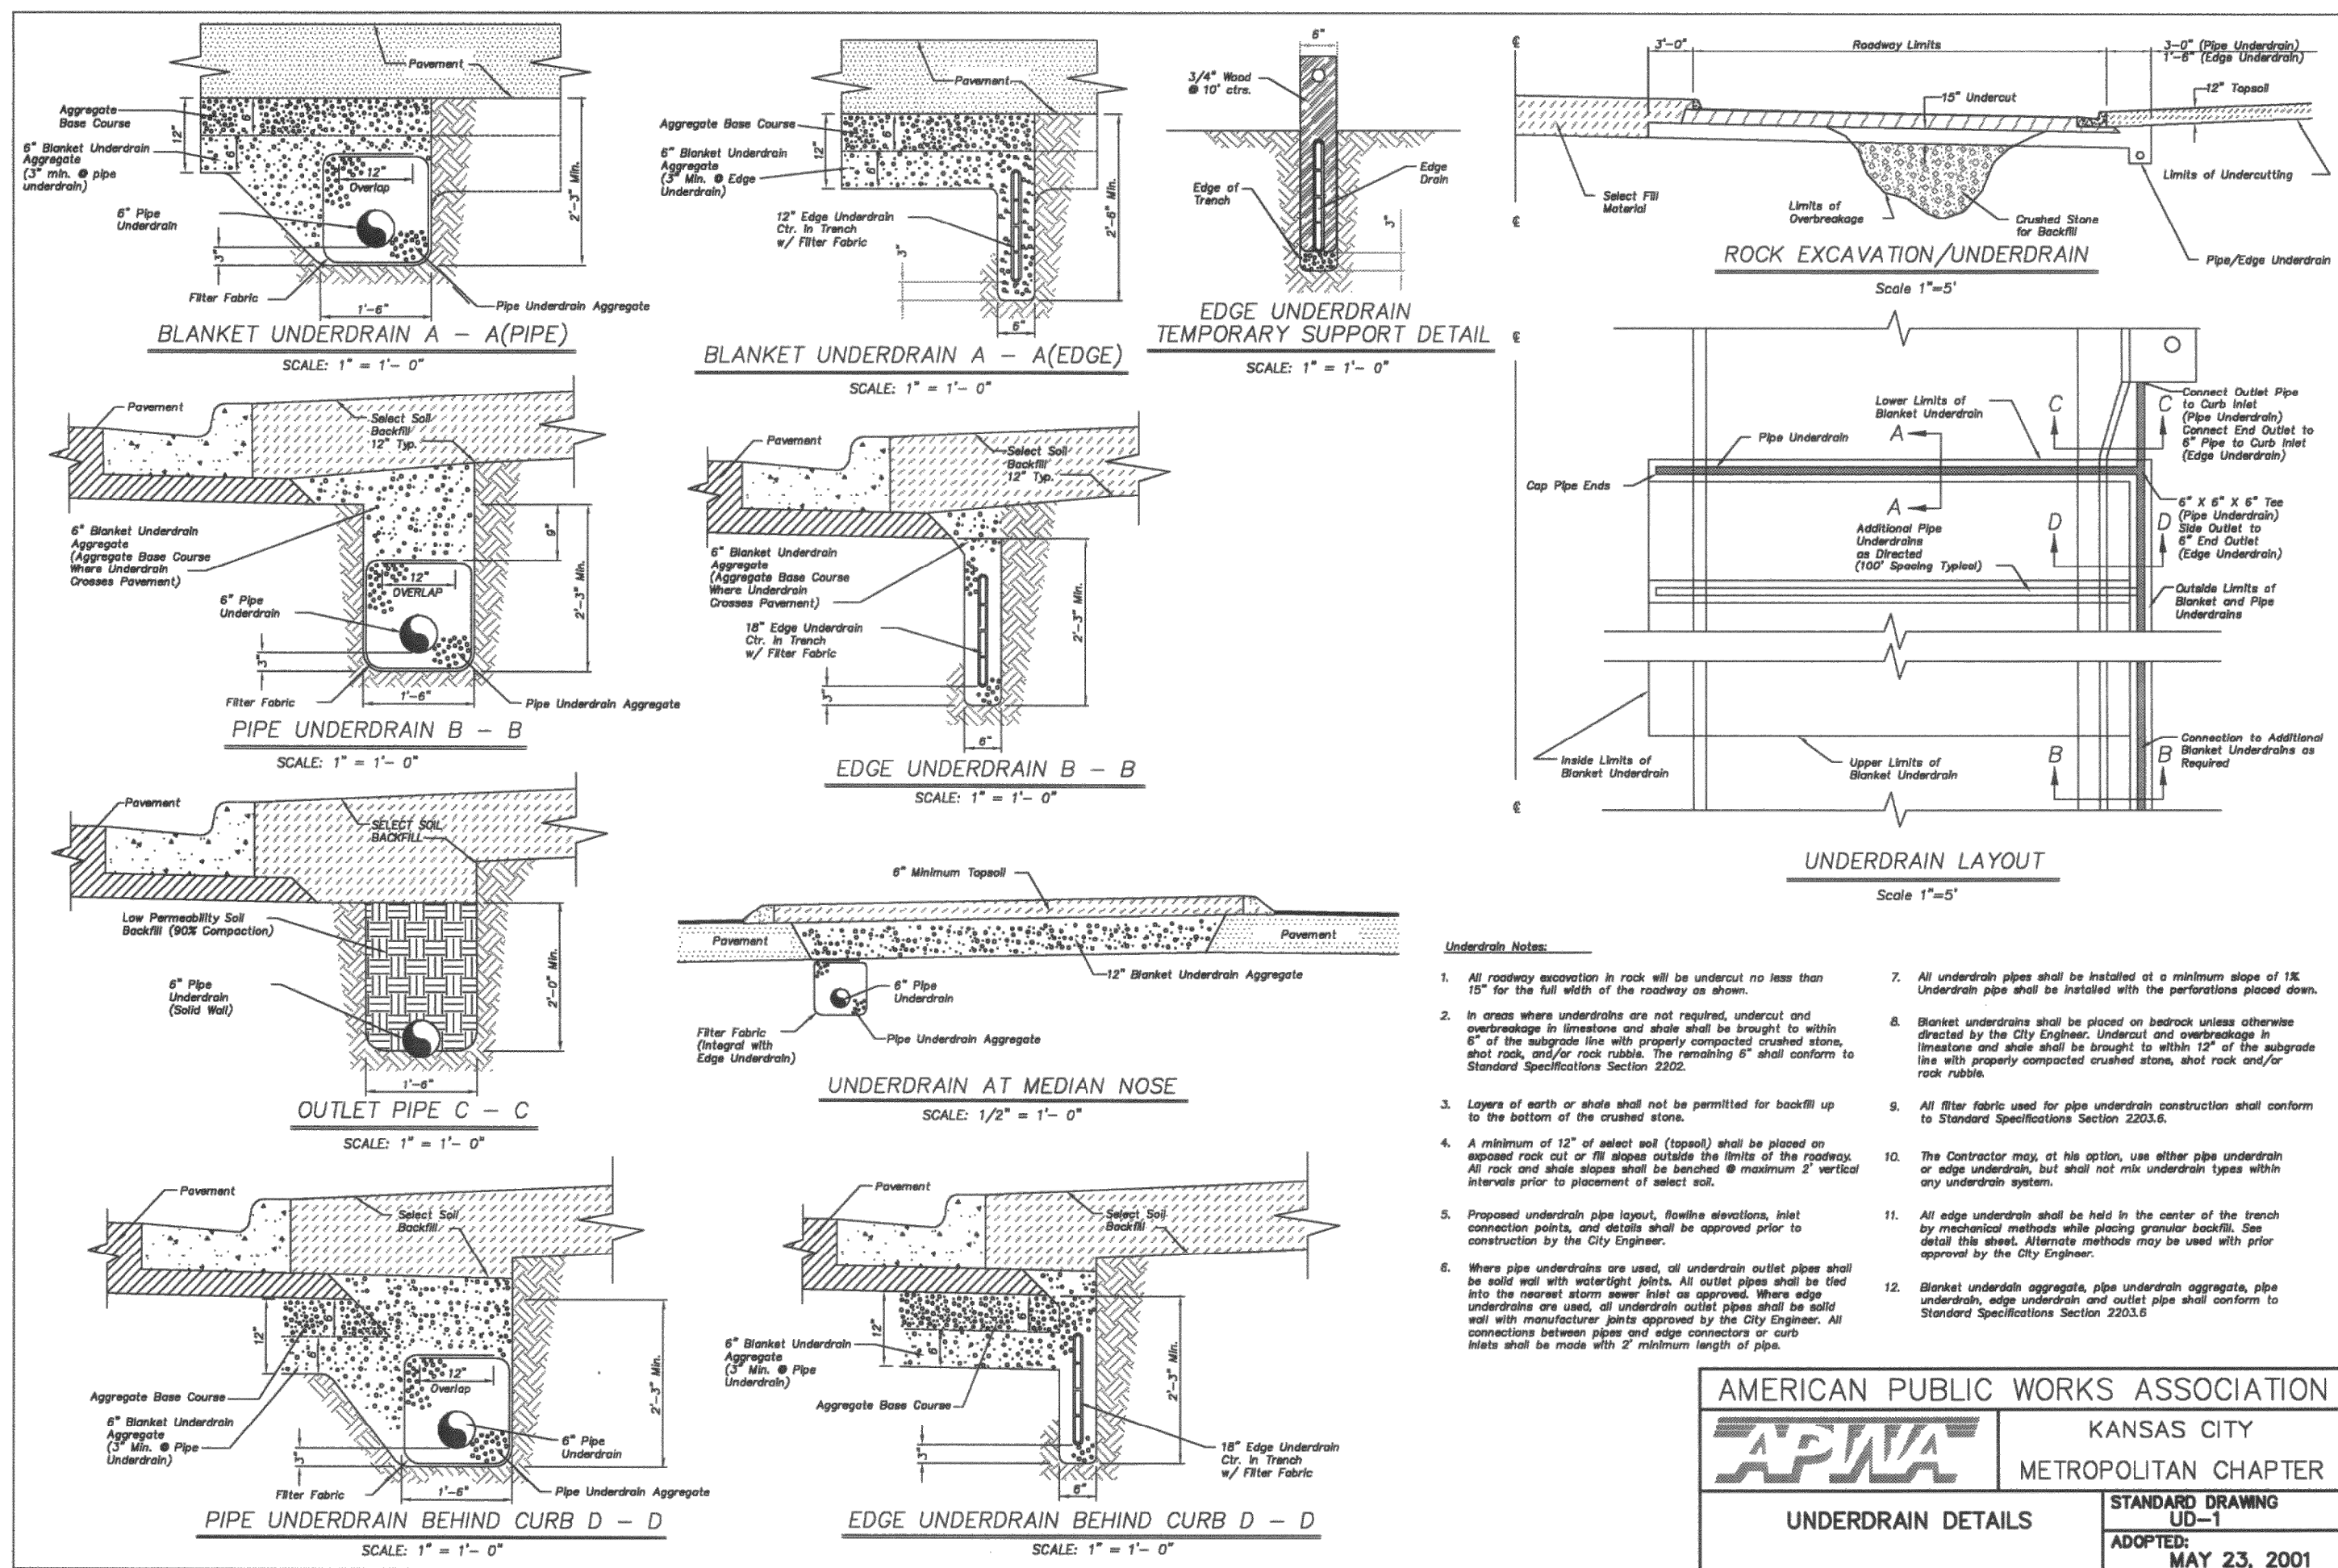

Accepted
Record Drawings


These plans have been reviewed for
accuracy and are accepted for basic
conformance to the approved
construction drawings.

RECORD DRAWING

The information provided on this drawing conforms to
construction records; it is not intended for construction,
implementation or recording purposes; and it is solely based
on information obtained by my firm.

"400-00 100.10", "4-00% 1.15% slope", or "8-inch HDPE-PVC
pipe" are all typical examples of revisions that indicate that
design data has been replaced with "as-built" information. All
other data is as designed and has not been field verified.

Date: 6/2/2022
Certified by: Matthew J. Schlicht
Title: Engineer
Firm: Engineering Solutions

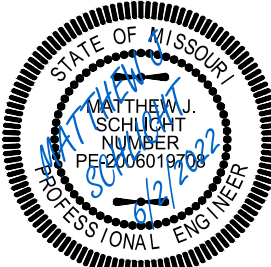

Matthew J. Schlicht
MO PE 2006019708
KS PE 19071
OK PE 25226
NE PE E-14335

REVISIONS

6/2/2022 As-Built