
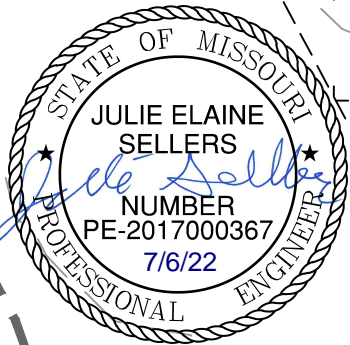
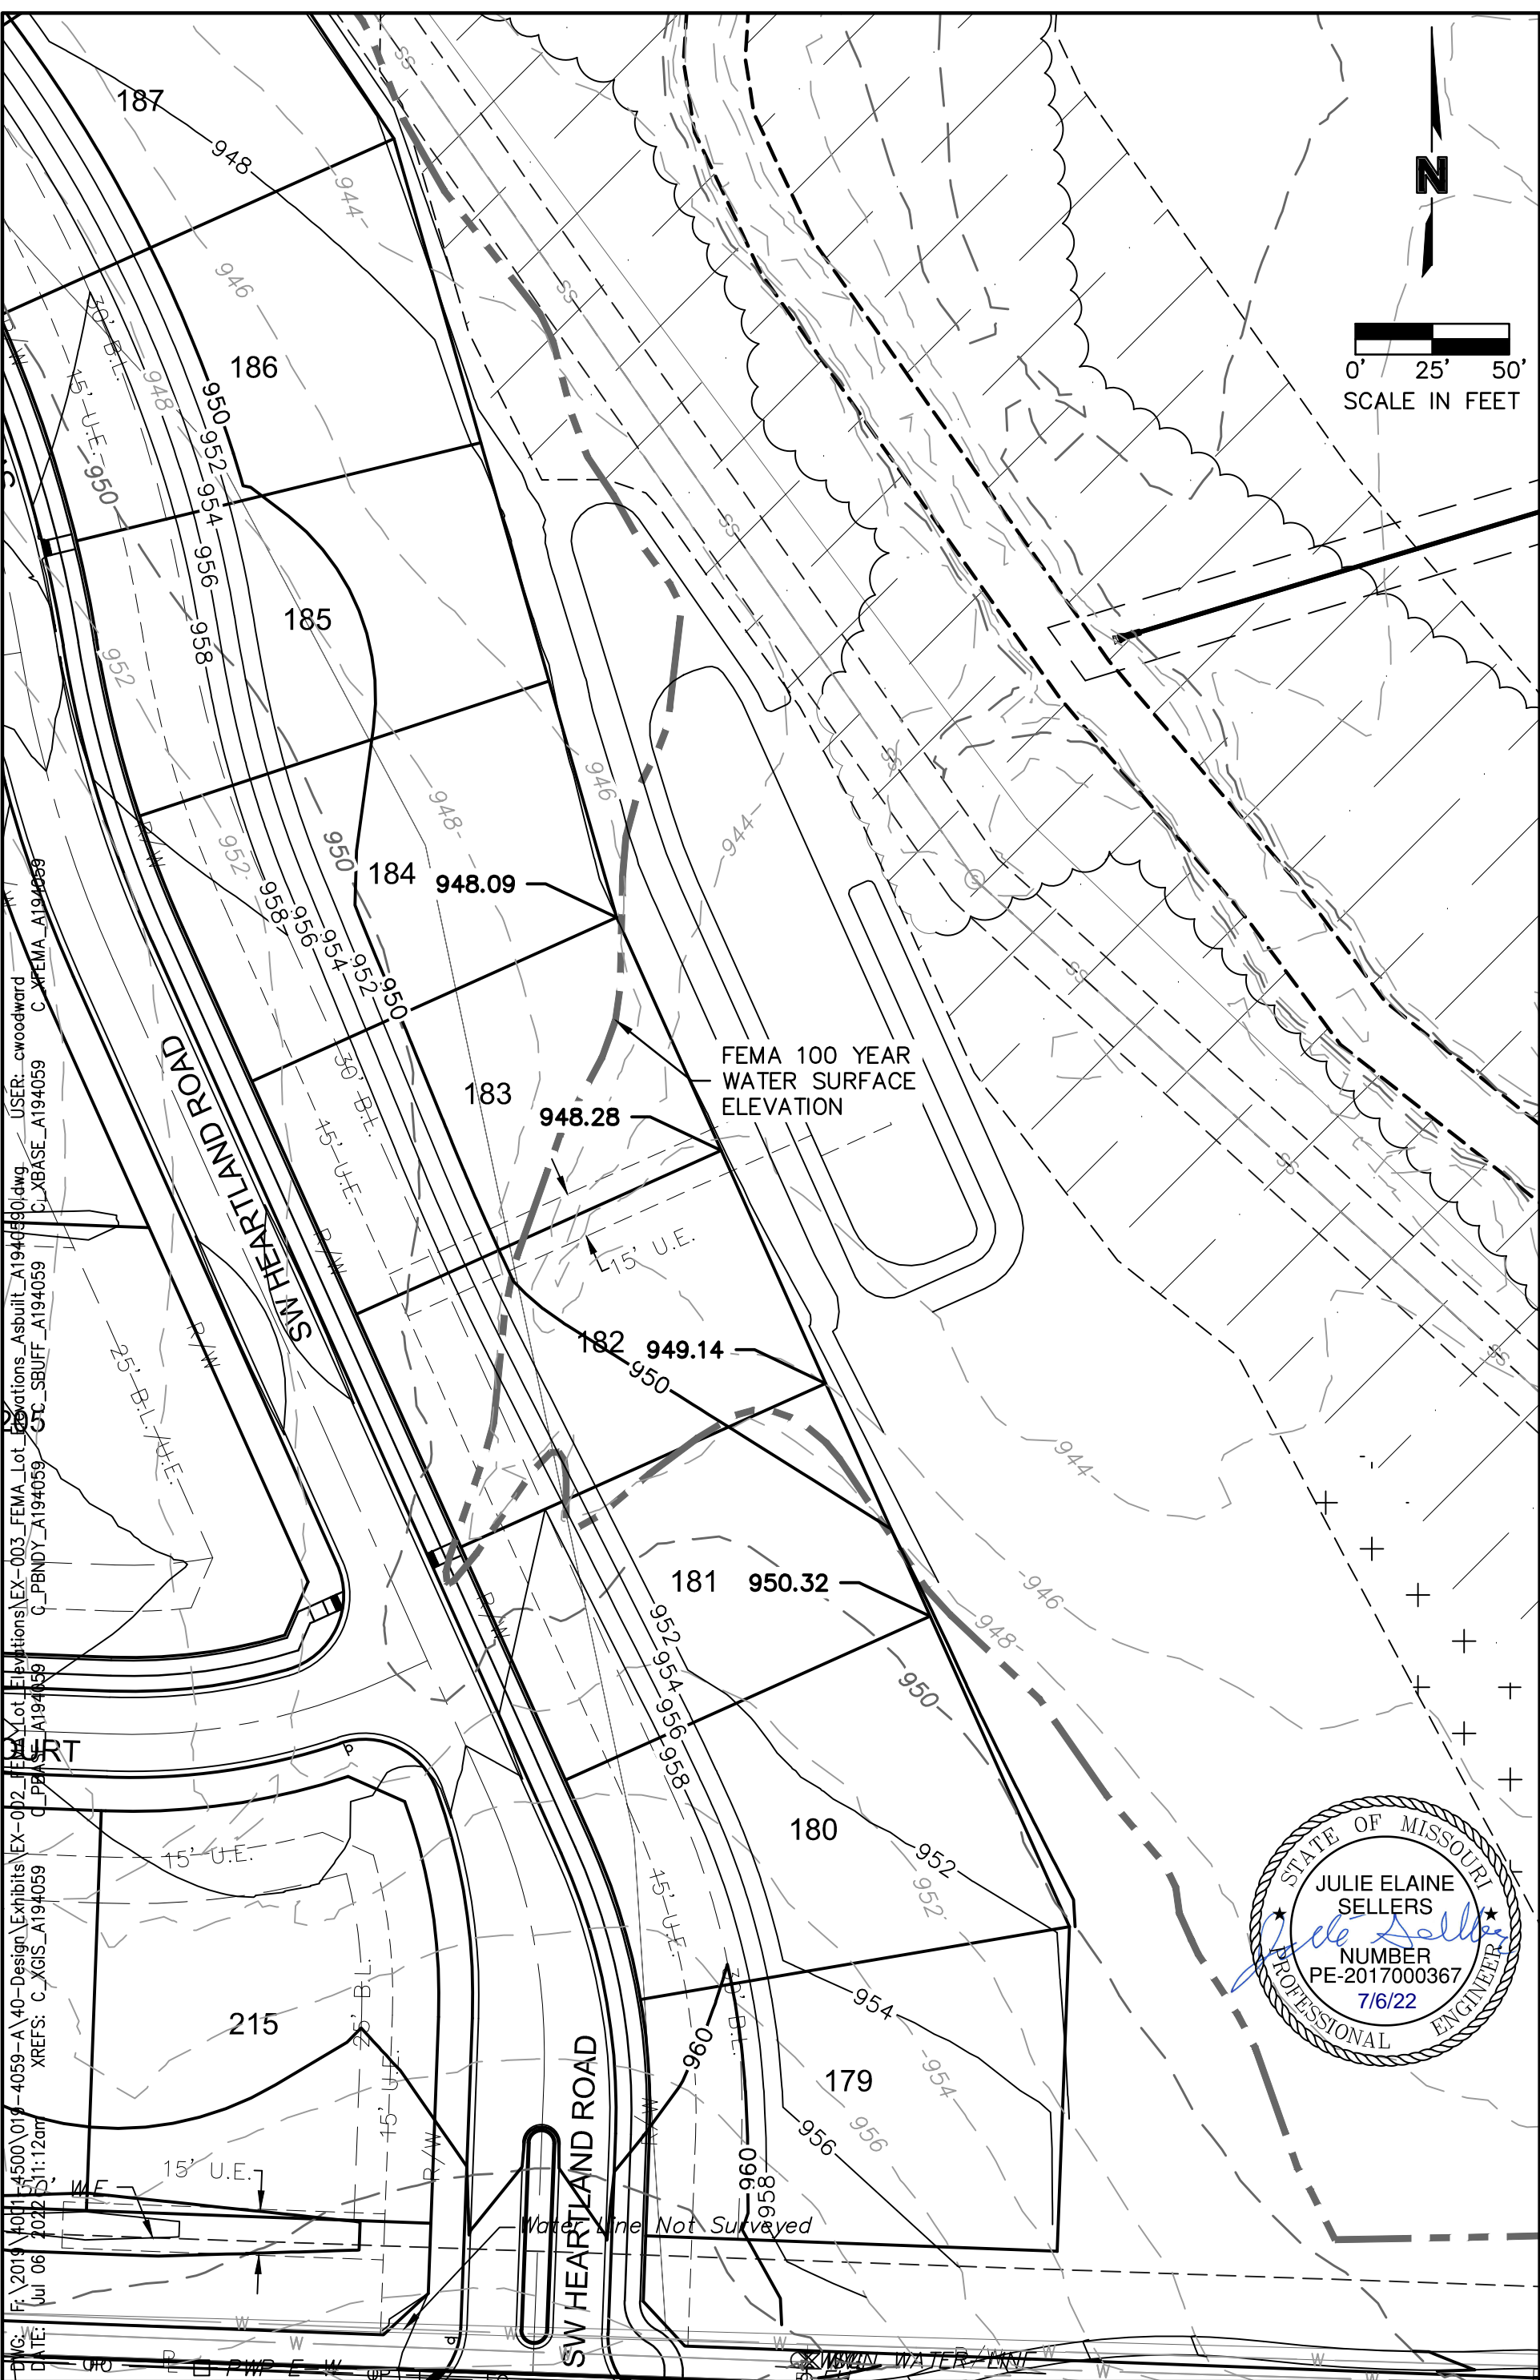


N

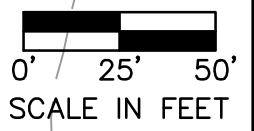

PROJECT NO: A19-40590  
 DRAWN BY: CLW  
 DATE: 07/06/2022  
 USER: cwoodward  
 C:\XBASE\_A194059 C:\XPEMA\_A194059  
 EX-003 FEMA Lot Elevations As-built A1940590.dwg  
 C:\PBNDY\_A194059 C:\SBUFF\_A194059  
 EX-002 FEMA Lot Elevations As-built A1940590.dwg  
 C:\PBNDY\_A194059 C:\SBUFF\_A194059  
 EX-001 Design Exhibits A1940590.dwg  
 C:\PBNDY\_A194059 C:\SBUFF\_A194059  
 XREFS: C:\XGIS\_A194059  
 DATE: Jul 06 2022 11:12am  
 DATE: Jul 06 2022 11:12am  
 DATE: Jul 06 2022 11:12am

PROJECT NO: A19-40590  
 DRAWN BY: CLW  
 DATE: 07/06/2022

**RETREAT AT HOOK FARMS 2ND PLAT**  
**AS-BUILT FEMA LOT ELEVATIONS**

**olsson**  
 1301 Burlington Street  
 North Kansas City, MO 64116  
 TEL 816.361.1177

EXHIBIT  
**EX-003**