


AS-BUILT PLANS - 5/10/2016

DATE	REVISION	NO.	BY	CHKD BY
05/10/2016	ISSUED FOR PERMITS	1	XXX	XXX
05/10/2016	REVISED PLANS PER CITY COMMENTS VIA EMAIL DATED 5-10-16	2	XXX	XXX
07/20/2016	REVISED PLANS PER CITY COMMENTS DATED 7-20-16	3	XXX	XXX
07/20/2016	REVISED PLANS PER CITY COMMENTS DATED 7-20-16	4	XXX	XXX

Consult engineers Inc planners  
CONSULTING ENGINEERS, INCORPORATED  
B. JAYCO STEWART, NO. 18-2646

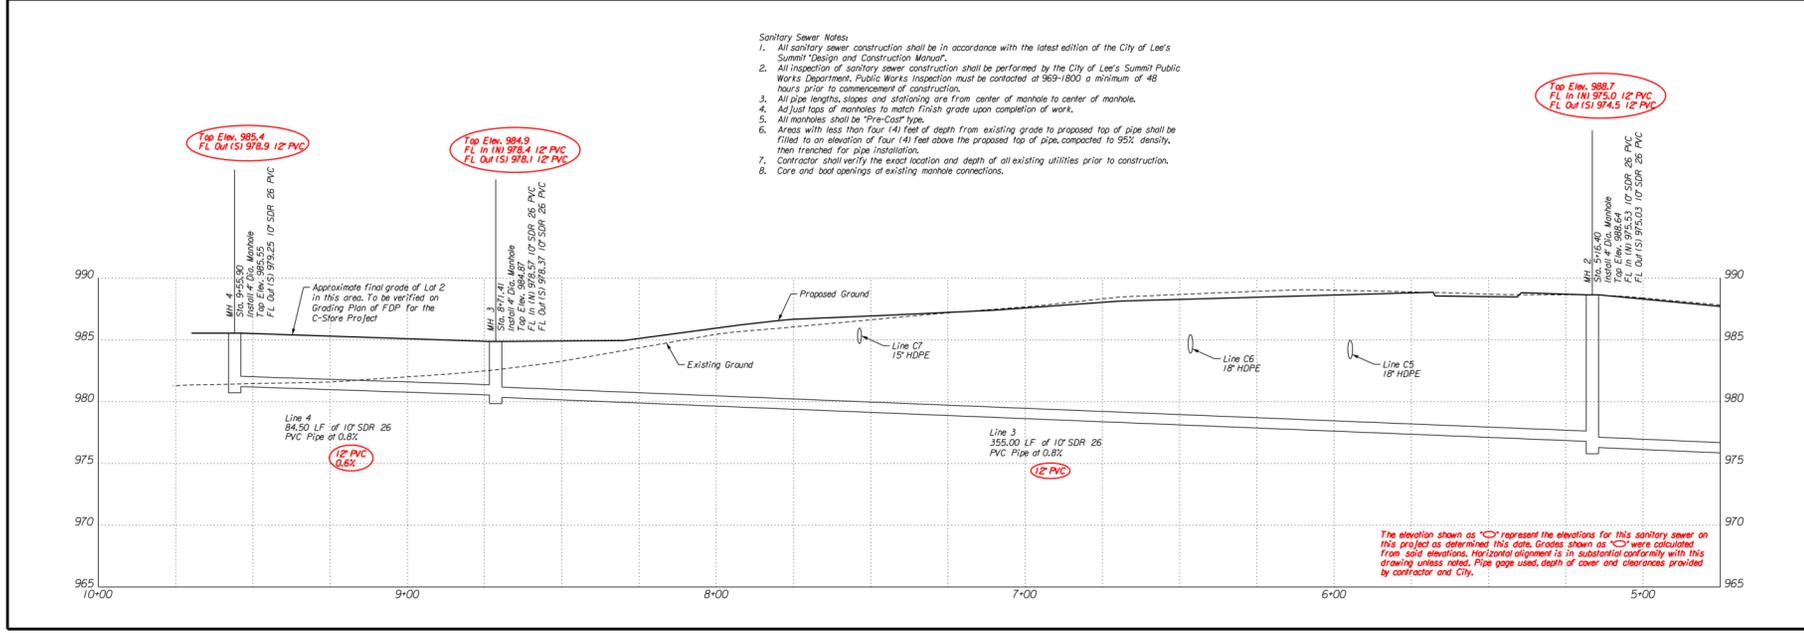

- Sanitary Sewer Notes:**
- All sanitary sewer construction shall be in accordance with the latest edition of the City of Lee's Summit "Design and Construction Manual".
  - All inspection of sanitary sewer construction shall be performed by the City of Lee's Summit Public Works Department. Public Works Inspection must be contacted at 969-1800 a minimum of 48 hours prior to commencement of construction.
  - All pipe lengths, slopes and starting are from center of manhole to center of manhole.
  - Adjust tops of manholes to match finish grade upon completion of work.
  - All manholes shall be "Pre-Cast" type.
  - Areas with less than four (4) feet of depth from existing grade to proposed top of pipe shall be filled to an elevation of four (4) feet above the proposed top of pipe, compacted to 95% density, then trenched for pipe installation.
  - Contractor shall verify the exact location and depth of all existing utilities prior to construction.
  - Core and boot openings at existing manhole connections.

The elevation shown as "C" represent the elevations for this sanitary sewer on this project as determined this date. Grades shown as "G" were calculated from said elevations. Horizontal alignment is in substantial conformity with this drawing unless noted. Pipe goes uses depth of cover and clearances provided by contractor and City.

SANITARY SEWER COLLECTION SYSTEM	
SHEET 1 OF 2	
STROTHER CROSSING	
LEE'S SUMMIT - JACKSON COUNTY - MISSOURI	
DATE	May, 2016
DESIGNER	XXX
DRAWING NO.	XXX
SCALE	AS SHOWN
SHEET NO.	14
TOTAL SHEETS	26