


DWG: F:\2019\2001-2500\019-2339-A140-Design\AutoCAD\Final Plans - Asbuilts\Sheets\CONV\STREET & STORM\CONV\A192339_Revise.dwg
DATE: Oct 31, 2022 4:52pm XREFS: C:\BASE_A192339 C:\FBASE_A192339 C:\PBDY_A192339 C:\PBLK_A192339 C:\PSURE_A192339 C:\PPATT_A192339 C:\PSTRM_A192339
USER: bworthley

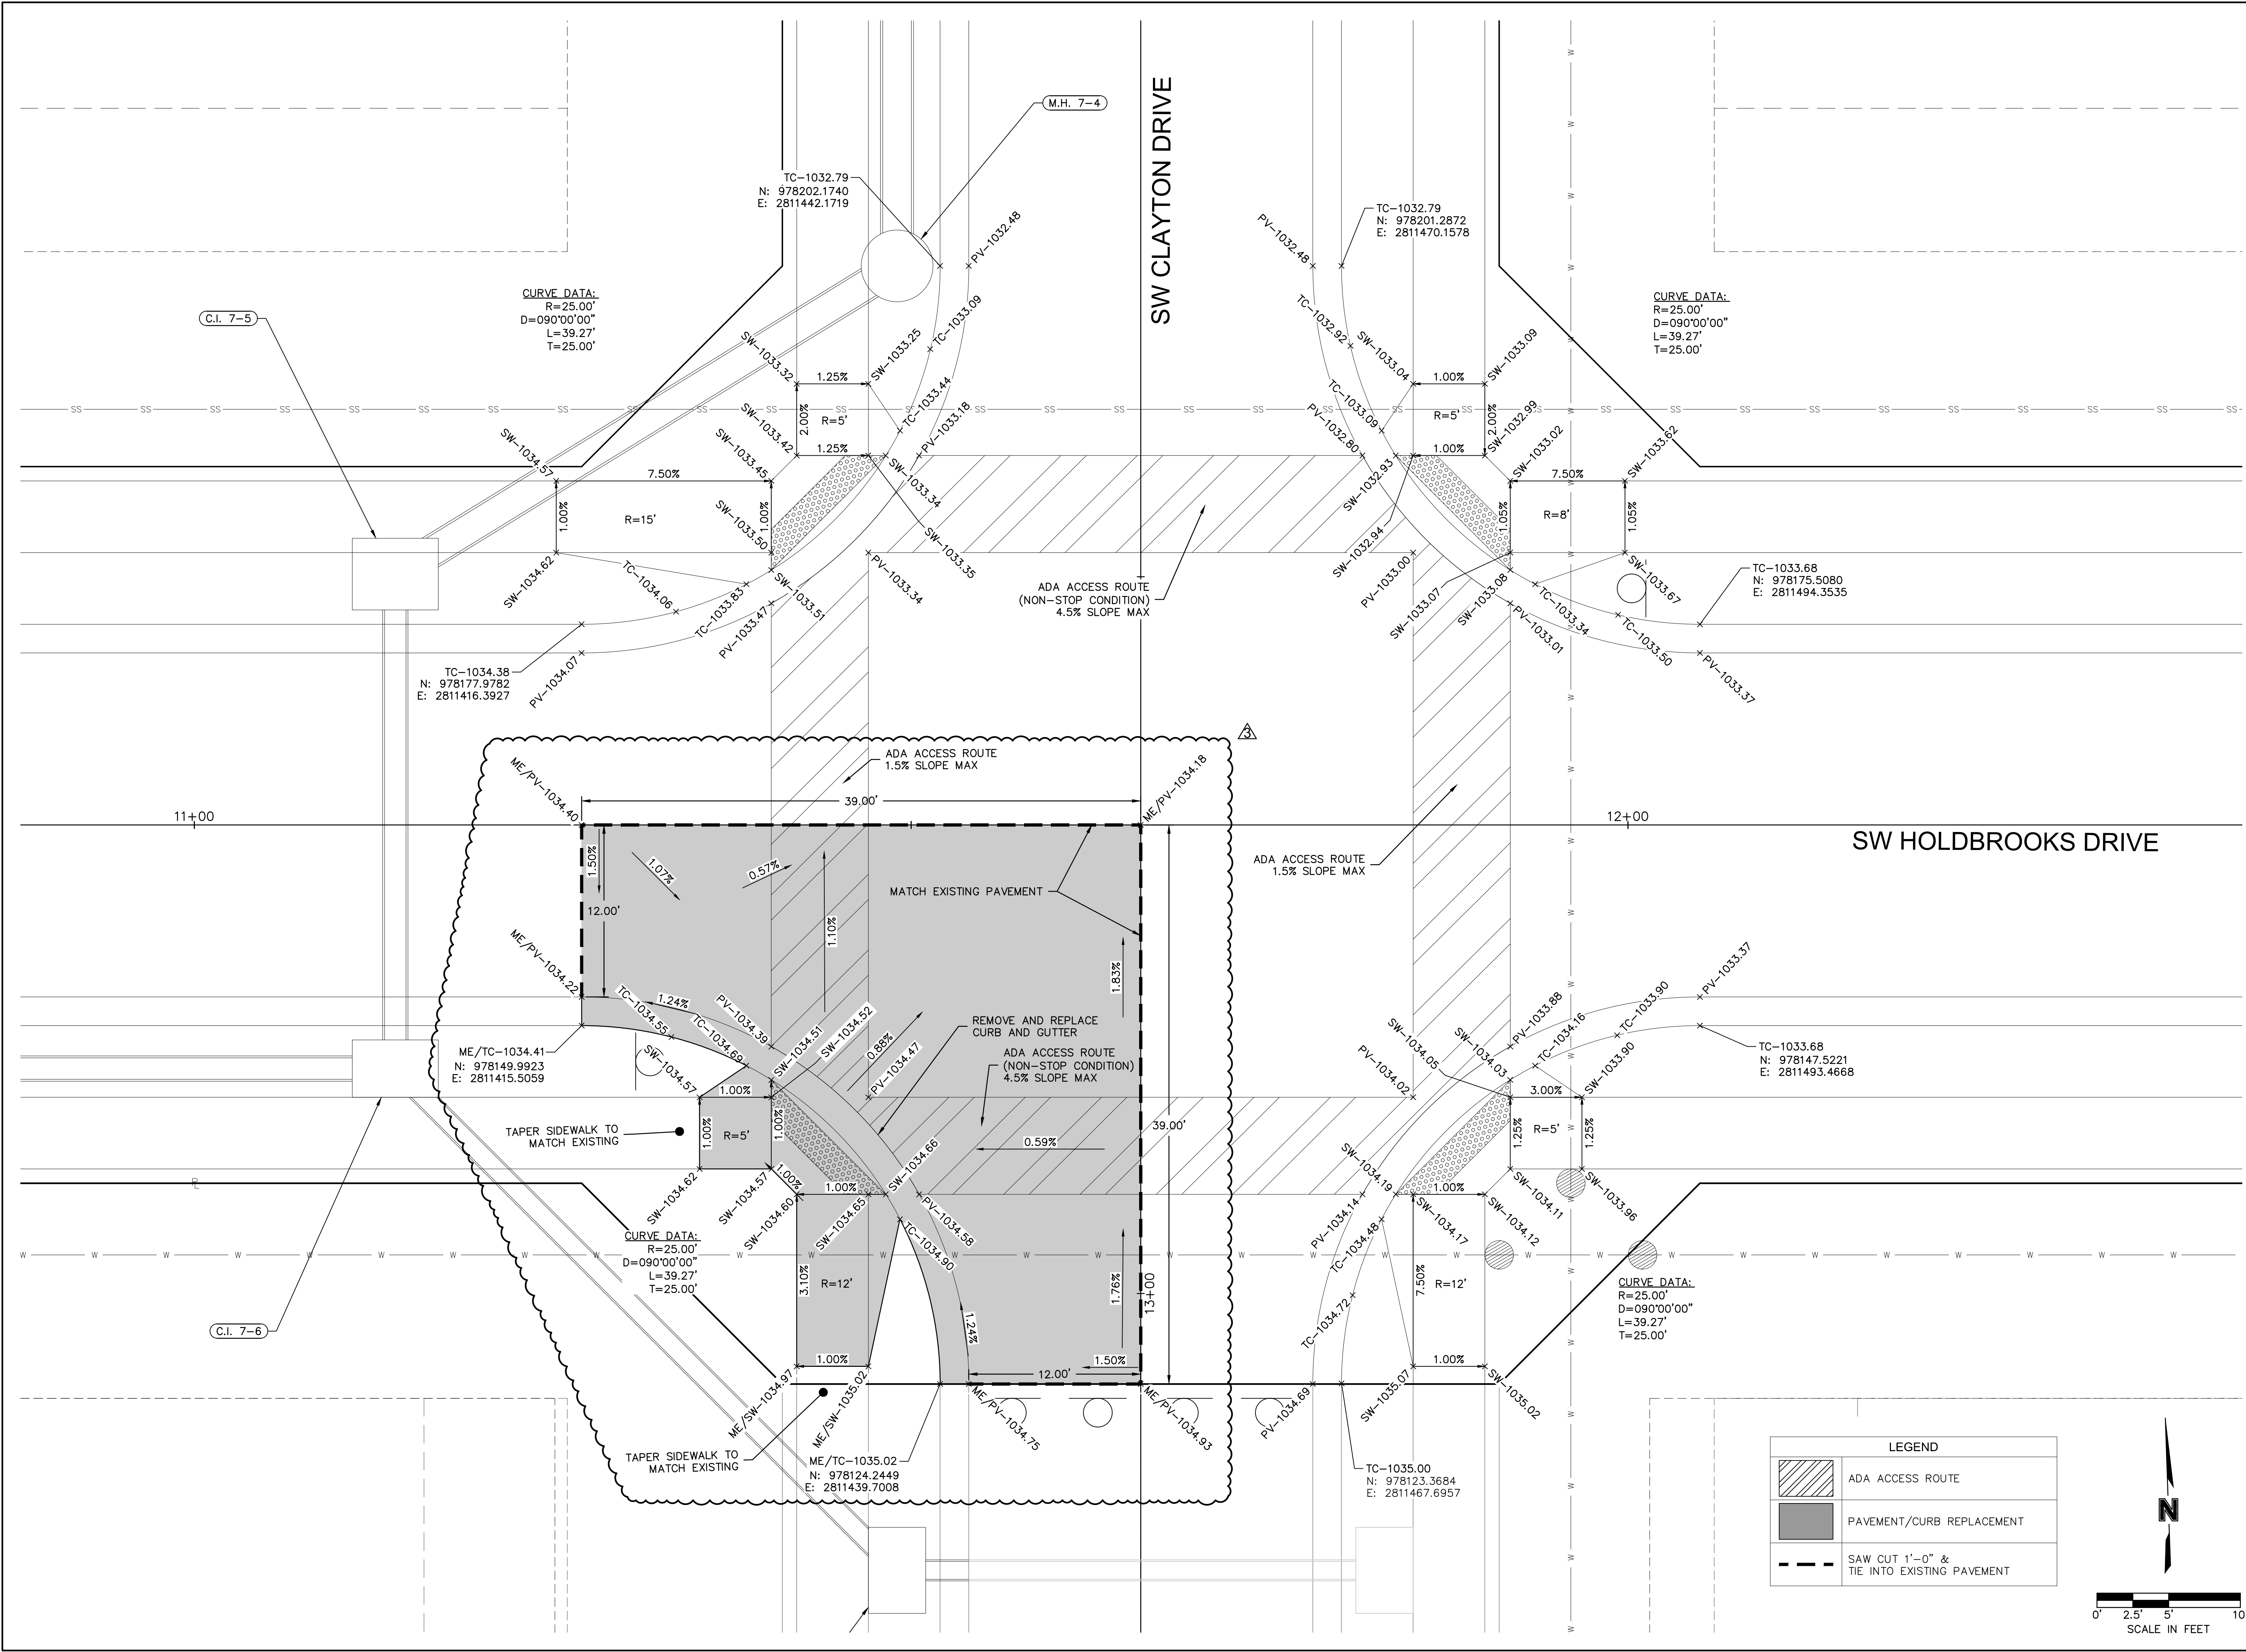

LEGEND	
	ADA ACCESS ROUTE
	PAVEMENT/CURB REPLACEMENT
	SAW CUT 1'-0" & TIE INTO EXISTING PAVEMENT

SW HOLDBROOKS DRIVE & SW CLAYTON PLACE INTERSECTION
STREET & STORM SEWER PLANS

OSAGE
FIRST PLAT

LEE'S SUMMIT, MISSOURI

BY

DATE

REV. NO.

10/31/2022

3

REVISIONS DESCRIPTION

CURB RAMP AND STREET GRADES REVISED

2020

drawn by: AA

checked by: SS

designed by: AA

QA/QC by: JES

project no.: A19-2339

drawn by: A192339

date: 3/17/2022

SHEET

C120

olsson

Olsson - Civil Engineering
Missouri Certificate of Authority # 001592
1301 Burlington Street
North Kansas City, MO 64116
TEL 816.361.1177
www.olson.com

STATE OF MISSOURI

JULIE ELAINE SELLERS

NUMBER PE-2017000367

11/1/2022

PROFESSIONAL ENGINEER