
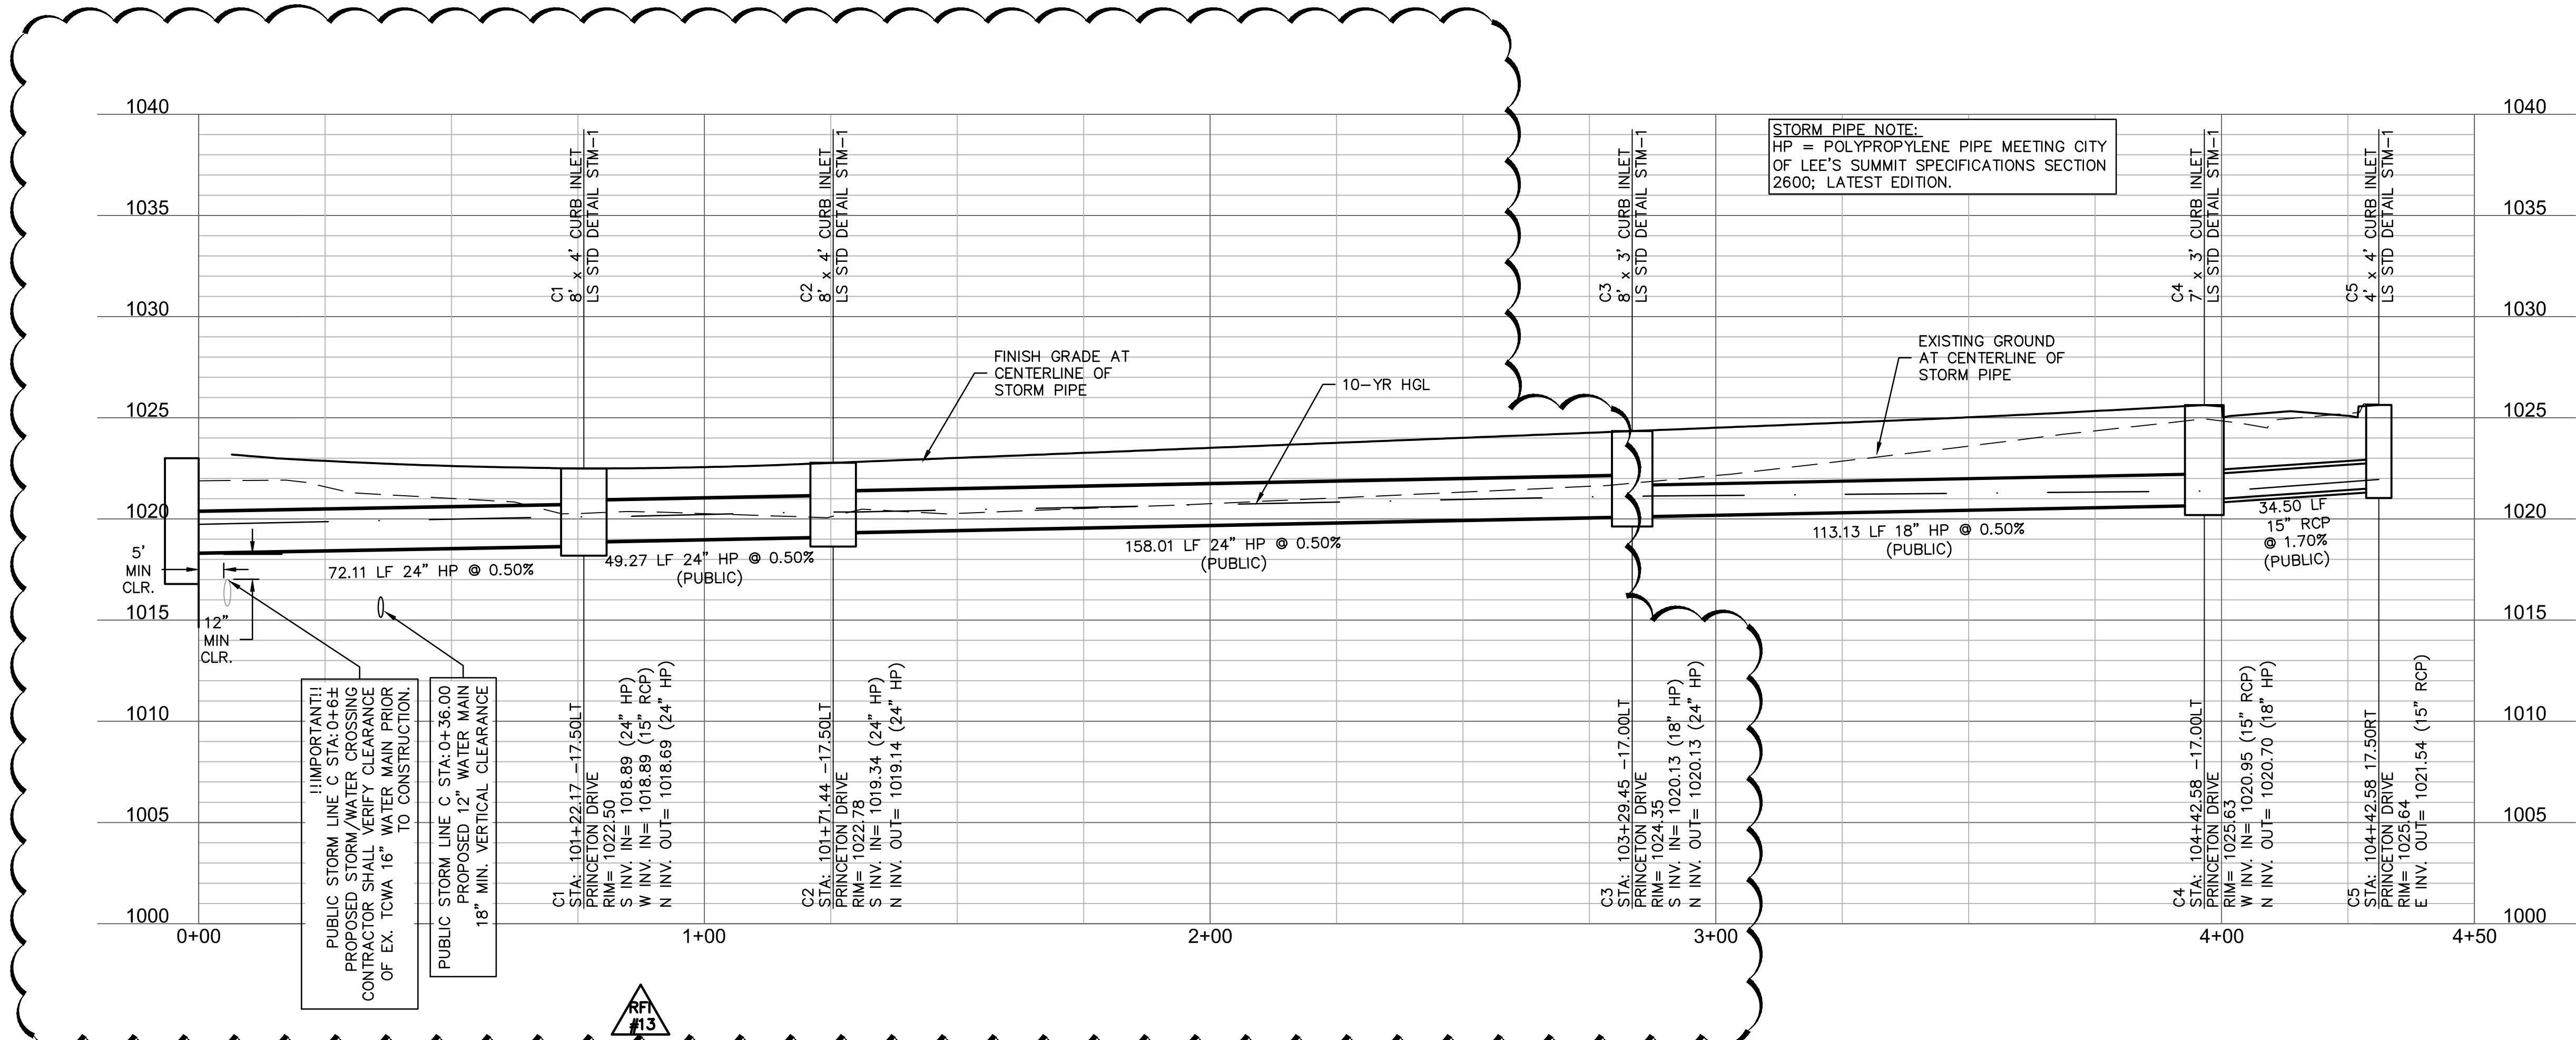


USER: rjeppson
C_TBLK_22x34_81450

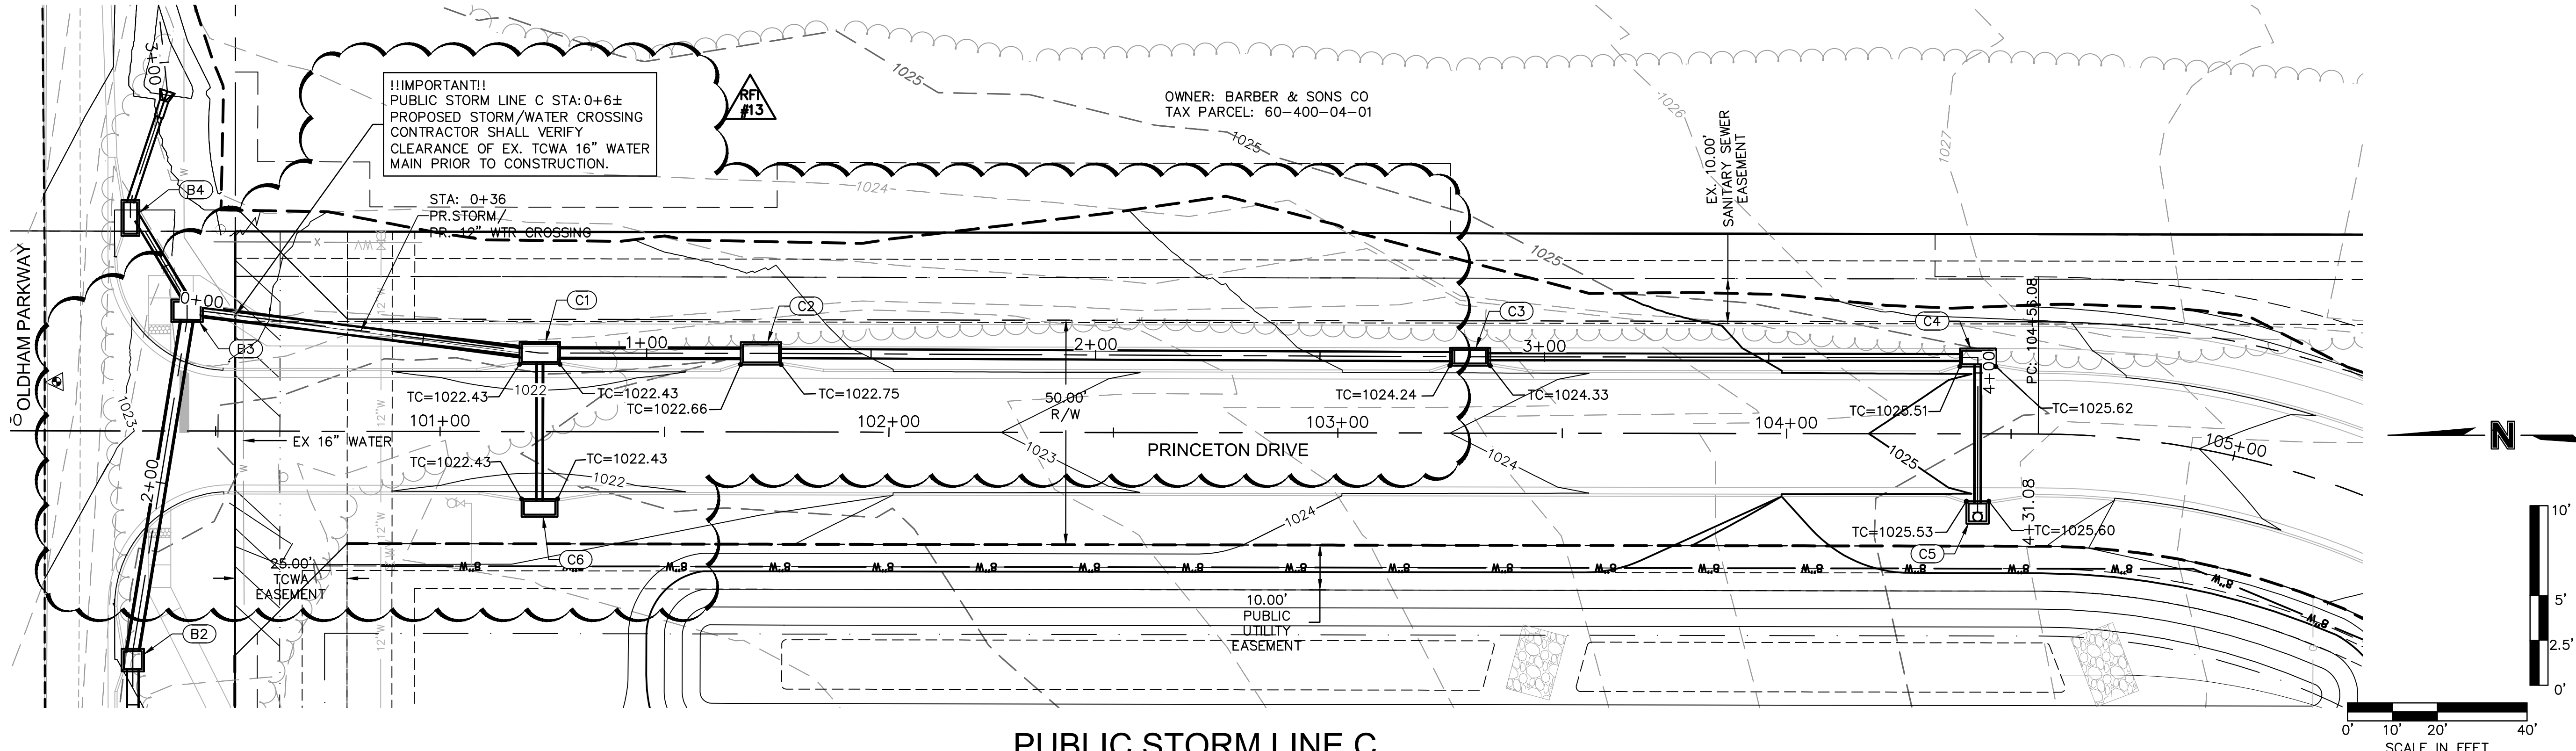

MISSOURI
ONE CALL SYSTEM

1-800-DIG-RITE OR 811
www.mo1call.com

SE PRINCETON DRIVE
PUBLIC STORM LINE C PLAN & PROFILE

THE PRINCETON SENIOR LIVING
SE OLDHAM PARKWAY

drawn by: _____ RPJ
designed by: _____ RVJ
checked by: _____ JLR
project no.: _____ 018-1450
drawing no.: _____ STM_PROF_81450
date: _____ 07.19.19

SHEET
ST1.2

AS-BUILT
11/01/2022

[illegible]

REVISIONS

LEE'S SUMMIT, MISSOURI

olsson

Olsson Engineering MO State Certificate of Authority #001592
Olsson Landscape Architecture MO State Cert. of Authority #2005000285
550 St. Louis St.
Springfield, MO 65806
TEL 417.890.8802

TEL 417.890.8802 www.olsson.com