



DWG: F:\2018\1001-1500\018-1450\40-Design\AutoCAD\Final Plans\Sheets\GNC\Public STORM\C_STM_DTLS_81450.DWG
DATE: Jul 24, 2019 3:10pm XREFS: C:\Bk\22x34_81450_C_PBASE_81450_V_TOPO_81450

USER: rjeppson

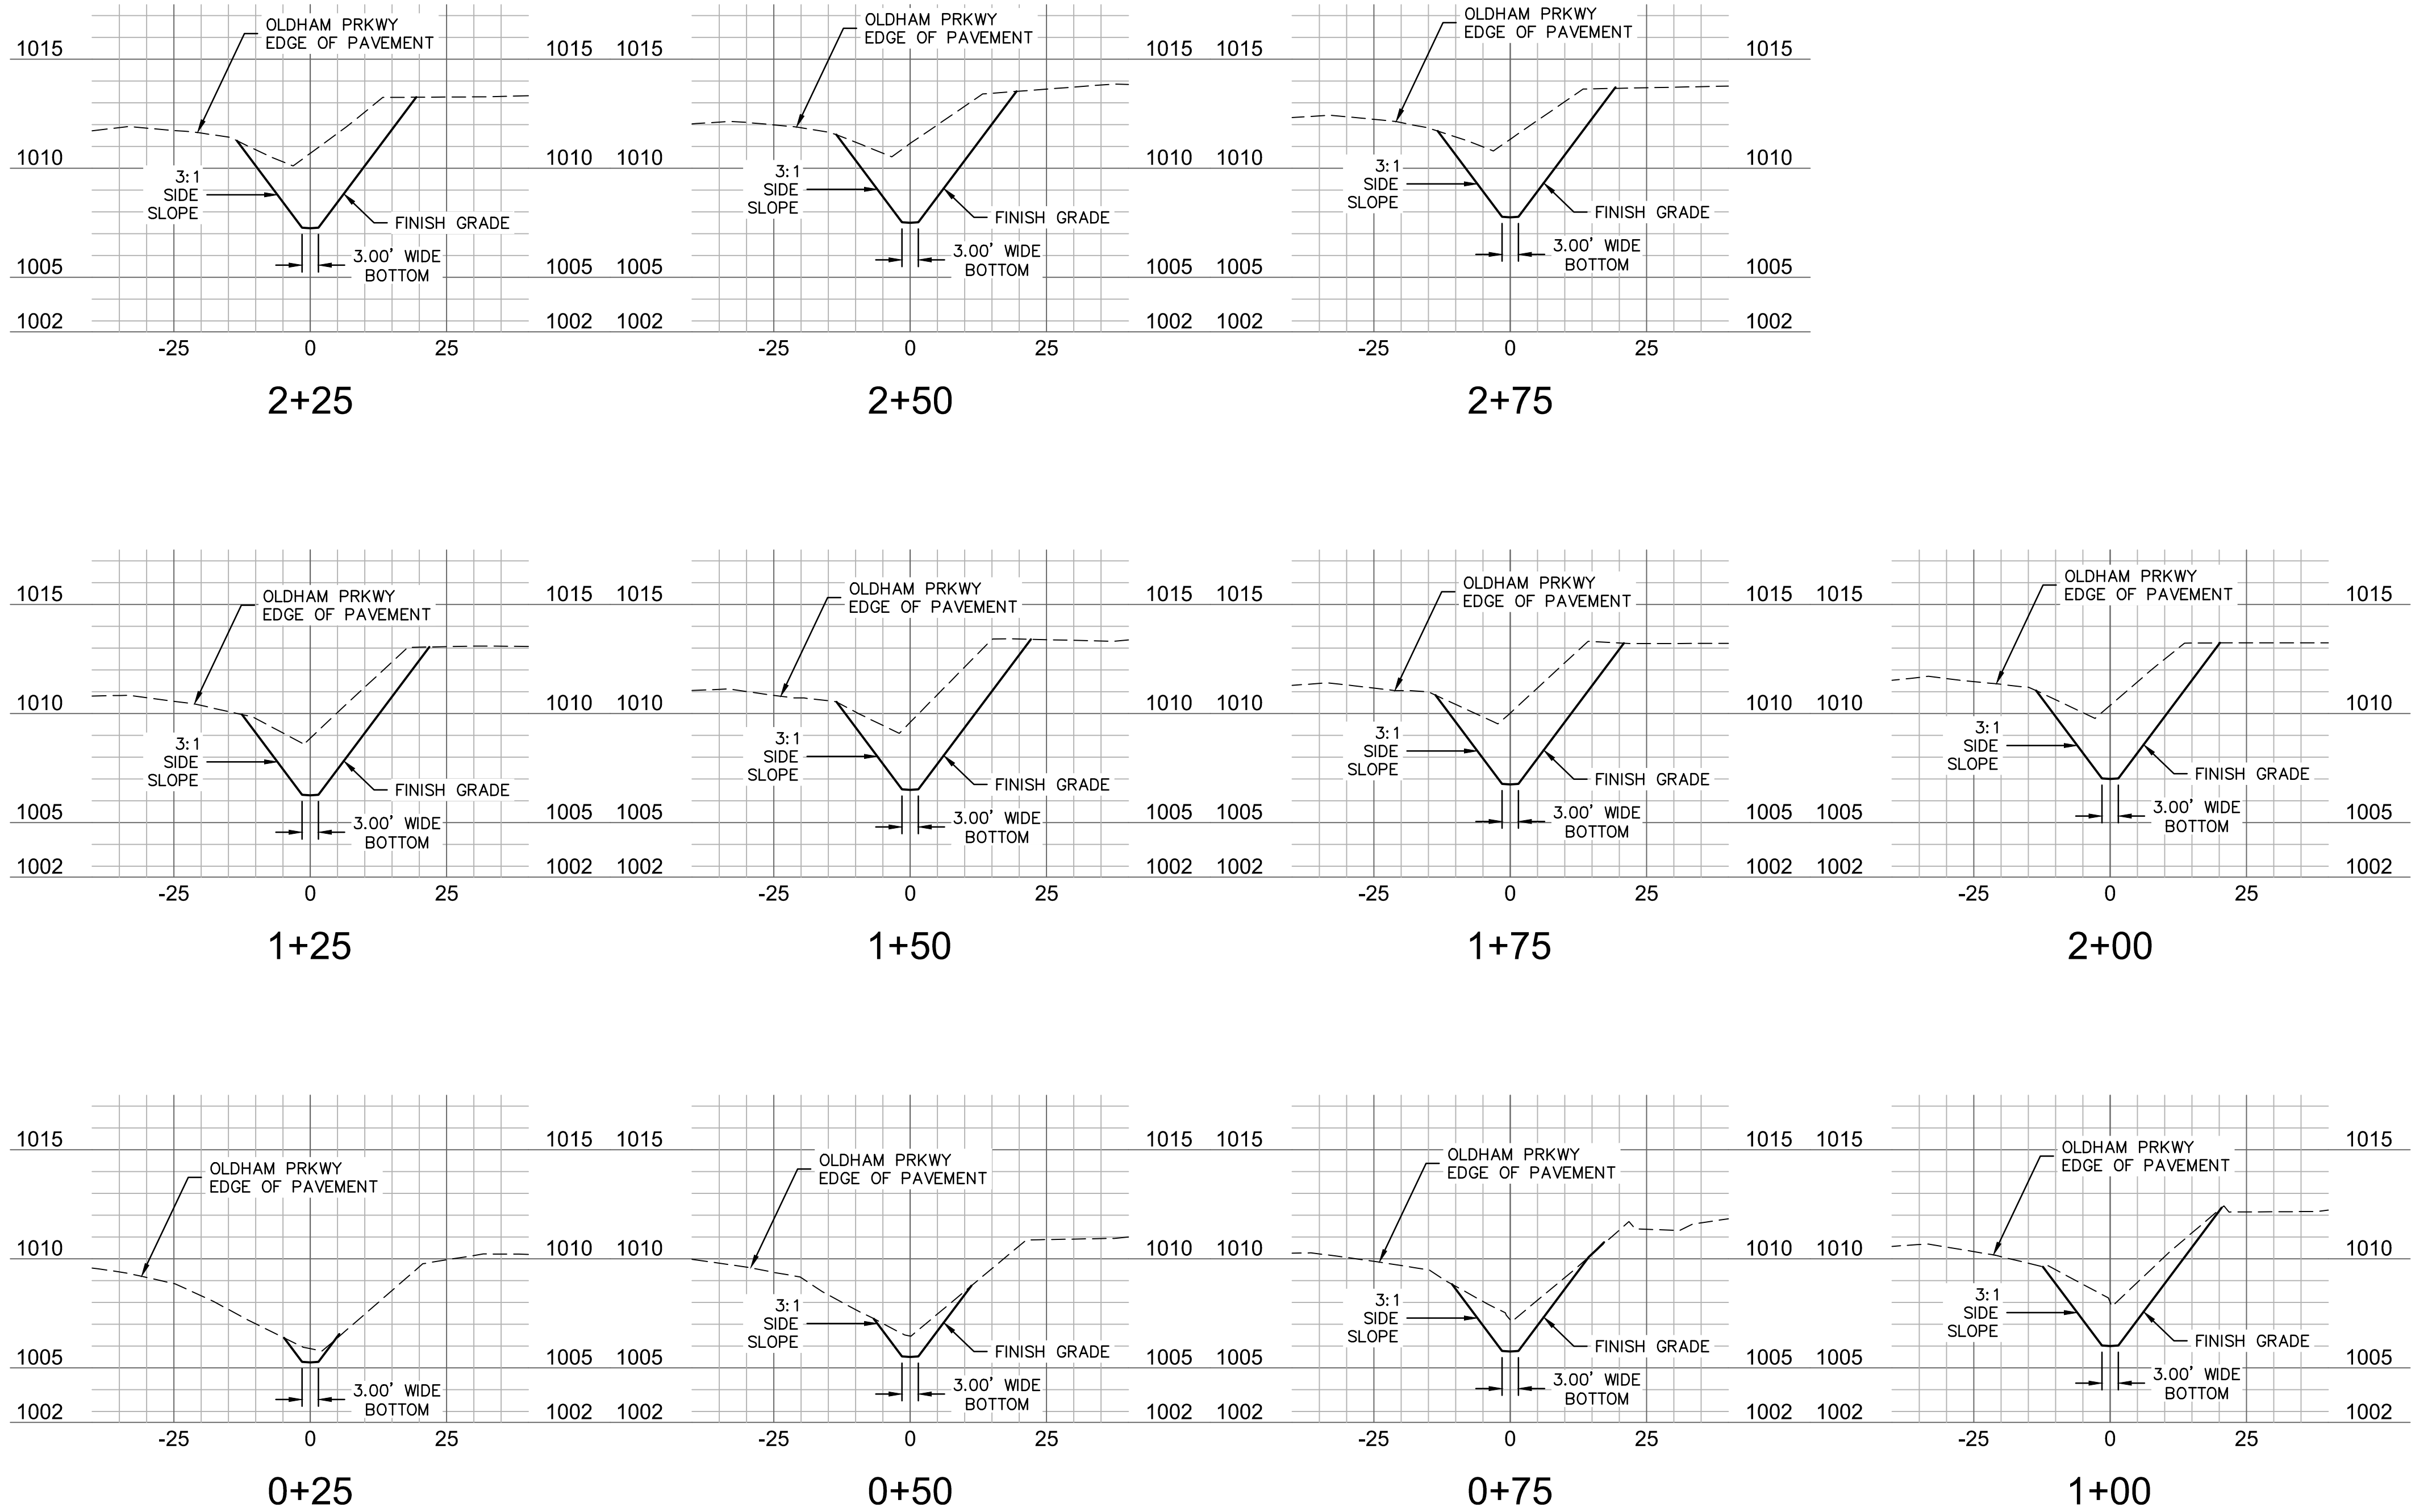

OLDHAM PARKWAY DRAINAGE DITCH SECTION VIEWS

HORIZONTAL SCALE 1" = 20'
VERTICAL SCALE 1" = 5'

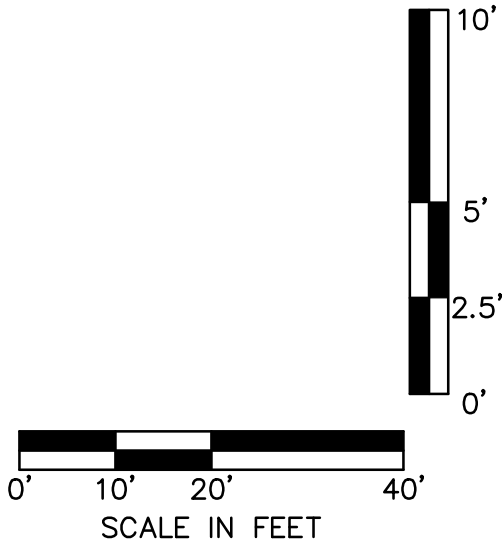

SE OLDHAM PARKWAY & SE PRINCETON DRIVE
DRAINAGE DITCH CROSS SECTIONS

THE PRINCETON SENIOR LIVING
SE OLDHAM PARKWAY

LEE'S SUMMIT, MISSOURI

2019

REVISIONS

REV. NO.	DATE	REVISIONS DESCRIPTION

AS-BUILT
11/01/2022

olsson

Olsson Engineering MO State Certificate of Authority #001592
Olsson Landscape Architecture MO State Cert. of Authority #200500285
550 St. Louis St.
Springfield, MO 65806
TEL 417.890.8802
www.olson.com

drawn by: RPL
designed by: RVL
checked by: JLR
project no.: 018-1450
drawing no.: C_STM_DTLS_81450
date: 07.19.19

SHEET
ST4.2