

THE TOWNHOMES OF CHAPEL RIDGE-2ND PLAT

LOTS 9-19 & TRACTS A-D STREET AND STORM CONSTRUCTION PLANS

Section 8, Township 48 North, Range 31 West
LEE'S SUMMIT, JACKSON COUNTY, MISSOURI

CONSTRUCTION AND DESIGN NOTES:

STREET & STORM SEWERS:

1 ~ STREET PAVEMENT SHALL CONSIST OF TYPE CG-2 CURBS WITH PAVEMENT PER TABLE LS-2 OF THE LEE'S SUMMIT DESIGN AND CONSTRUCTION MANUAL

RESIDENTIAL LOCAL STREET SEE BELOW FOR TYPICAL SECTION.

- OPTION 1) 4" TYPE II ASPHALT BASE AND 2" TYPE III ASPHALT SURFACE OVER A 6" MoDOT TYPE 5 BASE AND A SUBGRADE MIXTURE OF 6" FLY ASH STABILIZED SUBGRADE IN ACCORDANCE WITH THE CITY OF LEE'S SUMMIT DESIGN AND CONSTRUCTION MANUAL.
- OPTION 2) 4" TYPE II ASPHALT BASE AND 2" TYPE III ASPHALT SURFACE OVER 6" MoDOT TYPE 5 BASE OVERTOP A BIAXIAL GEOGRID MEETING THE REQUIREMENTS OF TABLE 2201.6-1

2 ~ STORM SEWER PIPE SHALL BE HIGH DENSITY POLYETHYLENE (HDPE) AS APPROVED BY CITY OF LEE'S SUMMIT DESIGN AND CONSTRUCTION MANUAL.

3 ~ JUNCTION BOXES SHALL BE PER CITY OF LEE'S SUMMIT STANDARD DRAWING NO. JB-1. FIELD INLETS SHALL BE PER CITY OF LEE'S SUMMIT STANDARD DRAWING FI-1. TOEWALLS SHALL BE PER CITY OF LEE'S SUMMIT STANDARD DRAWING NO. SD-35. STORM MANHOLES SHALL BE PER CITY OF LEE'S SUMMIT DETAIL SD-27. ROCK LINING AND RIP RAP SHALL BE PER CITY OF LEE'S SUMMIT.

GENERAL NOTES:

- 1 ~ ALL CONSTRUCTION SHALL CONFORM TO THE CITY OF LEE'S SUMMIT DESIGN AND CONSTRUCTION MANUAL AS ADOPTED BY ORDINANCE 5813.
- 2 ~ ALL REQUIRED EASEMENTS WITHIN THE BOUNDARY OF THIS PROJECT SHALL BE PROVIDED FOR ON THE FINAL PLAT.
- 3 ~ ANY REQUIRED EASEMENT LOCATED OUTSIDE OF THE BOUNDARY OF THIS PROJECT SHALL BE PROVIDED FOR BY SEPARATE INSTRUMENT PRIOR TO ISSUANCE OF CONSTRUCTION PERMITS.
- 4 ~ THE CONTRACTOR SHALL NOTIFY THE CITY OF LEE'S SUMMIT DEVELOPMENT ENGINEERING INSPECTION AT 816.969.1200 AT LEAST 48 HOURS PRIOR TO THE COMMENCEMENT OF ANY CONSTRUCTION.
- 5 ~ THE CONTRACTOR SHALL NOTIFY ENGINEERING SOLUTIONS AT 816.623.9888 OF ANY CONFLICT WITH THE IMPROVEMENTS PROPOSED BY THESE PLANS AND SITE CONDITIONS.
- 6 ~ THE CONTRACTOR SHALL NOTIFY THE CITY ENGINEER AND OBTAIN THE APPROPRIATE BLASTING PERMITS FOR A REQUIRED BLASTING. IF BLASTING IS ALLOWED, ALL BLASTING SHALL CONFORM TO STATE REGULATIONS AND LOCAL ORDINANCES.

UTILITY COMPANIES:

THE FOLLOWING LIST OF UTILITY COMPANIES IS PROVIDED FOR INFORMATION ONLY. WE DO NOT OFFER ANY GUARANTEE OR WARRANTY THAT THIS LIST IS COMPLETE OR ACCURATE. THE CONTRACTOR SHALL BE RESPONSIBLE FOR CONTACTING ALL UTILITY COMPANIES THAT MAY BE AFFECTED BY THE PROPOSED CONSTRUCTION AND VERIFYING THE ACTUAL LOCATION OF EACH UTILITY LINE. THE CONTRACTOR SHALL NOTIFY ENGINEERING SOLUTIONS AT 816.623.9888 OF ANY CONFLICT WITH PROPOSED IMPROVEMENTS.


EVERGY ~ 298-1196
MISSOURI GAS ENERGY ~ 756-5261
SOUTHWESTERN BELL TELEPHONE ~ 761-5011
COMCAST CABLE ~ 795-1100
WILLIAMS PIPELINE ~ 422-6300
CITY OF LEE'S SUMMIT PUBLIC WORKS ~ 969-1800
CITY OF LEE'S SUMMIT PUBLIC WORKS INSPECTIONS ~ 969-1800
CITY OF LEE'S SUMMIT WATER UTILITIES ~ 969-1900
MISSOURI ONE CALL (DIG RITE) ~ 1-800-344-7483

OIL - GAS WELLS

ACCORDING TO EDWARD ALTON MAY JR'S ENVIRONMENTAL IMPACT STUDY OF ABANDONED OIL AND GAS WELLS IN LEE'S SUMMIT, MISSOURI IN 1995, THERE ARE NOT OIL AND GAS WELLS WITHIN 165 FEET OF THE PROPERTY AS SURVEYED HEREON.

FLOOD INFORMATION:

The property is located in Zone "X" areas outside the 100 year flood plain per FEMA Map 29095C0430G, dated January 20, 2017

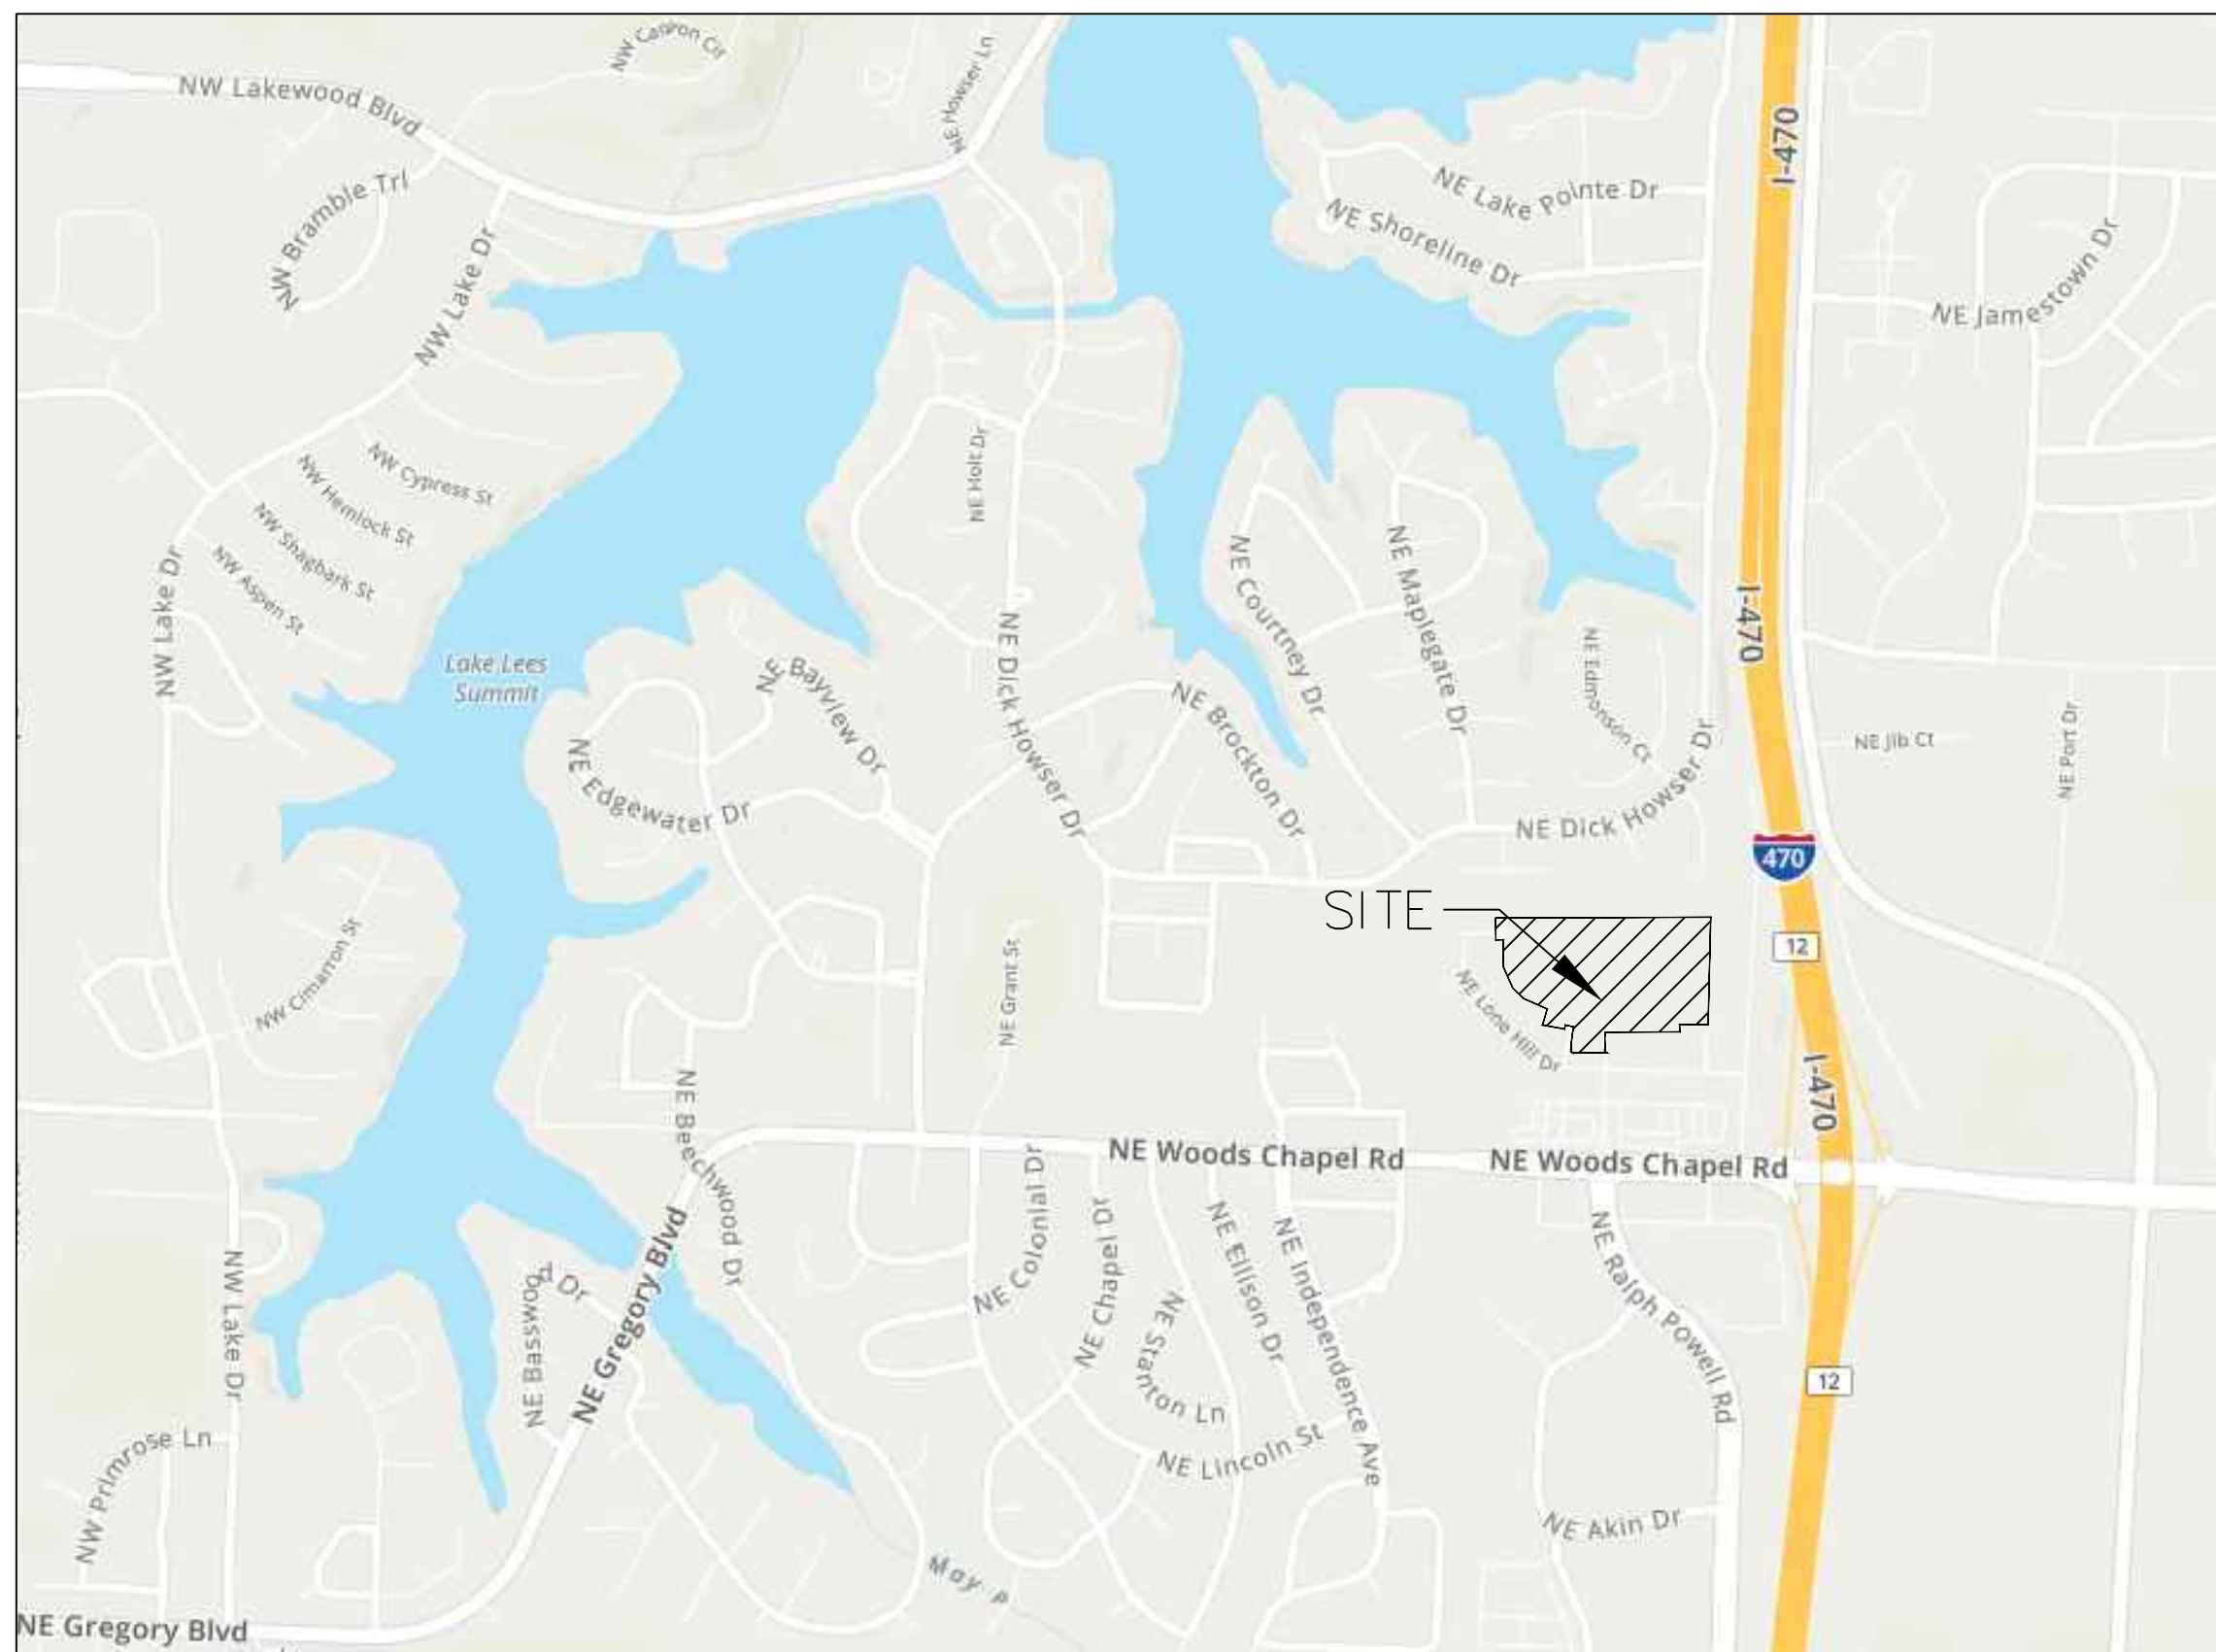


SITE LOCATION MAP

Summary of Quantities:

ITEM AND DESCRIPTION	UNIT	ESTIMATED QUANTITY
ASPHALT PAVING	S.Y.	3,430.98
CURBING	FT	2,343.62
5' SIDEWALK	S.F.	12,057.55
MoDOT Type 5 Base	S.Y.	3,702.68
GEOGRID	S.Y.	3,702.68
ADA SIDEWALK RAMP	UNIT	7
CLEARING, GRADING & GRUBBING	LS	1
SILT FENCE	FT	5,724.09
INLET PROTECTION	UNIT	44.00
SEEDING / MULCHING/ FERTILIZING	AC	18.83
CONST. ENTRANCE	UNIT	2.00
RIP RAP W/ FABRIC	S.Y.	35.00
DITCH CHECK	UNIT	3.00
STORM		
30" HDPE	FT	76.46
24" HDPE	FT	54.41
18" HDPE	FT	299.20
15" HDPE	FT	1,129.96
4' x 4' JUNCTION BOX	EA	2.00
18" HDPE END SECTION / TOE WALL	LS	2.00
30" HDPE END SECTION / TOE WALL	LS	2.00
DETENTION OUTLET CONTROL STRUCTURE	EA	1.00
4' x 4' STORM FIELD INLET	EA	6.00
5' x 4' STORM CURB INLET	EA	6.00

INDEX OF SHEETS:

C.001 ~ STREET & STORM COVER SHEET
C.050 ~ ESC PHASE 1 - PRE CLEARING PLAN
C.051 ~ ESC PHASE 2 - INITIAL AREA STABILIZATION PLAN
C.052 ~ ESC PHASE 3 - FINAL RESTORATION PLAN
C.053 ~ ESC - STANDARD DETAILS
C.100 ~ SITE PLAN
C.200 ~ MASTER DRAINAGE PLAN SHEET 1 OF 3 GRADING PLAN - SWPPP
C.201 ~ MASTER DRAINAGE PLAN SHEET 2 OF 3 SPOT ELEVATIONS
C.202 ~ MASTER DRAINAGE PLAN SHEET 3 OF 3 DRAINAGE AREA MAP
C.203 ~ STREET PLAN & PROFILE
C.204 ~ STREET PLAN & PROFILE
C.205 ~ STREET SIGNAGE PLAN
C.206 ~ SEDIMENT TRAP GRADING PLAN
C.207 ~ SIDEWALK AND INTERSECTION PLAN
C.208 ~ DETENTION BASIN PLAN
C.300 ~ STORM SEWER GENERAL LAYOUT
C.301 ~ STORM SEWER PLAN & PROFILE
C.302 ~ STORM SEWER PLAN & PROFILE
C.303 ~ STORM SEWER PLAN & PROFILE
C.304 ~ STORM SEWER TABLES 10 AND 100 YEAR
C.600 ~ CONSTRUCTION DETAILS
C.601 ~ CONSTRUCTION DETAILS

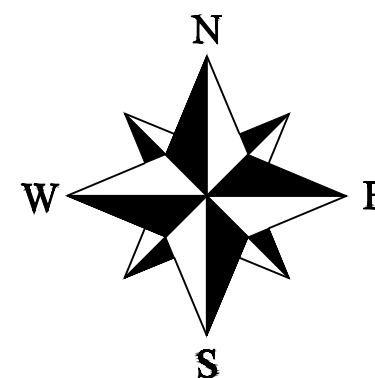

LEGEND:

B/L - BUILDING SET-BACK
C/A - COMMON AREA
D/E - DRAINAGE EASEMENT
FND. - FOUND
L/E - LANDSCAPE EASEMENT
L.N.A. - LIMITS OF NO ACCESS
R/W - RIGHT OF WAY
SAN - SANITARY SEWER LINE
S/W - SIDEWALK
U/E - UTILITY EASEMENT
W - WATER LINE
ST - STORM SEWER LINE

ENGINEER'S CERTIFICATION:

I HEREBY CERTIFY THAT THIS PROJECT HAS BEEN DESIGNED AND THESE PLANS PREPARED IN ACCORDANCE WITH THE CURRENT DESIGN CRITERIA OF THE CITY OF LEE'S SUMMIT, MISSOURI AND THE STATE OF MISSOURI. I FURTHER CERTIFY THAT THESE PLANS WERE DESIGNED IN ACCORDANCE TO AASHTO STANDARDS.

RECORD DRAWING

The information provided on this drawing conforms to construction records; it is not intended for construction, implementation or recording purposes; and it is solely based on information obtained by my firm.

"100-00 100.10", "4-00% 1.15% slope", or "8-inch HDPE-PVC pipe" are all typical examples of revisions that indicate that design data has been replaced with "as-built" information. All other data is as designed and has not been field verified.

Date: 11/17/2022

Certified by: Matthew J. Schlicht

Title: Engineer

Firm: Engineering Solutions




Professional Registration
Missouri
Engineering 2005002186-D
Surveying 2005008319-D
Kansas
Engineering E-1695
Surveying LS-218
Oklahoma
Engineering 6254
Nebraska
Engineering CA2821

THE TOWNHOMES OF CHAPEL RIDGE-2ND PLAT
LOTS 9-19 & TRACTS A-D
Lee's Summit, Jackson County, Missouri

Project: VILLAS OF CHAPEL RIDGE LS2MO
Issue Date: April 10, 2020

Street & Storm Cover Sheet
Construction Plans for:
THE TOWNHOMES OF CHAPEL RIDGE-2ND PLAT
LOTS 9-19 & TRACTS A-D
Lee's Summit, Jackson County, Missouri

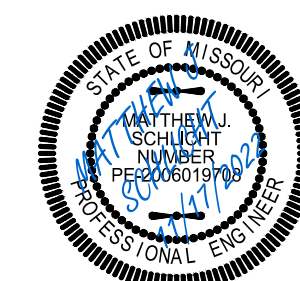





Matthew J. Schlicht
MO PE 2006019708
KS PE 19071
OK PE 25226
NE PE E-14335

REVISIONS

6/25/2021 As-Built
8/18/2021 As-Built
8/31/2021 As-Built
9/9/2021 As-Built
11/17/2022 As-Built

C. 001

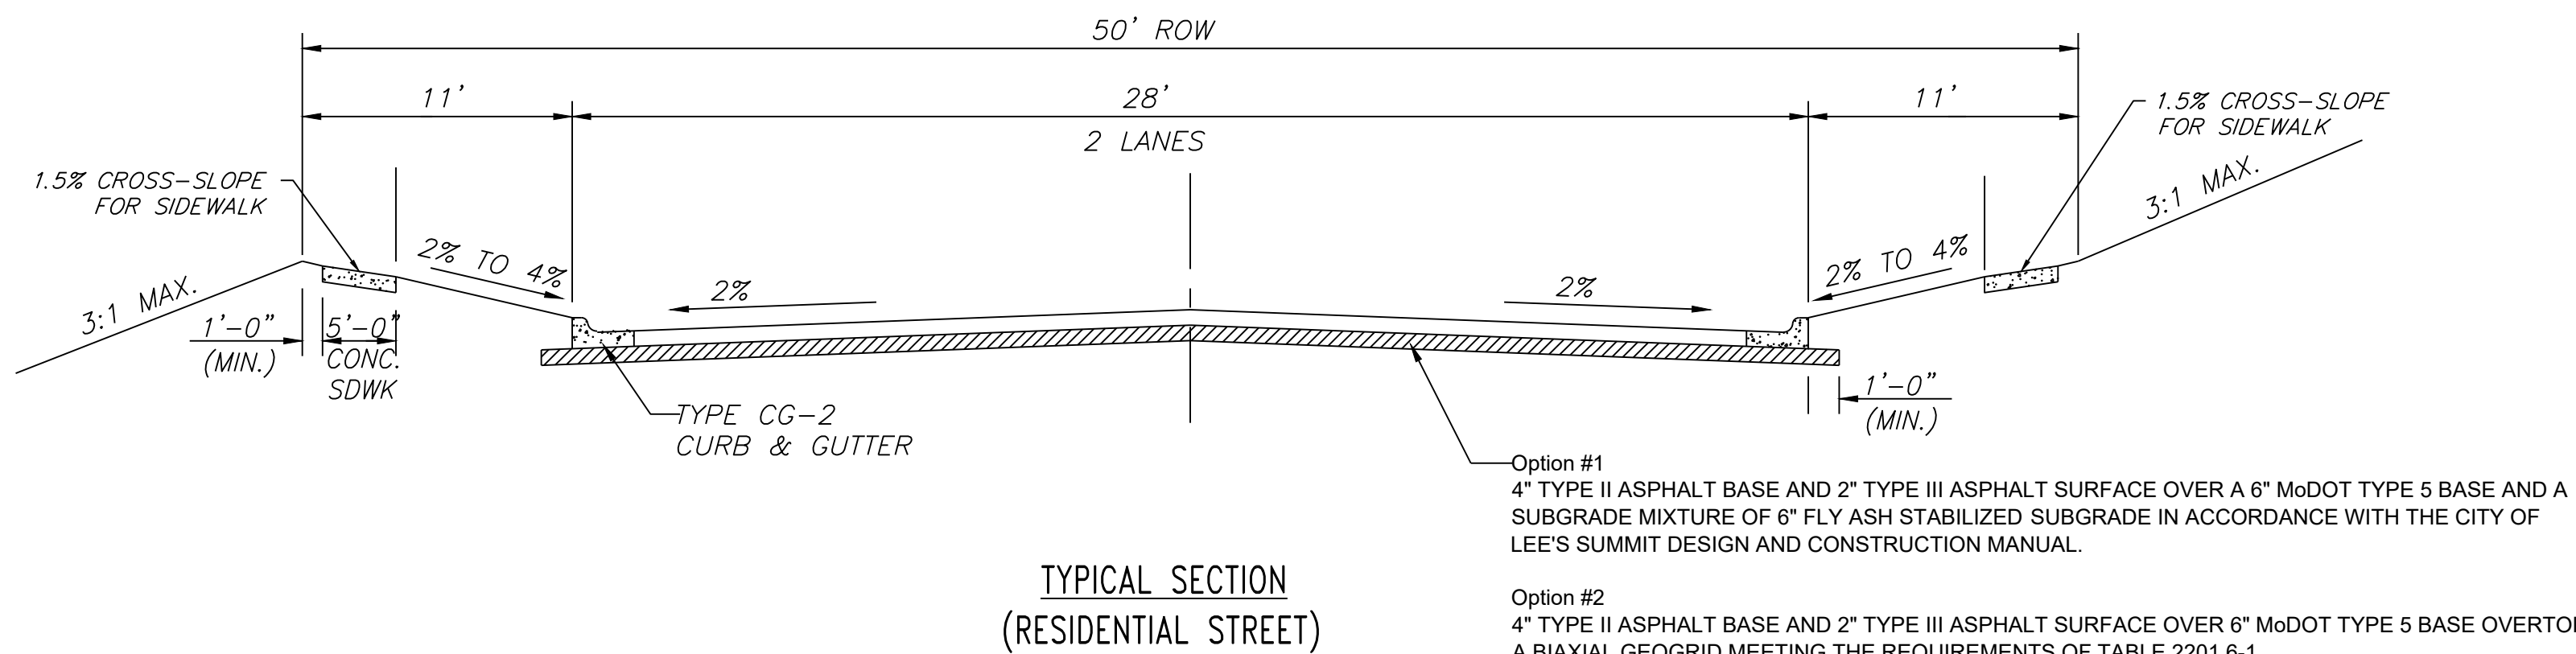


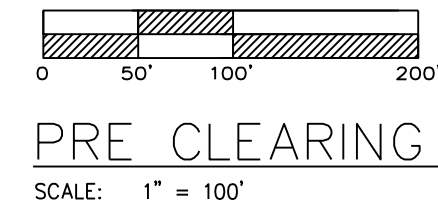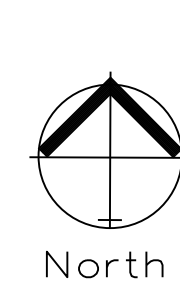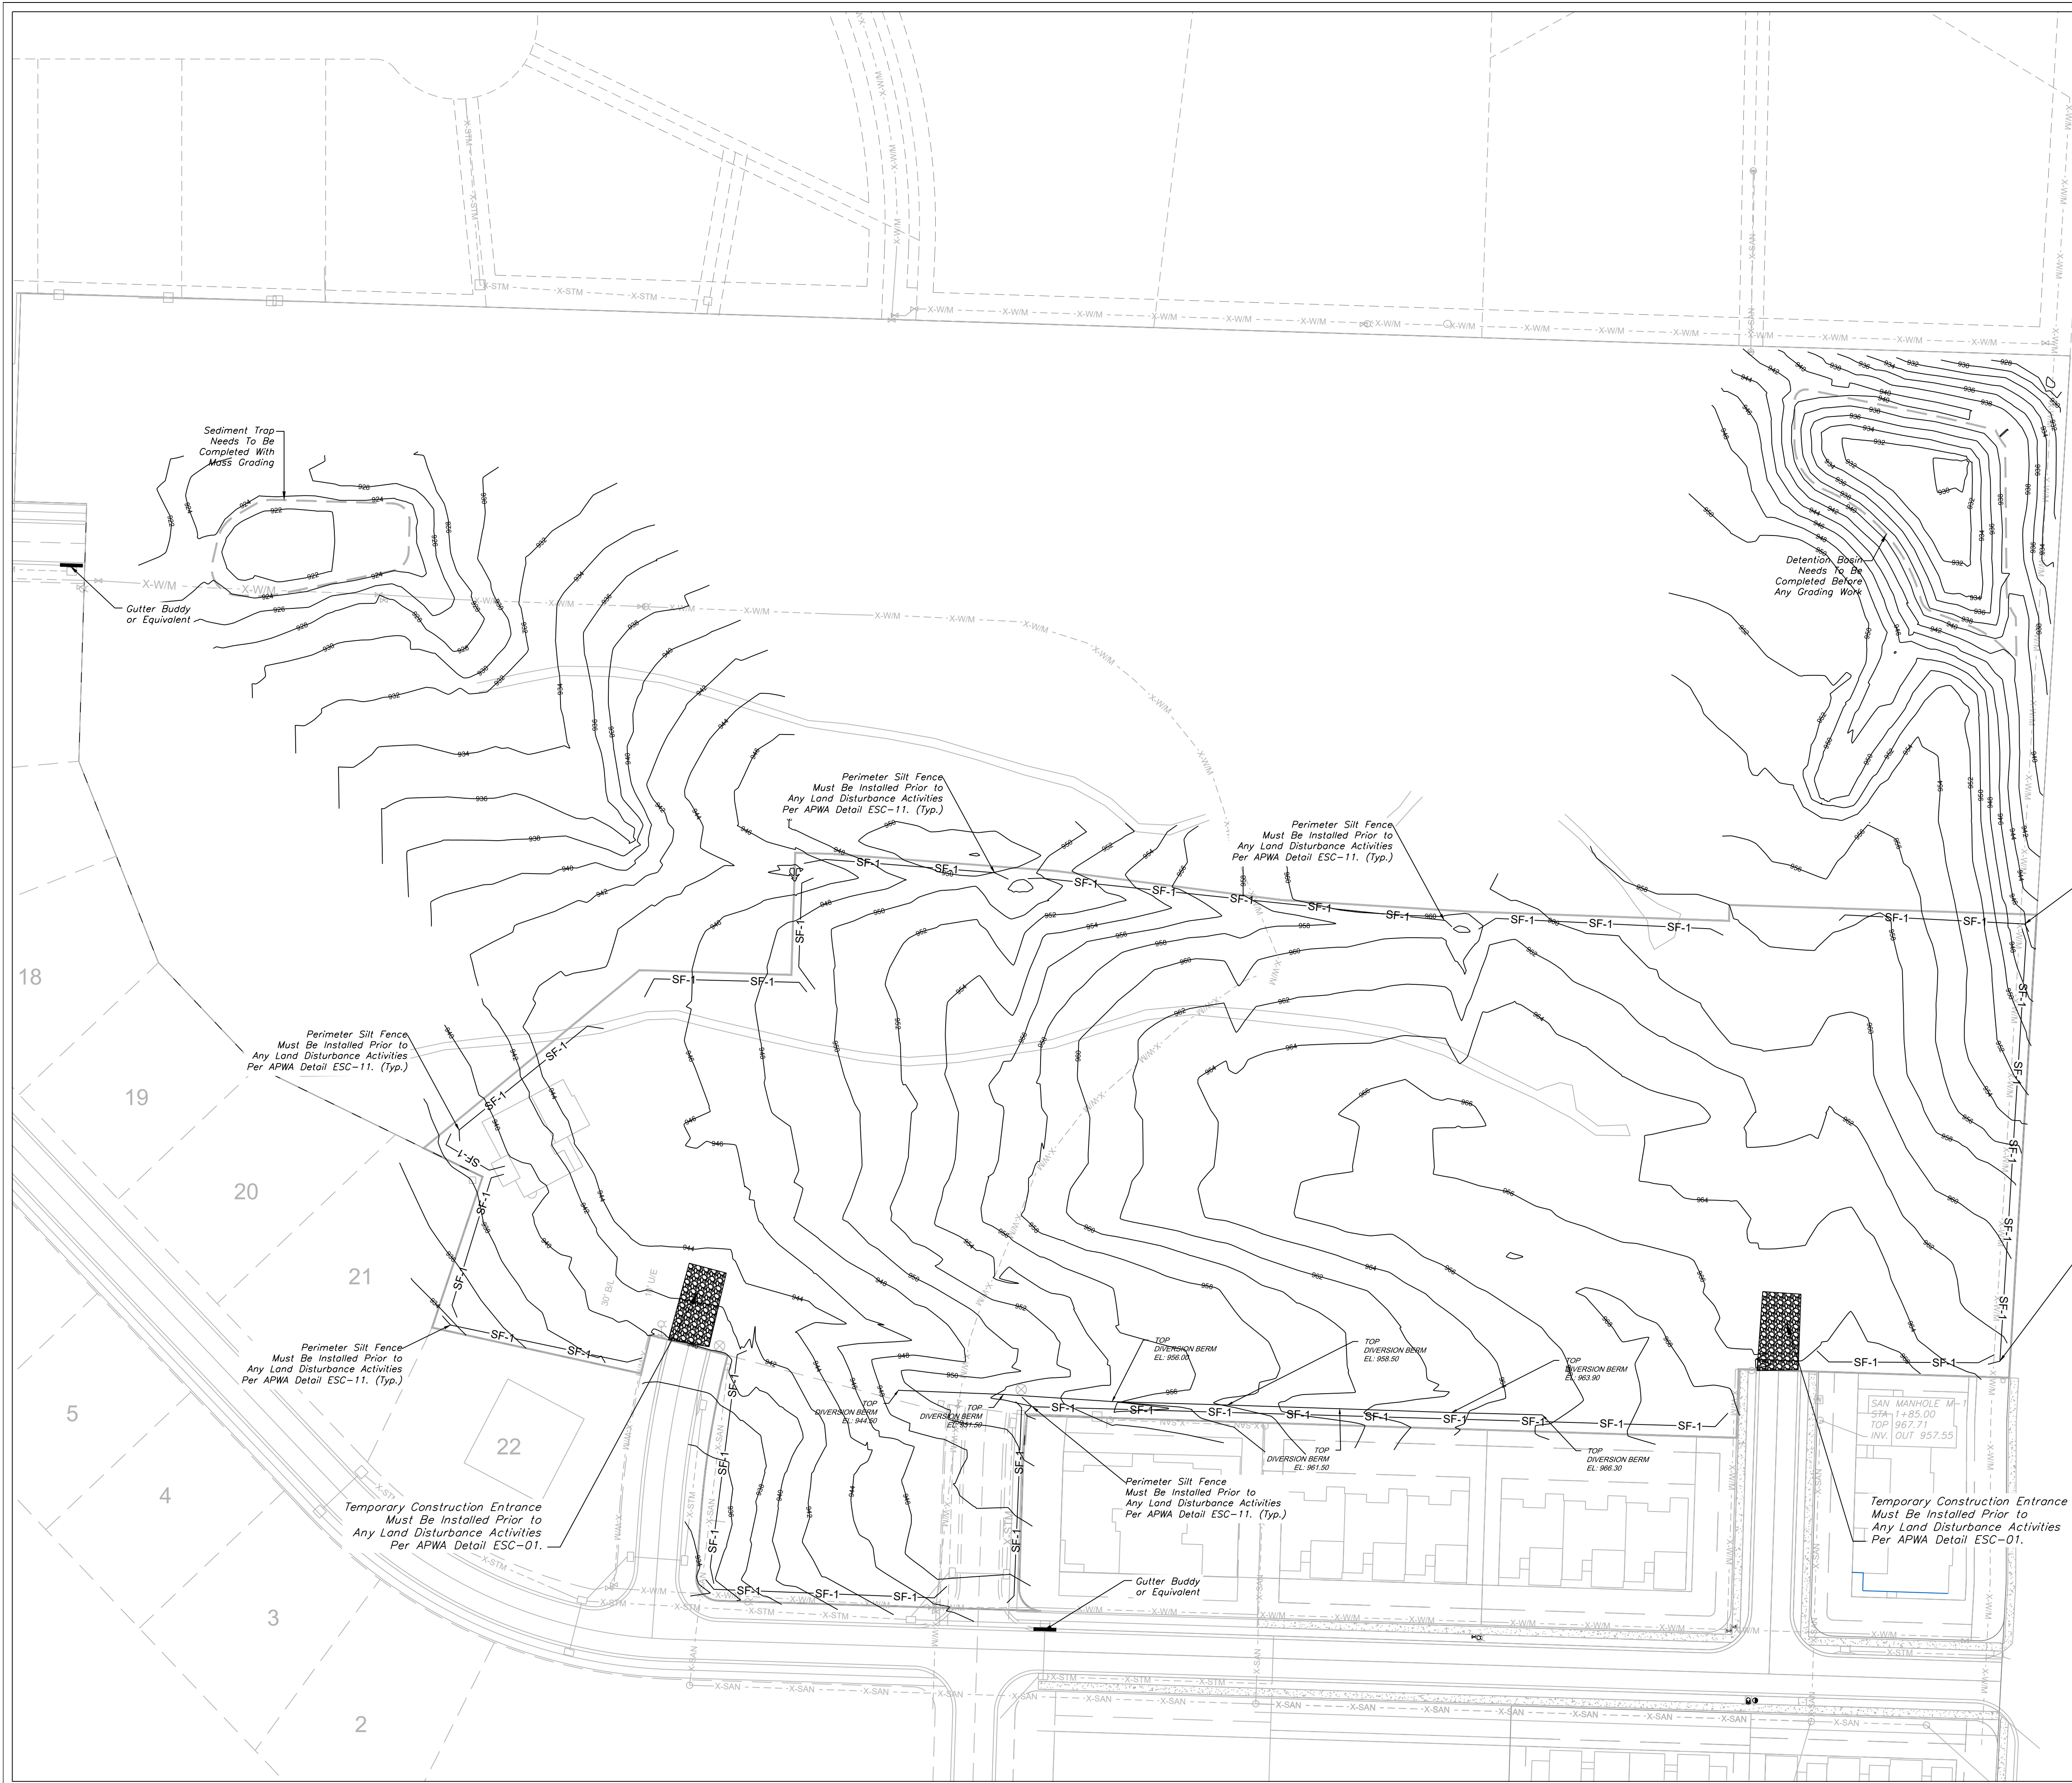

PRE CLEARING PLAN

SCALE: 1" = 100'

NOTES: The Land Disturbance Plans indicates the Final placement of erosion control devices. The contractor(s) may proceed with construction prior to the final placement of these devices by providing additional devices to control erosion on their items of work. These devices shall be maintained until the final devices are in place.

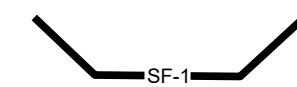


SILT FENCE PROTECTION
TO BE MAINTAINED BY CONTRACTOR

LEGEND

PHASE 1 SILT FENCE	— SF-1 — SF-1 —
PHASE 2 SILT FENCE	— SF-2 — SF-2 —
INLET PROTECTION	—

DURING ALL PHASES OF CONSTRUCTION,
INACTIVE AREA STABILIZATION METHODS AS
DESCRIBED IN APWA SECTION 5111.3 SHALL BE
USED TO CONTROL EROSION AND SILTATION.

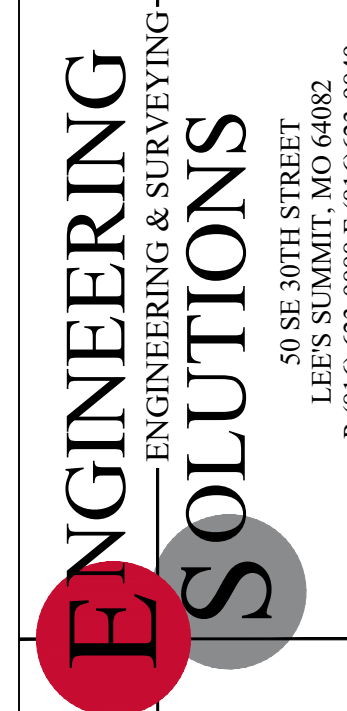


Professional Registration
Missouri
Engineering 2005002186-D
Surveying 2005008319-D
Kansas
Engineering E-1695
Surveying LS-218
Oklahoma
Engineering 6254
Nebraska
Engineering CA2821

THE TOWNHOMES OF CHAPEL RIDGE-2ND PLAT
LOTS 9-19 & TRACTS A-D
Lee's Summit, Jackson County, Missouri

Project:
VILLAS OF CHAPEL
RIDGE-LSMO
Issue Date:
April 10, 2020

ESC PHASE 1 - Pre Clearing Plan
Construction Plans for:
THE TOWNHOMES OF CHAPEL RIDGE-2ND PLAT
LOTS 9-19 & TRACTS A-D
Lee's Summit, Jackson County, Missouri


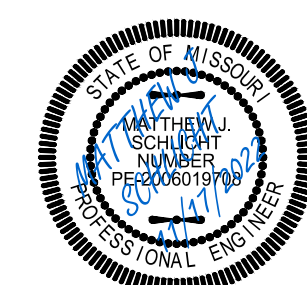


Matthew J. Schlicht
MO PE 2006019708
KS PE 19071
OK PE 25226
NE PE E-14335

REVISIONS
6/25/2021 As-Built
8/18/2021 As-Built
8/31/2021 As-Built
9/9/2021 As-Built
11/17/2022 As-Built

C.050

RECORD DRAWING
The information provided on this drawing conforms to construction records; it is not intended for construction, implementation or recording purposes; and it is solely based on information obtained by my firm.
"100-00 100.10", "4-00% 1.15% slope", or "8-inch HDPE-PVC pipe" are all typical examples of revisions that indicate that design data has been replaced with "as-built" information. All other data is as designed and has not been field verified.
Date: 11/17/2022
Certified by: Matthew J. Schlicht
Title: Engineer
Firm: Engineering Solutions

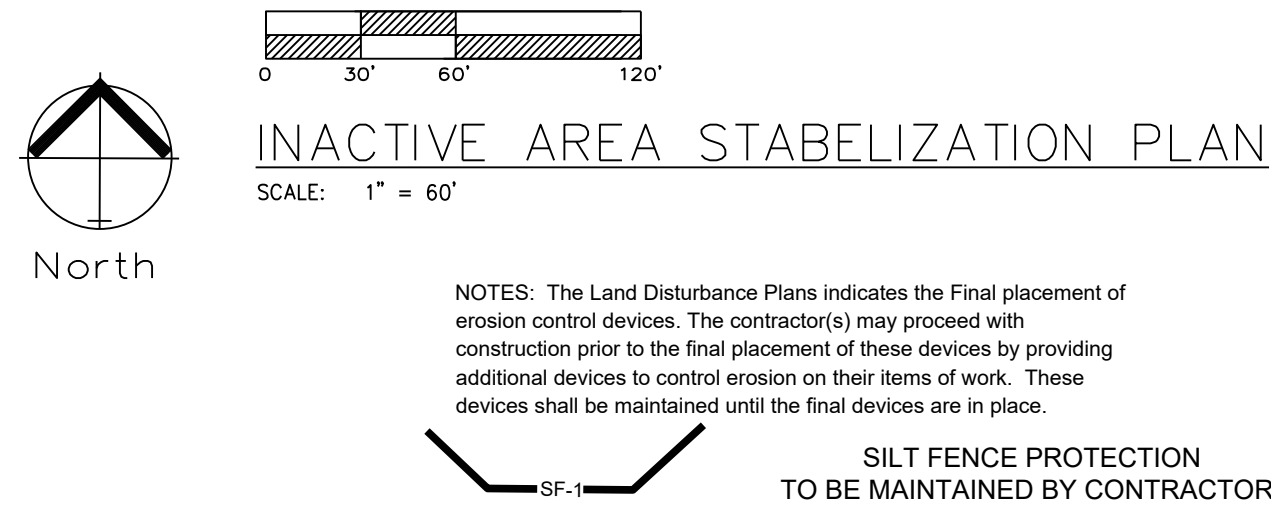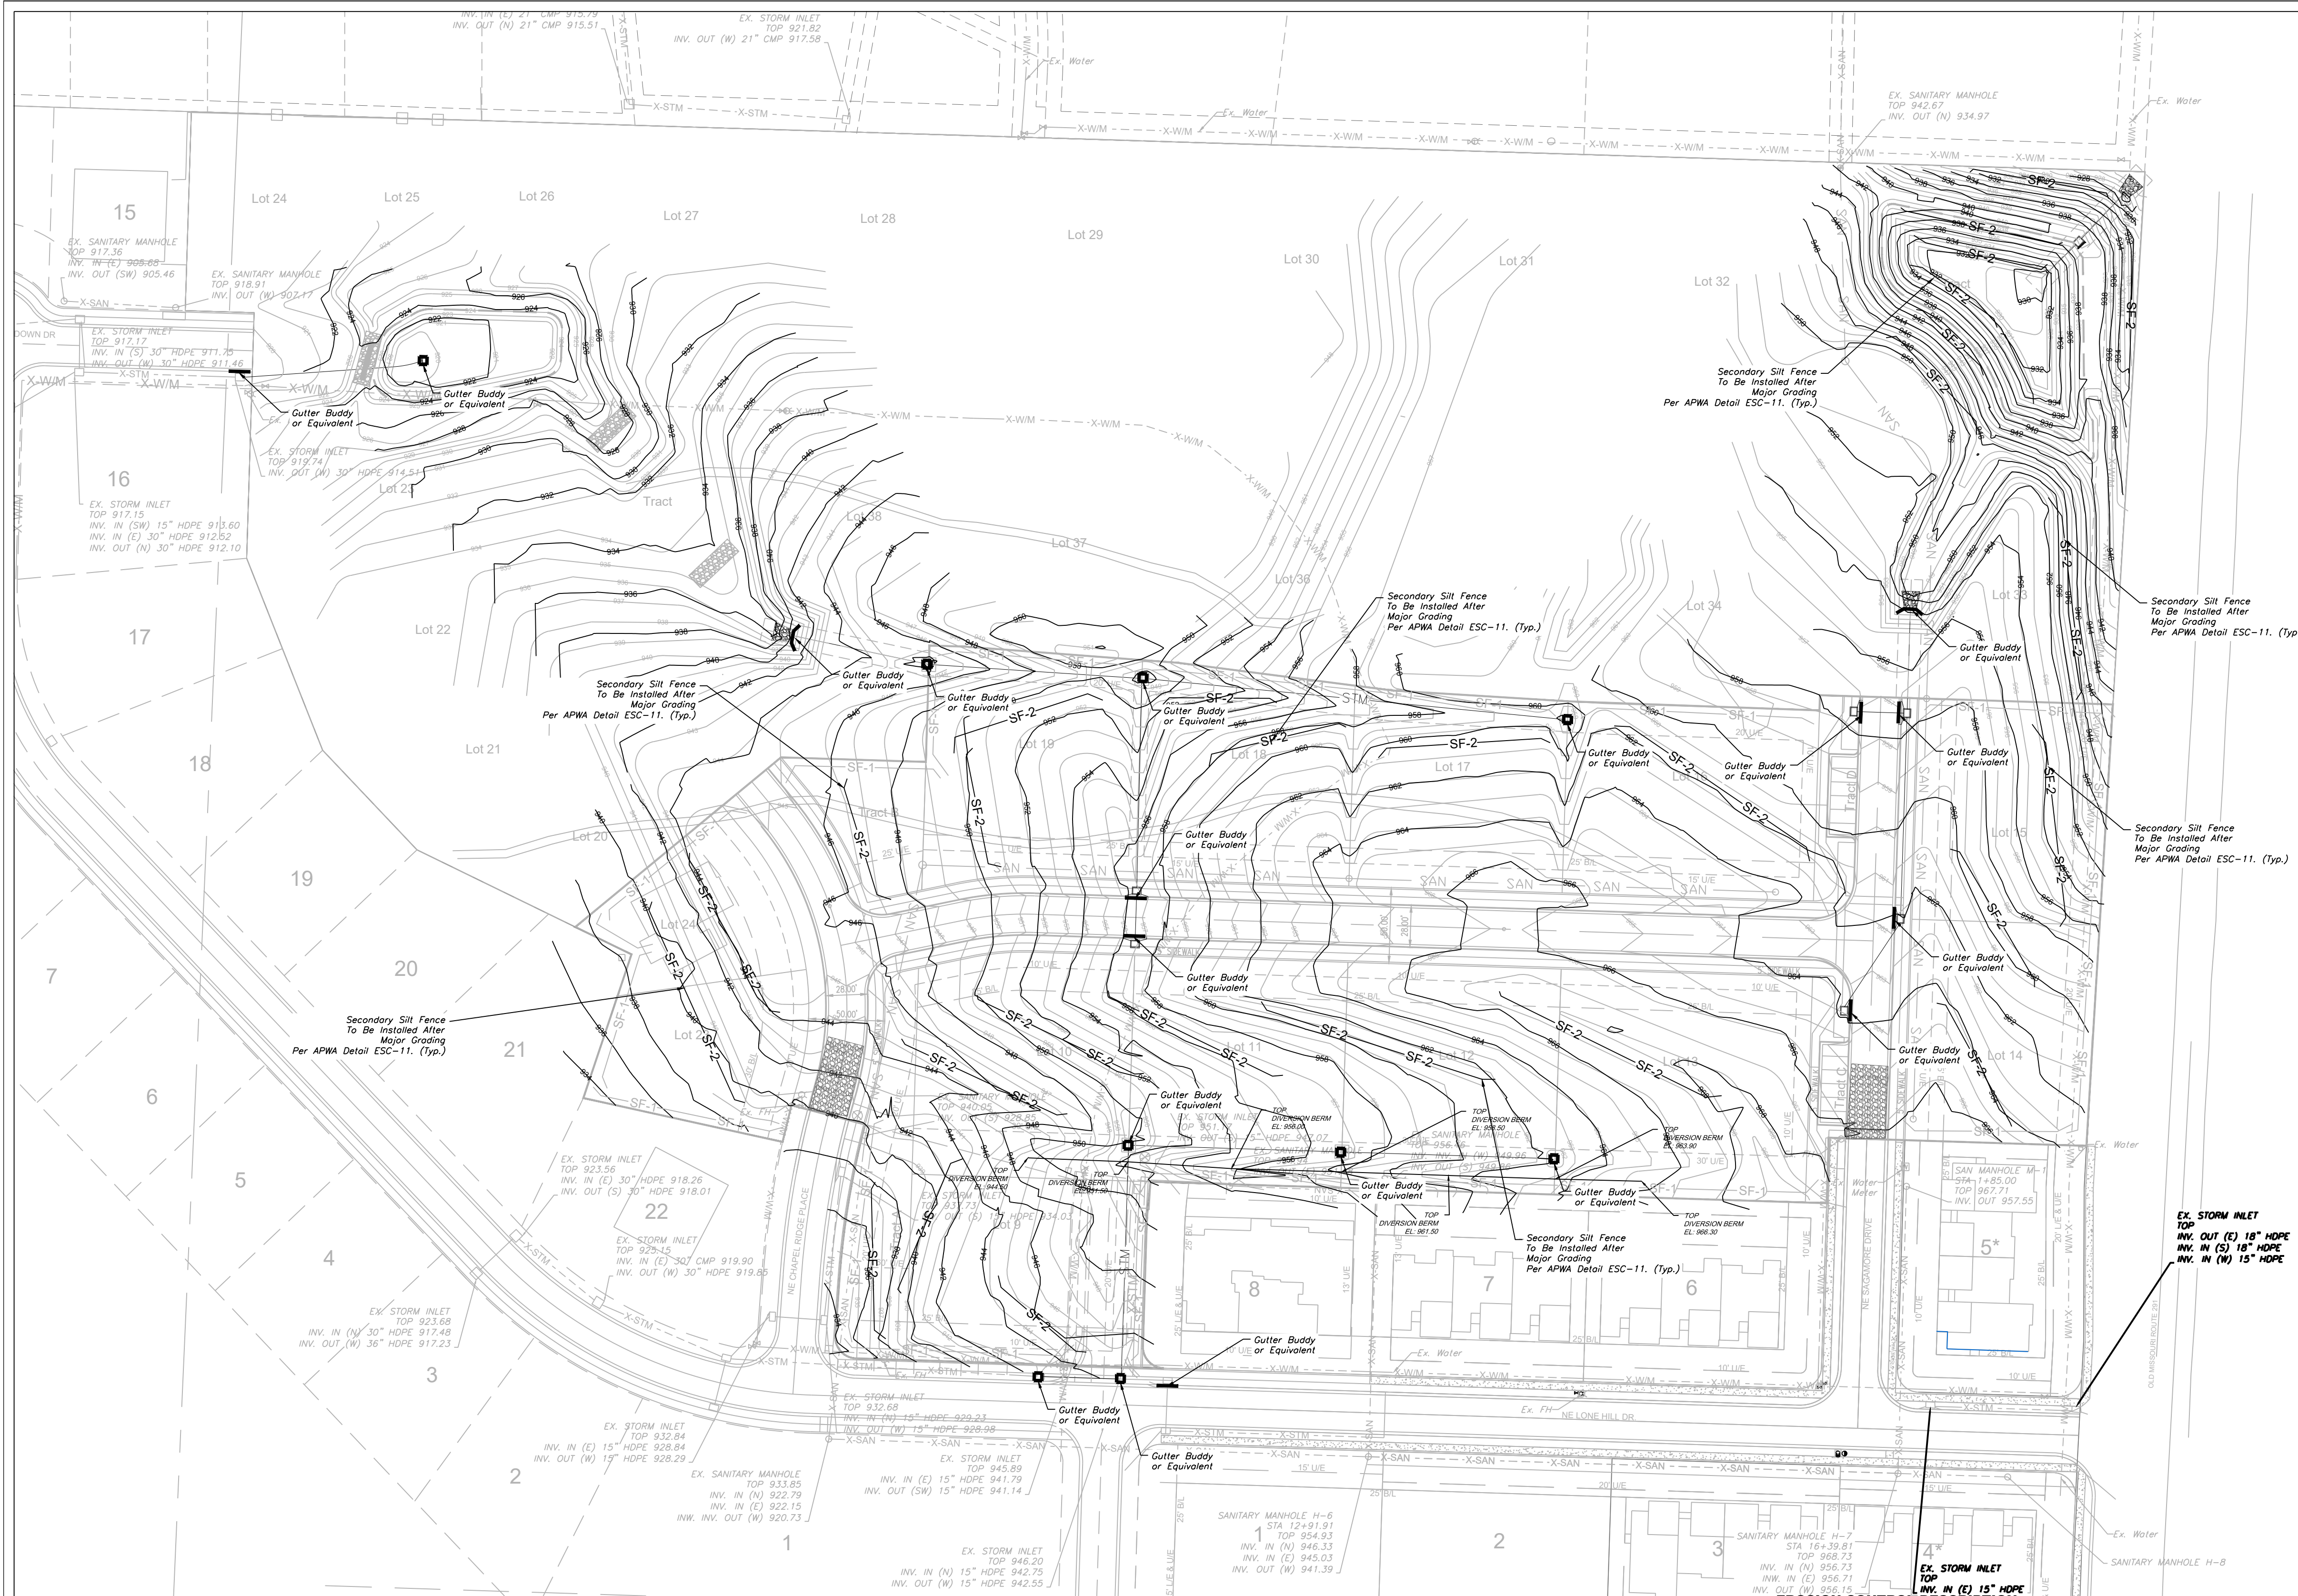

NOTES: The Land Disturbance Plans indicates the Final placement of erosion control devices. The contractor(s) may proceed with construction prior to the final placement of these devices by providing additional devices to control erosion on their items of work. These devices shall be maintained until the final devices are in place.

SILT FENCE PROTECTION TO BE MAINTAINED BY CONTRACTOR

- LEGEND**
- PHASE 1 SILT FENCE — SF-1 — SF-1
- PHASE 2 SILT FENCE — SF-2 — SF-2
- INLET PROTECTION
GUTTER BUDDY OR EQUIVALENT

DURING ALL PHASES OF CONSTRUCTION, INACTIVE AREA STABILIZATION METHODS AS DESCRIBED IN APWA SECTION 5111.3 SHALL BE USED TO CONTROL EROSION AND SILTATION.

MAINTENANCE:
TO MAINTAIN THE EROSION AND SEDIMENT CONTROLS, THE FOLLOWING PROCEDURES WILL BE PERFORMED:
SEDIMENT CAPTURE DEVICES: SEDIMENT WILL BE REMOVED FROM THE UPSTREAM OR UPSLOPE SIDE OF THE FILTER FABRIC FENCES, WHEN THE DEPTH OF ACCUMULATED SEDIMENT REACHES ABOUT ONE-THIRD THE HEIGHT OF THE STRUCTURE.
STORM SEWER INLETS: ANY SEDIMENT IN THE STORM SEWER INLETS WILL BE REMOVED AND DISPOSED OF PROPERLY.
TEMPORARY CONTROLS: ALL TEMPORARY CONTROLS WILL BE REMOVED AFTER THE DISTURBED AREAS HAVE BEEN STABILIZED.

INSPECTION PROCEDURES:
INSPECTIONS WILL BE DONE BY THE RESPONSIBLE PERSON(S) AT LEAST ONCE EVERY WEEK AND WITHIN 24 HOURS EACH STORM EVENT PRODUCING ANY AMOUNT OF RAINFALL. AREAS THAT HAVE BEEN RESEDED WILL BE INSPECTED REGULARLY AFTER SEED GERMINATION TO ENSURE COMPLETE COVERAGE OF EXPOSED AREAS. DISTURBED AREAS THAT HAVE NOT BEEN FINALLY STABILIZED SHALL HAVE ALL POLLUTION CONTROL MEASURES INSPECTED FOR PROPER INSTALLATION, OPERATION AND MAINTENANCE. LOCATIONS WHERE STORM WATER LEAVES THE SITE SHALL BE INSPECTED FOR EVIDENCE OF EROSION OR SEDIMENT DEPOSITION. ANY DEFICIENCIES SHALL BE NOTED IN A REPORT OF THE INSPECTION AND CORRECTED WITHIN SEVEN CALENDAR DAYS OF THE INSPECTION. THE PERMITTEE SHALL PROMPTLY NOTIFY THE SITE CONTRACTORS RESPONSIBLE FOR OPERATION AND MAINTENANCE OF POLLUTION CONTROL DEVICES OF DEFICIENCIES.

IF THE EXISTING GROUND COVER IS NATURAL GRASS, DISTURBED AREAS SHALL BE TEMPORARILY SEEDED WITH WHEAT/RYE AT A RATE OF 15 POUNDS PER 1000 SQUARE FEET. PERMANENT SEEDING SHALL CONSIST OF 90% IN THREE EQUAL PARTS OF THIN BLADE, TURF-TYPE, TALL FESCUE AND 10% BLUEGRASS SEED AT A RATE OF 10 POUNDS PER 1000 SQUARE FEET. BOTH TEMPORARY AND PERMANENT SEEDED AREAS SHALL BE MULCHED AND WATERED TO MAINTAIN THE PROPER MOISTURE LEVEL OF THE SOIL TO ESTABLISH GRASS. NEW GRASS SHALL BE WATERED AND MAINTAINED UNTIL IT REACHES A HEIGHT OF 3 INCHES. ANY BARE AREAS SHALL BE RESEDED.

ALL EROSION CONTROL DEVICES SHALL BE REMOVED BY GENERAL CONTRACTOR AFTER SITE STABILIZATION IS COMPLETE AND APPROVED BY ENGINEER.

THE DEVELOPER WILL DESIGNATE A QUALIFIED PERSON OR PERSONS TO PERFORM THE FOLLOWING INSPECTIONS:
STABILIZATION MEASURES: DISTURBED AREAS AND AREAS USED FOR STORAGE OF MATERIALS THAT ARE EXPOSED TO PRECIPITATION WILL BE INSPECTED FOR EVIDENCE OF, OR THE POTENTIAL FOR, POLLUTANTS ENTERING THE DRAINAGE SYSTEM. AFTER A PORTION OF THE SITE IS FINALLY STABILIZED, INSPECTIONS WILL BE CONDUCTED AT LEAST ONCE EVERY MONTH THROUGHOUT THE LIFE OF THE PROJECT. CONTRACTOR CAN CONTACT ENGINEERING SOLUTIONS FOR COPIES OF THE INSPECTION FORM TO BE USED FOR STABILIZATION MEASURES.

STRUCTURAL CONTROLS: FILTER FABRIC FENCES AND ALL OTHER EROSION AND SEDIMENT CONTROL MEASURES IDENTIFIED IN THE PLAN WILL BE INSPECTED REGULARLY FOR PROPER POSITIONING, ANCHORING, AND EFFECTIVENESS IN TRAPPING SEDIMENTS. SEDIMENT WILL BE REMOVED FROM THE UPSTREAM OR UPSLOPE SIDE OF THE FILTER FABRIC. CONTRACTOR CAN CONTACT ENGINEERING SOLUTIONS FOR COPIES OF THE INSPECTION FORM TO BE USED FOR STABILIZATION MEASURES.

DISCHARGE POINTS: DISCHARGE POINTS OR LOCATIONS WILL BE INSPECTED TO DETERMINE WHETHER EROSION CONTROL MEASURES ARE EFFECTIVE IN PREVENTING SIGNIFICANT AMOUNTS OF POLLUTANTS FROM ENTERING RECEIVING WATERS.

CONSTRUCTION ENTRANCE: LOCATIONS WHERE VEHICLES ENTER OR EXIT THE SITE WILL BE INSPECTED FOR EVIDENCE OF OFF-SITE SEDIMENT TRACKING.

A LOG OF EACH INSPECTION SHALL BE KEPT. THE INSPECTION REPORT IS TO INCLUDE THE FOLLOWING MINIMUM INFORMATION: INSPECTOR'S NAME, DATE OF INSPECTION, OBSERVATIONS RELATIVE TO THE EFFECTIVENESS OF THE POLLUTION CONTROL DEVICES, ACTIONS TAKEN OR NECESSARY TO CORRECT DEFICIENCIES, AND LISTINGS OF AREAS WHERE LAND DISTURBANCE OPERATIONS HAVE PERMANENTLY OR TEMPORARILY STOPPED. THE INSPECTION REPORT SHALL BE SIGNED BY THE PERMITTEE OR BY THE PERSON PERFORMING THE INSPECTION IF DULY AUTHORIZED TO DO SO.

EROSION CONTROL DESCRIPTION:

- 1.) SILT FENCE SHALL BE PLACED AT THE PERIMETER OF THE GRADING AND AT INTERMEDIATE AREAS THROUGHOUT THE SITE AS SHOWN ON THE PLAN. INLET SEDIMENT TRAPS SHALL BE PLACED SURROUNDING ALL STORM INLETS
- 2.) INSTALL TEMPORARY CONSTRUCTION ENTRANCE AS SHOWN ON PLAN

EROSION CONTROL PROCEDURE:

- 1.) SILT FENCE AND TEMPORARY CONSTRUCTION ENTRANCE SHALL BE INSTALLED AT THE PERIMETER OF THE GRADED AREAS PRIOR TO BEGINNING OF CLEARING OR DEMOLITION OPERATIONS. THE CONTRACTOR SHALL INSTALL SILT FENCE AS SHOWN ON PLANS AS GRADING PROGRESSES.

TEMPORARY CONSTRUCTION ENTRANCE NOTES:

- A.) INSTALLATION
- 1.) AVOID LOCATING ON STEEP SLOPES OR AT CURVES ON PUBLIC STREETS. IF POSSIBLE, LOCATE WHERE PERMANENT ROADS WILL EVENTUALLY BE CONSTRUCTED
 - 2.) REMOVE ALL VEGETATION AND OTHER UNSUITABLE MATERIAL FROM THE FOUNDATION AREA, GRADE AND CROWN FOR POSITIVE DRAINAGE
 - 3.) IF SLOPE TOWARDS THE PUBLIC ROAD EXCEED 2% CONSTRUCT A 6 TO 8 INCH HIGH RIDGE WITH 3H : 1V SIDE SLOPES ACROSS THE FOUNDATION APPROXIMATELY 15 FEET FROM THE EDGE OF THE PUBLIC ROAD TO DIVERT RUNOFF AWAY FROM IT.
 - 4.) INSTALL PIPE UNDER THE ENTRANCE IF NEEDED TO MAINTAIN DRAINAGE DITCHES ALONG PUBLIC ROADS
 - 5.) PLACE STONE TO DIMENSIONS AND GRADES AS SHOWN ON PLANS. LEAVE SURFACE SMOOTH AND SLOPED FOR DRAINAGE
 - 6.) DIVERT ALL SURFACE RUNOFF AND DRAINAGE FROM THE ENTRANCE TO A SEDIMENT CONTROL DEVICE
 - 7.) IF WET CONDITIONS ARE ANTICIPATED PLACE GEOTEXTILE FABRIC ON THE GRADED FOUNDATION TO IMPROVE STABILITY
- B.) TROUBLESHOOTING
- 1.) CONSULT WITH A QUALIFIED DESIGN PROFESSIONAL IF ANY OF THE FOLLOWING OCCUR:
 - INADEQUATE RUNOFF CONTROLS TO THE EXTENT THAT SEDIMENT WASHES ONTO PUBLIC ROADS
 - INSTALL DIVERSIONS OR OTHER RUNOFF CONTROL MEASURES
 - SMALL STONE, THIN PAD, OR ABSENCE OF GEOTEXTILE FABRIC RESULTS IN RUTS AND MUDDY CONDITIONS AS STONE IS PRESSED INTO SOIL
 - THICKNESS OR ADD GEOTEXTILE FABRIC
 - PAD TOO SHORT FOR HEAVY CONSTRUCTION TRAFFIC - EXTEND PAD BEYOND THE MINIMUM 50 FOOT LENGTH AS NECESSARY
- C.) INSPECTION AND MAINTENANCE
- 1.) INSPECT STONE PAD AND SEDIMENT DISPOSAL AREA WEEKLY AND AFTER ANY RAIN EVENT
 - 2.) RESHAPE PAD AS NEEDED FOR PROPER DRAINAGE AND RUNOFF CONTROL
 - 3.) TOP DRESS WITH CLEAN 2 AND 3 INCH STONE AS NEEDED
 - 4.) IMMEDIATELY REMOVE MUD OR SEDIMENT TRACKED OR WASHED ONTO PUBLIC ROADWAY. REPAIR ANY BROKEN ROAD PAVEMENT IMMEDIATELY
 - 5.) REMOVE ALL TEMPORARY ROAD MATERIALS FROM AREAS WHERE PERMANENT VEGETATION WILL BE ESTABLISHED

RECORD DRAWING
The information provided on this drawing conforms to construction records; it is not intended for construction, implementation or recording purposes; and it is solely based on information obtained by my firm.

"100-00 100 100", "4-00% 1.15% slope", or "8-inch HDPE-PVC pipe" are all typical examples of revisions that indicate that design data has been replaced with "as-built" information. All other data is as designed and has not been field verified.

Date: 11/17/2022
Certified by: Matthew J. Schlicht
Title: Engineer
Firm: Engineering Solutions

ENGINEERING SOLUTIONS
ENGINEERING & SURVEYING
50 SE 30TH STREET
LEE'S SUMMIT, MO 64082
P: (816) 623-9888 F: (816) 623-9849

Professional Registration
Missouri
Engineering 2005002186-D
Surveying 2005008319-D
Kansas
Engineering E-1695
Surveying LS-218
Oklahoma
Engineering 6254
Nebraska
Engineering CA2821

THE TOWNHOMES OF CHAPEL RIDGE-2ND PLAT
LOTS 9-19 & TRACTS A-D
Lee's Summit, Jackson County, Missouri

Project: VILLAGES OF CHAPEL RIDGE-LSMO
Issue Date: April 10, 2020



ESC PHASE 2 - Inactive Area Stabilization Plan
Construction Plans for:
THE TOWNHOMES OF CHAPEL RIDGE-2ND PLAT
LOTS 9-19 & TRACTS A-D
Lee's Summit, Jackson County, Missouri

Matthew J. Schlicht
MO PE 2006019708
KS PE 19071
OK PE 25226
NE PE E-14335

REVISIONS

6/25/2021	As-Built
8/18/2021	As-Built
8/31/2021	As-Built
9/9/2021	As-Built
11/7/2022	As-Built

C. 051

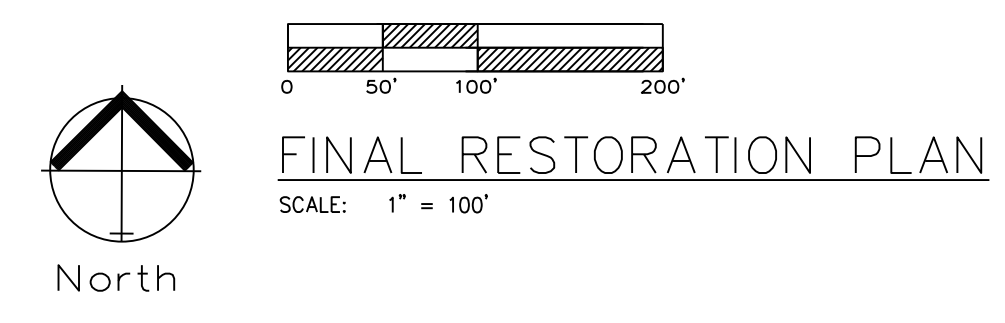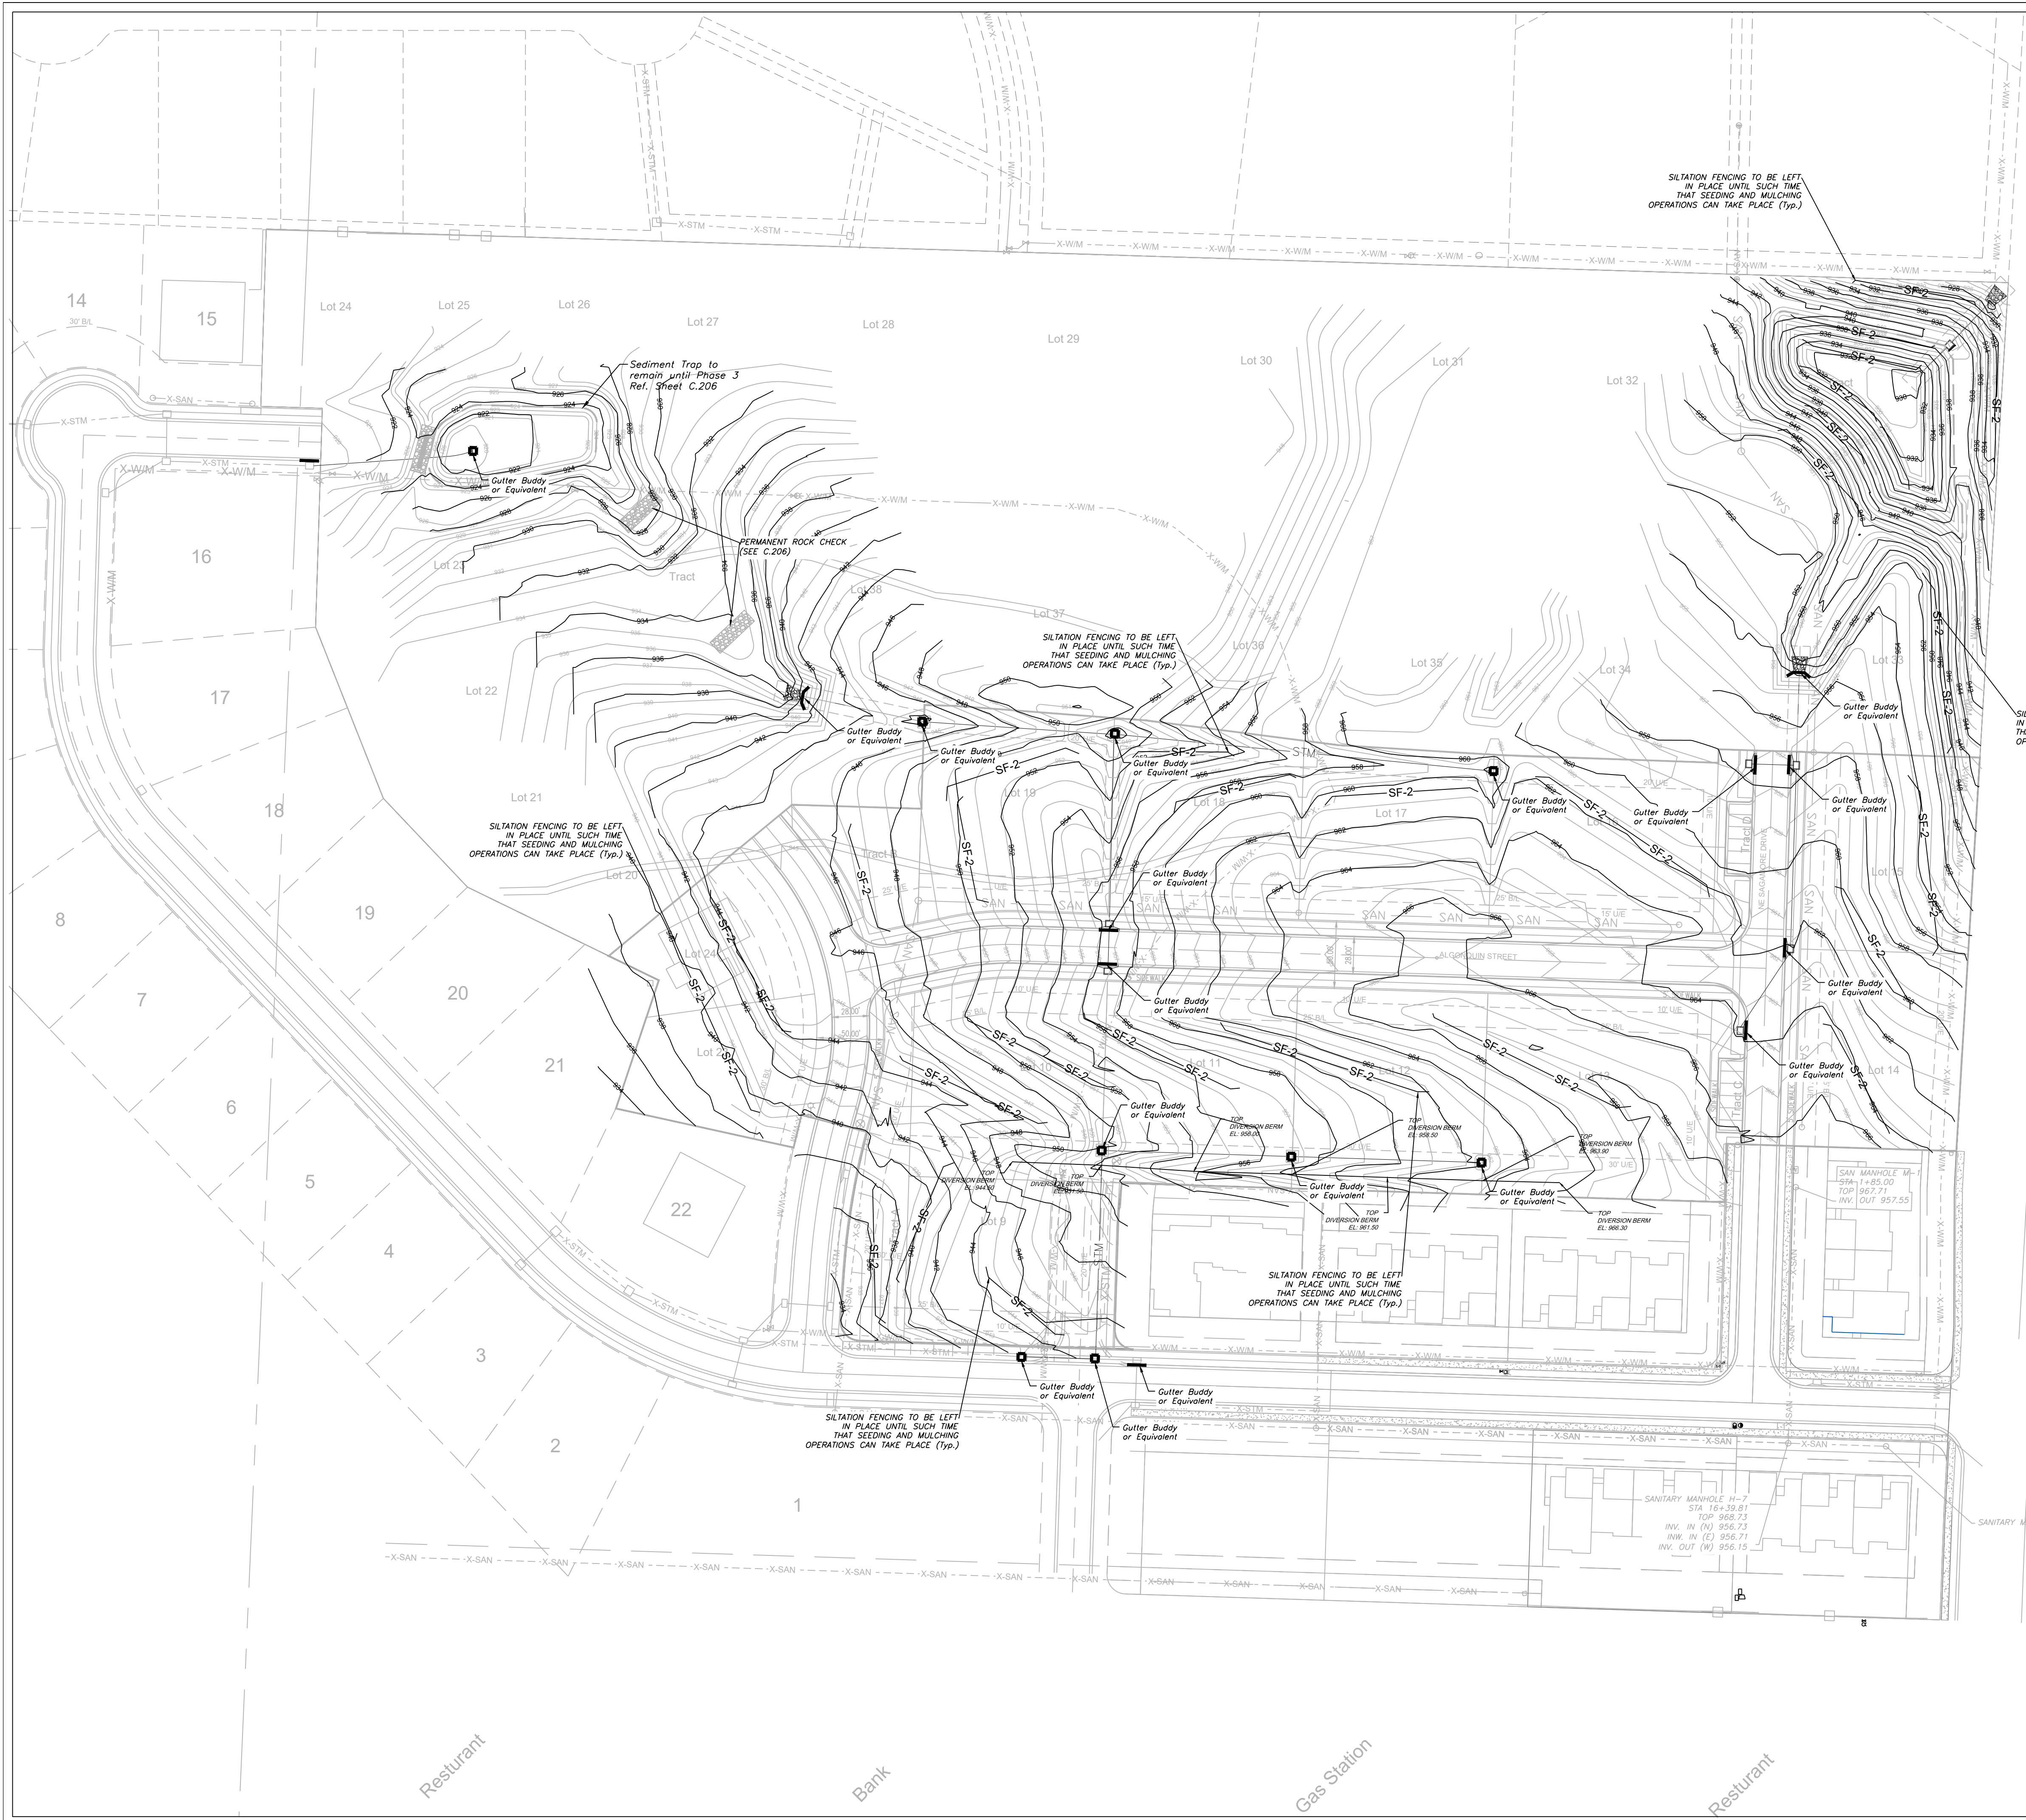

SILT FENCE PROTECTION
TO BE MAINTAINED BY CONTRACTOR

LEGEND		
PHASE 1 SILT FENCE	— SF-1 —	SF-1
PHASE 2 SILT FENCE	— SF-2 —	SF-2
INLET PROTECTION GUTTER BUDDY OR EQUIVALENT	—	

DURING ALL PHASES OF CONSTRUCTION, INACTIVE AREA STABILIZATION METHODS AS DESCRIBED IN APWA SECTION 5111.3 SHALL BE USED TO CONTROL EROSION AND SILTATION.

NOTES: The Land Disturbance Plans indicates the Final placement of erosion control devices. The contractor(s) may proceed with construction prior to the final placement of these devices by providing additional devices to control erosion on their items of work. These devices shall be maintained until the final devices are in place.

SEED AND MULCH NOTES:

All areas disturbed by construction activities shall be seeded and mulched. Seeding shall be done before the proposed seedbed becomes eroded, crusted over, or dried out and shall not be done when the ground is frozen, or covered with snow. The seed shall comply with the requirements of the Missouri Seed Law and the Federal Seed Act. Also, it shall contain no seed of any plant on the Federal Noxious Weed List. Other weed seeds shall not exceed one percent by weight of mix.

Seed and Fertilizer Rate:

Mix I - Rye Grass / Blue Grass 100 lbs. per Acre
Mix II - Tall Fescue / Blue Grass 195 lbs. per Acre
Lime 2000 lbs per Acre (50 lbs. per 1000 sq. ft.)
Fertilizer 800 to 1200 lbs per Acre (25 lbs per 1000 sq. ft.)

During the dates December 15th through May 31 All lime fertilizer, seed and mulch shall be applied to finished slopes of disturbed areas. During the months of June, July, October and November 1st through December 15th, lime fertilizer, seed and mulch shall be applied at the following rates:

Lime - 100% of specified quantity
Fertilizer - 75% of the specified quantity
Seed - 50% of the specified quantity
Mulch - 100% of the specified quantity

Mulch shall be Vegetative type, cereal straw from stalks of oats, rye, or barley, or approved equal. The straw shall be free of prohibited weed seed and relatively free of all other noxious and undesirable seed. Mulch shall be applied at the rate of 2 tons per acre, (70 to 90 lbs per 1000 sq. ft.). Mulch shall be embedded by a mulch anchoring tool or disk type roller having flat serrated disks spaced not more than 10 inches apart and cleaning scrapers shall be provided

ONCE SITE IS 90% VEGETATED ALL ESC DEVICES SHALL BE REMOVED AND ANY DISTURBED AREAS SHALL BE RESTORED

RECORD DRAWING

The information provided on this drawing conforms to construction records; it is not intended for construction, implementation or recording purposes; and it is solely based on information obtained by my firm.

"100-00 100.10", "4-00% 1.15% slope", or "8-inch HDPE-PVC pipe" are all typical examples of revisions that indicate that design data has been replaced with "as-built" information. All other data is as designed and has not been field verified.

Date: 11/17/2022
Certified by: Matthew J. Schlicht
Title: Engineer
Firm: Engineering Solutions

ENGINEERING SOLUTIONS

ENGINEERING & SURVEYING

50 SE 30TH STREET
LEE'S SUMMIT, MO 64082
P: (816) 621-9888 F: (816) 621-9849

Professional Registration

Missouri
Engineering 2005002186-D
Surveying 2005008319-D

Kansas
Engineering E-1695
Surveying LS-218

Oklahoma
Engineering S254

Nebraska
Engineering CA2821

Project: VILLAS OF CHAPEL RIDGE LSMO

Issue Date: April 10, 2020

ESC PHASE 3 - Final Restoration Plan

Construction Plans for:

THE TOWNHOMES OF CHAPEL RIDGE-2ND PLAT

LOTS 9-19 & TRACTS A-D

Lee's Summit, Jackson County, Missouri

Matthew J. Schlicht
MO PE 2006019708
KS PE 19071
OK PE 25226
NE PE E-14335

REVISIONS


6/25/2021	As-Built
8/18/2021	As-Built
8/31/2021	As-Built
9/9/2021	As-Built
11/17/2022	As-Built

C.052




THE TOWNHOMES OF CHAPEL RIDGE-2ND PLAT
LOTS 9-19 & TRACTS A-D
Lee's Summit, Jackson County, Missouri

Site Plan

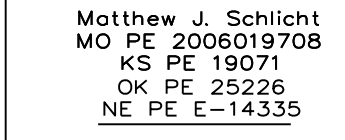


C.100

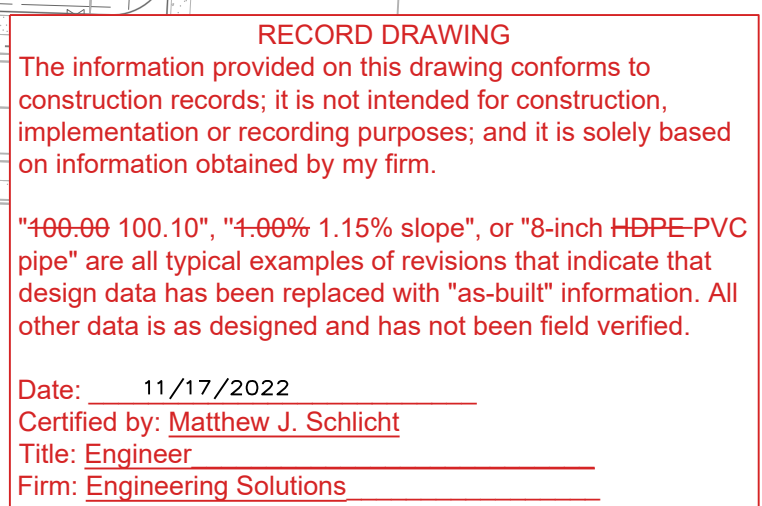

Contractor is Responsible to Remove All Existing Onsite Fence and Structures and properly dispose of these items offsite

Date: 11/17/2022
 Certified by: Matthew J. Schlicht
 Title: Engineer
 Firm: Engineering Solutions

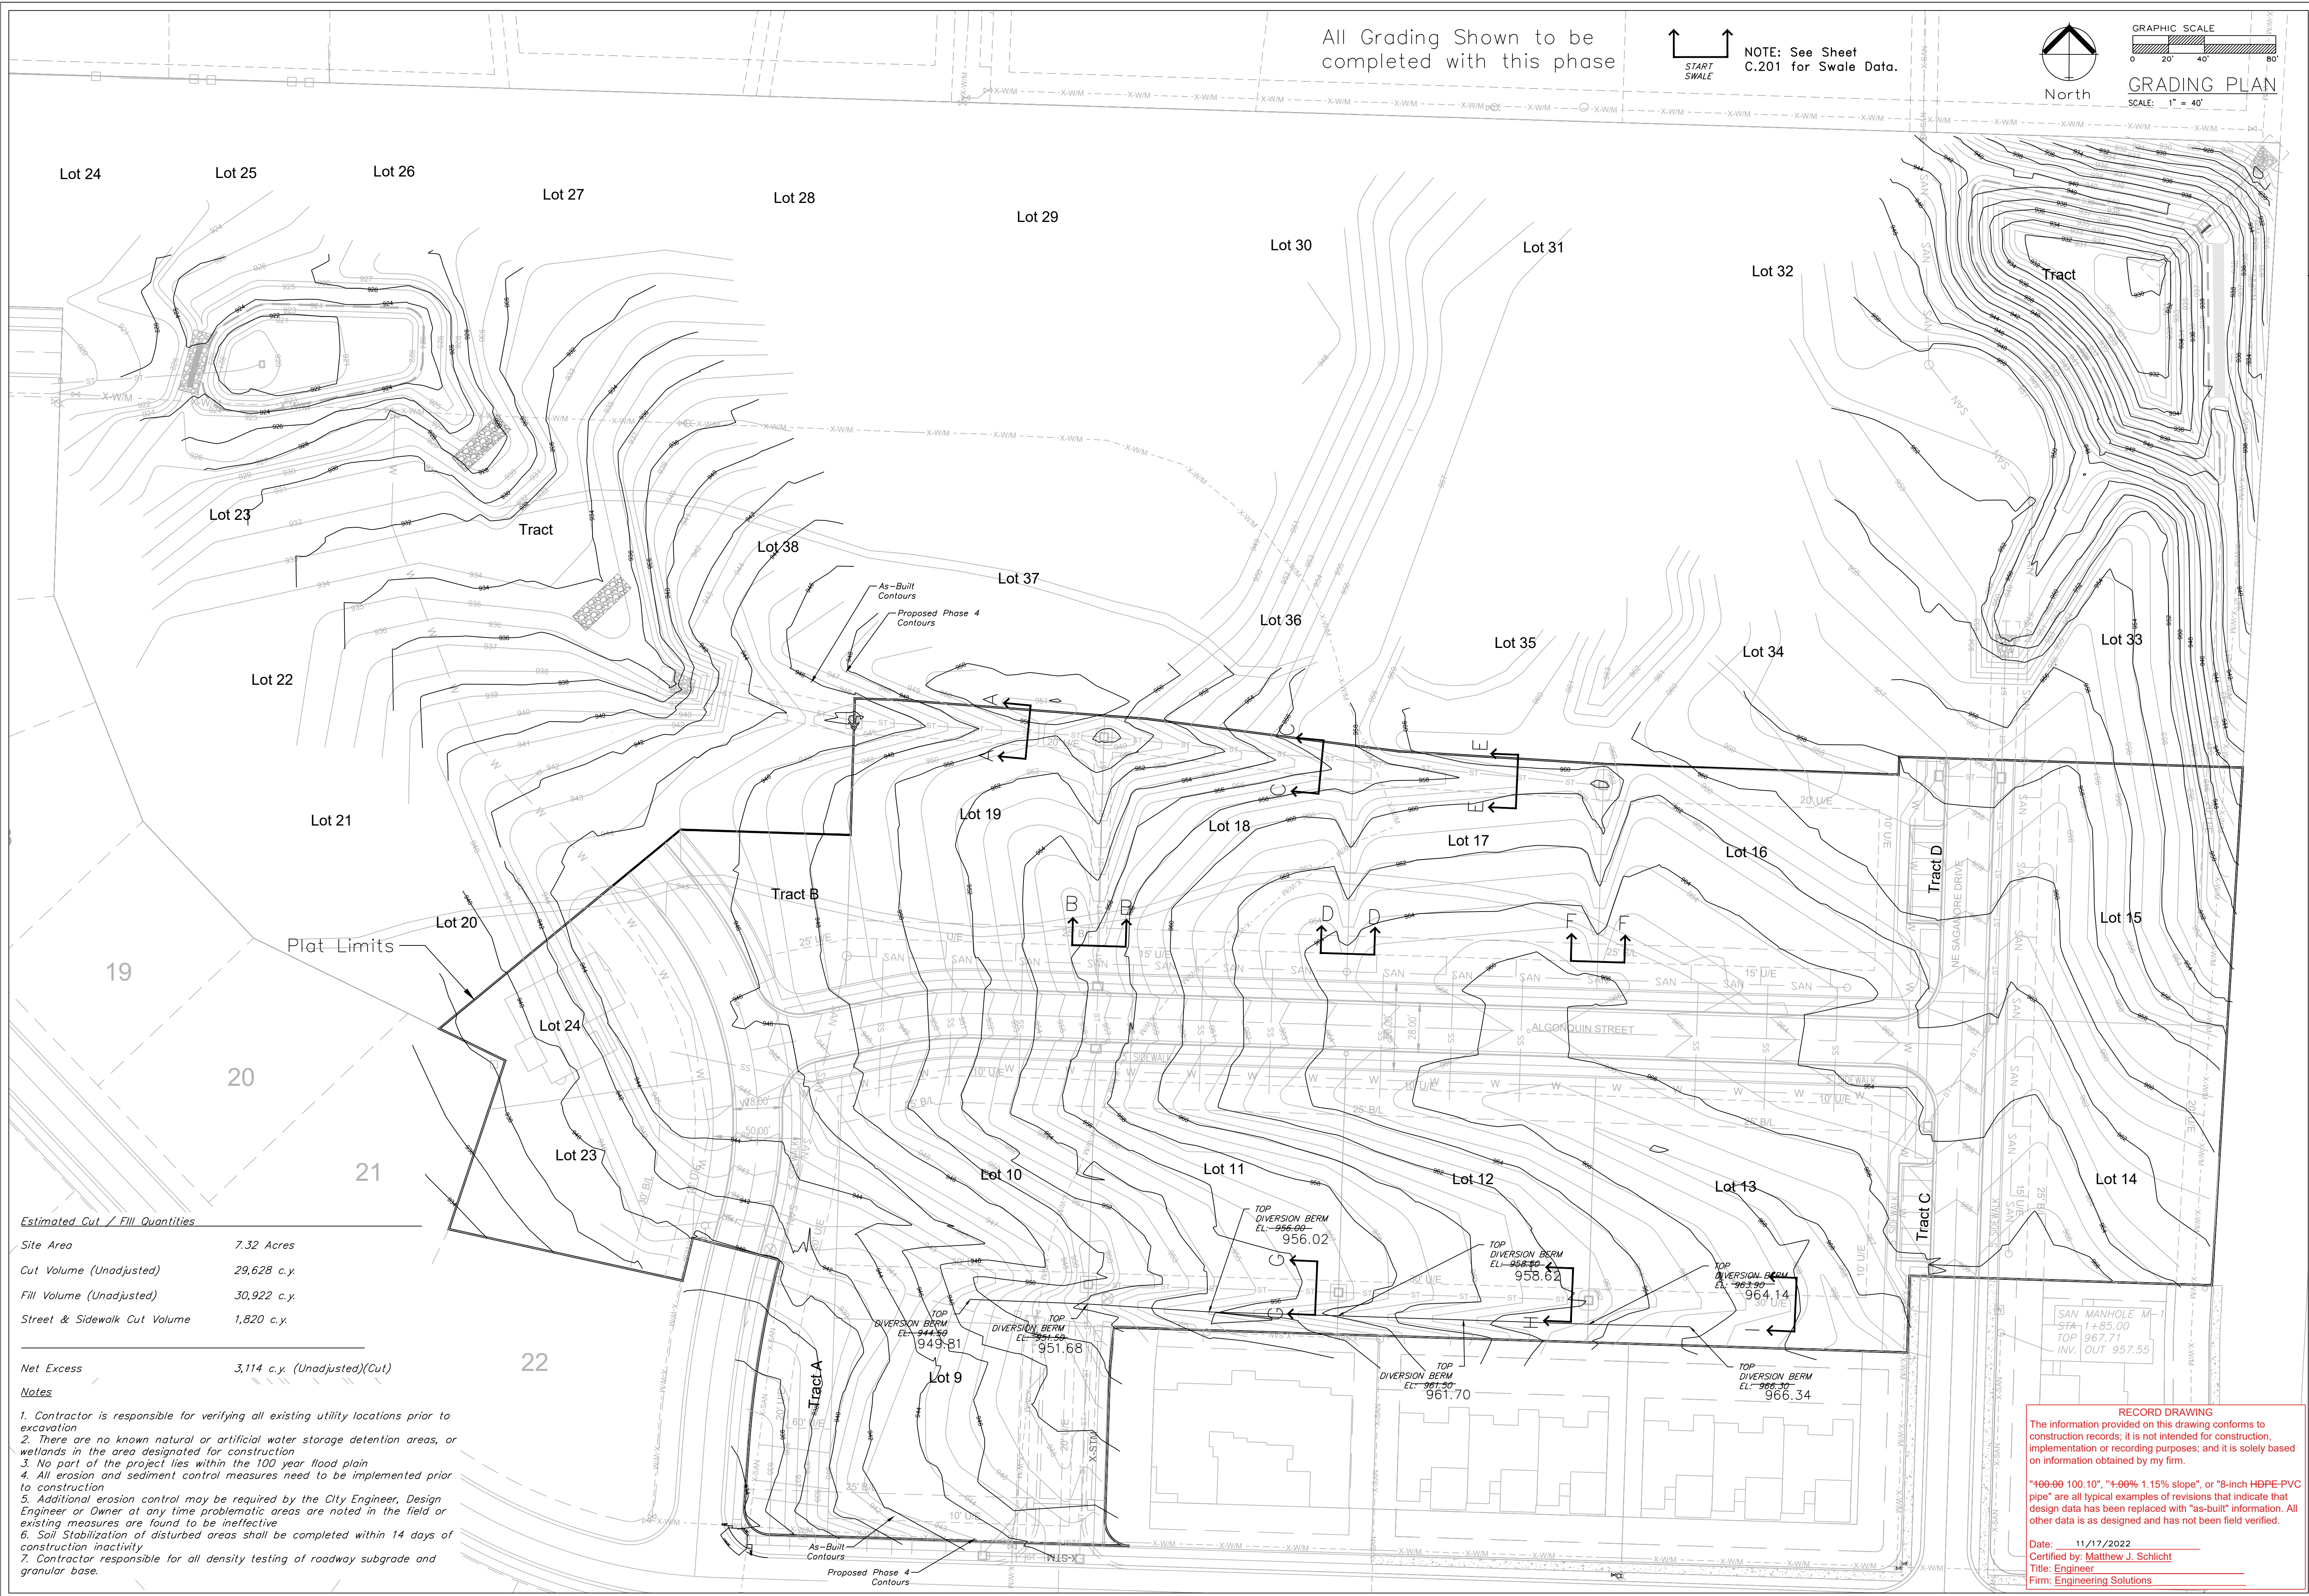

ENGINEERING SOLUTIONS
ENGINEERING & SURVEYING
50 SE 30TH STREET
LEE'S SUMMIT, MO 64082
P: (816) 623-9888 F: (816) 623-9849

Professional Registration
Missouri
Engineering 2005002186-D
Surveying 2005008319-D
Kansas
Engineering E-1695
Surveying LS-218
Oklahoma
Engineering 6254
Nebraska
Engineering CA2821

THE TOWNHOMES OF CHAPEL RIDGE-2ND PLAT
LOTS 9-19 & TRACTS A-D
Lee's Summit, Jackson County, Missouri

Project: VILLAS OF CHAPEL RIDGE-LSMO
Issue Date: April 10, 2020


Master Drainage Plan 1 of 3:
Grading Plan
Construction Plans for:
THE TOWNHOMES OF CHAPEL RIDGE-2ND PLAT
LOTS 9-19 & TRACTS A-D
Lee's Summit, Jackson County, Missouri

STATE OF MISSOURI
MATTHEW J. SCHLICHT
REGISTERED PROFESSIONAL ENGINEER
NO. 0000191708
EX. 19071
EXP. 25226
NE FE E-14335


REVISIONS

6/25/2021	As-Built
8/18/2021	As-Built
8/31/2021	As-Built
9/9/2021	As-Built
11/17/2022	As-Built

C. 200

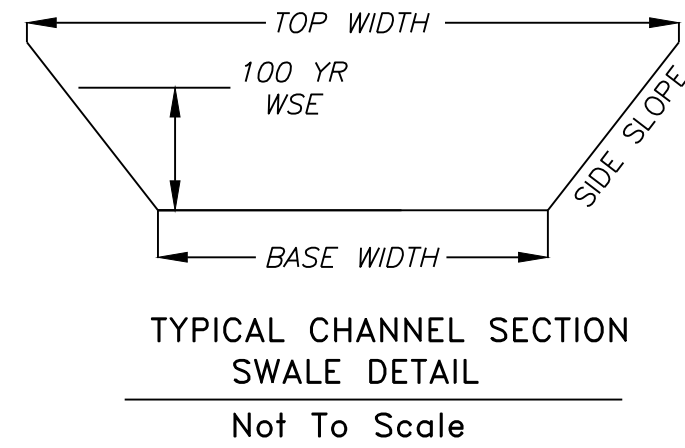

NOTE: Swale sections extend the entire length between upstream and downstream structures with the exception of a transition at each structure.

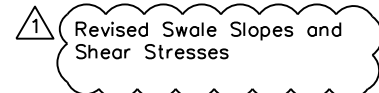

100 YEAR OVERFLOW SWALE SECTIONS

Section	100 Yr. Runoff (c.f.s.)	Bed Slope (%)	As-Built Slope	Base Width (ft)	Side Slope (1:V)	100 Yr WSE (ft)	Sectional Area	Velocity 100Yr. (f.p.s.)	Hydraulic Radius (ft)	Shear Stress (p.s.f.)	As-Built Shear Stress
A-A	1.35	6.67	6.67	4	5	0.11	0.50	2.70	0.10	0.42	0.42
B-B	2.37	6.67	6.77	6	5	0.13	0.86	2.74	0.12	0.49	0.50
C-C	3.60	6.67	6.70	4	5	0.20	1.00	3.60	0.17	0.69	0.69
D-D	2.50	6.67	7.07	6	5	0.13	0.86	2.89	0.12	0.49	0.52
E-E	3.60	2.72	2.79	6	5	0.21	1.48	2.43	0.18	0.34	0.32
F-F	1.03	6.67	7.56	6	5	0.08	0.51	2.01	0.08	0.34	0.35
G-G	3.00	6.00	5.56	5	3	0.18	1.00	3.01	0.16	0.51	0.56
H-H	3.73	4.16	3.57	5	3	0.21	1.27	2.94	0.18	0.46	0.41
I-I	3.37	4.00	4.69	5	3	0.20	1.12	3.01	0.18	0.45	0.52




NOTE: Swale should be lined with "Straw with Net" turf reinforcement (Curlex Blanket or Eqv.) . Per Table 5607-1 in APWA Manual

Townhomes	Lot Number	Basement Type	MBOE Lt.	MBOE Rt.
9	10	Full	940.8	951.0
10	11	Daylight	951.2	940.8
11	12	Daylight	958.1	951.2
12	13	Full	963.9	958.1
13	14	Daylight	966.0	963.9
14	15	Walkout	957.4	964.9
15	16	Walkout	946.5	957.4
16	17	Walkout	960.3	960.0
17	18	Walkout	959.1	960.3
18	19	Walkout	950.2	959.1
19		Daylight	946.2	950.2

Estates				
23	Walkout	935.0	939.3	
24	Walkout	939.3	939.2	

Note:

AS GRADED PLOT PLAN REQUIRED FOR EACH LOT.

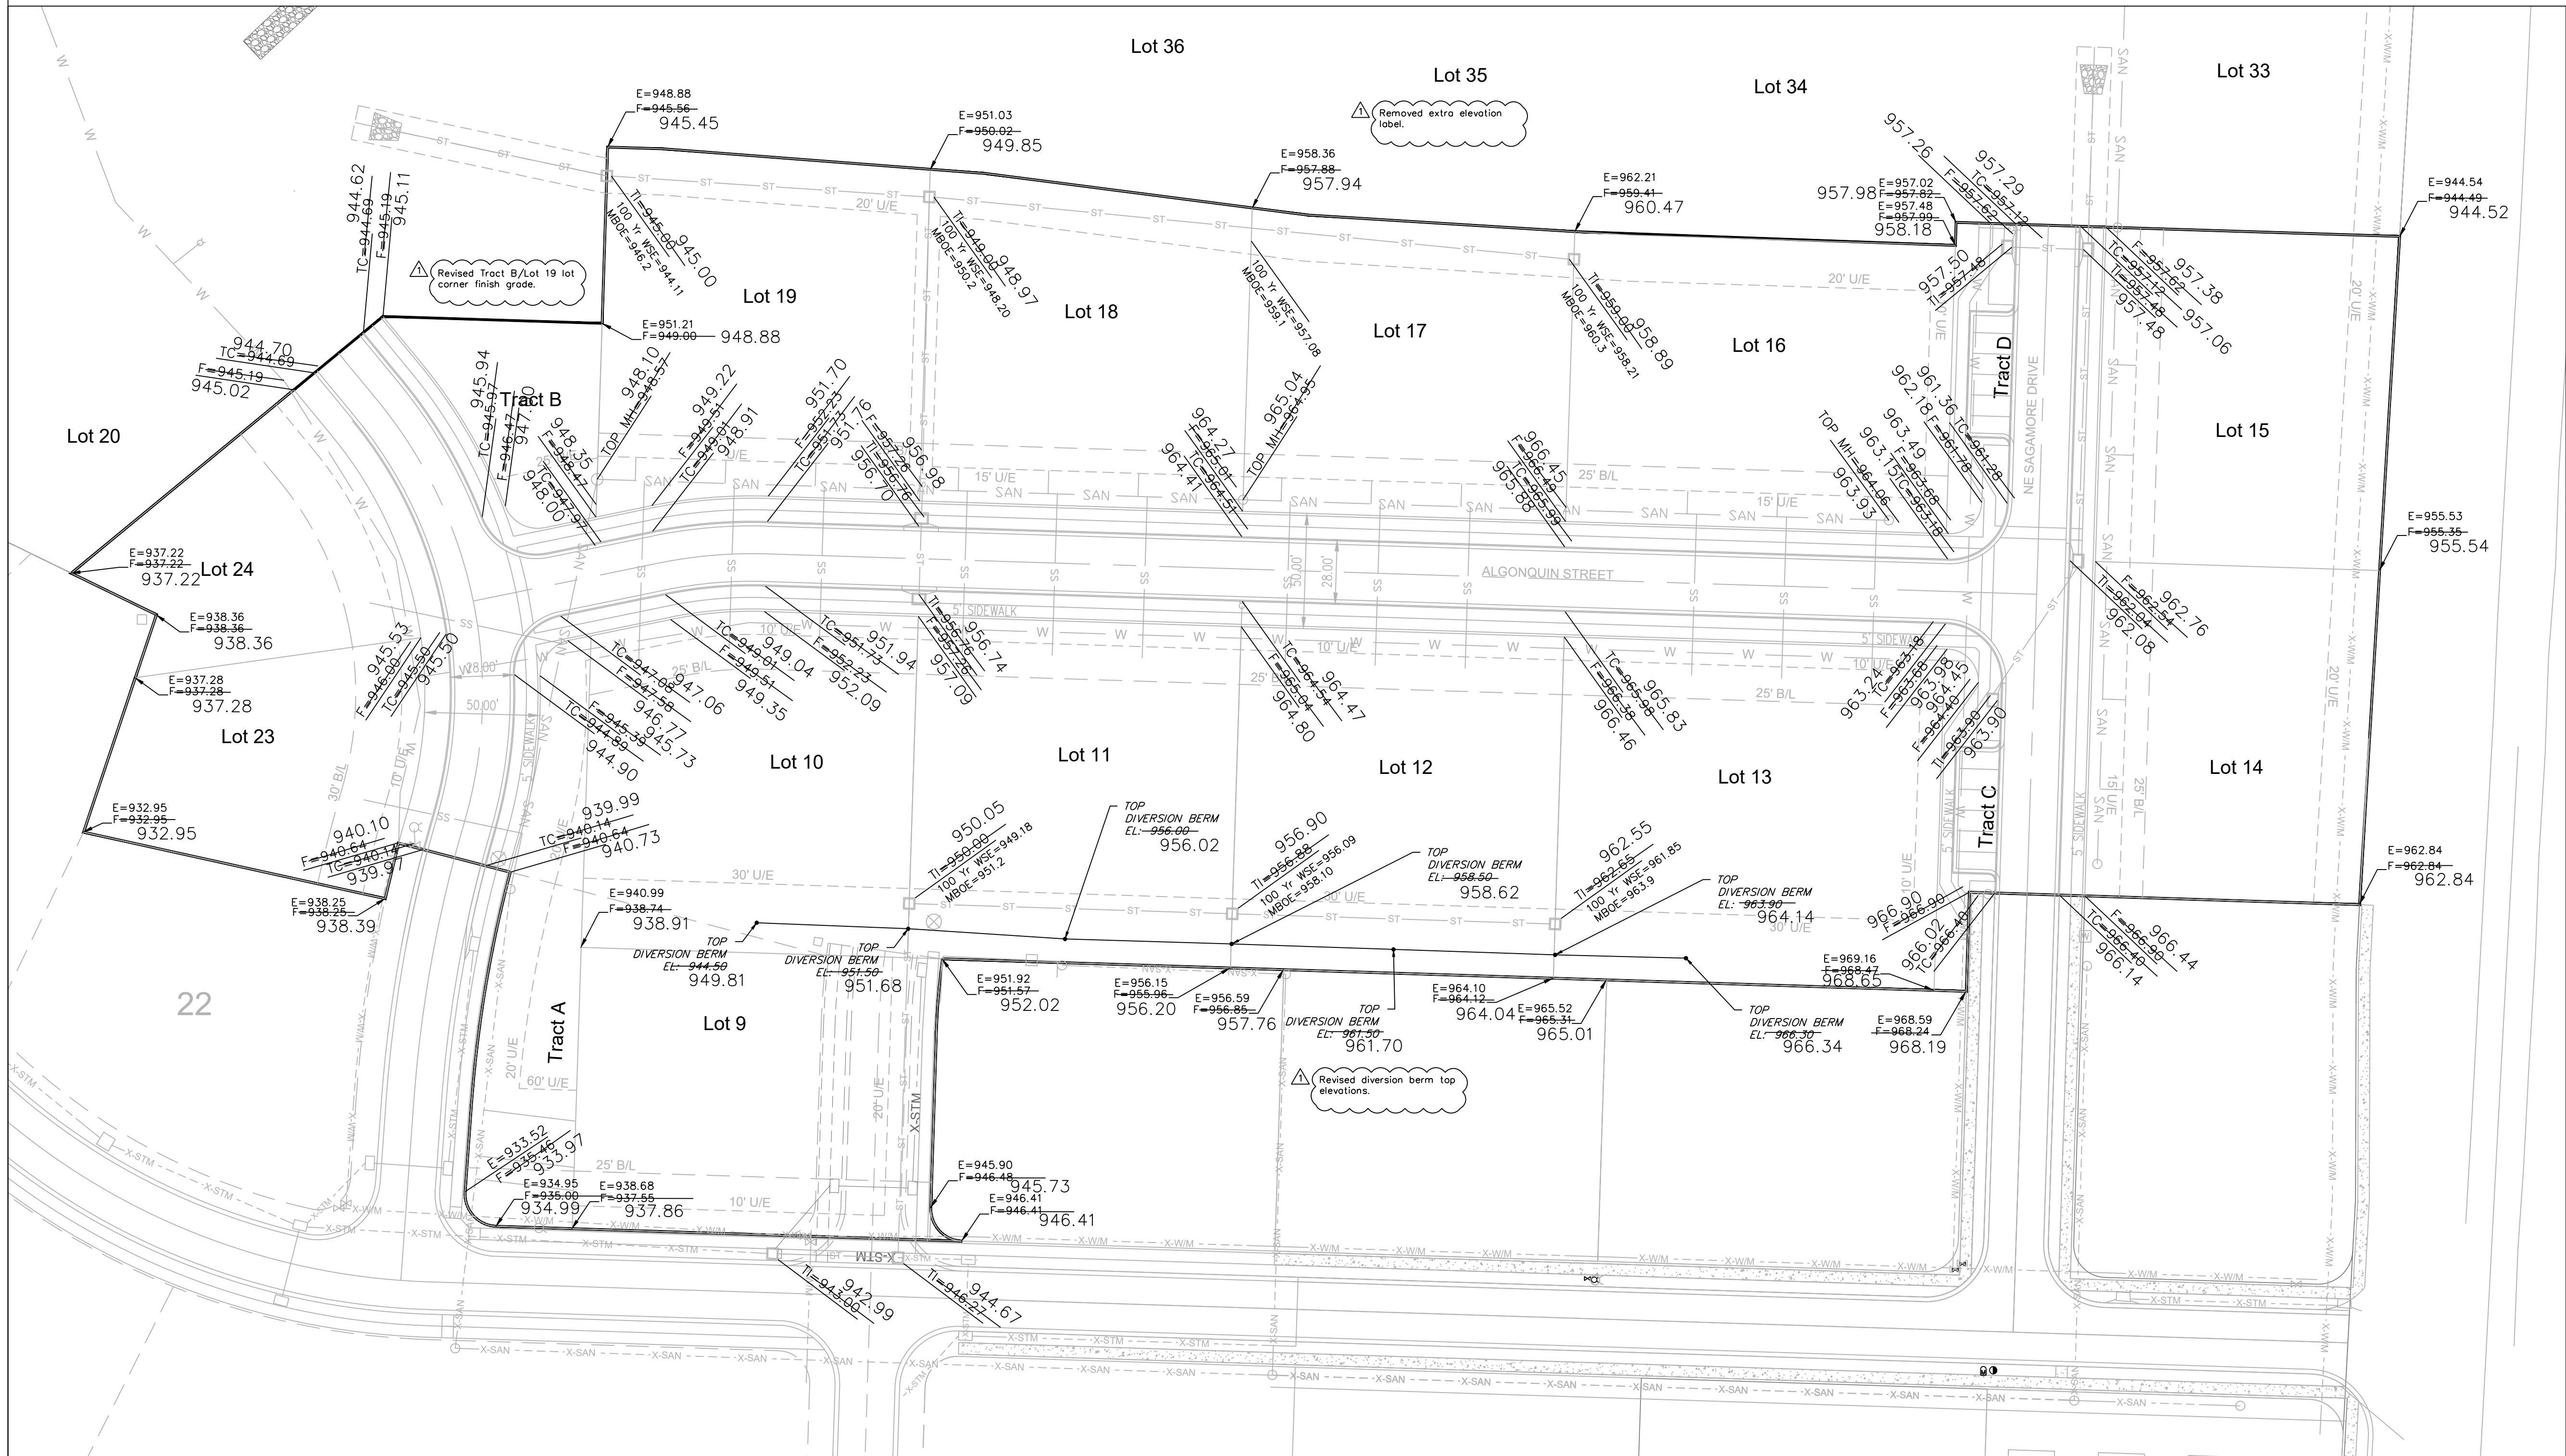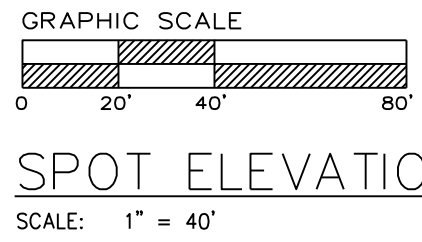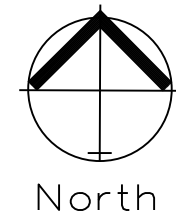

RECORD DRAWING
The information provided on this drawing conforms to construction records; it is not intended for construction, implementation or recording purposes; and it is solely based on information obtained by my firm.


Date: 11/17/2022
Certified by: Matthew J. Schlicht
Title: Engineer
Firm: Engineering Solutions

Master Drainage Plan 2 of 3:

Spot Elevations
Construction Plans for:
THE TOWNHOMES OF CHAPEL RIDGE-2ND PLAT
LOTS 9-19 & TRACTS A-D
Lee's Summit, Jackson County, Missouri



Project:
VILLAS OF CHAPEL
RIDGE-LSMO
Issue Date:
April 10, 2020

Professional Registration
Missouri
Engineering 2005002186-D
Surveying 2005008319-D
Kansas
Engineering E-1695
Surveying LS-218
Oklahoma
Engineering 6254
Nebraska
Engineering CA2821






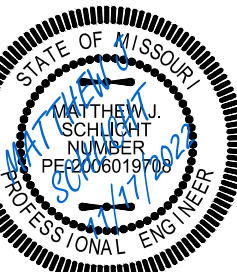


Matthew J. Schlicht
MO PE 2006019708
KS PE 19071
OK PE 25226
NE PE E-14335

REVISIONS
6/25/2021 As-Built
8/18/2021 As-Built
8/31/2021 As-Built
9/9/2021 As-Built
11/17/2022 As-Built

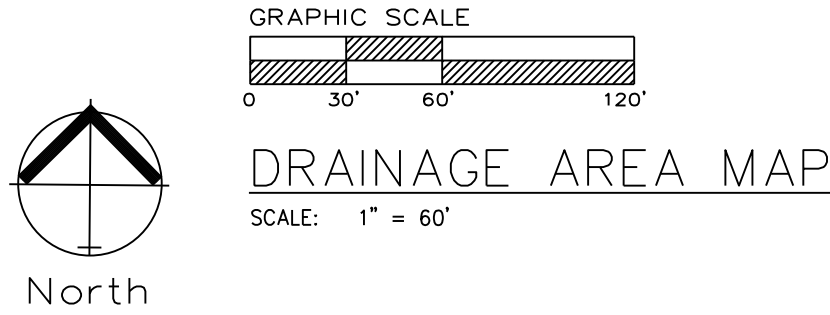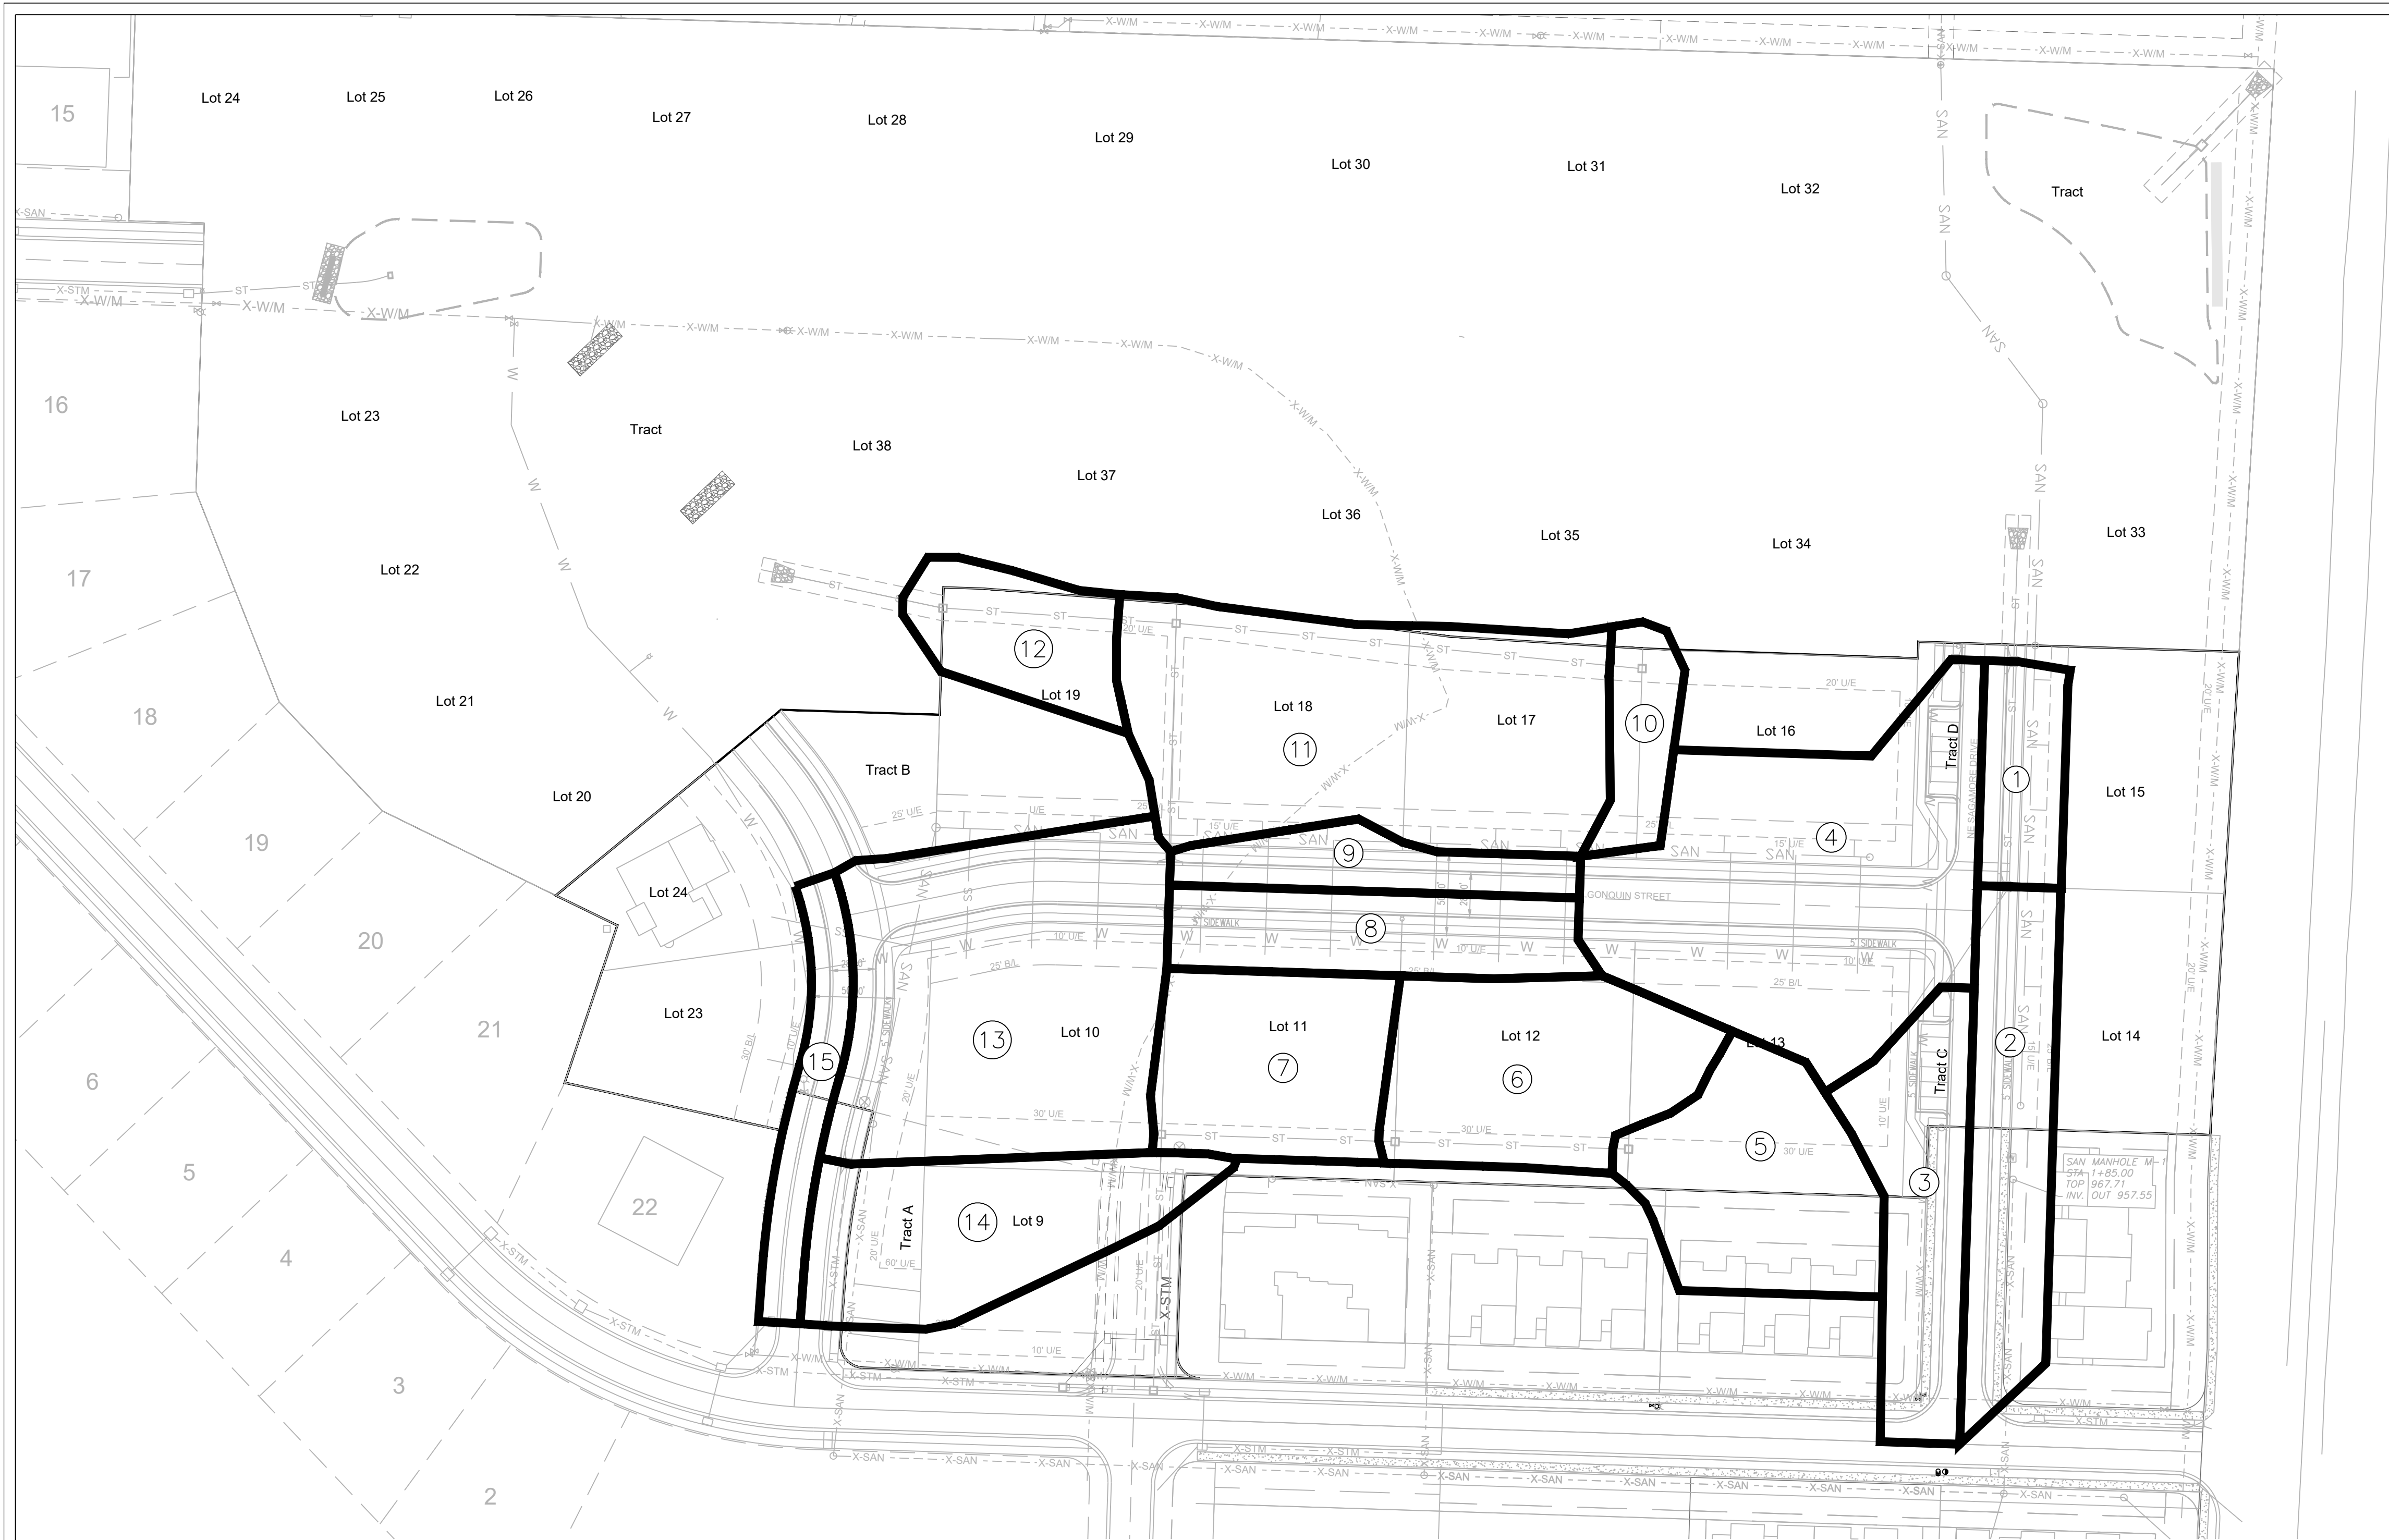

APWA STORM DRAINAGE "TC" COMPUTATIONS FOR : VILLAS OF CHAPEL RIDGE 2ND PLAT																							
yellow areas are self computing overwrite if necessary				Surface types: SURFACE CODES																			
				"C" Values																			
				TC COMPUTATION																			

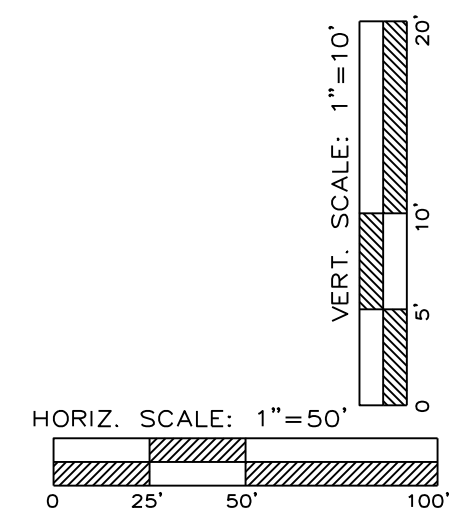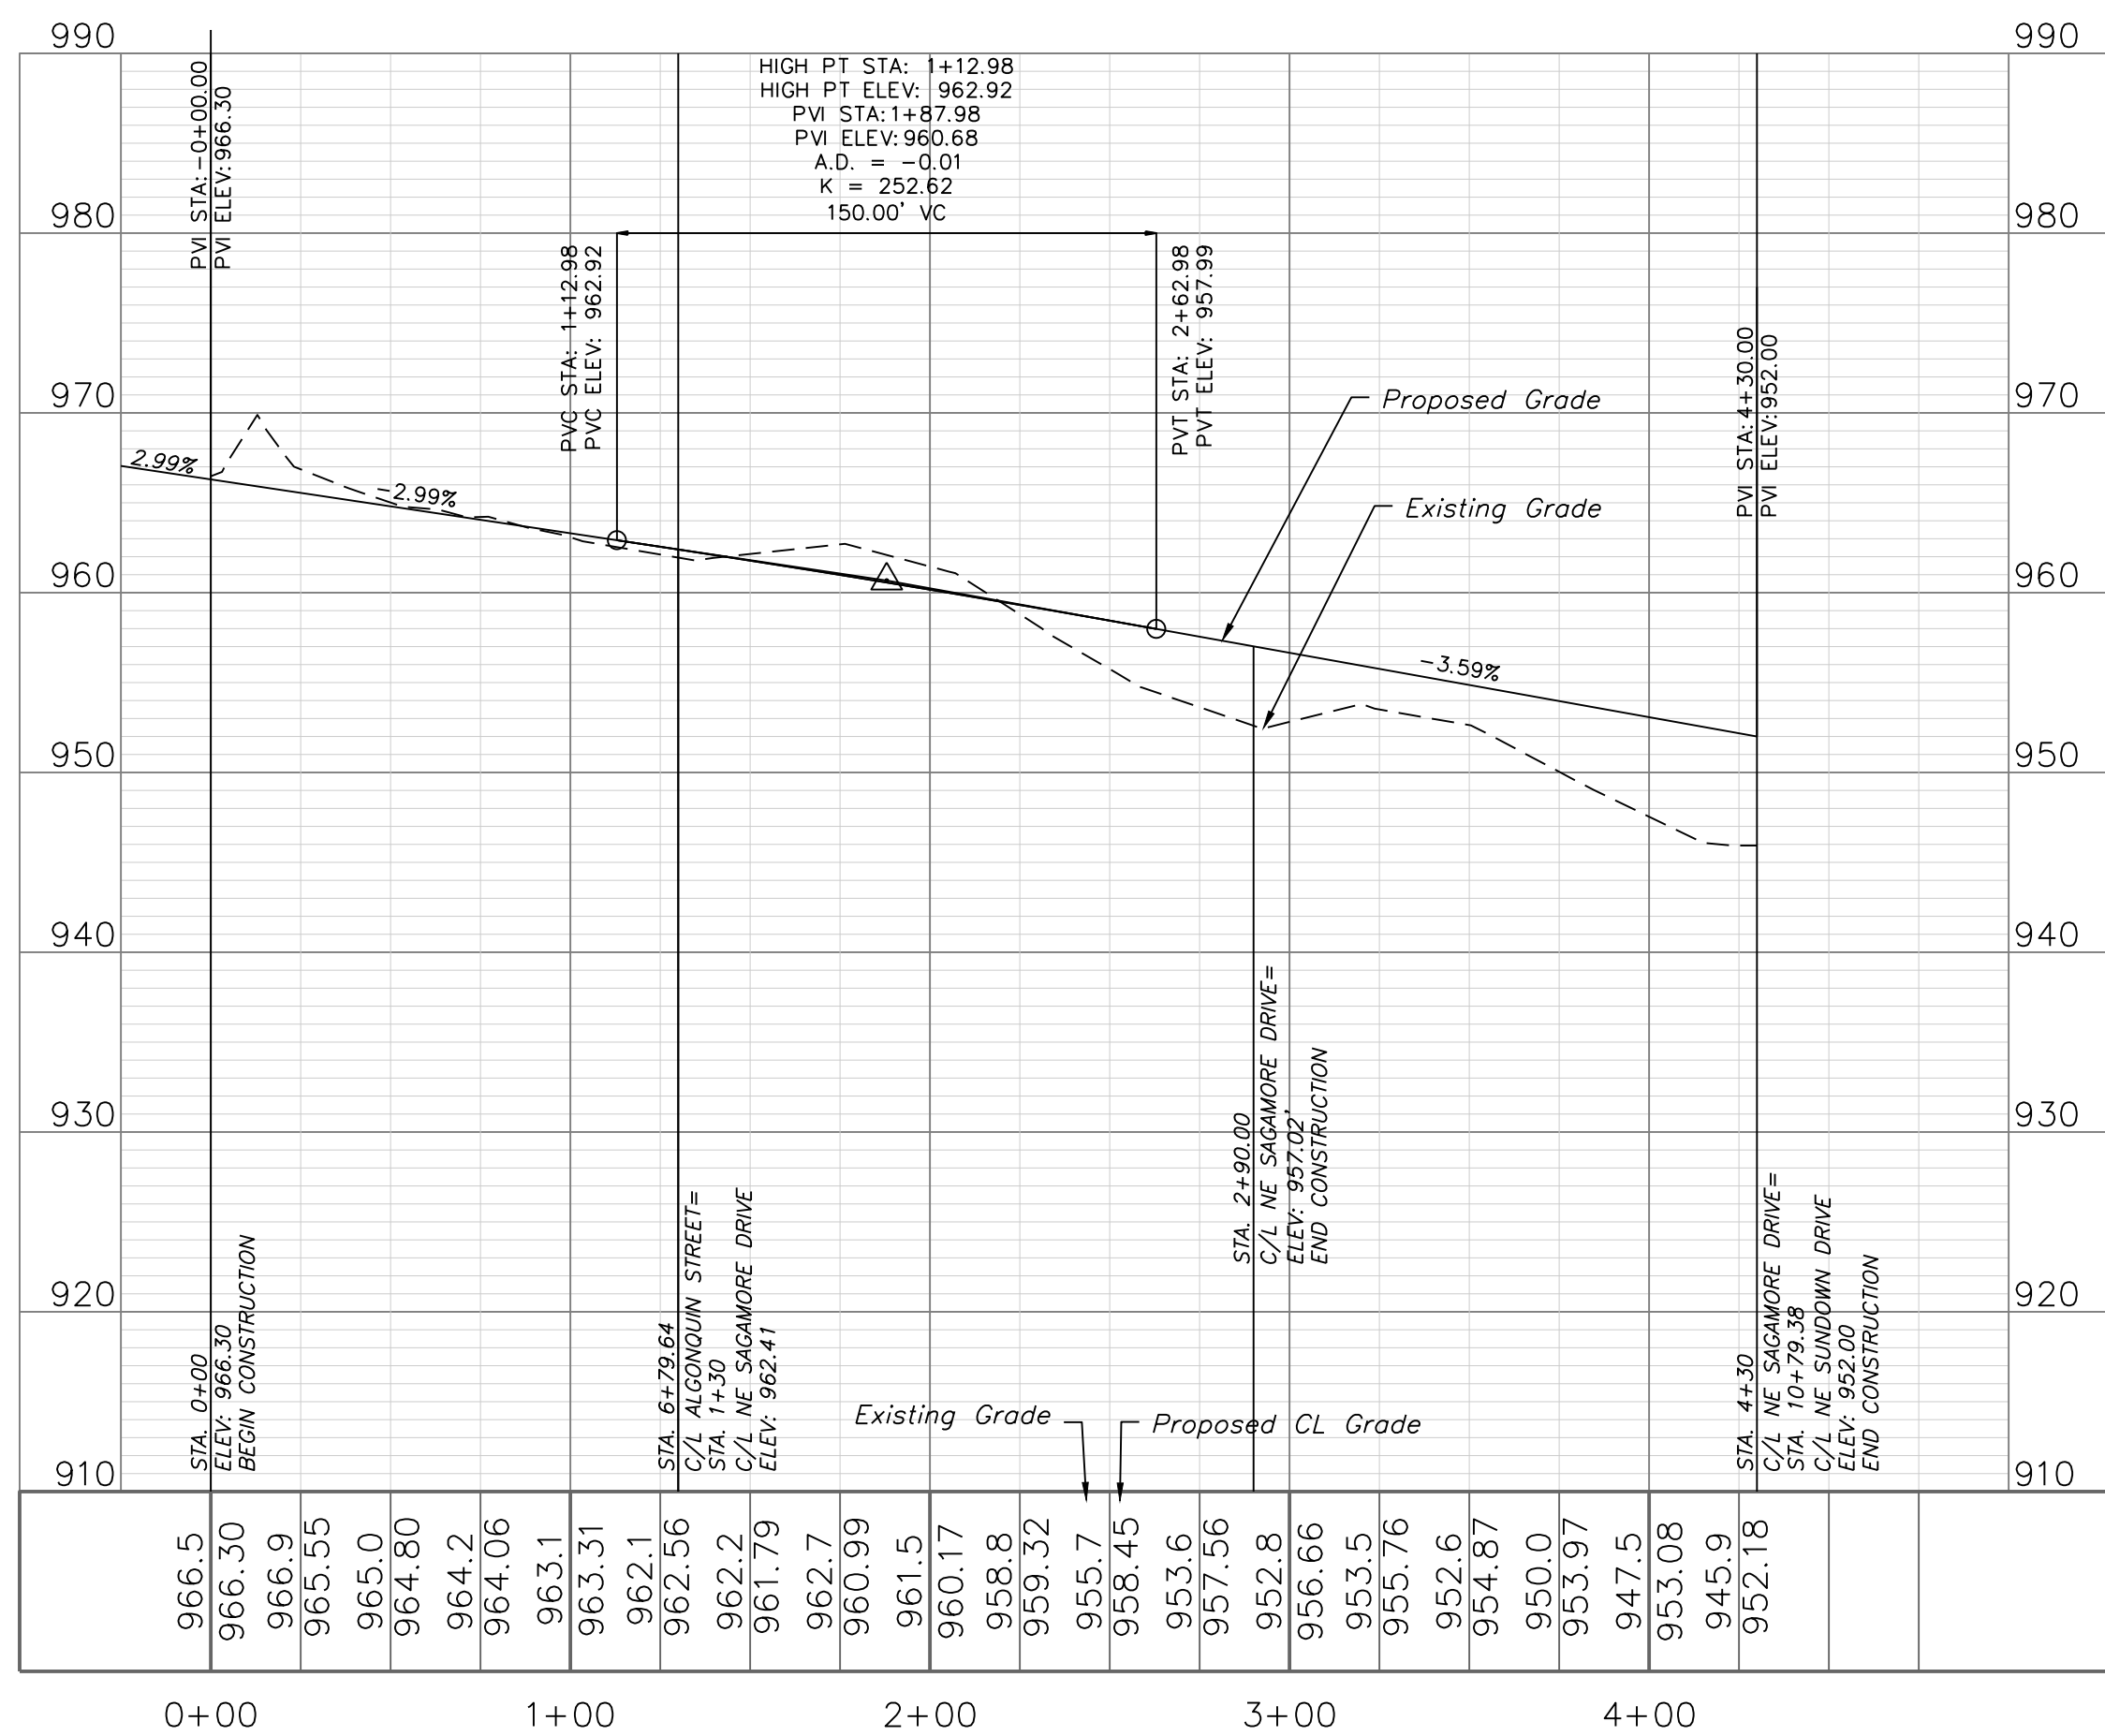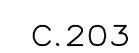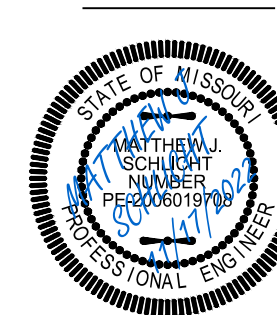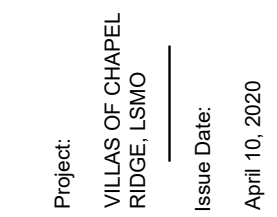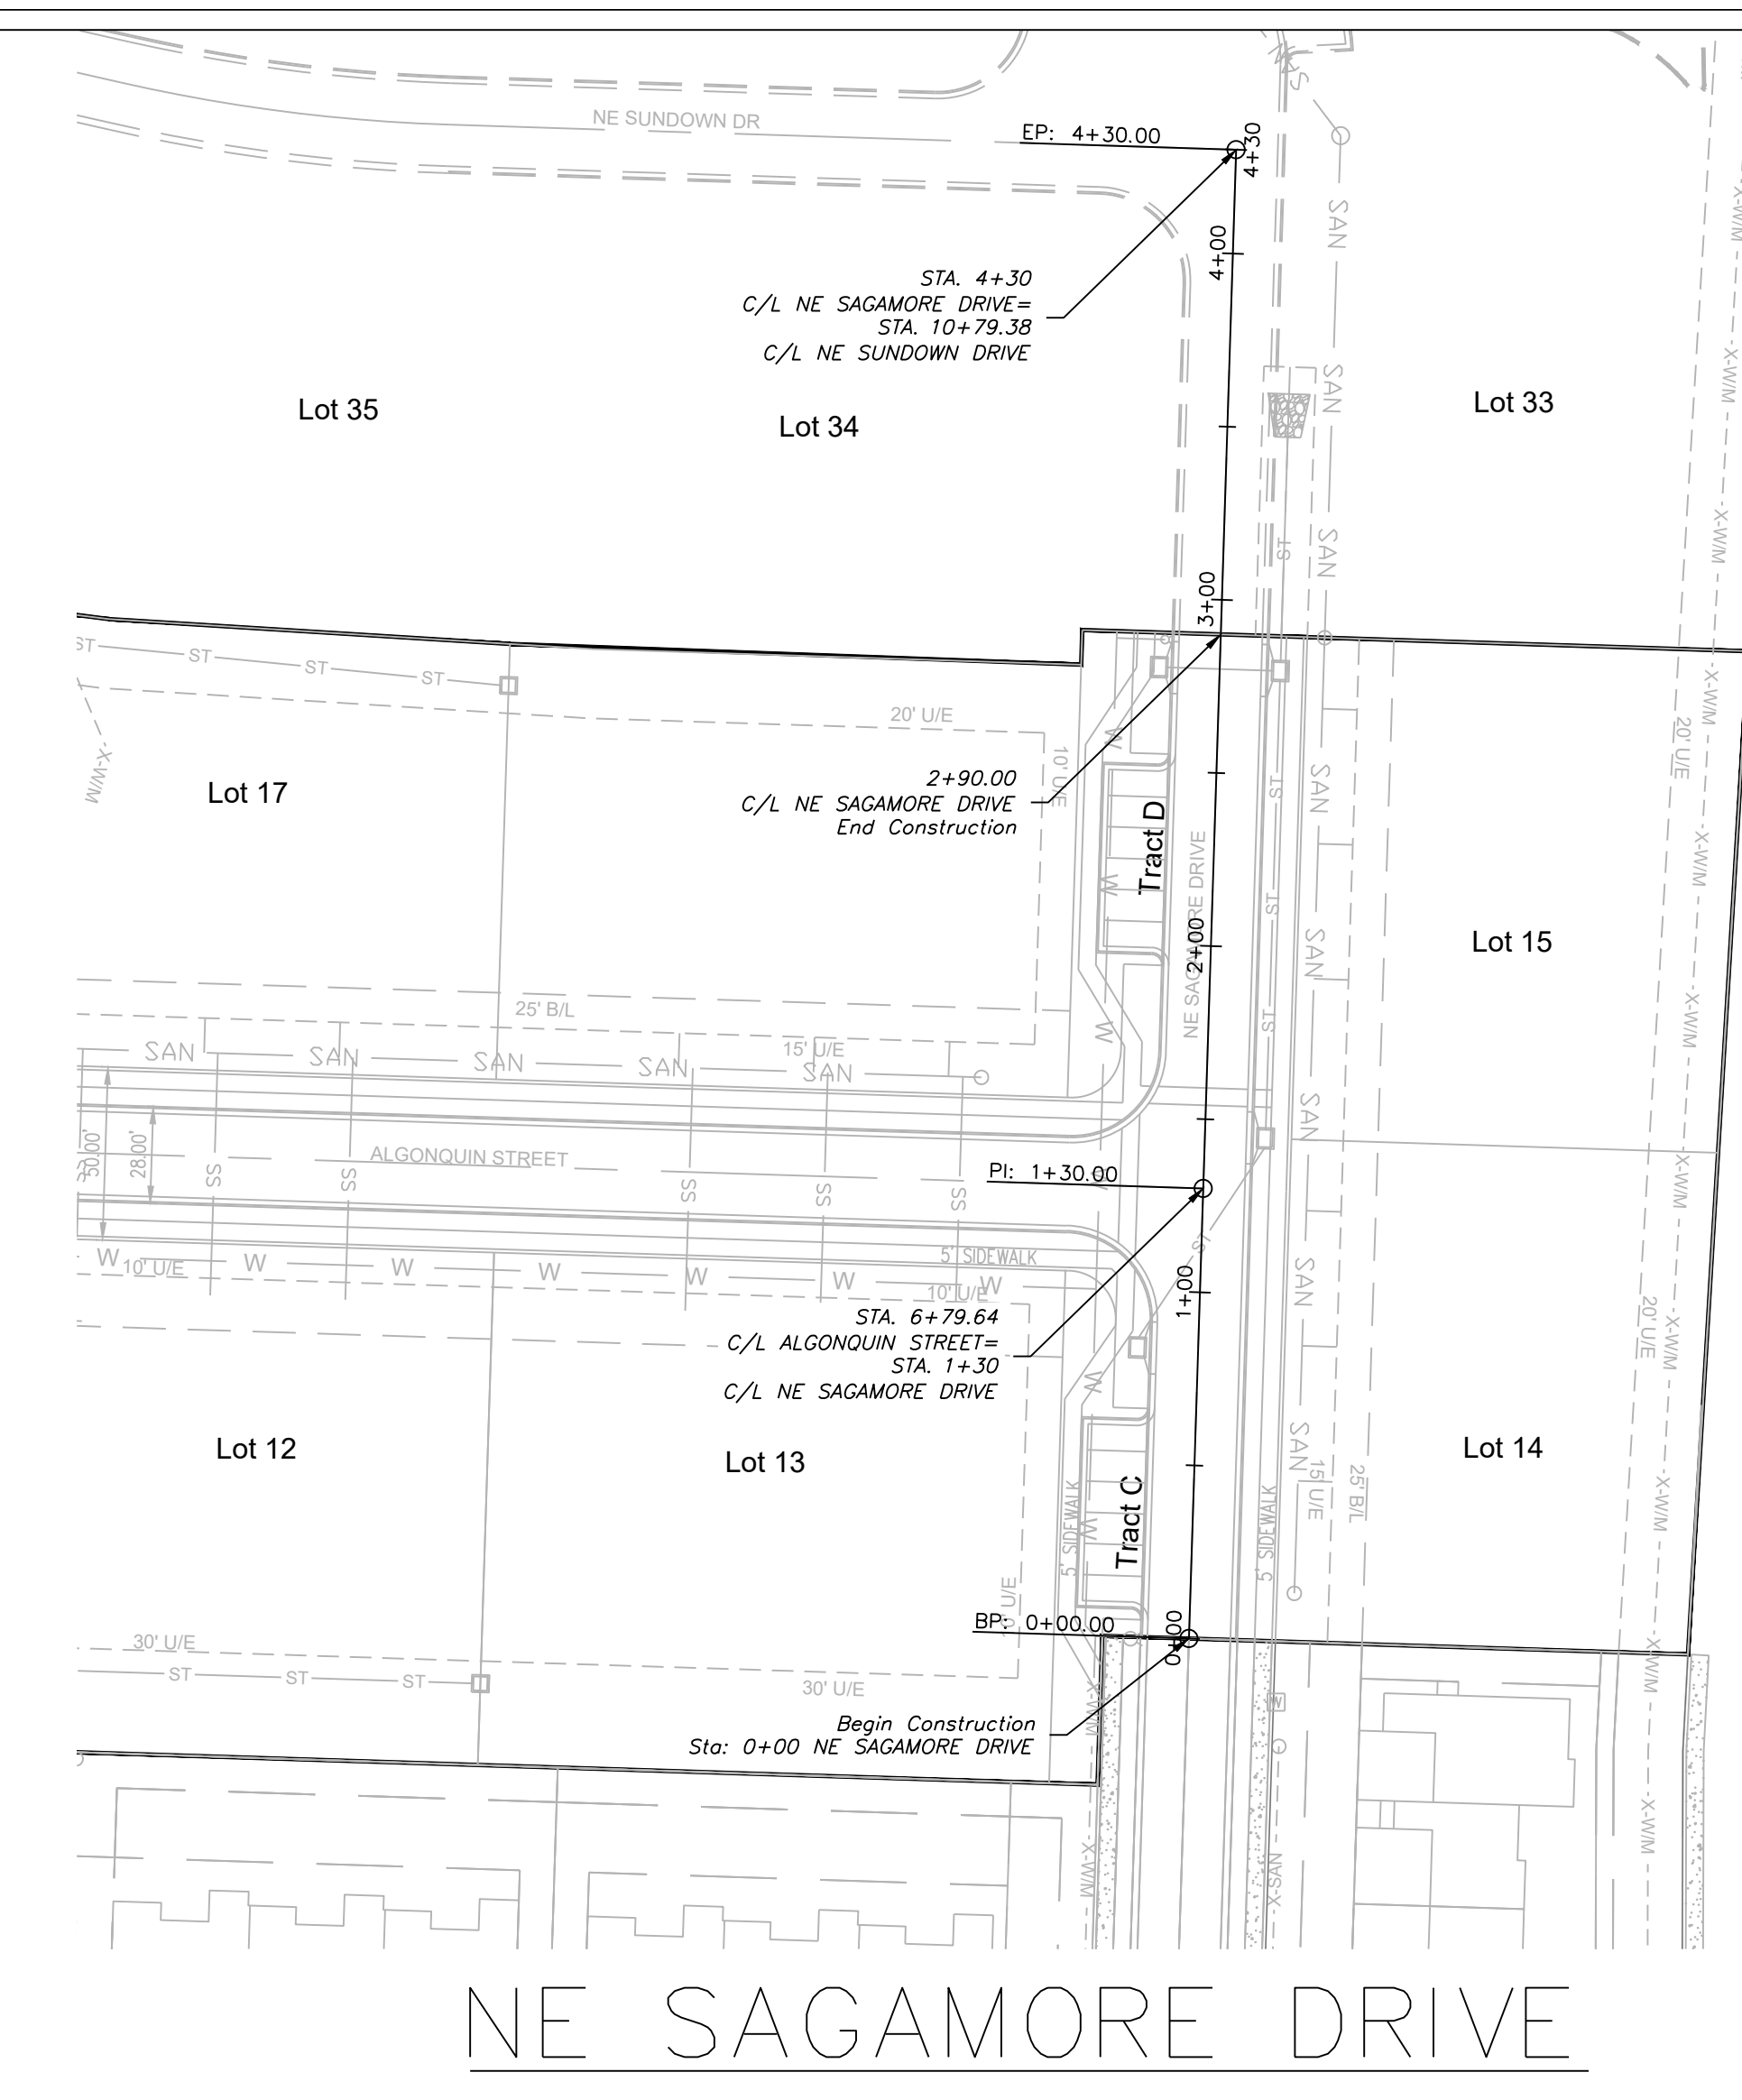

RECORD DRAWING

The information provided on this drawing conforms to construction records; it is not intended for construction, implementation or recording purposes; and it is solely based on information obtained by my firm.


"100-00 100.10, "4.00% 1.15% slope", or "8-inch HDPE-PV pipe" are all typical examples of revisions that indicate that design data has been replaced with "as-built" information. A other data is as designed and has not been field verified.

Date: 11/17/2022

Certified by: Matthew J. Schlicht



Title: Engineer

Firm: Engineering Solutions

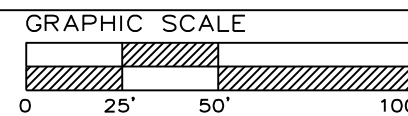

STREET PLAN & PROFILE
SCALE: 1" = 50'


ALGONQUIN STREET

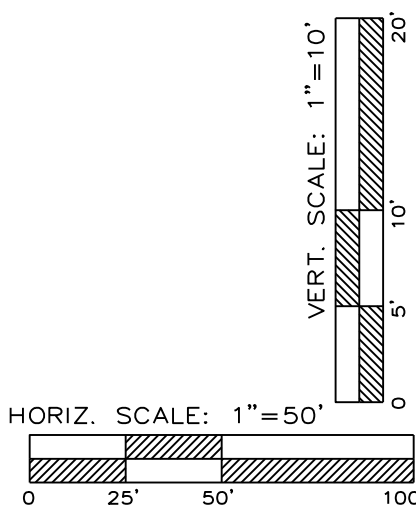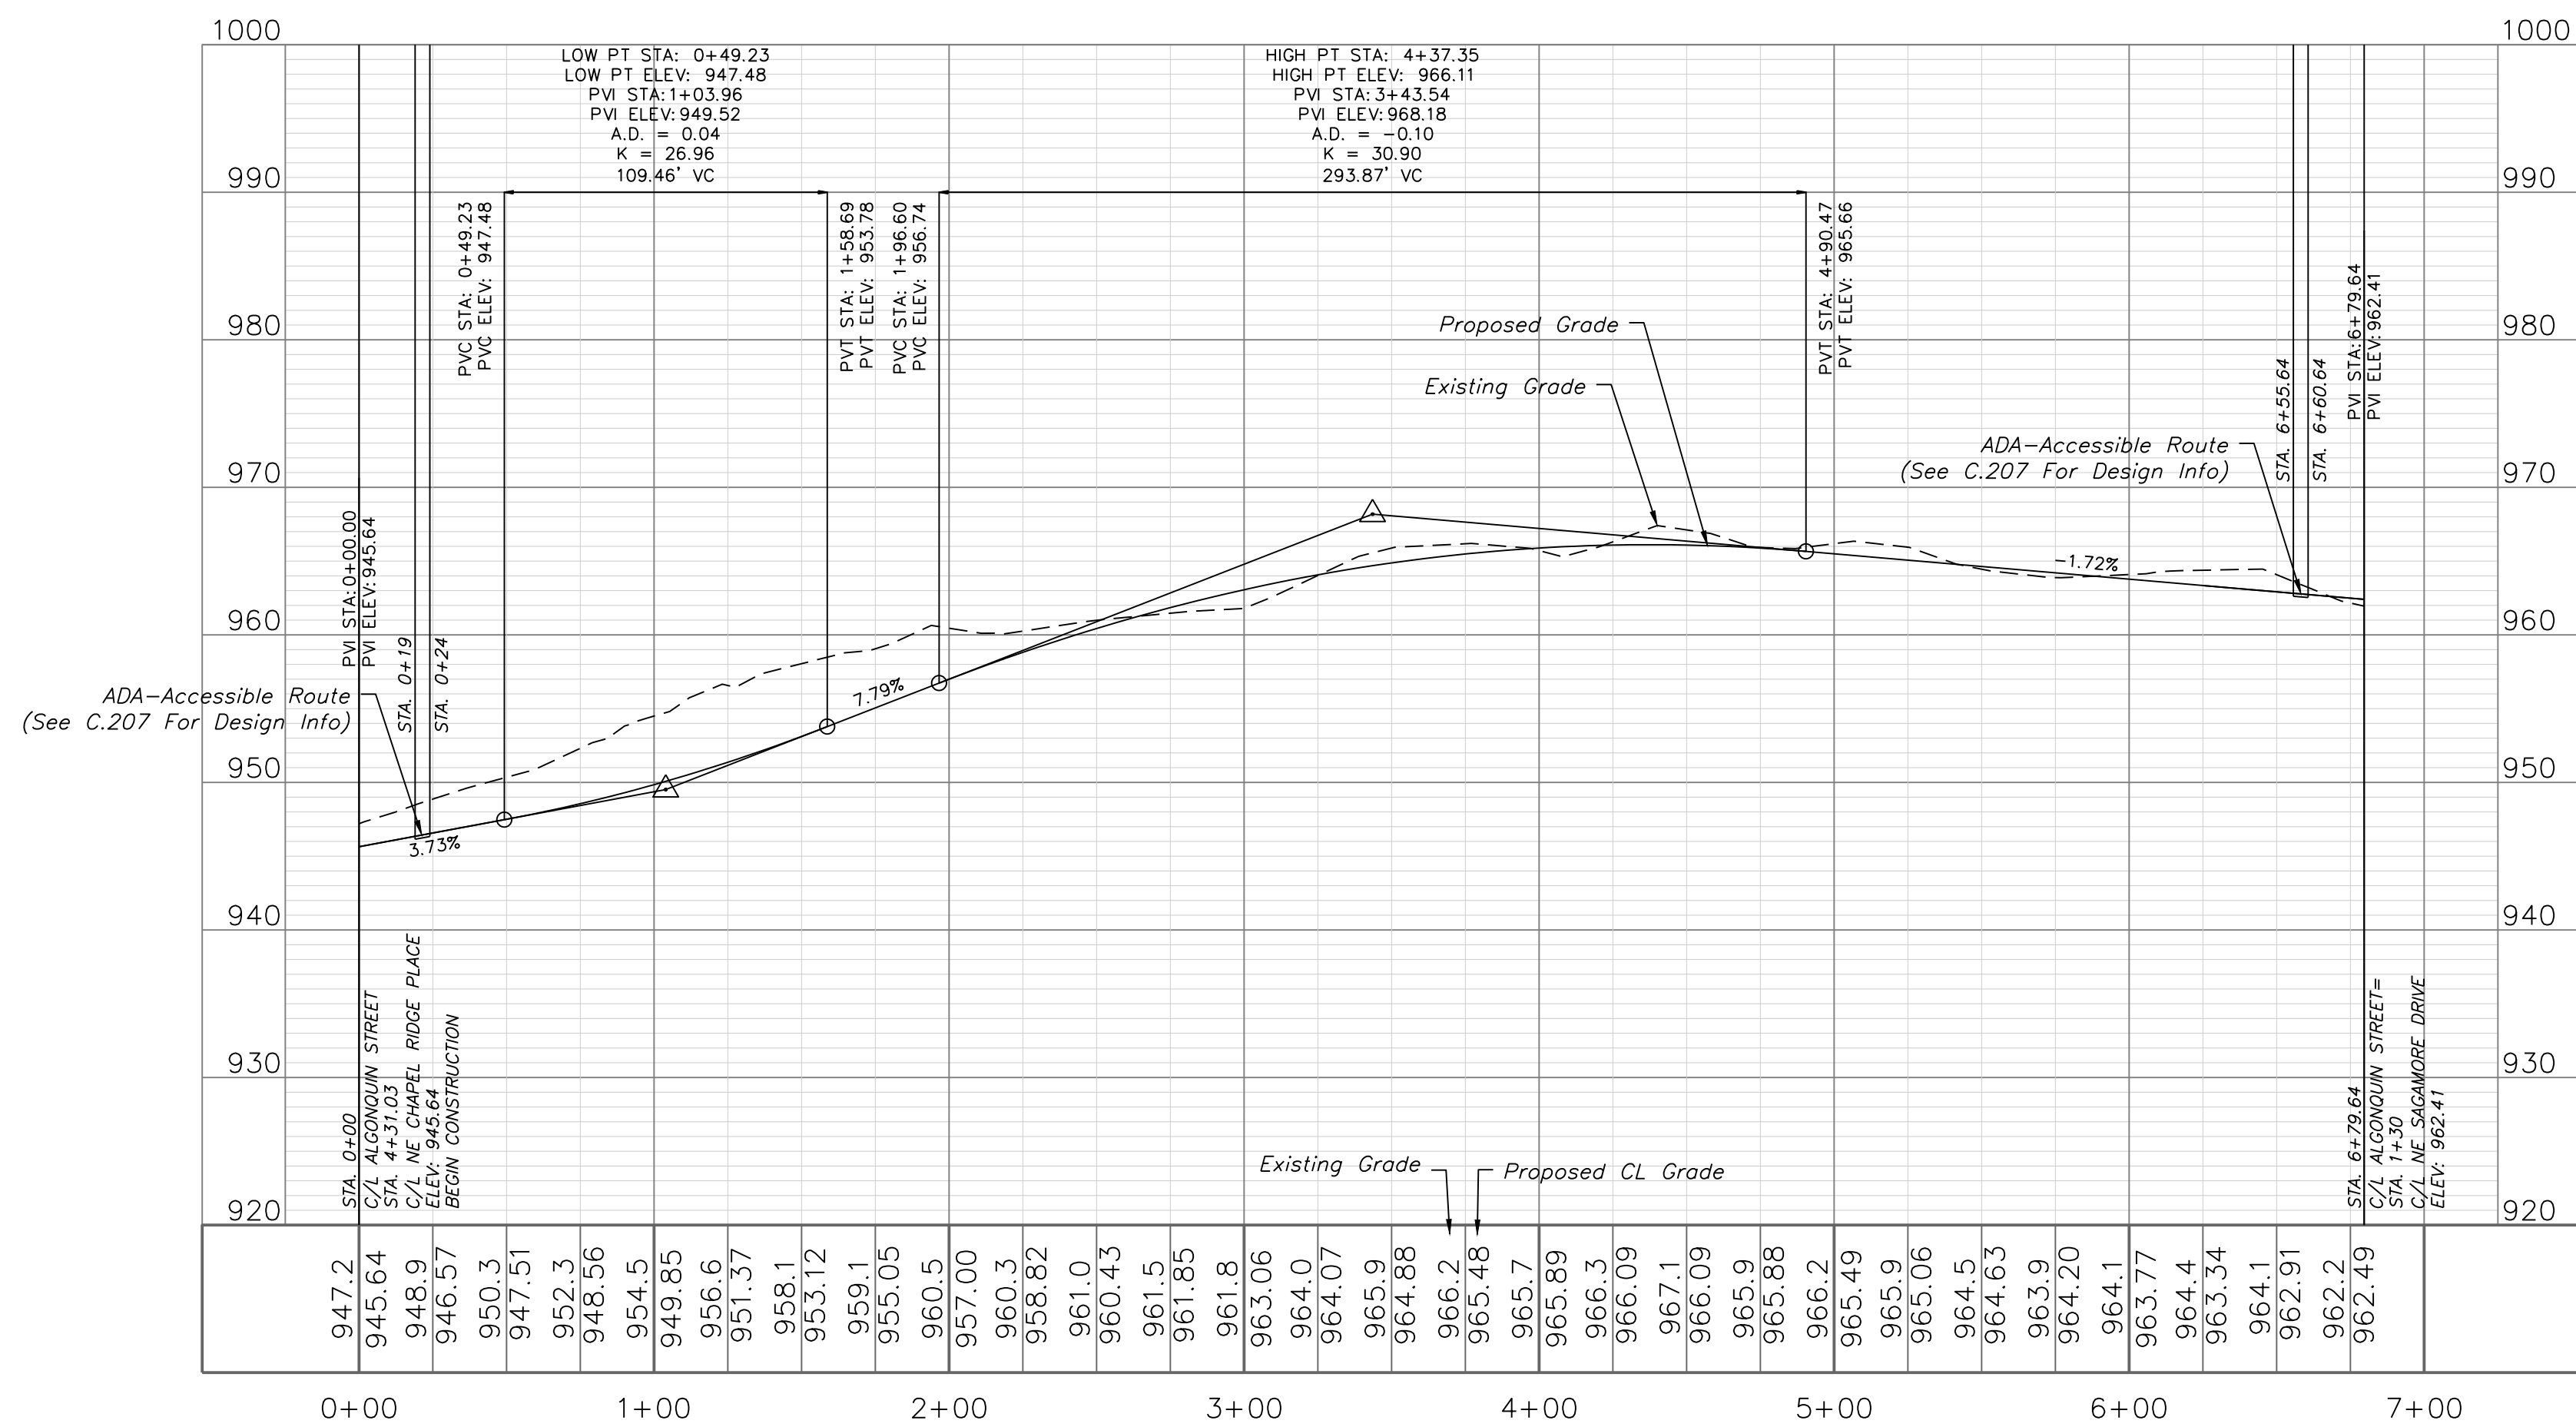

RECORD DRAWING
The information provided on this drawing conforms to construction records; it is not intended for construction, implementation or recording purposes; and it is solely based on information obtained by our firm.

"100-00 100.10", "4-00% 1.15% slope", or "8-inch HDPE-PVC pipe" are all typical examples of revisions that indicate that design data has been replaced with "as-built" information. All other data is as designed and has not been field verified.

Date: 11/17/2022
Certified by: Matthew J. Schlicht
Title: Engineer
Firm: Engineering Solutions

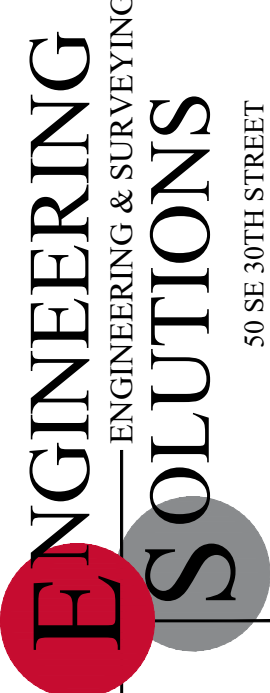


Professional Registration
Missouri
Engineering 2005002186-D
Surveying 2005008319-D
Kansas
Engineering E-1685
Surveying LS-218
Oklahoma
Engineering 6254
Nebraska
Engineering CA2821

THE TOWNHOMES OF CHAPEL RIDGE-2ND PLAT
LOTS 9-19 & TRACTS A-D
Lee's Summit, Jackson County, Missouri

Project:
VILLAS OF CHAPEL
RIDGE-LSMO
Issue Date:
April 10, 2020


Street Plan and Profile
Construction CHAPLS for:
THE TOWNHOMES OF CHAPEL RIDGE-2ND PLAT
LOTS 9-19 & TRACTS A-D
Lee's Summit, Jackson County, Missouri

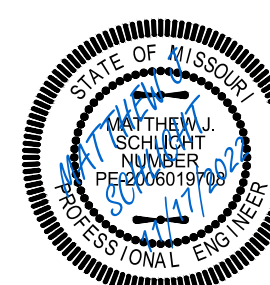


Matthew J. Schlicht
MO PE 2006019708
KS PE 19071
OK PE 25226
NE PE E-14335

REVISIONS


6/25/2021	As-Built
8/18/2021	As-Built
8/31/2021	As-Built
9/9/2021	As-Built
11/17/2022	As-Built

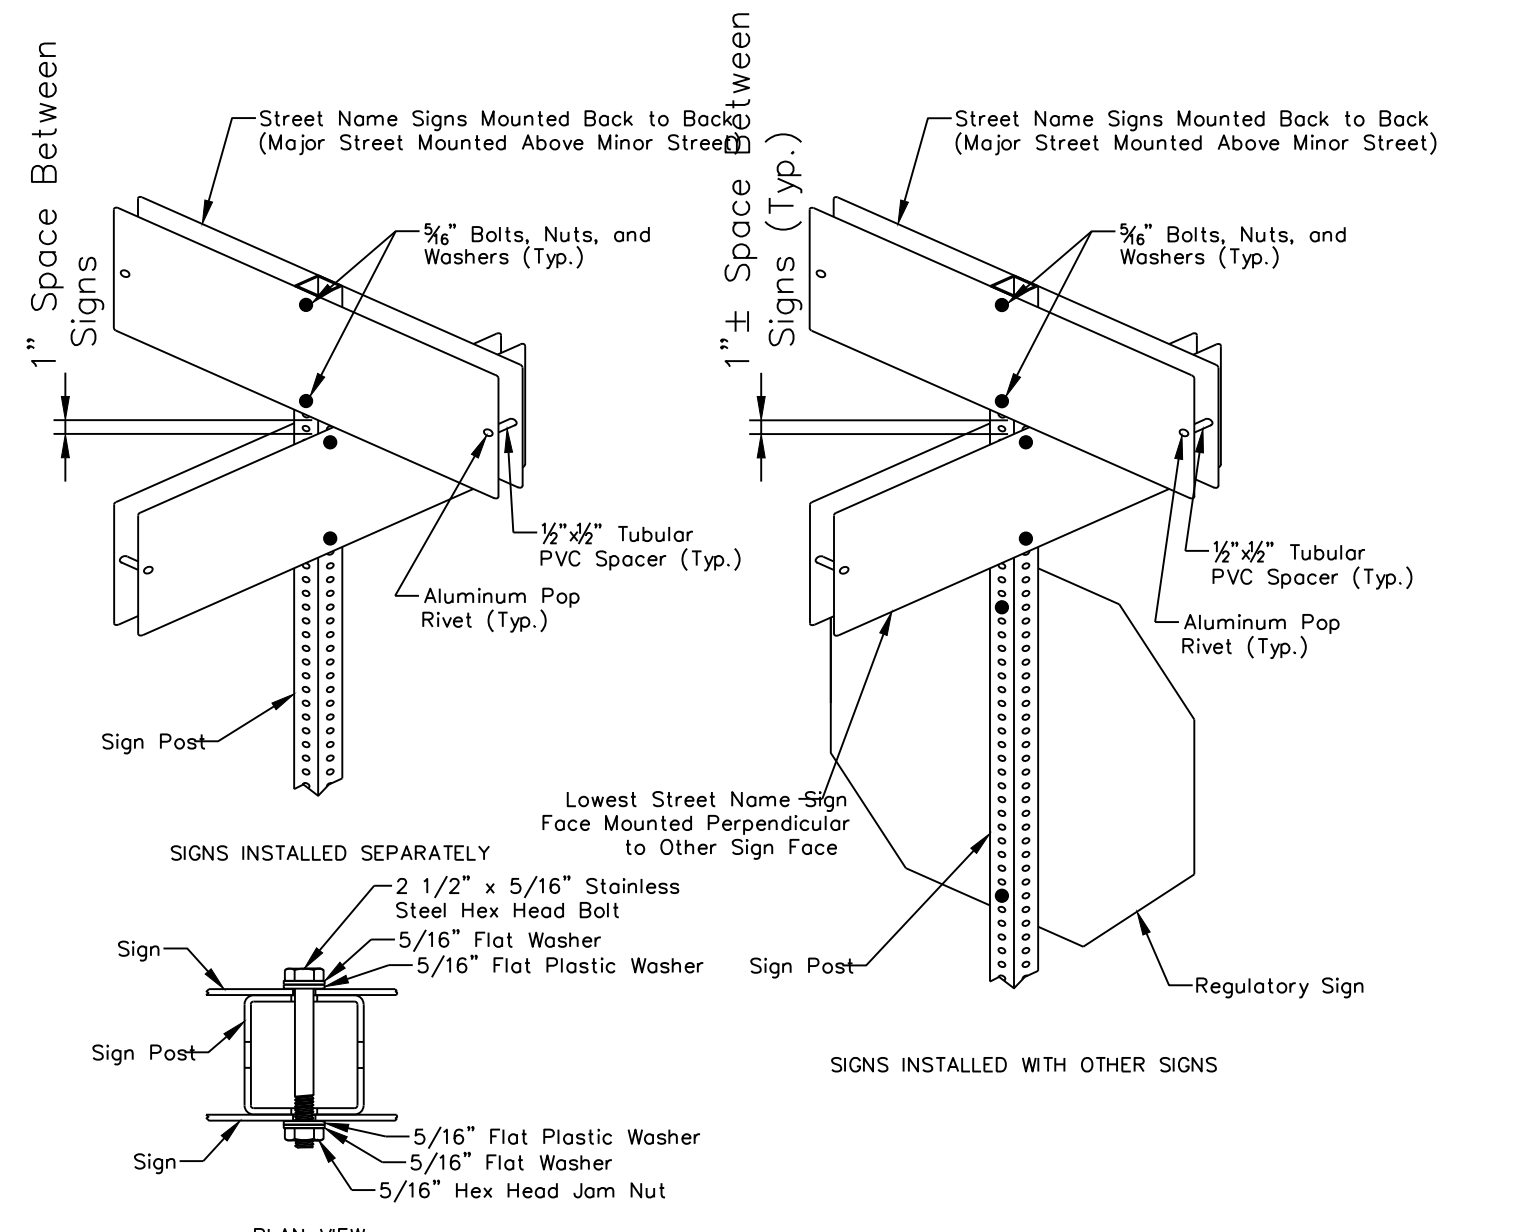


SQUARE STEEL POST MOUNTING DETAILS

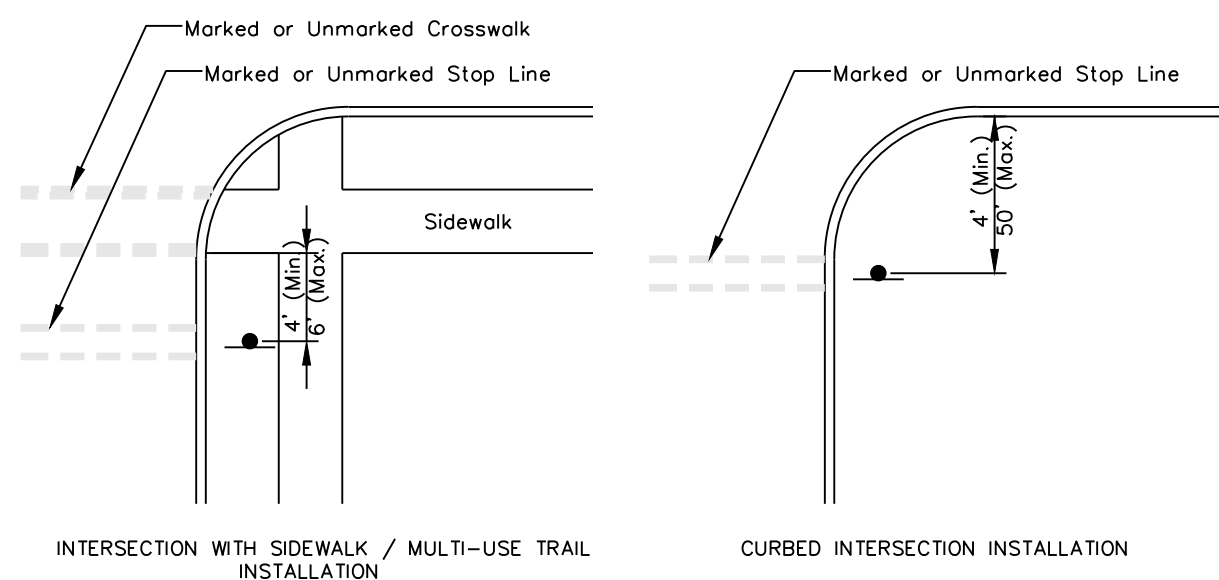

CONTROL SIGN LOCATION


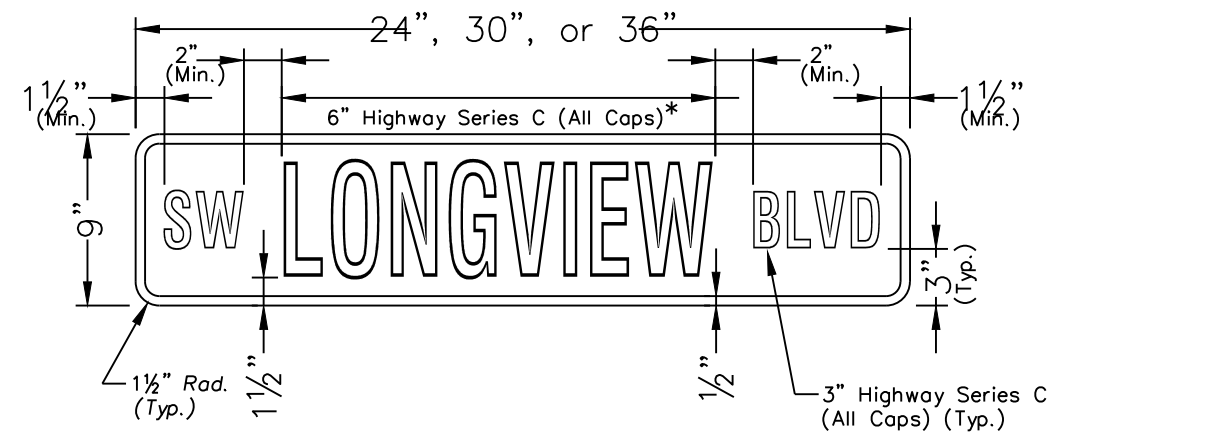


* Use Highway Series B (All Caps) in lieu of series C if necessary to fit text on a 36" sign blank.

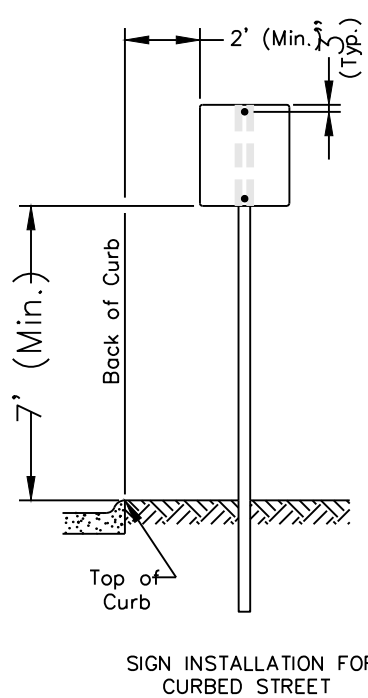



SIGN MOUNTING DETAILS

* The height to the bottom of a sign when it is located in a pedestrian walkway or extends into a walkway shall be a minimum of 80 inches above the walkway.

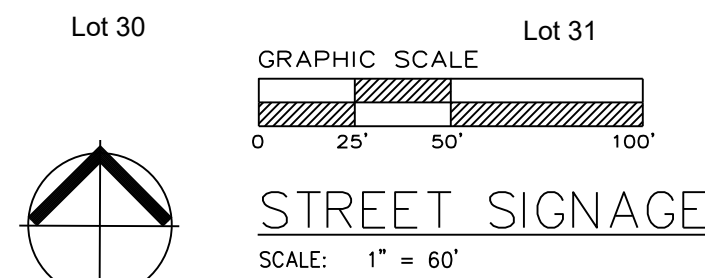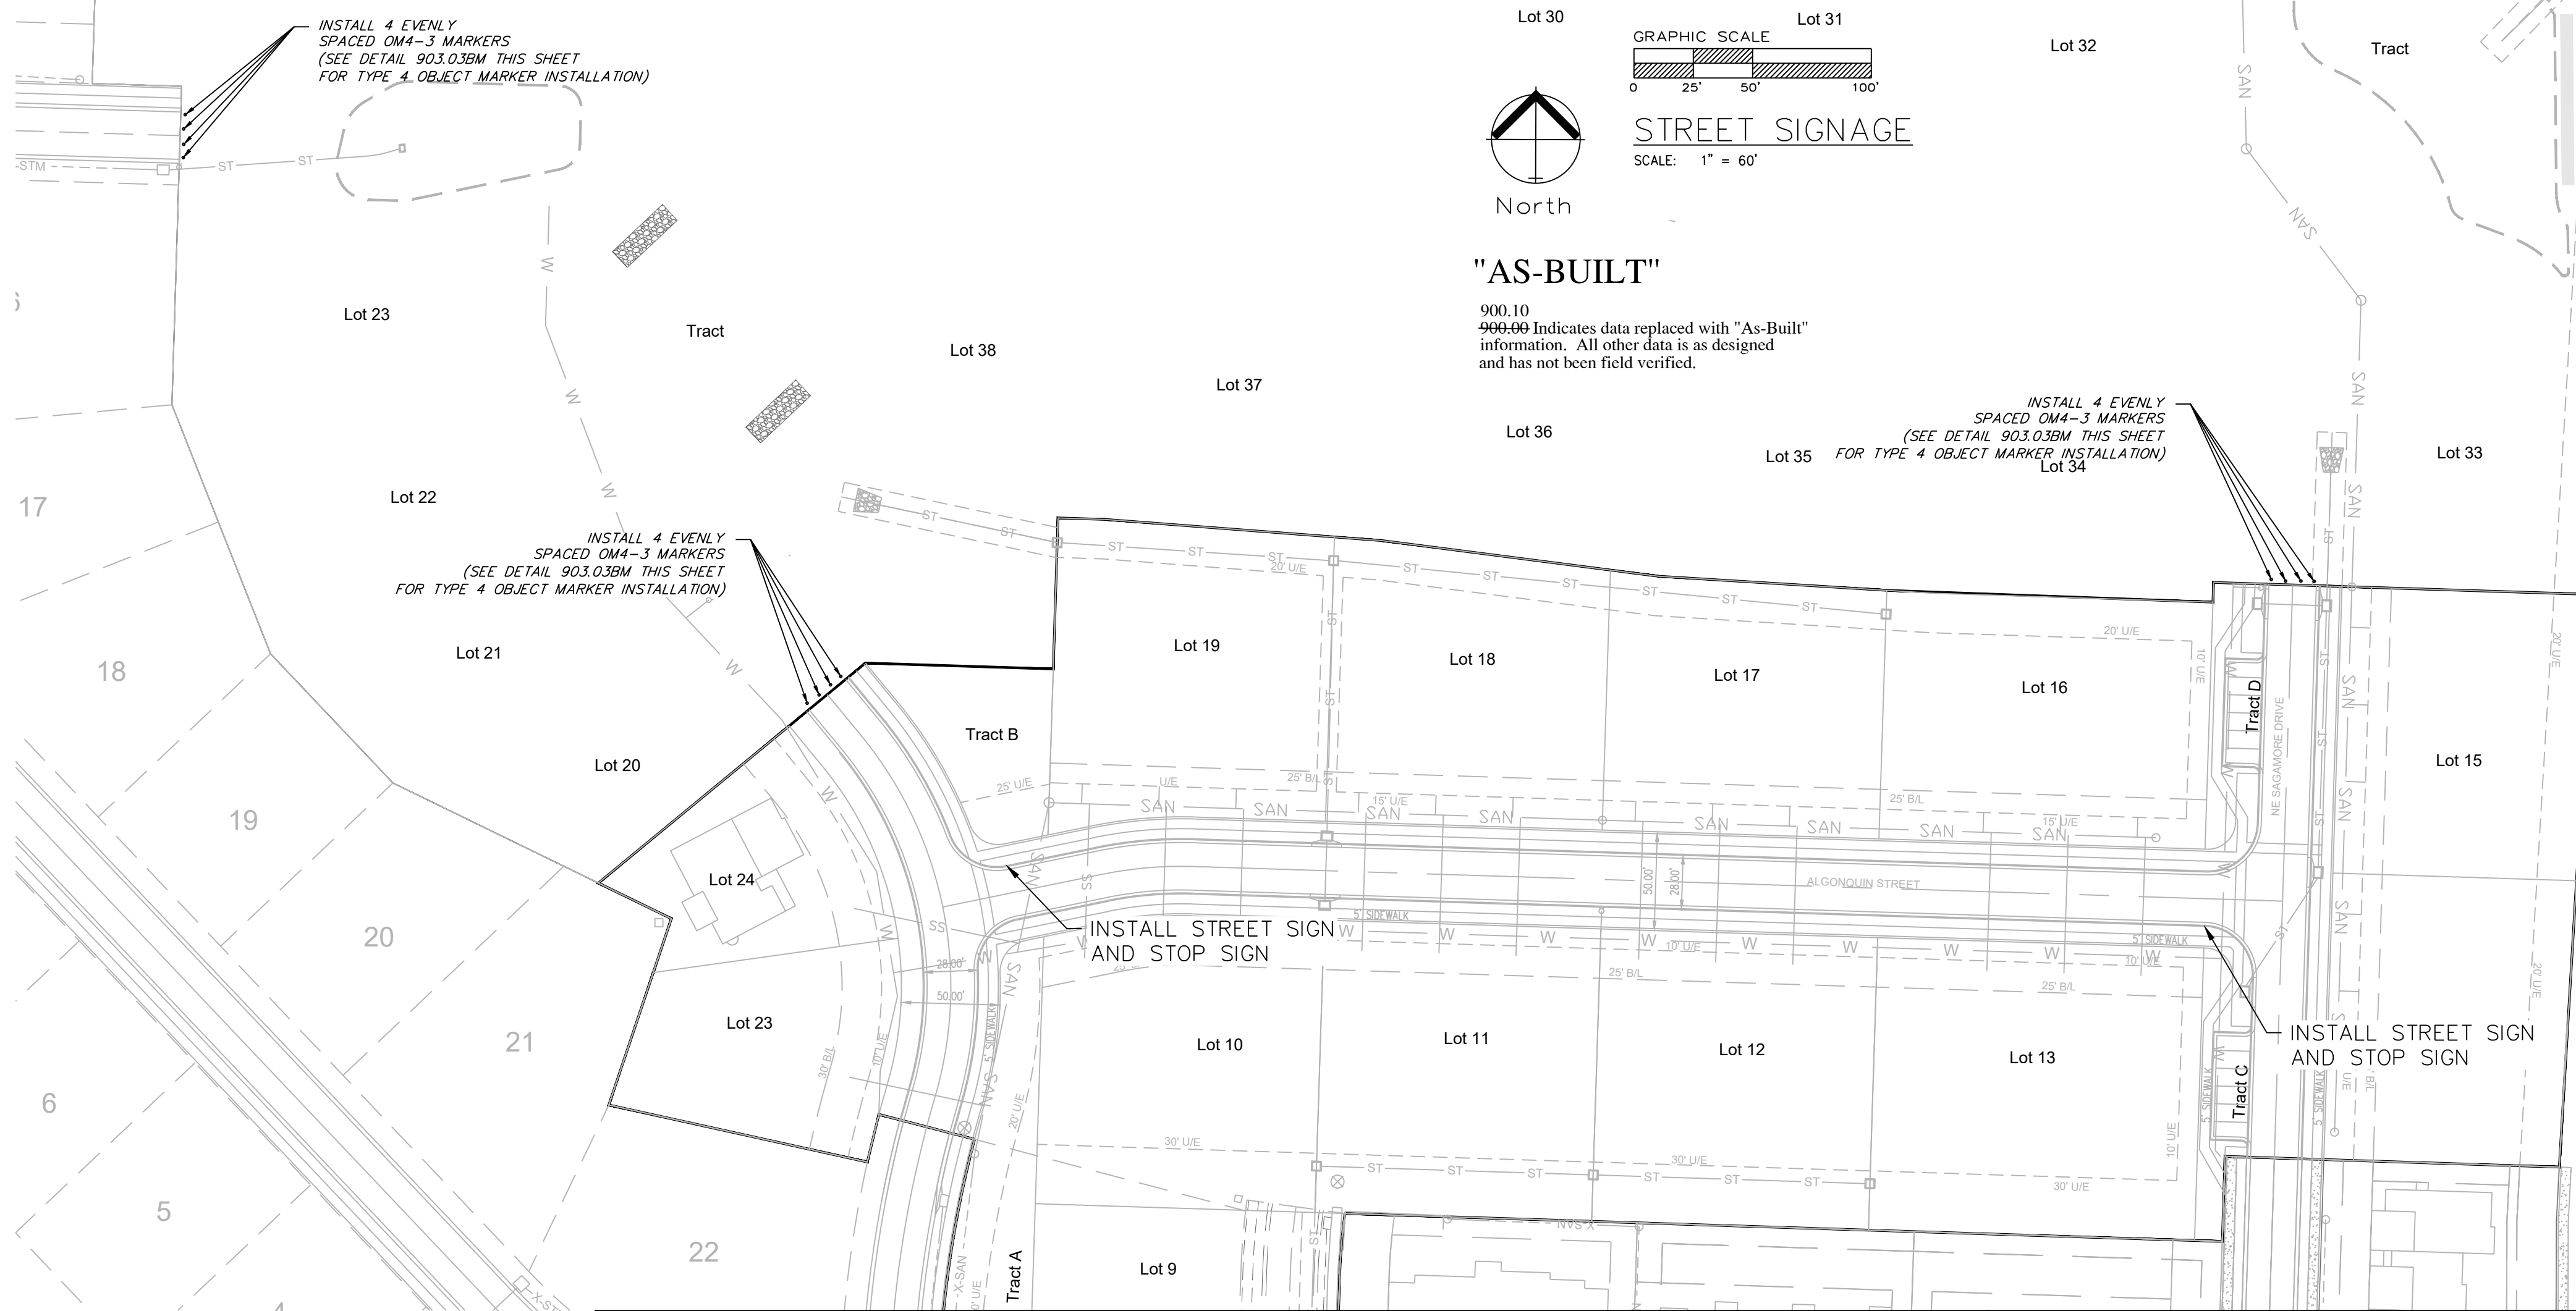


"AS-BUILT"

900.10
900.100 Indicates data replaced with "As-Built" information. All other data is as designed and has not been field verified.

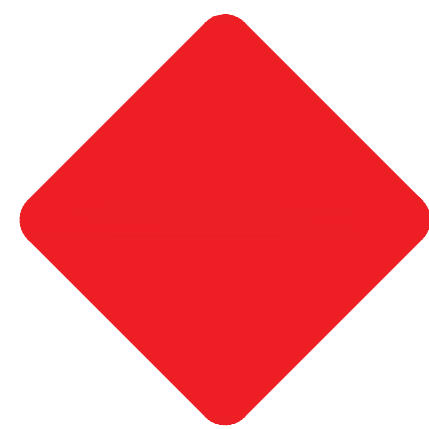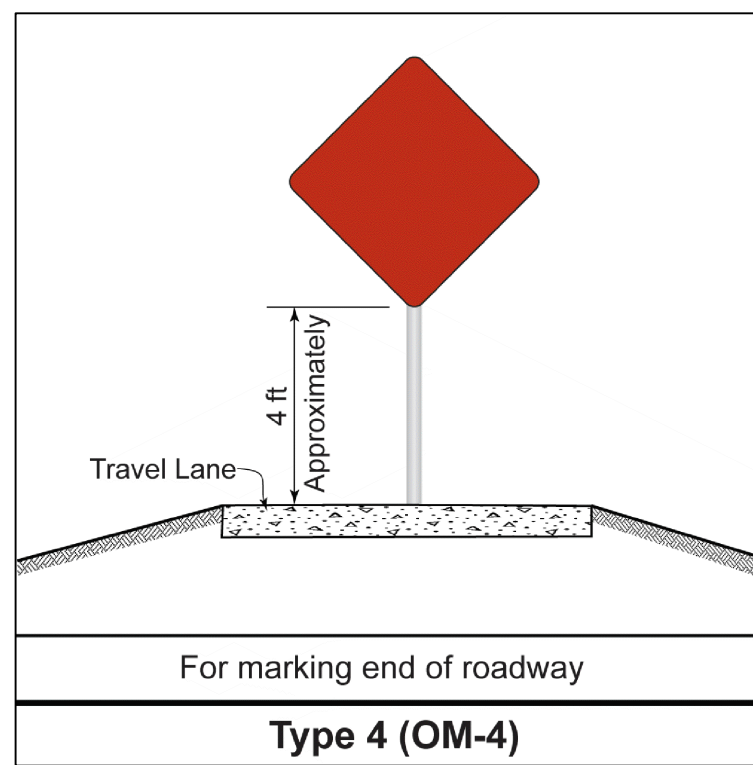

OM4-3
18" X 18"
DETAIL

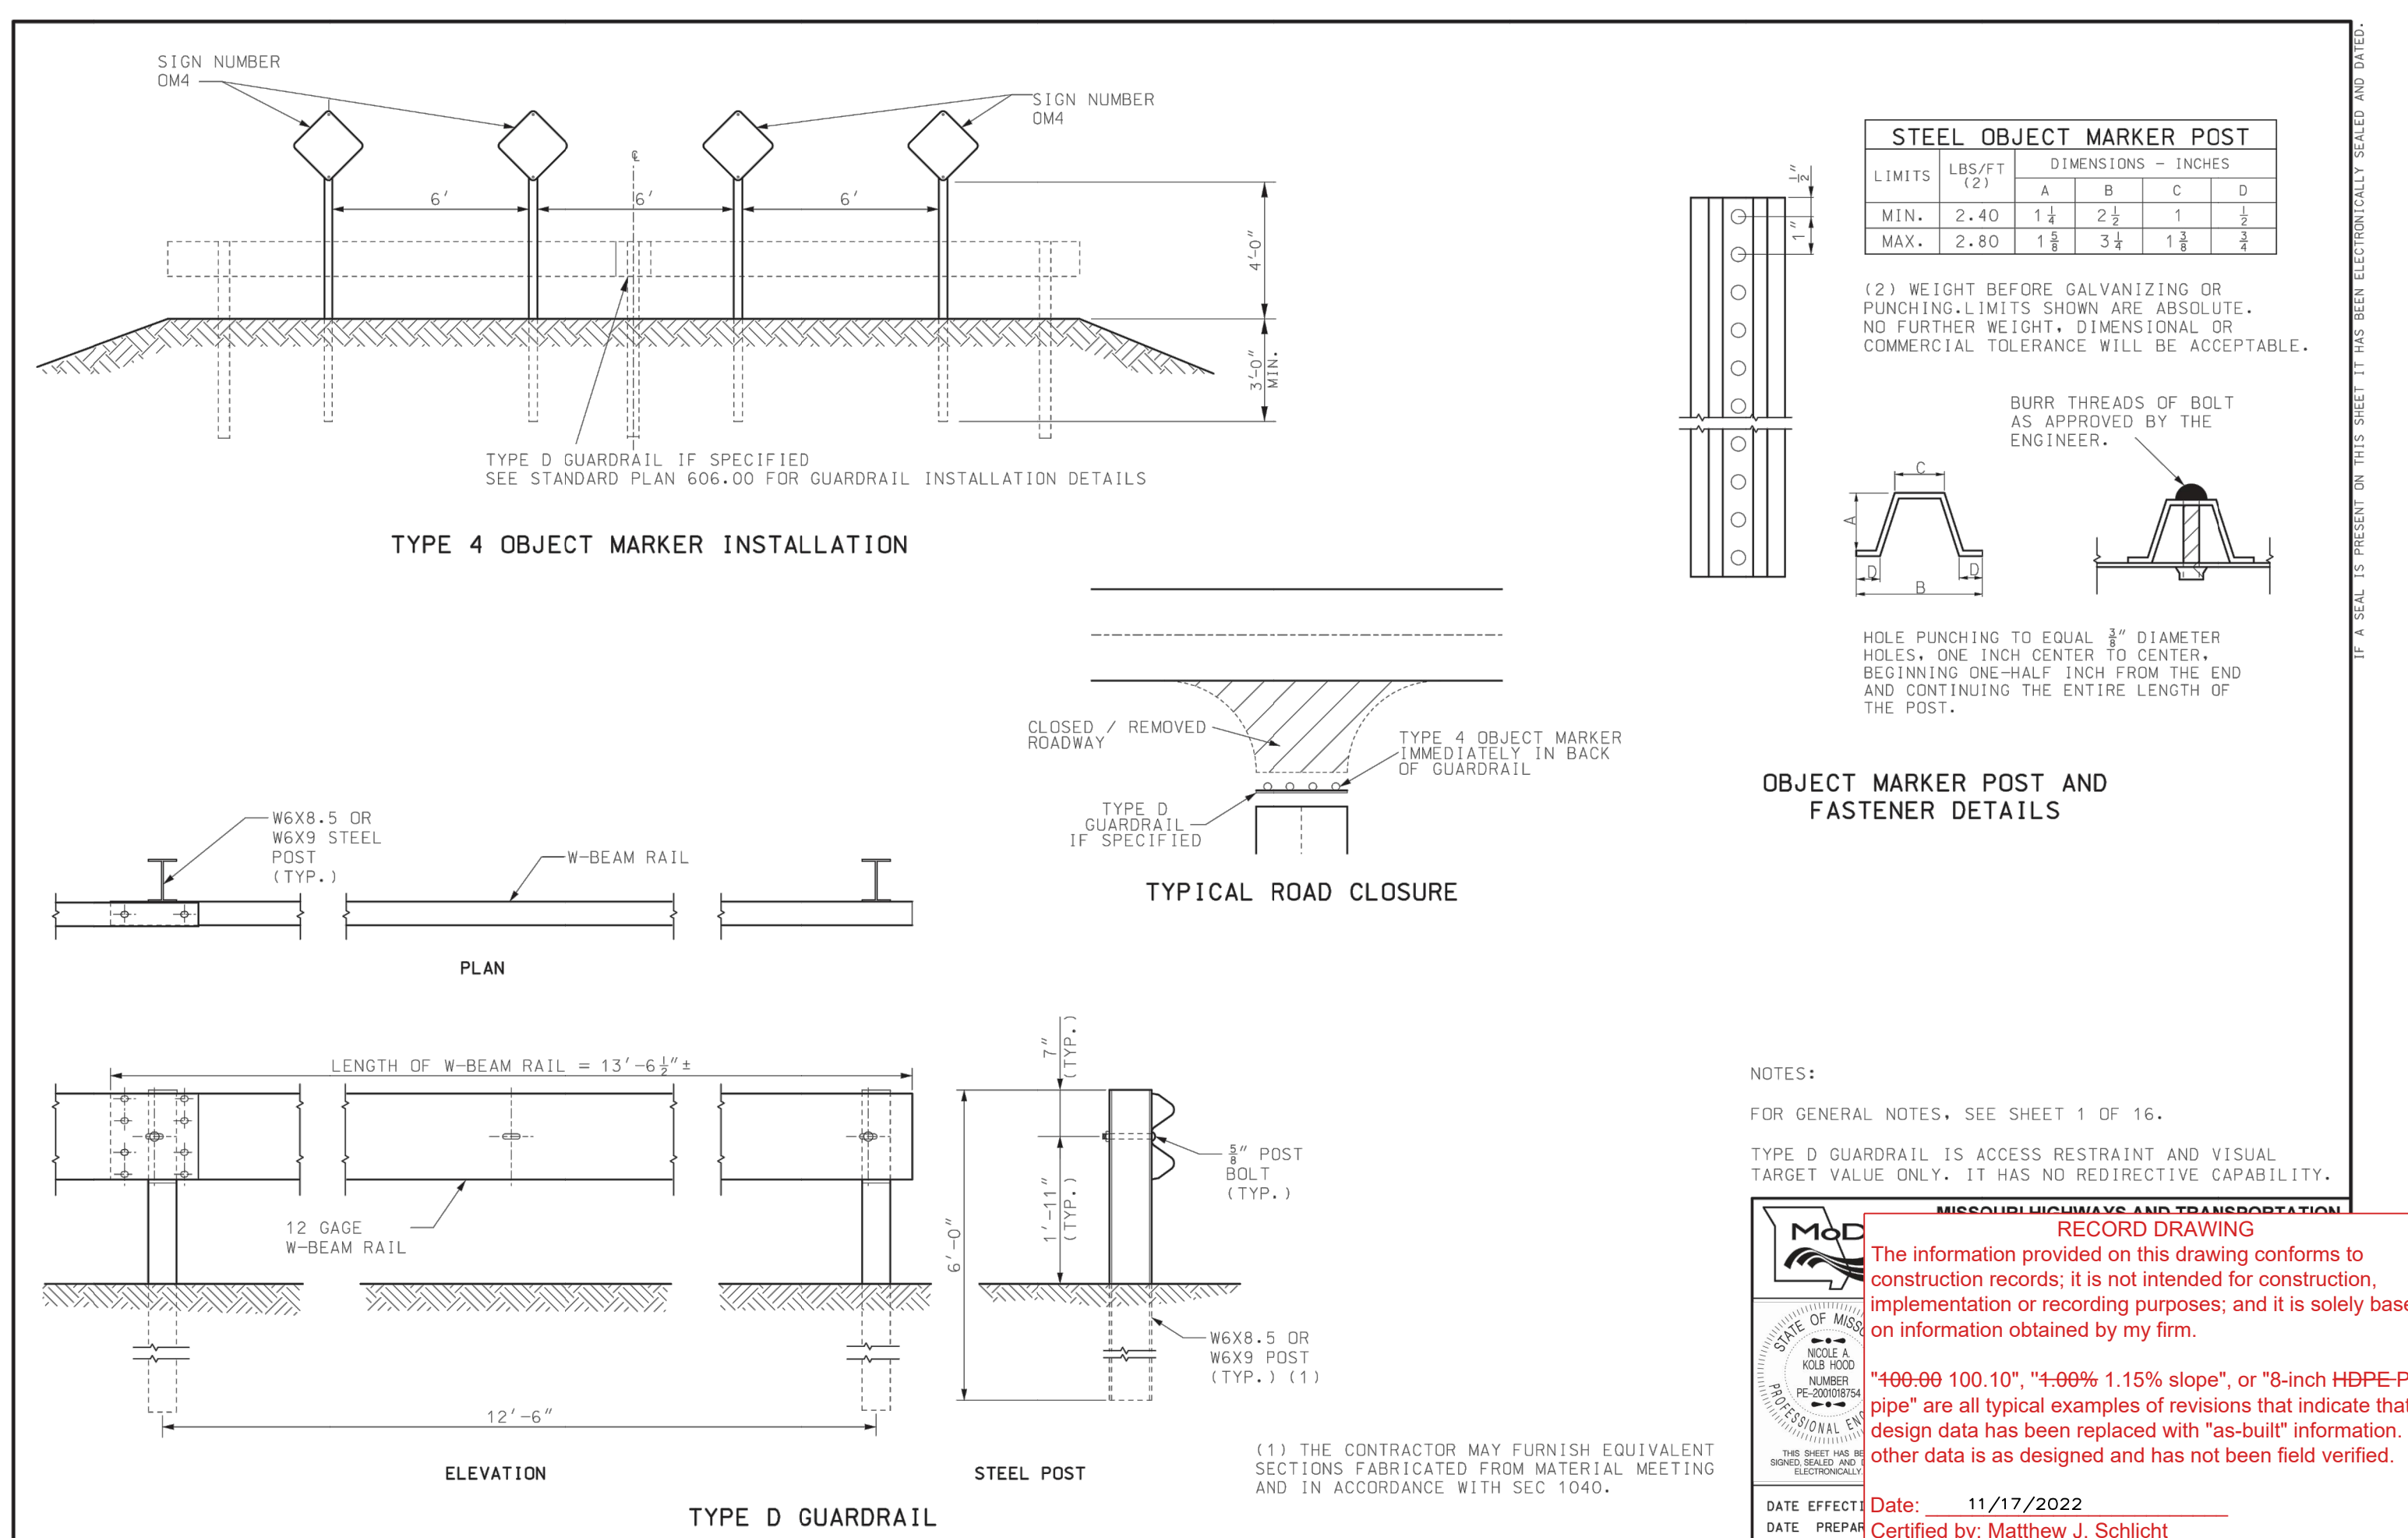

STEEL OBJECT MARKER POST		DIMENSIONS - INCHES			
LIMITS	LBS/FT (2)	A	B	C	D
MIN.	2.40	1 1/2	2 1/2	1	1 1/2
MAX.	2.80	1 3/4	3 1/2	1 1/2	2

(2) WEIGHT BEFORE GALVANIZING OR PUNCHING LIMITS SHOWN ARE ABSOLUTE. NO FURTHER WEIGHT, DIMENSIONAL OR COMMERCIAL TOLERANCE WILL BE ACCEPTABLE.

BURR THREADS OF BOLT AS APPROVED BY THE ENGINEER.

HOLE PUNCHING TO EQUAL 3/8" DIAMETER HOLES, ONE INCH CENTER TO CENTER, BEGINNING ONE-HALF INCH FROM THE END AND CONTINUING THE ENTIRE LENGTH OF THE POST.

OBJECT MARKER POST AND FASTENER DETAILS

NOTES:

FOR GENERAL NOTES, SEE SHEET 1 OF 16.

TYPE D GUARDRAIL IS ACCESS RESTRAINT AND VISUAL TARGET VALUE ONLY. IT HAS NO REDIRECTIVE CAPABILITY.

RECORD DRAWING
The information provided on this drawing conforms to construction records; it is not intended for construction, implementation or recording purposes; and it is solely based on information obtained by my firm.

"400-00 100.10" "4-00% 1.15% slope", or "8-inch HDPE-PVC pipe" are all typical examples of revisions that indicate that design data has been replaced with "as-built" information. All other data is as designed and has not been field verified.

DATE EFFECTS: 11/17/2022

Certified by: Matthew J. Schlicht

Title: Engineer


Firm: Engineering Solutions

Professional Registration
Missouri
Engineering 2005002186-D
Surveying 2005008319-D
Kansas
Engineering E-1685
Surveying LS-218
Oklahoma
Engineering 6254
Nebraska
Engineering CA2821

THE TOWNHOMES OF CHAPEL RIDGE-2ND PLAT
LOTS 9-19 & TRACTS A-D
Lee's Summit, Jackson County, Missouri

Project:
VILLAS OF CHAPEL
RIDGE-LSMO
Issue Date:
April 10, 2020


Street Signage Plan
Construction Plans for:
THE TOWNHOMES OF CHAPEL RIDGE-2ND PLAT
LOTS 9-19 & TRACTS A-D
Lee's Summit, Jackson County, Missouri

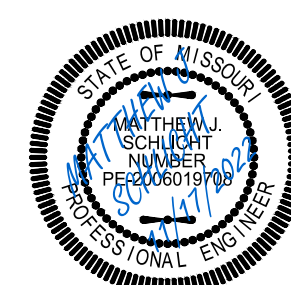

Matthew J. Schlicht
MO PE 2006019708
KS PE 19071
OK PE 25226
NE PE E-14335

REVISIONS

6/25/2021 As-Built
8/18/2021 As-Built
8/31/2021 As-Built
9/9/2021 As-Built
11/17/2022 As-Built

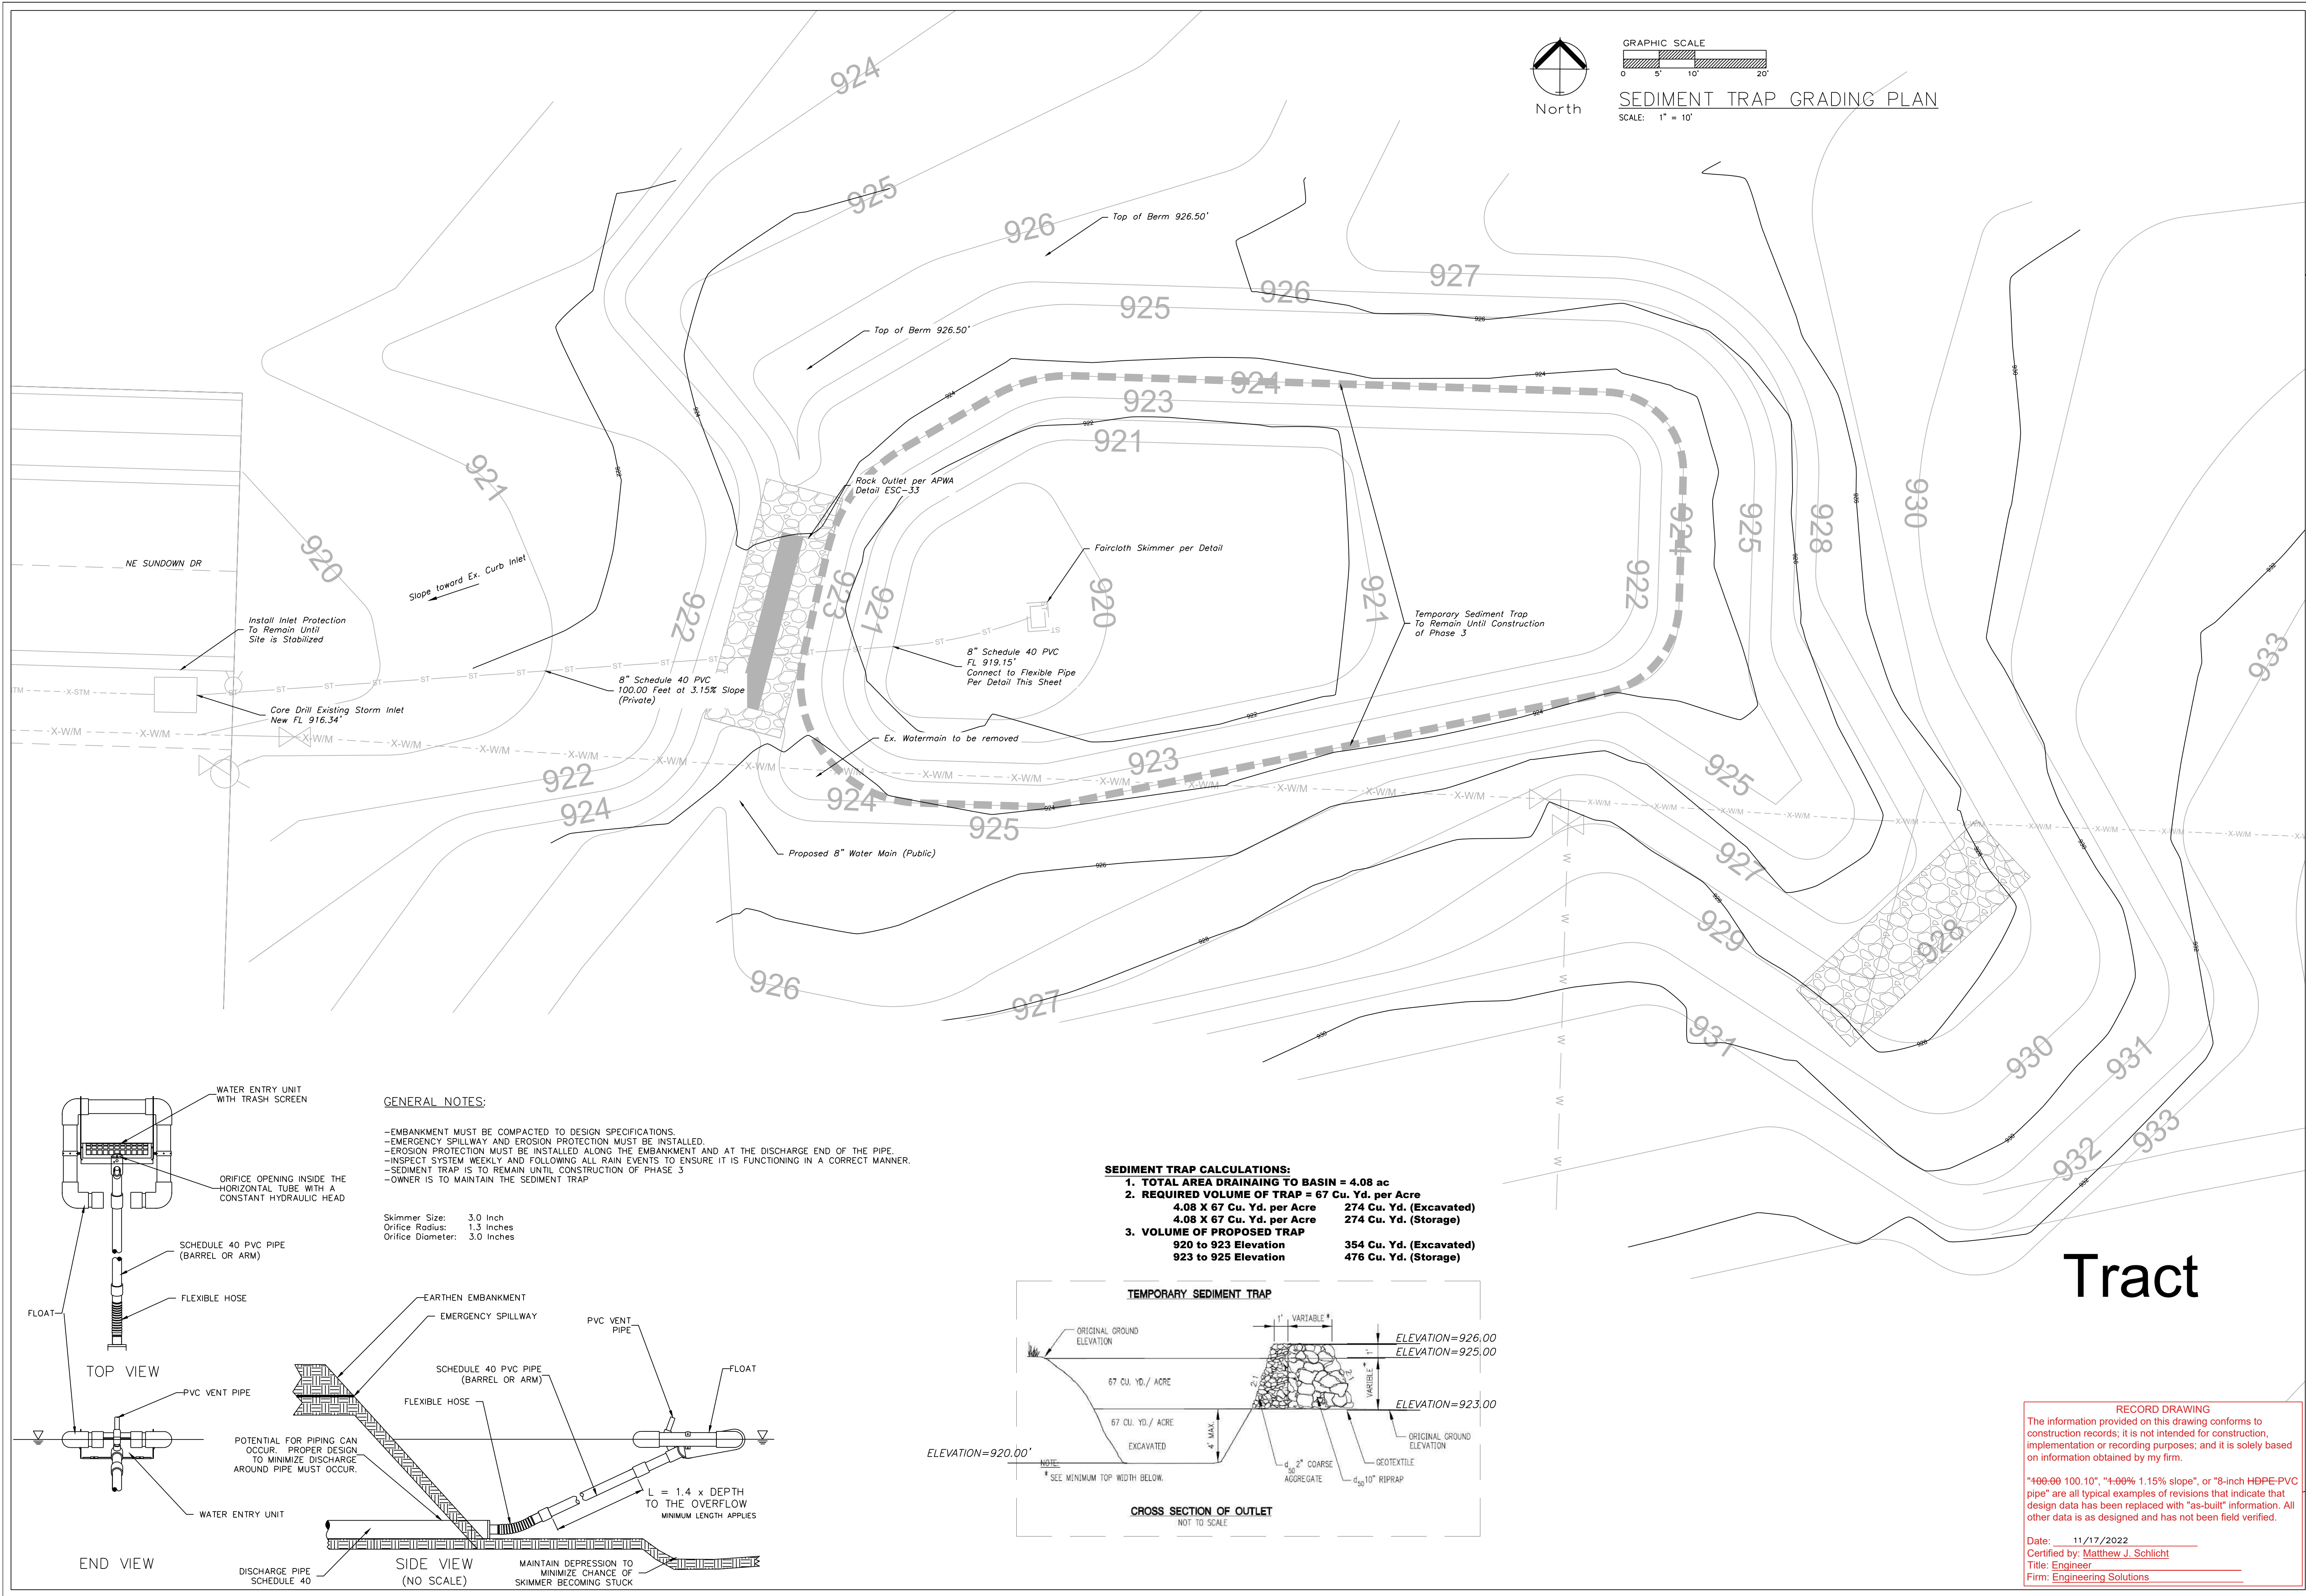

ENGINEERING SOLUTIONS
ENGINEERING & SURVEYING
50 SE 30TH STREET
LEE'S SUMMIT, MO 64082
P: (816) 623-9888 F: (816) 623-9849

Professional Registration
Missouri
Engineering 2005002186-D
Surveying 2005008319-D
Kansas
Engineering E-1685
Surveying LS-218
Oklahoma
Engineering 6254
Nebraska
Engineering CA2821

THE TOWNHOMES OF CHAPEL RIDGE-2ND PLAT
LOTS 9-19 & TRACTS A-D
Lee's Summit, Jackson County, Missouri

Project: VILLAS OF CHAPEL RIDGE LS100
Issue Date: April 10, 2020

Sediment Trap
Grading Plan
Construction Plans for:
THE TOWNHOMES OF CHAPEL RIDGE-2ND PLAT
LOTS 9-19 & TRACTS A-D
Lee's Summit, Jackson County, Missouri

STATE OF MISSOURI
MATTHEW J. SCHLICHT
REGISTERED PROFESSIONAL ENGINEER
NO. 000000017
EXPIRATION DATE 08/31/2025

Matthew J. Schlicht
MO PE 2006019708
KS PE 19071
OK PE 25226
NE PE E-14335

REVISIONS

6/25/2021	As-Built
8/18/2021	As-Built
8/31/2021	As-Built
9/9/2021	As-Built
11/17/2022	As-Built



C. 206


RECORD DRAWING

The information provided on this drawing conforms to construction records; it is not intended for construction, implementation or recording purposes; and it is solely based on information obtained by my firm.



"100-00 100.10", "4-00% 1.15% slope", or "8-inch HDPE-PVC pipe" are all typical examples of revisions that indicate that design data has been replaced with "as-built" information. All other data is as designed and has not been field verified.

Date: 11/17/2022
Certified by: Matthew J. Schlicht
Title: Engineer
Firm: Engineering Solutions

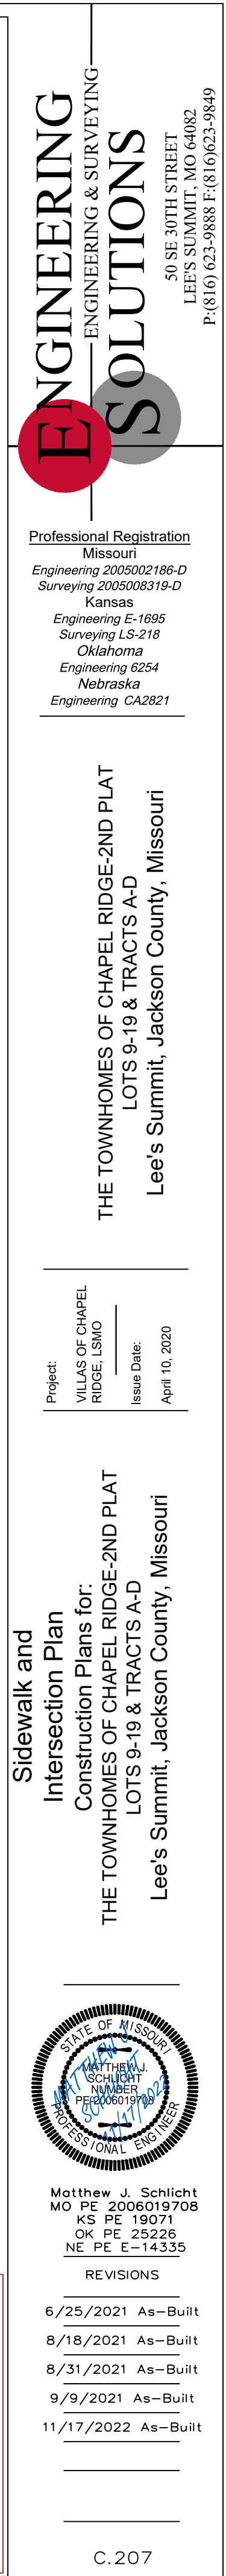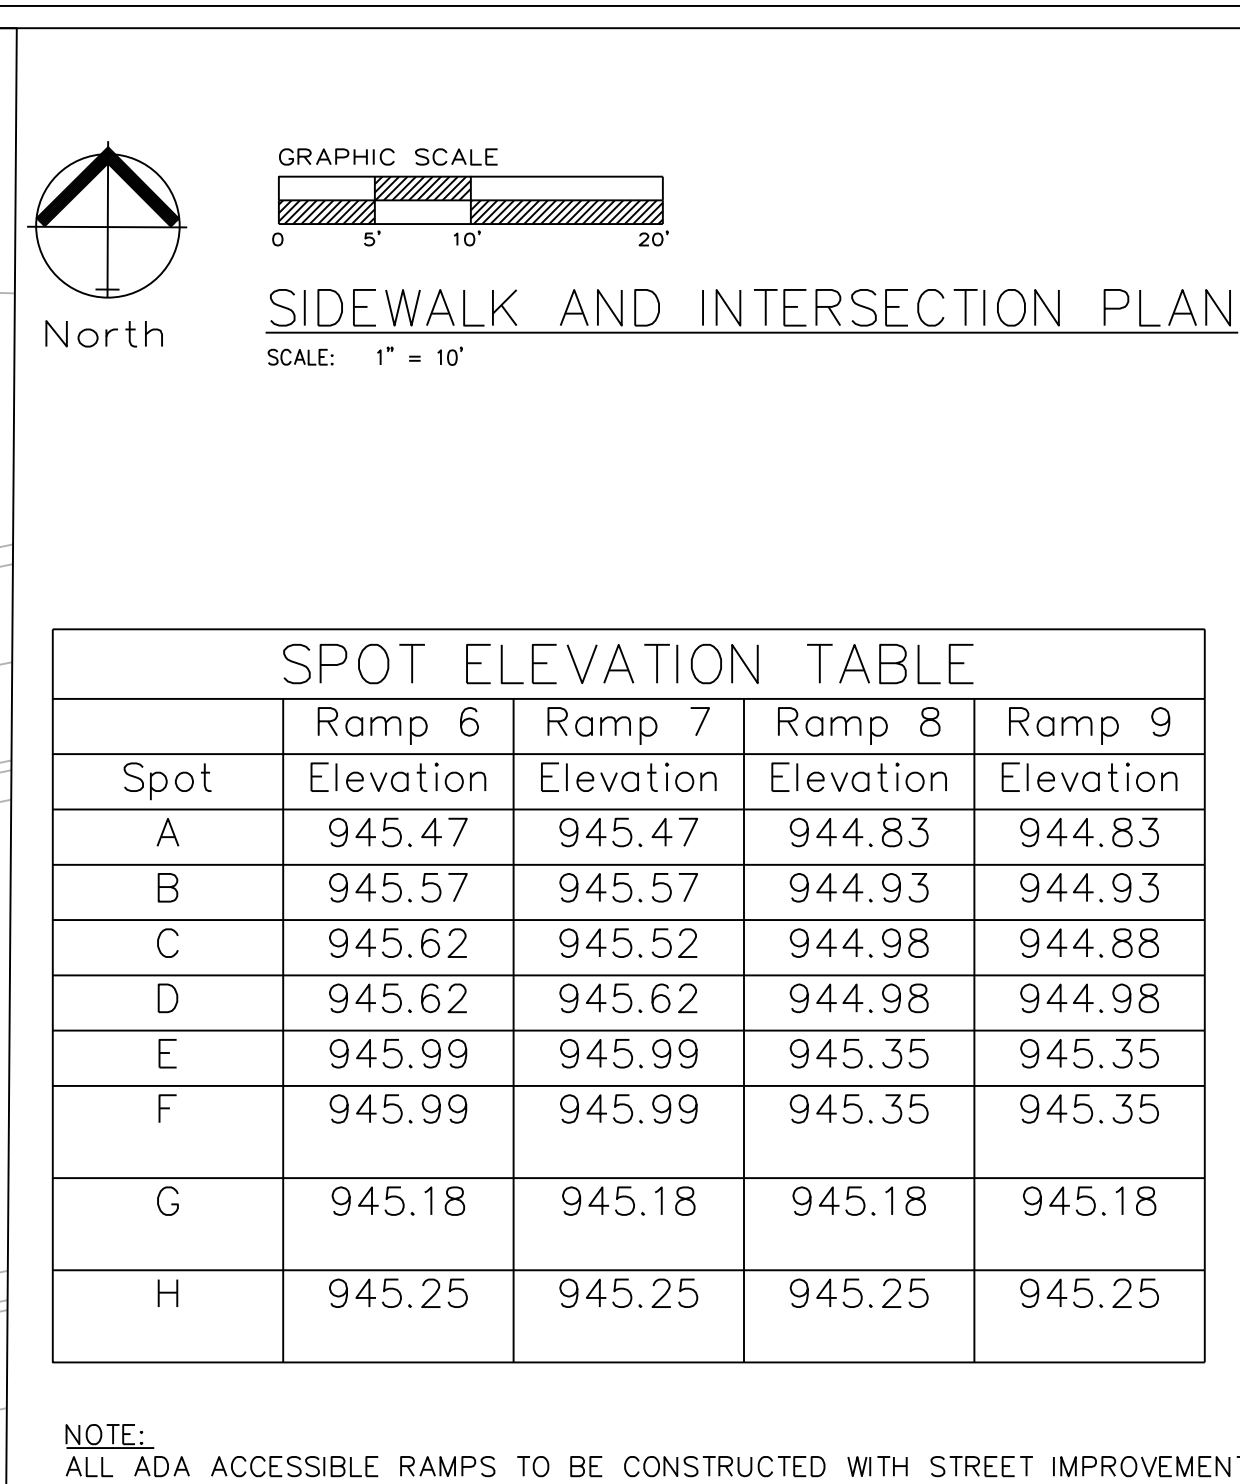

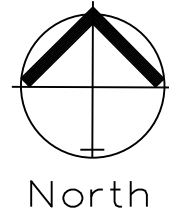

DETENTION BASIN PLAN
SCALE: 1" = 20'

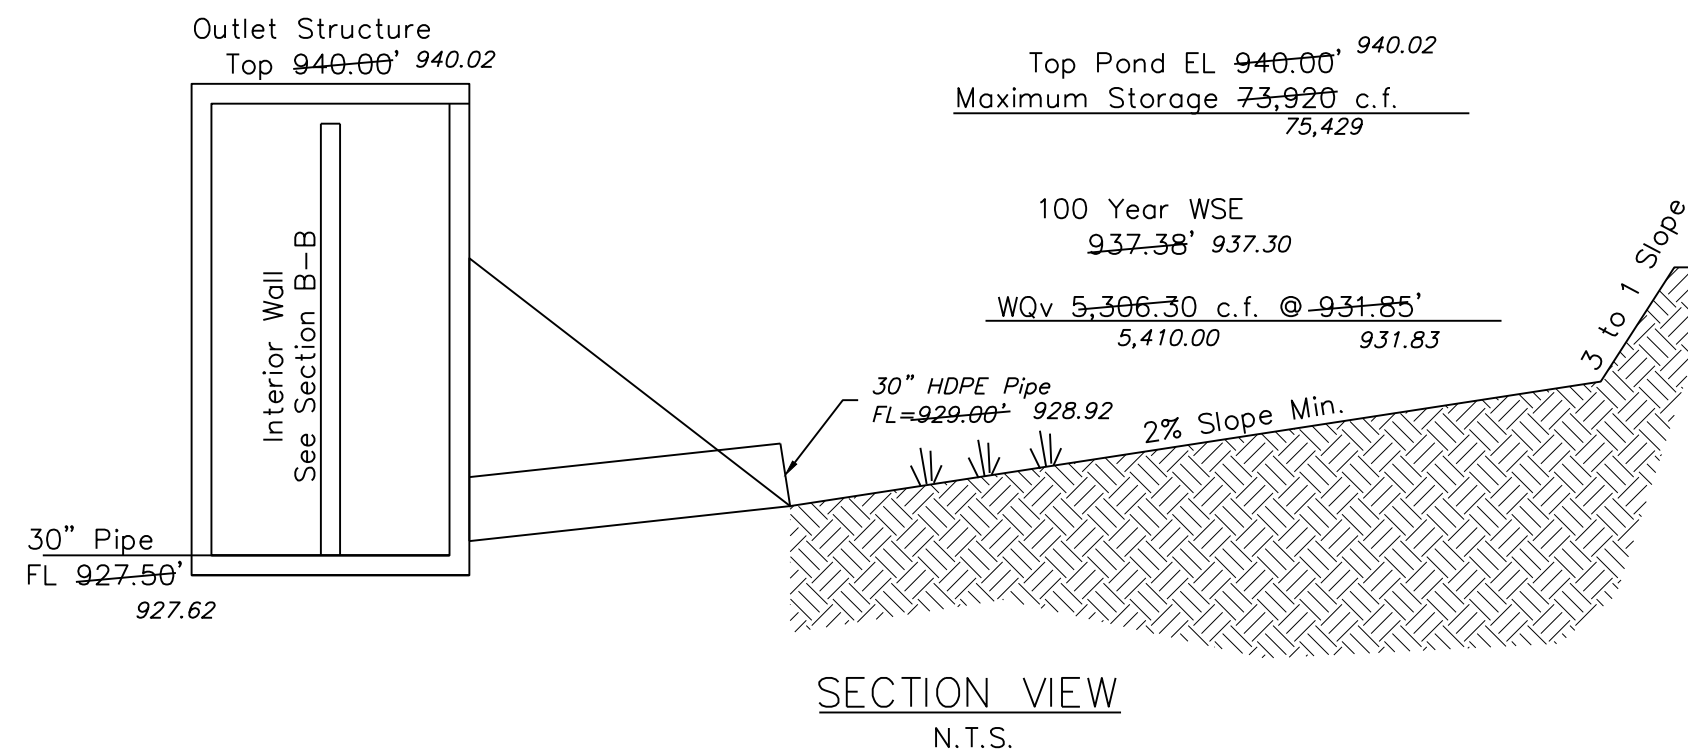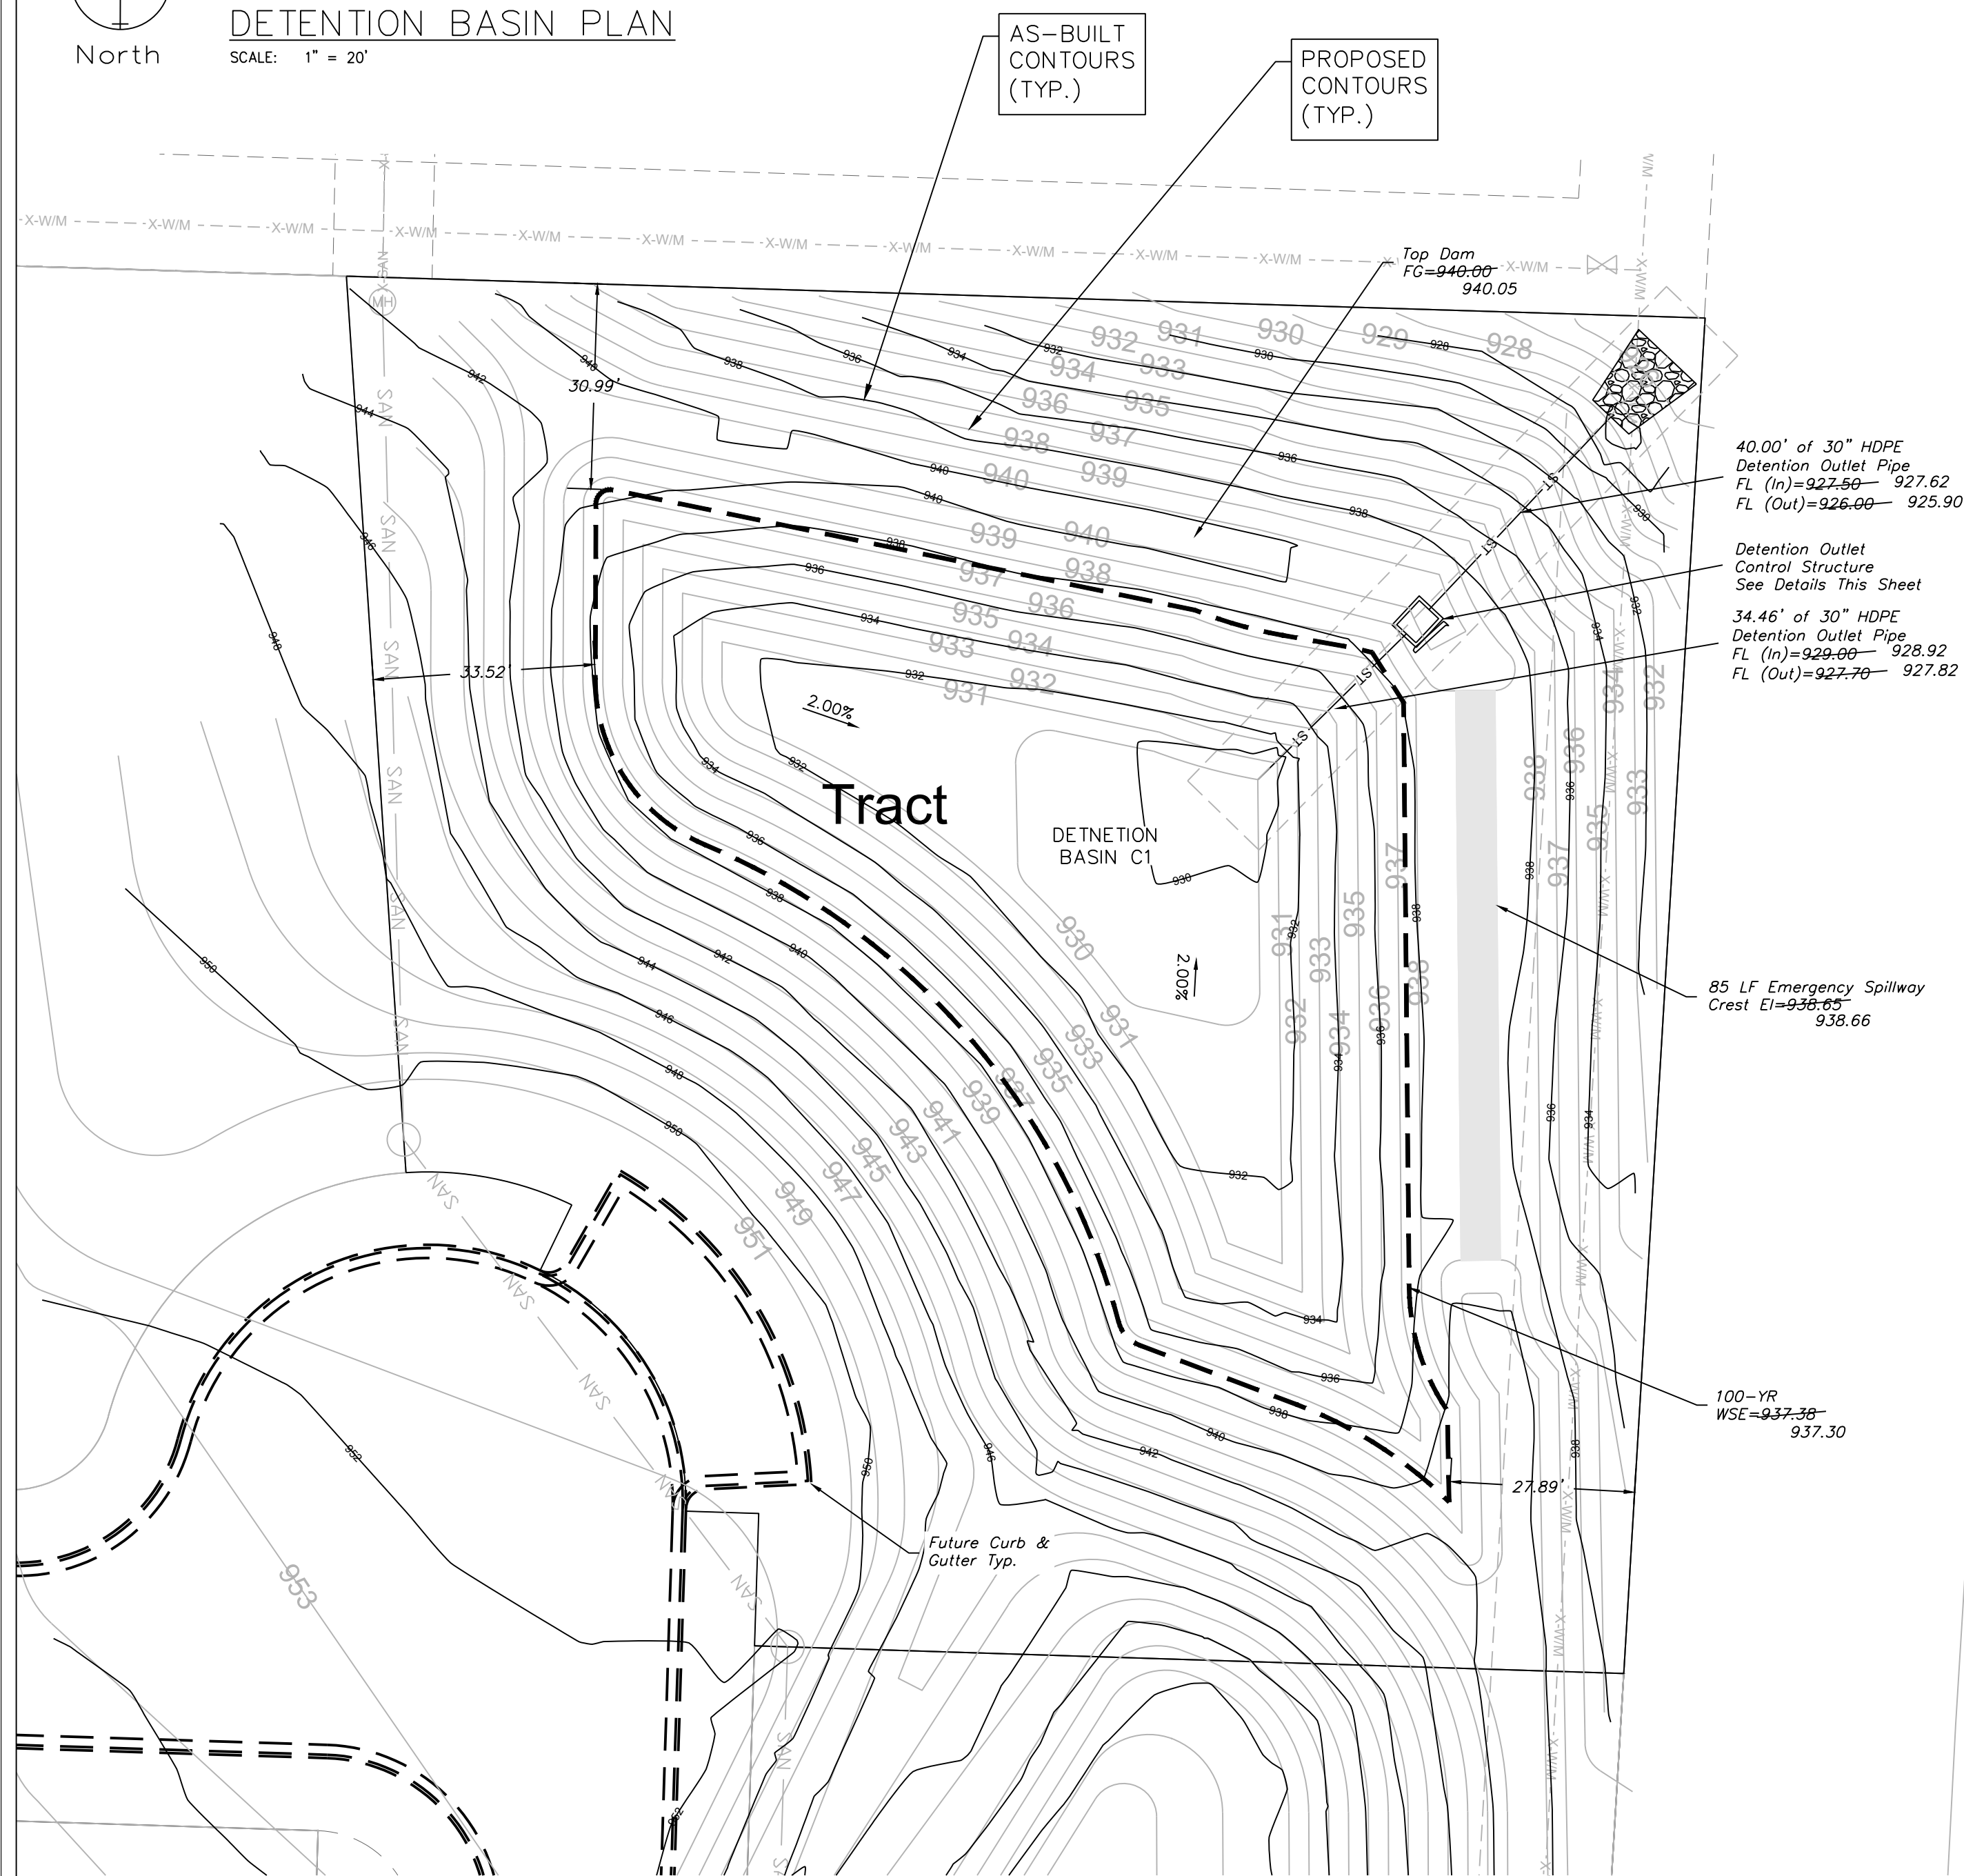


GENERAL NOTES:

1. Locate ring and cover over outlet.
2. All work and materials shall conform to APWA Sect. 2600.
3. Use 3/4" chamfer strip on all exposed concrete corners.
4. Steps required @ 16" O.C. when depth from top of casting to invert exceeds 4 feet.
5. Boxouts will not be allowed to project through the corners of the structure.
6. The minimum reinforcing shall be 1 H-bar over a cast-in place pipe and 2 H-bars over a precast boxout.
7. Limit opening height to 6" with No. 5 galvanized bars extending to corner rebars.
9. Show field inlet orientation on plans plus number and size of opening.
10. O.R. = one half outside pipe diameter (O.D.).
11. 4" Ø field tile or precast hole shall be located at entering pipe and in the front face sump points. These tiles or openings shall be capped with 1/4" galvanized wire mesh on the outside of the inlet and clear the invert and base concrete.
12. Location of the Manhole shall be located along the Northeast side of the structure.

REINFORCING


BARS	SIZE	SPACING (IN.)
H	4	12
V	4	12
L	5	6
W	5	6

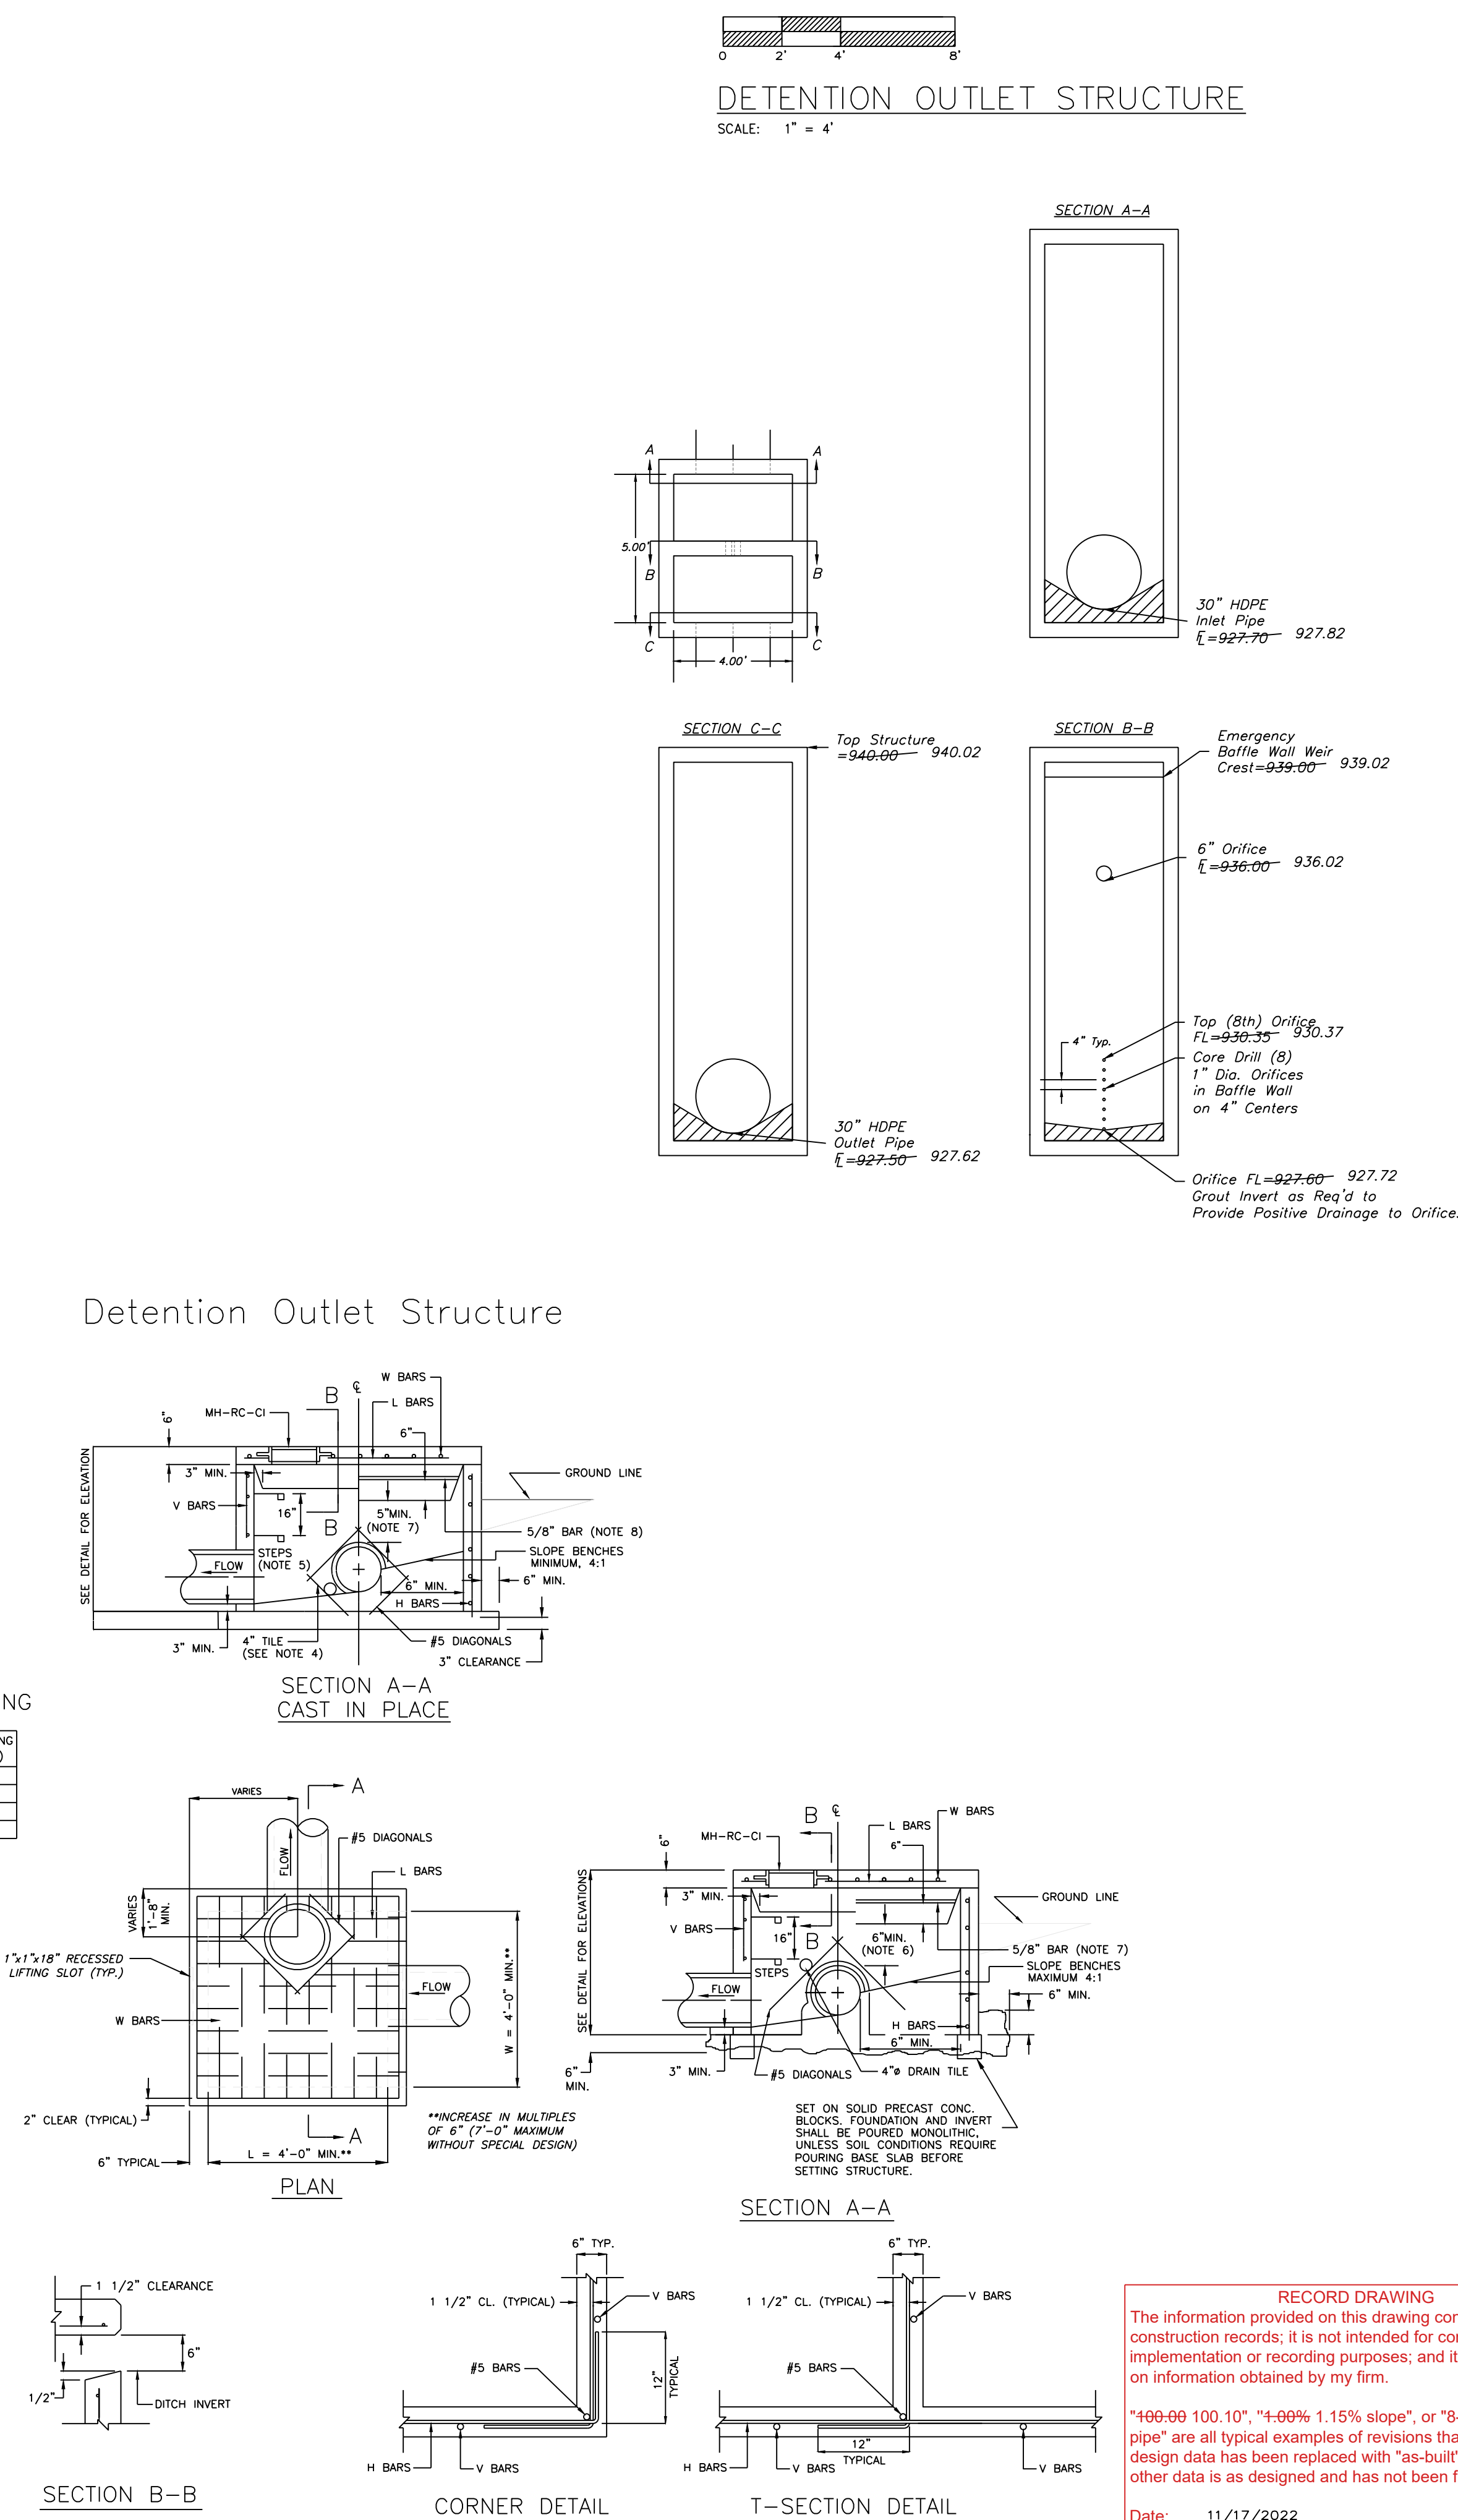

RECORD DRAWING
The information provided on this drawing conforms to construction records; it is not intended for construction, implementation or recording purposes; and it is solely based on information obtained by my firm.



"100-00 100.10", "4-00% 1.15% slope", or "8-inch HDPE-PVC pipe" are all typical examples of revisions that indicate that design data has been replaced with "as-built" information. All other data is as designed and has not been field verified.

Date: 11/17/2022
Certified by: Matthew J. Schlicht
Title: Engineer
Firm: Engineering Solutions

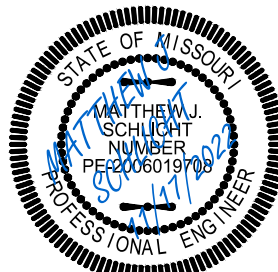


Matthew J. Schlicht
MO PE 2006019708
KS PE 19071
OK PE 25226
NE PE E-14335

REVISIONS
6/25/2021 As-Built
8/18/2021 As-Built
8/31/2021 As-Built
9/9/2021 As-Built
11/17/2022 As-Built

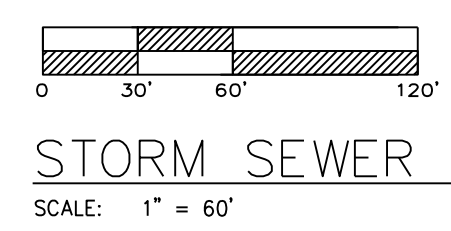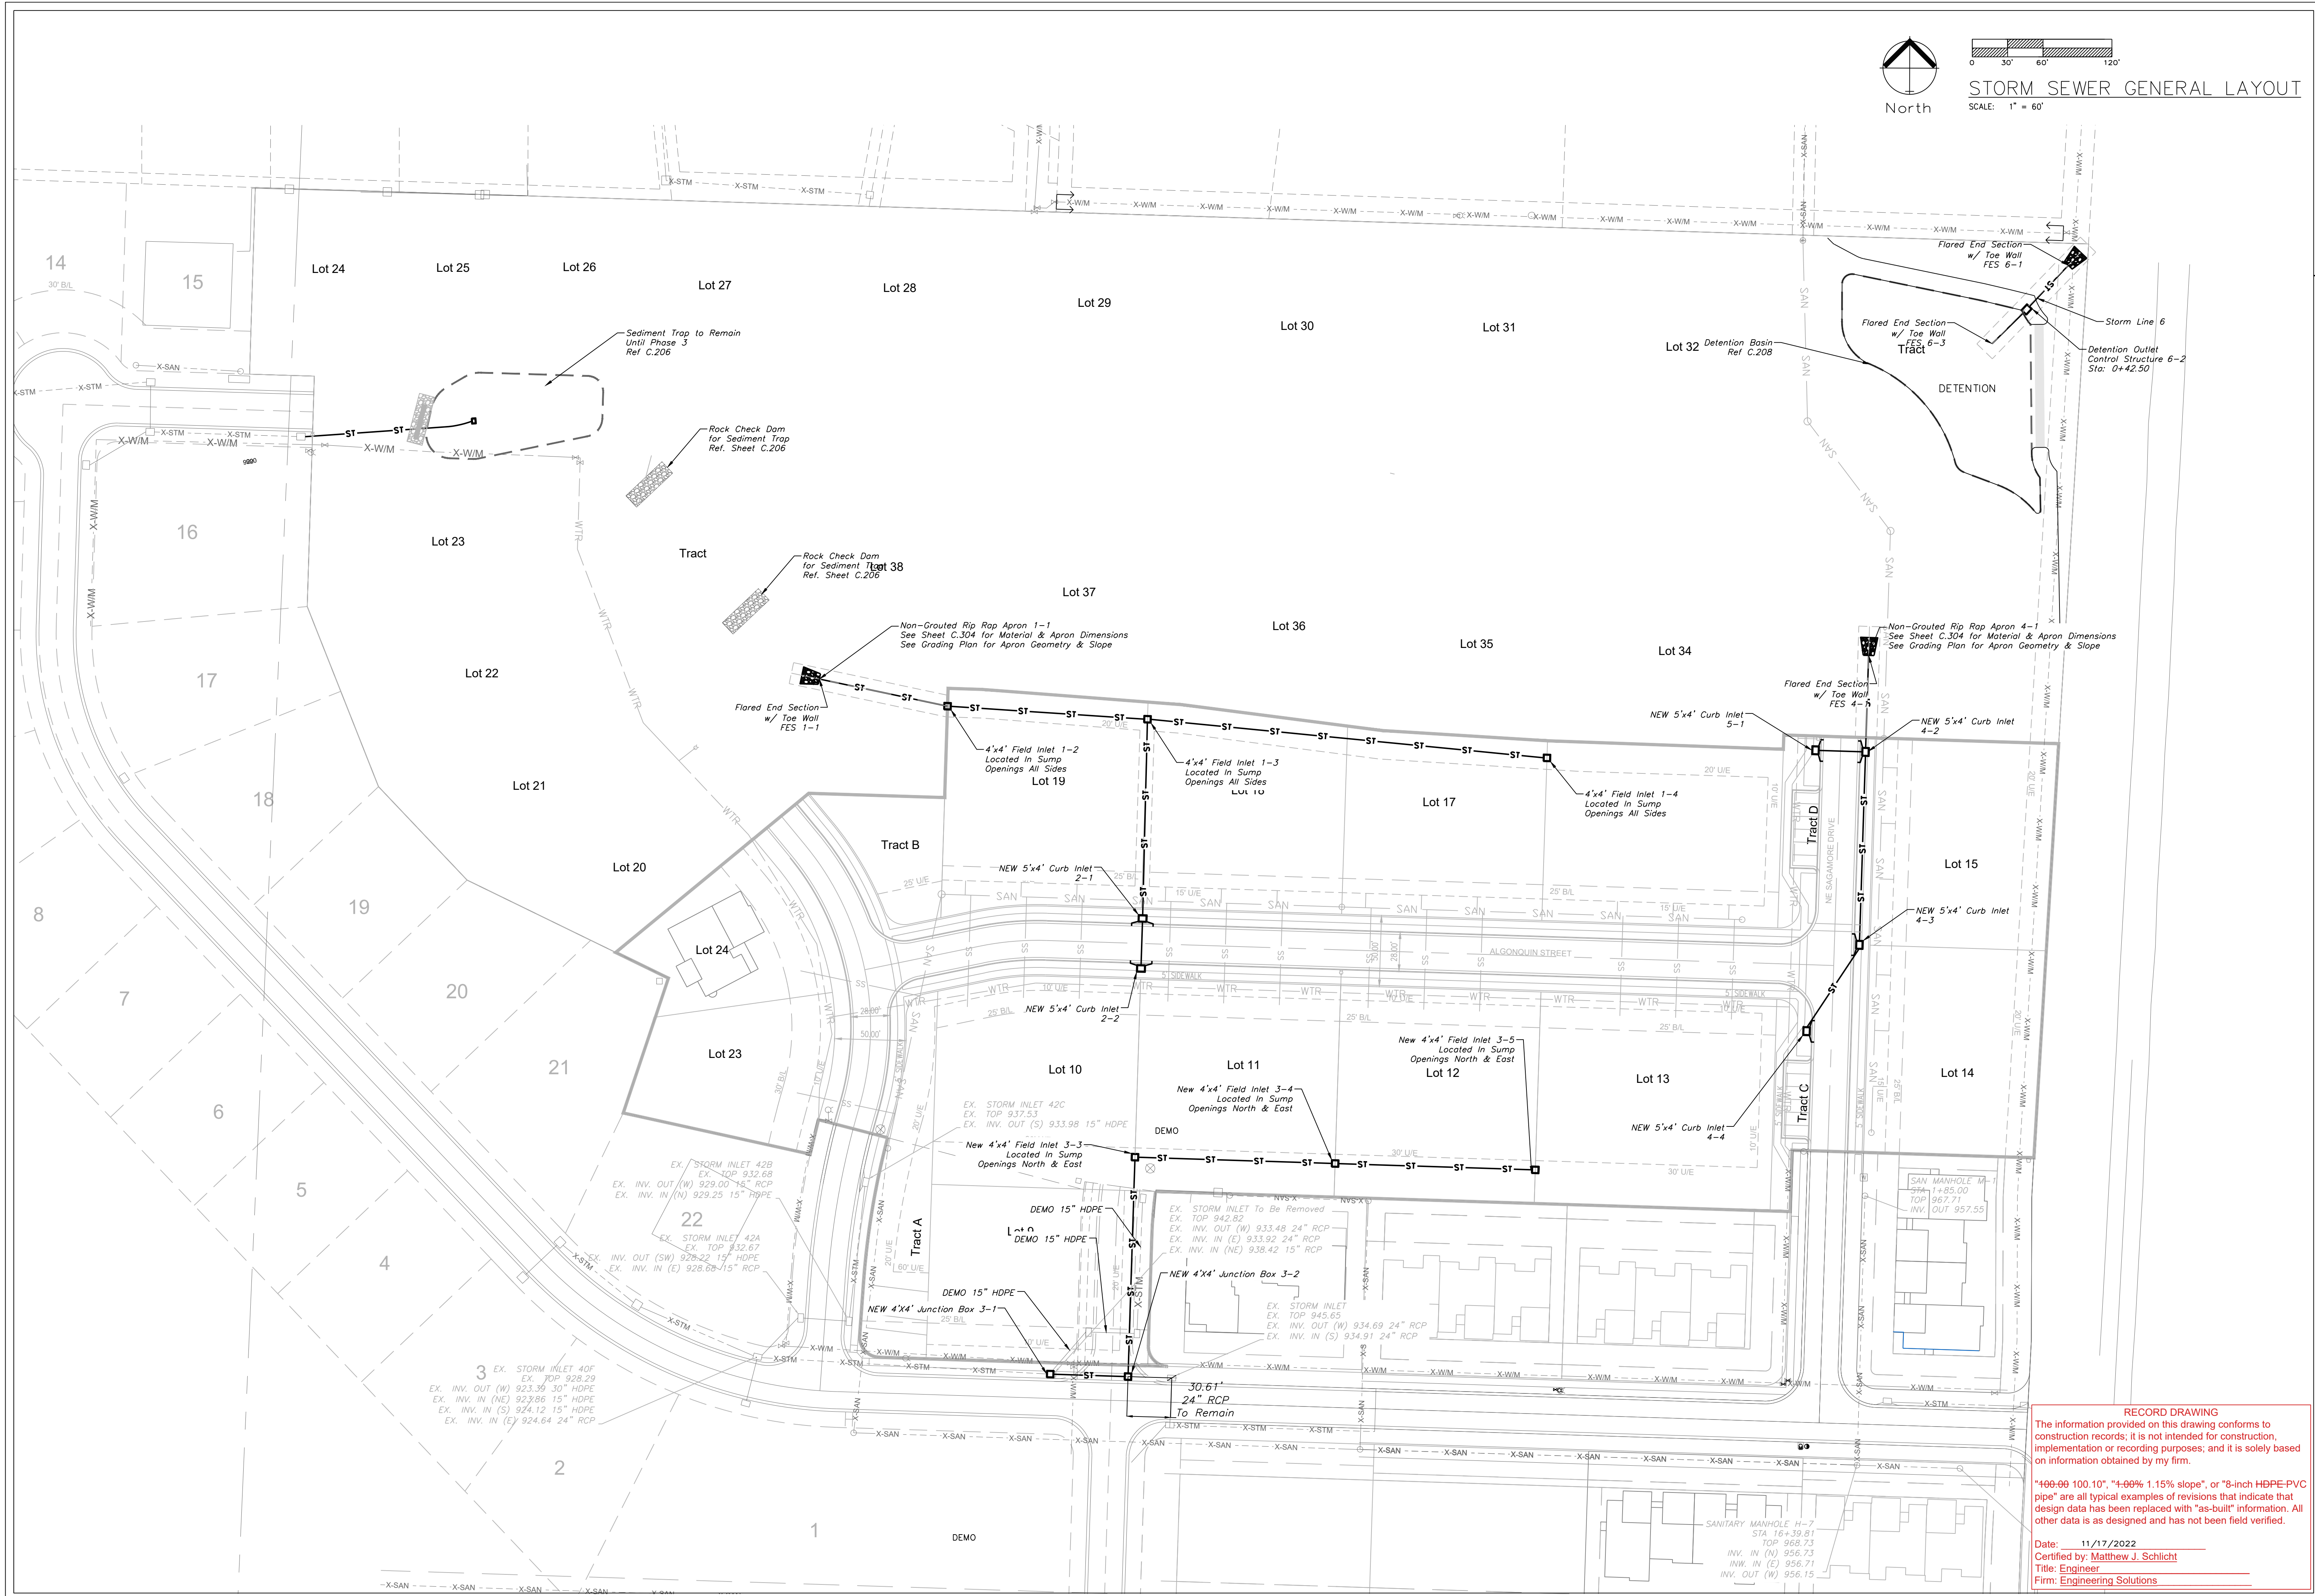

STORM SEWER GENERAL LAYOUT

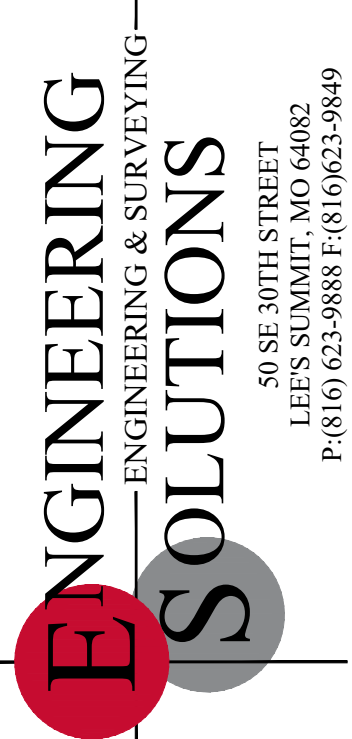


Professional Registration
Missouri
Engineering 2005002186-D
Surveying 2005008319-D
Kansas
Engineering E-1695
Surveying LS-218
Oklahoma
Engineering 6254
Nebraska
Engineering CA2821

THE TOWNHOMES OF CHAPEL RIDGE-2ND PLAT
LOTS 9-19 & TRACTS A-D
Lee's Summit, Jackson County, Missouri

Project:
VILLAS OF CHAPEL
RIDGE LS MO
Issue Date:
April 10, 2020

Storm Sewer General Layout
Construction Plans for:
THE TOWNHOMES OF CHAPEL RIDGE-2ND PLAT
LOTS 9-19 & TRACTS A-D
Lee's Summit, Jackson County, Missouri

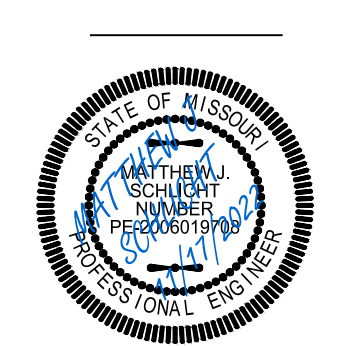





Matthew J. Schlicht
MO PE 2006019708
KS PE 19071
OK PE 25226
NE PE E-114335



REVISIONS	
6/25/2021	As-Built
8/18/2021	As-Built
8/31/2021	As-Built
9/9/2021	As-Built
11/17/2022	As-Built

RECORD DRAWING
The information provided on this drawing conforms to construction records; it is not intended for construction, implementation or recording purposes; and it is solely based on information obtained by my firm.

"400-00 100.10", "4-00% 1.15% slope", or "8-inch HDPE-PVC pipe" are all typical examples of revisions that indicate that design data has been replaced with "as-built" information. All other data is as designed and has not been field verified.


Date: 11/17/2022
Certified by: Matthew J. Schlicht
Title: Engineer
Firm: Engineering Solutions

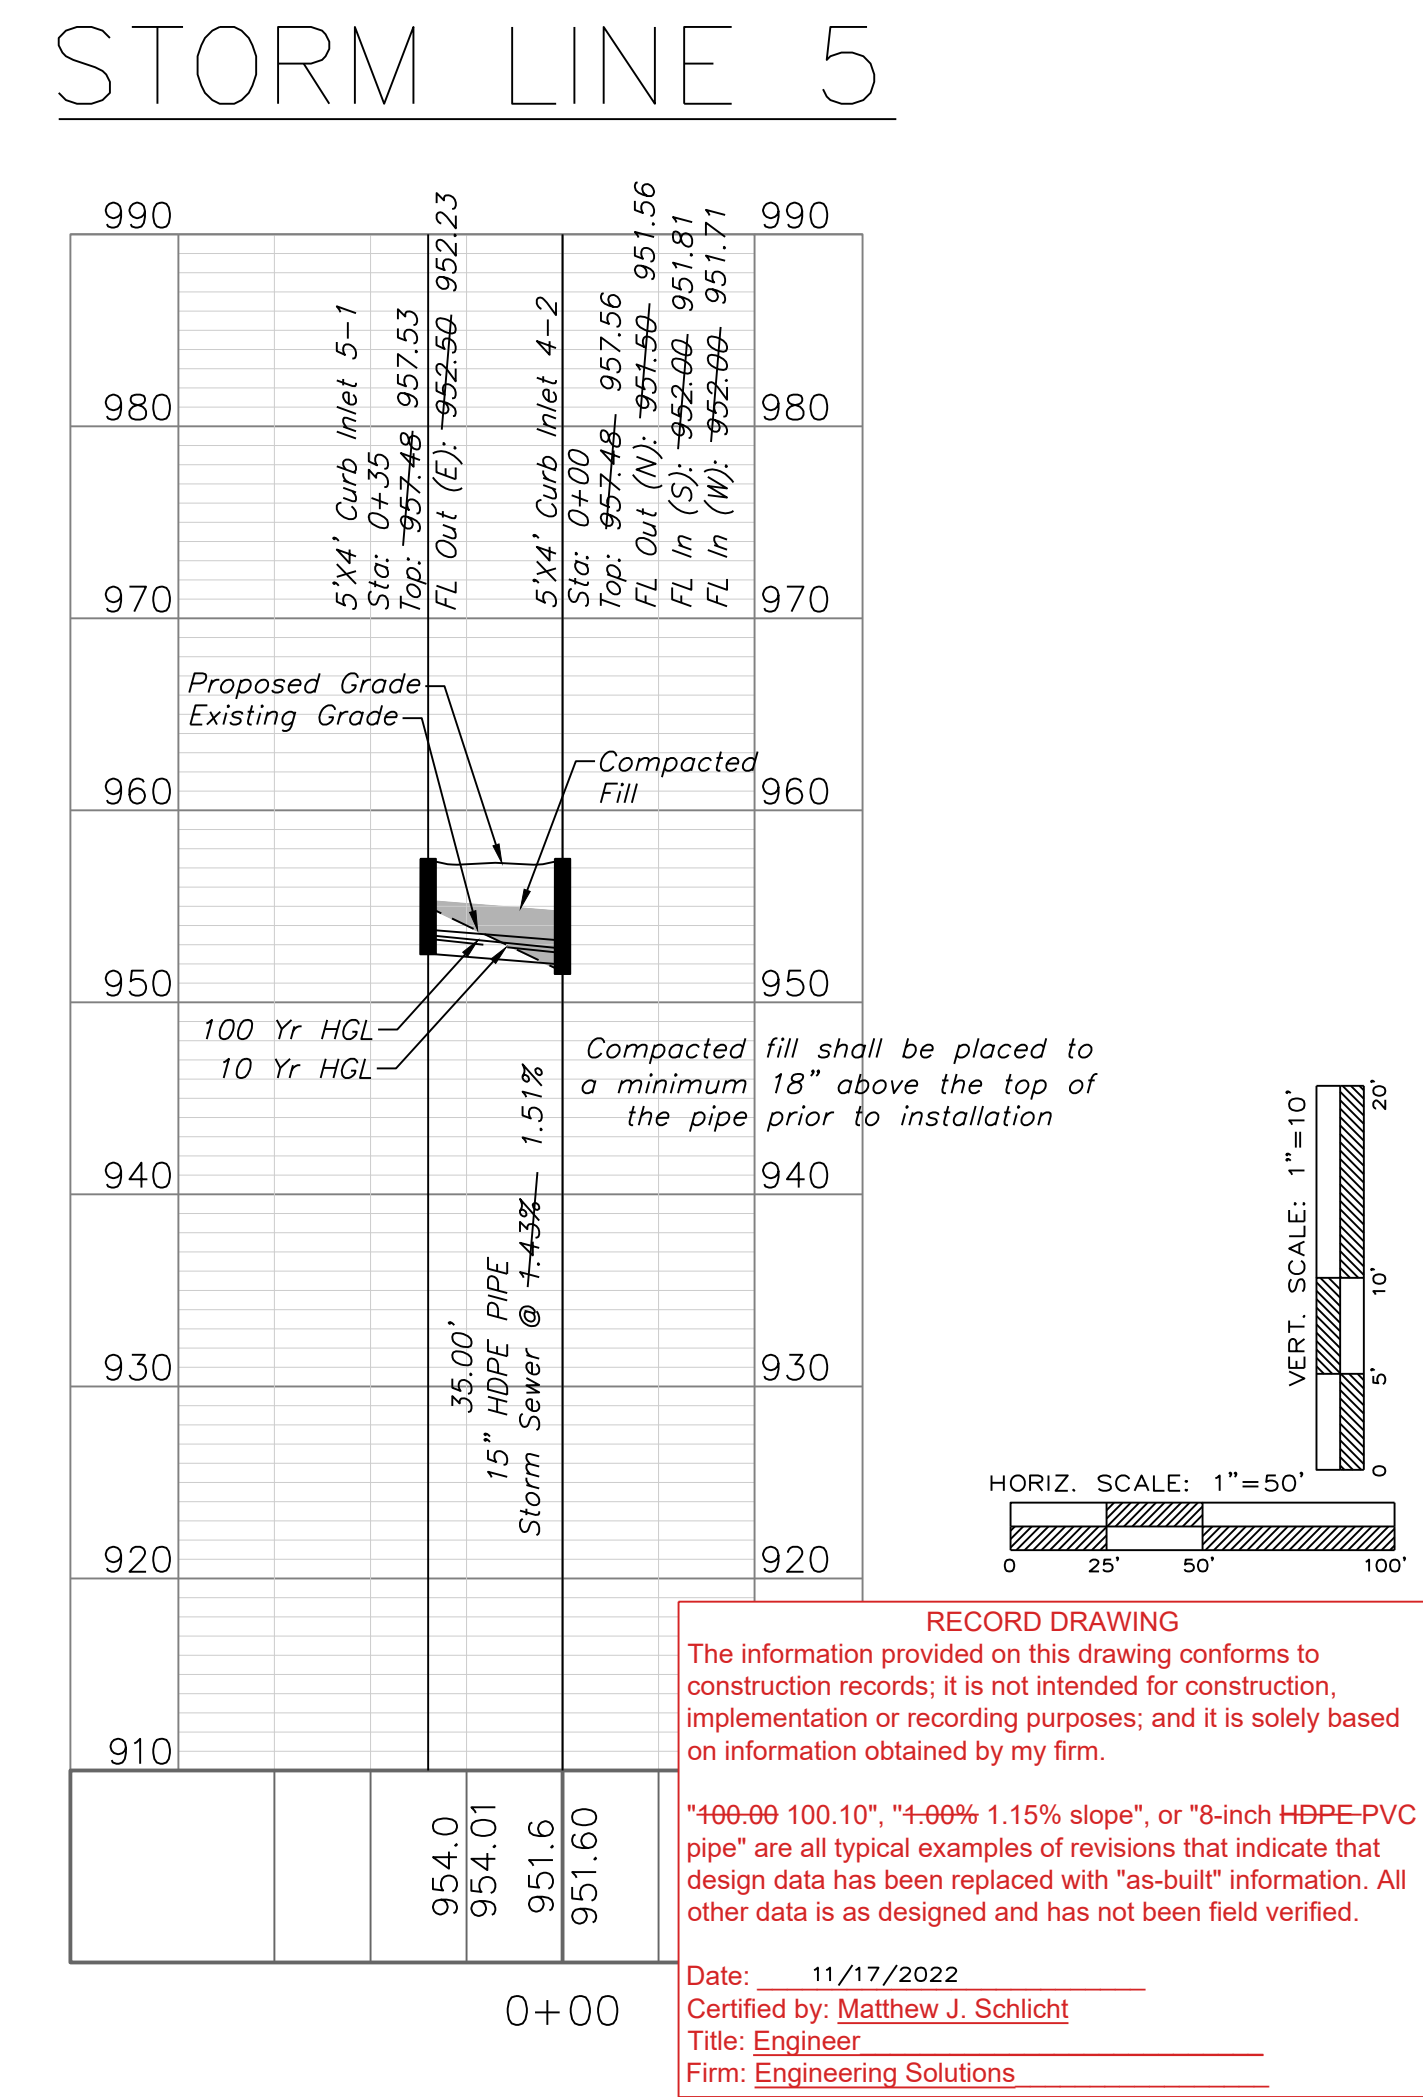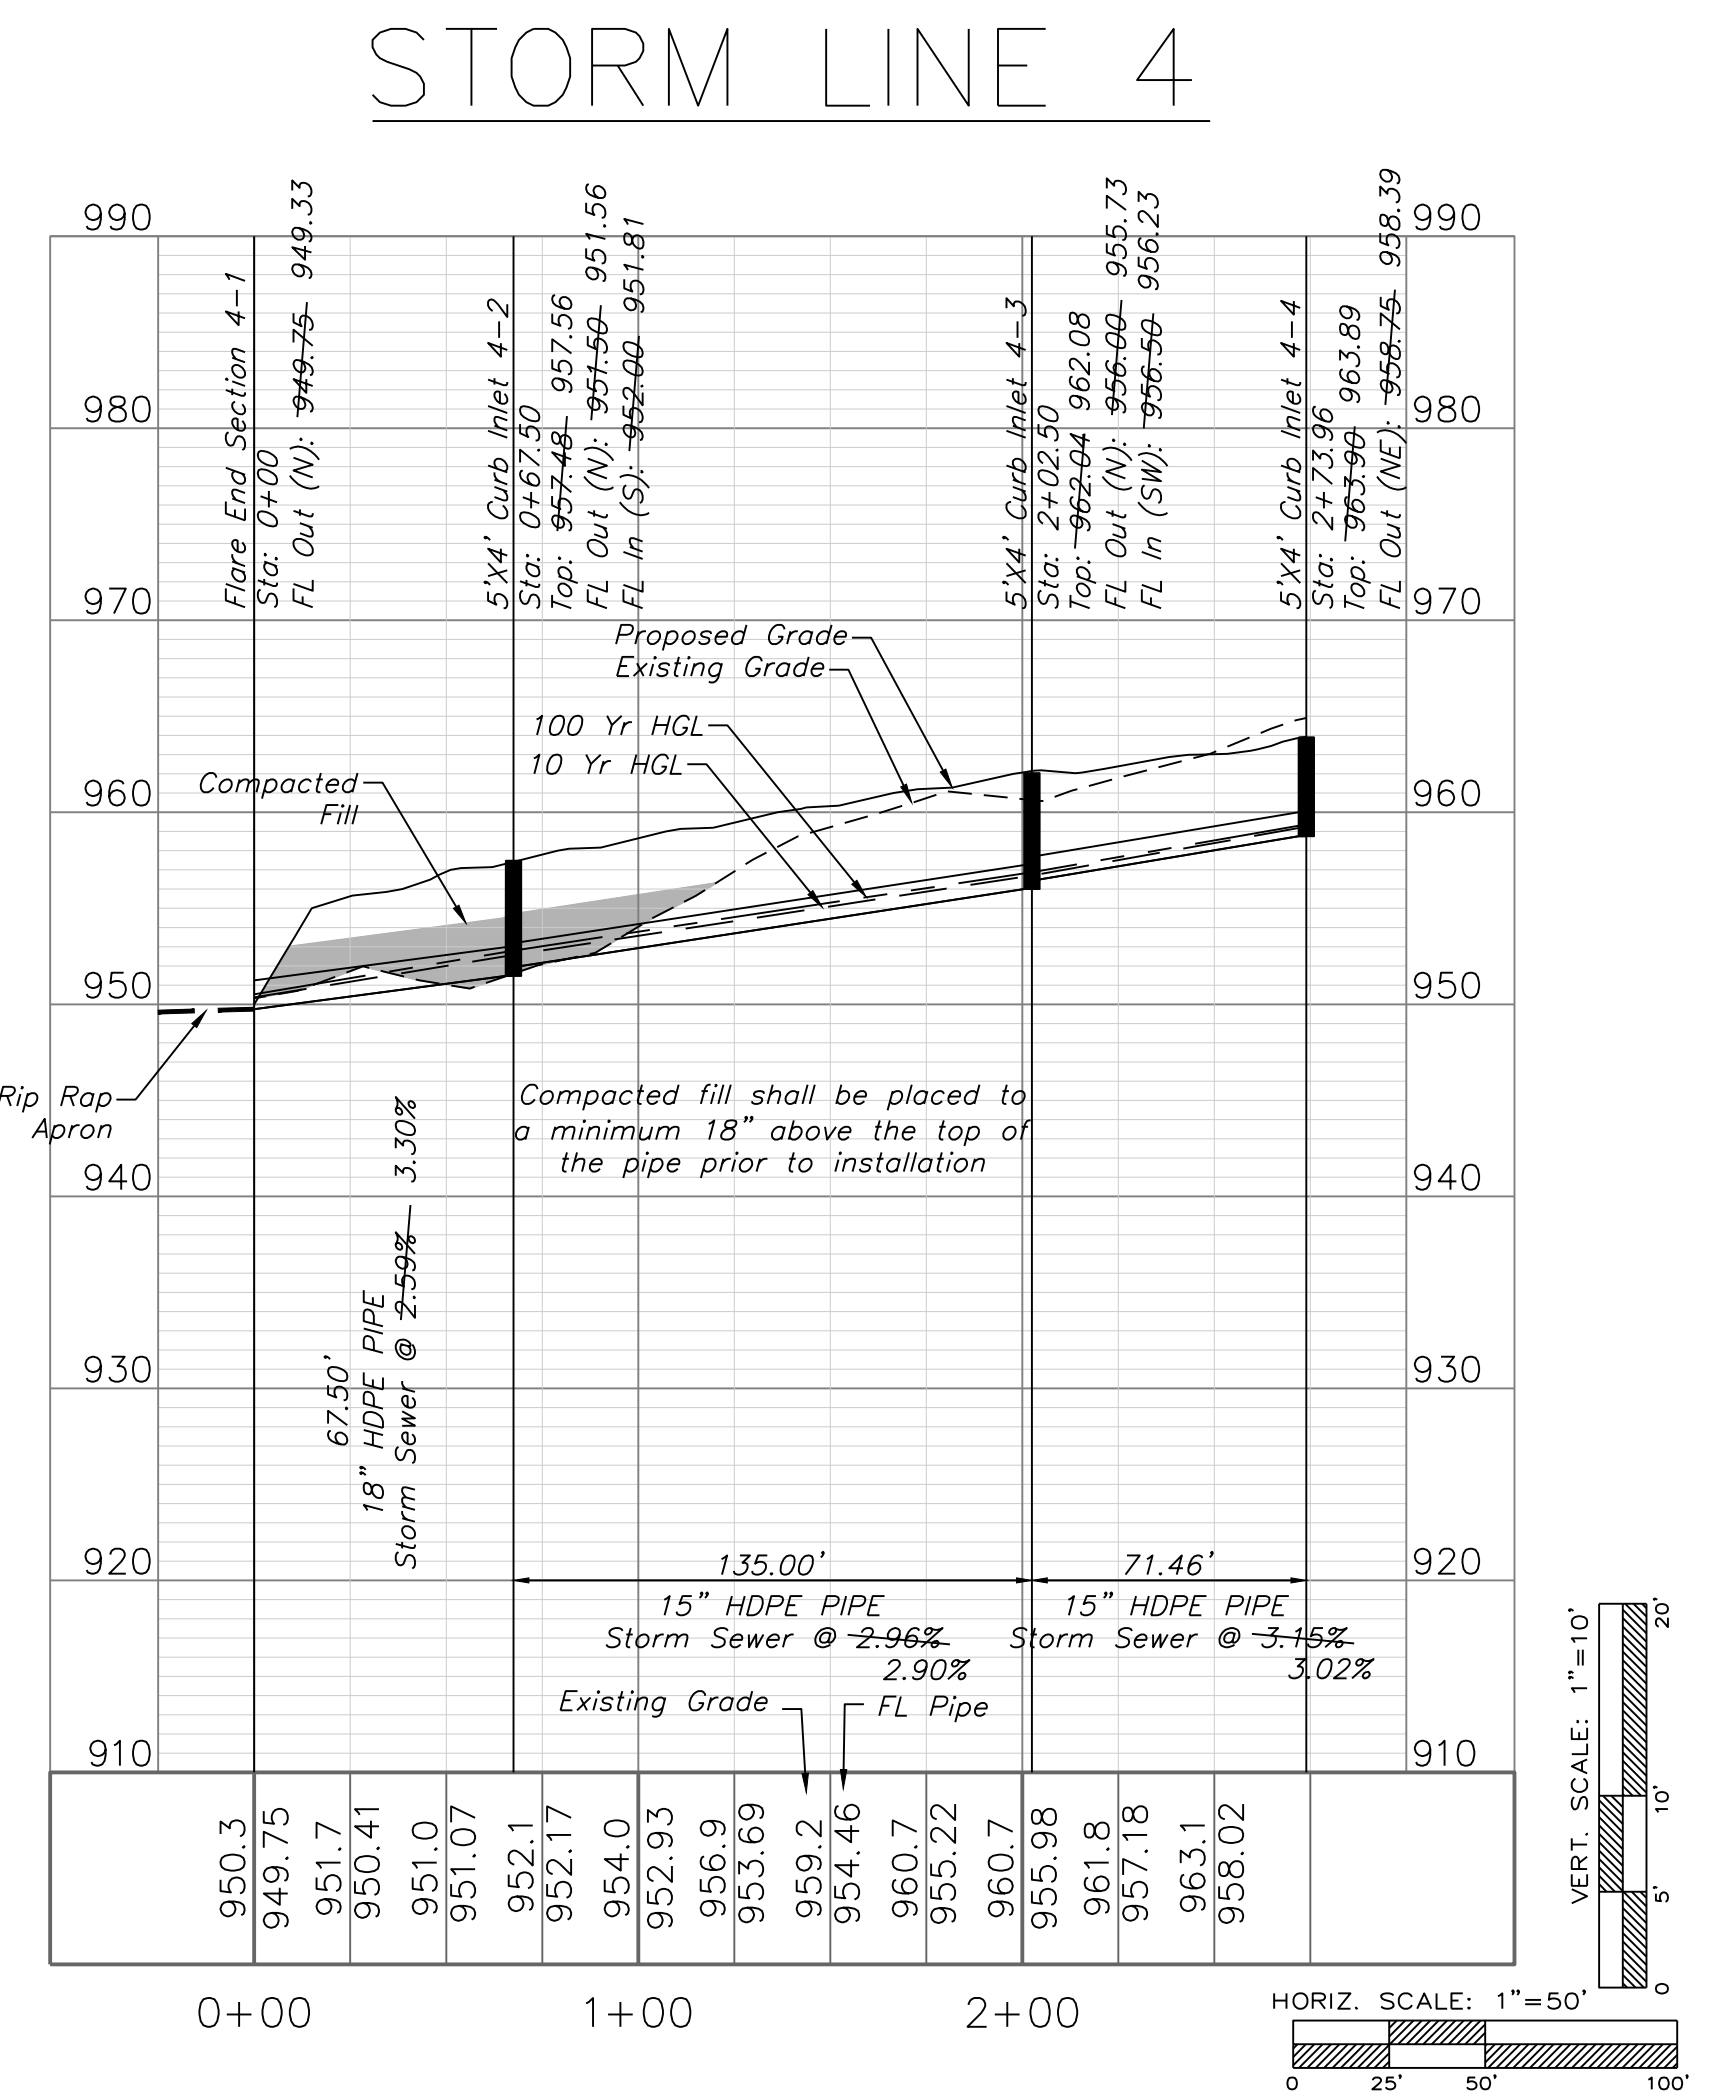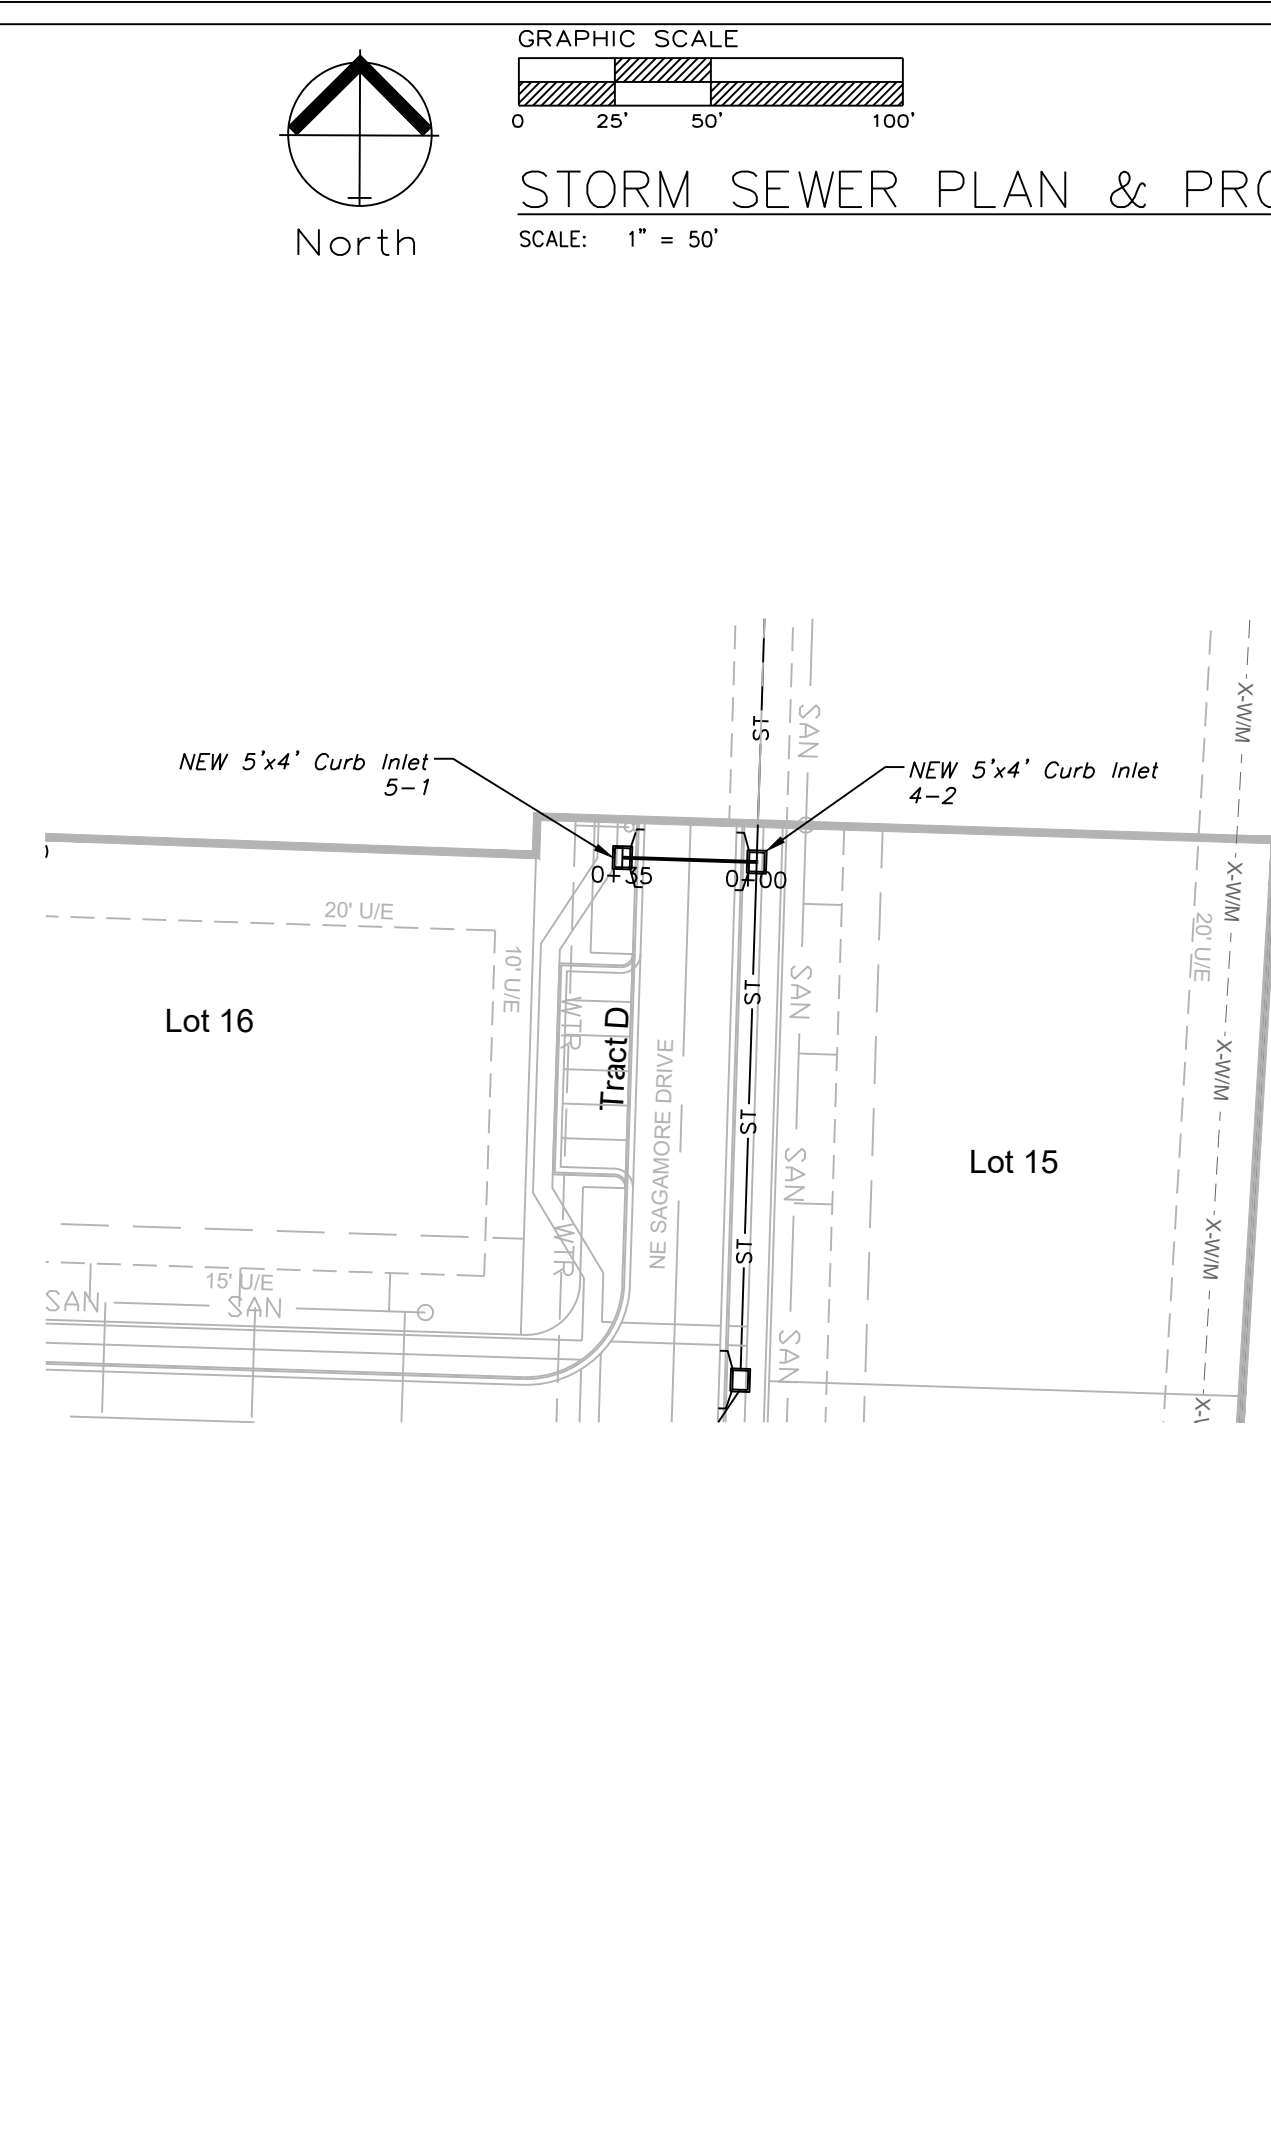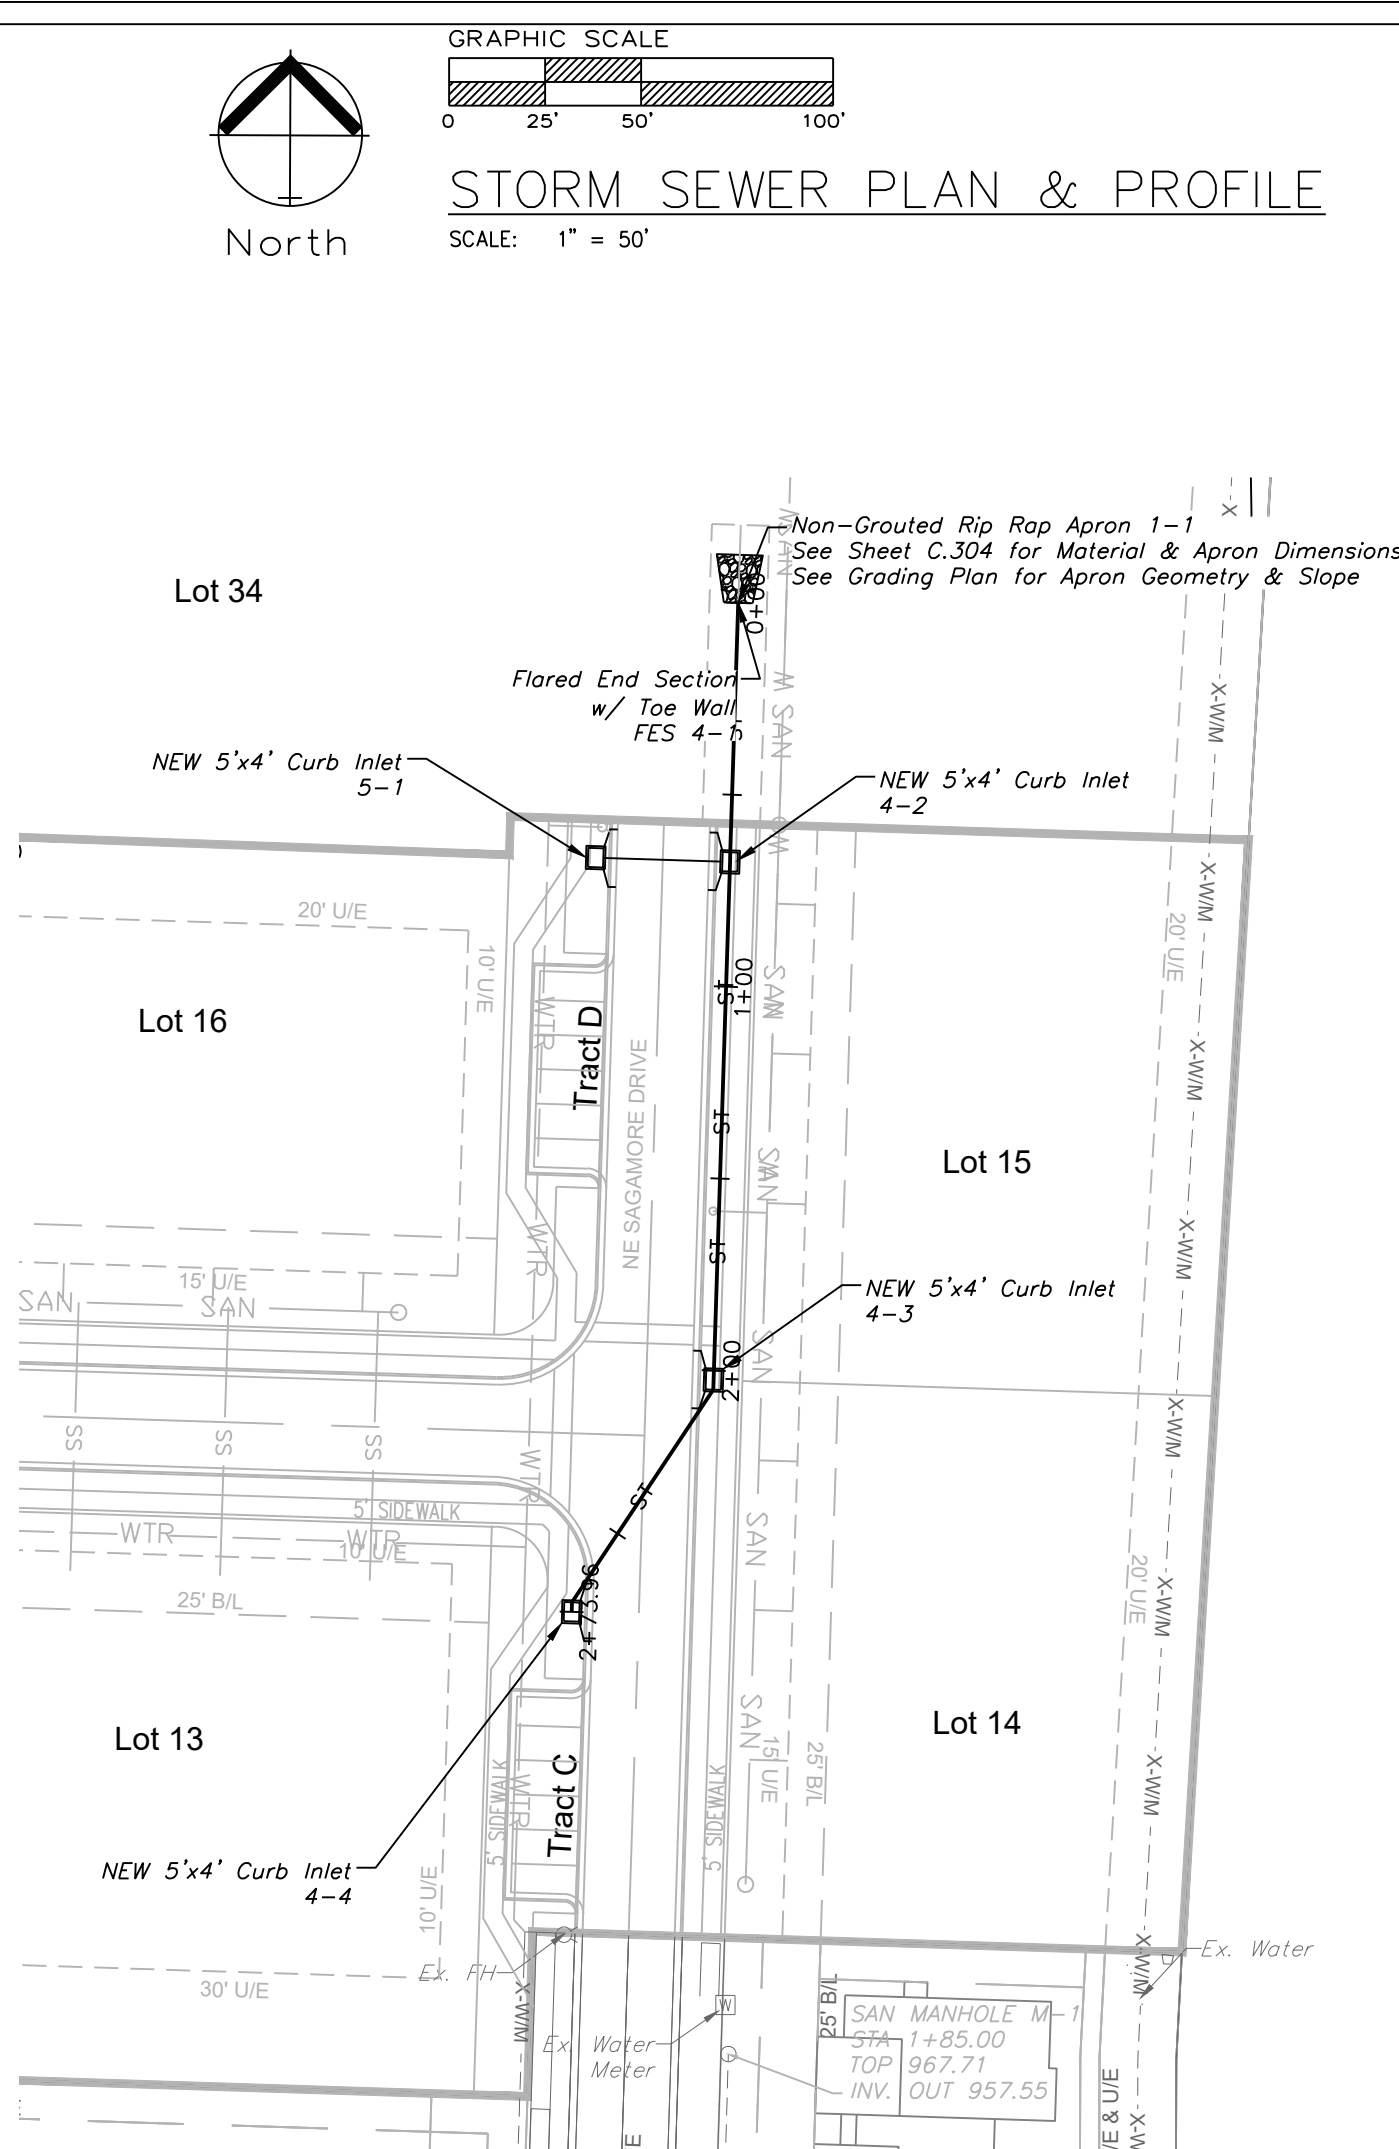

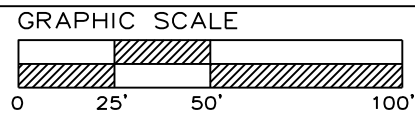
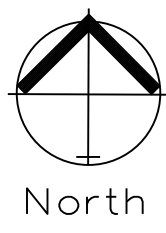


STORM SEWER PLAN & PROFILE

SCALE: 1" = 50'

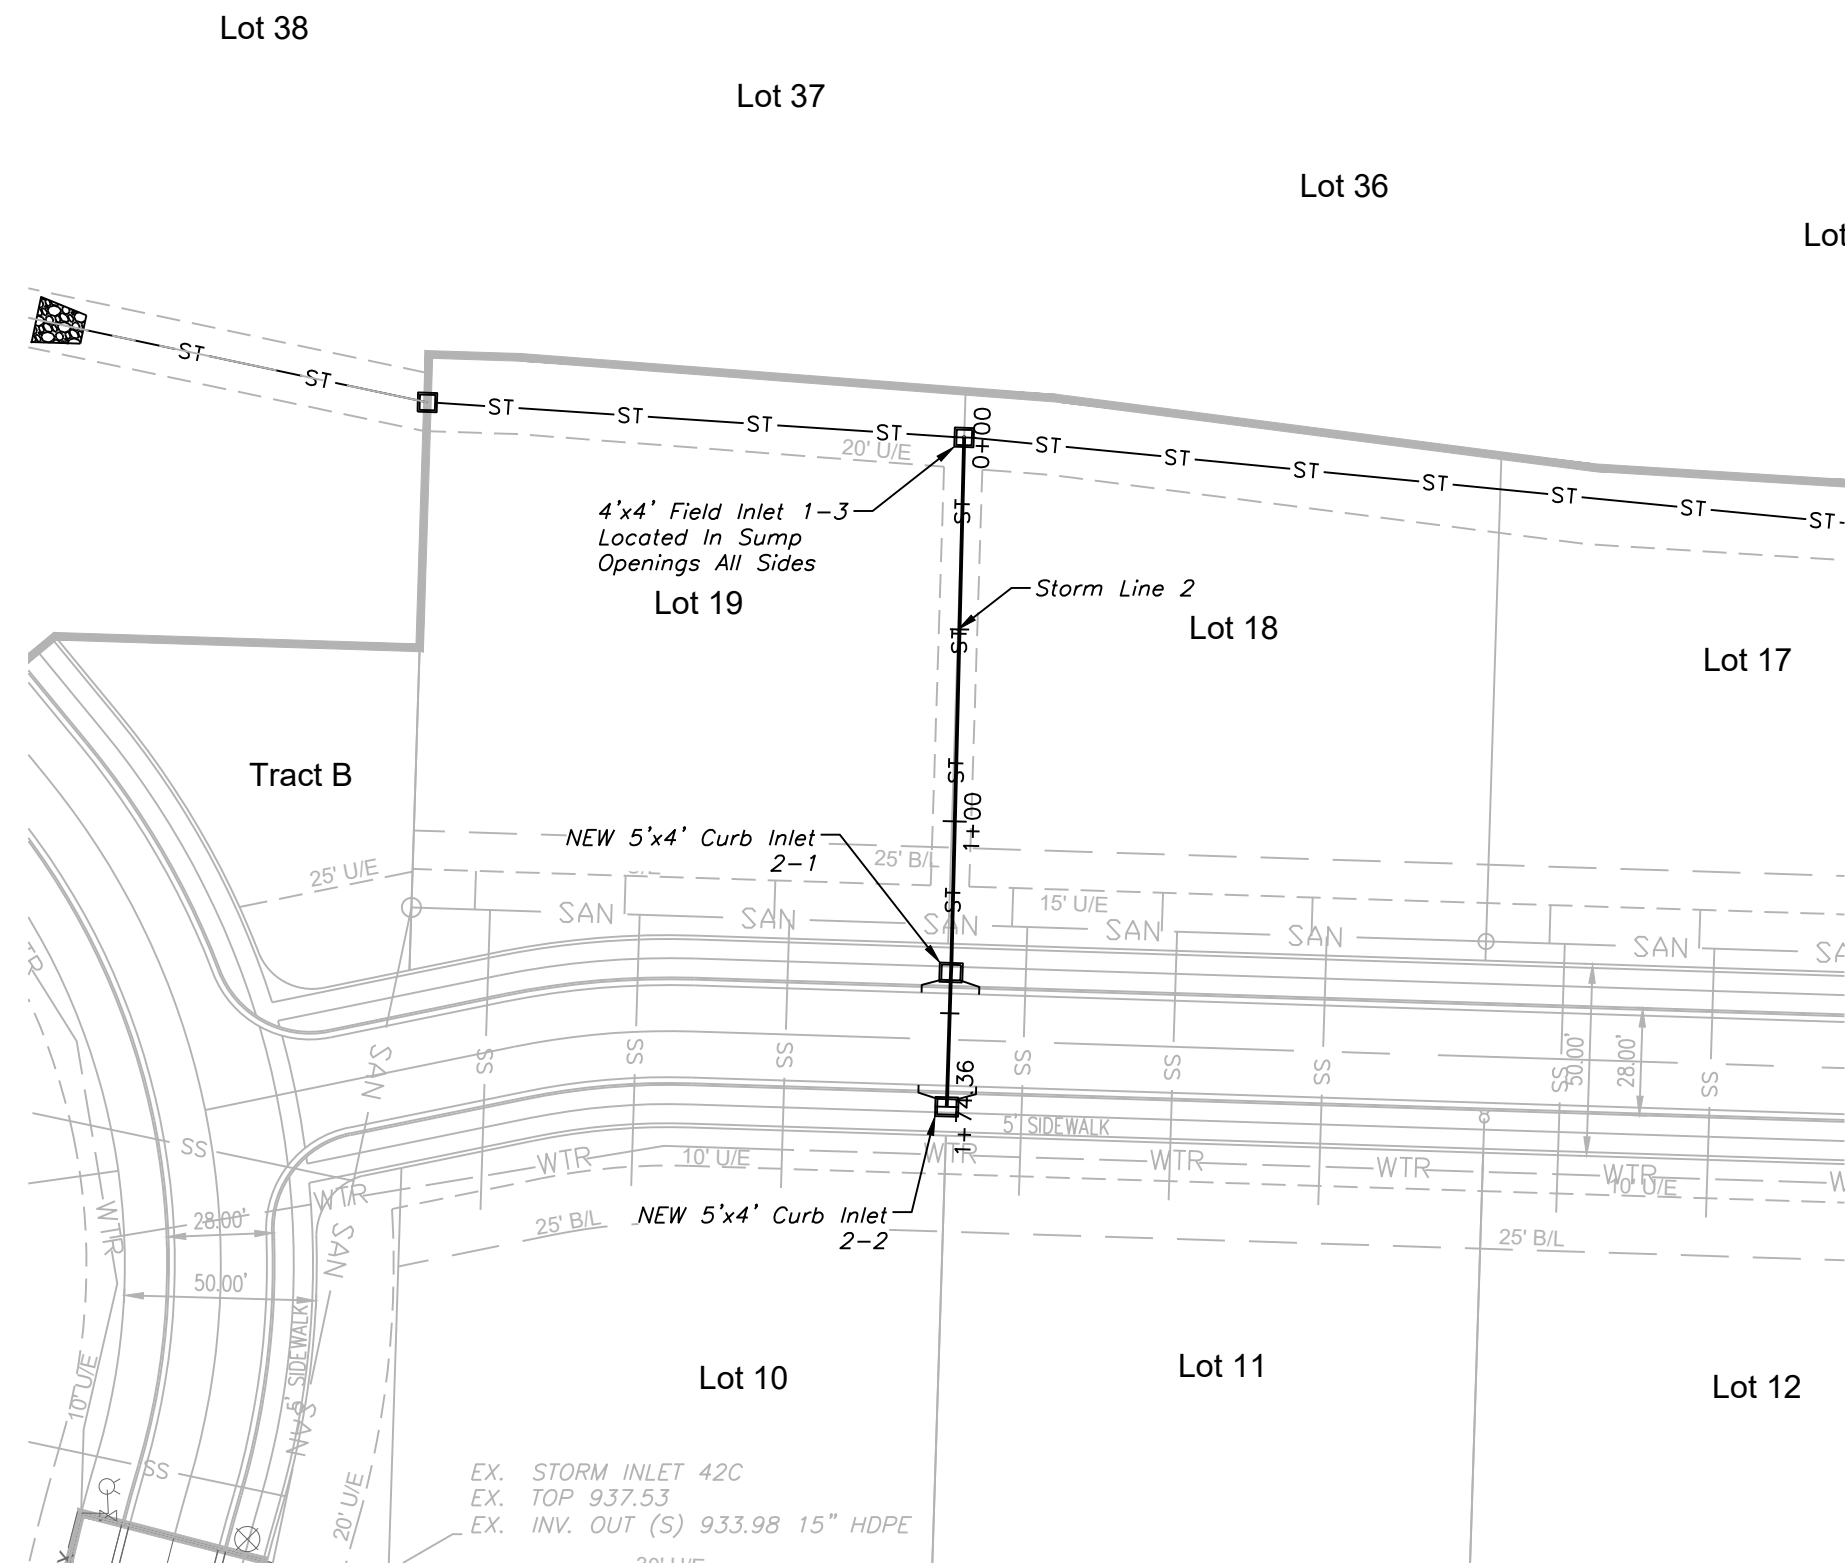


STORM LINE 2

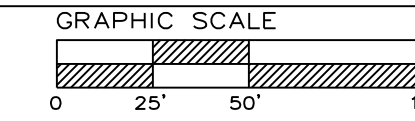
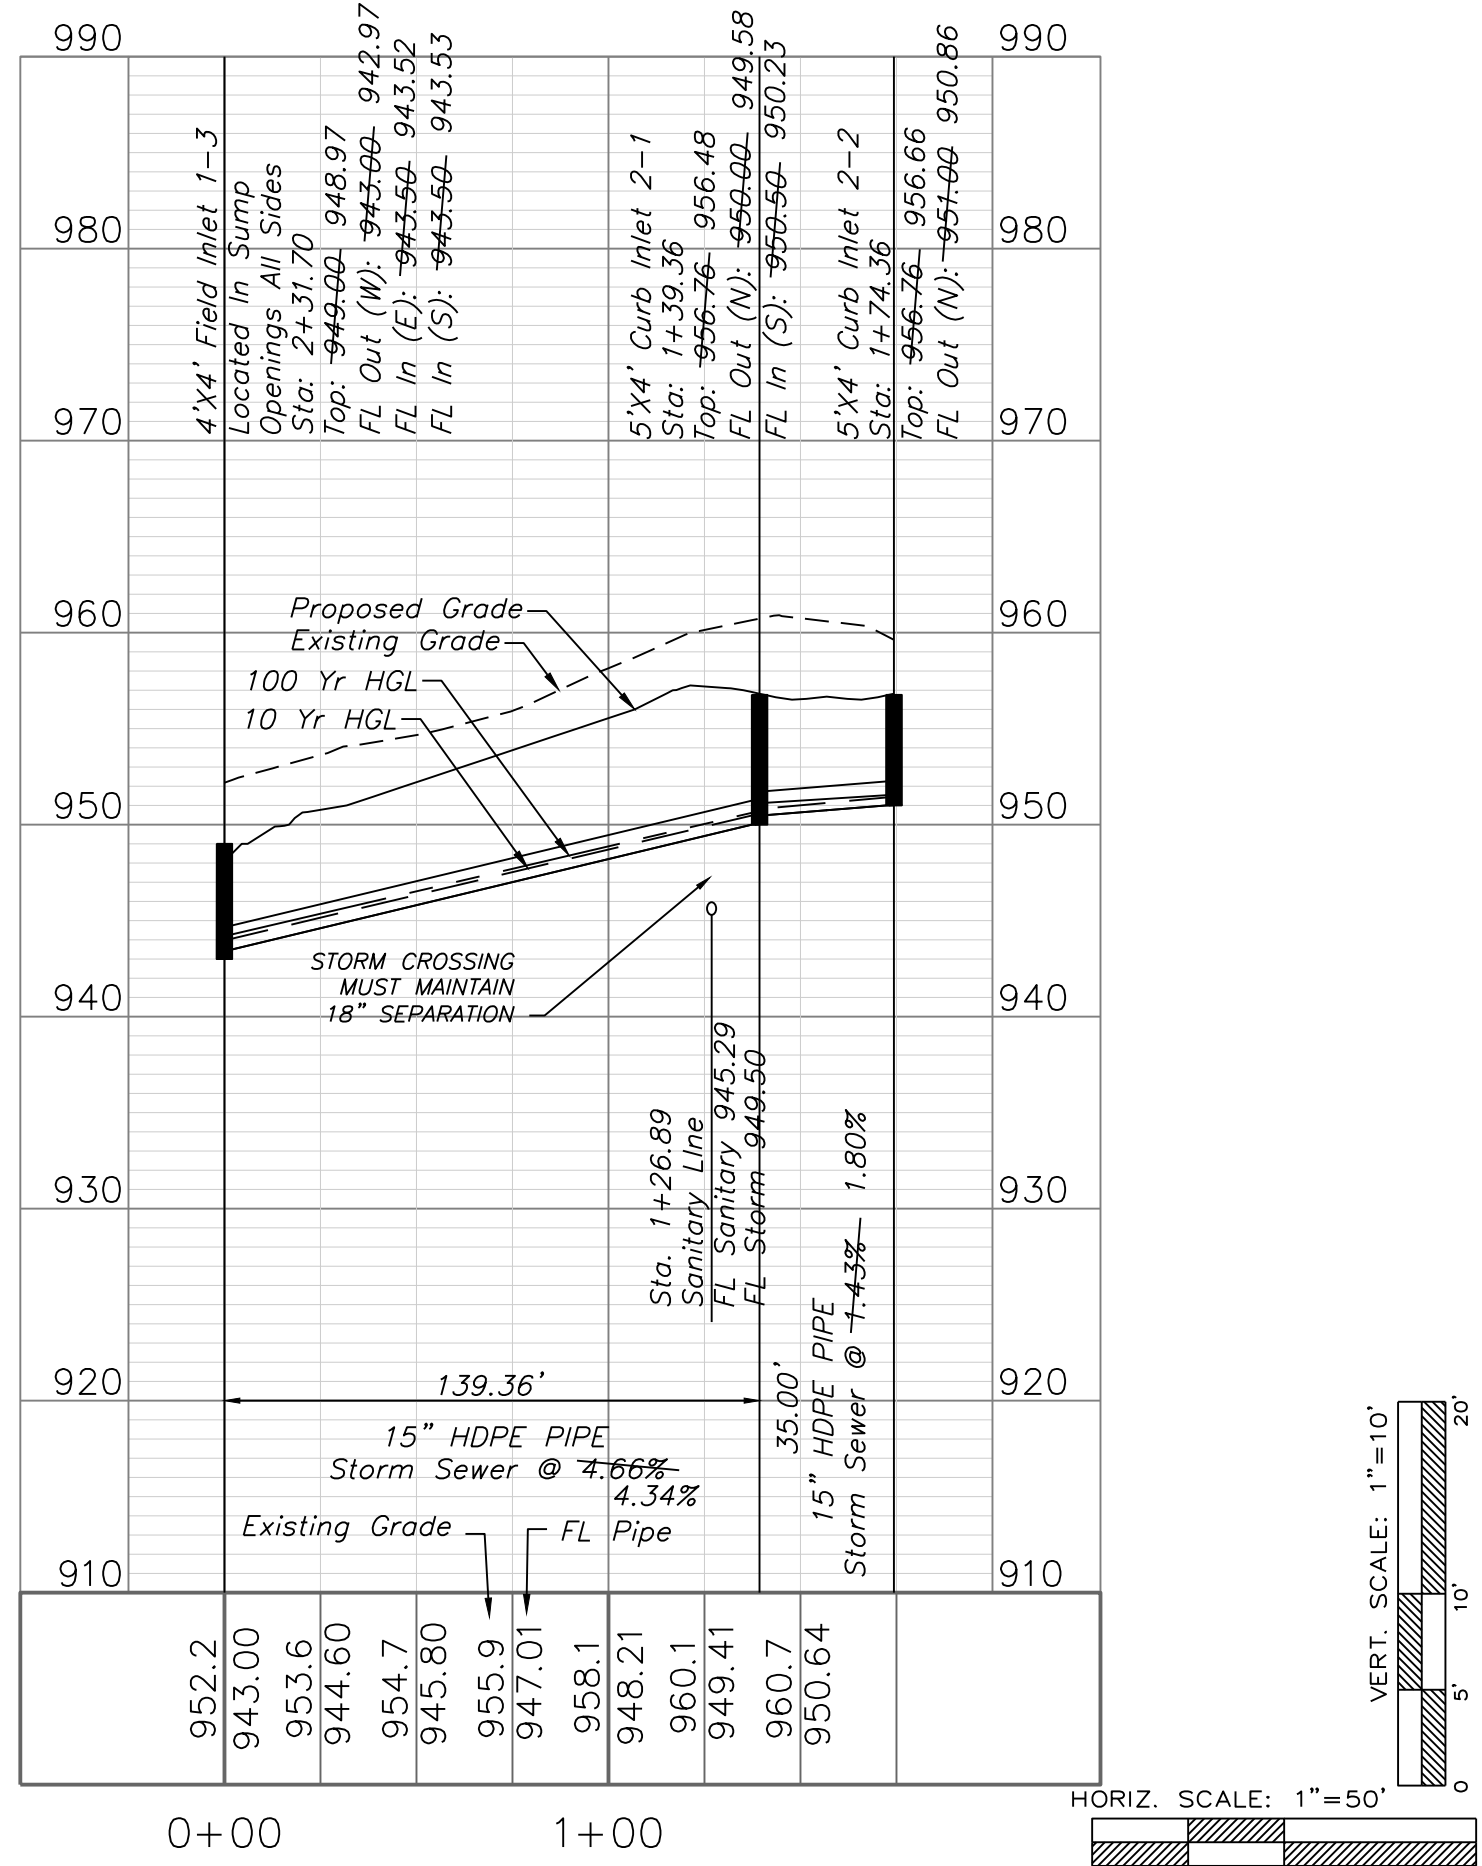


STORM SEWER PLAN & PROFILE

SCALE: 1" = 50'

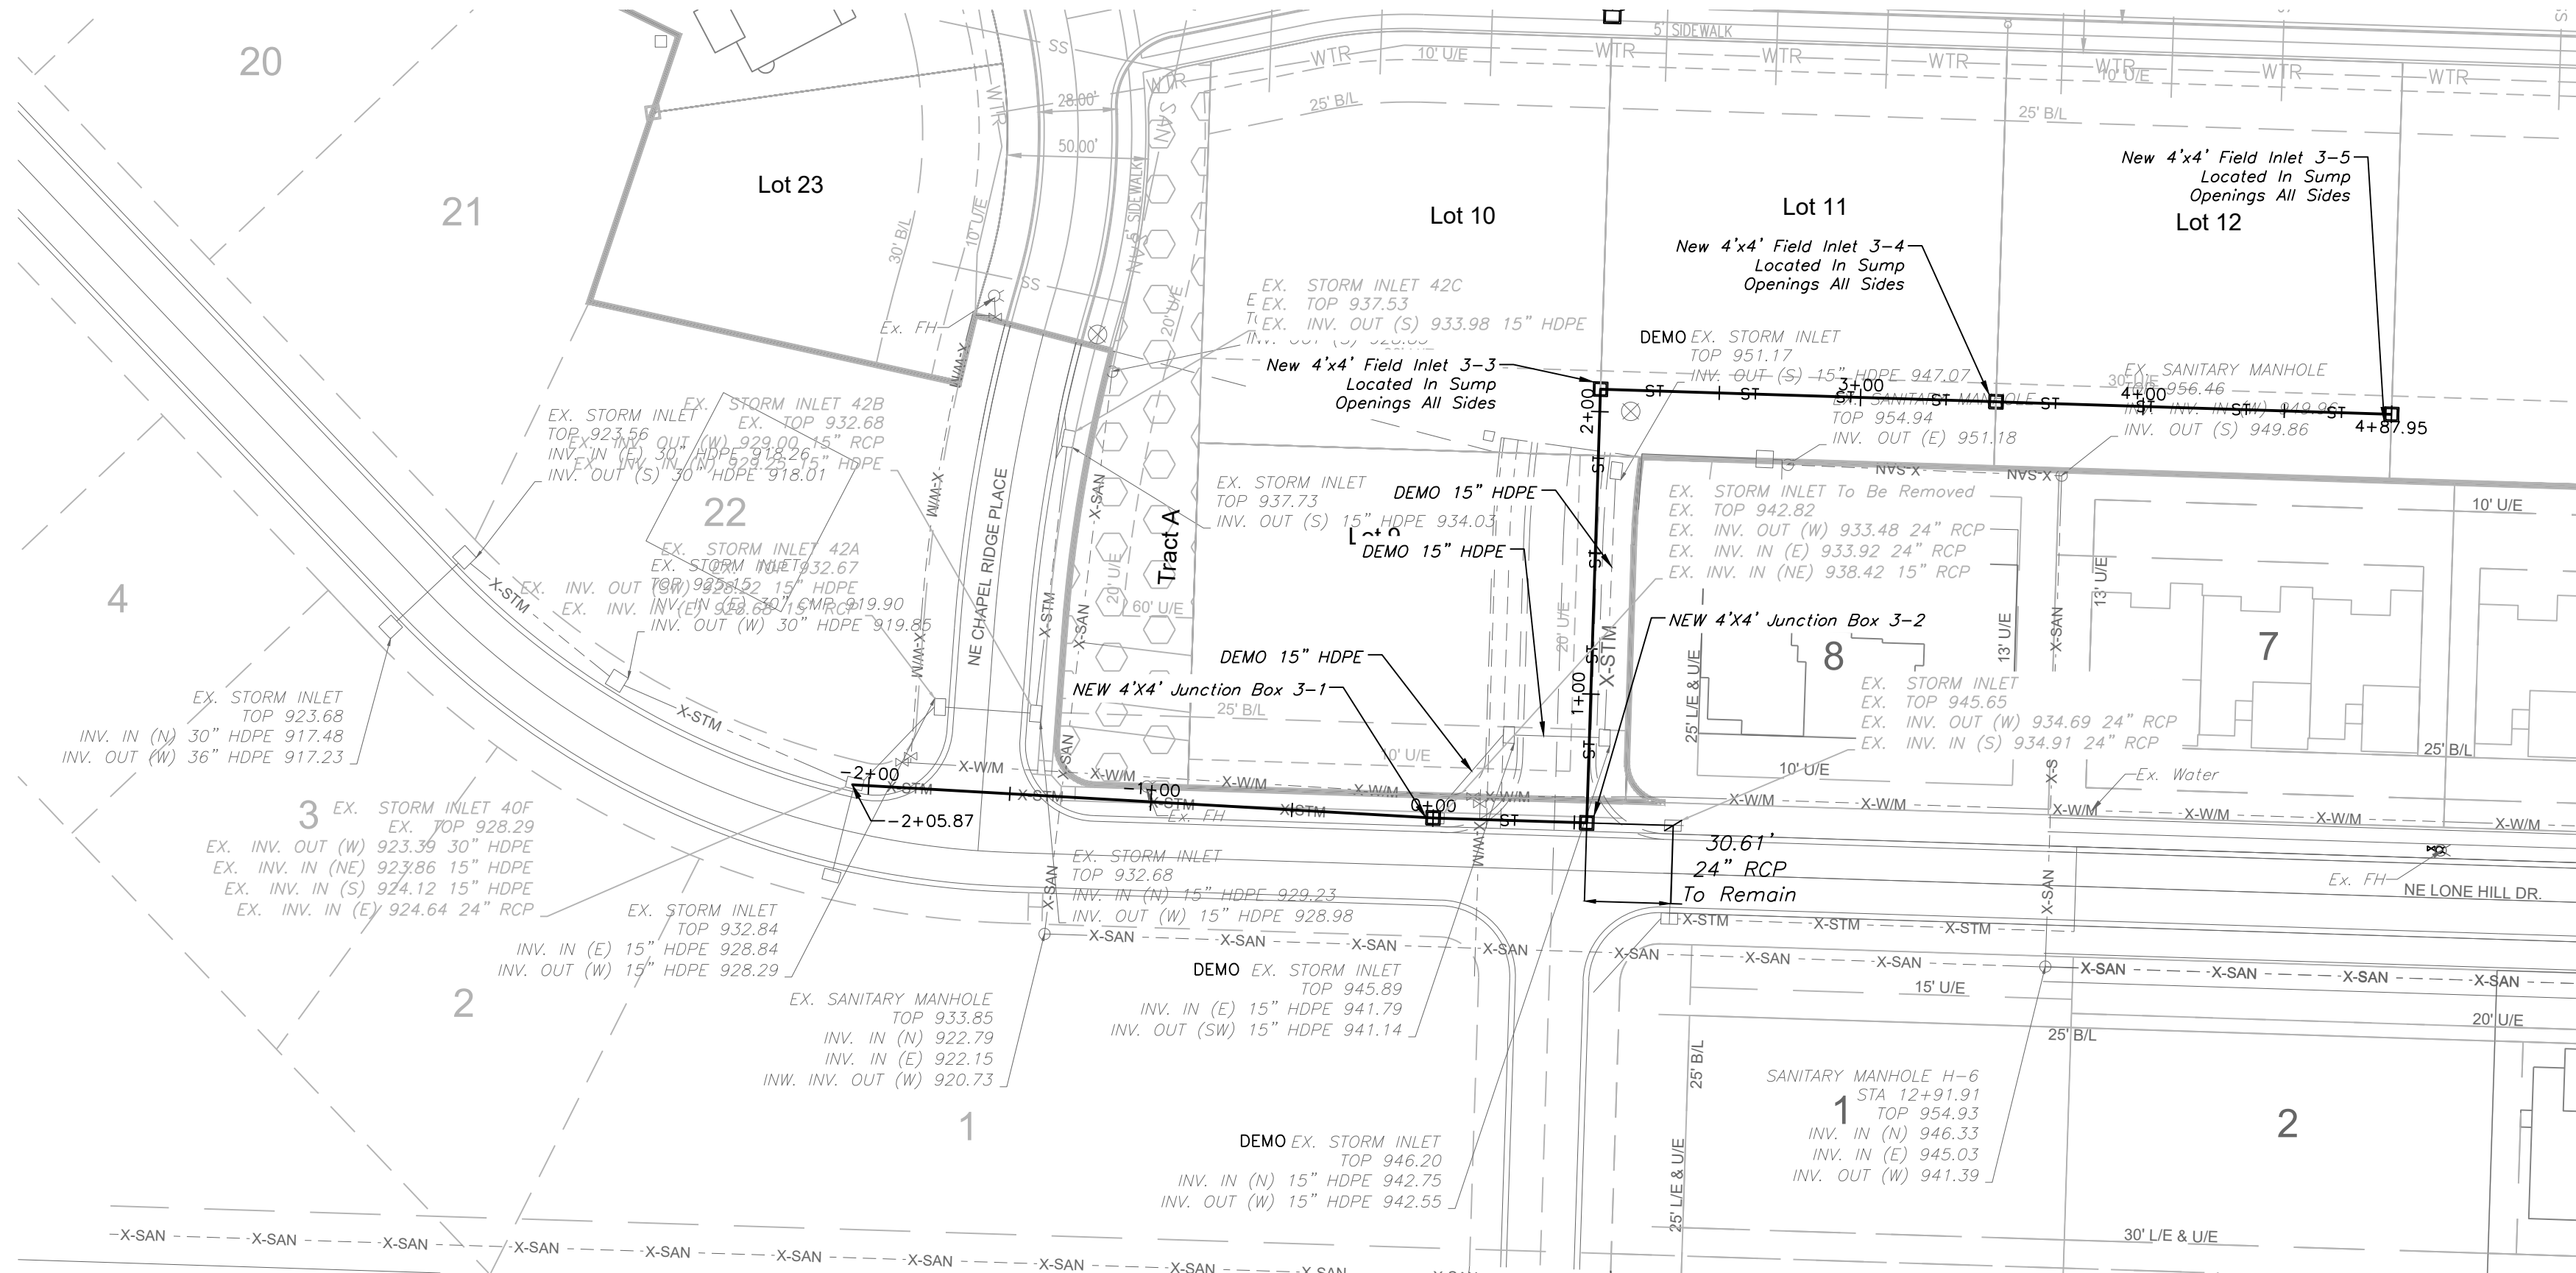

STORM LINE 3

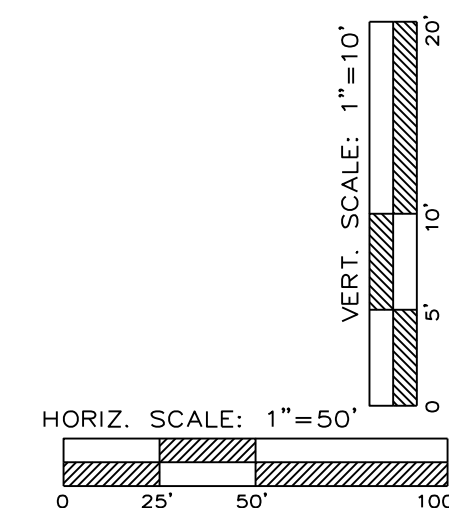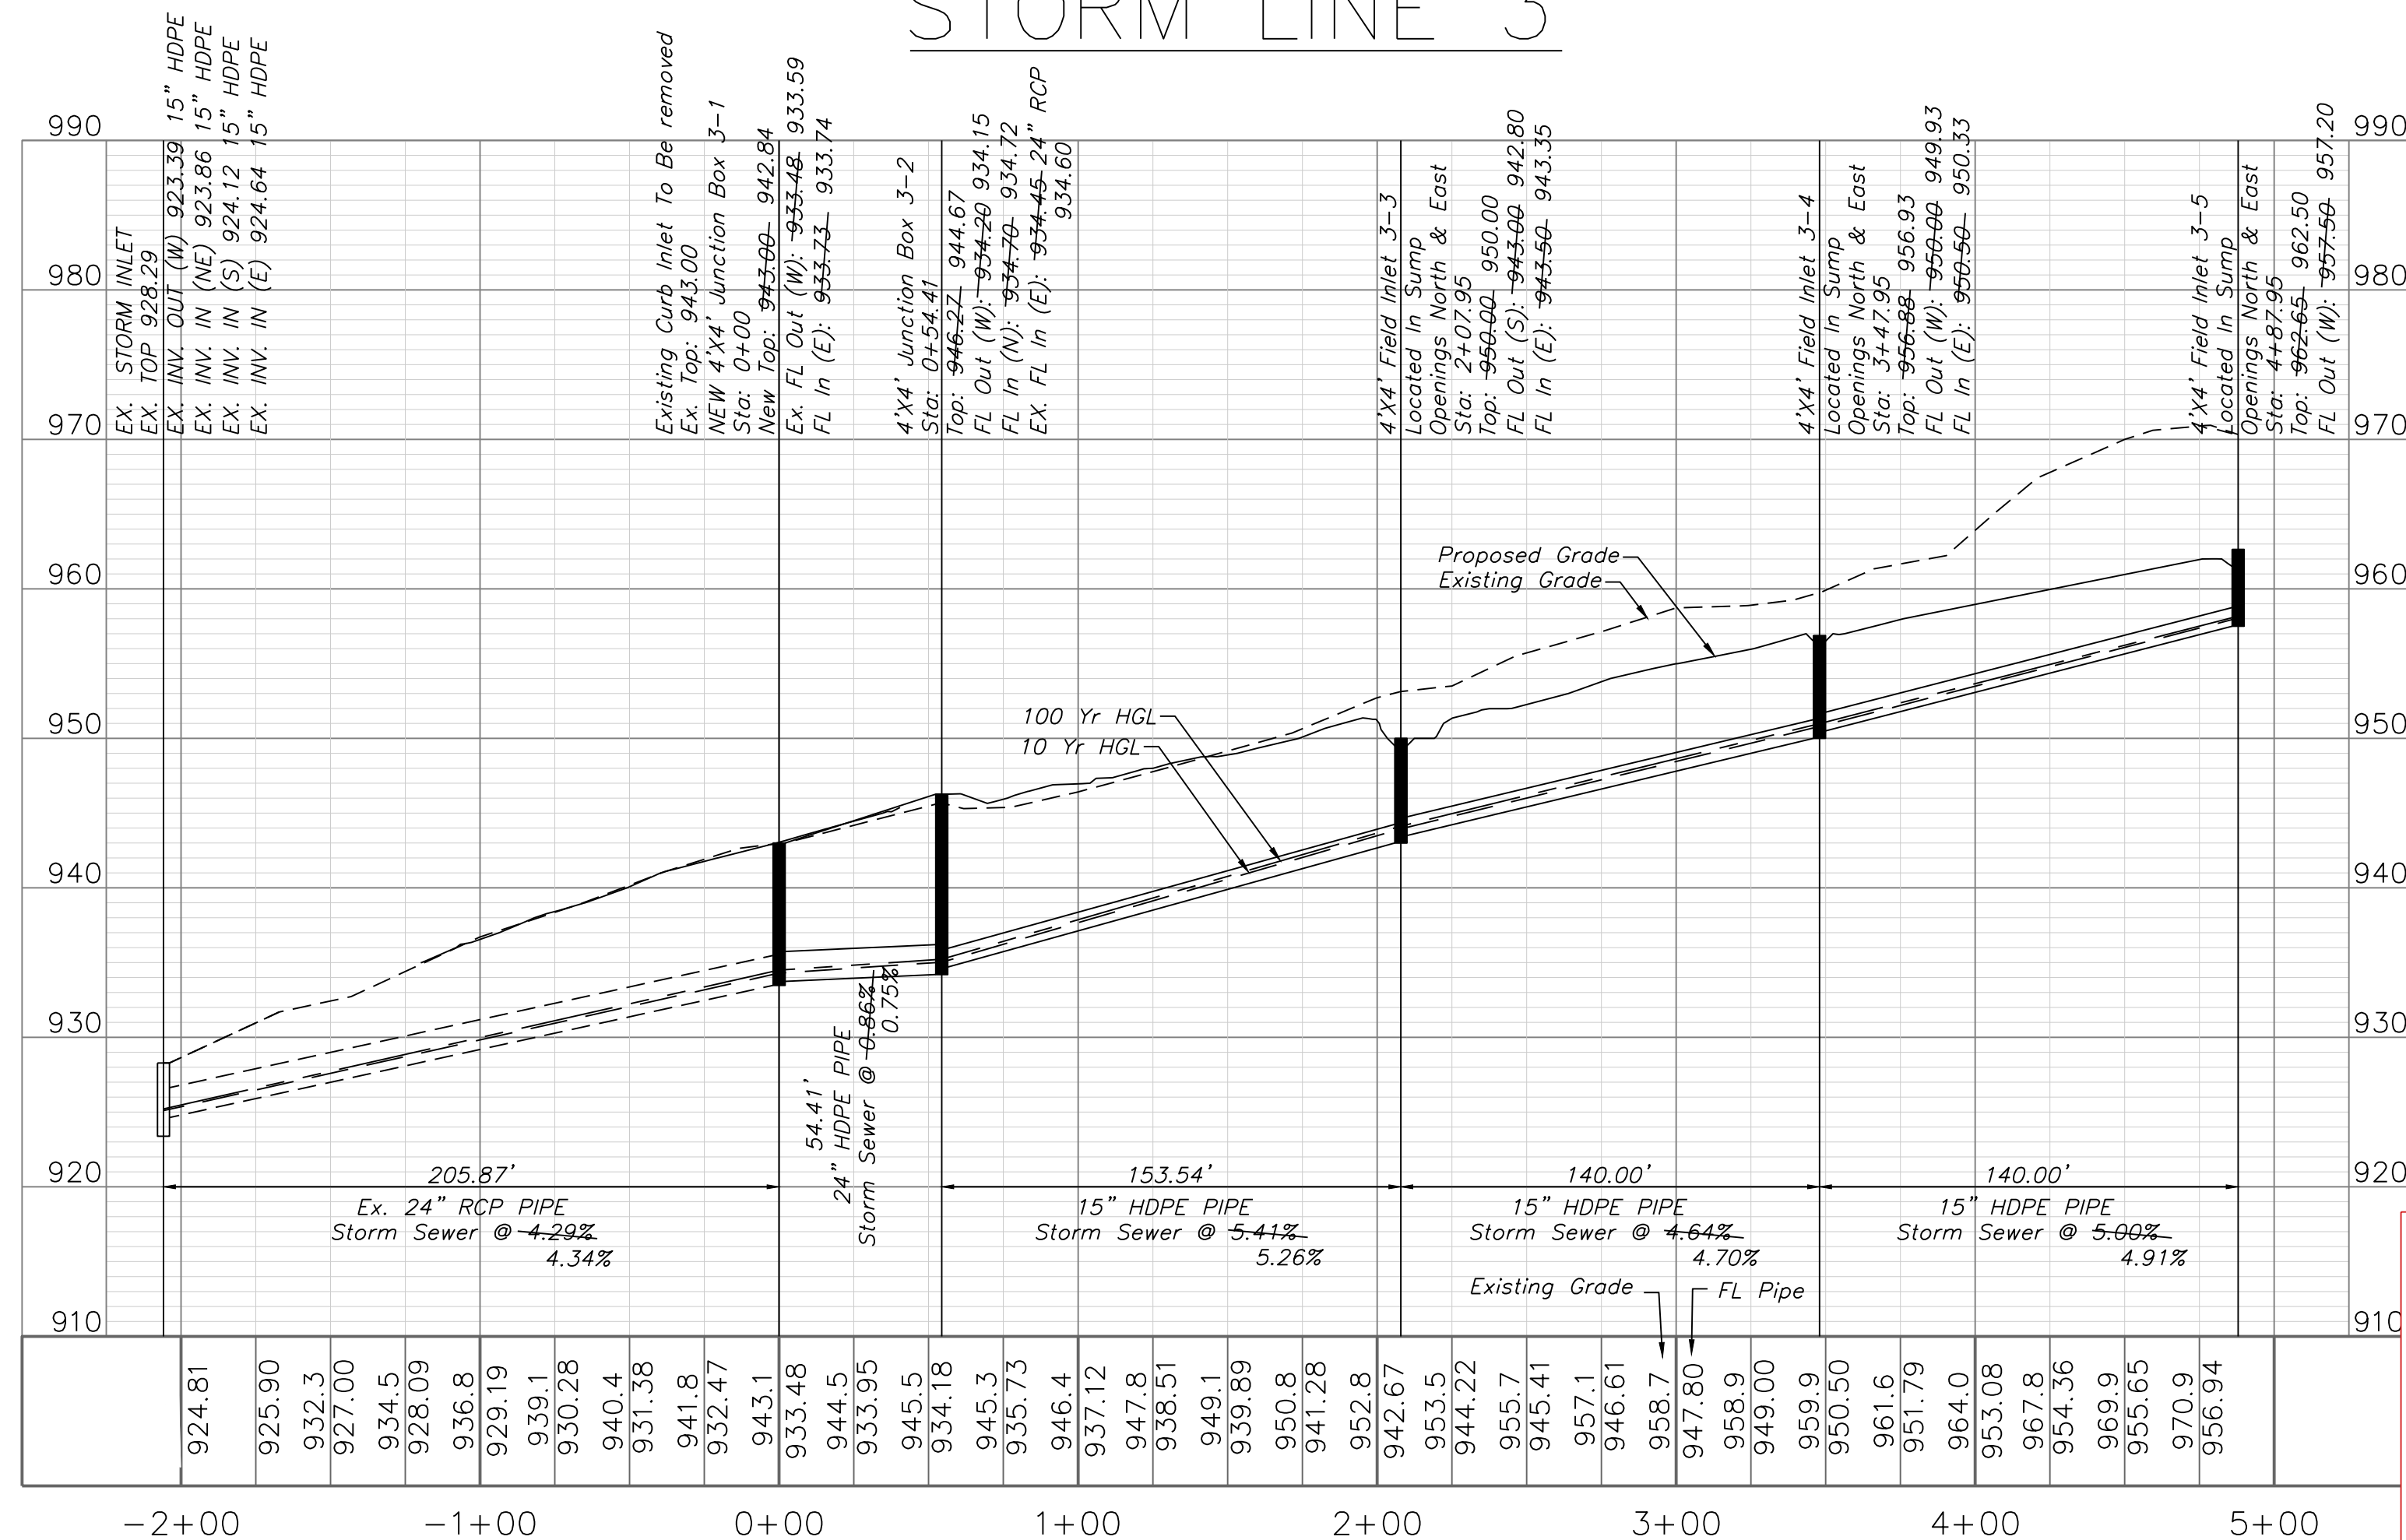

RECORD DRAWING
The information provided on this drawing conforms to construction records; it is not intended for construction, implementation or recording purposes; and it is solely based on information obtained by my firm.

*"400.00 100.10", "4.00% 1.15% slope", or "8-inch HDPE-PVC pipe" are all typical examples of revisions that indicate that design data has been replaced with "as-built" information. All other data is as designed and has not been field verified.

Date: 11/17/2022
Certified by: Matthew J. Schlicht
Title: Engineer
Firm: Engineering Solutions



Professional Registration
Missouri
Engineering 2005002186-D
Surveying 200500319-D
Kansas
Engineering E-1695
Surveying LS-218
Oklahoma
Engineering 6254
Nebraska
Engineering CA2821

THE TOWNHOMES OF CHAPEL RIDGE-2ND PLAT
LOTS 9-19 & TRACTS A-D
Lee's Summit, Jackson County, Missouri


Project: VILLAS OF CHAPEL RIDGE, L.S.M.O.
Issue Date: April 10, 2020

Storm Sewer Plan and Profile
Construction Plans for:
THE TOWNHOMES OF CHAPEL RIDGE-2ND PLAT
LOTS 9-19 & TRACTS A-D
Lee's Summit, Jackson County, Missouri




Matthew J. Schlicht
MO PE 2006019708
KS PE 19071
OK PE 25226
NE PE E-114335



REVISIONS	
6/25/2021	As-Built
8/18/2021	As-Built
8/31/2021	As-Built
9/9/2021	As-Built
11/17/2022	As-Built

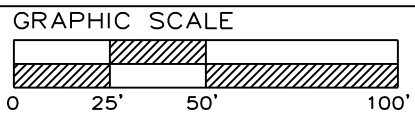

STORM SEWER PLAN & PROFILE
SCALE: 1" = 50'

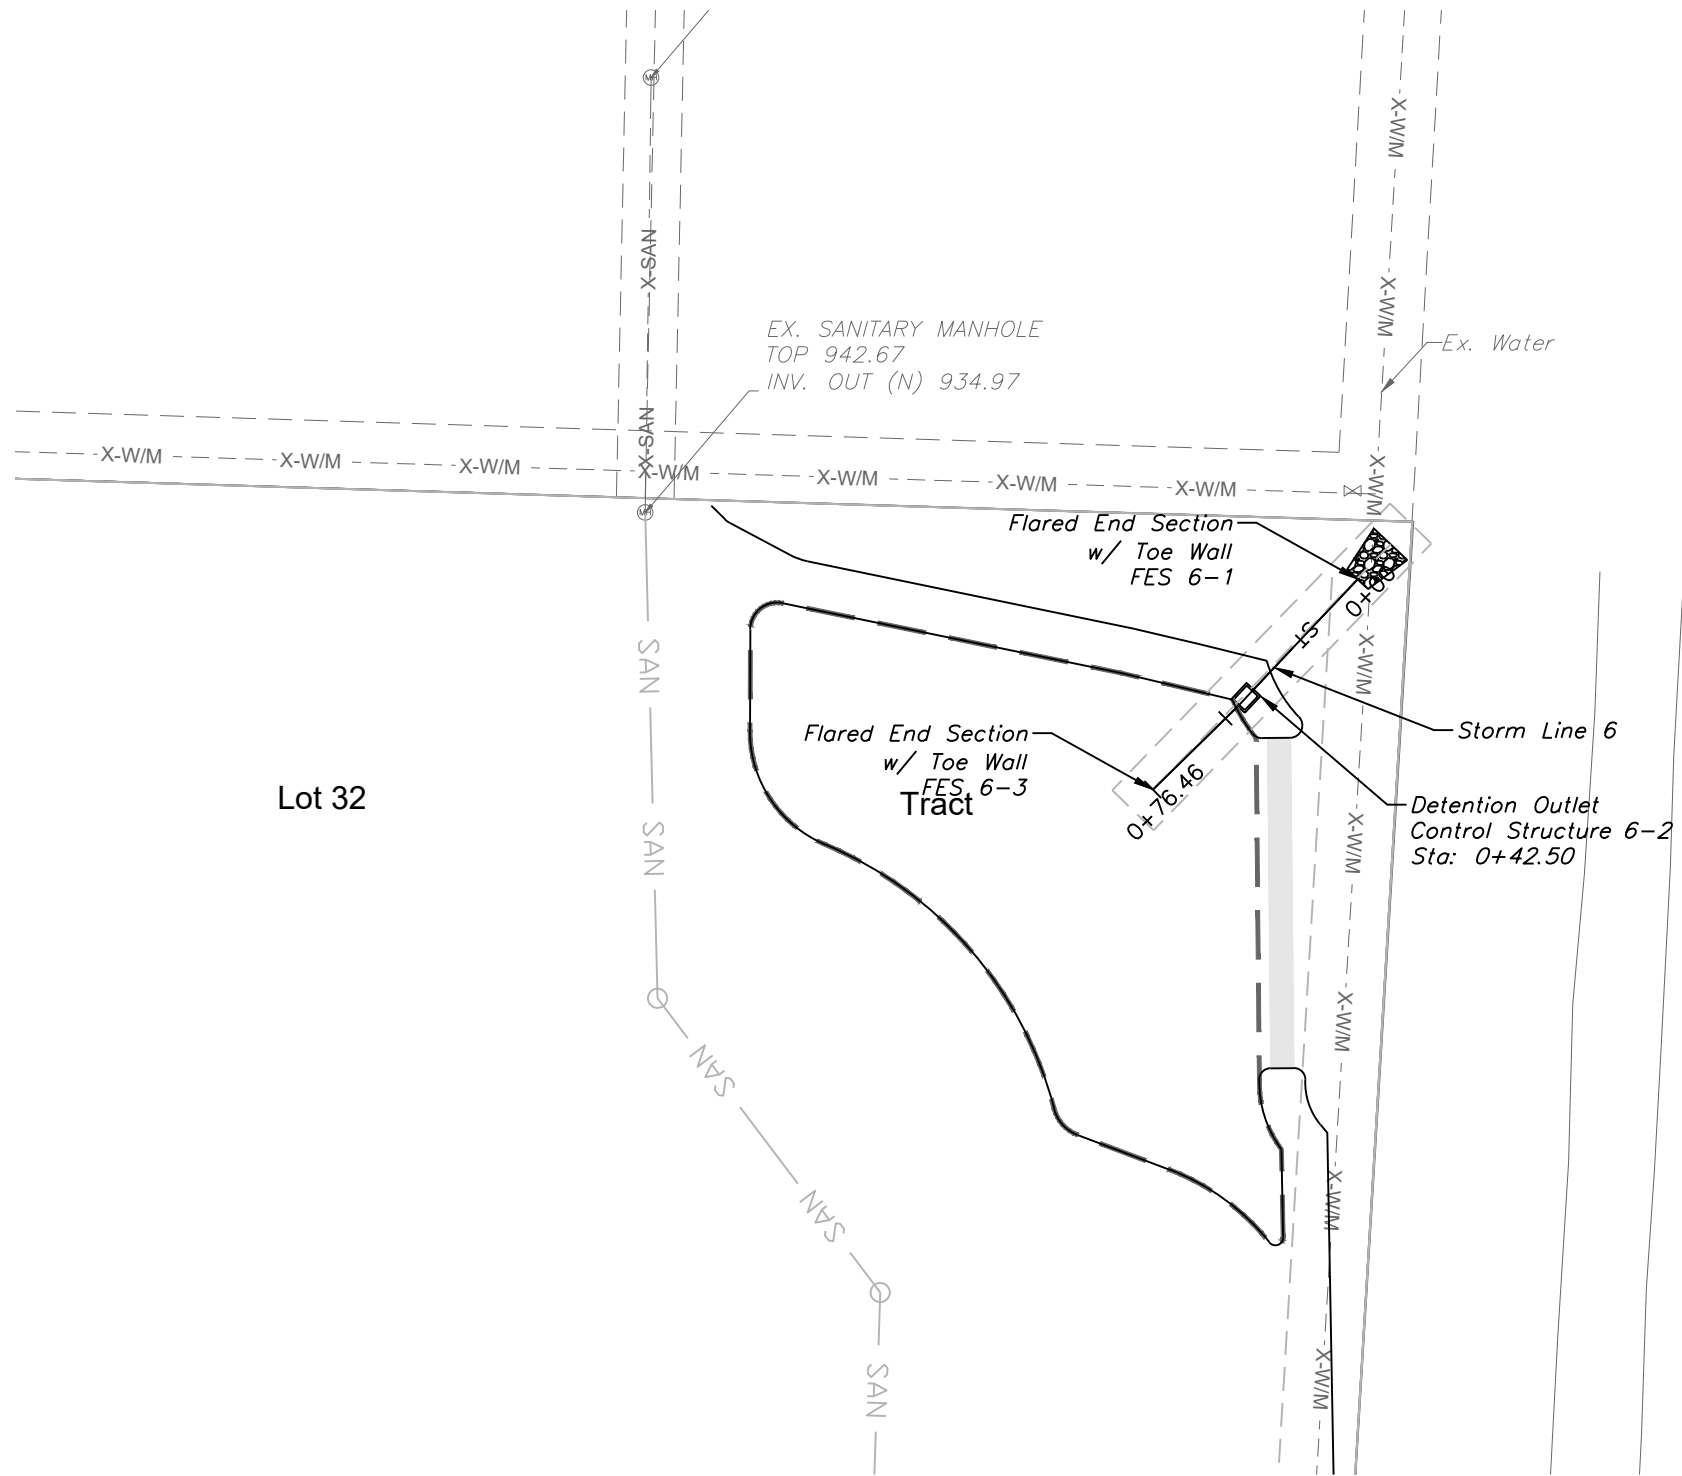

STORM LINE 6

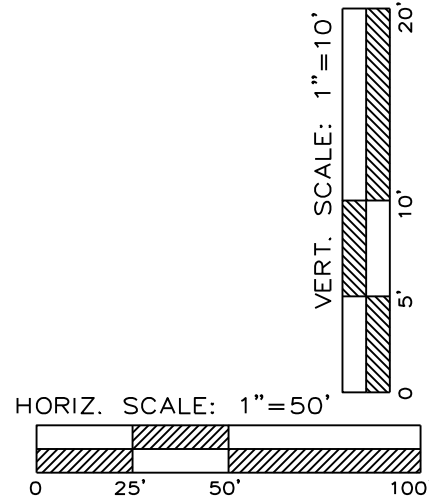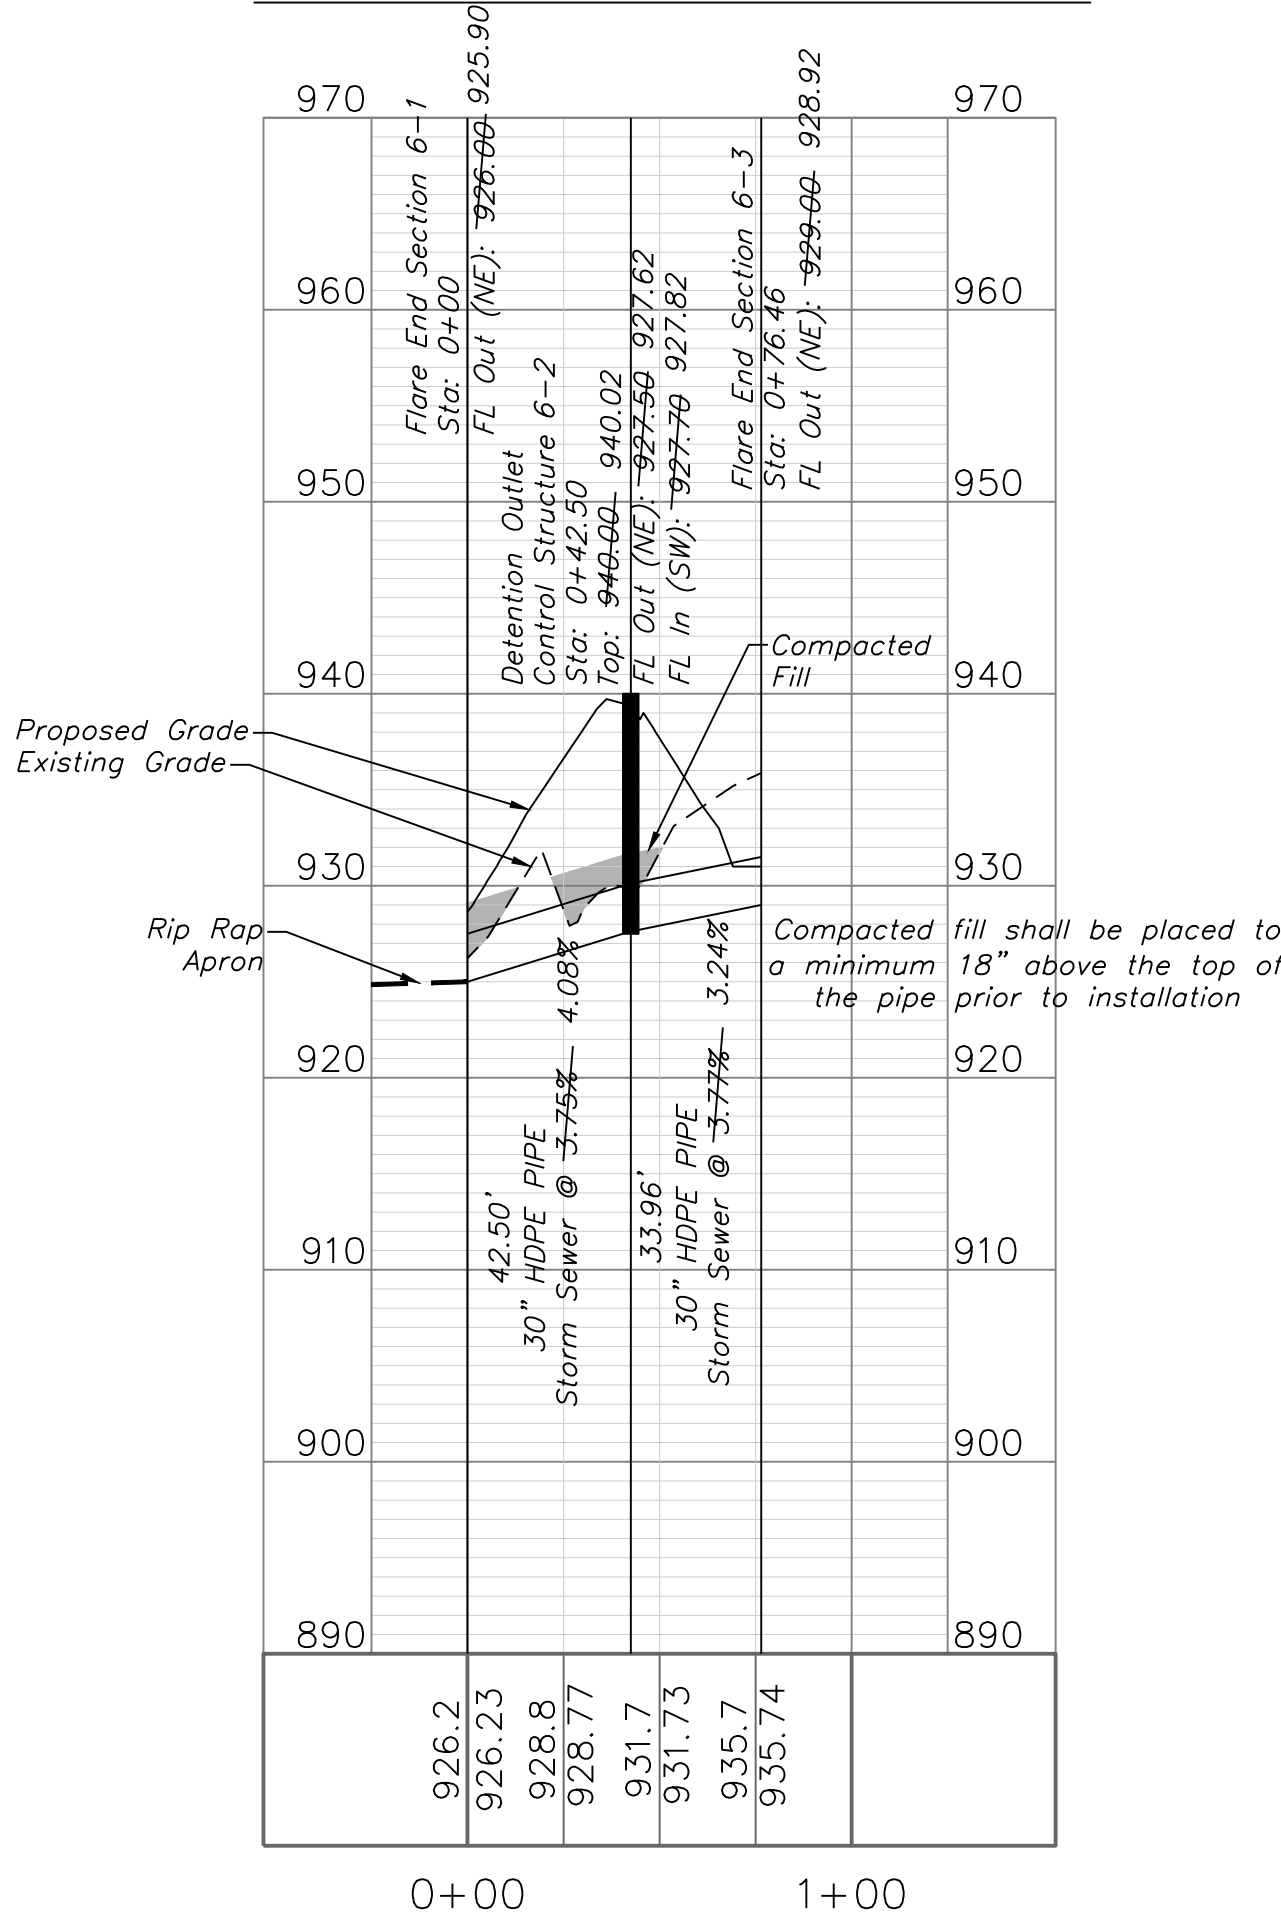

RECORD DRAWING
The information provided on this drawing conforms to construction records; it is not intended for construction, implementation or recording purposes; and it is solely based on information obtained by my firm.

*400.00 100.10", "4.00% 1.15% slope", or "8-inch HDPE-PVC pipe" are all typical examples of revisions that indicate that design data has been replaced with "as-built" information. All other data is as designed and has not been field verified.

Date: 11/17/2022
Certified by: Matthew J. Schlicht
Title: Engineer
Firm: Engineering Solutions




Professional Registration
Missouri
Engineering 2005002186-D
Surveying 2005008319-D
Kansas
Engineering E-1895
Surveying LS-218
Oklahoma
Engineering 6254
Nebraska
Engineering CA2821

THE TOWNHOMES OF CHAPEL RIDGE-2ND PLAT
LOTS 9-19 & TRACTS A-D
Lee's Summit, Jackson County, Missouri

Project: VILLAS OF CHAPEL RIDGE L&MO
Issue Date: April 10, 2020

Storm Sewer Plan and Profile
Construction Plans for:
THE TOWNHOMES OF CHAPEL RIDGE-2ND PLAT
LOTS 9-19 & TRACTS A-D
Lee's Summit, Jackson County, Missouri

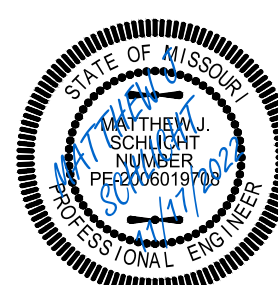

Matthew J. Schlicht
MO PE 2006019708
KS PE 19071
OK PE 25226
NE PE E-14335



REVISIONS
6/25/2021 As-Built
8/18/2021 As-Built
8/31/2021 As-Built
9/9/2021 As-Built
11/17/2022 As-Built

10 YEAR INLET																						
D.S. Str.	Str.	Area (ac)	InletTime (min)	Int. (in/hr)	RunoffCoeff. (C)	Q=CIA (cfs)	Q Carry-over (cfs)	QCaptured (cfs)	QBypassed (cfs)	JunctType	CurbHeight (in)	CurbLength (ft)	GutterSlope (ft/ft)	GutterWidth (ft)	CrossSlope, Sw (ft/ft)	CrossSlope, Sx (ft/ft)	InletDepth (ft)	BypassDepth (ft)	BypassSpread (ft)	GutterDepth (ft)	GutterSpread (ft)	Bypass Str.
1-1	1-2	0.21	5.20	7.21	0.66	1.00	0	1	0	Dp-Curb	6	16	Sag		0.02	0.02	0.08	n/a	n/a	0.08	3.78	Sag
1-2	1-3	0.87	6.20	6.94	0.66	3.99	0	3.99	0	Dp-Curb	6	16	Sag		0.02	0.02	0.19	n/a	n/a	0.19	9.51	Sag
1-3	1-4	0.12	5.30	7.18	0.66	0.57	0	0.57	0	Dp-Curb	6	16	Sag		0.02	0.02	0.05	n/a	n/a	0.05	2.6	Sag
1-3	2-1	0.17	6.00	7.00	0.66	0.78	0	0.3	0.49	Curb	10	5	0.078	2	0.05	0.02	0.11	0.1	1.9	0.11	2.66	EX 42A
2-1	2-2	0.28	6.00	7.00	0.66	1.29	0	0.39	0.9	Curb	10	5	0.078	2	0.05	0.02	0.13	0.12	2.94	0.13	3.74	EX 42C
EX 40F	3-1	0	0.00	0.00	0.00	0.00				JB												
3-1	3-2	0	0.00	0.00	0.00	0.00				JB												
3-2	3-3	0.36	5.30	7.18	0.66	1.71	0	1.71	0	Dp-Curb	6	16	Sag		0.02	0.02	0.11	n/a	n/a	0.11	5.4	Sag
3-3	3-4	0.45	5.50	7.13	0.66	2.12	0	2.12	0	Dp-Curb	6	16	Sag		0.02	0.02	0.12	n/a	n/a	0.12	6.24	Sag
3-4	3-5	0.4	5.50	7.13	0.66	1.88	0	1.88	0	Dp-Curb	6	16	Sag		0.02	0.02	0.12	n/a	n/a	0.12	5.76	Sag
EX 40F	EX 42A	0.15	6.00	7.00	0.66	0.69	5.79	1.15	5.33	Curb	10	5	0.03	2	0.05	0.02	0.26	0.25	9.35	0.26	10.13	EX 40F
EX 42A	EX 42B	0.43	5.80	7.05	0.66	2.00	0	0.63	1.37	Curb	10	5	0.03	2	0.05	0.02	0.18	0.16	5.04	0.18	6.07	EX 40F
EX 42B	EX 42C	0.84	6.10	6.97	0.66	3.86	0.9	0.84	3.93	Curb	10	5	0.059	2	0.05	0.02	0.21	0.2	7.08	0.21	7.71	EX 40F
4-1	4-2	0.15	5.50	7.13	0.66	0.71	1.07	0.57	1.21	Curb	10	5	0.036	2	0.05	0.02	0.17	0.15	4.5	0.17	5.49	Offsite
4-2	4-3	0.36	6.40	6.89	0.66	1.64	0	0.56	1.07	Curb	10	5	0.03	2	0.05	0.02	0.17	0.15	4.43	0.17	5.51	4-2
4-3	4-4	0.33	5.20	7.21	0.66	1.57	0	0.55	1.02	Curb	10	5	0.03	2	0.05	0.02	0.17	0.15	4.3	0.17	5.4	5-1
4-2	5-1	0.87	5.80	7.05	0.66	4.05	1.02	0.97	4.09	Curb	10	5	0.036	2	0.05	0.02	0.24	0.22	8.04	0.24	8.81	Offsite







10 YEAR PIPE																						
D.S. Str.	U.S. Str.	LineLength (ft)	Incr.Area (ac)	TotalArea (ac)	RunoffCoeff. (C)	IncrC x A	TotalC x A	InletTime (min)	TimeConc (min)	RnfalInt (in/hr)	TotalRunoff (cfs)	TotalFlow (cfs)	CapacFull (cfs)	Veloc (ft/s)	PipeSize (in)	PipeSlope (%)	Inv ElevDn (ft)	Inv ElevUp (ft)	HGLDn (ft)	HGLUp (ft)	Grnd/RimDn (ft)	Grnd/RimUp (ft)
1-1	1-2	91.62	0.21	1.65	0.66	0.14	1.09	5.2	8	6.5	7.10	7.10	24.70	8.78	18	3.27	936.00	939.00	936.55	940.03	937.50	945.00
1-2	1-3	140.08	0.87	1.44	0.66	0.57	0.95	6.2	7.7	6.6	6.26	6.26	21.58	7.89	18	2.50	939.50	943.00	940.05	943.97	945.00	949.00
1-3	1-4	280.60	0.12	0.12	0.66	0.08	0.08	5.3	5.3	7.2	0.57	0.57	16.24	1.97	15	3.74	943.50	954.00	943.97	954.29	949.00	959.00
1-3	2-1	139.36	0.17	0.45	0.66	0.11	0.3	6	6.1	7	2.07	2.07	18.13	4.36	15	4.66	943.50	950.00	943.97	950.57	949.00	956.76
2-1	2-2	35.00	0.28	0.28	0.66	0.18	0.18	6	6	7	1.29	1.29	10.03	4.44	15	1.43	950.50	951.00	950.80	951.45	956.76	956.76
EX 40F	3-1	205.87	0.00	1.21	0	0	0.8	0	6.6	6.8	5.46	5.46	46.87	7.22	24	4.29	924.64	933.48	925.10	934.30	928.29	943.00
3-1	3-2	54.41	0.00	1.21	0	0	0.8	0	6.5	6.9	5.49	5.49	27.33	5.64	24	0.86	933.73	934.20	934.34	935.03	943.00	946.27
3-2	3-3	153.54	0.36	1.21	0.66	0.24	0.8	5.3	6.2	6.9	5.54	5.54	19.52	9.60	15	5.41	934.70	943.00	935.16	943.95	946.27	950.00
3-3	3-4	140.00	0.45	0.85	0.66	0.3	0.56	5.5	5.9	7	3.94	3.94	18.09	7.28	15	4.64	943.50	950.00	943.95	950.80	950.00	956.88
3-4	3-5	140.00	0.40	0.4	0.66	0.26	0.26	5.5	5.5	7.1	1.88	1.88	18.77	5.94	15	5.00	950.50	957.50	950.80	958.05	956.88	962.65
EX 40F	EX 42A	43.25	0.15	1.42	0.66	0.1	0.94	6	6.5	6.9	6.43	6.43	26.65	11.93	15	10.08	923.86	928.22	924.28	929.24	928.29	932.67
EX 42A	EX 42B	33.90	0.43	1.27	0.66	0.28	0.84	5.8	6.4	6.9	5.77	5.77	6.27	5.72	15	0.94	928.68	929.00	929.62	929.97	932.67	932.68
EX 42B	EX 42C	97.97	0.84	0.84	0.66	0.55	0.55	6.1	6.1	7	3.86	3.86	18.45	4.98	15	4.83	929.25	933.98	929.97	934.77	932.68	937.53
4-1	4-2	67.50	0.15	1.71	0.66	0.1	1.13	5.5	6.8	6.8	7.65	7.65	21.98	8.49	18	2.59	949.75	951.50	950.36	952.57	951.25	957.48
4-2	4-3	135.00	0.36	0.69	0.66	0.24	0.46	6.4	6.4	6.9	3.14	3.14	14.45	5.05	15	2.96	952.00	956.00	952.57	956.71	957.48	962.04
4-3	4-4	71.46	0.33	0.33	0.66	0.22	0.22	5.2	5.2	7.2	1.57	1.57	14.90	5.67	15	3.15	956.50	958.75	956.77	959.25	962.04	963.90
4-2	5-1	35.00	0.87	0.87	0.66	0.57	0.57	5.8	5.8	7	4.05	4.05	10.03	6.10	15	1.43	952.00	952.50	952.57	953.31	957.48	957.48

100 YEAR INLET																						
D.S. Str.	Str.	Area (ac)	InletTime (min)	Int. (in/hr)	RunoffCoeff. (C)	Q =CIA (cfs)	Q Carry-over (cfs)	QCaptured (cfs)	QBypassed (cfs)	JunctType	CurbHeight (in)	CurbLength (ft)	GutterSlope (ft/ft)	GutterWidth (ft)	CrossSlope, Sw (ft/ft)	CrossSlope, Sx (ft/ft)	InletDepth (ft)	BypassDepth (ft)	BypassSpread (ft)	GutterDepth (ft)	GutterSpread (ft)	Bypass Str.
1-1	1-2	0.21	5.20	10.91	0.66	1.51	0	1.51	0	Dp-Curb	6	16	Sag		0.02	0.02	0.1	n/a	n/a	0.1	4.98	Sag
1-2	1-3	0.87	6.20	10.50	0.66	6.03	0	6.03	0	Dp-Curb	6	16	Sag		0.02	0.02	0.25	n/a	n/a	0.25	12.54	Sag
1-3	1-4	0.12	5.30	10.87	0.66	0.86	0	0.86	0	Dp-Curb	6	16	Sag		0.02	0.02	0.07	n/a	n/a	0.07	3.42	Sag
1-3	2-1	0.17	6.00	10.58	0.66	1.19	0	0.38	0.81	Curb	10	5	0.078	2	0.05	0.02	0.13	0.11	2.73	0.13	3.55	EX 42A
2-1	2-2	0.28	6.00	10.58	0.66	1.96	0	0.49	1.46	Curb	10	5	0.078	2	0.05	0.02	0.15	0.14	4.02	0.15	4.73	EX 42C
EX 40F	3-1	0.00	0.00	0.00	0.00	0.00				MH												
3-1	3-2	0.00	0.00	0.00	0.00	0.00				MH												
3-2	3-3	0.36	5.30	10.87	0.66	2.58	0	2.58	0	Dp-Curb	6	16	Sag		0.02	0.02	0.14	n/a	n/a	0.14	7.12	Sag
3-3	3-4	0.45	5.50	10.79	0.66	3.20	0	3.2	0	Dp-Curb	6	16	Sag		0.02	0.02	0.16	n/a	n/a	0.16	8.22	Sag
3-4	3-5	0.40	5.50	10.79	0.66	2.85	0	2.85	0	Dp-Curb	6	16	Sag		0.02	0.02	0.15	n/a	n/a	0.15	7.6	Sag
EX 40F	EX 42A	0.15	6.00	10.58	0.66	1.05	9.33	1.46	8.91	Curb	10	5	0.03	2	0.05	0.02	0.31	0.29	11.53	0.31	12.26	EX 40F
EX 42A	EX 42B	0.43	5.80	10.66	0.66	3.03	0	0.78	2.25	Curb	10	5	0.03	2	0.05	0.02	0.21	0.19	6.41	0.21	7.33	EX 40F
EX 42B	EX 42C	0.84	6.10	10.54	0.66	5.85	1.46	1.04	6.27	Curb	10	5	0.059	2	0.05	0.02	0.25	0.23	8.68	0.25	9.26	EX 40F
4-1	4-2	0.15	5.50	10.79	0.66	1.07	1.78	0.72	2.12	Curb	10	5	0.036	2	0.05	0.02	0.2	0.18	5.97	0.2	6.84	Offsite
4-2	4-3	0.36	6.40	10.43	0.66	2.48	0	0.7	1.78	Curb	10	5	0.03	2	0.05	0.02	0.19	0.17	5.73	0.19	6.7	4-2
4-3	4-4	0.33	5.20	10.91	0.66	2.38	0	0.69	1.69	Curb	10	5	0.03	2	0.05	0.02	0.19	0.17	5.59	0.19	6.57	5-1
4-2	5-1	0.87	5.80	10.66	0.66	6.12	1.69	1.21	6.6	Curb	10	5	0.036	2	0.05	0.02	0.27	0.26	9.83	0.27	10.54	Offsite

100 YEAR PIPE																						
D.S. Str.	U.S. Str.	LineLength (ft)	Incr.Area (ac)	TotalArea (ac)	RunoffCoeff. (C)	IncrC x A	TotalC x A	InletTime (min)	TimeConc (min)	RnfalInt (in/hr)	TotalRunoff (cfs)	TotalFlow (cfs)	CapacFull (cfs)	Veloc (ft/s)	PipeSize (in)	PipeSlope (%)	Inv ElevDn (ft)	Inv ElevUp (ft)	HGLDn (ft)	HGLUp (ft)	Grnd/RimDn (ft)	Grnd/RimUp (ft)
1-1	1-2	91.62	0.21	1.65	0.66	0.14	1.09	5.2	7.8	9.9	10.79	10.79	24.70	10.16	18	3.27	936.00	939.00	936.69	940.26	937.50	945.00
1-2	1-3	140.08	0.87	1.44	0.66	0.57	0.95	6.2	7.6	10	9.51	9.51	21.58	8.46	18	2.50	939.50	943.00	940.26	944.19	945.00	949.00
1-3	1-4	280.60	0.12	0.12	0.66	0.08	0.08	5.3	5.3	10.9	0.86	0.86	16.24	2.07	15	3.74	943.50	954.00	944.19	954.36	949.00	959.00
1-3	2-1	139.36	0.17	0.45	0.66	0.11	0.3	6	6.1	10.5	3.13	3.13	18.13	4.42	15	4.66	943.50	950.00	944.19	950.71	949.00	956.76
2-1	2-2	35.00	0.28	0.28	0.66	0.18	0.18	6	6	10.6	1.96	1.96	10.03	5.02	15	1.43	950.50	951.00	950.87	951.56	956.76	956.76
EX 40F	2-3	205.87	0.00	1.21	0	0	0.8	0	6.6	10.3	8.26	8.26	46.87	8.17	24	4.29	924.64	933.28	945.21	934.50	928.29	943.70
3-1	3-2	54.41	0.00	1.21	0	0	0.8	0	6.5	10.4	8.31	8.31	27.33	6.26	24	0.86	933.73	934.20	934.50	935.23	943.00	946.27
3-2	3-3	153.54	0.36	1.21	0.66	0.24	0.8	5.3	6.2	10.5	8.38	8.38	19.52	11.23	15	5.41	934.70	943.00	935.27	943.13	946.27	950.00
3-3	3-4	140.00	0.45	0.85	0.66	0.3	0.56	5.5	5.9	10.6	5.95	5.95	18.09	7.66	15	4.64	943.50	950.00	944.13	950.99	950.00	956.88
3-4	3-5	140.00	0.40	0.4	0.66	0.26	0.26	5.5	5.5	10.8	2.85	2.85	18.77	5.32	15	5.00	950.50	950.50	950.99	950.99	956.88	962.65
EX 40F	EX 42A	43.25	0.15	1.42	0.66	0.1	0.94	6	6.5	10.4	9.74	9.74	26.65	14.07	15	10.08	923.86	928.72	924.38	929.40	928.29	932.67
EX 42A	EX 42B	33.90	0.43	1.27	0.66	0.28	0.84	5.8	6.4	10.4	8.74	8.74	6.27	7.12	15	0.94	928.68	929.00	929.93	930.55	932.67	932.68
EX 42B	EX 42C	97.97	0.84	0.84	0.66	0.55	0.55	6.1	6.1	10.5	5.85	5.85	18.45	5.22	15	4.83	929.25	933.98	931.73	934.96	932.68	937.53
4-1	4-2	67.50	0.15	1.71	0.66	0.1	1.13	5.5	6.8	10.3	11.59	11.59	21.98	9.87	18	2.59	949.75	951.50	950.52	952.80	951.25	957.48
4-2	4-3	135.00	0.36	0.69	0.66	0.24	0.46	6.4	6.4	10.4	4.75	4.75	14.45	5.44	15	2.96	952.00	956.00	952.80	956.88	957.48	962.04
4-3	4-4	71.46	0.33	0.33	0.66	0.22	0.22	5.2	5.2	10.9	2.38	2.38	14.90	5.70	15	3.15	956.50	958.75	956.88	959.37	962.04	963.90
4-2	5-1	35.00	0.87	0.87	0.66	0.57	0.57	5.8	5.8	10.7	6.12	6.12	10.03	6.62	15	1.43	952.00	952.50	952.80	953.50	957.48	957.48

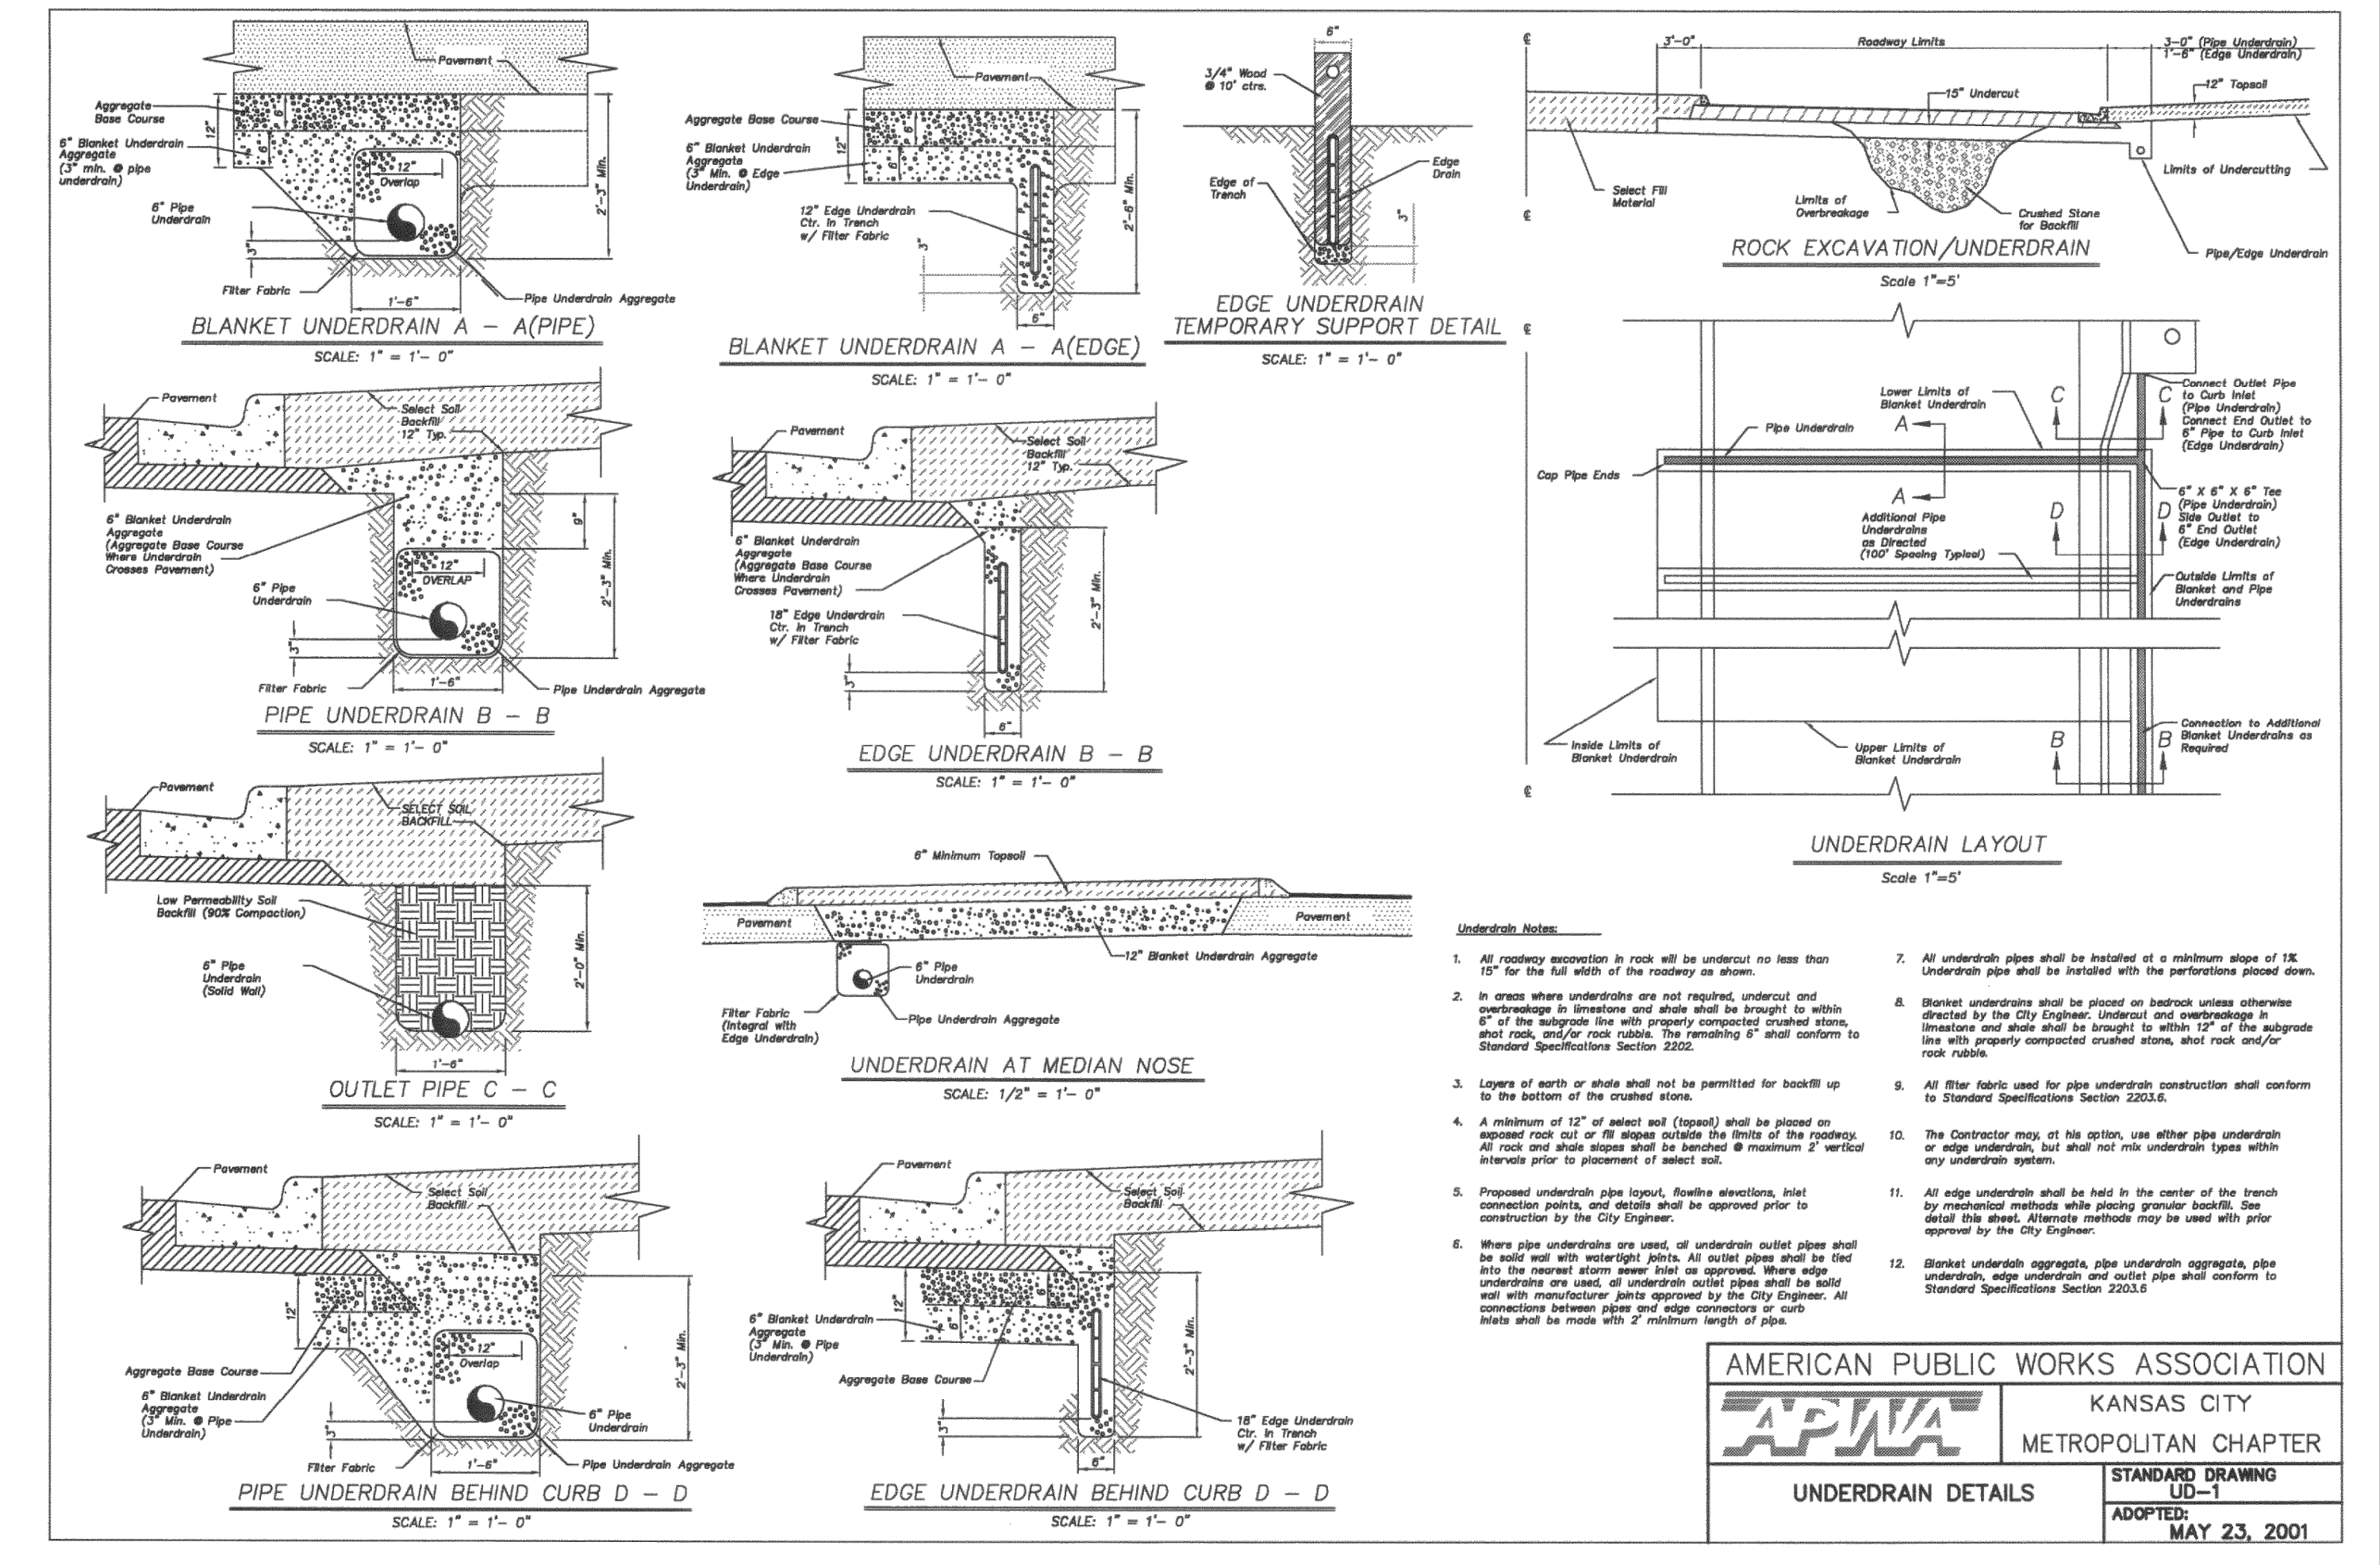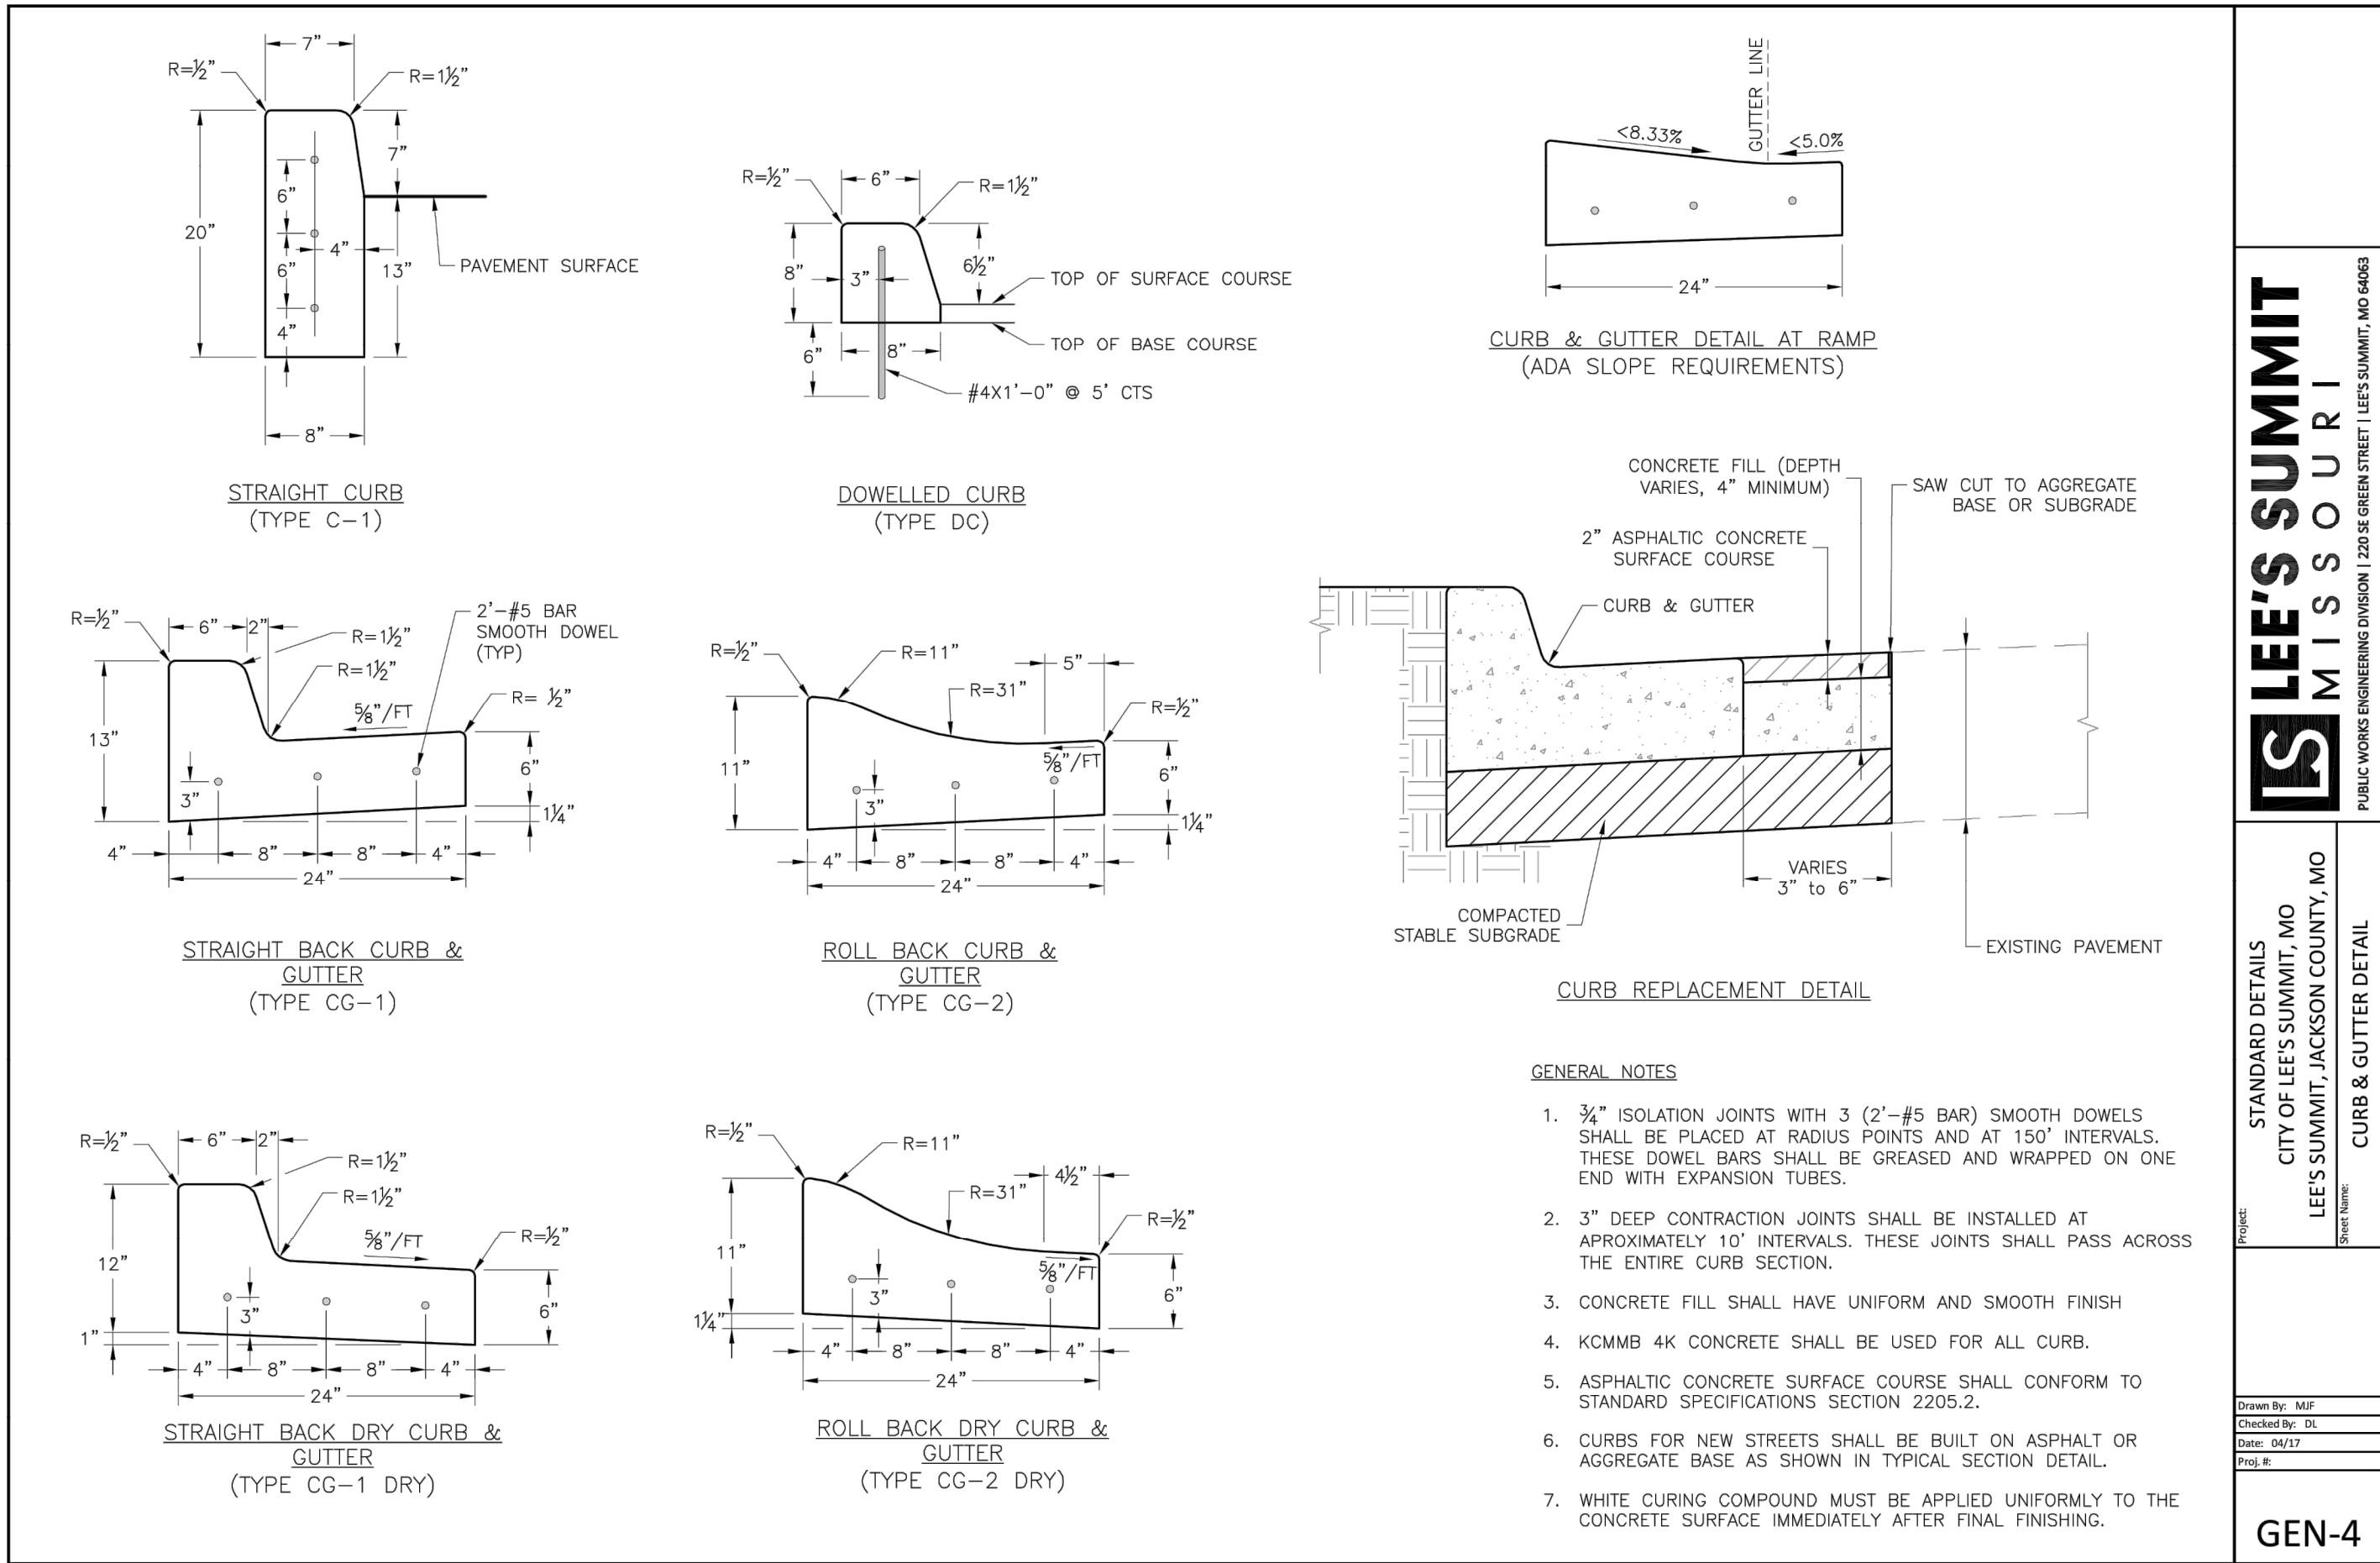

GENERAL NOTE:
1 - ALL CONSTRUCTION SHALL CONFORM TO THE CITY OF LEE'S SUMMIT DESIGN AND CONSTRUCTION MANUAL AS ADOPTED BY ORDINANCE 5813.

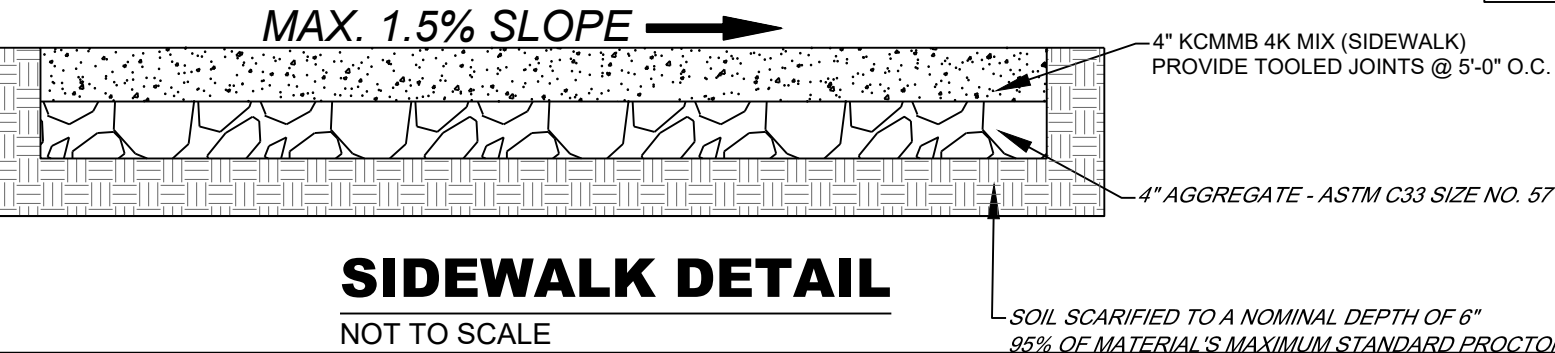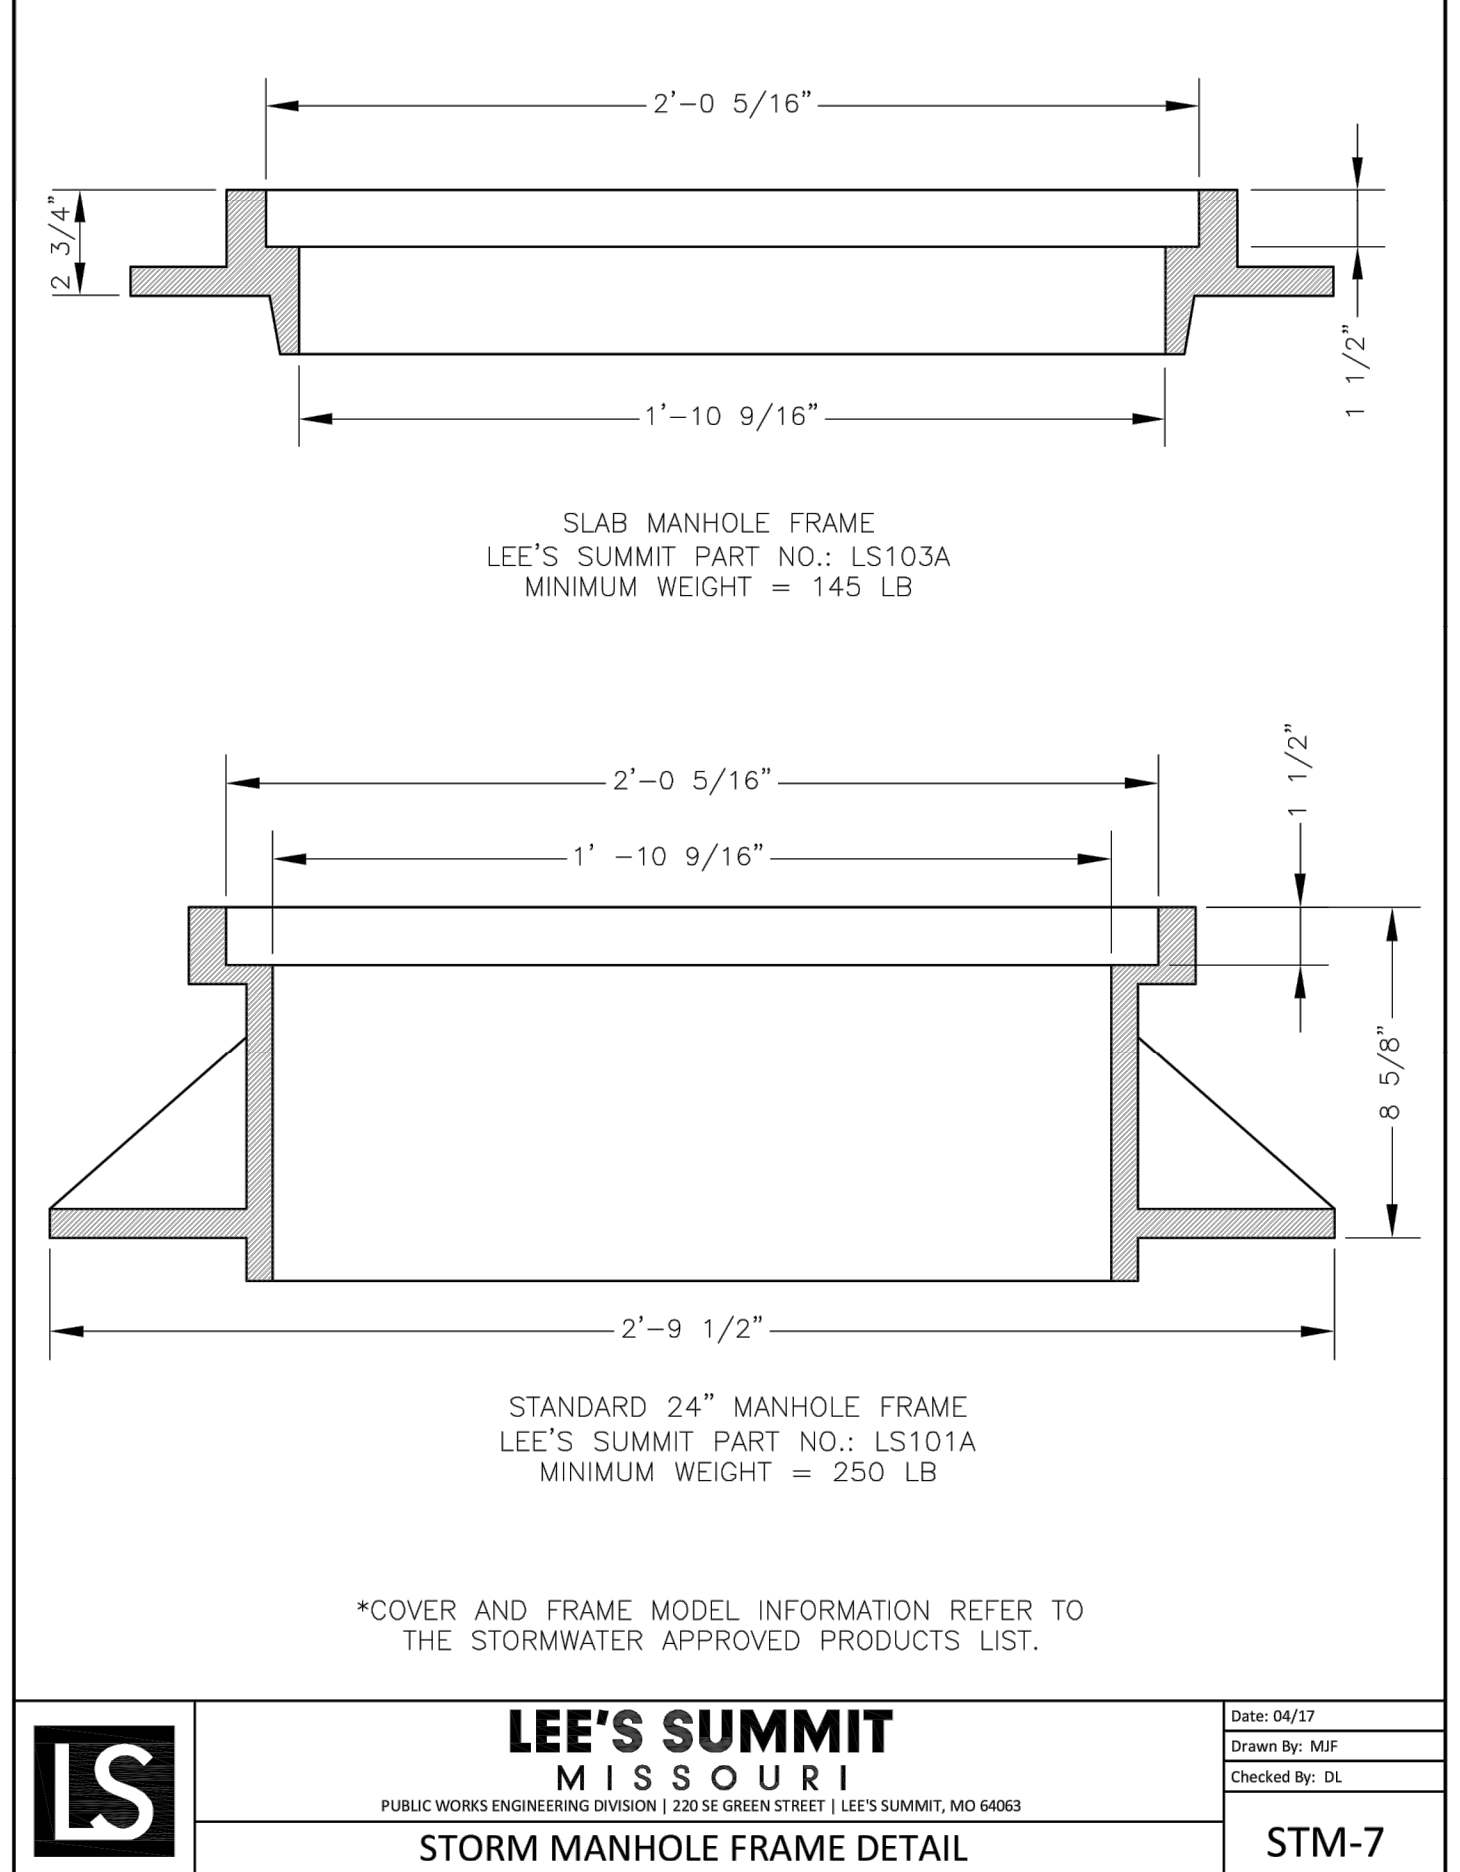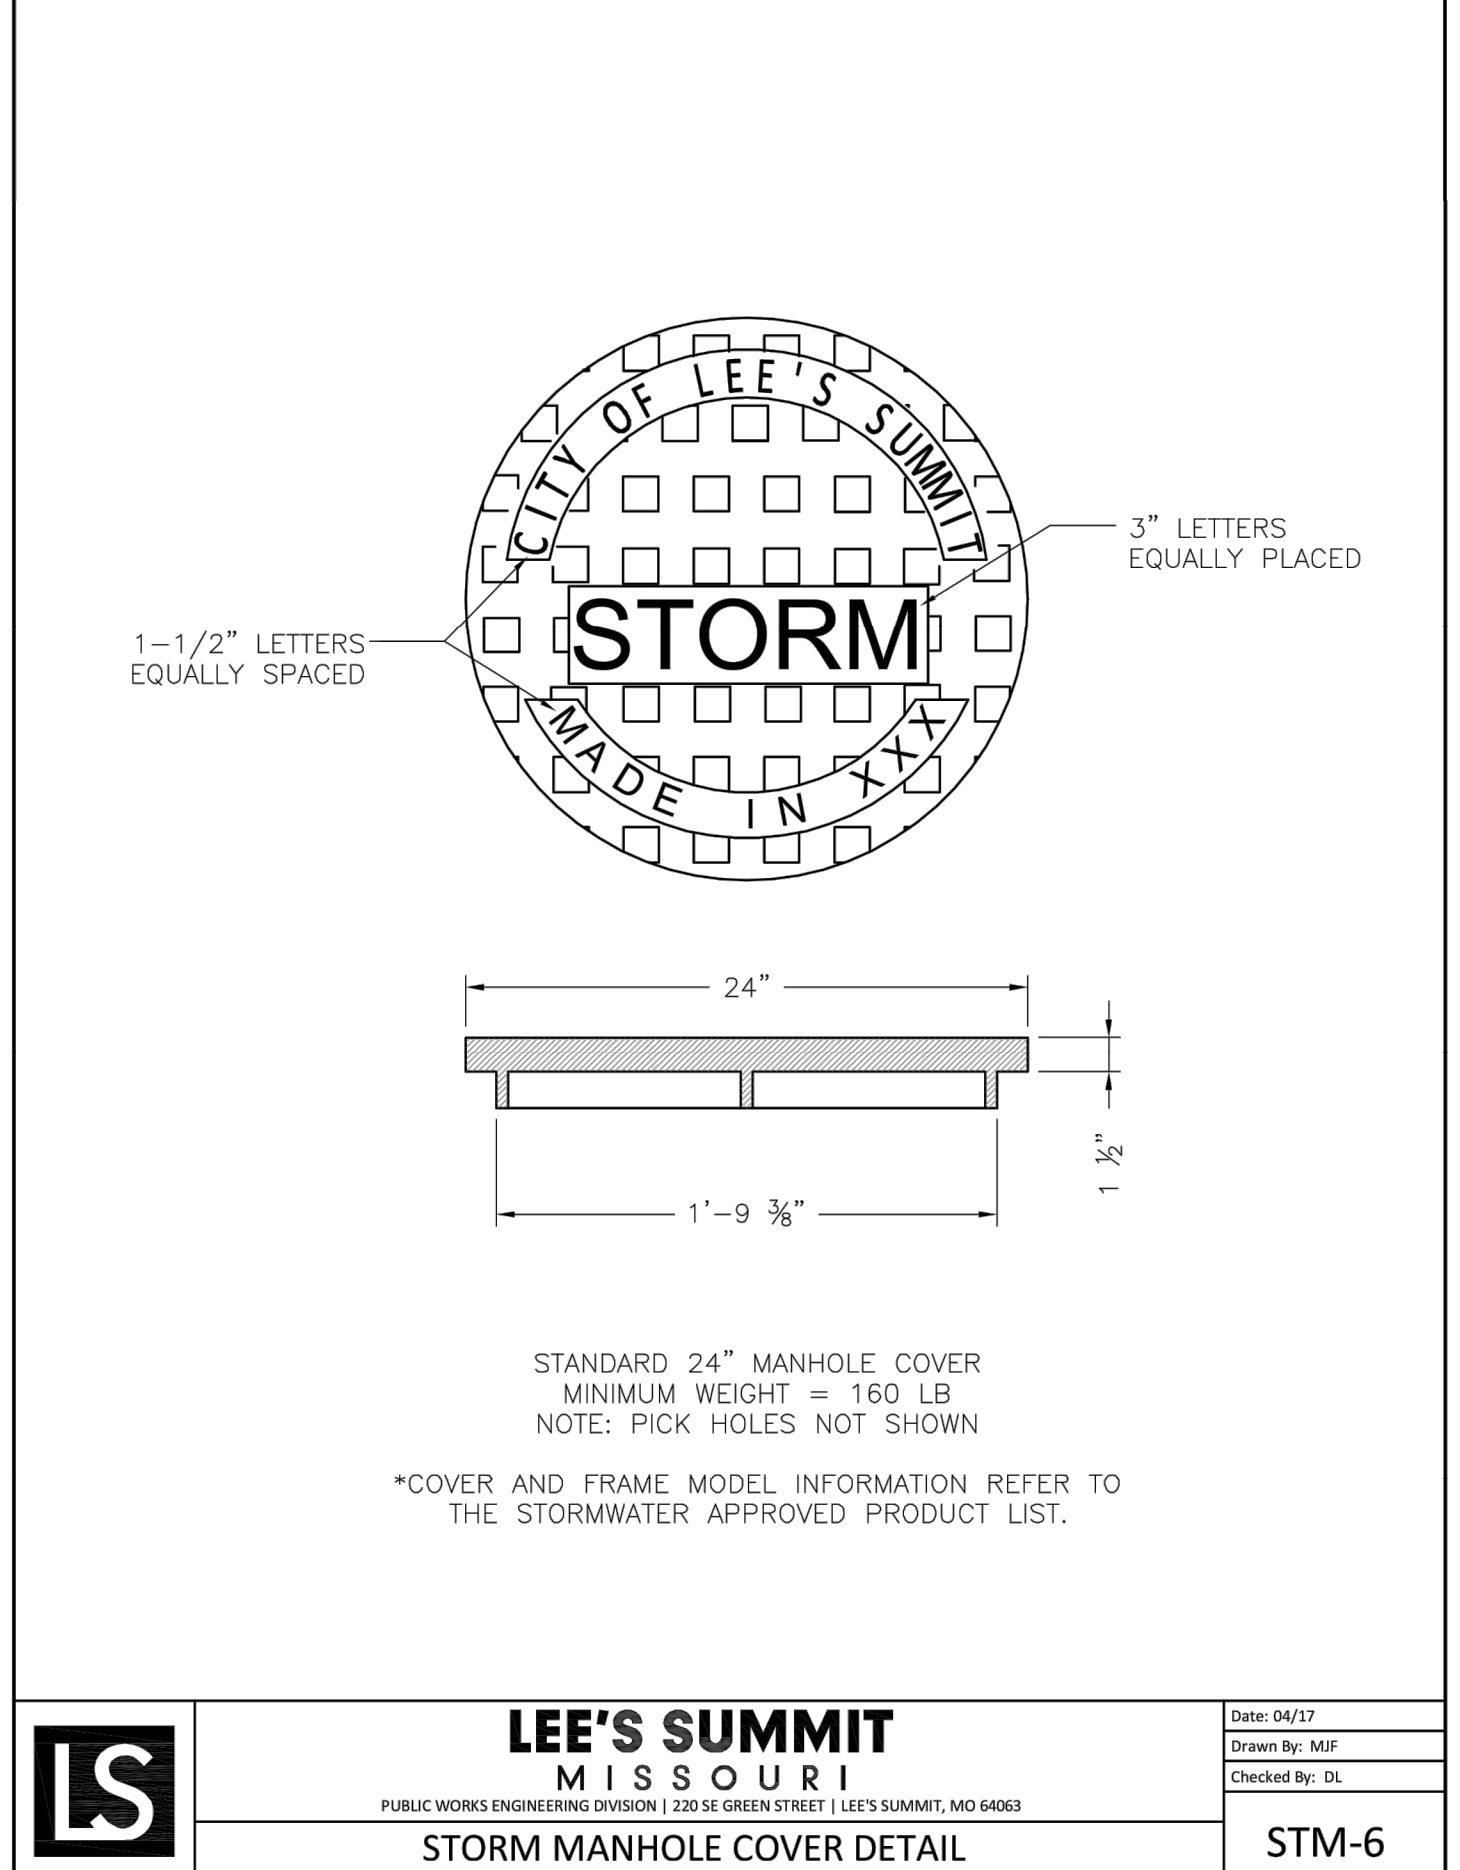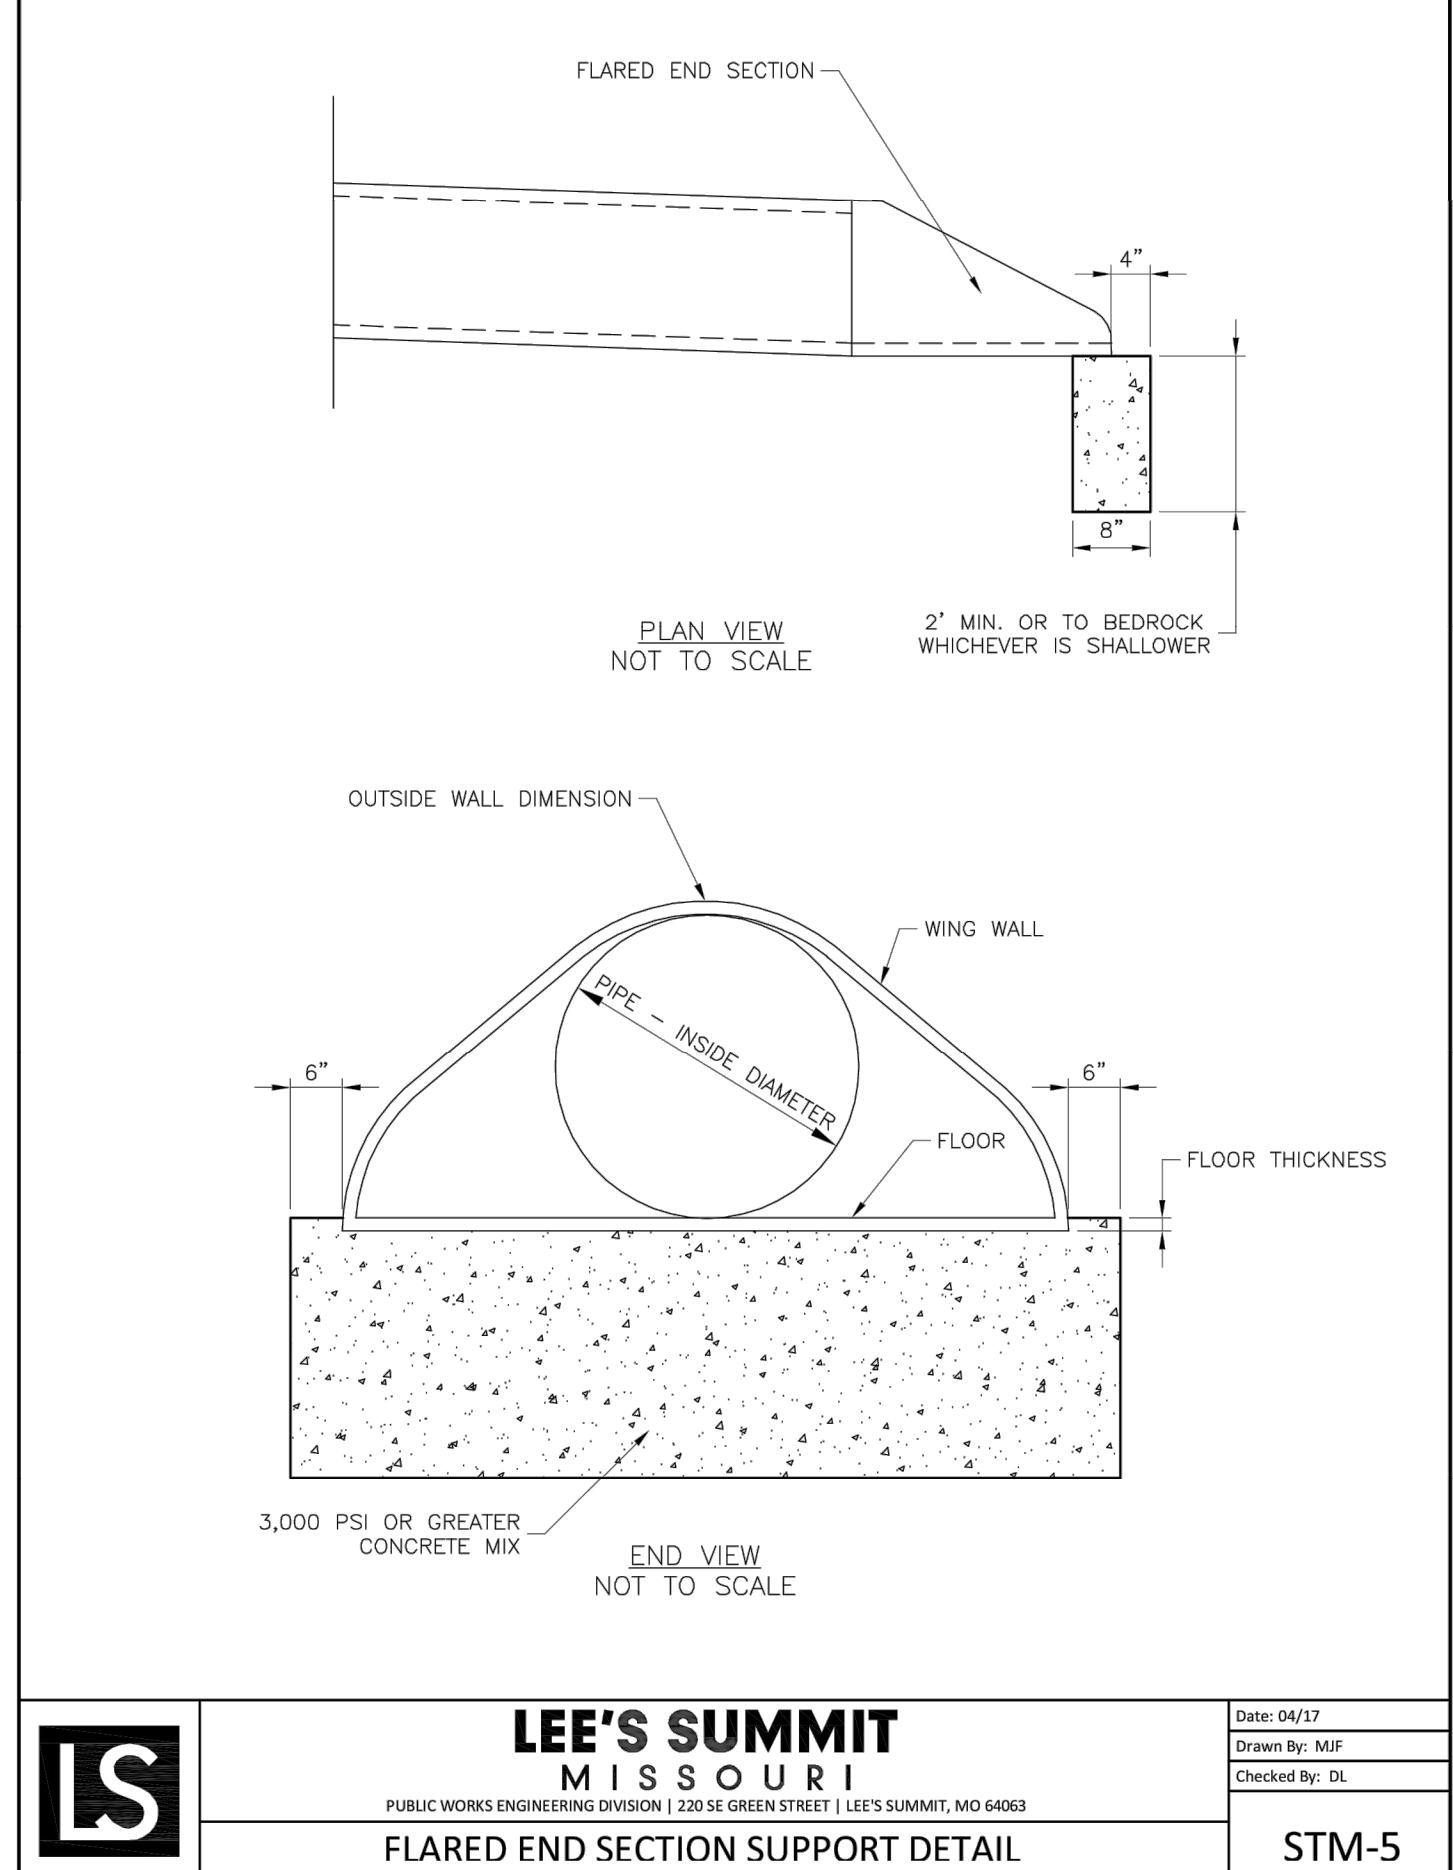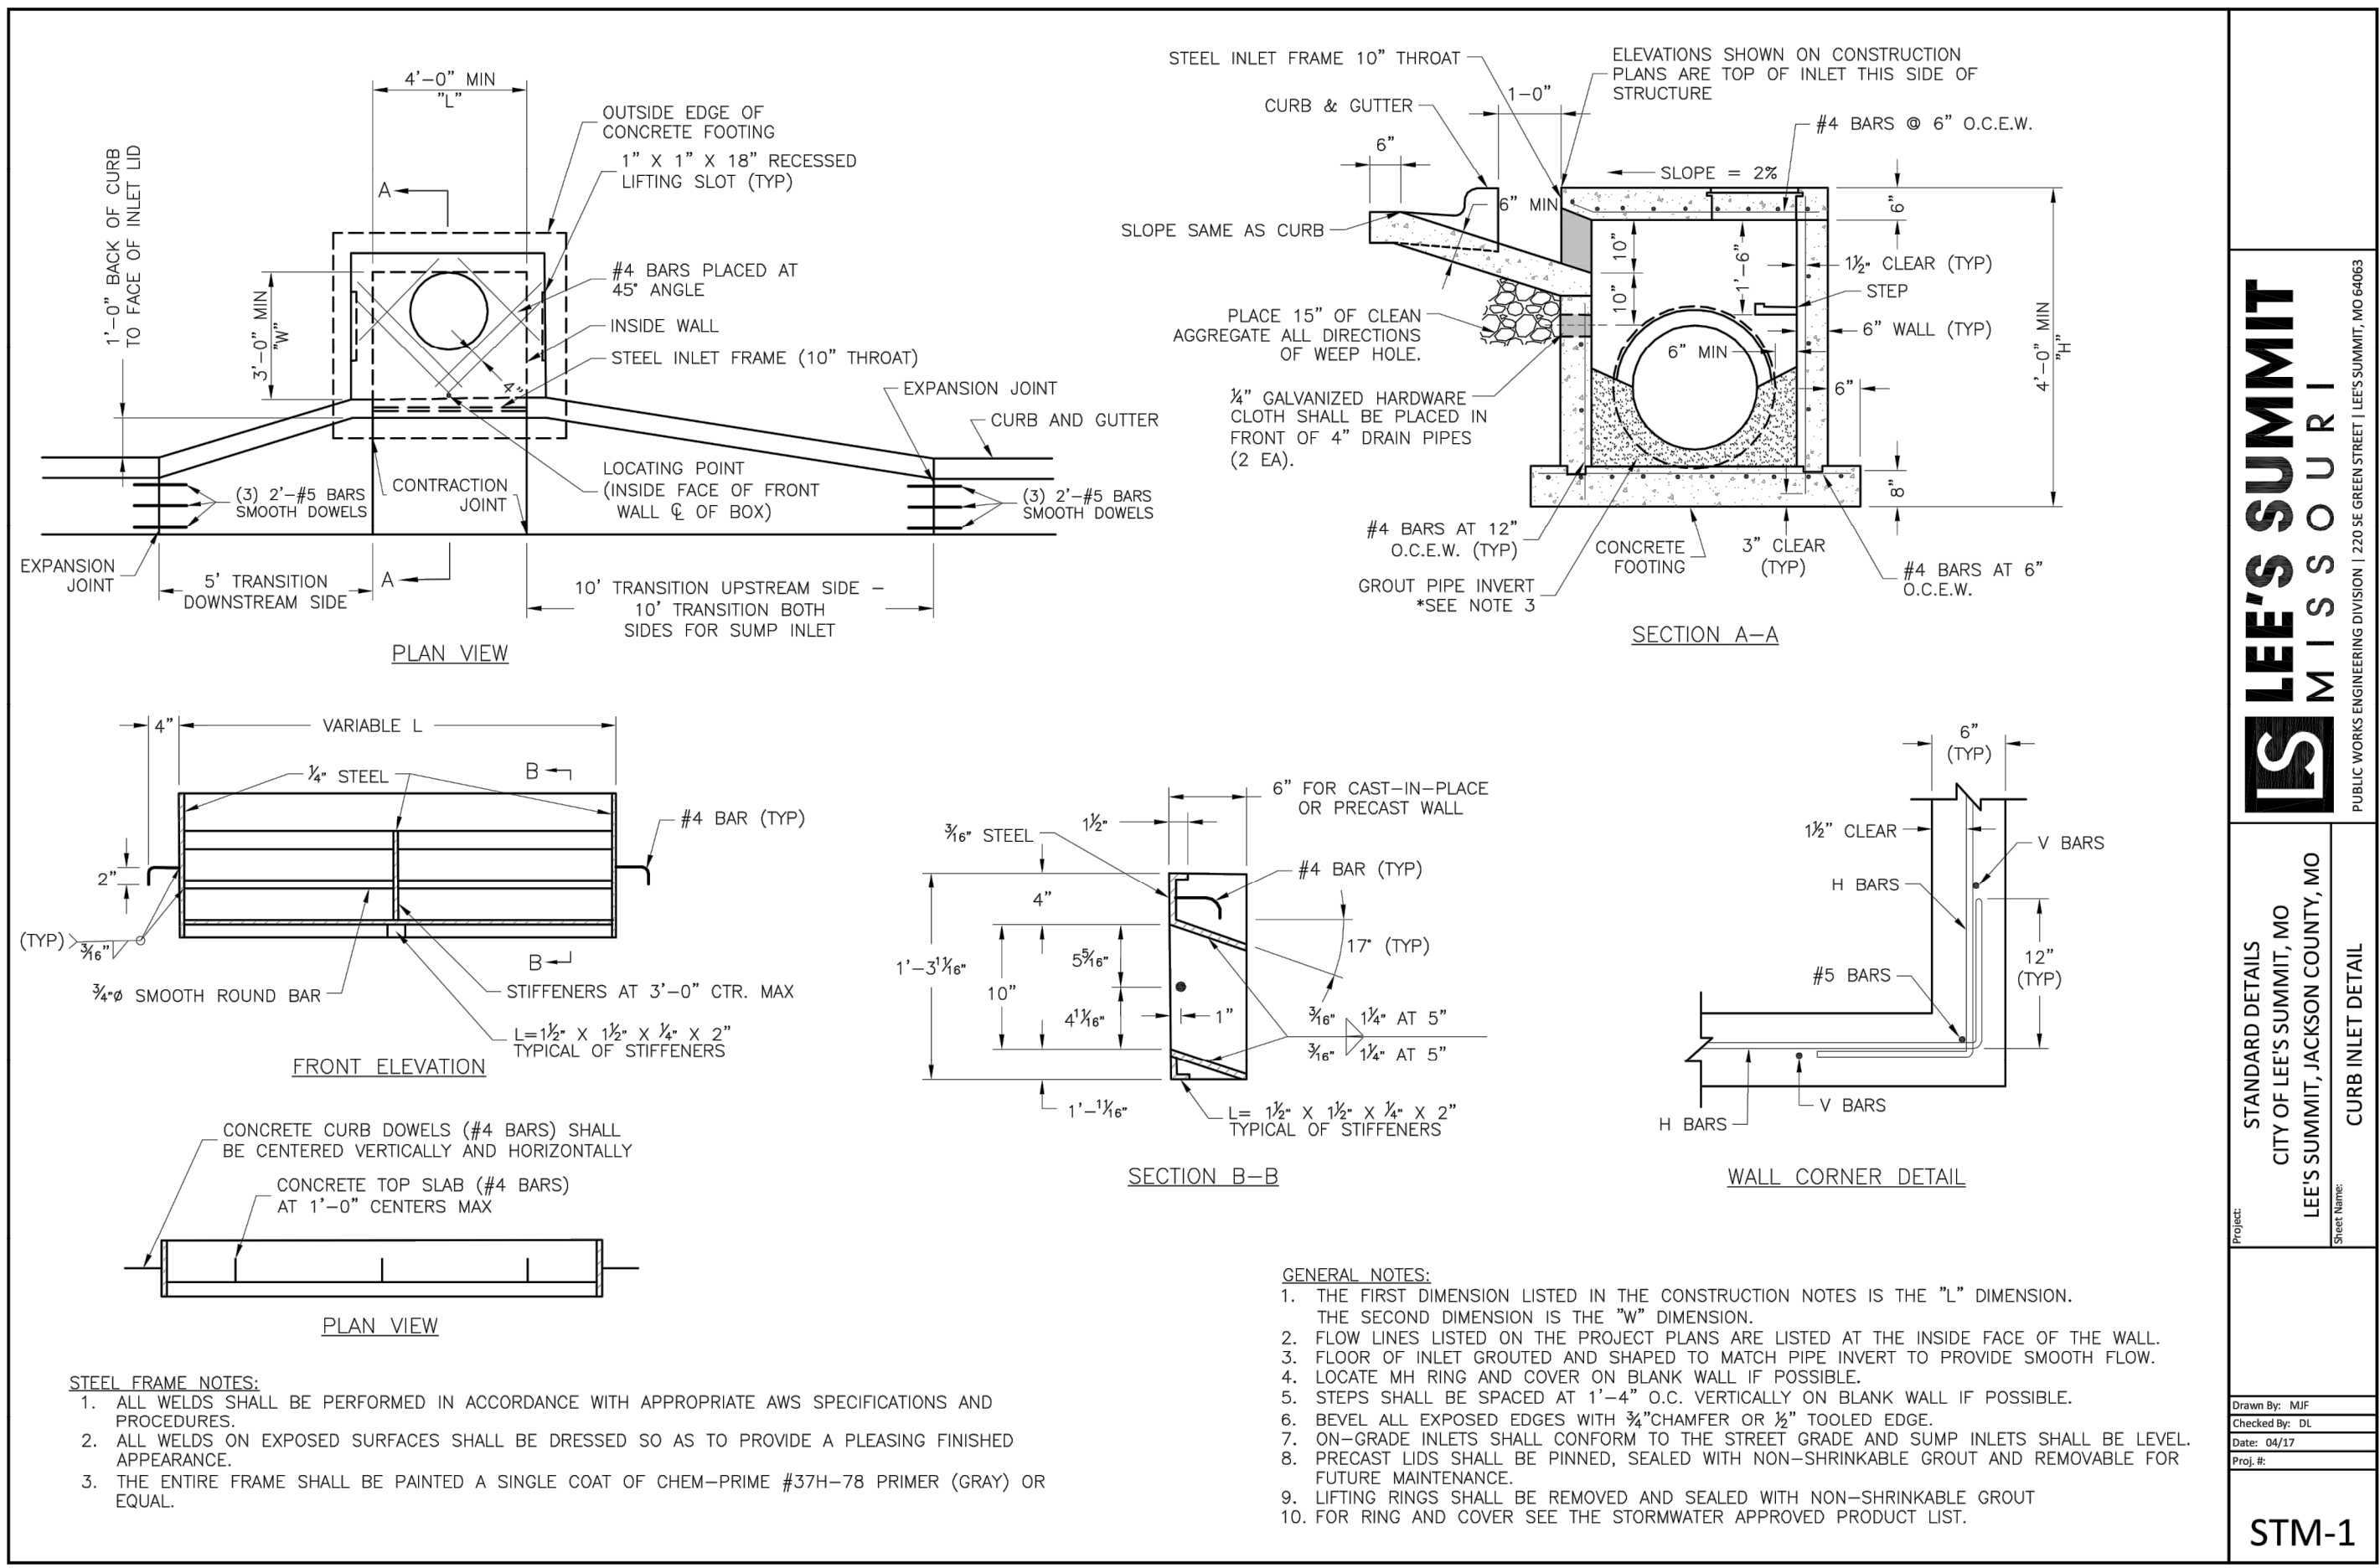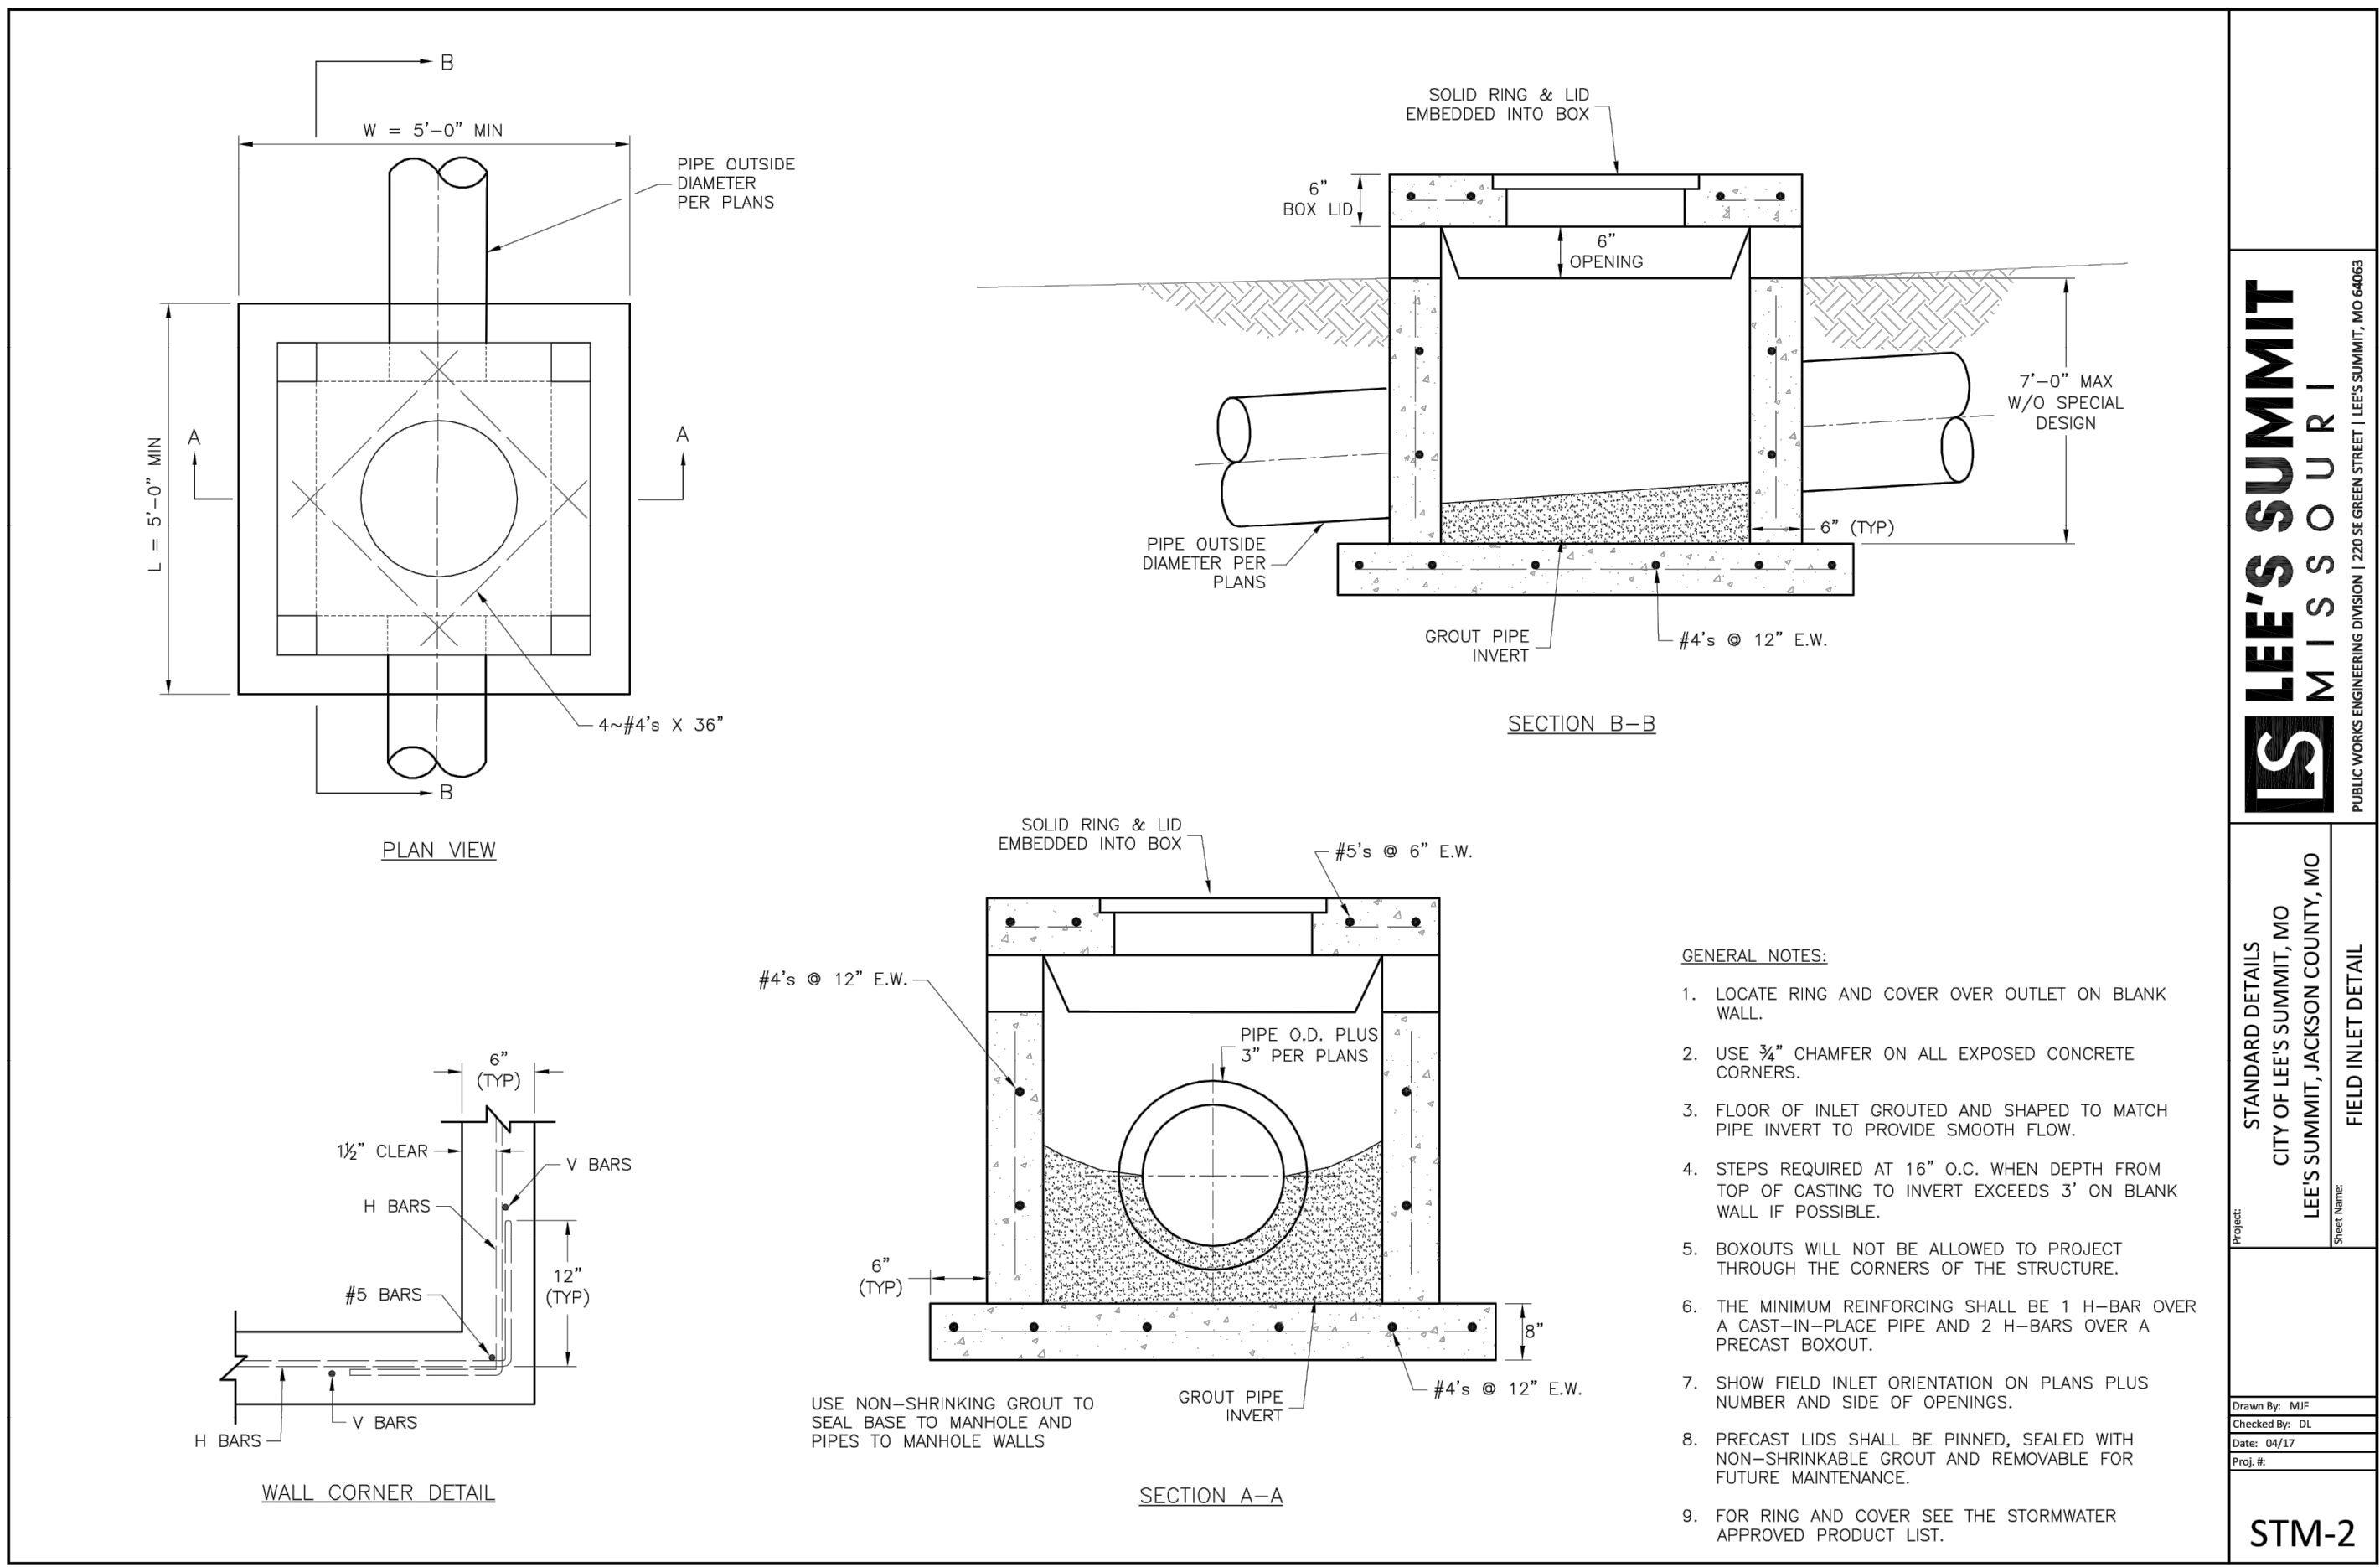

GENERAL NOTE:
1 - ALL CONSTRUCTION SHALL CONFORM TO THE CITY OF LEE'S SUMMIT DESIGN AND CONSTRUCTION MANUAL AS ADOPTED BY ORDINANCE 5813.