



Permit Review Drawings For

CREEKSIDE AT RAINTREE LOTS 1 THRU 31 AND TRACTS A THRU F STREET, STORM, MASS GRADING, & EROSION/SEDIMENT CONTROL PLANS

IN THE CITY OF LEE'S SUMMIT
JACKSON & CASS COUNTY, MISSOURI

SECTION 31, TOWNSHIP 47 N, RANGE 31 W
SECTION 32, TOWNSHIP 47 N, RANGE 31 W
SECTION 5, TOWNSHIP 46 N, RANGE 31 W

HDR Project No.
10028402-276408

Lee's Summit, MO
February 2017

PLAN SHEET INDEX

01C-CR-00	COVER SHEET
01C-CR-01	GENERAL LAYOUT AND NOTES
01C-CR-02	MASS GRADING PLAN
01C-CR-03	PRE-CLEARING EROSION AND SEDIMENT CONTROL PLAN
01C-CR-04	INACTIVE AREA STABILIZATION EROSION AND SEDIMENT CONTROL PLAN
01C-CR-05	FINAL RESTORATION EROSION AND SEDIMENT CONTROL PLAN
01C-CR-06	EROSION AND SEDIMENT CONTROL DETAILS
01C-CR-07	EROSION AND SEDIMENT CONTROL DETAILS
01C-CR-08	MASTER DRAINAGE PLAN
01C-CR-09	TYPICAL ADA RAMP DETAILS
01C-CR-10	TYPICAL ADA RAMP DETAILS
01C-CR-11	TYPICAL ROAD SECTION AND DETAILS
01C-CR-12	STREET PLAN & PROFILE SW MEADOWBROOK DR
01C-CR-13	STREET PLAN & PROFILE SW NAUTILUS PL
01C-CR-14	INTERSECTION AND SIGNAGE DETAILS
01C-CR-15	STORMWATER DRAINAGE MAP
01C-CR-16	STORM SEWER PLAN & PROFILE LINE 1-10 AND LINE 1-11
01C-CR-17	STORM SEWER PLAN & PROFILE LINE 1-20
01C-CR-18	STORM SEWER DETAILS
01C-CR-19	STORM SEWER DETAILS



3741 NE TROON DR
LEE'S SUMMIT, MO 64064
816.347.1100

MO STATE CERTIFICATE OF
AUTHORITY #000856

PROJECT FOR

**LANDROCK
DEVELOPMENT, LLC**

**CREEKSIDE AT RAINTREE
LOTS 1 THRU 31
LEE'S SUMMIT, MISSOURI**

MARK	DATE	CITY SUBMITTAL DESCRIPTION
B	04/14/2017	CITY RESUBMITTAL
A	03/08/2017	CITY SUBMITTAL

PROJECT NUMBER	10028825-276408
ORIGINAL ISSUE	MARCH 7, 2017

PROJECT MANAGER	SIMON SUN
PROJECT ENGINEER	WILL NEDS, E.I.T.



SHEET NAME

COVER SHEET

SCALE NO SCALE

SHEET NUMBER

01C-CR-00

FILE NAME 01C-CR-00.dwg

PERMIT REVIEW DRAWINGS

OWNER CONTACT

J.P. Roberts
Landrock Development, LLC
4335 McGee St
Kansas City, MO 64111
jp@landrocksignaturehomes.com
(816) 863-5588

CONSULTANT CONTACT

Simon Sun
HDR Engineering, Inc.
4435 Main St, Suite 1000
Kansas City, MO 64111
simon.sun@hdrinc.com
(816) 360-2756

UTILITIES

ELECTRIC: KCP&L	816-471-5275
GAS: LACLEDE GAS, MISSOURI GAS ENERGY DIVISION	816-756-5252
TELEPHONE: AT&T	816-325-5607
CABLE: TIME WARNER	816-358-8833
WATER: LEE'S SUMMIT WATER UTILITIES	816-969-1900
SEWER: LEE'S SUMMIT PUBLIC WORKS	816-969-1800
INTERCEPTOR SEWER: LITTLE BLUE VALLEY SEWER DISTRICT	816-796-7660



Know what's below.
Call before you dig.

UTILITY NOTES:
VISUAL INDICATIONS OF UTILITIES ARE AS SHOWN. UNDERGROUND LOCATIONS SHOWN, AS FURNISHED BY THEIR LESSORS, ARE APPROXIMATE AND SHOULD BE VERIFIED IN THE FIELD AT THE TIME OF CONSTRUCTION. FOR ACTUAL FIELD LOCATIONS OF UNDERGROUND UTILITIES IN MISSOURI, CALL 1-800-344-7483.

"AS-BUILT"
October 29, 2018

LEGEND AND SYMBOLS	
W	EXISTING WATER LINE
SS	EXISTING SANITARY SEWER LINE
FM	EXISTING SANITARY SEWER FORCE MAIN
SD	EXISTING STORM SEWER LINE
G	EXISTING GAS LINE
UGT	EXISTING UNDERGROUND TELEPHONE
FO	EXISTING UNDERGROUND FIBER OPTIC
OHE	EXISTING OVERHEAD ELECTRIC
UGE	EXISTING UNDERGROUND ELECTRIC
---	EXISTING CENTERLINE
---	EXISTING BOTTOM OF DITCH
---	EXISTING PROPERTY LINE
---	EXISTING ROW
---	EXISTING FENCE
---	EXISTING VEGETATION/BRUSH LINE
○	EXISTING TREE
○	EXISTING SHRUB
○	EXISTING SIGN
○	EXISTING CABLE T.V. PEDESTAL
○	EXISTING TELEPHONE PEDESTAL
○	EXISTING POWER POLE
○	EXISTING LIGHT POLE
○	EXISTING GAS METER
○	EXISTING STORM DRAINAGE MANHOLE
○	EXISTING SANITARY MANHOLE
○	EXISTING WATER VALVE
○	EXISTING WATER METER
○	EXISTING FIRE HYDRANT
△	EXISTING RIGHT OF WAY MARKER
↑	EXISTING DOWNGUY
EXIST	EXISTING
LF	LINEAR FEET

PROPOSED IMPROVEMENTS	
---	PROPOSED BOUNDARY LINE
---	PROPOSED ROW
---	PROPOSED LOT LINE
---	PROPOSED STREET CENTERLINE
---	PROPOSED CURB AND GUTTER
SS	PROPOSED SANITARY SEWER LINE
SD	PROPOSED STORM SEWER LINE
W	PROPOSED WATER LINE
---	PROPOSED EASEMENT LINE
---	PROPOSED BUILDING LINE
⊕	PROPOSED FIRE HYDRANT ASSEMBLY
⊕	PROPOSED WATER VALVE
○	PROPOSED MANHOLE
□	PROPOSED STORM INLET BOX
□	PROPOSED STORM JUNCTION BOX
⊕	PROJECT CONTROL POINT
⊕	PROJECT BENCHMARK

ENGINEERING CONTROL GENERAL NOTE

PROJECT COORDINATES ARE BASED ON THE MISSOURI STATE PLANE COORDINATE SYSTEM, WEST ZONE, UTILIZING JACKSON, MISSOURI GEOGRAPHIC REFERENCE SYSTEM MONUMENTS JA-50 & JA-137 (2003 ADJUSTMENT) AND ARE MODIFIED FROM STATE PLANE TO GROUND COORDINATES BY APPLYING A GRID SCALE FACTOR OF 0.9999011 AT REFERENCE MONUMENT JA-50.

JA-50 - STANDARD KC METRO ALUMINUM GRS DISK SET IN CONCRETE AND FLUSH WITH THE GROUND, STAMPED "JA-50, 1988".
N=992086.045, E=-2804352.667



JA-137 - STANDARD KC METRO ALUMINUM GRS DISK SET IN CONCRETE AND FLUSH WITH THE GROUND, STAMPED "JA-137, 1994".
N=947637.136, E=-2824418.706

PROJECT BENCHMARKS AND CONTROL POINTS:

BMK A	EL=970.63	DESC=TOP NUT OF FIRE HYDRANT	
CPT#1	N=973104.03	E=2822760.87	DESC=60D NAIL
CPT#2	N=973072.20	E=2822601.20	DESC=1/2" IRON BAR
CPT#3	N=972533.90	E=2822625.95	DESC=1/2" IRON BAR
CPT#4	N=972276.15	E=2823116.41	DESC=60D NAIL

- GENERAL NOTES:**
- ALL CONSTRUCTION TO FOLLOW THE CITY OF LEE'S SUMMIT DESIGN AND CONSTRUCTION MANUAL AS ADOPTED BY ORDINANCE 5813.
 - ALL WORKMANSHIP AND MATERIALS SHALL BE SUBJECT TO THE INSPECTION AND APPROVAL OF THE ENGINEERING DEPARTMENT OF THE CITY OF LEE'S SUMMIT, MISSOURI.
 - LINEAL FOOT MEASUREMENTS SHOWN ON THE PLANS ARE HORIZONTAL MEASUREMENTS, NOT SLOPE MEASUREMENTS.
 - NO RECENT GEOLOGICAL INVESTIGATION HAS BEEN PERFORMED ON THIS PROJECT.
 - THE UTILITY LOCATIONS SHOWN ON THESE PLANS ARE TAKEN FROM UTILITY COMPANY RECORDS AND APPARENT FIELD LOCATIONS. THE CONTRACTOR SHALL VERIFY THE LOCATION AND DEPTH OF ALL UTILITIES PRIOR TO CONSTRUCTION.
 - THE CONTRACTOR SHALL ADHERE TO THE PROVISIONS OF THE SENATE BILL NUMBER 583, 78TH GENERAL ASSEMBLY OF THE STATE OF MISSOURI. THE BILL REQUIRES THAT ANY PERSON OR FIRM DOING EXCAVATION ON PUBLIC RIGHT-OF-WAY DO SO ONLY AFTER GIVING NOTICE TO, AND OBTAINING INFORMATION FROM, UTILITY COMPANIES. STATE LAW REQUIRES 72 HOURS ADVANCE NOTICE. THE CONTRACTOR MAY ALSO UTILIZE THE FOLLOWING TOLL FREE PHONE NUMBER PROVIDED BY "MISSOURI ONE CALL SYSTEM, INC.": 1-(800)-DIG RITE OR 811. THIS PHONE NUMBER IS APPLICABLE ANYWHERE WITHIN THE STATE OF MISSOURI. PRIOR TO COMMENCEMENT OF WORK, THE CONTRACTOR SHALL NOTIFY ALL THOSE COMPANIES WHICH HAVE FACILITIES IN THE NEAR VICINITY OF THE CONSTRUCTION TO BE PERFORMED.
 - PRIOR TO ORDERING PRECAST STRUCTURES, SHOP DRAWINGS SHALL BE SUBMITTED TO THE DESIGN ENGINEER FOR APPROVAL.
 - THE CONTRACTOR SHALL PROTECT ALL MAJOR TREES FROM DAMAGE, OUTSIDE OF THE GRADING LIMITS. NO TREE SHALL BE REMOVED WITHOUT PERMISSION OF THE OWNER, UNLESS SHOWN OTHERWISE.
 - CLEARING AND GRUBBING OPERATIONS AND DISPOSAL OF ALL DEBRIS THEREFROM SHALL BE PERFORMED BY THE CONTRACTOR IN STRICT ACCORDANCE WITH ALL LOCAL CODES AND ORDINANCES.

- ALL WASTE MATERIAL RESULTING FROM THE PROJECT SHALL BE DISPOSED OF OFF-SITE BY THE CONTRACTOR, OR AS DIRECTED BY THE OWNER.
- ALL EXCAVATION SHALL BE UNCLASSIFIED.
- THE CONTRACTOR SHALL CONTROL THE EROSION AND SILTATION DURING ALL PHASES OF CONSTRUCTION, AND SHALL KEEP THE STREETS CLEAN OF MUD AND DEBRIS.
- ALL MANHOLES, CATCH BASINS, UTILITY VALVES AND METER PITS TO BE ADJUSTED OR REBUILT TO GRADE AS REQUIRED. ALL EXISTING UTILITIES SHALL BE ADJUSTED AS REQUIRED.
- SUBGRADE SOIL FOR ALL CONCRETE STRUCTURES, REGARDLESS OF THE TYPE OR LOCATION, SHALL BE FIRM, DENSE AND THOROUGHLY COMPACTED AND CONSOLIDATED; SHALL BE FREE FROM MUCK AND MUD; AND SHALL BE SUFFICIENTLY STABLE TO REMAIN FIRM AND INTACT UNDER THE FEET OF THE WORKMEN OR MACHINERY ENGAGED IN SUBGRADE SURFACING, LAYING REINFORCING STEEL, AND DEPOSITING CONCRETE THEREON. IN ALL CASES WHERE SUBSOIL IS MUCKY OR WORKS INTO MUD OR MUCK DURING SUCH OPERATION, A SEAL COURSE OF EITHER CONCRETE OR ROCK SHALL BE PLACED BELOW SUBGRADE TO PROVIDE A FIRM BASE FOR WORKING AND FOR PLACING THE FLOOR SLAB.
- THE CONTRACTOR SHALL CONTACT PUBLIC WORKS INSPECTIONS AT 816-969-1800 TO OBTAIN A PUBLIC WORKS CONSTRUCTION PERMIT. A MINIMUM 48 HOUR NOTICE SHALL BE GIVEN PRIOR TO PERMIT ISSUANCE.
- THE CONTRACTOR SHALL CONTACT THE CITY'S EROSION CONTROL SPECIALIST AT 816-969-1800 PRIOR TO ANY LAND DISTURBANCE.
- THE CONTRACTOR SHALL CONTACT THE RIGHT-OF-WAY INSPECTOR AT 816-969-1800 PRIOR TO ANY LAND DISTURBANCE ACTIVITIES WITHIN THE RIGHT-OF-WAY. THESE ACTIVITIES MAY REQUIRE A PERMIT.
- THE CONTRACTOR SHALL PROVIDE AND MAINTAIN ALL TRAFFIC HANDLING MEASURES NECESSARY TO ENSURE THAT THE GENERAL PUBLIC IS PROTECTED AT ALL TIMES. TRAFFIC CONTROL SHALL CONFORM TO THE MANUAL ON UNIFORM TRAFFIC CONTROL DEVICES (MUTCD - LATEST EDITION).

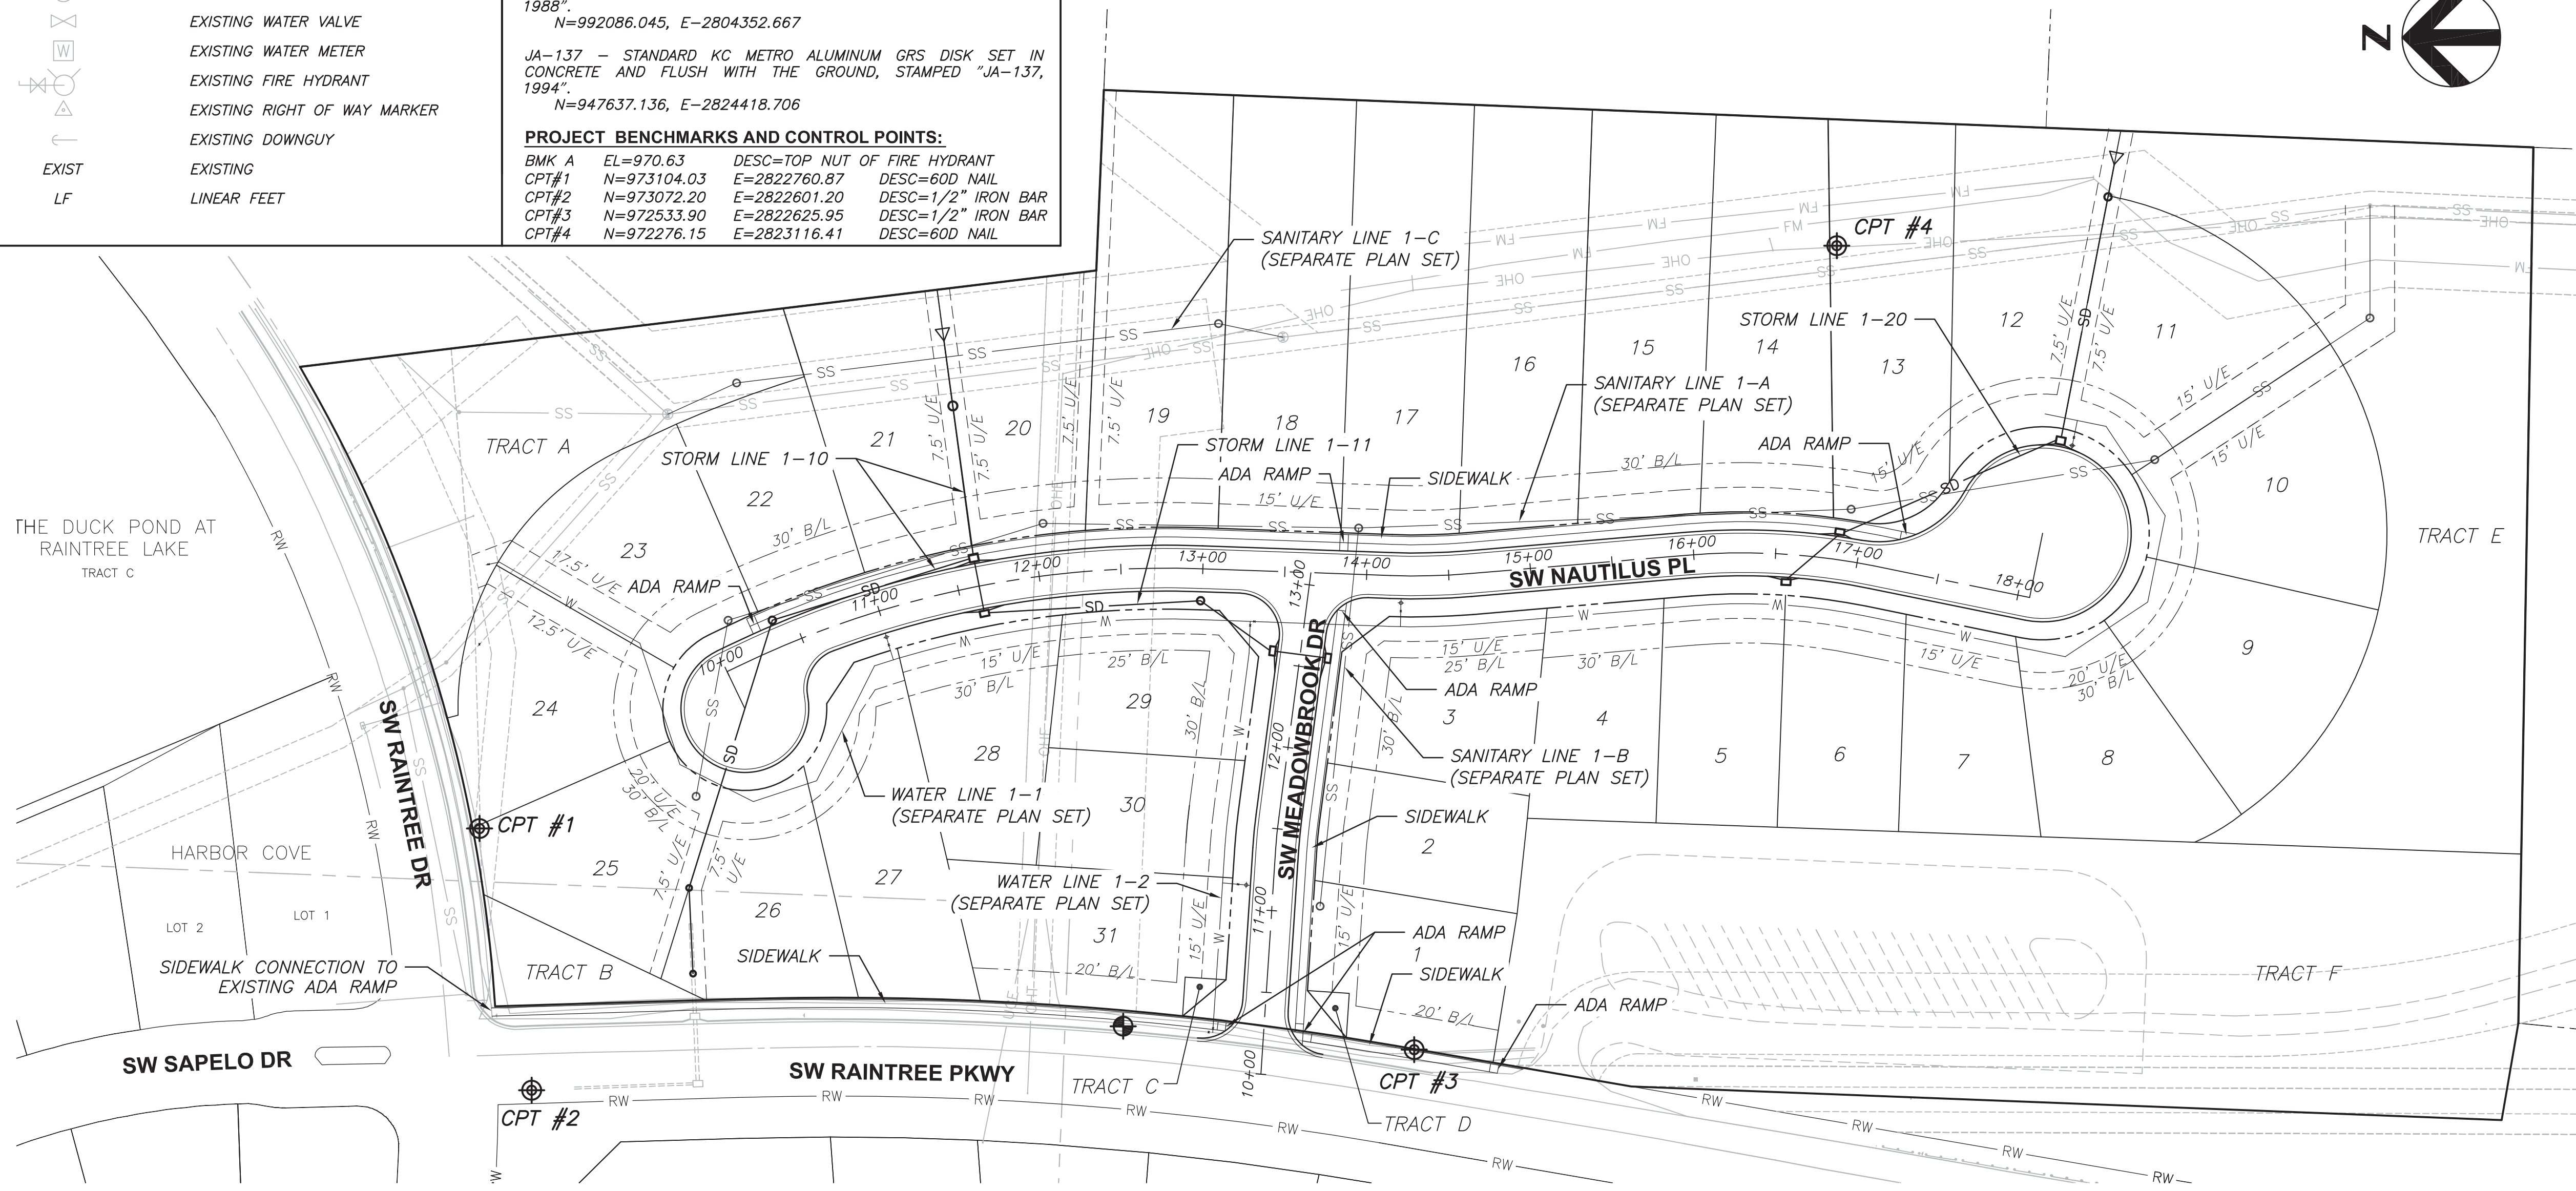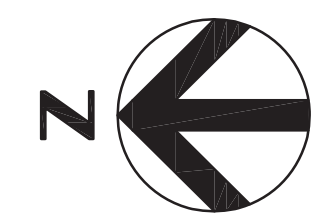

HR

3741 NE TROON DR
LEE'S SUMMIT, MO 64064
816.347.1100

MO STATE CERTIFICATE OF AUTHORITY #000856

PROJECT FOR

LANDROCK DEVELOPMENT, LLC


CREEKSIDE AT RAINTREE LOTS 1 THRU 31 LEE'S SUMMIT, MISSOURI

B	04/14/2017	CITY RESUBMITTAL
A	03/08/2017	CITY SUBMITTAL
MARK	DATE	DESCRIPTION
PROJECT NUMBER	10028825-276408	
ORIGINAL ISSUE	MARCH 7, 2017	
PROJECT MANAGER	SIMON SUN	
PROJECT ENGINEER	WILL NEDS, E.I.T.	



SHEET NAME

GENERAL LAYOUT AND NOTES

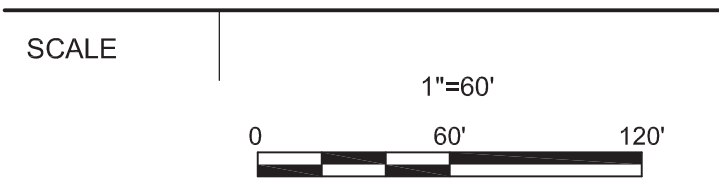

SHEET NUMBER

01C-CR-01

FILE NAME | 01C-CR-01.dwg

PERMIT REVIEW DRAWINGS



3741 NE TROON DR
LEE'S SUMMIT, MO 64064
816.347.1100

MO STATE CERTIFICATE OF
AUTHORITY #000856

PROJECT FOR

**LANDROCK
DEVELOPMENT, LLC**

**CREEKSIDE AT RAINTREE
LOTS 1 THRU 31
LEE'S SUMMIT, MISSOURI**

B	04/14/2017	CITY RESUBMITTAL
A	03/08/2017	CITY SUBMITTAL
MARK	DATE	DESCRIPTION


PROJECT NUMBER	10028825-276408
ORIGINAL ISSUE	MARCH 7, 2017

PROJECT MANAGER	SIMON SUN
PROJECT ENGINEER	WILL NEDS, E.I.T.



SHEET NAME

MASS GRADING PLAN

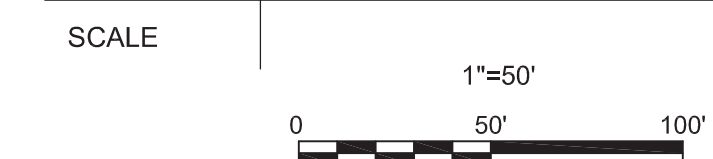

SHEET NUMBER

01C-CR-02

FILE NAME | 01C-CR-02.dwg


PERMIT REVIEW DRAWINGS

LEGEND

- 940 —— MAJOR CONTOUR
- MINOR CONTOUR

GRADING NOTES:

1. SLOPES SHALL BE GRADED AS SHOWN ON THE PLANS WITH A MAXIMUM SLOPE OF 3:1 UNLESS NOTED OTHERWISE.
2. CONTOURS SHOWN ARE AT 2-FOOT INTERVALS.
3. DISTURBED AREAS SHALL HAVE SURFACES ROUGHENED PER CITY OF LEE'S SUMMIT DESIGN AND CONSTRUCTION MANUAL AND KCAPWA SECTIONS 2102.3 AND 5106.4.
4. ALL PROPOSED GRADES ARE TO FINISH GRADE. THE CONTRACTOR IS RESPONSIBLE FOR MAKING ADJUSTMENTS FOR PAVEMENT THICKNESS, TOPSOIL REMOVAL/REPLACEMENT, ETC. INCLUDING TOP OF PAVEMENT.
5. EMBANKMENTS SHALL BE CONSTRUCTED TO 90% OF MAXIMUM DRY DENSITY OUTSIDE RIGHT OF WAY AND TO 95% WITHIN RIGHT OF WAY IN 8-INCH MAXIMUM LIFTS IN ACCORDANCE WITH APWA SECTION 2102.2 REQUIREMENTS.
6. REFER TO SHEET 01C-CR-08 FOR DETAILED MASTER DRAINAGE PLAN.

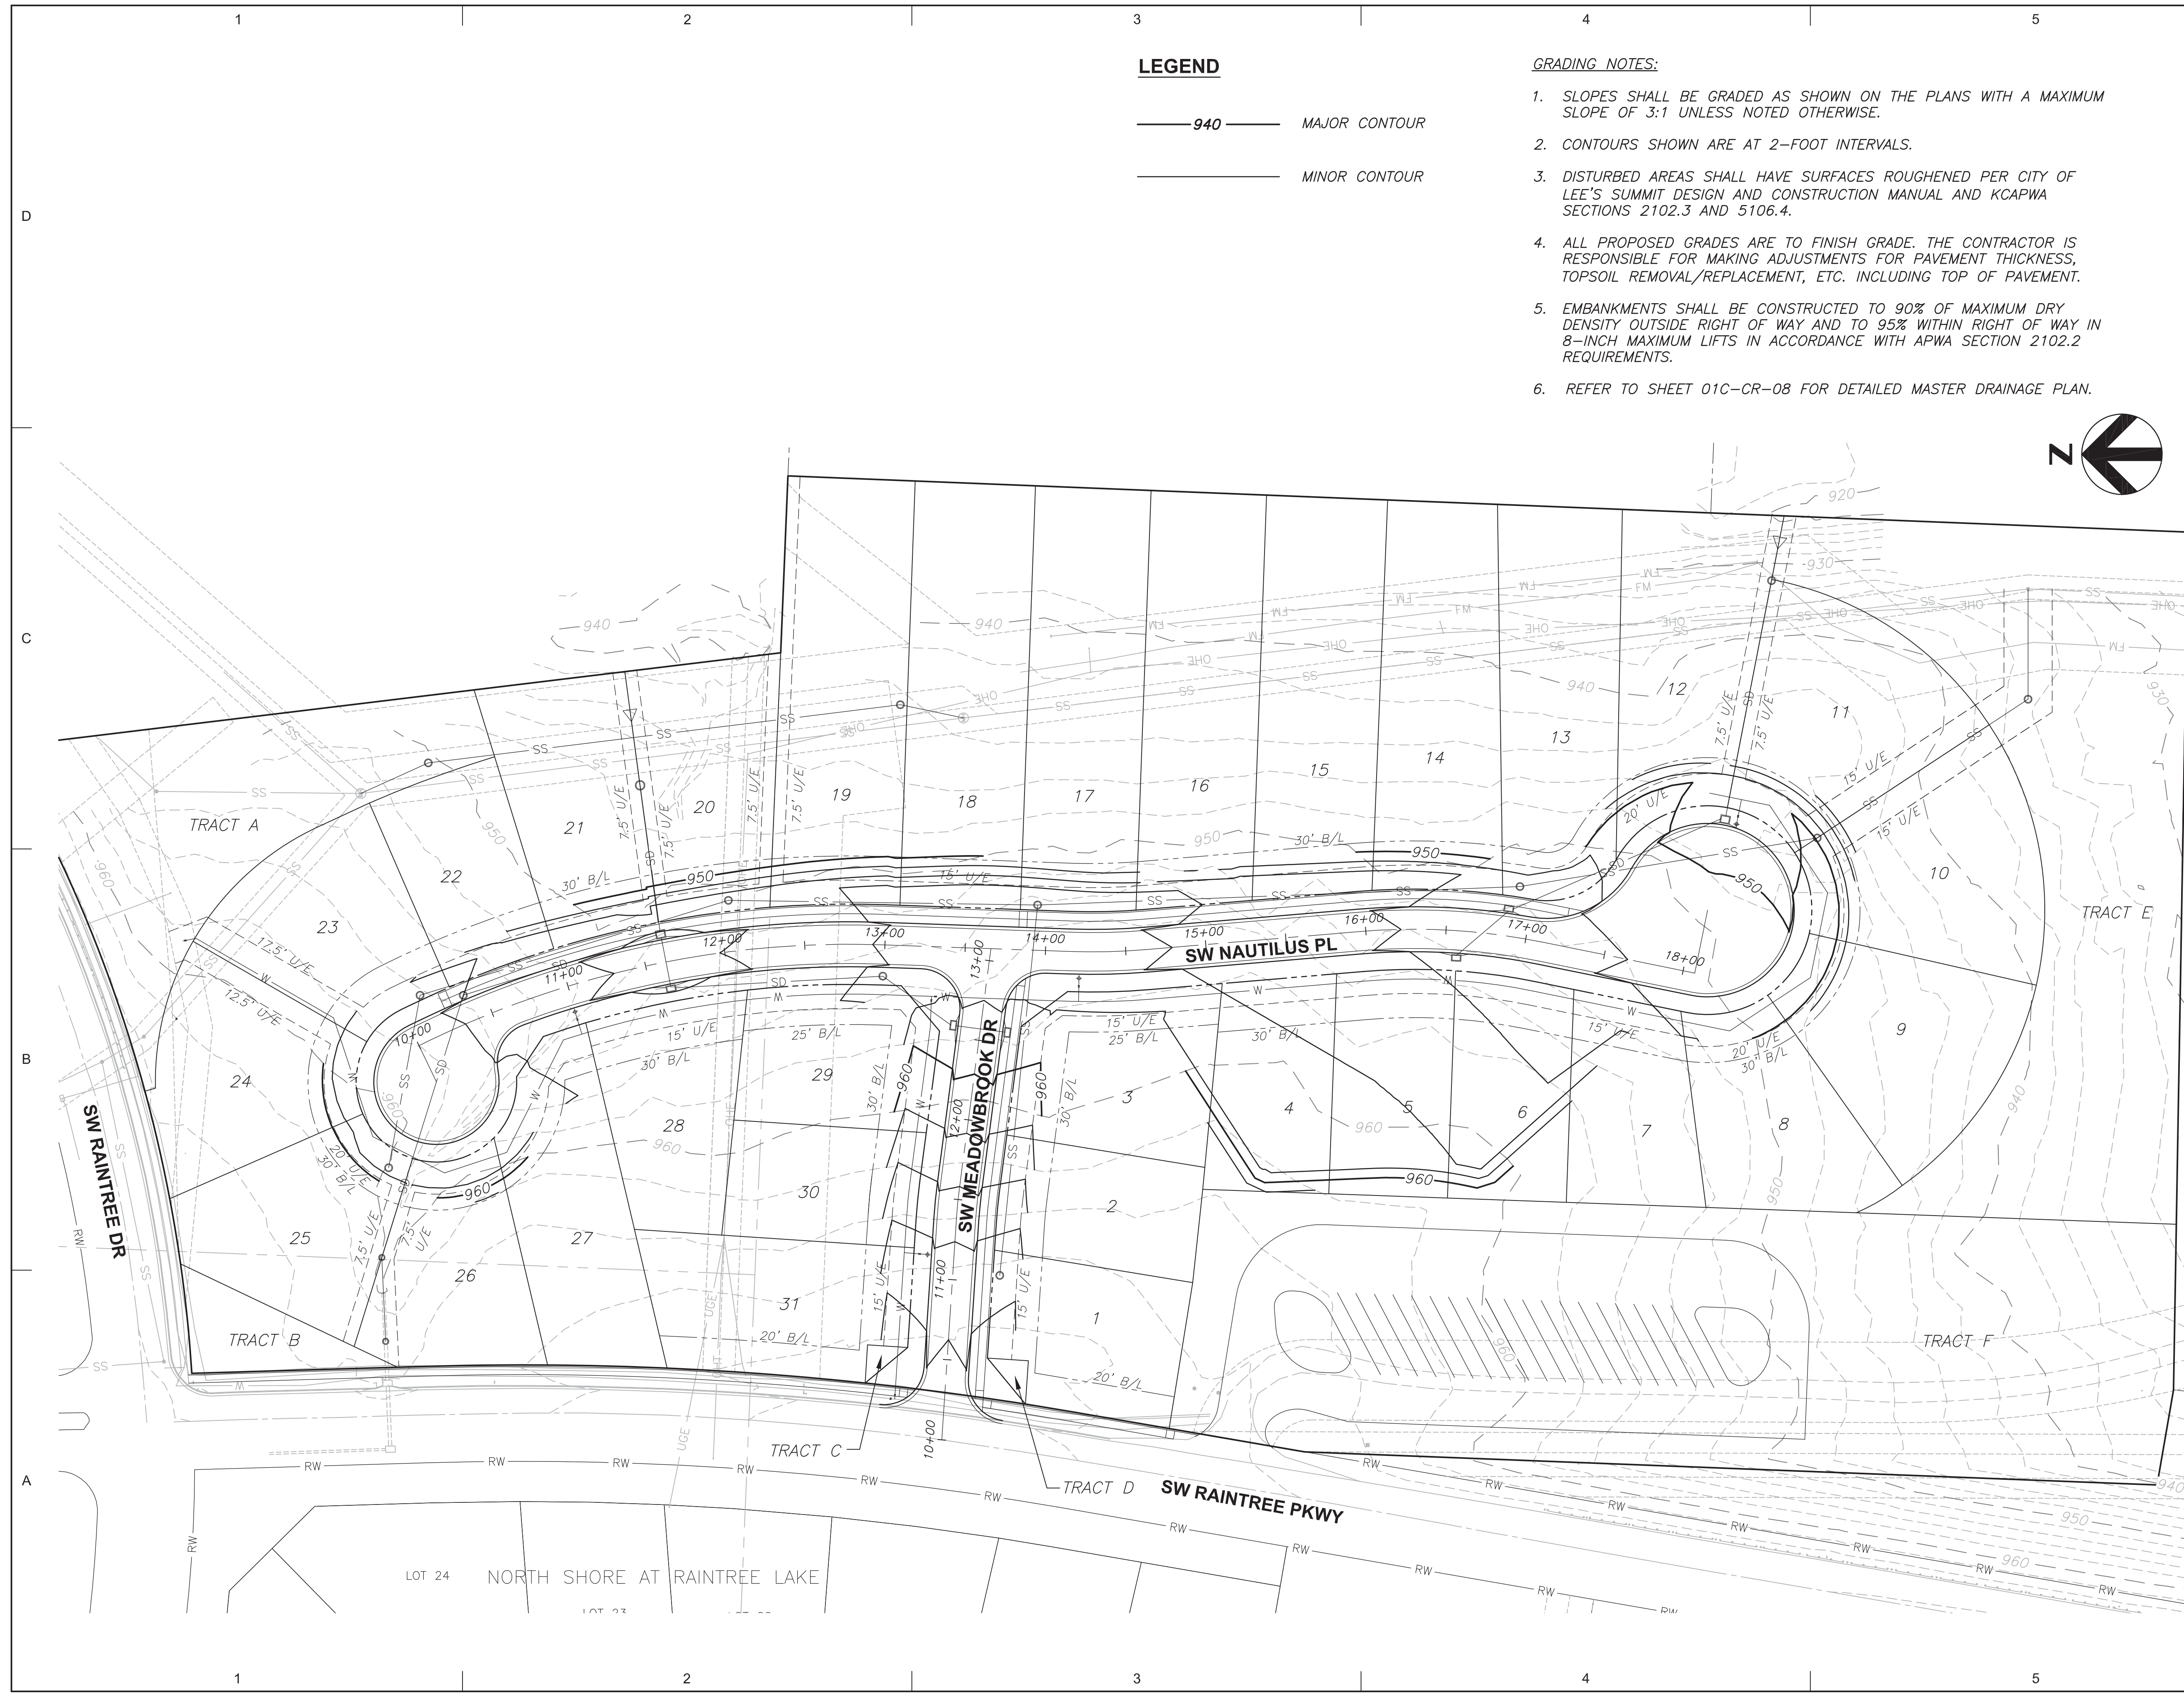

1

2

3

4

5

D

D

C

C

B

B

A

A

1

2

3

4

5

LOT 24 NORTH SHORE AT RAINTREE LAKE


GENERAL NOTES:

1. CONTRACTOR IS RESPONSIBLE FOR KEEPING ALL PUBLIC ROADWAYS ADJACENT TO THE CONSTRUCTION SITE FREE OF DIRT AND DEBRIS RESULTING FROM ACTIVITIES RELATED TO THE CONSTRUCTION OF THIS PROJECT.
2. CONTRACTOR SHALL UTILIZE TEMPORARY CONSTRUCTION ENTRANCE FOR ACCESS TO SITE.
3. MULCH BERMS SHALL BE AT LEAST 18-IN TALL AND 2-FT WIDE AT TOP OF BERM.
4. CONTRACTOR SHALL NOT STRIP ENTIRE SITE. LOCATE STOCKPILE/STORAGE AREAS AT TOP OF HILL. ADDITIONAL EROSION AND SEDIMENT CONTROL DEVICES SHALL BE PROVIDED AS REQUIRED SHOULD DISTURBED AREAS EXTEND BEYOND PLAN DEPICTED CONTROL MEASURES.
5. REFERENCE SHEET 01C-CR-07 FOR SEDIMENT TRAP DETAILS.


PRE-CLEARING EROSION AND SEDIMENT CONTROL SEQUENCING:

1. IMPLEMENT PRE-CLEARING PLAN: ALL STRUCTURAL BMPs SHOWN ON THE PRE-CLEARING PLAN MUST BE IN PLACE BEFORE GENERAL CLEARING OPERATIONS. CLEARING NECESSARY TO PLACE STRUCTURAL BMPs SHALL BE THE MINIMUM REQUIRED FOR INSTALLATION. COORDINATE CLEARING NECESSARY TO PLACE STRUCTURAL BMPs WITH LOCAL WEATHER FORECAST SO THAT CLEARING AND PLACEMENT MAY BE COMPLETED WITHIN A FORECAST DRY PERIOD. STABILIZE ALL DIVERSION DIKES, SEDIMENT BASINS, AND SEDIMENT TRAPS WITHIN 5 DAYS AFTER INSTALLATION.
2. EARLY WORK: CLEAR MINIMUM WORK ZONE AND CONSTRUCT ANY EARLY WORK ITEMS OF PERMANENT CONSTRUCTION THAT ARE SHOWN ON THE PRE-CLEARING PLAN. SANITARY SEWER MAY BE CONSTRUCTED BEFORE MASS GRADING OCCURS.

LEGEND

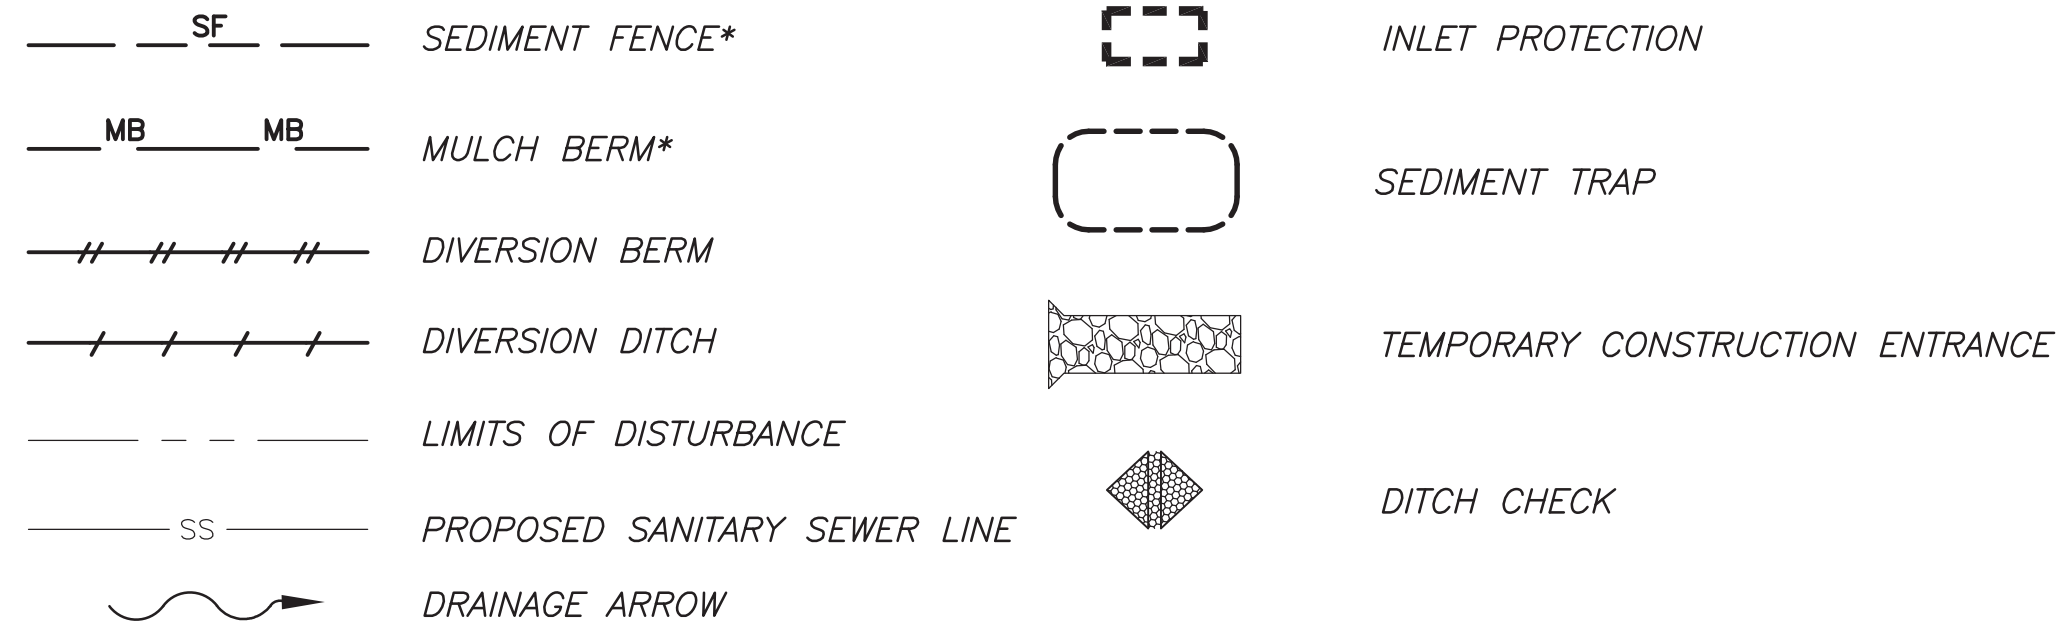

* MULCH BERMS MAY BE SUBSTITUTED FOR SEDIMENT FENCE AT CONTRACTOR'S DISCRETION.

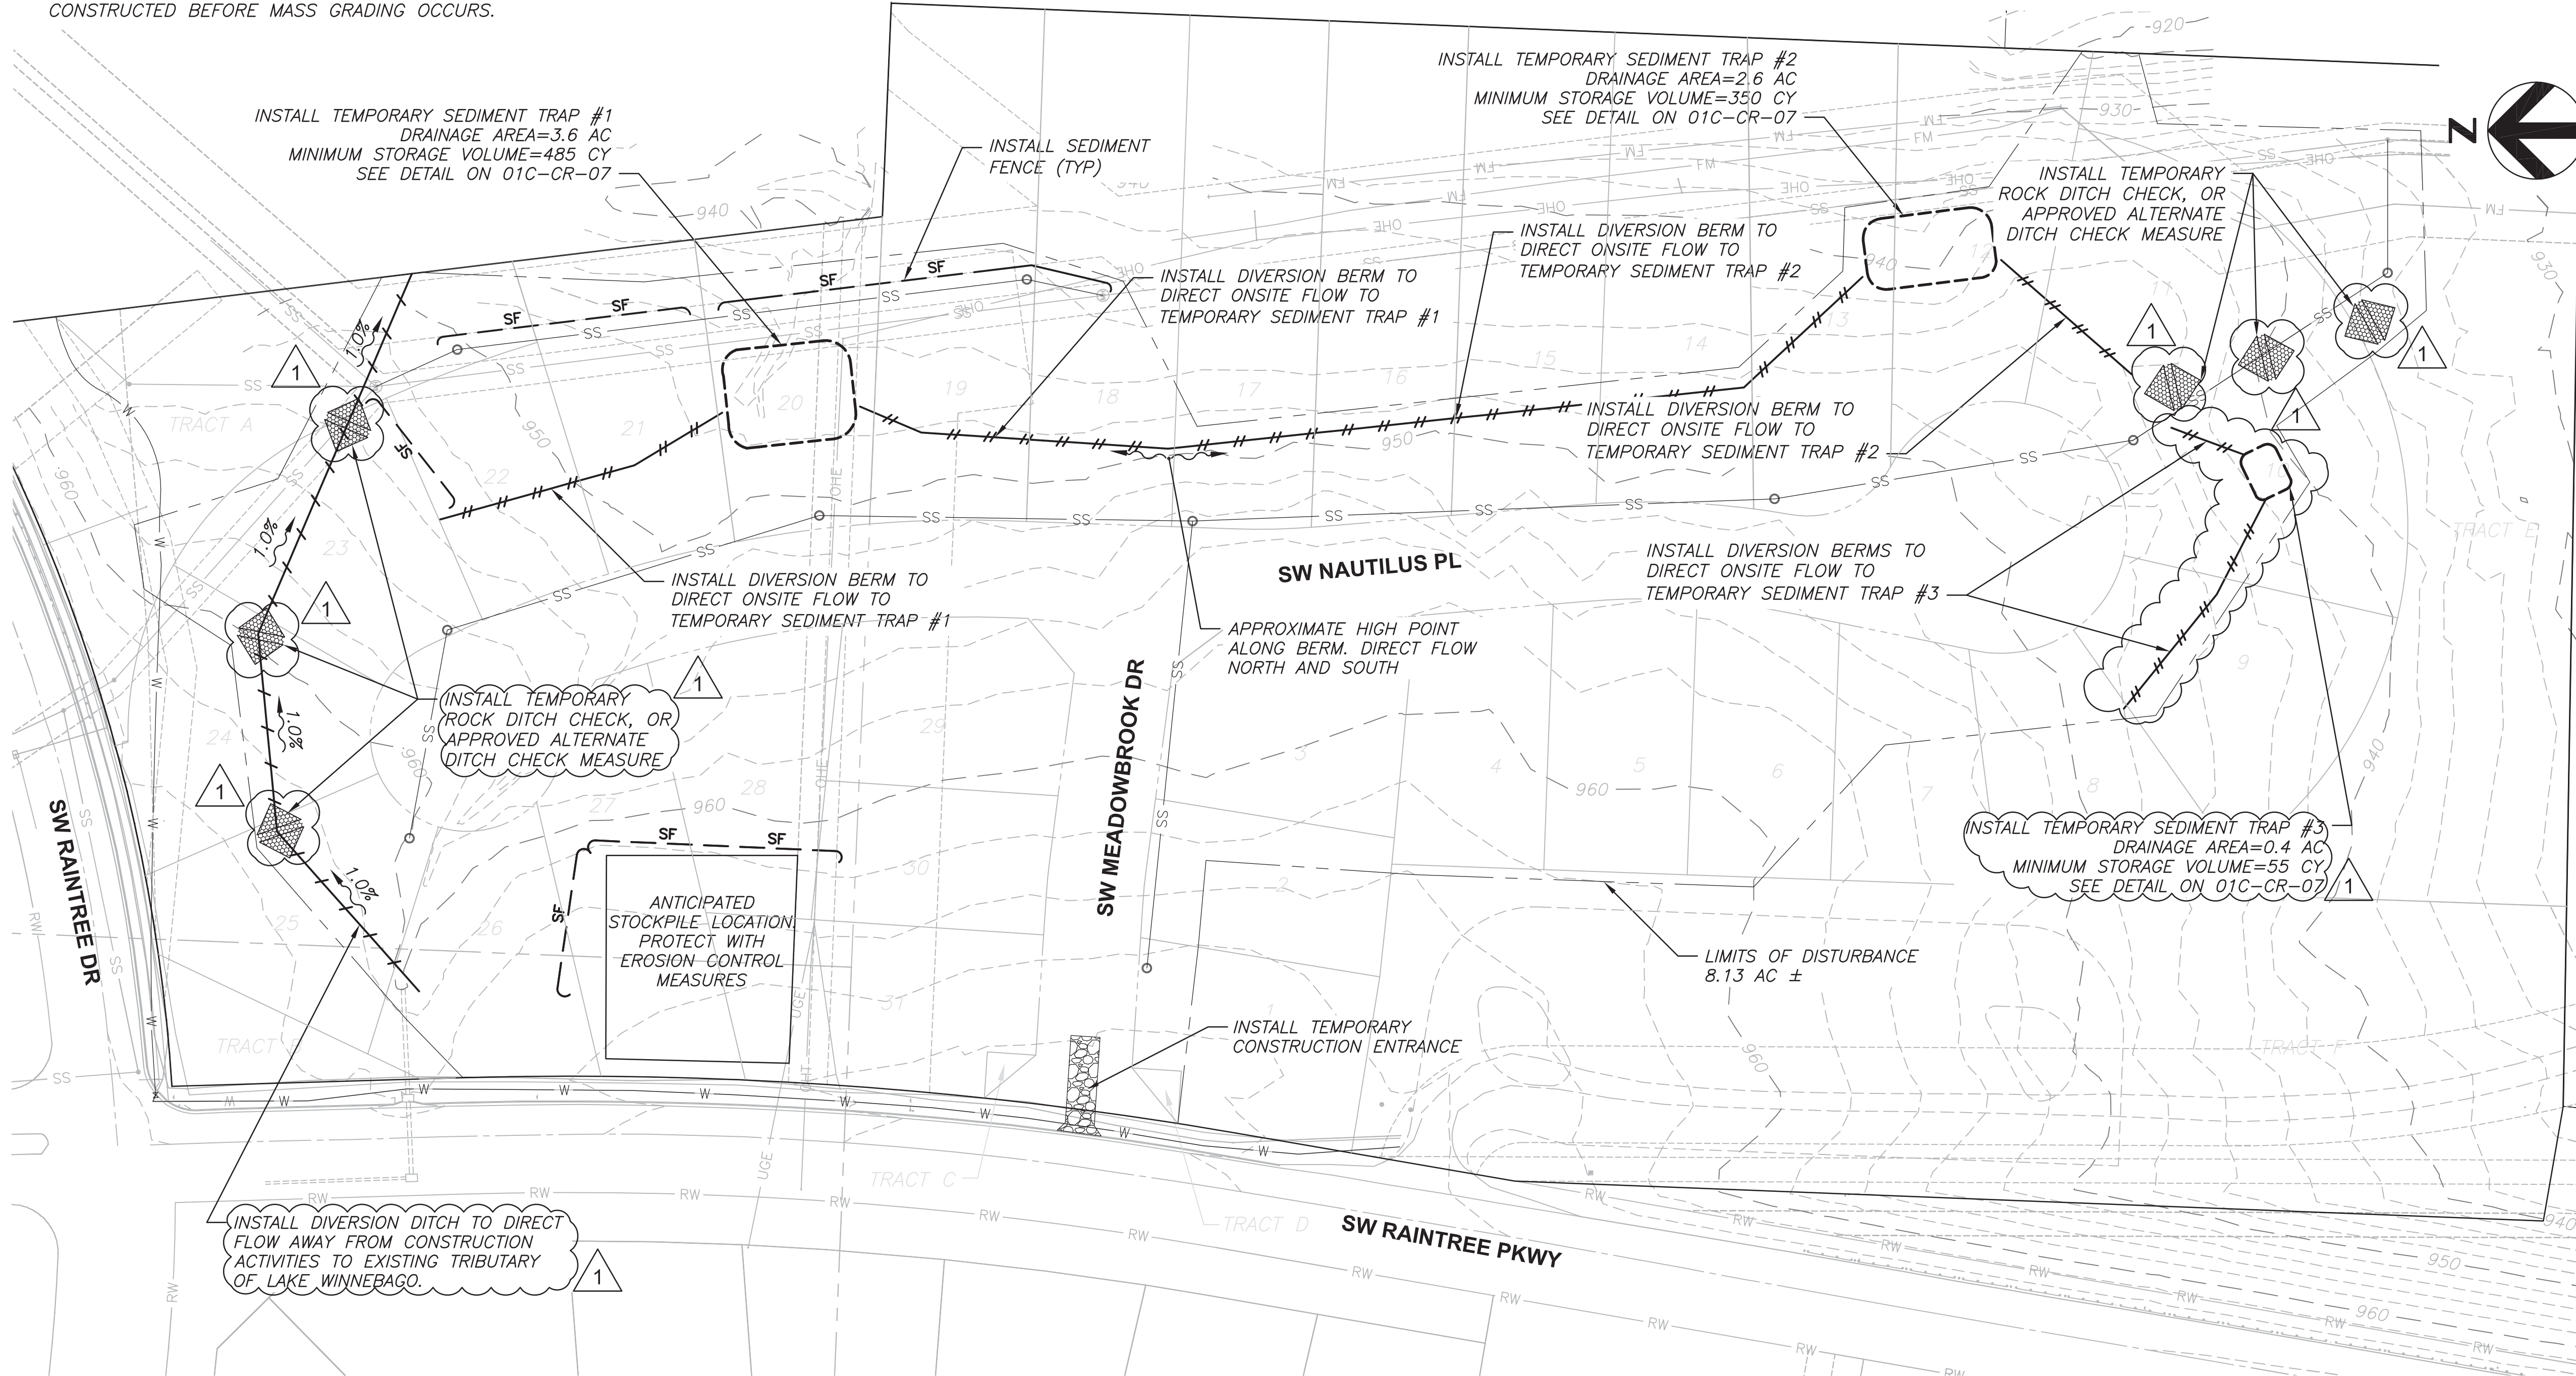

3741 NE TROON DR
LEE'S SUMMIT, MO 64064
816.347.1100

MO STATE CERTIFICATE OF
AUTHORITY #000856

PROJECT FOR

**LANDROCK
DEVELOPMENT, LLC**

**CREEKSIDE AT RAIN TREE
LOTS 1 THRU 31
LEE'S SUMMIT, MISSOURI**

MARK	DATE	DESCRIPTION
C	07/07/2017	CITY RESUBMITTAL
B	05/01/2017	CITY RESUBMITTAL
A	03/08/2017	CITY SUBMITTAL


PROJECT NUMBER	10028825-276408
ORIGINAL ISSUE	MARCH 7, 2017

PROJECT MANAGER	SIMON SUN
PROJECT ENGINEER	WILL NEDS, E.I.T.



SHEET NAME

**PRE-CLEARING
EROSION AND SEDIMENT
CONTROL PLAN**

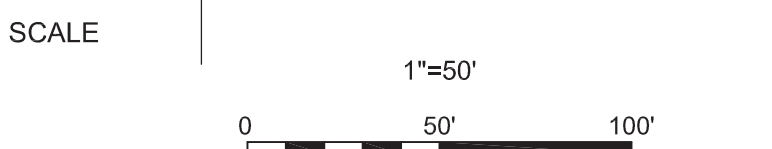

SHEET NUMBER

01C-CR-03

FILE NAME 01C-CR-03.dwg

PERMIT REVIEW DRAWINGS

GENERAL NOTES:

1. CONTRACTOR IS RESPONSIBLE FOR KEEPING ALL PUBLIC ROADWAYS ADJACENT TO THE CONSTRUCTION SITE FREE OF DIRT AND DEBRIS RESULTING FROM ACTIVITIES RELATED TO THE CONSTRUCTION OF THIS PROJECT.
2. CONTRACTOR SHALL UTILIZE TEMPORARY CONSTRUCTION ENTRANCE FOR ACCESS TO SITE.
3. MULCH BERMS SHALL BE AT LEAST 18-IN TALL AND 2-FT WIDE AT TOP OF BERM.
4. CONTRACTOR SHALL NOT STRIP ENTIRE SITE. LOCATE STOCKPILE/STORAGE AREAS AT TOP OF HILL. ADDITIONAL EROSION AND SEDIMENT CONTROL DEVICES SHALL BE PROVIDED AS REQUIRED SHOULD DISTURBED AREAS EXTEND BEYOND PLAN DEPICTED CONTROL MEASURES.
5. REFERENCE SHEET 01C-CR-07 FOR SEDIMENT TRAP DETAILS.


INACTIVE AREA STABILIZATION EROSION AND SEDIMENT CONTROL SEQUENCING:

1. GRADING: CLEAR SITE AND COMPLETE MASS GRADING.
2. IMPLEMENT STEEP SLOPE PROTECTION. DURING GRADING OPERATIONS, PLACE STEEP SLOPE PROTECTION SHOWN ON THE INACTIVE AREA STABILIZATION DRAWING AS SOON AS PRACTICABLE. THIS APPLIES TO SLOPES GREATER THAN 15%.
3. STABILIZE INACTIVE AREAS: THE GROUND COVER AND OTHER STRUCTURAL BMPs SHOWN ON THE INACTIVE AREA STABILIZATION DRAWING MUST BE PLACED WITHIN 14 DAYS OF CESSATION OF MASS GRADING AT EACH LOCATION. IN DETERMINING THE INACTIVE STATUS OF THE GROUND, EVALUATE EACH PORTION OF THE SITE SEPARATELY. THE NEED FOR SUBSEQUENT PLACEMENT OF TRENCHED UTILITIES, FUTURE BUILDING OR OTHER CONSTRUCTION IN AN OTHERWISE INACTIVE AREA IS NOT JUSTIFICATION FOR DELAY OF STABILIZATION.
4. INSTALL SITE IMPROVEMENTS: CONSTRUCT THE REMAINDER OF THE UTILITIES, ROADS, AND OTHER SITE IMPROVEMENTS DEPICTED ON THE CONSTRUCTION PLANS.

LEGEND

- SF SEDIMENT FENCE*
- MB MULCH BERM*
- DIVERSION BERM
- DIVERSION DITCH
- LIMITS OF DISTURBANCE
- SS PROPOSED SANITARY SEWER LINE
- W PROPOSED WATER SERVICE LINE
- SD PROPOSED STORM DRAINAGE LINE
- INLET PROTECTION
- SEDIMENT TRAP
- TEMPORARY CONSTRUCTION ENTRANCE
- DITCH CHECK

* MULCH BERMS MAY BE SUBSTITUTED FOR SEDIMENT FENCE AT CONTRACTOR'S DISCRETION.

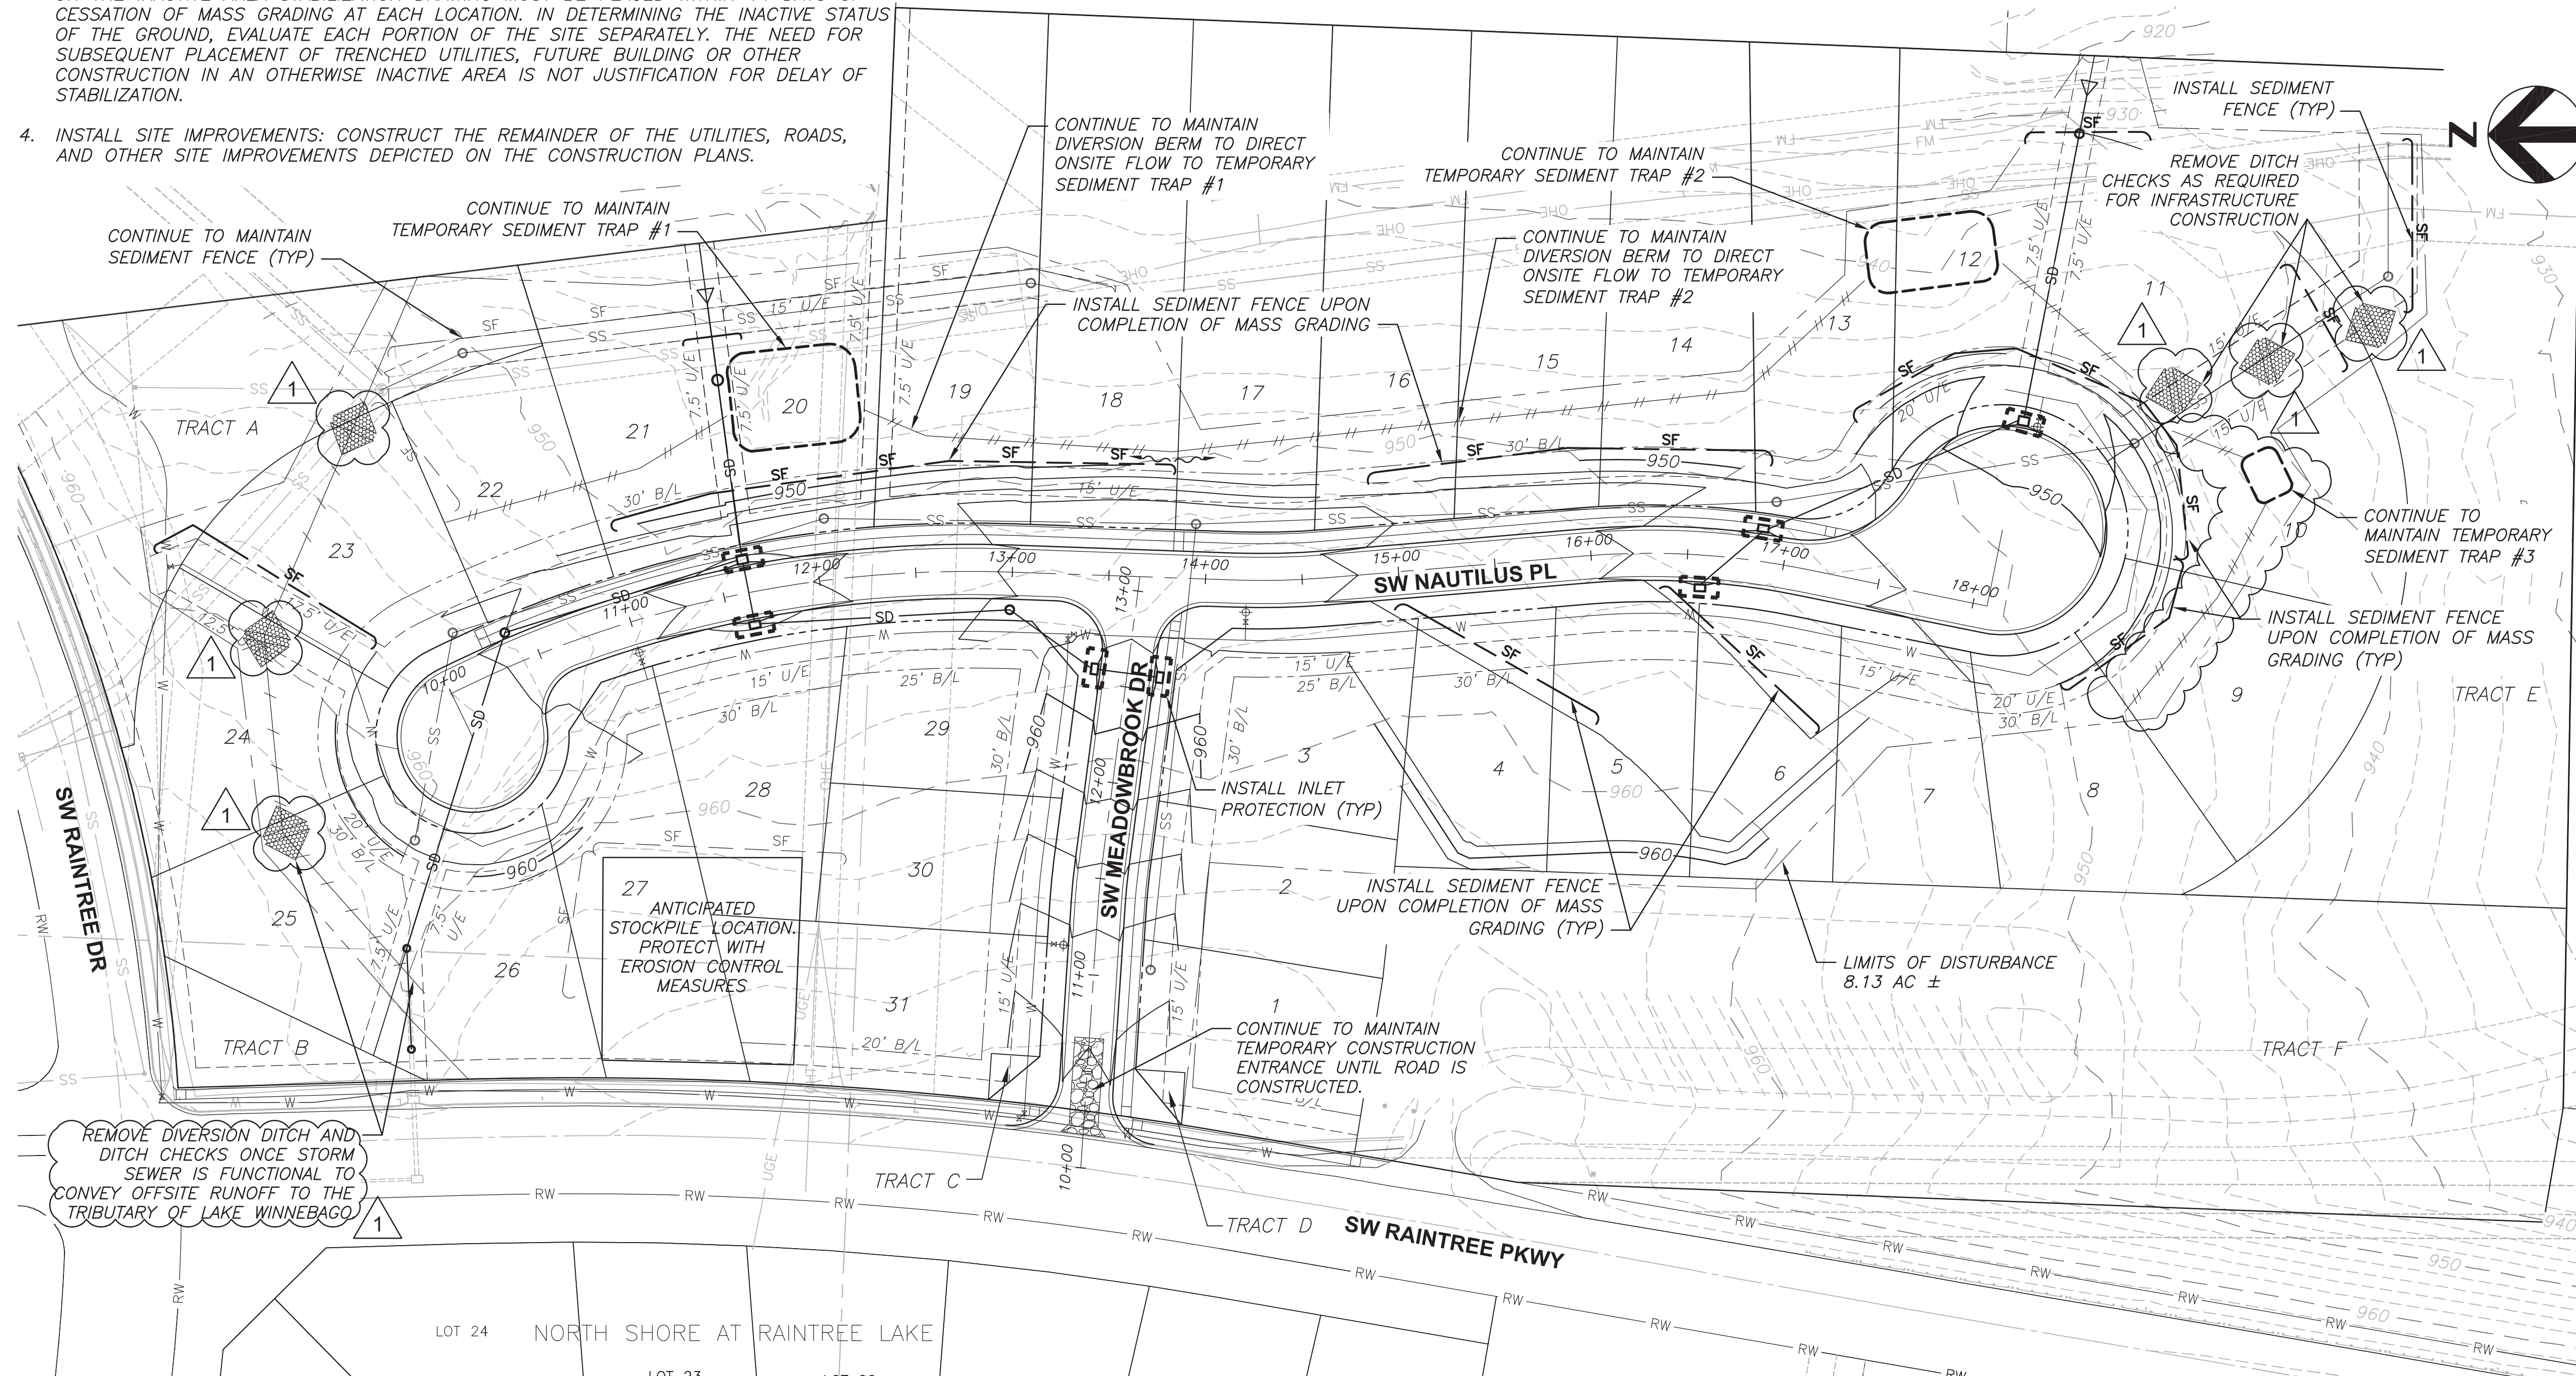

3741 NE TROON DR
LEE'S SUMMIT, MO 64064
816.347.1100

MO STATE CERTIFICATE OF
AUTHORITY #000856

PROJECT FOR

**LANDROCK
DEVELOPMENT, LLC**

**CREEKSIDE AT RAINTREE
LOTS 1 THRU 31
LEE'S SUMMIT, MISSOURI**

C	07/07/2017	CITY RESUBMITTAL
B	05/01/2017	CITY RESUBMITTAL
A	03/08/2017	CITY SUBMITTAL
MARK	DATE	DESCRIPTION


PROJECT NUMBER	10028825-276408
ORIGINAL ISSUE	MARCH 7, 2017

PROJECT MANAGER	SIMON SUN
PROJECT ENGINEER	WILL NEDS, E.I.T.



SHEET NAME

**INACTIVE AREA
STABILIZATION
EROSION AND SEDIMENT
CONTROL PLAN**

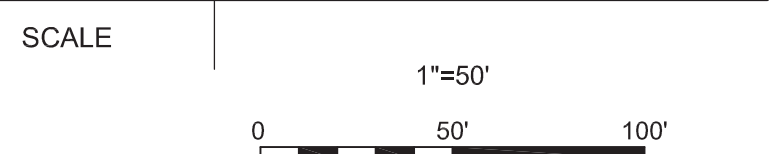

SHEET NUMBER

01C-CR-04

FILE NAME | 01C-CR-04.dwg

PERMIT REVIEW DRAWINGS

GENERAL NOTES:

1. CONTRACTOR IS RESPONSIBLE FOR KEEPING ALL PUBLIC ROADWAYS ADJACENT TO THE CONSTRUCTION SITE FREE OF DIRT AND DEBRIS RESULTING FROM ACTIVITIES RELATED TO THE CONSTRUCTION OF THIS PROJECT.
2. DISTURBED AREAS SHALL HAVE SURFACES ROUGHENED IN ACCORDANCE WITH KCAPWA SECTION 2153.11.
3. ALL DISTURBED AREAS SHALL BE SEEDED AND MULCHED, INCLUDING AREAS PREVIOUSLY OCCUPIED BY TEMPORARY EROSION CONTROL DEVICES.
4. REFERENCE SHEET 01C-CR-07 FOR SEDIMENT TRAP DETAILS.

FINAL RESTORATION EROSION AND SEDIMENT CONTROL SEQUENCING:

1. IMPLEMENT FINAL STABILIZATION: COORDINATE REMOVAL OF CONSTRUCTION PHASE BMPs NECESSARY TO PLACE FINAL STABILIZATION WITH LOCAL WEATHER FORECAST SO THAT REMOVAL AND PLACEMENT MAY BE COMPLETED WITHIN A FORECAST DRY PERIOD. DOWN-SLOPE PERIMETER CONTROLS SHALL NOT BE REMOVED UNTIL FINAL STABILIZATION IS PLACED AND VEGETATIVE COVER IS ESTABLISHED OVER THE REMAINDER OF THE SITE.
2. ESTABLISHMENT AND FINAL CONSTRUCTION: ONCE THE REMAINDER OF THE SITE IS STABILIZED INCLUDING ESTABLISHMENT OF SEEDED COVER TYPES, REMOVE THE SEDIMENT CONTROLS AND THE REMAINING ACCESS CONTROLS. RESTORE AREA DISTURBED BY REMOVAL OF SEDIMENT CONTROLS.
3. PLAN MODIFICATION: THE CONTRACTOR MUST MODIFY THE PLAN IF THE PLAN FAILS TO SUBSTANTIALLY CONTROL EROSION AND OFFSITE SEDIMENTATION. THE CONTRACTOR MAY MODIFY THE PLAN OR CONSTRUCTION SEQUENCE IF IMPLEMENTATION IS INFEASIBLE FOR SITE CONDITIONS OR CONTRACTOR METHODS.

LEGEND

- SF — SEDIMENT FENCE
- MB — MULCH BERM
- - - - - LIMITS OF DISTURBANCE
- SS — PROPOSED SANITARY SEWER LINE
- W — PROPOSED WATER SERVICE LINE
- SD — PROPOSED STORM DRAINAGE LINE
- // // // // — DIVERSION DITCH
- INLET PROTECTION
- SEDIMENT TRAP



3741 NE TROON DR
LEE'S SUMMIT, MO 64064
816.347.1100

MO STATE CERTIFICATE OF
AUTHORITY #000856

PROJECT FOR

**LANDROCK
DEVELOPMENT, LLC**

**CREEKSIDE AT RAIN TREE
LOTS 1 THRU 31
LEE'S SUMMIT, MISSOURI**

C	07/07/2017	CITY RESUBMITTAL
B	05/01/2017	CITY RESUBMITTAL
A	03/08/2017	CITY SUBMITTAL
MARK	DATE	DESCRIPTION


PROJECT NUMBER	10028825-276408
ORIGINAL ISSUE	MARCH 7, 2017

PROJECT MANAGER	SIMON SUN
PROJECT ENGINEER	WILL NEDS, E.I.T.



SHEET NAME

**FINAL RESTORATION
EROSION AND SEDIMENT
CONTROL PLAN**

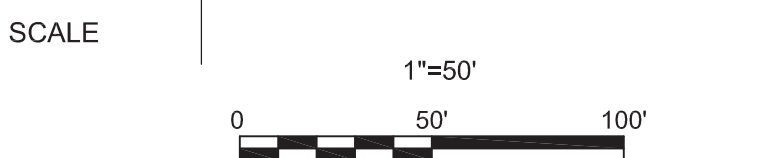



SHEET NUMBER

01C-CR-05

FILE NAME 01C-CR-05

PERMIT REVIEW DRAWINGS

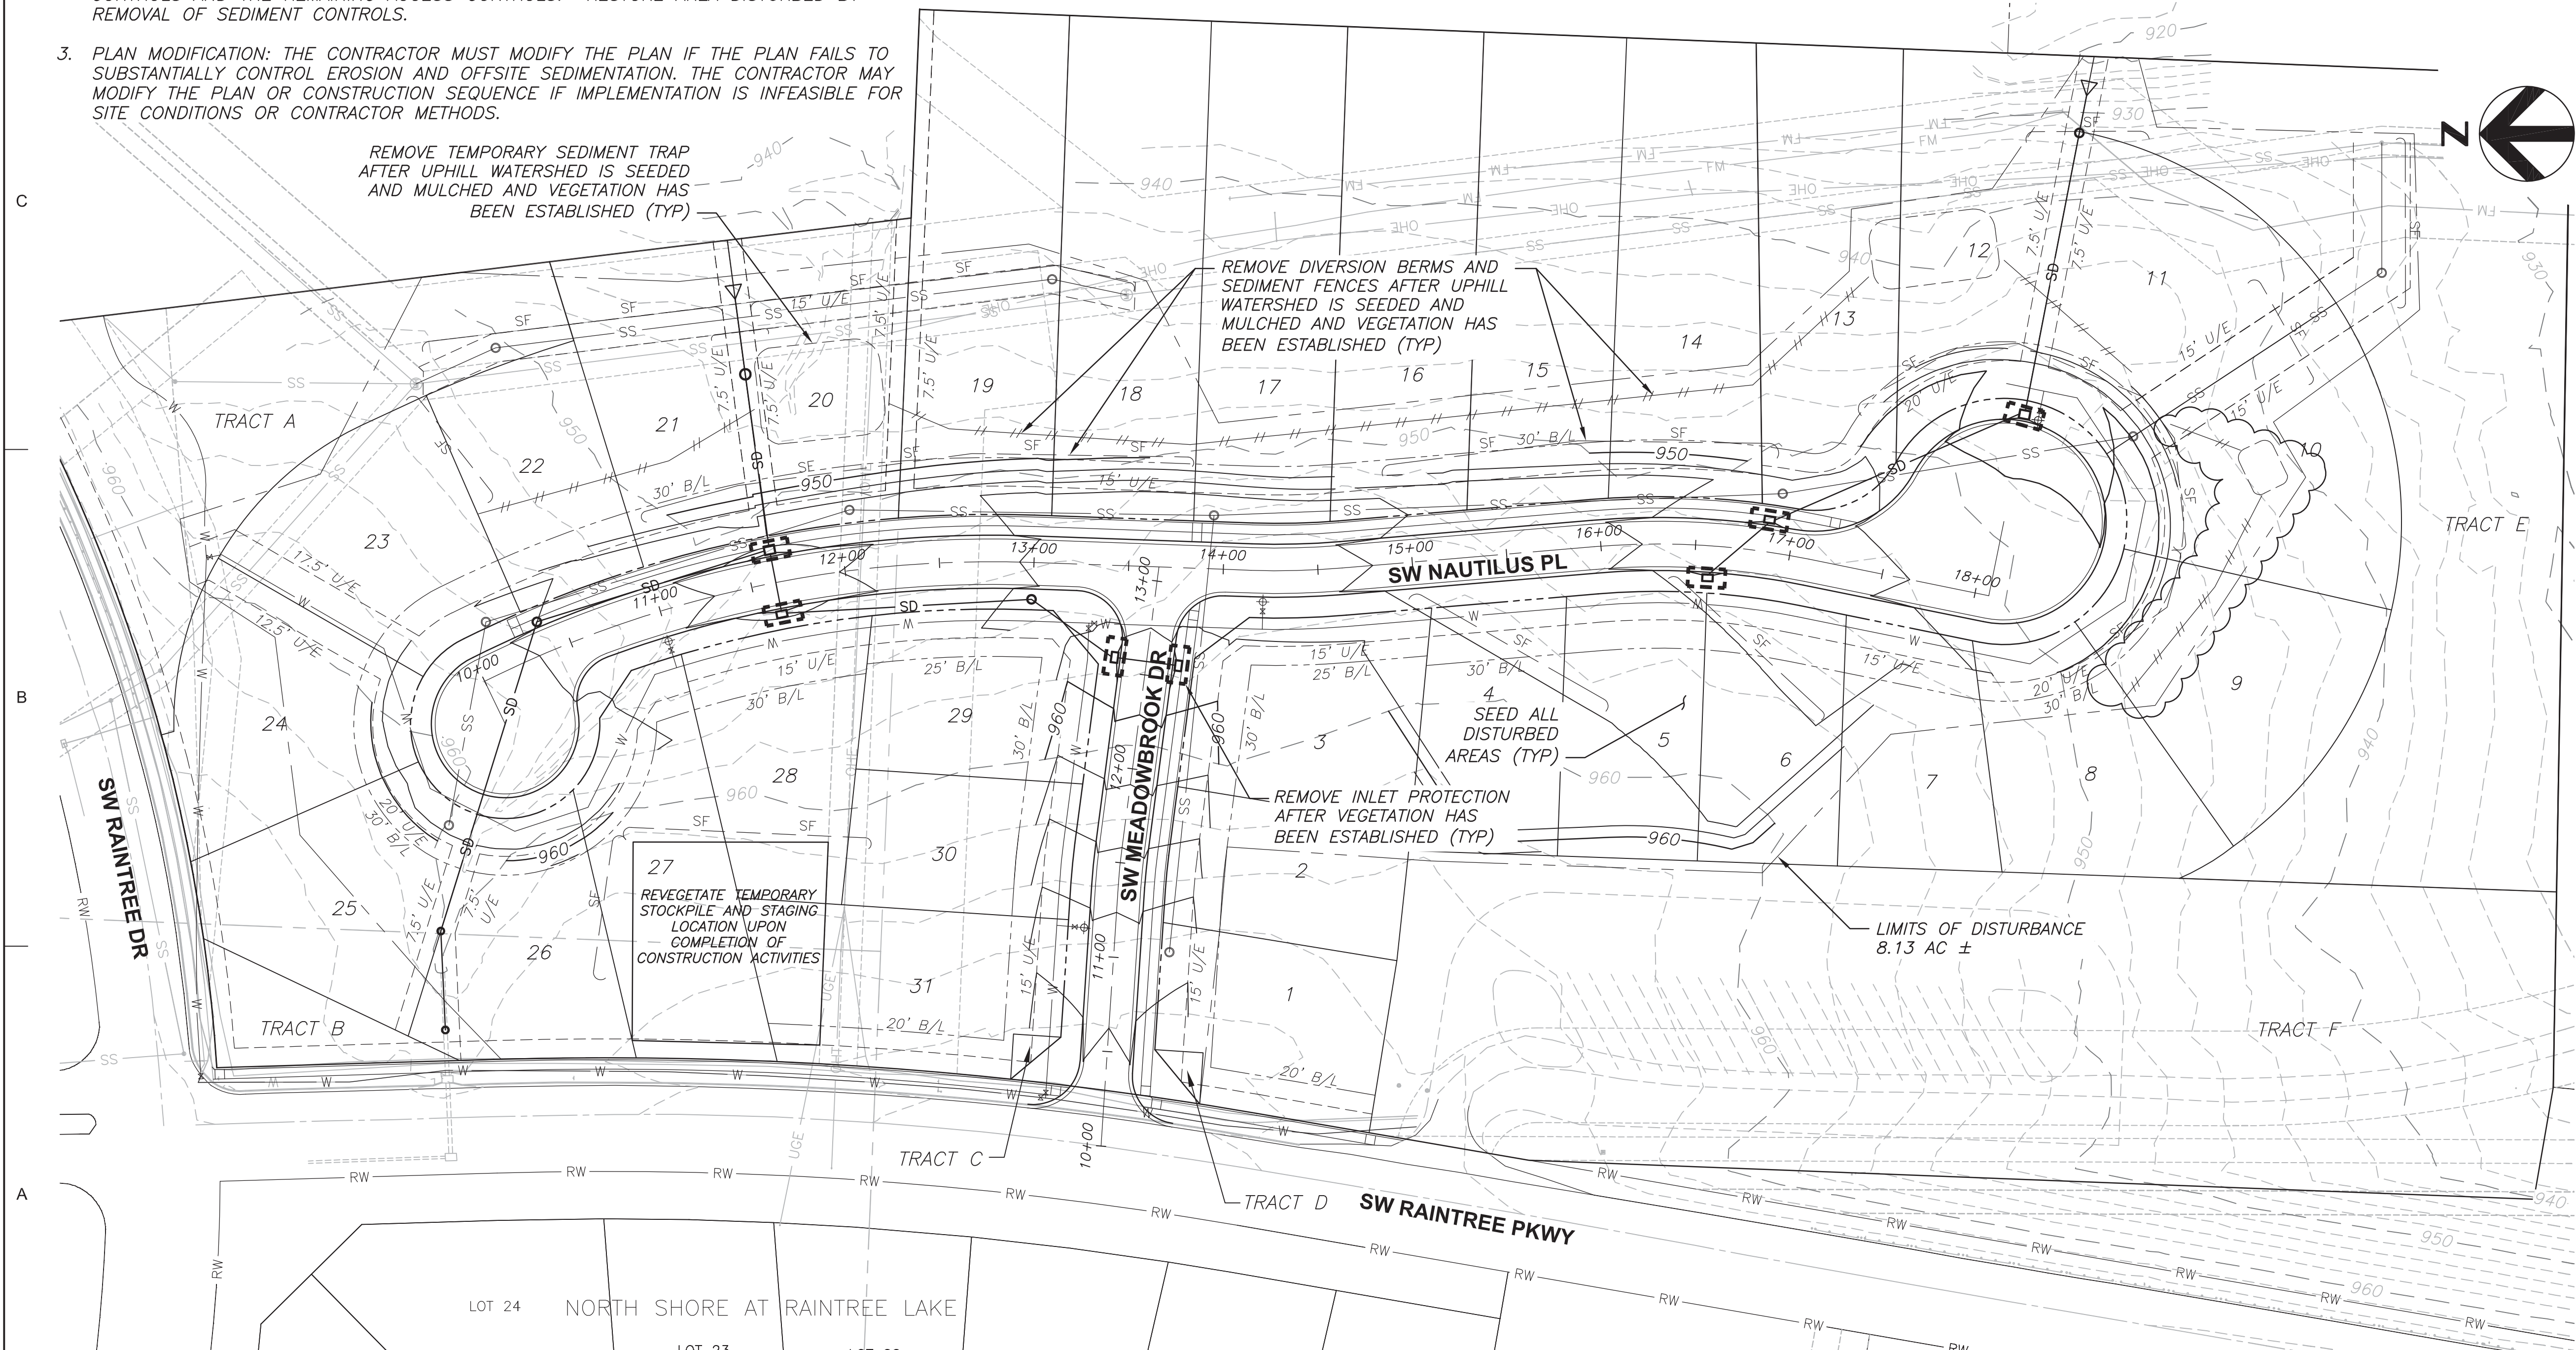

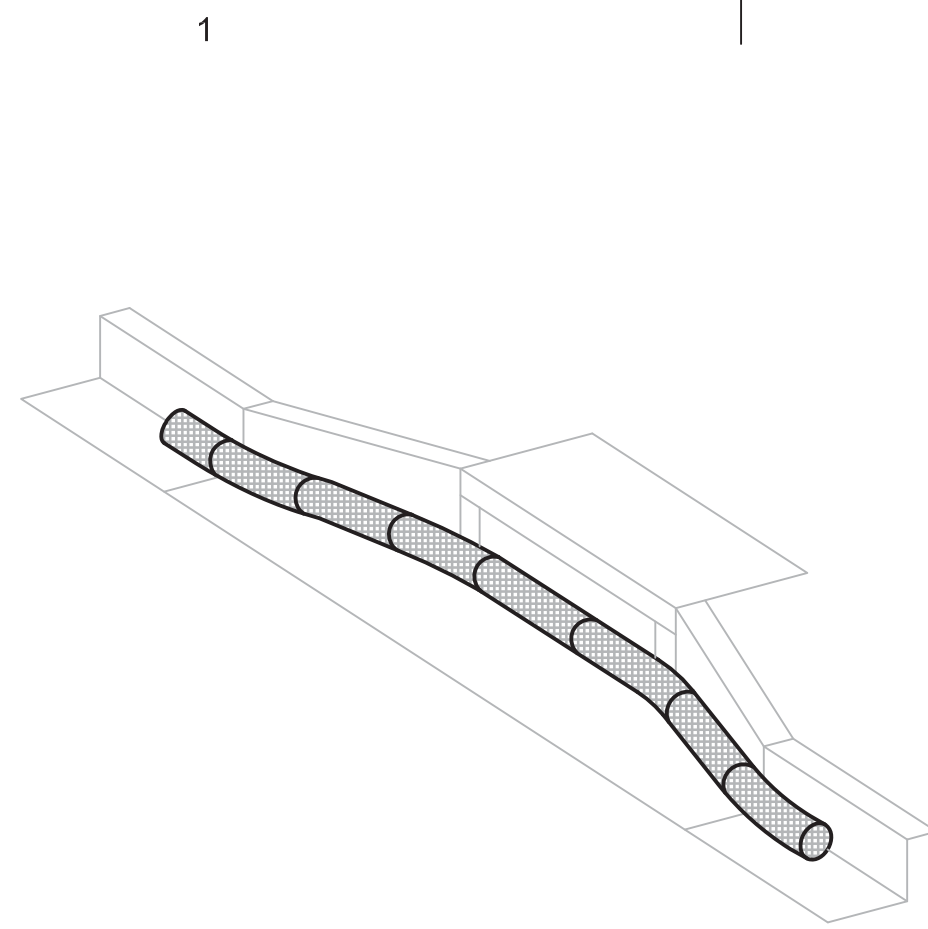


NOTES:






1. THE GUTTERBUDDY® OR APPROVED EQUAL SHALL BE A FILTER MANUFACTURED FROM RECYCLED SYNTHETIC FIBERS OR APPROVED ALTERNATIVE.
2. THE GUTTERBUDDY® WILL BE MANUFACTURED TO BE 9" IN DIAMETER AND SHALL HAVE A MINIMUM LENGTH OF 24" LONGER THAN THE CURB INLET OPENING. THIS WILL ALLOW FOR SUFFICIENT LENGTH TO COVER THE INLET WITH 12" BEYOND THE INLET ON BOTH ENDS.
3. THE GUTTERBUDDY® SHALL BE CLEANED IF A VISUAL INSPECTION SHOWS SILT AND DEBRIS BUILD UP AROUND THE GUTTERBUDDY®.
4. PONDING IS LIKELY IF SEDIMENT IS NOT REMOVED REGULARLY. INSPECTION OF GUTTERBUDDY® SHOULD BE ON A REGULAR BASIS AND IMMEDIATELY AFTER MAJOR RAIN EVENTS.

GUTTERBUDDY INLET PROTECTION

NOT TO SCALE

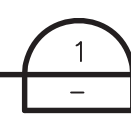


ALTERNATE INLET PROTECTION METHODS SUCH AS GRAVEL FILTER WITH 2"x4" BOARD AT INLET OPENING MAY BE UTILIZED AT CONTRACTOR'S DISCRETION.

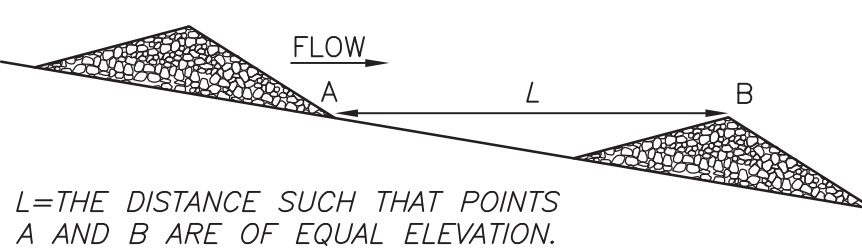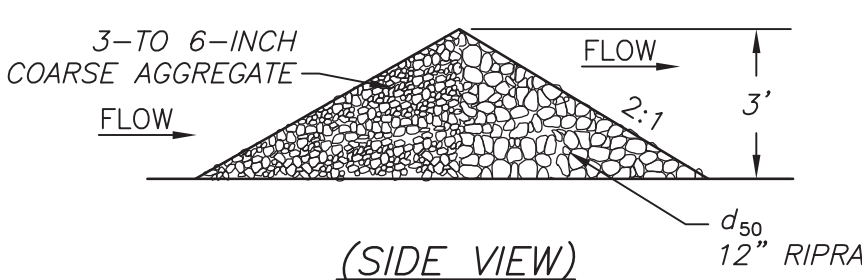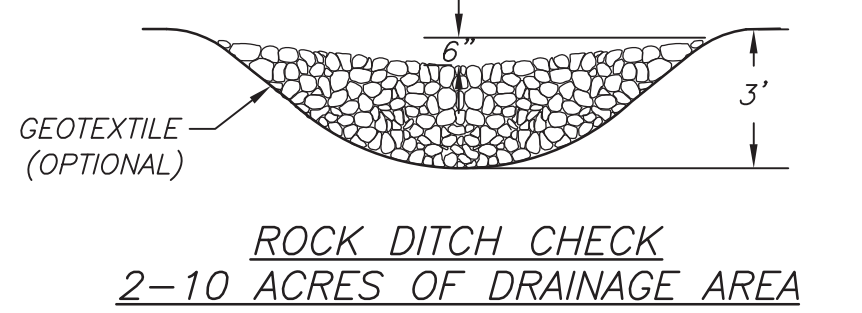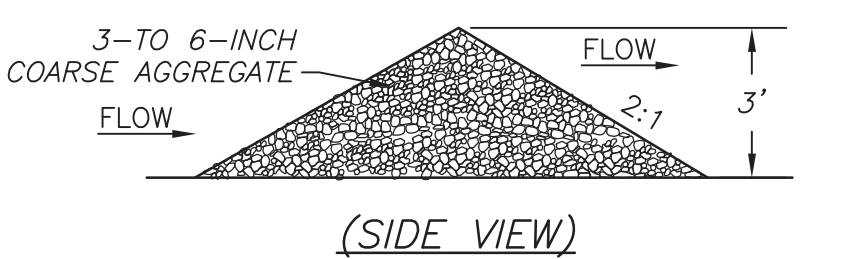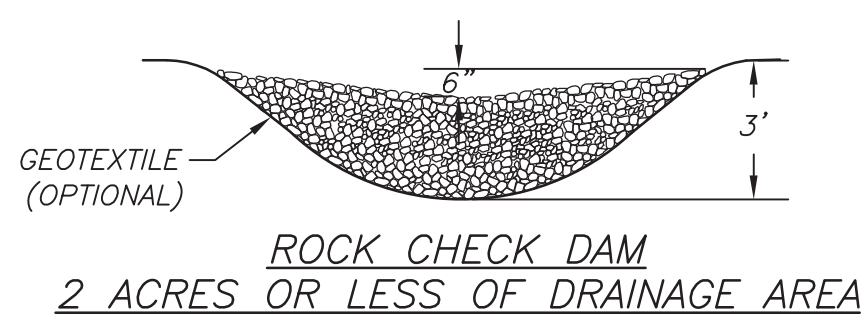

SPACING BETWEEN DITCH CHECKS

ROCK DITCH CHECK INSTALLATION

NOT TO SCALE



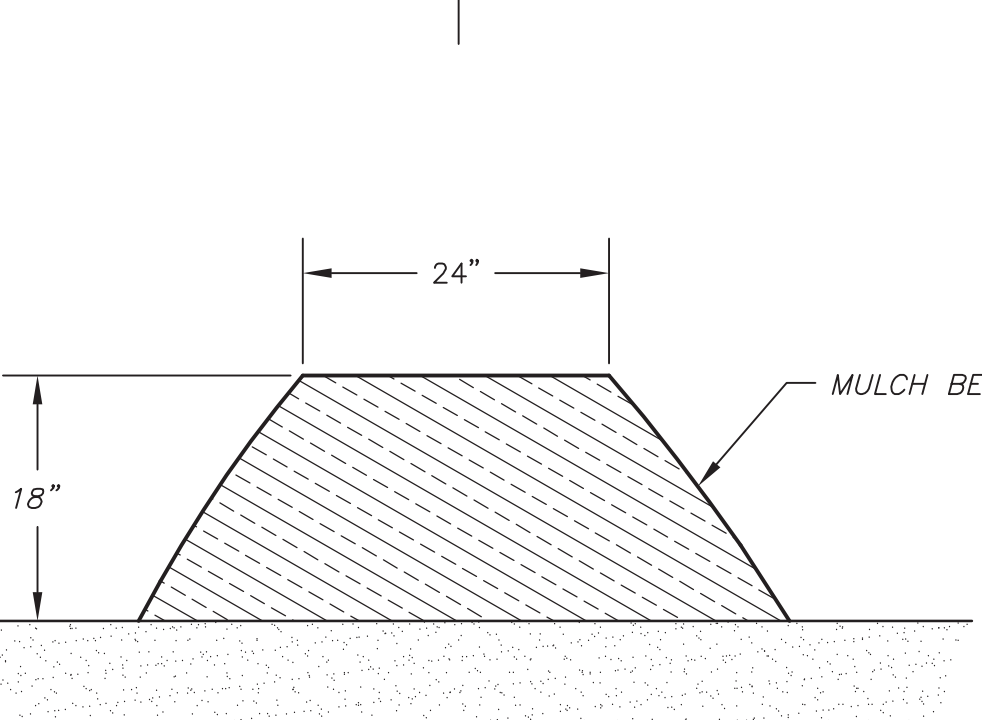


MULCH BERM NOTES:

1. THE EROSION CONTROL BERM SHALL BE PLACED, UNCOMPACTED, IN A WINDROW AT LOCATIONS SHOWN ON THE PLANS OR AS DIRECTED BY THE INSPECTOR.
2. PARALLEL TO THE BASE OF THE SLOPE, OR AROUND THE PERIMETER OF OTHER AFFECTED AREAS, CONSTRUCT A MULCH BERM. FOR MAXIMUM WATER FILTRATION ABILITY OR FOR STEEP SLOPES, CONSTRUCT A TRAPEZOIDAL MULCH BERM. IN EXTREME CONDITIONS AND WHERE SPECIFIED BY THE ENGINEER, A SECOND BERM SHALL BE CONSTRUCTED AT THE TOP OF THE SLOPE.
3. DO NOT USE MULCH BERMS IN ANY RUNOFF CHANNELS.
4. PLACE BERMS ON DENUDED AREAS AS SOON AS POSSIBLE. MULCH/COMPOST AND/OR TEMPORARY OR PERMANENT VEGETATION SHALL BE APPLIED/ESTABLISHED ABOVE THE MULCH BERMS WHEN NECESSARY FOR ADDITIONAL EROSION CONTROL.
5. WHEN SEDIMENT FILLS THE AREA BEHIND THE MULCH BERM TO 1/2 THE HEIGHT OF THE BERM THE CONTRACTOR SHALL REMOVE THE SEDIMENT AND PLUGGED MULCH AND RESHAPE BERM WITH CLEAN MULCH AS NEEDED.

MULCH BERM

NOT TO SCALE

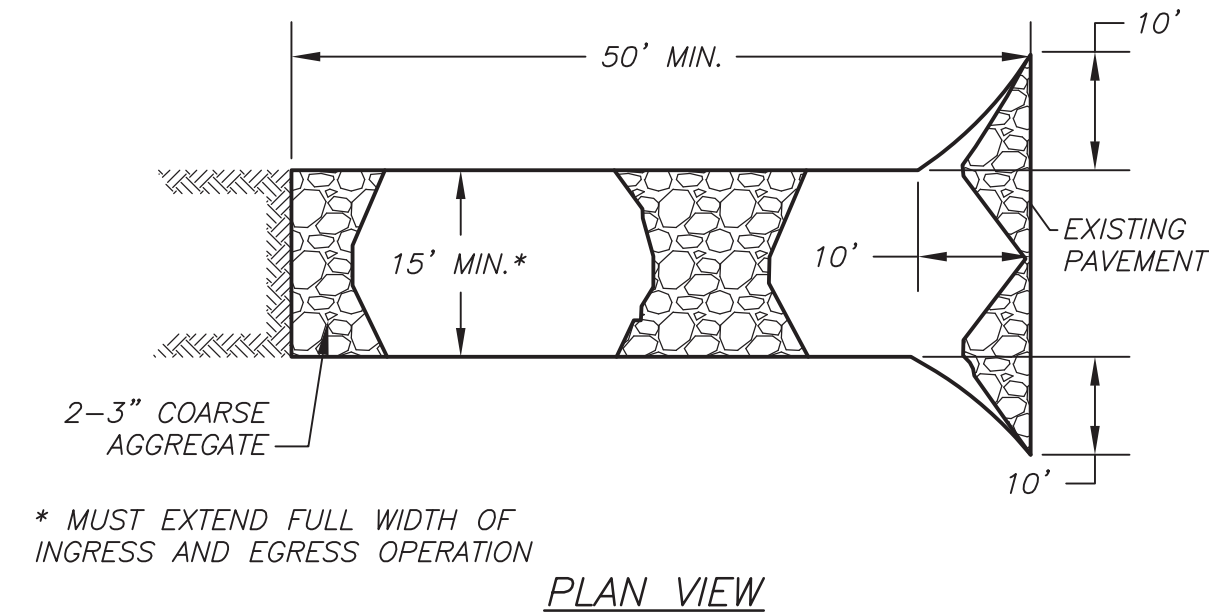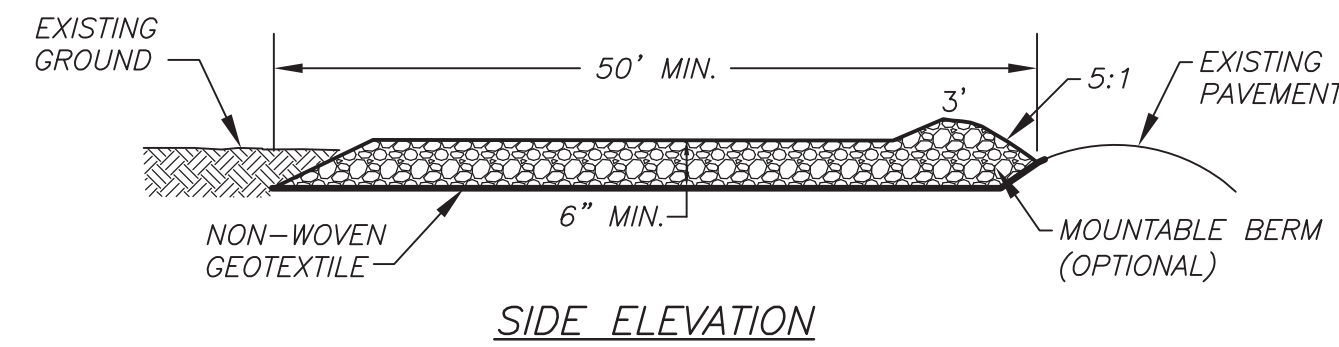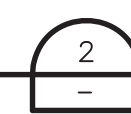

* MUST EXTEND FULL WIDTH OF INGRESS AND EGRESS OPERATION


TEMPORARY CONSTRUCTION ENTRANCE

NOT TO SCALE



TEMPORARY CONSTRUCTION ENTRANCE PAD NOTES:

- A) INSTALLATION:**
1. REMOVE ALL VEGETATION AND OTHER UNSUITABLE MATERIAL FROM THE FOUNDATION AREA, GRADE, AND CROWN FOR POSITIVE DRAINAGE.
 2. IF SLOPE TOWARDS THE PUBLIC ROAD EXCEEDS 2% CONSTRUCT A 6 TO 8 INCH HIGH RIDGE WITH 3H:1V SIDE SLOPES ACROSS THE FOUNDATION APPROXIMATELY 15 FEET FROM THE EDGE OF THE PUBLIC ROAD TO DIVERT RUNOFF AWAY FROM IT.
 3. PLACE STONE TO DIMENSIONS AND GRADE AS SHOWN ON PLANS. LEAVE SURFACE SMOOTH AND SLOPED FOR DRAINAGE.
 4. DIVERT ALL SURFACE RUNOFF AND DRAINAGE FROM THE ENTRANCE TO A SEDIMENT CONTROL DEVICE.
- B) TROUBLESHOOTING:**
1. INADEQUATE RUNOFF CONTROL TO THE EXTENT THAT SEDIMENT WASHES ONTO PUBLIC ROAD - INSTALL DIVERSIONS OR OTHER RUNOFF CONTROL MEASURES.
 2. SMALL STONE, THIN PAD, OR DETERIORATION OF GEOTEXTILE FABRIC RESULTS IN RUTS AND MUDDY CONDITIONS AS STONE IS PRESSED INTO SOIL - INCREASE STONE SIZE OR PAD THICKNESS OR REPLACE GEOTEXTILE FABRIC.
 3. PAD TOO SHORT FOR HEAVY CONSTRUCTION TRAFFIC - EXTEND PAD BEYOND THE MINIMUM 50 FOOT LENGTH AS NECESSARY.
- C) INSPECTION MAINTENANCE:**
1. INSPECT STONE PAD AND SEDIMENT DISPOSAL AREA WEEKLY AND AFTER 1/2-INCH OR GREATER STORM EVENTS.
 2. RESHAPE PAD AS NEEDED FOR PROPER DRAINAGE AND RUNOFF CONTROL.
 3. TOP DRESS WITH CLEAN 2 AND 3 INCH STONE AS NEEDED.
 4. IMMEDIATELY REMOVE MUD OR SEDIMENT TRACKED OR WASHED ONTO PUBLIC ROAD. REPAIR ANY BROKEN ROAD PAVEMENT IMMEDIATELY.
 5. REMOVE ALL TEMPORARY ROAD MATERIALS FROM AREAS WHERE PERMANENT VEGETATION WILL BE ESTABLISHED.

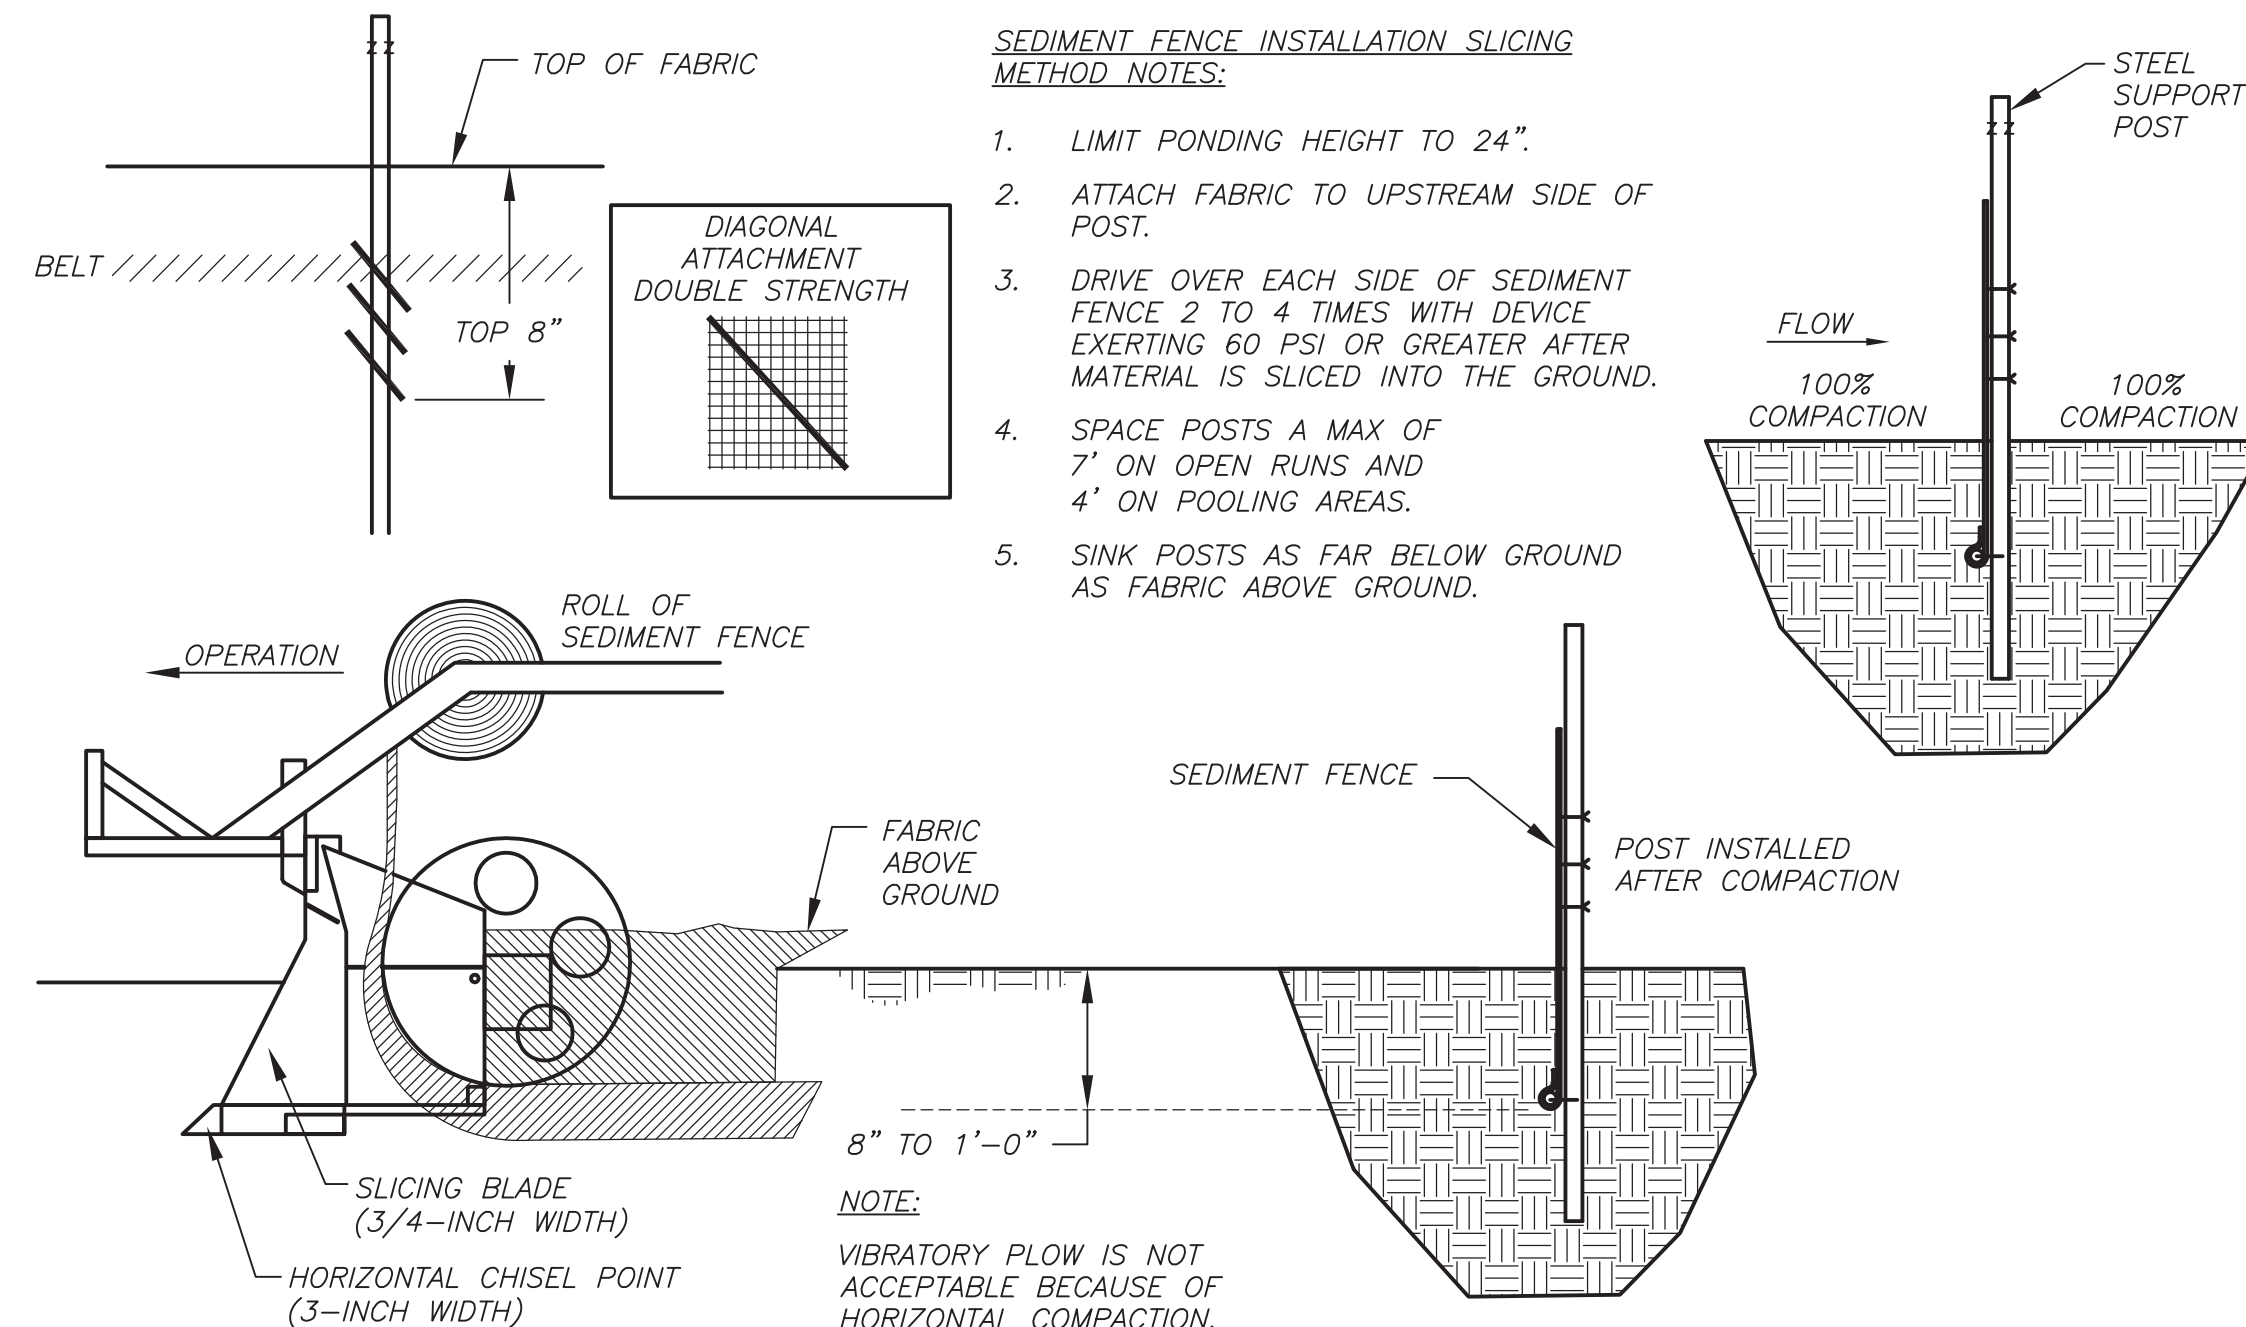


SEDIMENT FENCE (AKA SILT FENCE) NOTES:

1. SEDIMENT FENCE MAY BE USED IN LIEU OF MULCH BERMS AT CONTRACTOR'S DISCRETION.
2. REFER TO APWA KANSAS CITY METROPOLITAN CHAPTER DETAIL ESC-12 FOR SUPER SEDIMENT FENCE CONSTRUCTION SPECIFICATIONS.
3. THE MAXIMUM SLOPE LENGTH ABOVE THE FENCE SHOULD BE LESS THAN 100 FEET.
4. NO DITCH OR DRAINAGE WAY WITH AN AREA GREATER THAN 5 ACRES SHALL BE ENCLOSED ABOVE A SILT FENCE.
5. NO SILT FENCE SHALL BE CONSTRUCTED IN A LIVE STREAM OR DRAINAGE WAY WITH EXPECTED FLOWS GREATER THAN 1 CFS.

6. THE FILTER FABRIC SHALL HAVE A MINIMUM FILTERING EFFICIENCY OF 75%. A MINIMUM TENSILE STRENGTH OF 30 LBS. PER LINEAR INCH AND A FLOW RATE OF 0.3 GALLONS PER SQUARE FOOT PER MINUTE. THE FILTER FABRIC SHALL ALSO HAVE ULTRAVIOLET RAY INHIBITORS TO ASSURE A LIFE USE EXPECTANCY OF 6 MONTHS AT 0 TO 100 DEGREES FAHRENHEIT.
7. THE FILTER FABRIC SHALL BE 36 INCHES OR LESS IN HEIGHT, WITH JOINTS AT EVERY POST AVOIDING OVERLAP IF POSSIBLE (6" MIN. OVERLAP IF NECESSARY) AND POSTS SPACED EVERY 10 FEET WITH WIRE MESH SUPPORT OR 6 FEET WITHOUT SUPPORT, MAKING SURE THAT A MIN. OF 8" OF FABRIC IS BURIED IN THE 4"x4" TRENCH.
8. THE SILT FENCE SHALL BE INSPECTED AFTER EVERY RAINFALL TO DETERMINE IF ANY PART OF THE FENCE NEEDS TO BE REPAIRED OR REPLACED. IF IT IS DETERMINED THAT THE FENCE NEEDS ANY REPAIR OR REPLACEMENT THIS SHALL BE DONE IMMEDIATELY.
9. SEDIMENT DEPOSITS SHALL BE REMOVED AFTER EACH RAINFALL OR BEFORE THEY ACCUMULATE TO 1/2 OF THE FENCE HEIGHT.

SEDIMENT FENCE DETAIL

NOT TO SCALE

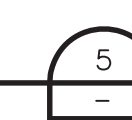

3741 NE TROON DR
LEE'S SUMMIT, MO 64064
816.347.1100

MO STATE CERTIFICATE OF
AUTHORITY #000856

PROJECT FOR

**LANDROCK
DEVELOPMENT, LLC**

**CREEKSIDE AT RAINTREE
LOTS 1 THRU 31
LEE'S SUMMIT, MISSOURI**

B	04/14/2017	CITY RESUBMITTAL
A	03/08/2017	CITY SUBMITTAL
MARK	DATE	DESCRIPTION

PROJECT NUMBER	10028825-276408
ORIGINAL ISSUE	MARCH 7, 2017

PROJECT MANAGER	SIMON SUN
PROJECT ENGINEER	WILL NEDS, E.I.T.



SHEET NAME

**EROSION AND SEDIMENT
CONTROL DETAILS**

SCALE	NO SCALE
-------	----------


SHEET NUMBER

01C-CR-06

FILE NAME | 01C-CR-06.dwg


PERMIT REVIEW DRAWINGS

DIVERSIONS

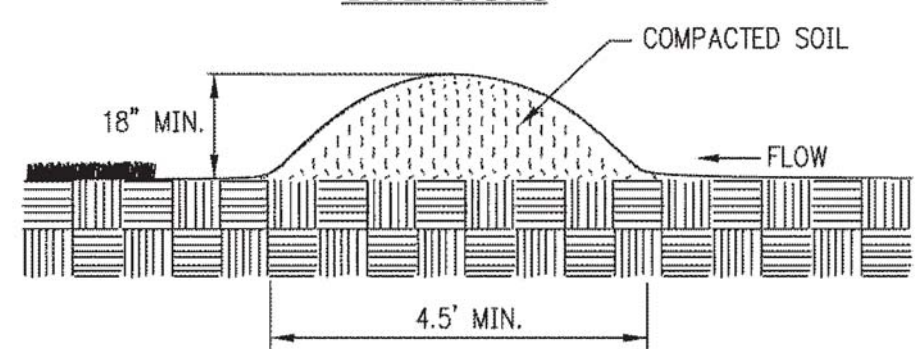


TEMPORARY DIVERSION DIKE NOT TO SCALE


TEMPORARY RIGHT-OF-WAY DIVERSIONS

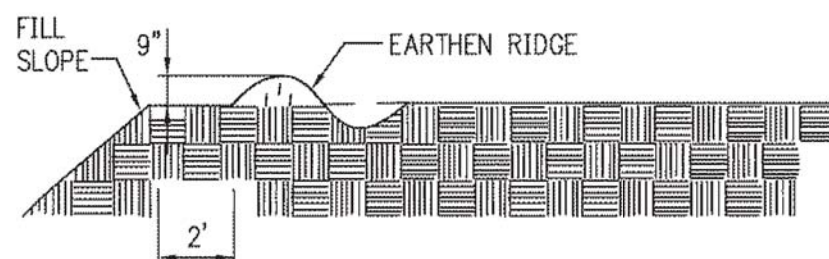


TEMPORARY FILL DIVERSION NOT TO SCALE

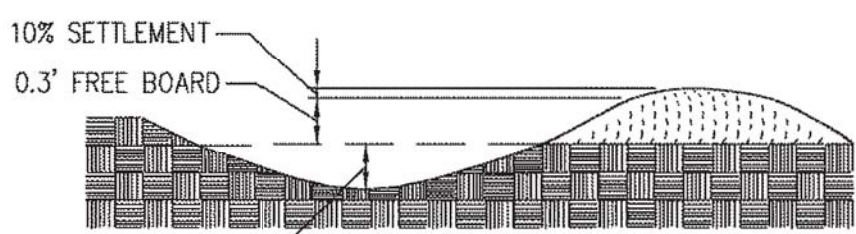


TYPICAL PARABOLIC DIVERSION

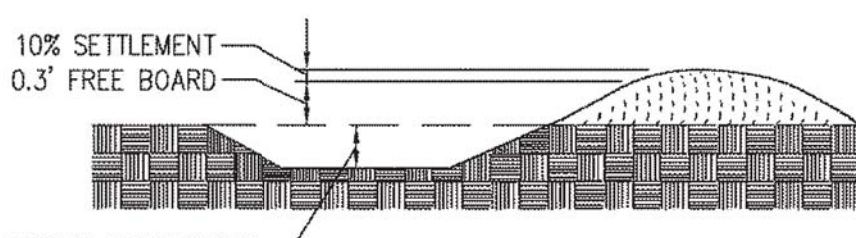


TYPICAL TRAPEZOIDAL DIVERSION

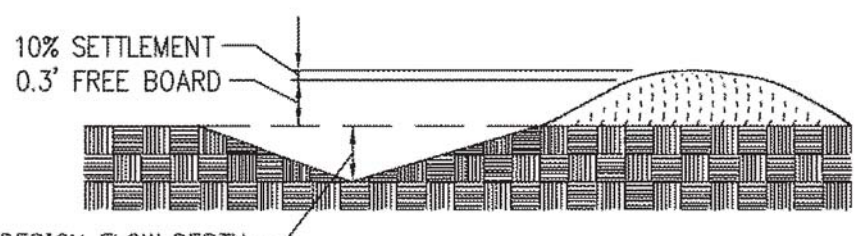

TYPICAL VEE-SHAPED DIVERSION

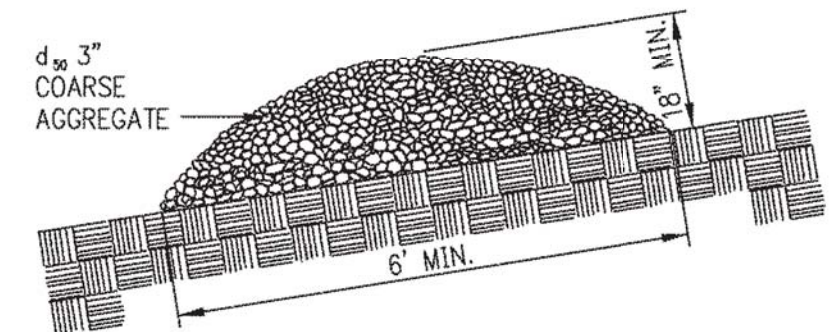

TYPICAL GRAVEL STRUCTURE

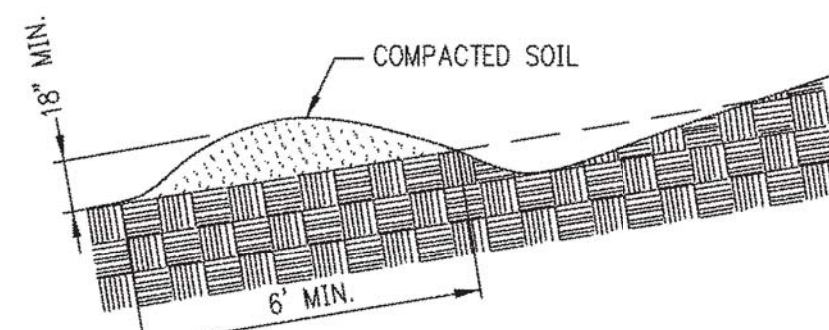

TYPICAL EARTHEN STRUCTURE

TEMPORARY DIVERSION DIKE NOTES:

- 1. TEMPORARY DIVERSION DIKES MUST BE INSTALLED AS A FIRST STEP IN THE LAND-DISTURBING ACTIVITY AND MUST BE FUNCTIONAL PRIOR TO UPSLOPE LAND DISTURBANCE.
2. THE DIKE SHOULD BE ADEQUATELY COMPACTED TO PREVENT FAILURE.
3. TEMPORARY OR PERMANENT SEEDING AND MULCH SHALL BE APPLIED TO THE DIKE IMMEDIATELY FOLLOWING ITS CONSTRUCTION.
4. THE DIKE SHOULD BE LOCATED TO MINIMIZE DAMAGES BY CONSTRUCTION OPERATIONS AND TRAFFIC.

TEMPORARY FILL DIVERSION NOTES:

- 1. THE DIVERSION SHALL BE CONSTRUCTED AT THE TOP OF THE FILL AT THE END OF EACH WORK DAY AS NEEDED.
2. THE DIVERSION SHALL BE LOCATED AT LEAST 2 FEET INSIDE THE TOP EDGE OF THE FILL.
3. THE SUPPORTING RIDGE SHALL BE CONSTRUCTED WITH A UNIFORM HEIGHT ALONG ITS ENTIRE LENGTH. WITHOUT UNIFORM HEIGHT, THE FILL DIVERSION MAY BE SUSCEPTIBLE TO BREACHING.

RIGHT-OF-WAY DIVERSION DETAIL NOTES:

- 1. THE DIVERSION SHALL BE INSTALLED AS SOON AS THE RIGHT-OF-WAY HAS BEEN CLEARED AND/OR GRADED.
2. ALL EARTHEN DIVERSIONS SHALL BE MACHINE- OR HAND-COMPACTED IN 8-INCH LIFTS.
3. THE OUTLET OF THE DIVERSION SHALL BE LOCATED IN AN UNDISTURBED AND STABILIZED AREA WHEN AT ALL POSSIBLE. THE FIELD LOCATION SHOULD BE ADJUSTED AS NEEDED TO UTILIZE A STABILIZED OUTLET.
4. EARTHEN DIVERSIONS WHICH WILL NOT BE SUBJECT TO CONSTRUCTION TRAFFIC SHOULD BE STABILIZED IN ACCORDANCE WITH TEMPORARY SEEDING.

DIVERSION DETAIL NOTES:


- 1. ALL TREES, BRUSH, STUMPS, OBSTRUCTIONS, AND OTHER OBJECTIONABLE MATERIAL SHALL BE REMOVED AND DISPOSED OF SO AS NOT TO INTERFERE WITH THE PROPER FUNCTIONING OF THE DIVERSION.
2. THE DIVERSION SHALL BE EXCAVATED OR SHAPED TO LINE, GRADE, AND CROSS-SECTION AS REQUIRED TO MEET THE CRITERIA SPECIFIED HEREIN, FREE OF IRREGULARITIES WHICH WILL IMPEDE FLOW.
3. FILLS SHALL BE COMPACTED AS NEEDED TO PREVENT UNEQUAL SETTLEMENT THAT WOULD CAUSE DAMAGE IN THE COMPLETED DIVERSION. FILL SHALL BE COMPOSED OF SOIL WHICH IS FREE FROM EXCESSIVE ORGANIC DEBRIS, ROCKS, OR OTHER OBJECTIONABLE MATERIALS.
4. ALL EARTH REMOVED AND NOT NEEDED IN CONSTRUCTION SHALL BE SPREAD OR DISPOSED OF SO THAT IT WILL NOT INTERFERE WITH THE FUNCTIONING OF THE DIVERSION.
5. PERMANENT STABILIZATION OF DISTURBED AREAS SHALL BE DONE IN ACCORDANCE WITH SECTION 2151.

AMERICAN PUBLIC WORKS ASSOCIATION


APWA KANSAS CITY METROPOLITAN CHAPTER DIVERSIONS STANDARD DRAWING NUMBER ESC-29 ADOPTED:

SOURCE: MODIFIED FROM VA. DCR, 1992


TEMPORARY SEDIMENT TRAP

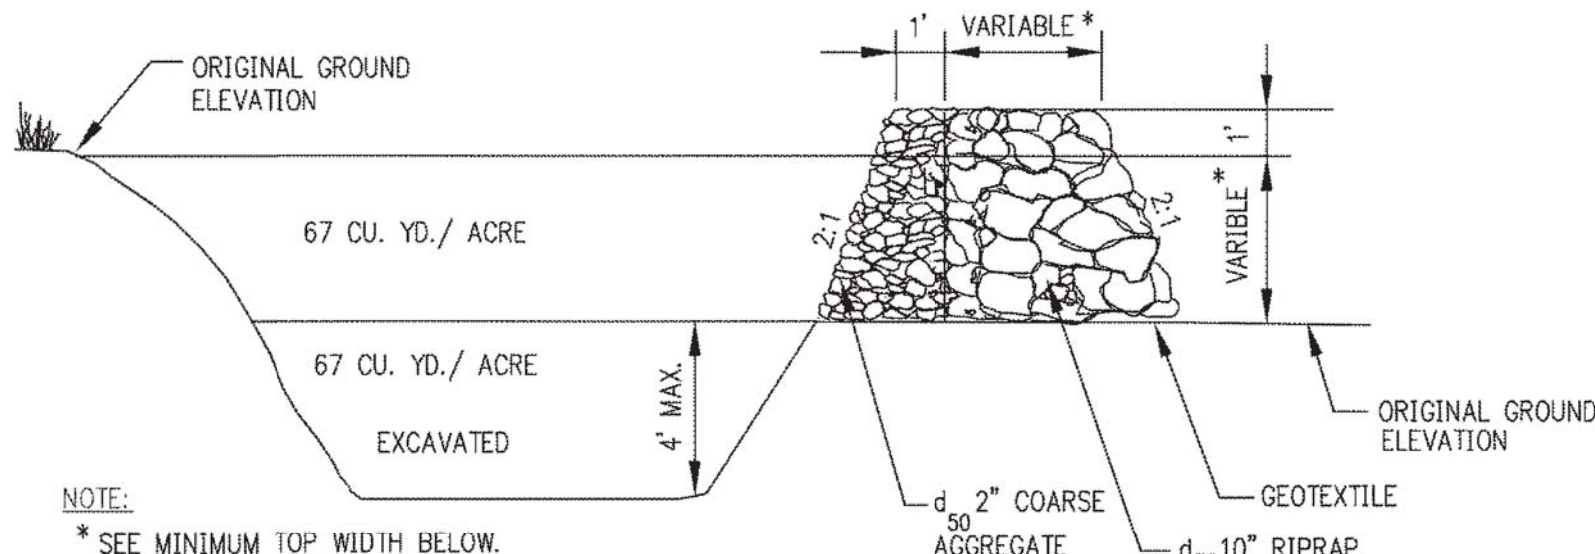

CROSS SECTION OF OUTLET NOT TO SCALE

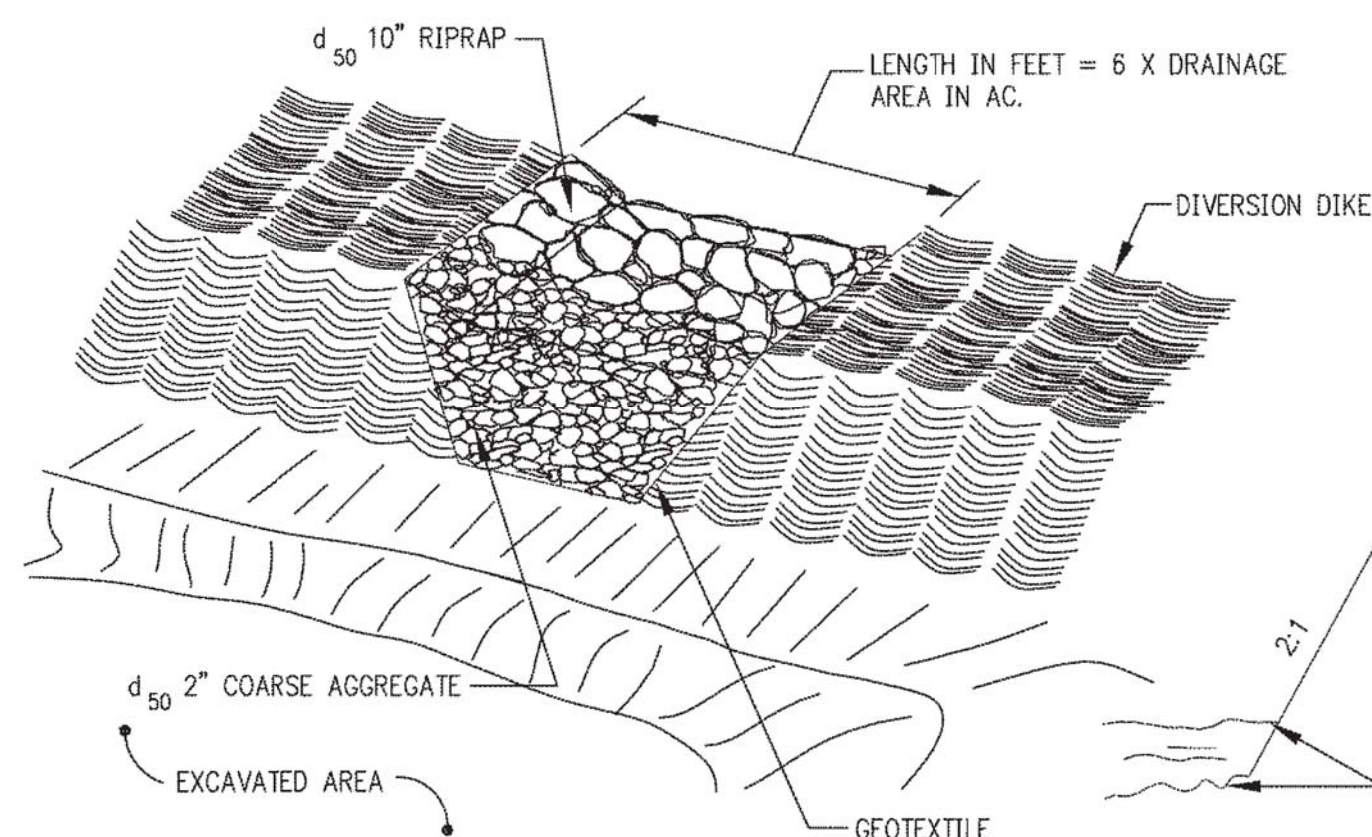

OUTLET (PERSPECTIVE VIEW)

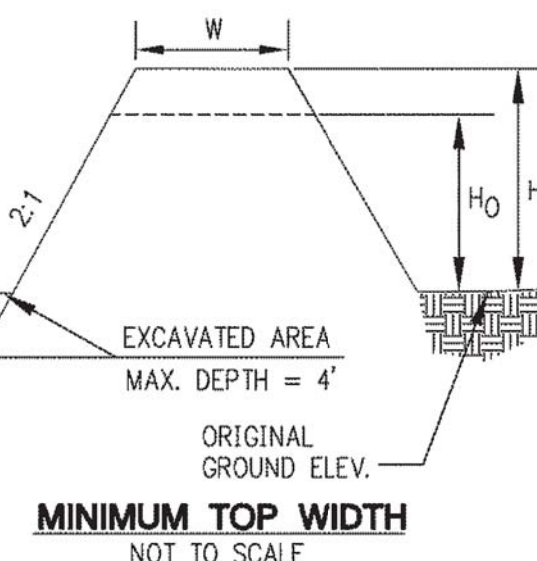

MINIMUM TOP WIDTH NOT TO SCALE

TEMPORARY SEDIMENT TRAP NOTES:

A) CONSTRUCTION SPECIFICATIONS:

- 1. THE AREA UNDER THE EMBANKMENT SHALL BE CLEARED, GRUBBED, AND STRIPPED OF ANY VEGETATION AND ROOT MAT.
2. FILL MATERIAL FOR THE EMBANKMENT SHALL BE FREE OF ROOTS OR OTHER WOODY VEGETATION, ORGANIC MATERIAL, LARGE STONES, AND OTHER OBJECTIONABLE MATERIAL. THE EMBANKMENT SHOULD BE COMPACTED IN 6-INCH LAYERS BY TRAVERSING WITH CONSTRUCTION EQUIPMENT.
3. THE EARTHEN EMBANKMENT SHALL BE SEEDING WITH TEMPORARY OR PERMANENT VEGETATION IMMEDIATELY AFTER INSTALLATION.
4. CONSTRUCTION OPERATIONS SHALL BE CARRIED OUT TO MINIMIZE EROSION AND WATER POLLUTION.
5. THE STRUCTURE SHALL BE REMOVED AND THE AREA STABILIZED WHEN THE UPSLOPE DRAINAGE AREA HAS BEEN STABILIZED.
6. ALL CUT AND FILL SLOPES SHALL BE 2H:1V OR FLATTER EXCEPT FOR EXCAVATED, WET STORAGE AREAS WHICH MAY BE AT A MAXIMUM 1H:1V GRADE.

B) INSPECTION AND MAINTENANCE:

- 1. INSPECT THE TEMPORARY SEDIMENT TRAP AFTER EACH STORM EVENT OF 1/2-INCH OR GREATER.
2. REMOVE AND PROPERLY DISPOSE OF SEDIMENT WHEN IT ACCUMULATES TO ONE-HALF THE DESIGN VOLUME AS INDICATED BY THE CLEAN-OUT STAKE.
3. PERIODICALLY CHECK THE EMBANKMENT, SPILLWAY, AND OUTLET APRON FOR EROSION DAMAGE, SETTLING SEEPAGE, OR SLUMPING ALONG THE TOE AND REPAIR IMMEDIATELY.
4. REPLACE THE SPILLWAY GRAVEL FACING IF IT BECOMES CLOGGED.
5. INSPECT VEGETATION AND RESEED IF NECESSARY.
6. REPLACE ANY DISPLACED RIPRAP SO THAT NO REPLACEMENT ROCK IS ABOVE THE DESIGN GRADE.
7. REMOVE THE TEMPORARY SEDIMENT TRAP AFTER THE DRAINAGE AREA HAS BEEN PERMANENTLY STABILIZED, INSPECTED, AND APPROVED. DO SO BY DRAINING ANY WATER, REMOVING THE SEDIMENT TO A DESIGNATED DISPOSAL AREA, AND GRADING THE SITE TO BLEND WITH THE SURROUNDING AREA; THEN STABILIZE.

Table with 3 columns: H, H0, W. Values range from 1.5 to 5.0.

AMERICAN PUBLIC WORKS ASSOCIATION

APWA KANSAS CITY METROPOLITAN CHAPTER TEMPORARY SEDIMENT TRAP STANDARD DRAWING NUMBER ESC-33 ADOPTED:

SOURCE: MODIFIED FROM VA. DCR, 1992



3741 NE TROON DR LEE'S SUMMIT, MO 64064 816.347.1100

MO STATE CERTIFICATE OF AUTHORITY #000856

PROJECT FOR

LANDROCK DEVELOPMENT, LLC

CREEKSIDE AT RAINTREE LOTS 1 THRU 31 LEE'S SUMMIT, MISSOURI

Table with 3 columns: Mark, Date, Description. Includes B 04/14/2017 CITY RESUBMITTAL and A 03/08/2017 CITY SUBMITTAL.

Table with 2 columns: Project Number, Original Issue. Values: 10028825-276408, MARCH 7, 2017.

Table with 2 columns: Project Manager, Project Engineer. Values: SIMON SUN, WILL NEDS, E.I.T.



SHEET NAME

EROSION AND SEDIMENT CONTROL DETAILS

SCALE NO SCALE

SHEET NUMBER


01C-CR-07

FILE NAME 01C-CR-07.dwg

PERMIT REVIEW DRAWINGS

MASTER DRAINAGE PLAN NOTES:

- MINIMUM BUILDING OPENING ELEVATIONS (MBOE'S) SHOWN REPRESENT THE MINIMUM RECOMMENDED ELEVATIONS THAT WILL PROVIDE ADEQUATE POSITIVE STORM WATER DRAINAGE TO THE LOWEST POINT ON THE LOT FROM THE ANTICIPATED LOW SIDE OF THE BUILDING. THE HOME BUILDER SHALL BE RESPONSIBLE FOR ENSURING ADEQUATE POSITIVE DRAINAGE AWAY FROM ALL BUILDING OPENINGS TO PREVENT LOCALIZED STRUCTURE FLOODING.
- A DAYLIGHT OR STANDARD UNIT MAY BE CONSTRUCTED ON WALKOUT LOT, AND A STANDARD UNIT MAY BE CONSTRUCTED ON A DAYLIGHT LOT.
- A DAYLIGHT UNIT IS DEFINED AS A UNIT HAVING A WINDOW ON THE BASEMENT LEVEL WITH AT LEAST 5'-4" OF CLEARANCE FROM THE FINISHED FIRST FLOOR ELEVATION TO THE BOTTOM OF THE WINDOW. CLEARANCES LESS THAN 5'-4" ARE DEFINED AS STANDARD UNITS, WHETHER OR NOT A WINDOW WELL IS REQUIRED.
- REFER TO SANITARY SEWER SHEETS FOR SEWER MAIN AND LATERAL ELEVATIONS. SOME LOT MBOE ELEVATIONS ARE HIGHER TO ACCOUNT FOR GRAVITY BASEMENT SEWER SERVICE.
- ALL FRONT LOT ELEVATIONS ARE PROPOSED ELEVATIONS. REAR LOT ELEVATIONS ARE EXISTING ELEVATIONS UNLESS NOTED OTHERWISE WITH AN ELEVATION FOLLOWED BY (P).
- HOME BUILDERS SHALL MAINTAIN 2% GRADE, 1.5% ACROSS SIDEWALKS, WITHIN RIGHT-OF-WAY. AS-BUILT ELEVATIONS SHOWN AT RIGHT-OF-WAY ARE CALCULATED FROM AS-BUILT BACK OF CURB ELEVATIONS.

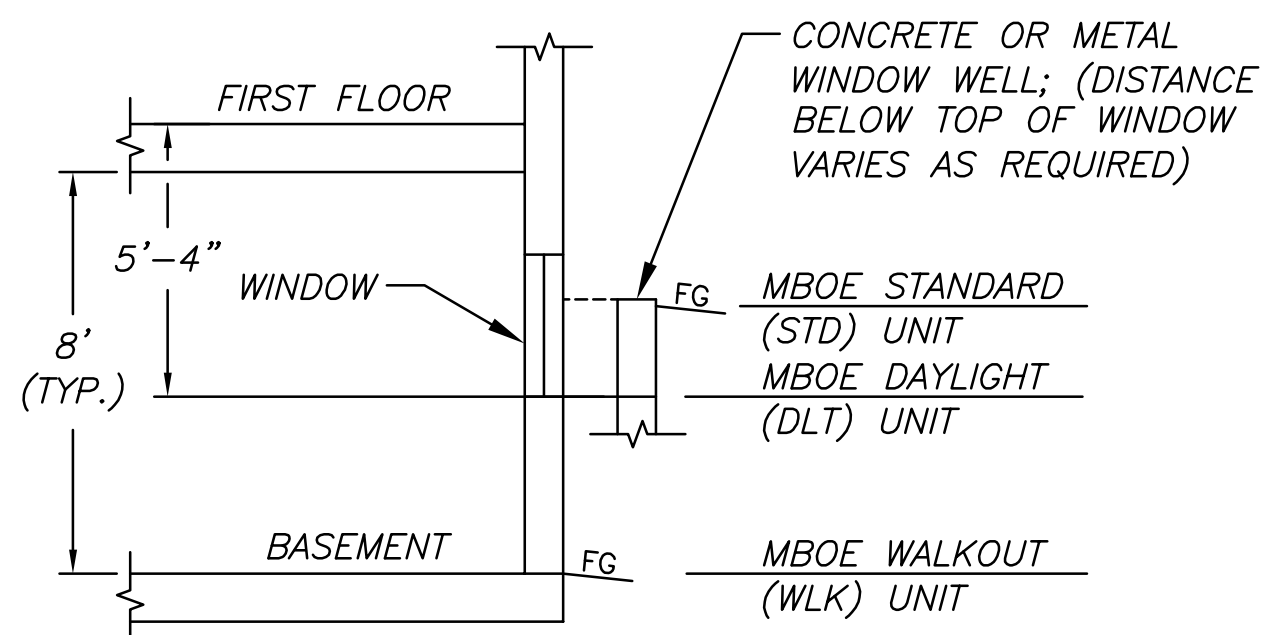


TYPICAL UNIT SECTION
NOT TO SCALE

LEGEND:

- STD = STANDARD UNIT
- DLT = DAYLIGHT UNIT
- WLK = WALKOUT UNIT
- MBOE = MINIMUM BUILDING OPENING ELEVATION
- () = DIRECTION OF MBOE
- ~ = DRAINAGE PATH
- FBD = FLAT BOTTOM DITCH
- ▨ = 1% STORM WSE

"AS-BUILT"
October 29, 2018

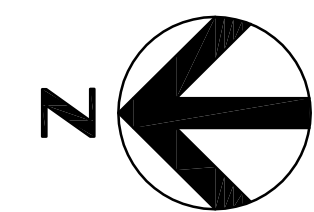

PROJECT FOR

LANDROCK DEVELOPMENT, LLC

**CREEKSIDE AT RAIN TREE
LOTS 1 THRU 31
LEE'S SUMMIT, MISSOURI**


C	10/29/2018	AS-BUILT
B	05/01/2017	CITY RESUBMITTAL
A	03/08/2017	CITY SUBMITTAL
MARK	DATE	DESCRIPTION

PROJECT NUMBER	10028825-276408
ORIGINAL ISSUE	MARCH 7, 2017

PROJECT MANAGER	SIMON SUN
PROJECT ENGINEER	WILL NEDS, E.I.T.

SHEET NAME

MASTER DRAINAGE PLAN

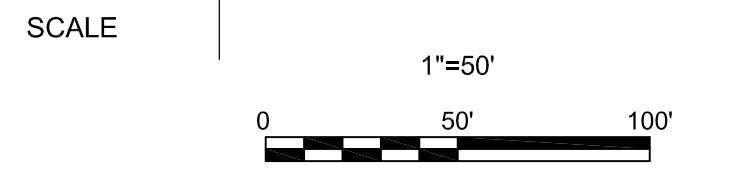

SHEET NUMBER

01C-CR-08

FILE NAME | 01C-CR-08.dwg

PERMIT REVIEW DRAWINGS



3741 NE TROON DR
LEE'S SUMMIT, MO 64064
816.347.1100

MO STATE CERTIFICATE OF
AUTHORITY #000856

C:\working\p\012511\As-Built\MDP.dwg, 01C-CR-08, 10/29/2018 10:49:20 AM, VMEDES



3741 NE TROON DR
LEE'S SUMMIT, MO 64064
816.347.1100

MO STATE CERTIFICATE OF
AUTHORITY #000856

PROJECT FOR

**LANDROCK
DEVELOPMENT, LLC**

**CREEKSIDE AT RAINTREE
LOTS 1 THRU 31
LEE'S SUMMIT, MISSOURI**

B	04/18/2017	CITY RESUBMITTAL
A	03/08/2017	CITY SUBMITTAL
MARK	DATE	DESCRIPTION

PROJECT NUMBER	10028825-276408
ORIGINAL ISSUE	MARCH 7, 2017

PROJECT MANAGER	SIMON SUN
PROJECT ENGINEER	WILL NEDS, E.I.T.



SHEET NAME

**TYPICAL ADA RAMP
DETAILS**


SCALE NO SCALE

SHEET NUMBER


01C-CR-09

FILE NAME 01C-CR-09.dwg

PERMIT REVIEW DRAWINGS

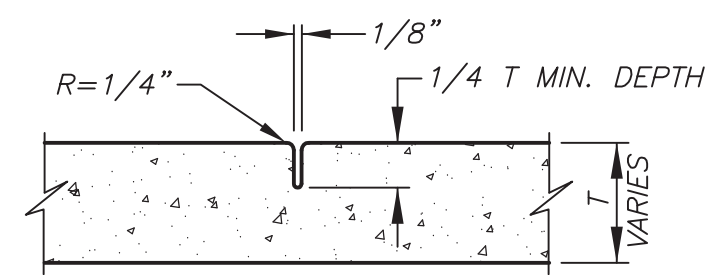


CONTRACTION JOINT

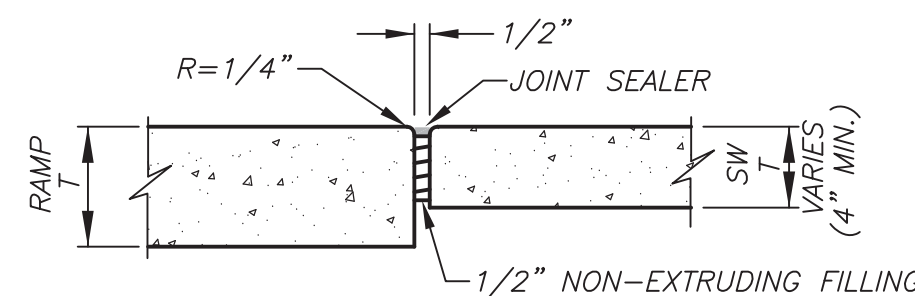


ISOLATION JOINT


JOINT DETAILS
NOT TO SCALE

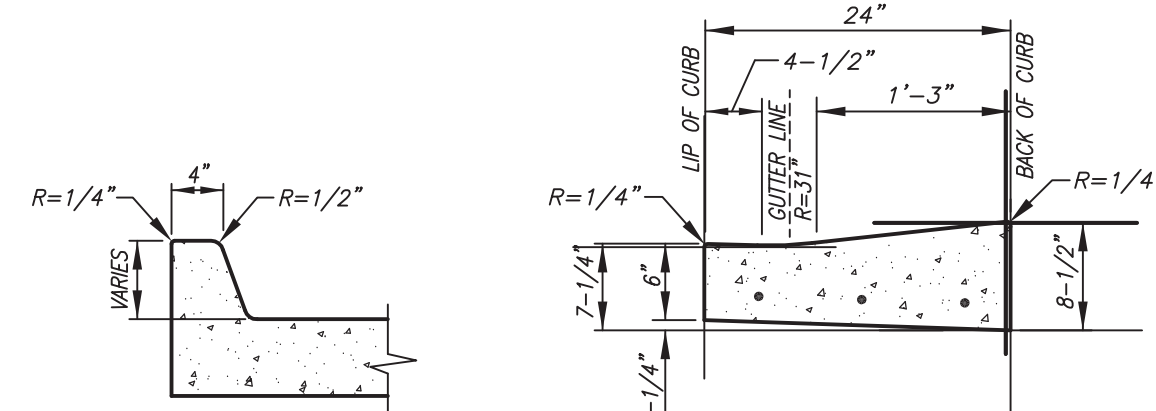

RAMP CURB DETAIL

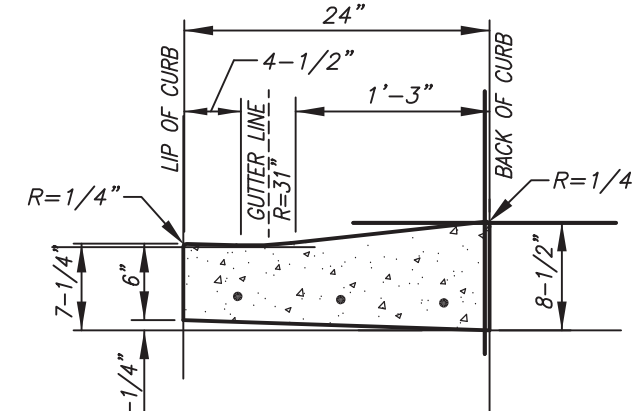


**STREET CURB AT RAMP
USE WITH TYPE CG-2 CURB**

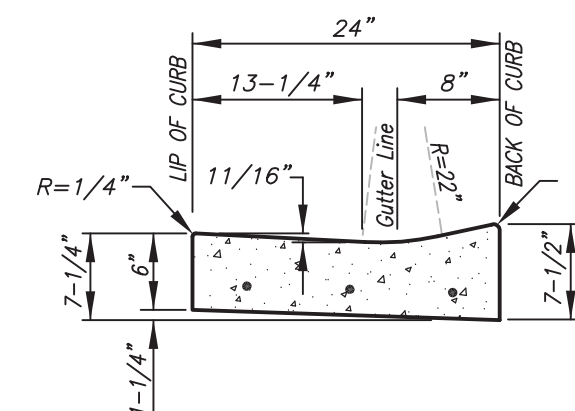

**STREET CURB AT RAMP
USE WITH TYPE CG-1 CURB**


ADA CURB DETAILS

NOT TO SCALE

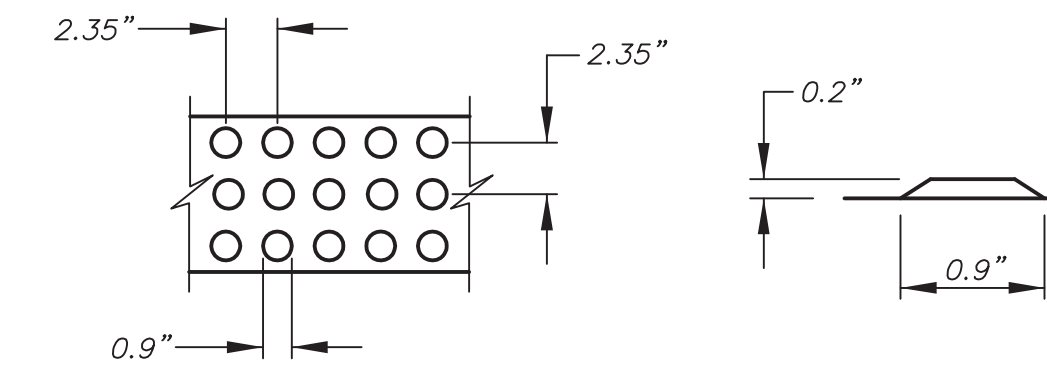


**DETECTABLE WARNING DOME
SPACING AND SECTION**


NOT TO SCALE

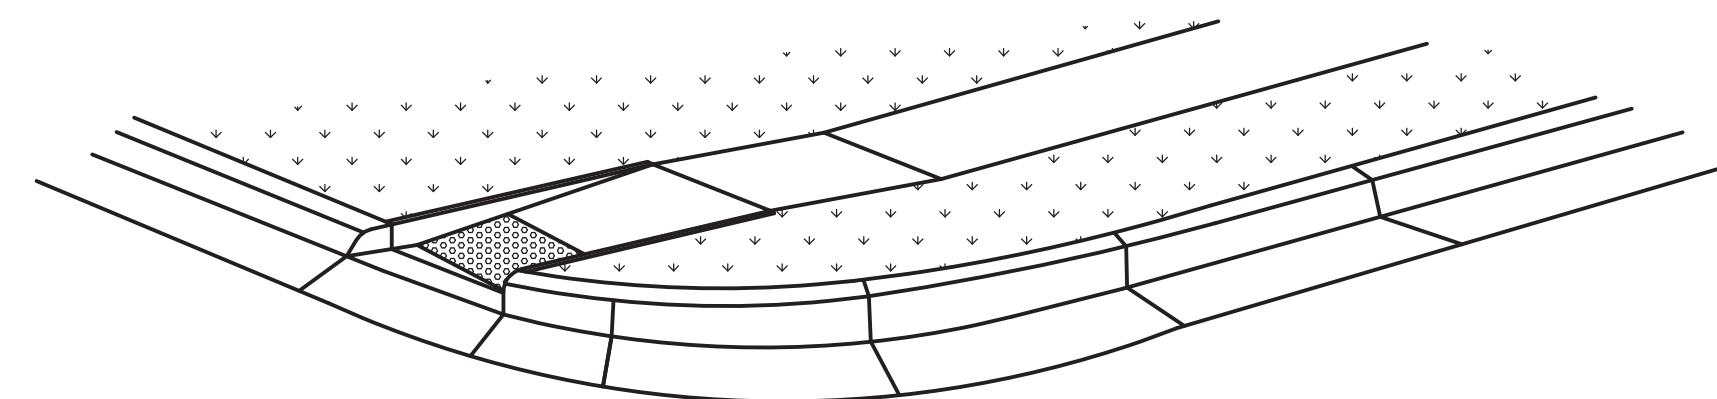

**3-D VIEW TYPE A
SIDEWALK RAMP**


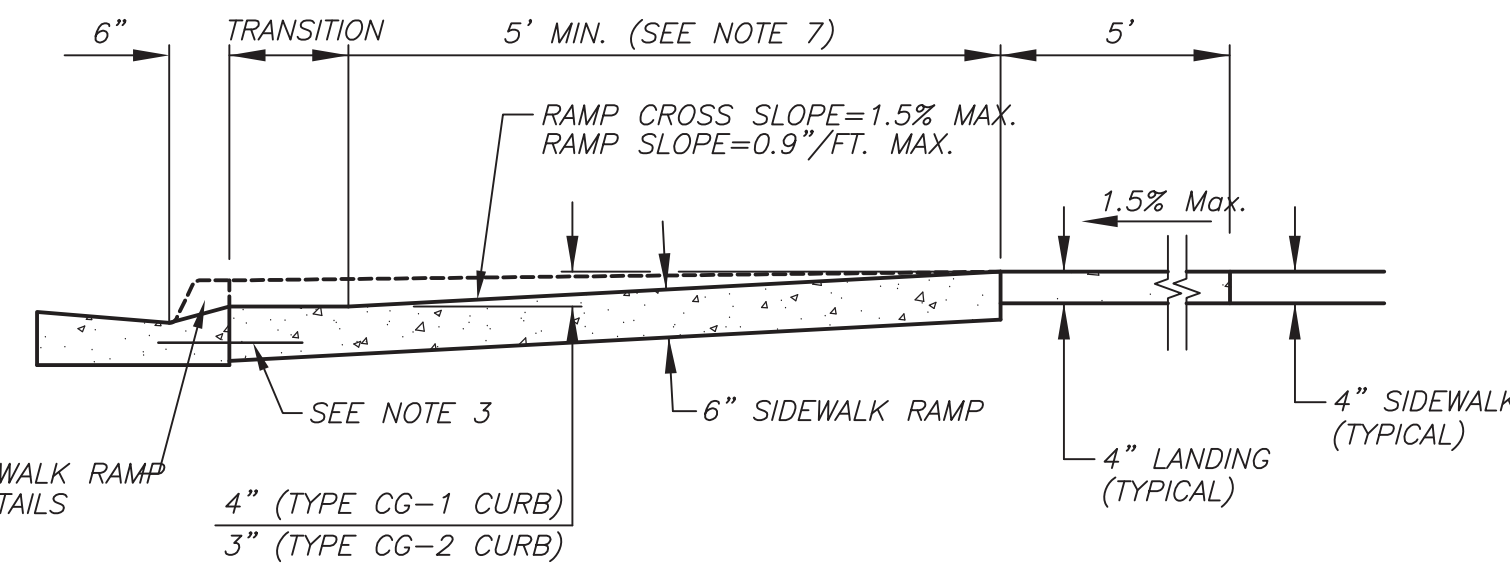


SECTION A-A

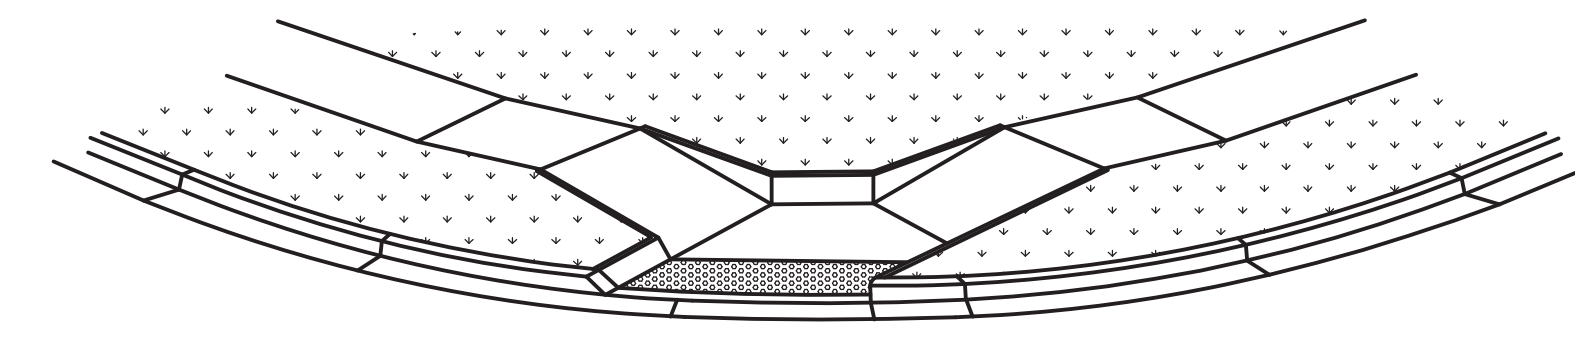


**3-D VIEW TYPE B
SIDEWALK RAMP**

LEGEND:

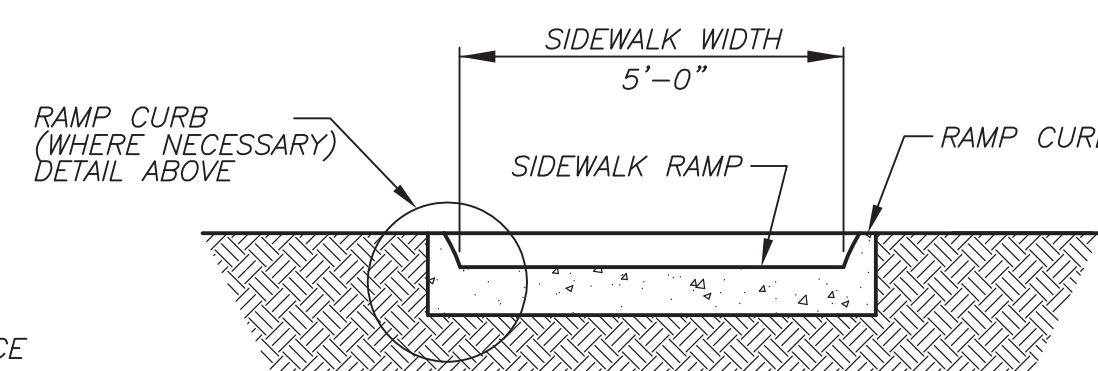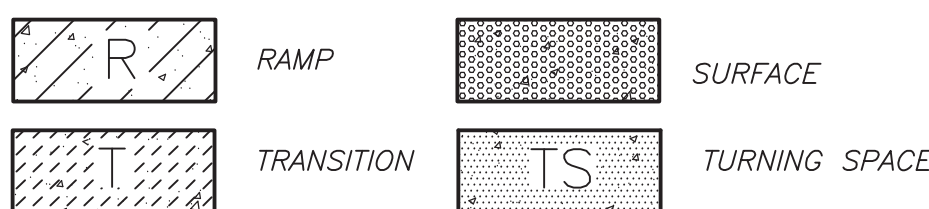


SECTION B-B

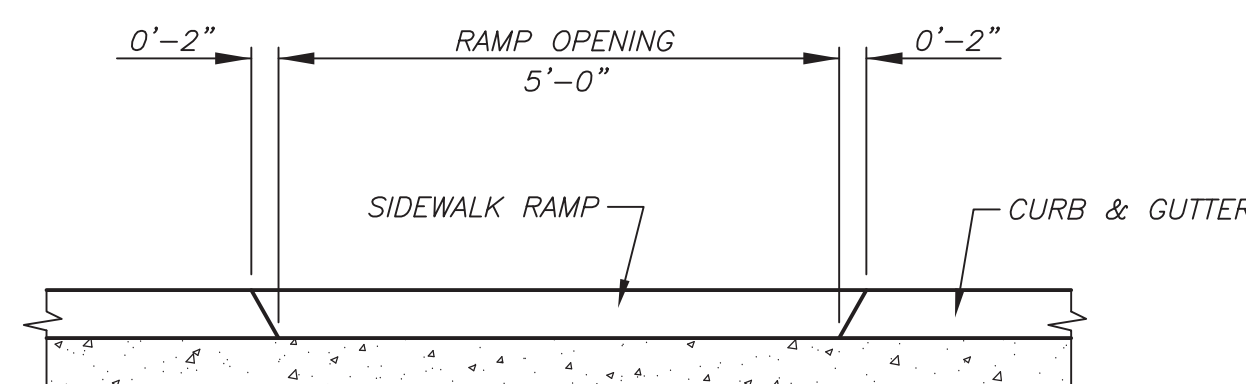

SECTION C-C

ALTERNATE DETECTABLE SURFACE LAYOUT

IF THE DISTANCE EXCEEDS 5', ADJUST DETECTABLE SURFACE AS SHOWN IN ALTERNATE DETECTABLE SURFACE LAYOUT.

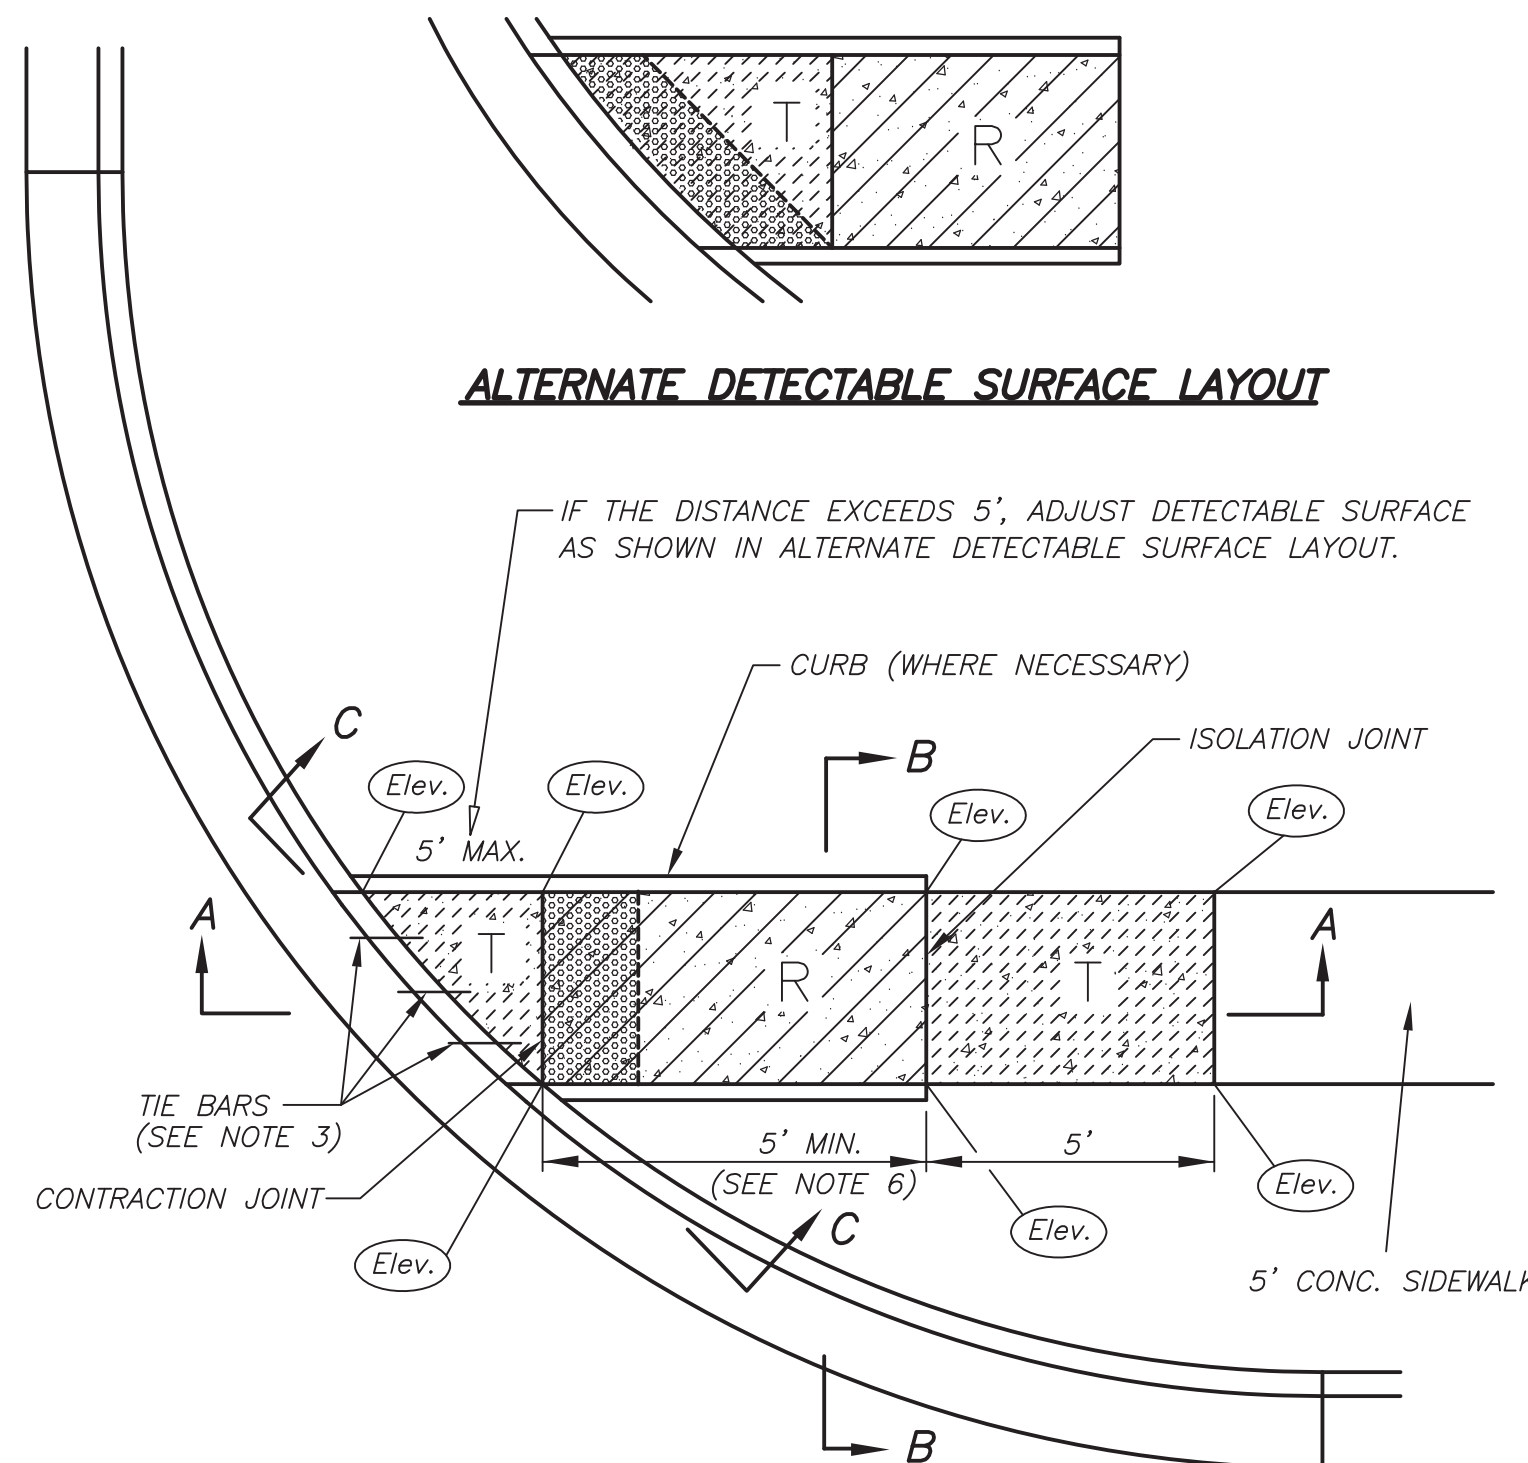


TYPE A SIDEWALK RAMP

NOT TO SCALE

SIDEWALK & SIDEWALK RAMP NOTES:

1. SIDEWALK RAMP LOCATION DETERMINED FROM THE INTERSECTION OF THE EXTENSION OF BACK OF SIDEWALK AND BACK OF CURB AND GUTTER.
2. PLAN DRAWINGS INCLUDE A TABLE OF ELEVATIONS FOR ALL POINTS.
3. KEY ALL CONSTRUCTION JOINTS OR USE TIE BARS #4 EPOXY COATED @ 12" O.C.
4. LONGITUDINAL JOINT SPACING TO MATCH WIDTH OF SIDEWALK.
5. ISOLATION JOINTS SHALL BE PLACED WHERE WALK ABUTS DRIVEWAYS AND SIMILAR STRUCTURES, AND 250' CENTERS MAX.
6. SIDEWALK RAMP SHALL BE LENGTHENED TO PROVIDE ADA COMPLIANCE SLOPE BUT NEED NOT EXCEED 15'.
7. ADA MAXIMUM RAMP SLOPE = 1"/FT.
ADA MAXIMUM CROSS SLOPE = 2%.
8. TURNING SPACES SHALL BE 1.5%, ± 0.5%, SLOPE IN ANY DIRECTION. TURNING SPACES SHALL HAVE A MINIMUM 4'x4' TURNING AREA. TURNING SPACES, WITH A SIDEWALK CURB, SHALL HAVE A 5' TURNING AREA PERPENDICULAR TO THE SIDEWALK CURB.
9. ALL SIDEWALK AND RAMP CONSTRUCTION SHALL MEET CURRENT PUBLIC RIGHT OF WAY ACCESSIBILITY GUIDELINES (PROWAG).

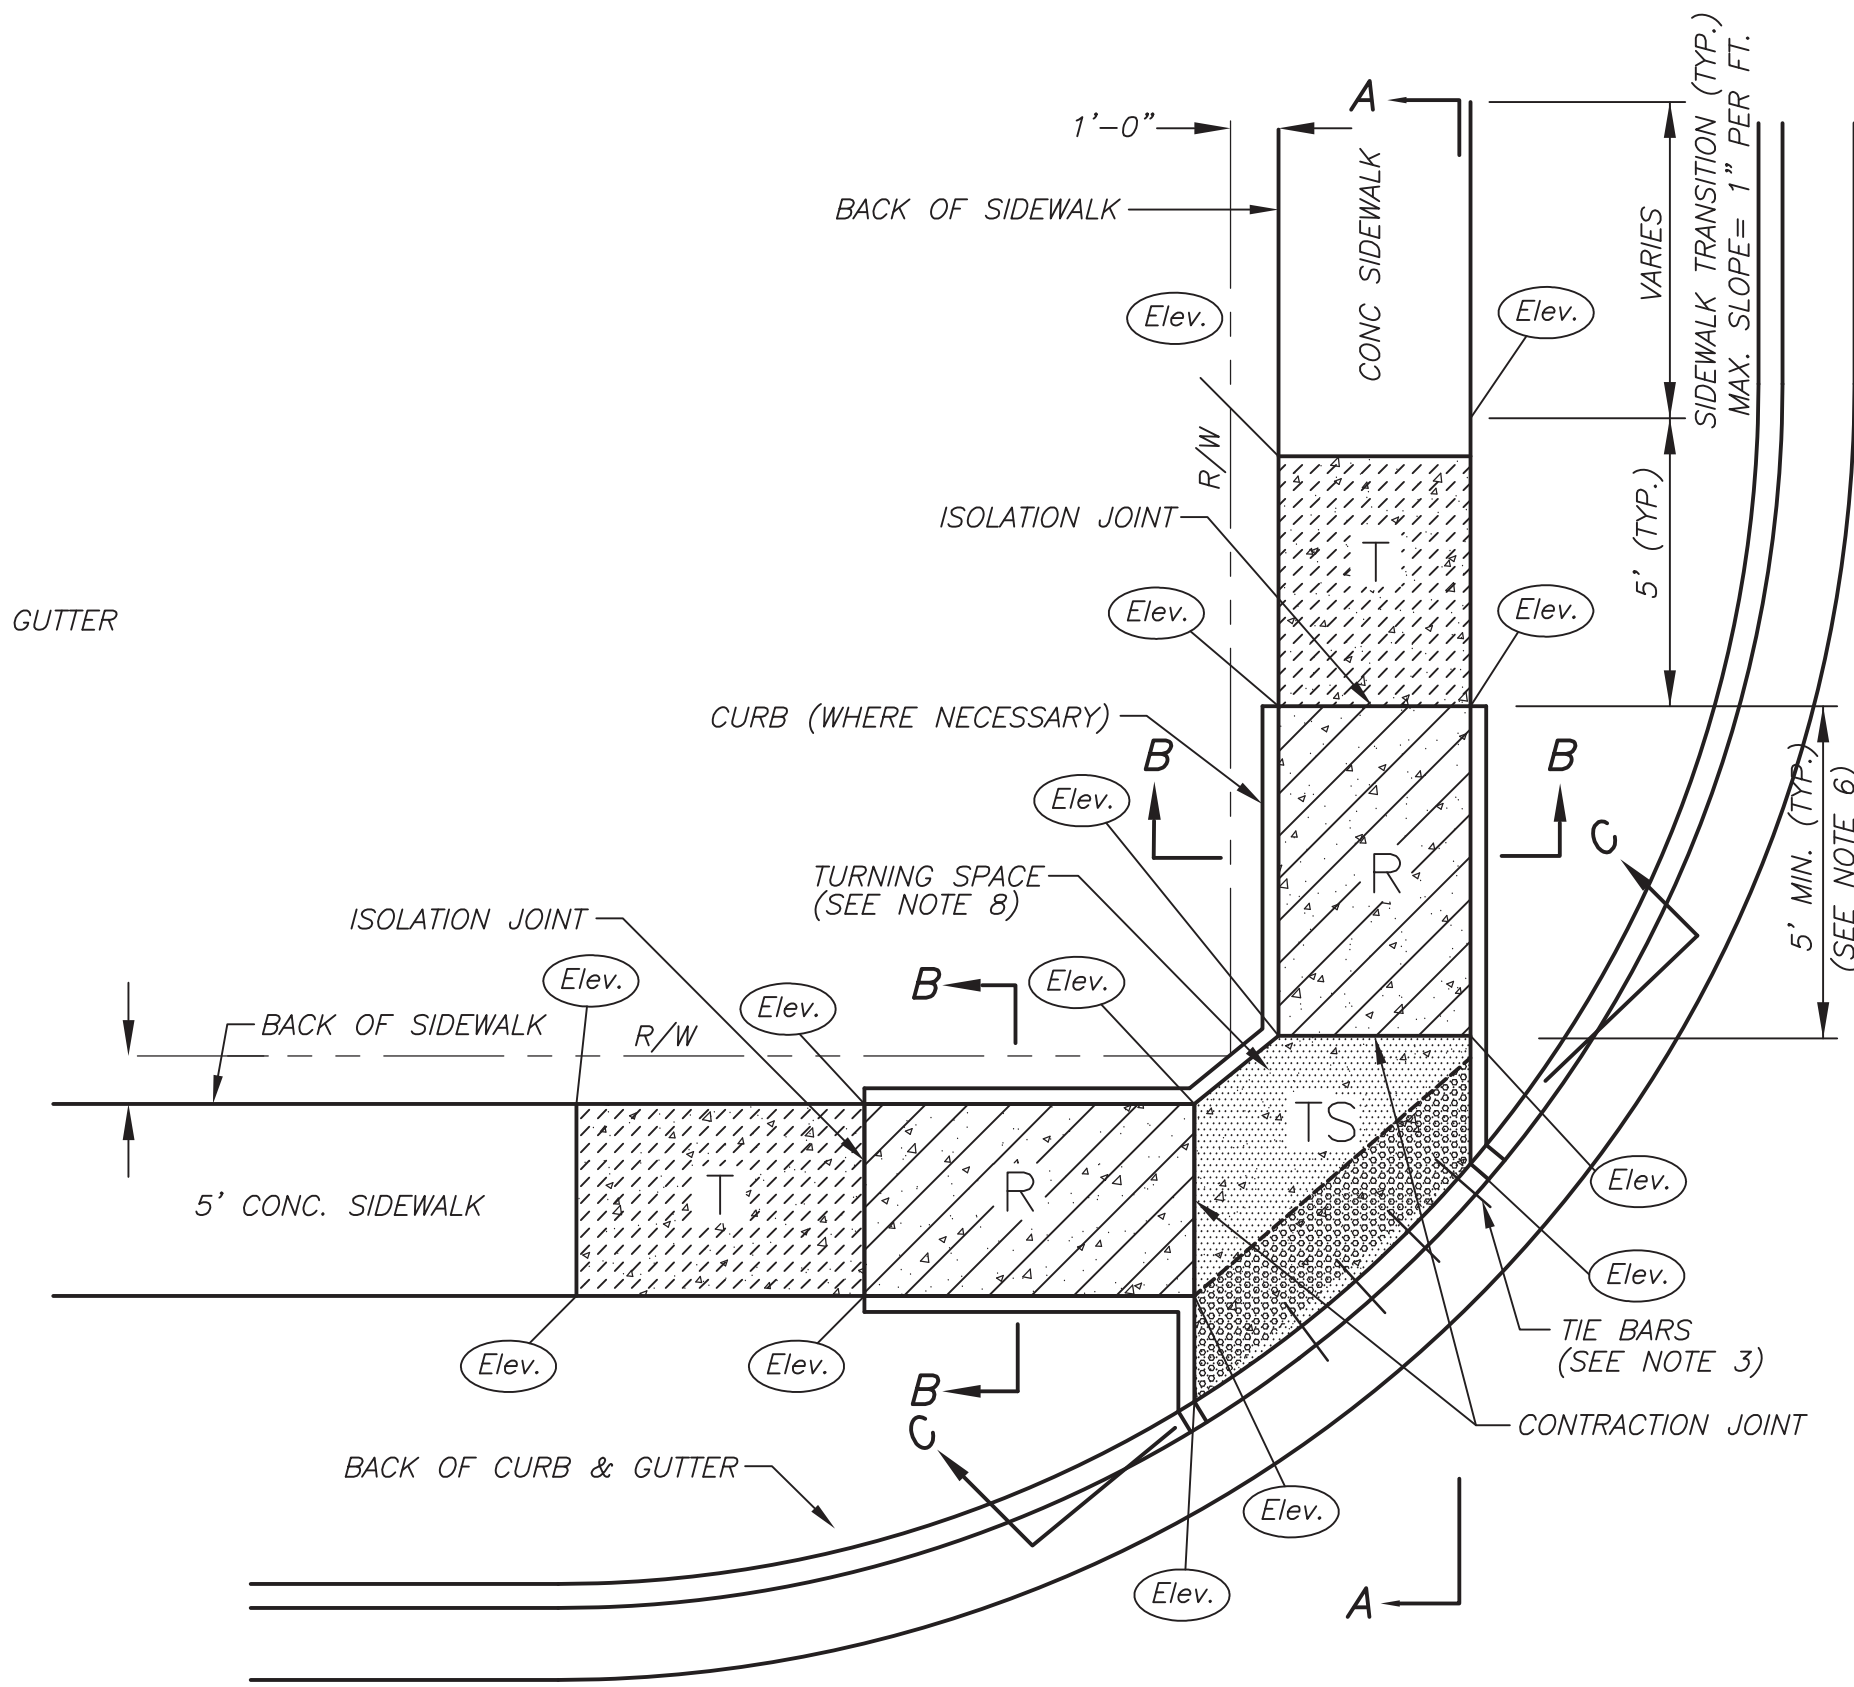

TYPE B SIDEWALK RAMP

NOT TO SCALE



3741 NE TROON DR
LEE'S SUMMIT, MO 64064
816.347.1100

MO STATE CERTIFICATE OF
AUTHORITY #000856

PROJECT FOR

**LANDROCK
DEVELOPMENT, LLC**

**CREEKSIDE AT RAINTREE
LOTS 1 THRU 31
LEE'S SUMMIT, MISSOURI**

B	04/18/2017	CITY RESUBMITTAL
A	03/08/2017	CITY SUBMITTAL
MARK	DATE	DESCRIPTION

PROJECT NUMBER	10028825-276408
ORIGINAL ISSUE	MARCH 7, 2017

PROJECT MANAGER	SIMON SUN
PROJECT ENGINEER	WILL NEDS, E.I.T.



SHEET NAME

**TYPICAL ADA RAMP
DETAILS**


SCALE | NO SCALE

SHEET NUMBER


01C-CR-10

FILE NAME | 01C-CR-10.dwg


PERMIT REVIEW DRAWINGS

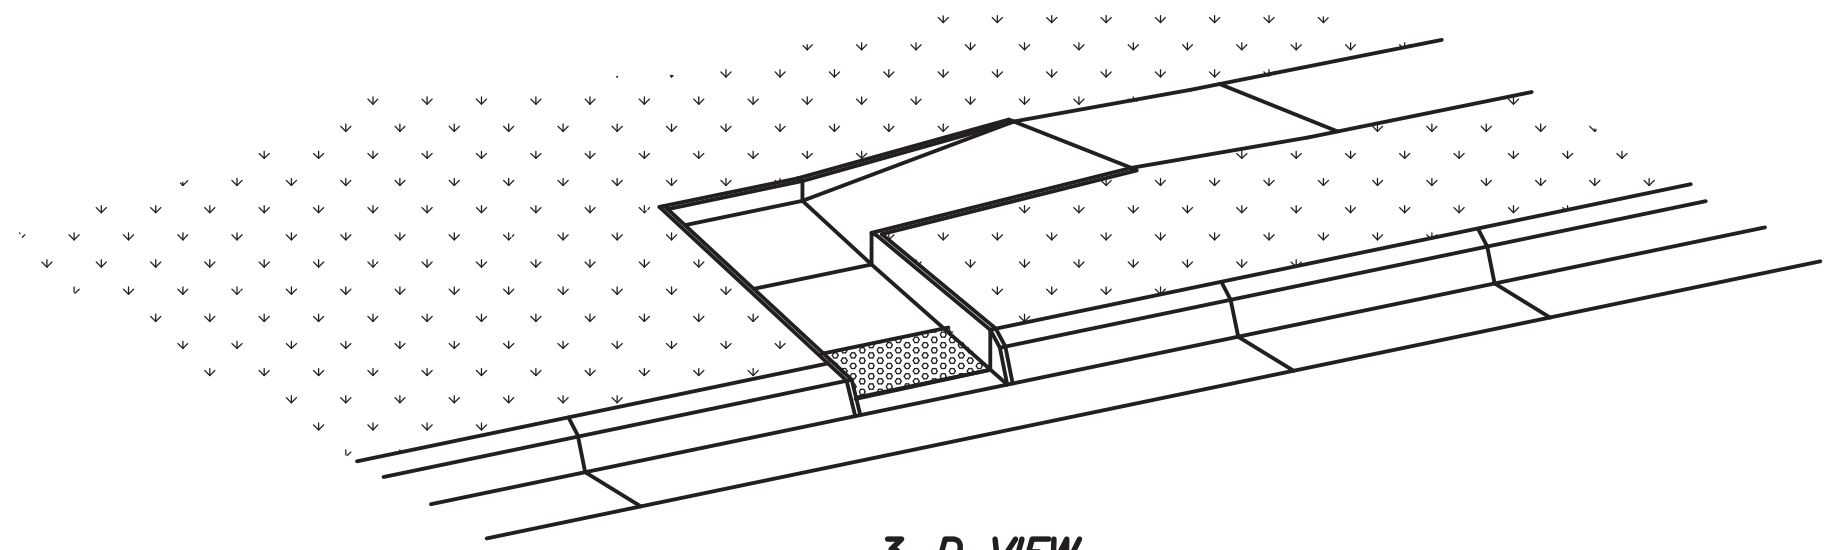


**3-D VIEW
MID-BLOCK SIDEWALK CONNECTION**

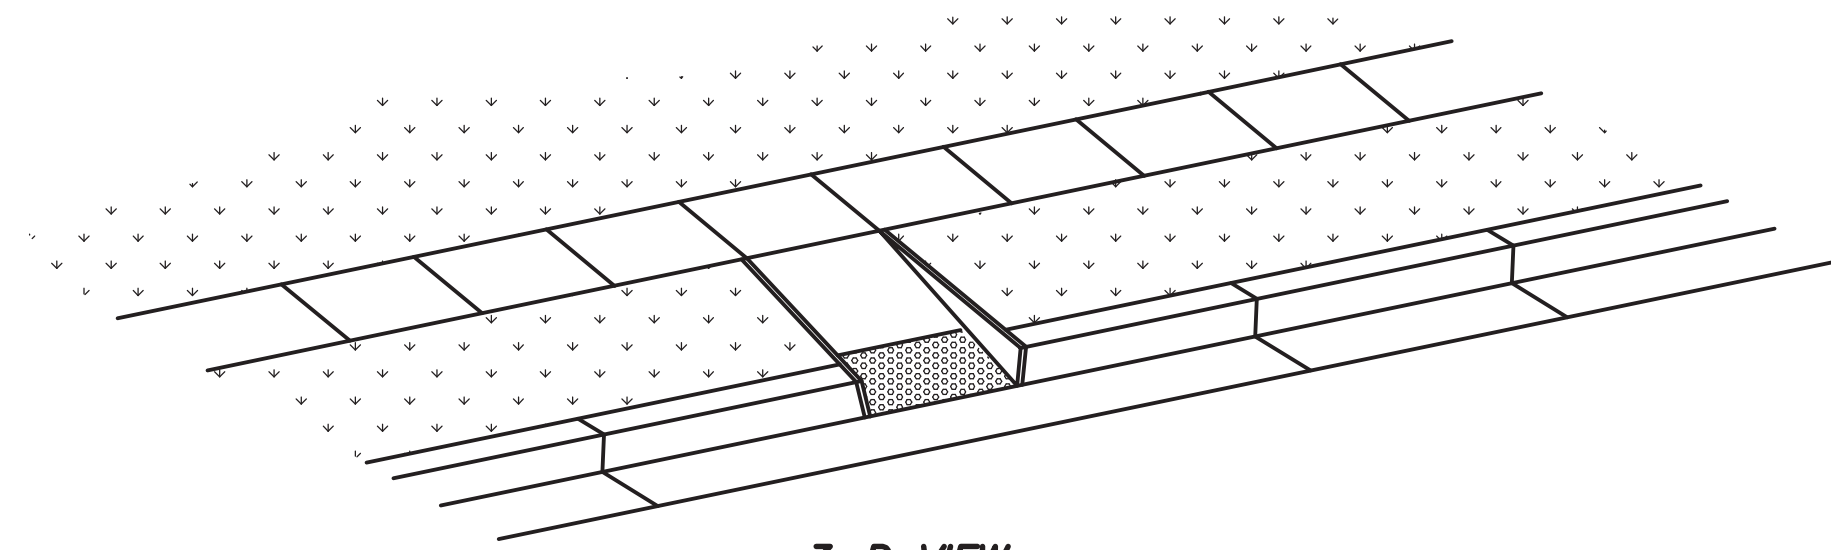


**3-D VIEW
MID-BLOCK SIDEWALK RAMP**

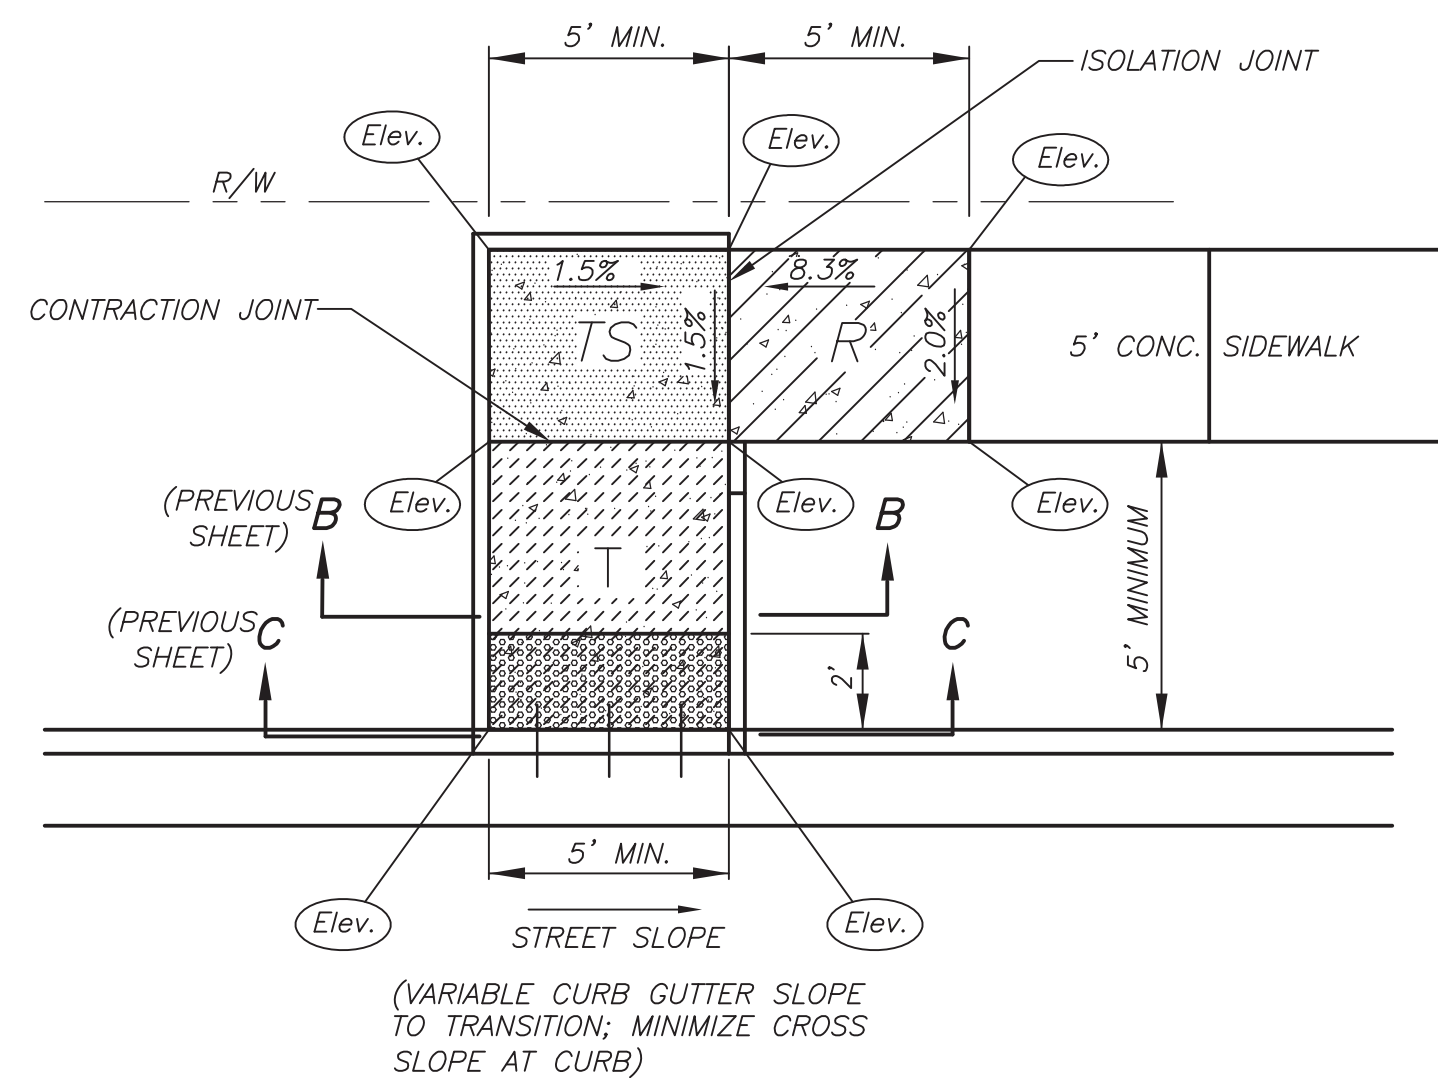


**MODIFIED MID-BLOCK
SIDEWALK CONNECTION**
NOT TO SCALE

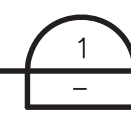

1. REFERENCE SHEET 01C-CR-09 FOR ADDITIONAL ADA RAMP NOTES AND CROSS-SECTION INFORMATION.

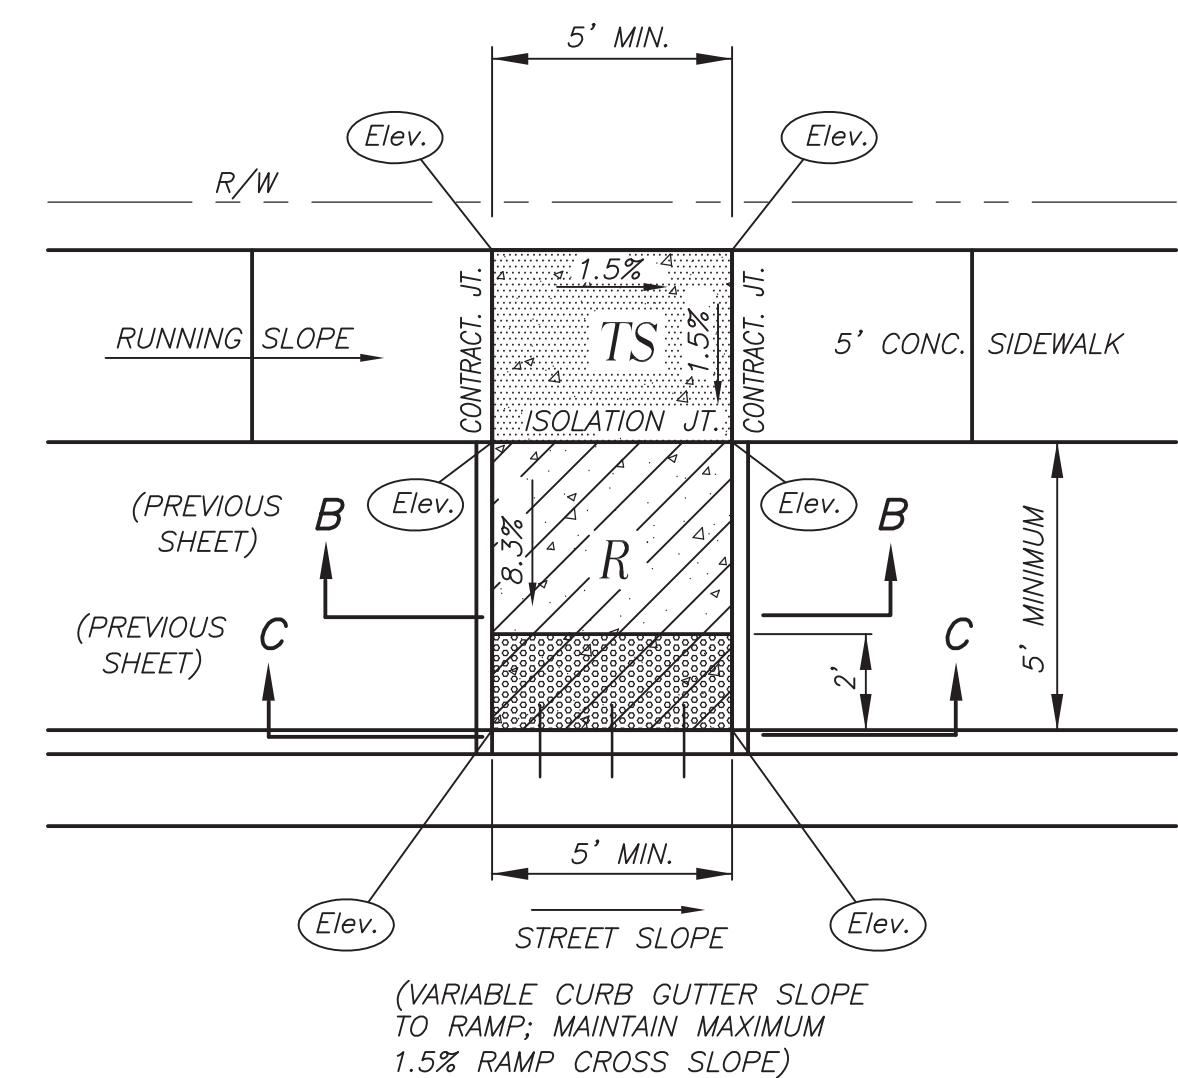

**MODIFIED MID-BLOCK
SIDEWALK RAMP**
NOT TO SCALE

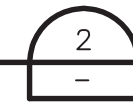



3741 NE TROON DR
LEE'S SUMMIT, MO 64064
816.347.1100

MO STATE CERTIFICATE OF
AUTHORITY #000856

PROJECT FOR

**LANDROCK
DEVELOPMENT, LLC**

**CREEKSIDE AT RAINTREE
LOTS 1 THRU 31
LEE'S SUMMIT, MISSOURI**

B	04/14/2017	CITY RESUBMITTAL
A	03/08/2017	CITY SUBMITTAL
MARK	DATE	DESCRIPTION

PROJECT NUMBER	10028825-276408
ORIGINAL ISSUE	MARCH 7, 2017

PROJECT MANAGER	SIMON SUN
PROJECT ENGINEER	WILL NEDS, E.I.T.



SHEET NAME

**TYPICAL ROAD
SECTIONS AND DETAILS**

SCALE | NO SCALE

SHEET NUMBER


01C-CR-11

FILE NAME | 01C-CR-11.dwg

PERMIT REVIEW DRAWINGS


GENERAL NOTES:

1. CONCRETE FOR CURB AND GUTTER AND ANY CONCRETE STREET PAVEMENT SHALL CONFORM TO KCMMB 4K MIX.
2. CONCRETE PAVEMENT JOINTS AND JOINT LOCATIONS SHALL BE PER APWA DETAILS AND AS MODIFIED BY CITY OF LEE'S SUMMIT SPECIFICATIONS.
3. GEOGRID MUST MEET SPECIFICATIONS OF LEE'S SUMMIT SECTION 2200, TABLE 2201.6-1. ALTERNATE GEOGRID MUST BE SUBMITTED TO CITY FOR REVIEW AND APPROVAL.
4. MATERIAL DEPTHS PROVIDED ARE CITY'S ABSOLUTE MINIMUM ACCEPTABLE DEPTHS.
5. ALL SIDEWALK SHOWN ALONG TRACTS SHALL BE CONSTRUCTED DURING PUBLIC INFRASTRUCTURE CONSTRUCTION.

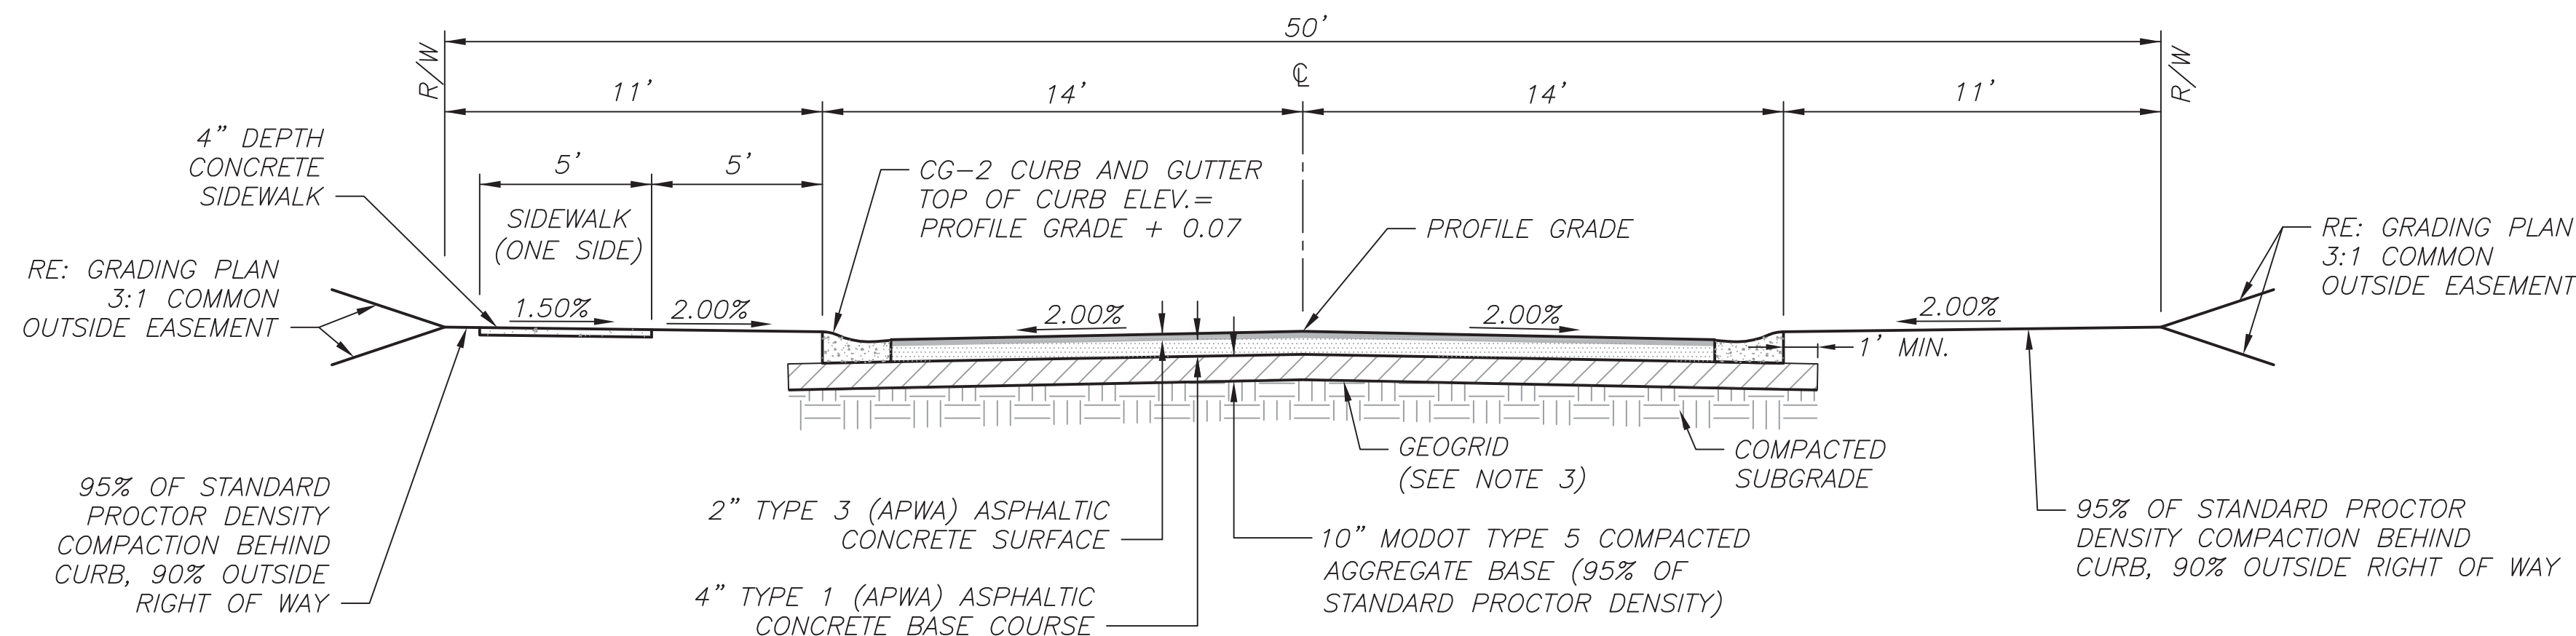


TYPICAL 28' ROADWAY SECTION

NOT TO SCALE

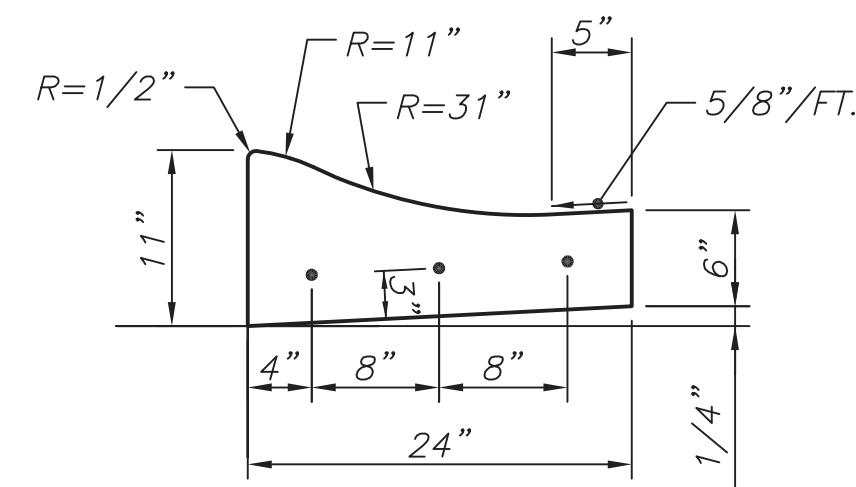

**TYPE CG-2
ROLL BACK CURB & GUTTER**

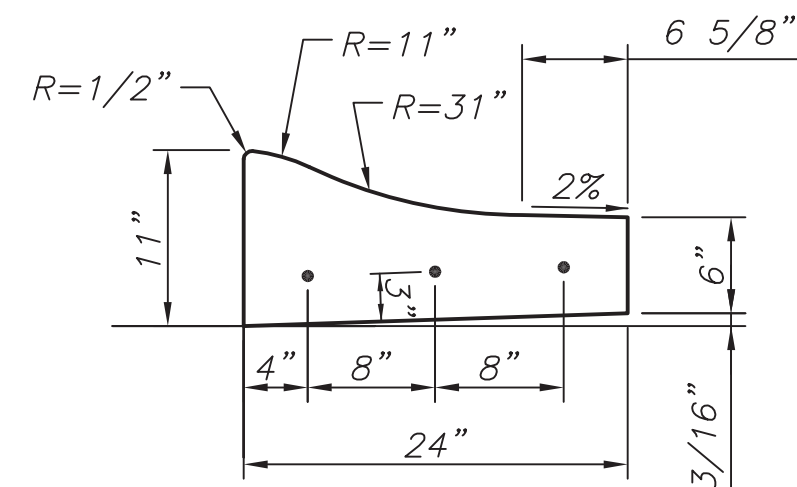


**MODIFIED TYPE CG-2 DRY
ROLL BACK DRY CURB & GUTTER**

GENERAL CURB NOTES:

1. 3/4" ISOLATION JOINTS WITH 5/8" DIA. x 2' SMOOTH DOWELS SHALL BE PLACED AT RADIUS POINTS AND AT 150' INTERVALS. THESE DOWEL BARS SHALL BE GREASED AND WRAPPED ON ONE END WITH EXPANSION TUBES.
2. 1" DEEP CONTRACTION JOINTS SHALL BE INSTALLED AT APPROXIMATELY 10' INTERVALS. THESE JOINTS SHALL PASS ACROSS THE ENTIRE CURB SECTION.
3. FIX DOWEL BARS WITH BAR SUPPORTS.
4. DEPTH OF CURB SHALL BE A MINIMUM OF 8" THROUGH THE HANICAP ACCESS RAMP.
5. CONCRETE SHALL CONFORM TO STANDARD SPECIFICATIONS SECTION 2208.2.B.

TYPICAL CURB & GUTTER DETAILS

NOT TO SCALE

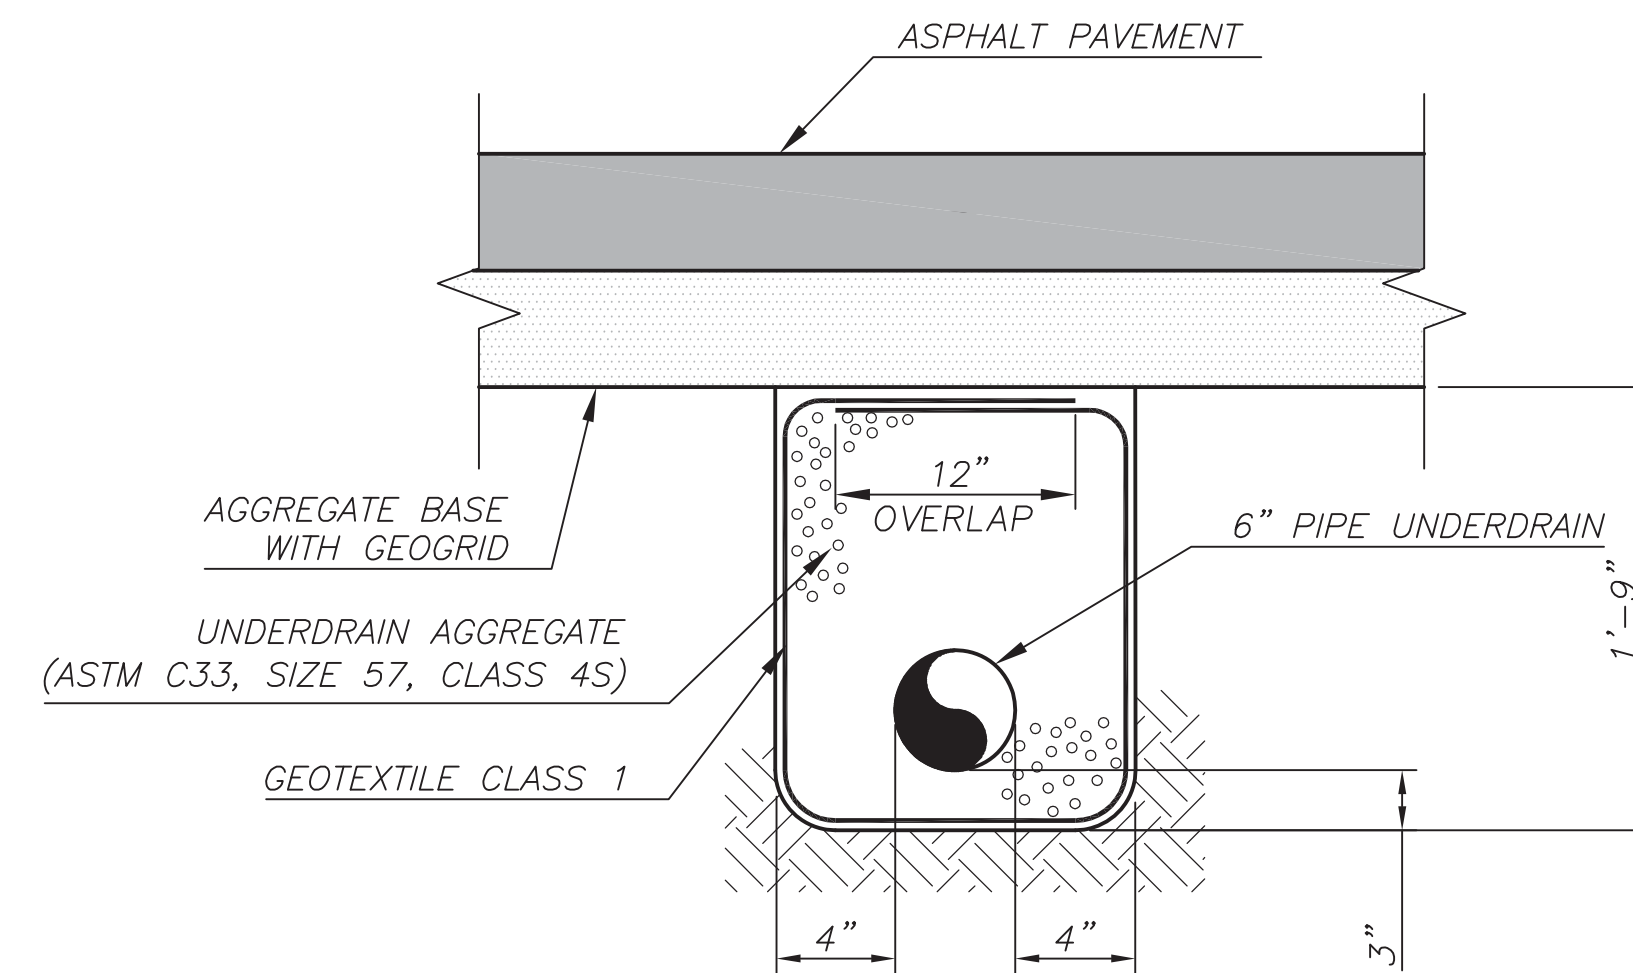

UNDERDRAIN NOTES:

1. WHERE PIPE UNDERDRAINS ARE USED, ALL UNDERDRAIN OUTLET PIPES SHALL BE SOLID WALL WITH WATERTIGHT JOINTS. ALL OUTLET PIPES SHALL BE TIED INTO THE NEAREST STORM SEWER INLETS AT ROADWAY SAG LOCATIONS AS INDICATED IN THE STREET PROFILE.
2. ALL UNDERDRAIN PIPES SHALL BE INSTALLED AT A MINIMUM SLOPE OF 1%. UNDERDRAIN PIPE SHALL BE INSTALLED WITH THE PERFORATIONS PLACED DOWN.
3. BLANKET UNDERDRAIN AGGREGATE, PIPE UNDERDRAIN AGGREGATE, PIPE UNDERDRAIN, EDGE UNDERDRAIN AND OUTLET PIPE SHALL CONFORM CITY OF LEE'S SUMMIT SPECIFICATIONS.

PIPE UNDERDRAIN LATERAL

NOT TO SCALE



3741 NE TROON DR
LEE'S SUMMIT, MO 64064
816.347.1100

MO STATE CERTIFICATE OF
AUTHORITY #000856

PROJECT FOR

**LANDROCK
DEVELOPMENT, LLC**


**CREEKSIDE AT RAINTREE
LOTS 1 THRU 31
LEE'S SUMMIT, MISSOURI**

ADA RAMP NOTES:


- 1. REFER TO SHEET 01C-CR-09 AND 01C-CR-10 FOR TYPICAL ADA RAMP NOTES AND DETAILS.




POINT TABLE	
POINT NO.	ELEVATION
100	965.83
101	965.86
102	965.87
103	965.88
104	965.95
105	965.96

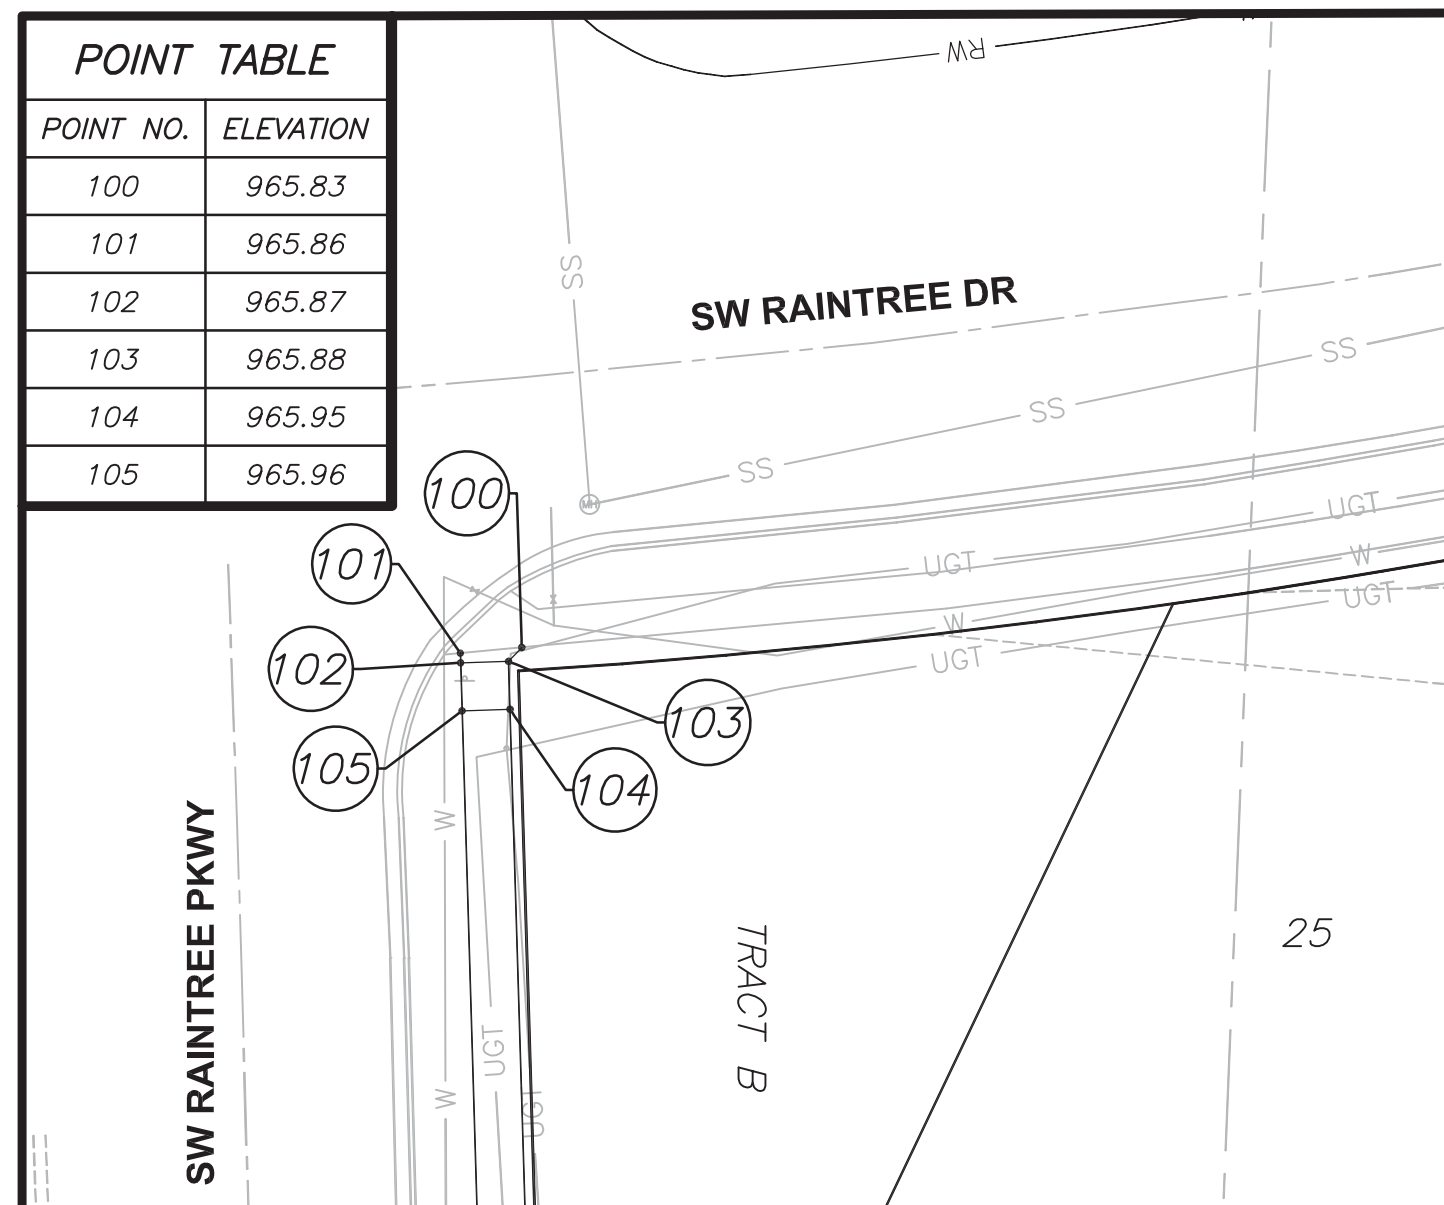


POINT TABLE	
POINT NO.	ELEVATION
126	956.26
127	956.14
128	956.24
129	956.31
130	956.38
131	956.31

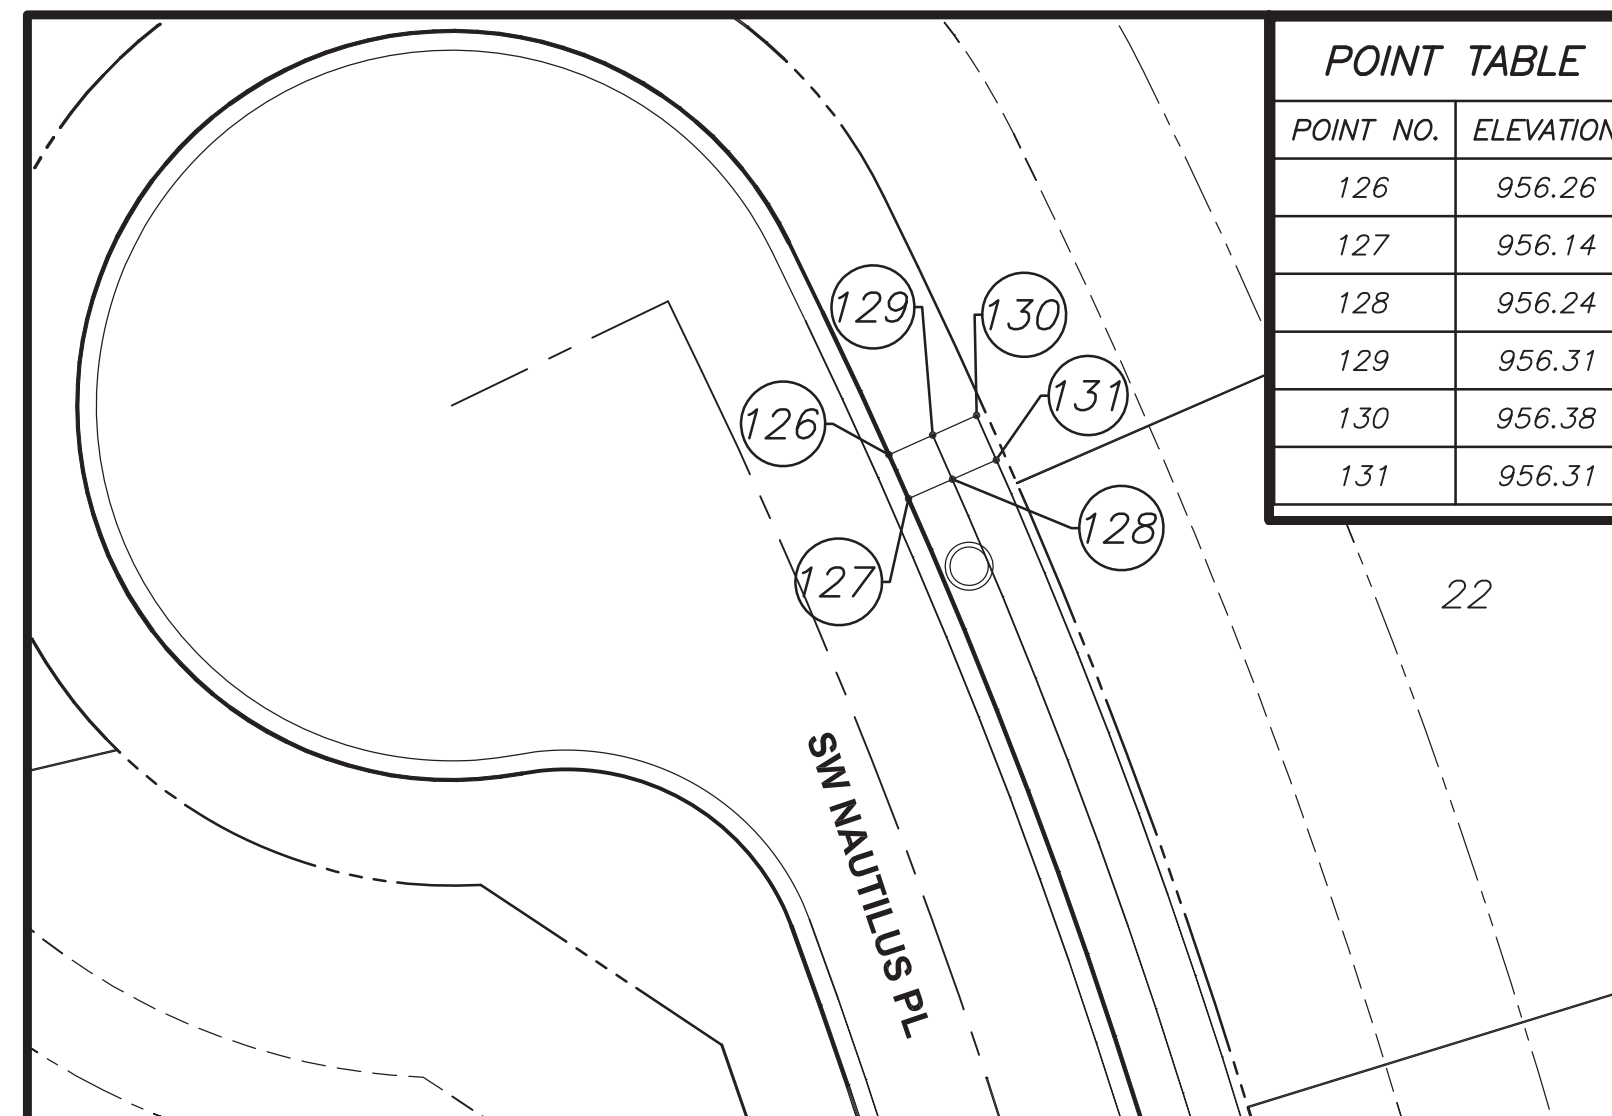


POINT TABLE	
POINT NO.	ELEVATION
106	968.94
107	968.92
108	968.75
109	968.77
110	968.58
111	968.53
112	968.62
113	968.56
114	968.66
115	968.73
116	968.63
117	968.67
118	968.67
119	968.80
120	968.80
121	966.81
122	966.73
123	966.64
124	966.72
125	966.50

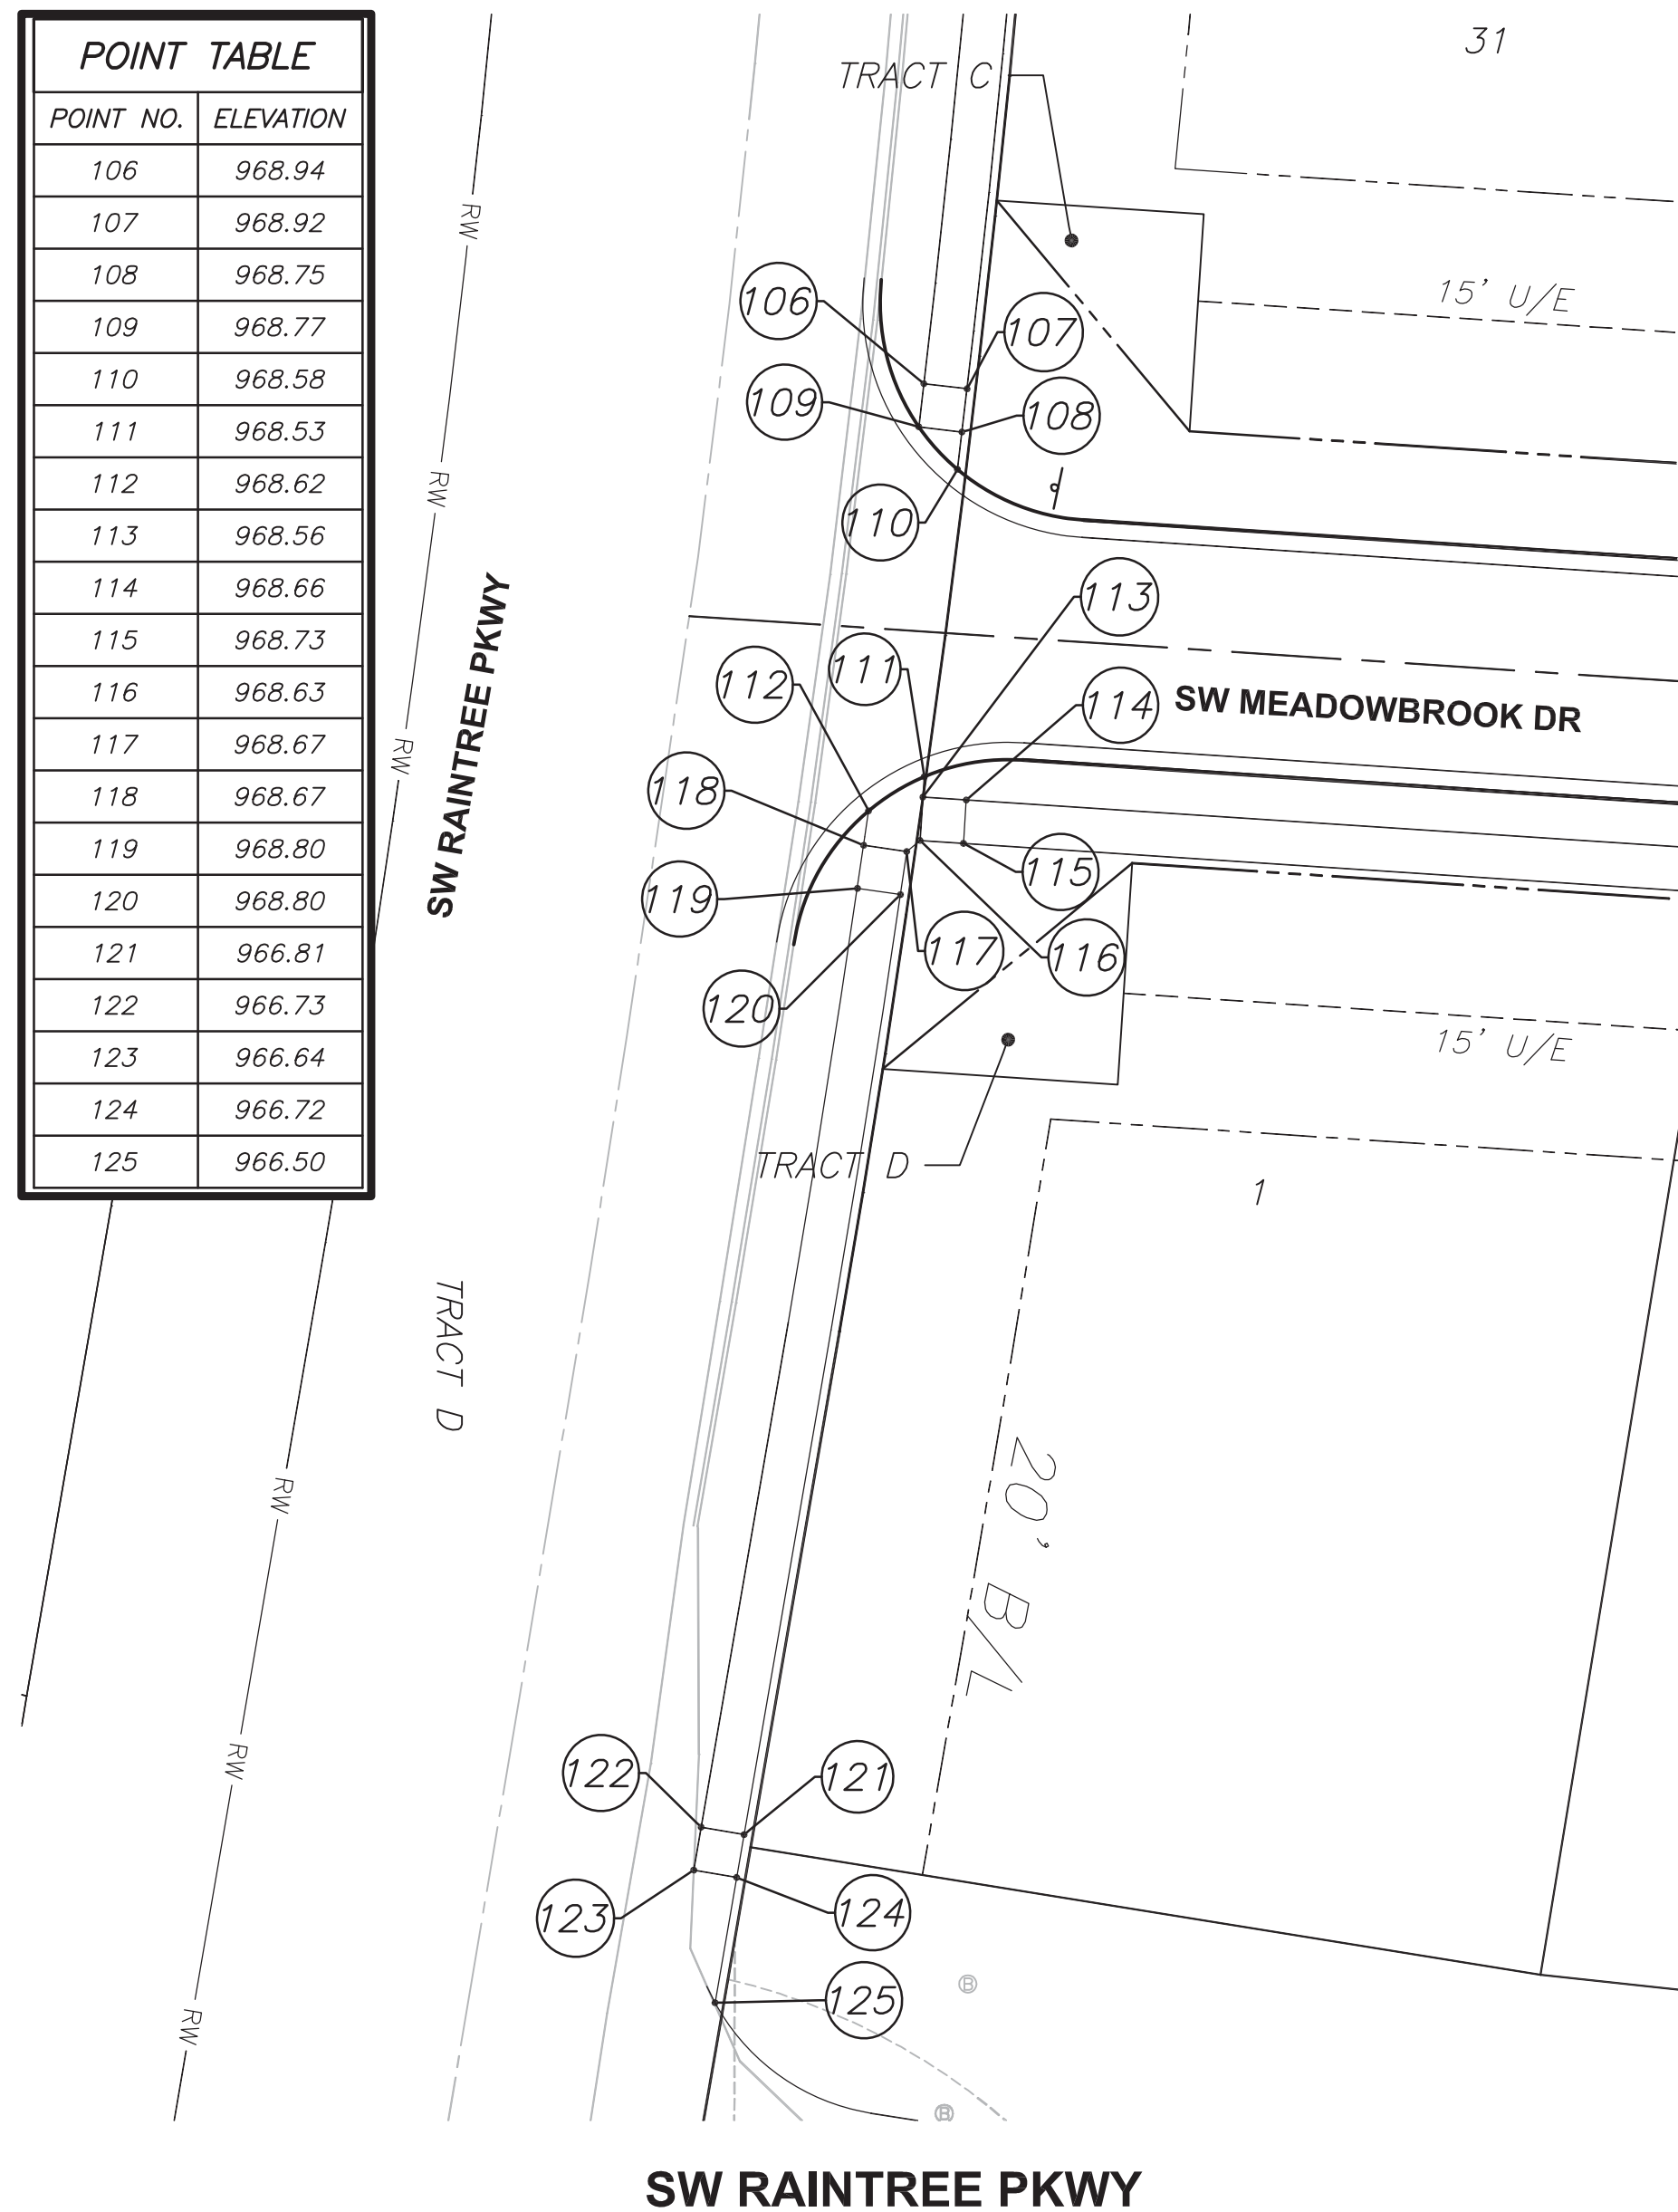

POINT TABLE	
POINT NO.	ELEVATION
132	957.83
133	957.76
134	957.56
135	957.63
136	957.39
137	957.42
138	957.35
139	957.51
140	957.58
141	957.62
142	957.58

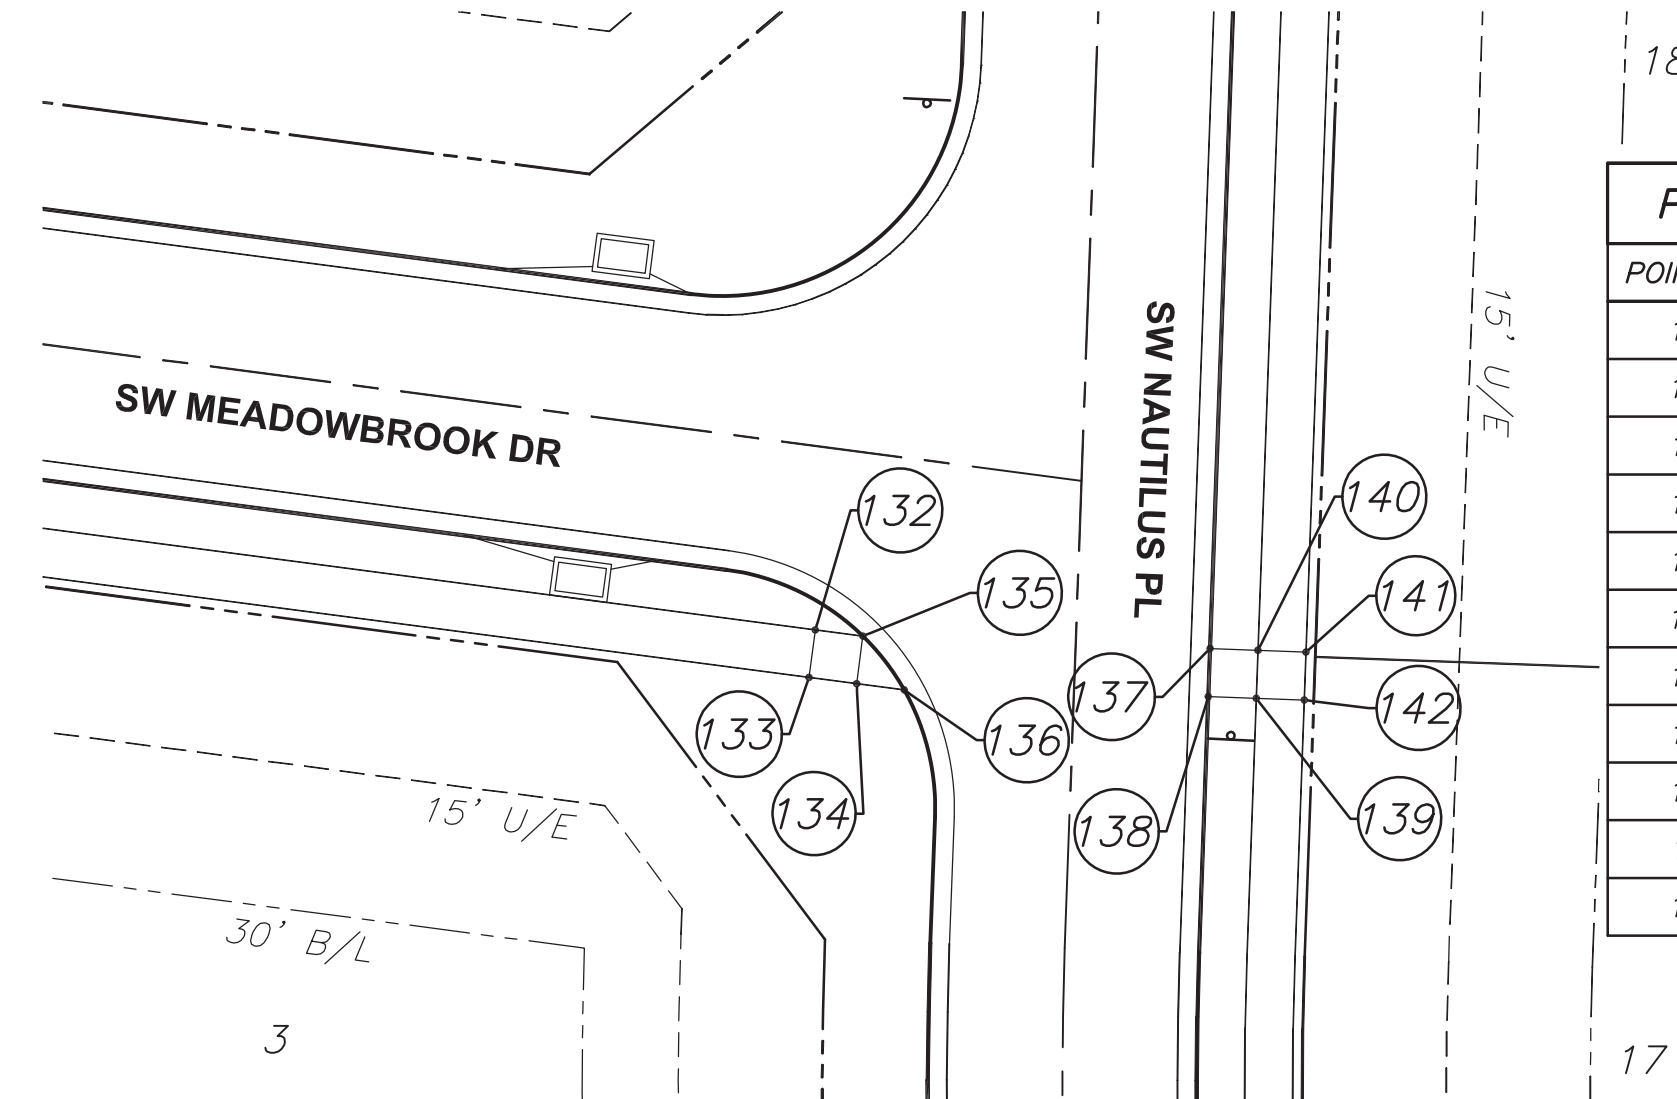

POINT TABLE	
POINT NO.	ELEVATION
143	952.71
144	952.66
145	952.42
146	952.47
147	952.24

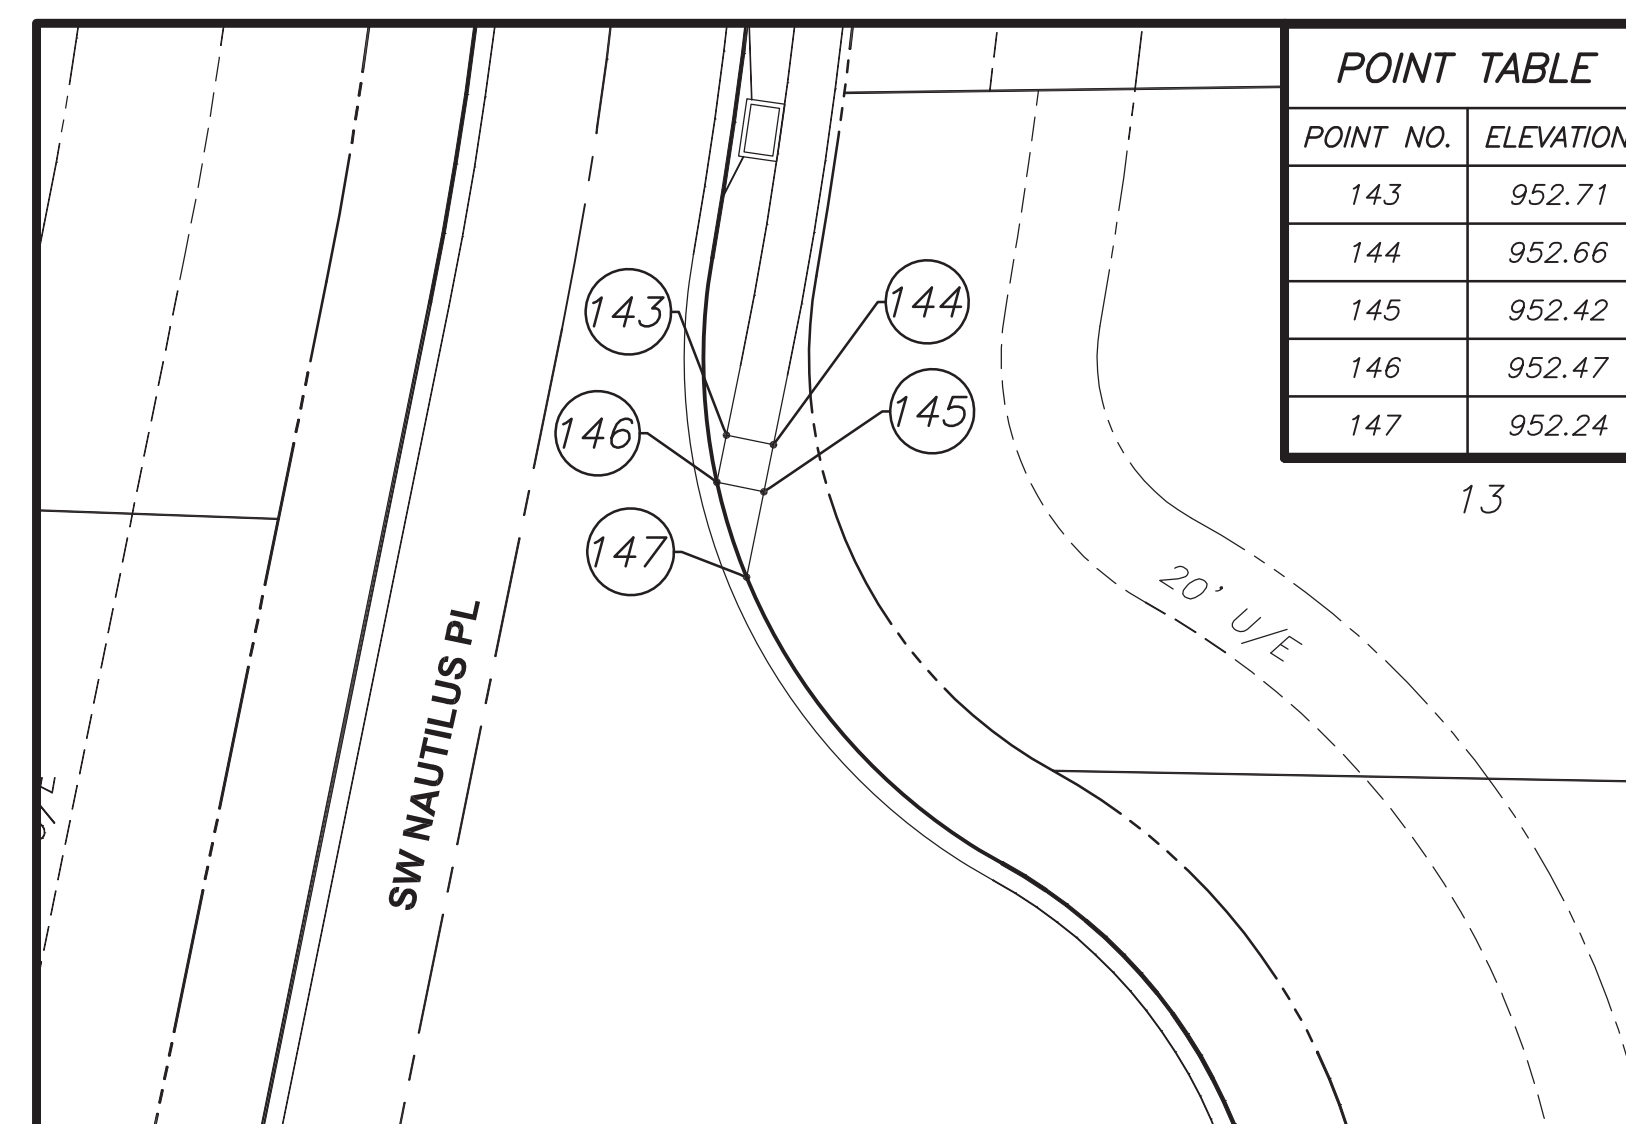


MARK	DATE	DESCRIPTION
B	04/18/2017	CITY RESUBMITTAL
A	03/08/2017	CITY SUBMITTAL

PROJECT NUMBER	10028825-276408
ORIGINAL ISSUE	MARCH 7, 2017
PROJECT MANAGER	SIMON SUN
PROJECT ENGINEER	WILL NEDS, E.I.T.



SHEET NAME

**ADA RAMP
ELEVATIONS**

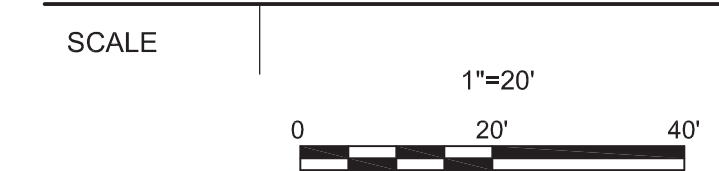

SHEET NUMBER

01C-CR-14

FILE NAME | 01C-CR-14.dwg

PERMIT REVIEW DRAWINGS



3741 NE TROON DR
LEE'S SUMMIT, MO 64064
816.347.1100

MO STATE CERTIFICATE OF
AUTHORITY #000856

PROJECT FOR

**LANDROCK
DEVELOPMENT, LLC**

**CREEKSIDE AT RAIN TREE
LOTS 1 THRU 31
LEE'S SUMMIT, MISSOURI**

MARK	DATE	DESCRIPTION
C	10/29/2018	AS-BUILT
B	05/01/2017	CITY RESUBMITTAL
A	03/08/2017	CITY SUBMITTAL

PROJECT NUMBER	10028825-276408
ORIGINAL ISSUE	MARCH 7, 2017

PROJECT MANAGER	SIMON SUN
PROJECT ENGINEER	WILL NEDS, E.I.T.




STORM PIPE AND STRUCTURE MATERIAL NOTES:

1. HDPE PIPE SHALL CONFORM TO AASHTO M294, TYPE S.
2. CONCRETE PIPE OR ALUMINIZED CORRUGATED METAL PIPE MAY BE USED IN LIEU OF HDPE PIPE. MANNING'S N VALUE SHALL BE EQUAL TO OR LESS THAN 0.013. CONCRETE PIPE SHALL CONFORM TO ASTM C76, CLASS III, WALL TYPE B. ALUMINIZED (TYPE 2) CORRUGATED METAL PIPE SHALL CONFORM TO AASHTO M274. PIPE GAUGE SHALL BE 14 FOR 30" DIAMETER AND SMALLER PIPES.
3. PROPOSED CURB INLETS SHALL CONFORM TO APWA TYPE 2 (CI-2), MANHOLES SHALL CONFORM TO APWA TYPE MH-1, JUNCTION BOXES SHALL CONFORM TO APWA TYPE JB-1.

GENERAL NOTES:

1. COORDINATES AND TOP ELEVATIONS SHOWN ARE LOCATED AT CENTER OF STRUCTURES. ROAD OFFSETS ARE AT INSIDE FACE OF CURB INLETS, AND AT CENTER OF MANHOLES AND JUNCTION BOXES.
2. PIPE LENGTHS INDICATED ARE FROM CENTER OF STRUCTURE TO CENTER OF STRUCTURE.
3. INSIDE FRONT FACE OF CURB INLETS SHALL BE LOCATED 1.5 FEET BEHIND BACK OF CURB. STRUCTURE SHALL BE PARALLEL WITH CURB ALIGNMENT.
4. WATER MAINS AND STORM SEWERS SHALL HAVE AT LEAST 10' OF CLEAR HORIZONTAL SEPARATION.

STORM SEWER STRUCTURE TABLE		
STRUCTURE	STATION & OFFSET	STREET NAME
FES 1-10A	11+68.80, 150.96' LT	SW NAUTILUS PL
MH 1-10B	11+67.23, 111.00' LT	SW NAUTILUS PL
CI 1-10C	11+62.89, 15.50' LT	SW NAUTILUS PL
MH 1-10D	10+27.92, 17.11' LT	SW NAUTILUS PL
MH 1-10E	9+21.83, 108.79' RT	SW NAUTILUS PL
MH 1-10F	9+01.27, 156.88' RT	SW NAUTILUS PL
CI 1-11A	11+62.89, 15.50' RT	SW NAUTILUS PL
MH 1-11B	12+99.34, 19.50' RT	SW NAUTILUS PL
CI 1-11C	12+57.14, 15.50' LT	SW MEADOWBROOK DR
CI 1-11D	12+57.14, 15.50' RT	SW MEADOWBROOK DR

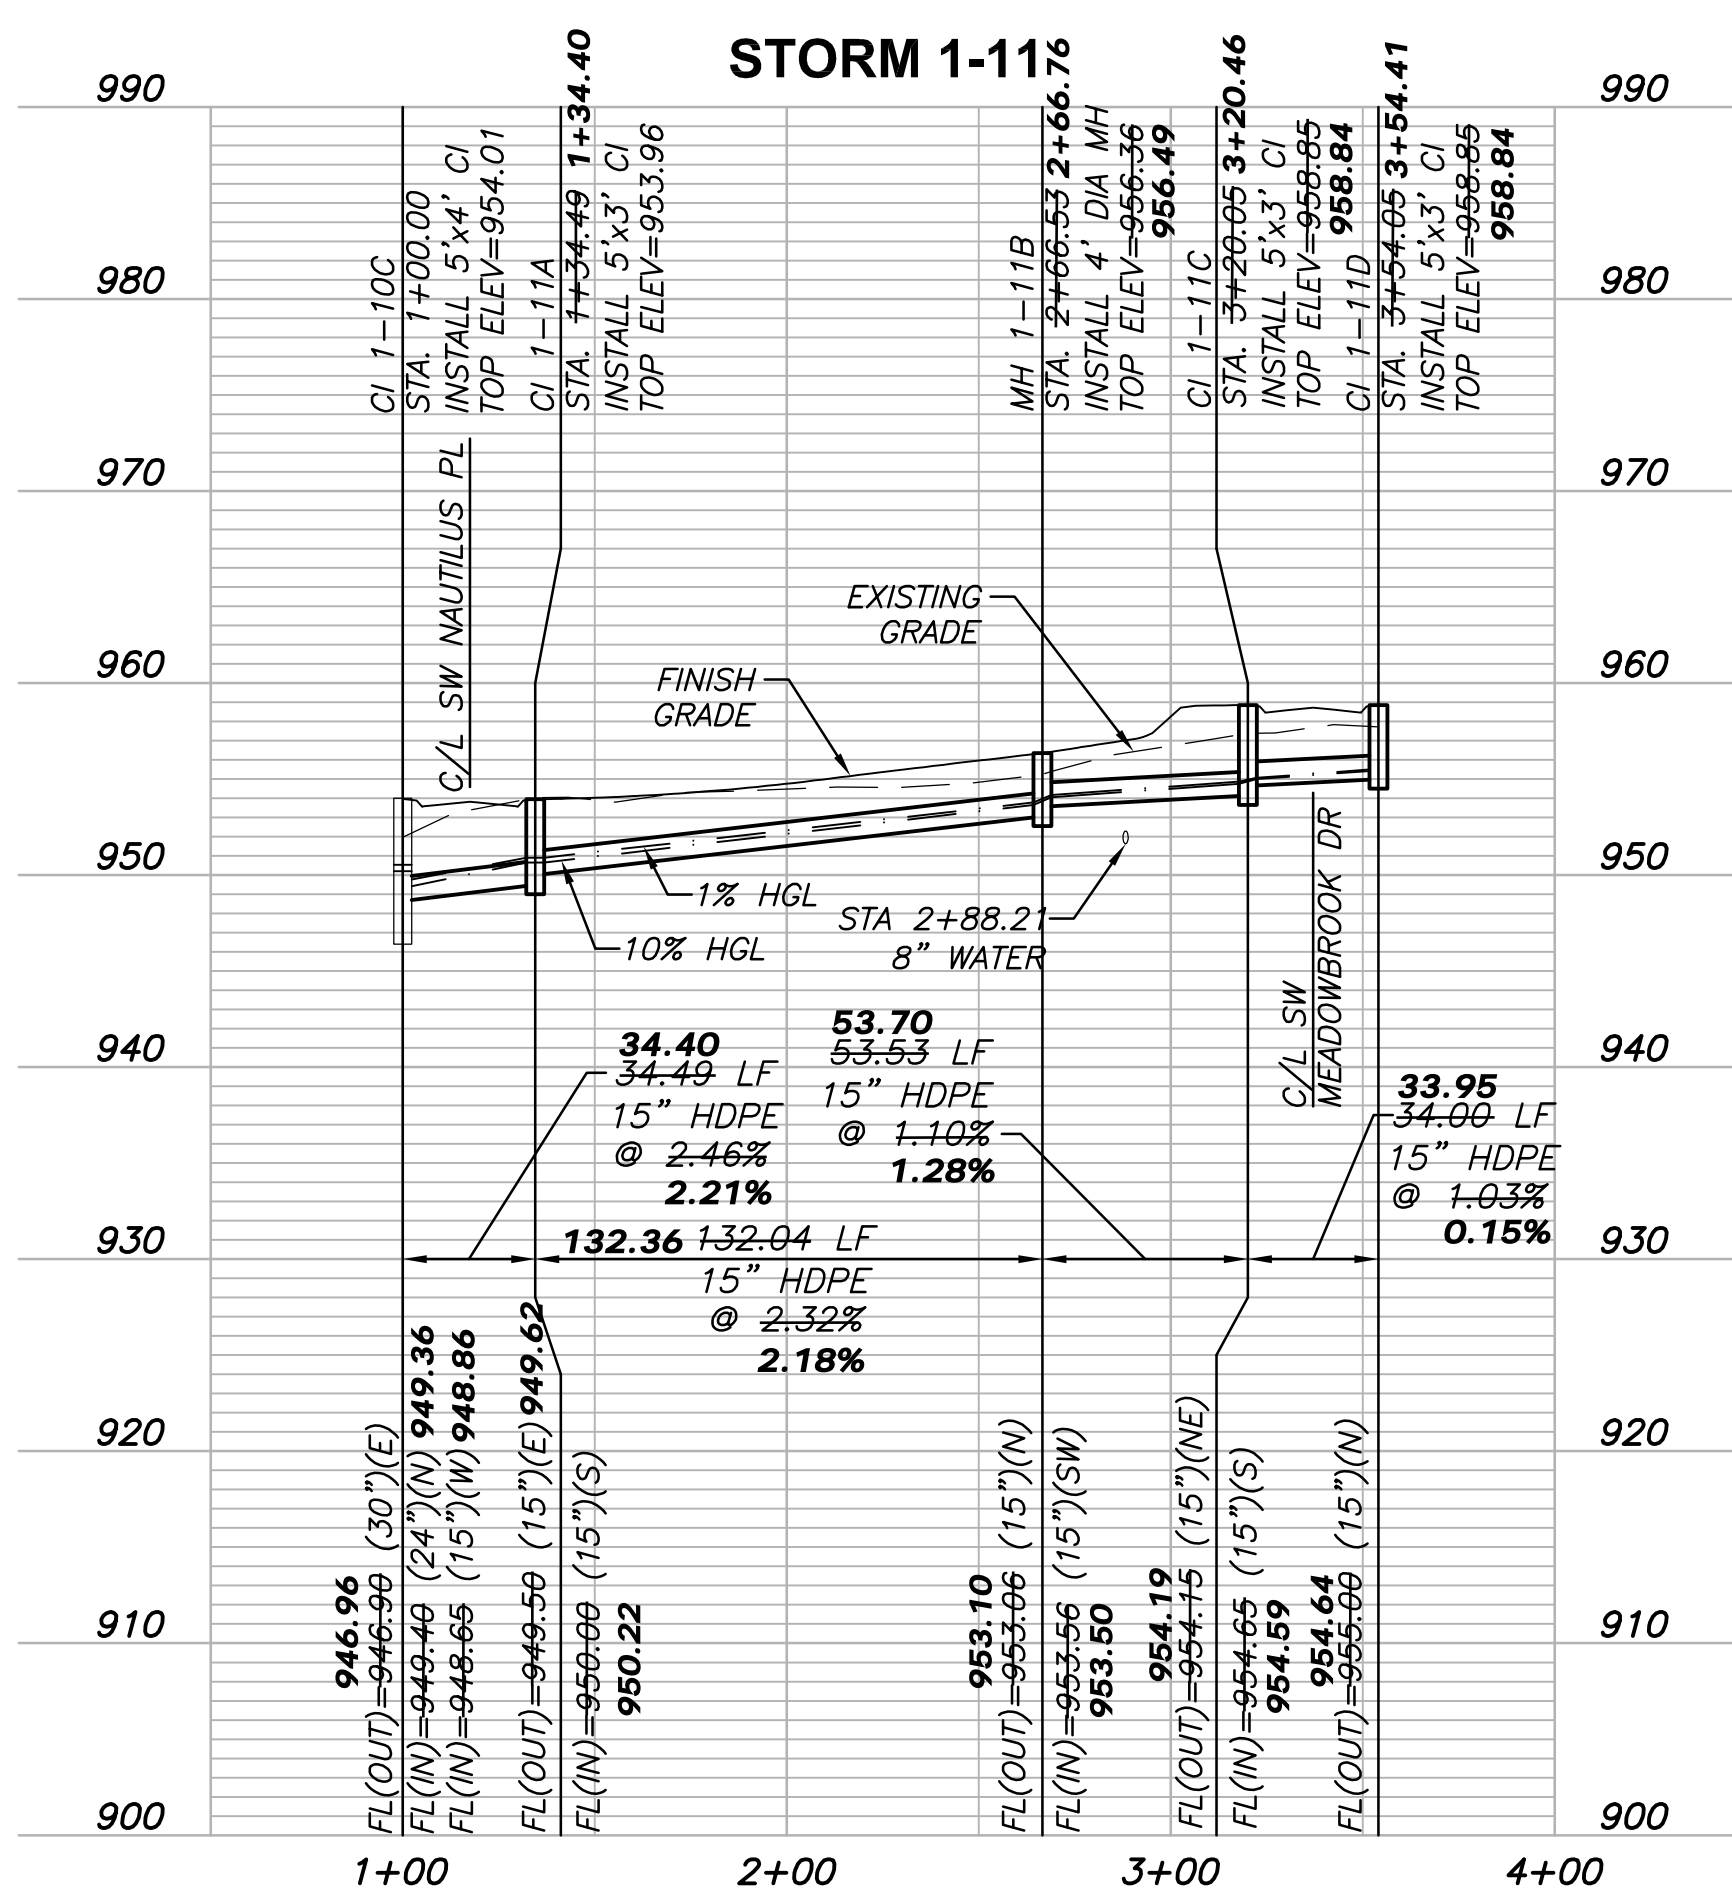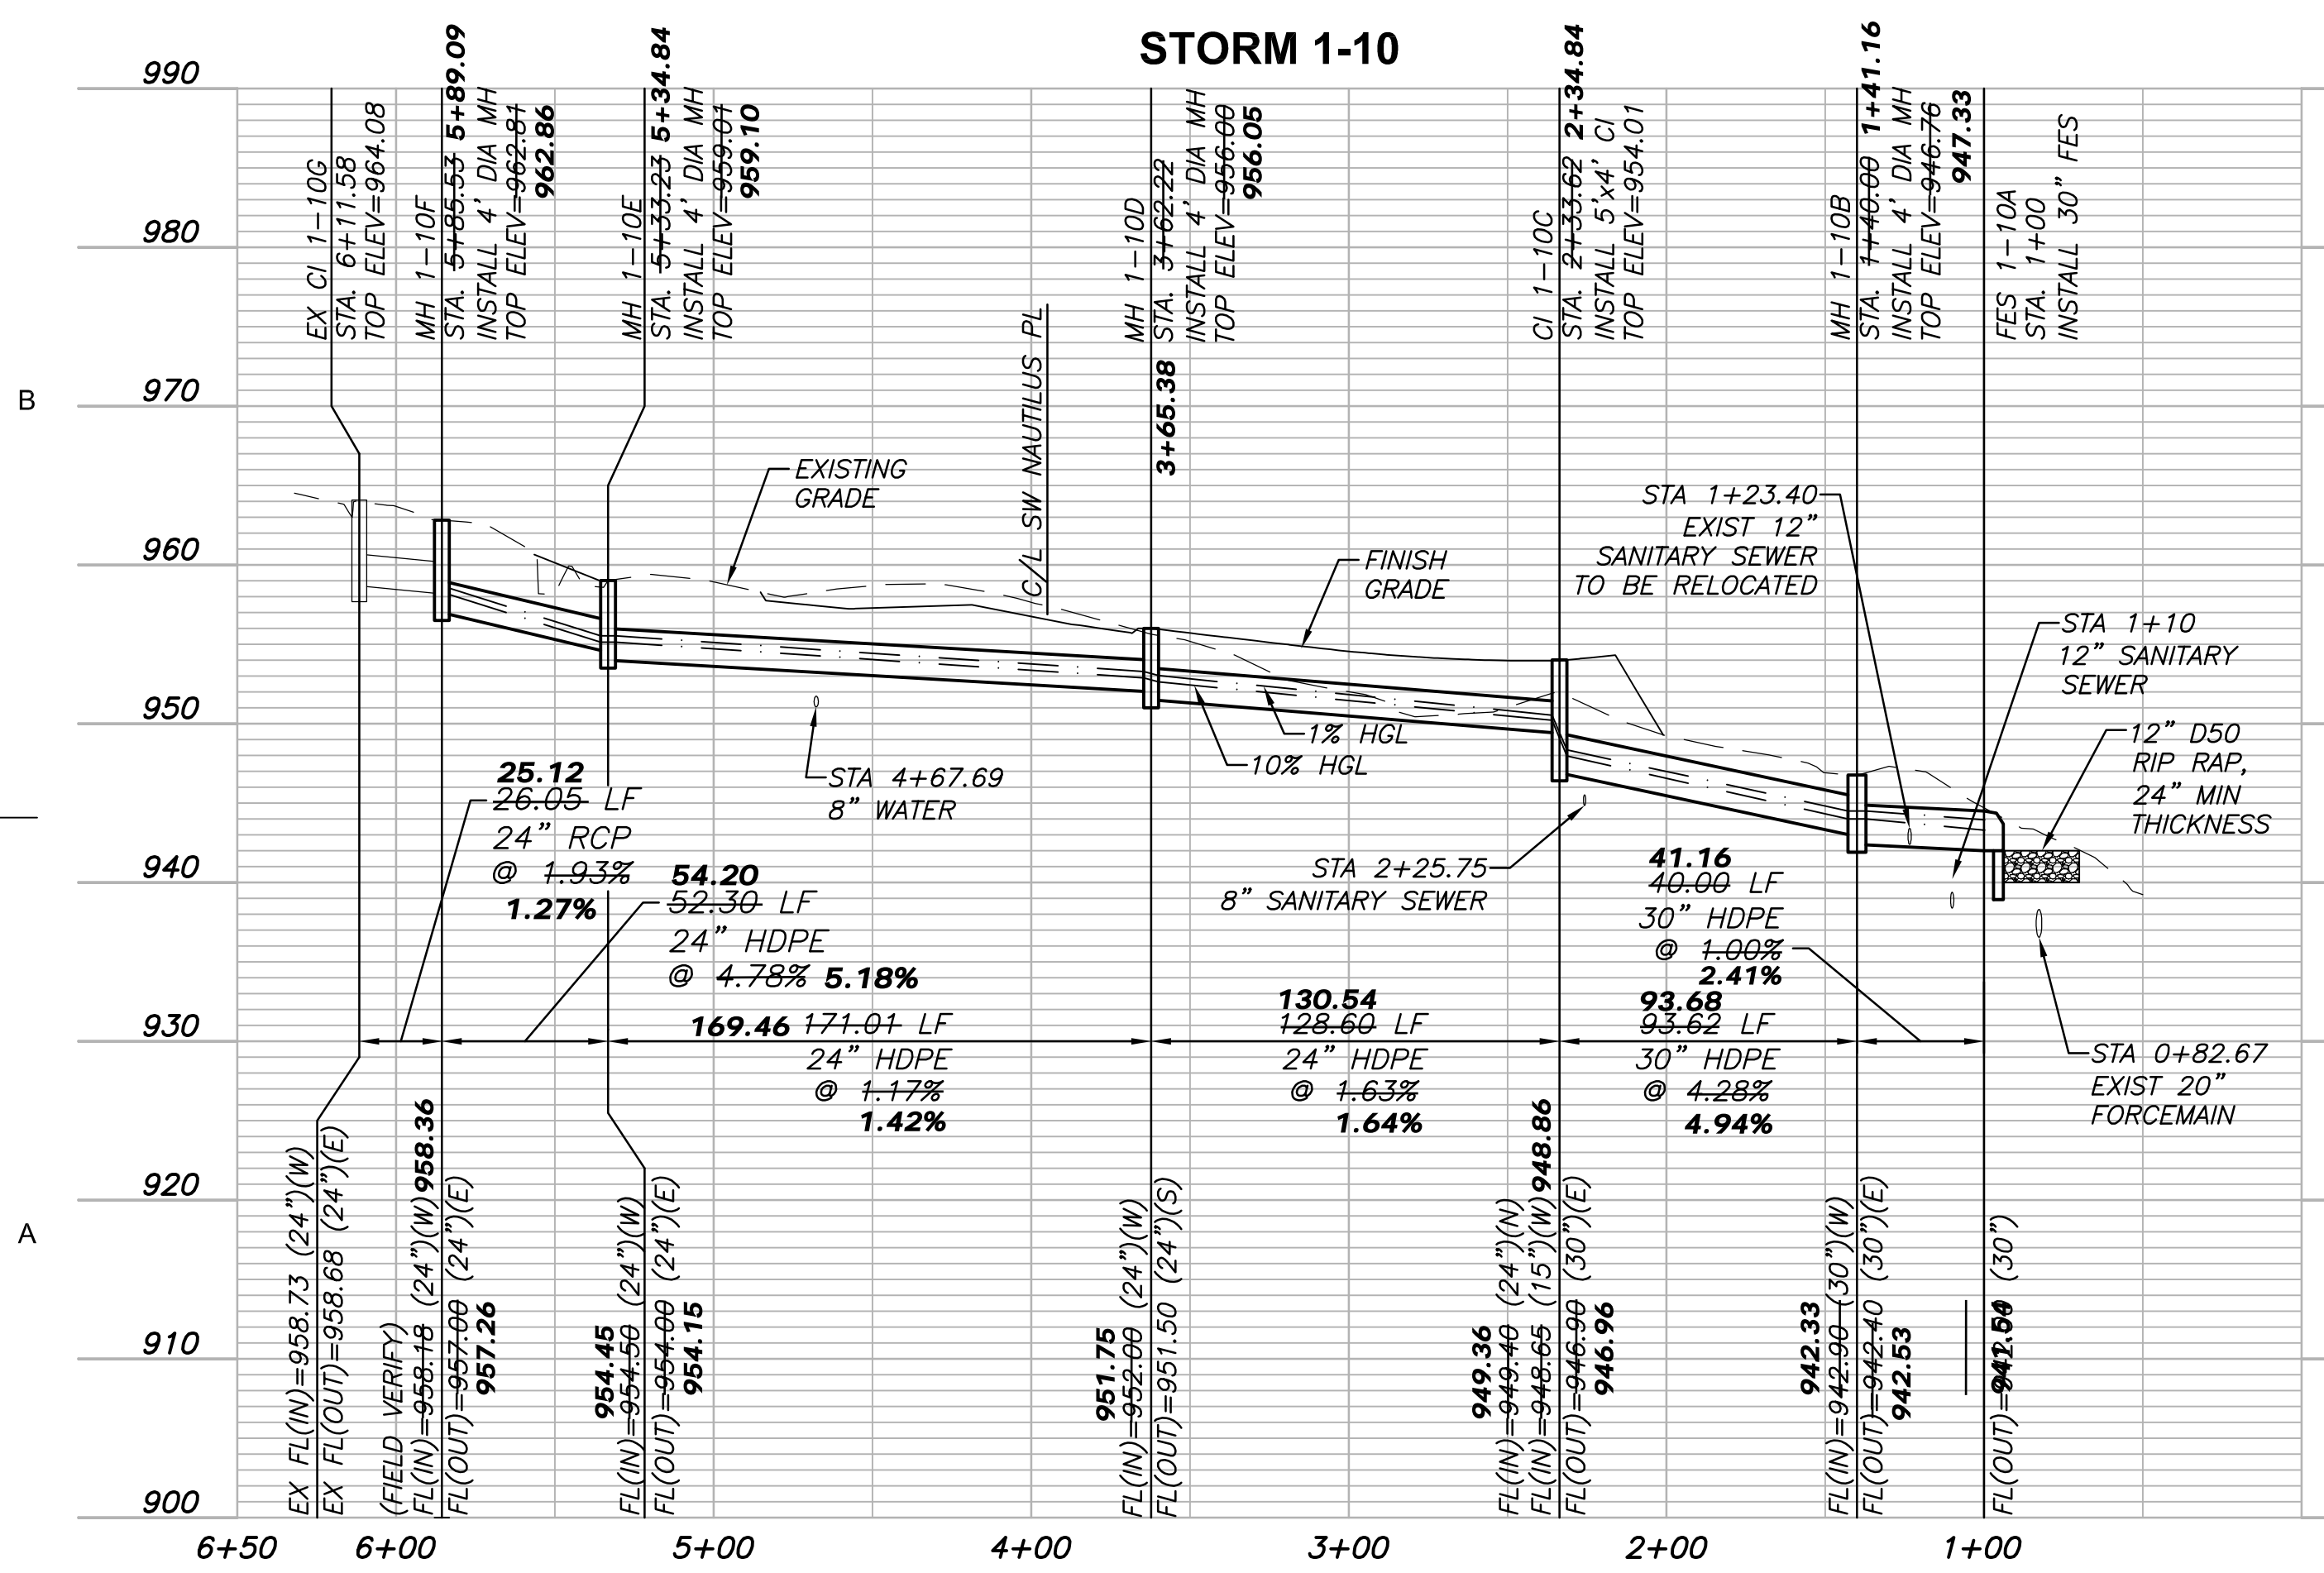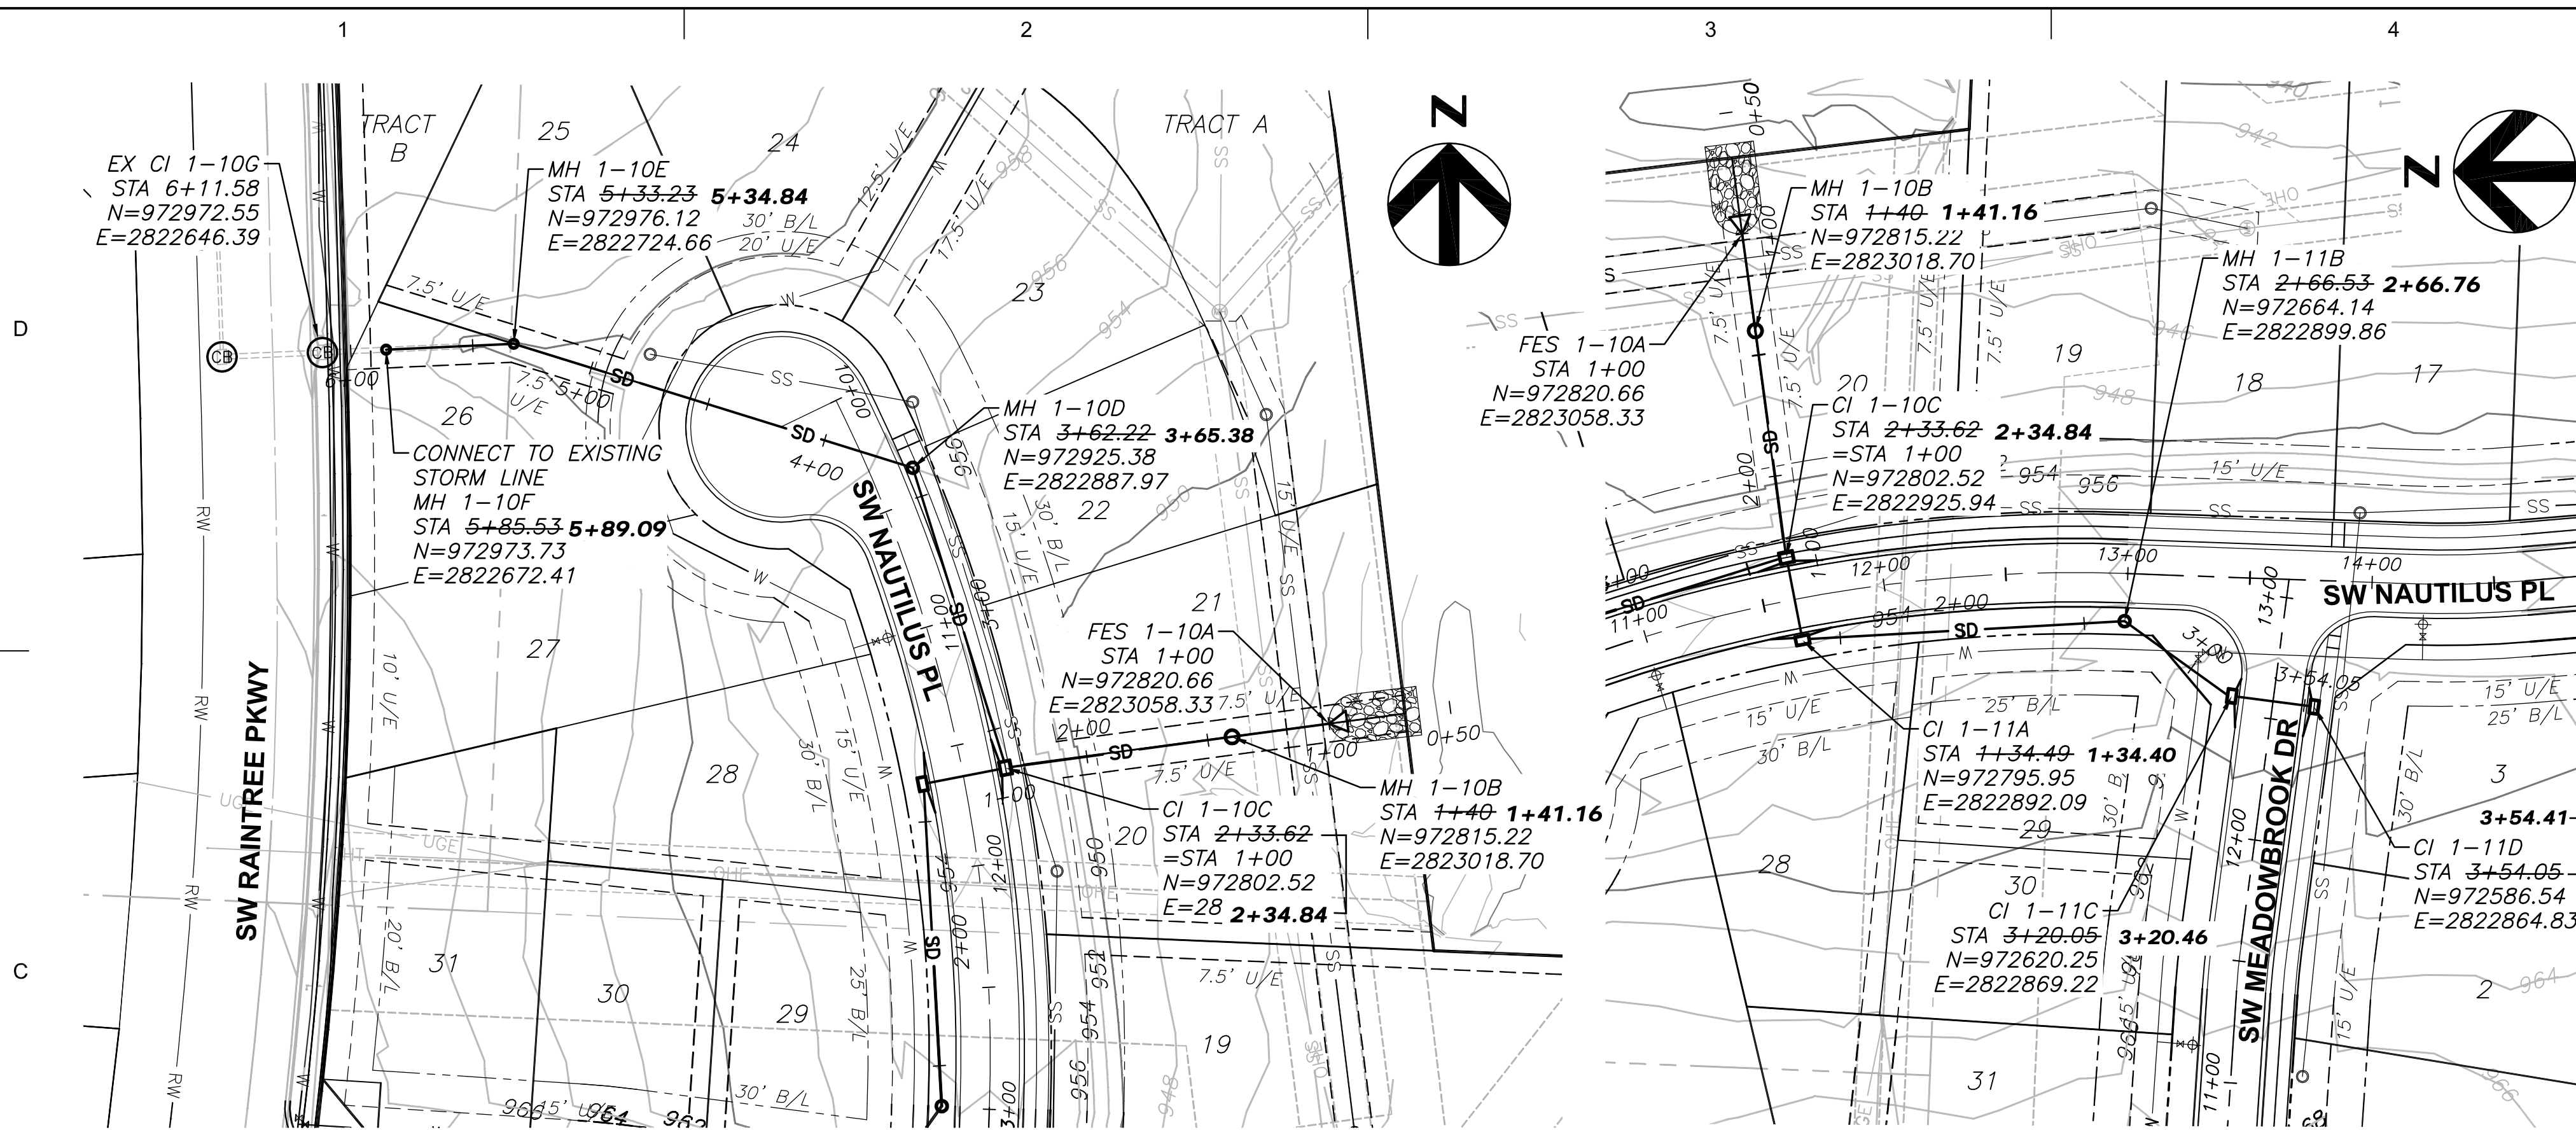


"AS-BUILT"
October 29, 2018

SHEET NAME

**STORM SEWER
PLAN AND PROFILE
LINES 1-10 AND 1-11**

SCALE

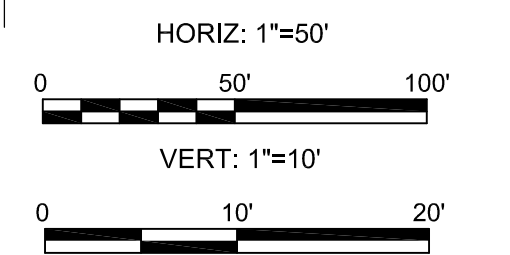

SHEET NUMBER


01C-CR-16

FILE NAME | 01C-CR-17.dwg

PERMIT REVIEW DRAWINGS

C:\working\m0212531101\01C-CR-17.dwg, 01C-CR-17, 10/29/2018 10:54:37 AM, WNEES

1
2
3
4
5

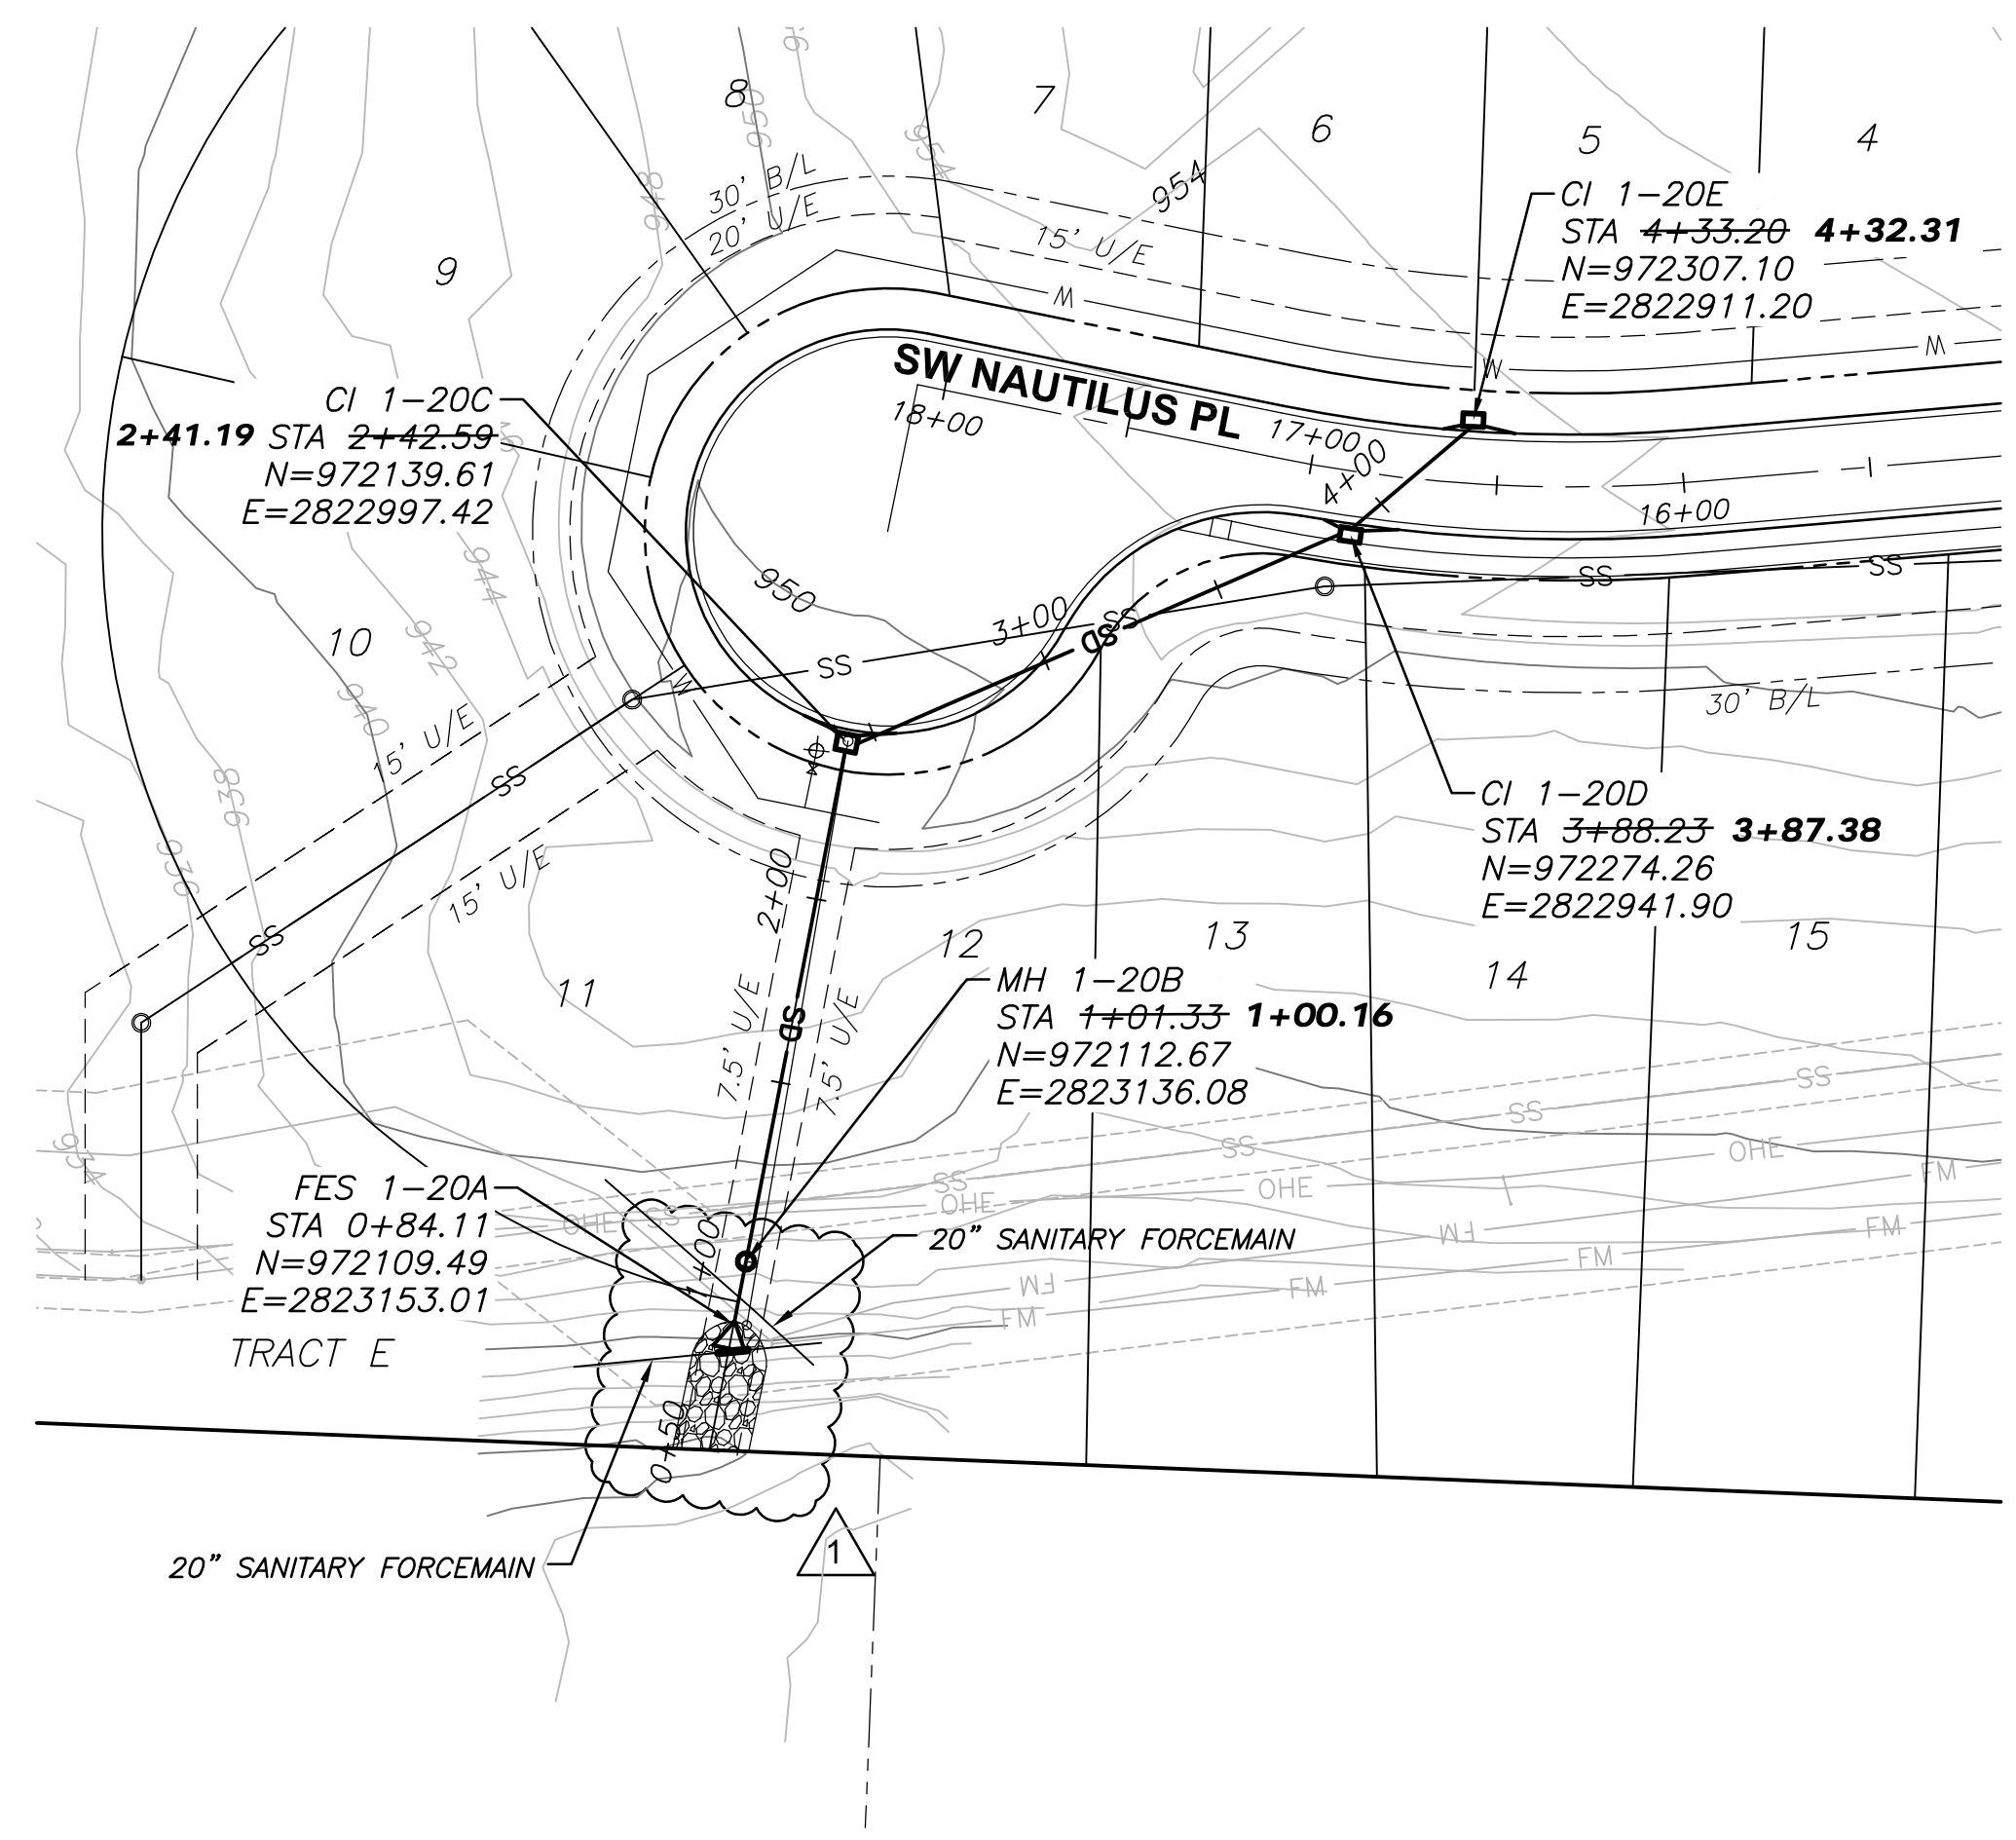


STORM PIPE AND STRUCTURE MATERIAL NOTES:

1. HDPE PIPE SHALL CONFORM TO AASHTO M294, TYPE S.
2. CONCRETE PIPE OR ALUMINIZED CORRUGATED METAL PIPE MAY BE USED IN LIEU OF HDPE PIPE. MANNING'S N VALUE SHALL BE EQUAL TO OR LESS THAN 0.013. CONCRETE PIPE SHALL CONFORM TO ASTM C76, CLASS III, WALL TYPE B. ALUMINIZED (TYPE 2) CORRUGATED METAL PIPE SHALL CONFORM TO AASHTO M274. PIPE GAUGE SHALL BE 14 FOR 30" DIAMETER AND SMALLER PIPES.
3. PROPOSED CURB INLETS SHALL CONFORM TO APWA TYPE 2 (CI-2), MANHOLES SHALL CONFORM TO APWA TYPE MH-1, JUNCTION BOXES SHALL CONFORM TO APWA TYPE JB-1.

GENERAL NOTES:

1. COORDINATES AND TOP ELEVATIONS SHOWN ARE LOCATED AT CENTER OF STRUCTURES. ROAD OFFSETS ARE AT INSIDE FACE OF CURB INLETS, AND AT CENTER OF MANHOLES AND JUNCTION BOXES.
2. PIPE LENGTHS INDICATED ARE FROM CENTER OF STRUCTURE TO CENTER OF STRUCTURE.
3. INSIDE FRONT FACE OF CURB INLETS SHALL BE LOCATED 1.5 FEET BEHIND BACK OF CURB. STRUCTURE SHALL BE PARALLEL WITH CURB ALIGNMENT.
4. WATER MAINS AND STORM SEWERS SHALL HAVE AT LEAST 10' OF CLEAR HORIZONTAL SEPARATION.

STORM SEWER STRUCTURE TABLE		
STRUCTURE	STATION & OFFSET	STREET NAME
FES 1-20A	18+05.50, 254.94' LT	SW NAUTILUS PL
MH 1-20B	18+05.64, 238.75' LT	SW NAUTILUS PL
CI 1-20C	18+06.86, 97.50' LT	SW NAUTILUS PL
CI 1-20D	16+86.95, 15.50' LT	SW NAUTILUS PL
CI 1-20E	16+60.98, 15.50' RT	SW NAUTILUS PL

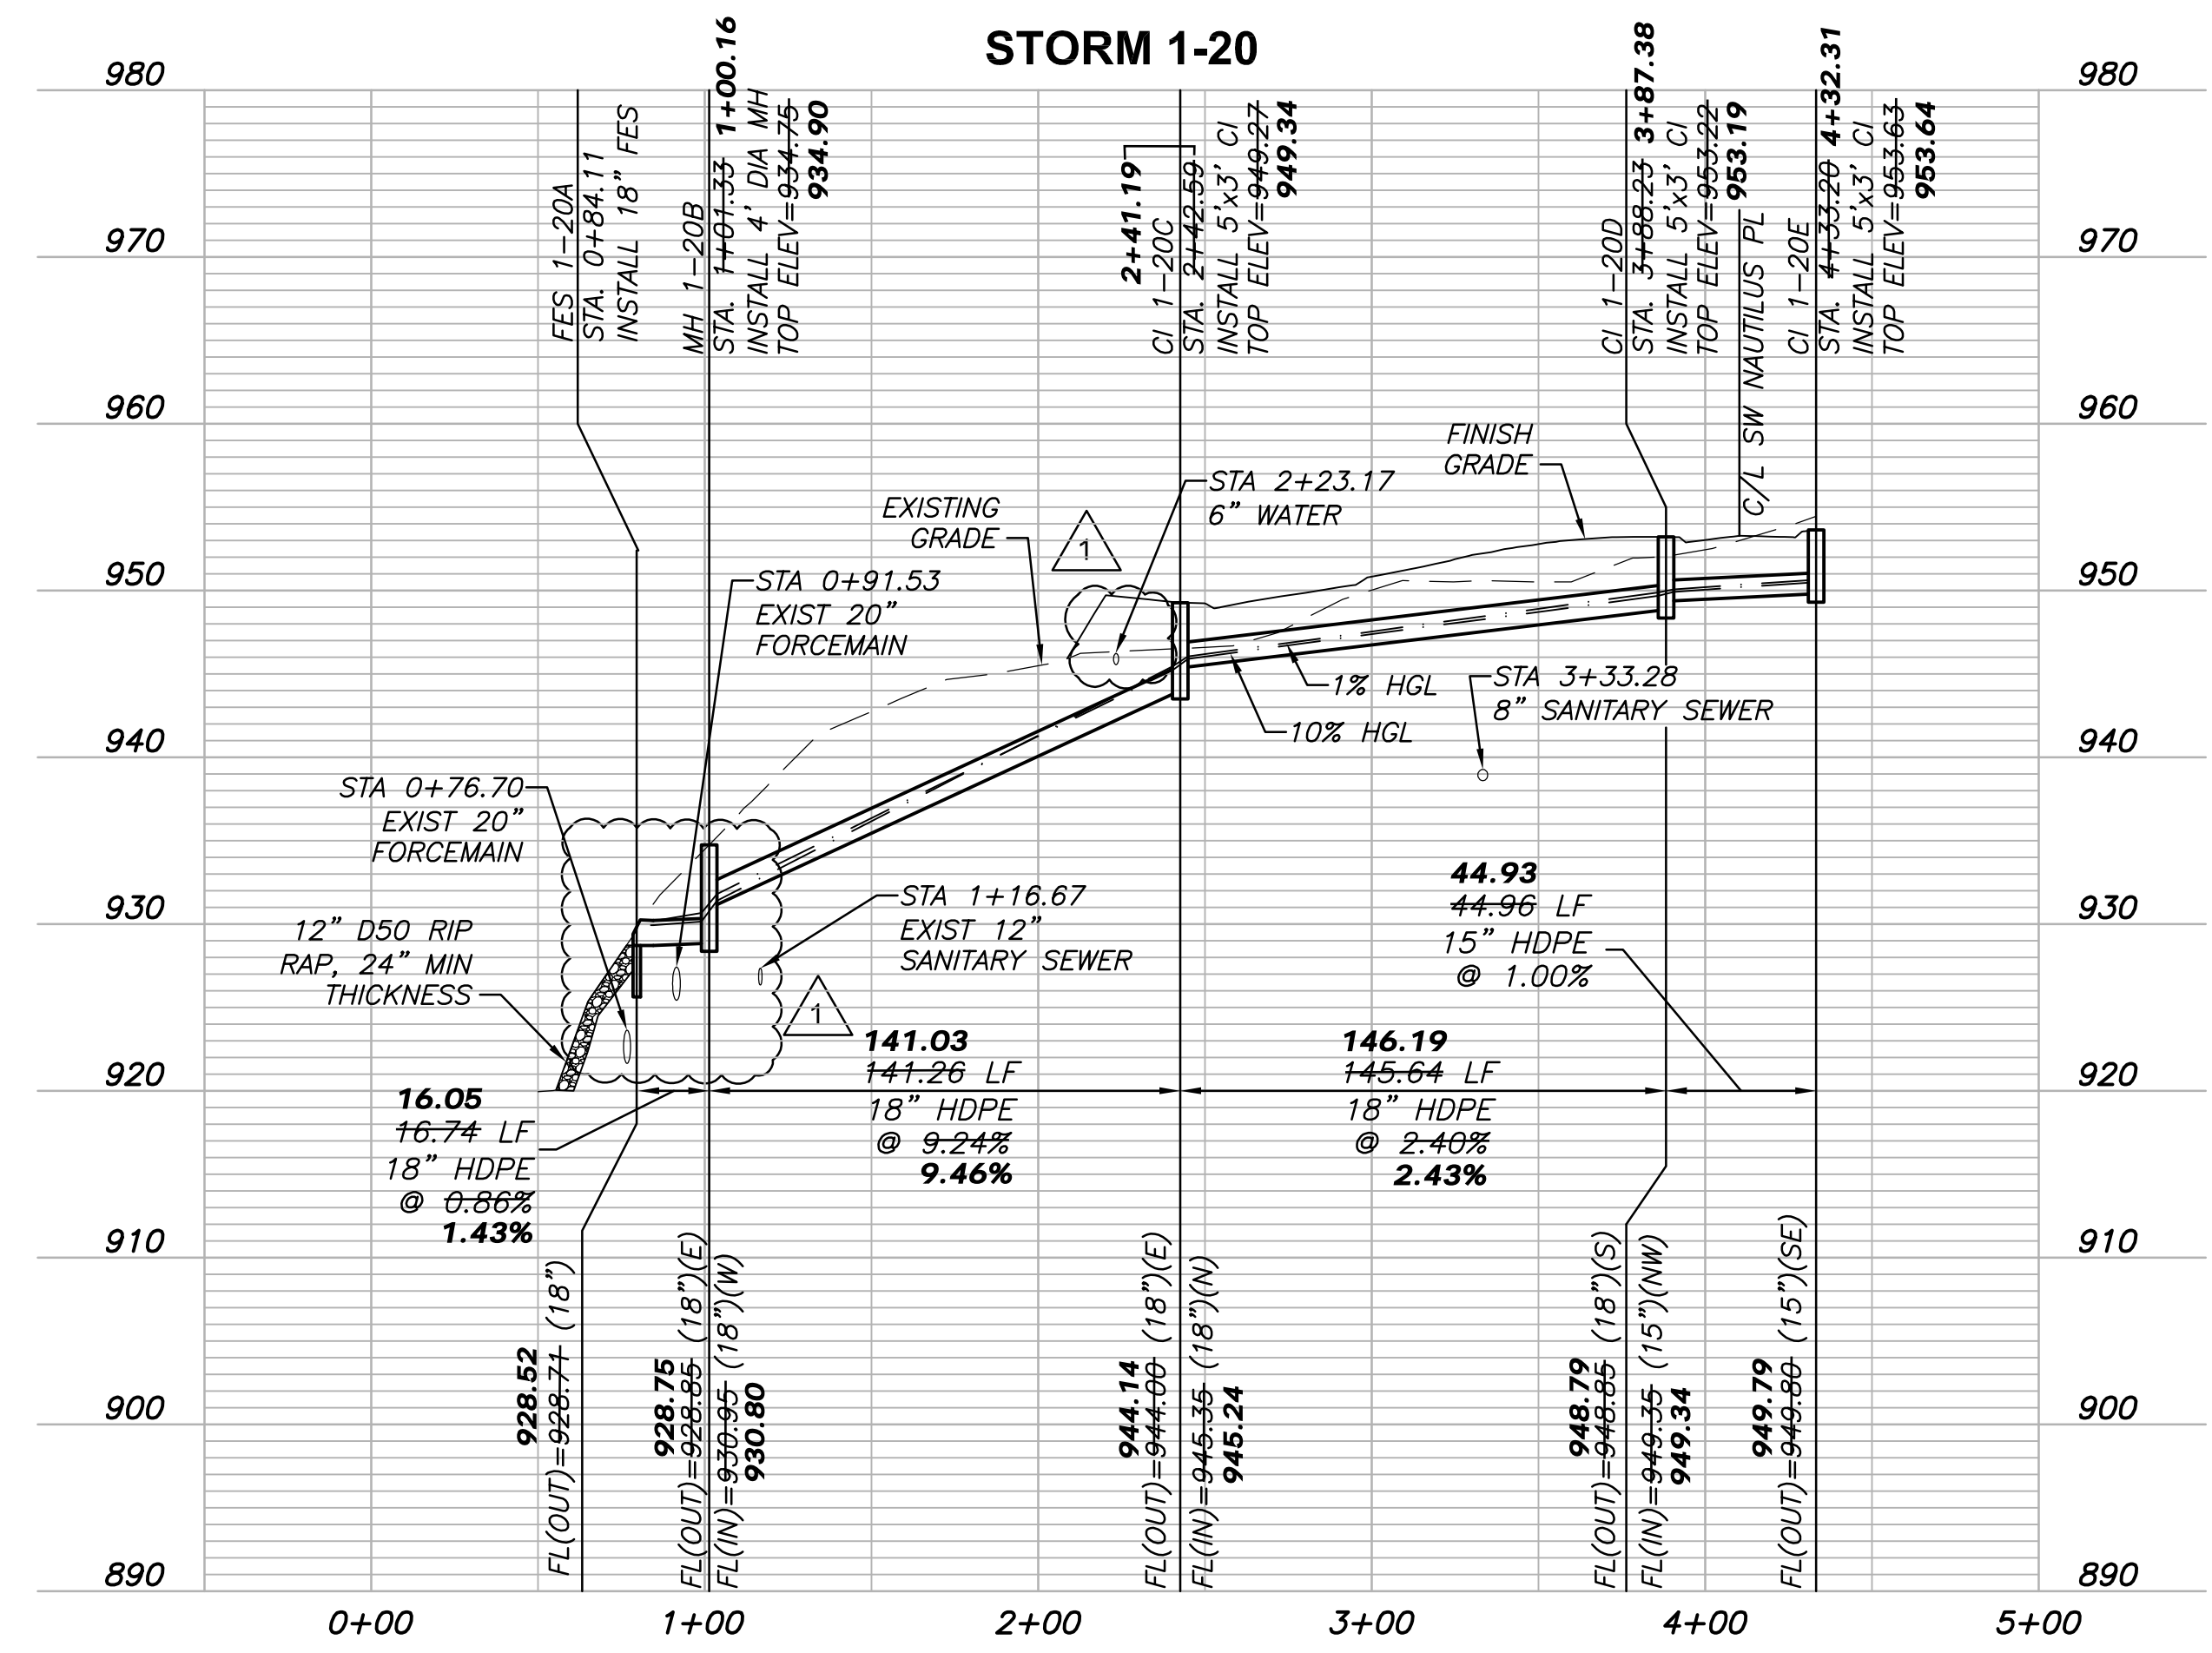

"AS-BUILT"
October 29, 2018



PROJECT FOR
LANDROCK DEVELOPMENT, LLC

CREEKSIDE AT RAIN TREE LOTS 1 THRU 31 LEE'S SUMMIT, MISSOURI


MARK	DATE	DESCRIPTION
D	10/29/2018	AS-BUILT
C	07/28/2017	CITY RESUBMITTAL
B	05/01/2017	CITY RESUBMITTAL
A	03/08/2017	CITY SUBMITTAL

PROJECT NUMBER	1002825-276408
ORIGINAL ISSUE	MARCH 7, 2017

PROJECT MANAGER	SIMON SUN
PROJECT ENGINEER	WILL NEDS, E.I.T.

SHEET NAME
STORM SEWER PLAN AND PROFILE

LINE 1-20

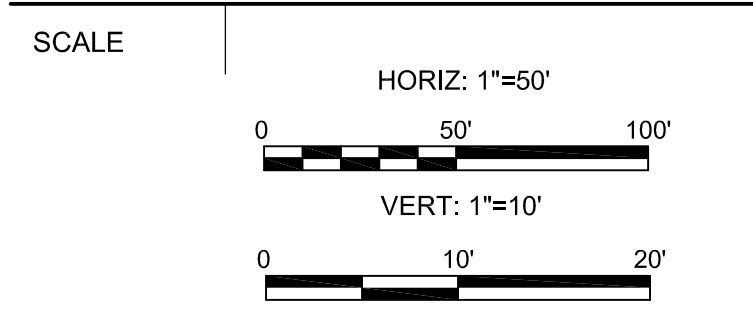

SHEET NUMBER
01C-CR-17

FILE NAME | 01C-CR-18.dwg

PERMIT REVIEW DRAWINGS

C:\working\p01\01465701\01C-CR-18.dwg, 01C-CR-18, 10/29/2018 11:19:37 AM, WNEEDS



3741 NE TROON DR
LEE'S SUMMIT, MO 64064
816.347.1100

MO STATE CERTIFICATE OF
AUTHORITY #000856

PROJECT FOR

**LANDROCK
DEVELOPMENT, LLC**

**CREEKSIDE AT RAINTREE
LOTS 1 THRU 31
LEE'S SUMMIT, MISSOURI**

B	04/14/2017	CITY RESUBMITTAL
A	03/08/2017	CITY SUBMITTAL
MARK	DATE	DESCRIPTION

PROJECT NUMBER	10028825-276408
ORIGINAL ISSUE	MARCH 7, 2017

PROJECT MANAGER	SIMON SUN
PROJECT ENGINEER	WILL NEDS, E.I.T.



SHEET NAME

**STORM SEWER
DETAILS**


SCALE NO SCALE

SHEET NUMBER


01C-CR-18

FILE NAME 01C-CR-18.dwg

PERMIT REVIEW DRAWINGS

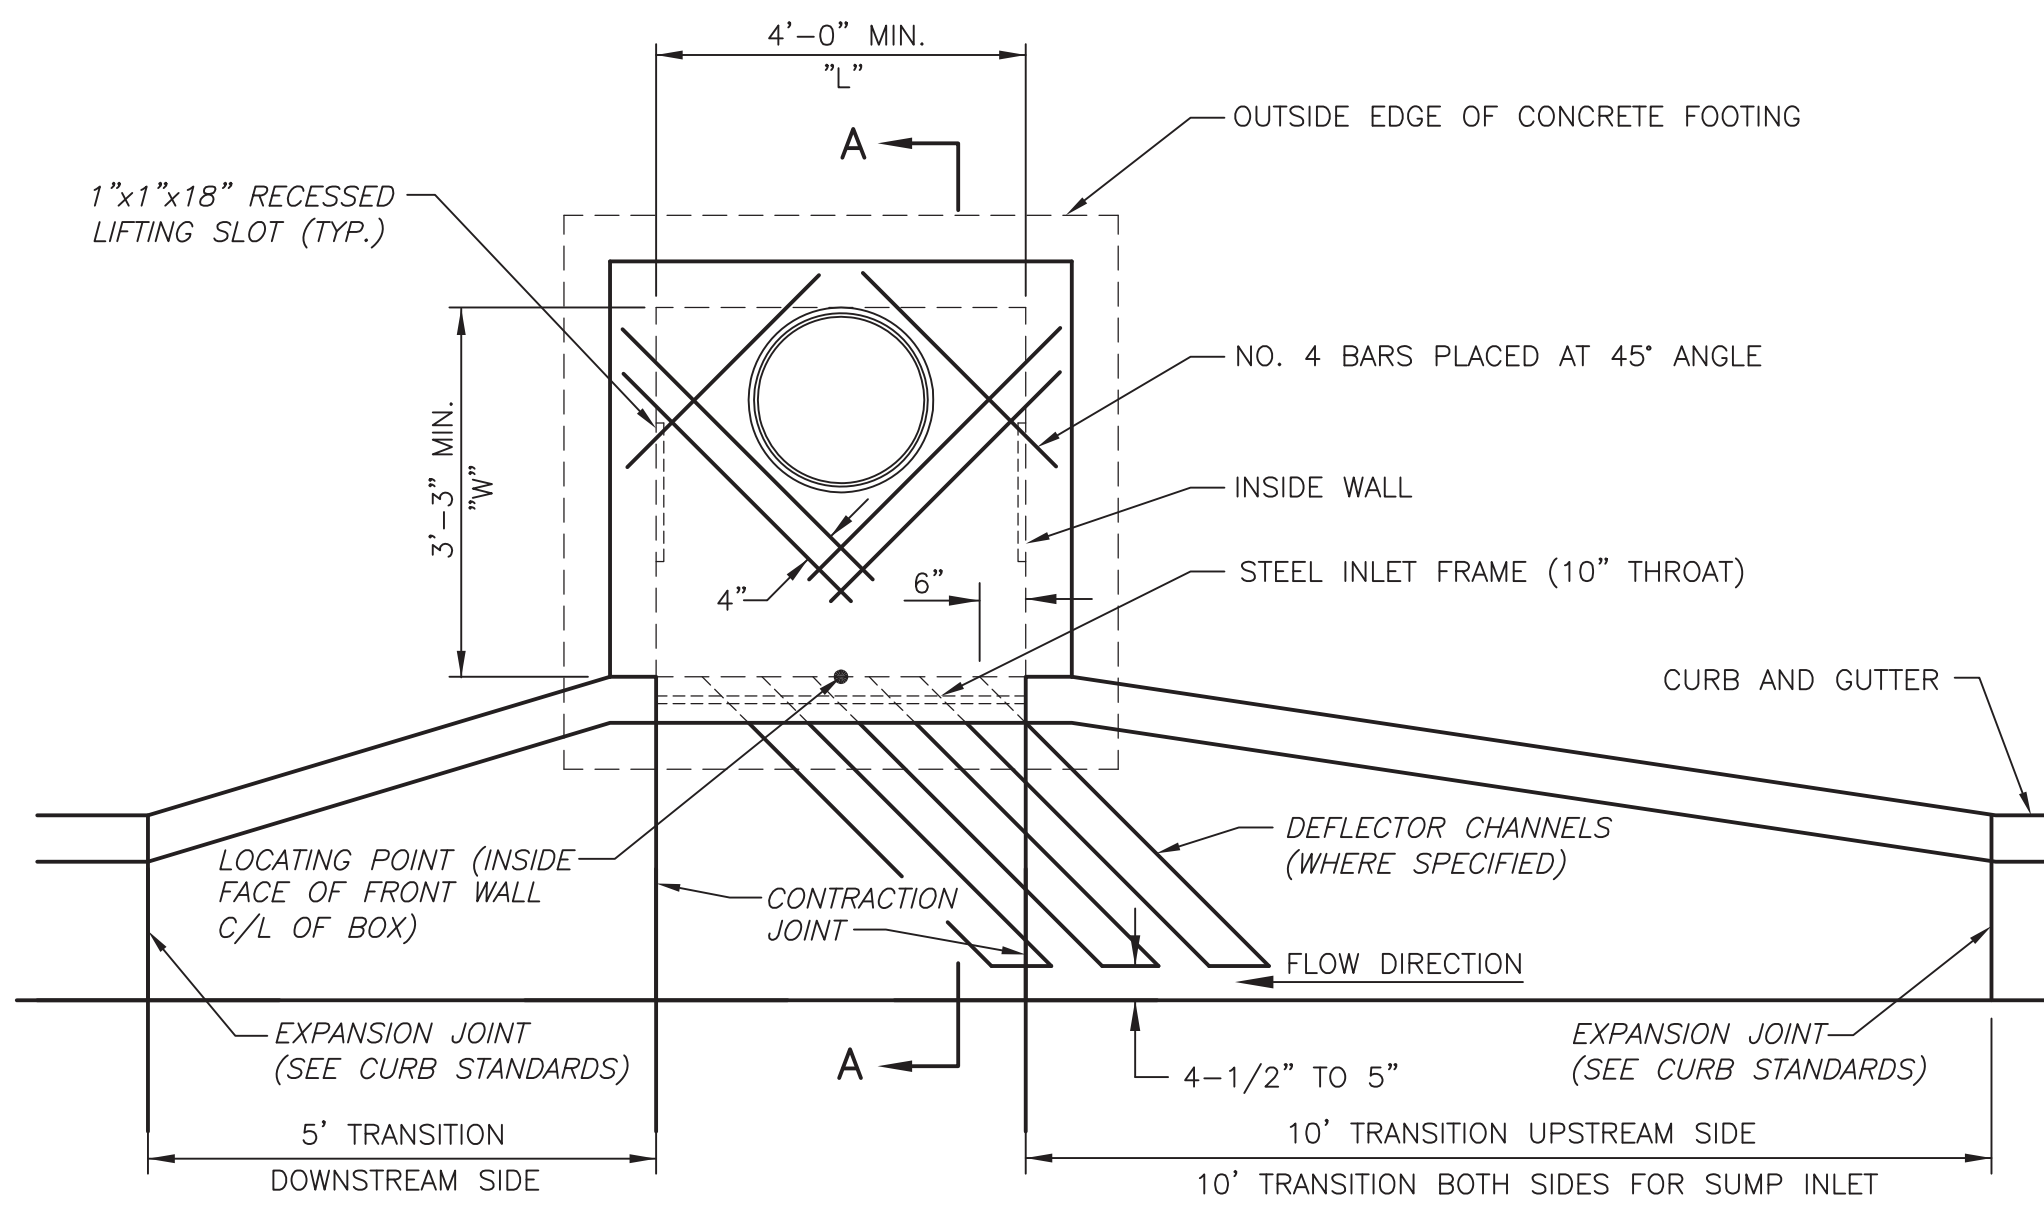


PLAN

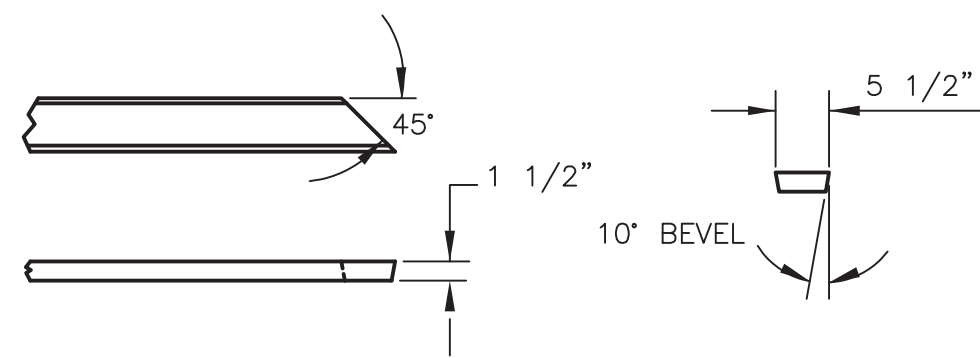

DEFLECTOR CHANNEL FORM DETAIL

NOTE:
FORMS SHOULD BE WELL OILED AND HAND PLACED AT TIME OF POUR. AFTER INITIAL SET, REMOVE FORMS AND FINISH SURFACE OF CONCRETE.

APWA CURB INLET - TYPE 2

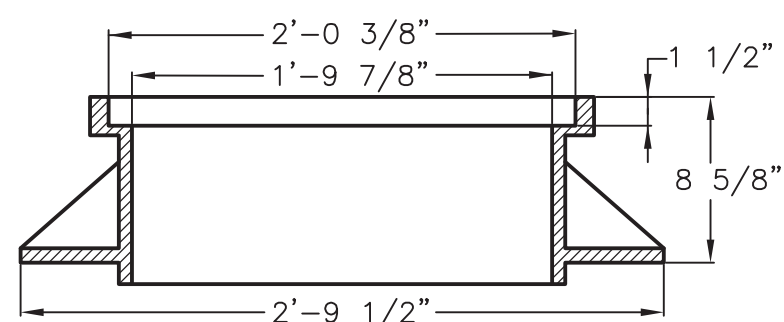

STANDARD 24" MANHOLE FRAME
LEE'S SUMMIT PART NO.: LS101A
MINIMUM WEIGHT = 250 LB
MATCHING COVER: LS101B

NOTE:
REFER TO WATER UTILITIES LIST OF APPROVED MANUFACTURER'S.


24" MANHOLE FRAME

NOT TO SCALE




STANDARD 24" MANHOLE COVER
LEE'S SUMMIT PART NO.: LS101B
MINIMUM WEIGHT = 160 LB
MATCHING FRAME: LS101A
NOTE: PICK HOLES NOT SHOWN.

NOTE:
REFER TO WATER UTILITIES LIST OF APPROVED MANUFACTURER'S.

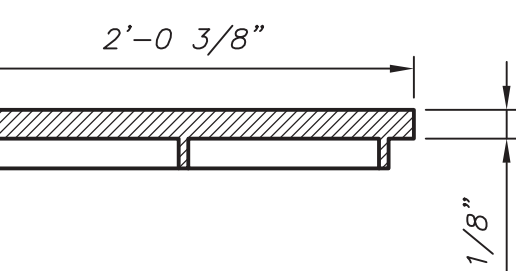

24" MANHOLE COVER

NOT TO SCALE

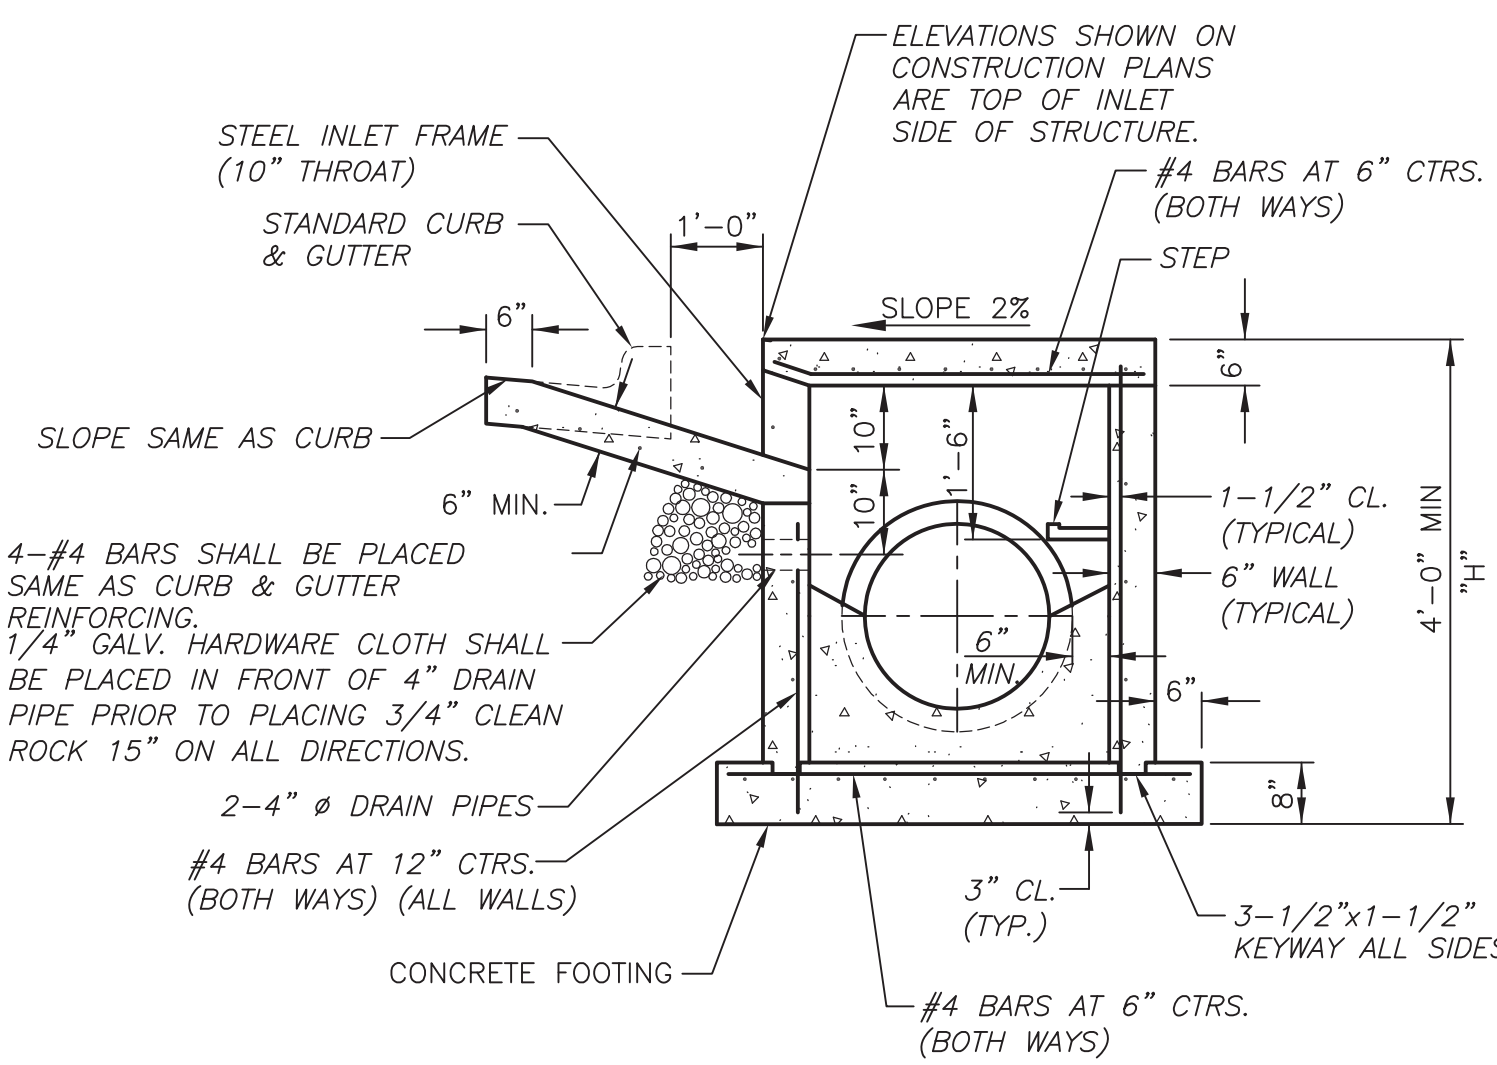

SECTION A-A


TYP

GENERAL CURB INLET NOTES:


1. THE FIRST DIMENSION LISTED IN THE CONSTRUCTION NOTES IS THE "L" DIMENSION. THE SECOND DIMENSION IS THE "W" DIMENSION. FL'S LISTED ON THE PROJECT PLANS ARE LISTED AT THE INSIDE FACE OF THE WALL.
2. FLOOR OF INLET SHALL BE SHAPED WITH INVERT TO PROVIDE SMOOTH FLOW.
3. LOCATE MH RING AND COVER OVER OUTLET.
4. STEPS SHALL BE SPACED AT 1'-4" O.C. VERTICALLY.
5. BEVEL ALL EXPOSED EDGES WITH 3/4" CHAMFER OR 1/2" TOOLED EDGE.
6. ON-GRADE INLETS SHALL CONFORM TO THE STREET GRADE AND SUMP INLETS SHALL BE LEVEL.
7. THE SUMS OF "L" & "W" SHALL NOT EXCEED 14' WITHOUT SPECIAL DESIGN (SEE PROJECT PLANS FOR DETAILS).
8. RING & COVER TO BE NEENAH R-1537, CLAY & BAILEY #2020, DEETER #2016 OR APPROVED EQUAL. (CASTING MAY VARY BY MUNICIPALITY, REFER TO PLANS & CONTRACT DOCUMENTS).

GENERAL STEEL INLET FRAME NOTES:

1. ALL WELDS SHALL BE PERFORMED IN ACCORDANCE WITH APPROPRIATE AWS SPECIFICATIONS AND PROCEDURES.
2. ALL WELDS ON EXPOSED SURFACES SHALL BE DRESSED SO AS TO PROVIDE A PLEASING FINISHED APPEARANCE.
3. THE ENTIRE FRAME SHALL BE PAINTED A SINGLE COAT OF CHEM-PRIME #37-77 PRIMER (RED) OR EQUAL.

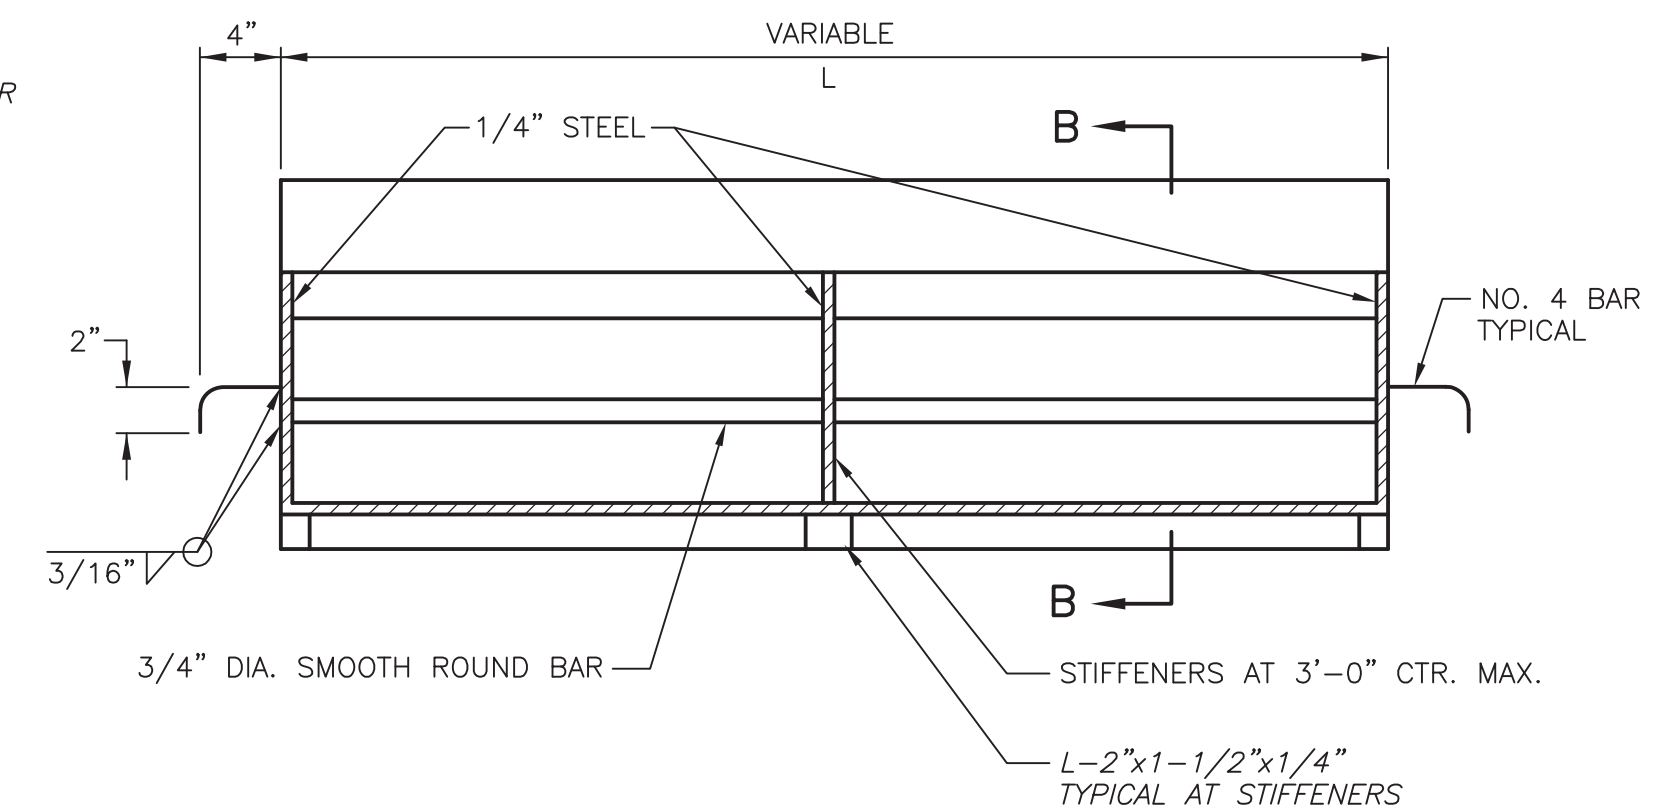

FRONT VIEW

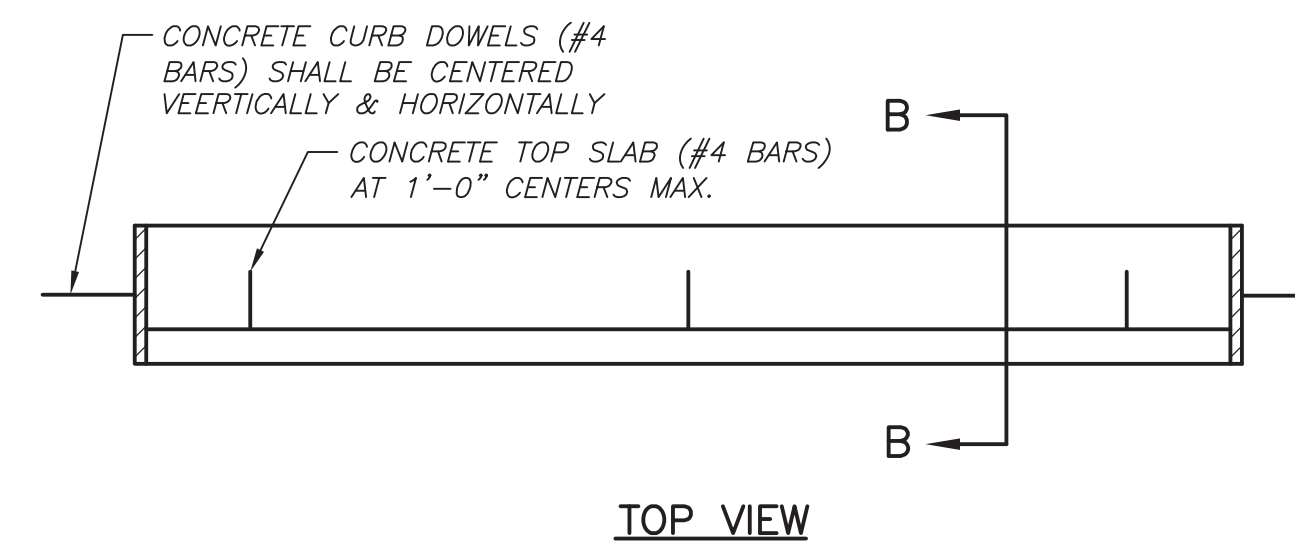

TOP VIEW

10" STEEL INLET FRAME





3741 NE TROON DR
LEE'S SUMMIT, MO 64064
816.347.1100

MO STATE CERTIFICATE OF
AUTHORITY #000856

PROJECT FOR

**LANDROCK
DEVELOPMENT, LLC**

**CREEKSIDE AT RAINTREE
LOTS 1 THRU 31
LEE'S SUMMIT, MISSOURI**

B	04/14/2017	CITY RESUBMITTAL
A	03/08/2017	CITY SUBMITTAL
MARK	DATE	DESCRIPTION

PROJECT NUMBER	10028825-276408
ORIGINAL ISSUE	MARCH 7, 2017

PROJECT MANAGER	SIMON SUN
PROJECT ENGINEER	WILL NEDS, E.I.T.



SHEET NAME

**STORM SEWER
DETAILS**





SCALE NO SCALE

SHEET NUMBER

01C-CR-19

FILE NAME 01C-CR-19.dwg

PERMIT REVIEW DRAWINGS

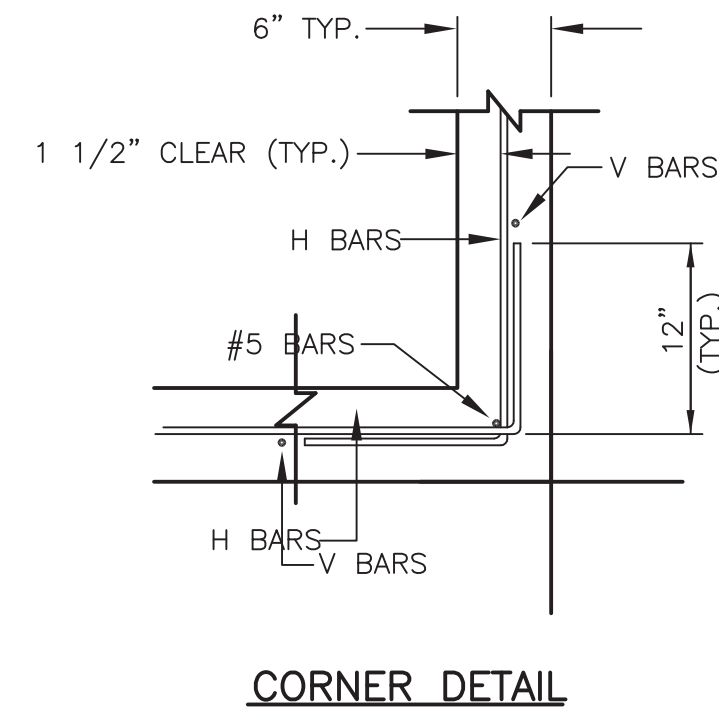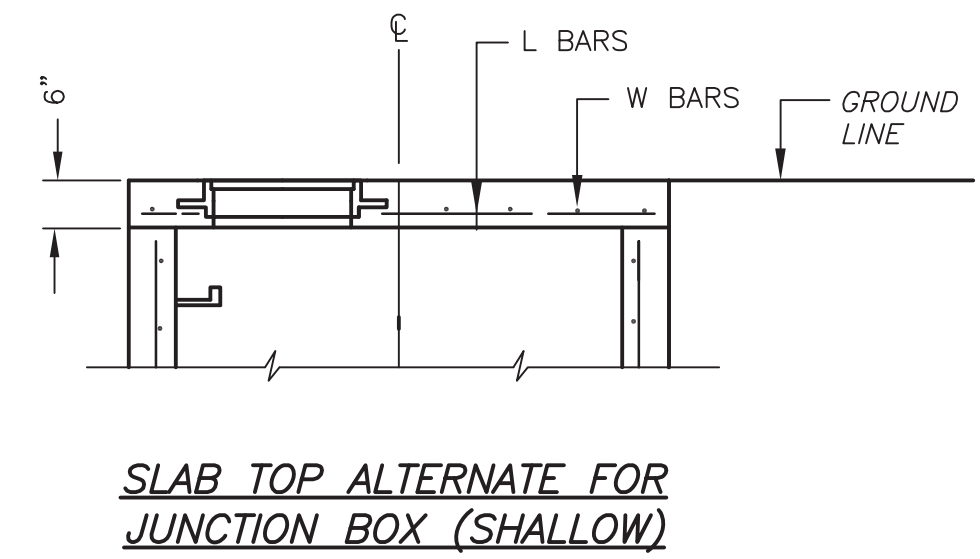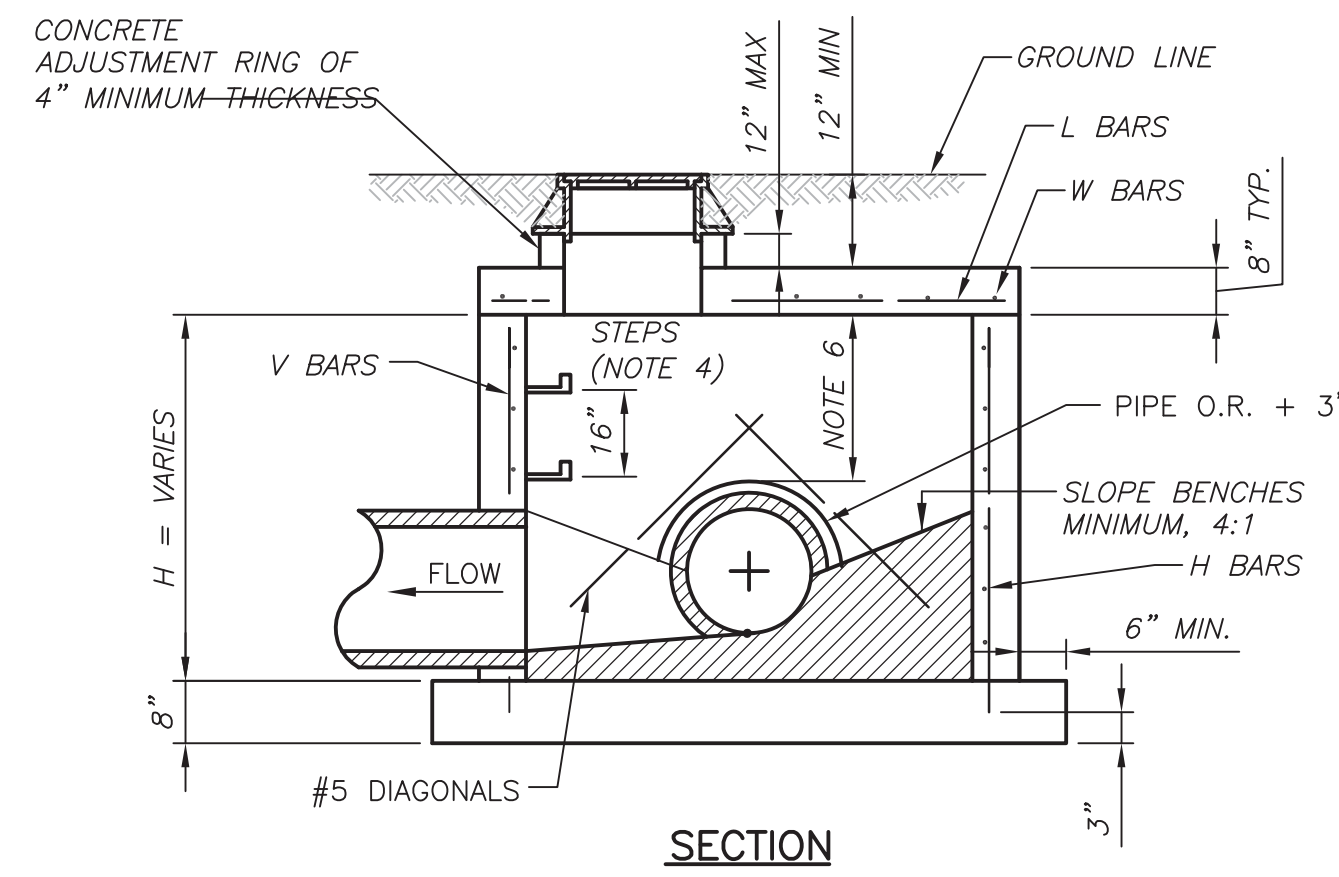
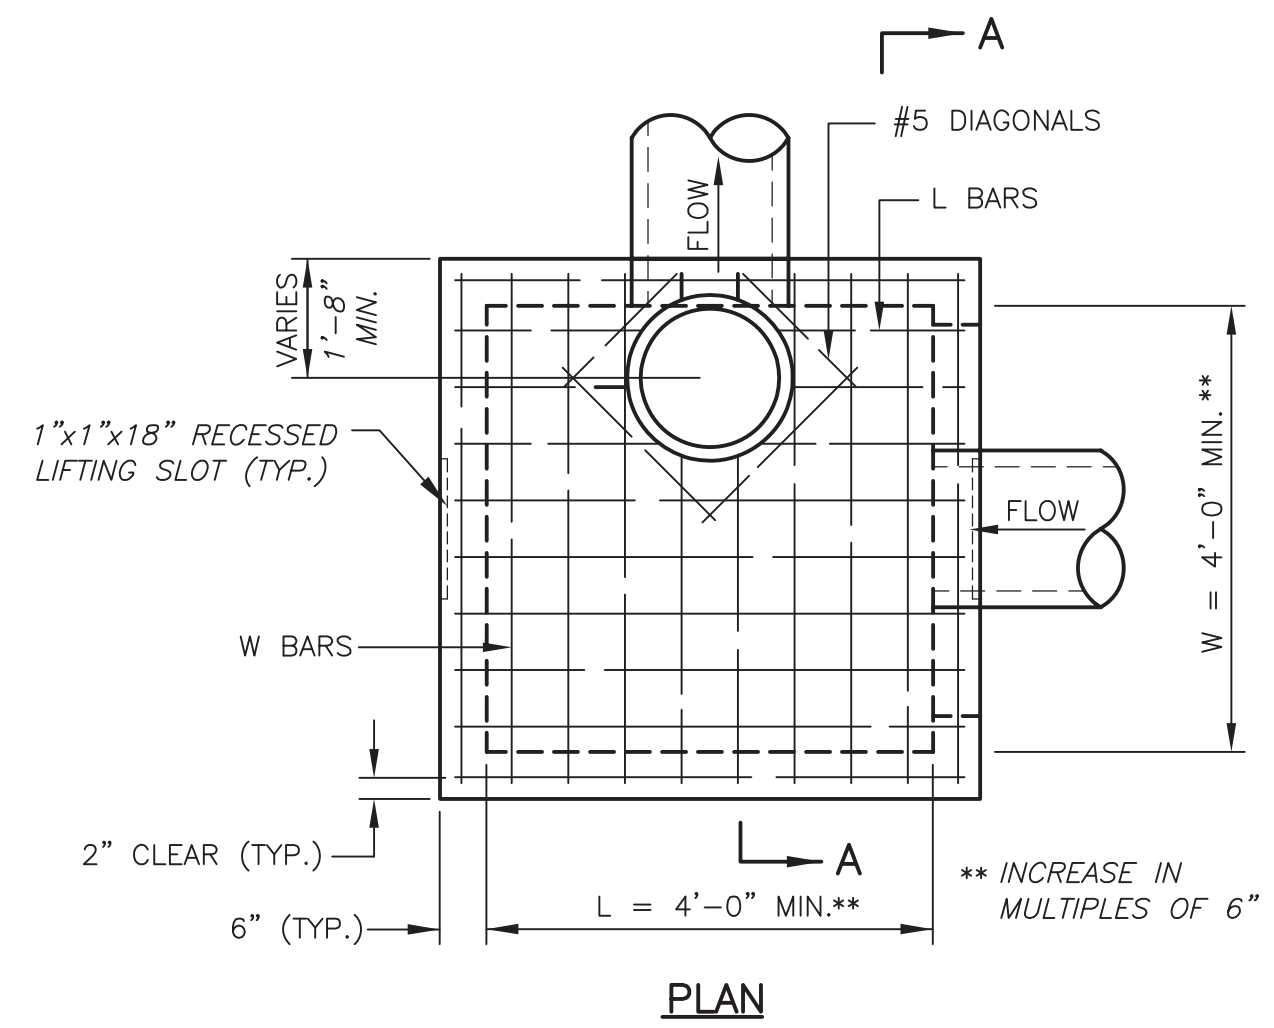


REINFORCING		
BARS	SIZE	SPACING (IN.)
H	4	12
V	4	12
L	5	6
W	5	6


GENERAL NOTES:

1. LOCATE RING AND COVER OVER OUTLET.
2. ALL WORK AND MATERIALS SHALL CONFORM TO PROJECT SPECIFICATIONS SECTION 02515.
3. USE 3/4" CHAMFER STRIP OR 1/2" R EDGER TOOL ON ALL EXPOSED CONCRETE CORNERS.
4. STEPS REQUIRED AT 16" O.C. WHEN DEPTH FROM TOP OF CASTING TO INVERT EXCEEDS 4'.
5. BOXOUTS WILL NOT BE ALLOWED TO PROJECT THROUGH THE CORNERS OF THE STRUCTURE AND THE MINIMUM DISTANCE BETWEEN BOXOUTS IS 6" WITH 1 CORNER BAR.
6. THE MINIMUM REINFORCING SHALL BE 1 H-BAR OVER A CAST-IN PLACE PIPE AND 2 H-BARS OVER A PRECAST BOXOUT.
7. O.R. = ONE HALF OUTSIDE PIPE DIAMETER (O.D.).
8. REINFORCING OF COVERS IN STREETS REQUIRE SPECIAL DESIGN.
9. RING & COVER SHALL BE NEENAH R-1736, CLAY & BAILEY #2008, DEETER #1315, EJ V1383 OR APPROVED EQUAL.

JUNCTION BOX DETAIL

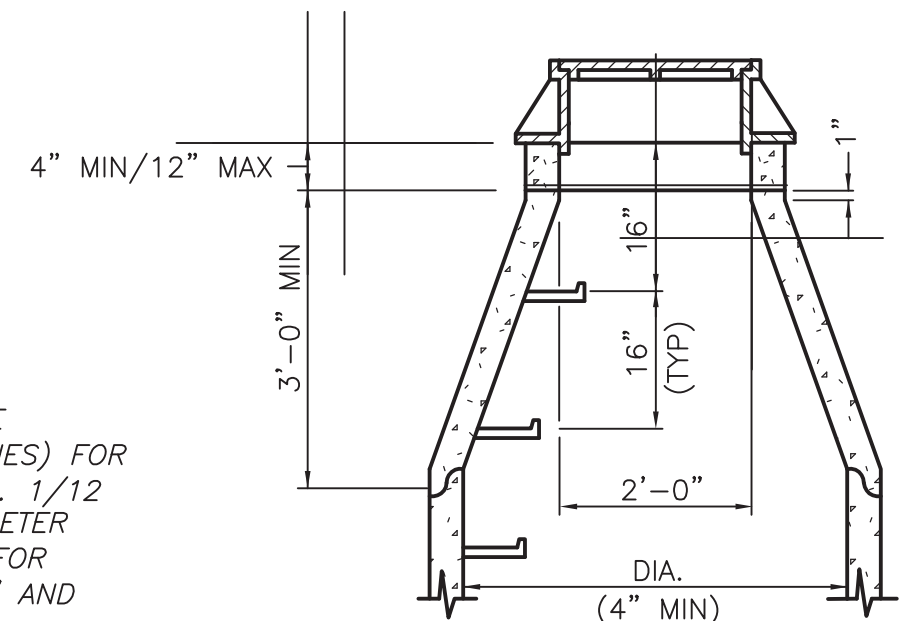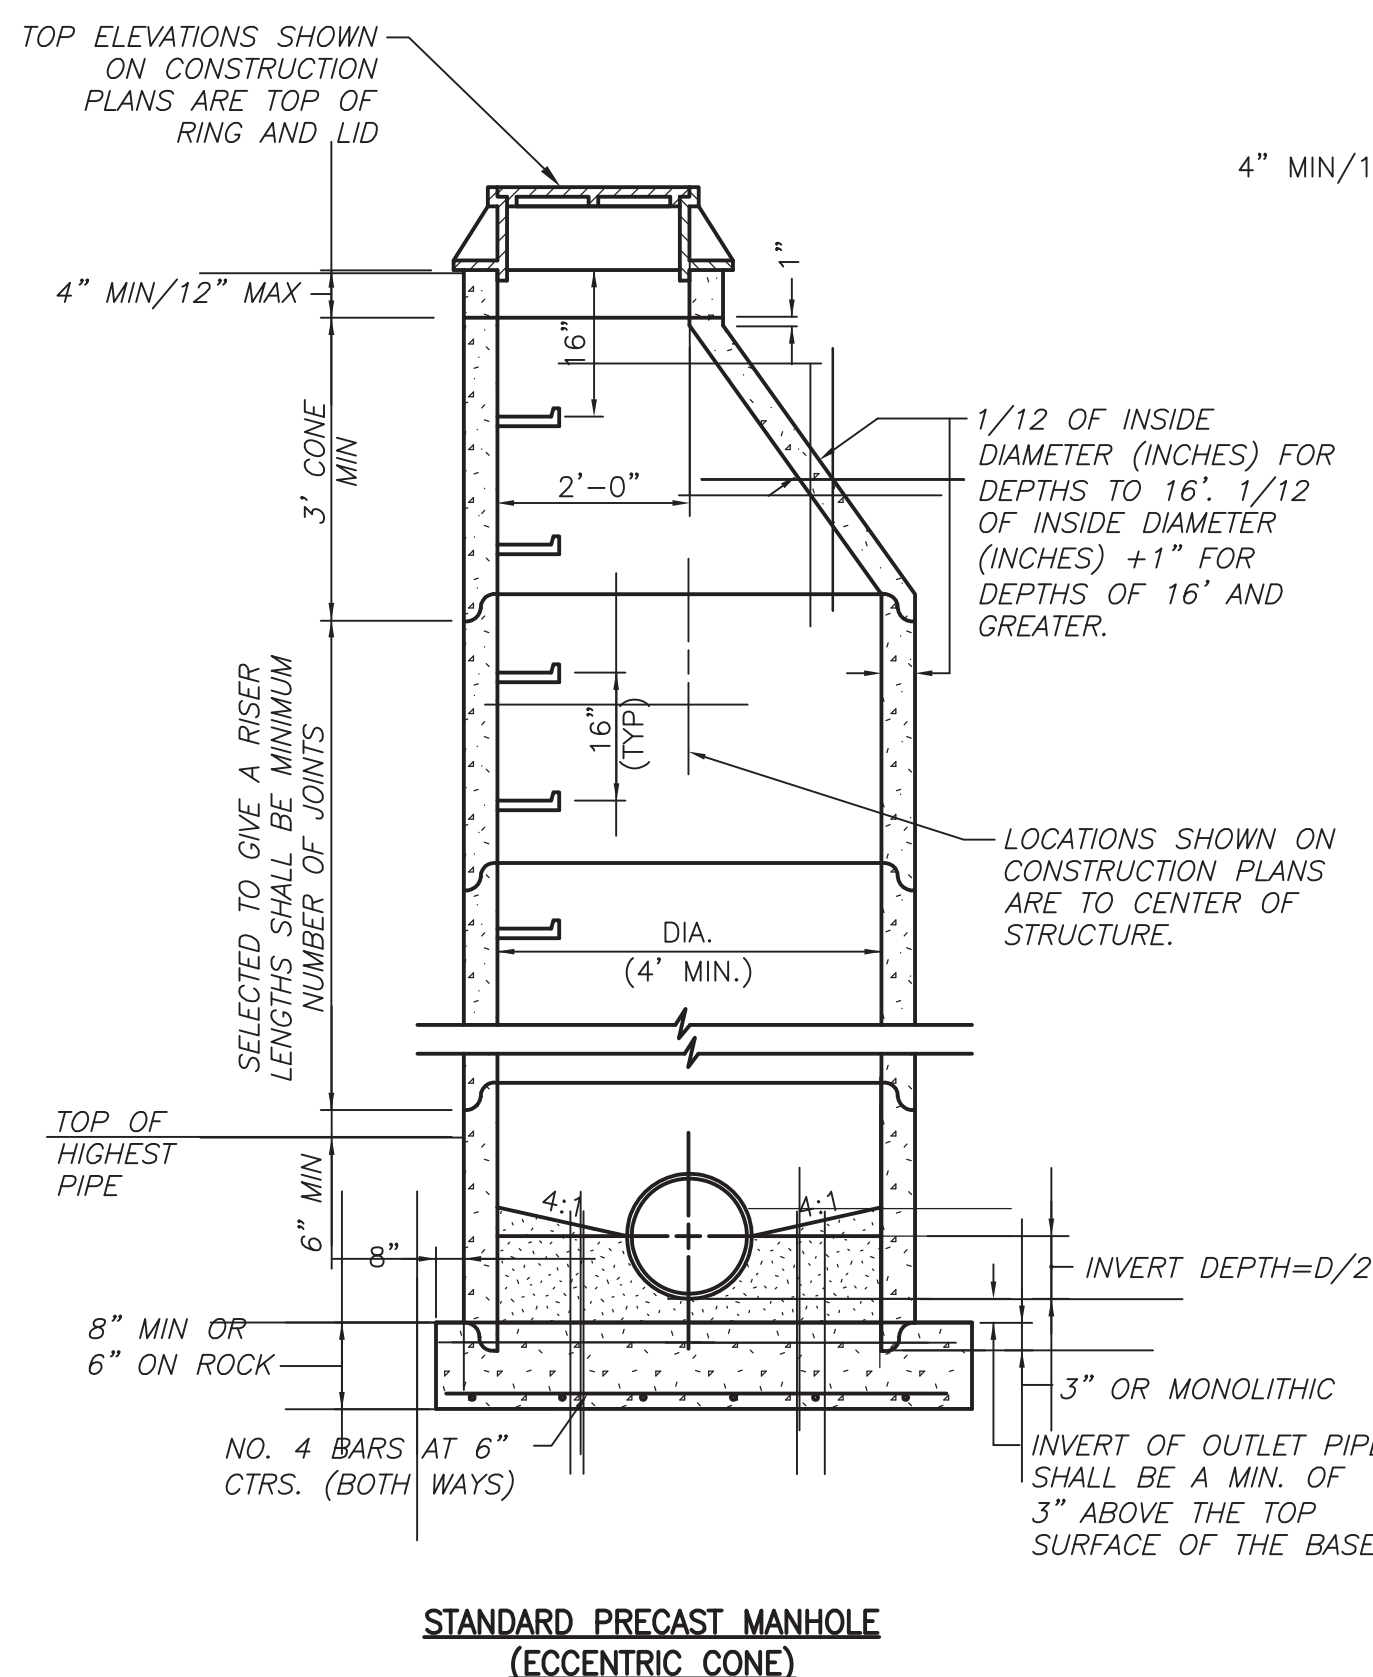

**STANDARD PRECAST MANHOLE
(CONCENTRIC CONE)
(SEE ECCENTRIC CONE FOR OTHER DETAILS)**

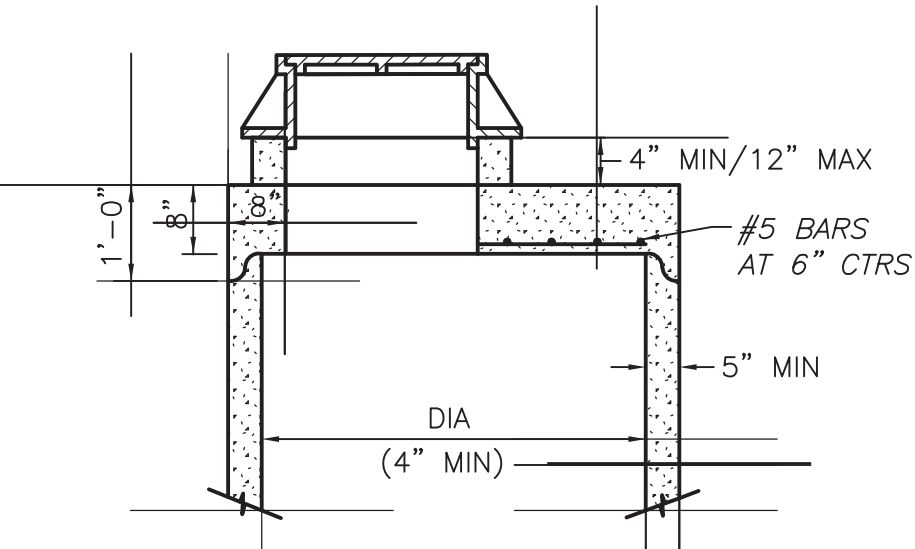

**STANDARD PRECAST MANHOLE
(SHALLOW TYPE)
(SEE ECCENTRIC CONE FOR OTHER DETAILS)**

PRECAST MANHOLE DETAIL

GENERAL MANHOLE NOTES:

1. ALL MANHOLES ARE TO BE PRECAST CONCRETE AND OF ECCENTRIC CONE TYPE UNLESS OTHERWISE SPECIFIED.
2. MANHOLE TOP ADJUSTMENTS SHALL BE ACCOMPLISHED BY THE USE OF CONCRETE ADJUSTMENT RINGS.
3. TOP OF MANHOLE CASTING SHALL BE SET FLUSH AND ON SAME SLOPE AS FINISHED SURFACE OR AS DIRECTED BY THE ENGINEER.
4. REINFORCEMENT IN ALL SECTIONS SHALL EQUAL OR EXCEED A.S.T.M. C-478 SPECIFICATIONS.
5. THE ENGINEER SHALL DESIGNATE MODIFICATIONS FOR MANHOLES WITH SPECIAL DESIGNS.
6. THE INSIDE DIAMETER OF THE MANHOLE SHALL BE 4'-0" FOR PIPE DIAMETERS FROM 12" - 24", 5'-0" FOR PIPE DIAMETERS FROM 27" - 36", AND 6'-0" FOR PIPE DIAMETERS 42" - 48", UNLESS OTHERWISE NOTED ON THE DRAWINGS.
7. CLEARANCE TOLERANCE OF PIPE OPENINGS: THE MAXIMUM ALLOWABLE PIPE OPENING ON A HORIZONTAL AXIS SHALL BE THE OUTSIDE DIAMETER OF THE PIPE PLUS 12". THE MAXIMUM ALLOWABLE PIPE OPENING ON VERTICAL AXIS SHALL BE THE OUTSIDE DIAMETER PLUS 8". THE MINIMUM CLEARANCE BETWEEN THE OUTSIDE SURFACE OF AN INSTALLED PIPE AND THE CONCRETE OF THE MANHOLE SHALL BE 2".
8. INSTALLATION OF PIPE OPENINGS: ALL REQUIRED PIPE OPENINGS SHALL BE PLANT CAST IN MANHOLE UNITS. FIELD ALTERATIONS OF OPENINGS WILL BE PERMITTED PROVIDED WALLS ARE SCORED WITH A MASONRY SAW TO A DEPTH SUFFICIENT TO SEVER REINFORCING STEEL. A CHIPPING HAMMER MAY THEN BE USED TO REMOVE THE CONCRETE. MINIMUM DISTANCE BETWEEN ANY TWO ADJACENT PIPES SHALL BE 4".
9. NO DIRECT PAYMENT FOR SHAPING FLOOR OR CONNECTING PIPES AS SHOWN ON PLANS.
10. RING & COVER SHALL BE DEETER #125B, EAST JORDAN IRON WORKS #2420Z RING W/#2408A COVER OR APPROVED EQUAL.
11. SANITARY SEWERS SHALL BE COATED AND CONFORM TO CITY STANDARDS.