


DWG: F:\2019\4001-4500\019-4061-BV40-Design\AutoCAD\Asbuilt\Sheets\GNCA\Street & Storm Plans\C_TL01_B194061.dwg
DATE: Oct 11, 2022 3:25pm
USER: ssaylor
XREFS: C_PTBK_B194061



- ☐ NOT FOR CONSTRUCTION
- ☐ REVIEWED FOR CONSTRUCTION

PROJECT TEAM & UTILITY CONTACT LIST	
OWNER / DEVELOPER HUNT MIDWEST REAL ESTATE DEVELOPMENT, INC. 8300 NE UNDERGROUND DRIVE KANSAS CITY, MO 64161 CONTACT: AARON SCHMIDT PHONE: 816.455.2500	UTILITY SERVICE NUMBERS NAME: LEE'S SUMMIT PUBLIC WORKS PHONE: 816-969-1800 NAME: LEE'S SUMMIT WATER & SERVICES DEPARTMENT PHONE: 816-969-1940 NAME: SPIRE (MGE) PHONE: 314-342-0500 NAME: AT&T PHONE: 800-286-8313 NAME: EVERGY PHONE: 816-471-5275 NAME: SPECTRUM (TWC) PHONE: 877-772-2253 NAME: GOOGLE FIBER PHONE: 877-454-6959
ENGINEER OLSSON 1301 BURLINGTON, SUITE 100 NORTH KANSAS CITY, MO 64116 CONTACT: JULIE E. SELLERS, P.E. PHONE: 816.361.1177 EMAIL: JSSELLERS@OLSSON.COM	
SURVEYOR OLSSON 1301 BURLINGTON, SUITE 100 NORTH KANSAS CITY, MO 64116 CONTACT: JASON ROUDEBUSH, P.L.S. PHONE: 816.361.1177 EMAIL: JROUDEBOUSH@OLSSON.COM	

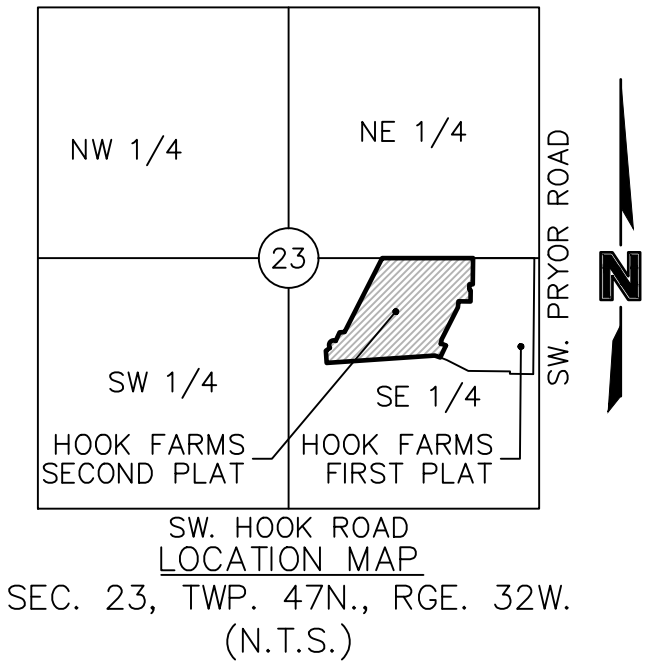


PROPERTY DESCRIPTION

A TRACT OF LAND IN THE SOUTHEAST QUARTER OF SECTION 23, TOWNSHIP 47 NORTH, RANGE 32 WEST OF THE 5TH PRINCIPAL MERIDIAN IN LEE'S SUMMIT, JACKSON COUNTY, MISSOURI BEING BOUNDED AND DESCRIBED BY OR UNDER THE DIRECT SUPERVISION OF JASON S. ROUDEBUSH, P.L.S. 2002014092 AS FOLLOWS: COMMENCING AT THE SOUTHEAST CORNER OF SAID SOUTHEAST QUARTER; THENCE NORTH 02°45'34" EAST, ON THE EAST LINE OF SAID SOUTHEAST QUARTER, 2,635.08 FEET TO THE NORTHEAST CORNER OF SAID SOUTHEAST QUARTER; THENCE NORTH 87°45'24" WEST, ON THE NORTH LINE OF SAID SOUTHEAST QUARTER, 50.00 FEET TO THE SOUTHEAST CORNER OF LOT 3, EAGLE CREEK-FIRST PLAT, A SUBDIVISION IN SAID LEE'S SUMMIT RECORDED AS INSTRUMENT NUMBER 110409 IN BOOK 165 AT PAGE 01 IN JACKSON COUNTY RECORDER OF DEEDS OFFICE, ALSO BEING THE NORTHWEST CORNER OF PROPOSED HOOK FARMS FIRST PLAT; THENCE CONTINUING NORTH 87°45'24" WEST ON SAID NORTH LINE, ALSO BEING THE PROPOSED NORTH LINE OF SAID PROPOSED HOOK FARMS FIRST PLAT, ALSO BEING THE SOUTH LINE OF SAID EAGLE CREEK-FIRST PLAT, 643.83 FEET TO THE POINT OF BEGINNING OF THE TRACT OF LAND TO BE HEREIN DESCRIBED; THENCE LEAVING SAID NORTH AND SOUTH LINES, SOUTH 02°59'10" WEST, ALONG THE PROPOSED WESTERLY LINE OF PROPOSED HOOK FARMS FIRST PLAT, 277.38 FEET; THENCE NORTH 87°00'50" WEST, ALONG SAID PROPOSED WESTERLY LINE, 36.00 FEET; THENCE SOUTH 02°59'10" WEST, ALONG SAID PROPOSED WESTERLY LINE, 50.00 FEET; THENCE SOUTH 42°00'50" EAST, ALONG SAID PROPOSED WESTERLY LINE, 19.80 FEET; THENCE SOUTH 02°59'10" WEST, ALONG SAID PROPOSED WESTERLY LINE, 116.00 FEET; THENCE NORTH 87°00'50" WEST, ALONG SAID PROPOSED WESTERLY LINE, 126.12 FEET; THENCE SOUTH 07°19'52" WEST, ALONG SAID PROPOSED WESTERLY LINE, 64.17 FEET; THENCE SOUTH 29°10'47" WEST, ALONG SAID PROPOSED WESTERLY LINE, 375.17 FEET; THENCE SOUTH 15°20'56" WEST, ALONG SAID PROPOSED WESTERLY LINE, 50.00 FEET; THENCE ALONG SAID PROPOSED WESTERLY LINE, EASTERLY ALONG A CURVE TO THE RIGHT HAVING AN INITIAL TANGENT BEARING OF SOUTH 74°39'04" EAST WITH A RADIUS OF 275.00 FEET, A CENTRAL ANGLE OF 11°57'16" AND AN ARC DISTANCE OF 57.38 FEET; THENCE SOUTH 27°18'12" WEST, ALONG SAID PROPOSED WESTERLY LINE, 138.17 FEET; THENCE LEAVING SAID PROPOSED WESTERLY LINE, NORTH 67°11'53" WEST, 61.05 FEET; THENCE SOUTH 88°21'16" WEST, 1,139.83 FEET; THENCE NORTH 01°38'44" WEST, 128.09 FEET; THENCE NORTH 57°02'58" EAST, 49.90 FEET; THENCE NORTHEASTERLY ALONG A CURVE TO THE RIGHT HAVING AN INITIAL TANGENT BEARING OF NORTH 32°57'02" WEST WITH A RADIUS OF 50.00 FEET, A CENTRAL ANGLE OF 150°22'53" AND AN ARC DISTANCE OF 131.23 FEET; THENCE NORTH 27°25'51" EAST, 98.75 FEET; THENCE NORTH 88°21'16" EAST, 52.12 FEET; THENCE NORTH 29°10'47" EAST, 873.51 FEET TO A POINT ON SAID NORTH LINE OF SAID SOUTHEAST QUARTER, ALSO BEING THE SOUTH LINE OF EAGLE CREEK-SECOND PLAT, A SUBDIVISION IN SAID LEE'S SUMMIT RECORDED AS INSTRUMENT NUMBER 200100058889 IN BOOK 165 AT PAGE 09 IN SAID JACKSON COUNTY RECORDER OF DEEDS OFFICE; THENCE SOUTH 87°45'24" EAST, ON SAID NORTH LINE AND SAID SOUTH LINE, 682.19 FEET TO THE SOUTHEAST CORNER OF SAID EAGLE CREEK-SECOND PLAT, ALSO BEING THE SOUTHWEST CORNER OF SAID EAGLE CREEK-FIRST PLAT; THENCE SOUTH 87°45'24" EAST ON SAID NORTH LINE, AND SAID SOUTH LINE OF EAGLE CREEK-FIRST PLAT, 273.64 FEET TO THE POINT OF BEGINNING. CONTAINING 1,157,274 SQUARE FEET OR 26.57 ACRES, MORE OR LESS.

BENCHMARK

JA-74
ELEVATION: 1058.10
N: 978461.2779
E: 2809447.9650
DESCRIPTION: KC METRO ALUMINUM GRS DISK SET IN CONCRETE. THE STATION IS STAMPED JA-74, 1988, AND PROJECTS ABOUT 1 INCH

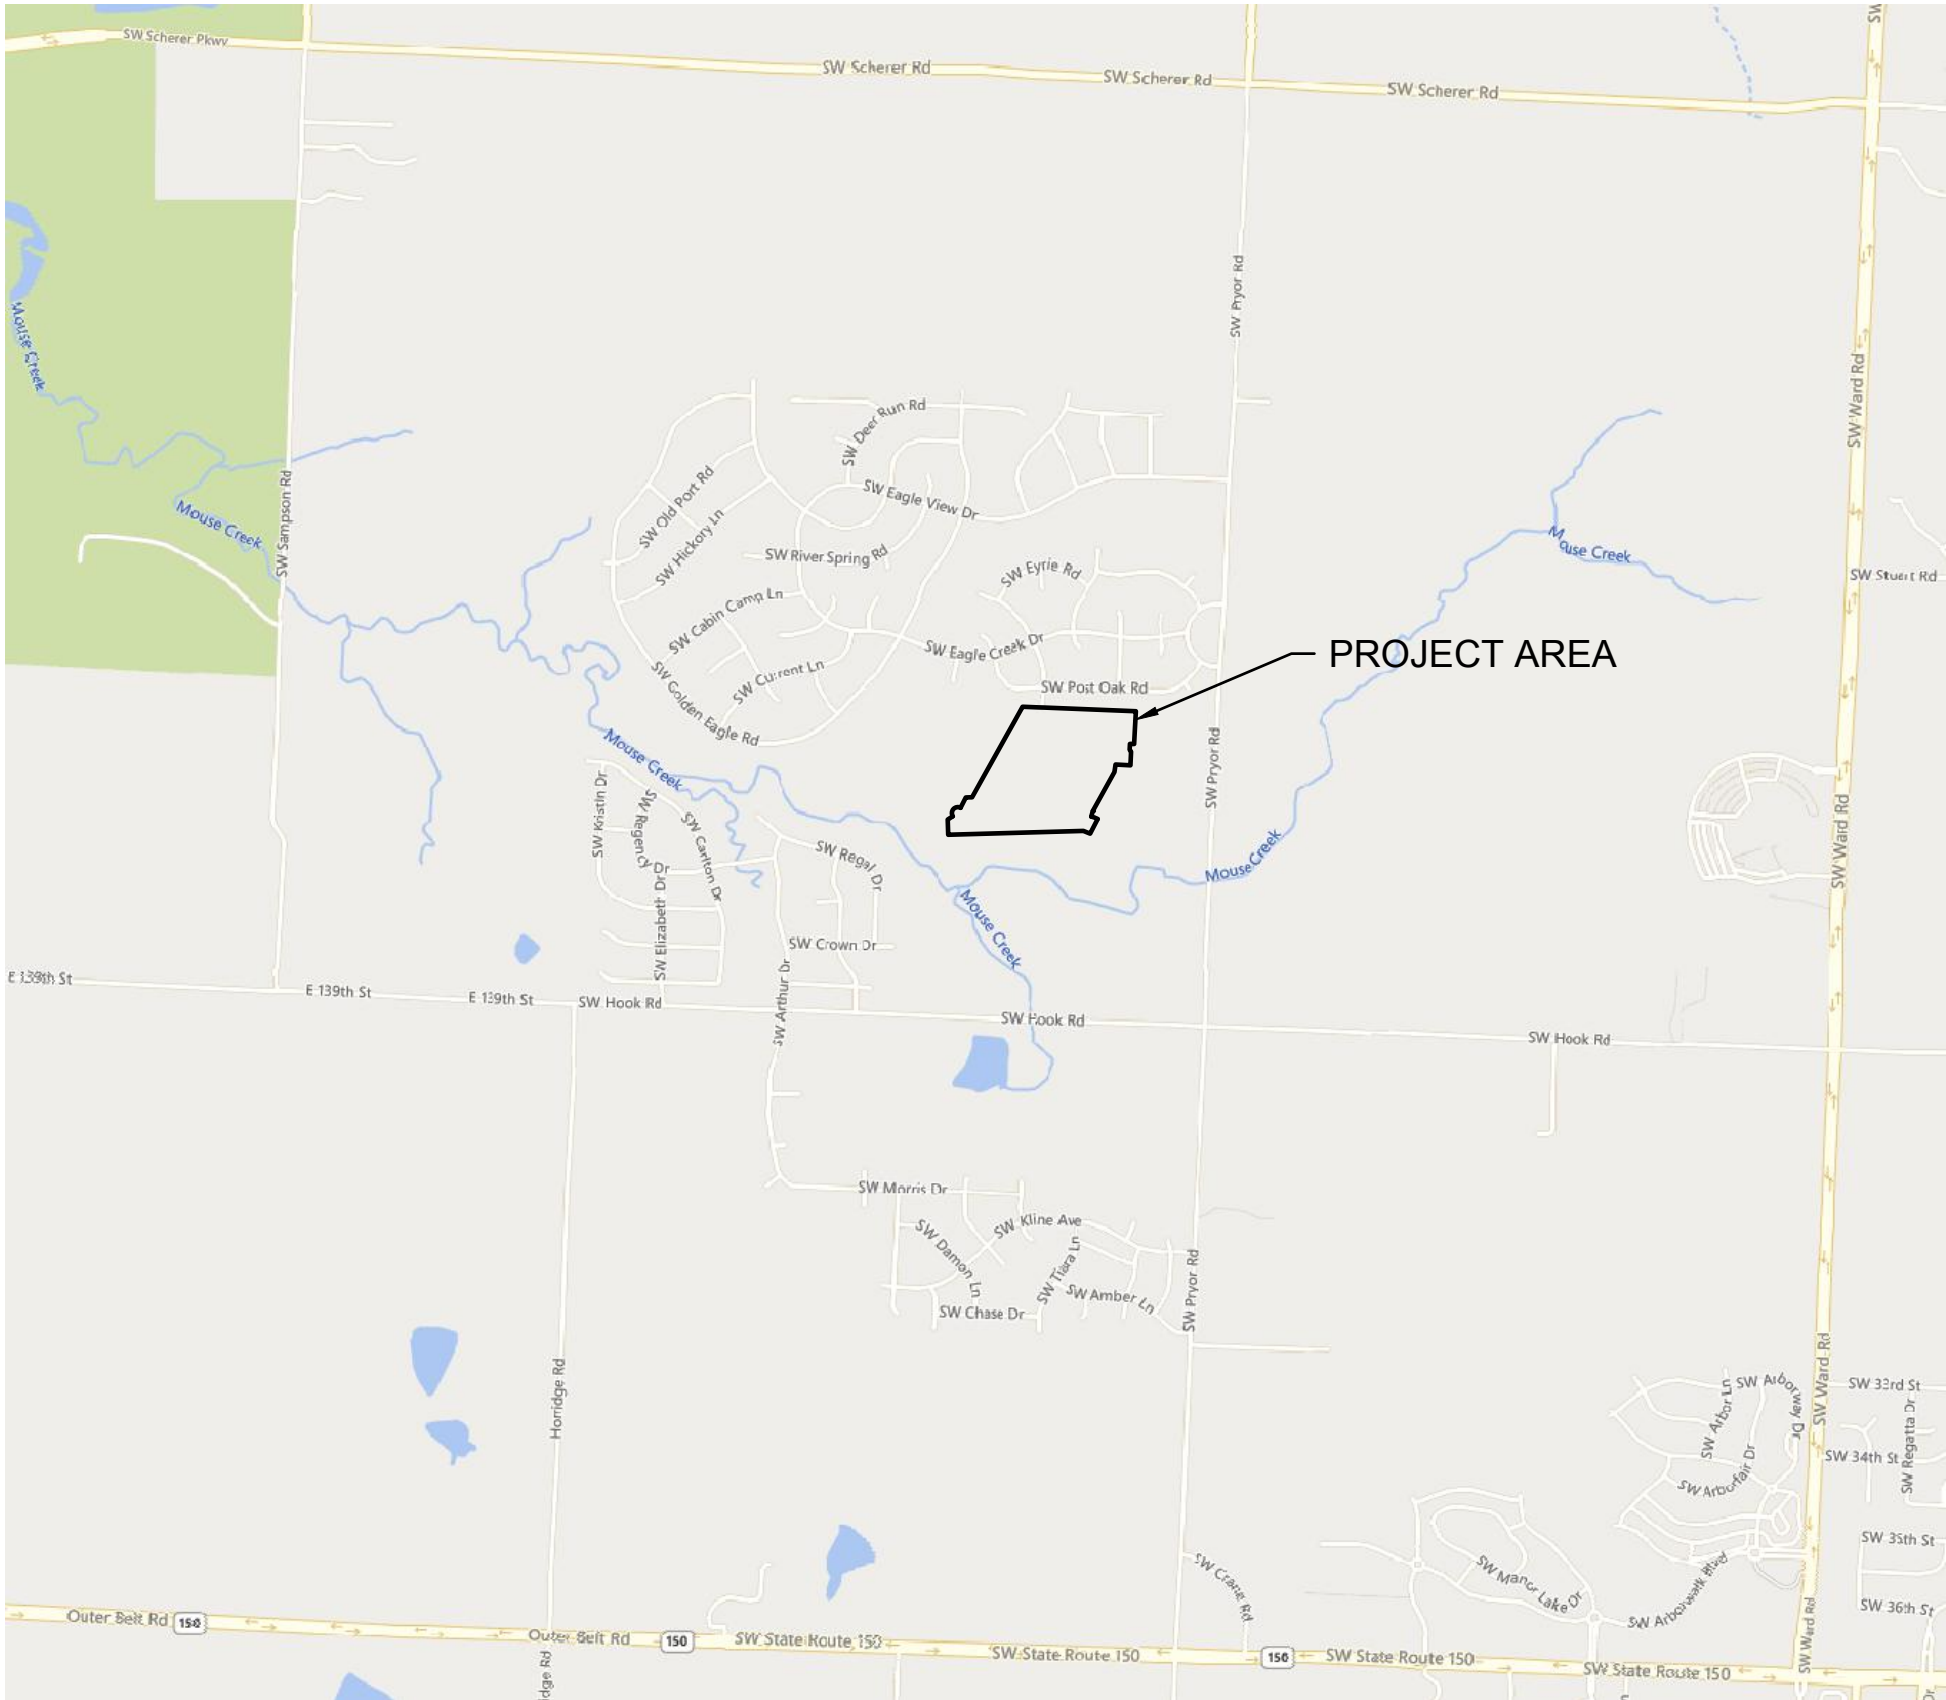

HOOK FARMS SECOND PLAT STREET & STORM SEWER PLANS

SECTION 23, TOWNSHIP 47 N, RANGE 32 W
IN LEE'S SUMMIT, JACKSON COUNTY, MO

SHEET LIST	
NUMBER	TITLE
C101	TITLE SHEET
C102	GENERAL NOTES
C103	GENERAL LAYOUT
C104	TYPICAL SECTIONS
C105	GRADING PLAN (FOR REFERENCE)
C106	GRADING PLAN (FOR REFERENCE)
C107	SWALE 1 PLAN & PROFILE
C108	SWALE 2 PLAN & PROFILE
C109	SWALE 2 PLAN & PROFILE
C110	ROADWAY PLAN & PROFILE (SW HOOK FARM DRIVE)
C111	ROADWAY PLAN & PROFILE (SW HOOK FARM DRIVE)
C112	ROADWAY PLAN & PROFILE (SW HOOK FARM DRIVE)
C113	ROADWAY PLAN & PROFILE (SW WHEATFIELD COURT)
C114	ROADWAY PLAN & PROFILE (SW WHEATFIELD COURT)
C115	ROADWAY PLAN & PROFILE (SW TRACKER LANE)
C116	ROADWAY PLAN & PROFILE (SW TRACKER LANE)
C117	ROADWAY PLAN & PROFILE (SW TRACKER LANE)
C118	ROADWAY PLAN & PROFILE (SW FARMHOUSE ROAD)
C119	ROADWAY PLAN & PROFILE (SW FIREFLY LANE)
C120	ROADWAY PLAN & PROFILE (SW FIREFLY LANE)
C121	ROADWAY PLAN & PROFILE (SW BARLEY FIELD DRIVE)
C122	ROADWAY PLAN & PROFILE (SW BARLEY FIELD DRIVE)
C123	TRAFFIC CONTROL PLAN
C124	SW TRACKER LANE & SW HOOK FARM DRIVE
C125	SW FIREFLY LANE & SW HOOK FARM DRIVE
C126	SW BARLEY FIELD DRIVE & SW HOOK FARM DRIVE
C127	SW FARMHOUSE ROAD & SW TRACKER LANE
C128	SW WHEATFIELD COURT & SW TRACKER LANE
C129	SW FIREFLY LANE & SW WHEATFIELD COURT
C130	SW BARLEY FIELD DRIVE & SW WHEATFIELD COURT
C131	SW HOOK FARM DRIVE CUL-DE-SAC
C132	STORM SEWER PLAN & PROFILE (LINE 1)
C133	STORM SEWER PLAN & PROFILE (LINE 1)
C134	STORM SEWER PLAN & PROFILE (LINE 2)
C135	STORM SEWER PLAN & PROFILE (LINE 2)
C136	STORM SEWER PLAN & PROFILE (LINES 3 & 4)
C137	STORM SEWER PLAN & PROFILE (LINES 5 & 7)
C138	STORM SEWER PLAN & PROFILE (LINE 6)
C139	STORM SEWER PLAN & PROFILE (LINE 8)
C140	STORM SEWER PLAN & PROFILE (LINE 9)
C141	STORM SEWER PLAN & PROFILE (LINE 10)
C142	STORM SEWER PLAN & PROFILE (LINES 11 & 12)
C143	WATER QUALITY BASIN PLAN
C144	MASTER DRAINAGE PLAN
C145	DRAINAGE PLAN
C146	DRAINAGE TABLES
C147	DRAINAGE TABLES
C148	DETAIL SHEET
C149	DETAIL SHEET
C150	DETAIL SHEET

OLSSON HAS BEEN RETAINED TO PROVIDE AS-BUILT DRAWINGS FOR THIS PROJECT.

Julie E. Sellers
JULIE E. SELLERS, P.E.
CIVIL ENGINEER
MO # PE-2017000367

11/28/22
DATE

AS BUILT

DATE SURVEYED: 2022-05-26
I HEREBY CERTIFY THAT THE CONDITIONS SHOWN ARE CORRECT
AND THE SEWER ARE ACCEPTABLY LOCATED WITHIN EXISTING
EASEMENTS OR RIGHT OF WAYS.

Olsson - Civil Engineering
Missouri Certificate of Authority #001592
1301 Burlington Street
North Kansas City, MO 64116
TEL 816.361.1177
FAX 816.361.1888
www.olsson.com

TITLE SHEET		STREET & STORM SEWER PLANS		HOOK FARMS SECOND PLAT		LEE'S SUMMIT, MO	
REV. NO.	DATE	REVISIONS DESCRIPTION	BY	REV. NO.	DATE	REVISIONS	2021
1	03-23-2021	REVISED PER CITY COMMENTS		1	03-23-2021		
2	04-16-2021	REVISED PER CITY COMMENTS		2	04-16-2021		
3	09-30-2021	CHANGES TO APPROVED PLANS		3	09-30-2021		

drawn by: B.M.W./A.A.
checked by: B.M.W./A.A.
designed by: J.E.S.
QA/QC by: B19-4061
project no.: 01-08-2021
date:

SHEET
C101

GENERAL NOTES

1. THE CONTRACTOR SHALL BE RESPONSIBLE FOR ENSURING THAT THE PLANS IN THEIR POSSESSION ARE THE MOST CURRENT VERSION ISSUED, ARE FULLY COORDINATED WITH ALL SUBCONTRACTORS, AND PRESENT ON SITE AT ALL TIMES. CURRENT PLANS PREPARED BY OLSSON MAY BE OBTAINED AT THE DIRECTION OF OLSSON'S CLIENT. DIRECT REQUESTS TO OLSSON MAY REQUIRE ADDITIONAL AUTHORIZATIONS, AGREEMENTS, AND/OR FEES. PLEASE CONTACT THE ENGINEER FOR INFORMATION.
2. THE CONTRACTOR SHALL BE RESPONSIBLE FOR ANY DEVIATIONS FROM THESE PLANS UNLESS WRITTEN APPROVAL FROM ENGINEER, OWNER, AND DEVELOPER.
3. ALL WORK AND MATERIALS SHALL BE SUBJECT TO INSPECTION AND APPROVAL BY THE OWNER OR THE OWNER'S REPRESENTATIVE.
4. ALL ESTIMATES OF QUANTITIES ARE FOR INFORMATIONAL PURPOSES ONLY. THE CONTRACTOR SHALL BE RESPONSIBLE FOR DETERMINING QUANTITIES AND ITEMS OF WORK.
5. THE CONTRACTOR SHALL BE RESPONSIBLE FOR PROVIDING ALL LABOR, MATERIALS, AND EQUIPMENT REQUIRED TO COMPLETE THE WORK SHOWN IN THE PLANS.
6. THE CONTRACTOR SHALL BE RESPONSIBLE FOR OBTAINING ALL REQUIRED PERMITS, PAYING ALL FEES, AND FOR OTHERWISE COMPLYING WITH ALL APPLICABLE REGULATIONS GOVERNING THE WORK.
7. THE CONTRACTOR SHALL NOT ENGAGE IN ACTIVITIES THAT MAY ENCROACH ON WATERS OF THE U.S., INCLUDING WETLANDS, UNTIL ANY NECESSARY PERMITS MAY BE OBTAINED. THE CONTRACTOR SHALL REVIEW AND COMPLY WITH ALL CONDITIONS DESCRIBED IN THE PERMIT.
8. THE CONTRACTOR SHALL BE SOLELY RESPONSIBLE FOR CONDITIONS OF THE JOB SITE, THE SAFETY OF ALL PERSONS INCLUDING VISITORS AND THE GENERAL PUBLIC, AND PROPERTY DURING PERFORMANCE OF THE WORK. THIS REQUIREMENT WILL APPLY CONTINUOUSLY THROUGHOUT THE PROJECT AND NOT BE LIMITED BY WORKING HOURS. ANY CONSTRUCTION OBSERVATION BY THE ENGINEER OF THE CONTRACTOR'S PERFORMANCE IS NOT INTENDED TO INCLUDE REVIEW OF THE ADEQUACY OF THE CONTRACTOR'S SAFETY MEASURES.
9. PRIOR TO COMMENCEMENT OF WORK THE CONTRACTOR SHALL NOTIFY AND COORDINATE WITH ALL UTILITY COMPANIES AND OBTAIN ANY RELEVANT INFORMATION. NOTIFY ENGINEER OF ANY DISCREPANCIES.
10. THE CONTRACTOR IS RESPONSIBLE FOR THE PROTECTION OF ALL BOUNDARY CORNERS AND SECTION CORNERS. ANY BOUNDARY CORNER AND/OR SECTION CORNER DISTURBED OR DAMAGED BY CONSTRUCTION ACTIVITIES SHALL BE RESET BY A LAND SURVEYOR LICENSED IN THE STATE OF MISSOURI, AT THE CONTRACTOR'S EXPENSE.
11. THE CONTRACTOR IS RESPONSIBLE FOR THE PROTECTION OF ADJACENT PROPERTIES AND SHALL TAKE ALL PRECAUTIONS NECESSARY TO PREVENT DAMAGE DURING CONSTRUCTION. THE CONTRACTOR IS ALSO RESPONSIBLE FOR REPAIRING ANY DAMAGE RESULTING FROM CONSTRUCTION ACTIVITIES.
12. PRIOR TO MOVING OFF THE JOB THE CONTRACTOR SHALL NOTIFY THE OWNER AND ENGINEER TO PERFORM A FINAL WALK-THROUGH OF THE CONSTRUCTION SITE.

REFERENCES

1. UNLESS EXPLICITLY DESCRIBED OTHERWISE WITHIN THESE PLANS THE FOLLOWING SHALL APPLY:
 - A. ALL CONSTRUCTION, INCLUDING THOSE LISTED BELOW, SHALL CONFORM TO THE LATEST CODES AND ORDINANCES OF LEE'S SUMMIT, MISSOURI.
 - B. ALL CONSTRUCTION IN MODOT RIGHT-OF-WAY SHALL CONFORM TO THE LATEST SPECIFICATIONS ADOPTED BY U.S. DEPARTMENT OF TRANSPORTATION AND MODOT.
 - C. ALL TRAFFIC CONTROL SIGNAGE SHALL CONFORM WITH THE CURRENT EDITION OF THE MANUAL FOR UNIFORM TRAFFIC CONTROL DEVICES (MUTCD).
 - D. ALL UTILITY EXTENSIONS AND CONSTRUCTION SHALL CONFORM TO THE STANDARDS AND SPECIFICATIONS OF THE UTILITY COMPANIES..
 - E. ALL EXTERIOR PAVEMENT (PCC, ASPHALT, ETC.) SHALL BE IN CONFORMANCE WITH THE SPECIFICATIONS OF LEE'S SUMMIT, MISSOURI AND THE RECOMMENDATIONS OF THE GEOTECHNICAL REPORT.
4. THE CONTRACTOR IS RESPONSIBLE FOR CONTACTING THE DELIVERY MANAGER AND COORDINATING ANY MAILBOXES THAT MAY BE DISTURBED. FAILURE TO DO SO MAY SUBJECT THE CONTRACTOR TO PROSECUTION BY THE FEDERAL GOVERNMENT.

EXISTING CONDITIONS

1. THE CONTRACTOR SHALL VISIT THE SITE AND BECOME FAMILIAR WITH THE EXISTING CONDITIONS OF THE PROJECT AREA.
2. THE CONTRACTOR SHALL BE RESPONSIBLE FOR PERFORMING THEIR OWN INVESTIGATIONS AND MAKING THEIR OWN ASSUMPTIONS REGARDING SITE SURFACE AND SUBSURFACE CONDITIONS. THIS INCLUDES THE LOCATION AND CONSISTENCY OF ANY EXISTING ROCK LAYERS UNDERLYING THE PROJECT SITE. CONTACT THE ENGINEER REGARDING ANY DISCREPANCIES THAT MAY AFFECT THE ABILITY TO CONSTRUCT FROM THESE PLANS AS DESIGNED.
3. EXISTING CONDITIONS WERE DETERMINED THROUGH A VARIETY OF METHODS THAT MAY INCLUDE SURVEY, AERIAL IMAGERY, AVAILABLE RECORDS, GIS DATA, ETC. SUBSURFACE CONDITIONS ARE APPROXIMATE AND MAY NOT INCLUDE ALL UTILITIES AND OTHER SITE IMPROVEMENTS PRESENT ON SITE. THE CONTRACTOR SHALL MAKE EXPLORATION EXCAVATIONS AND LOCATE EXISTING UNDERGROUND UTILITIES SUFFICIENTLY AHEAD OF CONSTRUCTION TO PERMIT REVISIONS TO PLANS WHEN CONFLICTS AND DISCREPANCIES ARE FOUND.

CONSTRUCTION

1. THE CONTRACTOR SHALL INSTALL TRAFFIC CONTROL WHILE WORKING IN THE PUBLIC RIGHT-OF-WAY AS SHOWN IN THESE PLANS. IF PLANS ARE NOT PROVIDED, CONTRACTOR SHALL COORDINATE AND PROVIDE CONTROLS TO THE SATISFACTION OF THE RIGHT-OF-WAY OWNER.
2. THE CONTRACTOR SHALL PROTECT ALL TREES OVER 3" CALIPER FROM DAMAGE. NO TREE SHALL BE REMOVED WITHOUT PERMISSION OF THE OWNER, UNLESS SHOWN OTHERWISE ON THESE PLANS.
3. THE CONTRACTOR SHALL DISPOSE ALL WASTE MATERIAL RESULTING FROM THE PROJECT OFF-SITE AND IN STRICT CONFORMANCE WITH ALL LOCAL CODES AND ORDINANCES.
4. ALL MANHOLES, CATCH BASINS, UTILITY VALVES AND METER PITS ARE TO BE ADJUSTED OR REBUILT TO GRADE AS REQUIRED. NOT ALL ADJUSTMENTS ARE INDICATED IN THE PLANS.
5. THE CONTRACTOR SHALL STREET SWEEP OR OTHERWISE CLEAN ALL ACCESS ROUTES TO THE SITE AT CONCLUSION OF THE PROJECT.

SHOP DRAWINGS

1. THE CONTRACTOR SHALL SUBMIT SHOP DRAWINGS A MINIMUM OF 7 DAYS PRIOR TO THE REQUESTED DATE OF APPROVAL. ENGINEER SHALL REVIEW SHOP DRAWINGS OR SAMPLES IN CONFORMANCE WITH THE DESIGN FOR THIS PROJECT AS DESCRIBED IN THE PLANS. THE CONTRACTOR SHALL BE RESPONSIBLE FOR ERRORS OR OMISSIONS IN SHOP DRAWINGS. THE ENGINEER'S REVIEW SHALL NOT EXTEND TO MEANS OR METHODS OF CONSTRUCTION. CONTRACTOR SHALL BE RESPONSIBLE FOR ANY VARIATION FROM THE REQUIREMENTS OF THE CONTRACT DOCUMENTS UNLESS CONTRACTOR HAS NOTIFIED ENGINEER OF EACH SUCH VARIATION AT THE TIME OF SUBMISSION, AND OBTAINED ENGINEER'S WRITTEN APPROVAL OF EACH SUCH VARIATION. PRIOR TO SUBMITTING EACH SHOP DRAWING OR SAMPLE, CONTRACTOR SHALL HAVE REVIEWED AND VERIFIED:
 - A. ALL FIELD MEASUREMENTS, QUANTITIES, DIMENSIONS, SPECIFIED PERFORMANCE CRITERIA, INSTALLATION REQUIREMENTS, MATERIALS, CATALOG NUMBERS AND SIMILAR INFORMATION WITH RESPECT THERETO;
 - B. ALL MATERIALS WITH RESPECT TO INTENDED USE, FABRICATION, SHIPPING, HANDLING, STORAGE, ASSEMBLY AND INSTALLATION PERTAINING TO THE PERFORMANCE OF THE WORK;
 - C. ALL INFORMATION RELATIVE TO MEANS, METHODS, TECHNIQUES, SEQUENCES AND PROCEDURES OF CONSTRUCTION AND SAFETY PRECAUTIONS AND PROGRAMS INCIDENT THERETO;
 - D. CONTRACTOR SHALL ALSO HAVE REVIEWED AND COORDINATED EACH SHOP DRAWING OR SAMPLE WITH OTHER SHOP DRAWINGS AND SAMPLES; AND WITH THE REQUIREMENTS OF THE WORK AND THE CONTRACT DOCUMENTS.
 - E. ALL SUBMITTED SHOP DRAWINGS SHALL BEAR A STAMP OR SPECIFIC WRITTEN INDICATION AND SIGNATURE THAT CONTRACTOR HAS FULLY COMPLETED THE ABOVE TASKS.
2. SHOP DRAWINGS AS DESCRIBED ABOVE ARE REQUIRED FOR, BUT NOT LIMITED TO, THE FOLLOWING:
 - A. ALL STORM SEWER STRUCTURES TO BE INSTALLED WITH THIS PROJECT.
 - B. ANY ITEMS IN THESE PLANS THAT ALLOW FOR AN "APPROVED EQUAL" ALTERNATIVE.

STORM SEWER GENERAL NOTES:

1. STORM STRUCTURES SHALL BE PER CURRENT CITY DETAILS. IF CITY DOES NOT HAVE PUBLISHED DETAILS, STRUCTURES SHALL BE PER CURRENT APWA SPECIFICATIONS.
2. PRIOR TO COMMENCEMENT OF WORK THE CONTRACTOR SHALL NOTIFY AND COORDINATE CONSTRUCTION WITH CITY OF LEE'S SUMMIT, MISSOURI.
3. ALL PIPE LENGTHS AND ELEVATIONS ARE CALCULATED LINEARLY FROM CENTER OF STRUCTURE TO CENTER OF STRUCTURE.
4. ALL STRUCTURE DIMENSIONS ARE TO INSIDE FACE OF STRUCTURE.
5. COORDINATES ARE PROVIDED AT THE CENTER OF STRUCTURE. ADDITIONAL COORDINATES PROVIDED ARE PER LOCAL CODES AND ORDINANCES OR AS AN AID WHEN ORIENTING THE BOX DURING INSTALLATION.
6. THE CONTRACTOR SHALL EXPOSE EXISTING UTILITIES AT LOCATIONS OF POSSIBLE CONFLICT AND POINTS OF CONNECTION PRIOR TO ANY CONSTRUCTION OF STORM SEWER.
7. STORM SEWER TRENCHES SHALL BE CONSTRUCTED SUCH THAT UNDISTURBED EXISTING SOIL OR FILL COMPACTED TO 95% PROCTOR DENSITY IS AT A DEPTH THAT IS 18" ABOVE TOP OF PROPOSED PIPE.
8. STRUCTURE INVERT CHANNELS SHALL BE SMOOTH, CIRCULAR, AND CONFORMING TO 1/2 THE ADJACENT PIPE SECTION (INVERT TO CENTER). CHANGES IN DIRECTION OF FLOW SHALL BE MADE WITH A SMOOTH CURVE AND MAINTAIN SHAPE THROUGHOUT. CHANGES IN GRADE OF ADJACENT PIPES SHALL BE TRANSITIONED SMOOTHLY AND EVENLY THROUGH THE STRUCTURE.
9. PIPE PENETRATIONS SHALL BE GROUTED TO ENSURE WATERTIGHT SEALS.
10. MAINTAIN MINIMUM DEPTH OF COVER PER APWA 5606.06

ESTIMATE OF QUANTITIES				
ITEM NO.	DESCRIPTION	UNIT	QUANTITY	AS-BUILT
STREET				
	EXCAVATION	C.Y.	26149	
	EMBANKMENT	C.Y.	25993	
	SUBGRADE STABILIZATION (6" FLYASH TREATMENT)	S.Y.	15049	
	6" ASPHALT PAVEMENT	S.Y.	12232	
	CONCRETE CURB & GUTTER (CG-2)	L.F.	8300	
	CONCRETE CURB & GUTTER (CG-2 DRY)	L.F.	166	
	5' CONCRETE SIDEWALK	L.F.	16.50	
	MILL & OVERLAY	S.Y.	40	
	ADA RAMP	EA.	15	
	STOP SIGNS	EA.	7	
	STREET NAME SIGNS	EA.	14	
	END OF ROAD TREATMENT	EA.	1	
STORM				
	STD. CURB INLET (5'x3' INSIDE)	EA.	21	21
	STD. CURB INLET (5'x4' INSIDE)	EA.	2	2
	STD. CURB INLET (5'x5' INSIDE)	EA.	2	2
	STD. CURB INLET (8'x3' INSIDE)	EA.	2	2
	STD. STORM MANHOLE (4' DIA. INSIDE)	EA.	1	1
	STD. STORM MANHOLE (5' DIA. INSIDE)	EA.	1	1
	STD. FIELD INLET (4'x4' INSIDE)	EA.	7	7
	WATER QUALITY BASIN OUTLET STRUCTURE	EA.	1	1
	12" PVC	L.F.	168.41	
	15" HDPE	L.F.	1992.05	1759.36+
	18" HDPE	L.F.	477.24	324.77+
	24" HDPE	L.F.	945.56	942.83
	30" HDPE	L.F.	216.94	217.86
	36" HDPE	L.F.	549.76	547.53
	12" HDPE END SECTION	EA.	1	1
	15" HDPE END SECTION	EA.	1	1
	18" HDPE END SECTION	EA.	1	1
	24" HDPE END SECTION	EA.	1	1
	36" HDPE END SECTION	EA.	1	1
	RIPRAP	S.Y.	85.3	64.67
	CONNECTION TO EXISTING PIPE	EA.	2	2


SUMMARY OF QUANTITIES AS INDICATED ABOVE AND ANY QUANTITIES AS SHOWN WITHIN THE PLANS HAVE BEEN PROVIDED FOR PERMITTING PURPOSES ONLY AND ARE NOT INTENDED FOR USE IN PREPARATION OF CONTRACT DOCUMENTS. QUANTITIES INTENDED FOR, BUT NOT LIMITED TO, THE PREPARATION OF PROPOSALS AND BID DOCUMENTS SHALL BE INDEPENDENTLY EVALUATED BY THE ESTIMATING PARTY BASED UPON THE CONTENTS OF THESE PLANS.

AS BUILT

DATE SURVEYED: 2022-05-26

[illegible]

DWG: F:\2011
DATE: Oct 11

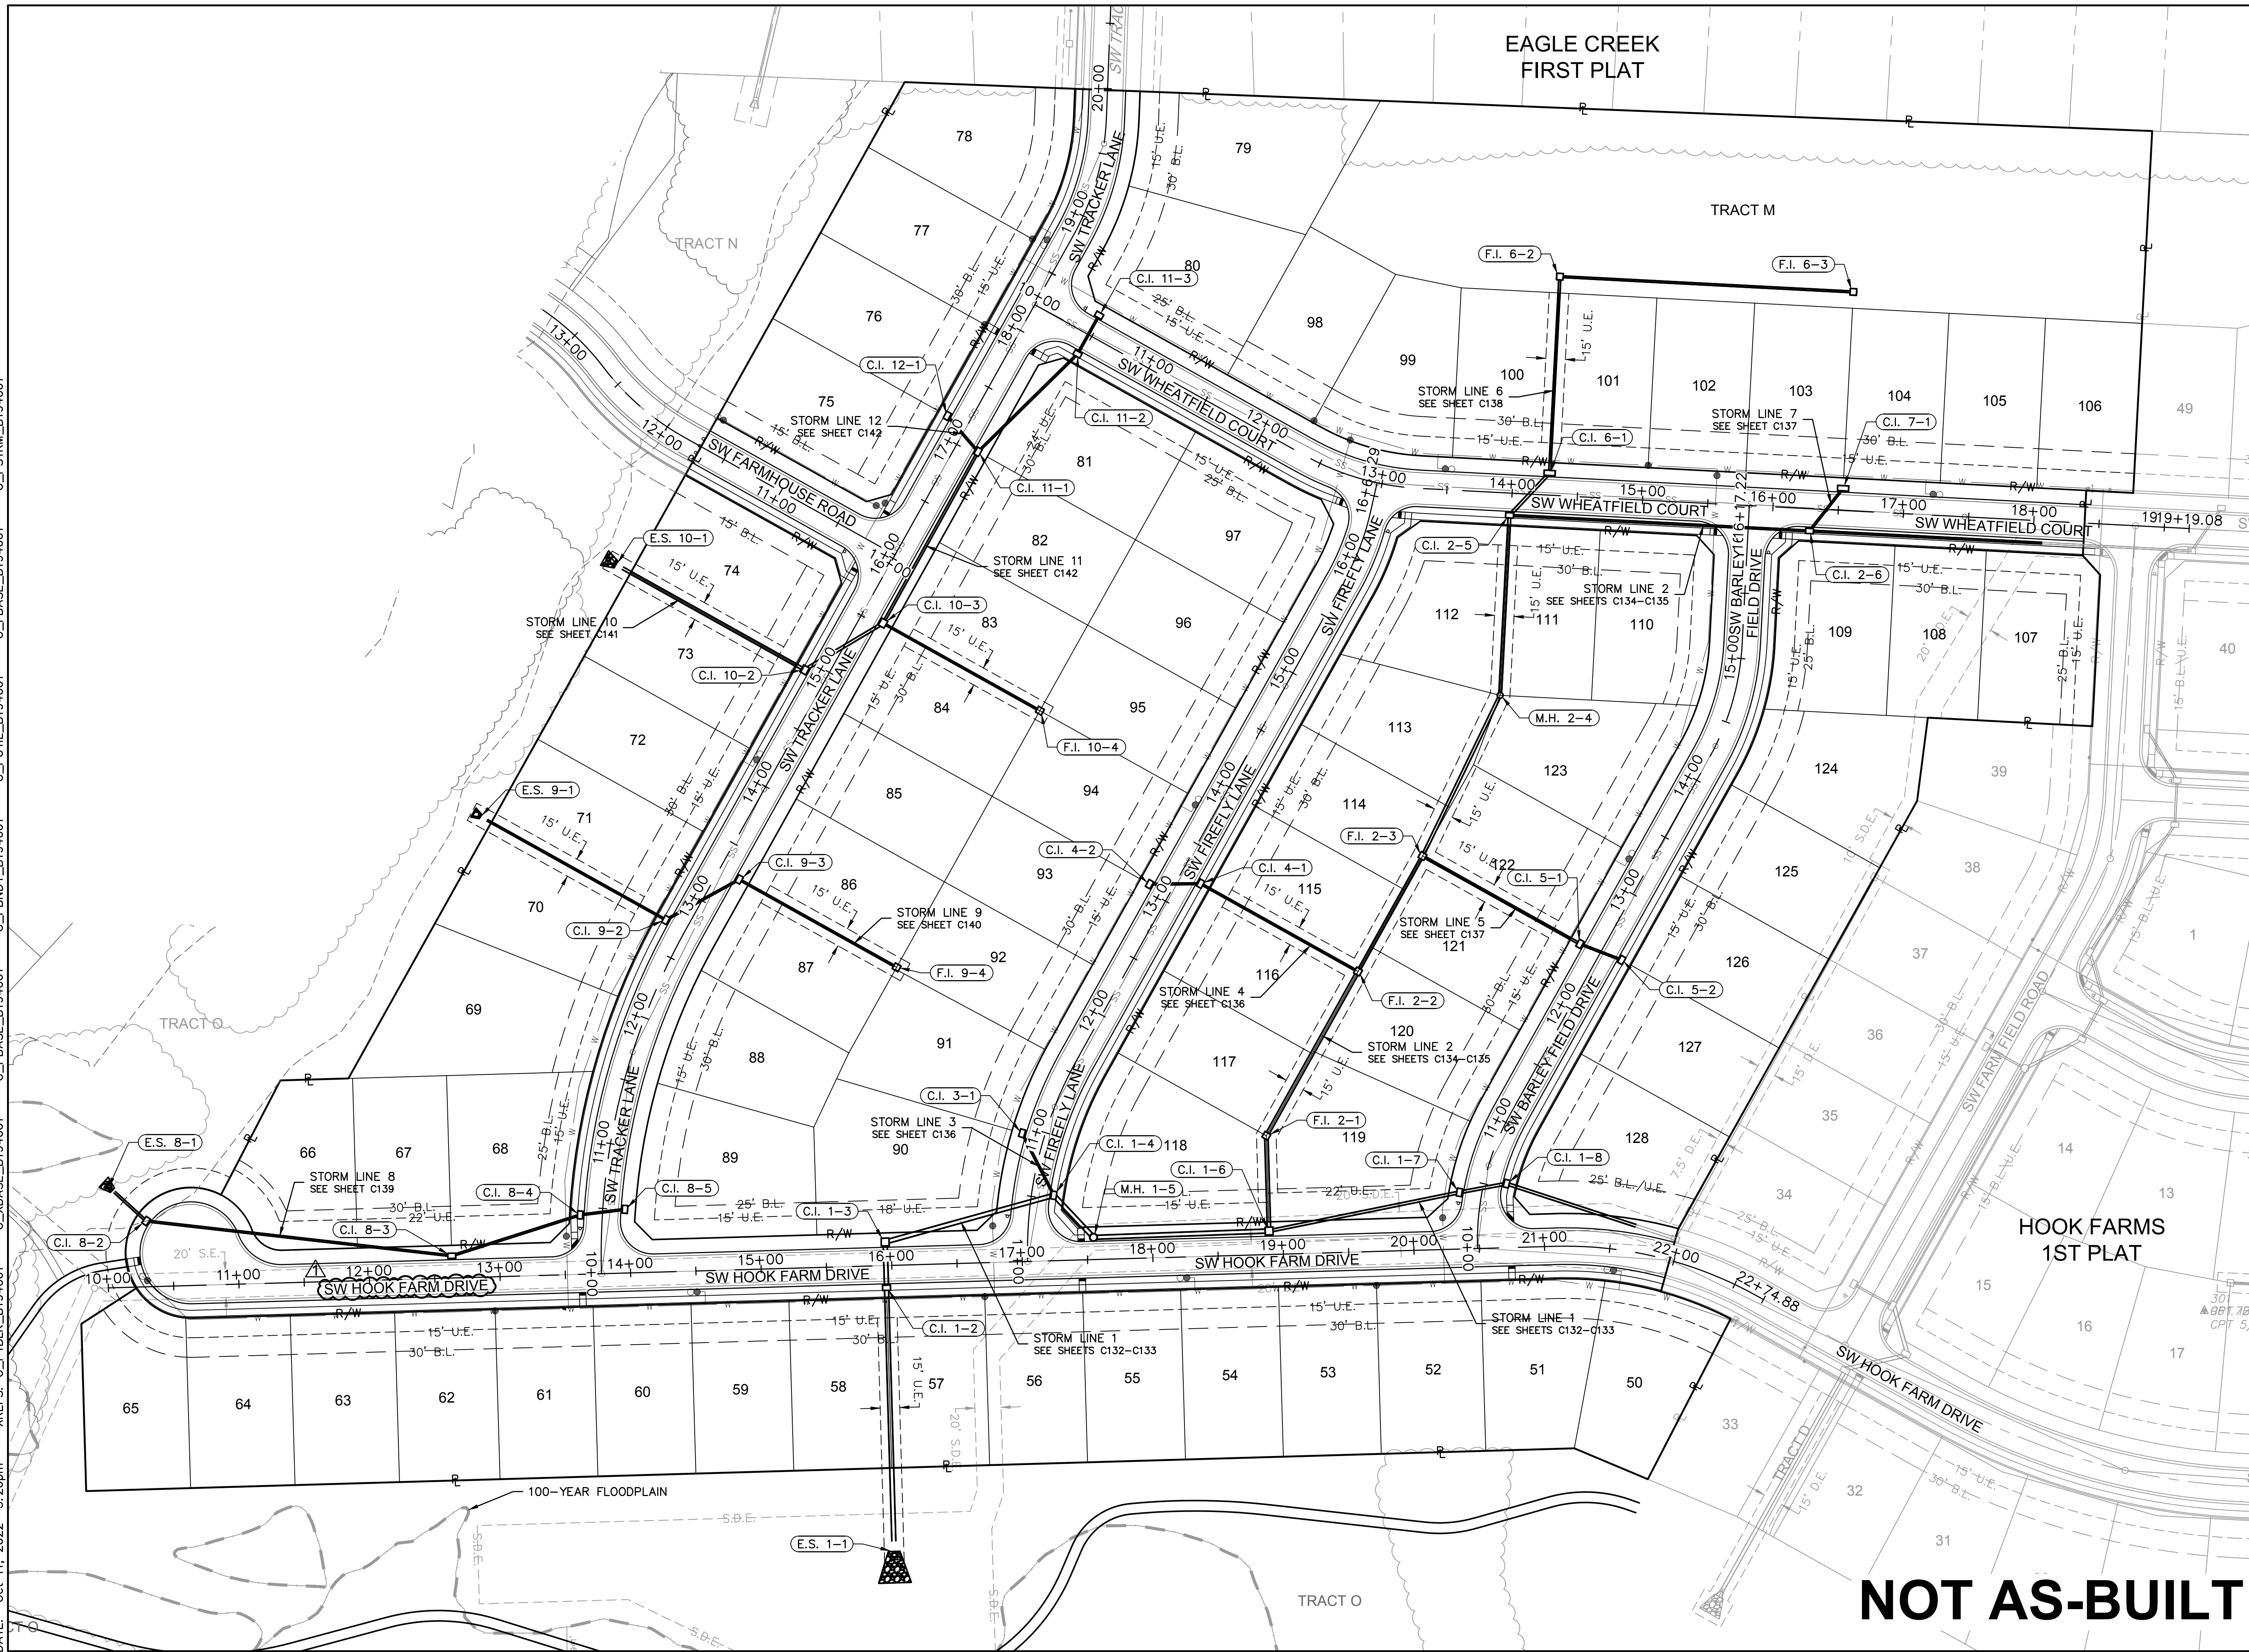

NOT AS-BUILT

GENERAL LAYOUT STREET & STORM SEWER PLANS


HOOK FARMS
SECOND PLAT

LEE'S SUMMIT. MO.

2021

REV. NO.	DATE	REVISIONS DESCRIPTION	BY
1	03-23-2021	REVISED PER CITY COMMENTS	
2	04-16-2021	REVISED PER CITY COMMENTS	
3	09-30-2021	CHANGES TO APPROVED PLANS	

REVISIONS

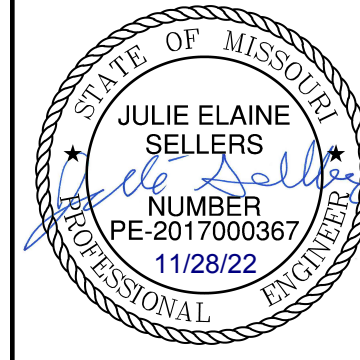


Olsson - Civil Engineering
Missouri Certificate of Authority #001592
1301 Burlington Street
North Kansas City, MO 64116
TEL 816.361.1177
FAX 816.361.1888
www.olsson.com

olsson


61-B\40-Design\AutoCAD\Asbuilt\Sheets\GNV\Street & Storm Plans\C_TYP01_B194061.dwg
XREFS: C_PTBK_B194061

NOT AS-BUILT

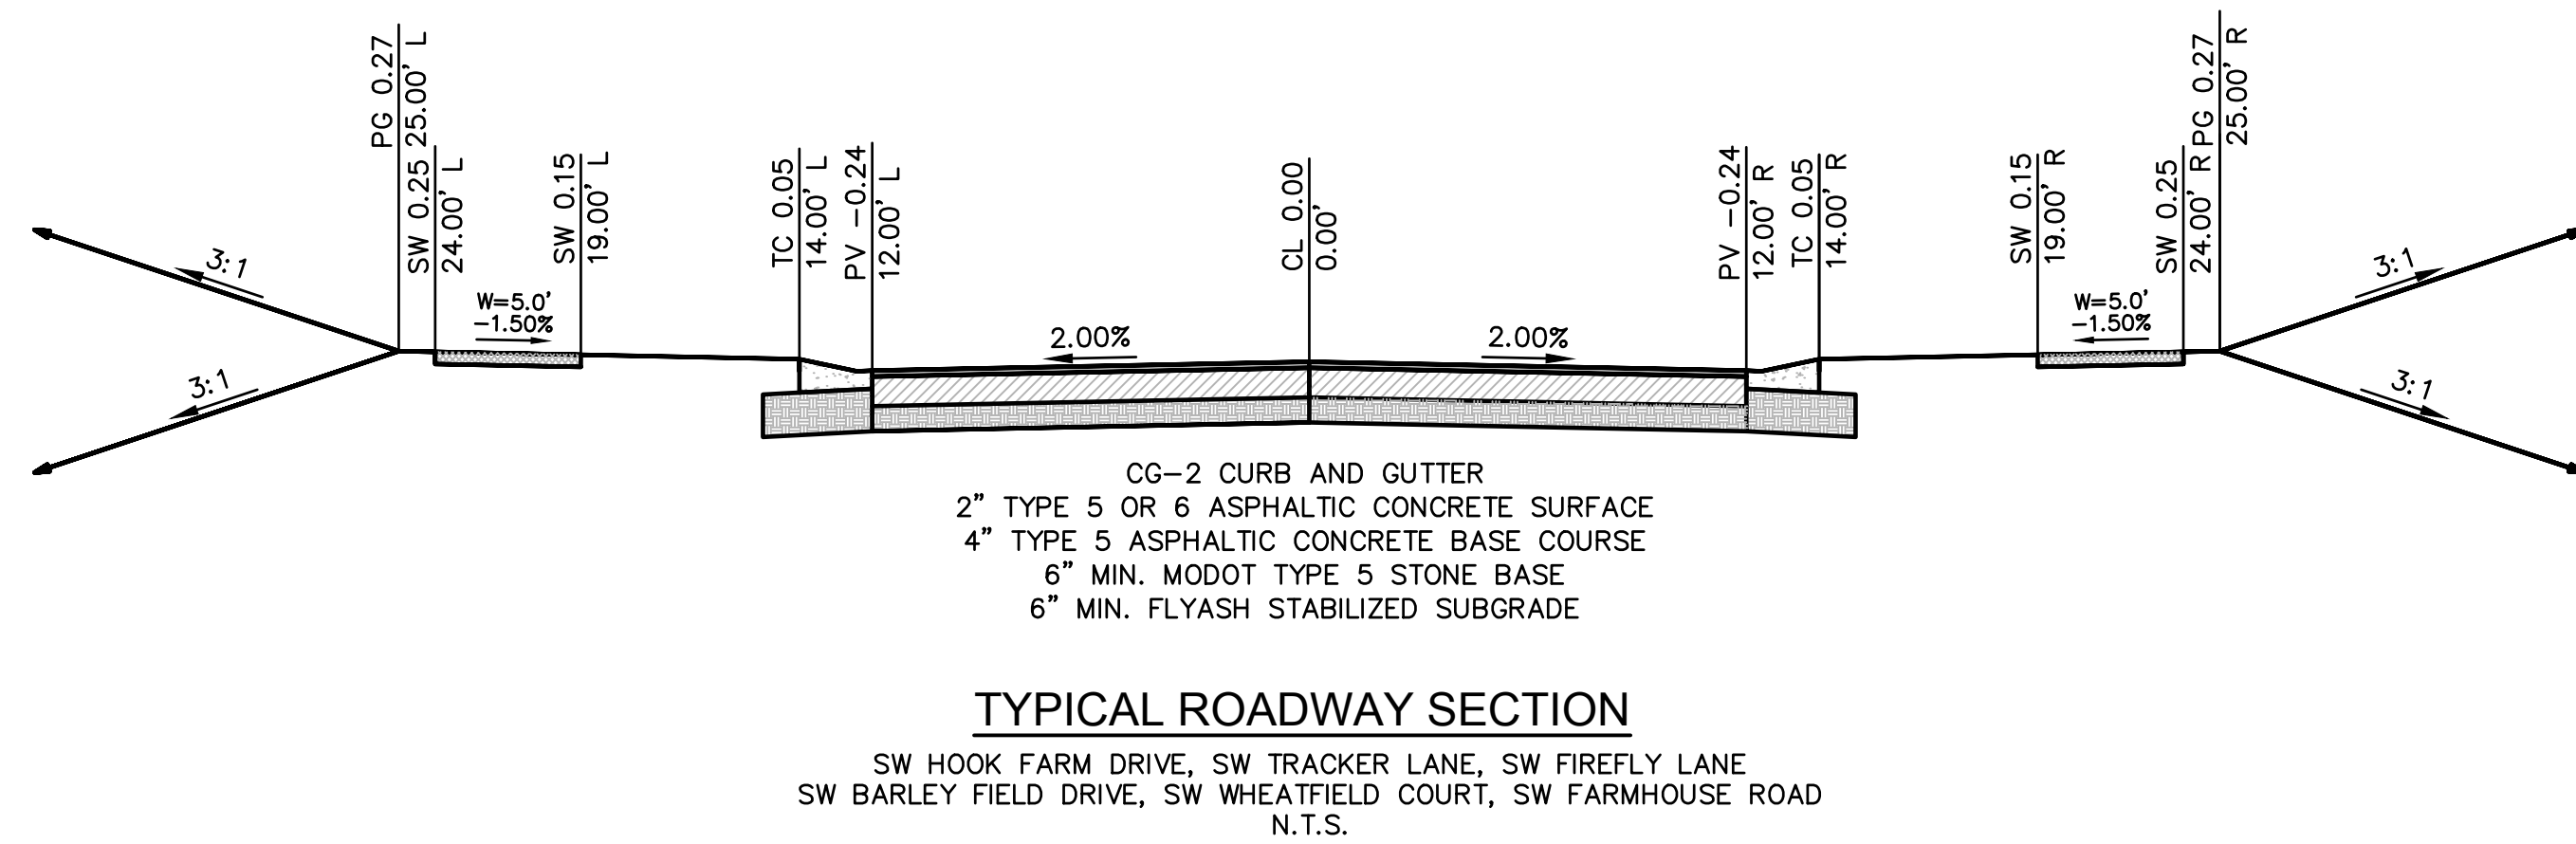

drawn by: B.M.W./A.A.
checked by: B.M.W.
designed by: B.M.W./A.A.
QA/QC by: J.E.S.
project no.: B19-4061
date: 01-08-2021

SHEET
C104

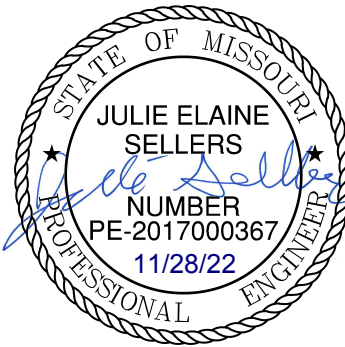[illegible]

Olsson - Civil Engineering
Missouri Certificate of Authority #001592
1301 Burlington Street
North Kansas City, MO 64116
TEL 816.361.1177
FAX 816.361.1888
www.olsson.com

oslo


GENERAL NOTES:

1. CONTRACTOR SHALL ADHERE TO THE "DESIGN AND CONSTRUCTION MANUAL" SECTION 2100 AS ADOPTED BY THE CITY OF LEE'S SUMMIT (LATEST EDITION), FOR EXCAVATION AND EMBANKMENT WORK WITHIN THE PROPOSED RIGHT-OF-WAY.
2. AREAS OF CONSTRUCTION SHALL BE STRIPPED OF ALL VEGETATION, ORGANIC MATTER AND TOPSOIL TO A DEPTH AS RECOMMENDED BY GEOTECHNICAL ENGINEER AND OR TESTING AGENCY. SOILS REMOVED DURING SITE STRIPPING SHOULD BE EVALUATED TO DETERMINE IF PORTIONS OF THE TOPSOIL STRATUM MAY BE UTILIZED AS STRUCTURAL FILL WITHIN PAVEMENT AREAS. ANY MATERIAL NOT DEEMED AS SUITABLE FILL MATERIAL BY THE GEOTECHNICAL ENGINEER AND OR TESTING AGENCY SHALL BE REMOVED FROM THE JOB SITE BY THE CONTRACTOR AT HIS EXPENSE.
3. ALL EMBANKMENT OUTSIDE OF RIGHT-OF-WAY SHOULD BE PLACED IN CONTROLLED LIFTS HAVING A MAXIMUM LOOSE LIFT THICKNESS OF 8". EMBANKMENT SHOULD BE COMPACTED TO A MINIMUM OF 95% OF THE MATERIALS MAXIMUM DRY DENSITY AS DETERMINED BY ASTM D-698 (STANDARD PROCTOR COMPACTION). MOISTURE CONTENT OF THE FILL AT THE TIME OF COMPACTION SHALL BE WITHIN A RANGE OF -0 TO +4 PERCENT OF OPTIMUM MOISTURE CONTENT.

EARTHWORK QUANTITIES		
LOCATION	CUT (C.Y.)	FILL (C.Y.)
STREET	26,149	25,993
SITE	117,707	77,137
FUTURE PHASE	0	54,547
TOTAL	143,856	157,677

EARTHWORK QUANTITIES NOTES:

1. EARTHWORK QUANTITIES BASED ON FINISHED GRADE SURFACE AND DO NOT INCLUDE ADJUSTMENTS FOR TOPSOIL AND SHRINKAGE.
2. EARTHWORK QUANTITIES DO NOT TAKE INTO CONSIDERATION EXCAVATION, REMOVAL AND DISPOSAL OF MATERIAL DEEMED UNSUITABLE BY A GEOTECHNICAL ENGINEER. THE EARTHWORK CONTRACTOR IS RESPONSIBLE FOR EXCAVATION, REMOVAL AND DISPOSAL OF UNSUITABLE MATERIAL AND FOR REPLACING IT WITH SUITABLE MATERIAL.

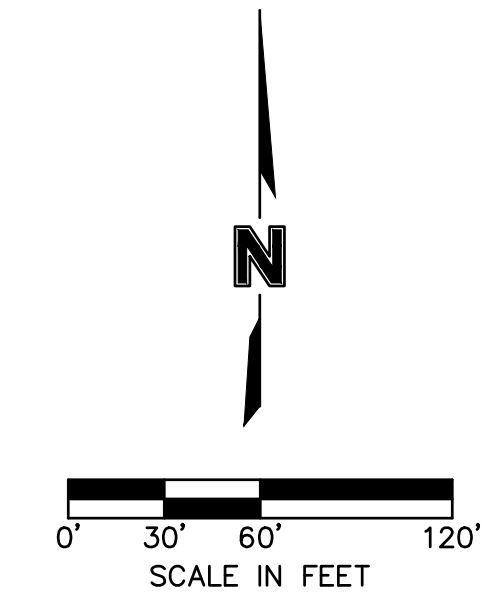

**NOT AS-BUILT SURFACE
REFER TO MASTER
DRAINAGE PLAN**

LEGEND	
-100-	EXISTING INDEX CONTOURS
-100-	EXISTING INTERMEDIATE CONTOURS
-100-	PROPOSED INDEX CONTOURS
-100-	PROPOSED INTERMEDIATE CONTOURS


GRADING PLAN (FOR REFERENCE)
STREET & STORM SEWER PLANS

HOOK FARMS
SECOND PLAT

LEE'S SUMMIT, MO

drawn by: B.M.W./A.A.
checked by: B.M.W./A.A.
designed by: B.M.W./A.A.
QA/QC by: J.E.S.
project no.: B19-4061
date: 01-08-2021

SHEET
C105

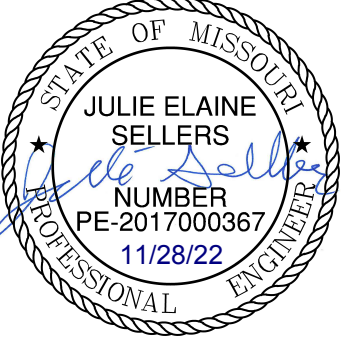

REV. NO.	DATE	REVISIONS DESCRIPTION
1	03-23-2021	REVISED PER CITY COMMENTS
2	04-16-2021	REVISED PER CITY COMMENTS
3	09-30-2021	CHANGES TO APPROVED PLANS

REVISIONS


olsson

Olsson - Civil Engineering
Missouri Certificate of Authority #001592
1301 Burlington Street
North Kansas City, MO 64116
TEL 816.361.1177
FAX 816.361.1888
www.olsson.com

X Indicates condition applies to lot

0' 30' 60' 120'
SCALE IN FEET

N

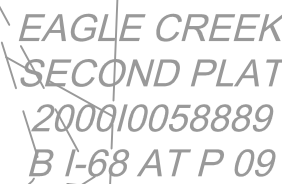

FL In (E) = 947.09 8" PVC
FL Out (W) = 946.64 8" PVC

LEE'S SUMMIT, MO.



Olsson - Civil Engineering
Missouri Certificate of Authority #001592
1301 Burlington Street
North Kansas City, MO 64116

REVISIONS

DWG: F:\2019\4001-4500\019-4061-B\40-Design\AutoCAD\Asbuilt\Sheets\GNCV\Street & Storm Plans\C_SWL01_B194061.dwg
XREFS: C:\PTBLK_B194061 C:\PBASE_B194061 C:\PBDY_B194061
DATE: Oct 11, 2022 3:28pm

Section	Drainage Area	C	Tc	i	K	Peak Flow
	(ac.)		(min)	(in/hr)		(cfs)
A-A	0.89	0.51	11	8.06	1.25	4.56
B-B	0.49	0.51	12	5.73	2.25	3.21
C-C	0.86	0.51	5	8.77	1.25	4.52

	Mannings	Channel	Swale	Left Side	Right Side	Bottom	Discharge	Water	Flow Area	Velocity	Wetted	Top Width	Specific	Shear Stress
SECTION	Coefficient	Slope (%)	Depth (ft)	Slope (H:V)	Slope (H:V)	Width (ft)	(cfs)	Depth (ft)	(ft ²)	(ft/sec)	Perimeter (ft)	(ft)	Energy (ft)	(lbs/ft ³)
A-A	0.03	2.10%	1.29	3:1	3:1	5.00	4.56	0.29	1.70	2.68	6.83	6.74	0.40	0.33
B-B	0.03	2.10%	1.23	3:1	3:1	5.00	3.21	0.23	1.31	2.45	6.45	6.38	0.32	0.27
C-C	0.03	2.10%	1.18	3:1	3:1	5.00	4.53	0.28	1.64	2.76	6.77	6.68	0.40	0.33

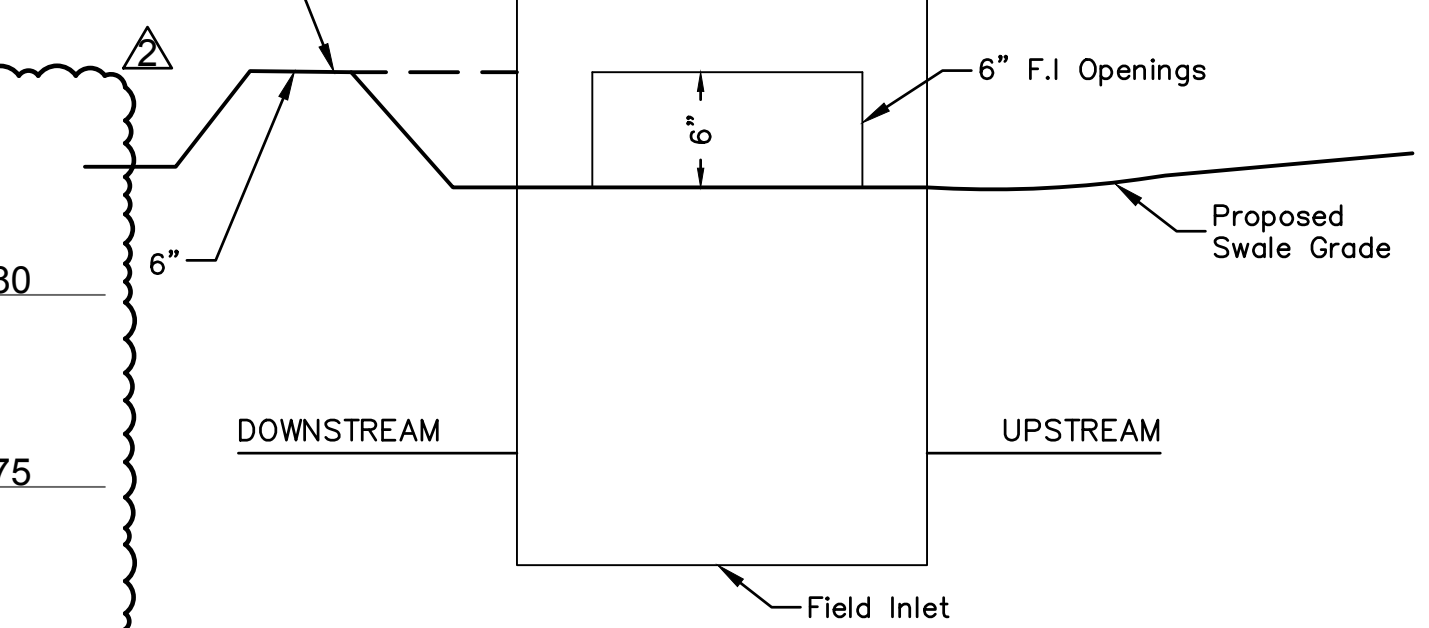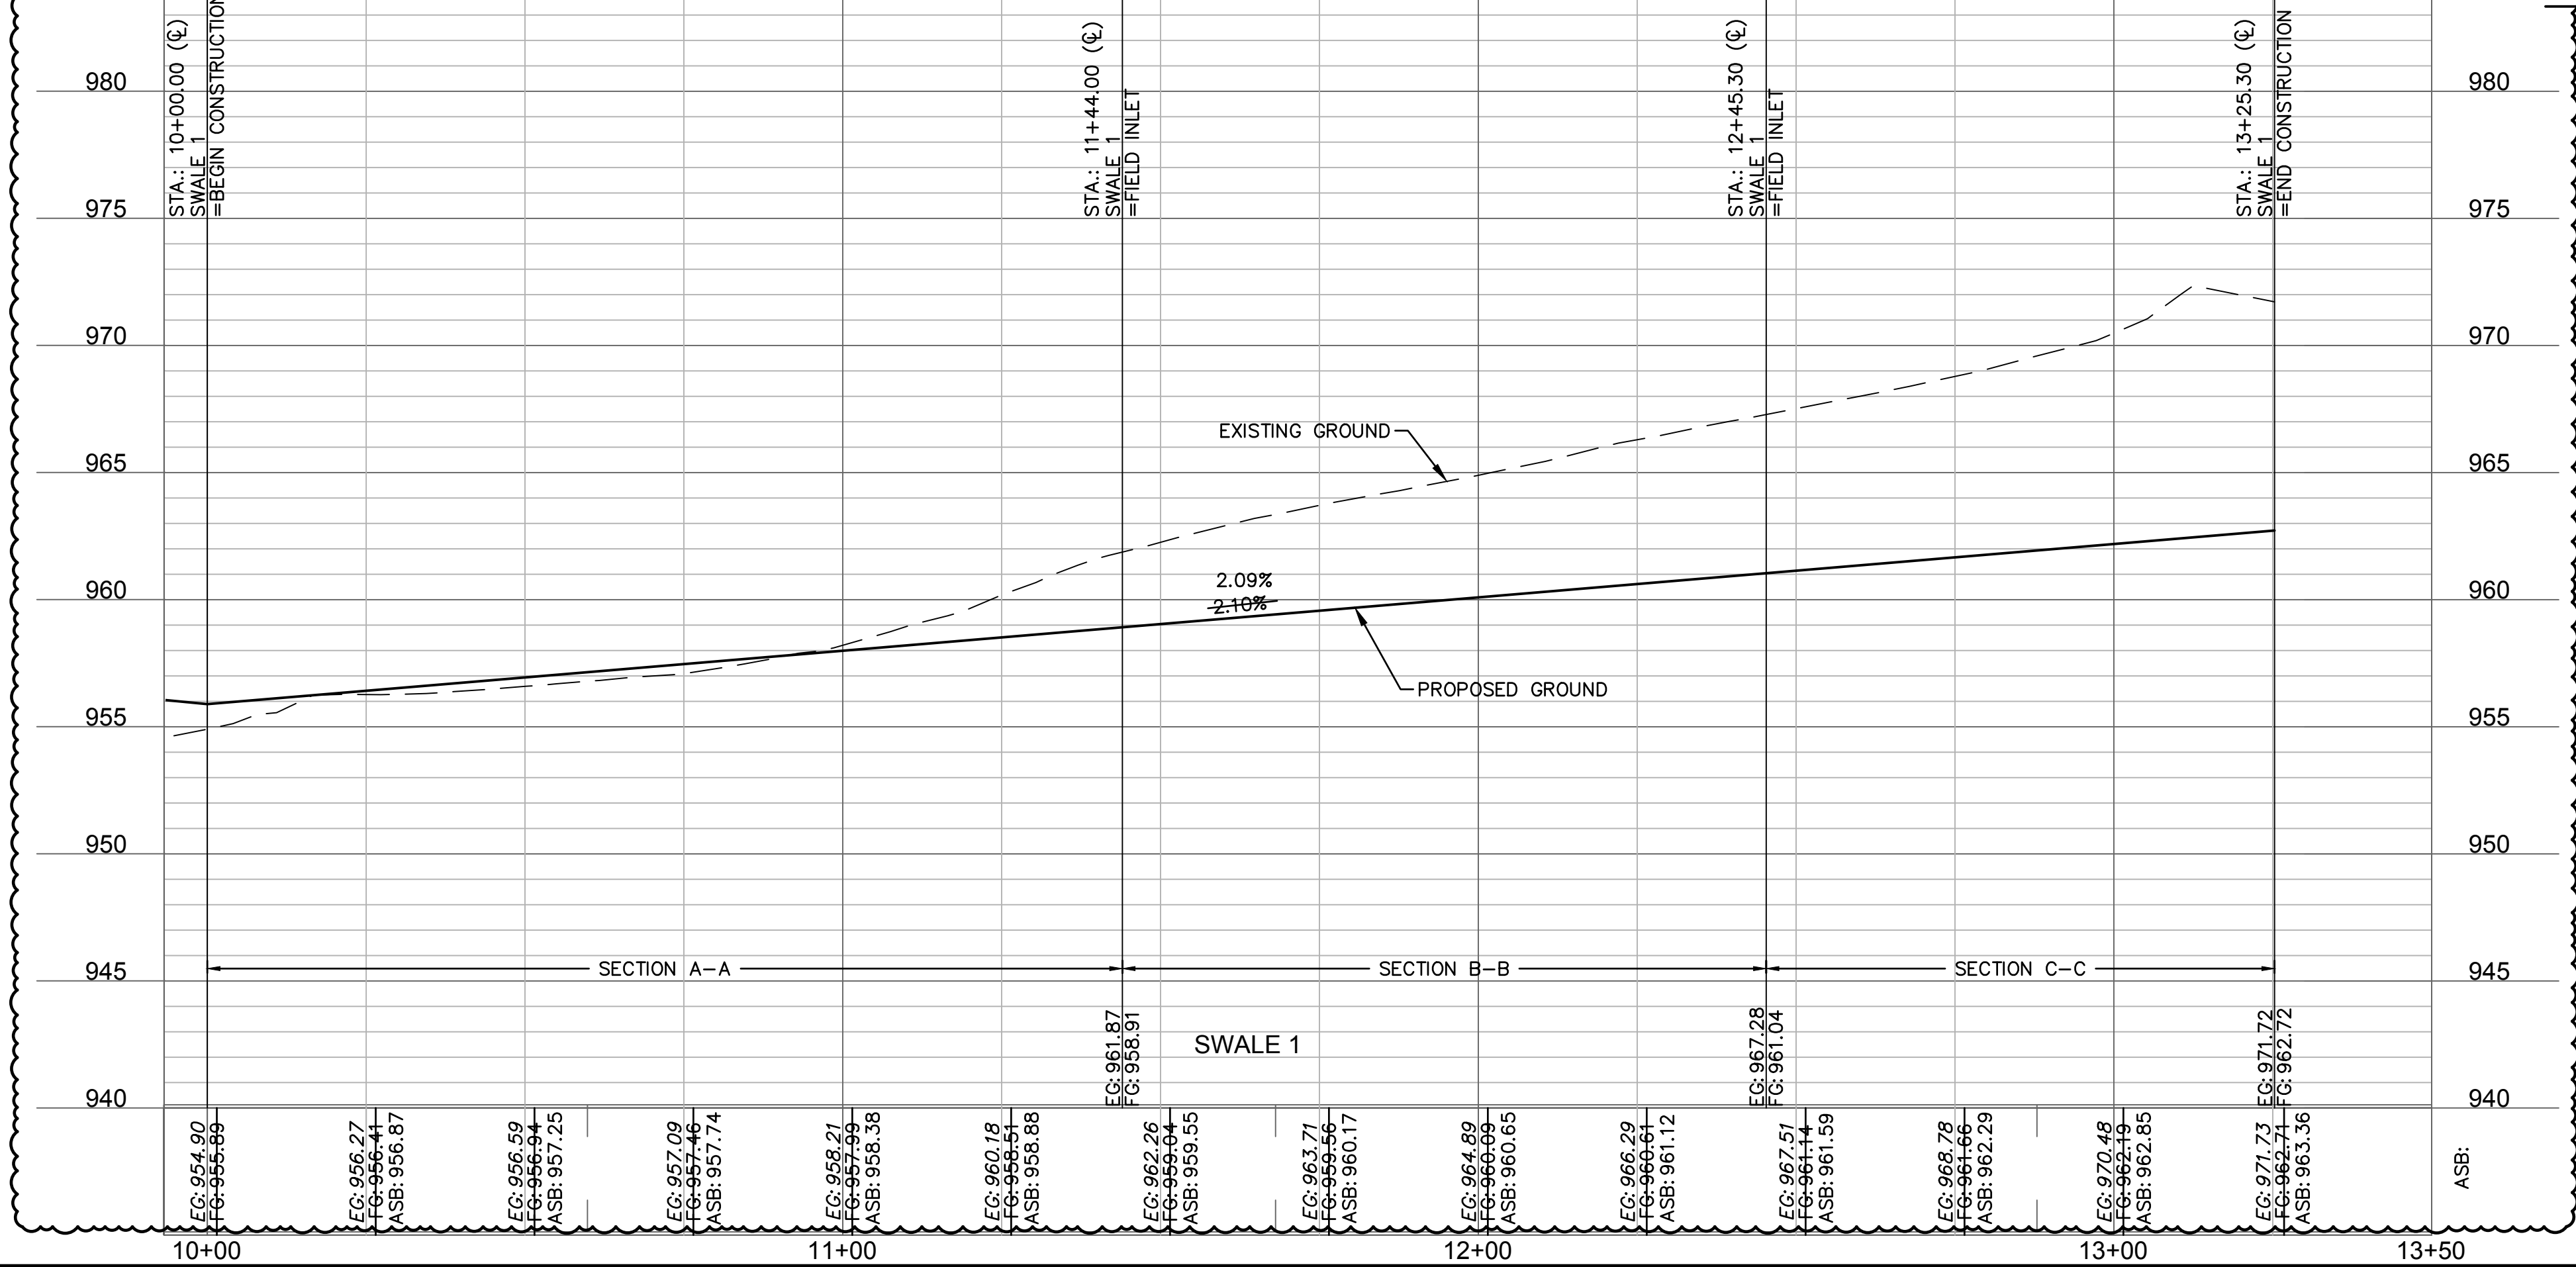


NOTE: INCLUDE SUMP PER ABOVE DETAIL WHERE
FIELD INLETS ARE LOCATED WITHIN SWALES.

SUMP DETAIL
N.T.S.

AS BUILT

DATE SURVEYED: 2022-05-26

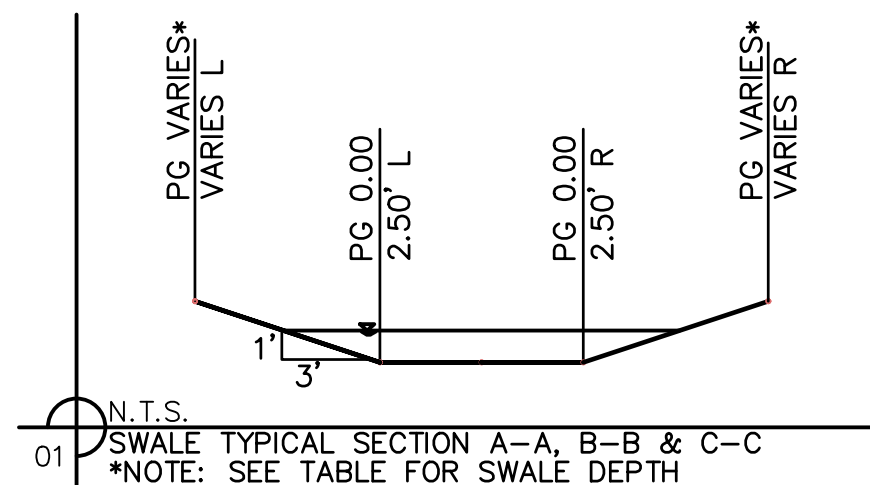

01 SWALE TYPICAL SECTION A-A, B-B & C-C
*NOTE: SEE TABLE FOR SWALE DEPTH

SWALE GRADING NOTES:

1. CONTRACTOR SHALL CONSTRUCT SWALES WITH MINIMUM SLOPE, WIDTH AND DEPTH AS SHOWN IN THE SWALE DESIGN TABLES.
2. AS-BUILT SURVEY IS REQUIRED/APPROVED BY CITY FOR ALL SWALES AND PRIOR TO APPROVAL FOR ANY BUILDING FOUNDATION PERMIT. CONTRACTOR SHALL BE REQUIRED TO UPGRADE SWALES AT CONTRACTOR'S EXPENSE IF ABOVE REQUIREMENTS ARE NOT MET.

olsson

Olsson - Civil Engineering
Missouri Certificate of Authority #001592
1301 Burlington Street
North Kansas City, MO 64116
TEL 816.361.1177
FAX 816.361.1888
www.olsson.com

[illegible]

REVISIONS


SWALE 1 PLAN & PROFILE
STREET & STORM SEWER PLANS

HOOK FARMS
SECOND PLAT





LEE'S SUMMIT, MO.

drawn by: B.M.W./A.A.
checked by: B.M.W.
designed by: B.M.W./A.A.
QA/QC by: J.E.S.
project no.: B19-4061
date: 01-08-2021

SHEET
C107

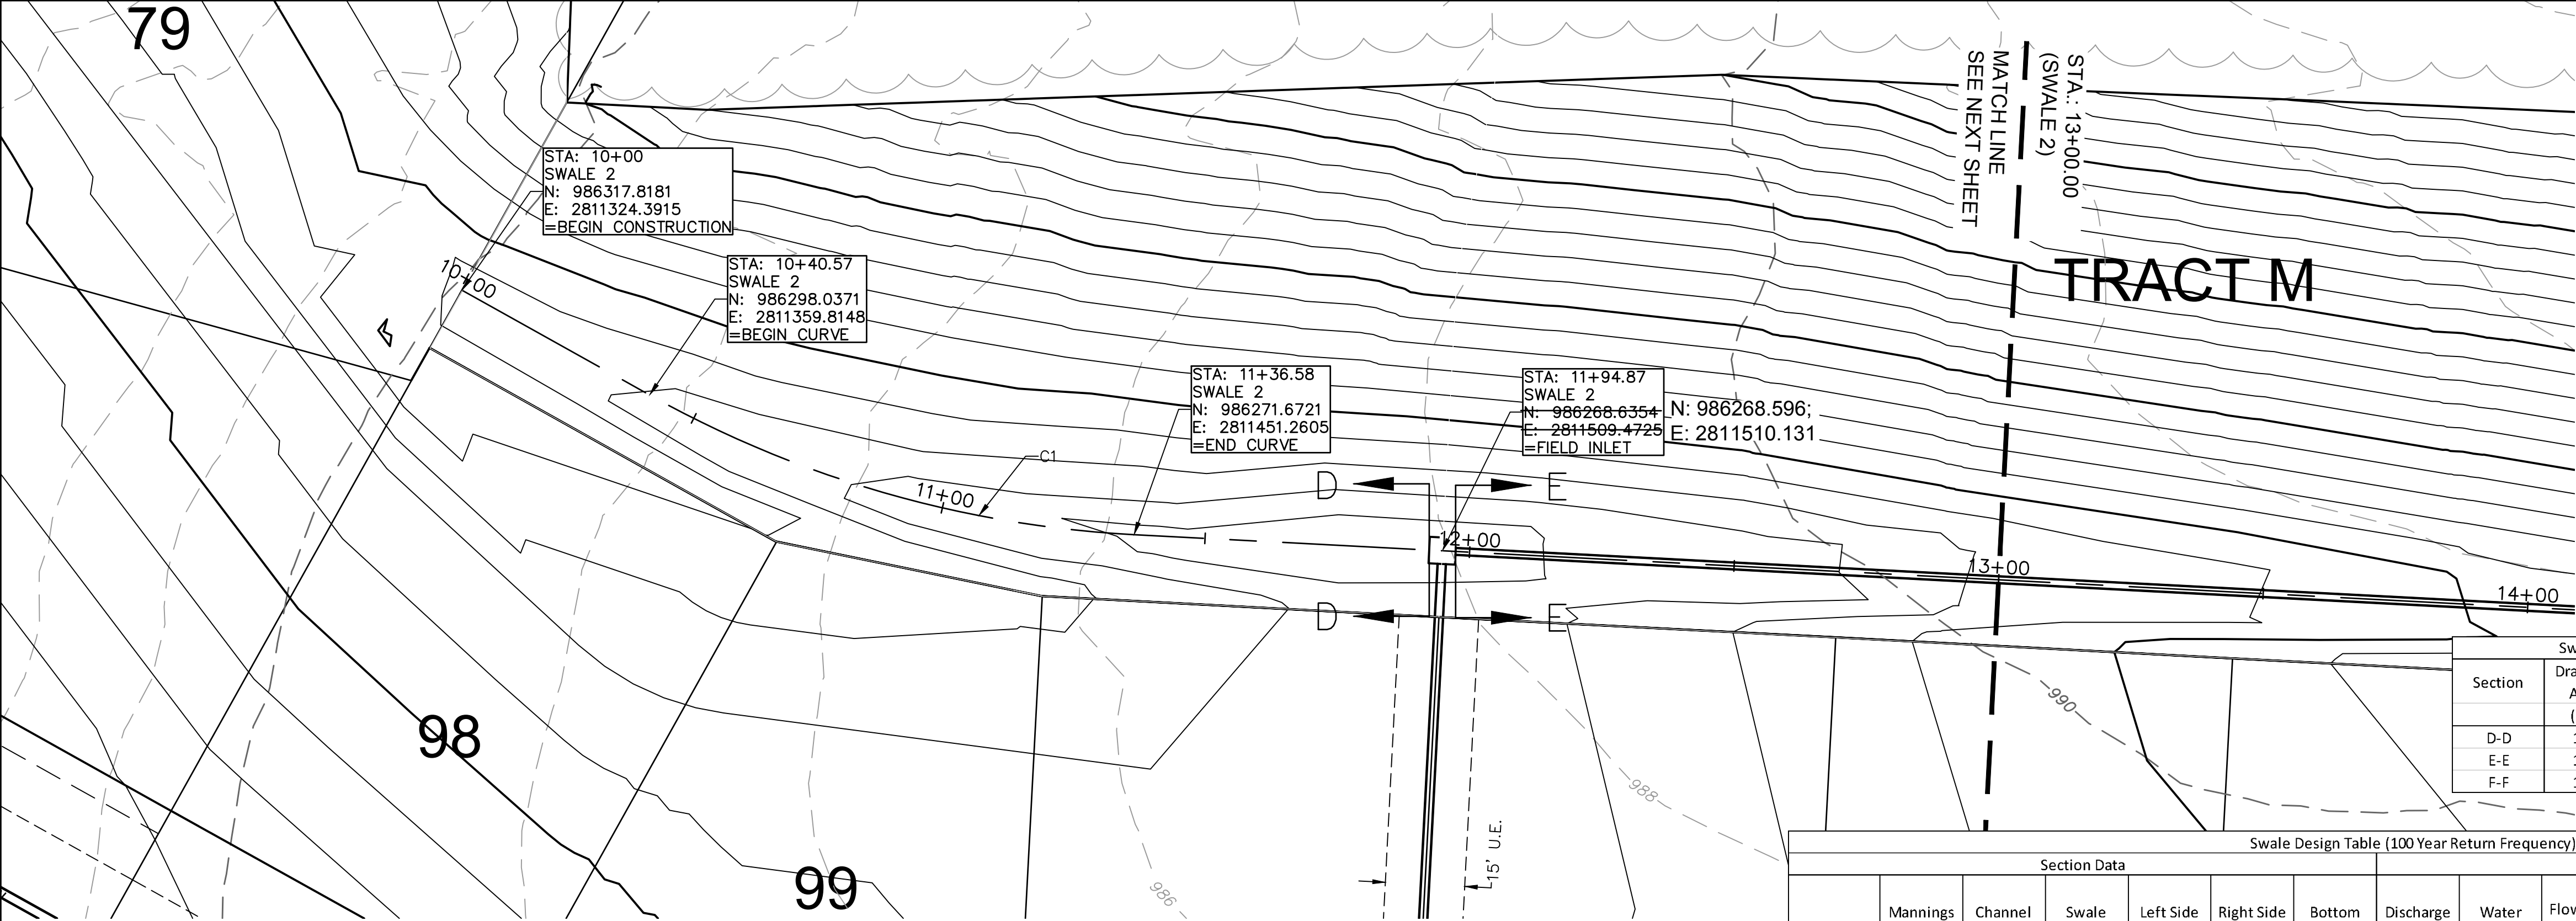

ALIGNMENT CURVES								
CURVE ID #	STATION RANGE	START COORD.	END COORD.	RADIUS (FT)	LENGTH (FT)	DELTA	CHORD BEARING	CHORD LENGTH (FT)
C1	10+40.57 11+36.58	N: 986298.04 E: 2811359.81	N: 986271.67 E: 2811451.26	210.00	96.00	026°11'37"	S73°55'01"E	95.17

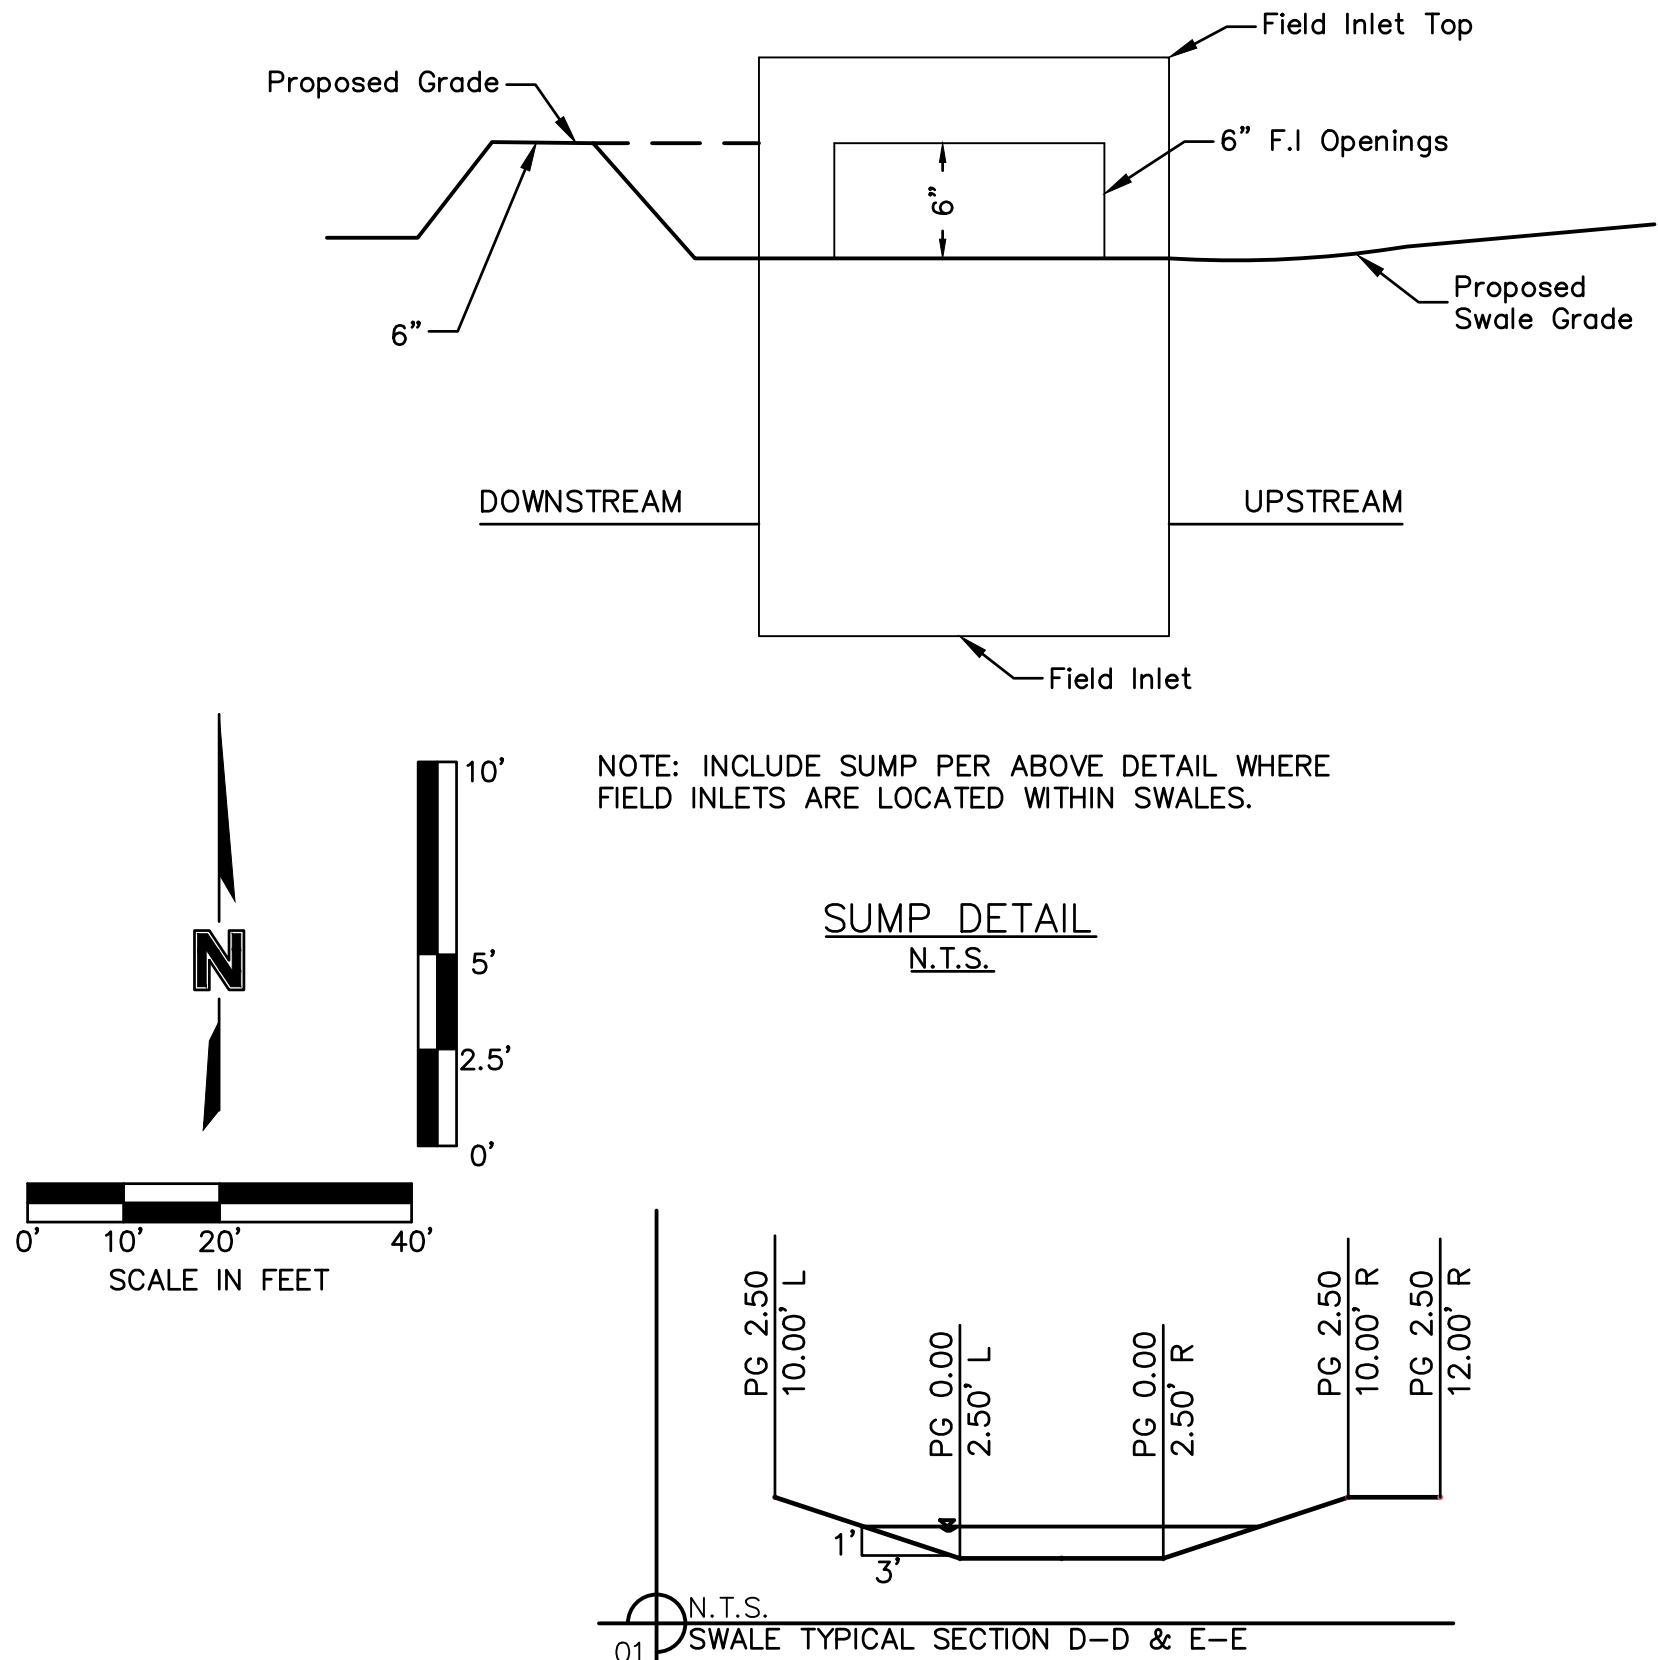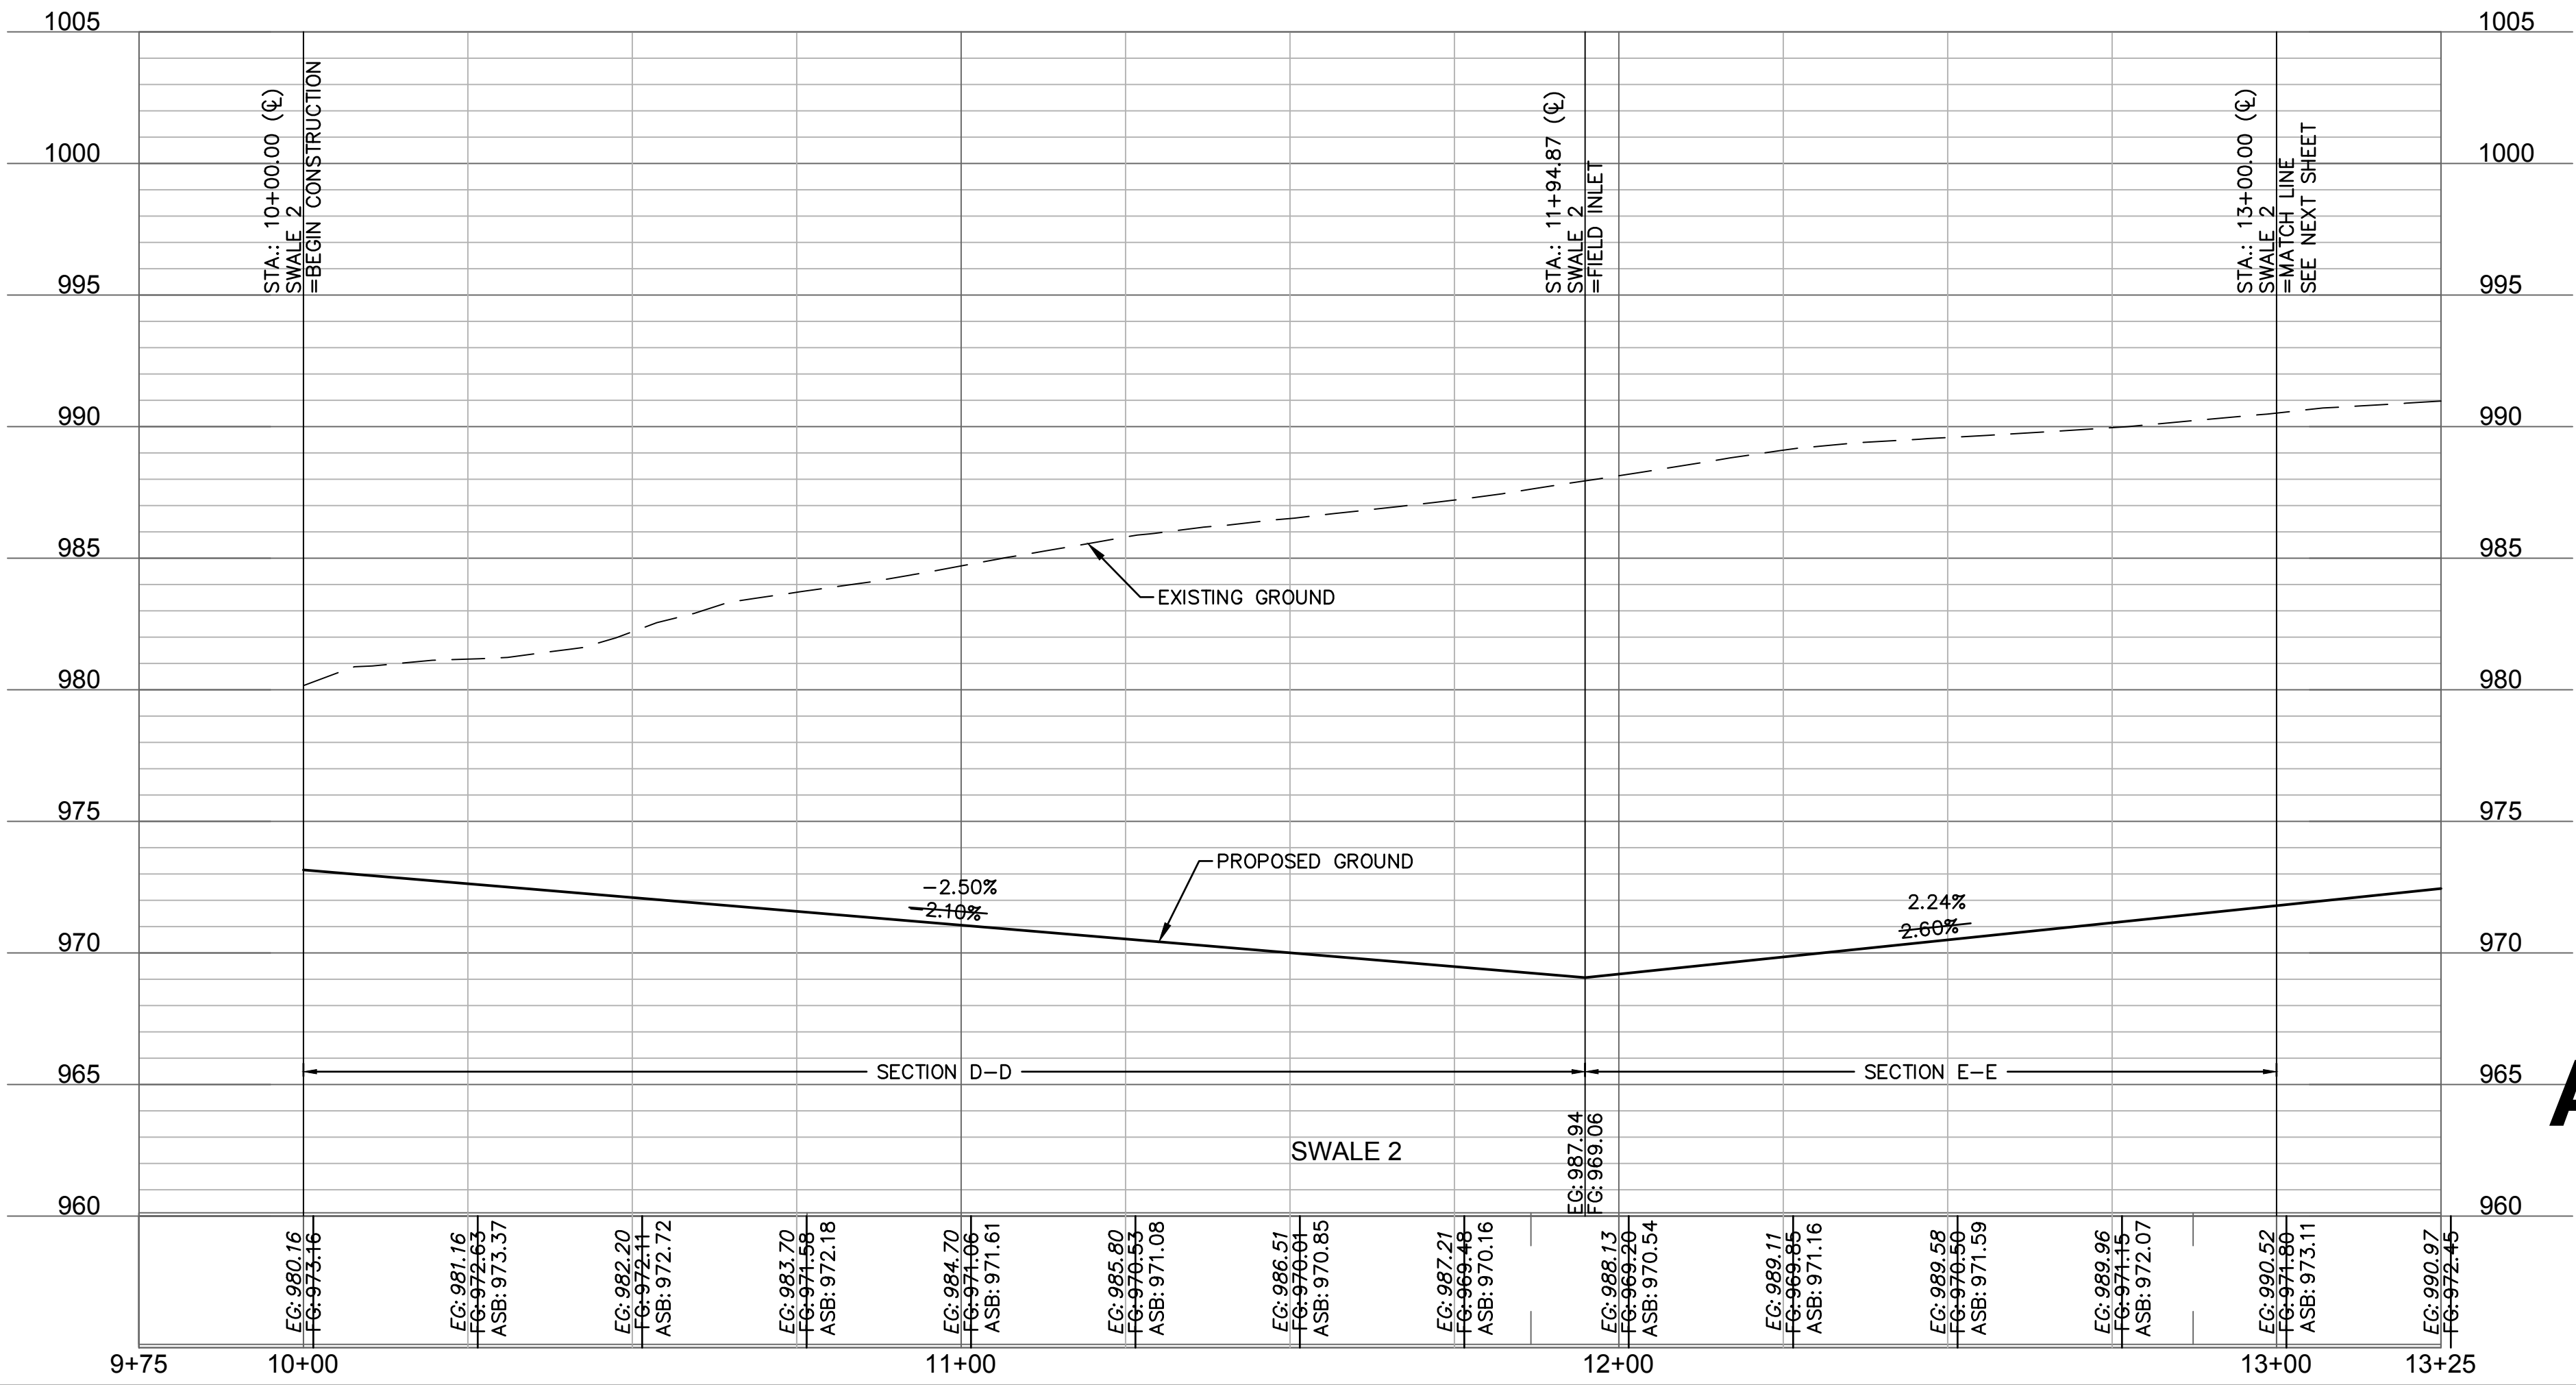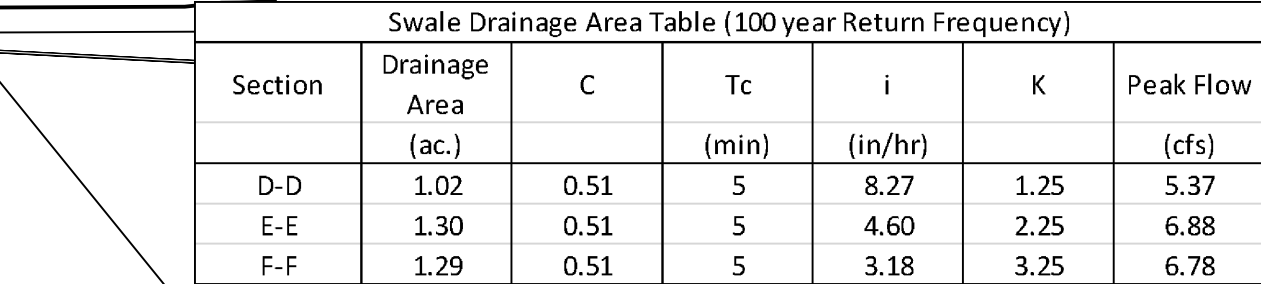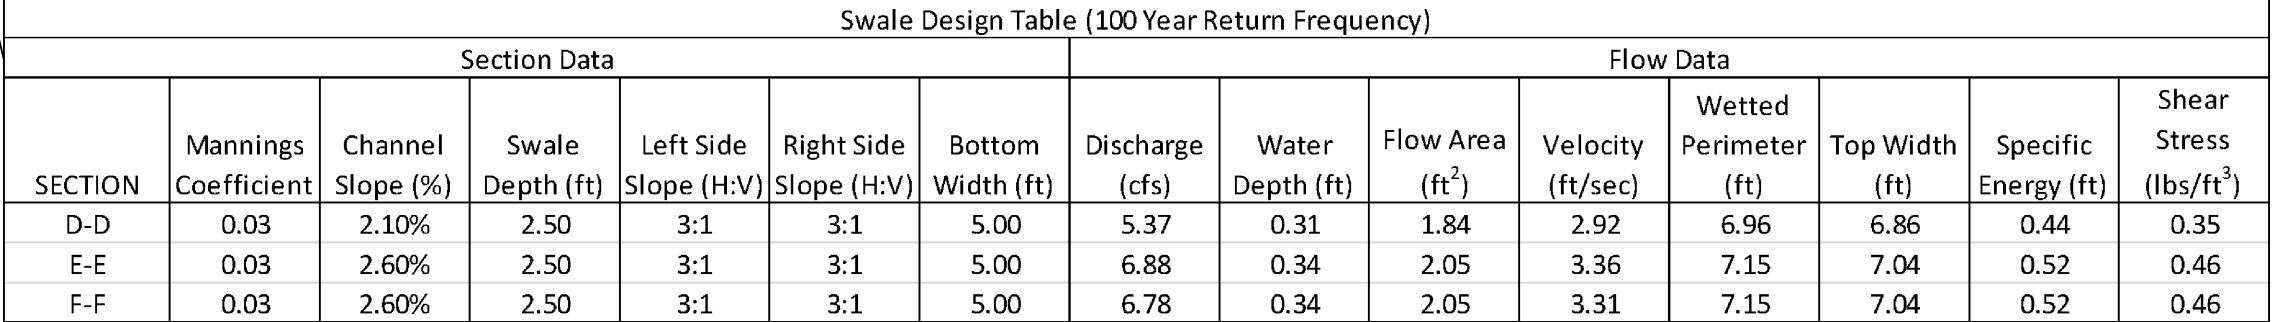


AS BUILT

DATE SURVEYED: 2022-05-26



SWALE GRADING NOTES:

1. CONTRACTOR SHALL CONSTRUCT SWALES WITH MINIMUM SLOPE, WIDTH AND DEPTH AS SHOWN IN THE SWALE DESIGN TABLES.
2. AS-BUILT SURVEY IS REQUIRED/APPROVED BY CITY FOR ALL SWALES AND PRIOR TO APPROVAL FOR ANY BUILDING FOUNDATION PERMIT. CONTRACTOR SHALL BE REQUIRED TO REGRADE SWALES AT CONTRACTOR'S EXPENSE IF ABOVE REQUIREMENTS ARE NOT MET.

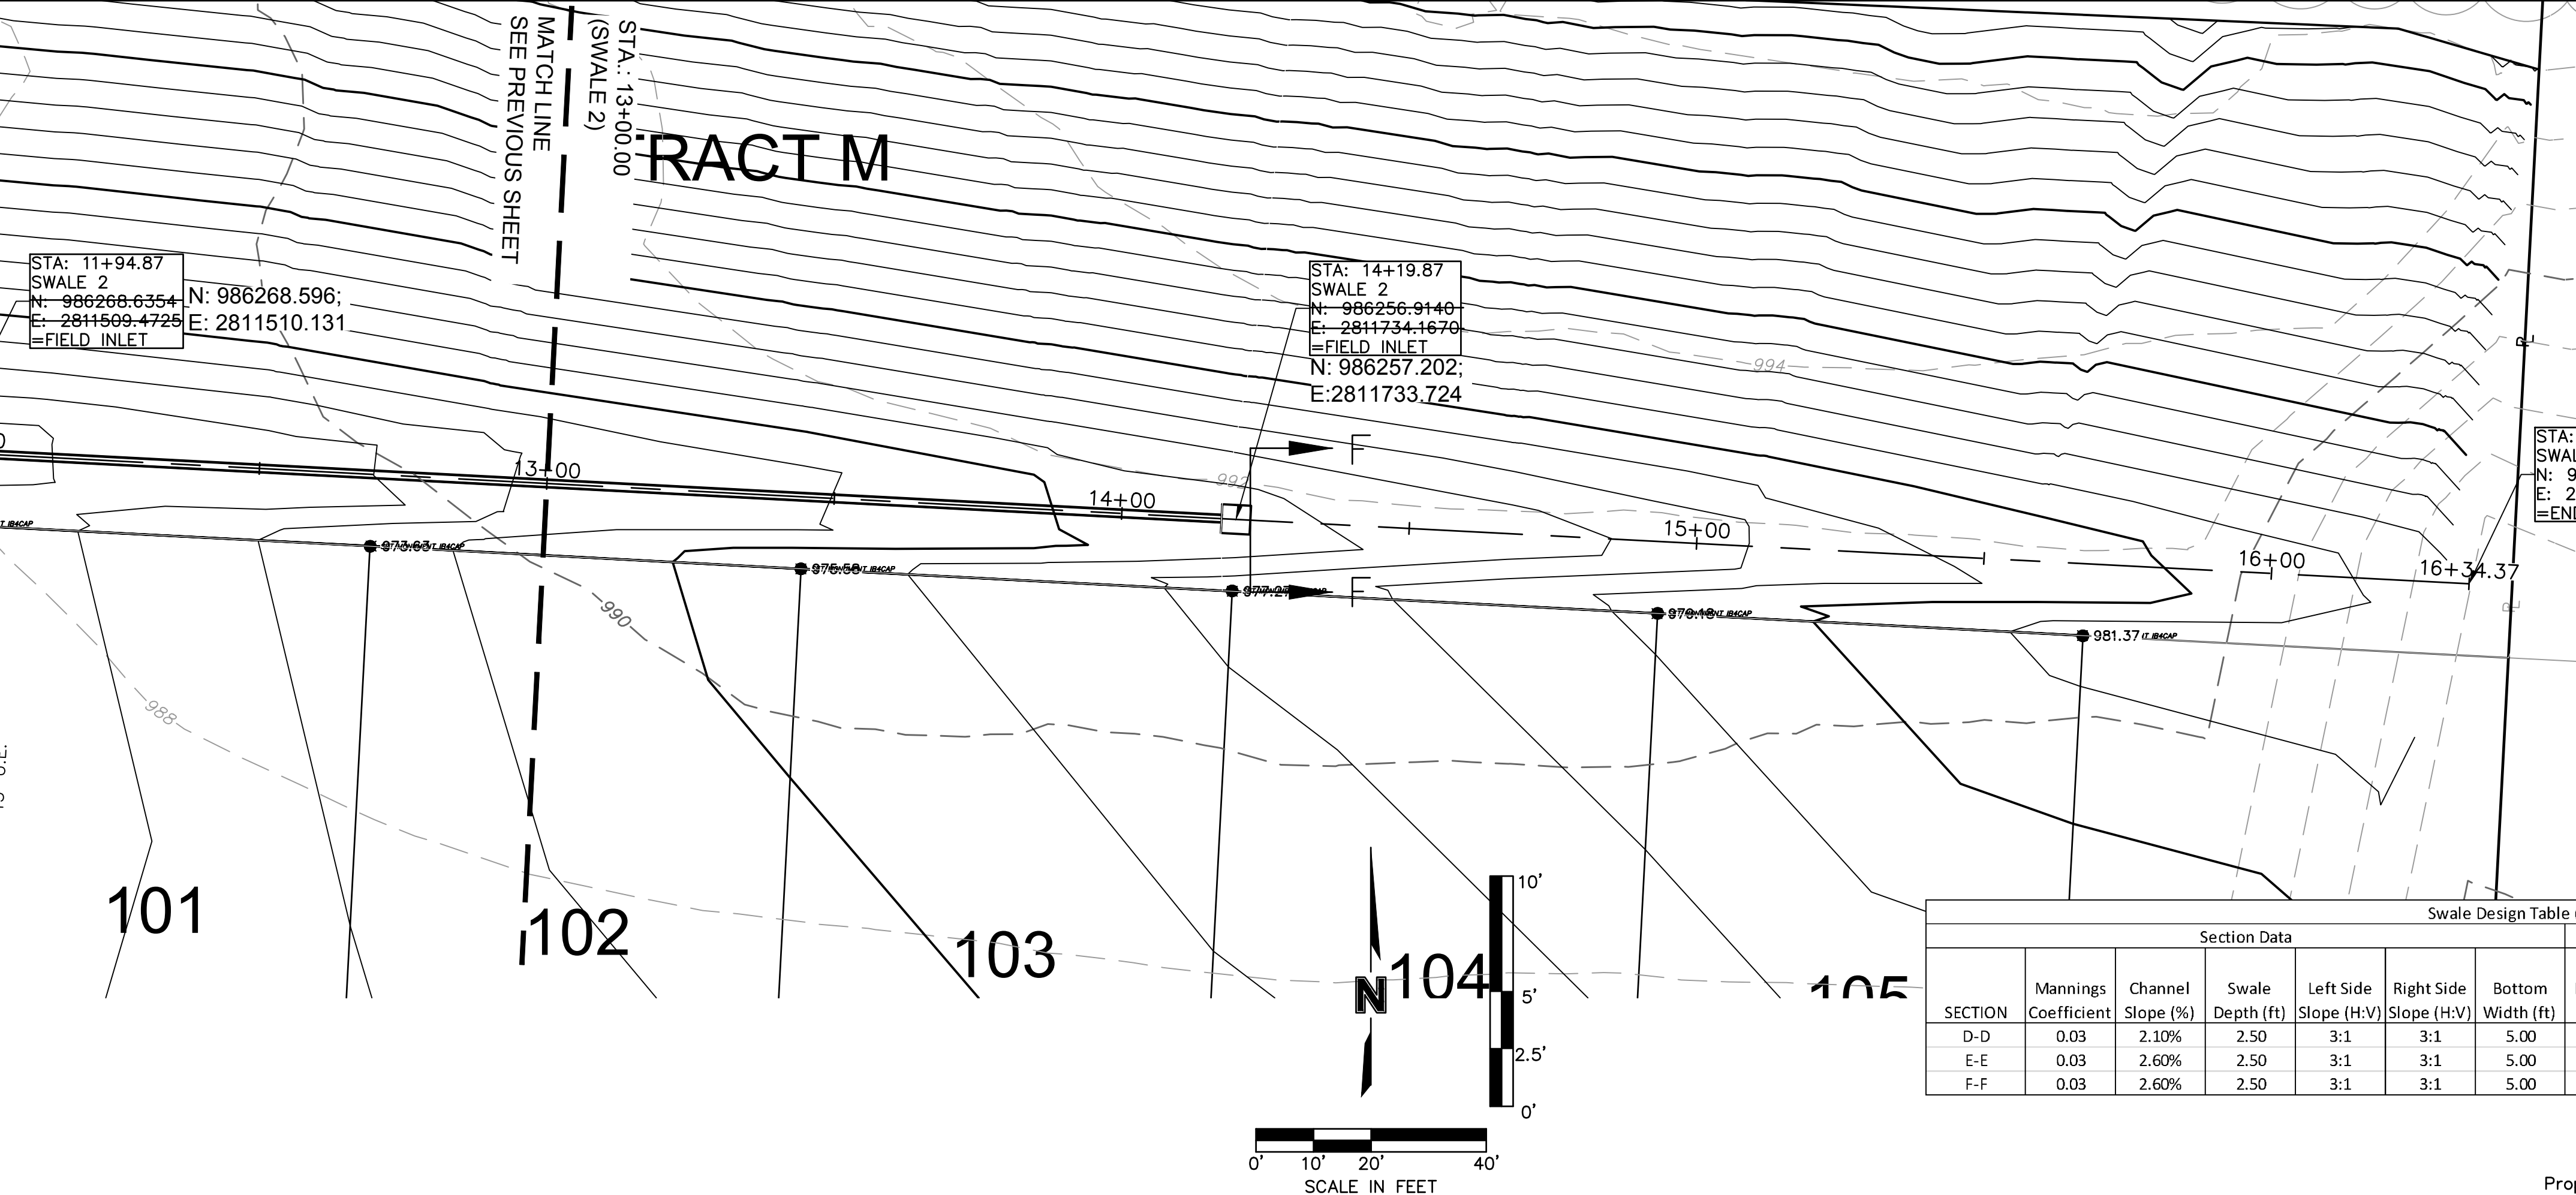

Swale Drainage Area Table (100 year Return Frequency)						
Section	Drainage Area (ac.)	C	Tc (min)	i (in/hr)	K	Peak Flow (cfs)
D-D	1.02	0.51	5	8.27	1.25	5.37
E-E	1.30	0.51	5	4.60	2.25	6.88
F-F	1.29	0.51	5	3.18	3.25	6.78

Swale Design Table (100 Year Return Frequency)														
Section Data							Flow Data							
SECTION	Mannings Coefficient	Channel Slope (%)	Swale Depth (ft)	Left Side Slope (H:V)	Right Side Slope (H:V)	Bottom Width (ft)	Discharge (cfs)	Water Depth (ft)	Flow Area (ft ²)	Velocity (ft/sec)	Wetted Perimeter (ft)	Top Width (ft)	Specific Energy (ft)	Shear Stress (lbs/ft ²)
D-D	0.03	2.10%	2.50	3:1	3:1	5.00	5.37	0.31	1.84	2.92	6.96	6.86	0.44	0.35
E-E	0.03	2.60%	2.50	3:1	3:1	5.00	6.88	0.34	2.05	3.36	7.15	7.04	0.52	0.46
F-F	0.03	2.60%	2.50	3:1	3:1	5.00	6.78	0.34	2.05	3.31	7.15	7.04	0.52	0.46

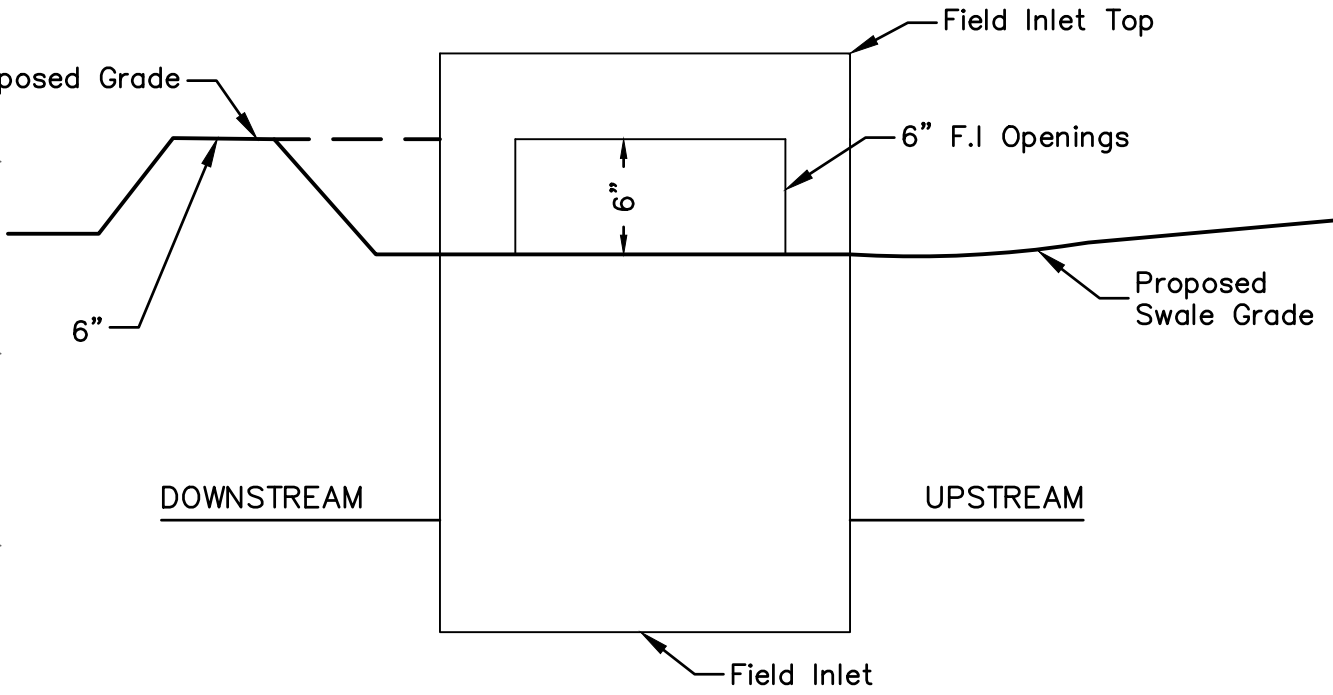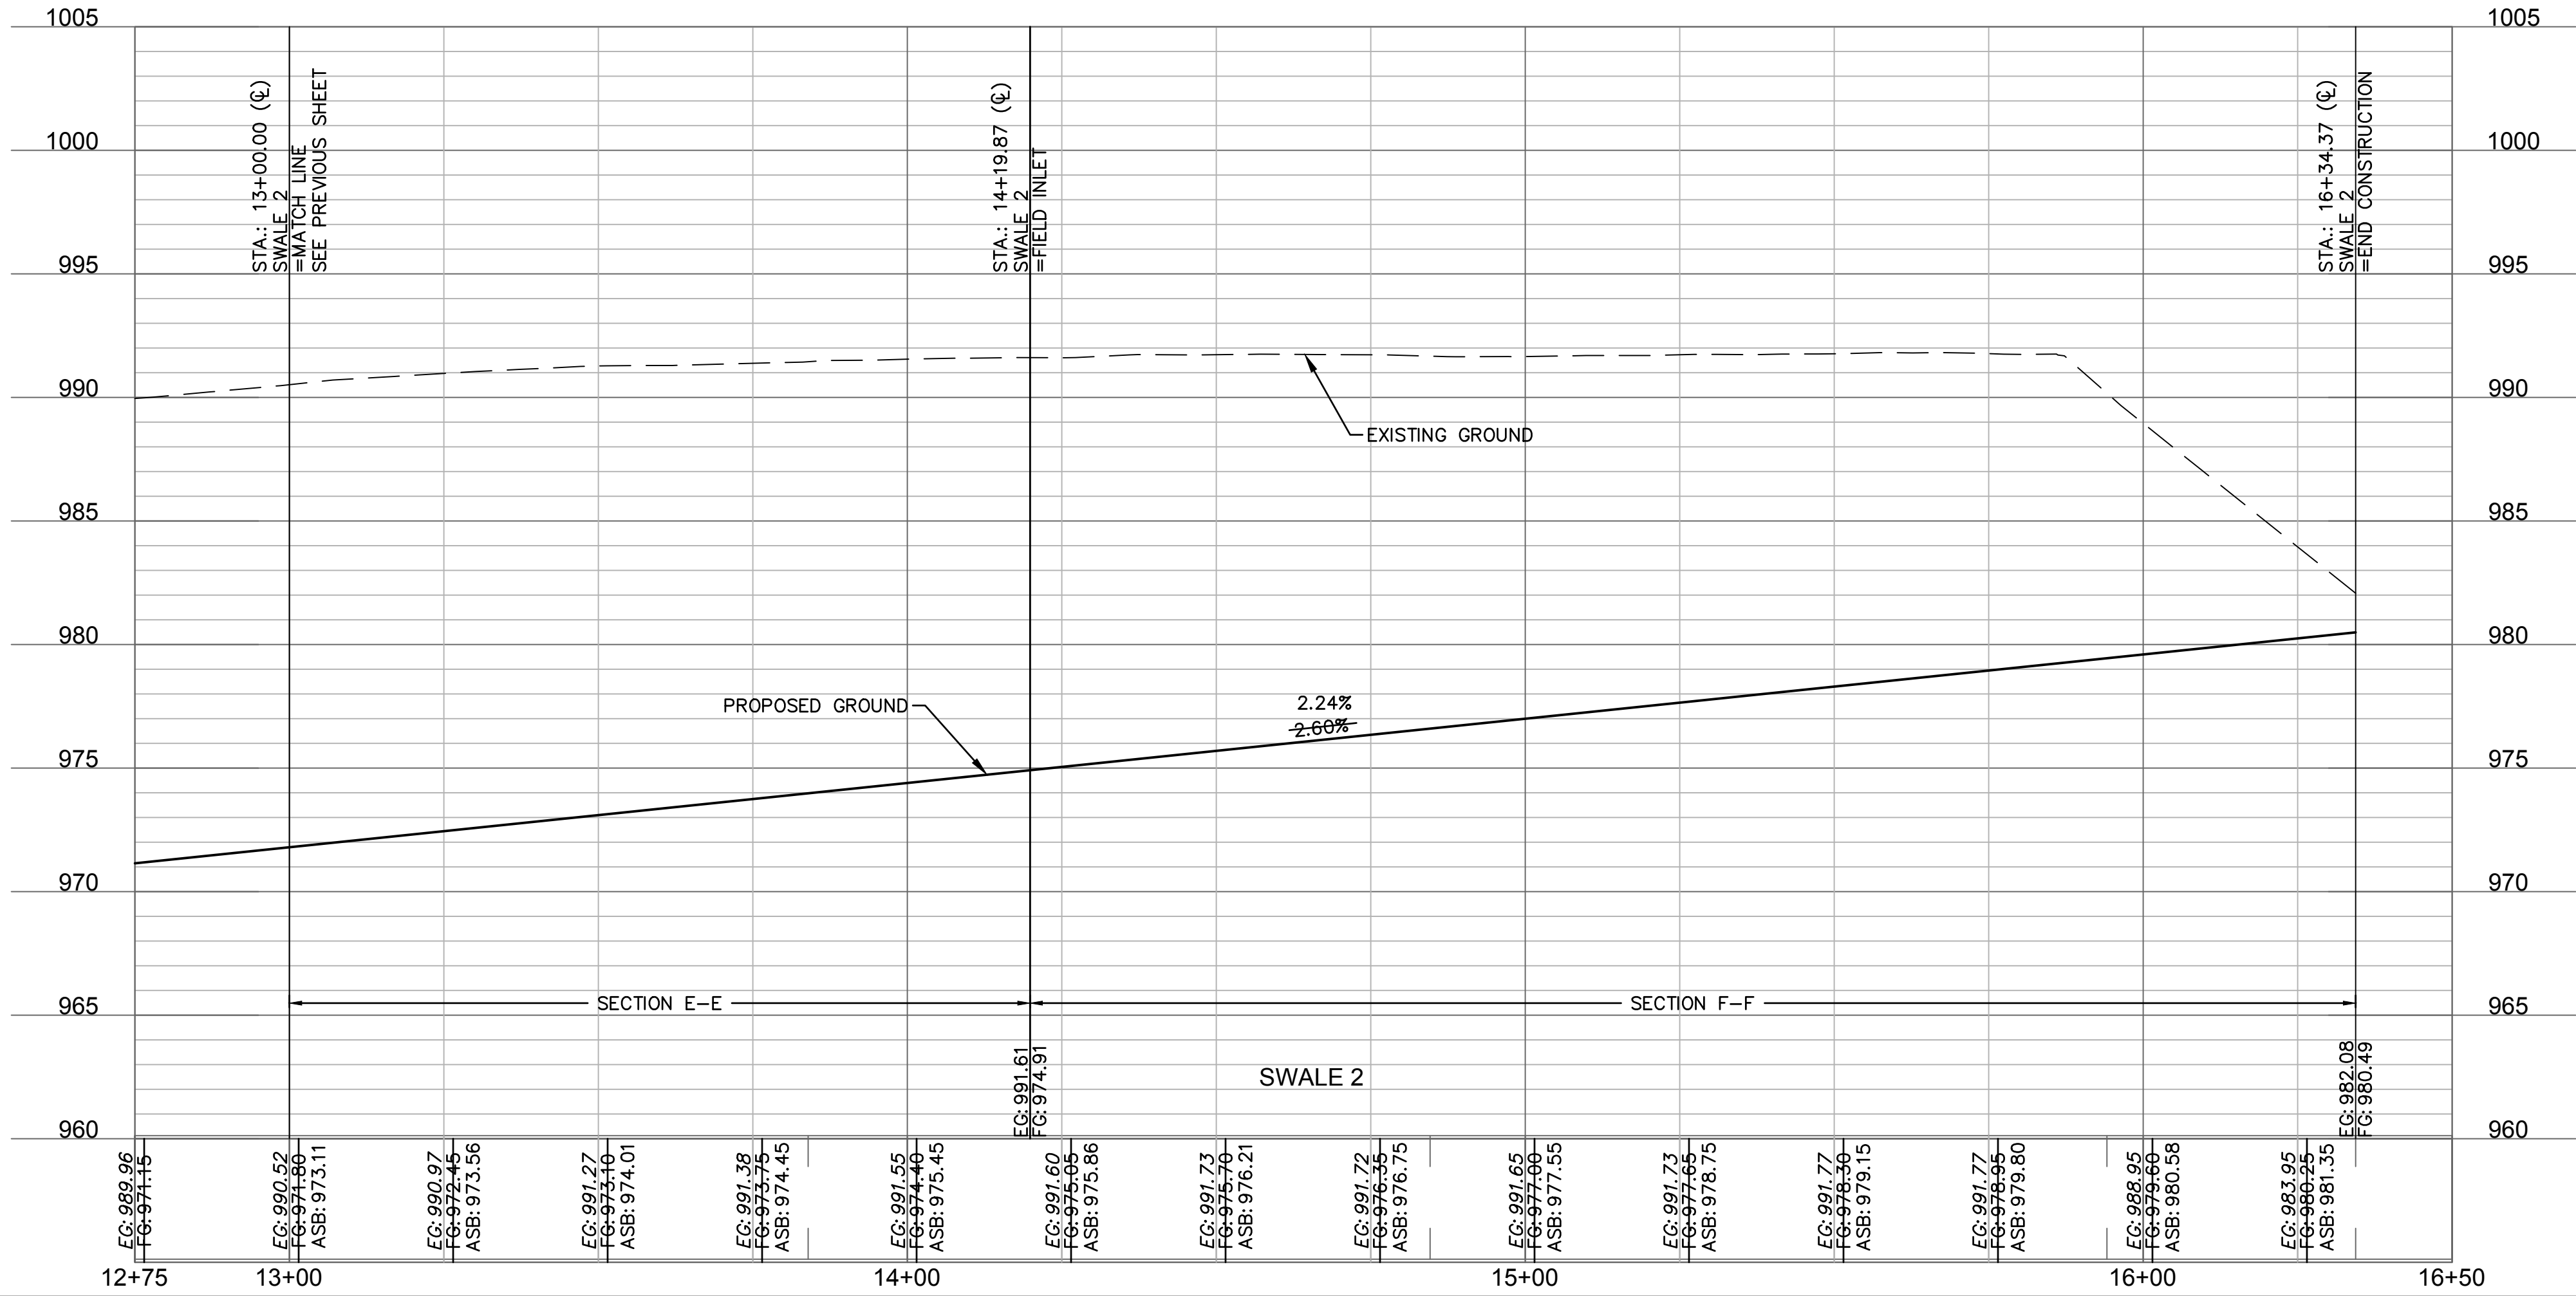


NOTE: INCLUDE SUMP PER ABOVE DETAIL WHERE FIELD INLETS ARE LOCATED WITHIN SWALES.

SUMP DETAIL
N.T.S.

AS BUILT

DATE SURVEYED: 2022-05-26

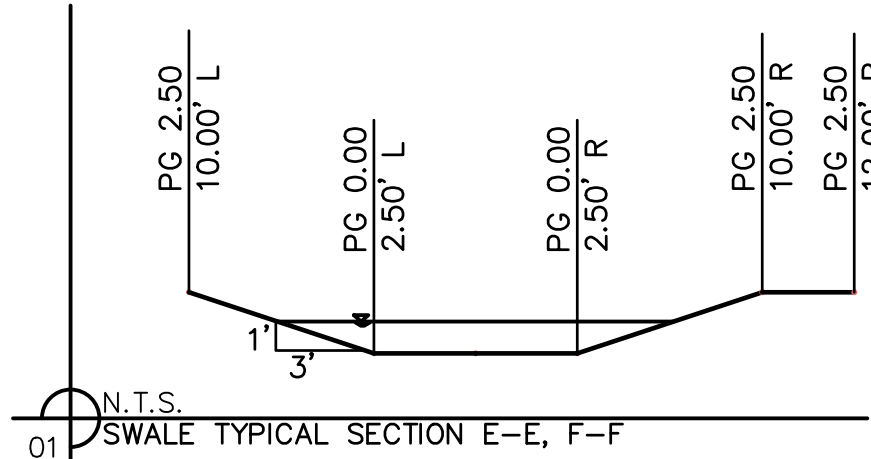

SWALE GRADING NOTES:

- CONTRACTOR SHALL CONSTRUCT SWALES WITH MINIMUM SLOPE, WIDTH AND DEPTH AS SHOWN IN THE SWALE DESIGN TABLES.
- AS-BUILT SURVEY IS REQUIRED/APPROVED BY CITY FOR ALL SWALES AND PRIOR TO APPROVAL FOR ANY BUILDING FOUNDATION PERMIT. CONTRACTOR SHALL BE REQUIRED TO REGRADE SWALES AT CONTRACTOR'S EXPENSE IF ABOVE REQUIREMENTS ARE NOT MET.

olsson

Olsson - Civil Engineering
Missouri Certificate of Authority #001592
1301 Burlington Street
North Kansas City, MO 64116
TEL 816.361.1177
FAX 816.361.1888
www.olsson.com

STATE OF MISSOURI
JULIE ELAINE SELLERS
NUMBER PE-2017000367
11/28/22
PROFESSIONAL ENGINEER

BY

REVISIONS

REV. NO.

DATE

REVISIONS DESCRIPTION

1

03-23-2021

REVISED PER CITY COMMENTS

2

04-16-2021

REVISED PER CITY COMMENTS

3

09-30-2021

CHANGES TO APPROVED PLANS

SWALE 2 PLAN & PROFILE
STREET & STORM SEWER PLANS


HOOK FARMS
SECOND PLAT


LEE'S SUMMIT, MO

2021

drawn by: B.M.W./A.A.
checked by: B.M.W.
designed by: B.M.W./A.A.
QA/QC by: J.E.S.
project no.: B19-4061
date: 01-08-2021

SHEET
C109

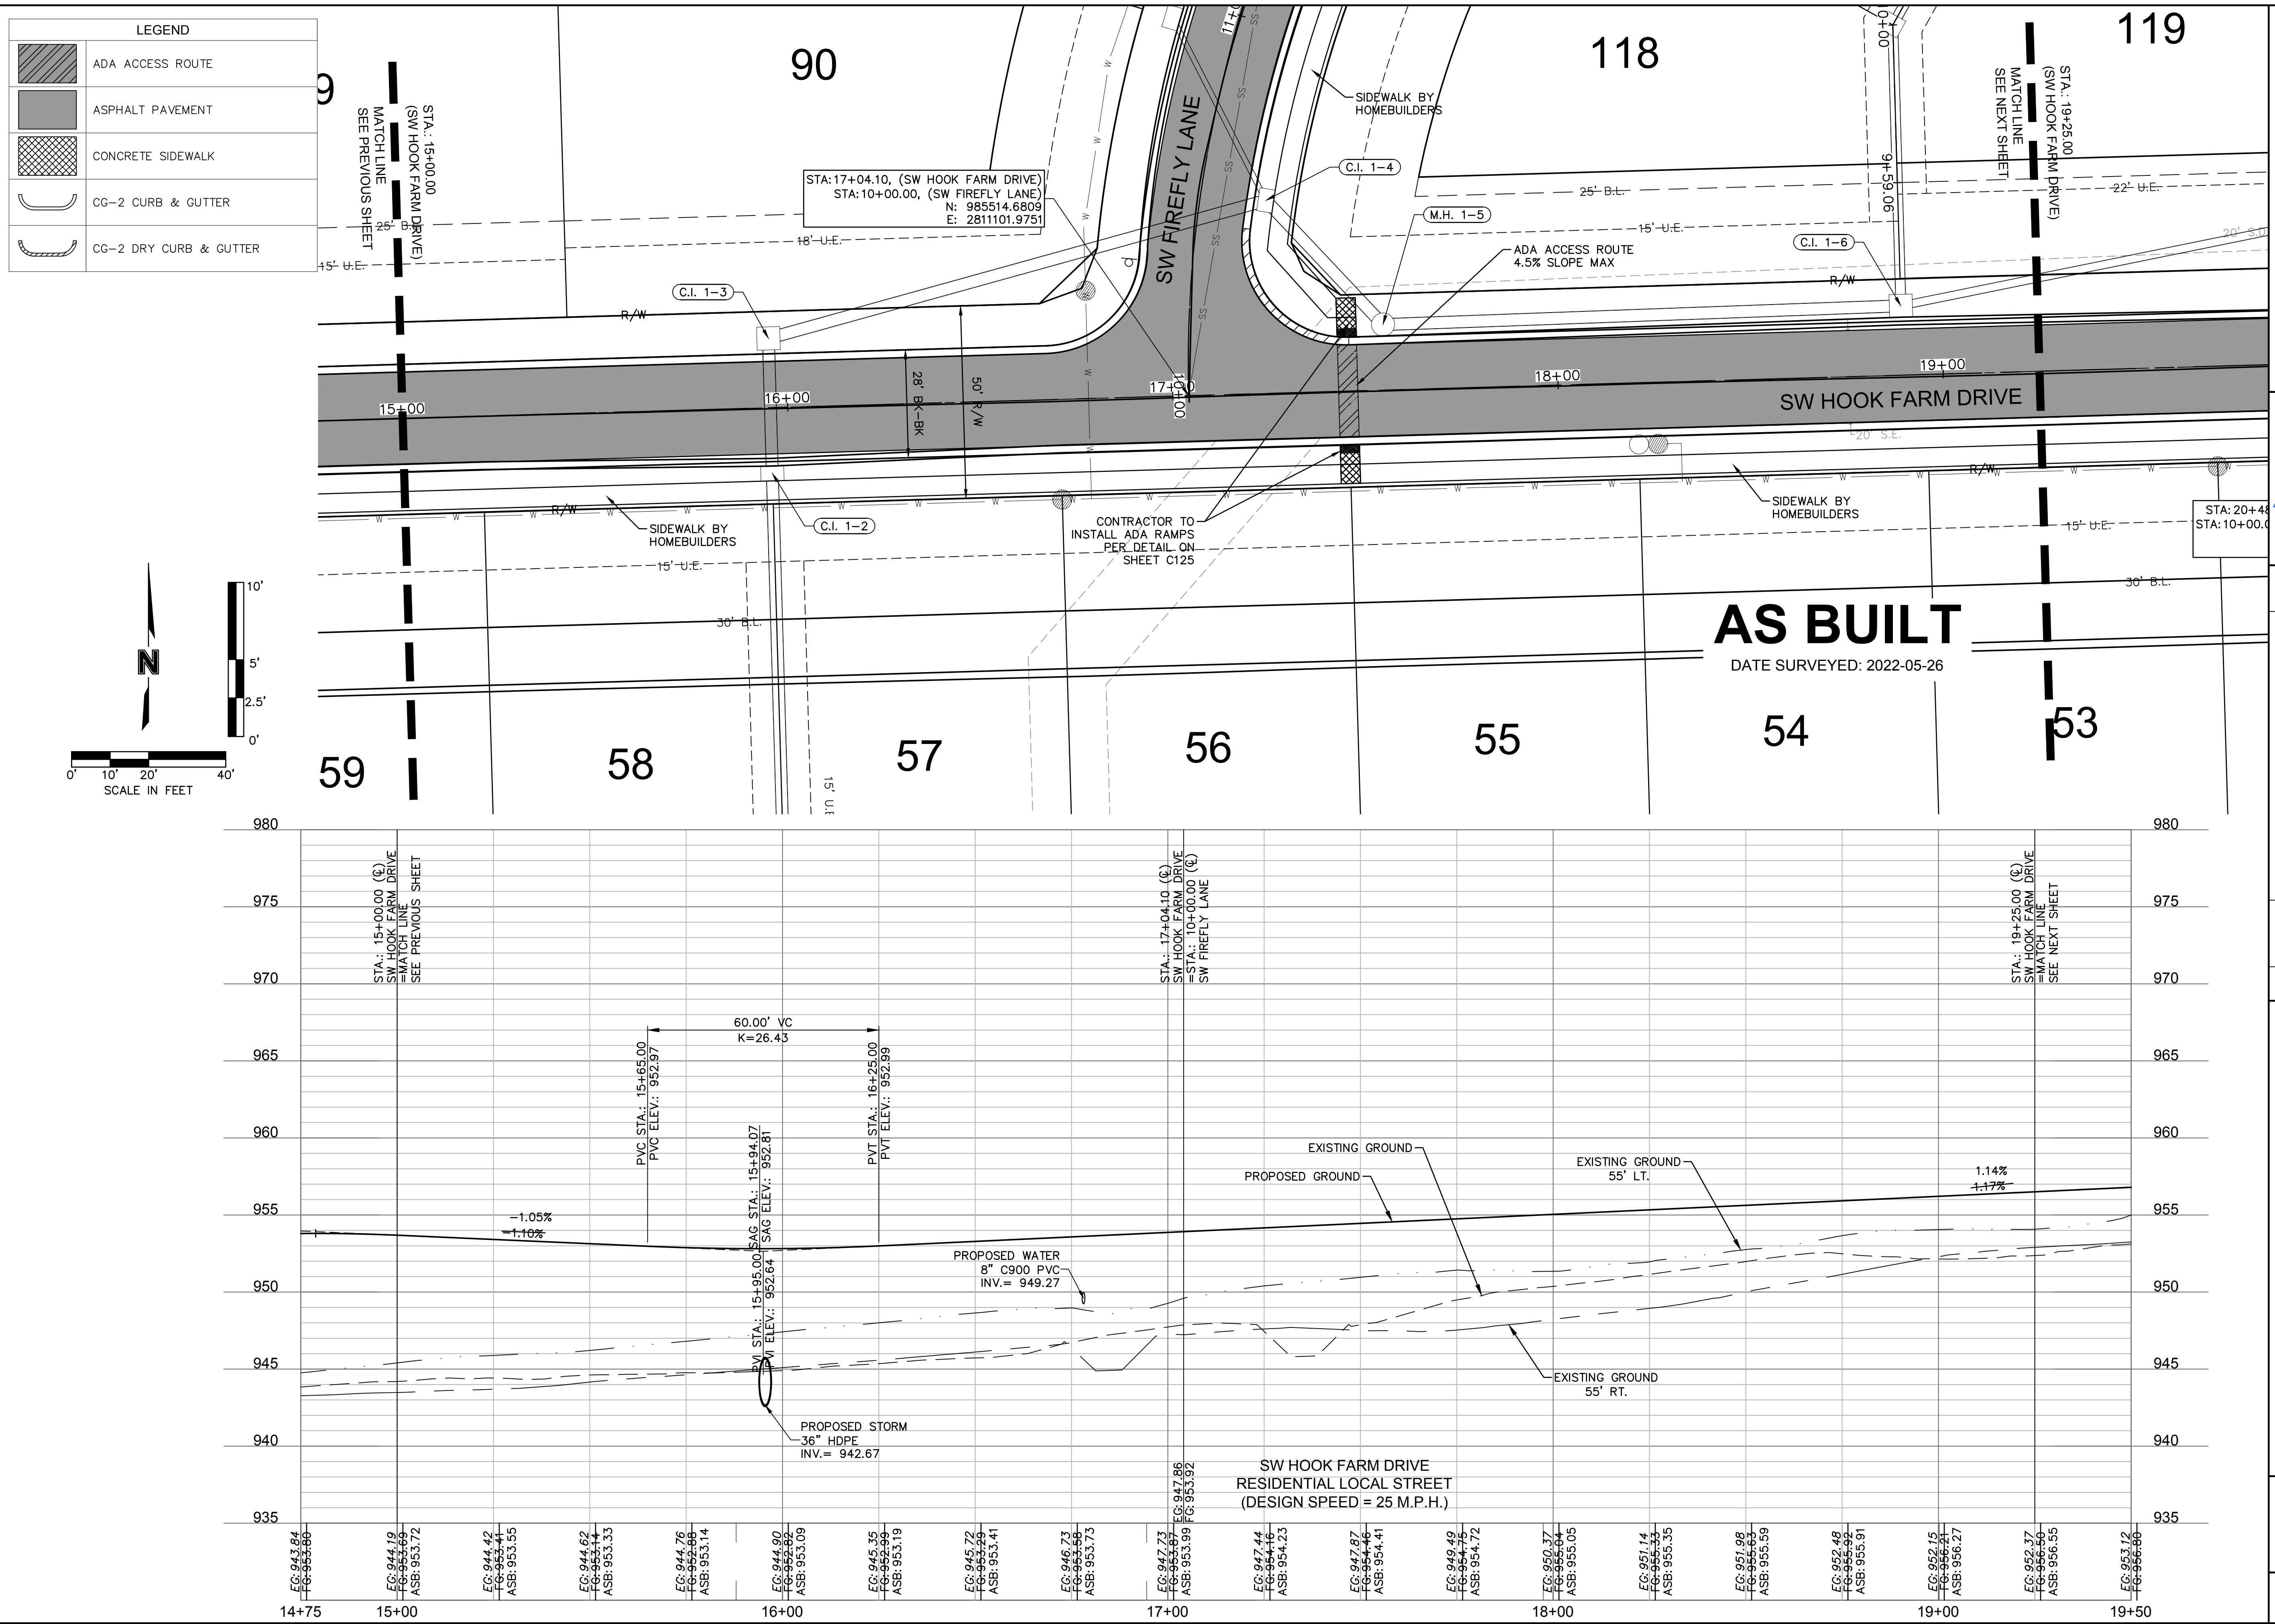

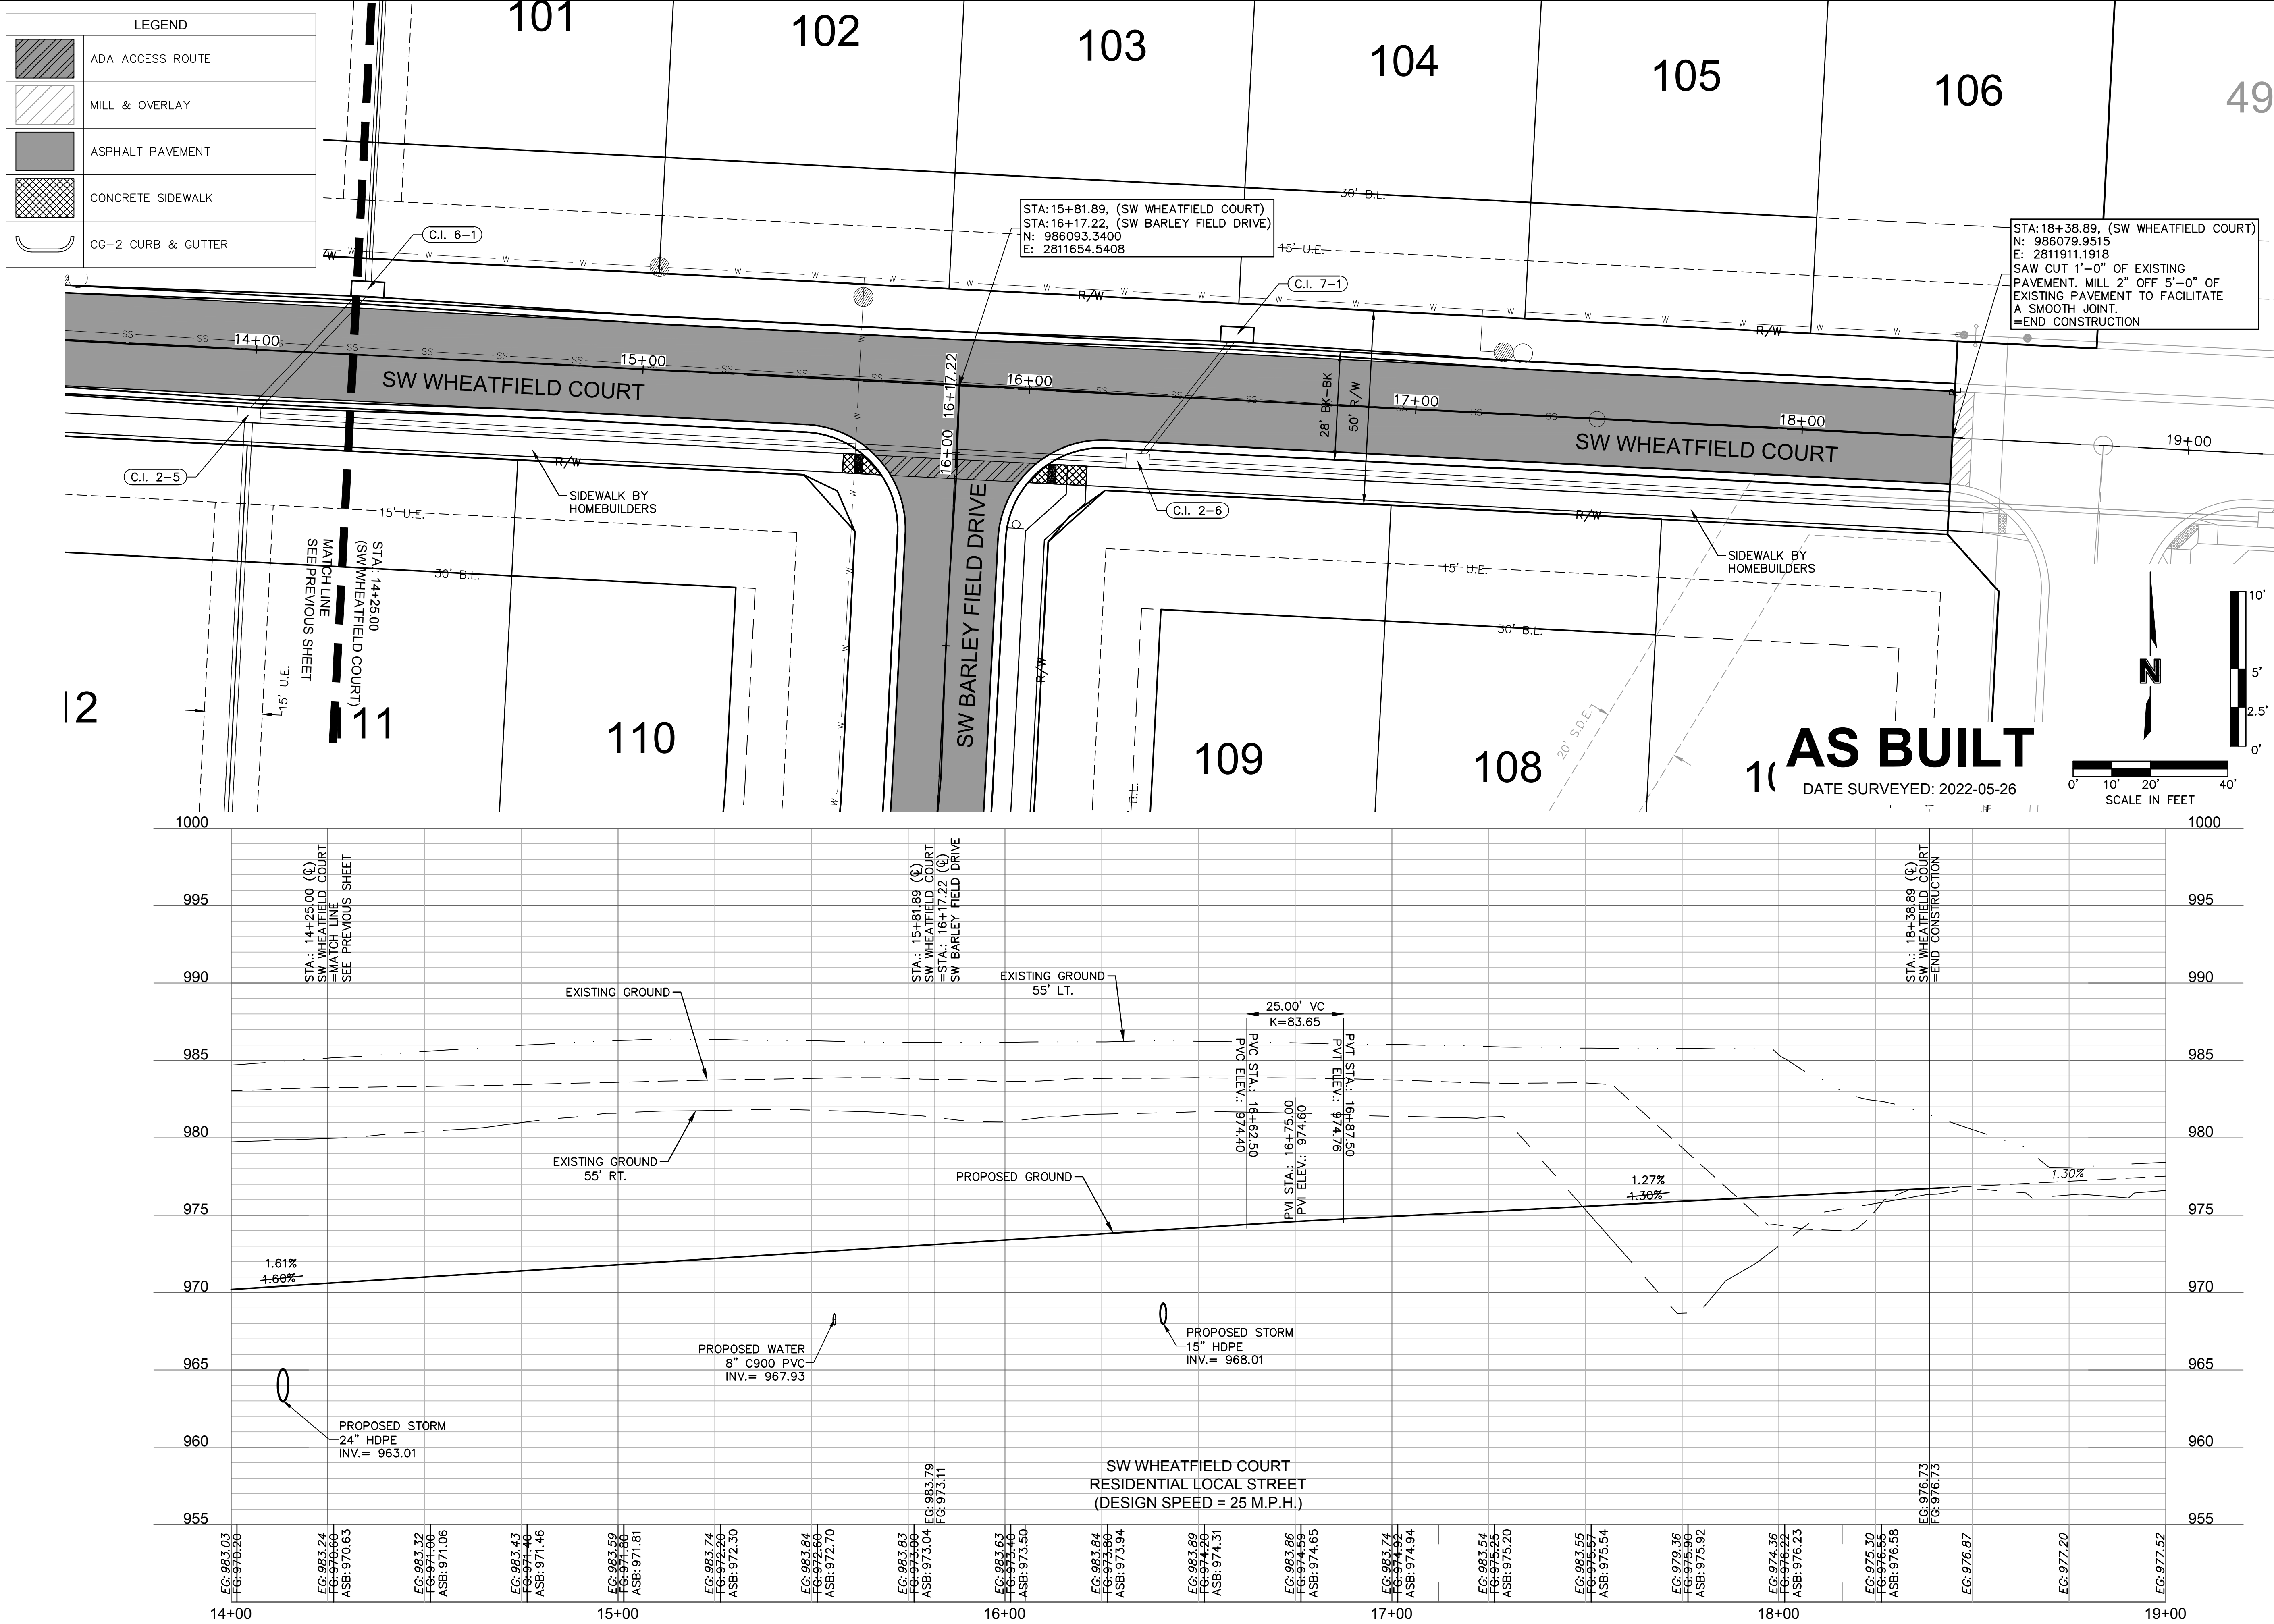

olsson

Olsson - Civil Engineering
Missouri Certificate of Authority #001592
1301 Burlington Street
North Kansas City, MO 64116
TEL 816.361.1177
FAX 816.361.1888
www.olsson.com

STATE OF MISSOURI
JULIE ELAINE SELLERS
NUMBER PE-2017000367
11/28/22
PROFESSIONAL ENGINEER



BY
REVISIONS
REV. NO. DATE REVISIONS DESCRIPTION
1 03-23-2021 REVISED PER CITY COMMENTS
2 04-16-2021 REVISED PER CITY COMMENTS
3 09-30-2021 CHANGES TO APPROVED PLANS

ROADWAY PLAN & PROFILE (SW WHEATFIELD COURT)
STREET & STORM SEWER PLANS
HOOK FARMS
SECOND PLAT
LEE'S SUMMIT, MO
2021


drawn by: B.M.W./A.A.
checked by: B.M.W.
designed by: B.M.W./A.A.
QA/QC by: J.E.S.
project no.: B19-4061
date: 01-08-2021

SHEET
C114

DWG: F:\2019\4001-4500\019-4061-B\40-Design\AutoCAD\Asbuilt\Sheets\GNVC\Street & Storm Plans\C_RPP02_B194061.dwg
 XREFS: C_PTBULK_B194061 C_XBASE_B194061 C_PBNDY_B194061 C_PUTIL_B194061 C_PSURF_B194061 C_PATT_B194061
 DATE: Oct 11, 2022 3:31pm USER: ssaylor

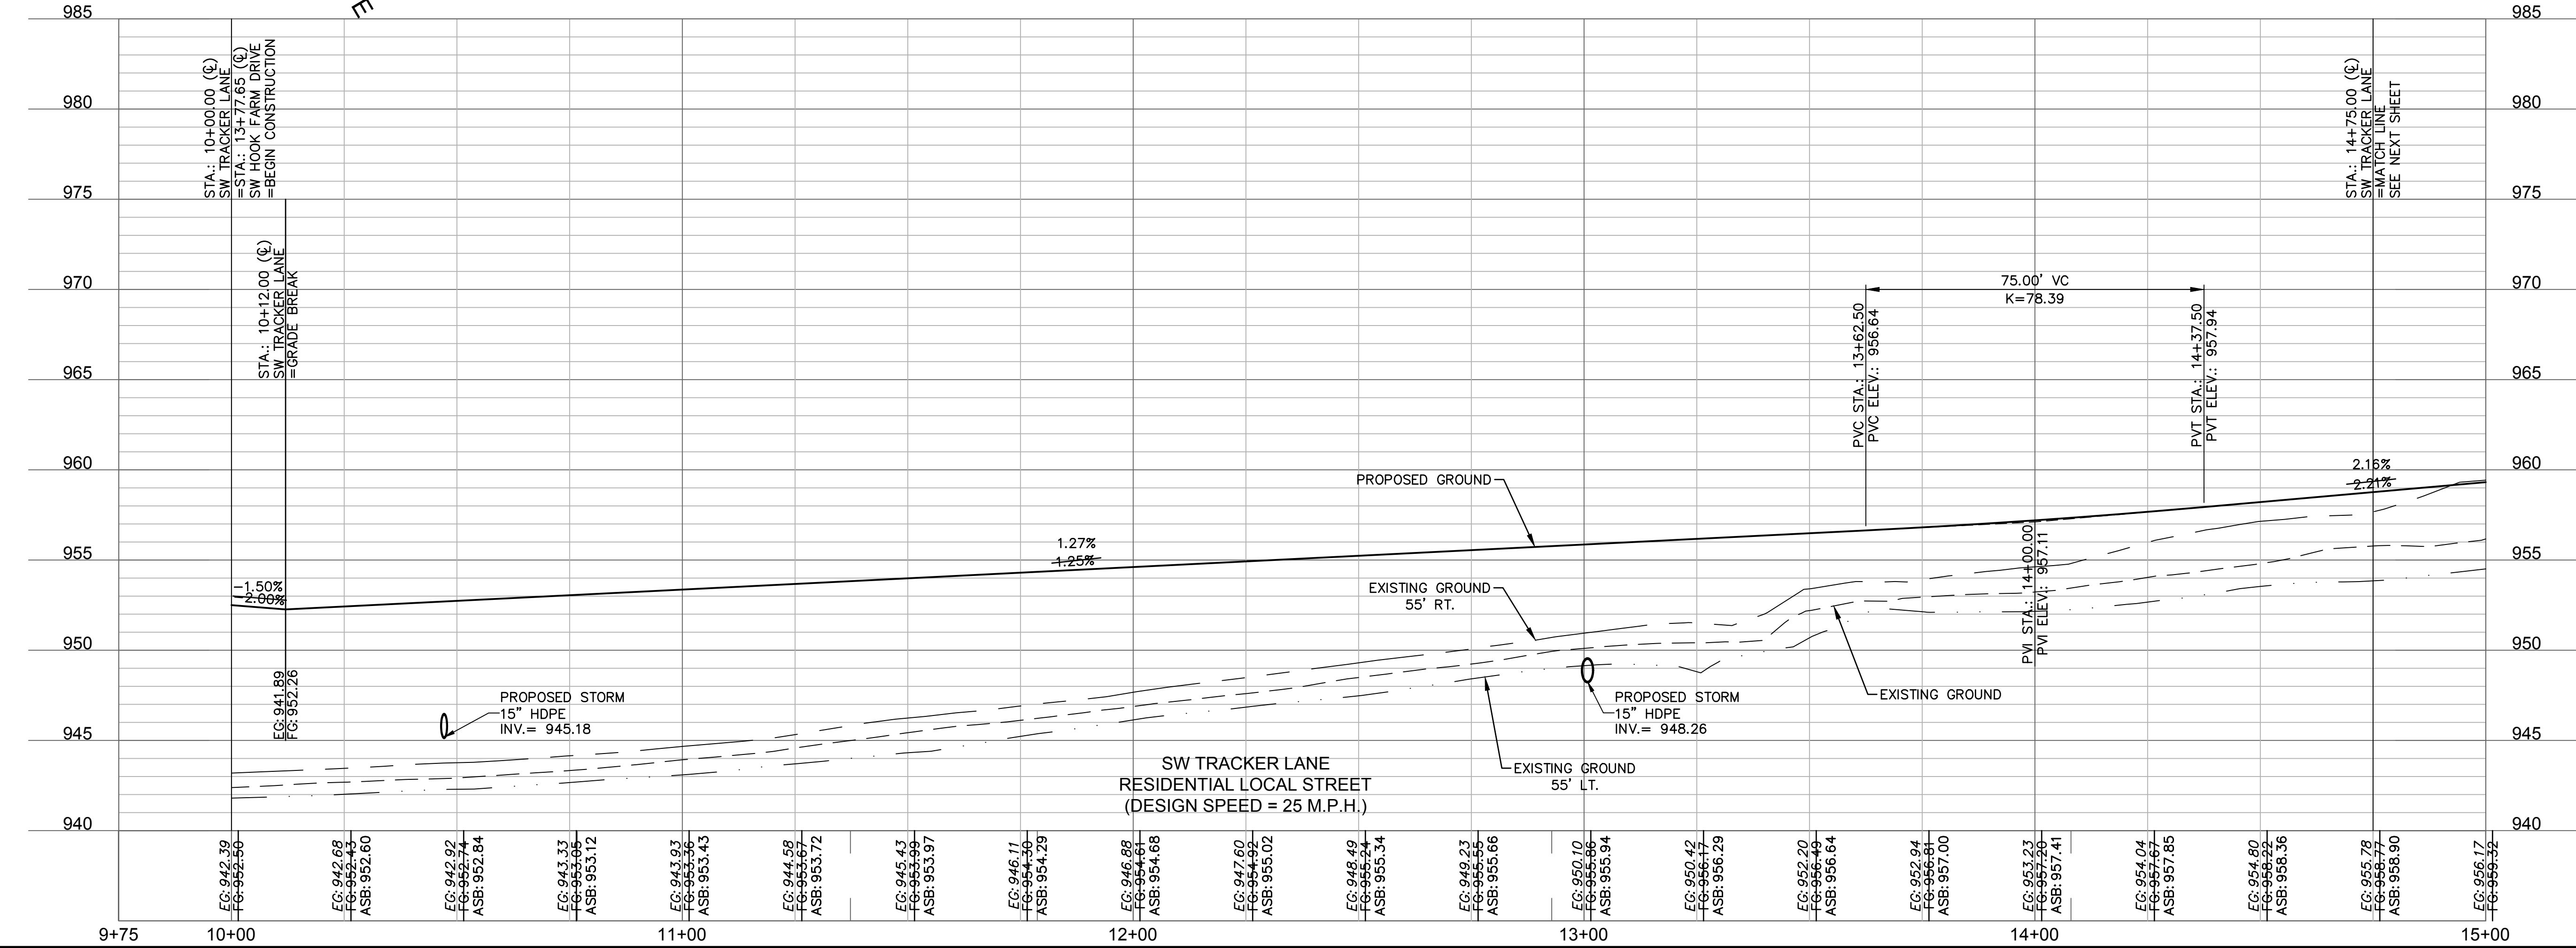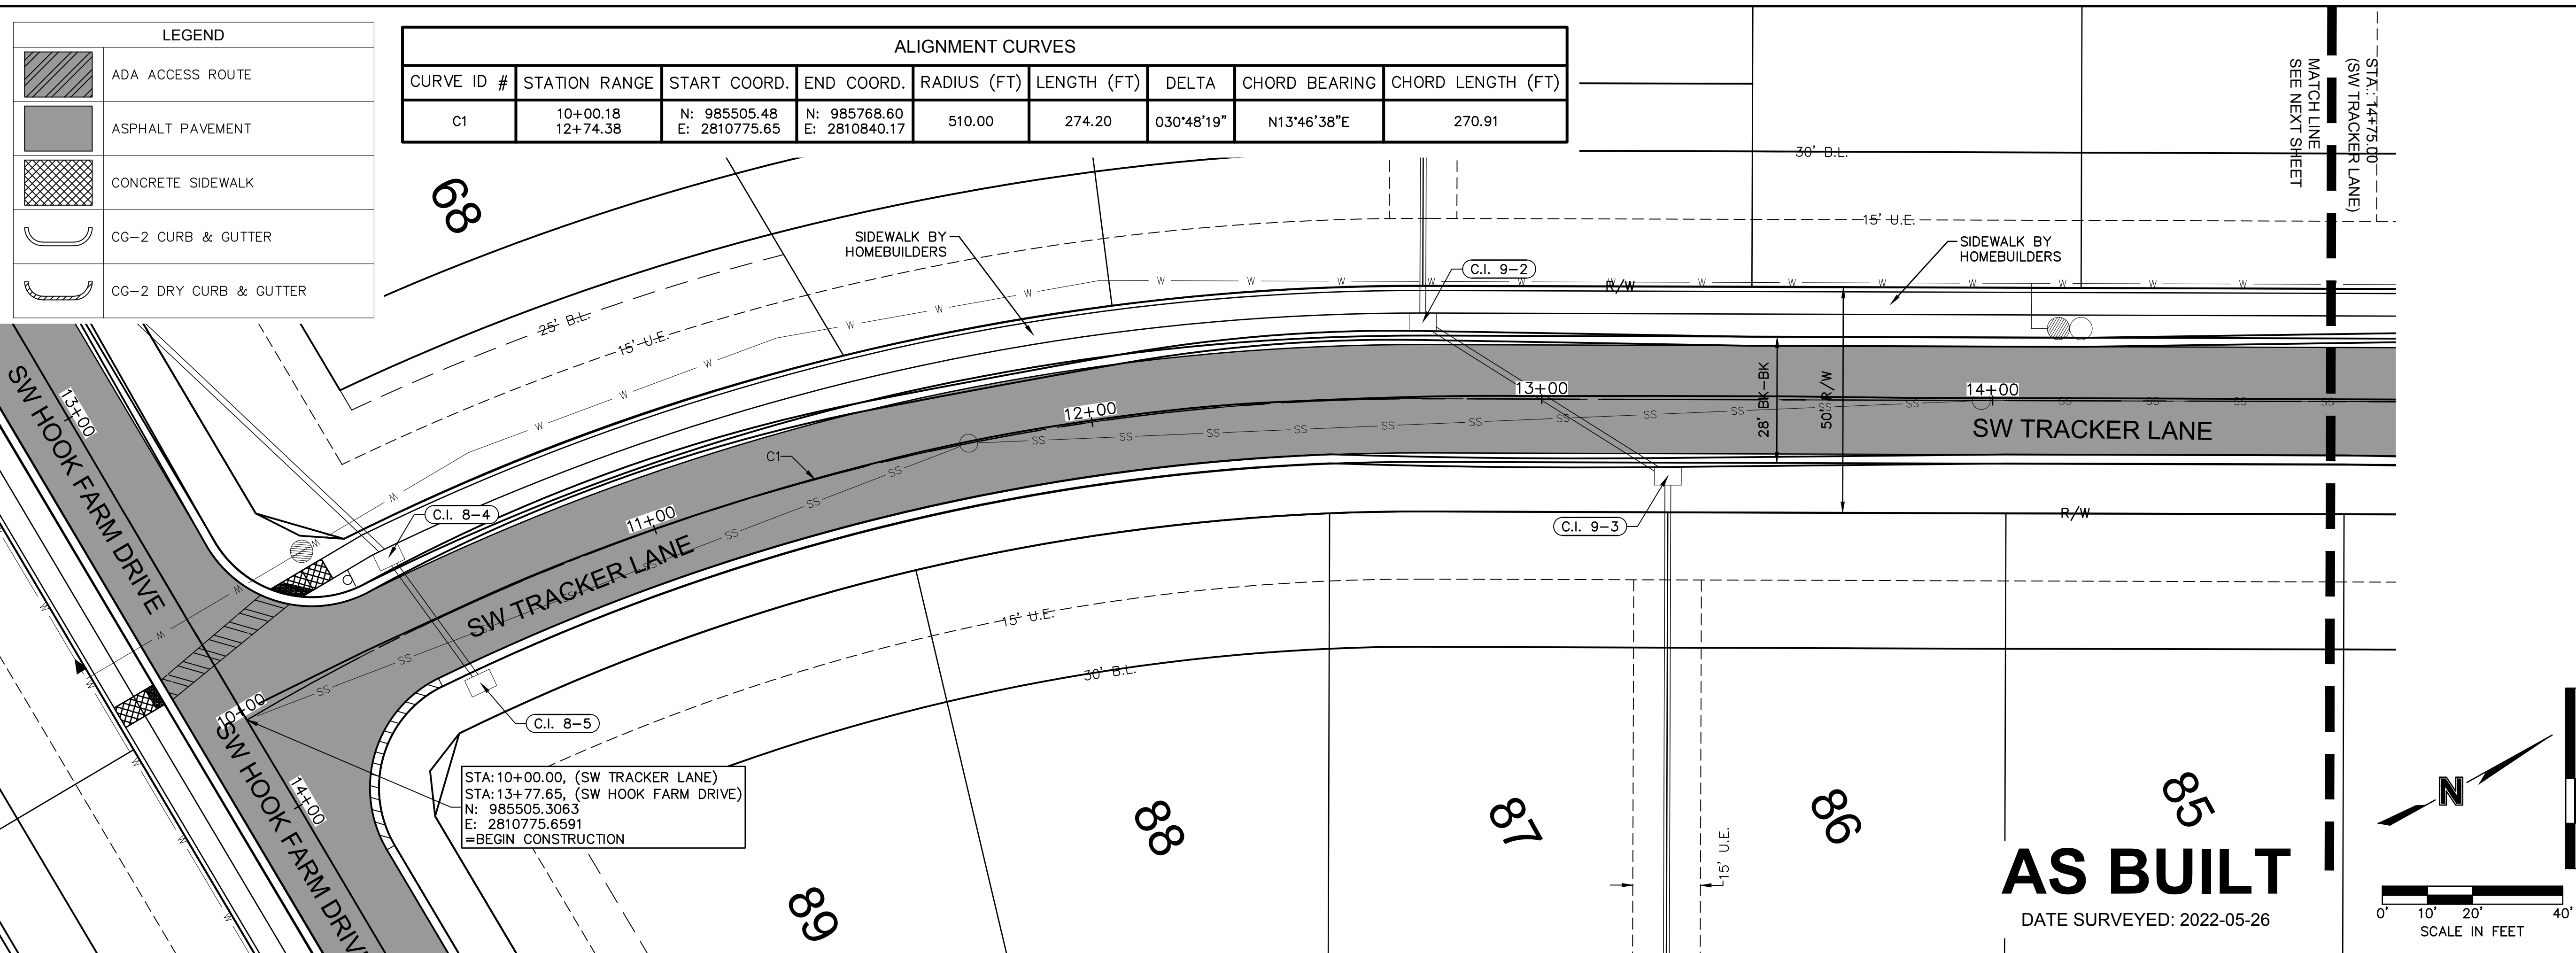

ROADWAY PLAN & PROFILE (SW TRACKER LANE) STREET & STORM SEWER PLANS		HOOK FARMS SECOND PLAT		2021	
				LEE'S SUMMIT, MO	
drawn by: _____		B.M.W./A.A.			
checked by: _____		B.M.W.			
designed by: _____		B.M.W./A.A.			
QA/QC by: _____		J.E.S.			
project no.: _____		B19-4061			
date: _____		01-08-2021			
SHEET C115					

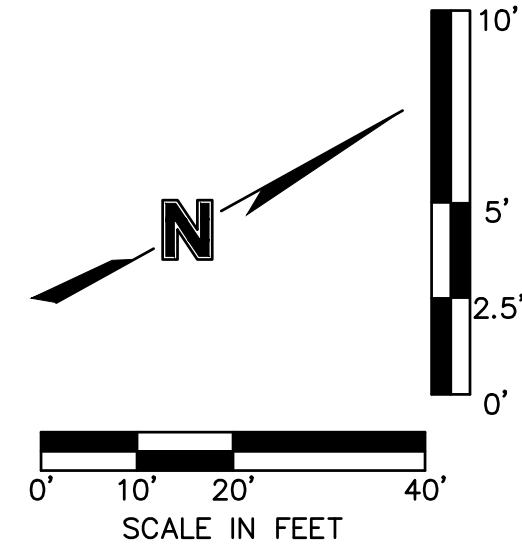

AS BUILT


DATE SURVEYED: 2022-05-26

DATE SURVEYED: 2022-05-26


drawn by: B.M.W./A.A.
checked by: B.M.W.
designed by: B.M.W./A.A.
QA/QC by: J.E.S.
project no.: B19-4061
date: 01-08-2021

SHEET
C116

	ADA ACCESS ROUTE
	MILL & OVERLAY
	ASPHALT PAVEMENT
	CONCRETE SIDEWALK
	CG-2 CURB & GUTTER
	CG-2 DRY CURB & GUTTER

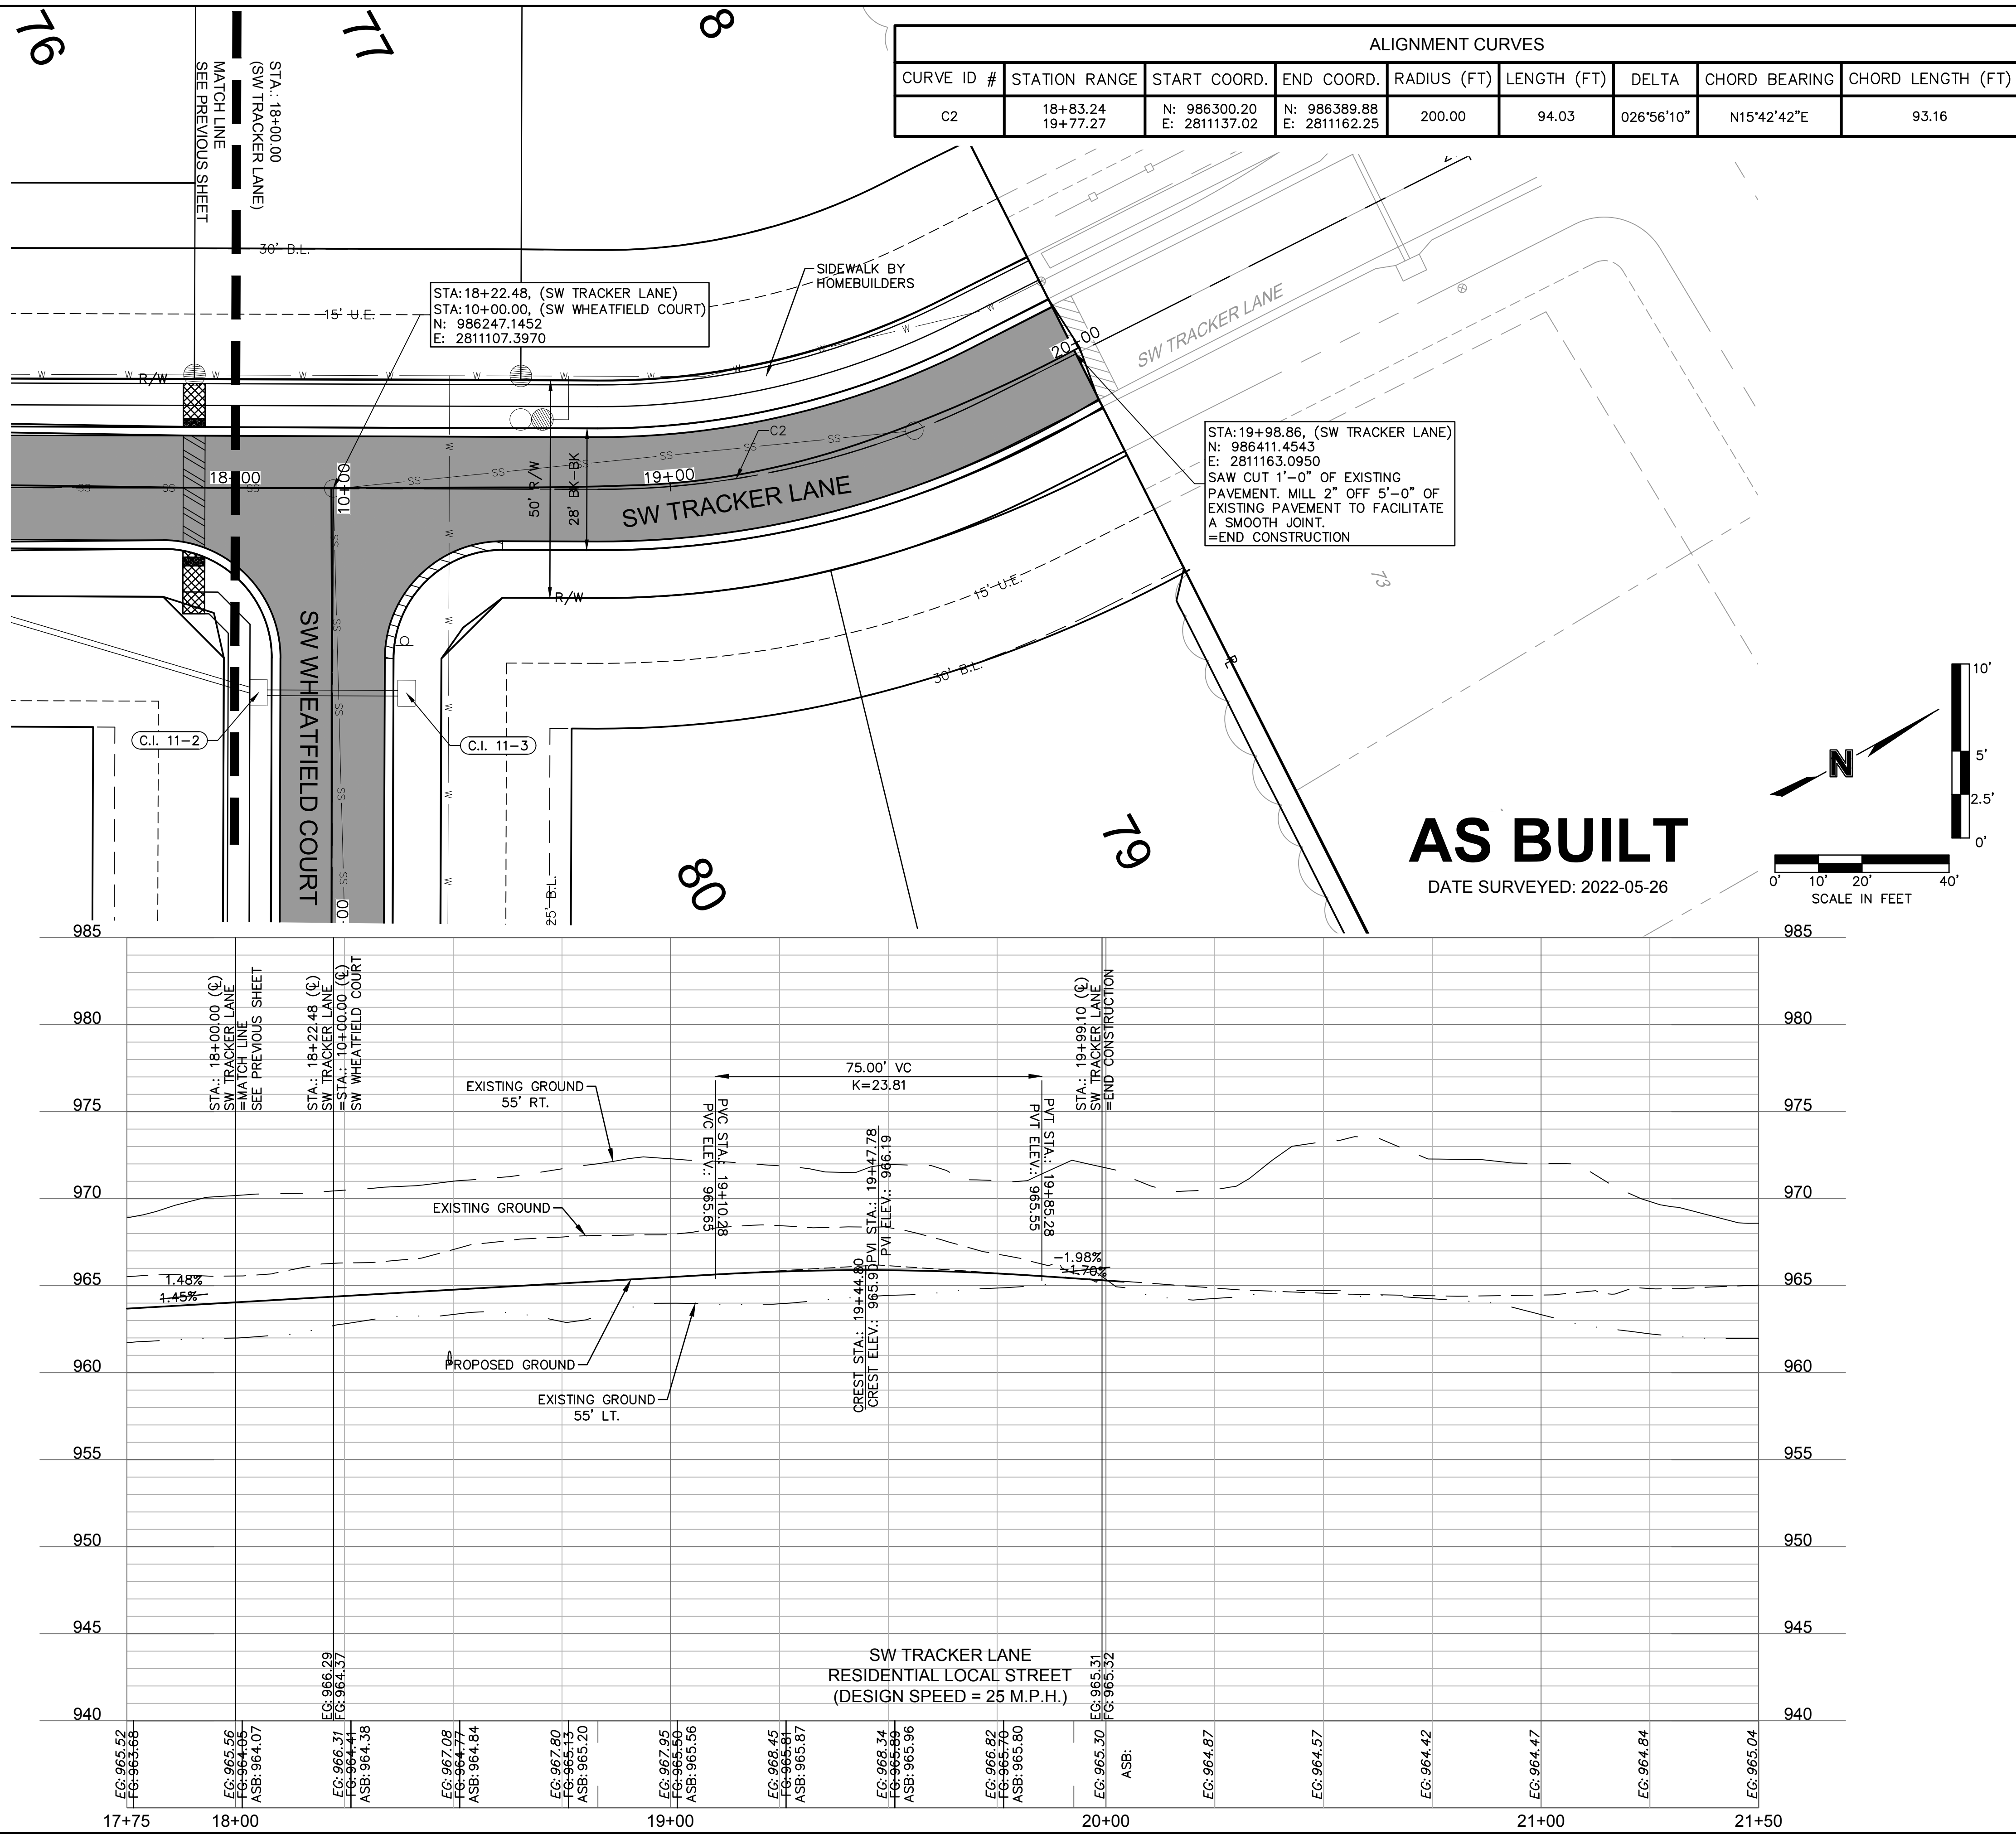

DWG: F:\2019\4001-4500\019-4061-BV40-Design\AutoCAD\Asbuilt\Sheets\GNCV\Street & Storm Plans\C_RPP02_B194061.dwg
DATE: Oct 11, 2022 3:32pm
XREFS: C_PTBK_B194061 C_XBASE_B194061 C_PBDY_B194061 C_PBASE_B194061 C_PUTIL_B194061 C_PPSURF_B194061 C_FBASE_B194061 C_PPATT_B194061
USER: ssoylor

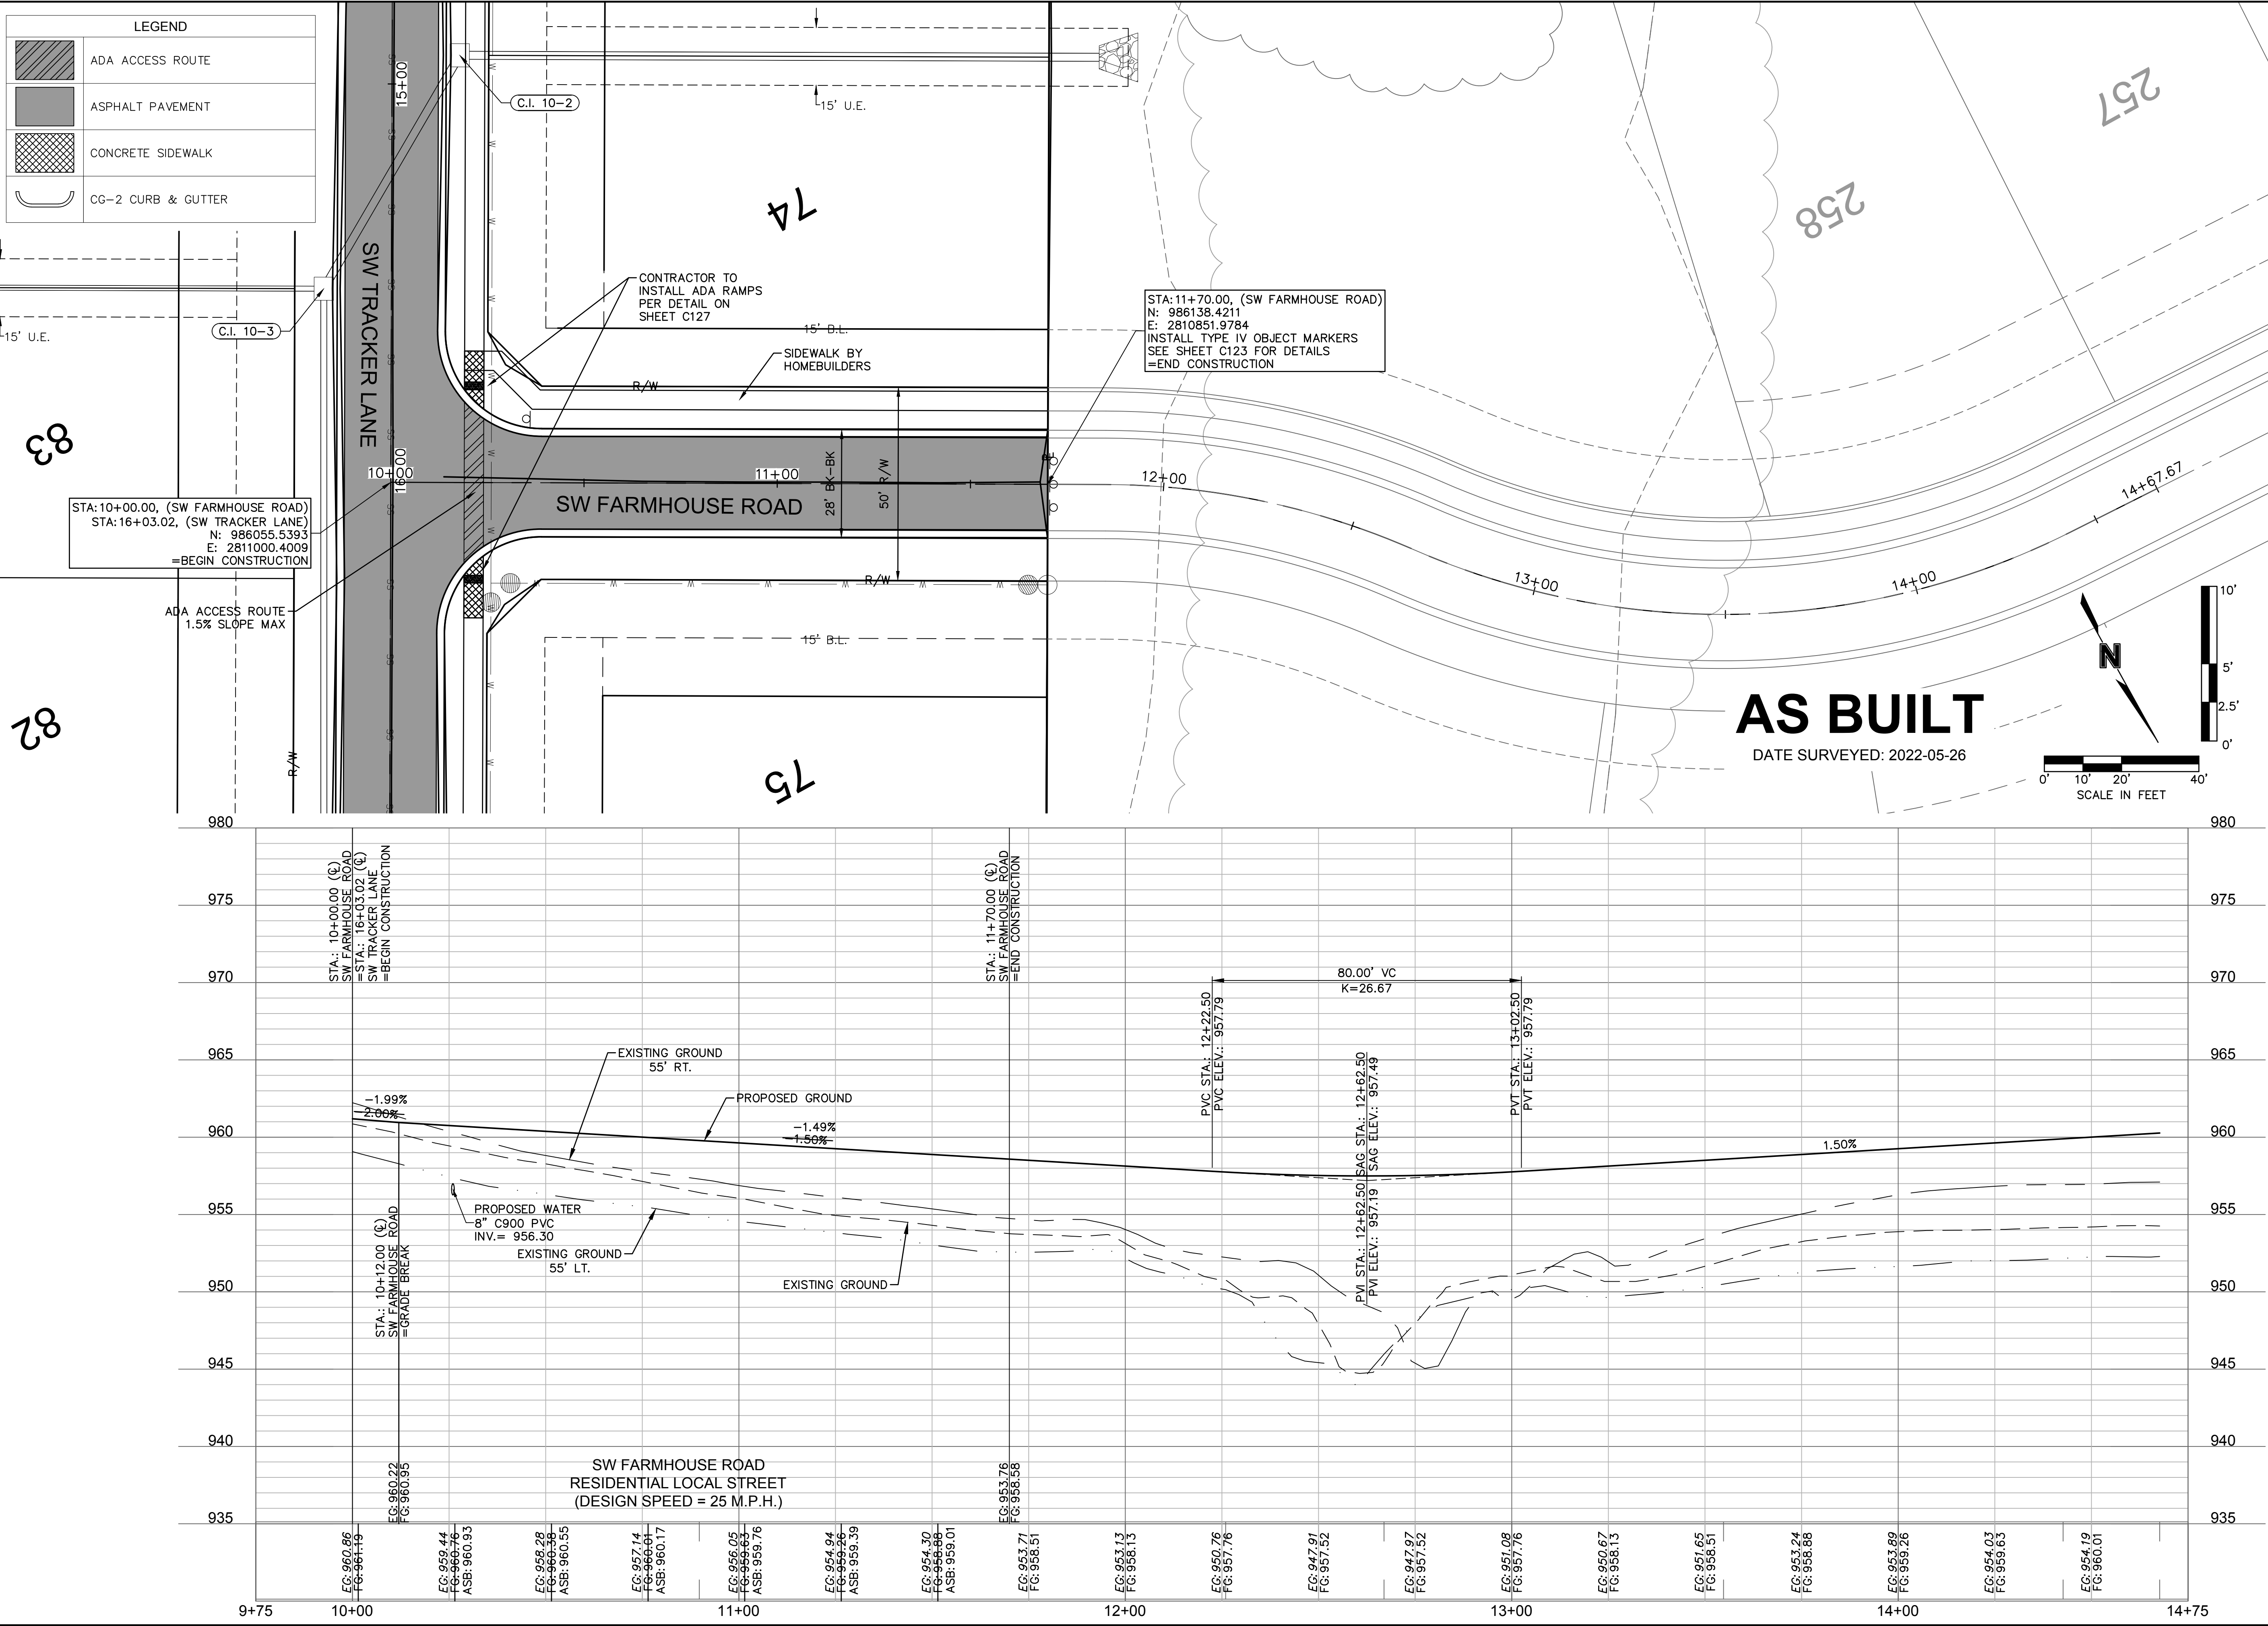

olsson

Olsson - Civil Engineering
Missouri Certificate of Authority #001592
1301 Burlington Street
North Kansas City, MO 64116
TEL 816.361.1177
FAX 816.361.1888
www.olsson.com

STATE OF MISSOURI
JULIE ELAINE SELLERS
NUMBER PE-2017000367
11/28/22
PROFESSIONAL ENGINEER

ROADWAY PLAN & PROFILE (SW FARMHOUSE ROAD)
STREET & STORM SEWER PLANS

HOOK FARMS
SECOND PLAT

LEE'S SUMMIT, MO

drawn by: B.M.W./A.A.
checked by: B.M.W.
designed by: B.M.W./A.A.
QA/QC by: J.E.S.
project no.: B19-4061
date: 01-08-2021


2021

REVISIONS


REV. NO.	DATE	REVISIONS DESCRIPTION	BY
1	03-23-2021	REVISED PER CITY COMMENTS	
2	04-16-2021	REVISED PER CITY COMMENTS	
3	09-30-2021	CHANGES TO APPROVED PLANS	

SHEET C118

LEGEND	
	ADA ACCESS ROUTE
	ASPHALT PAVEMENT
	CONCRETE SIDEWALK
	CG-2 CURB & GUTTER
	CG-2 DRY CURB & GUTTER

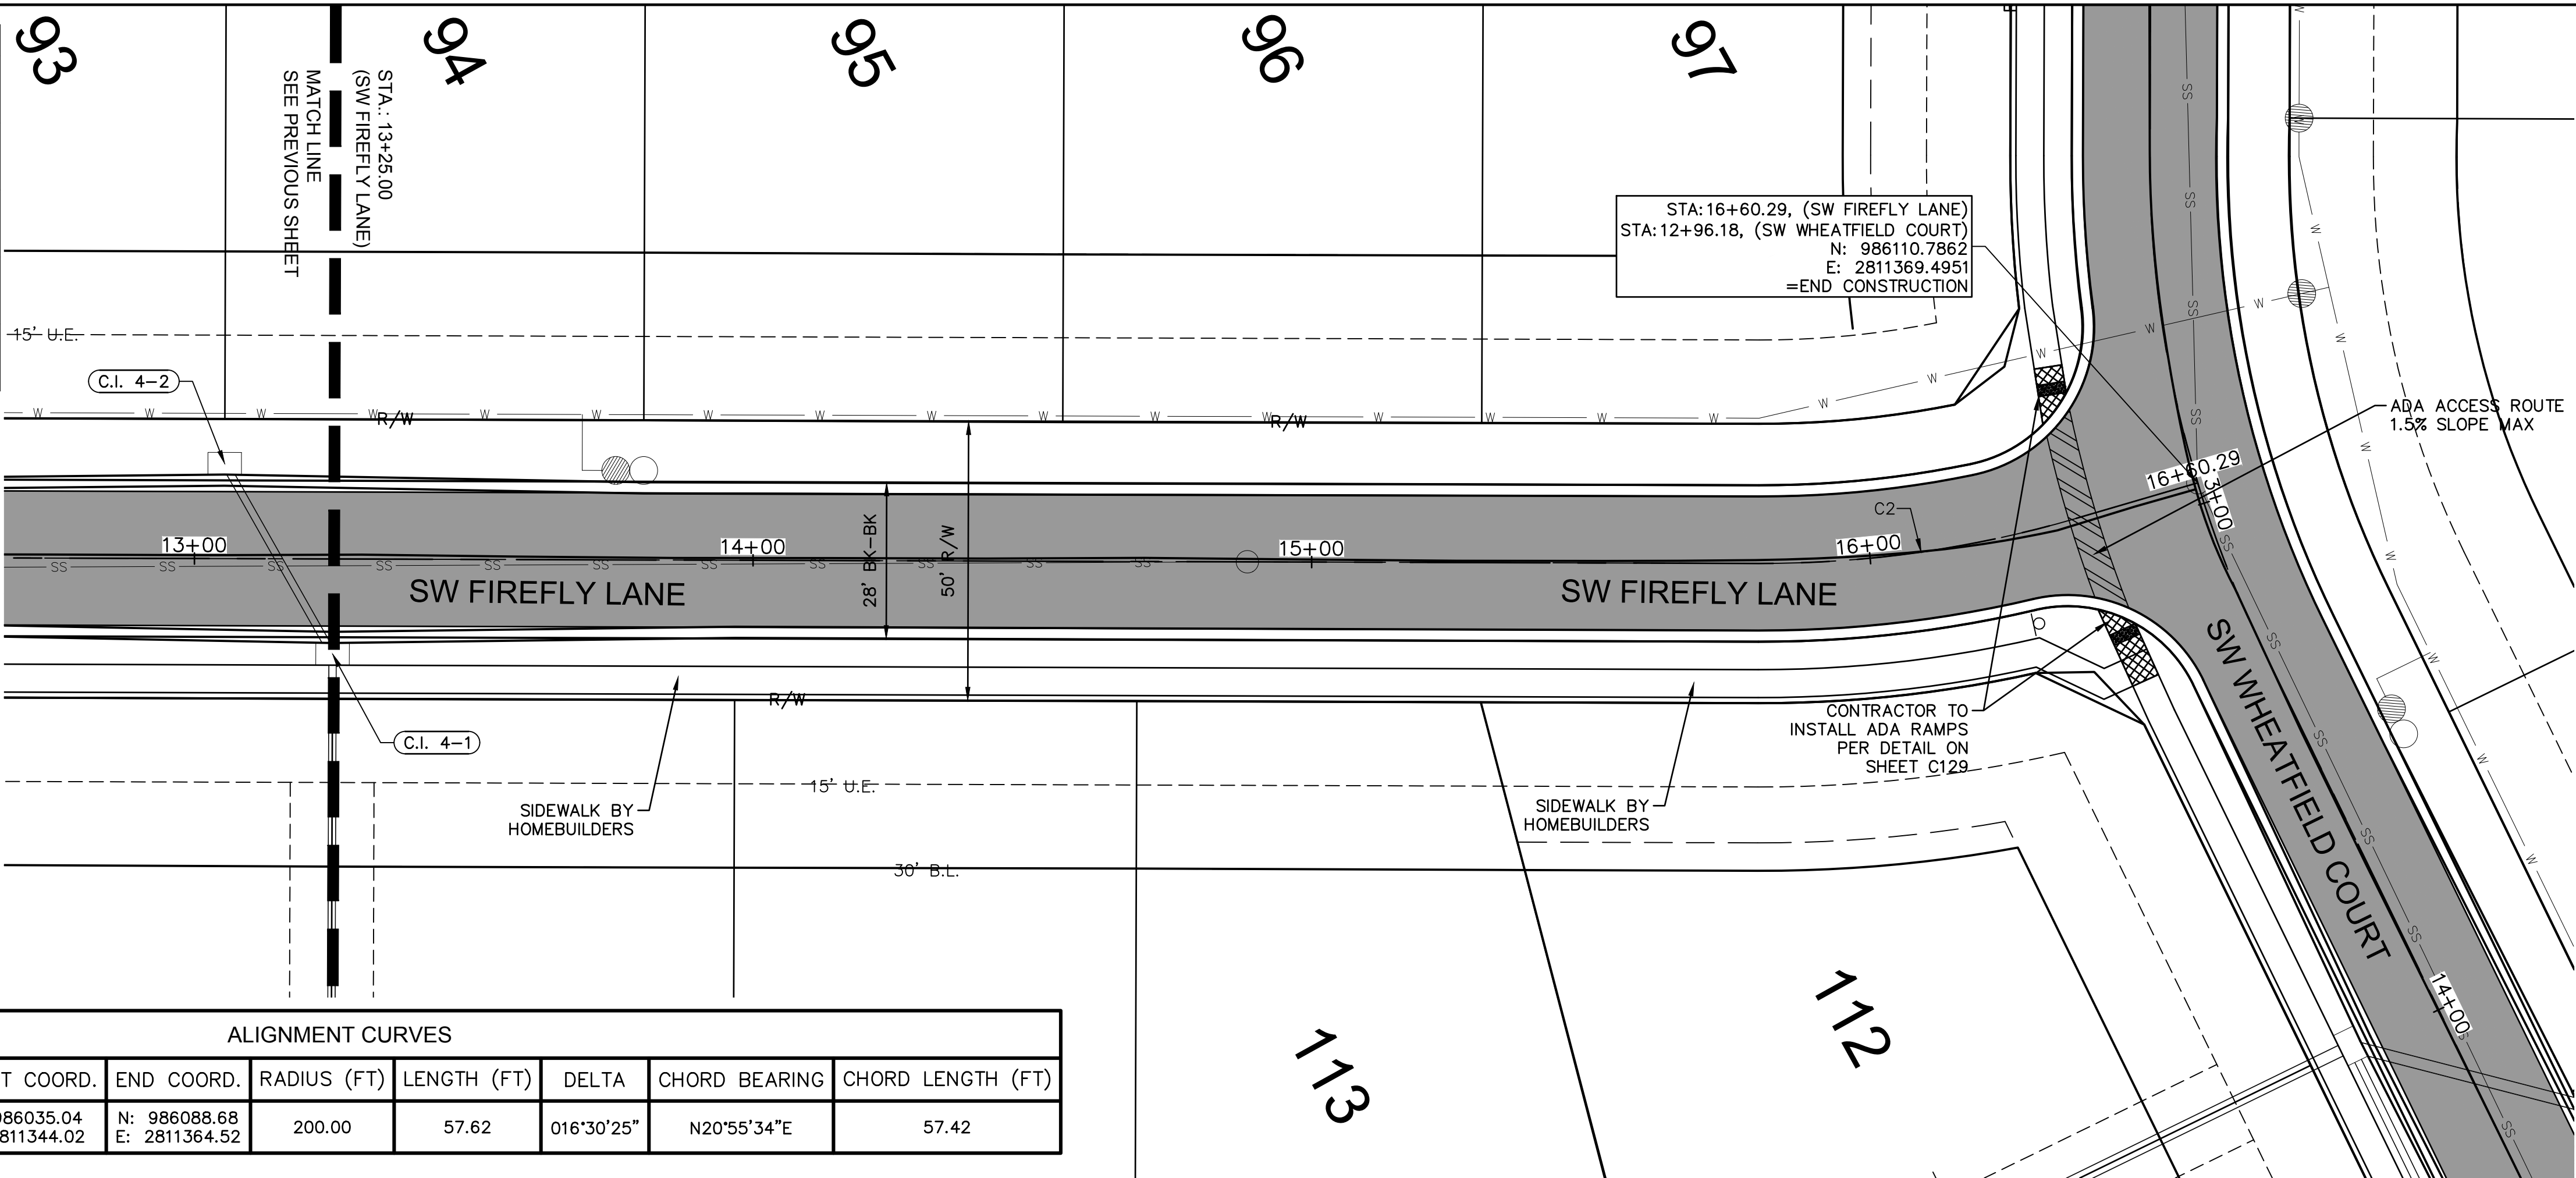

ALIGNMENT CURVES								
CURVE ID #	STATION RANGE	START COORD.	END COORD.	RADIUS (FT)	LENGTH (FT)	DELTA	CHORD BEARING	CHORD LENGTH (FT)
C2	15+80.01 16+37.63	N: 986035.04 E: 2811344.02	N: 986088.68 E: 2811364.52	200.00	57.62	016°30'25"	N20°55'34"E	57.42

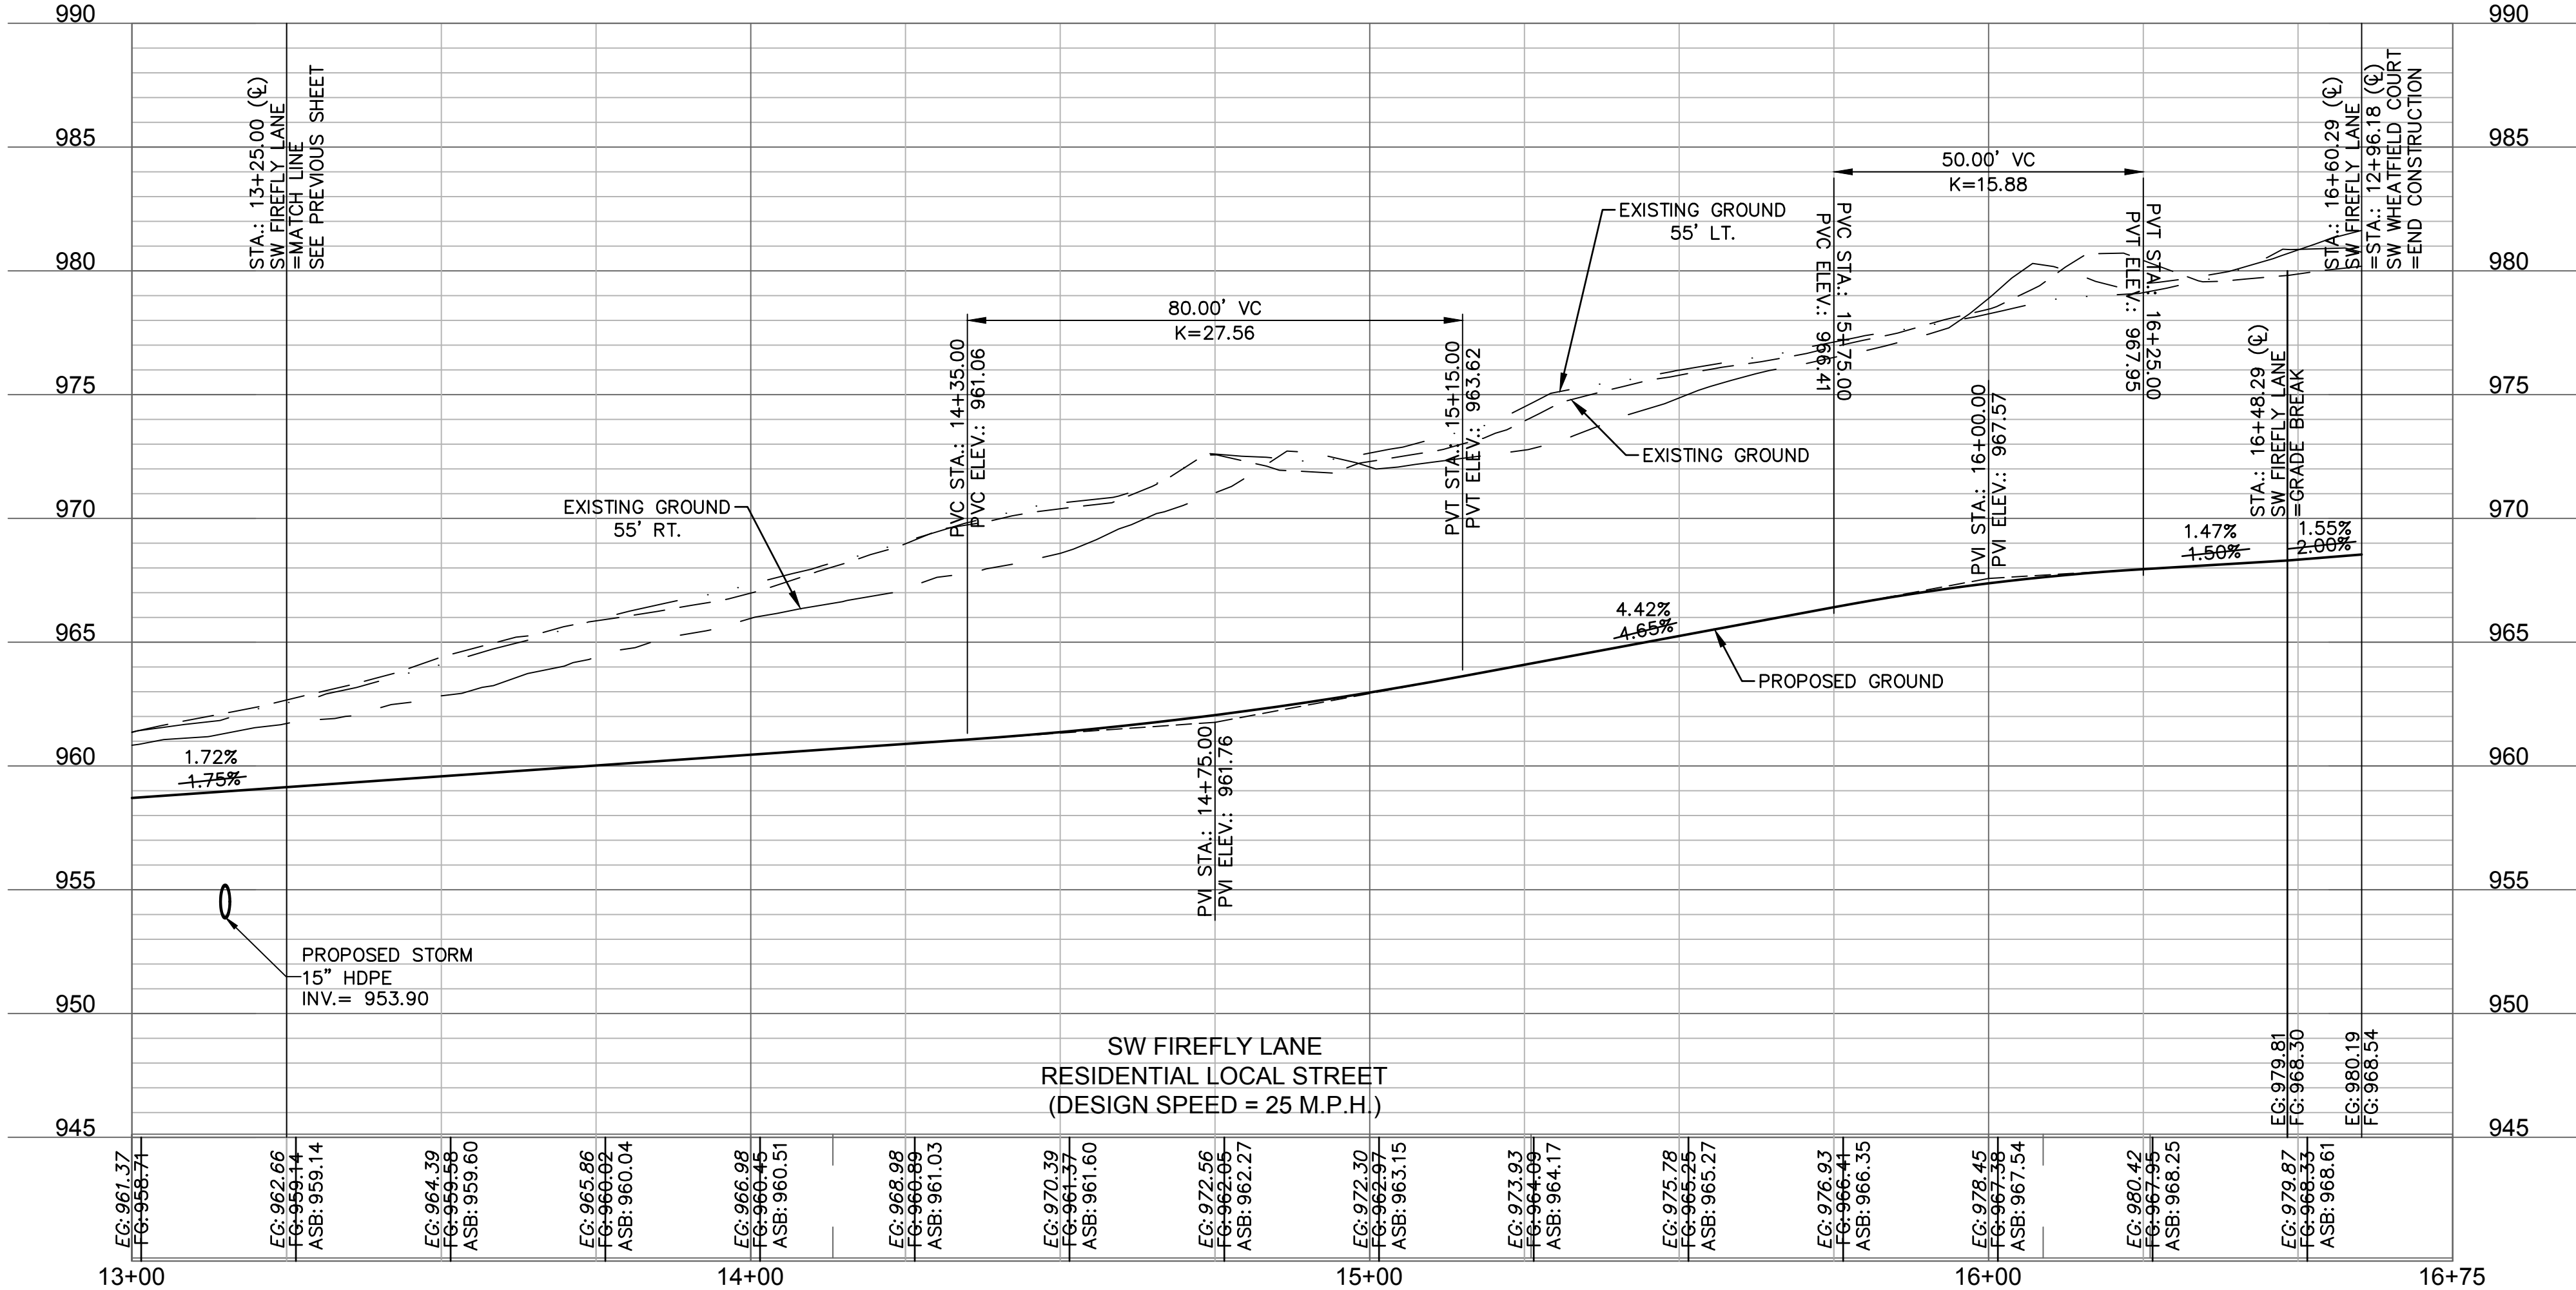

AS BUILT
DATE SURVEYED: 2022-05-26

olsson
Olsson - Civil Engineering
Missouri Certificate of Authority #001592
1301 Burlington Street
North Kansas City, MO 64116
TEL 816.361.1177
FAX 816.361.1888
www.olsson.com

STATE OF MISSOURI
JULIE ELAINE SELLERS
NUMBER PE-2017000367
11/28/22
PROFESSIONAL ENGINEER


REV. NO.	DATE	REVISIONS DESCRIPTION	BY
1	03-23-2021	REVISED PER CITY COMMENTS	
2	04-16-2021	REVISED PER CITY COMMENTS	
3	09-30-2021	CHANGES TO APPROVED PLANS	

ROADWAY PLAN & PROFILE (SW FIREFLY LANE) STREET & STORM SEWER PLANS		2021
HOOK FARMS SECOND PLAT		
LEE'S SUMMIT, MO		



drawn by:	B.M.W./A.A.
checked by:	B.M.W.
designed by:	B.M.W./A.A.
QA/QC by:	J.E.S.
project no.:	B19-4061
date:	01-08-2021

DWG: F:\2019\4001-4500\019-4061-BV40-Design\AutoCAD\Asbuilt\Sheets\GNCA\Street & Storm Plans\C_RPP03_B194061.dwg
DATE: Oct 11, 2022 3:33pm
XREFS: C_PTBLK_B194061 C_XBASE_B194061 C_PBASE_B194061 C_PBDY_B194061 C_PUTIL_B194061 C_PSURF_B194061 C_FBASE_B194061 C_PPATT_B194061
USER: ssoylor

LEGEND	
	ADA ACCESS ROUTE
	ASPHALT PAVEMENT
	CONCRETE SIDEWALK
	CG-2 CURB & GUTTER

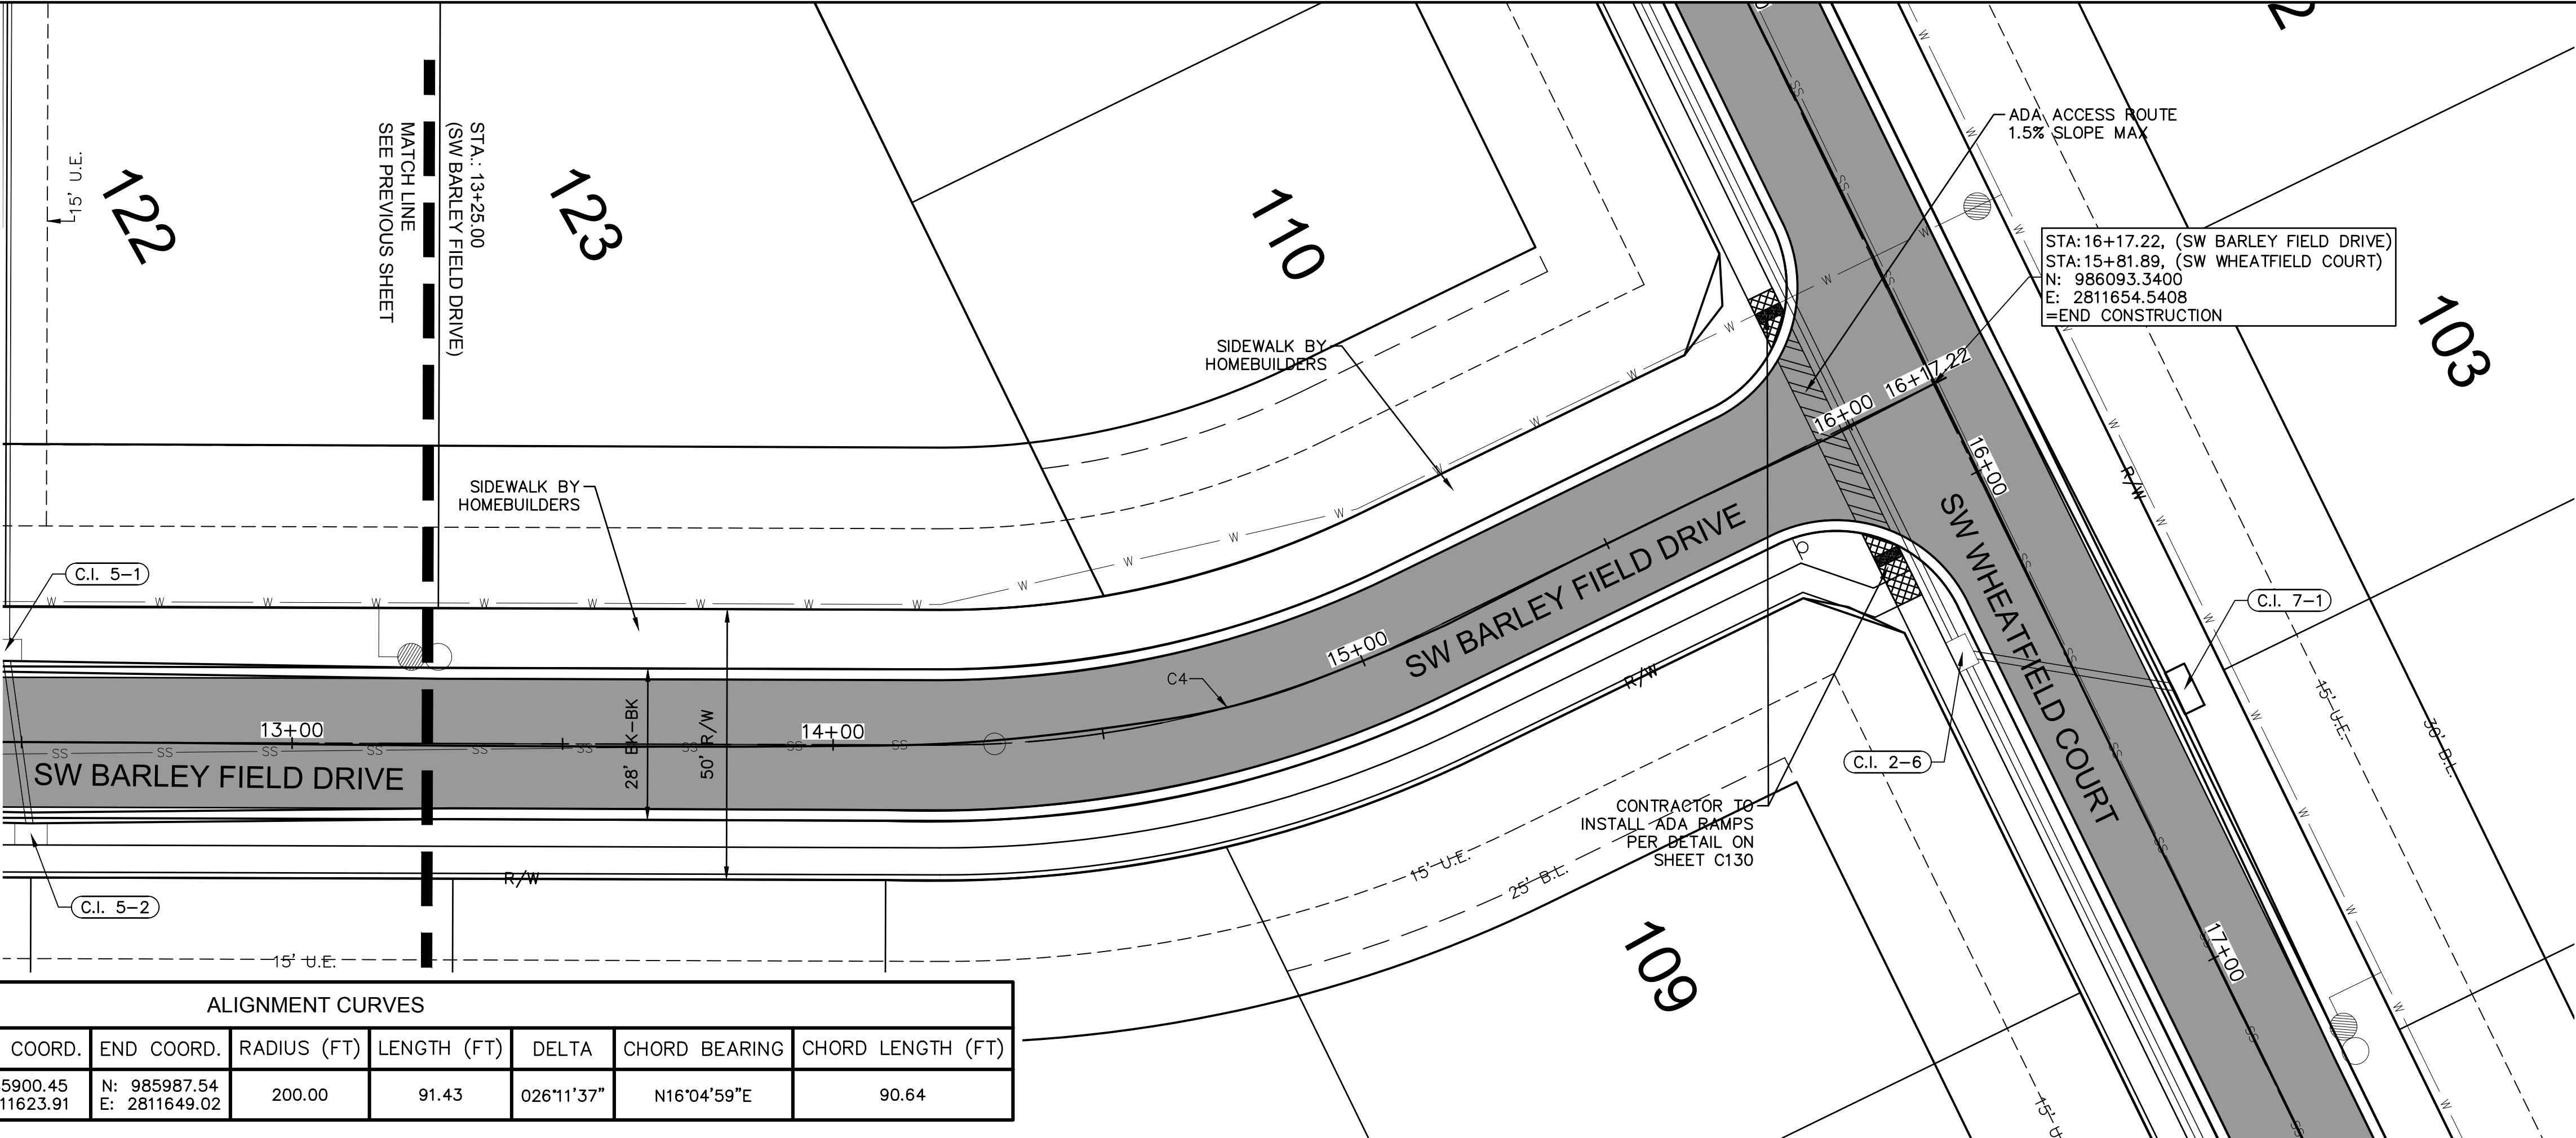

ALIGNMENT CURVES								
CURVE ID #	STATION RANGE	START COORD.	END COORD.	RADIUS (FT)	LENGTH (FT)	DELTA	CHORD BEARING	CHORD LENGTH (FT)
C4	14+19.84 15+11.28	N: 985900.45 E: 2811623.91	N: 985987.54 E: 2811649.02	200.00	91.43	026°11'37"	N16°04'59"E	90.64

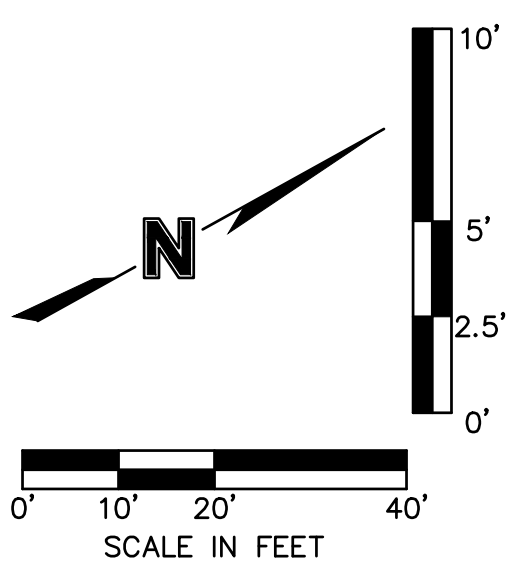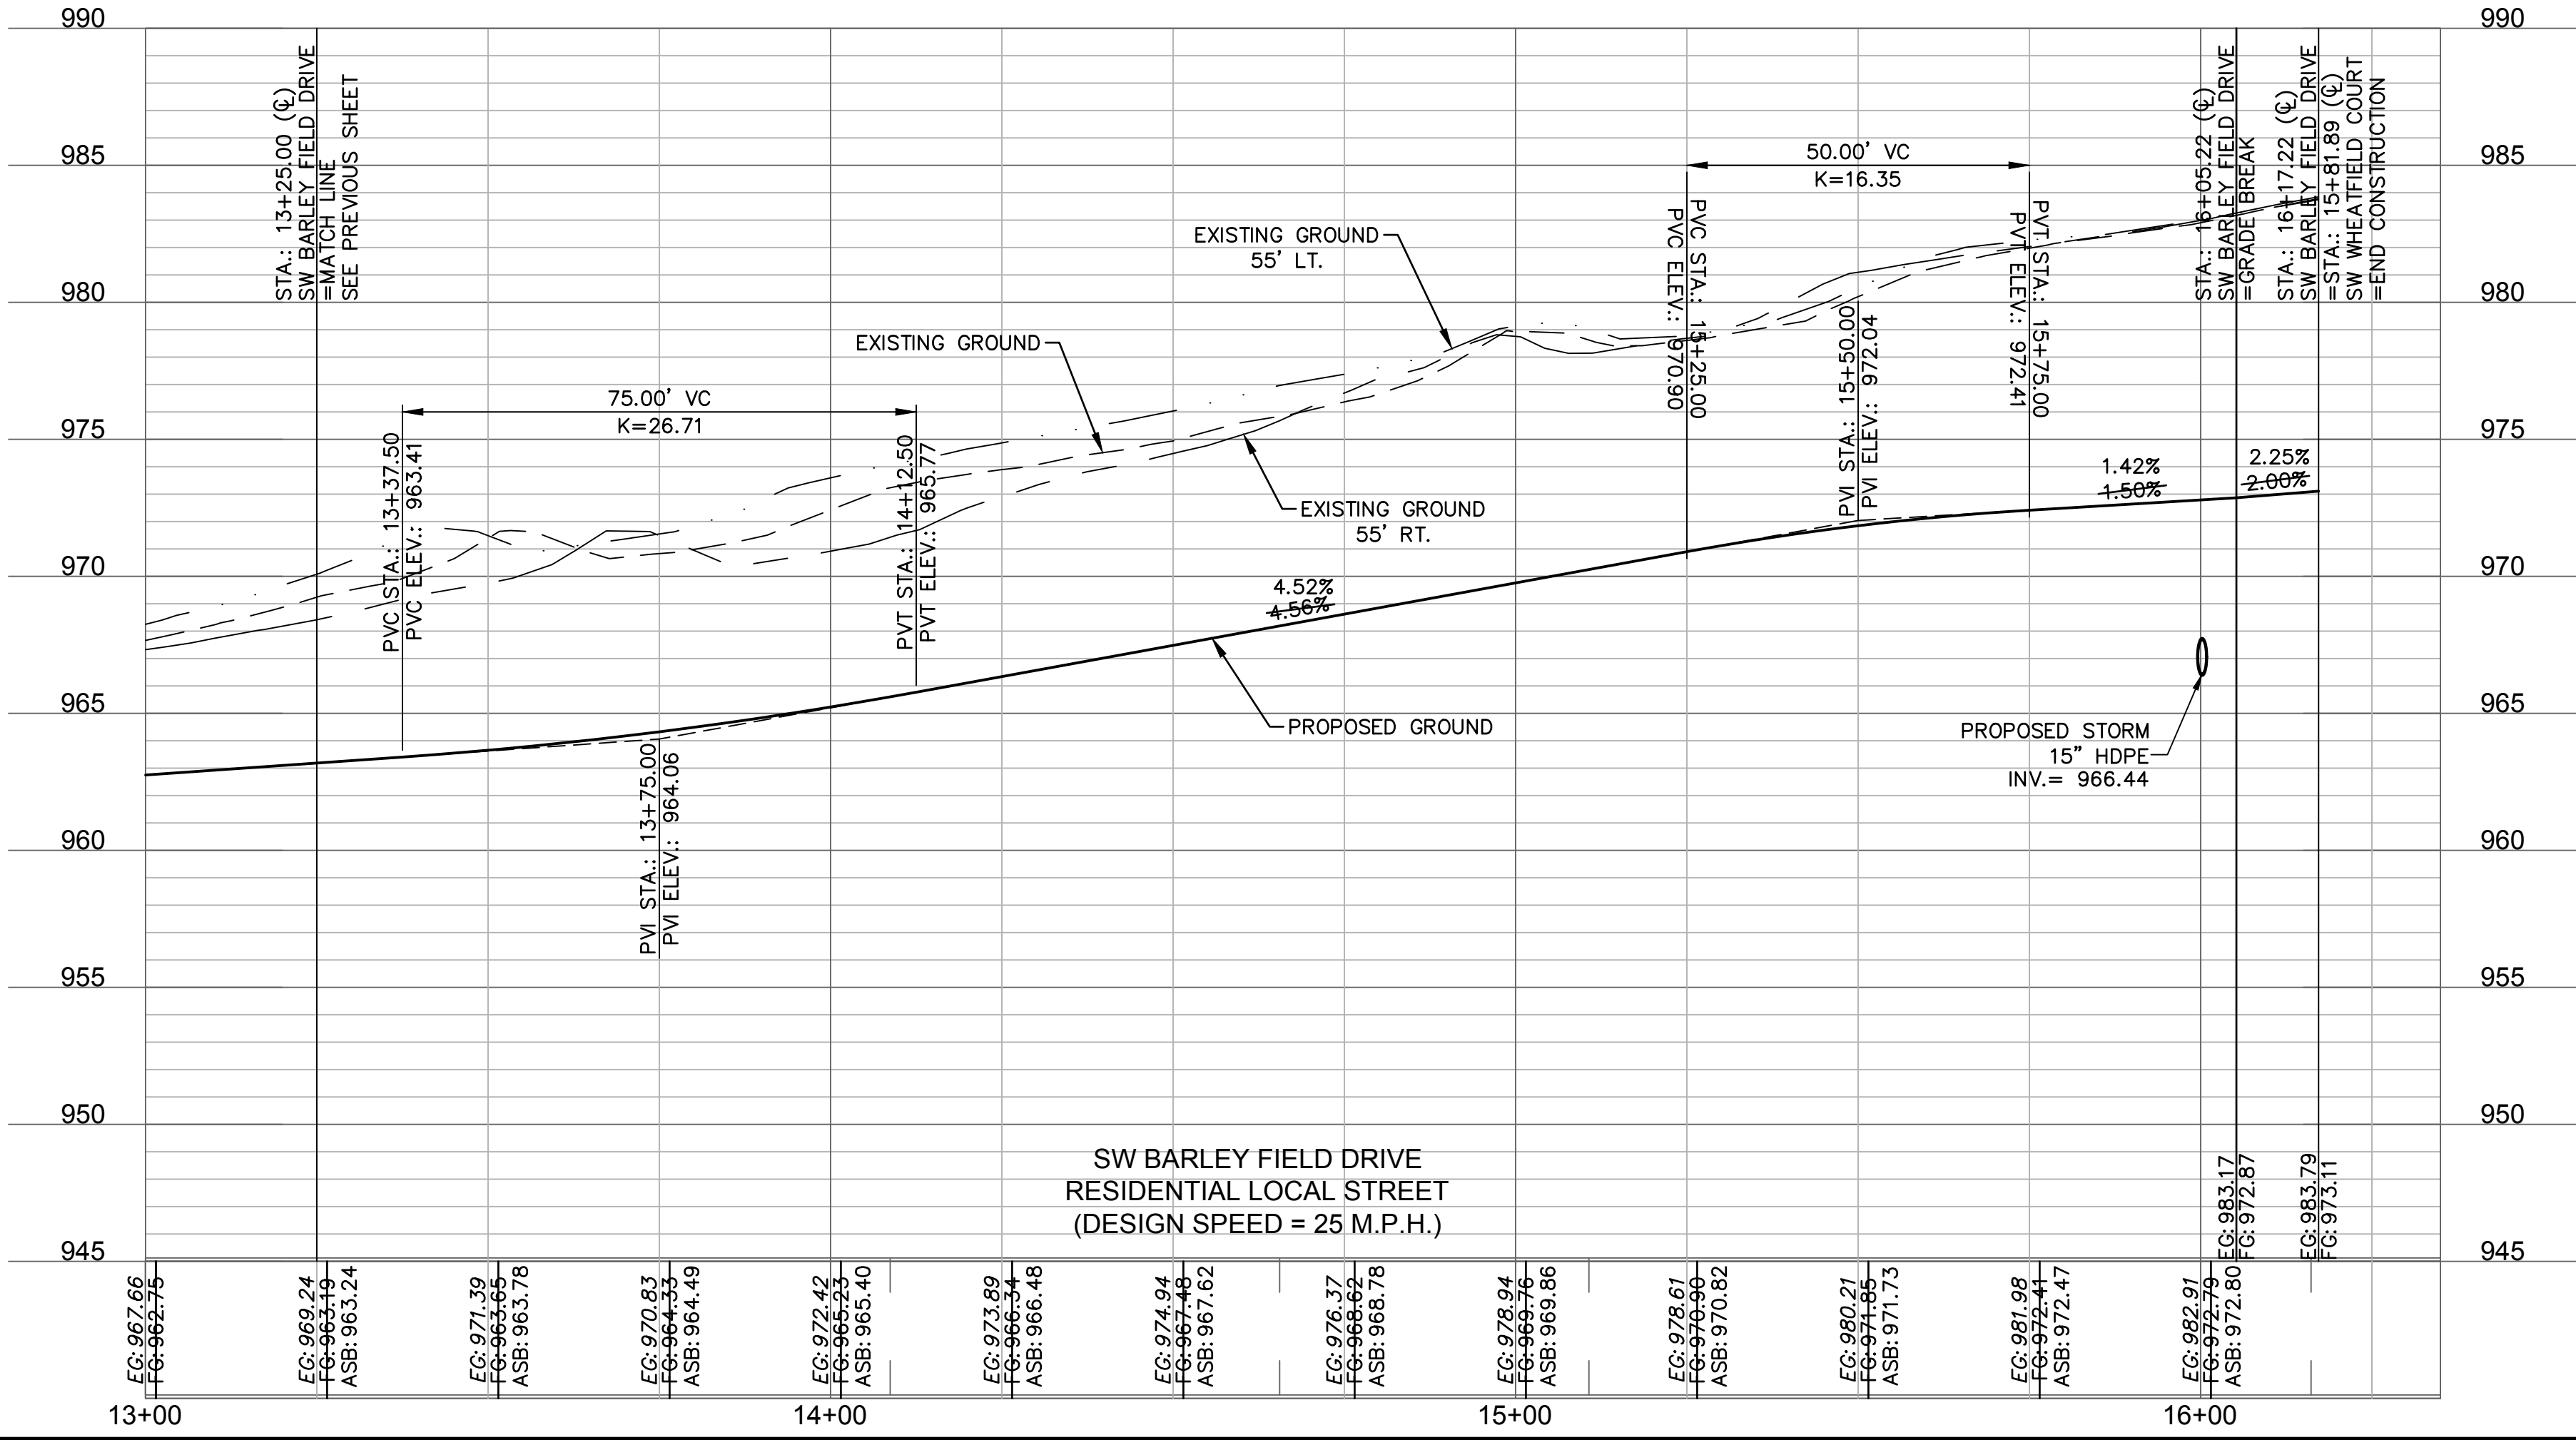

AS BUILT
DATE SURVEYED: 2022-05-26

olsson

Olsson - Civil Engineering
Missouri Certificate of Authority #001592
1301 Burlington Street
North Kansas City, MO 64116
TEL 816.361.1177
FAX 816.361.1888
www.olsson.com

STATE OF MISSOURI
JULIE ELAINE SELLERS
NUMBER PE-2017000367
11/28/22
PROFESSIONAL ENGINEER

ROADWAY PLAN & PROFILE (SW BARLEY FIELD DRIVE)
STREET & STORM SEWER PLANS

HOOK FARMS
SECOND PLAT

LEE'S SUMMIT, MO

drawn by: B.M.W./A.A.
checked by: B.M.W.
designed by: B.M.W./A.A.
QA/QC by: J.E.S.
project no.: B19-4061
date: 01-08-2021

2021

REV. NO.

DATE

REVISIONS DESCRIPTION

BY

1

03-23-2021

REVISED PER CITY COMMENTS

2

04-16-2021


REVISED PER CITY COMMENTS

3

09-30-2021

CHANGES TO APPROVED PLANS

REVISIONS

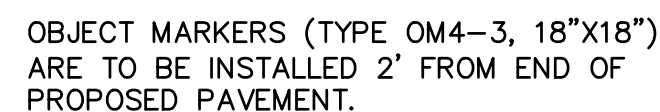

DWG: F:\2019\4001-4500\019-4061-B\40-Design\AutoCAD\Asbuilt\Sheets\GNCV\Street & Storm Plans\C_TOP01_B194061.dwg
 DATE: Oct 11, 2022 3:34pm XREFS: C:\PTBLK_B194061 C:\XBASE_B194061 C:\PBN DY_B194061
 USER: ssaylor C:\PUTIL

EAGLE CREEK
FIRST PLAT

TRACT M

HOOK FARMS
1ST PLAT

TRAFFIC CONTROL PLAN STREET & STORM SEWER PLANS

HOOK FARMS SECOND PLAT

LEE'S SUMMIT, MO

drawn by: B.M.W./A.A.
checked by: B.M.W.
designed by: B.M.W./A.A.
QA/QC by: J.E.S.
project no.: B19-4061
date: 01-08-2021

SHEET
C123

[illegible]


DEVISIONIC




olson

Olsson - Civil Engineering
Missouri Certificate of Authority #001592
1301 Burlington Street
North Kansas City, MO 64116
TEL 816.361.1177
FAX 816.361.1888
www.olsson.com


JER:	ssay/or			
C_PUTIL_B194061	C_FBASE_B194061	C_PSTRM_B194061	C_PSURF_B194061	C_PPATT_B194061

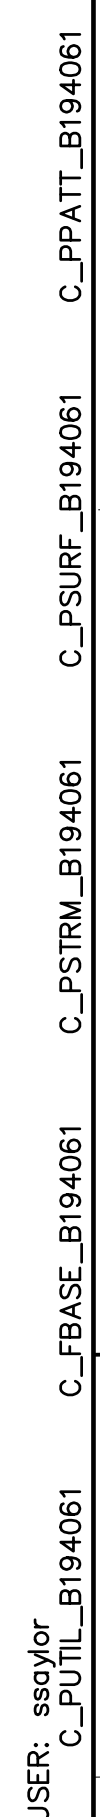


3. SLOPES.
4. LANDING SHALL BE PROVIDED WHERE INDICATED ON PLAN SHEET OR BY PROWAG STANDARDS. LANDING SHALL BE 4'x4' MINIMUM.
5. RAMP RUNS SHALL HAVE A MAXIMUM RUNNING SLOPE OF 1:12 UNLESS THE RAMP LENGTH IS OVER 15 FEET, THEN THE SLOPE CAN BE GREATER AS INDICATED IN DETAILS TO REACH STREET GRADES.
6. LANDINGS SHALL HAVE A MAXIMUM SLOPE OF 2% IN ANY DIRECTION.
7. CROSS SLOPE FOR RAMPS AND SIDEWALK SHALL NOT EXCEED 2%.
8. AFTER CURBS HAVE BEEN CONSTRUCTED, AND BEFORE ASPHALT OR CONCRETE PAVEMENT IS POURED, CURBS SHOULD BE MEASURED WITH A LEVEL TO ENSURE CURB ALONG ADA RAMPS AND LANDINGS WILL MEET ADA REQUIREMENTS.
9. ADA RAMP CONSTRUCTION WILL BE INSPECTED THOROUGHLY BY THE CITY INSPECTOR. CONTRACTOR SHALL BE REQUIRED TO RECONSTRUCT RAMPS, CURBS AND/OR PAVEMENT AT CONTRACTOR'S EXPENSE IF ADA RAMPS AND LANDINGS CANNOT MEET THE ADA REQUIREMENTS, PER APPROVED PLAN OR APPROVED ALTERNATIVE.
10. CURVE DATA IS FOR BACK OF CURB.

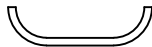LEGEND	
TC—	TOP OF CURB
PV—	TOP OF PAVEMENT
SW—	SIDEWALK
L	LANDING AREA
R	RAMP AREA
T	TRANSITION AREA
	ADA ACCESS ROUTE
	CG-2 CURB & GUTTER
	CG-2 DRY CURB & GUTTER
	ADA RAMP (CONSTRUCTED BY CONTRACTOR)



NOT AS-BUILT

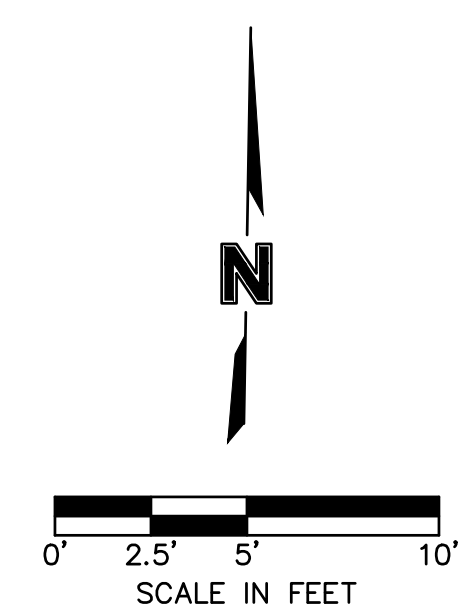[illegible]


	C_PUTIL_B194061	C_FBASE_B194061	C_PSTRM_B194061	C_PSURF_B194061	C_PPATT_B194061
--	-----------------	-----------------	-----------------	-----------------	-----------------

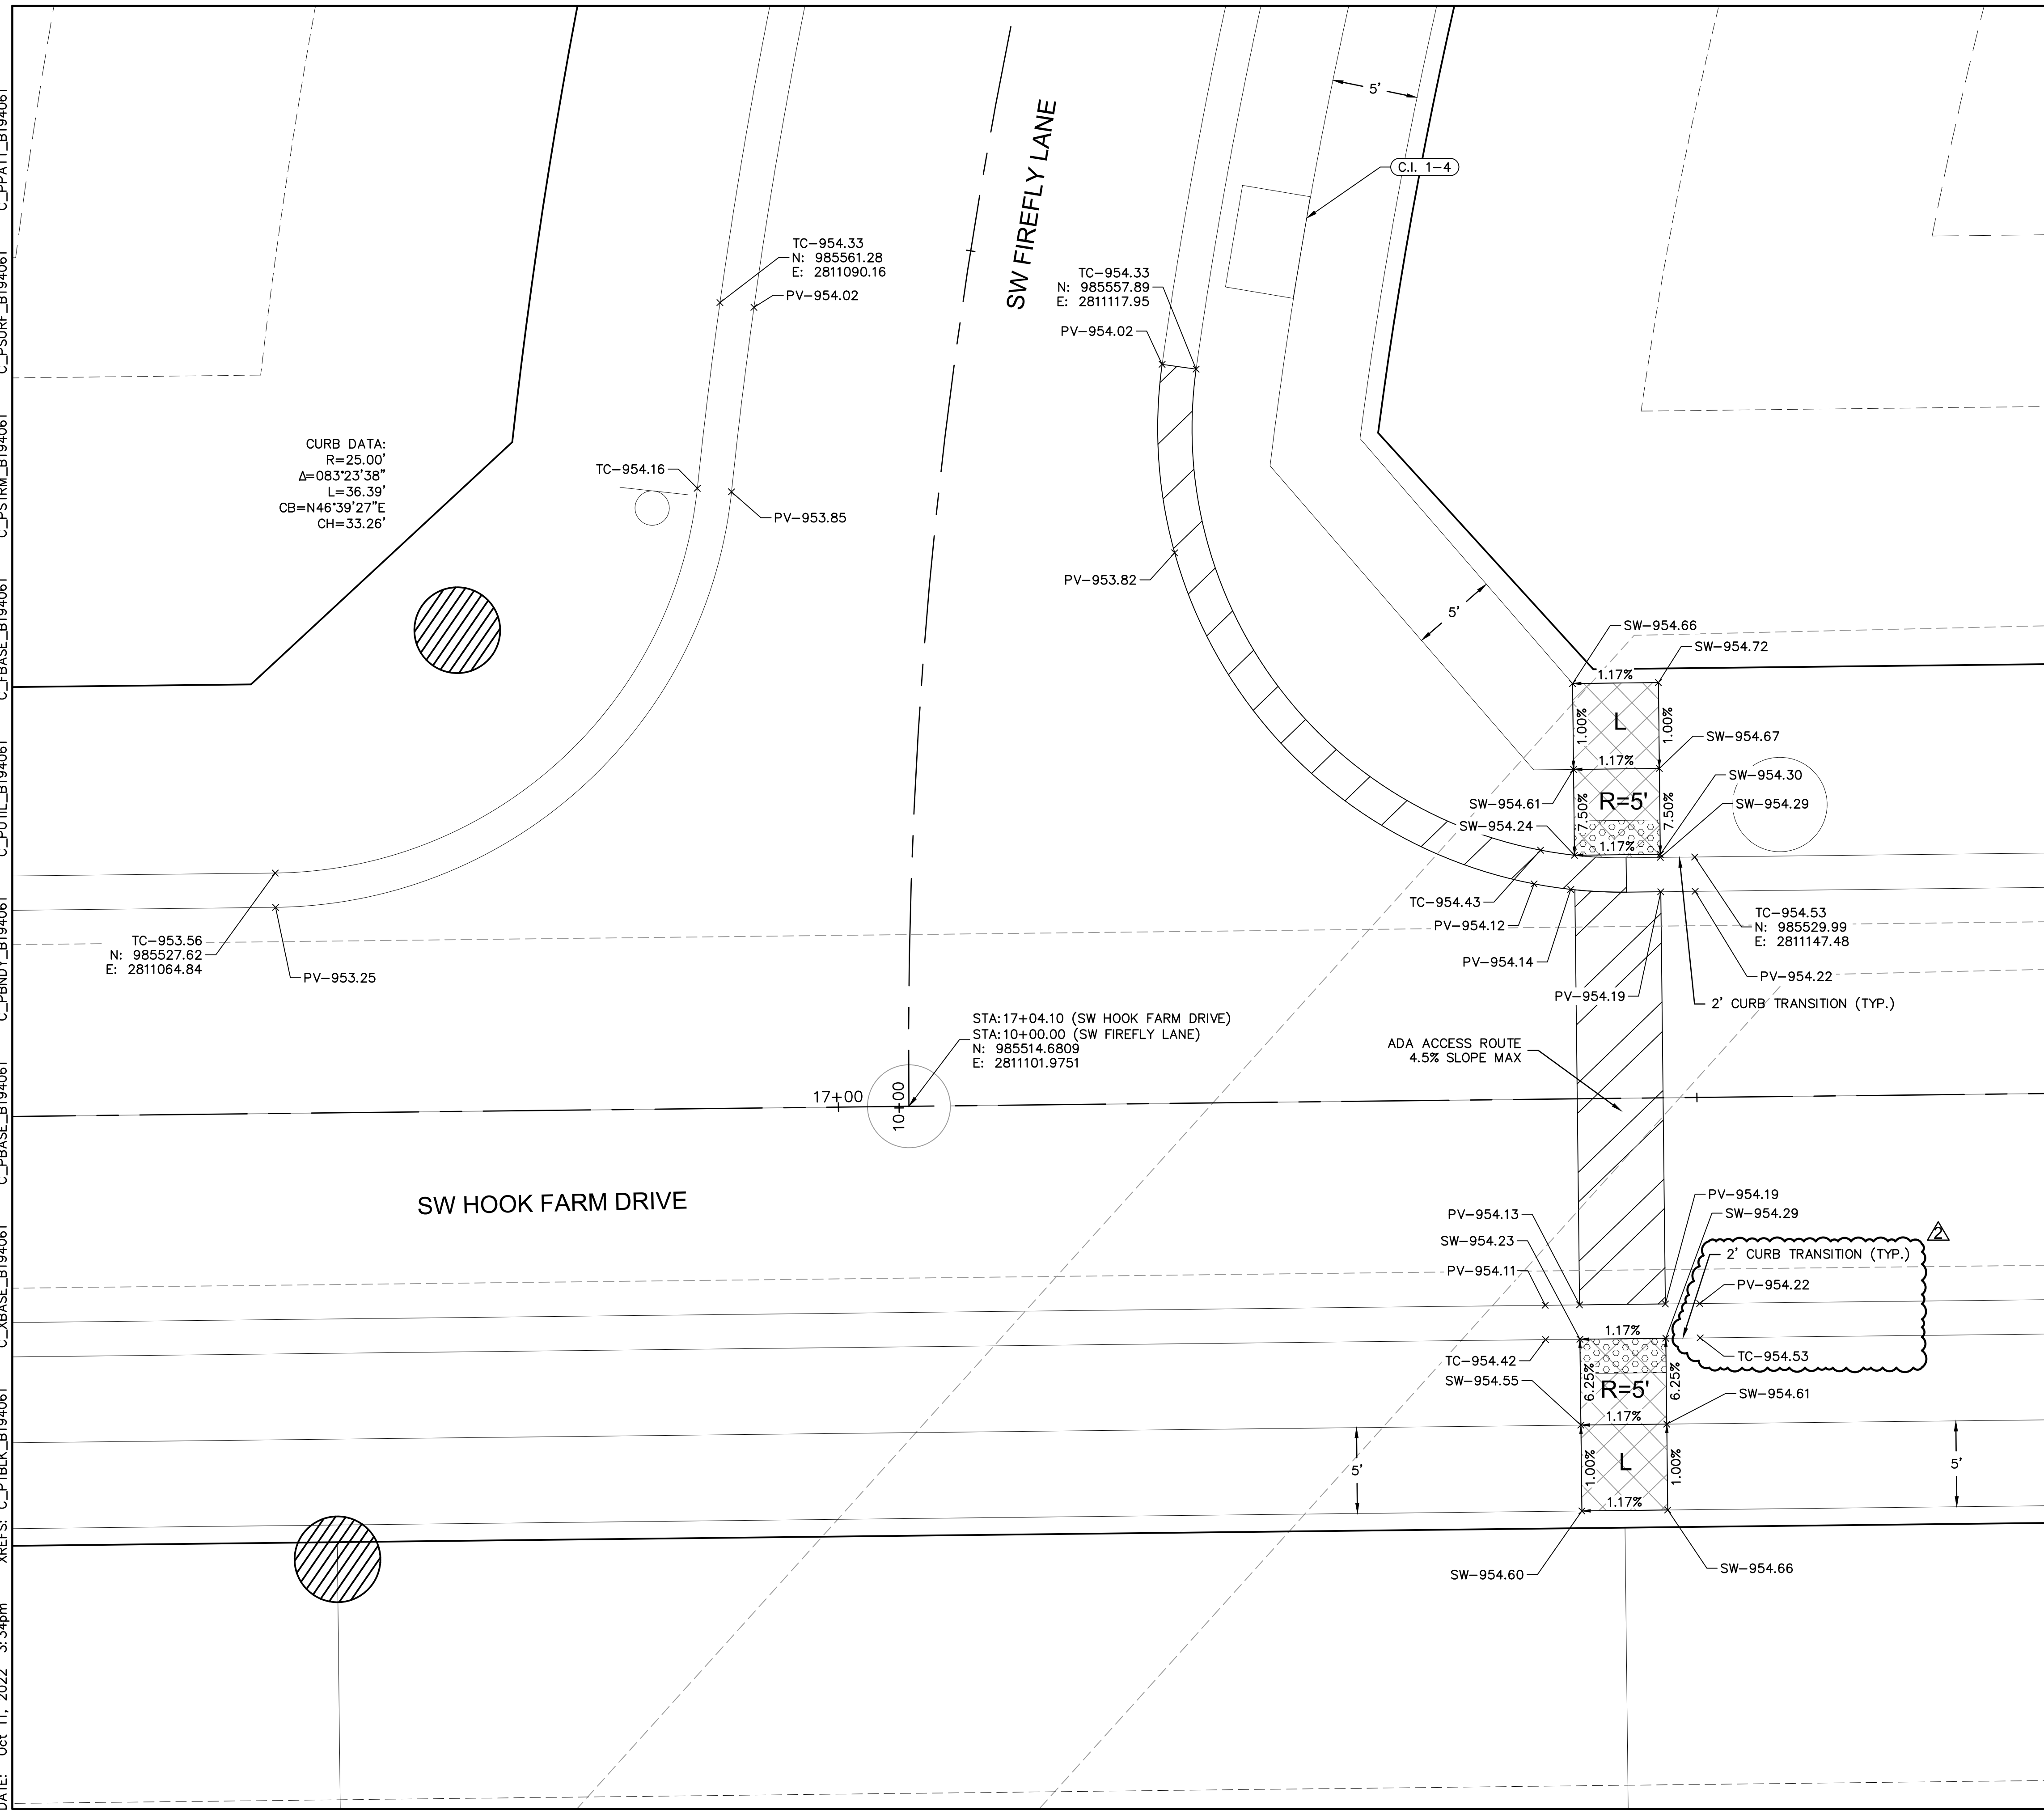

1. ALL ADA CURB RAMPS SHALL BE BUILT PER CURRENT MUNICIPALITY ADOPTED ADA STANDARDS.
2. CURB RAMP FLARES SHALL NOT BE STEEPER THAN 1:10 MAX SLOPES.
3. LANDING SHALL BE PROVIDED WHERE INDICATED ON PLAN SHEET OR BY PROWAG STANDARDS. LANDING SHALL BE 4'X4' MINIMUM.
4. RAMP RUNS SHALL HAVE A MAXIMUM RUNNING SLOPE OF 1:12 UNLESS THE RAMP LENGTH IS OVER 15 FEET, THEN THE SLOPE CAN BE GREATER AS INDICATED IN DETAILS TO REACH STREET GRADES.
5. LANDINGS SHALL HAVE A MAXIMUM SLOPE OF 2% IN ANY DIRECTION.
6. CROSS SLOPE FOR RAMPS AND SIDEWALK SHALL NOT EXCEED 2%.
7. AFTER CURBS HAVE BEEN CONSTRUCTED, AND BEFORE ASPHALT OR CONCRETE PAVEMENT IS POURED, CURBS SHOULD BE MEASURED WITH A LEVEL TO ENSURE CURB ALONG ADA RAMPS AND LANDINGS WILL MEET ADA REQUIREMENTS.
8. ADA RAMP CONSTRUCTION WILL BE INSPECTED THOROUGHLY BY THE CITY INSPECTOR. CONTRACTOR SHALL BE REQUIRED TO RECONSTRUCT RAMPS, CURBS AND/OR PAVEMENT AT CONTRACTOR'S EXPENSE IF ADA RAMPS AND LANDINGS CANNOT MEET THE ADA REQUIREMENTS, PER APPROVED PLAN OR APPROVED ALTERNATIVE.
9. CURVE DATA IS FOR BACK OF CURB.

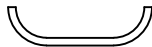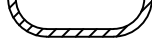
LEGEND	
TC—	TOP OF CURB
PV—	TOP OF PAVEMENT
SW—	SIDEWALK
L	LANDING AREA
R	RAMP AREA
T	TRANSITION AREA
	ADA ACCESS ROUTE
	CG-2 CURB & GUTTER
	CG-2 DRY CURB & GUTTER
	ADA RAMP (CONSTRUCTED BY CONTRACTOR)


NOT AS-BUILT

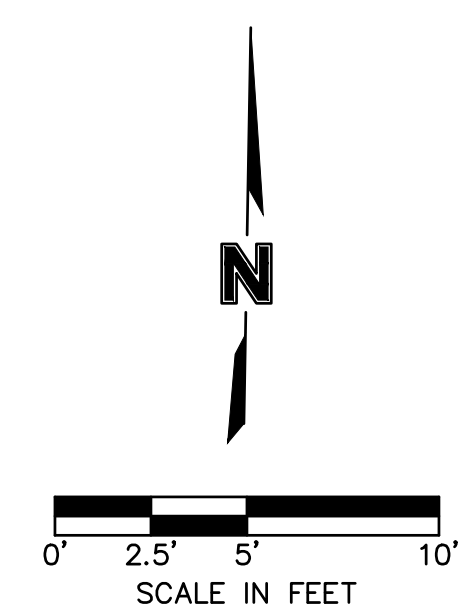


SW FIREFLY LANE & SW HOOK FARM DRIVE STREET & STORM SEWER PLANS		HOOK FARMS SECOND PLAT		2021	
				LEE'S SUMMIT, MO	
drawn by: _____		B.M.W./A.A.			
checked by: _____		B.M.W.			
designed by: _____		B.M.W./A.A.			
QA/QC by: _____		J.E.S.			
project no.: _____		B19-4061			
date: _____		01-08-2021			
SHEET C125					

& Storm Plans\C_INT01_B194061.dwg	USER: ssaylor		
C_PBASE_B194061	C_PUTIL_B194061	C_FBASE_B194061	C_PSTRM_B194061
			C_PSURF_B194061
			C_PPATT_B194061

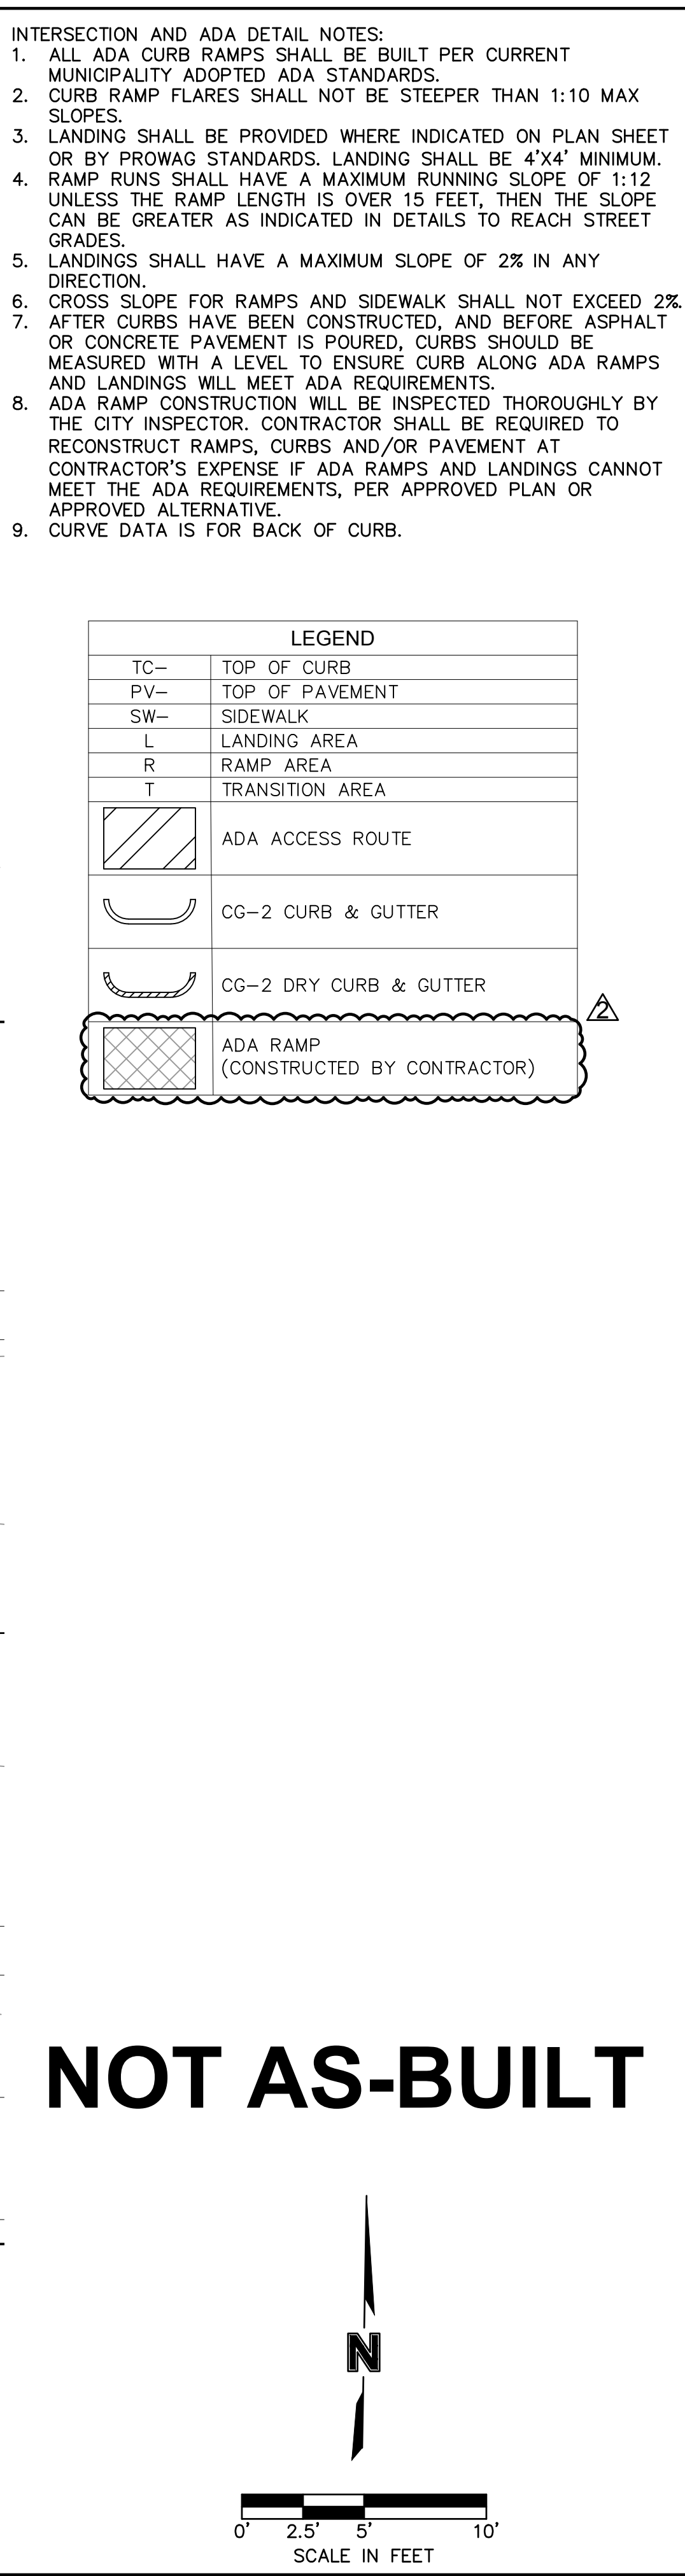

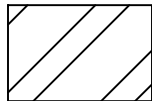LEGEND	
TC-	TOP OF CURB
PV-	TOP OF PAVEMENT
SW-	SIDEWALK
L	LANDING AREA
R	RAMP AREA
T	TRANSITION AREA
	ADA ACCESS ROUTE
	CG-2 CURB & GUTTER
	CG-2 DRY CURB & GUTTER
	ADA RAMP (CONSTRUCTED BY CONTRACTOR)


NOT AS-BUILT

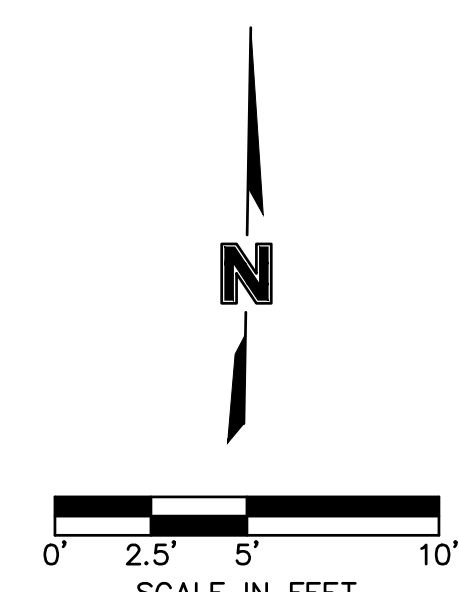


olsson

Olsson - Civil Engineering
Missouri Certificate of Authority #001592
1301 Burlington Street
North Kansas City, MO 64116
TEL 816.361.1177
FAX 816.361.1888
www.olsson.com


DWG: F:\2019\4001-4500\019-4061-B\40-Design\AutoCAD\Asbuilt\Sheets\GNCV\Street & Storm Plans\C_INT01_B194061.dwg	USER: ssayor
XREFS: C:\PTBLK\B194061	C_PBASE_B194061
DATE: Oct 11, 2022 3:34pm	C_PENDY_B194061
	C_PUTIL1_B194061
	C_PSTRM_B194061
	C_PBASE_B194061
	C_PSTRM_B194061
	C_PSURF_B194061
	C_PPATT_B194061

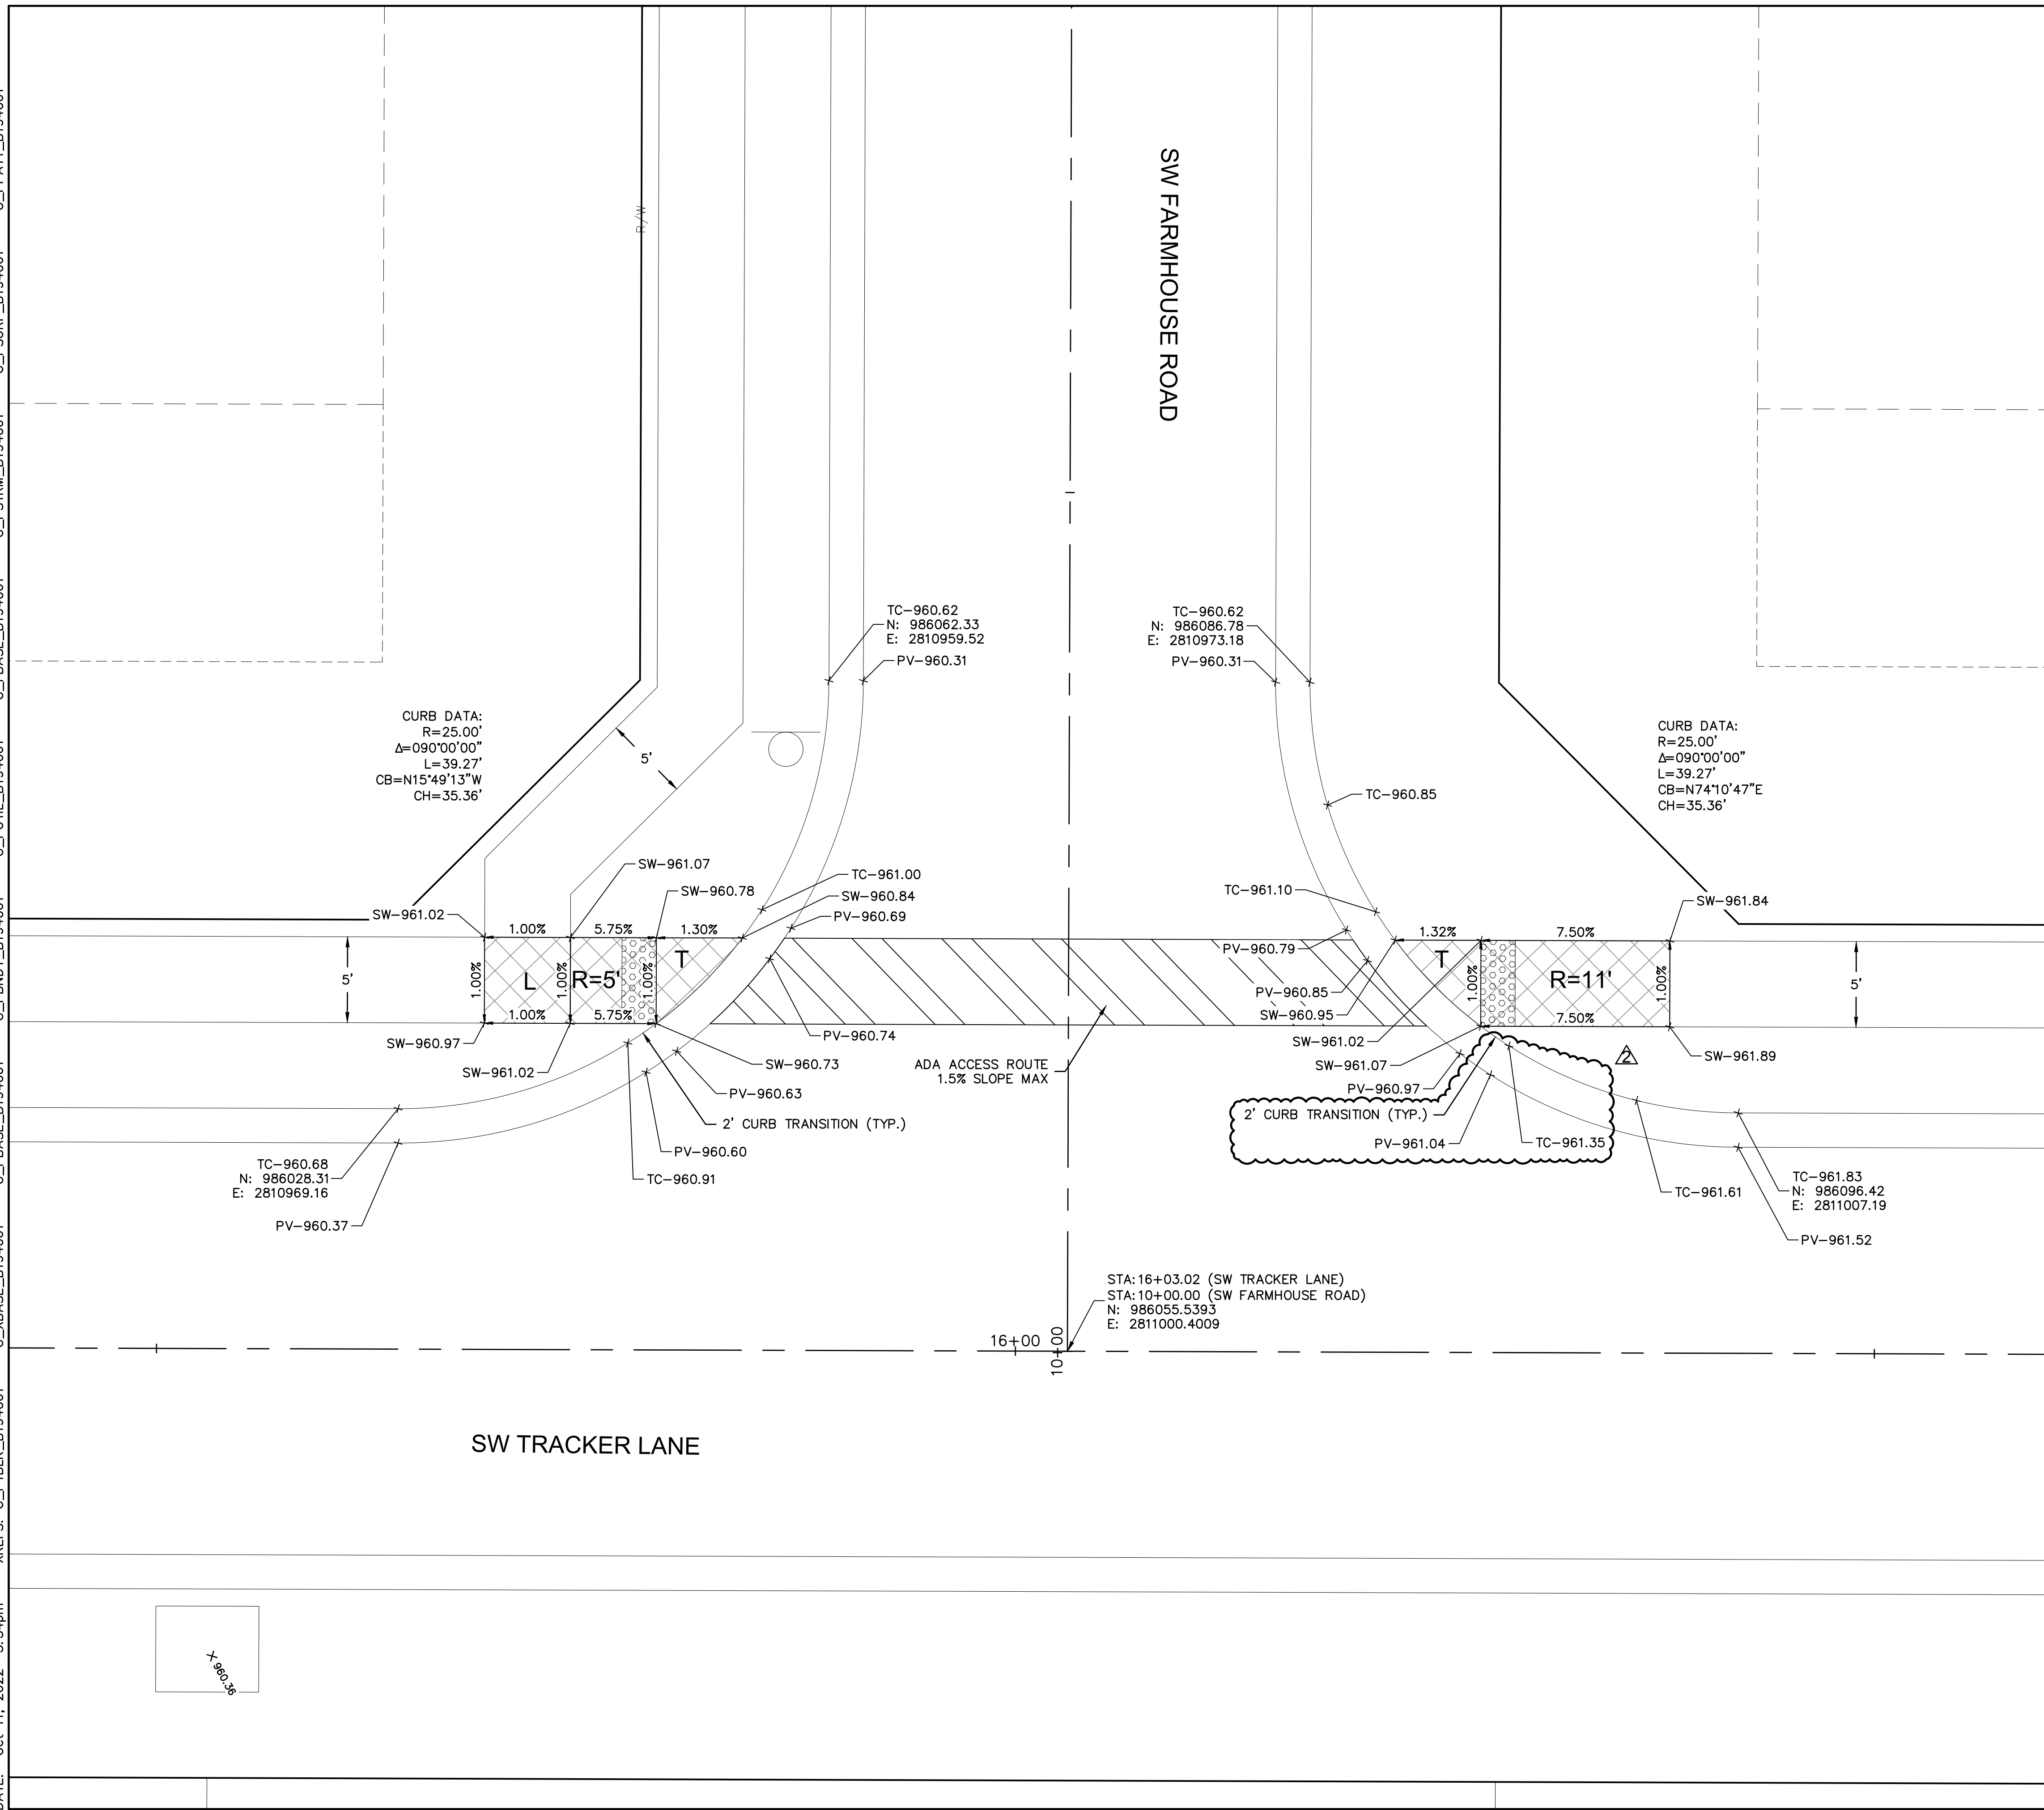

- INTERSECTION AND ADA DETAIL NOTES:
1. ALL ADA CURB RAMPS SHALL BE BUILT PER CURRENT MUNICIPALITY ADOPTED ADA STANDARDS.
2. CURB RAMP FLARES SHALL NOT BE STEEPER THAN 1:10 MAX SLOPES.
3. LANDING SHALL BE PROVIDED WHERE INDICATED ON PLAN SHEET OR BY PROWAG STANDARDS. LANDING SHALL BE 4'x4' MINIMUM.
4. RAMP RUNS SHALL HAVE A MAXIMUM RUNNING SLOPE OF 1:12 UNLESS THE RAMP LENGTH IS OVER 15 FEET, THEN THE SLOPE CAN BE GREATER AS INDICATED IN DETAILS TO REACH STREET GRADES.
5. LANDINGS SHALL HAVE A MAXIMUM SLOPE OF 2% IN ANY DIRECTION.
6. CROSS SLOPE FOR RAMPS AND SIDEWALK SHALL NOT EXCEED 2%.
7. AFTER RAMPS HAVE BEEN CONSTRUCTED, AND BEFORE ASPHALT OR CONCRETE PAVEMENT IS LAYED, CURBS SHOULD BE MEASURED WITH A LEVEL TO ENSURE CURB ALONG ADA RAMPS AND LANDINGS WILL MEET ADA REQUIREMENTS.
8. ADA RAMP CONSTRUCTION WILL BE INSPECTED THOROUGHLY BY THE CITY INSPECTOR. CONTRACTOR SHALL BE REQUIRED TO RECONSTRUCT RAMPS, CURBS AND/OR PAVEMENT AT CONTRACTOR'S EXPENSE IF ADA RAMPS AND LANDINGS CANNOT MEET THE ADA REQUIREMENTS, PER APPROVED PLAN OR APPROVED ALTERNATIVE.
9. CURVE DATA IS FOR BACK OF CURB.

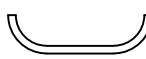LEGEND	
TC-	TOP OF CURB
PV-	TOP OF PAVEMENT
SW-	SIDEWALK
L	LANDING AREA
R	RAMP AREA
T	TRANSITION AREA
	ADA ACCESS ROUTE
	CG-2 CURB & GUTTER
	CG-2 DRY CURB & GUTTER
	ADA RAMP (CONSTRUCTED BY CONTRACTOR)

NOT AS-BUILT

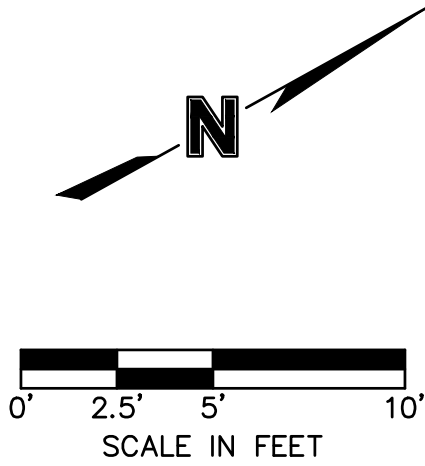


						Olsson - Civil Engineering Missouri Certificate of Authority #001592 1301 Burlington Street North Kansas City, MO 64116 TEL 816.361.1177 FAX 816.361.1888 www.olsson.com	
SW FARMHOUSE ROAD & SW TRACKER LANE STREET & STORM SEWER PLANS			REV.	DATE	REVISIONS DESCRIPTION	BY	
		1	03-23-2021		REVISED PER CITY COMMENTS		
		2	04-16-2021		REVISED PER CITY COMMENTS		
		3	09-30-2021		CHANGES TO APPROVED PLANS		
HOOK FARMS SECOND PLAT							
LEE'S SUMMIT, MO		2021			REVISIONS		

drawn by: _____ B.M.W./A.
 checked by: _____ B.M.W./
 designed by: _____ B.M.W./A.A.
 QA/QC by: _____ J.E.S.
 project no.: _____ 819-4061
 date: _____ 01-08-2021


SHEET

C127

USER: ssayfor			
C_PUTIL_B194061	C_FBASE_B194061	C_PSTRM_B194061	C_PSURF_B194061
C_PPATT_B194061			

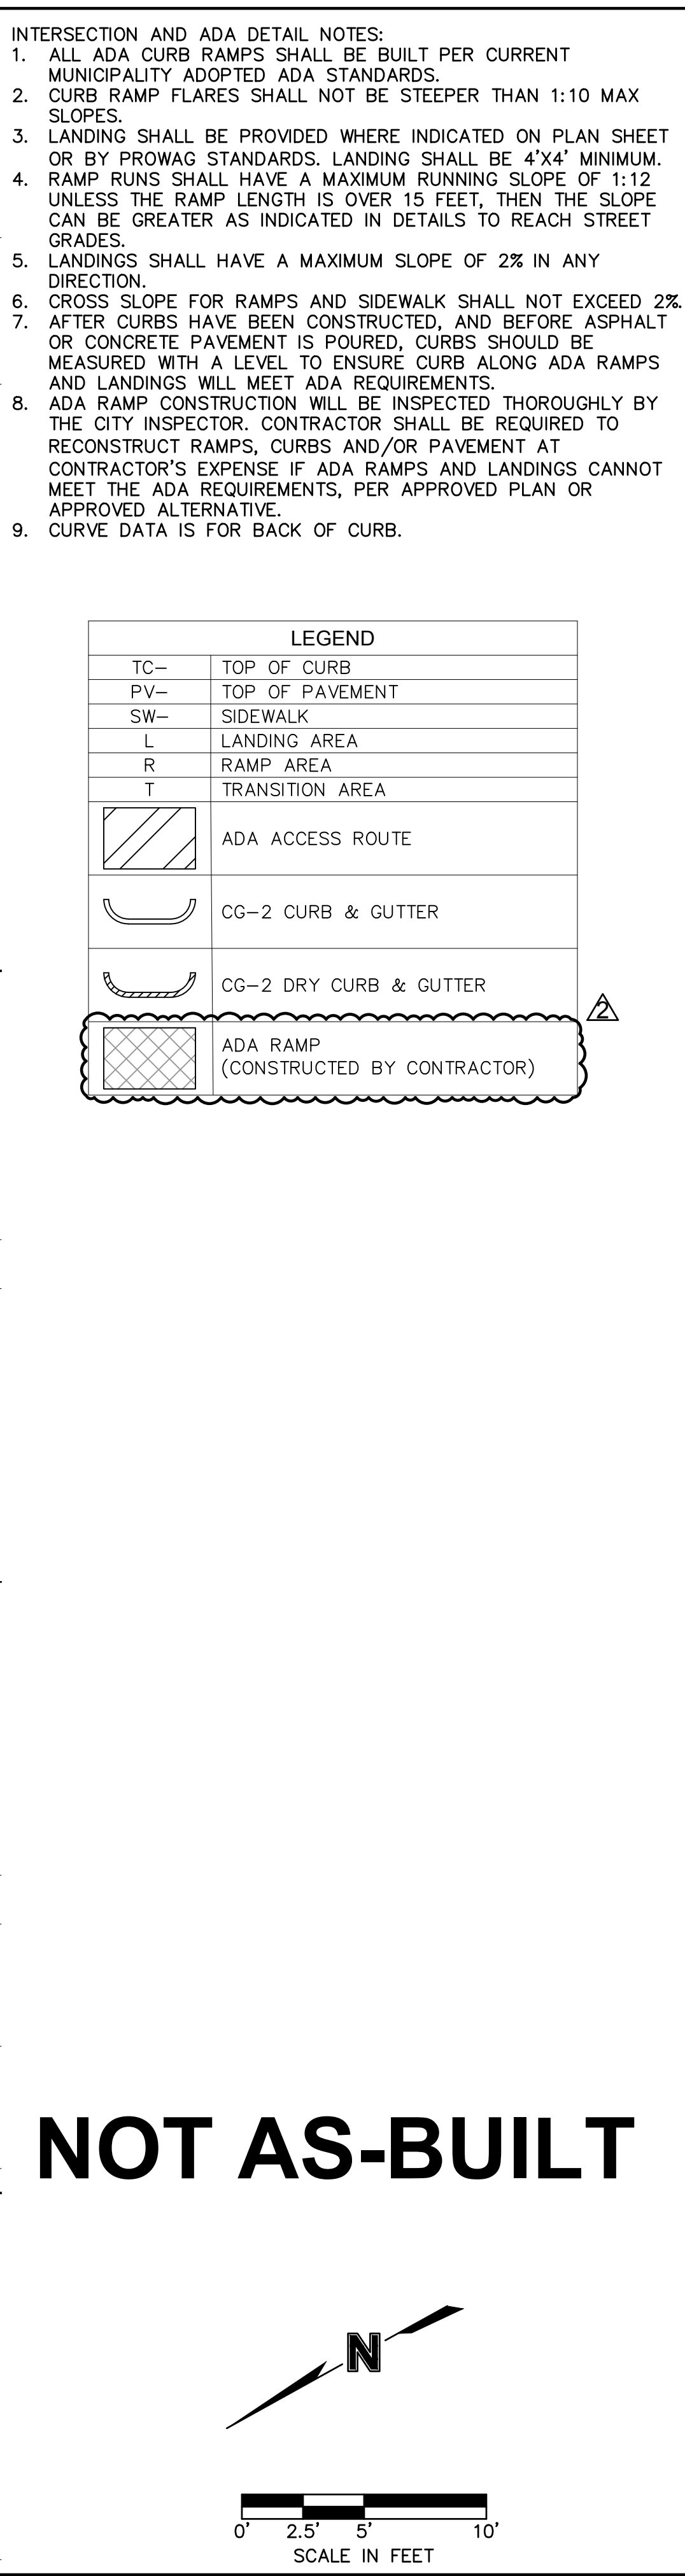

- INTERSECTION AND ADA DETAIL NOTES:
1. ALL ADA CURB RAMPS SHALL BE BUILT PER CURRENT MUNICIPALITY ADOPTED ADA STANDARDS.
2. CURB RAMP FLARES SHALL NOT BE STEEPER THAN 1:10 MAX SLOPES.
3. LANDING SHALL BE PROVIDED WHERE INDICATED ON PLAN SHEET OR BY PROWAG STANDARDS. LANDING SHALL BE 4'x4' MINIMUM.
4. RAMP RUNS SHALL HAVE A MAXIMUM RUNNING SLOPE OF 1:12 UNLESS THE RAMP LENGTH IS OVER 15 FEET, THEN THE SLOPE CAN BE GREATER AS INDICATED IN DETAILS TO REACH STREET GRADES.
5. LANDINGS SHALL HAVE A MAXIMUM SLOPE OF 2% IN ANY DIRECTION.
6. CROSS SLOPE FOR RAMPS AND SIDEWALK SHALL NOT EXCEED 2%.
7. AFTER CURBS HAVE BEEN CONSTRUCTED, AND BEFORE ASPHALT OR CONCRETE PAVEMENT IS POURED, CURBS SHOULD BE MEASURED WITH A LEVEL TO ENSURE CURB ALONG ADA RAMPS AND LANDINGS WILL MEET ADA REQUIREMENTS.
8. ADA RAMP CONSTRUCTION WILL BE INSPECTED THOROUGHLY BY THE CITY INSPECTOR. CONTRACTOR SHALL BE REQUIRED TO RECONSTRUCT RAMPS, CURBS AND/OR PAVEMENT AT CONTRACTOR'S EXPENSE IF ADA RAMPS AND LANDINGS CANNOT MEET THE ADA REQUIREMENTS, PER APPROVED PLAN OR APPROVED ALTERNATIVE.
9. CURVE DATA IS FOR BACK OF CURB.

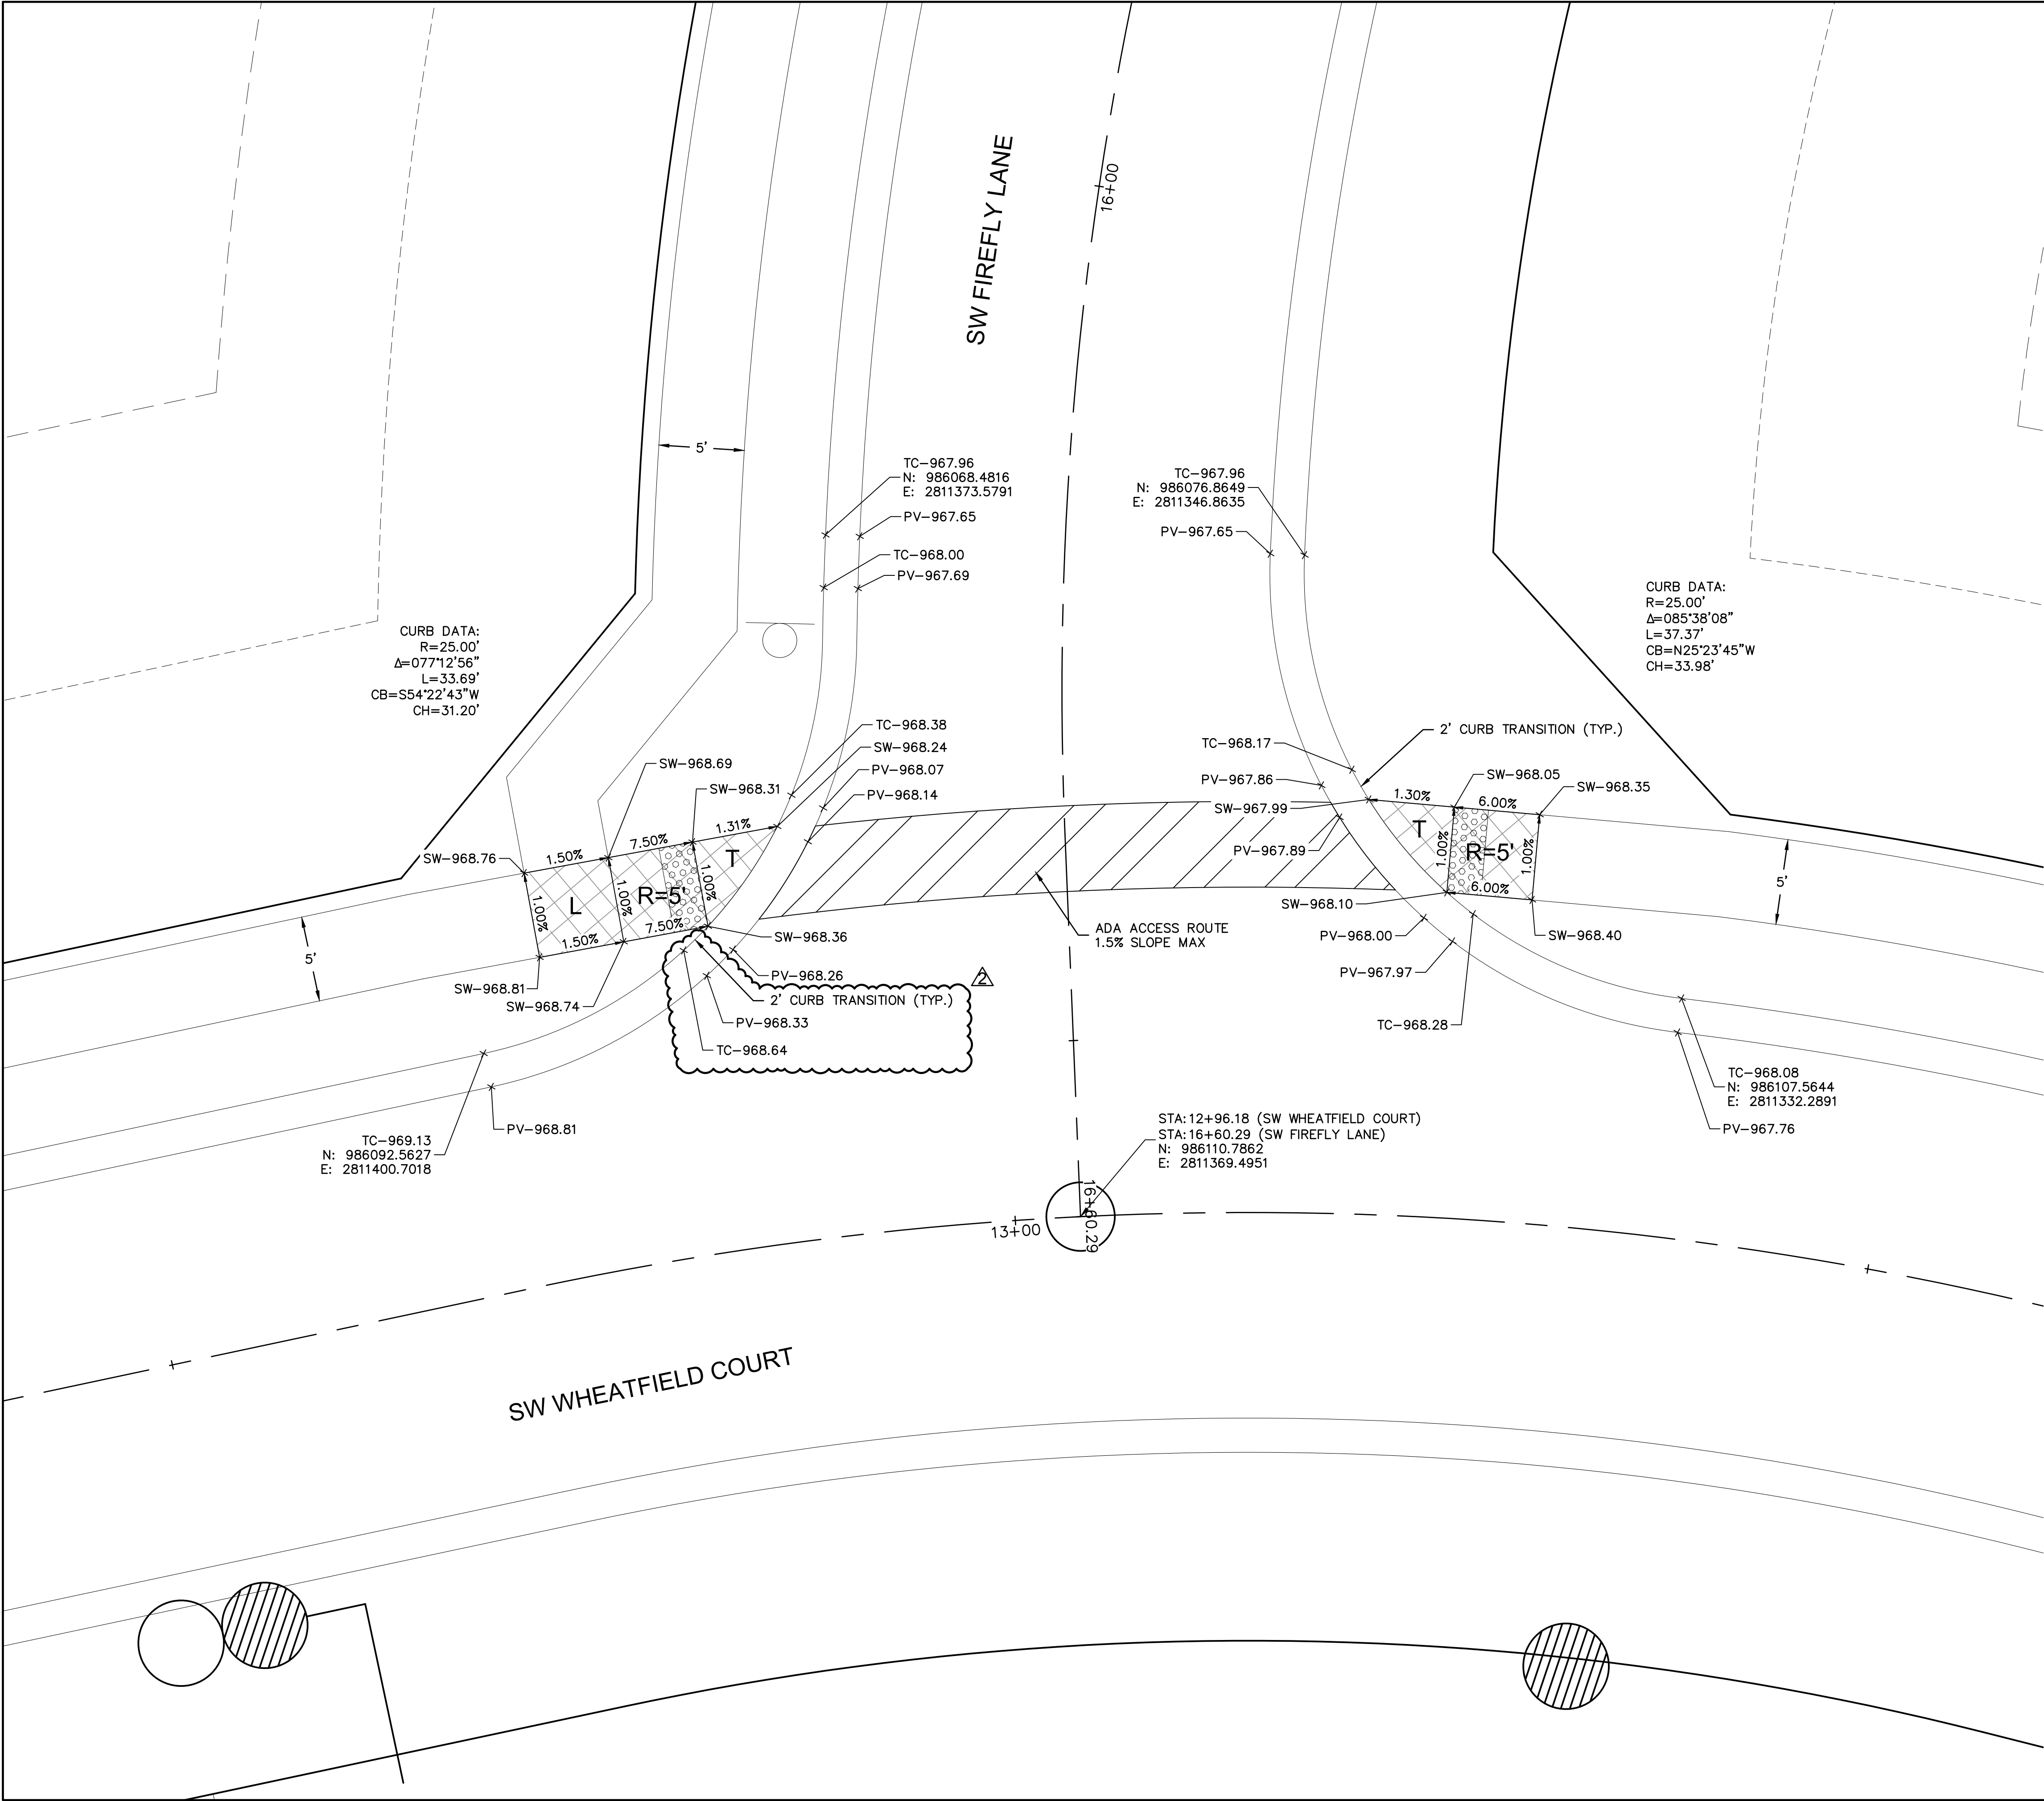

- INTERSECTION AND ADA DETAIL NOTES:
1. ALL ADA CURB RAMP SHALL BE BUILT PER CURRENT MUNICIPALITY ADOPTED ADA STANDARDS.
 2. CURB RAMP FLARES SHALL NOT BE STEEPER THAN 1:10 MAX SLOPES.
 3. LANDING SHALL BE PROVIDED WHERE INDICATED ON PLAN SHEET OR BY PROWAG STANDARDS. LANDING SHALL BE 4'X4' MINIMUM.
 4. RAMP RUNS SHALL HAVE A MAXIMUM RUNNING SLOPE OF 1:12 UNLESS THE RAMP LENGTH IS OVER 15 FEET, THEN THE SLOPE CAN BE GREATER AS INDICATED IN DETAILS TO REACH STREET GRADES.
 5. LANDINGS SHALL HAVE A MAXIMUM SLOPE OF 2% IN ANY DIRECTION.
 6. CROSS SLOPE FOR RAMP AND SIDEWALK SHALL NOT EXCEED 2%.
 7. AFTER CURBS HAVE BEEN CONSTRUCTED, AND BEFORE ASPHALT OR CONCRETE PAVEMENT IS POURED, CURBS SHOULD BE MEASURED WITH A LEVEL TO ENSURE CURB ALONG ADA RAMP AND LANDINGS WILL MEET ADA REQUIREMENTS.
 8. ADA RAMP CONSTRUCTION WILL BE INSPECTED THOROUGHLY BY THE CITY INSPECTOR. CONTRACTOR SHALL BE REQUIRED TO RECONSTRUCT RAMP, CURBS AND/OR PAVEMENT AT CONTRACTOR'S EXPENSE IF ADA RAMP AND LANDINGS CANNOT MEET THE ADA REQUIREMENTS, PER APPROVED PLAN OR APPROVED ALTERNATIVE.
 9. CURVE DATA IS FOR BACK OF CURB.

LEGEND	
TC--	TOP OF CURB
PV--	TOP OF PAVEMENT
SW--	SIDEWALK
L	LANDING AREA
R	RAMP AREA
T	TRANSITION AREA
	ADA ACCESS ROUTE
	CG-2 CURB & GUTTER
	CG-2 DRY CURB & GUTTER
	ADA RAMP (CONSTRUCTED BY CONTRACTOR)

SW FIREFLY LANE & SW WHEATFIELD COURT
STREET & STORM SEWER PLANS

HOOK FARMS
SECOND PLAT

LEE'S SUMMIT, MO

2021

REVISIONS

REV. NO.	DATE	REVISIONS DESCRIPTION	BY
1	03-23-2021	REVISED PER CITY COMMENTS	
2	04-16-2021	REVISED PER CITY COMMENTS	
3	09-30-2021	CHANGES TO APPROVED PLANS	

SW FIREFLY LANE & SW WHEATFIELD COURT
STREET & STORM SEWER PLANS

HOOK FARMS
SECOND PLAT

LEE'S SUMMIT, MO

drawn by: B.M.W./A.A.

checked by: B.M.W.


designed by: B.M.W./A.A.

QA/QC by: J.E.S.

project no.: B19-4061

date: 01-08-2021

SHEET
C129

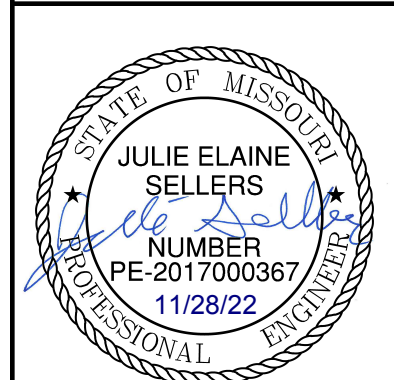

REV. NO.	DATE	REVISIONS DESCRIPTION	BY
1	03-23-2021	REVISED PER CITY COMMENTS	
2	04-16-2021	REVISED PER CITY COMMENTS	
3	09-30-2021	CHANGES TO APPROVED PLANS	

SW FIREFLY LANE & SW WHEATFIELD COURT
STREET & STORM SEWER PLANS

HOOK FARMS
SECOND PLAT

LEE'S SUMMIT, MO

2021

REVISIONS

REV. NO.	DATE	REVISIONS DESCRIPTION	BY
1	03-23-2021	REVISED PER CITY COMMENTS	
2	04-16-2021	REVISED PER CITY COMMENTS	
3	09-30-2021	CHANGES TO APPROVED PLANS	

SW FIREFLY LANE & SW WHEATFIELD COURT
STREET & STORM SEWER PLANS

HOOK FARMS
SECOND PLAT

LEE'S SUMMIT, MO

drawn by: B.M.W./A.A.

checked by: B.M.W.

designed by: B.M.W./A.A.

QA/QC by: J.E.S.

project no.: B19-4061

date: 01-08-2021

SHEET
C129

USER: ssayfor			
C_PUTIL_B194061	C_FBASE_B194061	C_PSTRM_B194061	C_PSURF_B194061
C_PPATT_B194061			

C_PPATT_B194061

C_PSURF_B194061

C_PSTRM_B194061

C_FBASE_B194061

R: ssaylor
C_PUTIL_B194061

__B194061.dwg
C_PBDY_B194061


C:\Storm Plans\C_IN
C_PBASE_B194061

\\GNCV\GNCV\Streets\XBASE_B194061


\\-Design\AutoCAD\A:
;_PTBLK_B194061

-4500\019-4061-B
3:35pm XREF


DWG: F:\2019\4
DATE: Oct 11, 20

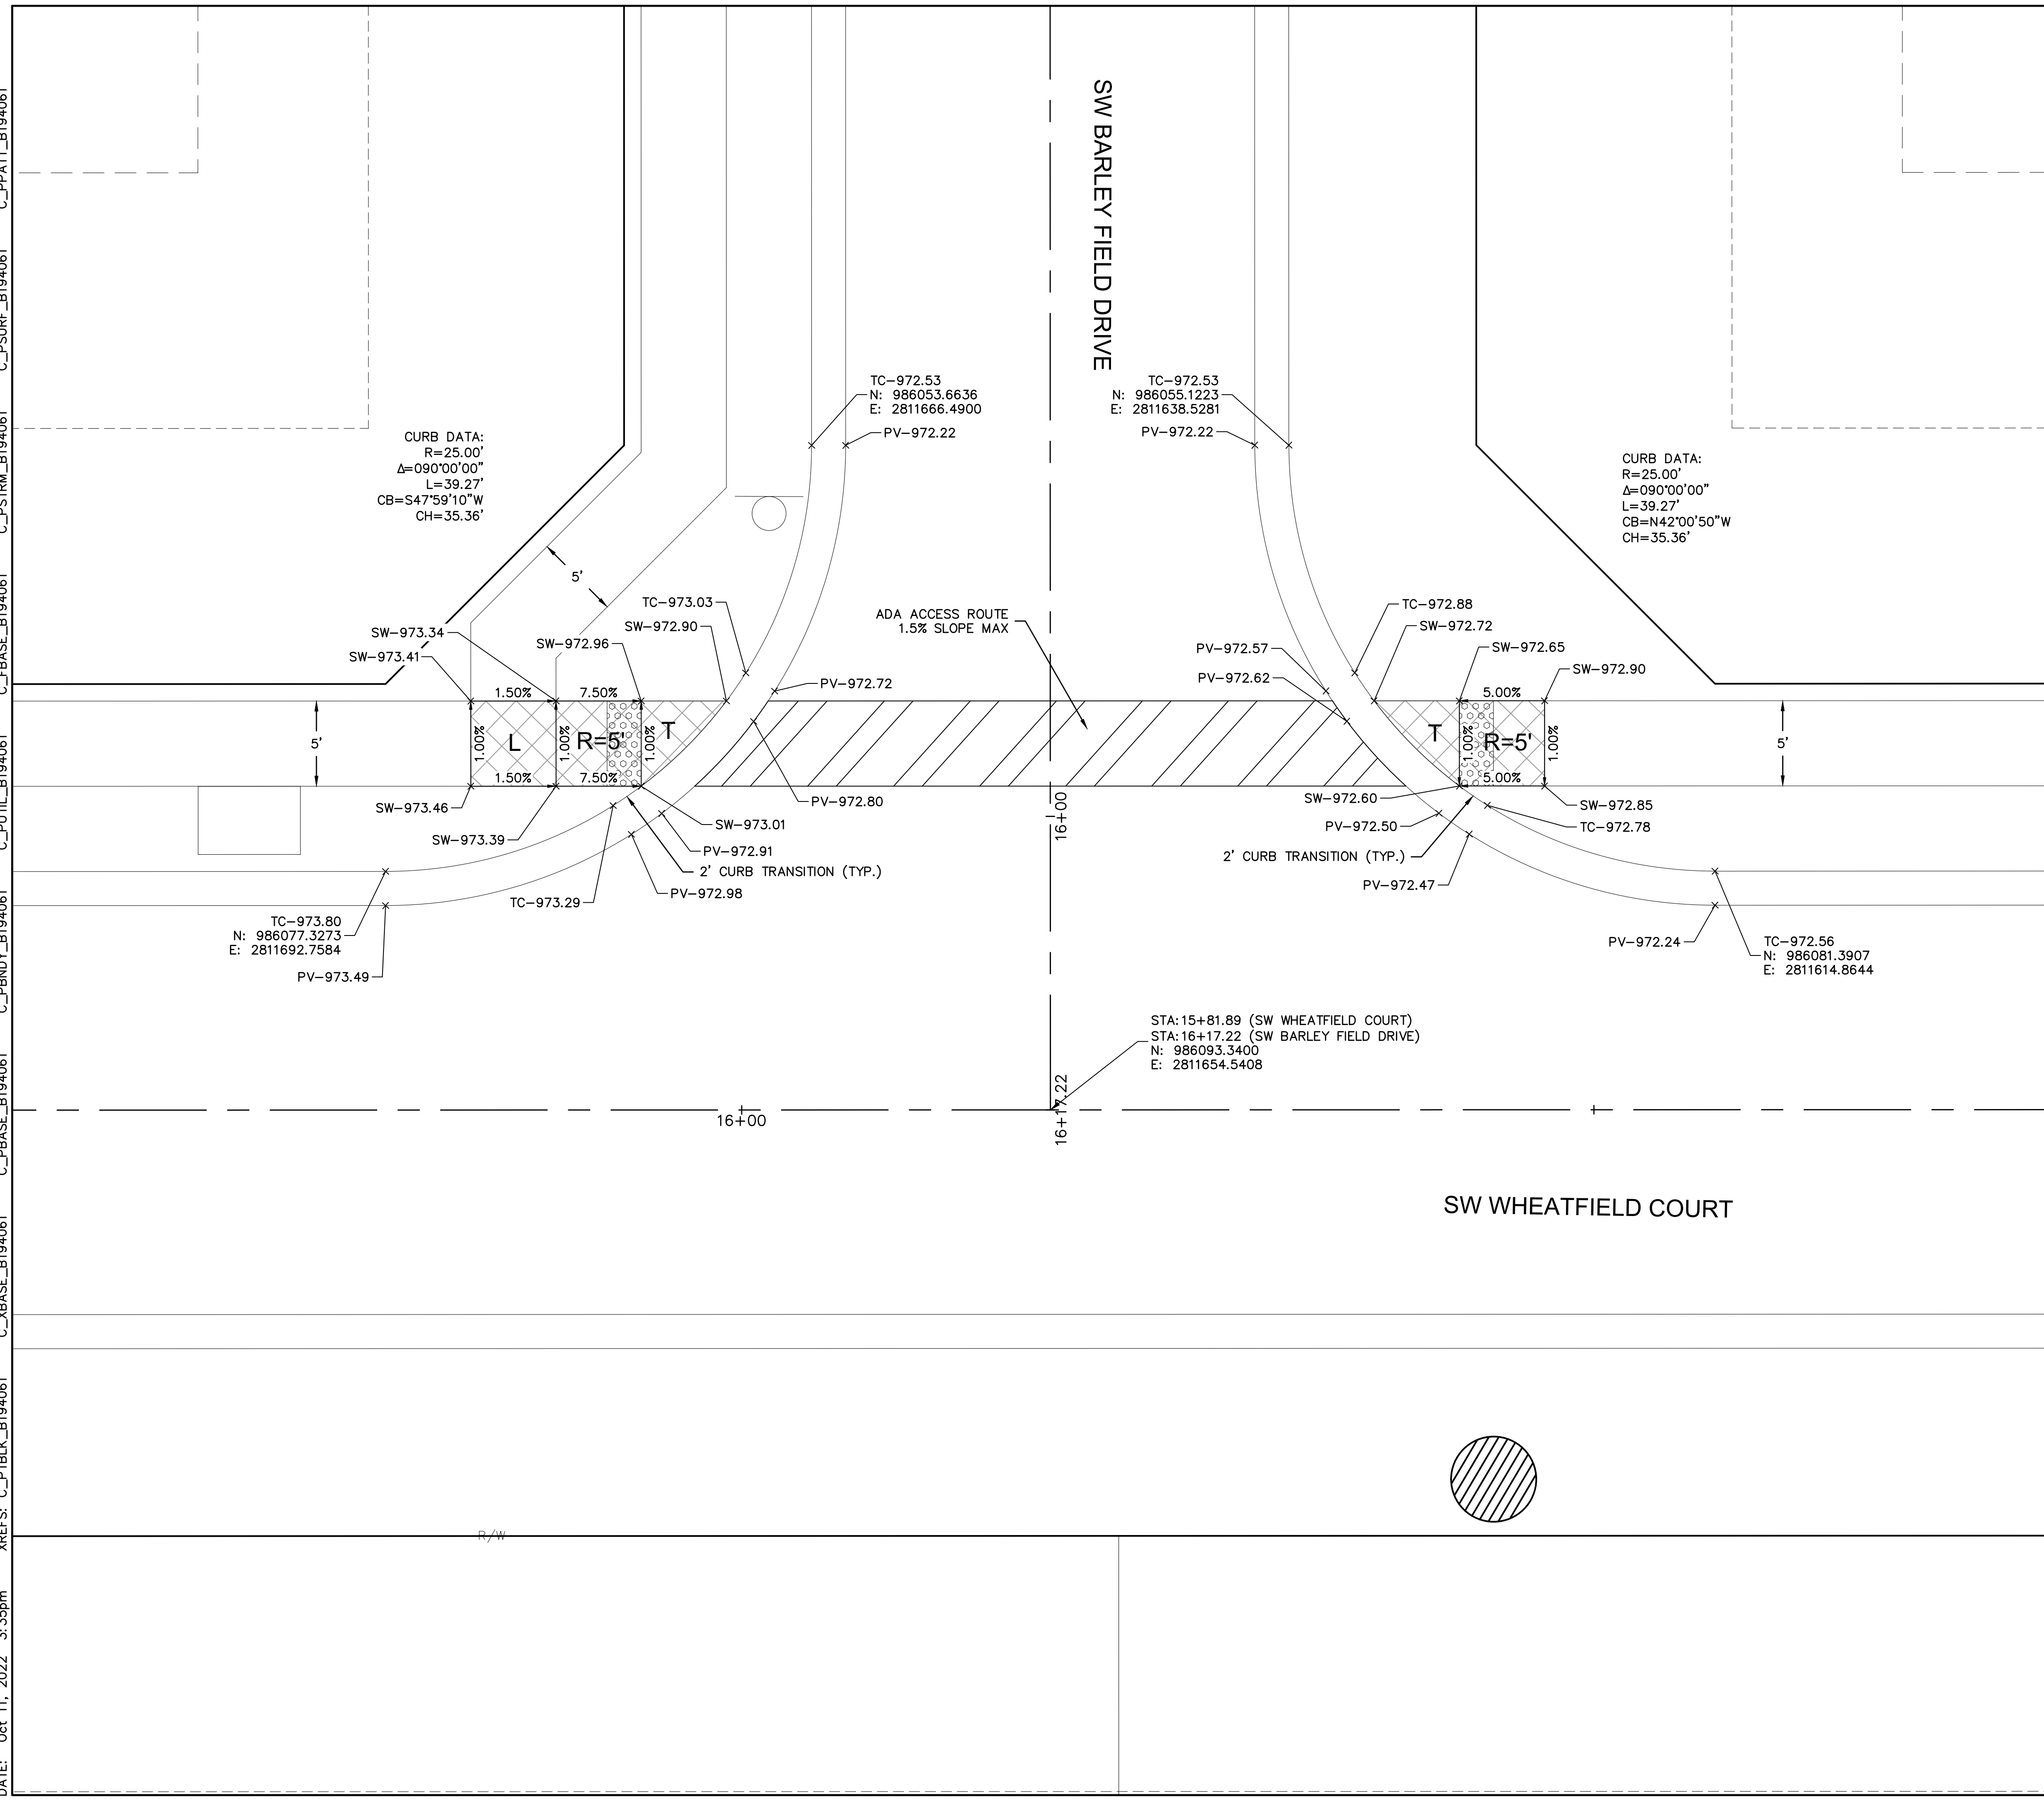

- INTERSECTION AND ADA DETAIL NOTES:
1. ALL ADA CURB RAMPS SHALL BE BUILT PER CURRENT MUNICIPALITY ADOPTED ADA STANDARDS.
2. CURB RAMP FLARES SHALL NOT BE STEEPER THAN 1:10 MAX SLOPES.
3. LANDING SHALL BE PROVIDED WHERE INDICATED ON PLAN SHEET OR BY PROWAG STANDARDS. LANDING SHALL BE 4'x4' MINIMUM.
4. RAMP RUNS SHALL HAVE A MAXIMUM RUNNING SLOPE OF 1:12. UNLESS THE RAMP LENGTH IS OVER 15 FEET, THEN THE SLOPE CAN BE GREATER AS INDICATED IN DETAILS TO REACH STREET GRADES.
5. LANDINGS SHALL HAVE A MAXIMUM SLOPE OF 2% IN ANY DIRECTION.
6. CROSS SLOPE FOR RAMPS AND SIDEWALK SHALL NOT EXCEED 2%.
7. AFTER CURBS HAVE BEEN CONSTRUCTED, AND BEFORE ASPHALT OR CONCRETE PAVEMENT IS POURED, CURBS SHOULD BE MEASURED WITH A LEVEL TO ENSURE CURB ALONG ADA RAMPS AND LANDINGS WILL MEET ADA REQUIREMENTS.
8. ADA RAMP CONSTRUCTION WILL BE INSPECTED THOROUGHLY BY THE CITY INSPECTOR. CONTRACTOR SHALL BE REQUIRED TO RECONSTRUCT RAMPS, CURBS AND/OR PAVEMENT AT CONTRACTOR'S EXPENSE IF ADA RAMPS AND LANDINGS CANNOT MEET THE ADA REQUIREMENTS, PER APPROVED PLAN OR APPROVED ALTERNATIVE.
9. CURVE DATA IS FOR BACK OF CURB.

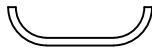
LEGEND	
TC—	TOP OF CURB
PV—	TOP OF PAVEMENT
SW—	SIDEWALK
L	LANDING AREA
R	RAMP AREA
T	TRANSITION AREA
	ADA ACCESS ROUTE
	CG-2 CURB & GUTTER
	CG-2 DRY CURB & GUTTER
	ADA RAMP (CONSTRUCTED BY CONTRACTOR)

NOT AS-BUILT

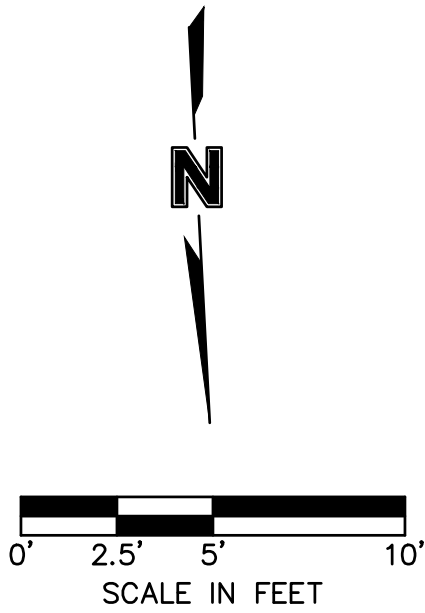

drawn by: _____ B.M.W./A.A. checked by: _____ B.M.W./ designed by: _____ B.M.W./A.A. QA/QC by: _____ J.E.S. project no.: _____ B19-4061 date: _____ 01-08-2021 olsson Olsson - Civil Engineering Missouri Certificate of Authority #001592 1301 Burlington Street North Kansas City, MO 64116 TEL 816.361.1177 FAX 816.361.1888 www.olsson.com																																																	
																																																	
<table border="1" style="width: 100%; border-collapse: collapse;"> <thead> <tr> <th style="width: 10%;">REV. NO.</th> <th style="width: 15%;">DATE</th> <th style="width: 55%;">REVISIONS DESCRIPTION</th> <th style="width: 20%;">BY</th> </tr> </thead> <tbody> <tr><td>1</td><td>03-23-2021</td><td>REVISED PER CITY COMMENTS</td><td></td></tr> <tr><td>2</td><td>04-16-2021</td><td>REVISED PER CITY COMMENTS</td><td></td></tr> <tr><td>3</td><td>09-30-2021</td><td>CHANGES TO APPROVED PLANS</td><td></td></tr> <tr><td> </td><td></td><td></td><td></td></tr> <tr><td> </td><td></td><td></td><td></td></tr> <tr><td> </td><td></td><td></td><td></td></tr> <tr><td> </td><td></td><td></td><td></td></tr> <tr><td> </td><td></td><td></td><td></td></tr> <tr><td> </td><td></td><td></td><td></td></tr> <tr><td> </td><td></td><td></td><td></td></tr> <tr><td> </td><td></td><td></td><td></td></tr> </tbody> </table>		REV. NO.	DATE	REVISIONS DESCRIPTION	BY	1	03-23-2021	REVISED PER CITY COMMENTS		2	04-16-2021	REVISED PER CITY COMMENTS		3	09-30-2021	CHANGES TO APPROVED PLANS																																	
REV. NO.	DATE	REVISIONS DESCRIPTION	BY																																														
1	03-23-2021	REVISED PER CITY COMMENTS																																															
2	04-16-2021	REVISED PER CITY COMMENTS																																															
3	09-30-2021	CHANGES TO APPROVED PLANS																																															
<table border="1" style="width: 100%; border-collapse: collapse;"> <tr> <td style="width: 60%; text-align: center;"> SW BARLEY FIELD DRIVE & SW WHEATFIELD COURT STREET & STORM SEWER PLANS HOOK FARMS SECOND PLAT </td> <td style="width: 40%; text-align: center;"> 2021 </td> </tr> <tr> <td colspan="2" style="text-align: center;"> LEE'S SUMMIT, MO </td> </tr> <tr> <td colspan="2" style="text-align: center;"> REVISIONS </td> </tr> </table>		SW BARLEY FIELD DRIVE & SW WHEATFIELD COURT STREET & STORM SEWER PLANS HOOK FARMS SECOND PLAT	2021	LEE'S SUMMIT, MO		REVISIONS																																											
SW BARLEY FIELD DRIVE & SW WHEATFIELD COURT STREET & STORM SEWER PLANS HOOK FARMS SECOND PLAT	2021																																																
LEE'S SUMMIT, MO																																																	
REVISIONS																																																	
SHEET C130																																																	

DWG: F:\2019\4001-4500\019-4061-BV40-Design\AutoCAD\Asbuilt\Sheets\GNCV\Street & Storm Plans\C_INT02_B194061.dwg
DATE: Oct 11, 2022 3:35pm
XREFS: C_PTBK_B194061 C_XBASE_B194061 C_PBASE_B194061 C_PSTRM_B194061 C_PSURF_B194061 C_PPATT_B194061
USER: sso\lor C_PUTIL_B194061

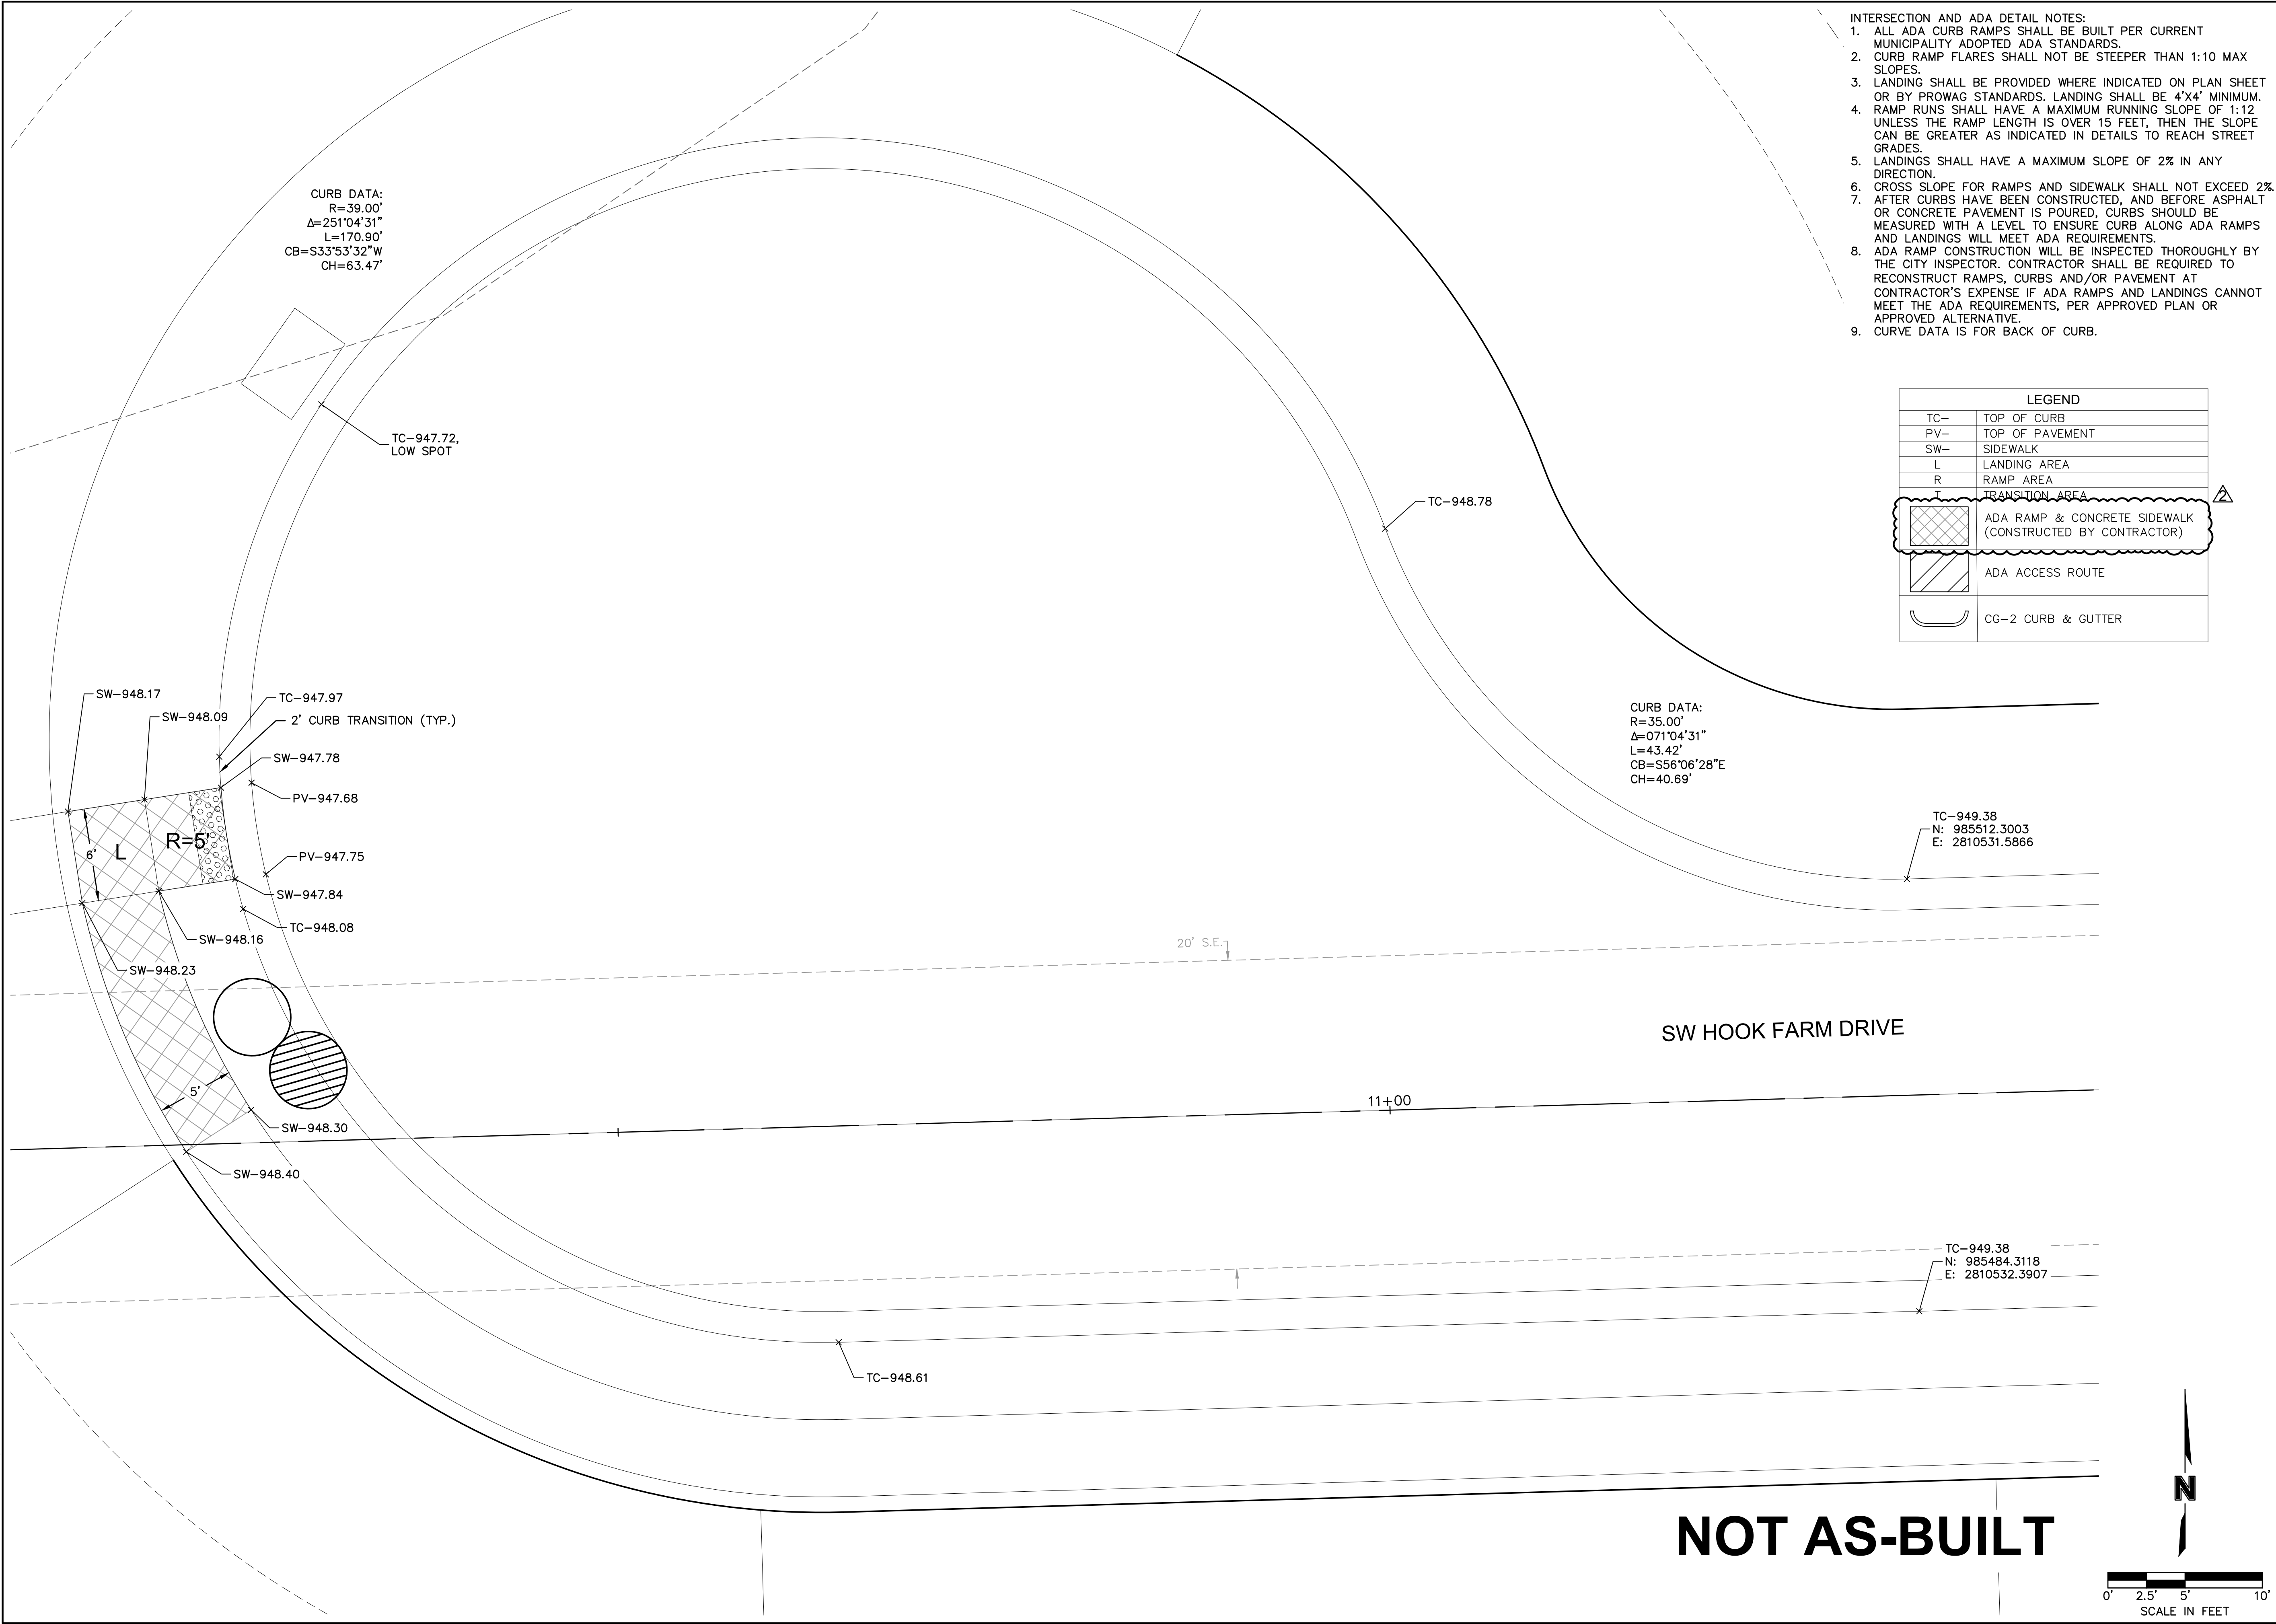

- INTERSECTION AND ADA DETAIL NOTES:
1. ALL ADA CURB RAMPS SHALL BE BUILT PER CURRENT MUNICIPALITY ADOPTED ADA STANDARDS.
 2. CURB RAMP FLARES SHALL NOT BE STEEPER THAN 1:10 MAX SLOPES.
 3. LANDING SHALL BE PROVIDED WHERE INDICATED ON PLAN SHEET OR BY PROWAG STANDARDS. LANDING SHALL BE 4'X4' MINIMUM.
 4. RAMP RUNS SHALL HAVE A MAXIMUM RUNNING SLOPE OF 1:12 UNLESS THE RAMP LENGTH IS OVER 15 FEET, THEN THE SLOPE CAN BE GREATER AS INDICATED IN DETAILS TO REACH STREET GRADES.
 5. LANDINGS SHALL HAVE A MAXIMUM SLOPE OF 2% IN ANY DIRECTION.
 6. CROSS SLOPE FOR RAMPS AND SIDEWALK SHALL NOT EXCEED 2%.
 7. AFTER CURBS HAVE BEEN CONSTRUCTED, AND BEFORE ASPHALT OR CONCRETE PAVEMENT IS POURED, CURBS SHOULD BE MEASURED WITH A LEVEL TO ENSURE CURB ALONG ADA RAMPS AND LANDINGS WILL MEET ADA REQUIREMENTS.
 8. ADA RAMP CONSTRUCTION WILL BE INSPECTED THOROUGHLY BY THE CITY INSPECTOR. CONTRACTOR SHALL BE REQUIRED TO RECONSTRUCT RAMPS, CURBS AND/OR PAVEMENT AT CONTRACTOR'S EXPENSE IF ADA RAMPS AND LANDINGS CANNOT MEET THE ADA REQUIREMENTS, PER APPROVED PLAN OR APPROVED ALTERNATIVE.
 9. CURVE DATA IS FOR BACK OF CURB.

LEGEND	
TC--	TOP OF CURB
PV--	TOP OF PAVEMENT
SW--	SIDEWALK
L	LANDING AREA
R	RAMP AREA
T	TRANSITION AREA
	ADA RAMP & CONCRETE SIDEWALK (CONSTRUCTED BY CONTRACTOR)
	ADA ACCESS ROUTE
	CG-2 CURB & GUTTER

olsson

Olsson - Civil Engineering
Missouri Certificate of Authority #001592
1301 Burlington Street
North Kansas City, MO 64116
TEL 816.361.1177
FAX 816.361.1888
www.olsson.com

STATE OF MISSOURI
JULIE ELAINE SELLERS
NUMBER PE-2017000367
11/28/22
PROFESSIONAL ENGINEER

BY

REVISIONS


SW HOOK FARM DRIVE CUL-DE-SAC STREET & STORM SEWER PLANS

HOOK FARMS SECOND PLAT


LEE'S SUMMIT, MO

drawn by: B.M.W./A.A.
checked by: B.M.W.
designed by: J.E.S.
QA/QC by: B19-4061
project no.: 01-08-2021
date:

SHEET C131

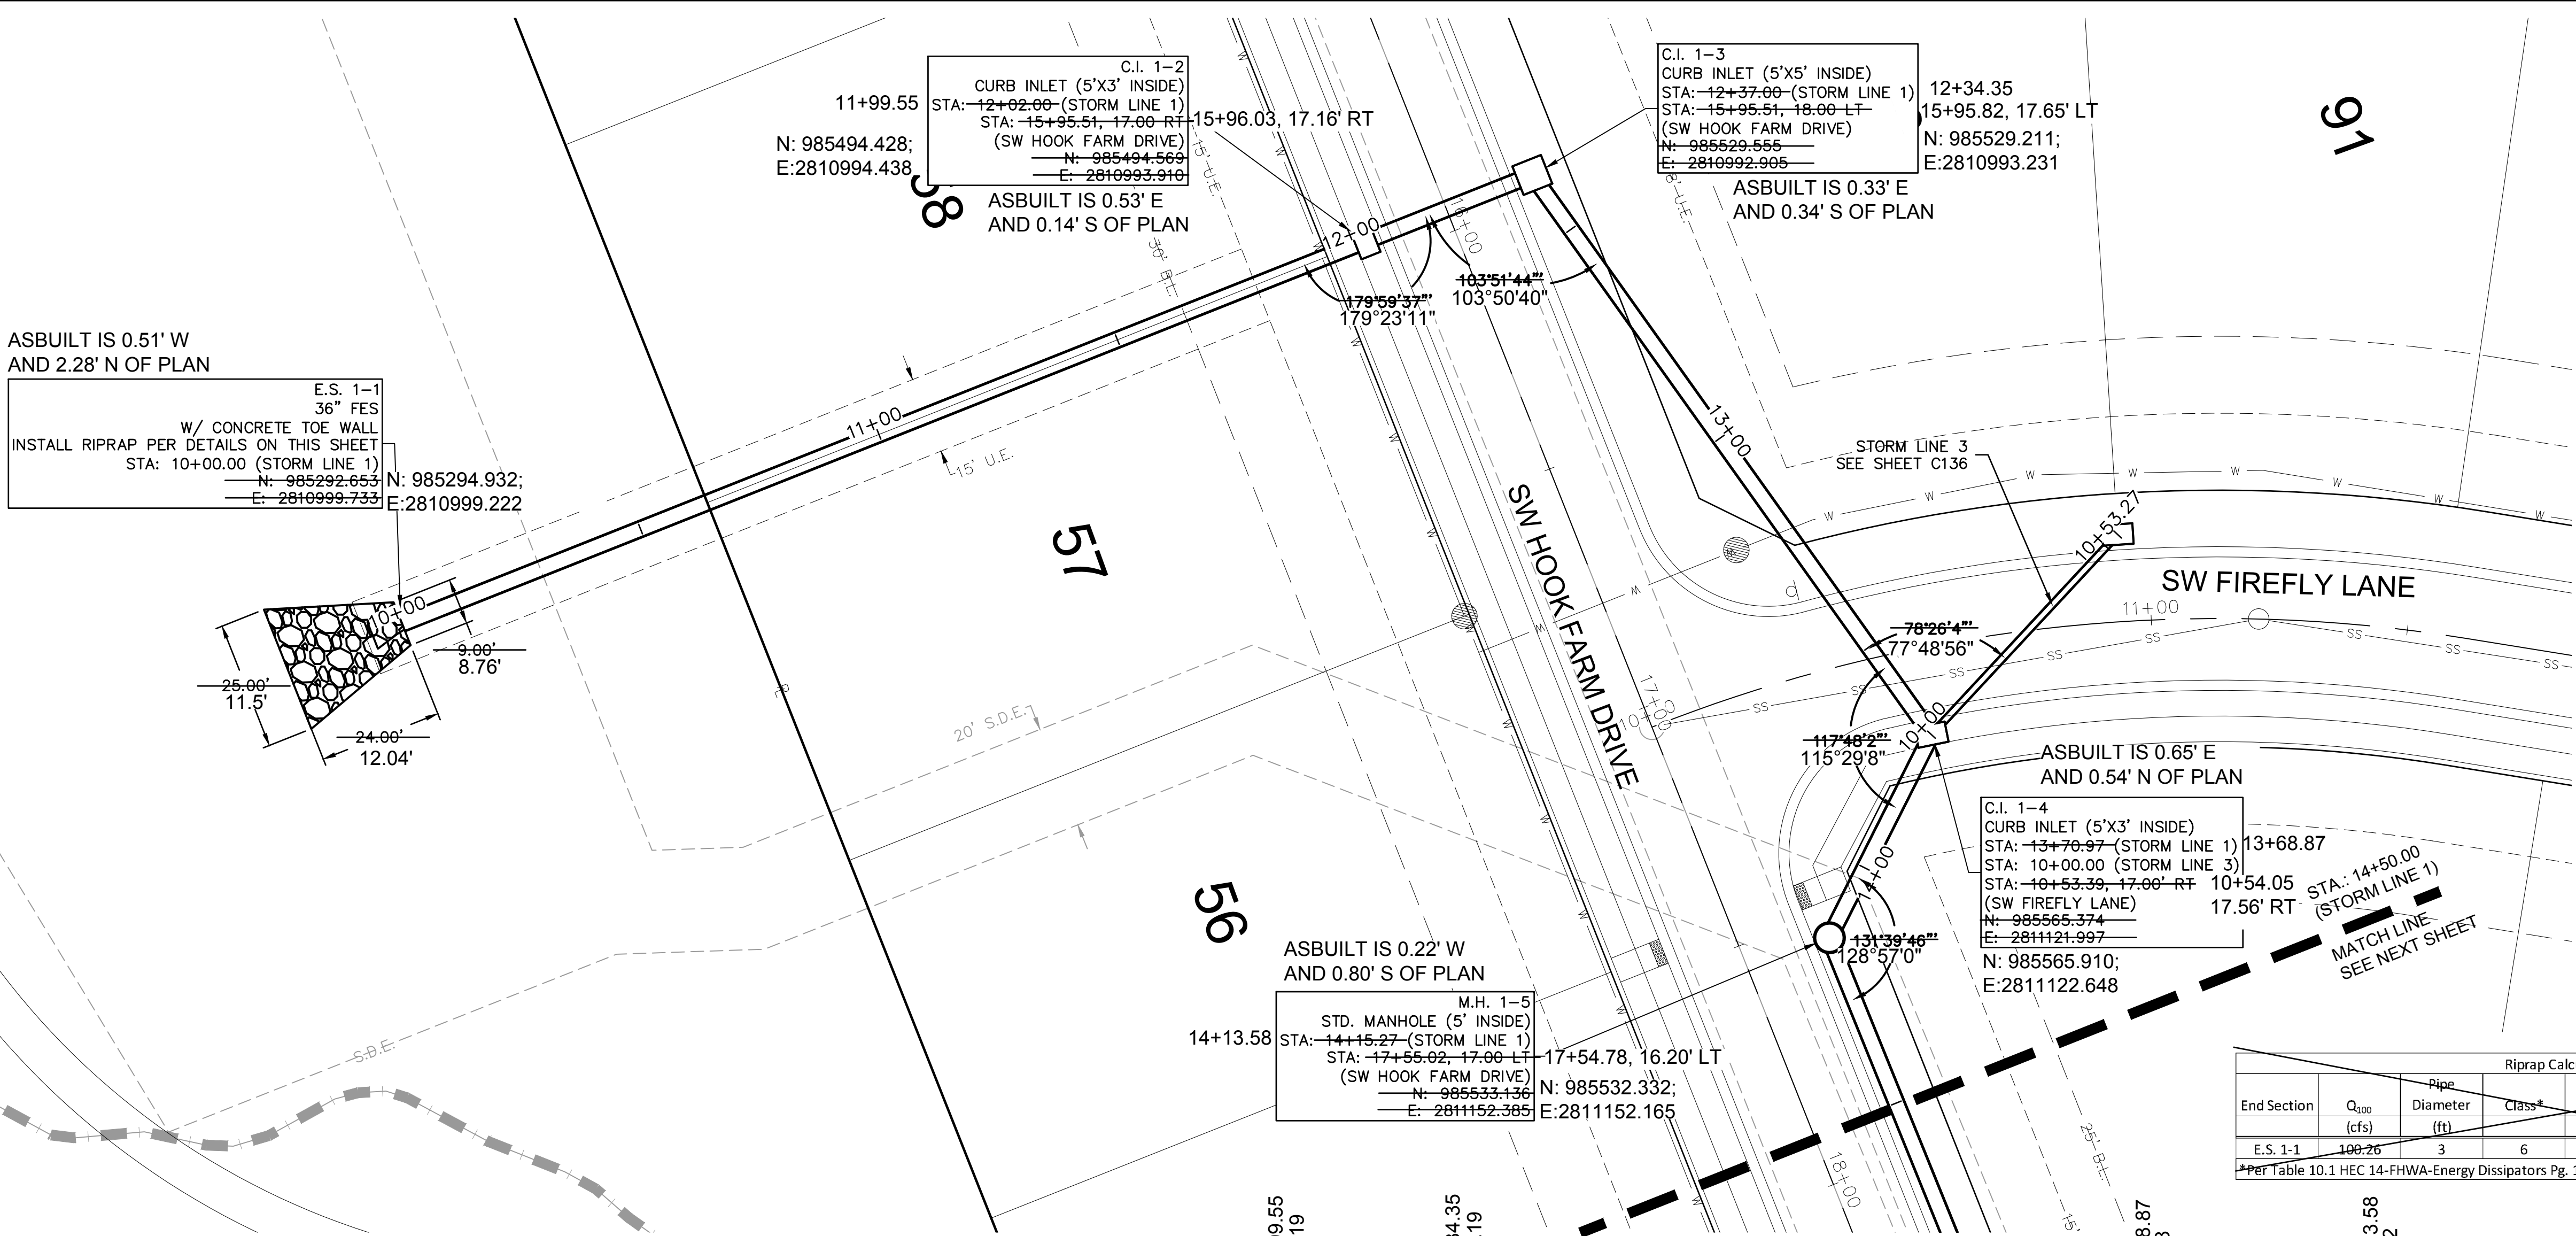


AS BUILT
DATE SURVEYED: 2022-05-26

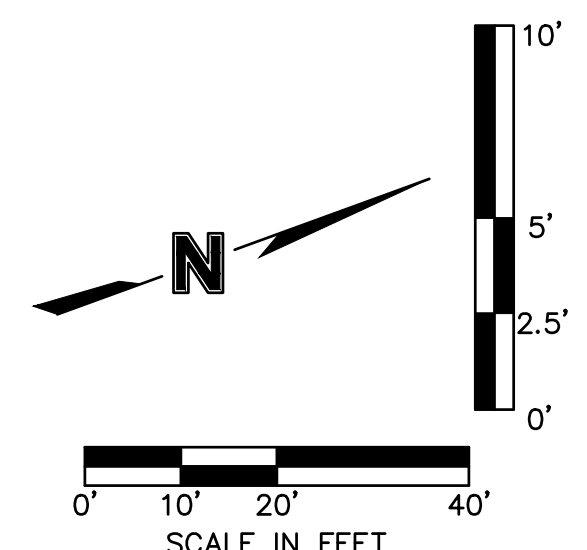

*NOTE: CONTRACTOR SHALL FILL AND COMPACT TO 95% STANDARD DENSITY TO A POINT 18" MINIMUM ABOVE THE TOP OF PIPE PRIOR TO EXCAVATION FOR THE PIPE

Riprap Calculations							
End Section	Q ₁₀₀ (cfs)	Ripe Diameter (ft)	Class*	D50* (in)	Apron Length (ft)	Apron Depth (ft)	Area (SY)
E.S. 1-1	100.26	3	6	22	24	3.67	45.3

*Per Table 10.1 HEC 14-FHWA-Energy Dissipators Pg. 10-18

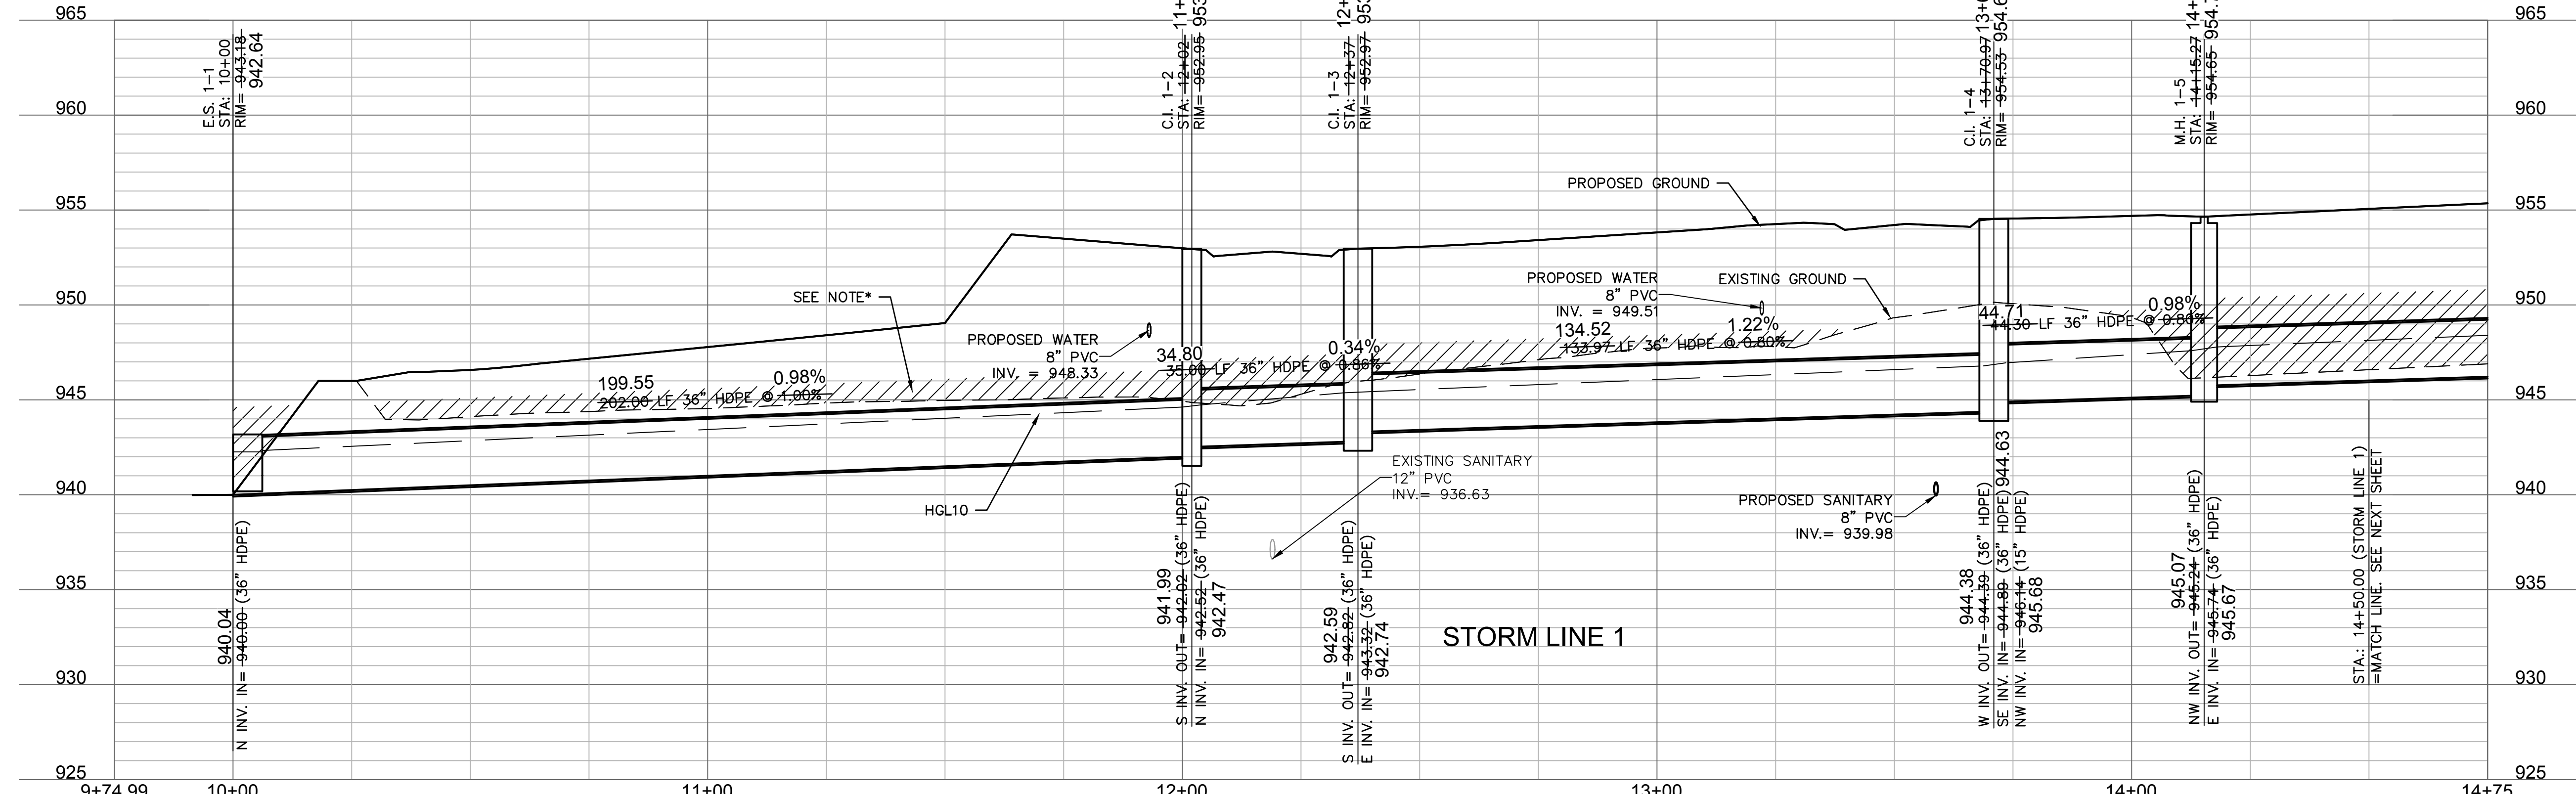

Olsson - Civil Engineering
Missouri Certificate of Authority #001592
1301 Burlington Street
North Kansas City, MO 64116
TEL 816.361.1177
FAX 816.361.1888
www.olsson.com

STATE OF MISSOURI
JULIE ELAINE SELLERS
NUMBER PE-2017000367
11/28/22
PROFESSIONAL ENGINEER

BY

REVISIONS

STORM SEWER PLAN & PROFILE (LINE 1)
STREET & STORM SEWER PLANS


HOOK FARMS
SECOND PLAT

LEE'S SUMMIT, MO

2021

drawn by: B.M.W./A.A.
checked by: B.M.W.
designed by: B.M.W./A.A.
QA/QC by: J.E.S.
project no.: B19-4061
date: 01-08-2021

SHEET
C132

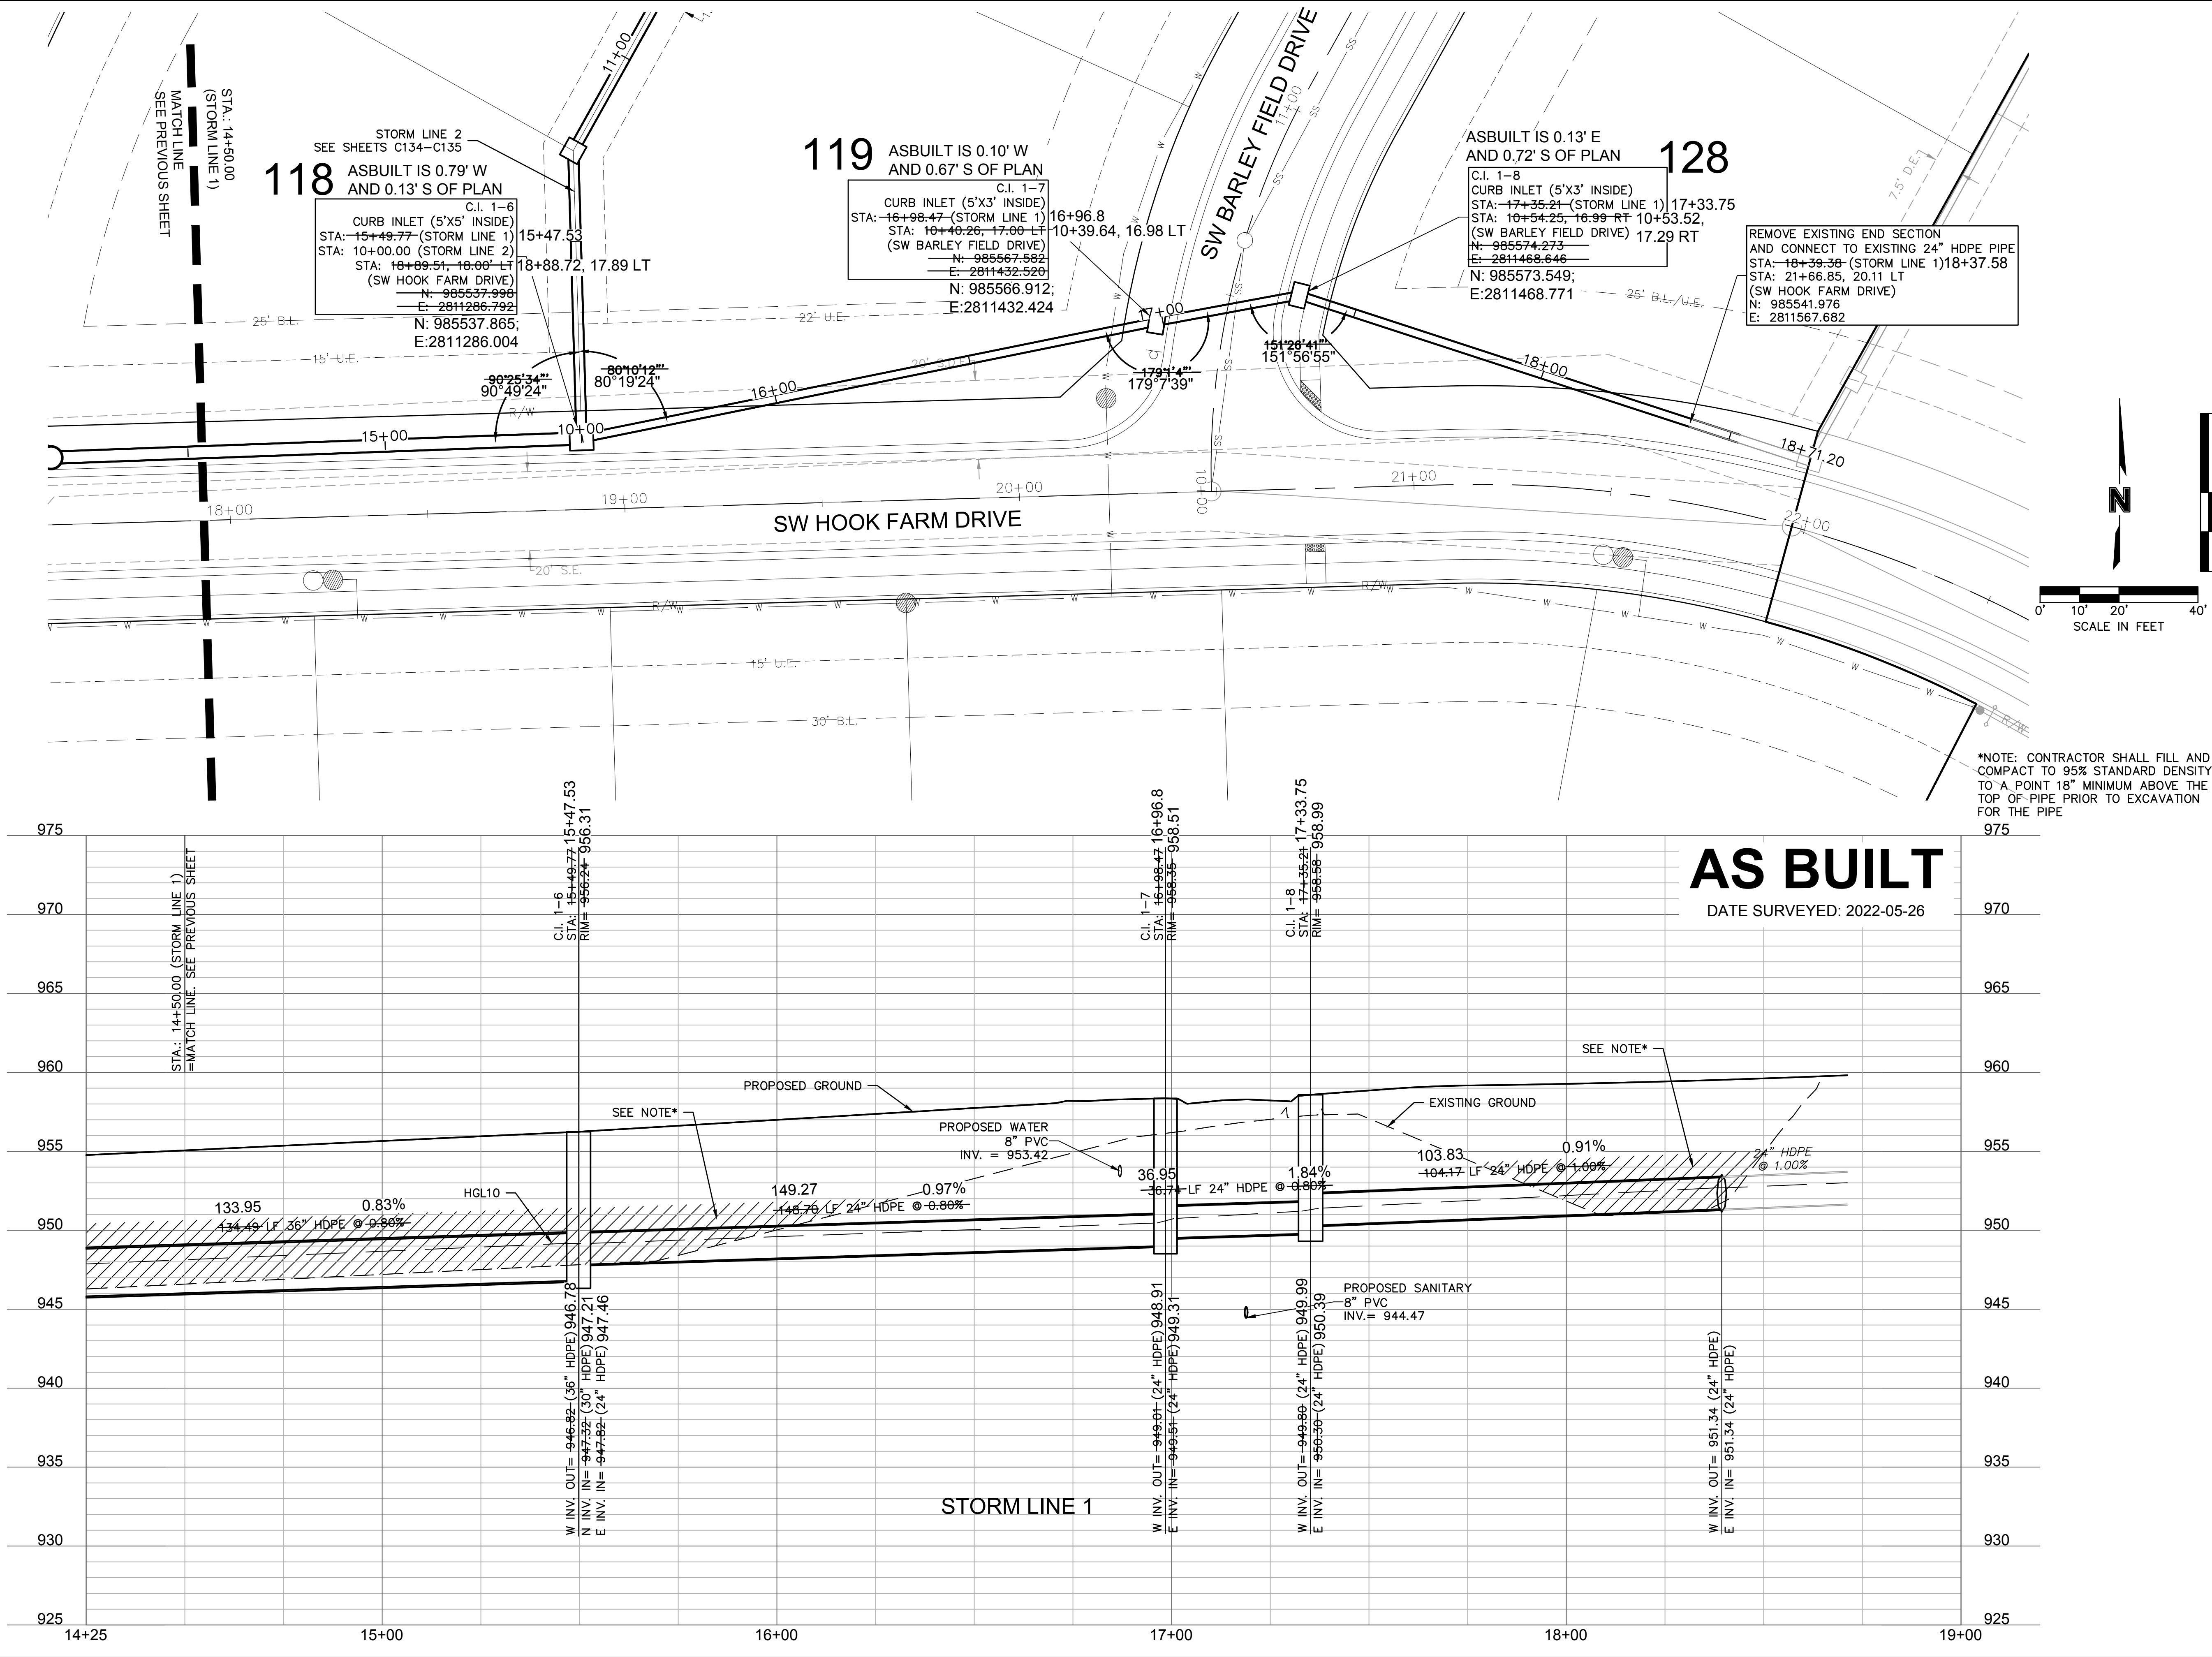

olsson

Olsson - Civil Engineering
Missouri Certificate of Authority #001592
1301 Burlington Street
North Kansas City, MO 64116
TEL 816.361.1177
FAX 816.361.1888
www.olsson.com

STATE OF MISSOURI
JULIE ELAINE
SELLERS
Professional Engineer
NUMBER
PE-2017000367
11/28/22

BY

DATE

REV. NO.

REVISIONS DESCRIPTION

1

03-23-2021

1

REVISED PER CITY COMMENTS

2

04-16-2021

2

REVISED PER CITY COMMENTS

3

09-30-2021

3

CHANGES TO APPROVED PLANS

2021

REVISIONS


STORM SEWER PLAN & PROFILE (LINE 1)
STREET & STORM SEWER PLANS


HOOK FARMS
SECOND PLAT





LEE'S SUMMIT, MO



drawn by: B.M.W./A.A.
checked by: B.M.W.
designed by: B.M.W./A.A.
QA/QC by: J.E.S.
project no.: B19-4061
date: 01-08-2021

SHEET
C133




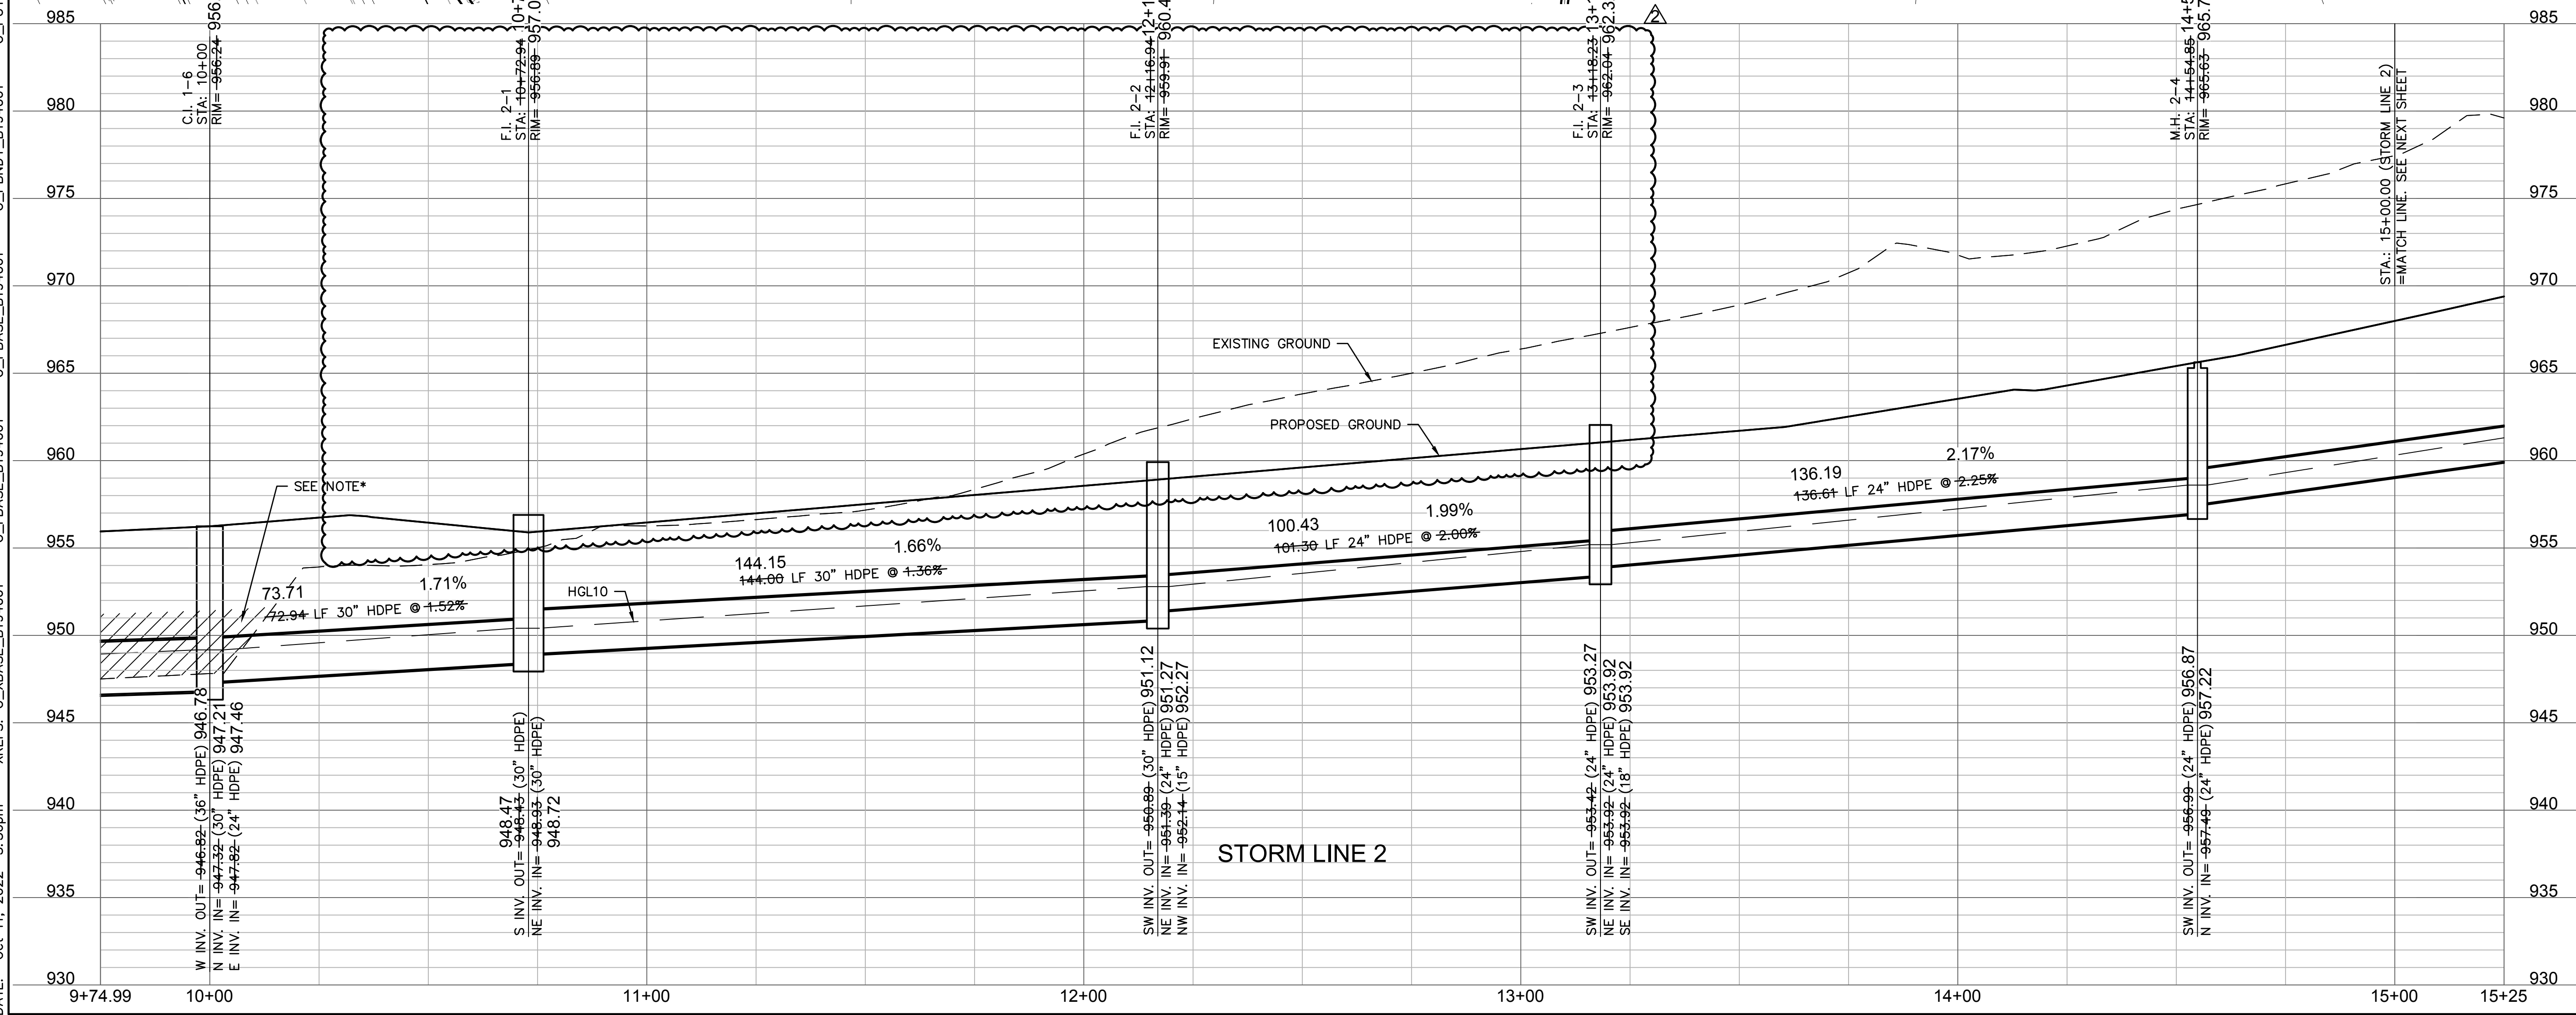


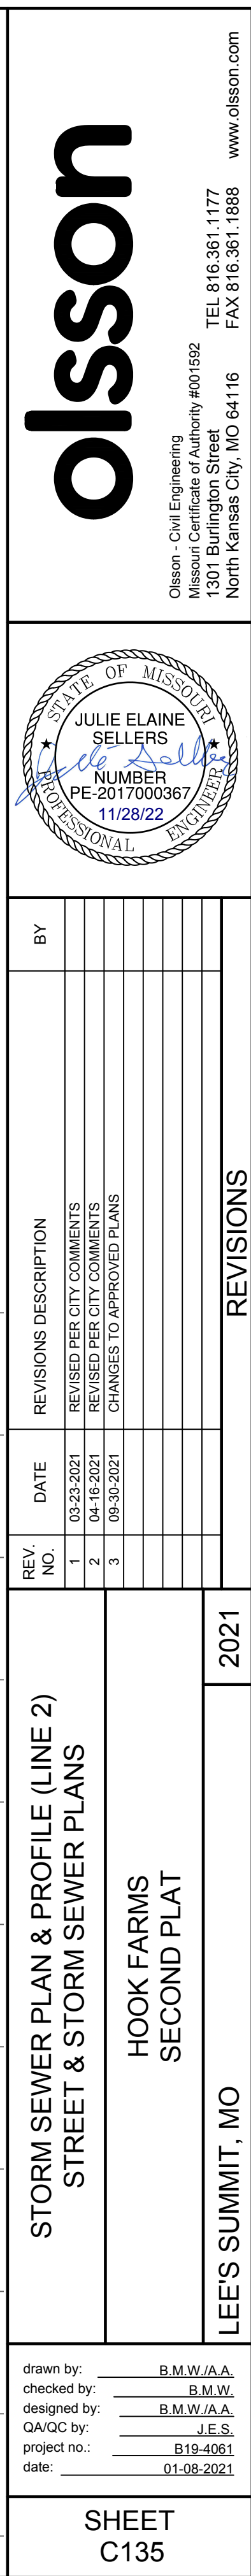

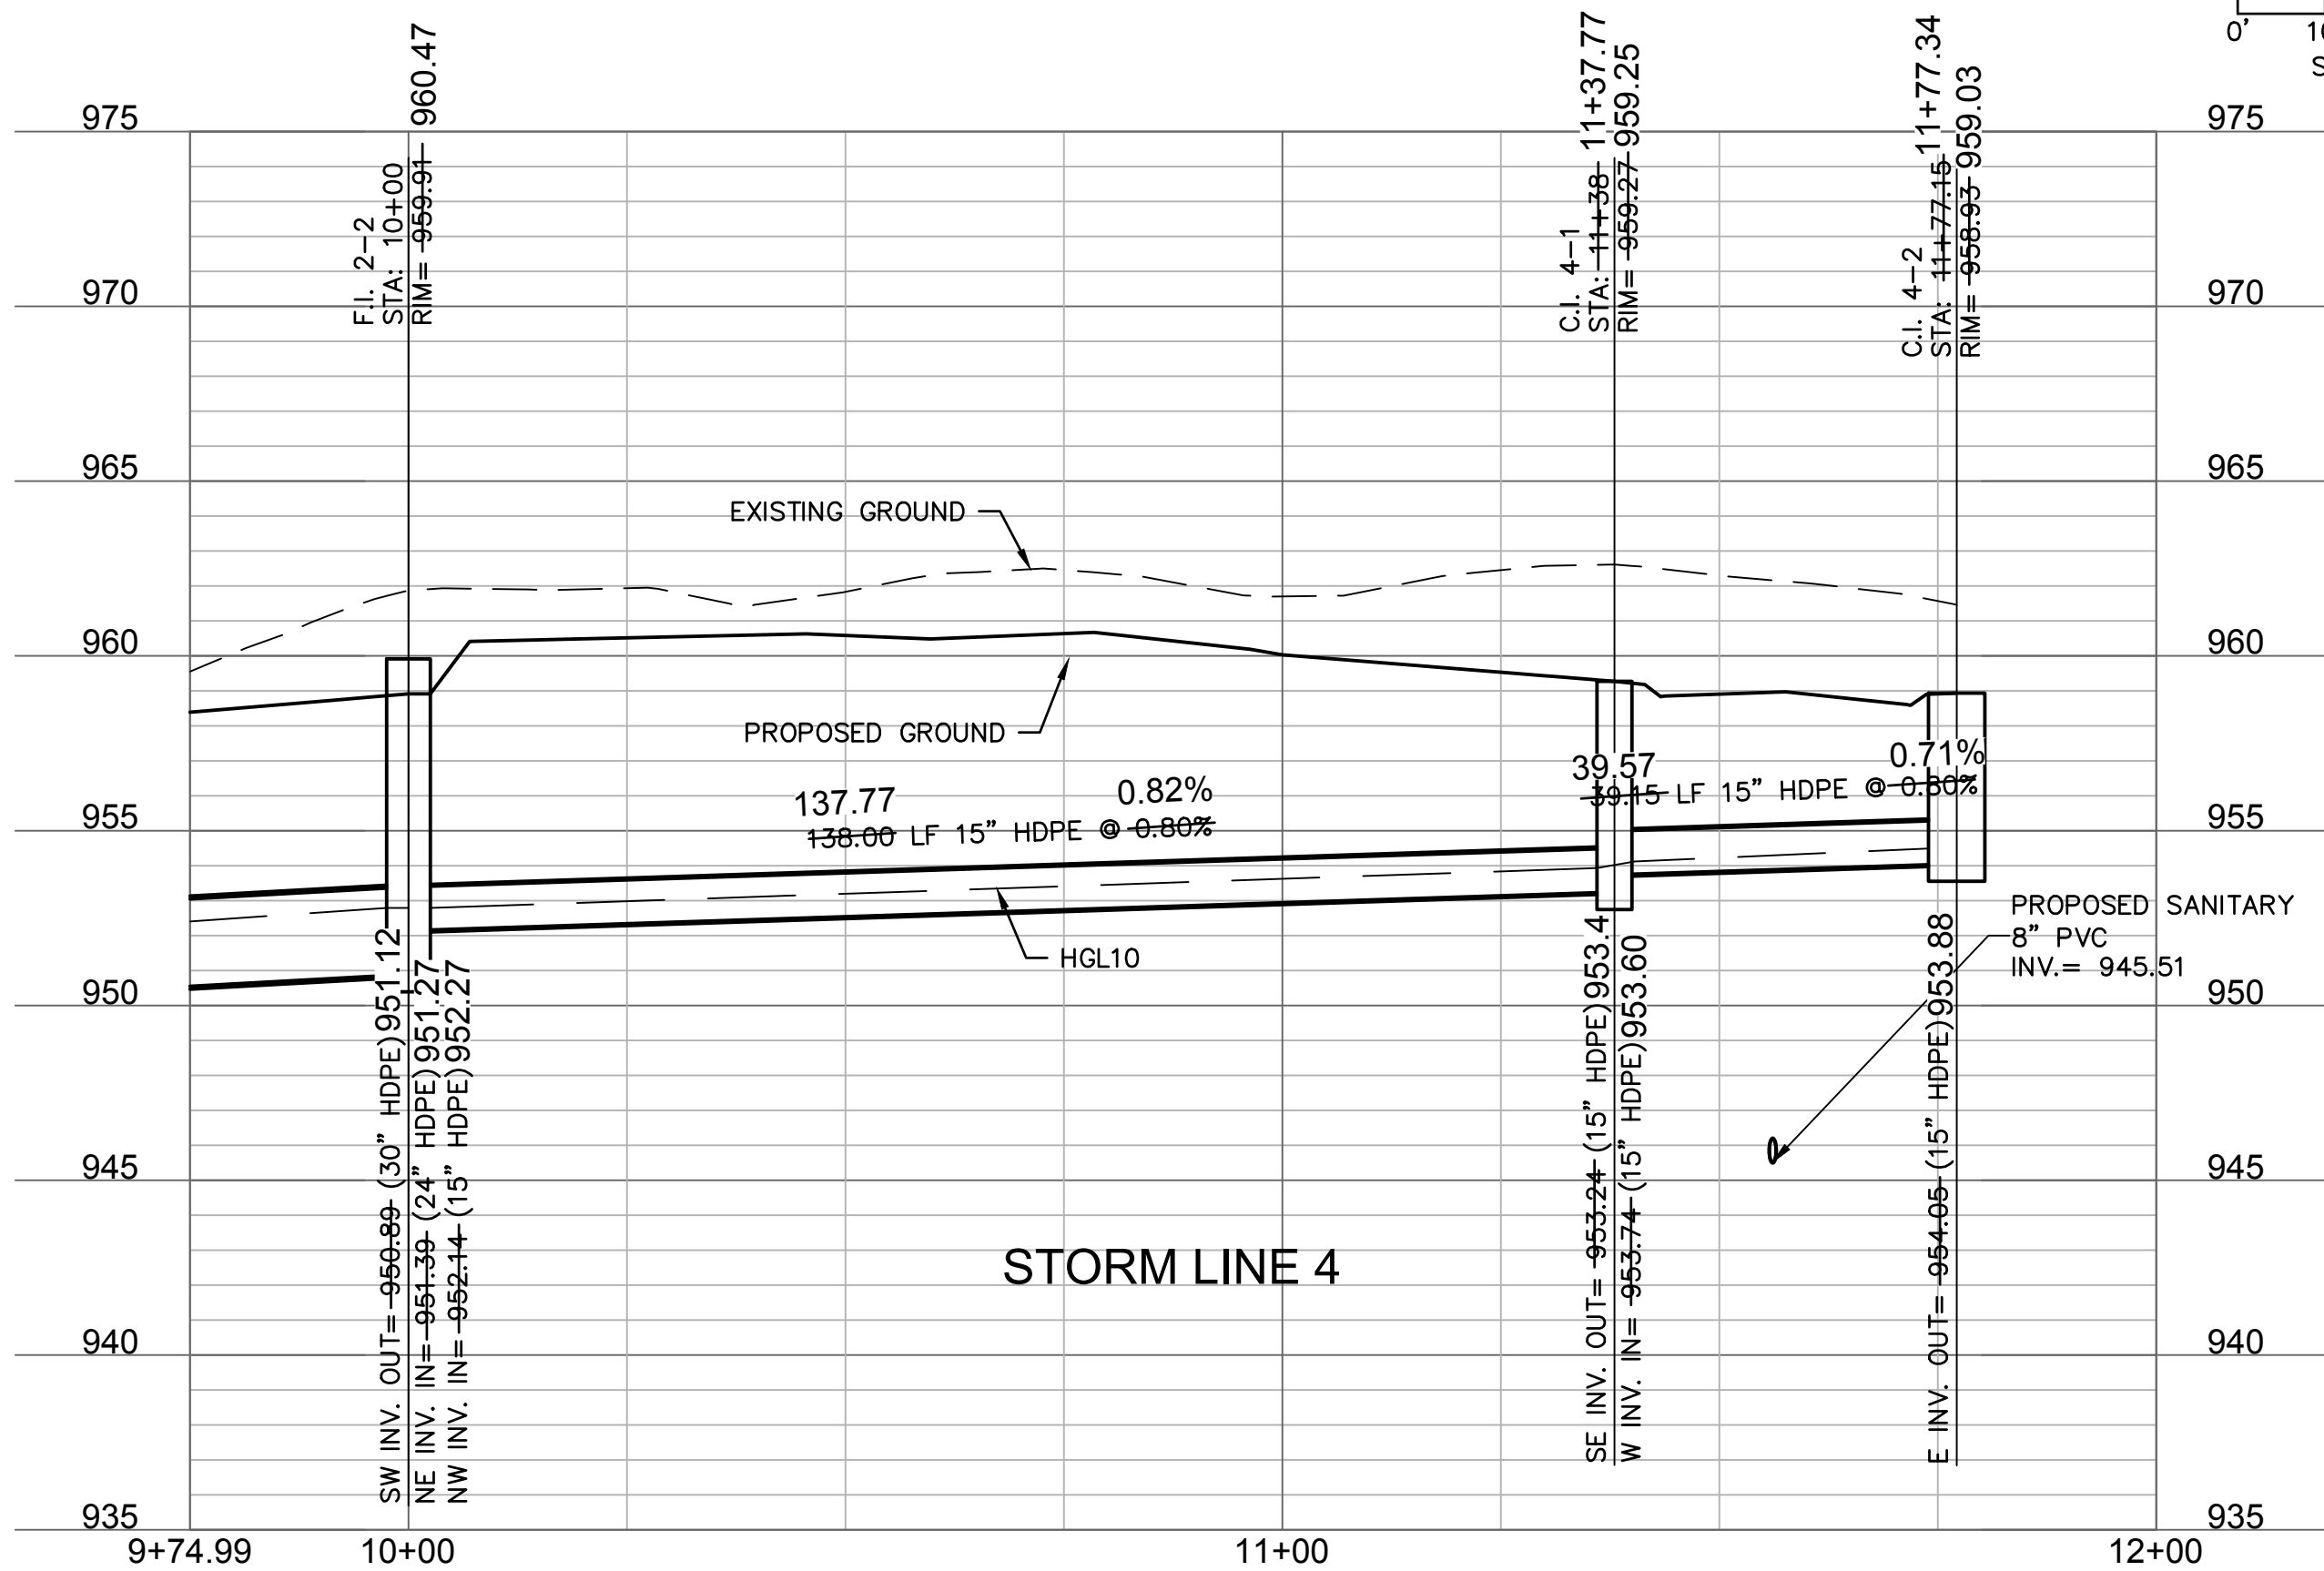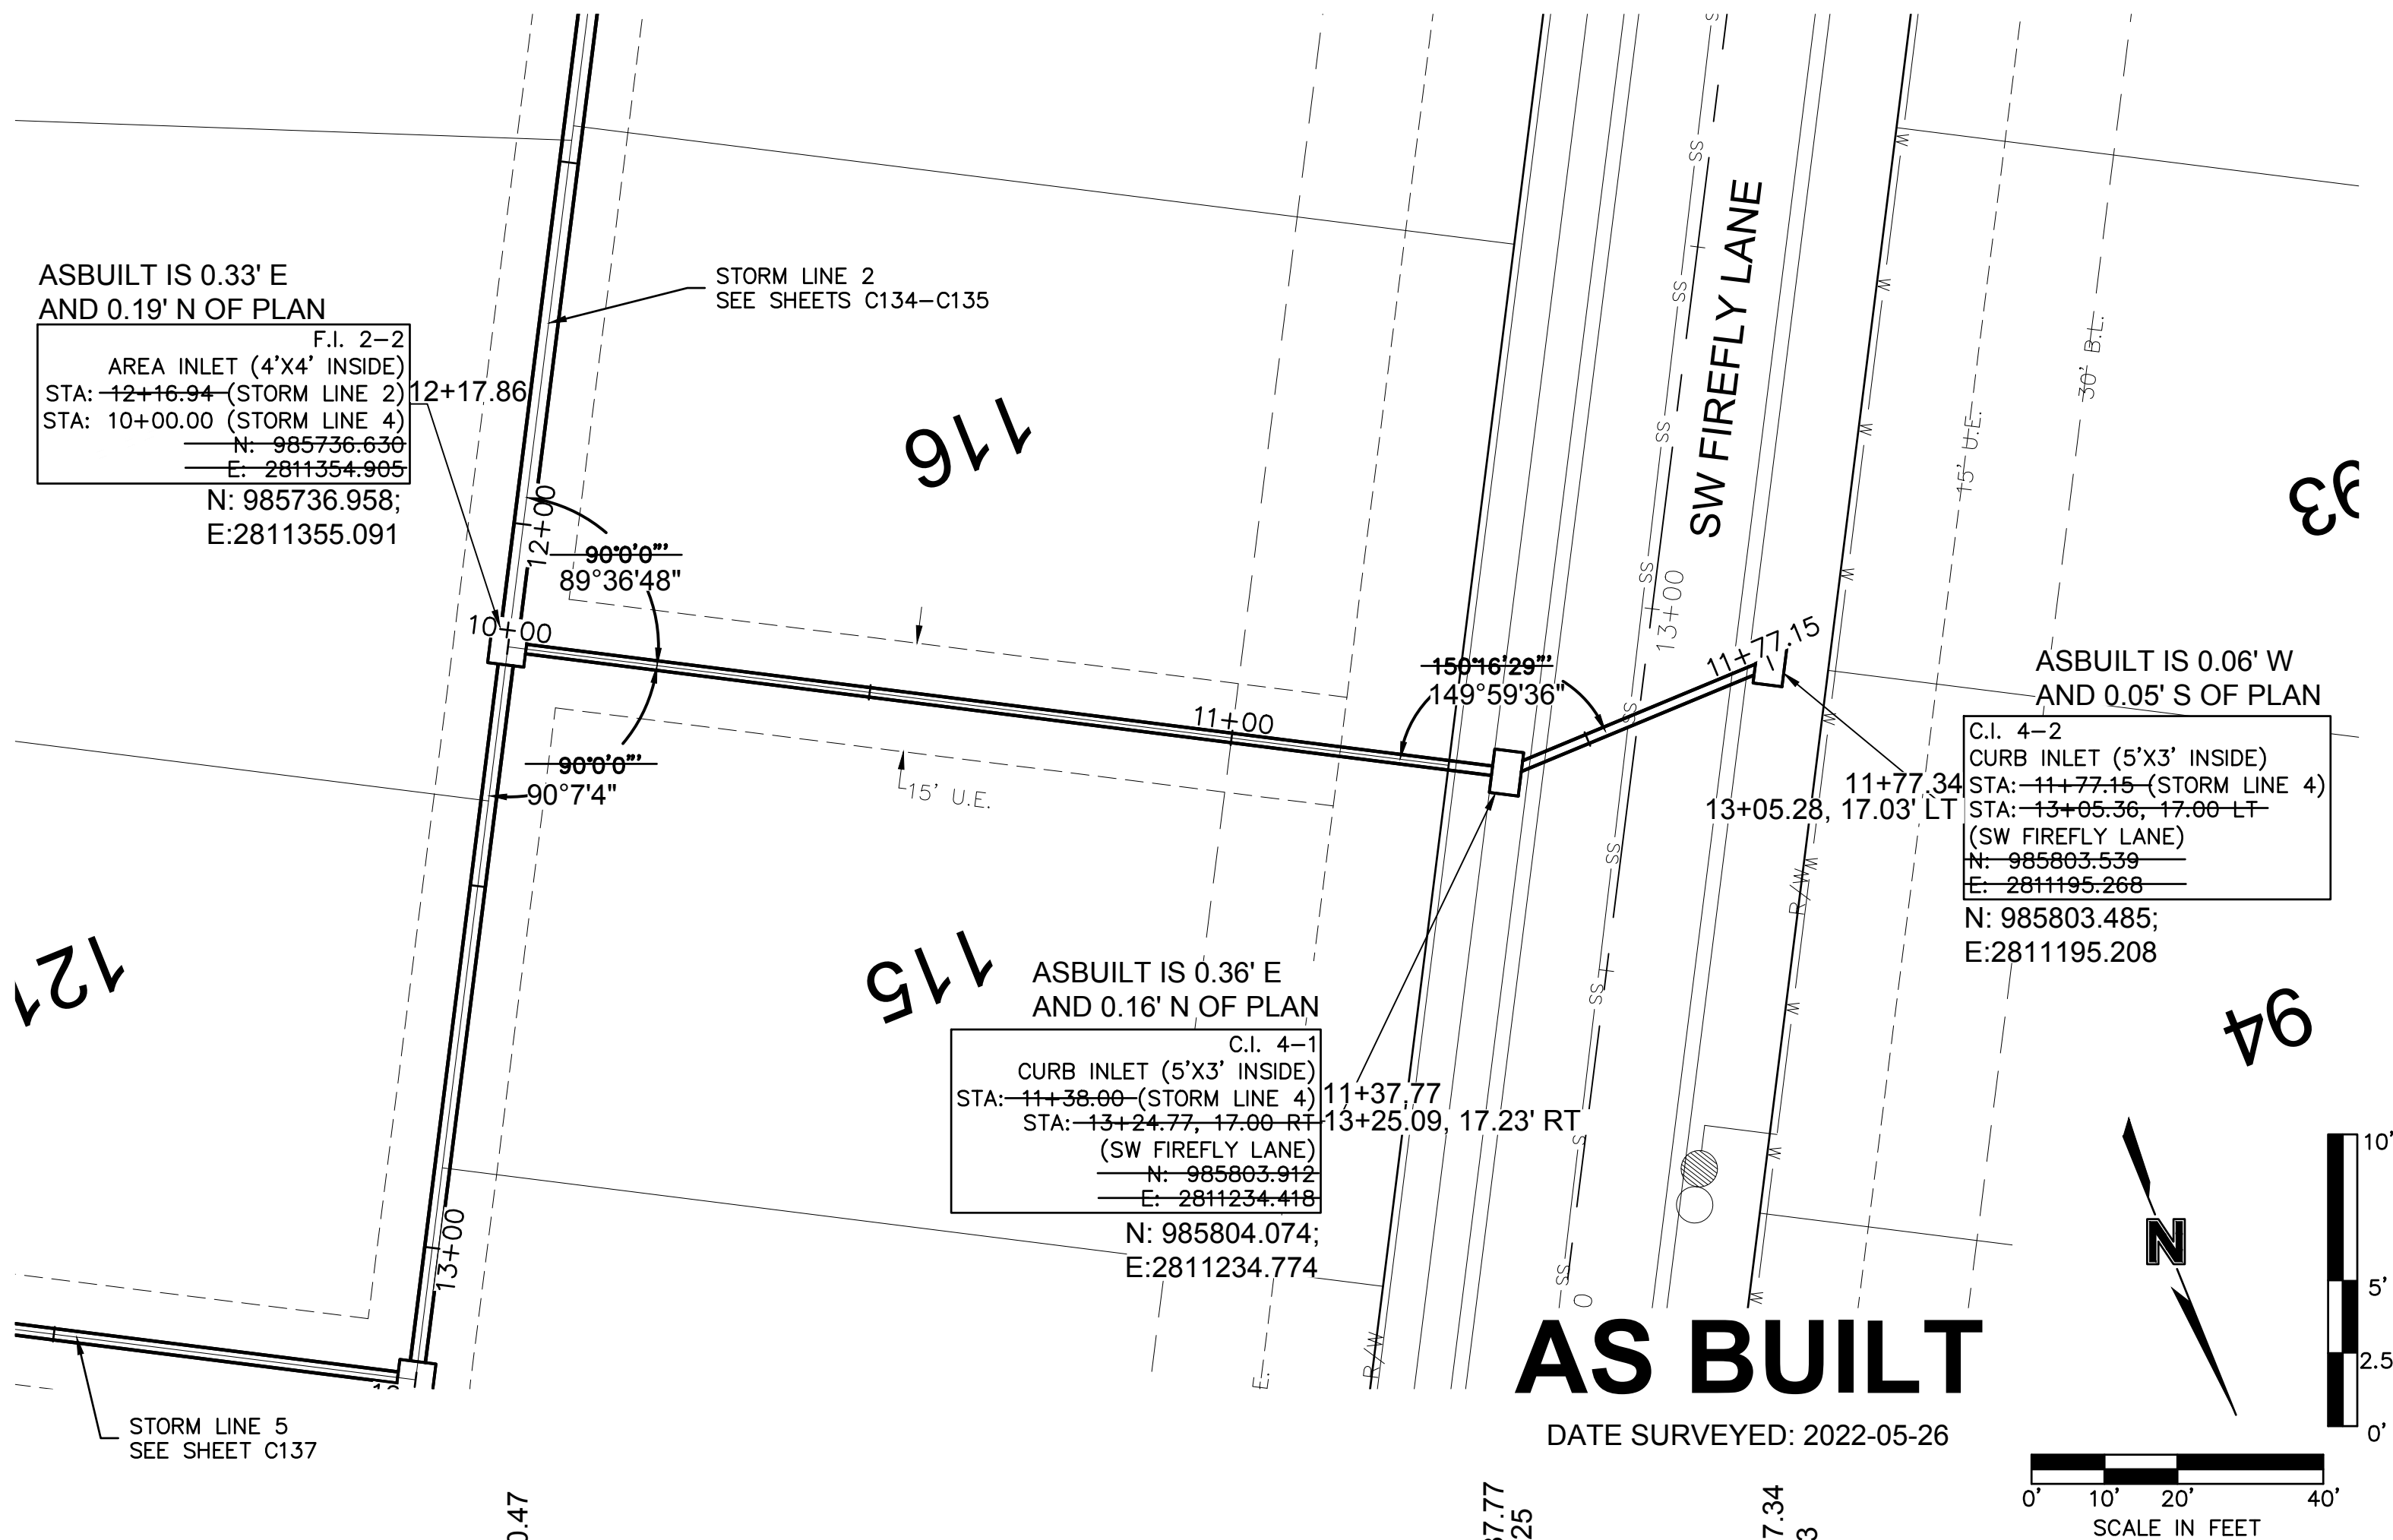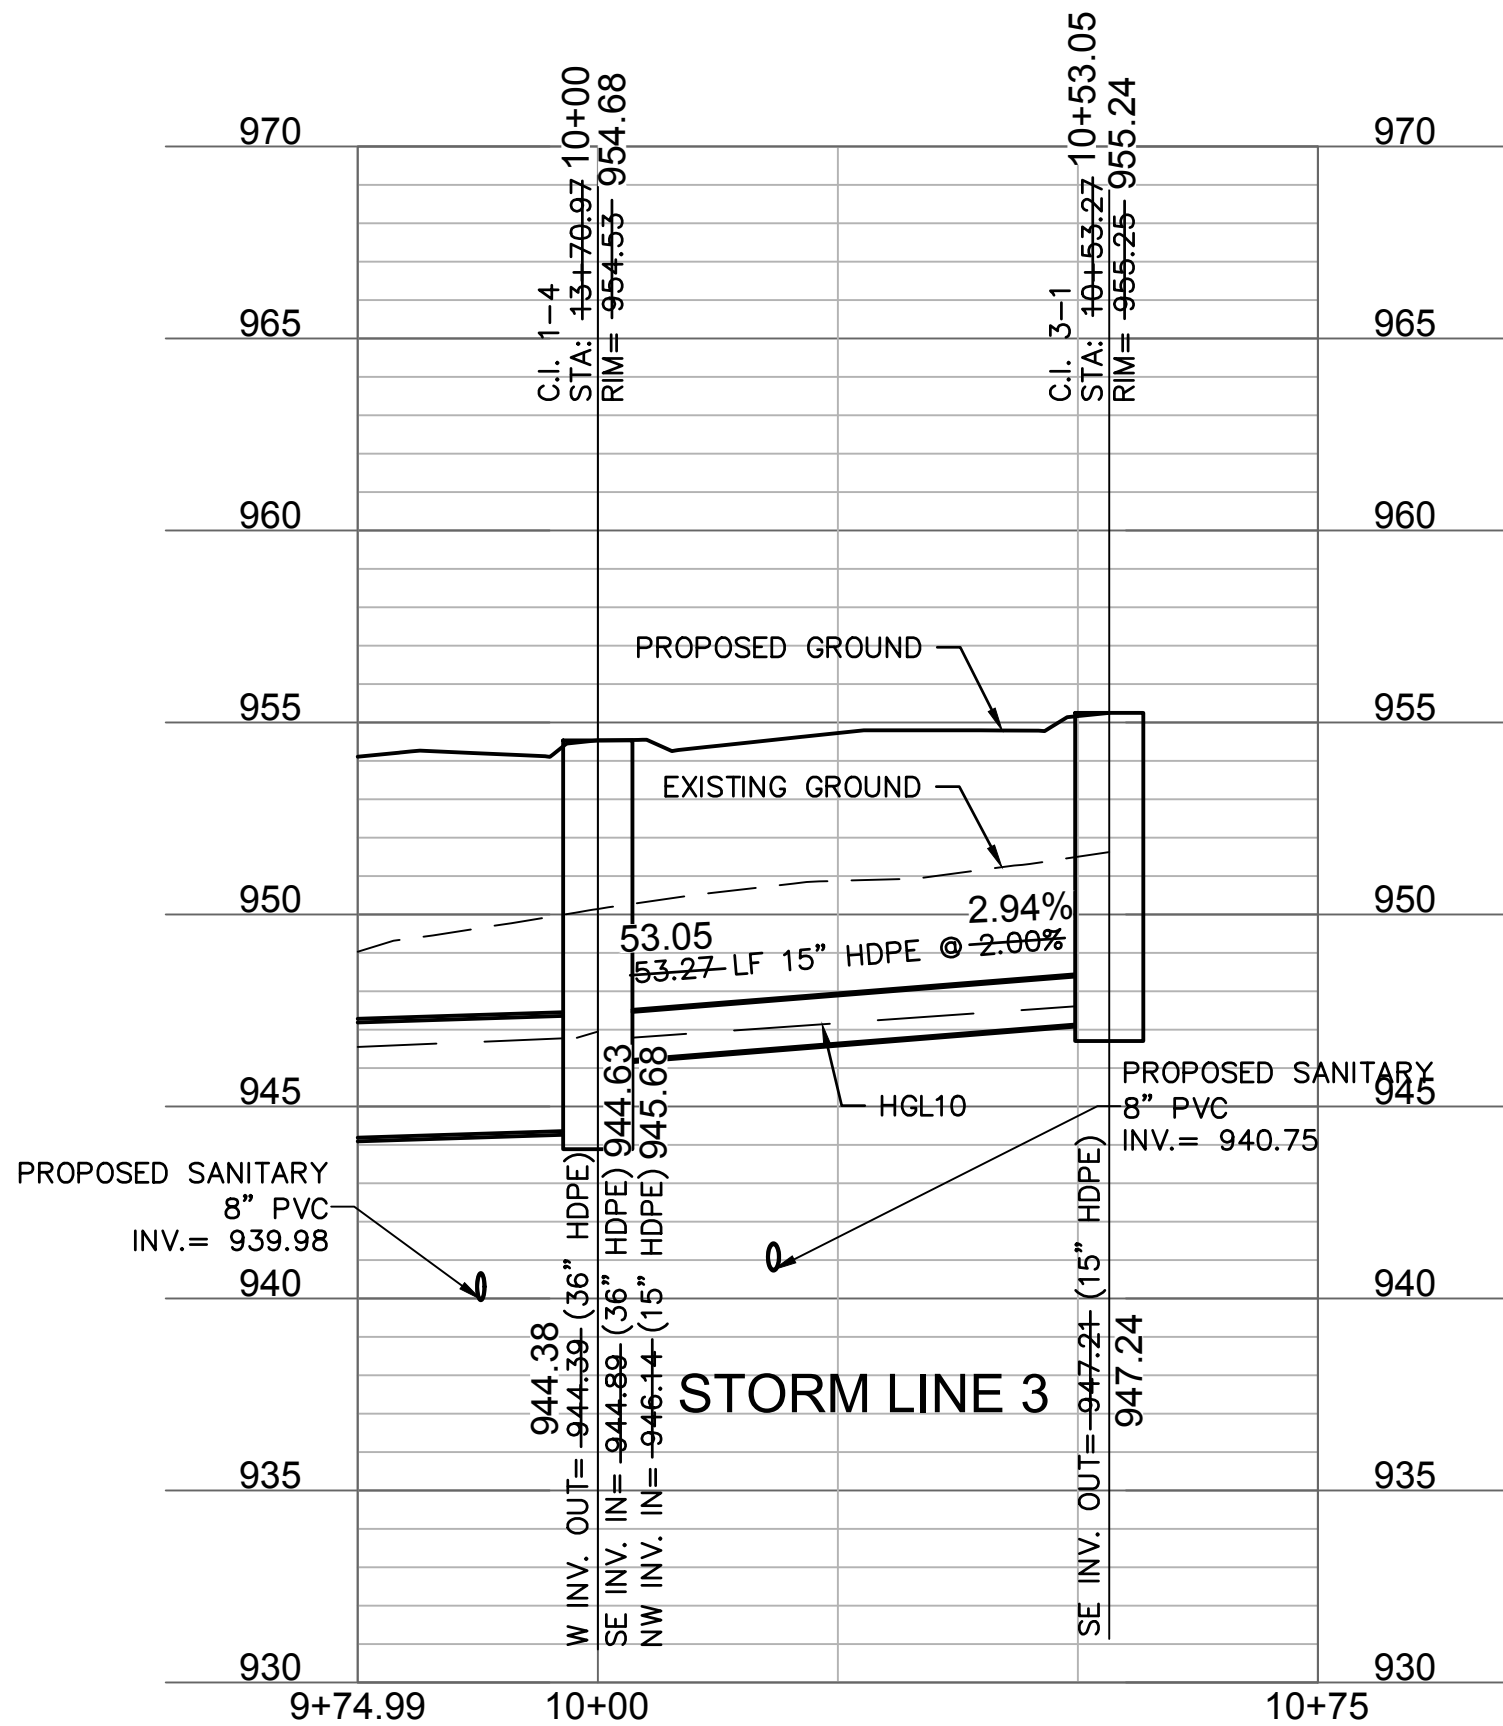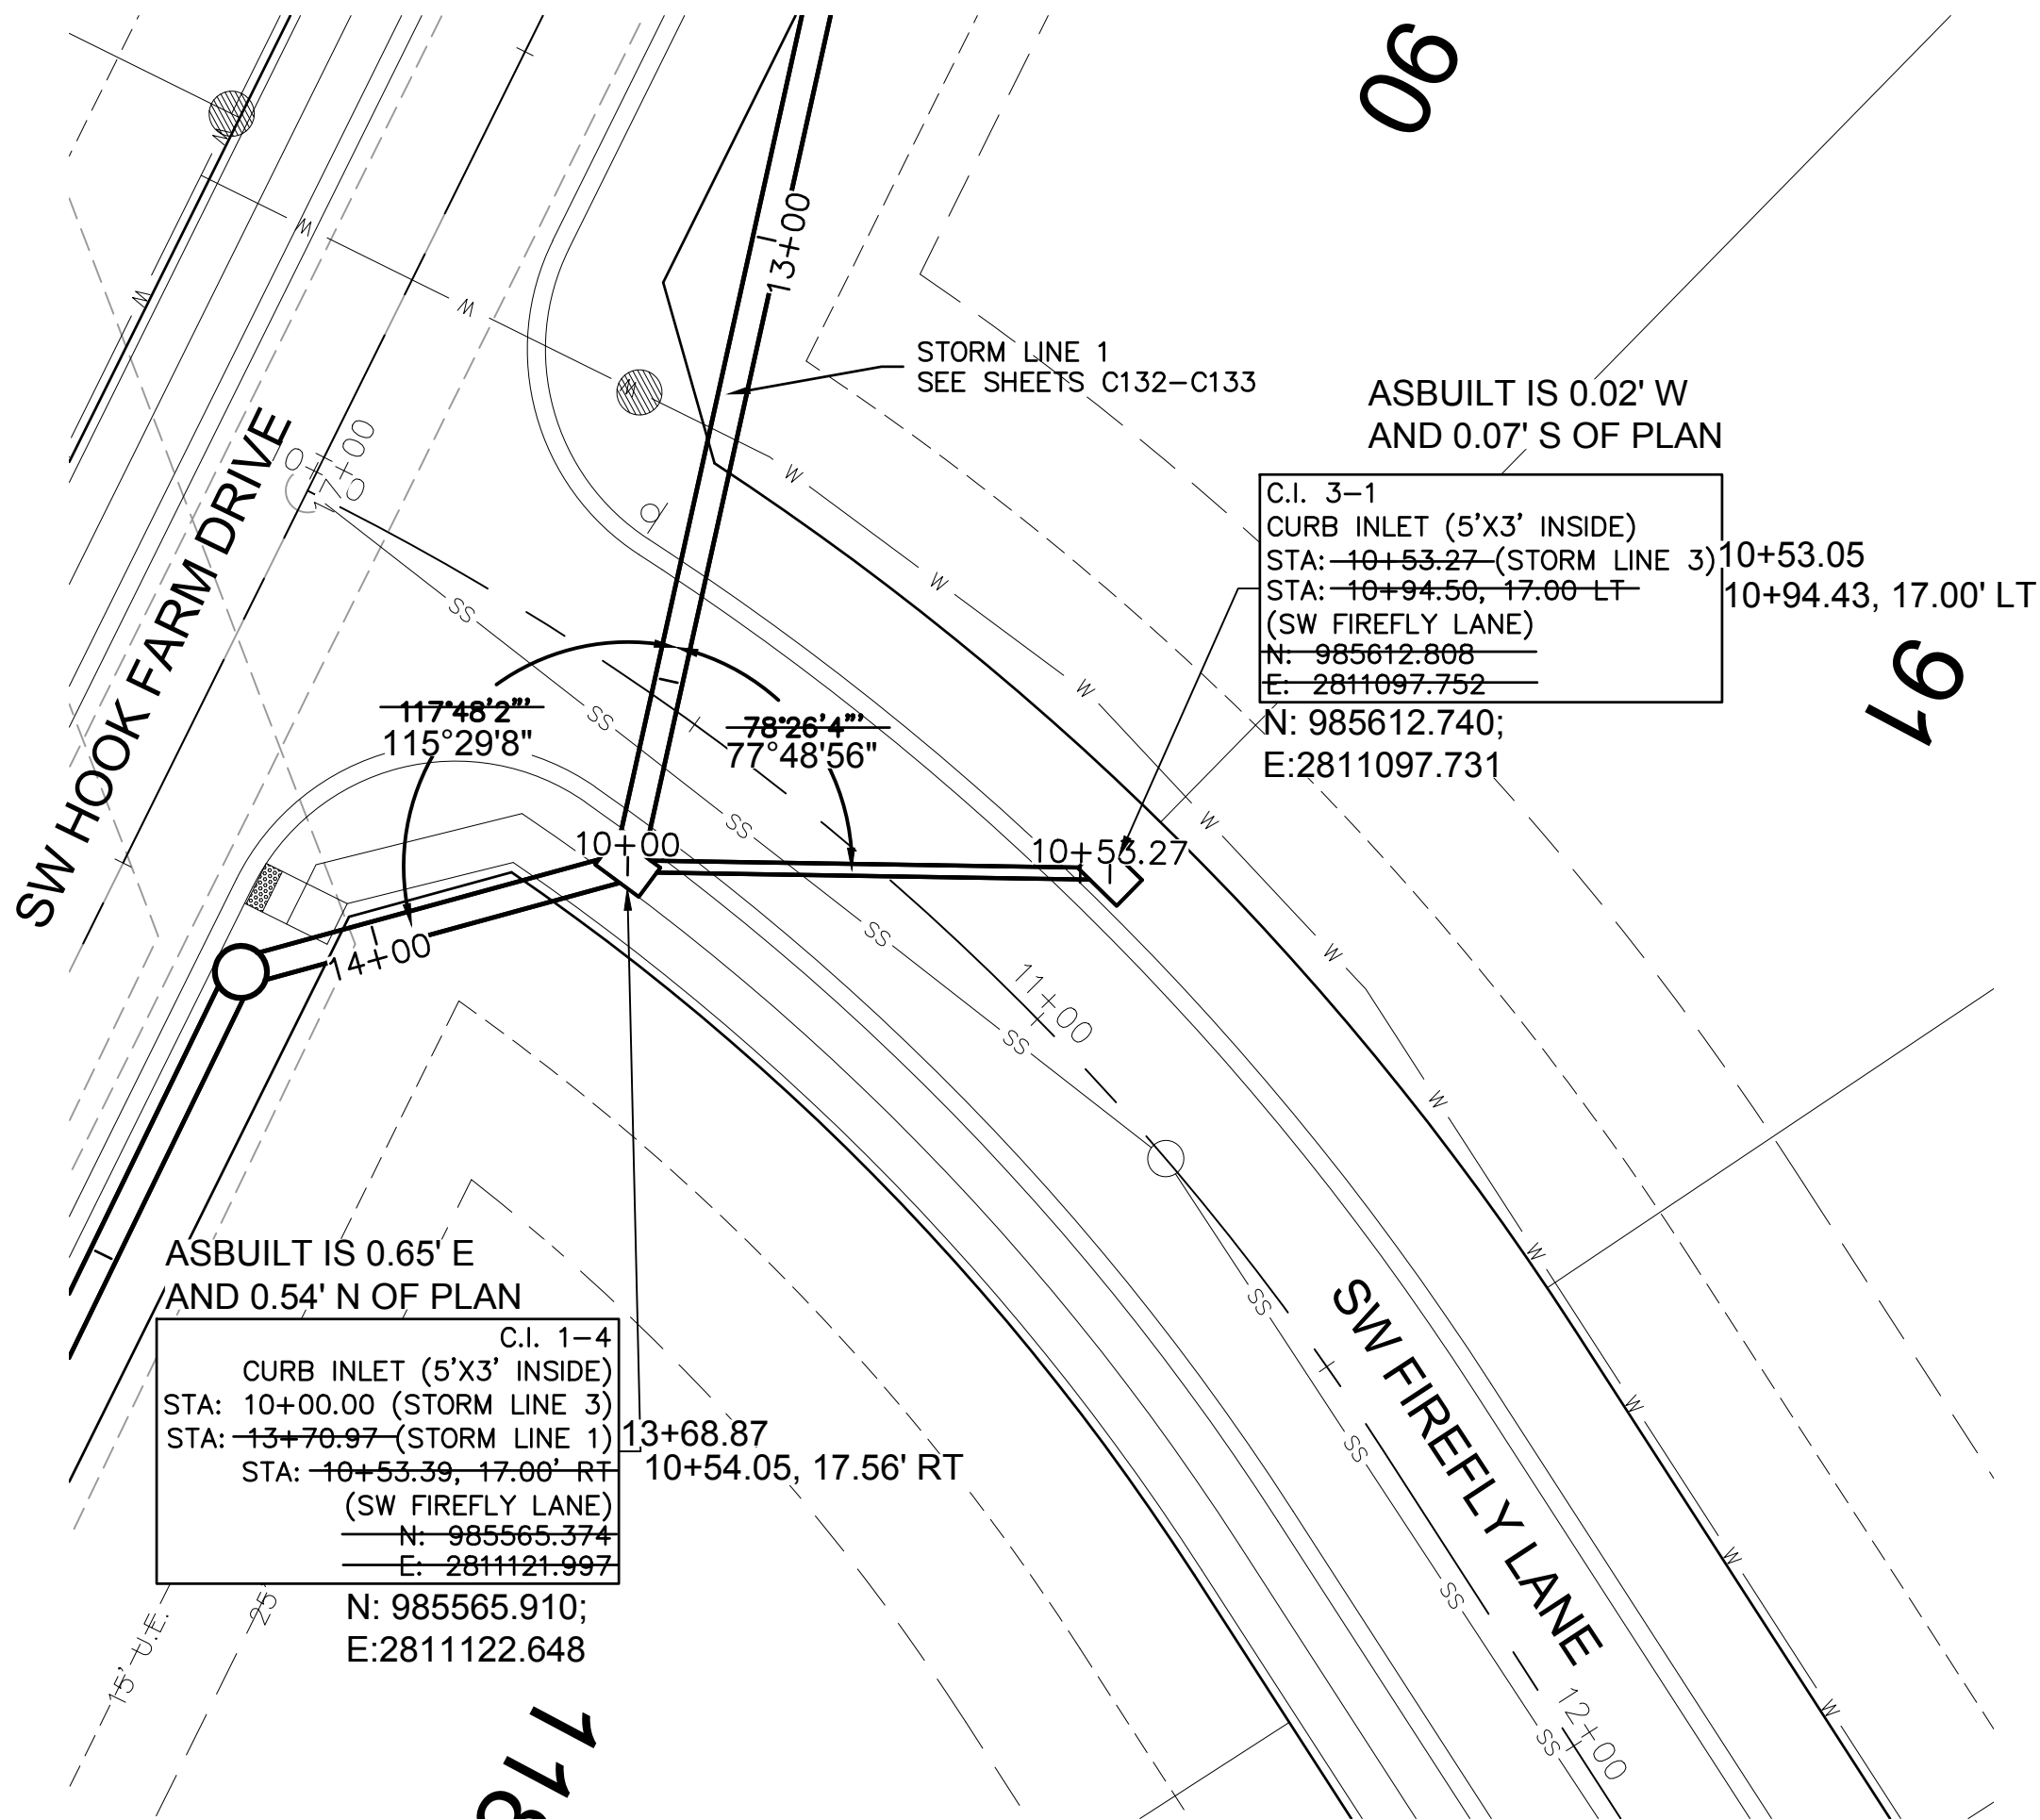

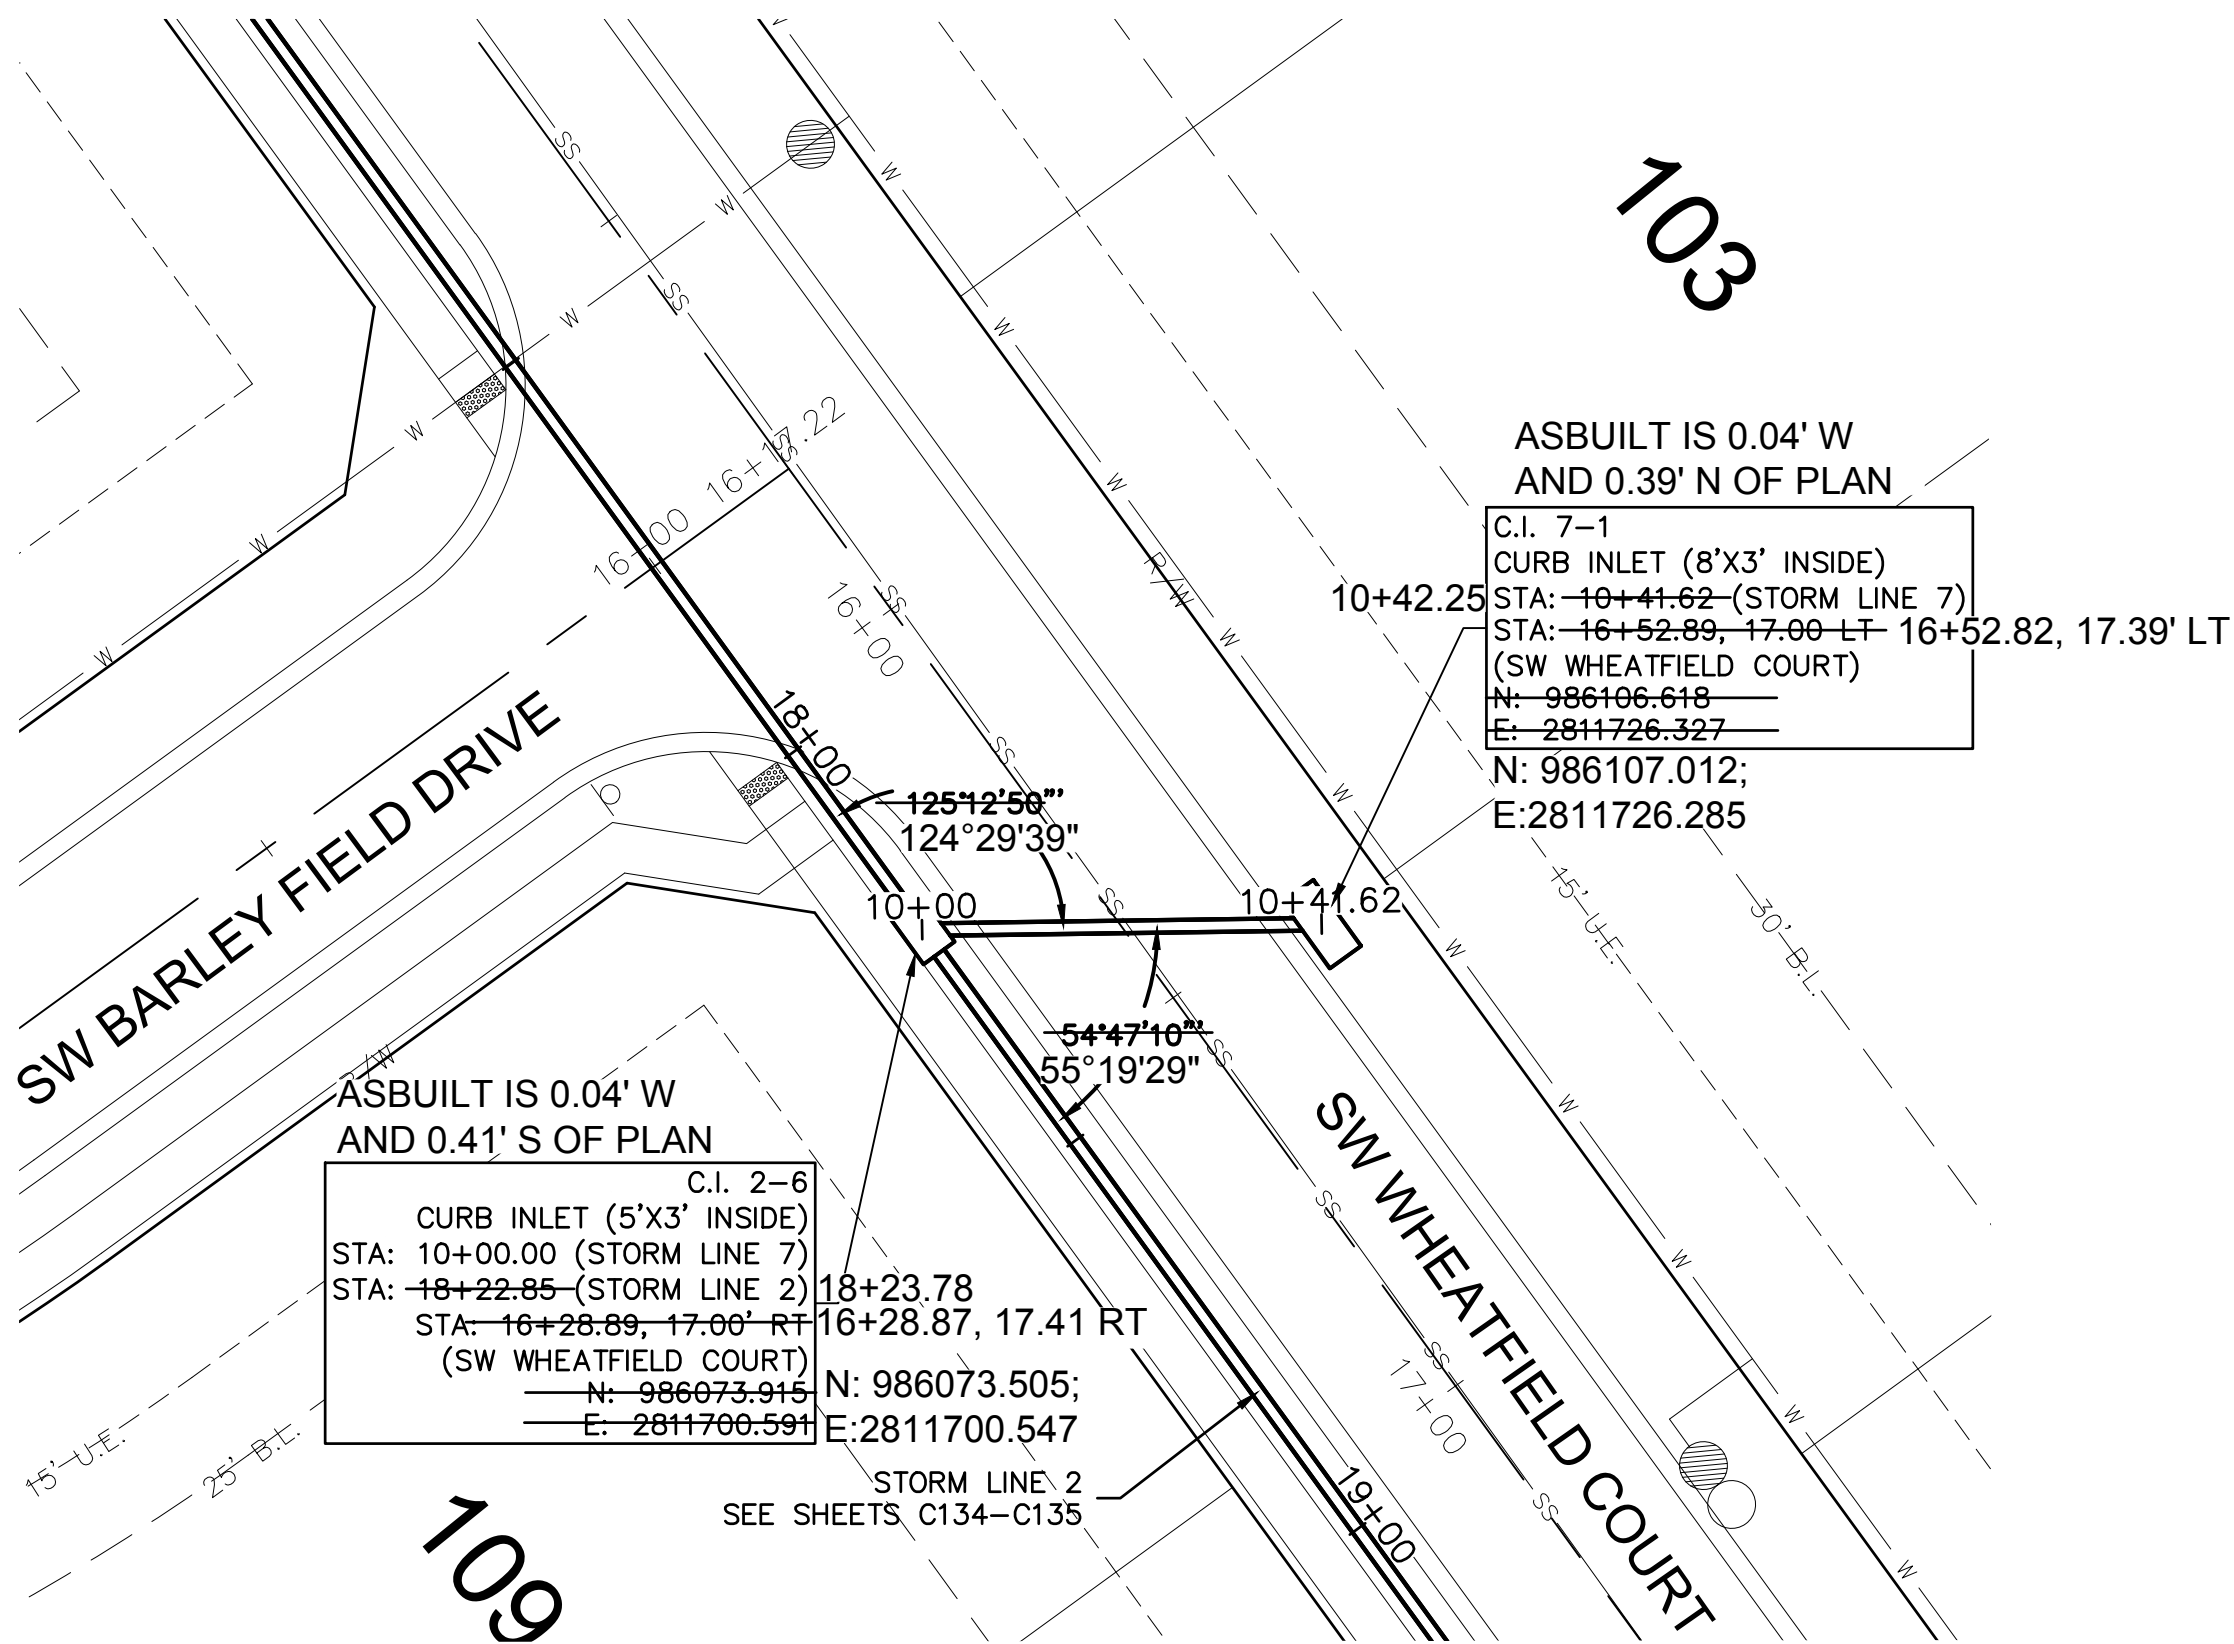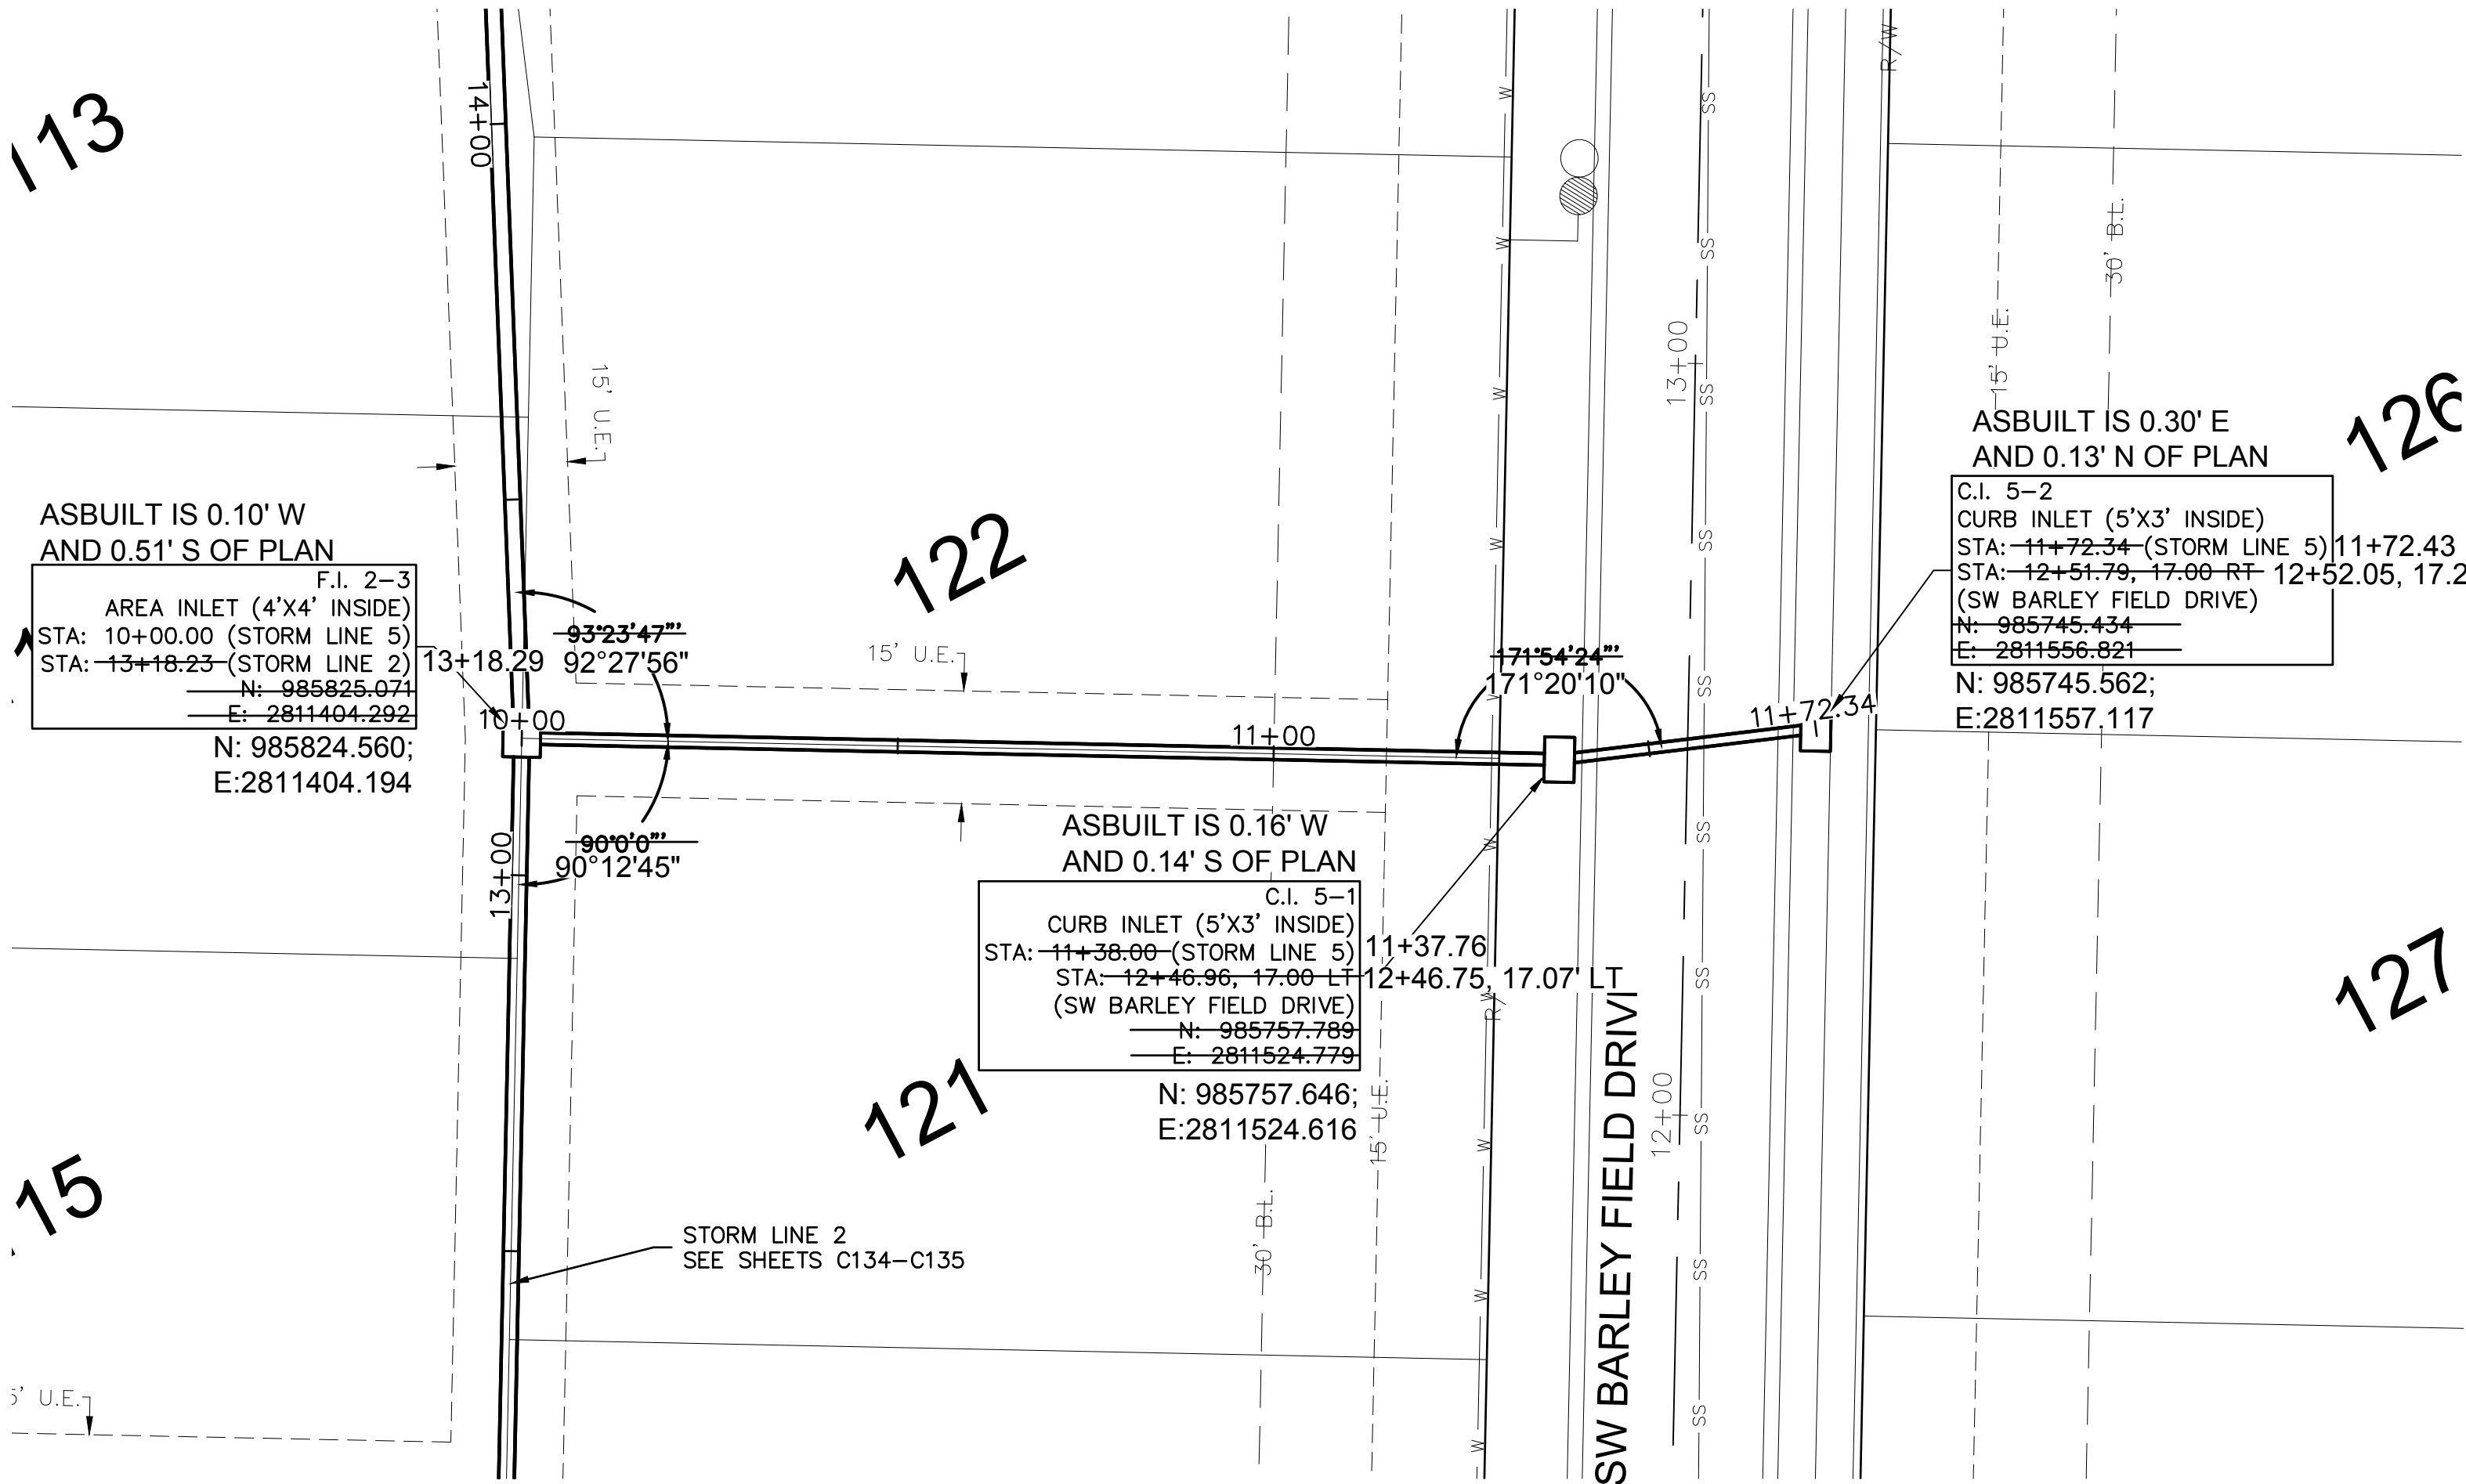

AS BUILT
DATE SURVEYED: 2022-05-26

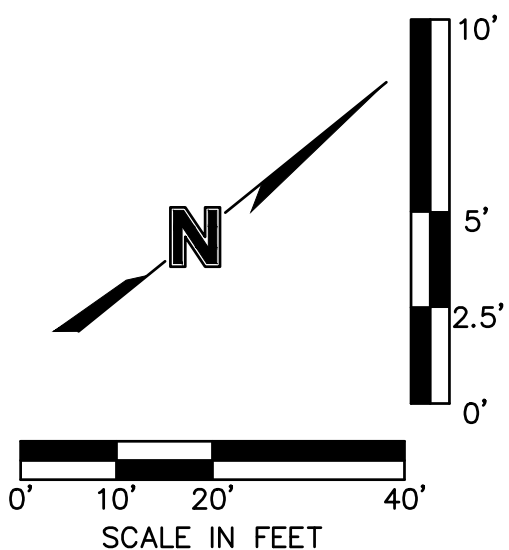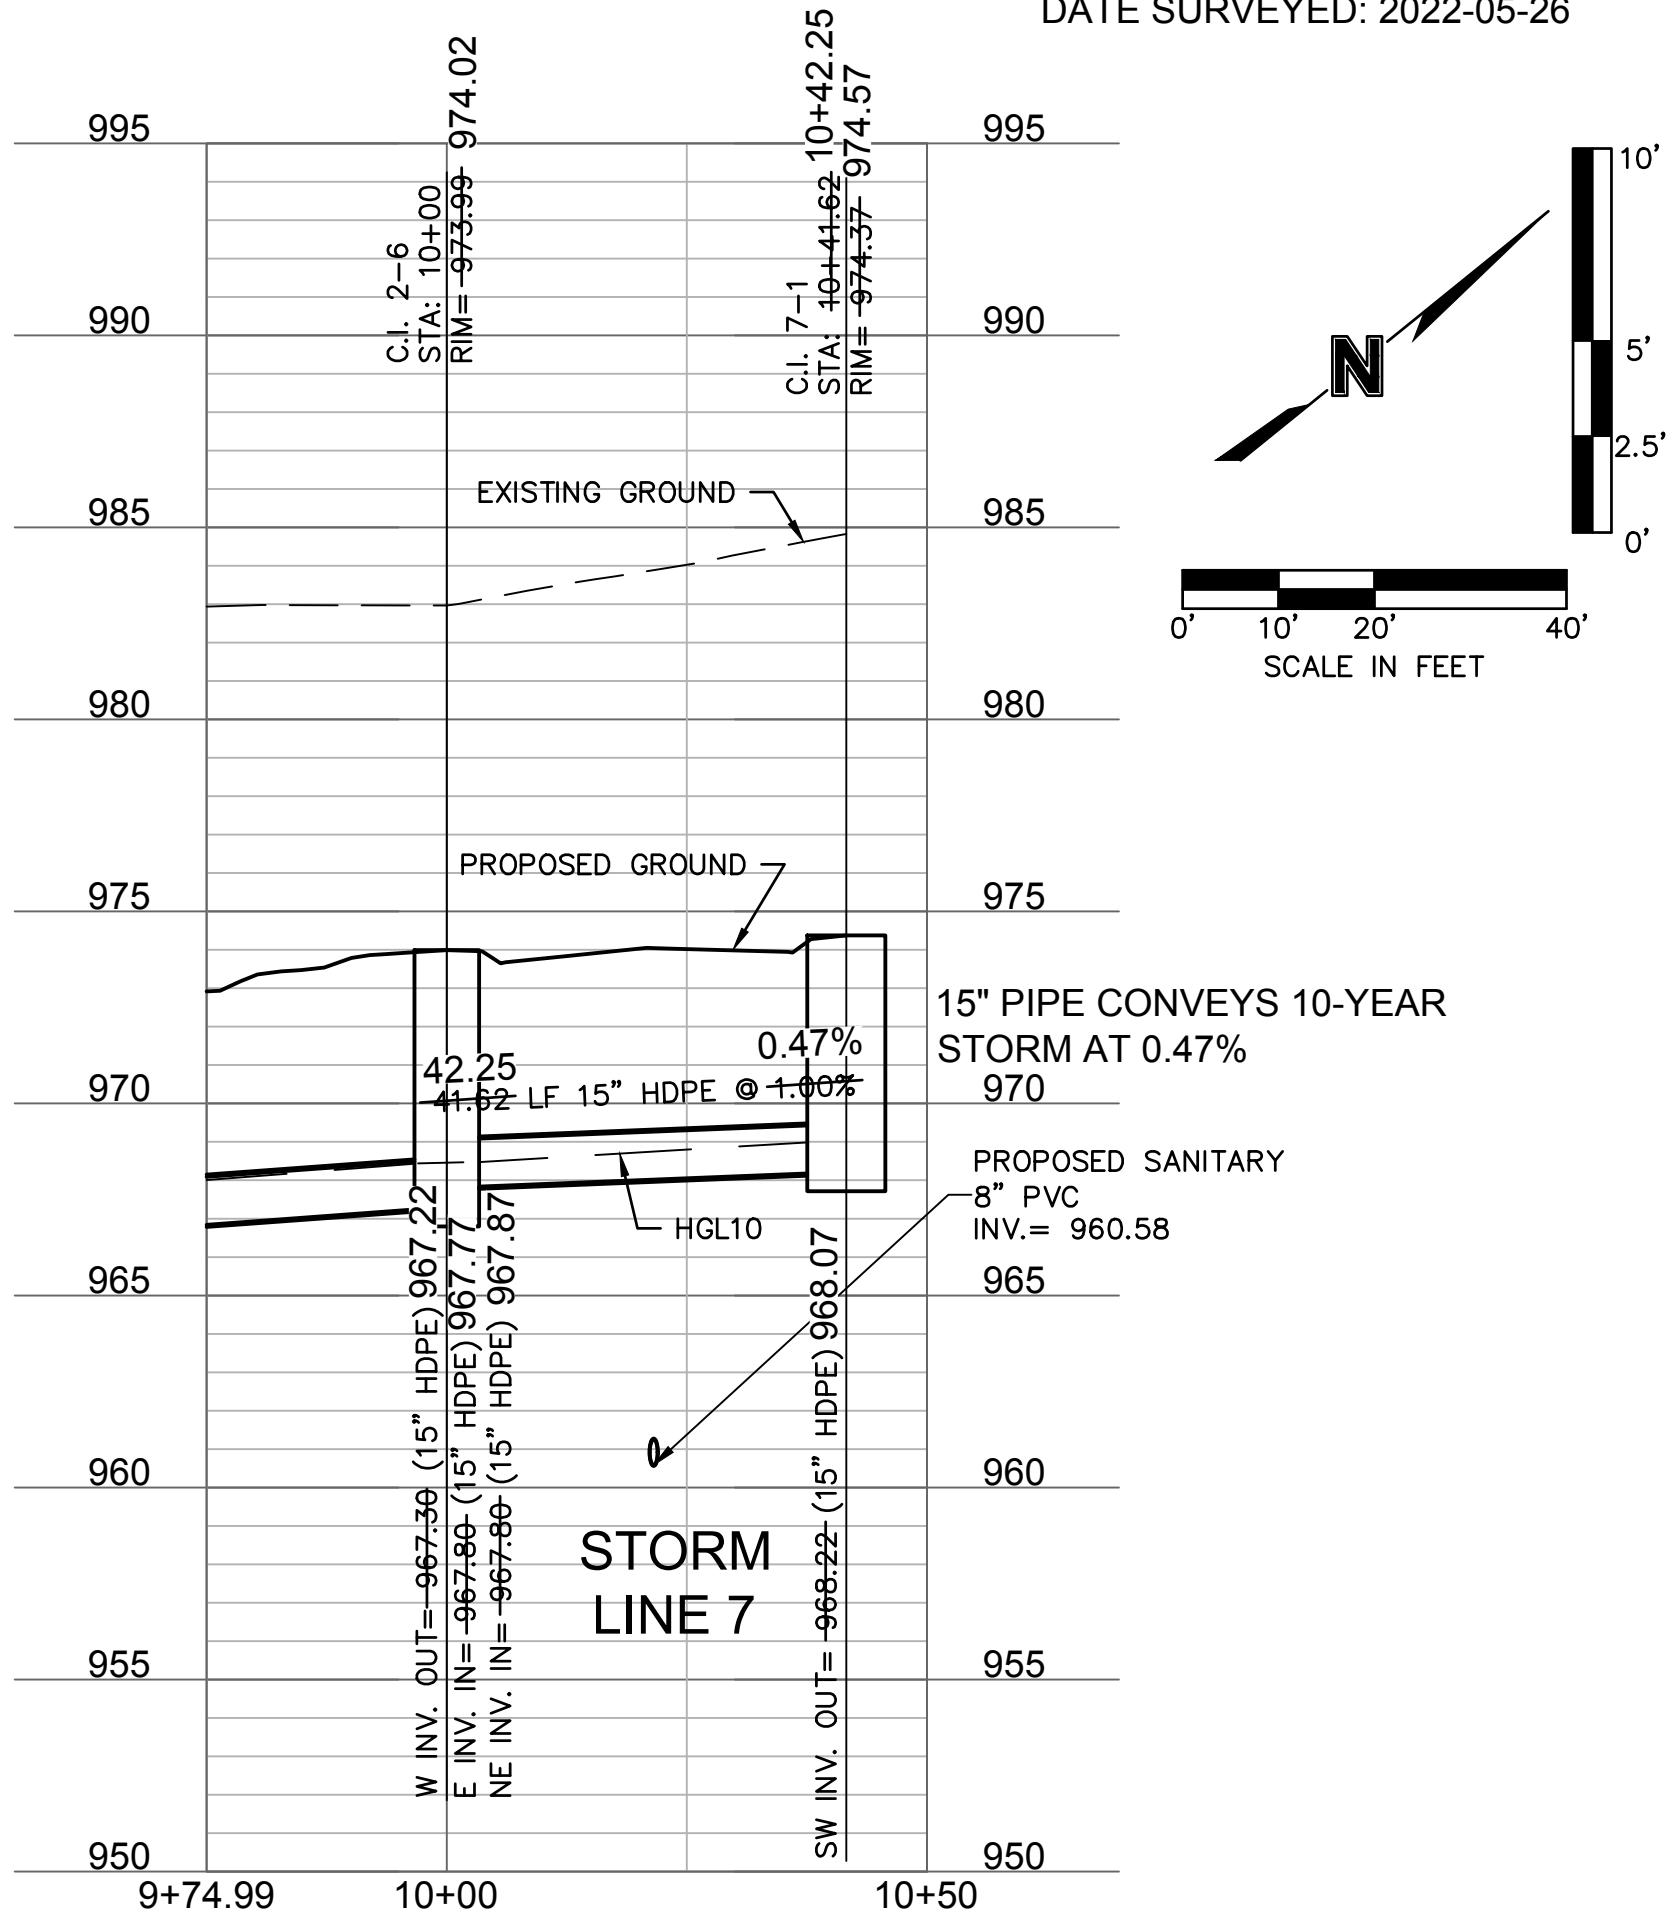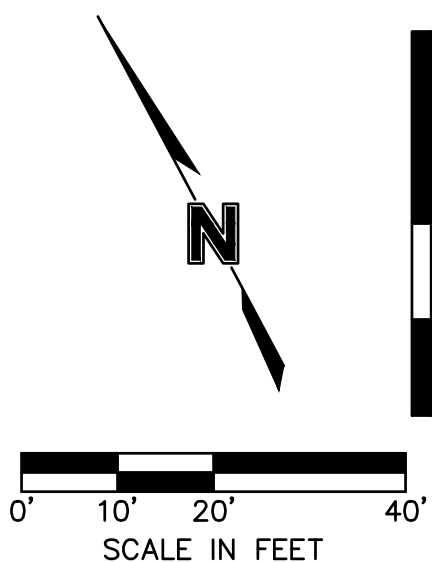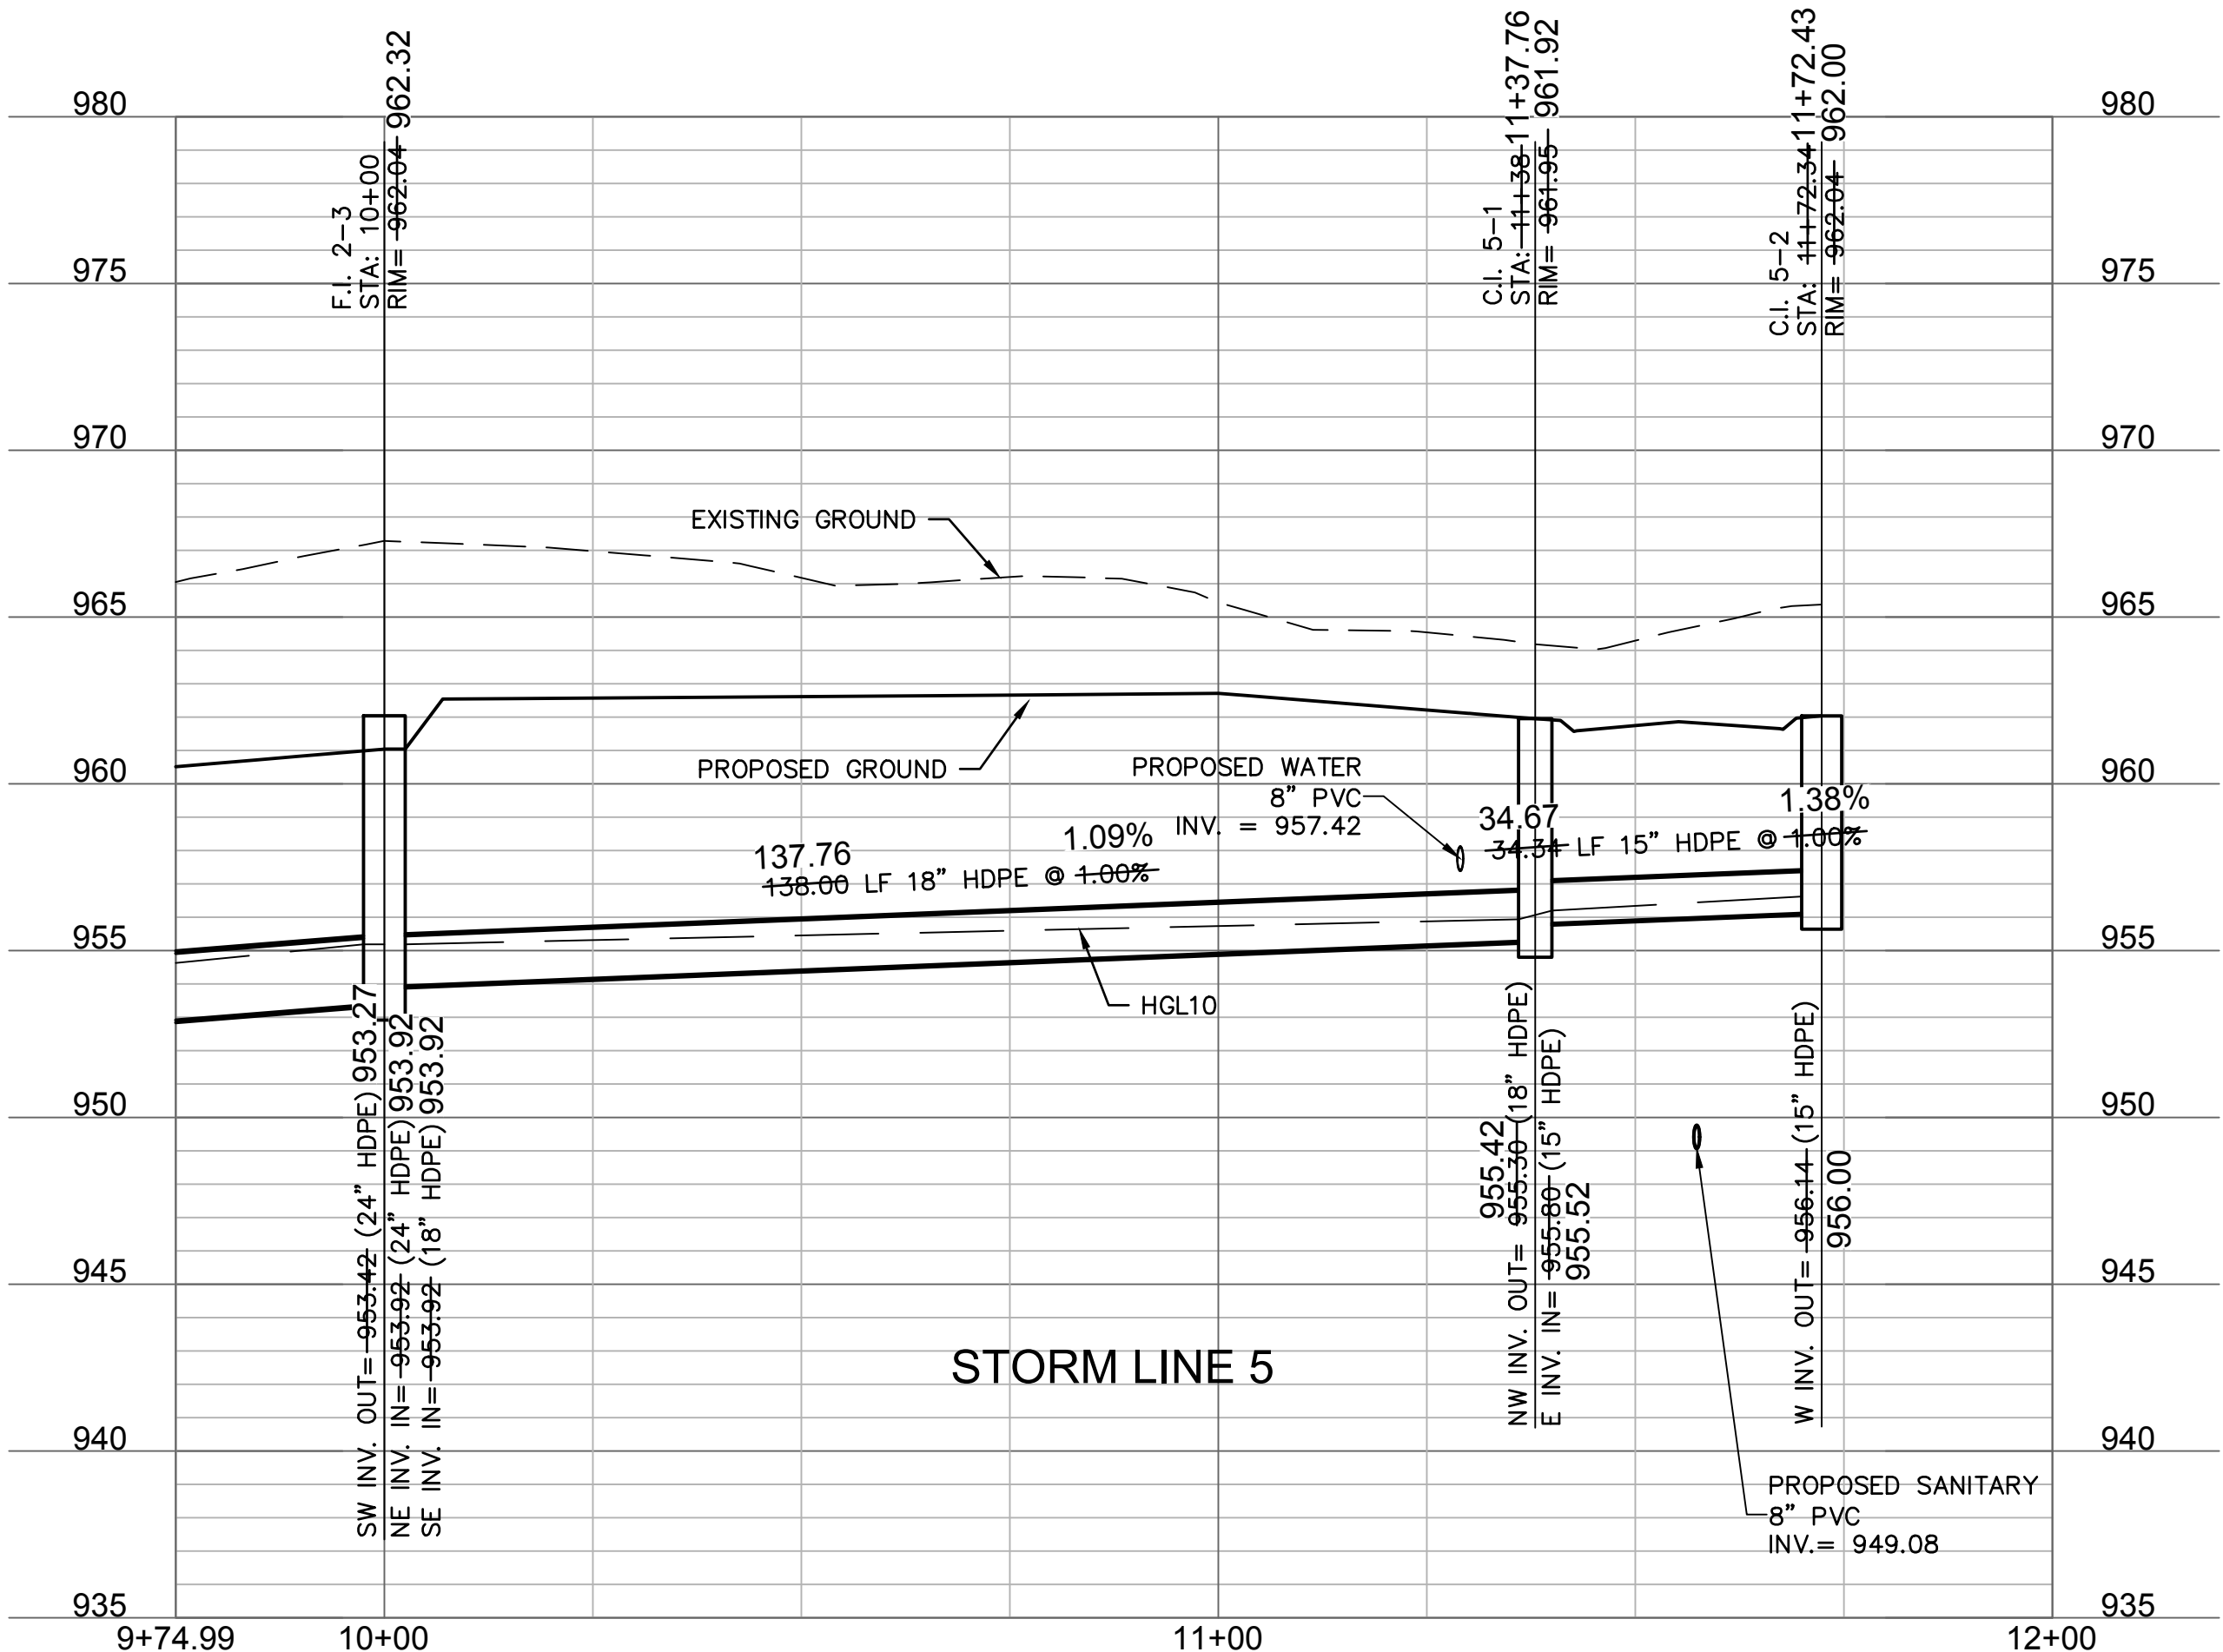

olsson

Olsson - Civil Engineering
Missouri Certificate of Authority #001592
1301 Burlington Street
North Kansas City, MO 64116
TEL 816.361.1177
FAX 816.361.1888
www.olsson.com



STATE OF MISSOURI
JULIE ELAINE SELLERS
NUMBER PE-2017000367
11/28/22
PROFESSIONAL ENGINEER

BY
DATE
REV. NO.
1 03-23-2021
2 04-16-2021
3 09-30-2021
REVISIONS DESCRIPTION
REVISED PER CITY COMMENTS
REVISED PER CITY COMMENTS
CHANGES TO APPROVED PLANS

STORM SEWER PLAN & PROFILE (LINES 5 & 7)
STREET & STORM SEWER PLANS
HOOK FARMS
SECOND PLAT
LEE'S SUMMIT, MO
2021

drawn by: B.M.W./A.A.
checked by: B.M.W.
designed by: B.M.W./A.A.
QA/QC by: J.E.S.
project no.: B19-4061
date: 01-08-2021

SHEET C137

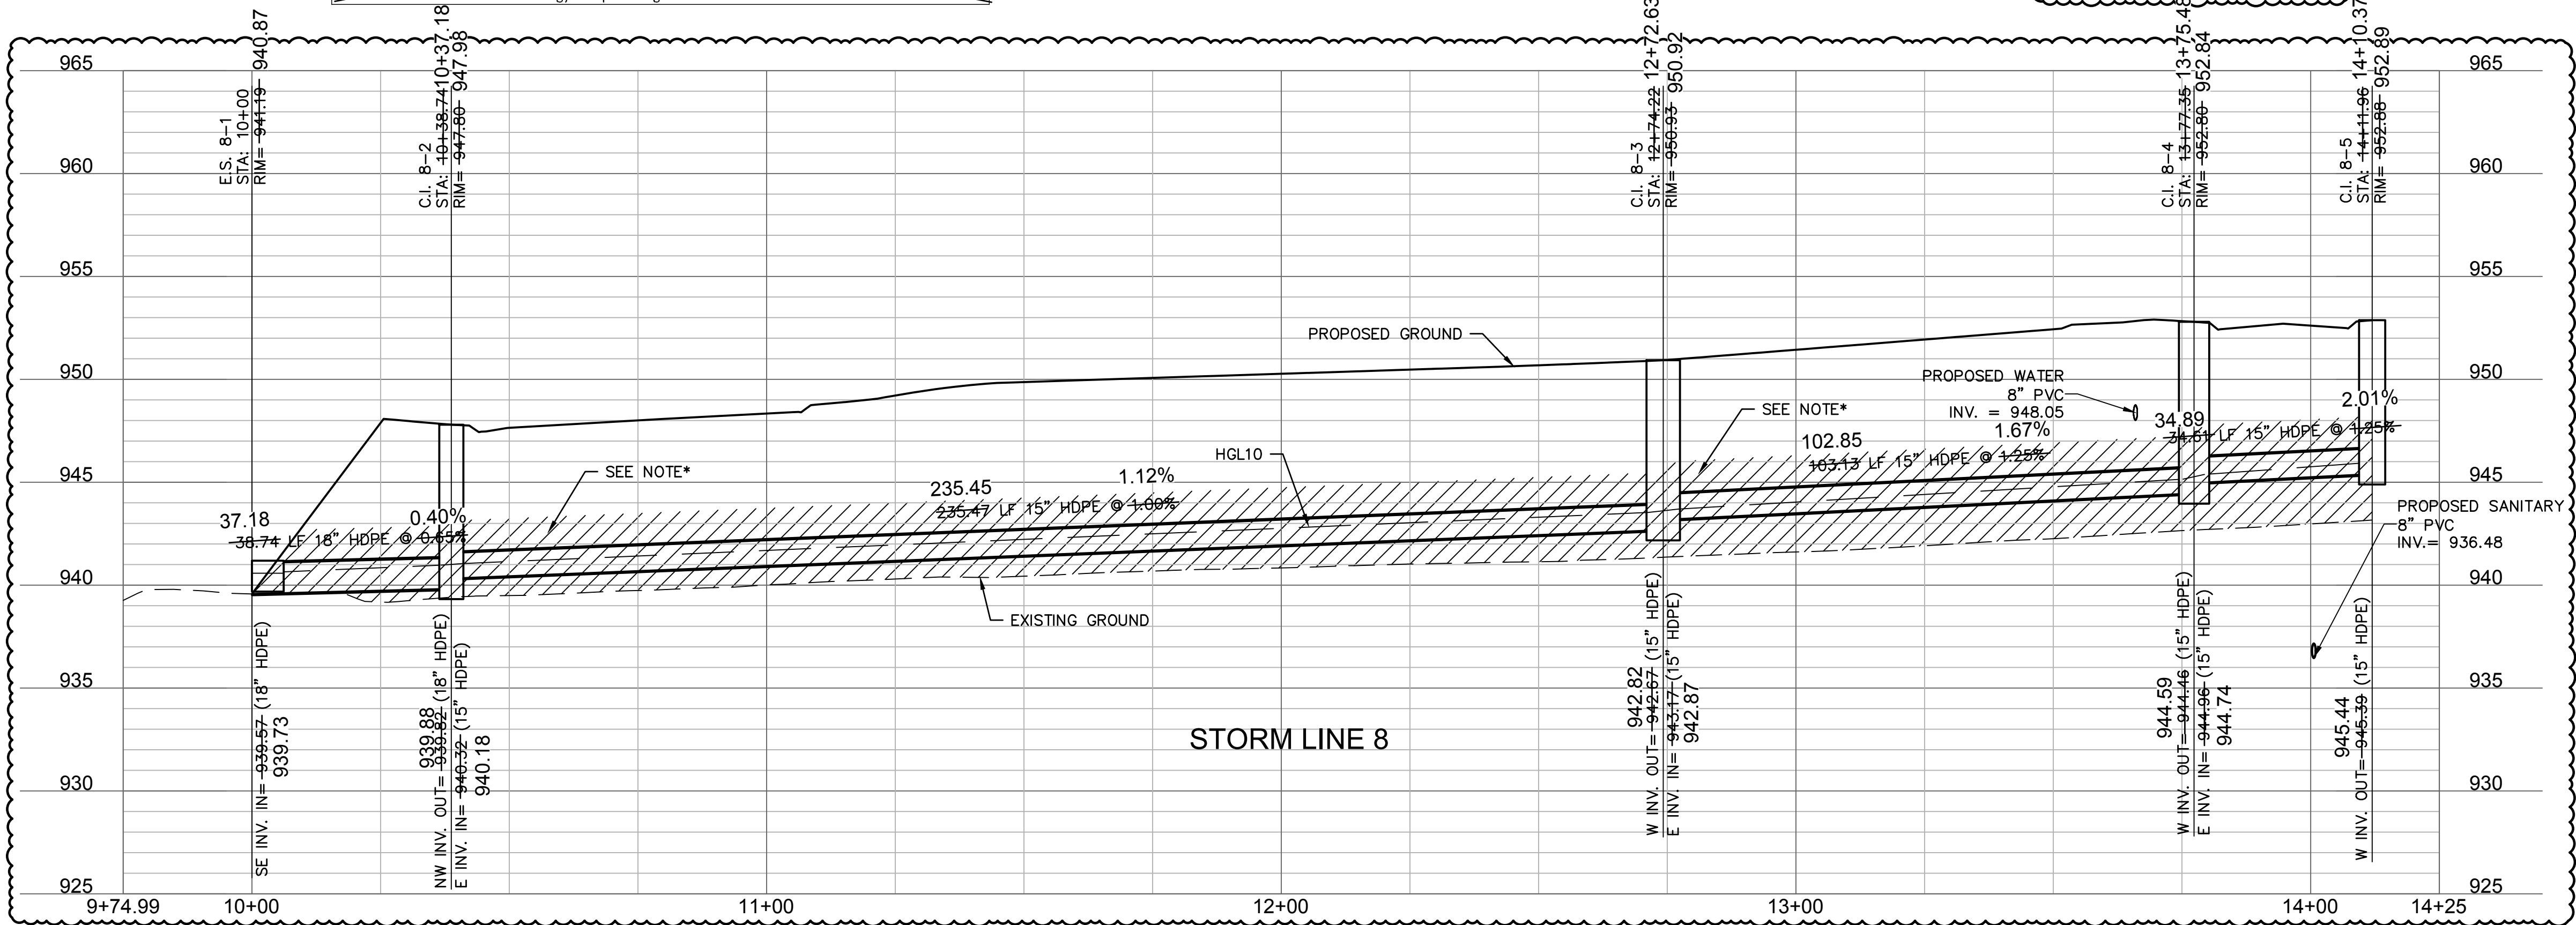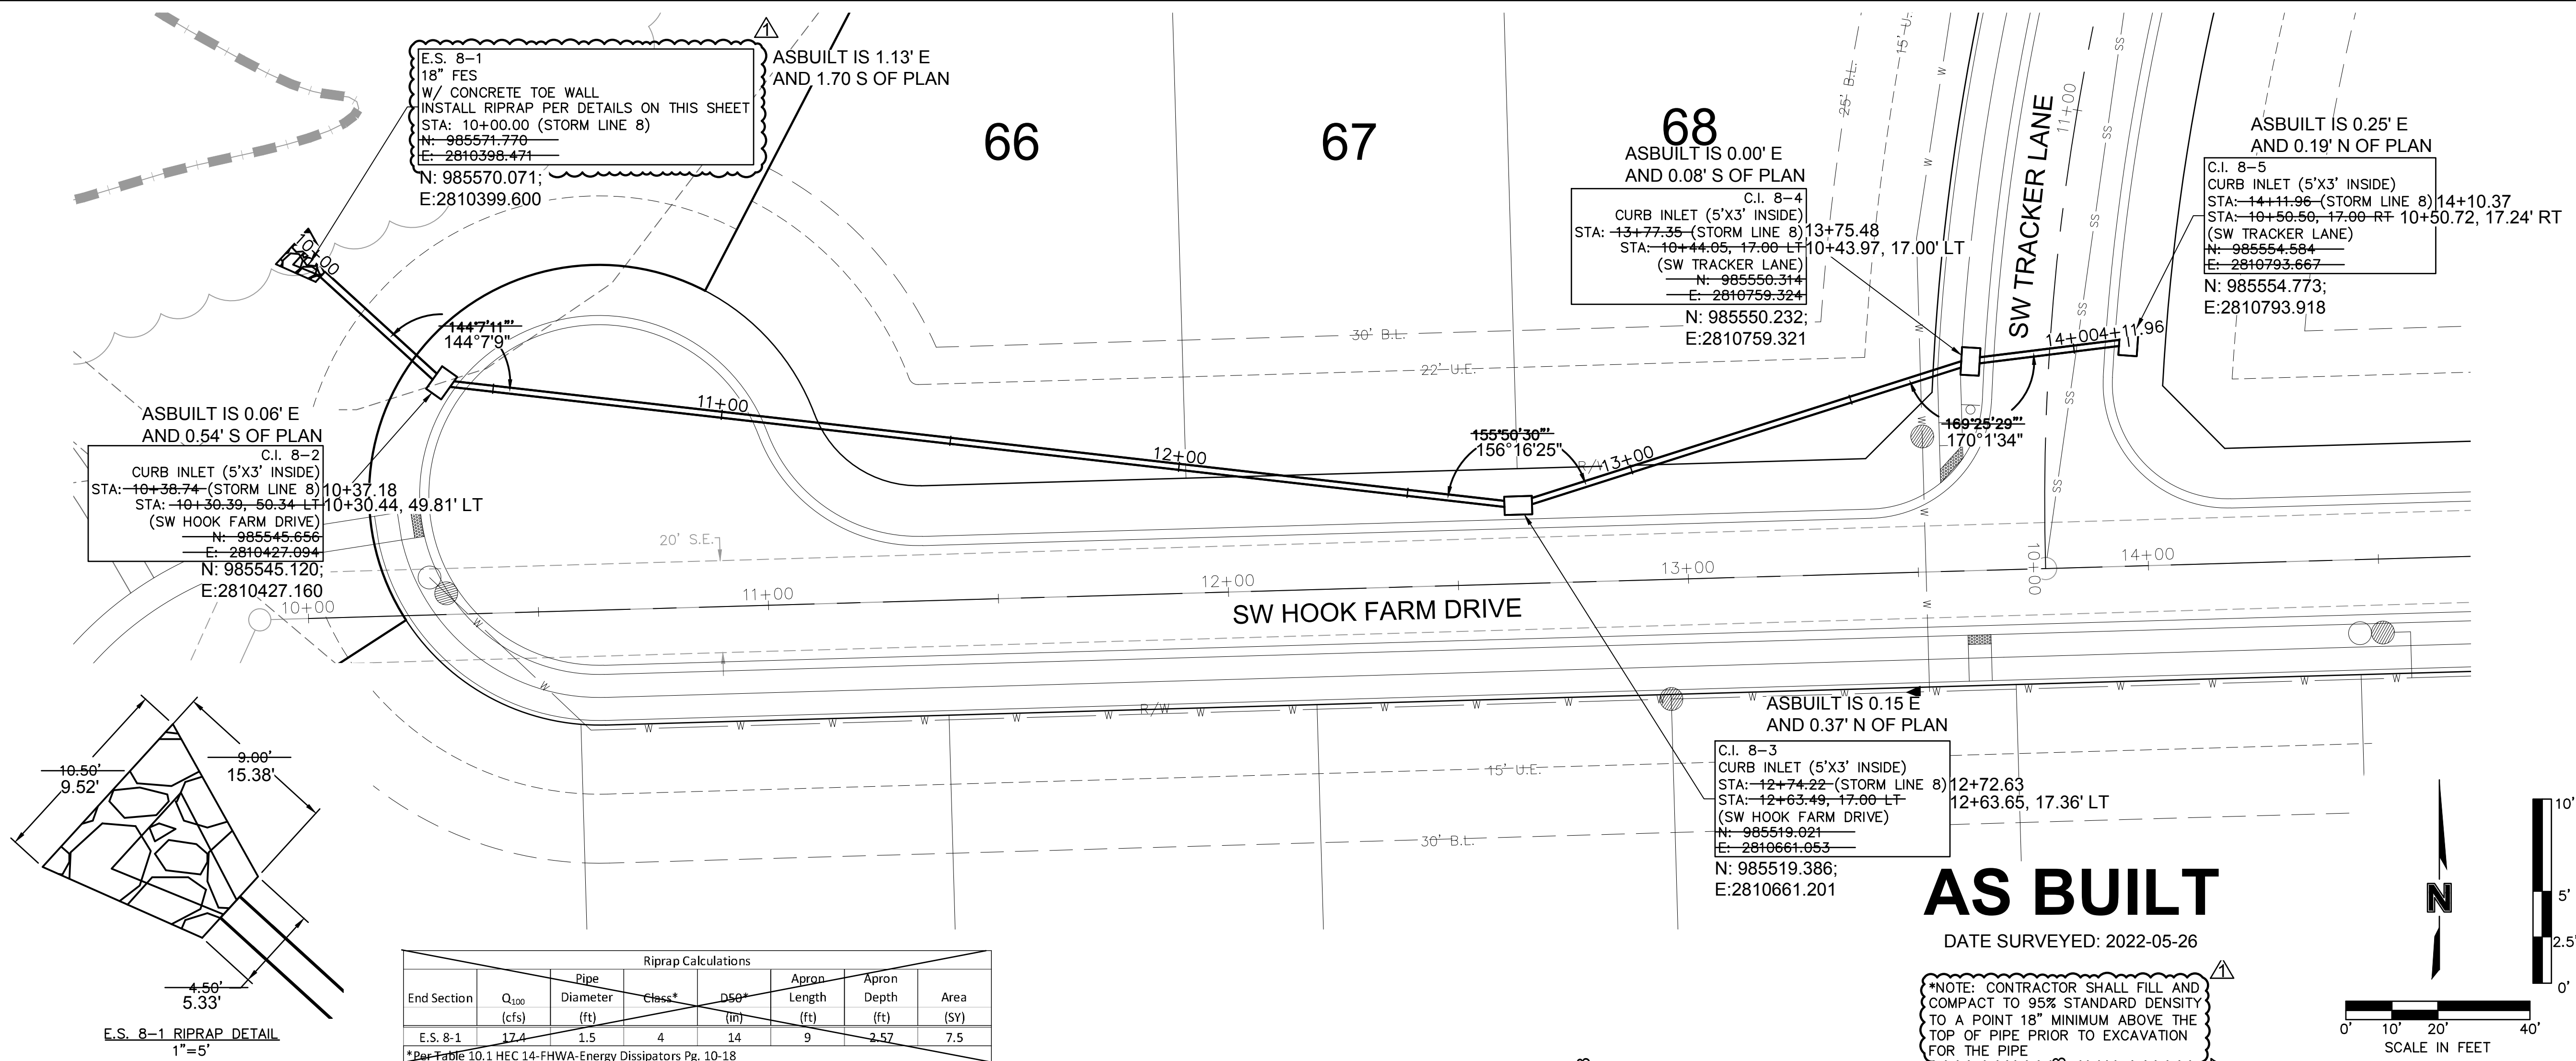

olsson

Olsson - Civil Engineering
Missouri Certificate of Authority #001592
1301 Burlington Street
North Kansas City, MO 64116
TEL 816.361.1177
FAX 816.361.1888
www.olsson.com

STATE OF MISSOURI
JULIE ELAINE SELLERS
NUMBER PE-2017000367
11/28/22
PROFESSIONAL ENGINEER

BY

REVISIONS DESCRIPTION

REV. NO.

DATE

1 03-23-2021 REVISED PER CITY COMMENTS

2 04-18-2021 REVISED PER CITY COMMENTS

3 09-30-2021 CHANGES TO APPROVED PLANS

2021


STORM SEWER PLAN & PROFILE (LINE 8)
STREET & STORM SEWER PLANS

HOOK FARMS
SECOND PLAT

LEE'S SUMMIT, MO

drawn by: B.M.W./A.A.
checked by: B.M.W.
designed by: B.M.W./A.A.
QA/QC by: J.E.S.
project no.: B19-4061
date: 01-08-2021


SHEET
C139

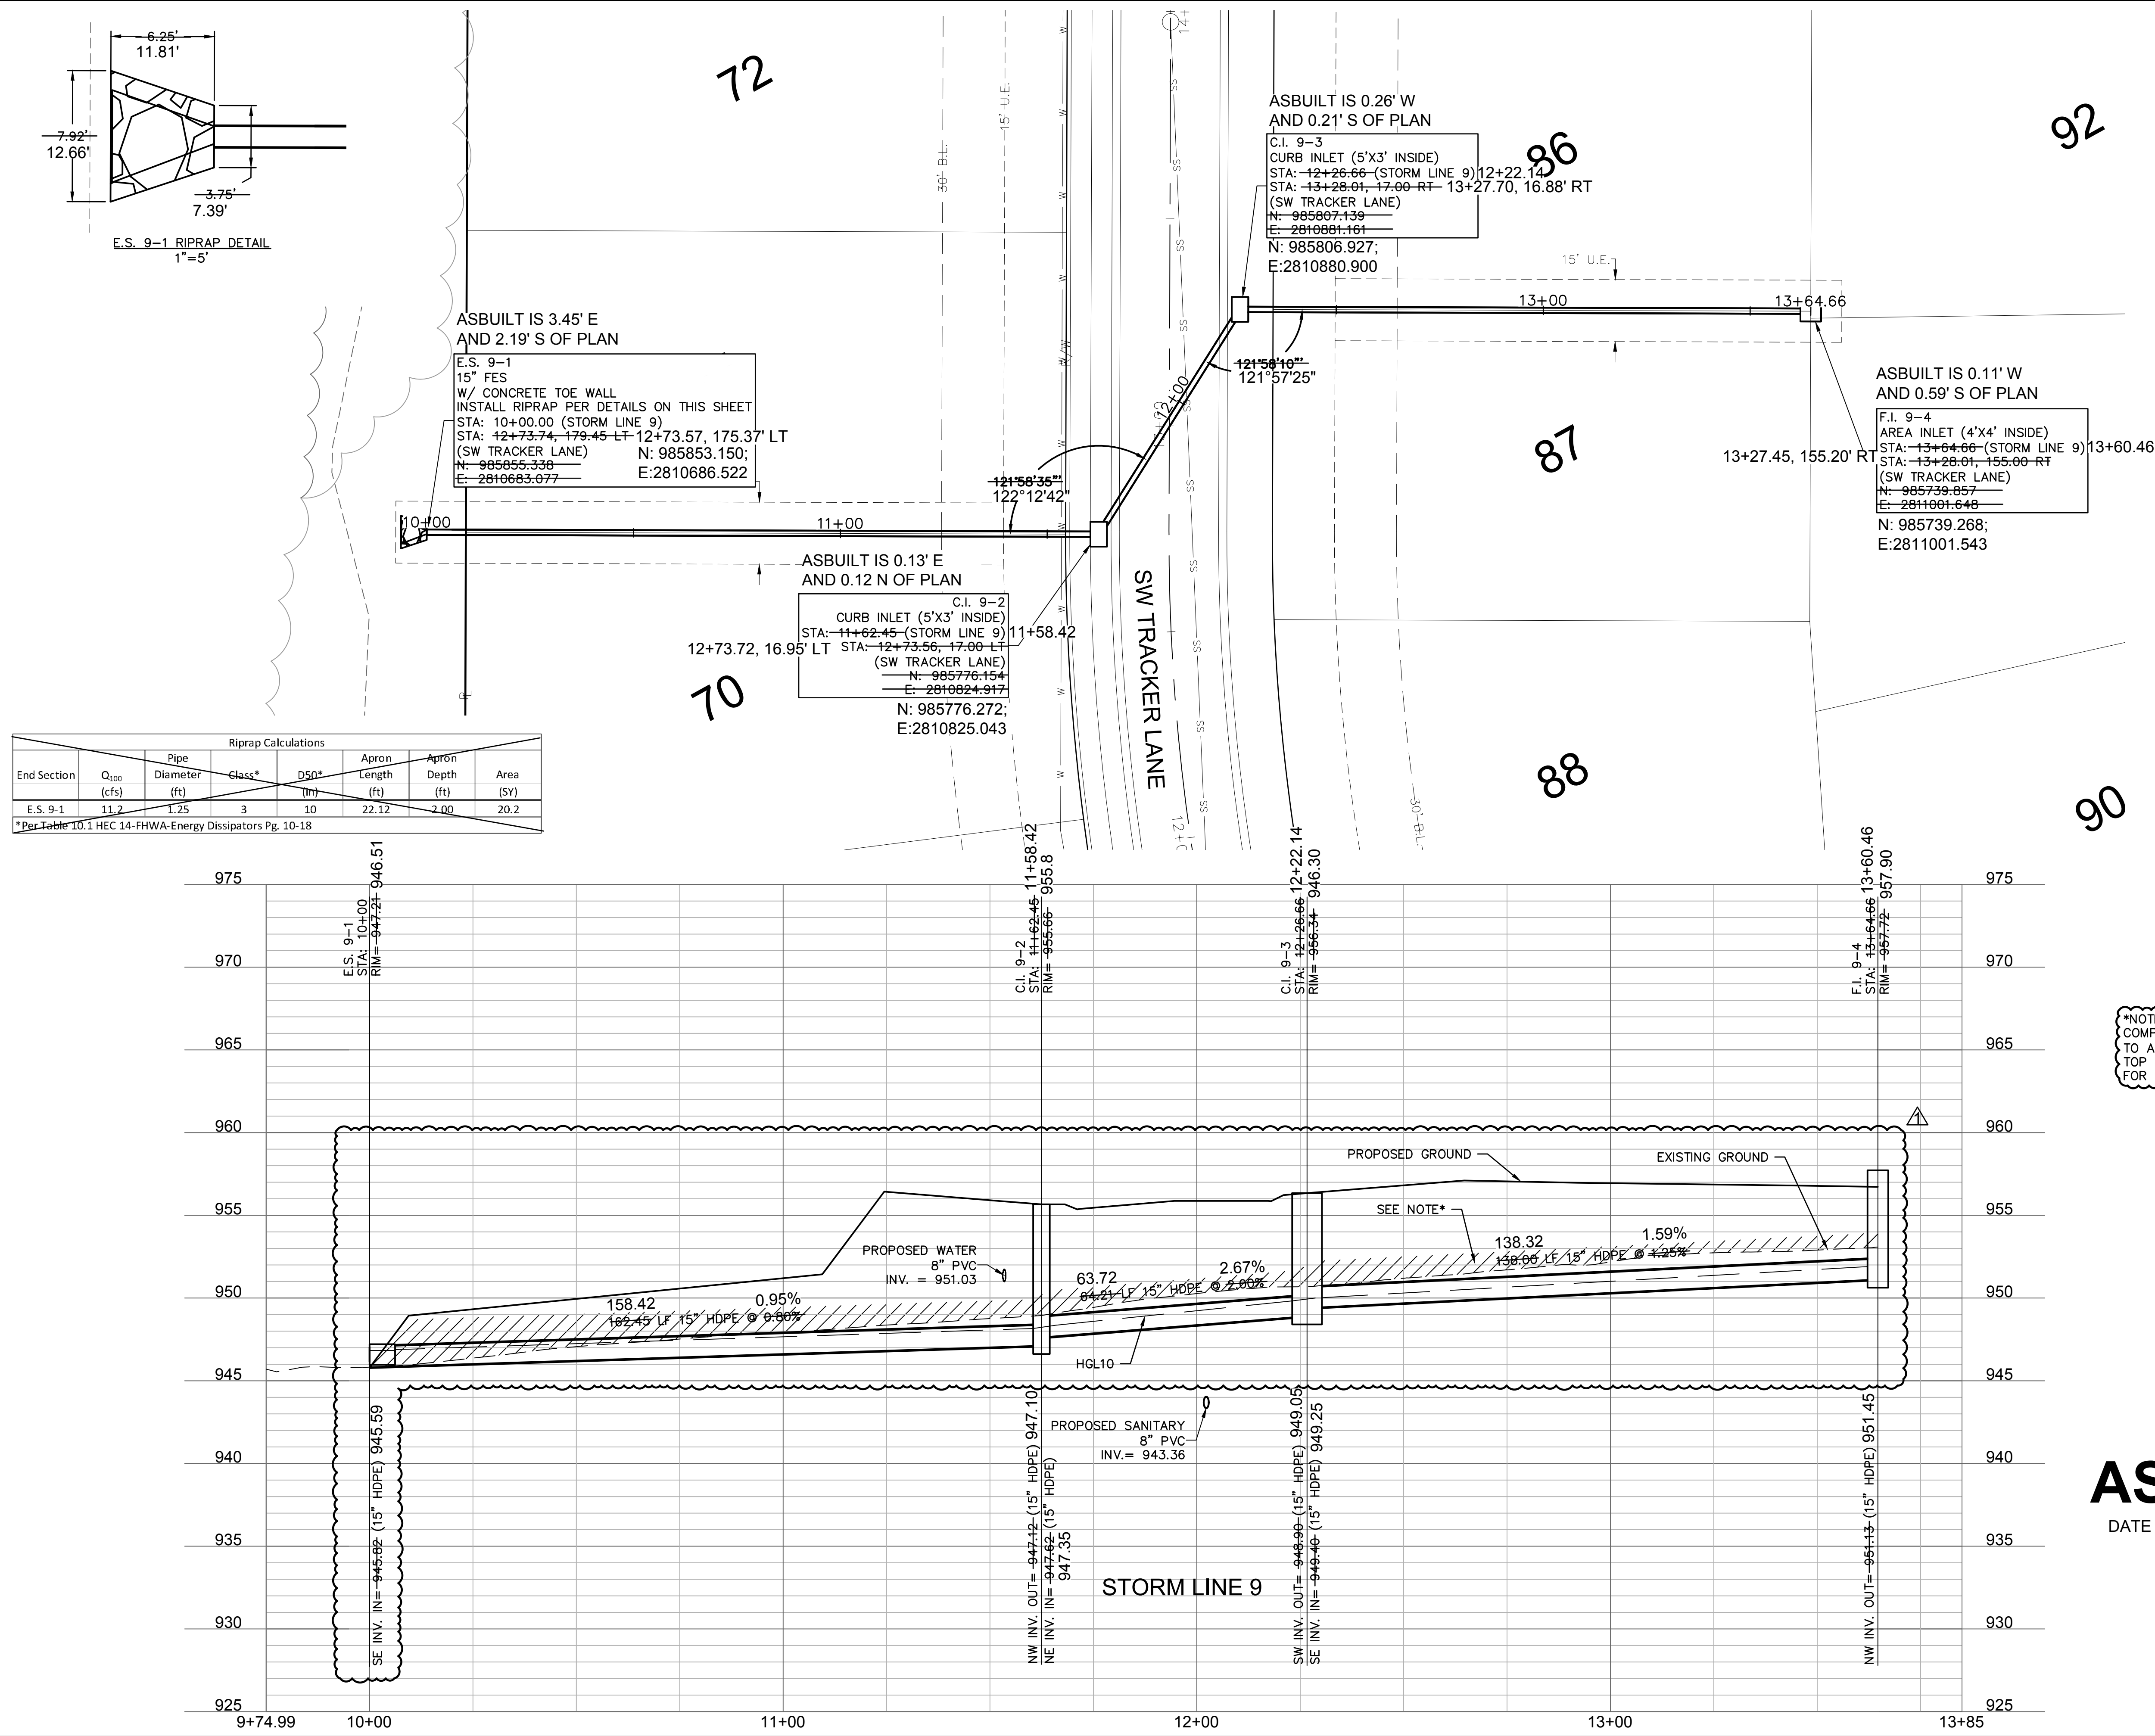

*NOTE: CONTRACTOR SHALL FILL AND COMPACT TO 95% STANDARD DENSITY TO A POINT 18" MINIMUM ABOVE THE TOP OF PIPE PRIOR TO EXCAVATION FOR THE PIPE



AS BUILT

DATE SURVEYED: 2022-05-26

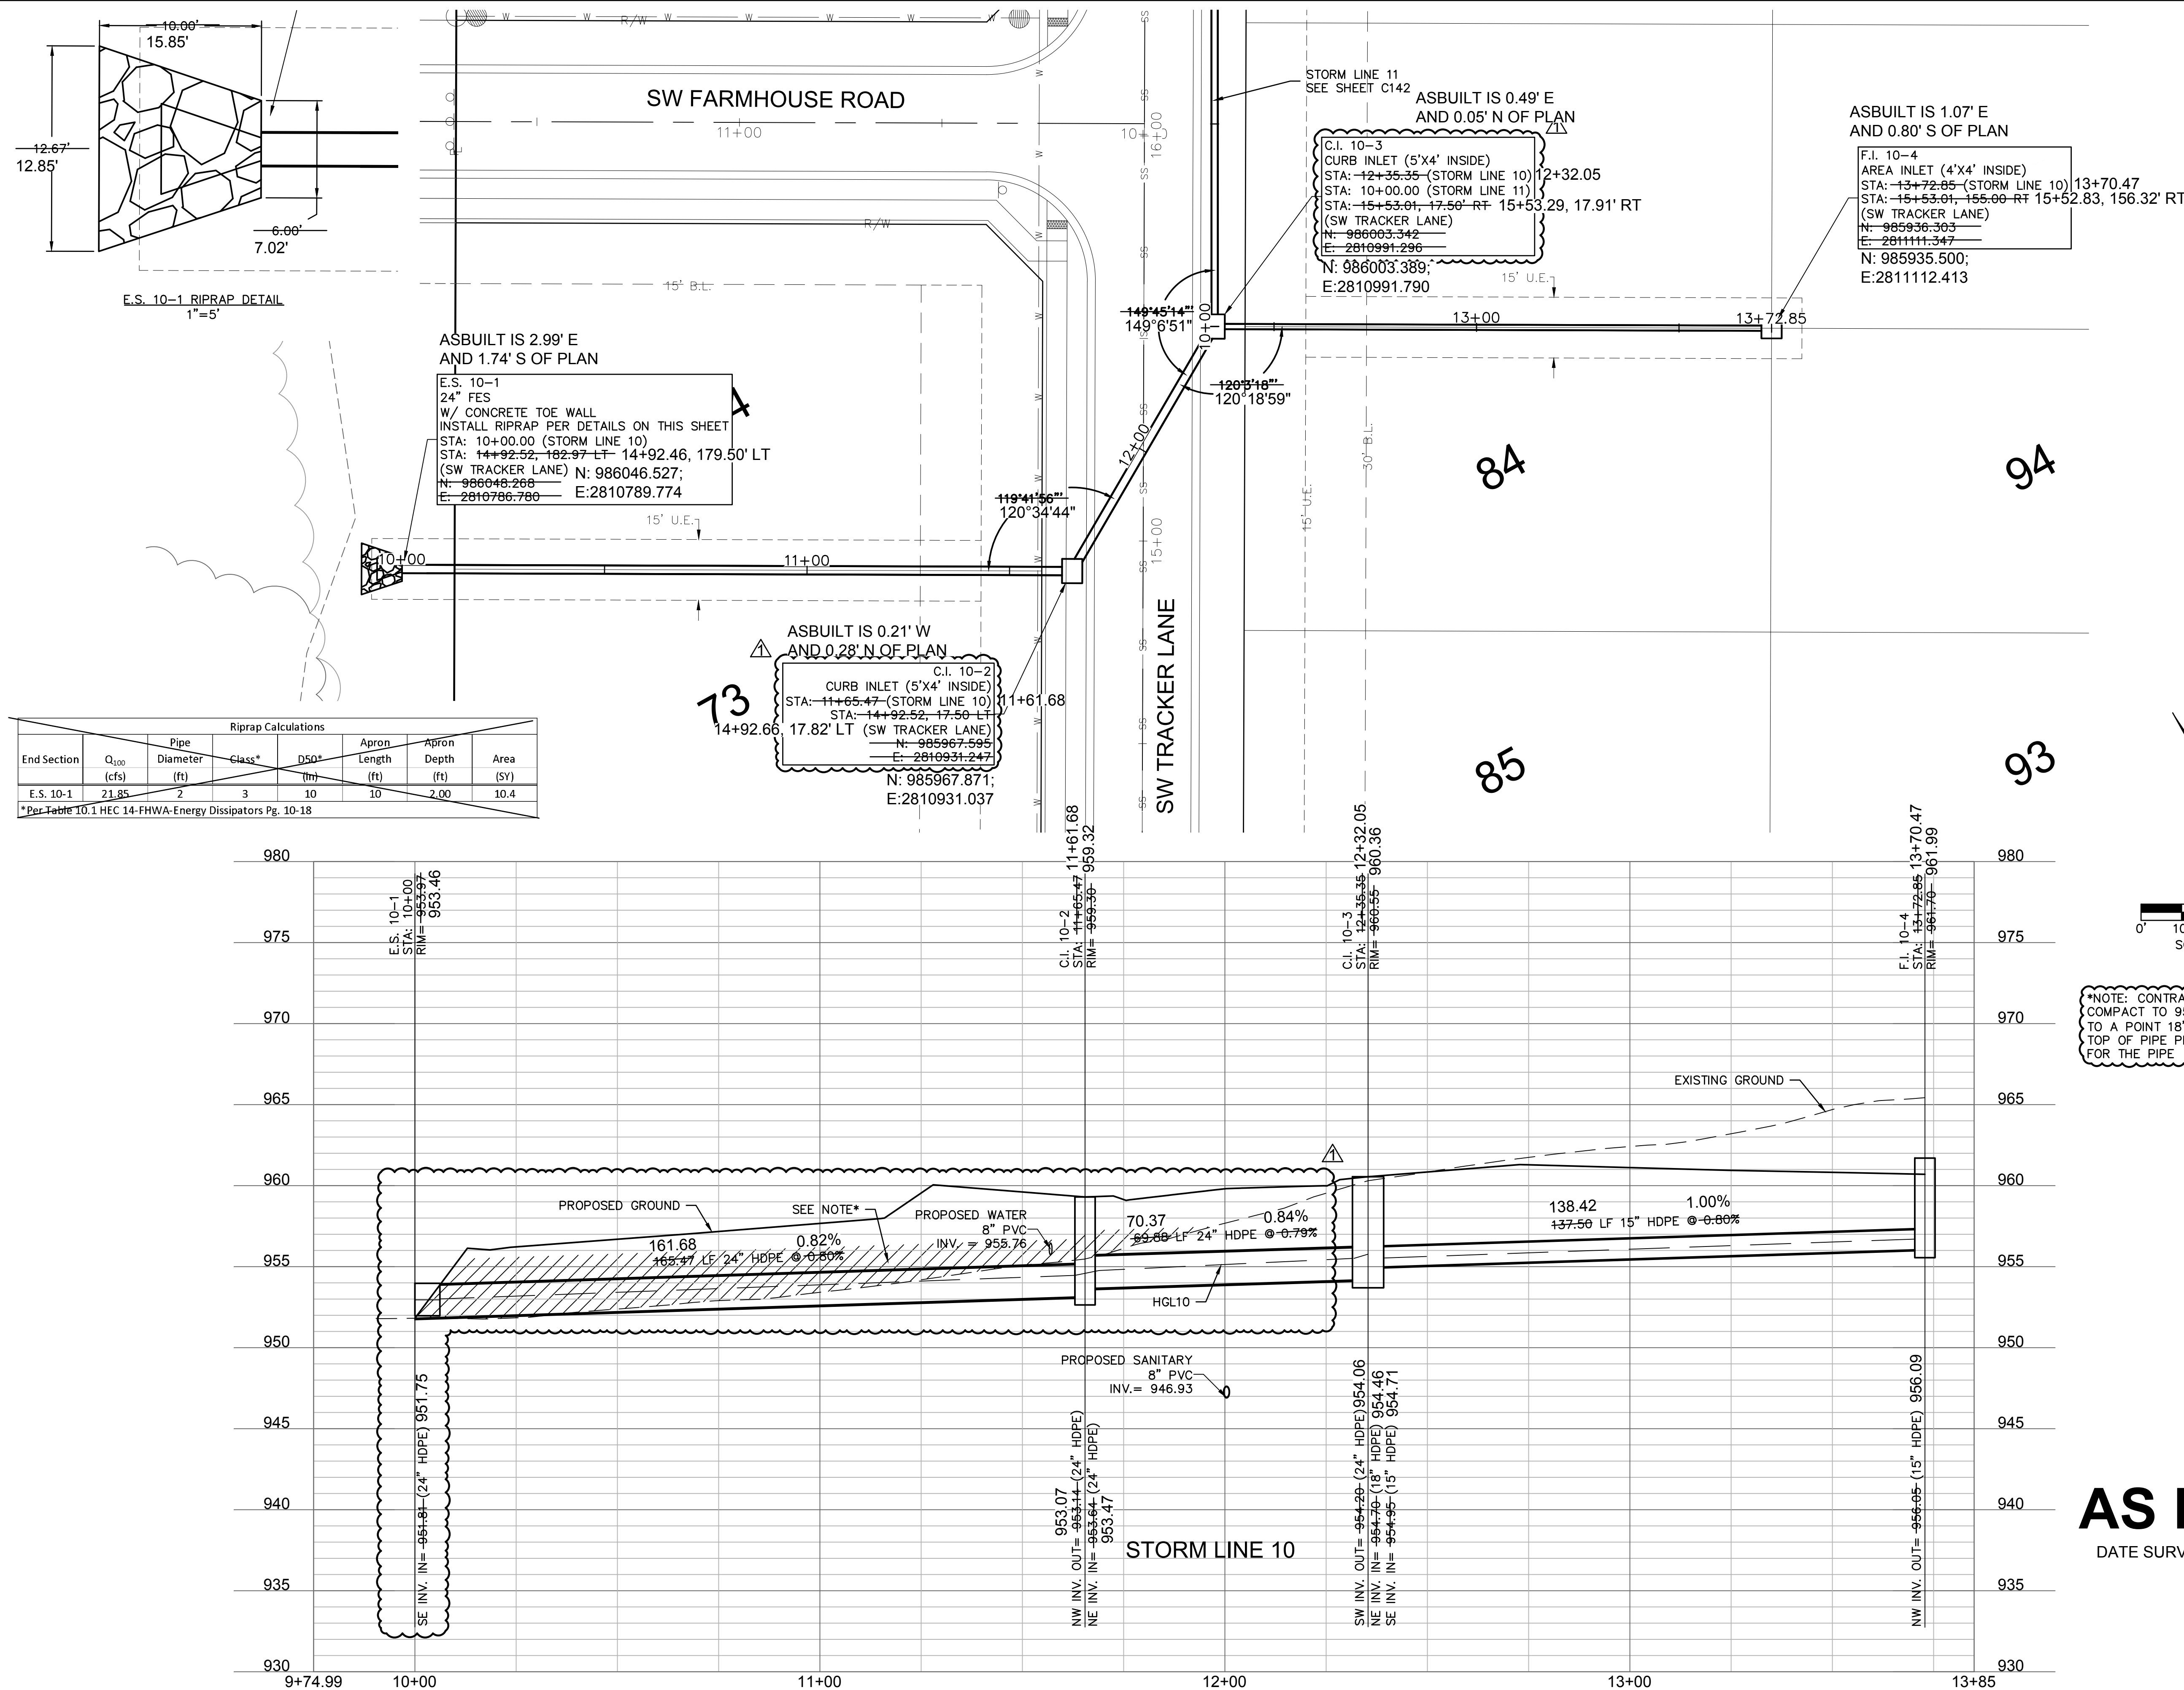

AS BUILT

DATE SURVEYED: 2022-05-26

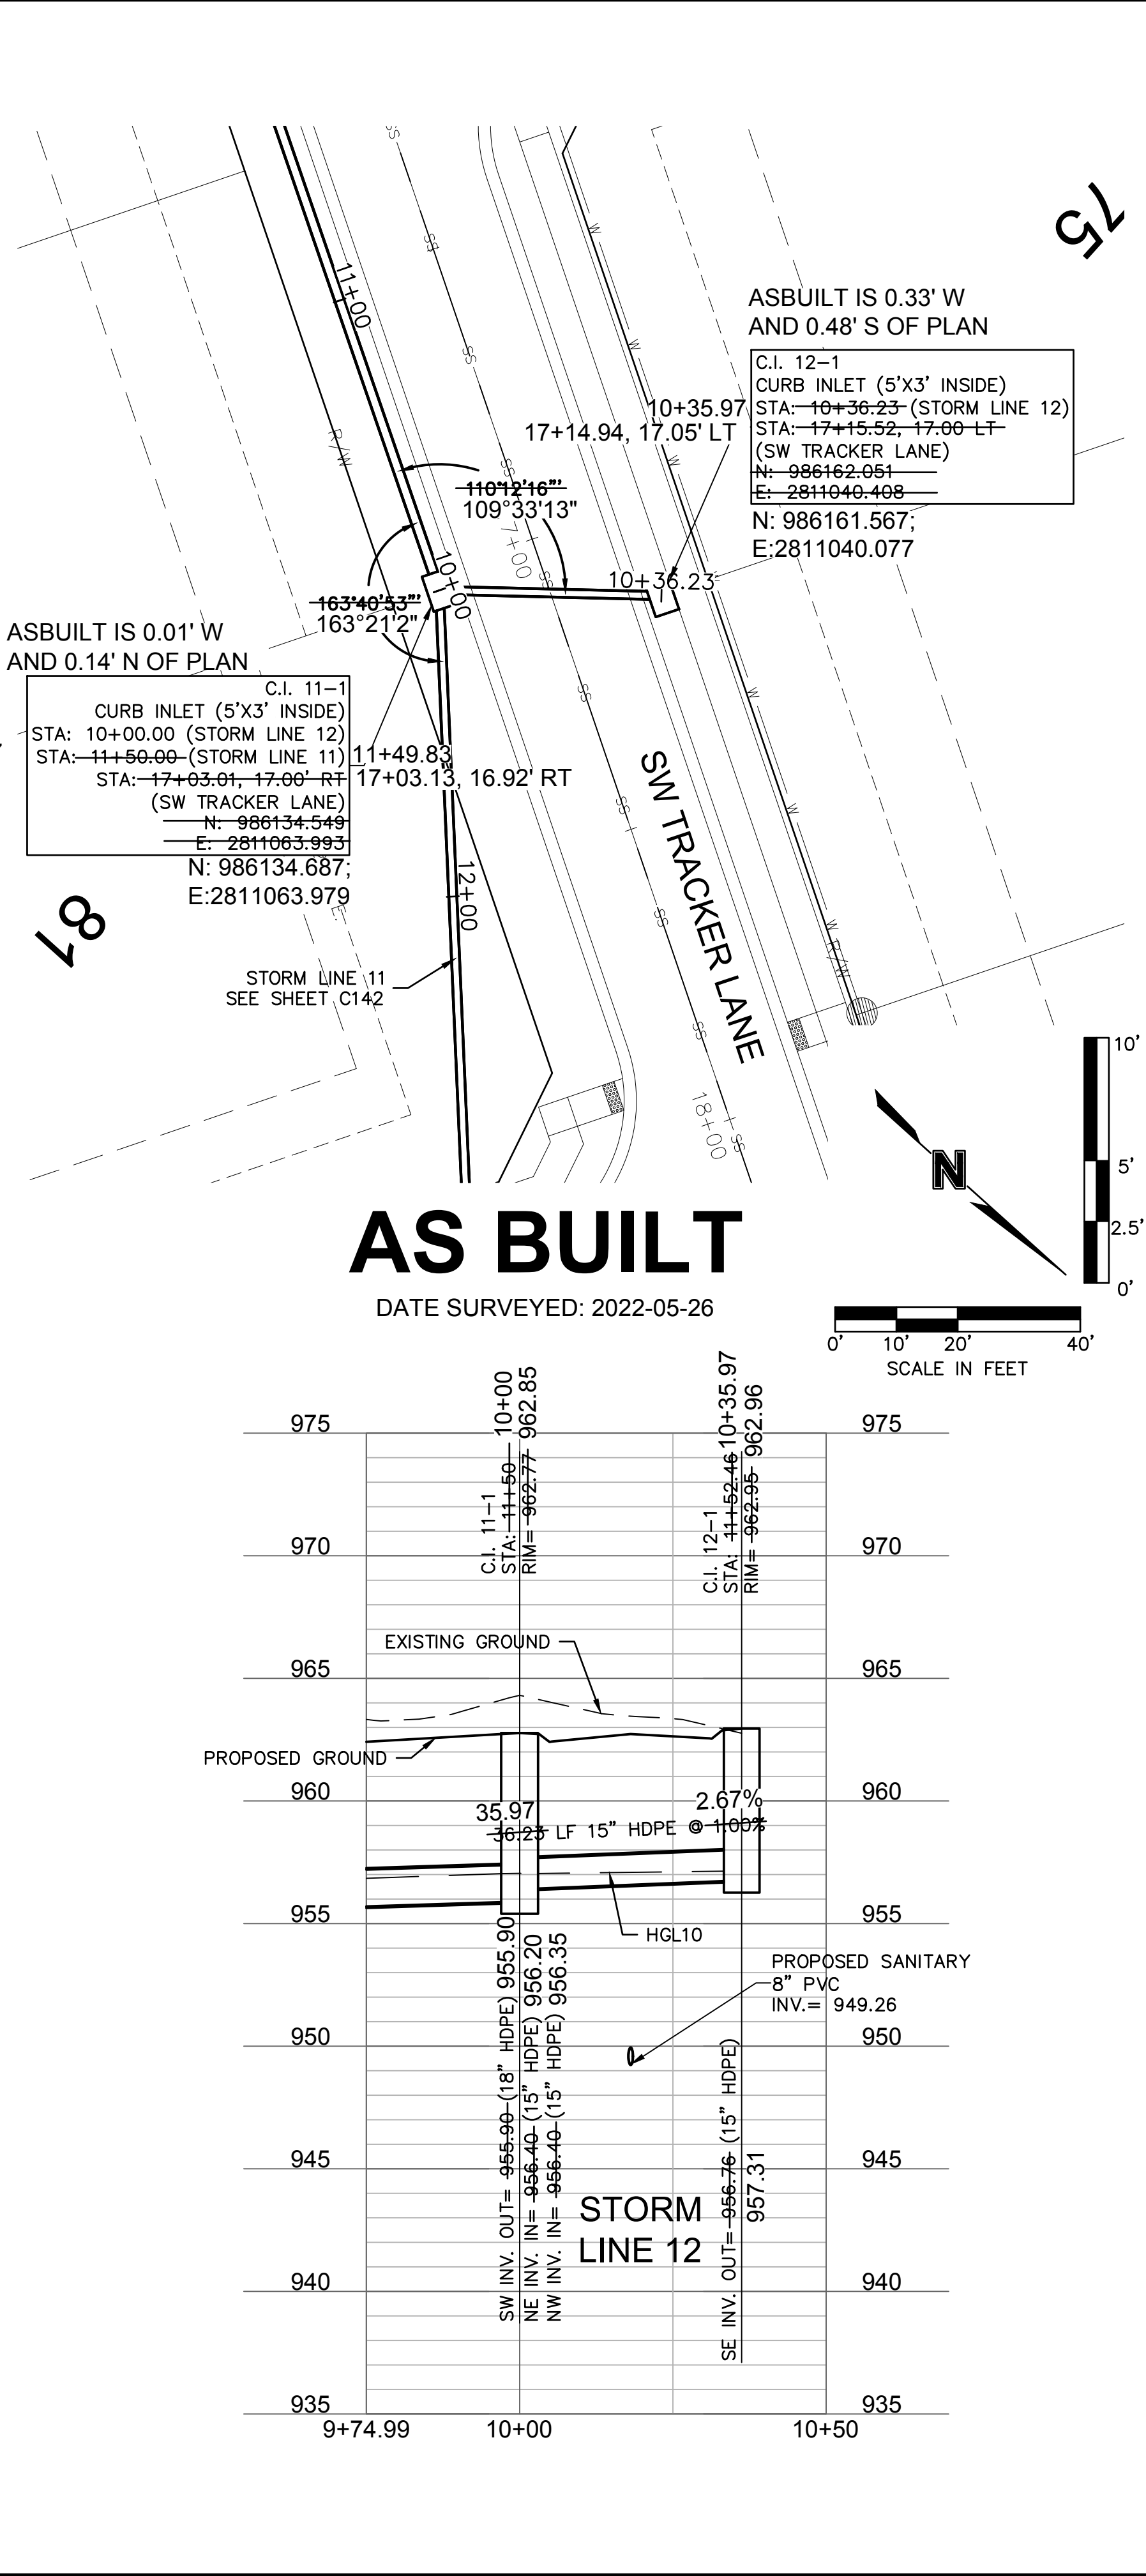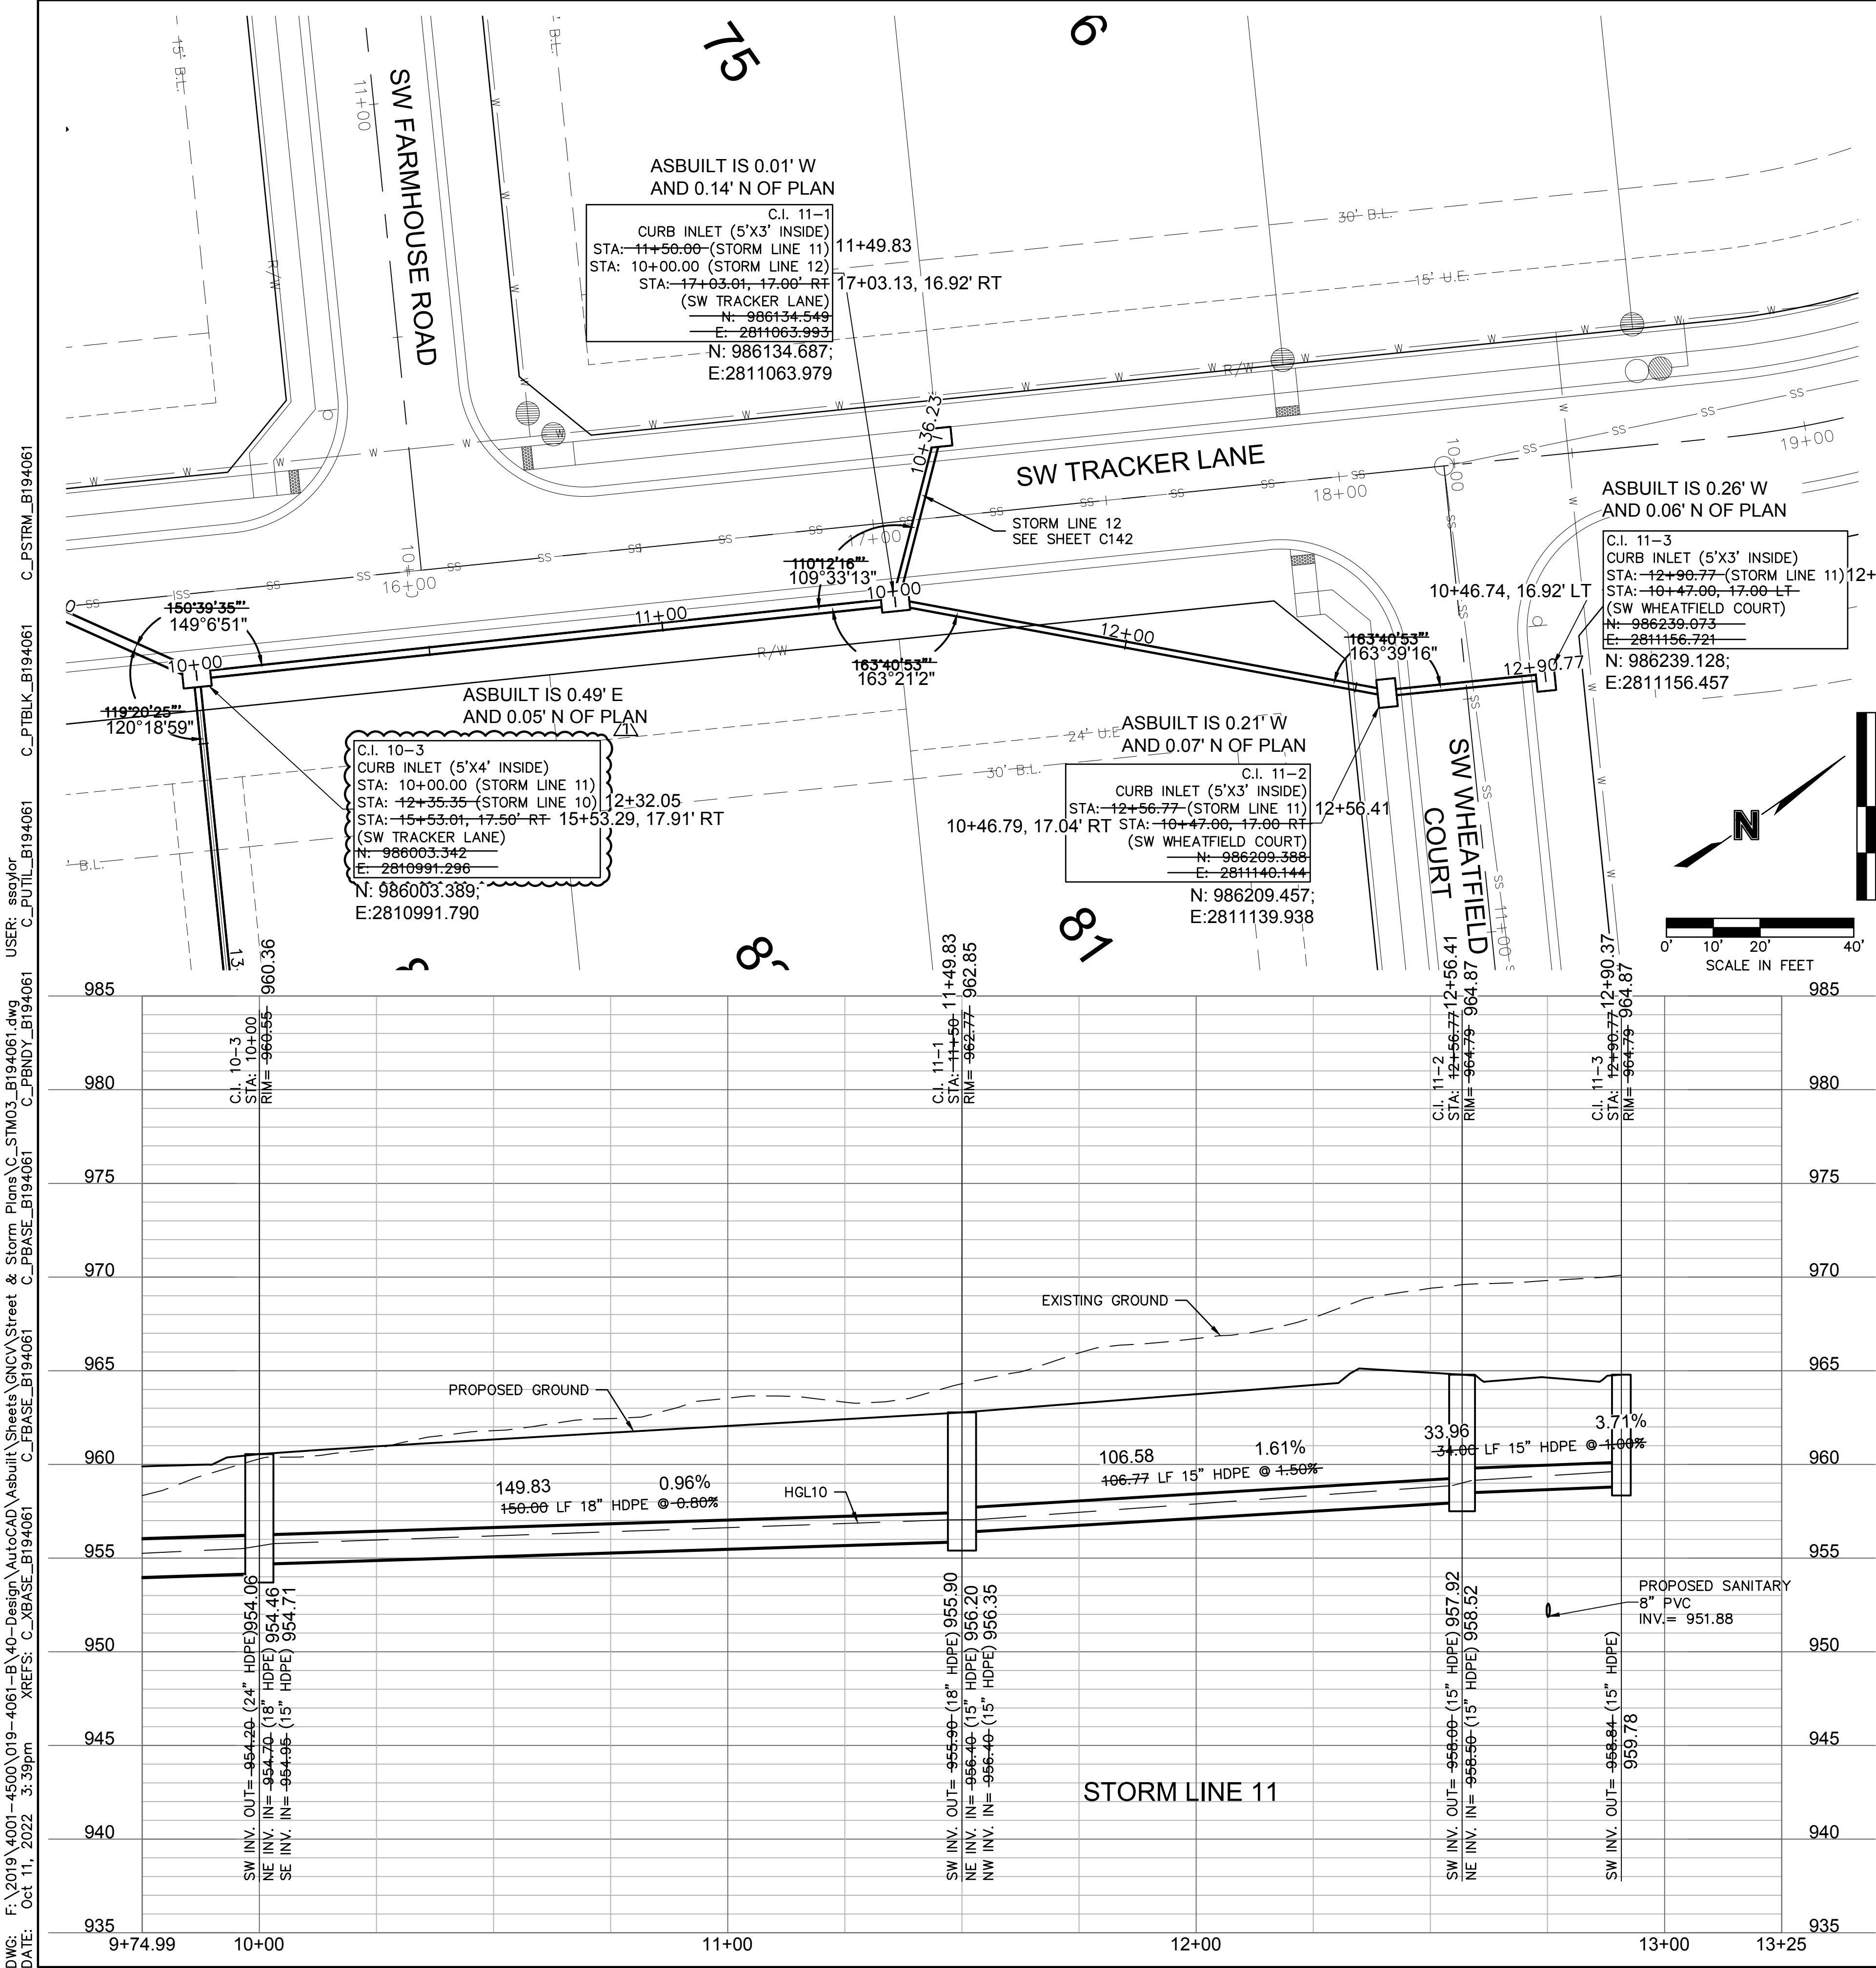

olsson

Olsson - Civil Engineering
Missouri Certificate of Authority #001592
1301 Burlington Street
North Kansas City, MO 64116
TEL 816.361.1177
FAX 816.361.1888
www.olsson.com

JULIE ELAINE SELLERS
Professional Engineer
NUMBER PE-2017000367
11/28/22

STATE OF MISSOURI

STORM SEWER PLAN & PROFILE (LINES 11 & 12)
STREET & STORM SEWER PLANS
HOOK FARMS
SECOND PLAT
LEE'S SUMMIT, MO

2021




drawn by: B.M.W./A.A.
checked by: B.M.W.
designed by: B.M.W./A.A.
QA/QC by: J.E.S.
project no.: B19-4061
date: 01-08-2021

SHEET C142



REV.	NO.	DATE	REVISIONS DESCRIPTION
1		03-23-2021	REVISED PER CITY COMMENTS
2		04-16-2021	REVISED PER CITY COMMENTS
3		09-30-2021	CHANGES TO APPROVED PLANS

REVISIONS

DWG: F:\2019\4001-4500\019-4061-BV40-Design\AutoCAD\Asbuilt\Sheets\GNCV\Street & Storm Plans\C_DBP01_B194061.dwg
DATE: Oct 11, 2022 3:39pm
C:\PTBLK_B194061 C:\PBNDY_B194061 C:\PBASE_B194061 C:\PUTIL_B194061
USER: ssoylor

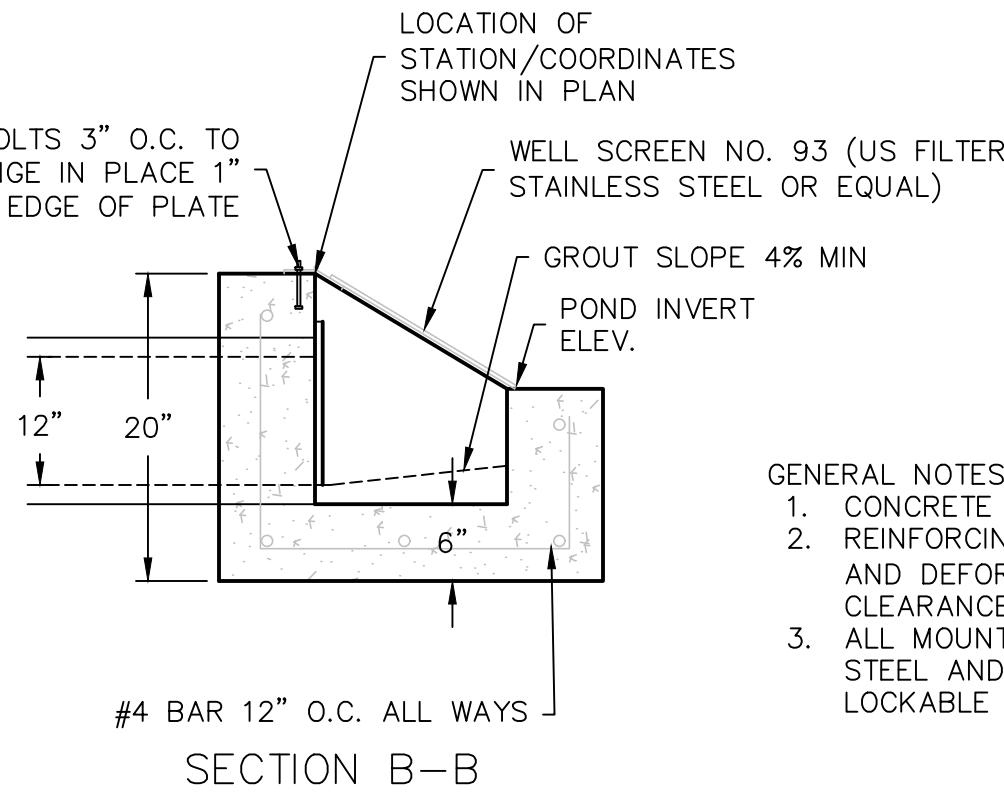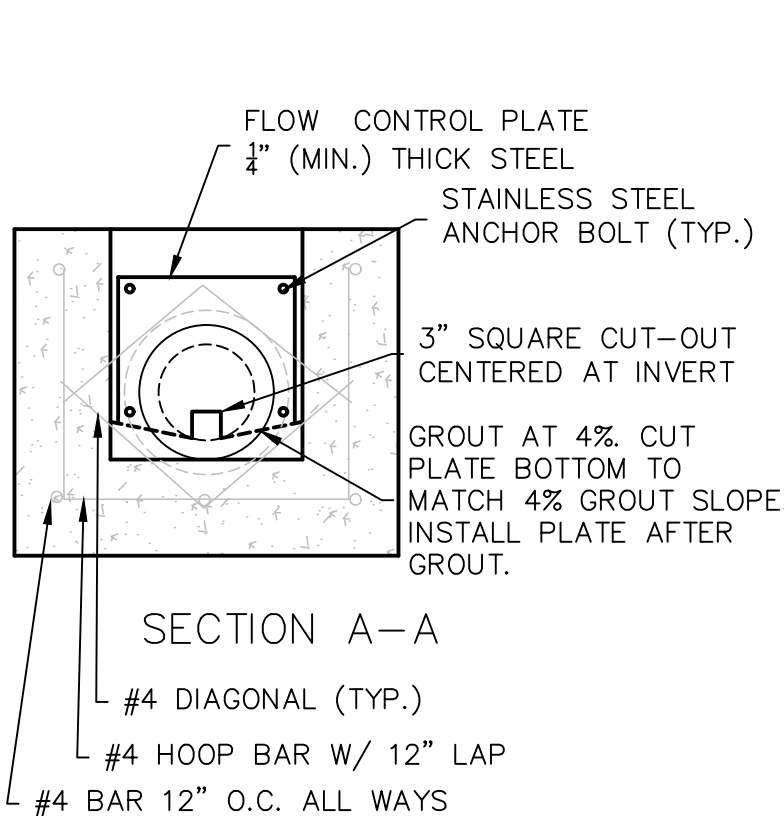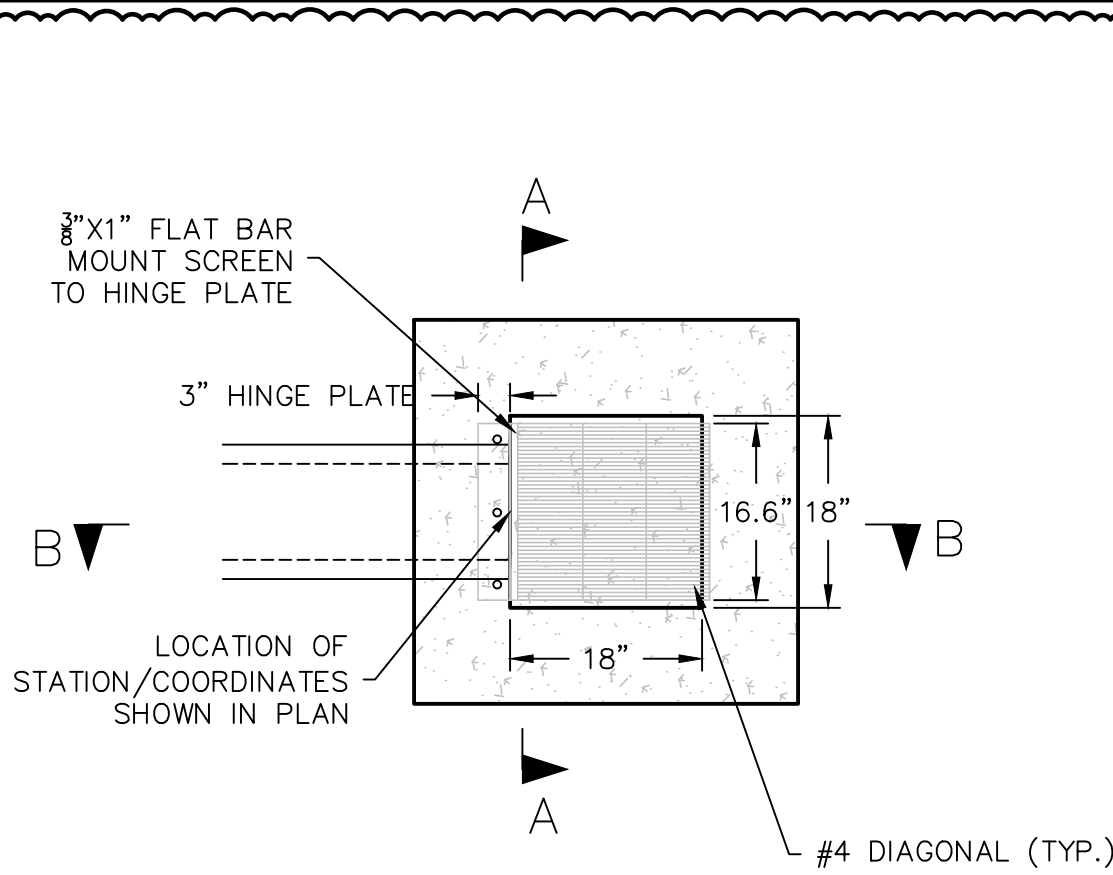

- GENERAL NOTES:
1. CONCRETE SHALL BE CLASS B
 2. REINFORCING BARS SHALL BE EPOXY COATED AND DEFORMED, AND SHALL HAVE MINIMUM 2" CLEARANCE.
 3. ALL MOUNTING HARDWARE TO BE STAINLESS STEEL AND PROVIDED WITH HINGES AND LOCKABLE OR BOLTABLE ACCESS.

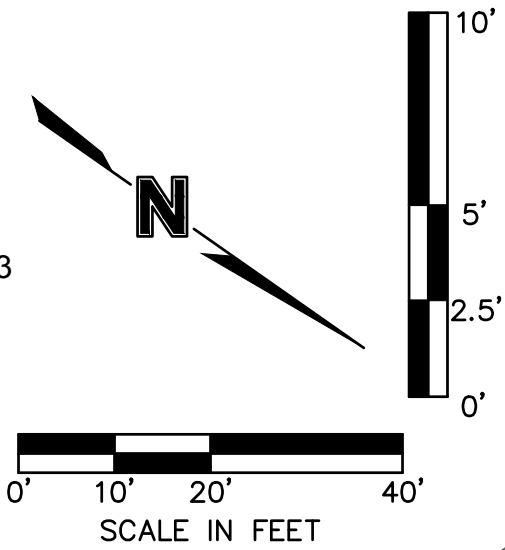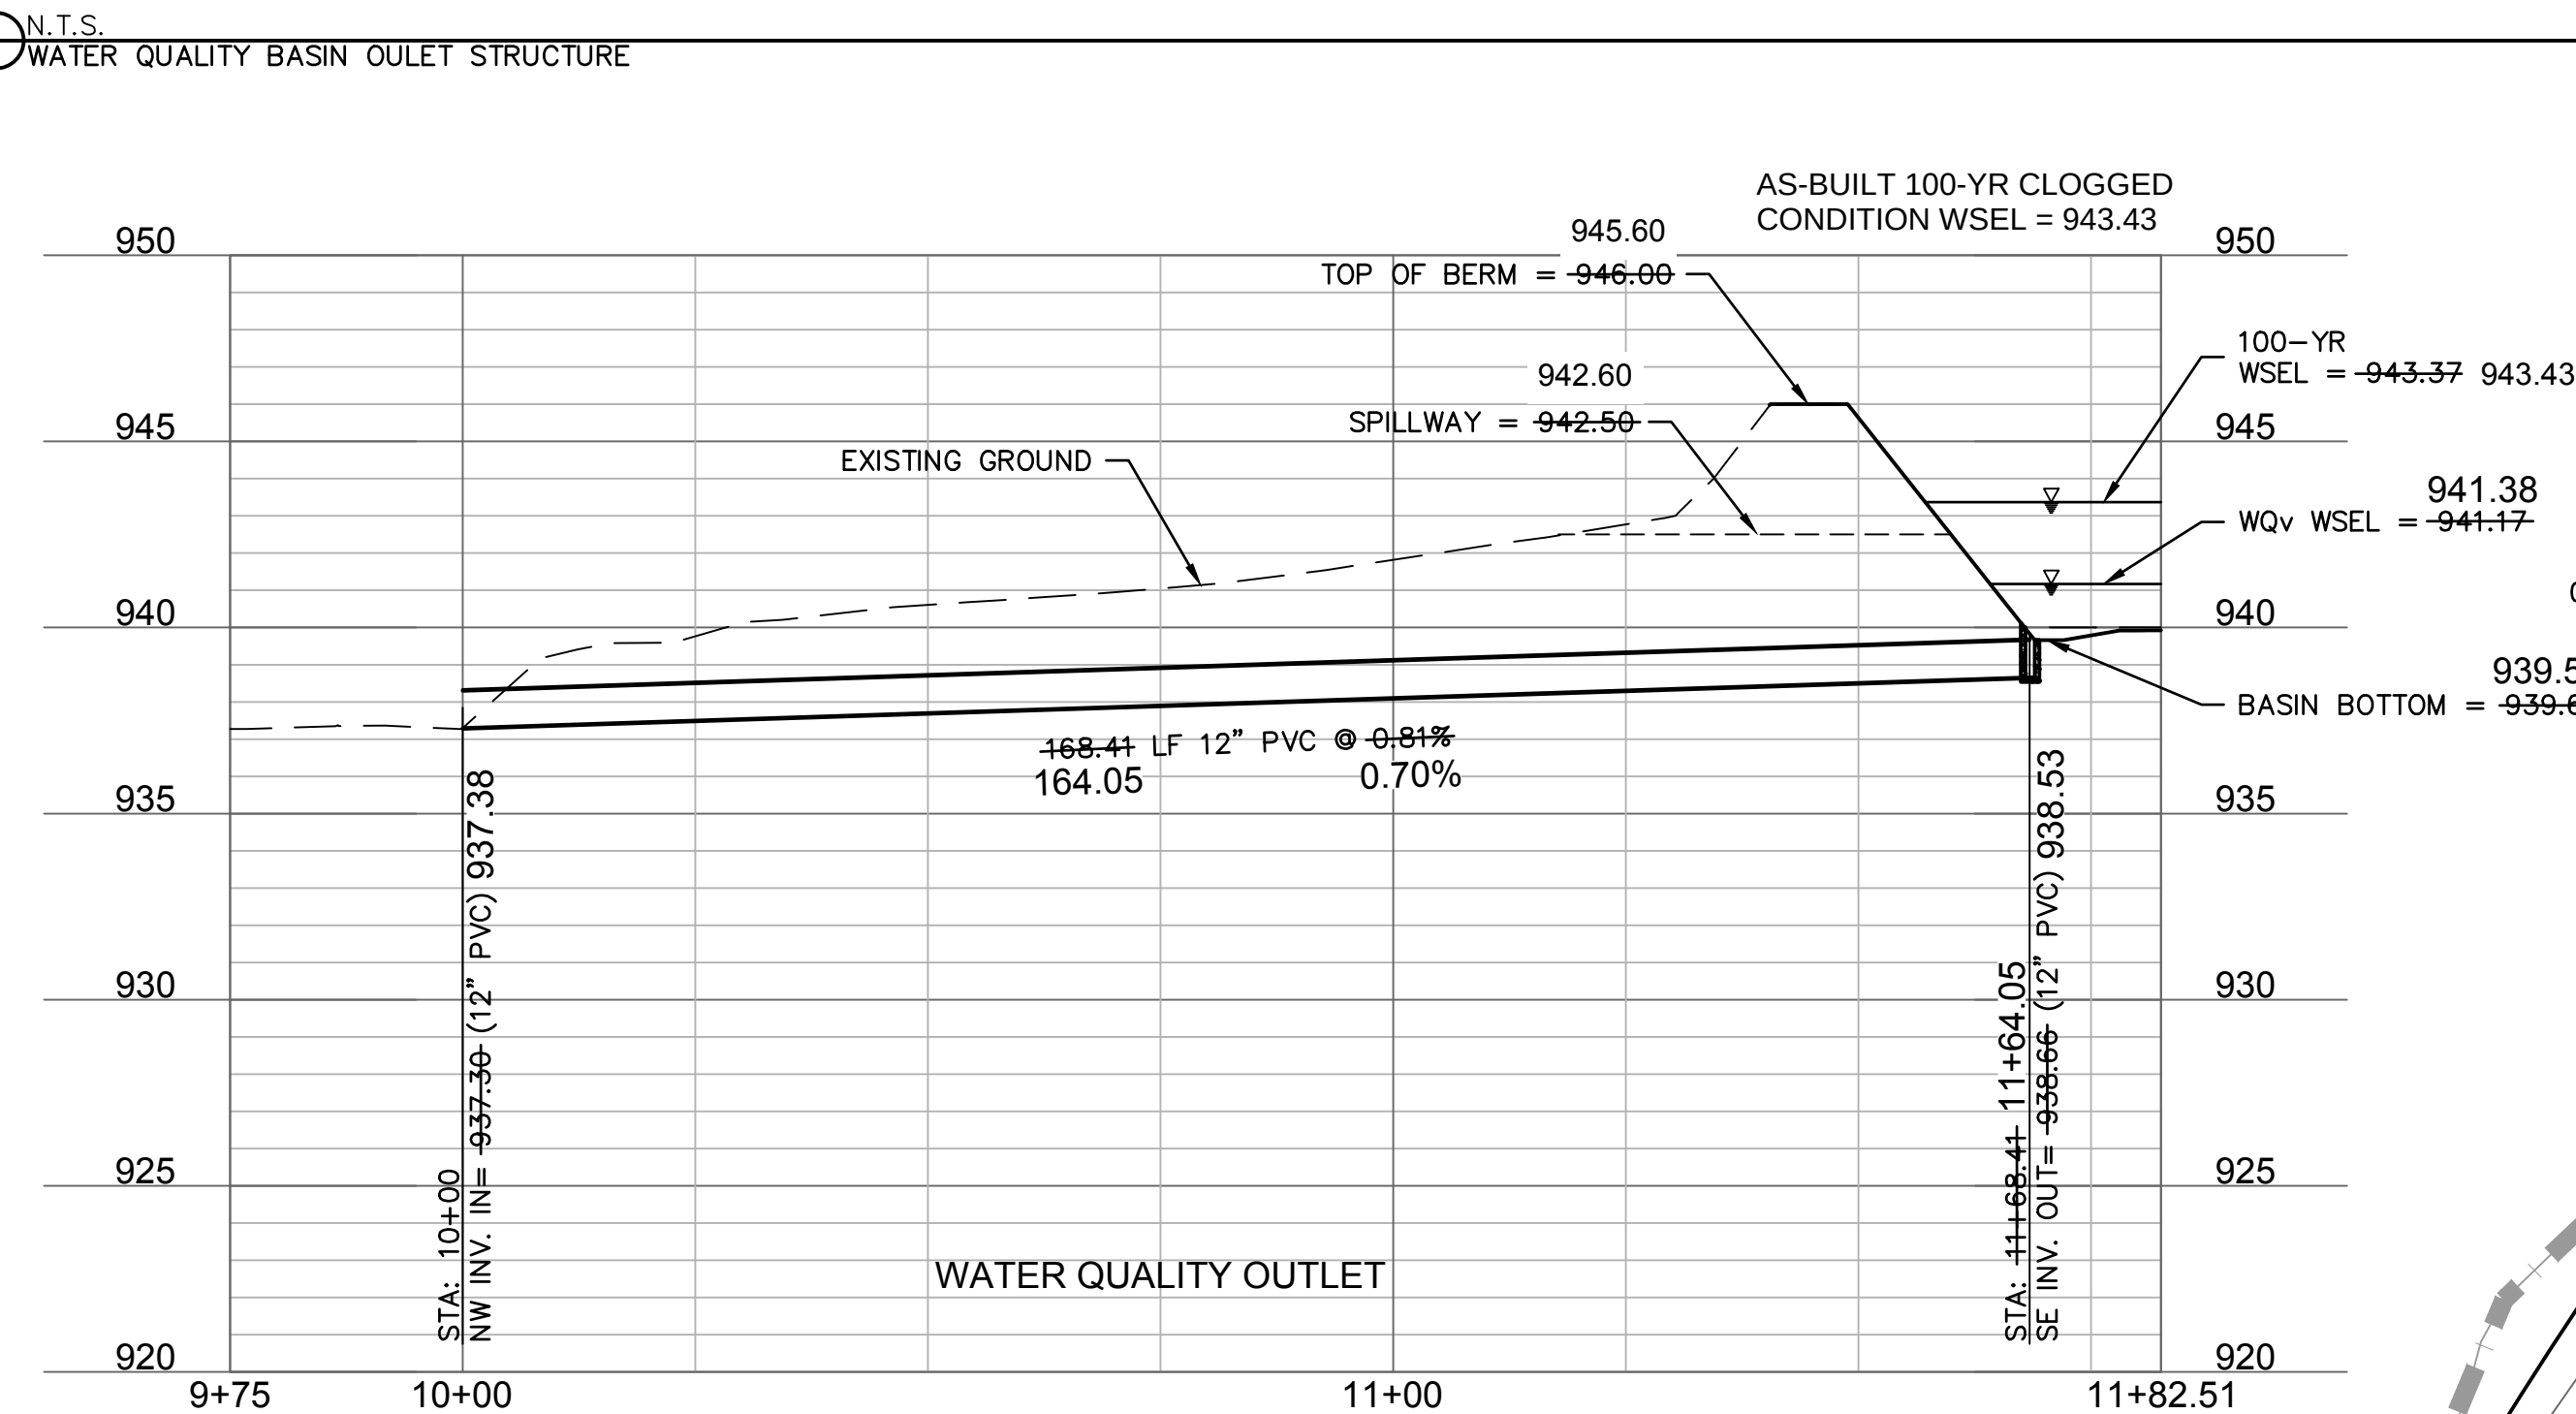


INSTALL 1731 S.F. OF NORTH AMERICAN GREEN SC250 TURF REINFORCEMENT MATTING OVER SPILLWAY

BASIN DETAILS	
SPILLWAY TYPE	BROAD CRESTED WEIR
SPILLWAY LENGTH	75.58 FT
SPILLWAY ELEVATION	944.36 942.50 FT
SPILLWAY DEPTH	0.50 3.50 FT
DAM ELEVATION	944.86 946.00 FT
WATER QUALITY STORM WATER SURFACE ELEVATION	941.38 941.17 FT
100-YR DESIGN WATER SURFACE ELEVATION	943.49 943.37 FT
DESIGN STORAGE	80,201 109,935 CF

Riprap Calculations						
End Section	Q ₁₀₀ (cfs)	Pipe Diameter (ft)	Class*	D50* (in)	Apron Length (ft)	Apron Depth (ft)
WQv Outlet	4.154	1	1	5	4	1.46

*Per Table 10.1 HEC 14-FHWA-Energy Dissipators Pg. 10-18

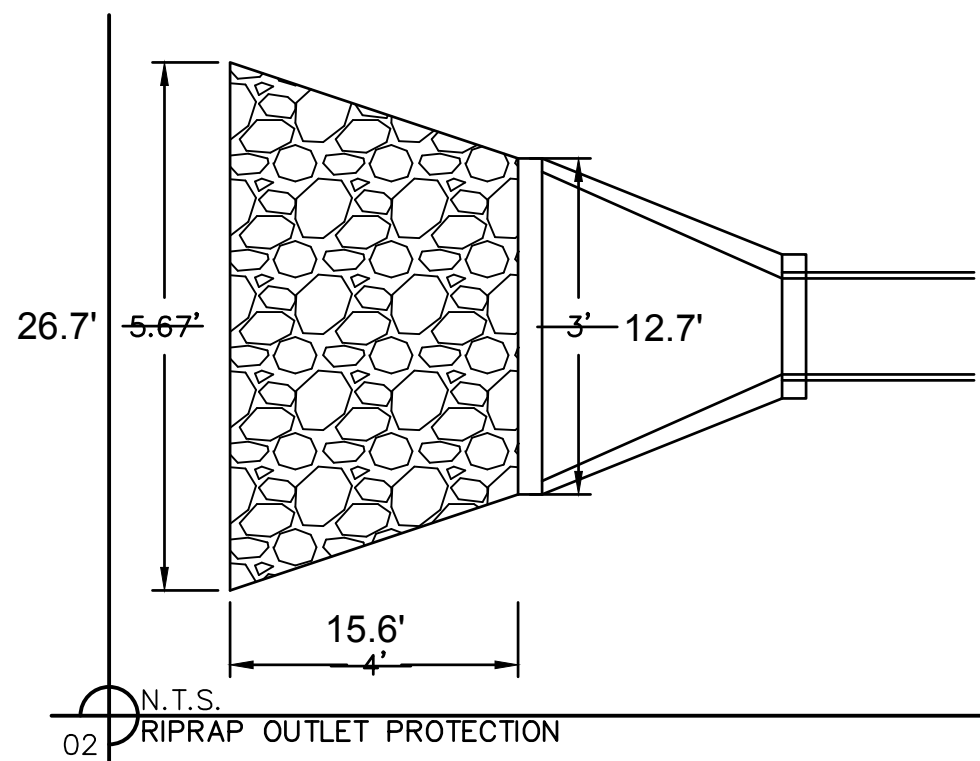

AS BUILT
DATE SURVEYED: 2022-05-26

STA.: 10+00.00
INSTALL 12" HDPE END SECTION
W/ CONCRETE TOE WALL.
INSTALL RIPRAP PER
DETAILS ON THIS SHEET.
N: 985095.415
E: 2811129.828
N: 985097.57
E: 2811128.71

STA.: 11+64.05
WATER QUALITY BASIN
OUTLET STRUCTURE,
SEE DETAIL ON THIS SHEET
N: 985236.846
E: 2811041.573
N: 985097.57
E: 2811128.71

olsson

Olsson - Civil Engineering
Missouri Certificate of Authority #001592
1301 Burlington Street
North Kansas City, MO 64116
TEL 816.361.1177
FAX 816.361.1888
www.olsson.com

STATE OF MISSOURI
JULIE ELAINE SELLERS
NUMBER PE-2017000367
11/28/22
PROFESSIONAL ENGINEER

WATER QUALITY BASIN PLAN
STREET & STORM SEWER PLANS
HOOK FARMS
SECOND PLAT
LEE'S SUMMIT, MO
2021

drawn by: B.M.W./A.A.
checked by: B.M.W./A.A.
designed by: B.M.W./A.A.
QA/QC by: J.E.S.
project no.: B19-4061
date: 01-08-2021

REVISIONS

REV. NO.	DATE	REVISIONS DESCRIPTION	BY
1	03-23-2021	REVISED PER CITY COMMENTS	
2	04-16-2021	REVISED PER CITY COMMENTS	
3	09-30-2021	CHANGES TO APPROVED PLANS	

SHEET C143

DWG: F:\2019\4001-4500\019-4061-BV40-Design\AutoCAD\Asbuilt\Sheets\GNCV\Street & Storm Plans\B194061.dwg
DATE: Oct 11, 2022 3:13pm
XREFS: C_XBASE_B194061 C_PBASE_B194061 C_PBDY_B194061 C_PUTIL_B194061 C_PTBLK_B194061
USER: cwoodward

Hook Farms Second Plat			
Minimum Building Opening Elevation			
Lot	Rear Left MBOE	Rear Right MBOE	As Built Plot Plan Required
50	954.92	953.57	Y
51	953.57	952.88	Y
52	952.88	950.65	Y
53	950.65	950.27	Y
54	950.27	949.30	Y
55	949.30	948.19	Y
56	948.19	947.82	Y
57	947.82	979.35	Y
58	947.34	947.97	Y
59	947.97	947.72	Y
60	947.72	947.99	Y
61	947.99	946.90	Y
62	946.90	944.72	Y
63	944.72	942.92	Y
64	942.92	942.70	Y
65	973.63	940.82	Y
66	941.13	943.41	Y
67	943.41	947.90	Y
68	947.90	954.22	Y
69	943.41	948.62	Y
70	948.62	949.34	Y
71	949.34	950.54	Y
72	950.54	953.88	Y
73	953.88	956.67	Y
74	977.02	959.59	Y

MBOE elevations have been provided per lot lines, facing the lot from the street. Interpolation will be allowed between the right and left side MBOE's provided, depending on the location of the lowest opening on the proposed structure.

Hook Farms Second Plat			
Minimum Building Opening Elevation			
Lot	Rear Left MBOE	Rear Right MBOE	As Built Plot Plan Required
75	958.90	977.02	Y
76	956.91	957.60	Y
77	957.60	958.44	Y
78	958.44	960.42	Y
79	981.53	975.44	Y
98	975.44	974.55	Y
99	974.55	973.89	Y
100	973.89	971.83	Y
101	971.83	974.23	Y
102	974.23	976.18	Y
103	976.18	977.87	Y
104	977.87	979.78	Y
105	979.78	981.97	Y
106	981.97	981.86	Y
113	966.25	964.26	Y
114	964.26	962.62	Y
115	962.62	961.34	Y
116	961.34	959.40	Y
117	959.40	957.84	Y
118	957.84	956.70	Y
119	957.17	958.17	Y
120	958.17	960.37	Y
121	960.37	961.93	Y
122	961.93	963.96	Y
123	963.96	966.25	Y
124	969.47	965.97	Y
125	965.97	964.26	Y
126	964.26	961.86	Y
127	961.86	959.66	Y
128	959.66	961.40	Y

NOTES:



MBOE - MINIMUM BUILDING OPENING ELEVATION
FG - FINISHED GRADE

LEGEND

100 AS-BUILT SURFACE CONTOURS
100 PROPOSED SURFACE CONTOURS

BASEMENT TYPES

(S) STANDARD
(W) WALKOUT
(D) DAYLIGHT

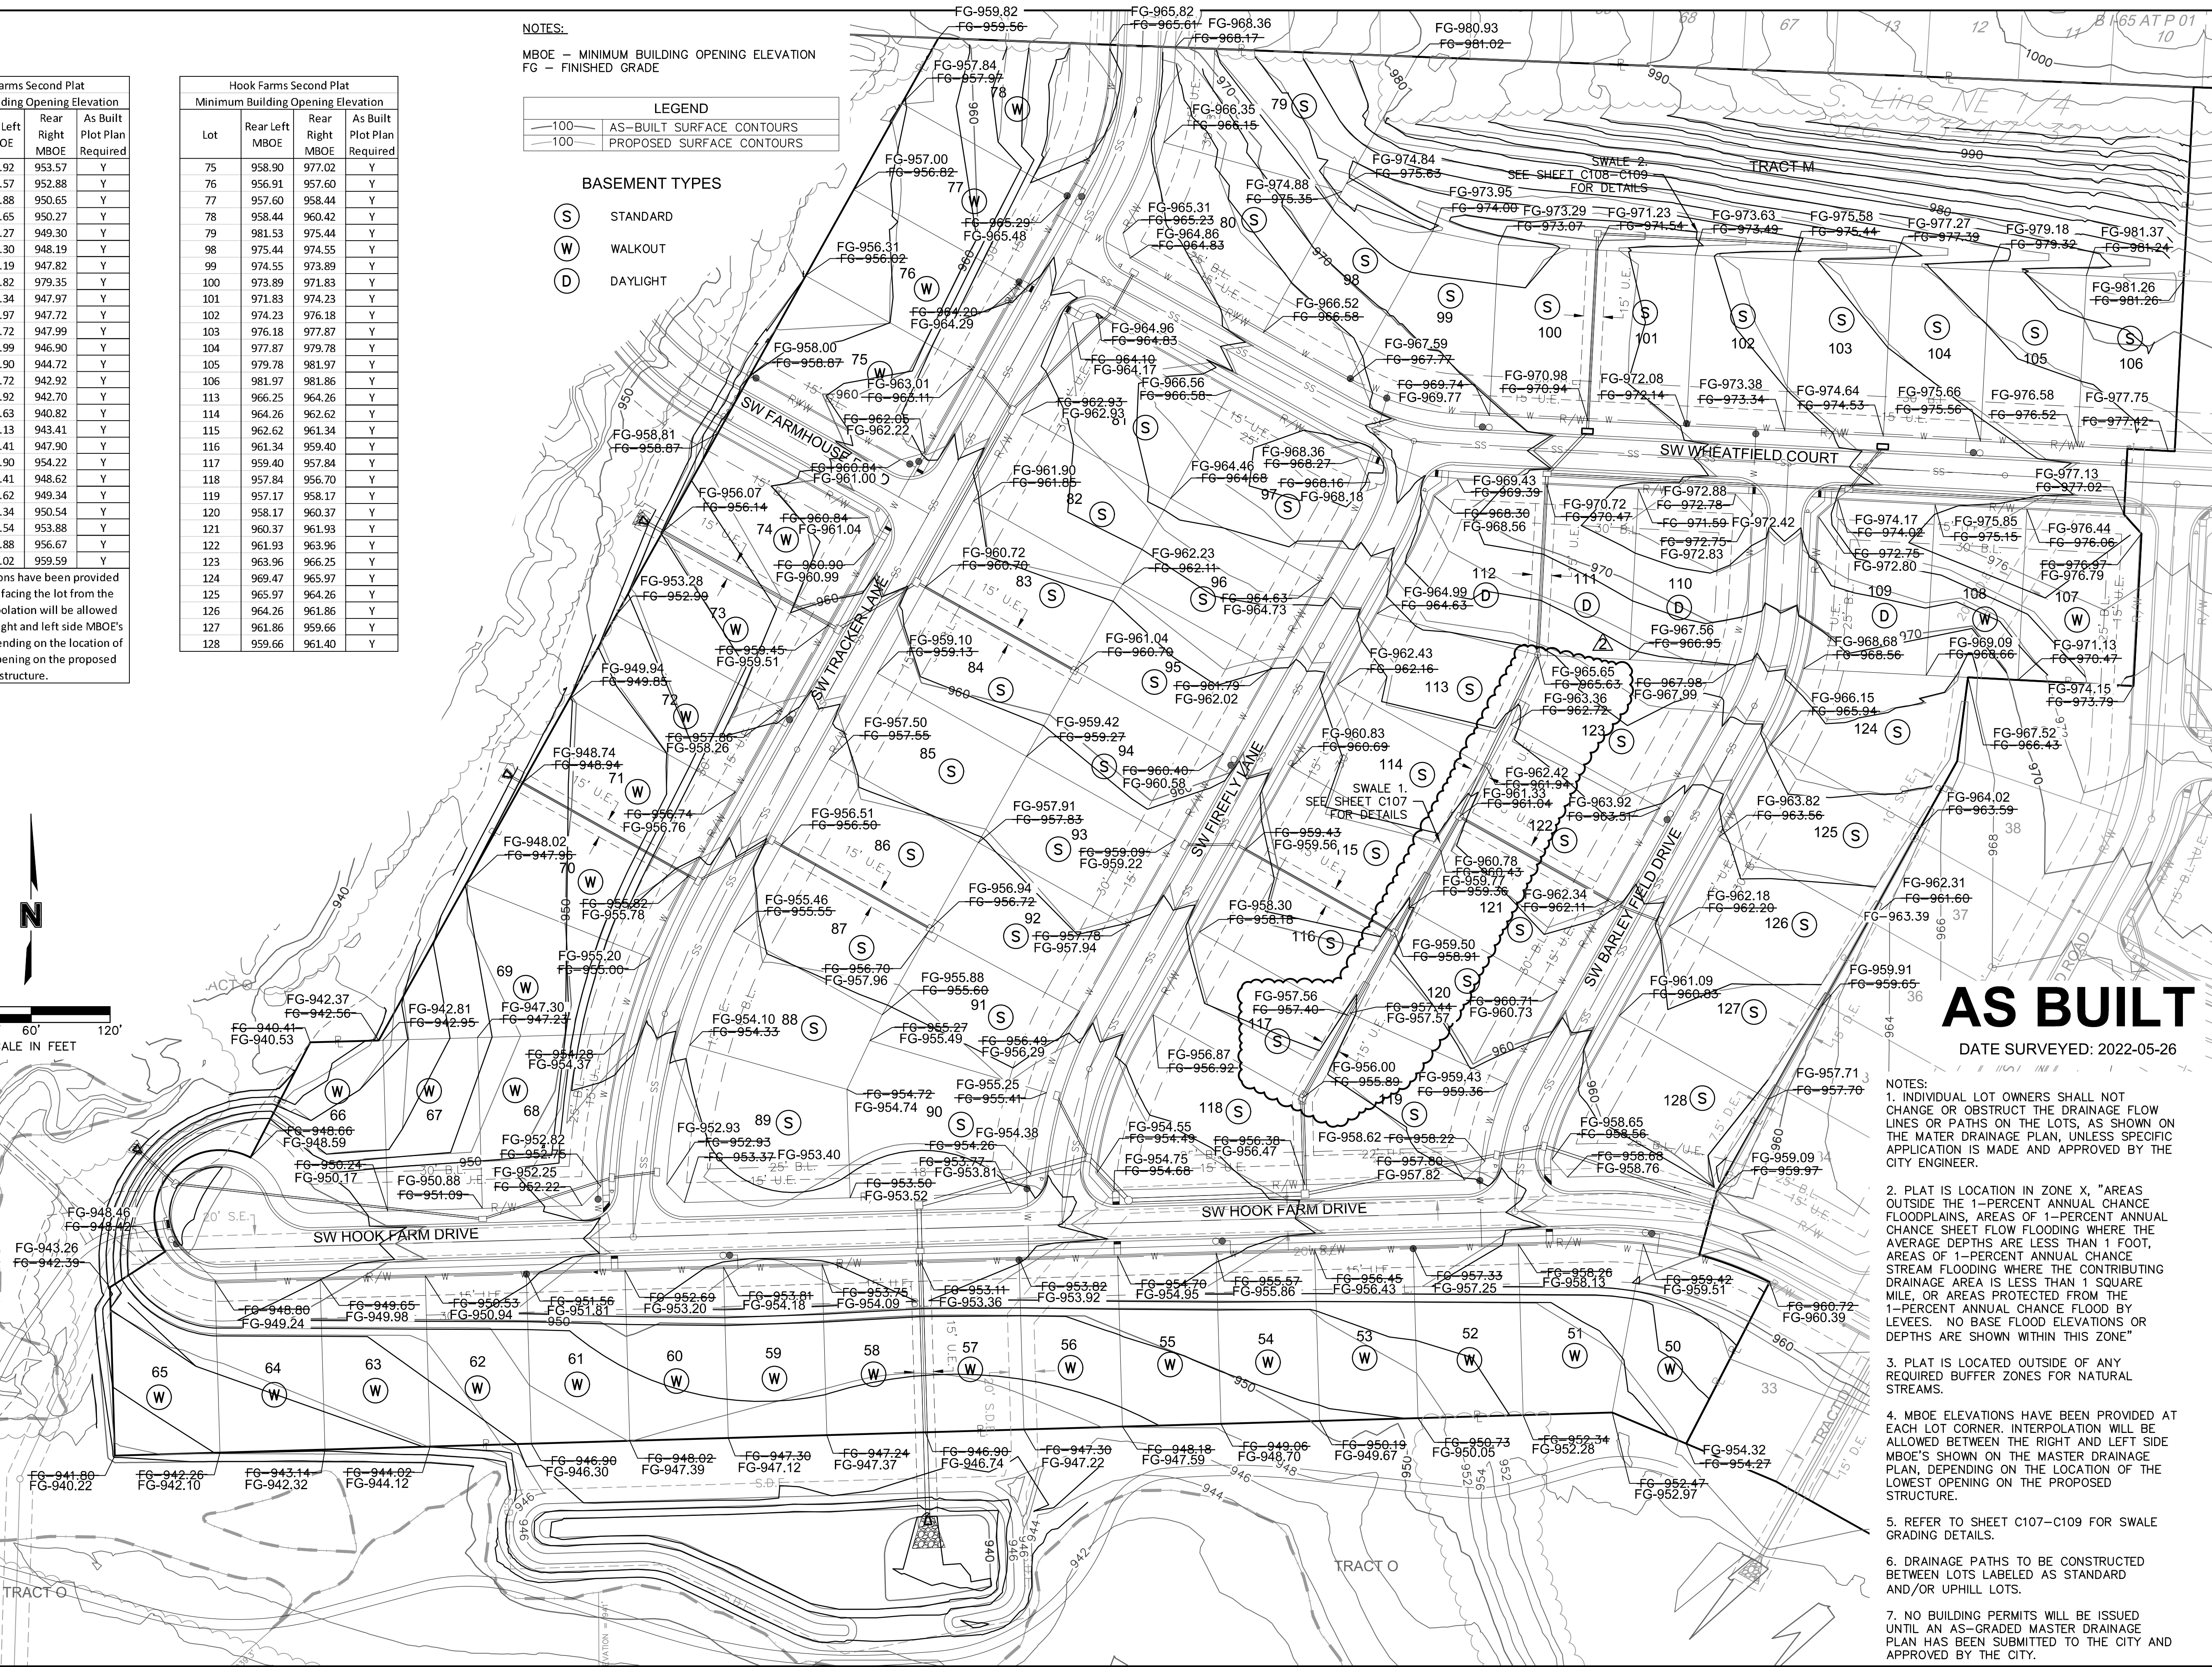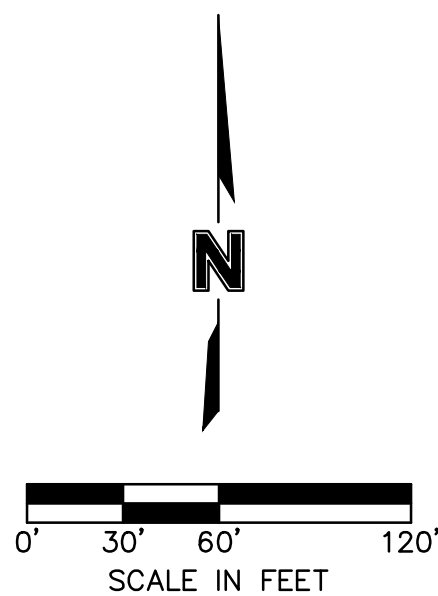

AS BUILT

DATE SURVEYED: 2022-05-26

- NOTES:
1. INDIVIDUAL LOT OWNERS SHALL NOT CHANGE OR OBSTRUCT THE DRAINAGE FLOW LINES OR PATHS ON THE LOTS, AS SHOWN ON THE MASTER DRAINAGE PLAN, UNLESS SPECIFIC APPLICATION IS MADE AND APPROVED BY THE CITY ENGINEER.
 2. PLAT IS LOCATION IN ZONE X, "AREAS OUTSIDE THE 1-PERCENT ANNUAL CHANCE FLOODPLAINS, AREAS OF 1-PERCENT ANNUAL CHANCE SHEET FLOW FLOODING WHERE THE AVERAGE DEPTHS ARE LESS THAN 1 FOOT, AREAS OF 1-PERCENT ANNUAL CHANCE STREAM FLOODING WHERE THE CONTRIBUTING DRAINAGE AREA IS LESS THAN 1 SQUARE MILE, OR AREAS PROTECTED FROM THE 1-PERCENT ANNUAL CHANCE FLOOD BY LEVEES." NO BASE FLOOD ELEVATIONS OR DEPTHS ARE SHOWN WITHIN THIS ZONE"
 3. PLAT IS LOCATED OUTSIDE OF ANY REQUIRED BUFFER ZONES FOR NATURAL STREAMS.
 4. MBOE ELEVATIONS HAVE BEEN PROVIDED AT EACH LOT CORNER. INTERPOLATION WILL BE ALLOWED BETWEEN THE RIGHT AND LEFT SIDE MBOE'S SHOWN ON THE MASTER DRAINAGE PLAN, DEPENDING ON THE LOCATION OF THE LOWEST OPENING ON THE PROPOSED STRUCTURE.
 5. REFER TO SHEET C107-C109 FOR SWALE GRADING DETAILS.
 6. DRAINAGE PATHS TO BE CONSTRUCTED BETWEEN LOTS LABELED AS STANDARD AND/OR UPHILL LOTS.
 7. NO BUILDING PERMITS WILL BE ISSUED UNTIL AN AS-GRADED MASTER DRAINAGE PLAN HAS BEEN SUBMITTED TO THE CITY AND APPROVED BY THE CITY.


MASTER DRAINAGE PLAN
STREET & STORM SEWER PLANS

HOOK FARMS
SECOND PLAT

LEE'S SUMMIT, MO

drawn by: B.M.W.A.A.
checked by: B.M.W.A.A.
designed by: B.M.W.A.A.
QA/QC by: J.E.S.
project no.: B19-4061
date: 01-08-2021

SHEET
C144

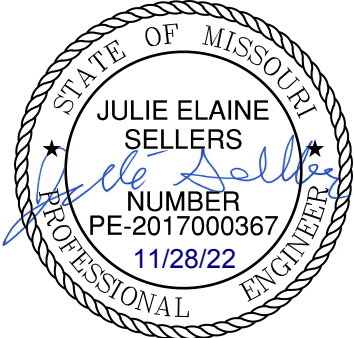

BY		REVISIONS DESCRIPTION	
REV.	NO.	DATE	DESCRIPTION
1	1	03-23-2021	REVISED PER CITY COMMENTS
2	2	04-16-2021	REVISED PER CITY COMMENTS
3	3	09-30-2021	CHANGES TO APPROVED PLANS

REVISIONS

olsson


Olsson - Civil Engineering
Missouri Certificate of Authority #001592
1301 Burlington Street
North Kansas City MO 64116

TEL 816.361.1177
FAX 816.361.1888

www.olson.com

DWG: F:\2019\4001-4500\019-4061-BV40-Design\AutoCAD\Asbuilt\Sheets\GNCV\Street & Storm Plans\B194061.dwg
DATE: Oct 11, 2022 3:40pm
XREFS: C:\B194061\B194061.dwg
C:\PBASE_B194061
C:\PBDY_B194061
C:\PSTRM_B194061
C:\PTBLK_B194061
C:\PUTIL_B194061
USER: ssaylor

LEGEND	
	FINISHED INDEX CONTOURS
	FINISHED INTERMEDIATE CONTOURS
	RIDGE LINE
	DRAINAGE AREA
	RUNOFF COEFFICIENT
	STORM STRUCTURE NUMBER

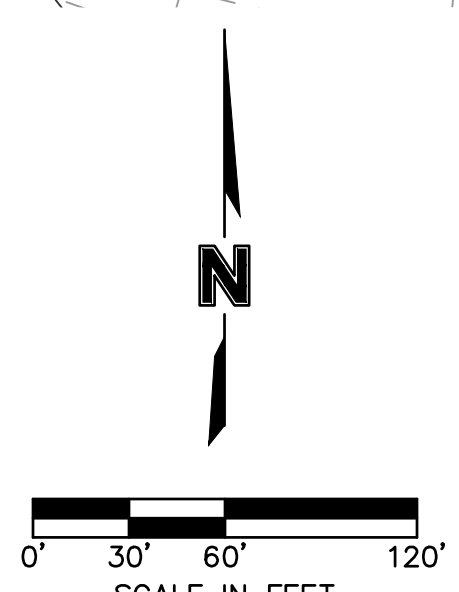

olsson

Olsson - Civil Engineering
Missouri Certificate of Authority #001592
1301 Burlington Street
North Kansas City, MO 64116
TEL 816.361.1177
FAX 816.361.1888
www.olsson.com

STATE OF MISSOURI
JULIE ELAINE
SELLERS
NUMBER
PE-2017000367
11/28/22
PROFESSIONAL ENGINEER

BY

REVISIONS DESCRIPTION

DATE

REV. NO.

1

REVISED PER CITY COMMENTS

03-23-2021

1

2

REVISED PER CITY COMMENTS

04-16-2021

2

3

CHANGES TO APPROVED PLANS

09-30-2021

3

DRAINAGE PLAN
STREET & STORM SEWER PLANS

HOOK FARMS
SECOND PLAT

2021

drawn by: B.M.W./A.A.
checked by: B.M.W.
designed by: B.M.W./A.A.
QA/QC by: J.E.S.
project no.: B19-4061
date: 01-08-2021

SHEET
C145

Inlet Design Table						
10 Year Return Frequency						
Inlet ID	Captured Flow	Bypass Flow	Inlet Efficiency (Note 2)	Gutter Depth	Gutter Spread	Ponding Depth
	(cfs)	(cfs)	(%)	(ft)	(ft)	(ft)
C.I. 1-2(L)	3.36	0.00	100.00%	0.20	10.20	...
C.I. 1-2(R)	0.23	0.00	100.00%	0.07	3.74	...
C.I. 1-2	4.19	0.00	100.00%	...	...	...
C.I. 1-3(L)	0.34	0.00	100.00%	0.09	4.36	...
C.I. 1-3(R)	2.74	0.00	100.00%	0.19	9.44	...
C.I. 1-3	7.20	0.00	100.00%	...	...	...
C.I. 1-4	1.43	0.24	85.63%	0.14	7.21	...
C.I. 1-6	1.94	0.32	85.85%	0.18	8.79	...
C.I. 1-7	1.08	0.13	89.48%	0.13	6.36	...
C.I. 1-8	1.05	0.12	89.77%	0.13	6.28	...
F.I. 2-1	3.04	0.00	100.00%	...	...	0.15
F.I. 2-2	2.59	0.00	100.00%	...	...	0.13
F.I. 2-3	2.48	0.00	100.00%	...	...	0.13
C.I. 2-5	0.64	0.03	95.13%	0.11	5.27	...
C.I. 2-6	0.97	0.08	91.95%	0.12	6.22	...
C.I. 3-1	1.08	0.11	90.54%	0.13	6.47	...
C.I. 4-1	1.66	0.32	83.66%	0.16	7.76	...
C.I. 4-2	1.28	0.18	87.85%	0.14	6.92	...
C.I. 5-1	1.34	0.20	87.27%	0.14	7.05	...
C.I. 5-2	1.54	0.27	85.02%	0.15	7.50	...
C.I. 6-1	3.22	0.90	78.18%	0.21	10.38	...
F.I. 6-2	3.41	0.00	100.00%	...	...	0.16
F.I. 6-3	4.16	0.00	100.00%	...	...	0.18
C.I. 7-1	3.80	1.42	72.80%	0.23	11.35	...
C.I. 8-2(L)	2.06	0.00	100.00%	0.15	7.65	...
C.I. 8-2(R)	0.99	0.00	100.00%	0.13	6.25	...
C.I. 8-2	3.99	0.00	100.00%	...	...	...
C.I. 8-3	1.51	0.17	89.96%	0.16	7.96	...
C.I. 8-4	1.10	0.14	88.79%	0.13	6.37	...
C.I. 8-5	1.86	0.38	83.08%	0.17	8.31	...
C.I. 9-2	0.98	0.08	92.39%	0.13	6.34	...
C.I. 9-3	1.59	0.25	86.30%	0.16	7.76	...
F.I. 9-4	3.68	0.00	100.00%	...	...	0.17
C.I. 10-2	0.33	0.01	97.51%	0.08	3.88	...
C.I. 10-3	1.85	0.41	81.75%	0.16	8.20	...
F.I. 10-4	2.63	0.00	100.00%	...	...	0.14
C.I. 11-1	3.20	1.41	69.52%	0.22	11.03	...
C.I. 11-2	0.91	0.07	92.93%	0.12	6.12	...
C.I. 11-3	3.67	2.18	62.75%	0.24	11.98	...
C.I. 12-1	0.94	0.07	92.82%	0.12	6.25	...

Drainage Area Design Table						
10 Year Return Frequency						
Inlet ID	Drainage Area	C	Tc	i	K	Peak Flow
	(ac)		(min)	(in/hr)		(cfs)
C.I. 1-2(L)	0.87	0.51	5.00	7.35	1.00	3.26
C.I. 1-2(R)	0.06	0.51	5.00	7.35	1.00	0.23
C.I. 1-2(B)	0.16	0.51	5.00	7.35	1.00	0.60
C.I. 1-2	1.09	0.51	5.00	7.35	1.00	4.09
C.I. 1-3(L)	0.09	0.51	5.00	7.35	1.00	0.34
C.I. 1-3(R)	0.55	0.51	5.00	7.35	1.00	2.06
C.I. 1-3(B)	1.10	0.51	5.00	7.35	1.00	4.13
C.I. 1-3	1.74	0.51	5.00	7.35	1.00	6.53
C.I. 1-4	0.36	0.51	5.00	7.35	1.00	1.35
C.I. 1-6	0.50	0.51	5.00	7.35	1.00	1.88
C.I. 1-7	0.27	0.51	5.00	7.35	1.00	1.01
C.I. 1-8	0.24	0.51	5.00	7.35	1.00	0.90
F.I. 2-1	0.81	0.51	5.00	7.35	1.00	3.04
F.I. 2-2	0.69	0.51	5.00	7.35	1.00	2.59
F.I. 2-3	0.66	0.51	5.00	7.35	1.00	2.48
C.I. 2-5	0.18	0.51	5.00	7.35	1.00	0.68
C.I. 2-6	0.28	0.51	5.00	7.35	1.00	1.05
C.I. 3-1	0.27	0.51	5.00	7.35	1.00	1.01
C.I. 4-1	0.52	0.51	5.00	7.35	1.00	1.95
C.I. 4-2	0.39	0.51	5.00	7.35	1.00	1.46
C.I. 5-1	0.40	0.51	5.00	7.35	1.00	1.50
C.I. 5-2	0.46	0.51	5.00	7.35	1.00	1.73
C.I. 6-1	0.72	0.51	5.00	7.35	1.00	2.70
F.I. 6-2	0.91	0.51	5.00	7.35	1.00	3.41
F.I. 6-3	1.11	0.51	5.00	7.35	1.00	4.16
C.I. 7-1	1.02	0.51	5.00	7.35	1.00	3.83
C.I. 8-2(L)	0.55	0.51	5.00	7.35	1.00	2.06
C.I. 8-2(R)	0.22	0.51	5.00	7.35	1.00	0.83
C.I. 8-2(B)	0.25	0.51	5.00	7.35	1.00	0.94
C.I. 8-2	1.02	0.51	5.00	7.35	1.00	3.83
C.I. 8-3	0.31	0.51	5.00	7.35	1.00	1.16
C.I. 8-4	0.31	0.51	5.00	7.35	1.00	1.16
C.I. 8-5	0.53	0.51	5.00	7.35	1.00	1.99
C.I. 9-2	0.28	0.51	5.00	7.35	1.00	1.05
C.I. 9-3	0.38	0.51	5.00	7.35	1.00	1.43
F.I. 9-4	0.98	0.51	5.00	7.35	1.00	3.68
C.I. 10-2	0.09	0.51	5.00	7.35	1.00	0.34
C.I. 10-3	0.23	0.51	5.00	7.35	1.00	0.86
F.I. 10-4	0.70	0.51	5.00	7.35	1.00	2.63
C.I. 11-1	0.63	0.51	5.00	7.35	1.00	2.36
C.I. 11-2	0.26	0.51	5.00	7.35	1.00	0.98
C.I. 11-3	1.32	0.51	5.00	7.35	1.00	4.95
C.I. 12-1	0.27	0.51	5.00	7.35	1.00	1.01

Storm Sewer Design Calculation Table													
10 Year Return Frequency													
Upstream Structure	Downstream Structure	Length (ft)	Upstream Invert (ft)	Downstream Invert (ft)	Slope (%)	Diameter (in)	Manning's n	Total Flow (cfs)	Velocity (ft/s)	Capacity (cfs)	Flow Depth (ft)	Upstream Struct. HGL (ft)	Upstream Top Elev. (ft)
C.I. 1-2	E.S. 1-1	202.00	942.02	940.00	1.00	36	0.012	65.27	10.82	72.25	2.23	944.61	952.95
C.I. 1-3	C.I. 1-2	35.00	942.83	942.52	0.86	36	0.012	61.08	10.33	68.99	2.19	944.61	952.95
C.I. 1-4	C.I. 1-3	133.97	944.39	943.32	0.80	36	0.012	53.88	9.58	64.51	2.10	946.77	954.53
M.H. 1-5	C.I. 1-4	44.30	945.24	944.89	0.79	36	0.012	51.37	9.41	64.22	2.03	947.57	954.65
C.I. 1-6	M.H. 1-5	134.49	946.82	945.74	0.80	36	0.012	51.37	9.44	64.75	2.02	949.15	956.22
C.I. 1-7	C.I. 1-6	148.70	949.01	947.82	0.80	24	0.012	16.30	7.01	21.91	1.33	950.46	958.22
C.I. 1-8	C.I. 1-7	36.74	949.80	949.51	0.79	24	0.012	15.22	6.97	21.77	1.23	951.21	958.58
NULL ON LINE 1	C.I. 1-8	104.17	951.34	950.30	1.00	24	0.012	14.17	7.17	24.48	1.09	952.69	953.52
F.I. 2-1	C.I. 1-6	72.94	948.43	947.32	1.52	30	0.012	34.08	8.46	54.44	1.85	950.41	956.89
F.I. 2-2	F.I. 2-1	144.00	950.89	948.93	1.36	30	0.012	30.54	8.99	51.83	1.46	952.77	959.91
F.I. 2-3	F.I. 2-2	101.30	953.42	951.39	2.00	24	0.012	25.01	9.67	34.69	1.38	955.18	962.04
M.H. 2-4	F.I. 2-3	136.61	956.99	953.92	2.25	24	0.012	19.65	8.37	36.73	1.26	958.58	965.63
C.I. 2-5	M.H. 2-4	138.00	962.32	957.49	3.50	24	0.012	19.65	9.27	45.84	1.09	963.91	970.31
C.I. 2-6	C.I. 2-5	230.00	967.30	963.07	1.84	15	0.012	8.72	8.09	9.49	0.94	968.44	973.99
NULL ON LINE 2	C.I. 2-6	178.30	969.58	967.80	1.00	15	0.012	3.95	5.30	6.99	0.67	970.38	970.95
C.I. 3-1	C.I. 1-4	53.27	947.21	946.14	2.01	15	0.012	1.08	2.42	9.91	0.63	947.62	955.25
C.I. 4-1	F.I. 2-2	138.00	953.24	952.14	0.80	15	0.012	2.94	4.48	6.25	0.63	953.93	959.27
C.I. 4-2	C.I. 4-1	39.15	954.05	953.74	0.79	15	0.012	1.28	3.62	6.22	0.38	954.50	958.93
C.I. 5-1	F.I. 2-3	138.00	955.30	953.92	1.00	18	0.012	2.88	2.89	11.38	1.26	955.94	961.95
C.I. 5-2	C.I. 5-1	34.34	956.14	955.80	0.99	15	0.012	1.54	4.00	6.96	0.40	956.63	962.04
C.I. 6-1	C.I. 2-5	44.69	963.21	962.82	0.87	24	0.012	10.29	5.69	22.89	1.09	964.36	970.78
F.I. 6-2	C.I. 6-1	150.50	964.91	963.71	0.80	18	0.012	7.57	5.97	10.16	0.96	965.97	970.06
F.I. 6-3	F.I. 6-2	225.00	970.47	965.41	2.25	15	0.012	4.16	6.45	10.49	0.55	971.29	975.91
C.I. 7-1	C.I. 2-6	41.62	968.22	967.80	1.01	15	0.012	3.80	5.25	7.03	0.66	969.04	974.37
C.I. 8-2	E.S. 8-1	38.74	939.82	939.57	0.65	18	0.012	8.46	5.88	9.14	1.13	940.97	946.73
C.I. 8-3	C.I. 8-2	235.47	942.67	940.32	1.00	15	0.012	4.47	4.98	6.99	0.86	943.53	950.92
C.I. 8-4	C.I. 8-3	103.13	944.46	943.17	1.25	15	0.012	2.96	5.09	7.82	0.53	945.15	952.80
C.I. 8-5	C.I. 8-4	34.61	945.39	944.96	1.24	15	0.012	1.86	4.43	7.80	0.42	945.93	952.88
C.I. 9-2	E.S. 9-1	162.45	947.12	945.82	0.80	15	0.012	5.73	5.70	6.26	0.94	948.09	955.66
C.I. 9-3	C.I. 9-2	64.21	948.90	947.62	1.99	15	0.012	4.75	6.55	9.88	0.61	949.78	956.35
F.I. 9-4	C.I. 9-3	138.00	951.13	949.40	1.25	15	0.012	3.68	5.44	7.83	0.60	951.90	957.72
C.I. 10-2	E.S. 10-1	165.47	953.14	951.81	0.80	24	0.012	13.10	6.67	21.93	1.11	954.44	959.29
C.I. 10-3	C.I. 10-2	69.88	954.20	953.64	0.79	24	0.012	12.77	6.63	22.01	1.09	955.48	960.55
F.I. 10-4	C.I. 10-3	137.50	956.05	954.95	0.80	15	0.012	2.63	4.48	6.25	0.57	956.70	961.70
C.I. 11-1	C.I. 10-3	150.00	955.90	954.70	0.80	18	0.012	8.72	6.26	10.18	1.07	957.04	962.77
C.I. 11-2	C.I. 11-1	106.77	958.00	956.40	1.50	15	0.012	4.58	6.07	8.56	0.65	958.87	964.79
C.I. 11-3	C.I. 11-2	34.00	958.84	958.50	1.00	15	0.012	3.67	5.19	7.00	0.64	959.61	964.79
C.I. 12-1	C.I. 11-1	36.23	956.76	956.40	0.99	15	0.012	0.94	2.23	6.97	0.64	957.14	962.95

NOT AS-BUILT

olsson

Olsson - Civil Engineering
Missouri Certificate of Authority #001592
1301 Burlington Street
North Kansas City MO 64116
TEL 816.361.1177
FAX 816.361.1888
www.olsson.com

STATE OF MISSOURI
JULIE ELAINE SELLERS
NUMBER PE-201700

Inlet Design Table						
100 Year Return Frequency						
Inlet ID	Captured Flow	Bypass Flow	Inlet Efficiency (Note 2)	Gutter Depth	Gutter Spread	Ponding Depth
	(cfs)	(cfs)	(%)	(ft)	(ft)	(ft)
C.I. 1-2(L)	6.19	0.00	100.00%	0.26	12.82	...
C.I. 1-2(R)	0.39	0.00	100.00%	0.09	4.62	...
C.I. 1-2	7.63	0.00	100.00%	...	...	...
C.I. 1-3(L)	0.59	0.00	100.00%	0.11	5.38	...
C.I. 1-3(R)	6.36	0.00	100.00%	0.26	12.96	...
C.I. 1-3	14.19	0.00	100.00%	...	...	...
C.I. 1-4	2.44	0.89	73.20%	0.19	9.34	...
C.I. 1-6	3.55	1.43	71.29%	0.24	11.81	...
C.I. 1-7	1.90	0.48	79.74%	0.16	8.20	...
C.I. 1-8	1.92	0.50	79.31%	0.17	8.25	...
F.I. 2-1	5.33	0.00	100.00%	...	...	0.22
F.I. 2-2	4.54	0.00	100.00%	...	...	0.19
F.I. 2-3	4.34	0.00	100.00%	...	...	0.19
C.I. 2-5	1.08	0.11	90.84%	0.13	6.50	...
C.I. 2-6	1.58	0.26	85.66%	0.15	7.68	...
C.I. 3-1	1.89	0.42	81.80%	0.17	8.30	...
C.I. 4-1	2.57	0.96	72.69%	0.19	9.63	...
C.I. 4-2	2.03	0.53	79.27%	0.17	8.55	...
C.I. 5-1	2.14	0.60	78.02%	0.18	8.76	...
C.I. 5-2	2.44	0.85	74.25%	0.19	9.38	...
C.I. 6-1	5.35	4.17	56.23%	0.28	14.21	...
F.I. 6-2	5.99	0.00	100.00%	...	...	0.23
F.I. 6-3	7.30	0.00	100.00%	...	...	0.27
C.I. 7-1	5.55	4.78	53.73%	0.29	14.65	...
C.I. 8-2(L)	3.62	0.00	100.00%	0.19	9.45	...
C.I. 8-2(R)	2.87	0.00	100.00%	0.19	9.30	...
C.I. 8-2	8.13	0.00	100.00%	...	...	...
C.I. 8-3	3.64	1.42	71.92%	0.24	12.02	...
C.I. 8-4	1.83	0.46	79.78%	0.16	8.02	...
C.I. 8-5	3.80	2.55	59.83%	0.25	12.28	...
C.I. 9-2	1.62	0.26	86.25%	0.16	7.85	...
C.I. 9-3	4.00	2.86	58.28%	0.25	12.72	...
F.I. 9-4	6.45	0.00	100.00%	...	...	0.25
C.I. 10-2	0.56	0.03	94.87%	0.10	4.79	...
C.I. 10-3	4.19	4.36	49.04%	0.27	13.48	...
F.I. 10-4	4.61	0.00	100.00%	...	...	0.20
C.I. 11-1	5.09	7.04	41.98%	0.32	15.85	...
C.I. 11-2	1.49	0.22	87.24%	0.15	7.56	...
C.I. 11-3	5.08	7.77	39.56%	0.32	16.10	...
C.I. 12-1	1.55	0.23	87.07%	0.15	7.71	...






Drainage Area Design Table						
100 Year Return Frequency						
Inlet ID	Drainage Area	C	Tc	i	K	Peak Flow
	(ac)		(min)	(in/hr)		(cfs)
C.I. 1-2(L)	0.87	0.51	5.00	10.32	1.25	5.73
C.I. 1-2(R)	0.06	0.51	5.00	10.32	1.25	0.39
C.I. 1-2(B)	0.16	0.51	5.00	10.32	1.25	1.05
C.I. 1-2	1.09	0.51	5.00	10.32	1.25	7.17
C.I. 1-3(L)	0.09	0.51	5.00	10.32	1.25	0.59
C.I. 1-3(R)	0.55	0.51	5.00	10.32	1.25	3.62
C.I. 1-3(B)	1.10	0.51	5.00	10.32	1.25	7.24
C.I. 1-3	1.74	0.51	5.00	10.32	1.25	11.45
C.I. 1-4	0.36	0.51	5.00	10.32	1.25	2.37
C.I. 1-6	0.50	0.51	5.00	10.32	1.25	3.29
C.I. 1-7	0.27	0.51	5.00	10.32	1.25	1.78
C.I. 1-8	0.24	0.51	5.00	10.32	1.25	1.58
F.I. 2-1	0.81	0.51	5.00	10.32	1.25	5.33
F.I. 2-2	0.69	0.51	5.00	10.32	1.25	4.54
F.I. 2-3	0.66	0.51	5.00	10.32	1.25	4.34
C.I. 2-5	0.18	0.51	5.00	10.32	1.25	1.18
C.I. 2-6	0.28	0.51	5.00	10.32	1.25	1.84
C.I. 3-1	0.27	0.51	5.00	10.32	1.25	1.78
C.I. 4-1	0.52	0.51	5.00	10.32	1.25	3.42
C.I. 4-2	0.39	0.51	5.00	10.32	1.25	2.57
C.I. 5-1	0.40	0.51	5.00	10.32	1.25	2.63
C.I. 5-2	0.46	0.51	5.00	10.32	1.25	3.03
C.I. 6-1	0.72	0.51	5.00	10.32	1.25	4.74
F.I. 6-2	0.91	0.51	5.00	10.32	1.25	5.99
F.I. 6-3	1.11	0.51	5.00	10.32	1.25	7.30
C.I. 7-1	1.02	0.51	5.00	10.32	1.25	6.71
C.I. 8-2(L)	0.55	0.51	5.00	10.32	1.25	3.62
C.I. 8-2(R)	0.22	0.51	5.00	10.32	1.25	1.45
C.I. 8-2(B)	0.25	0.51	5.00	10.32	1.25	1.65
C.I. 8-2	1.02	0.51	5.00	10.32	1.25	6.71
C.I. 8-3	0.31	0.51	5.00	10.32	1.25	2.04
C.I. 8-4	0.31	0.51	5.00	10.32	1.25	2.04
C.I. 8-5	0.53	0.51	5.00	10.32	1.25	3.49
C.I. 9-2	0.28	0.51	5.00	10.32	1.25	1.84
C.I. 9-3	0.38	0.51	5.00	10.32	1.25	2.50
F.I. 9-4	0.98	0.51	5.00	10.32	1.25	6.45
C.I. 10-2	0.09	0.51	5.00	10.32	1.25	0.59
C.I. 10-3	0.23	0.51	5.00	10.32	1.25	1.51
F.I. 10-4	0.70	0.51	5.00	10.32	1.25	4.61
C.I. 11-1	0.63	0.51	5.00	10.32	1.25	4.15
C.I. 11-2	0.26	0.51	5.00	10.32	1.25	1.71
C.I. 11-3	1.32	0.51	5.00	10.32	1.25	8.69
C.I. 12-1	0.27	0.51	5.00	10.32	1.25	1.78

Storm Sewer Design Calculation Table													
100 Year Return Frequency													
Upstream Structure	Downstream Structure	Length (ft)	Upstream Invert (ft)	Downstream Invert (ft)	Slope (%)	Diameter (in)	Manning's n	Total Flow (cfs)	Velocity (ft/s)	Capacity (cfs)	Flow Depth (ft)	Upstream Struct. HGL (ft)	Upstream Top Elev. (ft)
C.I. 1-2	E.S. 1-1	202.00	942.02	940.00	0.00	36	0.012	100.26	14.26	72.25	2.90	946.61	952.95
C.I. 1-3	C.I. 1-2	35.00	942.83	942.52	0.00	36	0.012	92.63	13.11	68.99	3.00	948.11	952.95
C.I. 1-4	C.I. 1-3	133.97	944.39	943.32	0.80	36	0.012	78.44	11.10	64.51	3.00	950.76	954.53
M.H. 1-5	C.I. 1-4	44.30	945.24	944.89	0.79	36	0.012	74.11	10.49	64.22	3.00	951.99	954.65
C.I. 1-6	M.H. 1-5	134.49	946.82	945.74	0.80	36	0.012	74.11	10.49	64.75	3.00	954.09	956.22
C.I. 1-7	C.I. 1-6	148.70	949.01	947.82	0.80	24	0.012	17.99	5.73	21.91	2.00	955.58	958.22
C.I. 1-8	C.I. 1-7	36.74	949.80	949.51	0.79	24	0.012	16.09	5.12	21.77	2.00	955.89	958.58
NULL ON LINE 1	C.I. 1-8	104.17	951.34	950.30	1.00	24	0.012	14.17	4.51	24.48	2.00	956.36	953.52
F.I. 2-1	C.I. 1-6	72.94	948.43	947.32	1.52	30	0.012	54.19	11.04	54.44	2.50	956.33	956.89
F.I. 2-2	F.I. 2-1	144.00	950.89	948.93	1.36	30	0.012	48.00	9.78	51.83	2.50	958.21	959.91
F.I. 2-3	F.I. 2-2	101.30	953.42	951.39	2.00	24	0.012	38.86	12.37	34.69	2.00	961.35	962.04
M.H. 2-4	F.I. 2-3	136.61	956.99	953.92	2.25	24	0.012	29.94	9.53	36.73	2.00	964.35	965.63
C.I. 2-5	M.H. 2-4	138.00	962.32	957.49	3.50	24	0.012	29.94	9.53	45.84	2.00	966.83	970.31
C.I. 2-6	C.I. 2-5	230.00	967.30	963.07	1.84	15	0.012	11.08	9.03	9.49	1.25	973.17	973.99
NULL ON LINE 2	C.I. 2-6	178.30	969.58	967.80	1.00	15	0.012	3.95	3.22	6.99	1.25	974.24	970.95
C.I. 3-1	C.I. 1-4	53.27	947.21	946.14	2.01	15	0.012	1.89	1.54	9.91	1.25	951.57	955.25
C.I. 4-1	F.I. 2-2	138.00	953.24	952.14	0.80	15	0.012	4.60	3.75	6.25	1.25	959.40	959.27
C.I. 4-2	C.I. 4-1	39.15	954.05	953.74	0.79	15	0.012	2.03	1.65	6.22	1.25	959.50	958.93
C.I. 5-1	F.I. 2-3	138.00	955.30	953.92	1.00	18	0.012	4.58	2.59	11.38	1.50	962.53	961.95
C.I. 5-2	C.I. 5-1	34.34	956.14	955.80	0.99	15	0.012	2.44	1.99	6.96	1.25	962.60	962.04
C.I. 6-1	C.I. 2-5	44.69	963.21	962.82	0.87	24	0.012	17.78	5.66	22.89	2.00	967.63	970.78
F.I. 6-2	C.I. 6-1	150.50	964.91	963.71	0.80	18	0.012	13.29	7.52	10.16	1.50	971.03	970.06
F.I. 6-3	F.I. 6-2	225.00	970.47	965.41	2.25	15	0.012	7.30	5.95	10.49	1.25	972.39	975.91
C.I. 7-1	C.I. 2-6	41.62	968.22	967.80	1.01	15	0.012	5.55	4.52	7.63	1.25	973.94	974.37
C.I. 8-2	E.S. 8-1	38.74	939.82	939.57	0.65	18	0.012	17.40	9.91	9.14	1.44	941.90	946.73
C.I. 8-3	C.I. 8-2	235.47	942.67	940.32	1.00	15	0.012	9.27	7.55	6.99	1.25	946.64	950.92
C.I. 8-4	C.I. 8-3	103.13	944.46	943.17	1.25	15	0.012	5.63	4.59	7.82	1.25	947.57	952.80
C.I. 8-5	C.I. 8-4	34.61	945.39	944.96	1.24	15	0.012	3.80	3.10	7.80	1.25	947.77	952.88
C.I. 9-2	E.S. 9-1	162.45	947.12	945.82	0.80	15	0.012	11.20	9.13	6.26	1.25	952.40	955.66
C.I. 9-3	C.I. 9-2	64.21	948.90	947.62	1.99	15	0.012	9.58	7.81	9.88	1.25	954.12	956.35
F.I. 9-4	C.I. 9-3	138.00	951.13	949.40	1.25	15	0.012	6.45	5.26	7.83	1.25	956.73	957.72
C.I. 10-2	E.S. 10-1	165.47	953.14	951.81	0.80	24	0.012	21.85	7.88	21.93	1.63	954.81	959.29
C.I. 10-3	C.I. 10-2	69.88	954.20	953.64	0.79	24	0.012	21.29	7.83	22.01	1.58	955.85	960.55
F.I. 10-4	C.I. 10-3	137.50	956.05	954.95	0.80	15	0.012	4.61	4.90	6.25	0.92	956.92	961.70
C.I. 11-1	C.I. 10-3	150.00	955.90	954.70	0.80	18	0.012	13.21	7.48	10.18	1.50	958.22	962.77
C.I. 11-2	C.I. 11-1	106.77	958.00	956.40	1.50	15	0.012	6.57	5.35	8.56	1.25	959.51	964.79
C.I. 11-3	C.I. 11-2	34.00	958.84	958.50	1.00	15	0.012	5.08	4.80	7.00	1.15	959.75	964.79
C.I. 12-1	C.I. 11-1	36.23	956.76	956.40	0.99	15	0.012	1.55	1.26	6.97	1.25	958.59	962.95

NOT AS-BUILT

olsson

Olsson - Civil Engineering
Missouri Certificate of Authority #001592
1301 Burlington Street
North Kansas City MO 64116
TEL 816.361.11

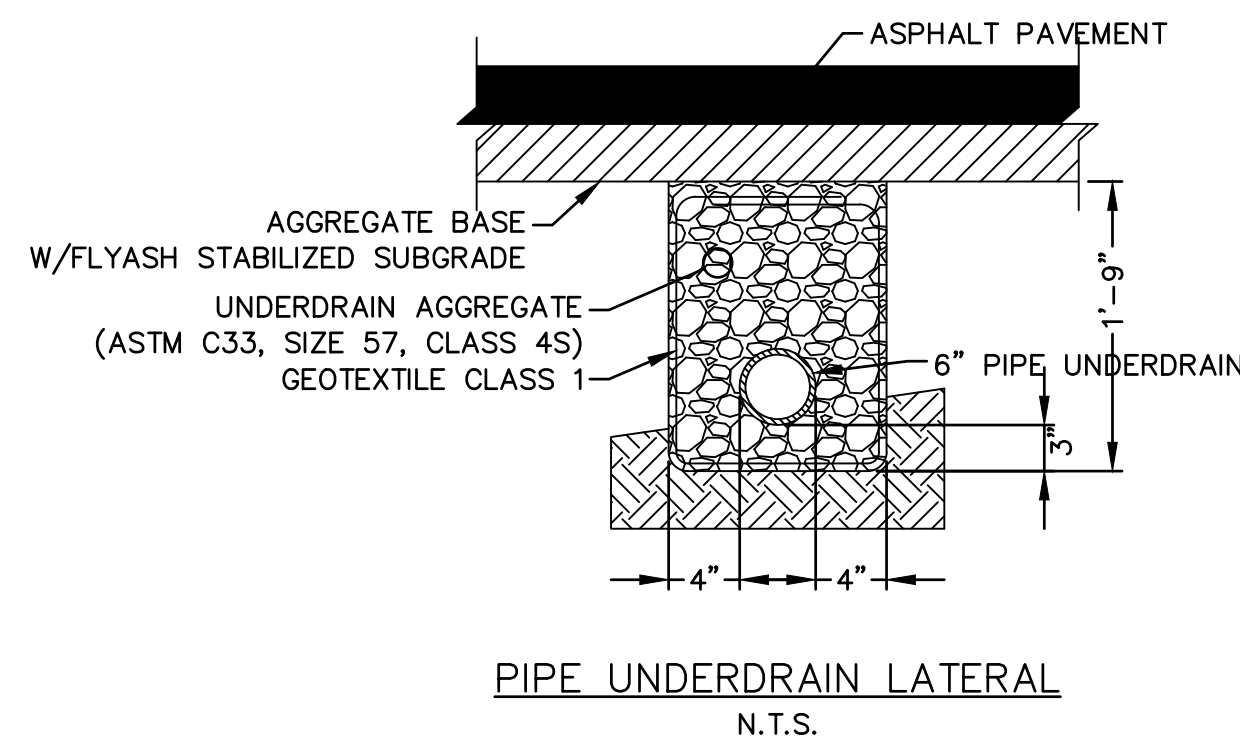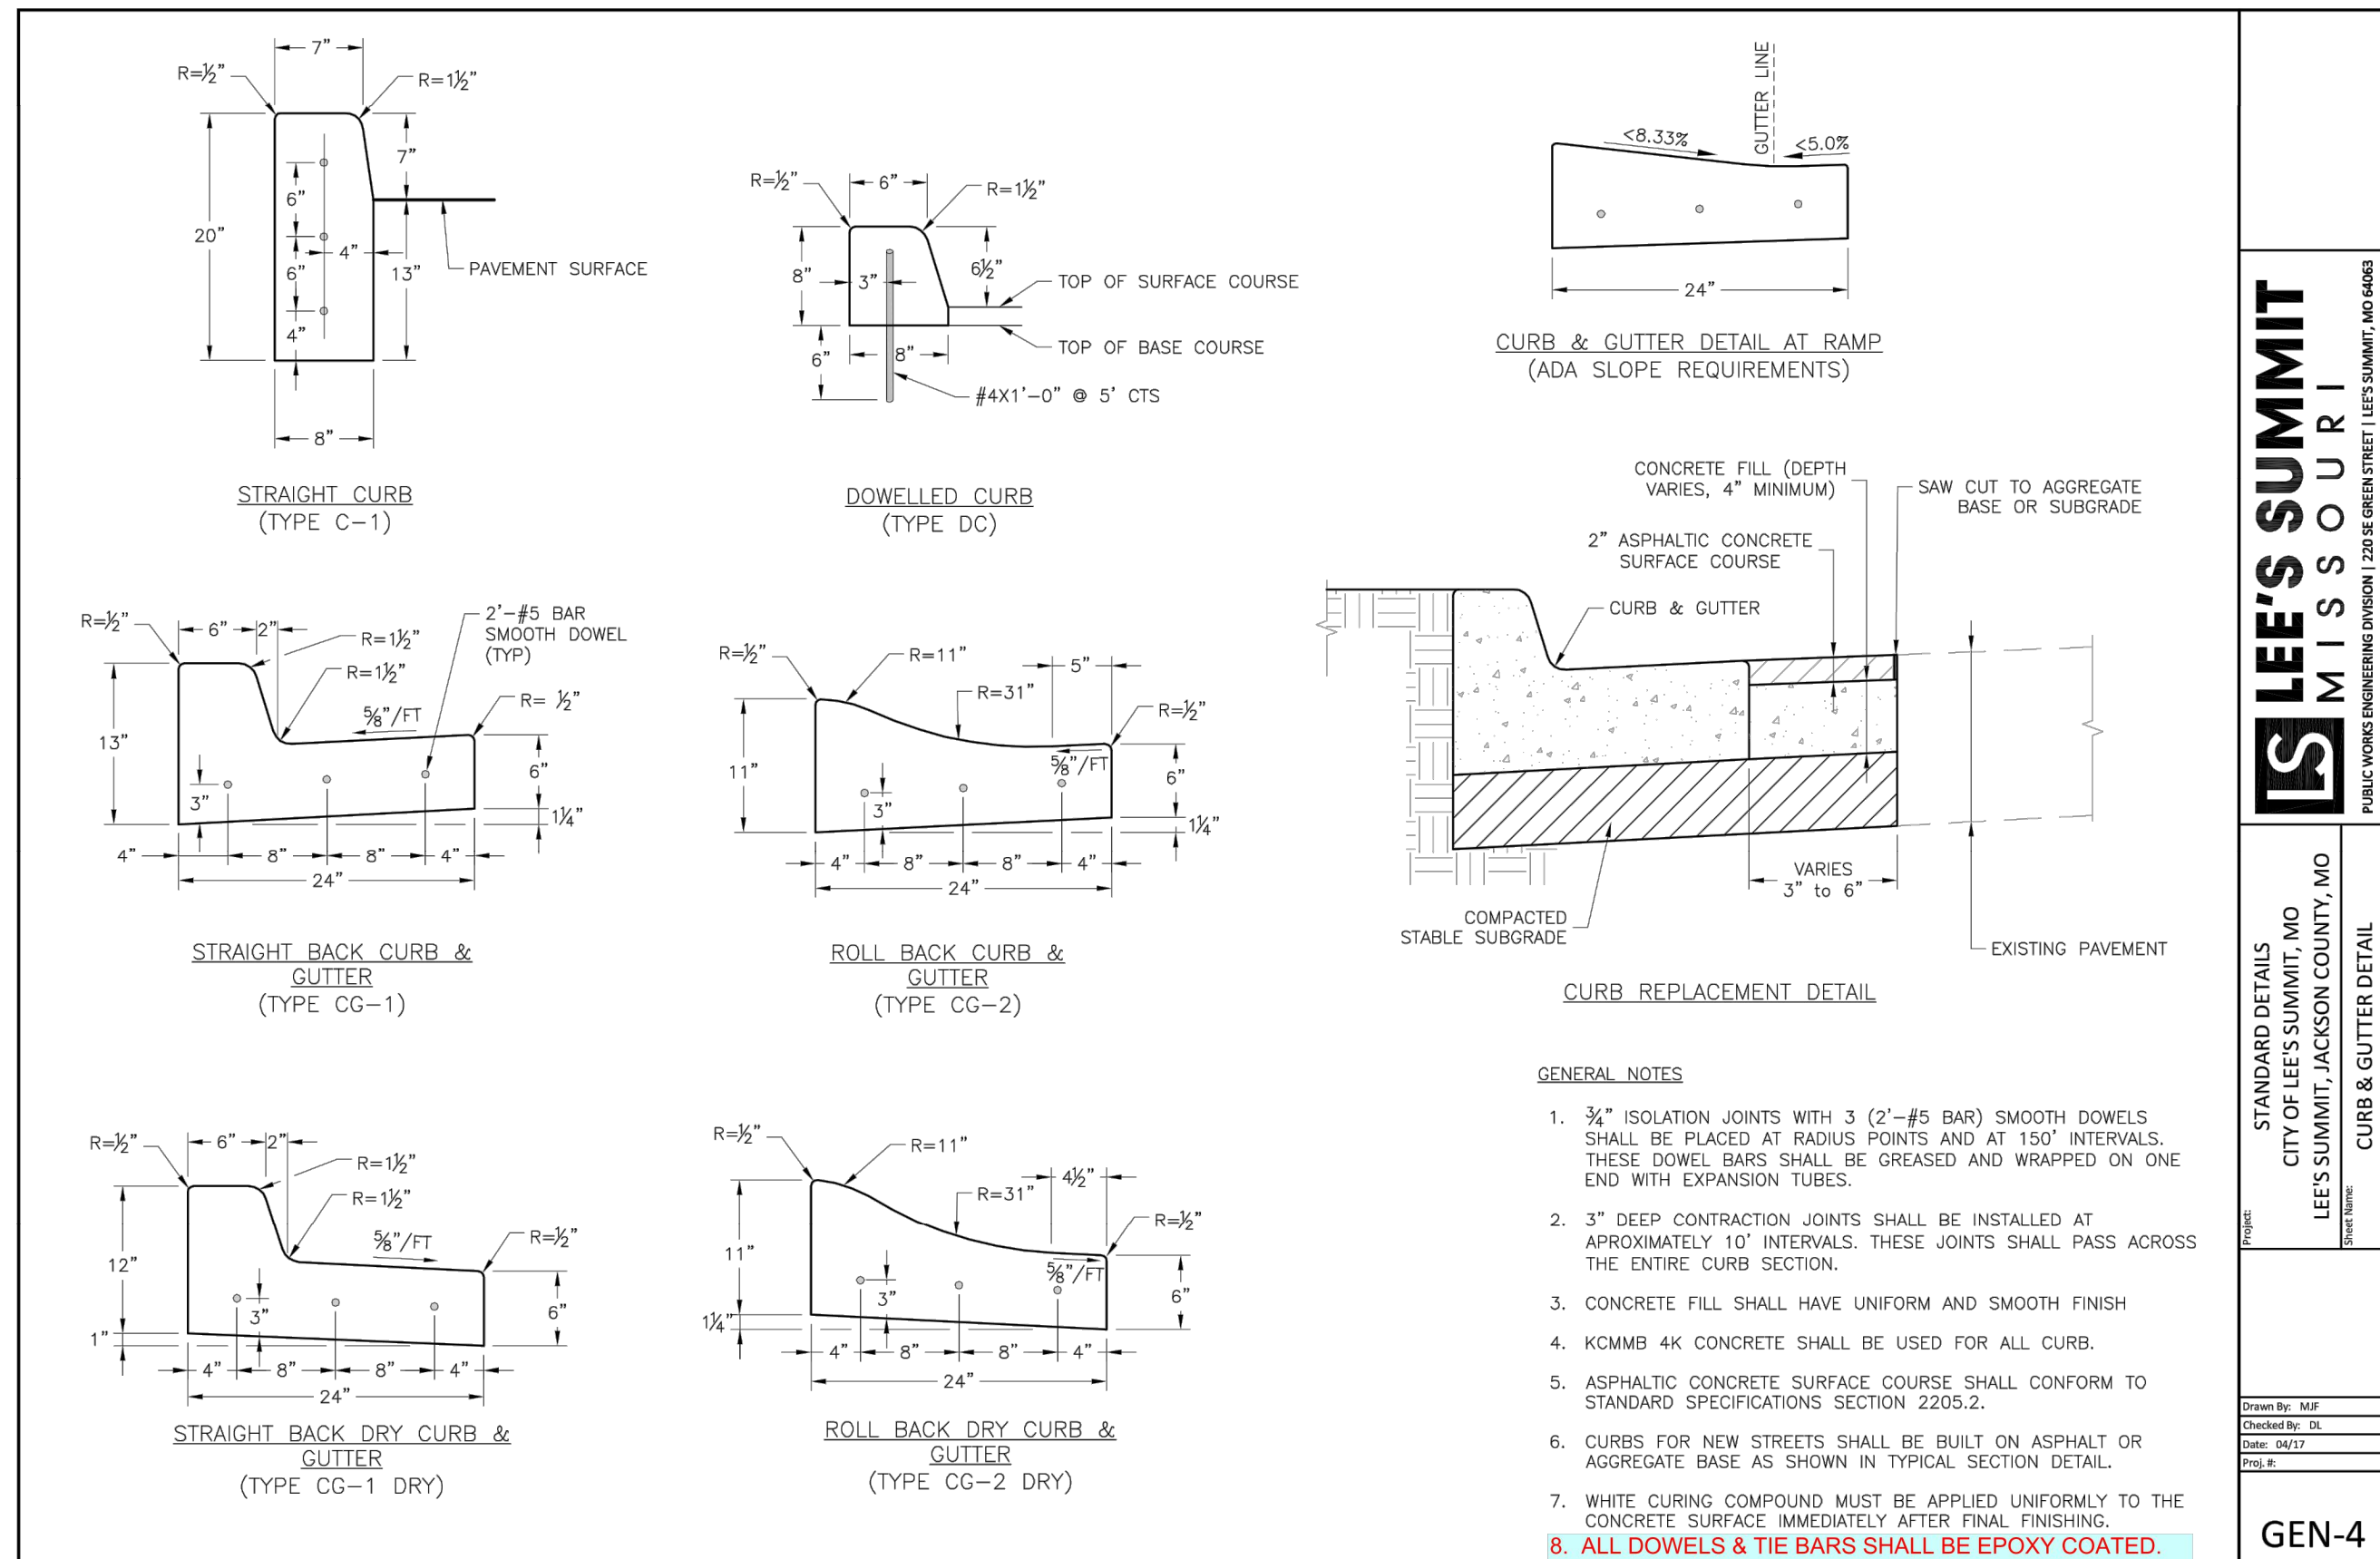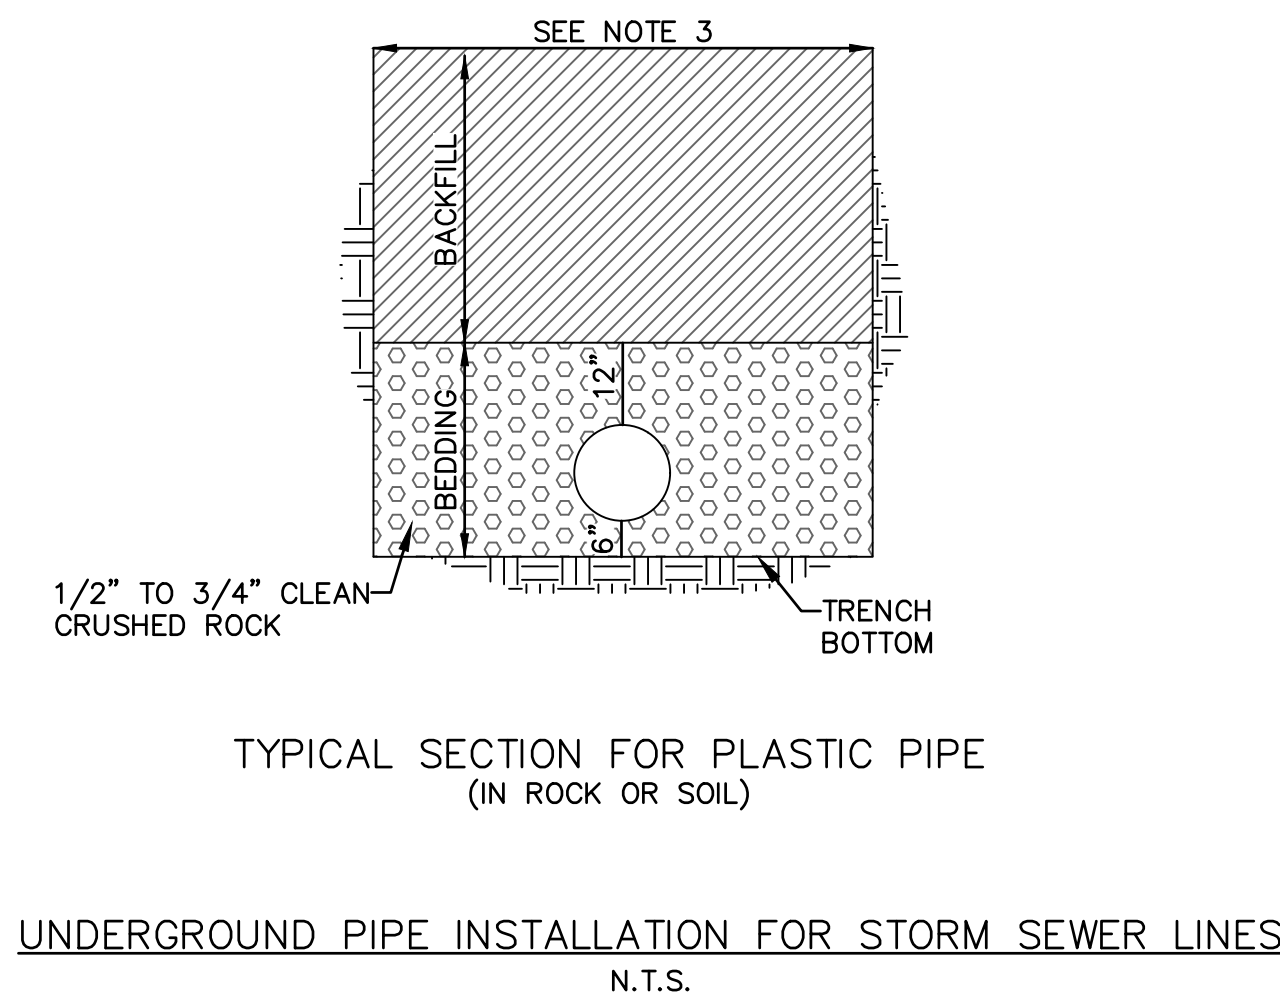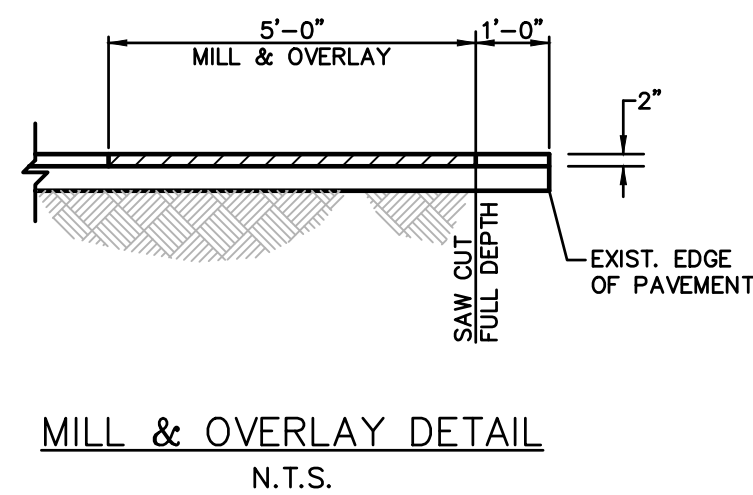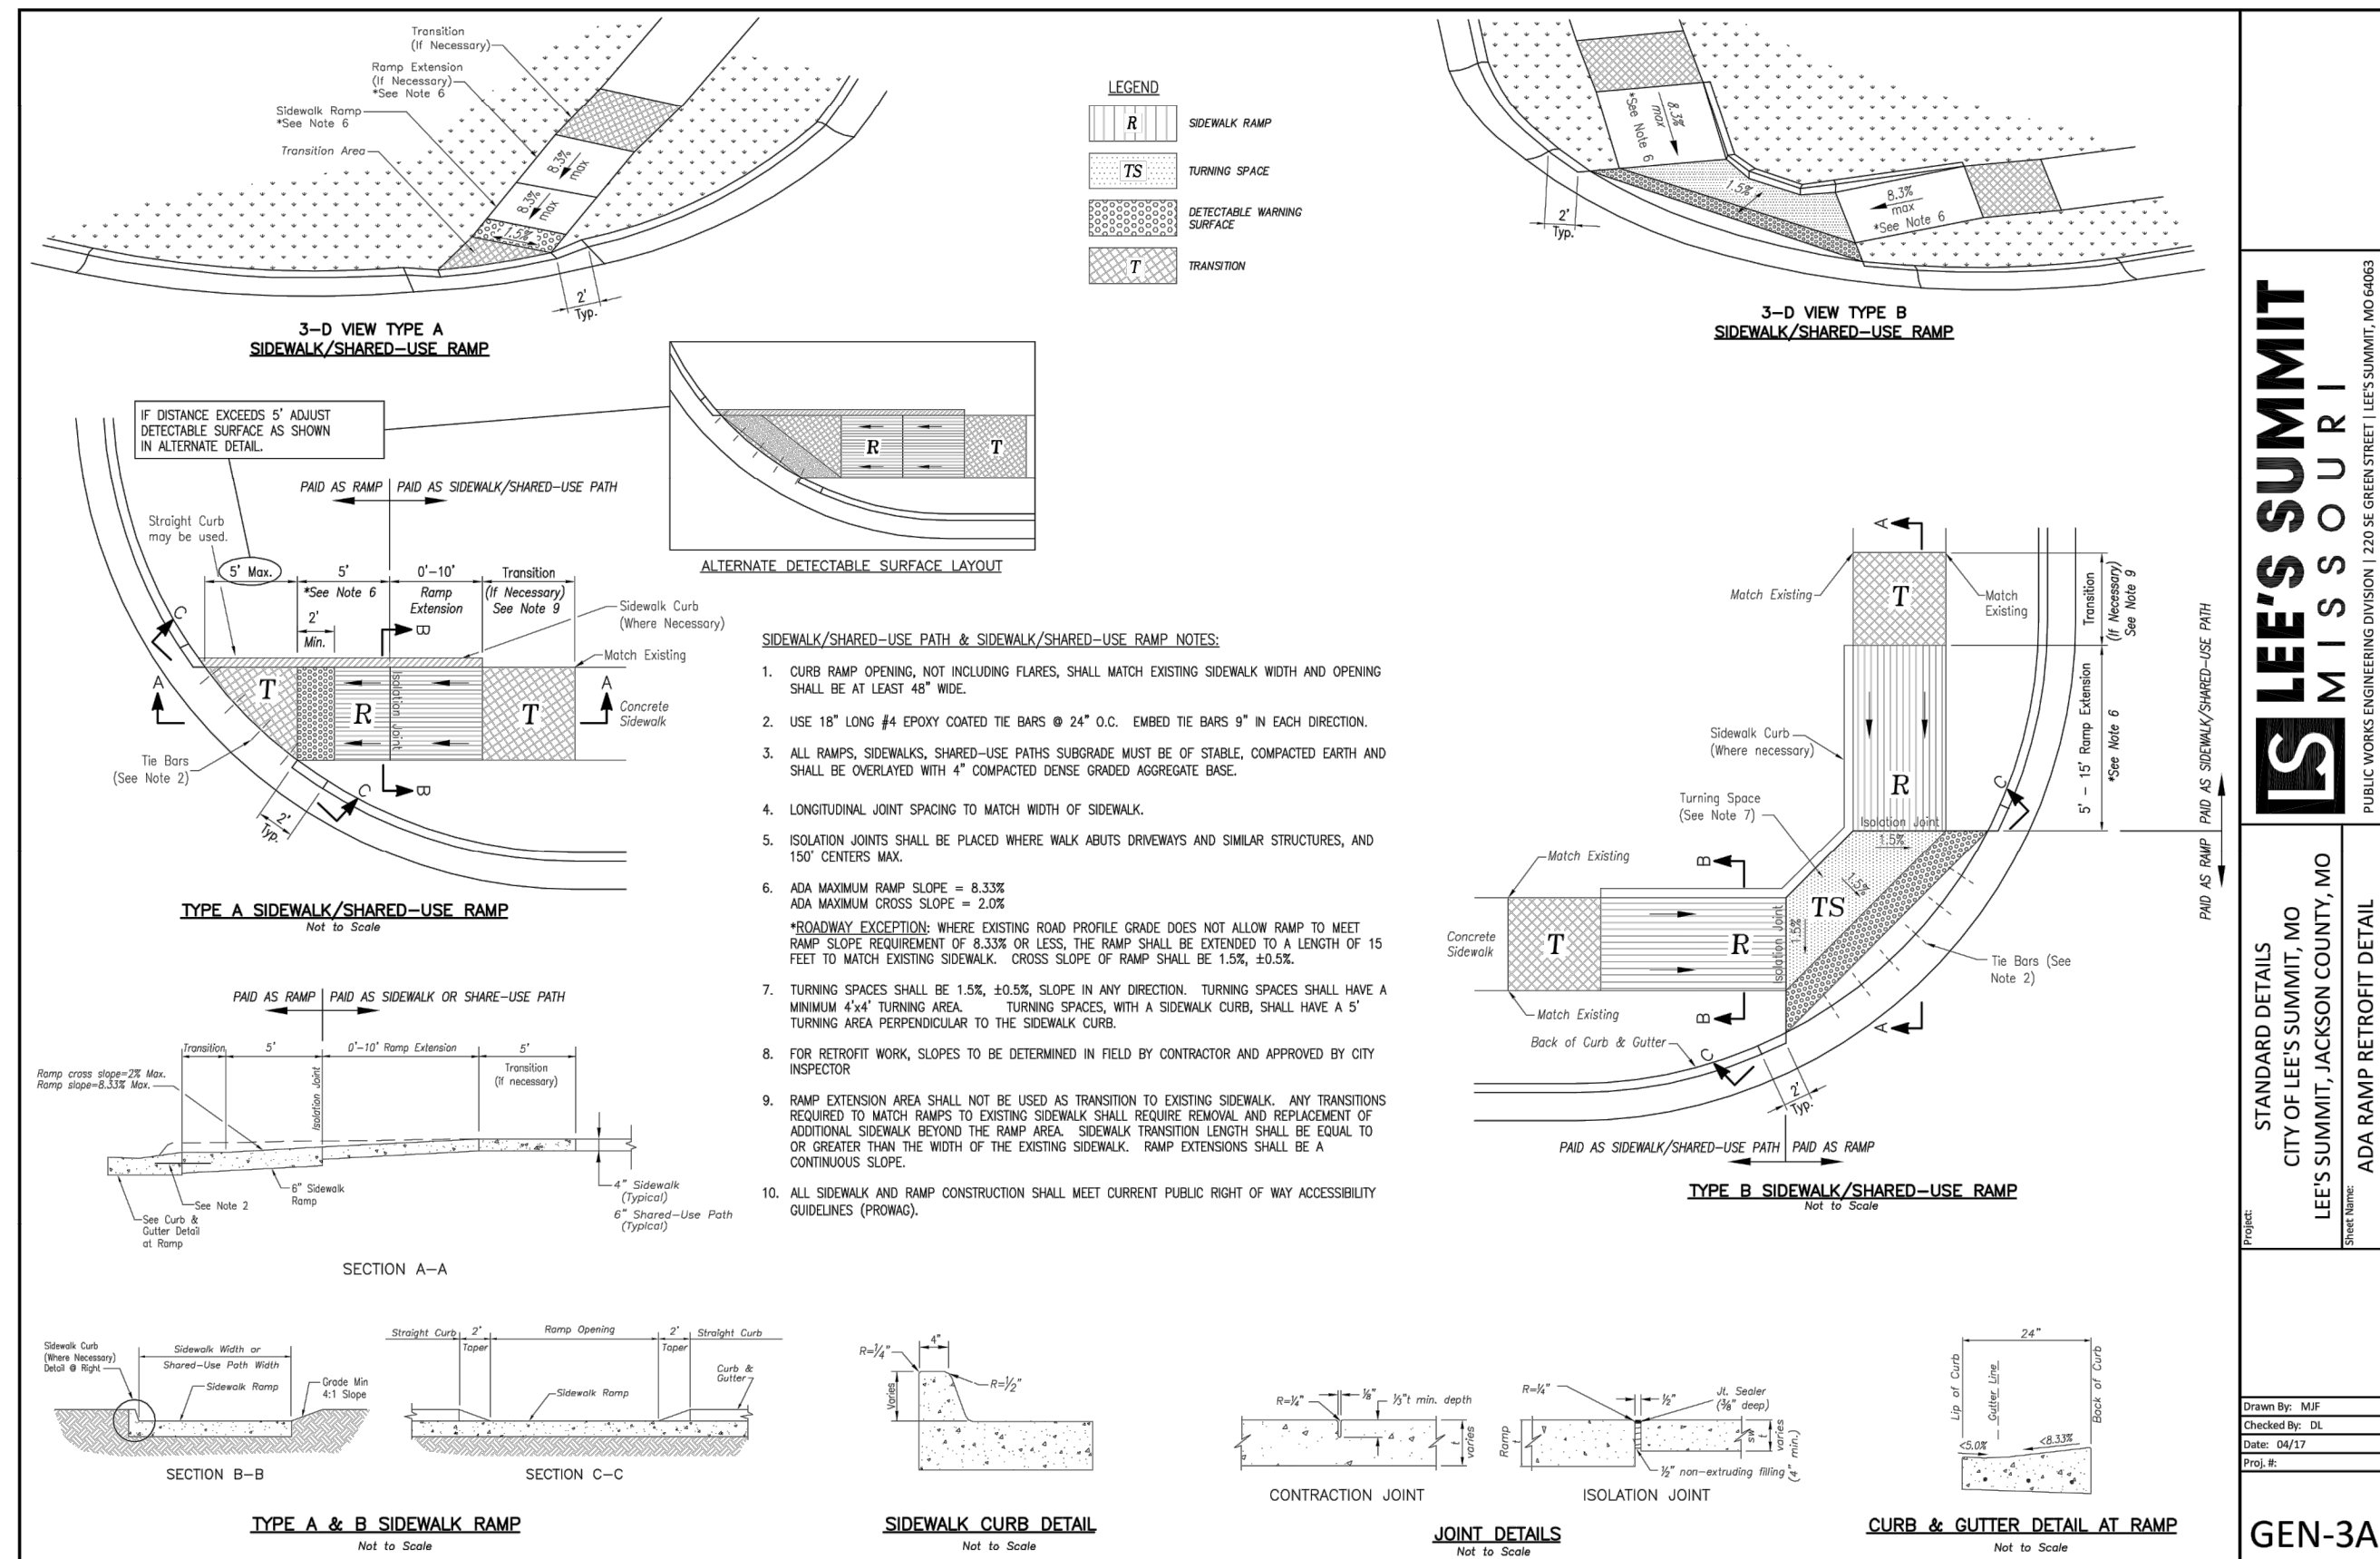


NOTES:

1. Where Pipe Underdrains are used, all Underdrain Outlet Pipes shall be solid wall with watertight joints. All Outlets Pipes shall be tied into the nearest storm sewer inlets at roadway sag locations as indicated in the street profile.
2. All Underdrain Pipes shall be installed at a minimum slope of 1%.
3. Underdrain Pipes shall be installed with the perforations placed down.
4. Blanket Underdrain Aggregate, Pipe Underdrain Aggregate, Pipe Underdrain, Edge Underdrain and Outlet Pipe shall conform to City of Lee's Summit Specifications.
5. Overlap geotextile at top of trench a minimum of 12".

NOT AS-BUILT

[illegible]


[illegible]

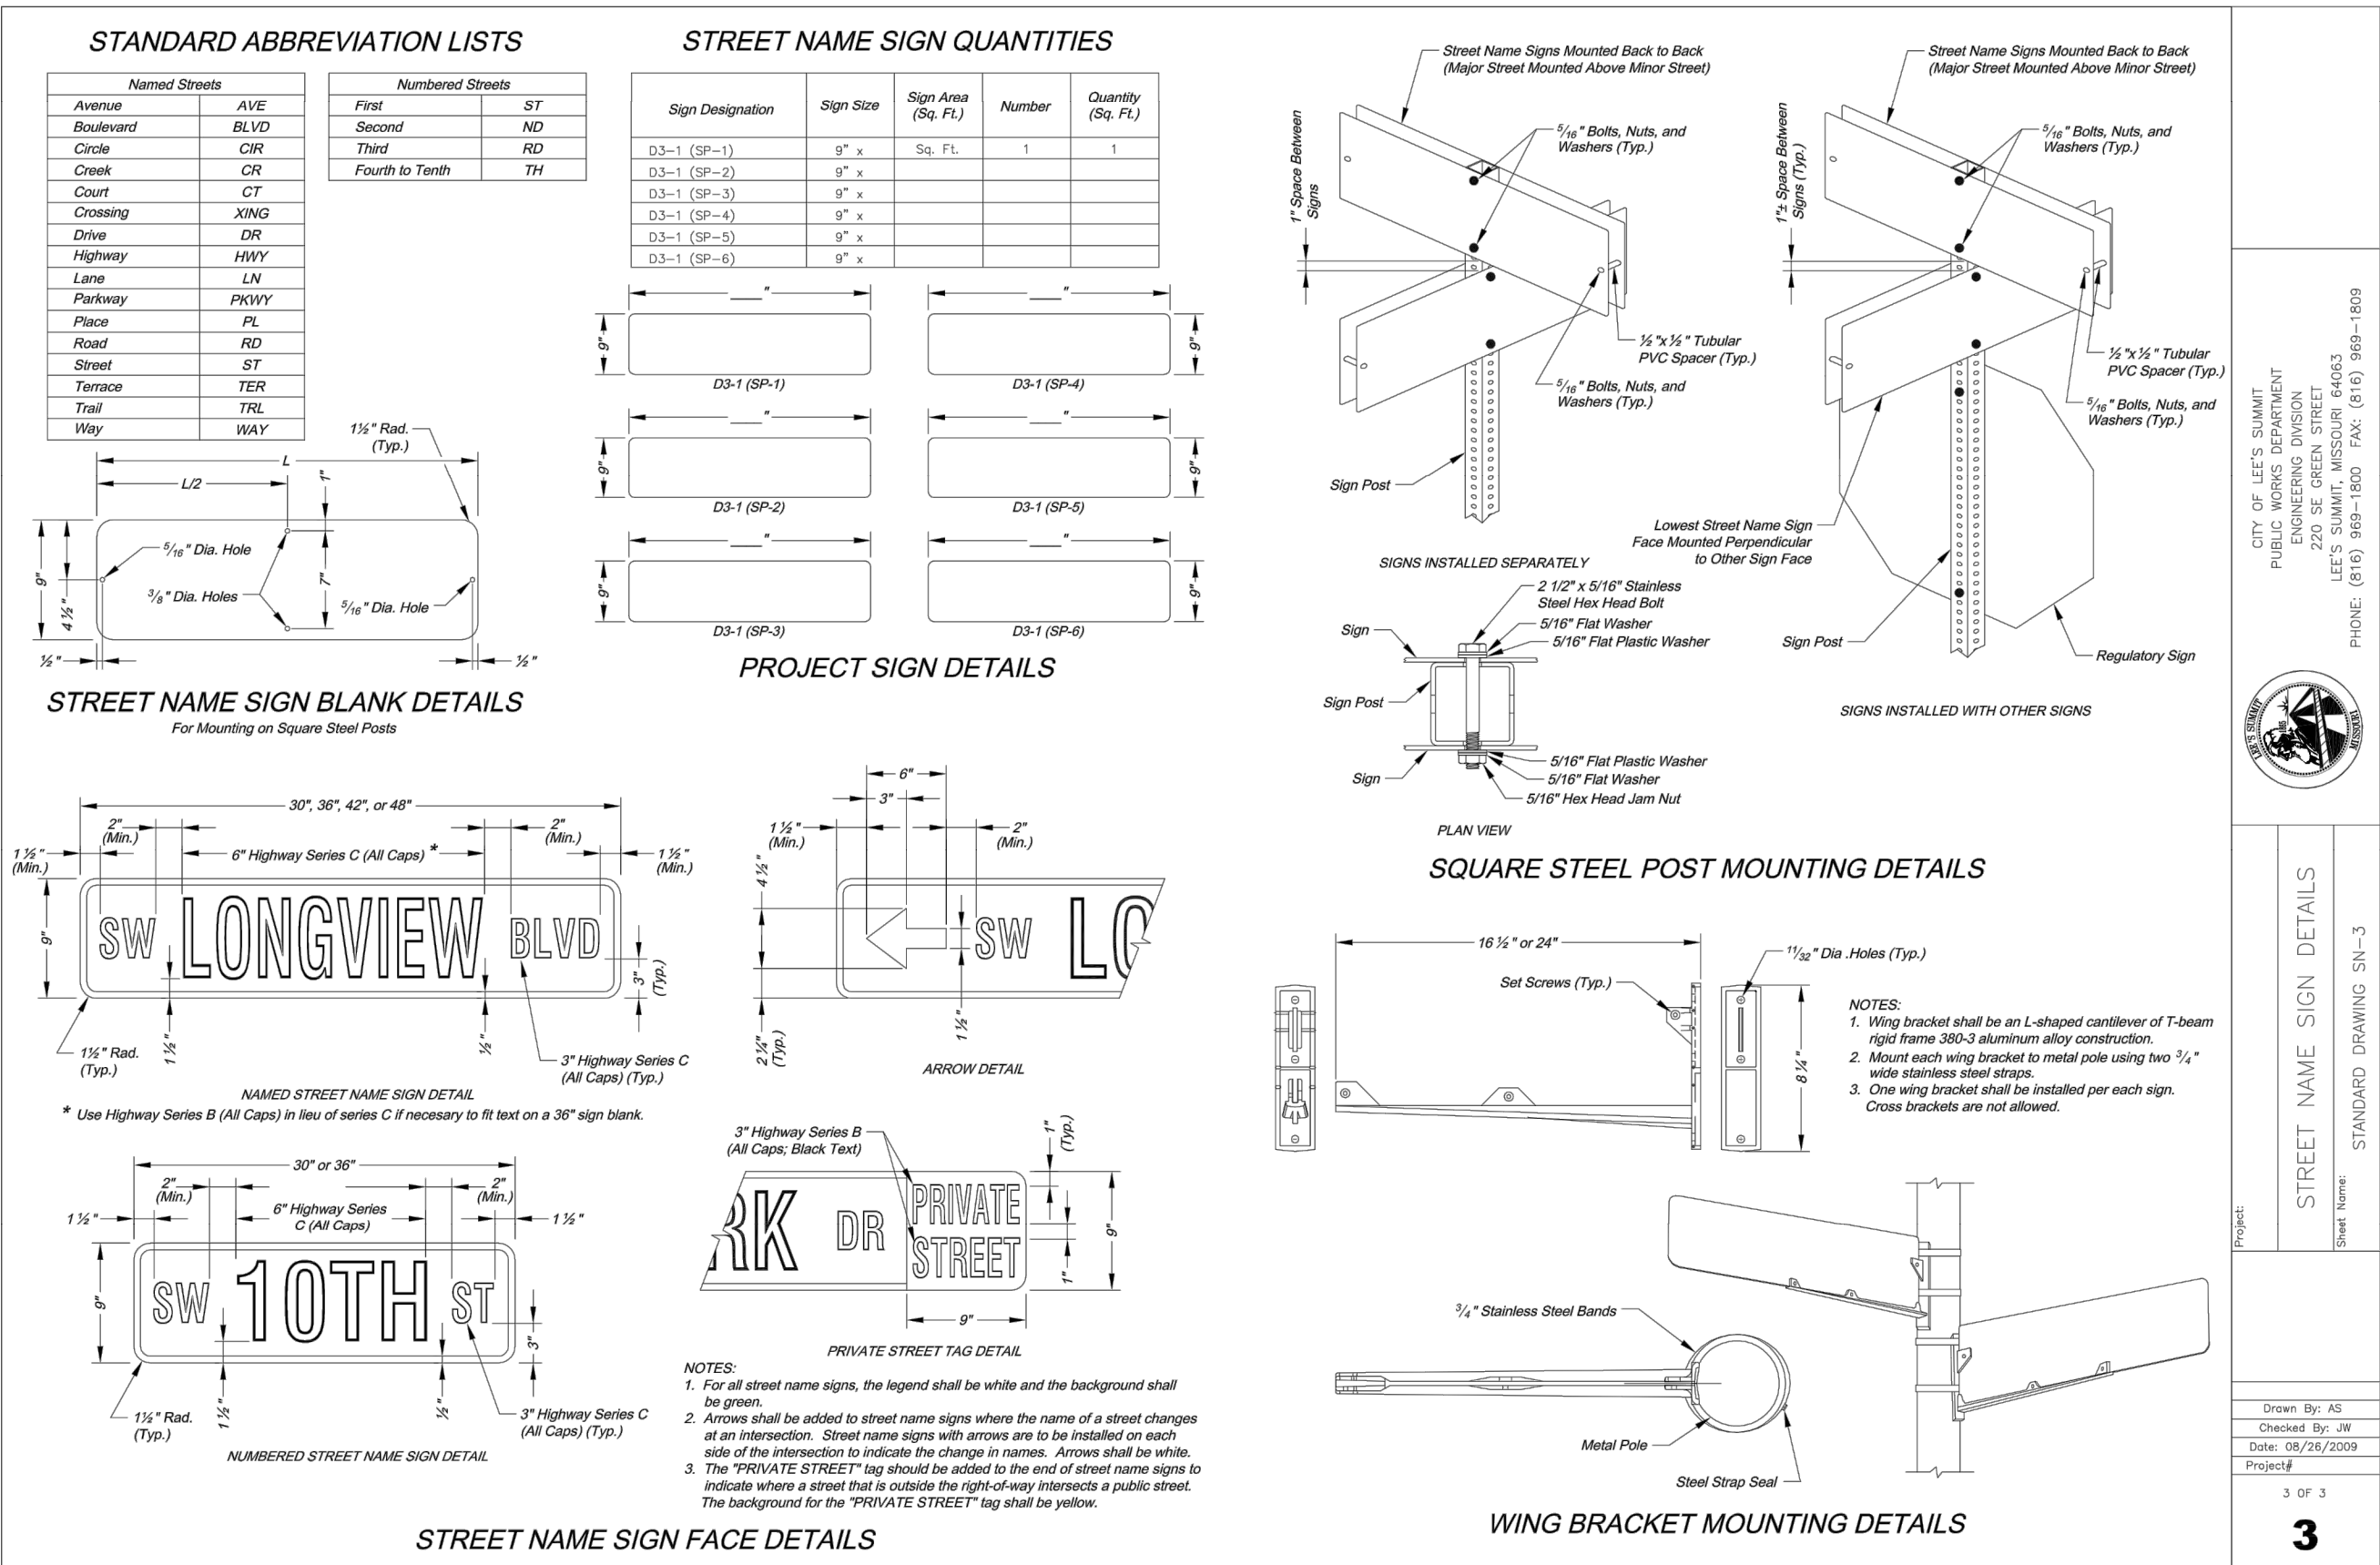

CITY OF LEE'S SUMMIT
PUBLIC WORKS DEPARTMENT
ENGINEERING DIVISION
LEE'S SUMMIT, MISSOURI 64083
PHONE: (816) 389-1850 FAX: (816) 389-1859

STREET NAME SIGN DETAILS
Sheet Name: STANDARD DRAWING SN-3
1 OF 3


Drawn By: AS
Checked By: JW
Date: 05/24/2020
Project:

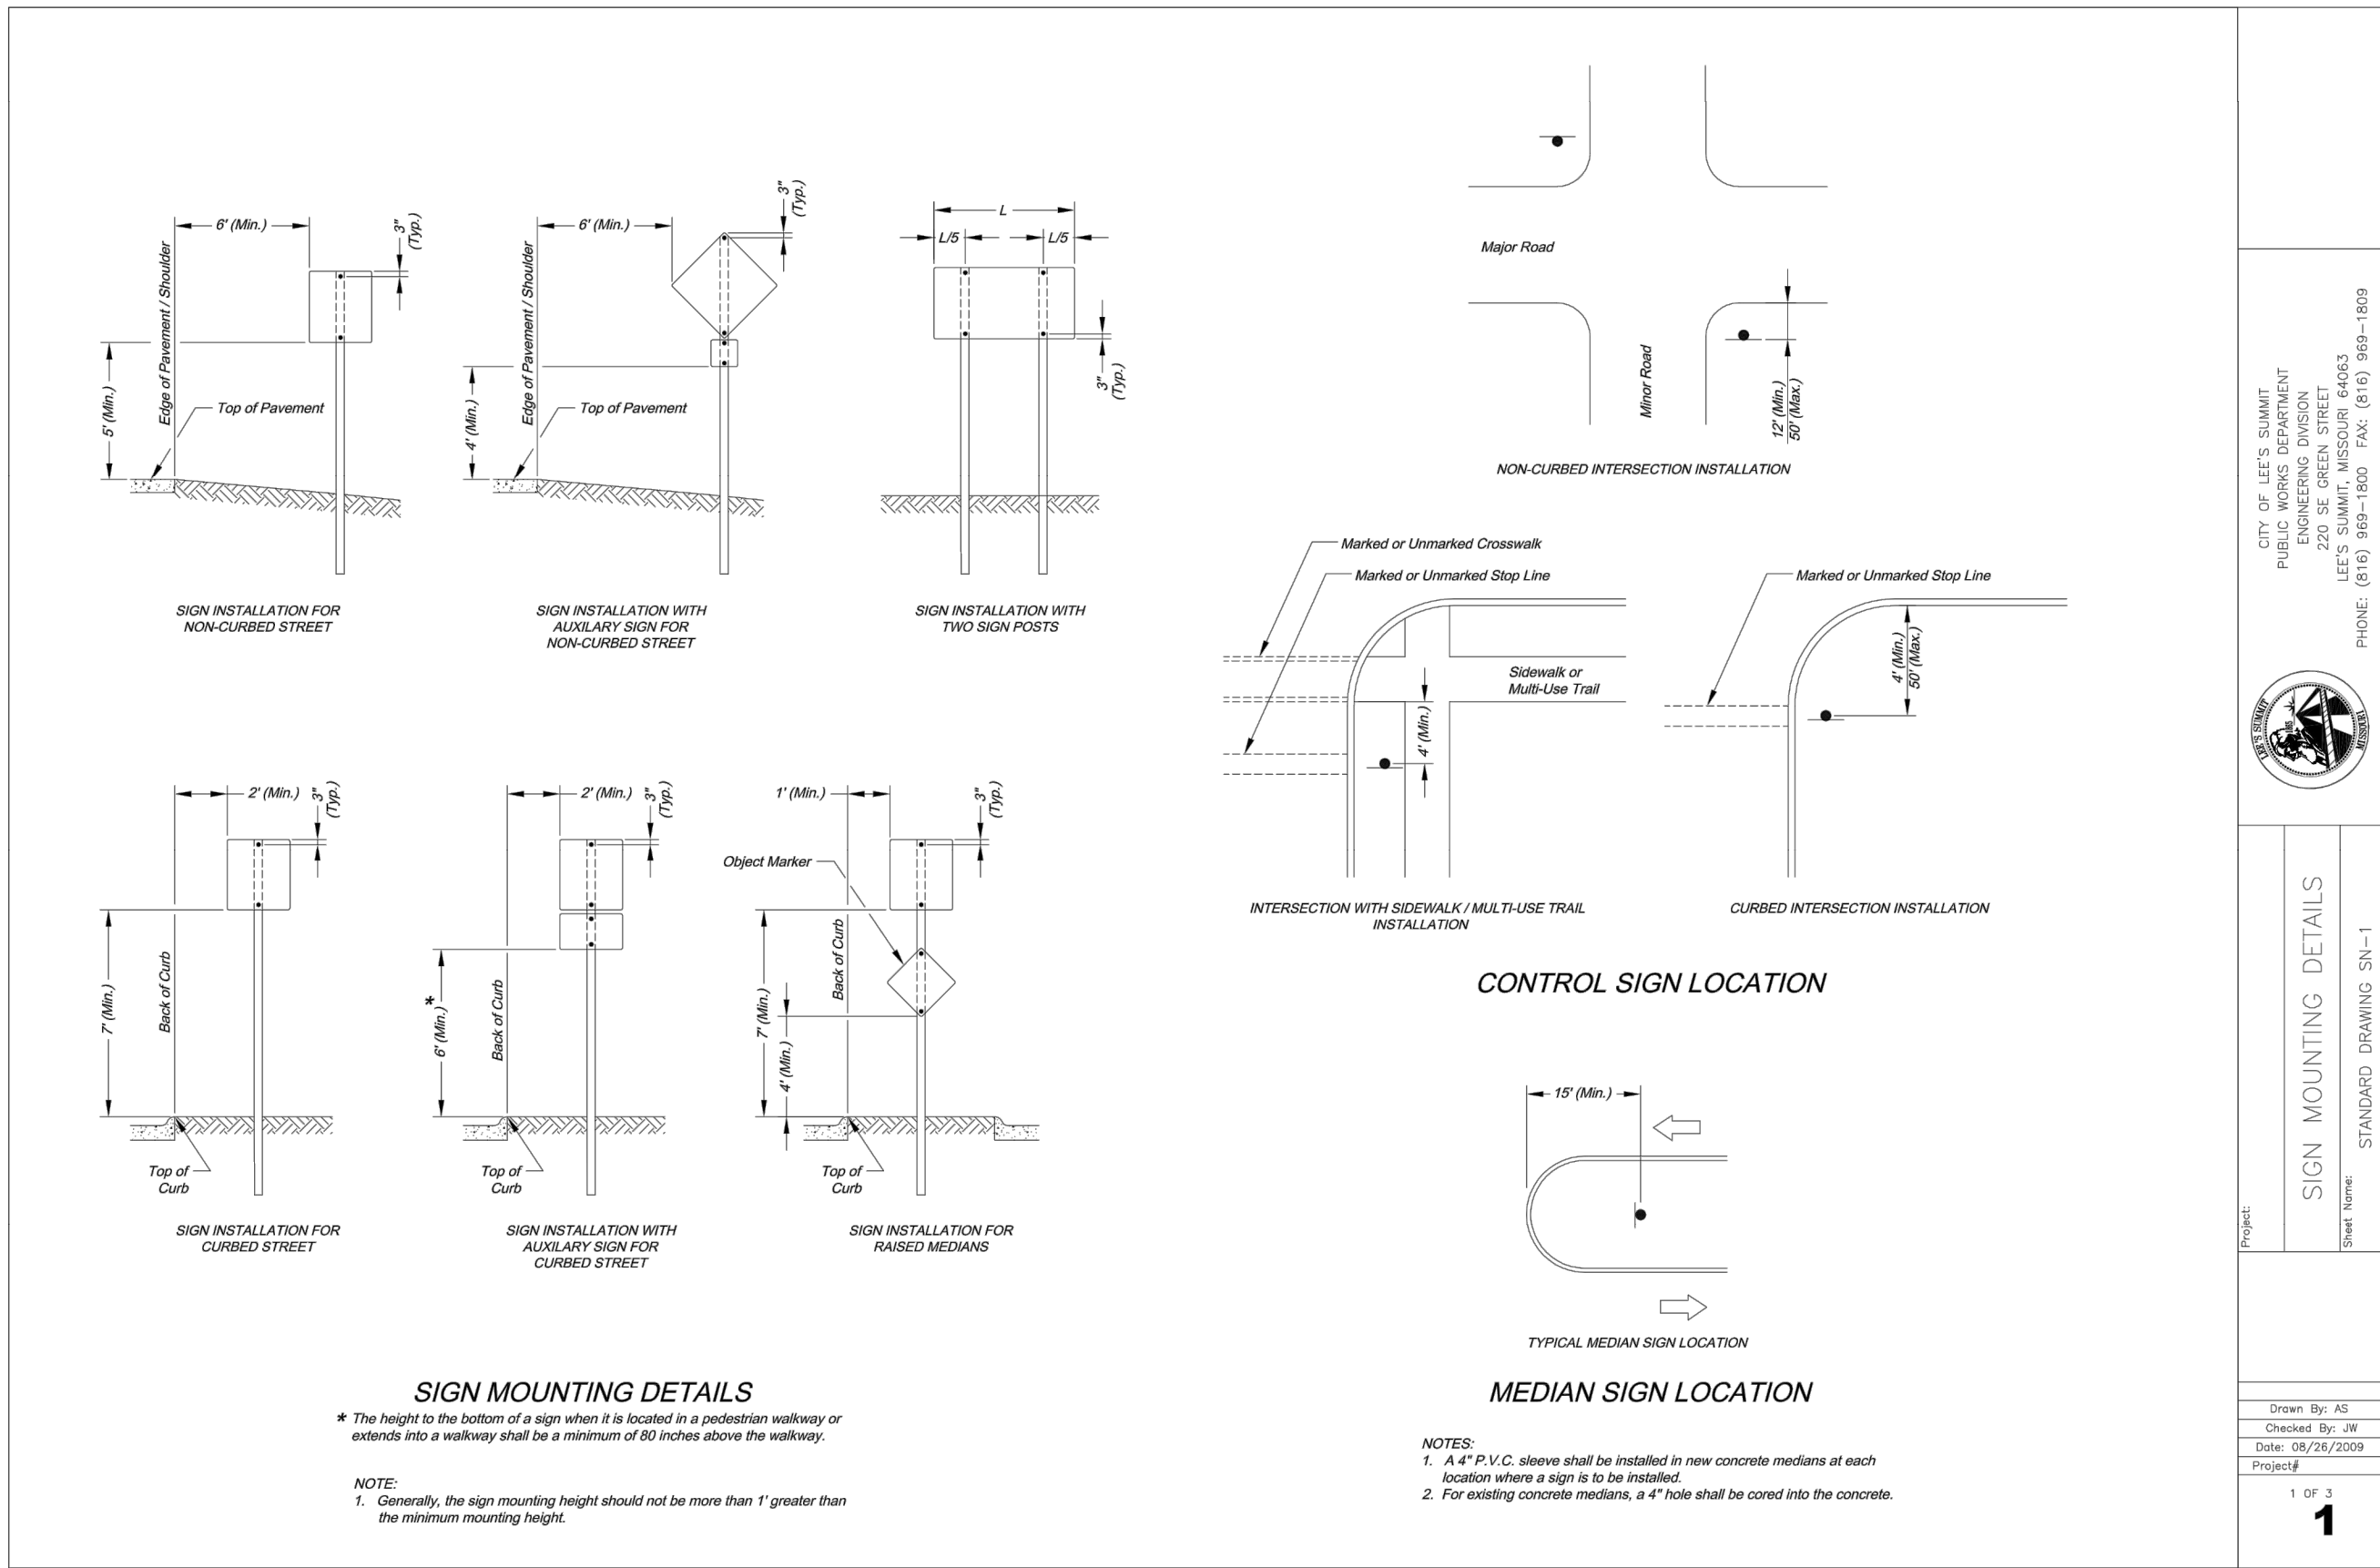

CITY OF LEE'S SUMMIT
PUBLIC WORKS DEPARTMENT
ENGINEERING DIVISION
LEE'S SUMMIT, MISSOURI 64083
PHONE: (816) 389-1850 FAX: (816) 389-1859

SIGN MOUNTING DETAILS
Sheet Name: STANDARD DRAWING SN-1
1 OF 3

Drawn By: AS
Checked By: JW
Date: 05/24/2020
Project:

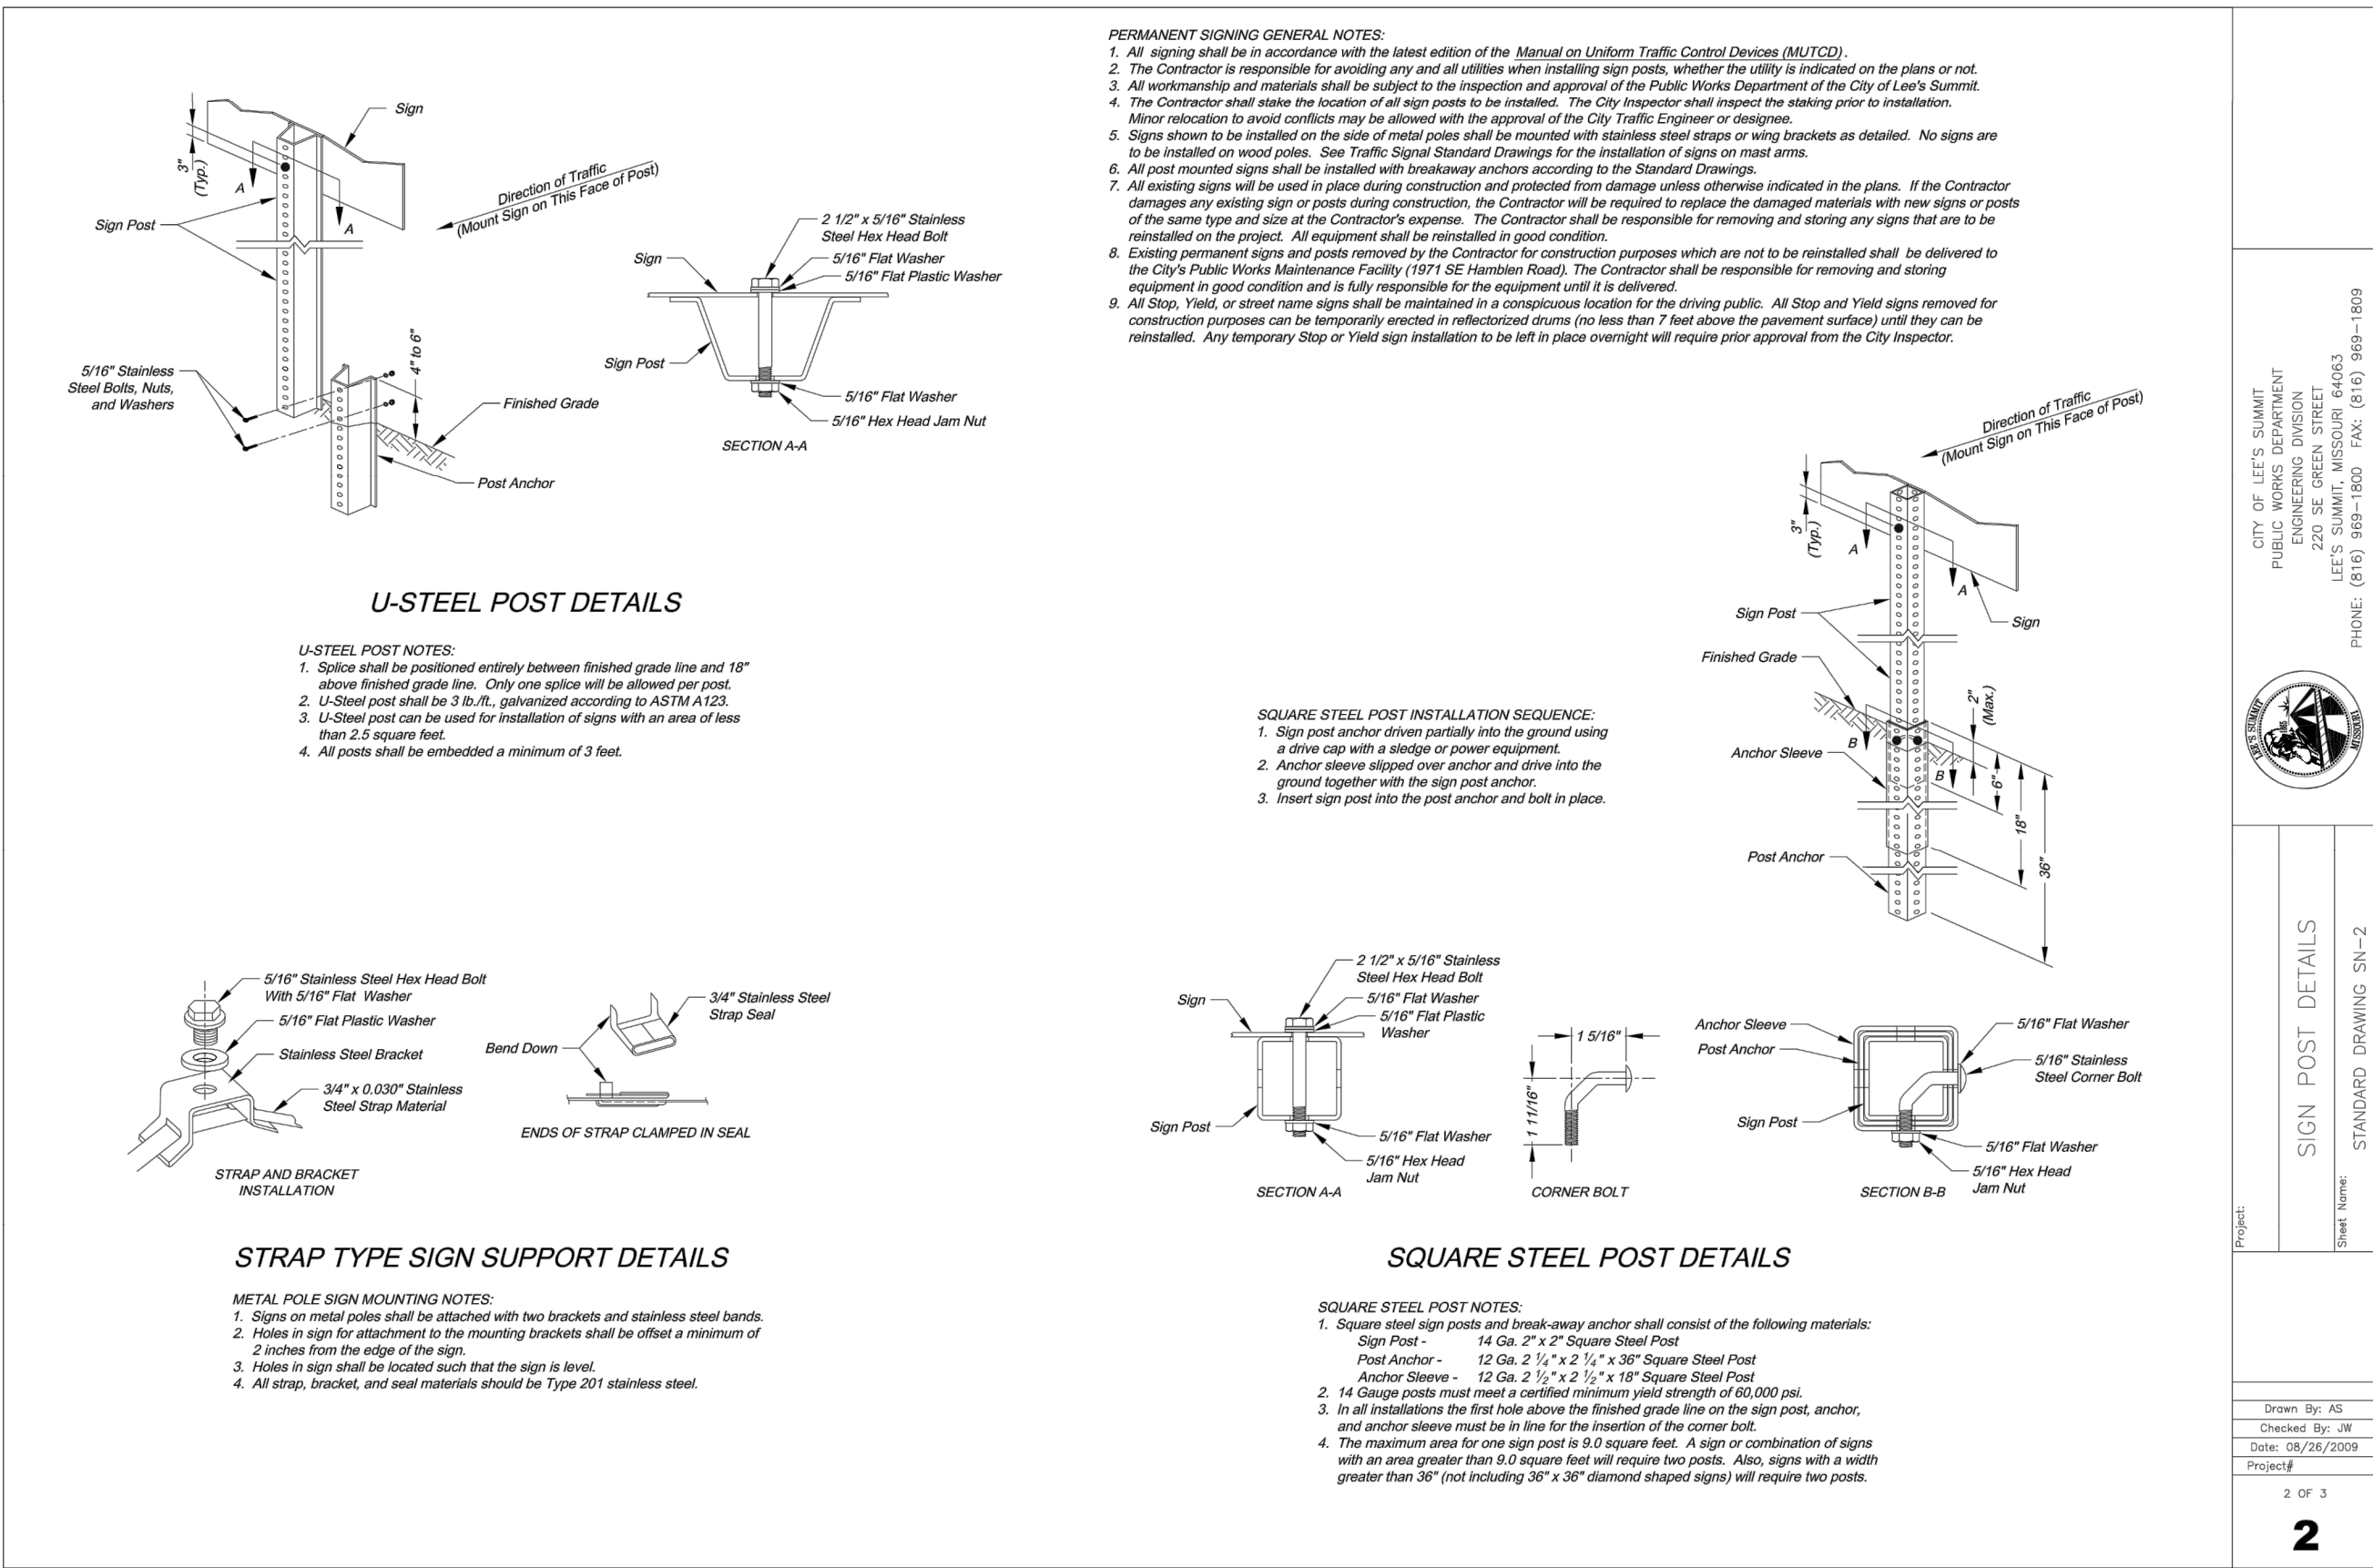

CITY OF LEE'S SUMMIT
PUBLIC WORKS DEPARTMENT
ENGINEERING DIVISION
LEE'S SUMMIT, MISSOURI 64083
PHONE: (816) 389-1850 FAX: (816) 389-1859


SIGN POST DETAILS
Sheet Name: STANDARD DRAWING SN-2
2 OF 3

Drawn By: AS
Checked By: JW
Date: 05/24/2020
Project:

NOT AS-BUILT

STORM MANHOLE NOTES

- ALL MANHOLES ARE TO BE PRECAST CONCRETE AND OF ECCENTRIC CONE TYPE UNLESS OTHERWISE SPECIFIED.
- MANHOLE TOP ADJUSTMENTS SHALL BE ACCOMPLISHED BY THE USE OF CONCRETE ADJUSTMENT RINGS.
- TOP OF MANHOLE CASTING SHALL BE SET FLUSH AND ON SAME SLOPE AS FINISHED SURFACE OR AS DIRECTED BY THE ENGINEER.
- THE ENGINEER SHALL DESIGNATE MODIFICATIONS FOR MANHOLES WITH SPECIAL DESIGNS.
- THE INSIDE DIAMETER OF THE MANHOLE SHALL BE 4'-0" FOR PIPE DIAMETERS FROM 12" THRU 24", 5'-0" FOR PIPE DIAMETERS FROM 27" THRU 36", AND 6'-0" FOR PIPE DIAMETERS 42" THRU 48".
- CLEARANCE TOLERANCE OF PIPE OPENINGS: THE MAXIMUM ALLOWABLE PIPE OPENING ON A HORIZONTAL AXIS SHALL BE THE OUTSIDE DIAMETER OF THE PIPE PLUS 12". THE MAXIMUM ALLOWABLE PIPE OPENING ON VERTICAL AXIS SHALL BE THE OUTSIDE DIAMETER PLUS 8". THE MAXIMUM CLEARANCE BETWEEN THE OUTSIDE SURFACE OF AN INSTALLED PIPE AND THE CONCRETE OF THE MANHOLE SHALL BE 2".
- INSTALLATION OF PIPE OPENINGS: ALL REQUIRED PIPE OPENINGS SHALL BE PLANT CAST IN MANHOLE UNITS. FIELD ALTERATIONS OF OPENINGS WILL BE PERMITTED PROVIDED WALLS ARE SCORED WITH A MASONRY SAW TO A DEPTH SUFFICIENT TO SEVER REINFORCING STEEL. A CHIPPING HAMMER MAY THEN BE USED TO REMOVE THE CONCRETE. MINIMUM DISTANCE BETWEEN ANY TWO ADJACENT PIPES SHALL BE 2".
- NO DIRECT PAYMENT FOR SHAPING FLOOR OR CONNECTING PIPES AS SHOWN ON PLANS.
- RING AND COVER TO BE NEENAH R-1736, CLAY & BAILEY #2008, DEETER # 1316, OR APPROVED EQUAL. (CASTING MAY VARY BY MUNICIPALITY, REFER TO PLANS & CONTRACT DOCUMENTS.)

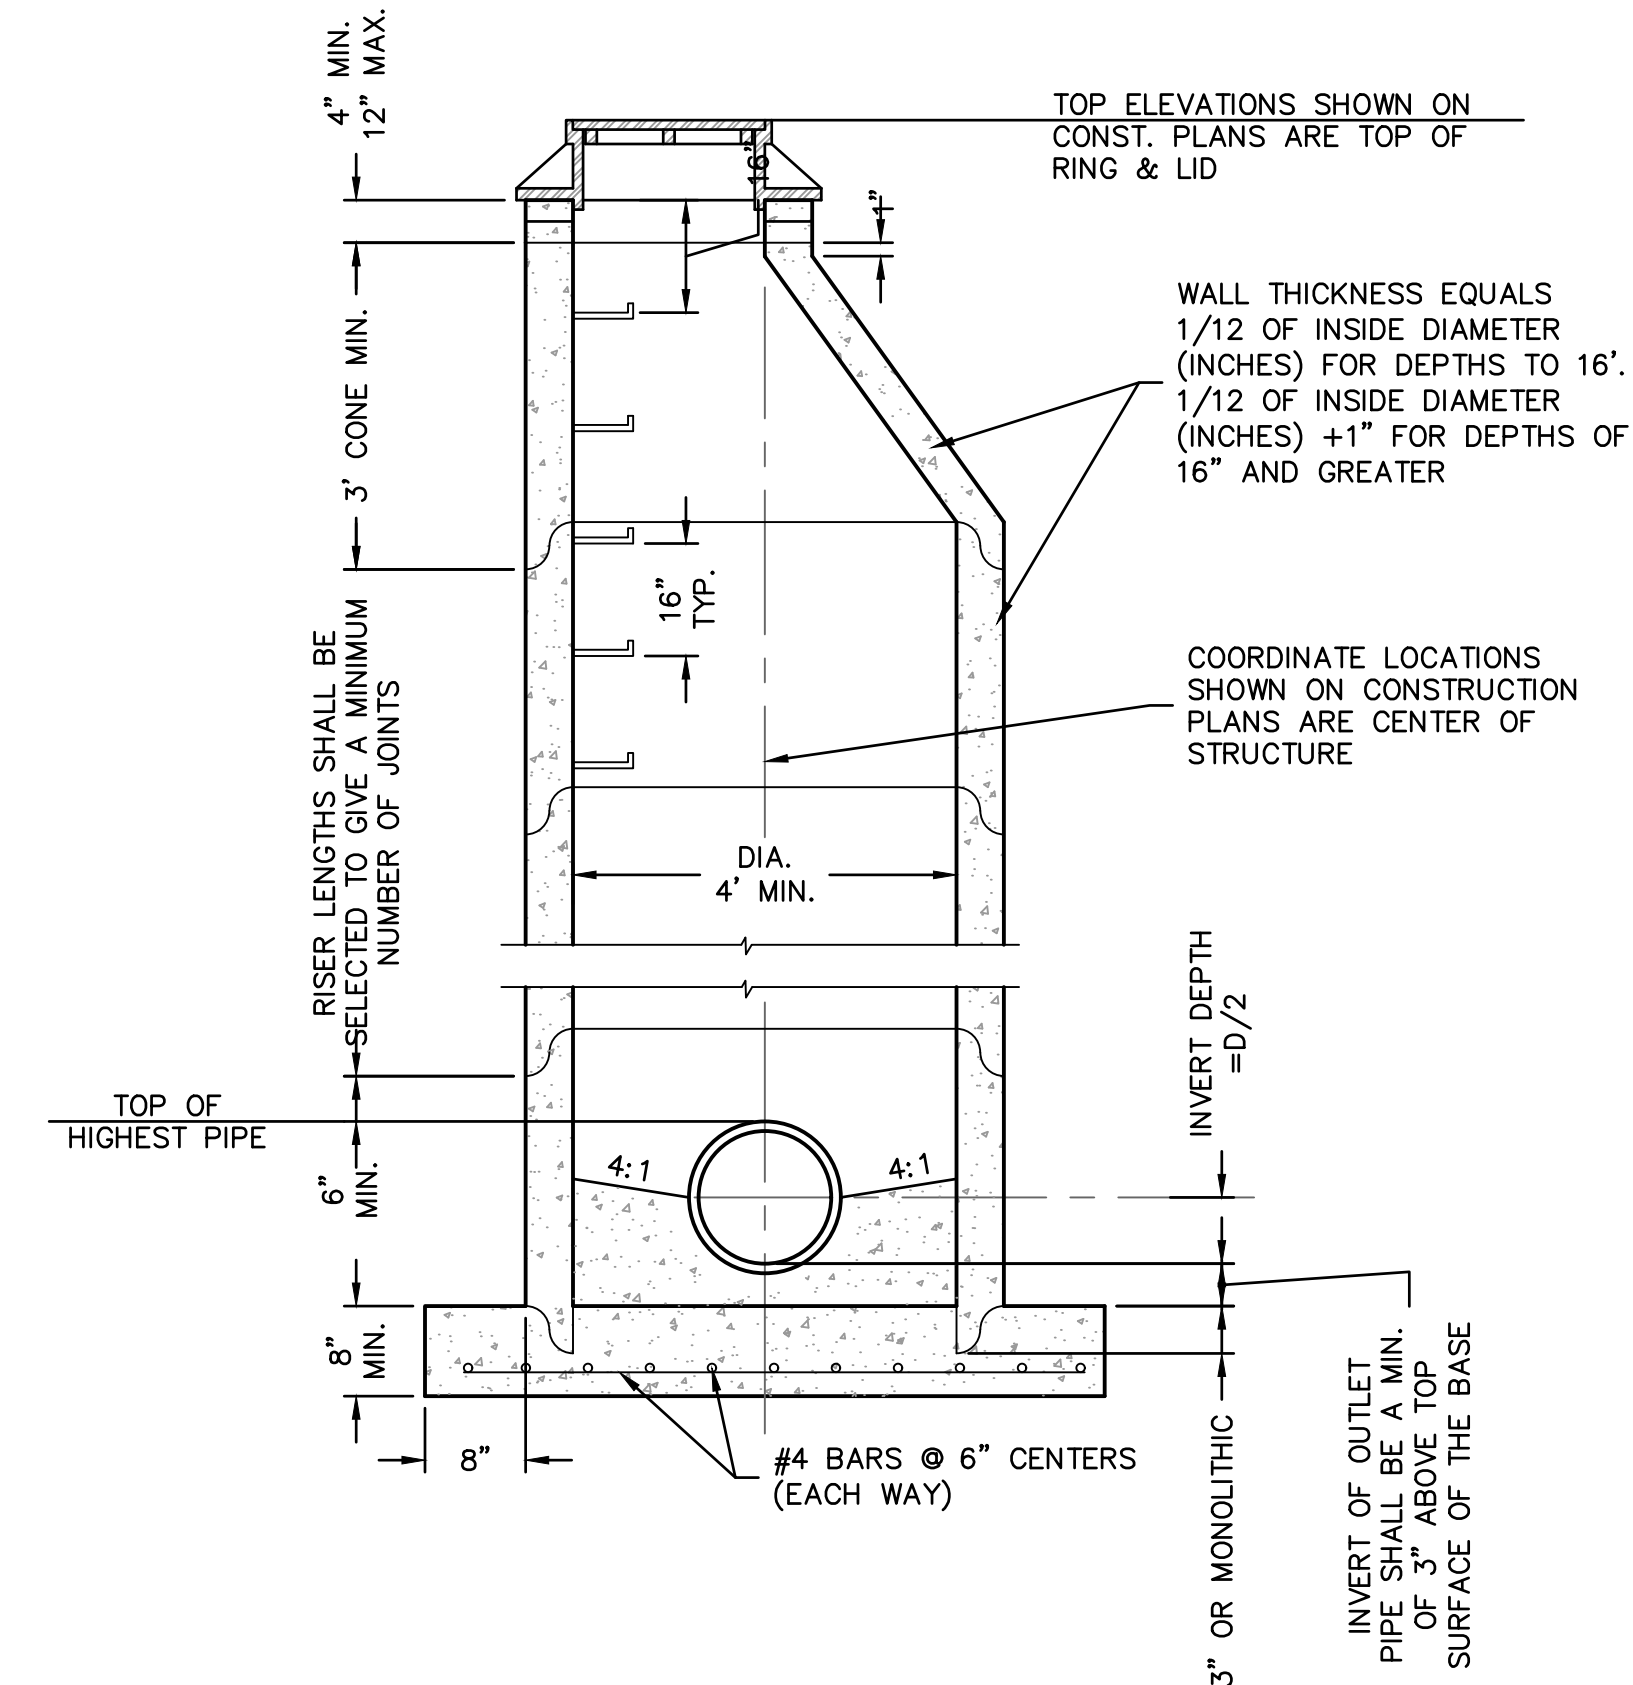

olsson
Olsson - Civil Engineering
Missouri Certificate of Authority #001592
1301 Burlington Street
North Kansas City MO 64116
TEL 816.361.1177
FAX 816.361.1888
www.olsson.com

JULIE ELAINE SELLERS
Professional Engineer
NUMBER PE-2017000367
11/28/22

REVISIONS

REV. NO.	DATE	REVISIONS DESCRIPTION
1	03-23-2021	REVISED PER CITY COMMENTS
2	04-16-2021	CHANGES TO APPROVED PLANS
3	09-30-2021	

DETAIL SHEET
STREET & STORM SEWER PLANS
HOOK FARMS
SECOND PLAT
LEE'S SUMMIT, MO

drawn by: B.M.W./A.A.
checked by: B.M.W./
designed by: B.M.W./A.A.
QA/QC by: J.E.S.
project no.: B19-4061
date: 01-08-2021

SHEET C150