
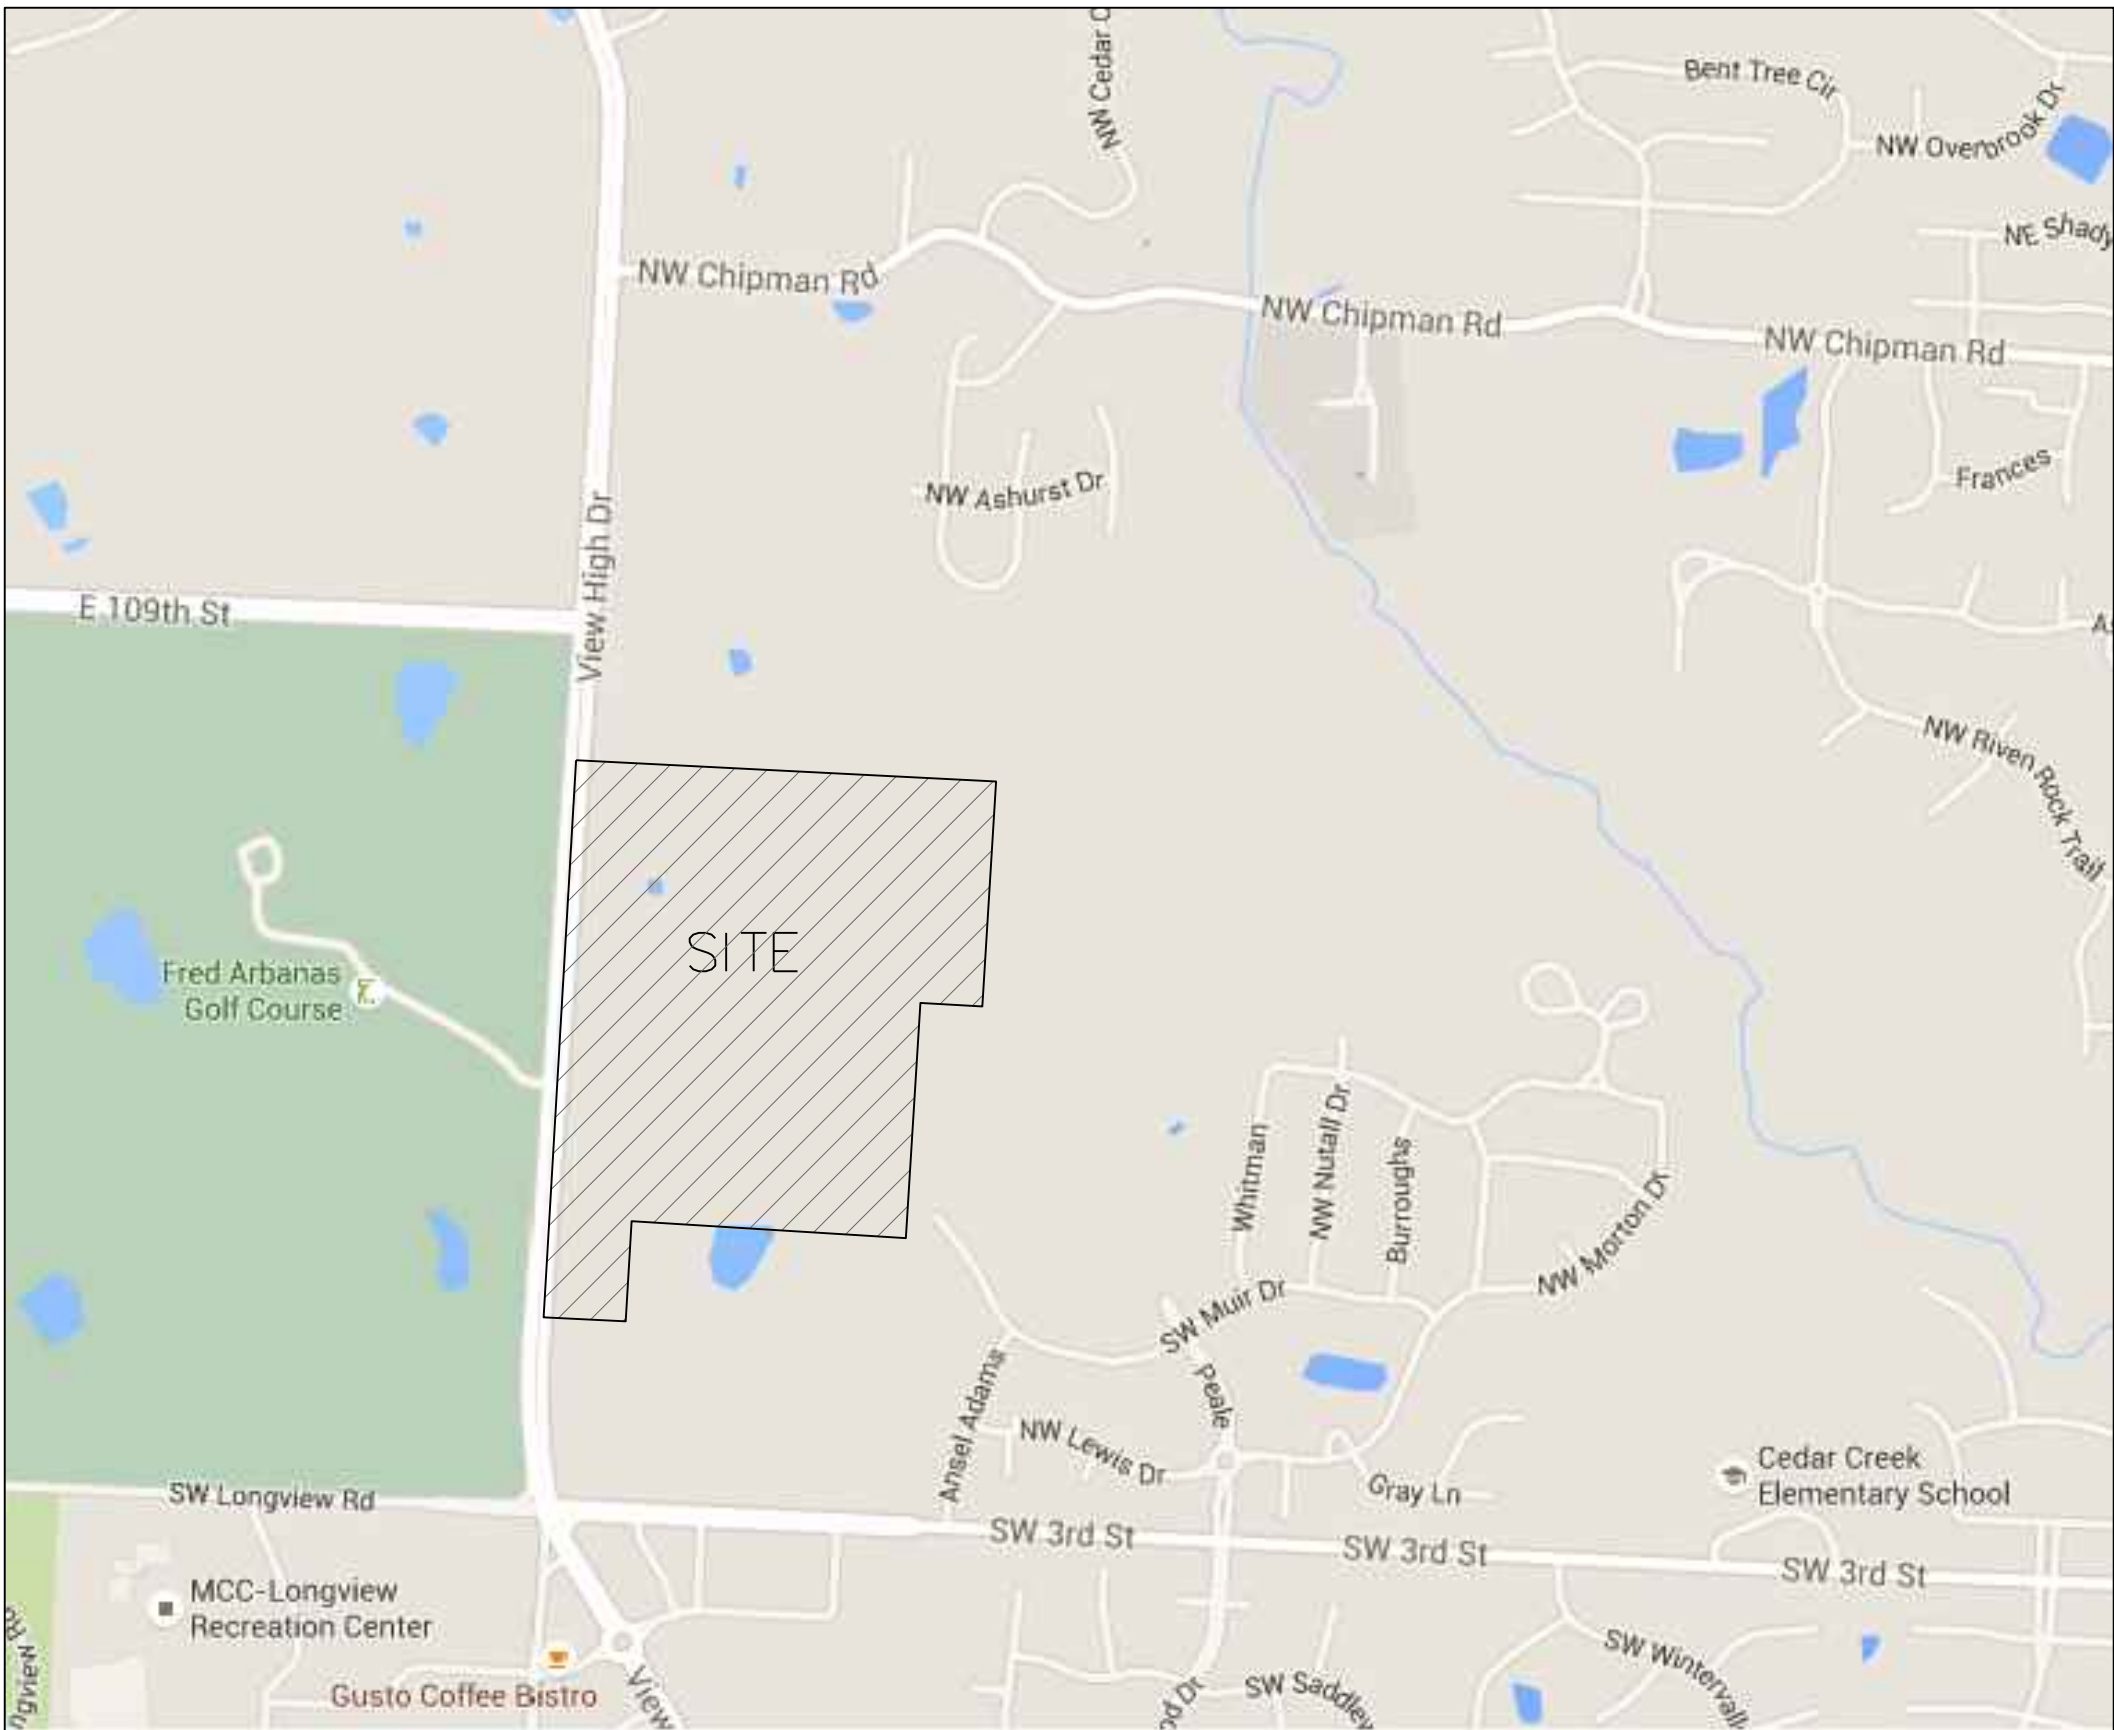


Village at View High  
ON-SITE SANITARY SEWER CONSTRUCTION PLANS  
PART OF THE NW 1/4, SECTION 03-T.47-R.32  
LEE'S SUMMIT, JACKSON COUNTY, MISSOURI

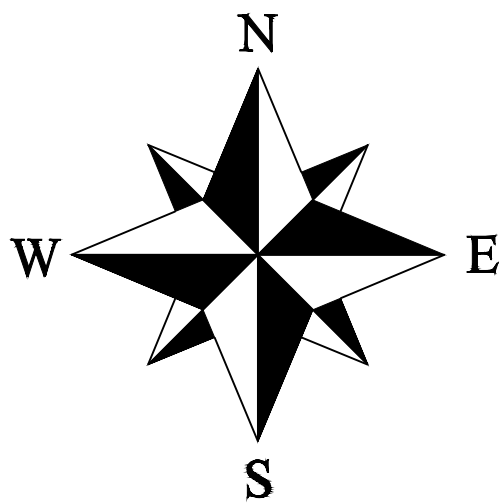

SITE LOCATION MAP

GENERAL NOTE:  
1 ~ ALL CONSTRUCTION SHALL CONFORM TO THE CITY OF LEE'S SUMMIT DESIGN AND CONSTRUCTION MANUAL AS ADOPTED BY ORDINANCE 5813.  
2 ~ TRENCH CHECKS SHALL BE INSTALL AT ALL SANITARY WYES LOCATION.  
3 ~ ALL SANITARY LINES SHALL BE INSTALL WITH TRACER WIRE.

Record Drawing

UTILITY COMPANIES:

THE FOLLOWING LIST OF UTILITY COMPANIES IS PROVIDED FOR INFORMATION ONLY. WE DO NOT OFFER ANY GUARANTEE OR WARRANTY THAT THIS LIST IS COMPLETE OR ACCURATE. THE CONTRACTOR SHALL BE RESPONSIBLE FOR CONTACTING ALL UTILITY COMPANIES THAT MAY BE AFFECTED BY THE PROPOSED CONSTRUCTION AND VERIFYING THE ACTUAL LOCATION OF EACH UTILITY LINE. THE CONTRACTOR SHALL NOTIFY ENGINEERING SOLUTIONS AT 816.623.9888 OF ANY CONFLICT WITH PROPOSED IMPROVEMENTS.  
KCP&L ~ 298-1196  
MISSOURI GAS ENERGY ~ 756-5261  
SOUTHWESTERN BELL TELEPHONE ~ 761-5011  
COMCAST CABLE ~ 795-1100  
WILLIAMS PIPELINE ~ 422-6300  
CITY OF LEE'S SUMMIT PUBLIC WORKS ~ 969-1800  
CITY OF LEE'S SUMMIT PUBLIC WORKS INSPECTIONS ~ 969-1800  
CITY OF LEE'S SUMMIT WATER UTILITIES ~ 969-1900  
MISSOURI ONE CALL (DIG RITE) ~ 1-800-344-7483

INDEX OF SHEETS:

- C.400 ~ COVER SHEET
- C.401 ~ SANITARY SEWER GENERAL LAYOUT
- C.402 ~ SANITARY LINE PLAN & PROFILE
- C.403 ~ SANITARY LINE PLAN & PROFILE
- C.404 ~ SANITARY LINE PLAN & PROFILE
- C.405 ~ SANITARY DETAILS

LEGEND:

- B/L ~ BUILDING SET-BACK
- C/A ~ COMMON AREA
- D/E ~ DRAINAGE EASEMENT
- FND. ~ FOUND
- L/E ~ LANDSCAPE EASEMENT
- L.N.A. ~ LIMITS OF NO ACCESS
- R/W ~ RIGHT OF WAY
- SAN ~ SANITARY SEWER LINE
- S/W ~ SIDEWALK
- U/E ~ UTILITY EASEMENT
- W ~ WATER LINE
- ST ~ STORM SEWER LINE

ENGINEER'S CERTIFICATION:

I HEREBY CERTIFY THAT THIS PROJECT HAS BEEN DESIGNED AND THESE PLANS PREPARED IN ACCORDANCE WITH THE CURRENT DESIGN CRITERIA OF THE CITY OF LEE'S SUMMIT, MISSOURI AND THE STATE OF MISSOURI. I FURTHER CERTIFY THAT THESE PLANS WERE DESIGNED IN ACCORDANCE TO AASHTO STANDARDS.

CITY OF LEE'S SUMMIT, MISSOURI

APPROVED: DATE: \_\_\_\_\_

BY: \_\_\_\_\_  
CITY ENGINEER

CONSTRUCTION AND DESIGN NOTES:

- SANITARY SEWERS:**
- SANITARY SEWER PIPE SHALL BE POLY VINYL CHLORIDE (PVC), SDR-26, UNLESS NOTED OTHERWISE IN THESE PLANS.
  - HOUSE SEWER LATERALS SHALL BE 4 INCH PVC, SDR-26. LATERALS SHALL BE CONSTRUCTED USING A TOP ORIENTED "WYE" AT THE SEWER STATION. SHOWN IN THESE PLANS. LATERALS SHALL BE LAID AT A GRADE OF 2.0% FROM THE SEWER MAIN TO THE STREET RIGHT-OF-WAY LINE OR EASEMENT LINE AS REPRESENTED BY THE LATERAL LENGTH SHOWN IN THESE PLANS. THE ELEVATION SHOWN FOR THE END OF THE LATERAL IN THESE PLANS IS APPROXIMATE. THE ACTUAL ELEVATION SHALL BE DETERMINED BY THE FLOW LINE ELEVATION OF THE SEWER MAIN, THE FITTINGS AND GRADE OF THE SEWER LATERAL.
  - THE CONTRACTOR SHALL MAINTAIN A LOG OF THE "AS BUILT" STATION AND LENGTH OF EACH HOUSE LATERAL AND SHALL PROVIDE ENGINEERING SOLUTIONS, L.L.C. WITH A COPY OF SAID LOG UPON COMPLETION OF SEWER CONSTRUCTION.
  - ALL MANHOLES INSTALLED IN THE STREET RIGHT-OF-WAY SHALL BE FINISHED 1/2" PER FOOT ABOVE THE NEAREST ADJACENT BACK OF CURB
  - A STAKE SHALL BE PLACED AT THE END OF EACH WYE CONNECTION WITH THE END ELEVATION WRITTEN ON THE STAKE
  - FILL AREAS SHALL HAVE 3 FEET OF COMPACTED FILL IN PLACE PRIOR TO TRENCHING
  - A TRENCH CHECK CONSISTING OF FLOWABLE FILL MUST BE INSTALLED ON EVERY PRIVATE LATERAL.

"AS-BUILT"

900.10  
~~900.00~~ Indicates data replaced with "As-Built" information. All other data is as designed and has not been field verified.


Cover Sheet  
Construction Plans for:  
Village at View High  
Lee's Summit, Jackson County, Missouri

Project: View High Project  
Issue Date: November 22, 2019

Matthew J. Schlicht  
MO PE 2006019708  
KS PE 19071  
OK PE 25226

REVISIONS  
11/22/19 As-Built




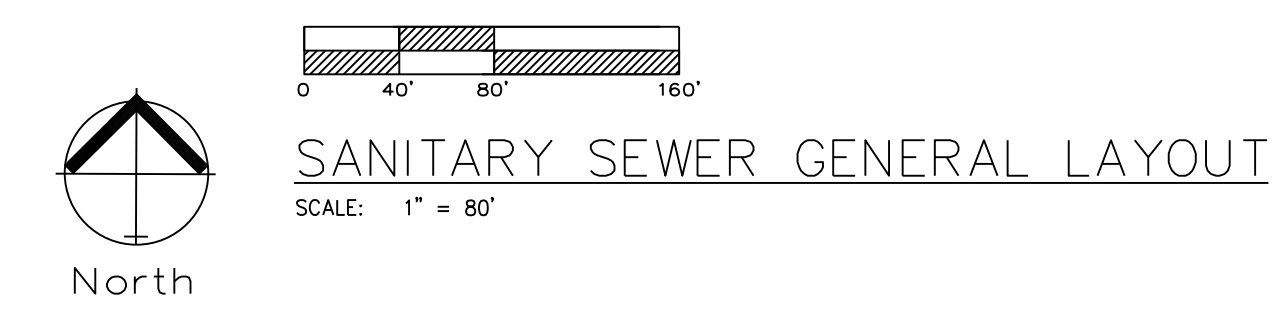

## Record Drawing

C.401



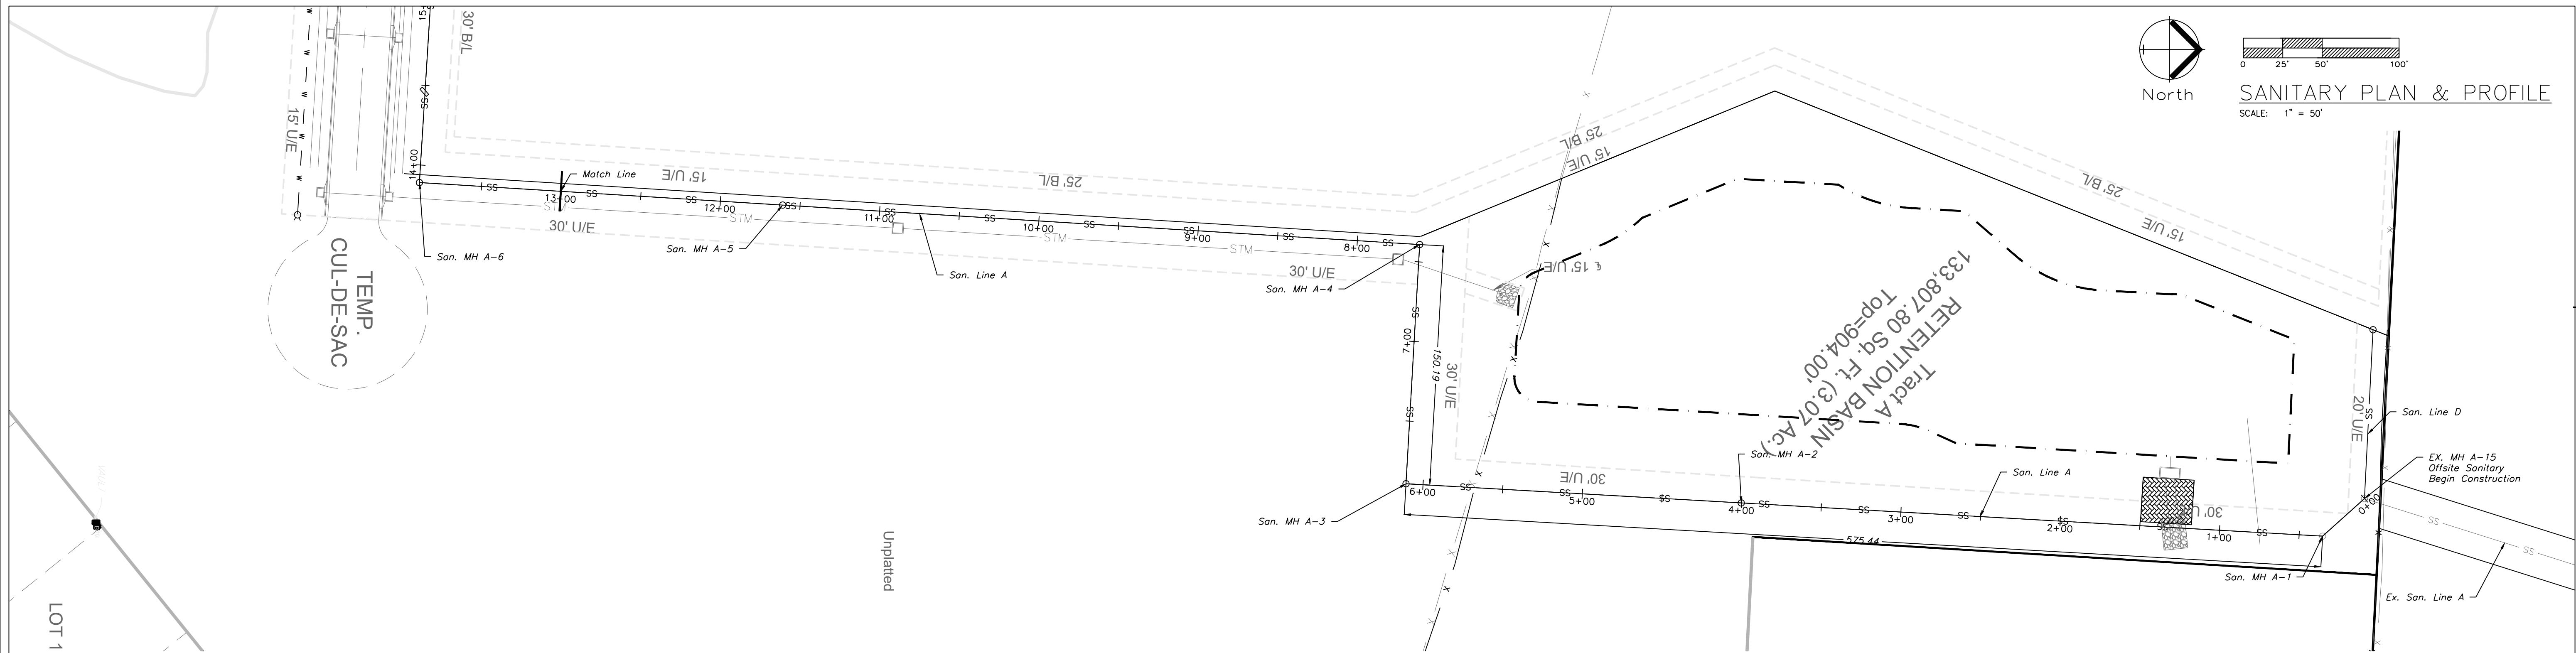

GENERAL NOTE:


- 1 ~ ALL CONSTRUCTION SHALL CONFORM TO THE CITY OF LEE'S SUMMIT DESIGN AND CONSTRUCTION MANUAL AS ADOPTED BY ORDINANCE 5813.
- 2 ~ TRENCH CHECKS SHALL BE INSTALL AT ALL SANITARY WYES LOCATION.
- 3 ~ ALL SANITARY LINES SHALL BE INSTALL WITH TRACER WIRE.

SANITARY LINE A

Record Drawing

"AS-BUILT"

900.10  
900.00 Indicates data replaced with "As-Built" information. All other data is as designed and has not been field verified.

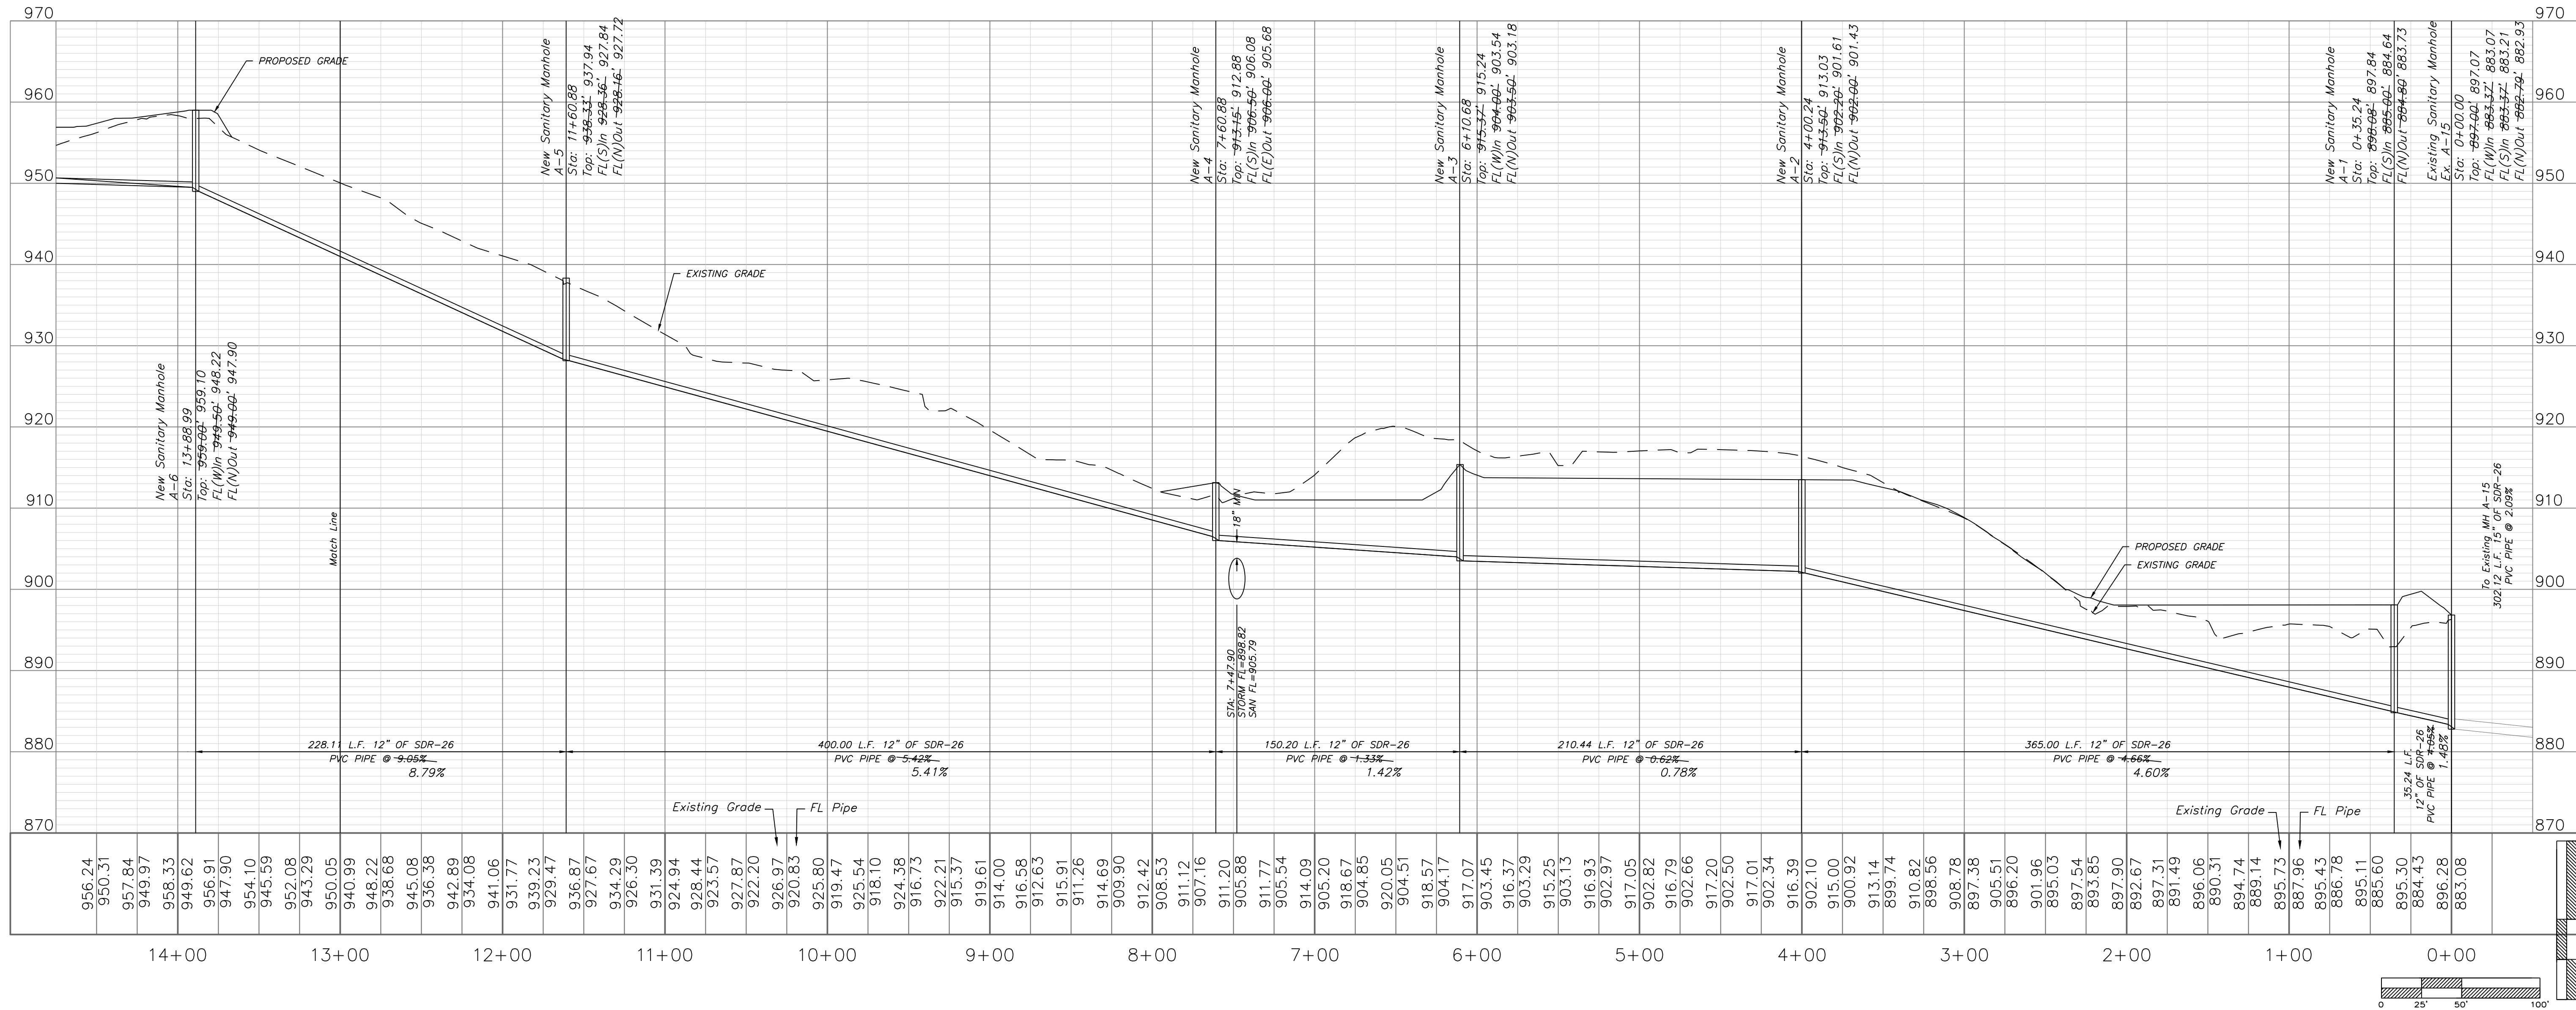

Professional Registration  
Missouri  
Engineering 2005002186-D  
Surveying 2005003192-D  
Kansas  
Engineering E-1895  
Surveying LS-218  
Oklahoma  
Engineering 6254  
Nebraska  
Engineering CA2821

Village At View High  
Lee's Summit, Jackson County, Missouri

Project:  
View High Project

Sanitary Plan and Profile  
Construction Plans for:  
Village at View High  
Lee's Summit, Jackson County, Missouri

Matthew J. Schlicht  
MO PE 2006019708  
KS PE 19071  
OK PE 25326

REVISIONS  
11/22/19 As-Built

11/22/19 As-Built


C.402



GENERAL NOTE:

- 1 ~ ALL CONSTRUCTION SHALL CONFORM TO THE CITY OF LEE'S SUMMIT DESIGN AND CONSTRUCTION MANUAL AS ADOPTED BY ORDINANCE 5813.  
2 ~ TRENCH CHECKS SHALL BE INSTALL AT ALL SANITARY WYES LOCATION.  
3 ~ ALL SANITARY LINES SHALL BE INSTALL WITH TRACER WIRE.


SANITARY LINE A CONT'D

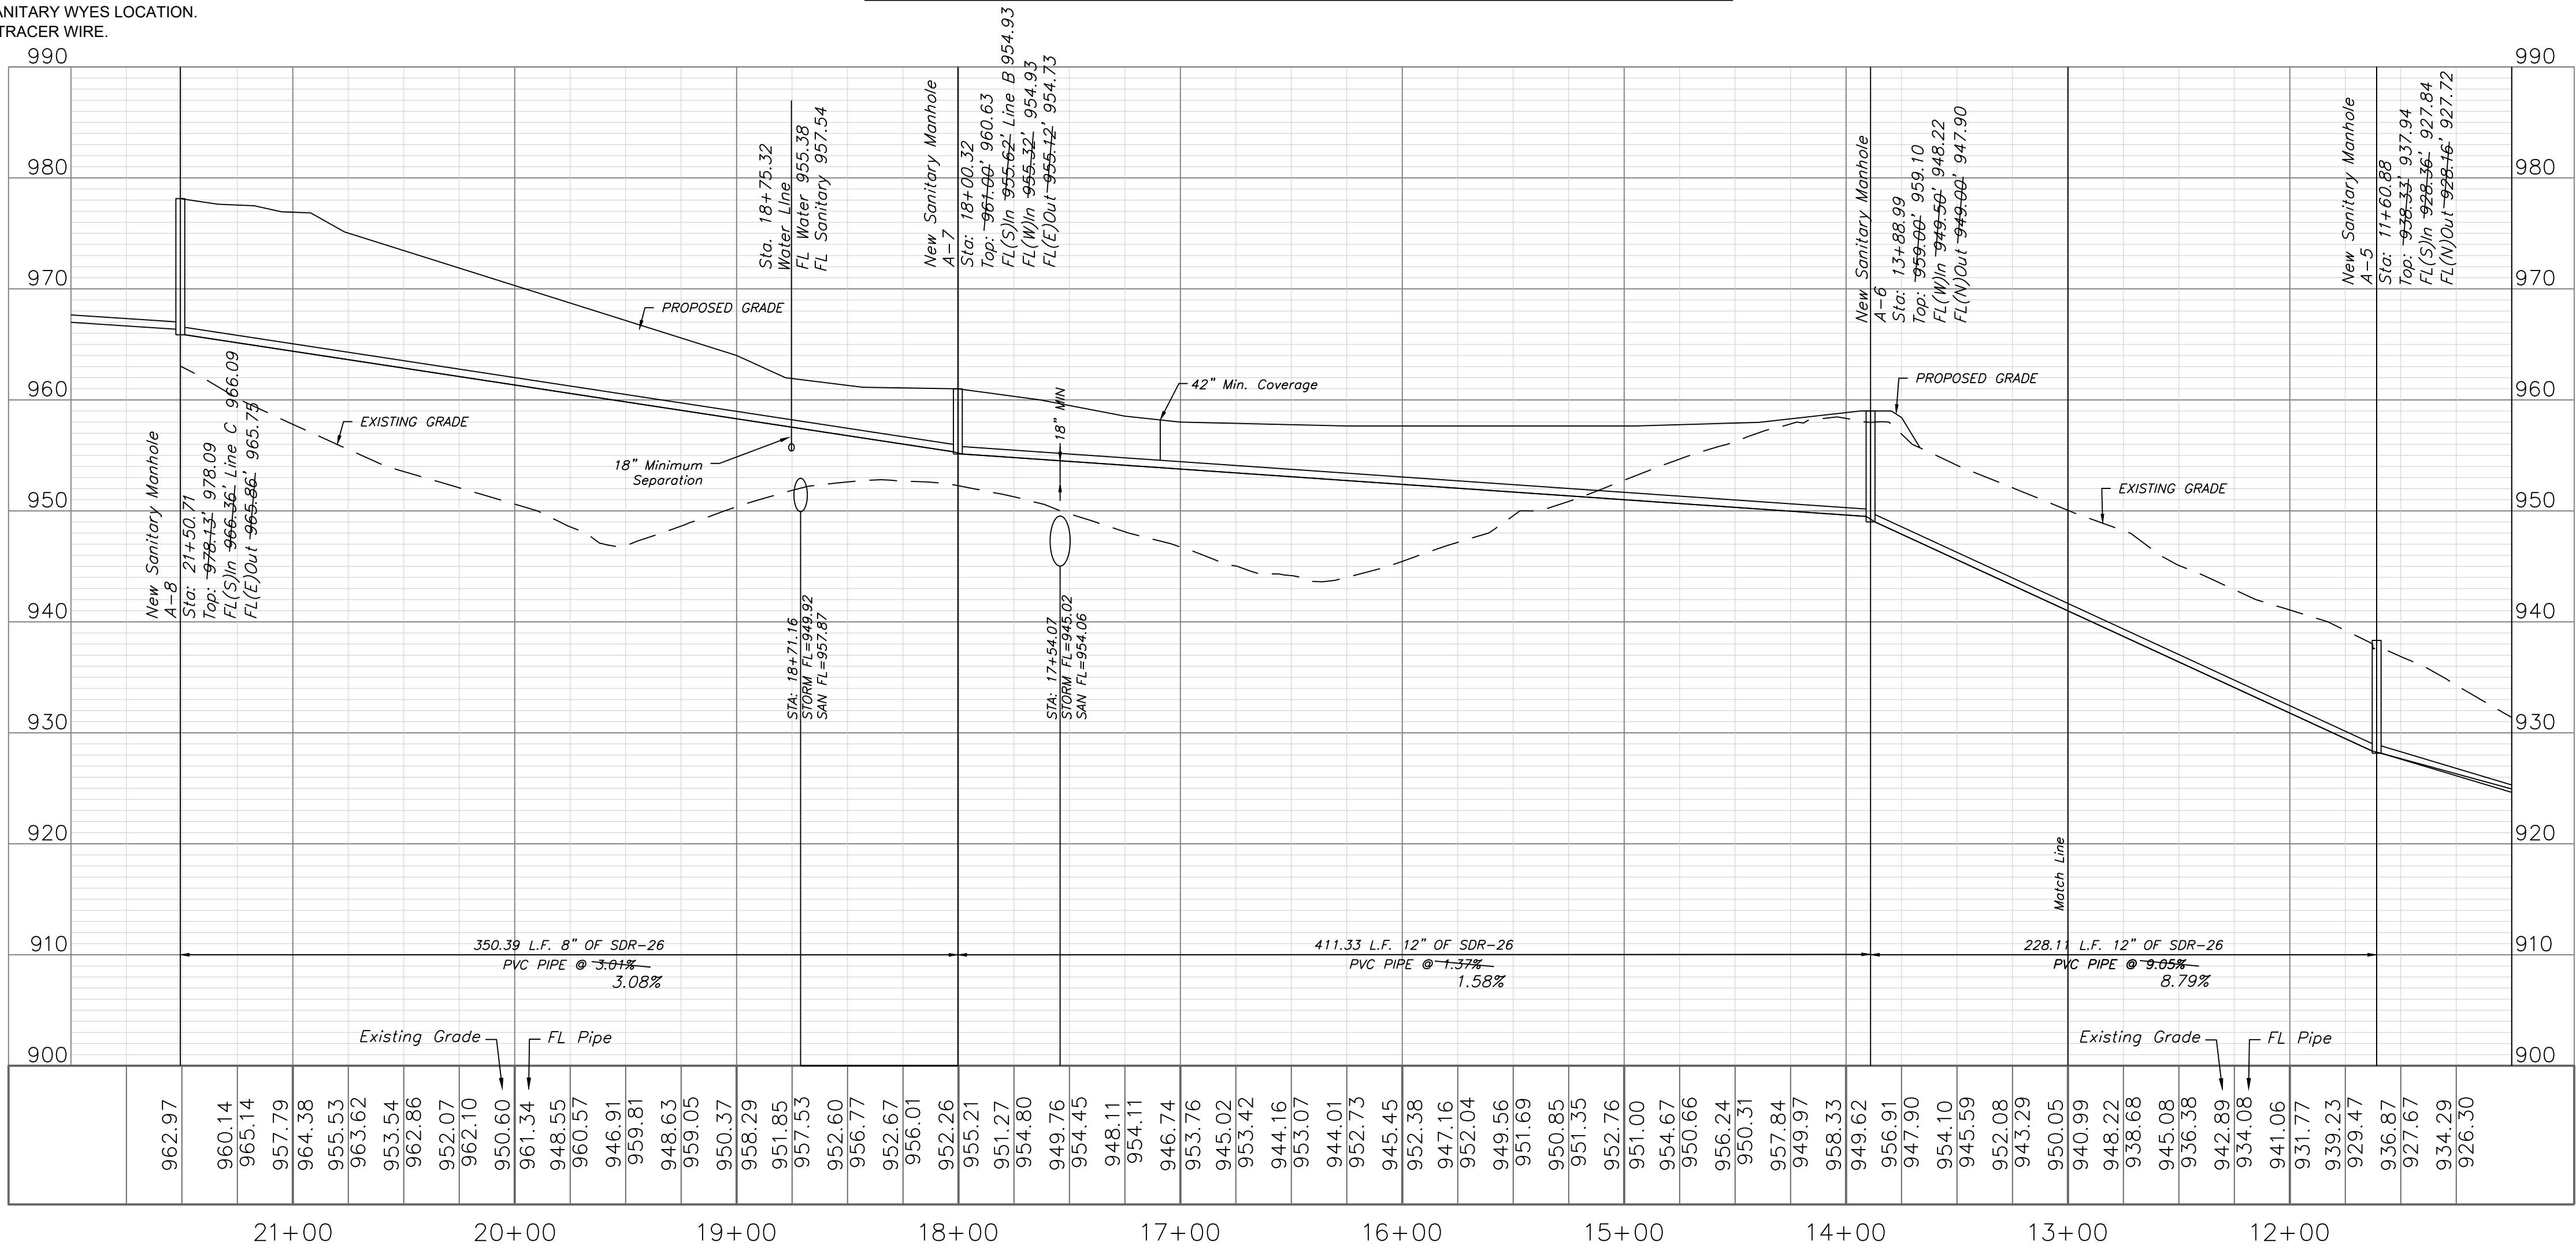

Record Drawing

"AS-BUILT"

900.10  
900.00 Indicates data replaced with "As-Built" information. All other data is as designed and has not been field verified.

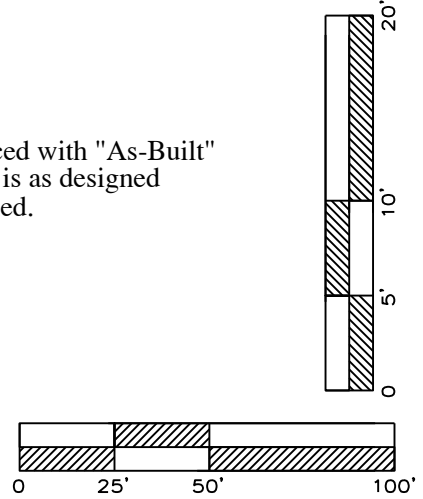

Sanitary Plan and Profile  
Construction Plans for:  
Village at View High  
Lee's Summit, Jackson County, Missouri


Project:  
View High Project  
Issue Date:  
November 22, 2019

Village At View High  
Lee's Summit, Jackson County, Missouri


Matthew J. Schlicht  
MO PE 2006019708  
KS PE 19071  
OK PE 25226

REVISIONS  
11/22/19 As-Built




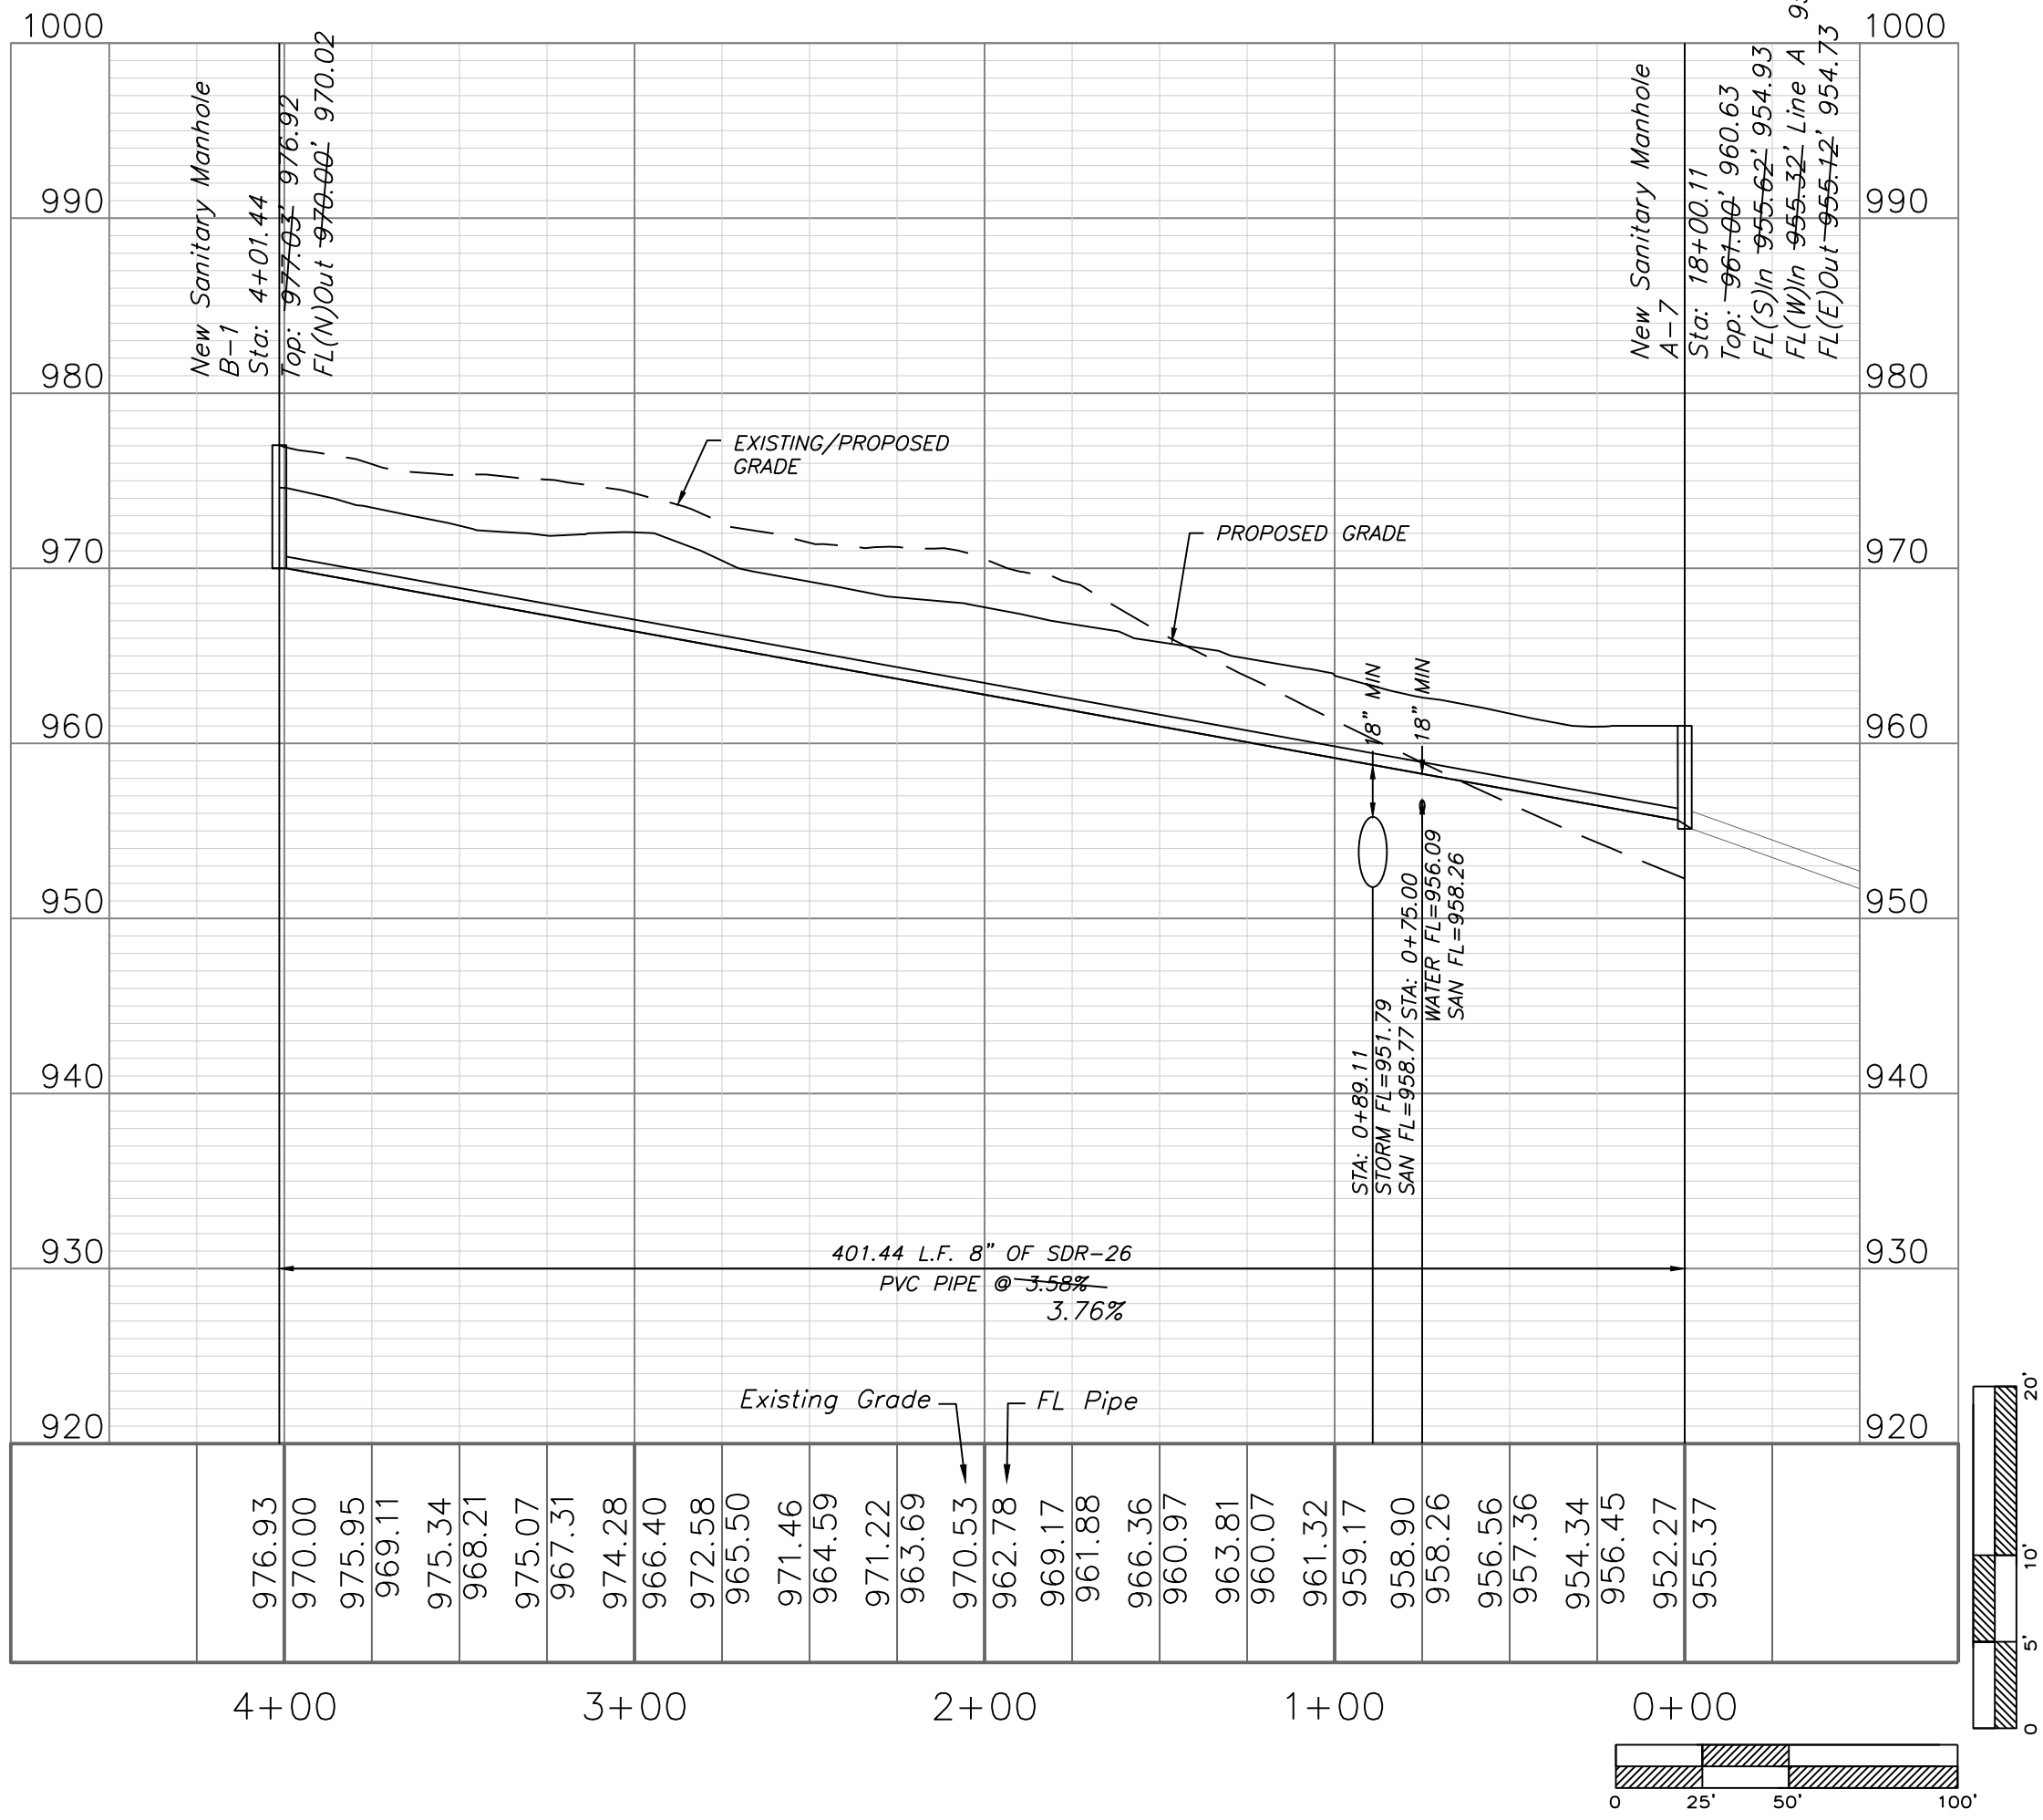

SANITARY LINE B

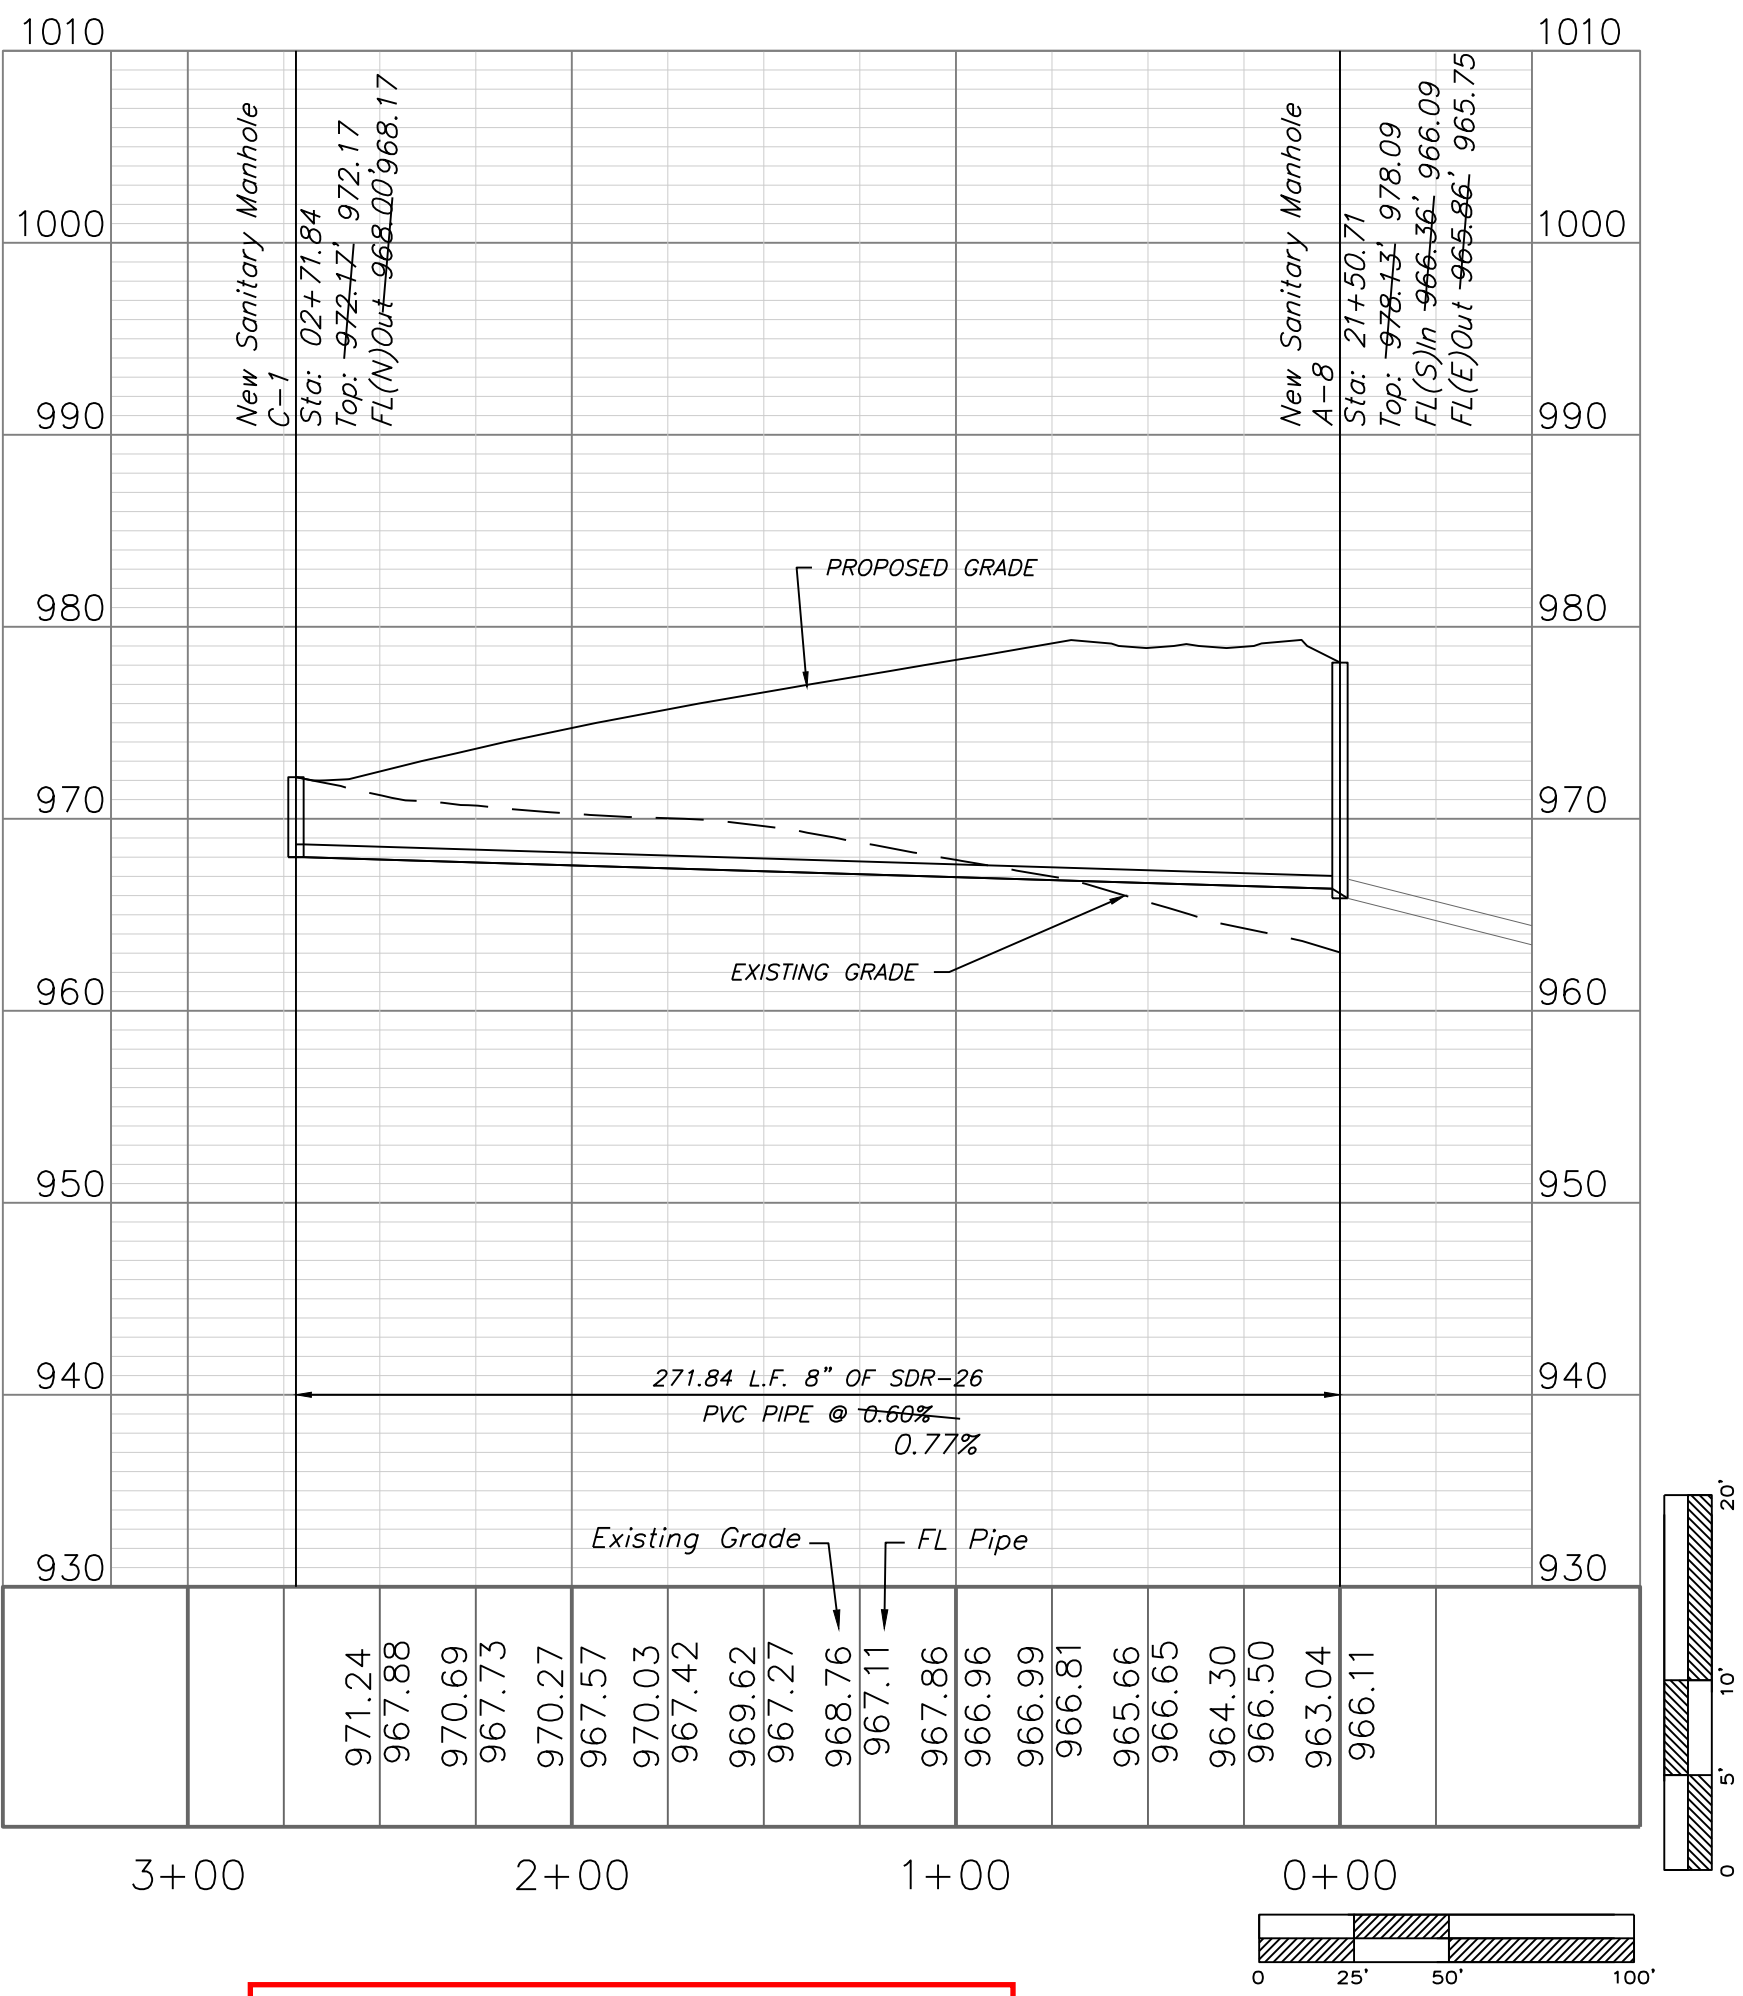

Record Drawing

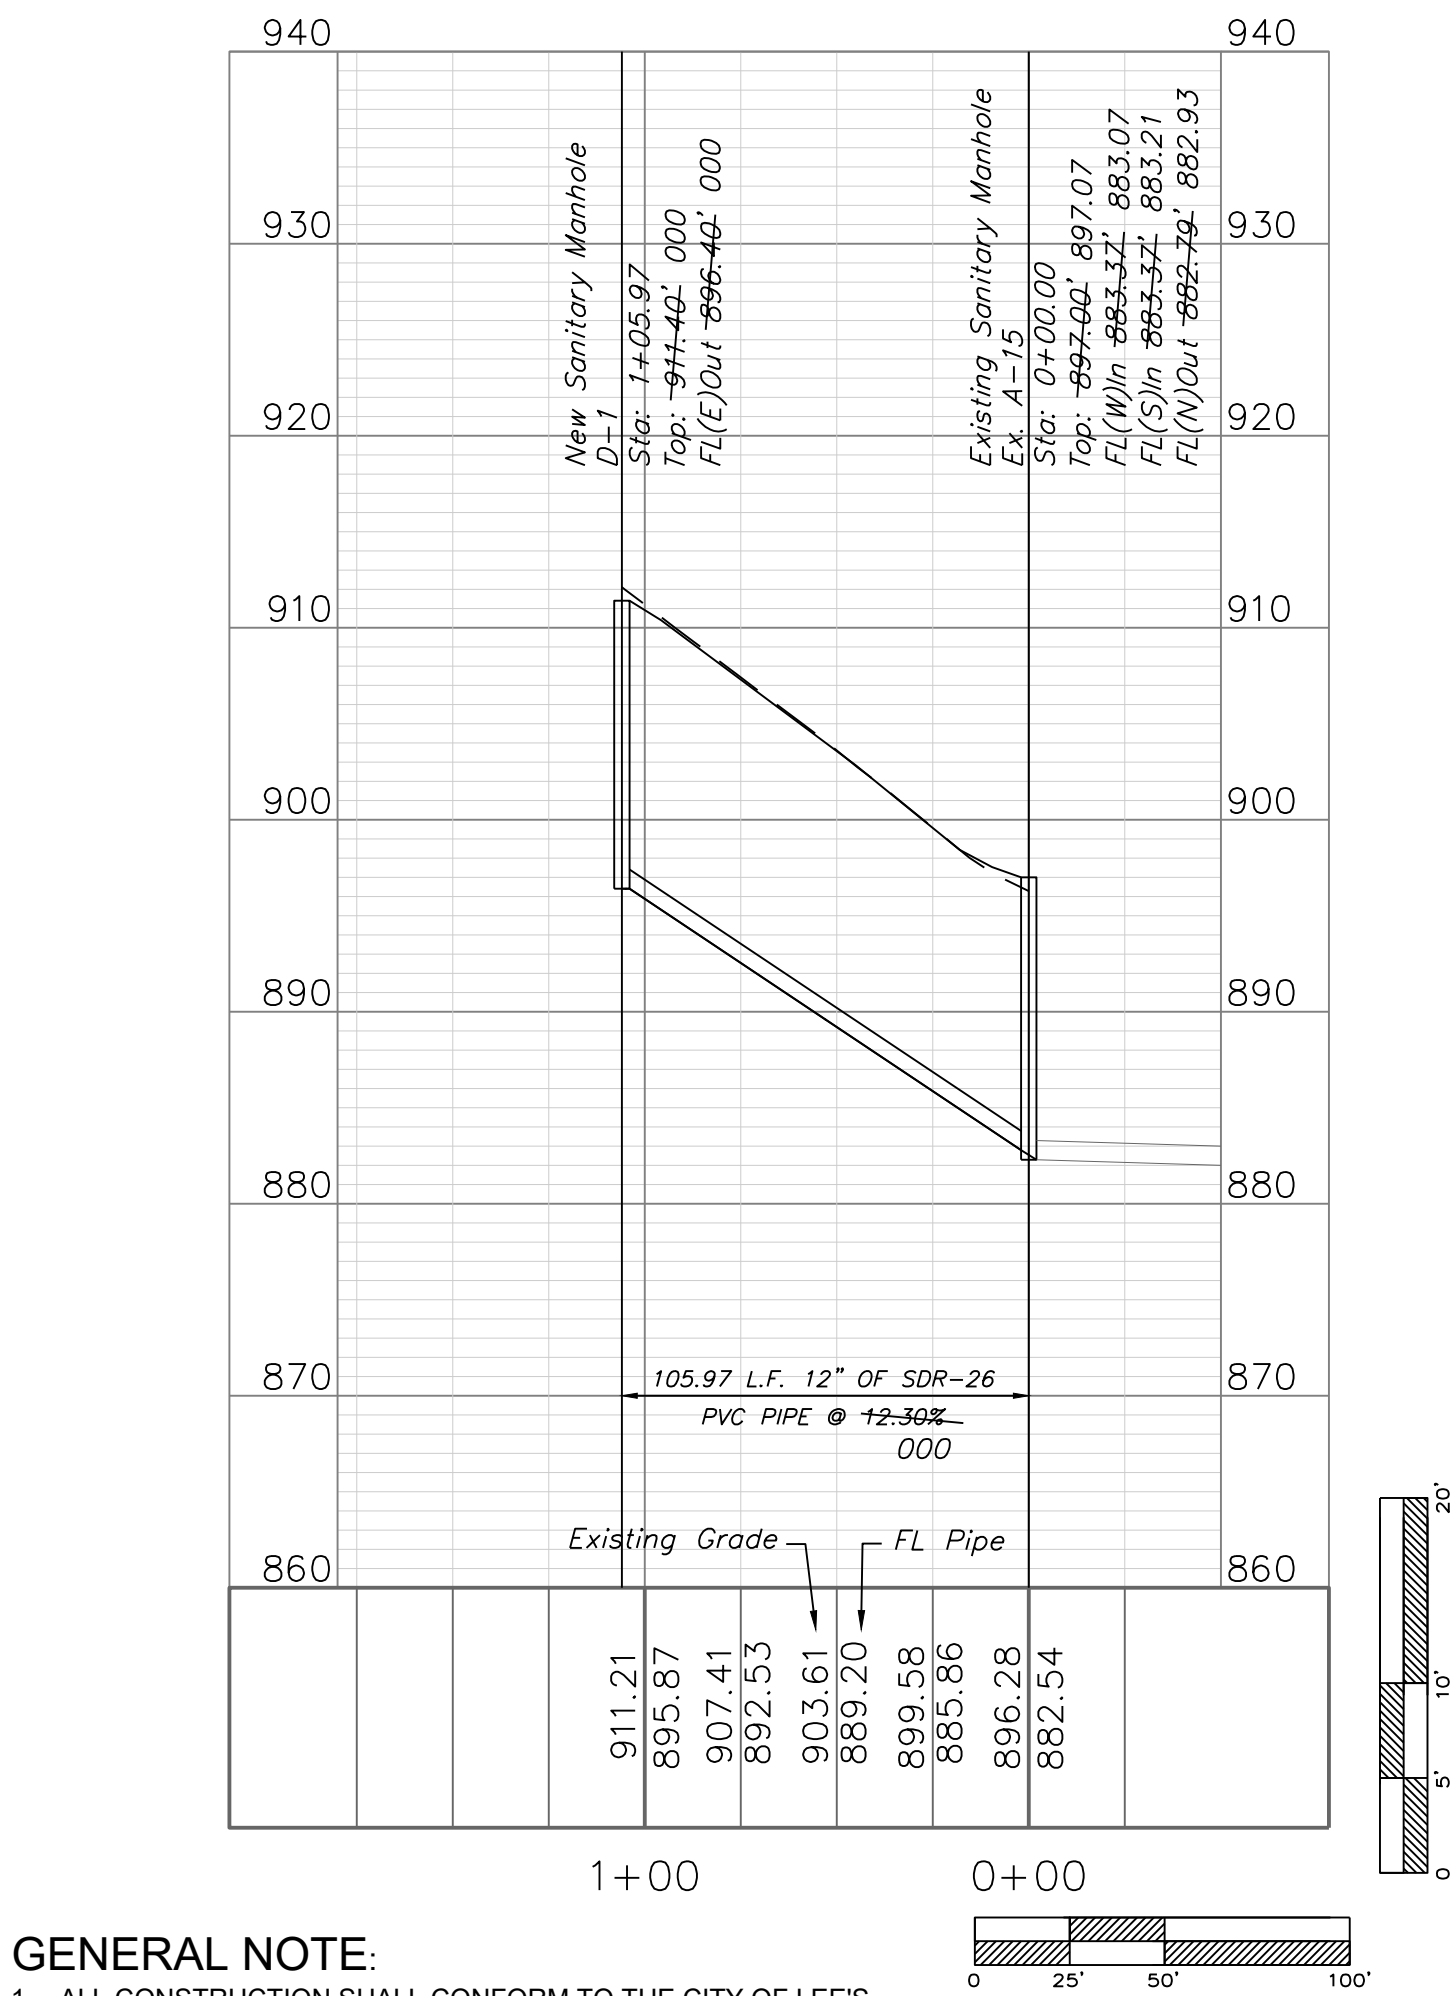

GENERAL NOTE:  
1 ~ ALL CONSTRUCTION SHALL CONFORM TO THE CITY OF LEE'S SUMMIT DESIGN AND CONSTRUCTION MANUAL AS ADOPTED BY ORDINANCE 5813.  
2 ~ TRENCH CHECKS SHALL BE INSTALL AT ALL SANITARY WYES LOCATION.  
3 ~ ALL SANITARY LINES SHALL BE INSTALL WITH TRACER WIRE.

"AS-BUILT"  
900.10  
900.00 Indicates data replaced with "As-Built" information. All other data is as designed and has not been field verified.

Sanitary Plan and Profile  
Construction Plans for:  
Village at View High  
Lee's Summit, Jackson County, Missouri

Project:  
View High Project  
Issue Date:  
November 22, 2019

Matthew J. Schlicht  
MO PE 2006019708  
KS PE 19071  
OK PE 15526  
REVISIONS  
11/22/19 As-Built






C. 404

Village At View High  
Lee's Summit, Jackson County, Missouri

Professional Registration  
Missouri  
Engineering 2005002186-D  
Surveying 2005003192-D  
Kansas  
Engineering E-1695  
Surveying LS-218  
Oklahoma  
Engineering 6254  
Nebraska  
Engineering CA2821

ENGINEERING  
ENGINEERING & SURVEYING  
SOLUTIONS  
50 SE 30TH STREET  
LEE'S SUMMIT, MO 64082  
P: (816) 623-9888 F: (816) 623-9849



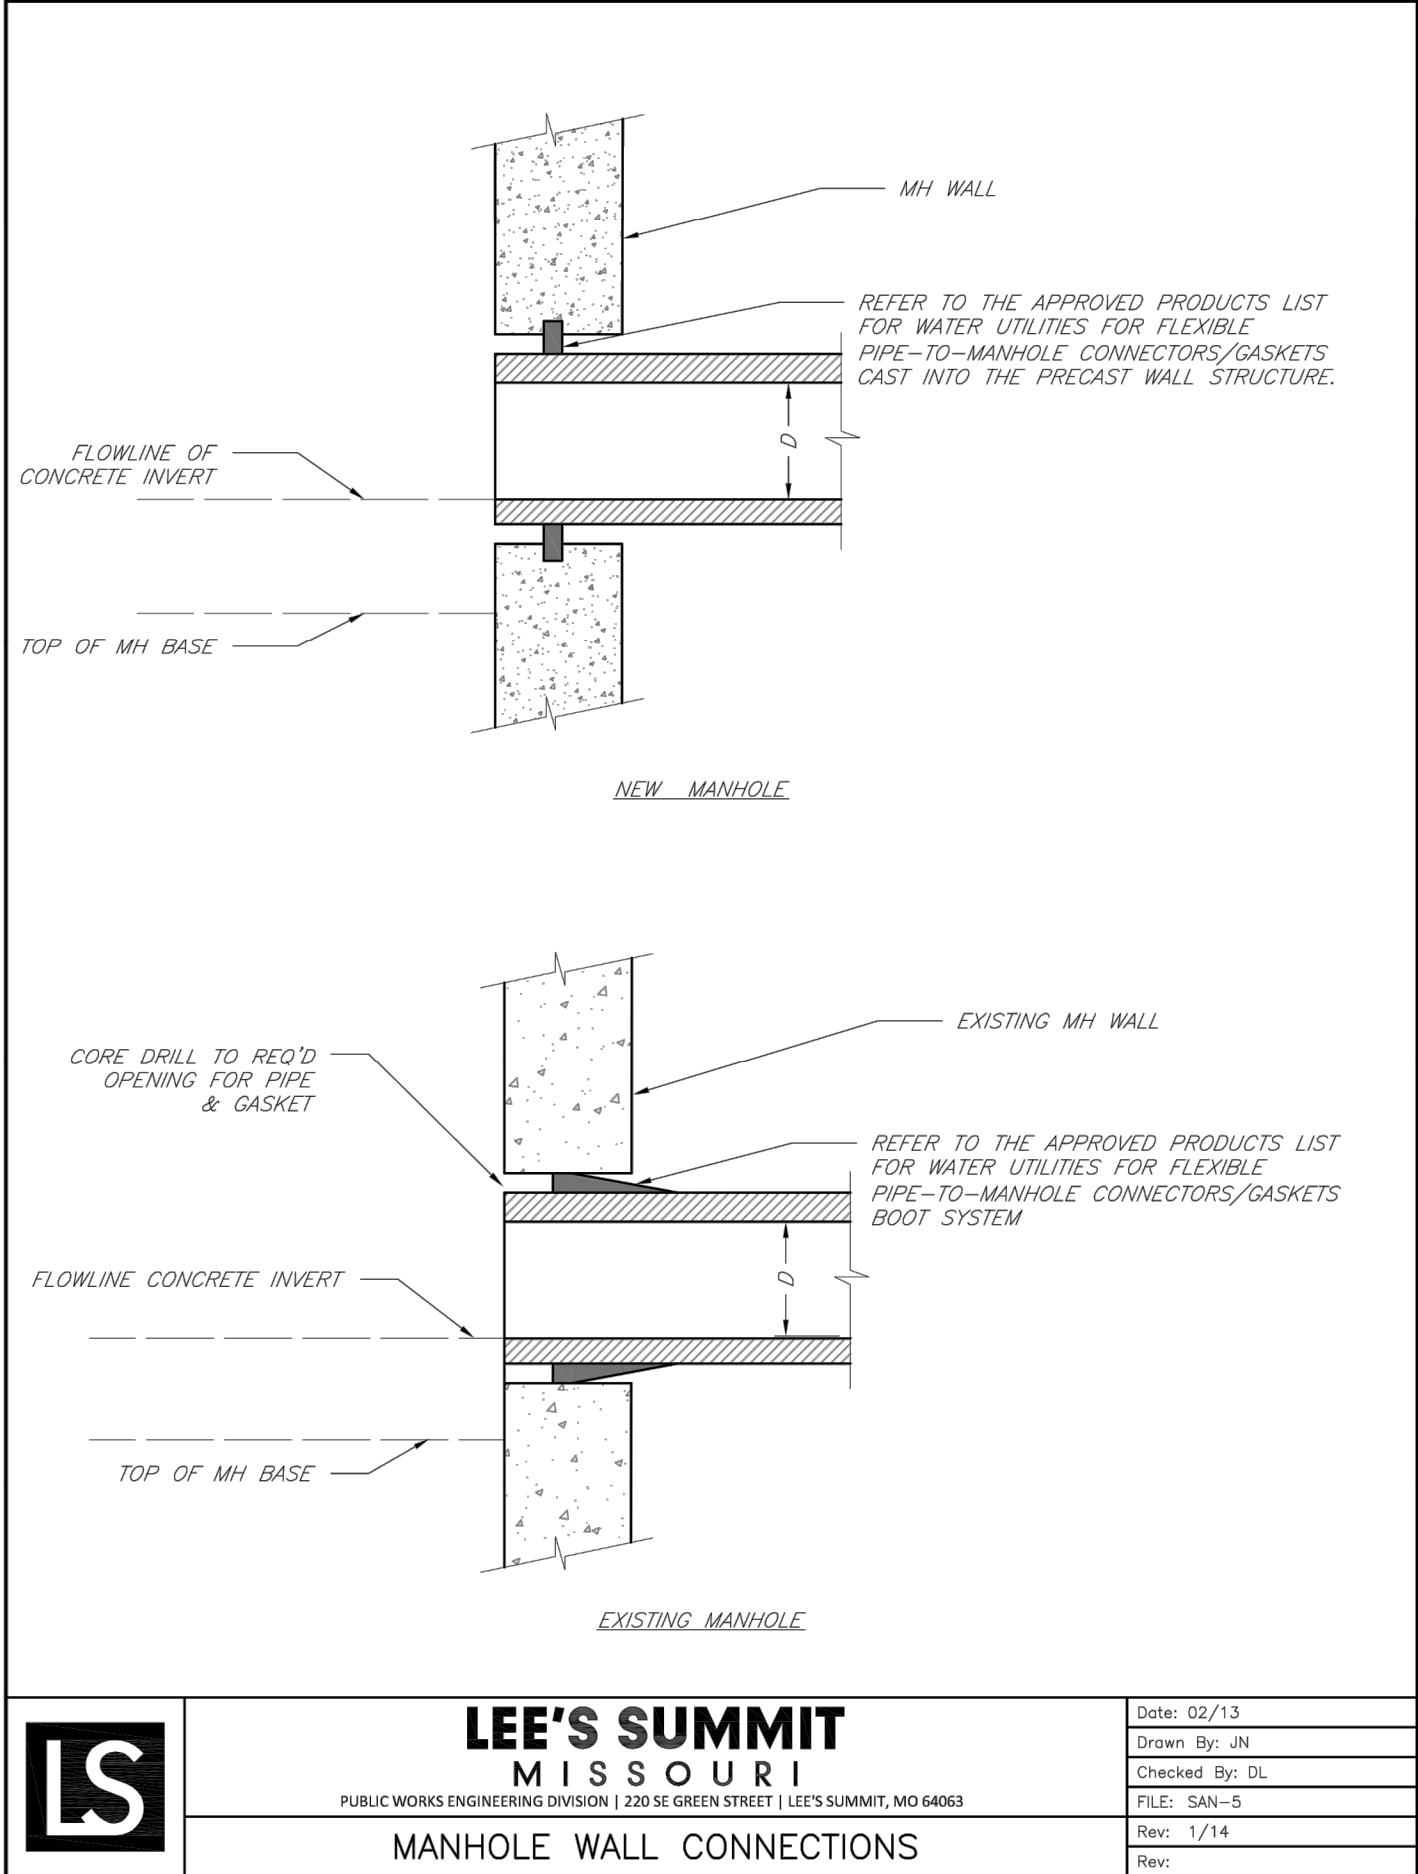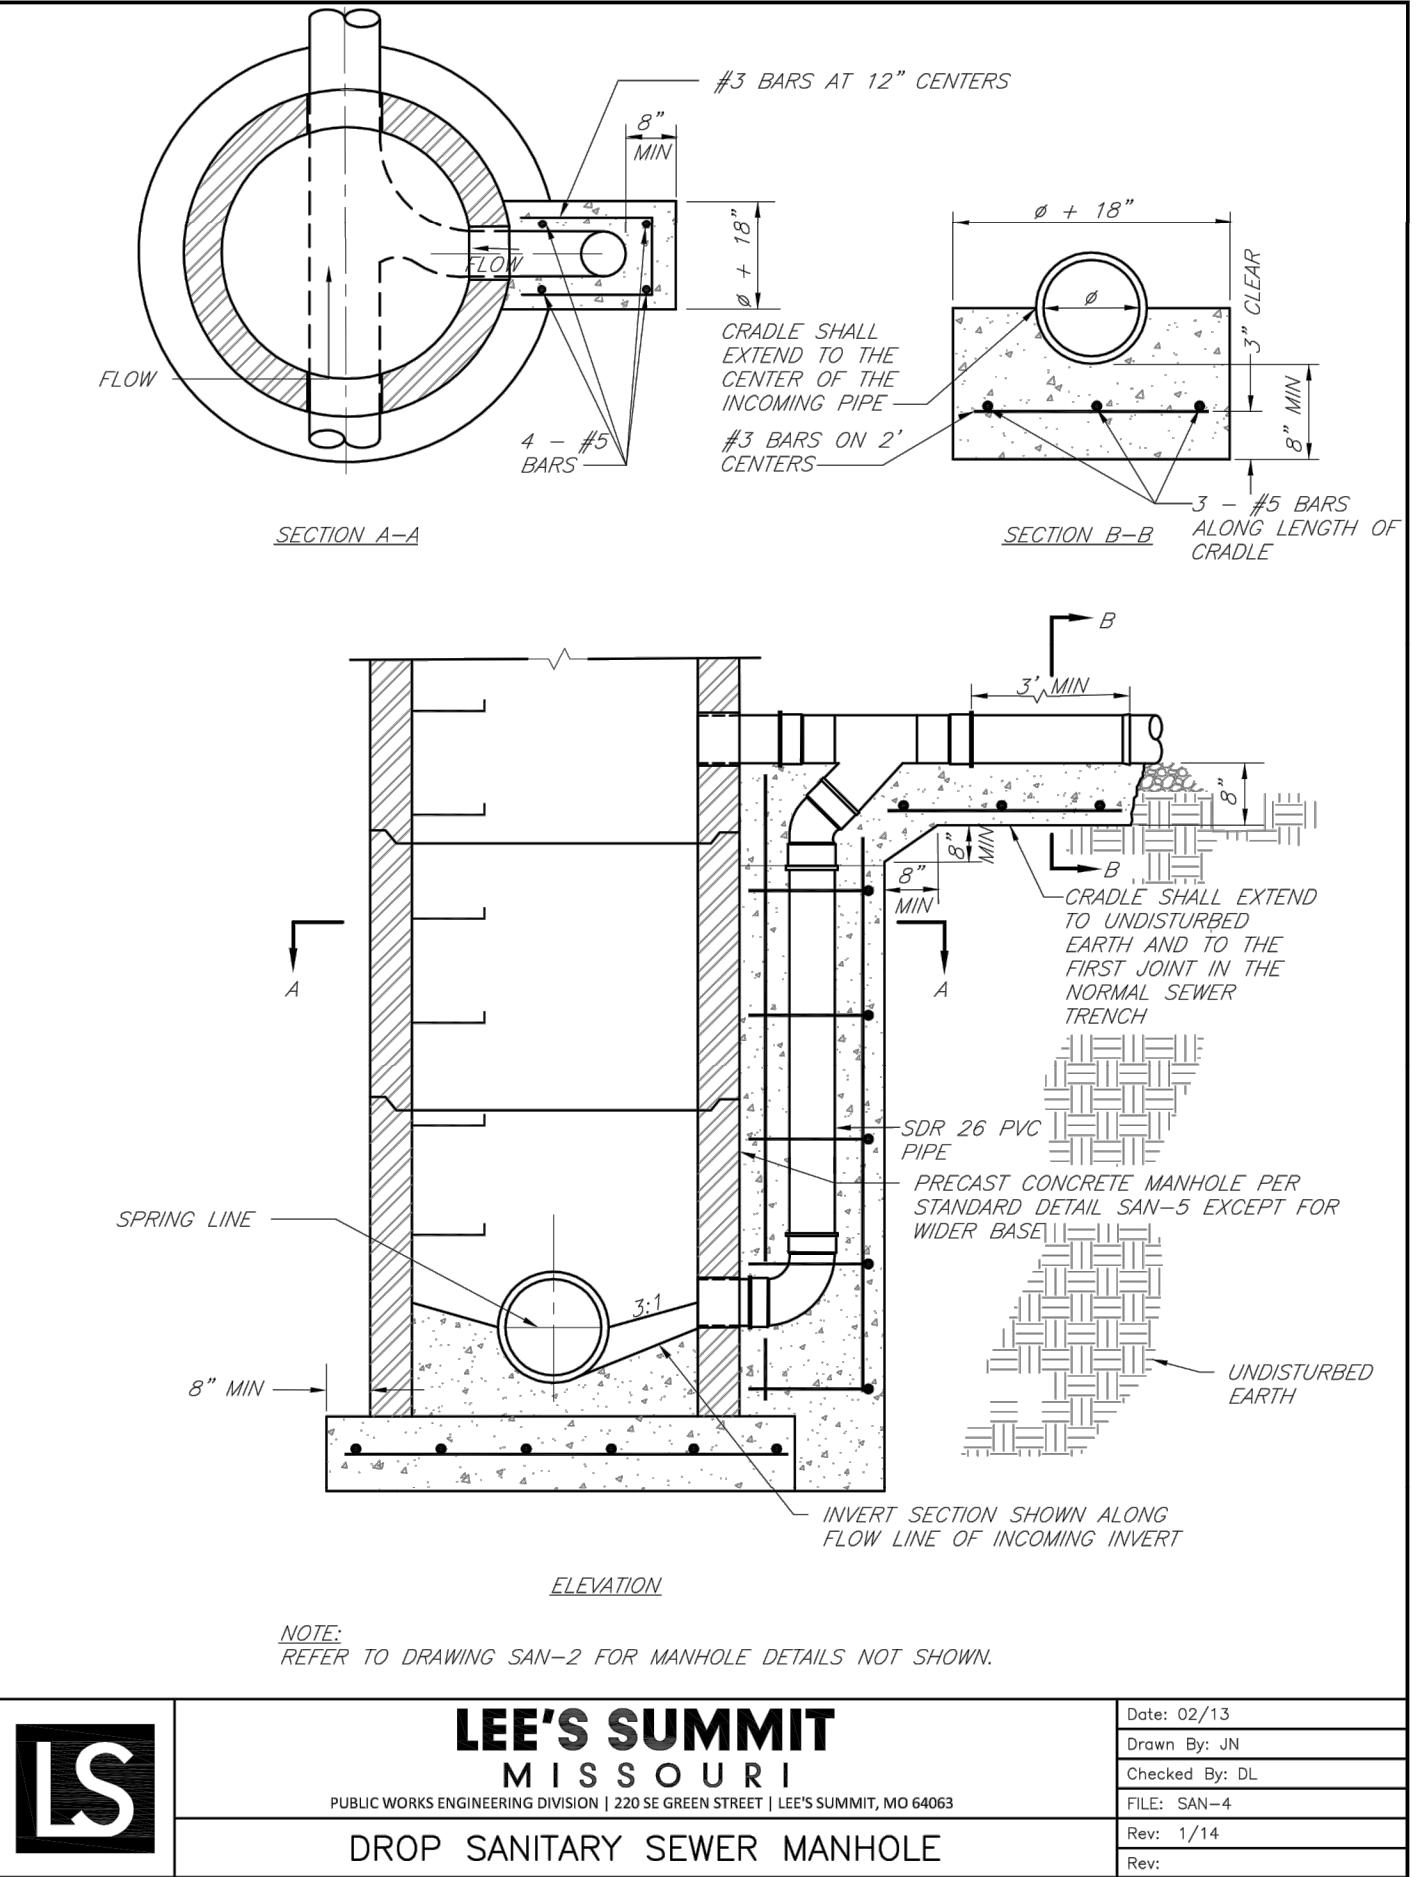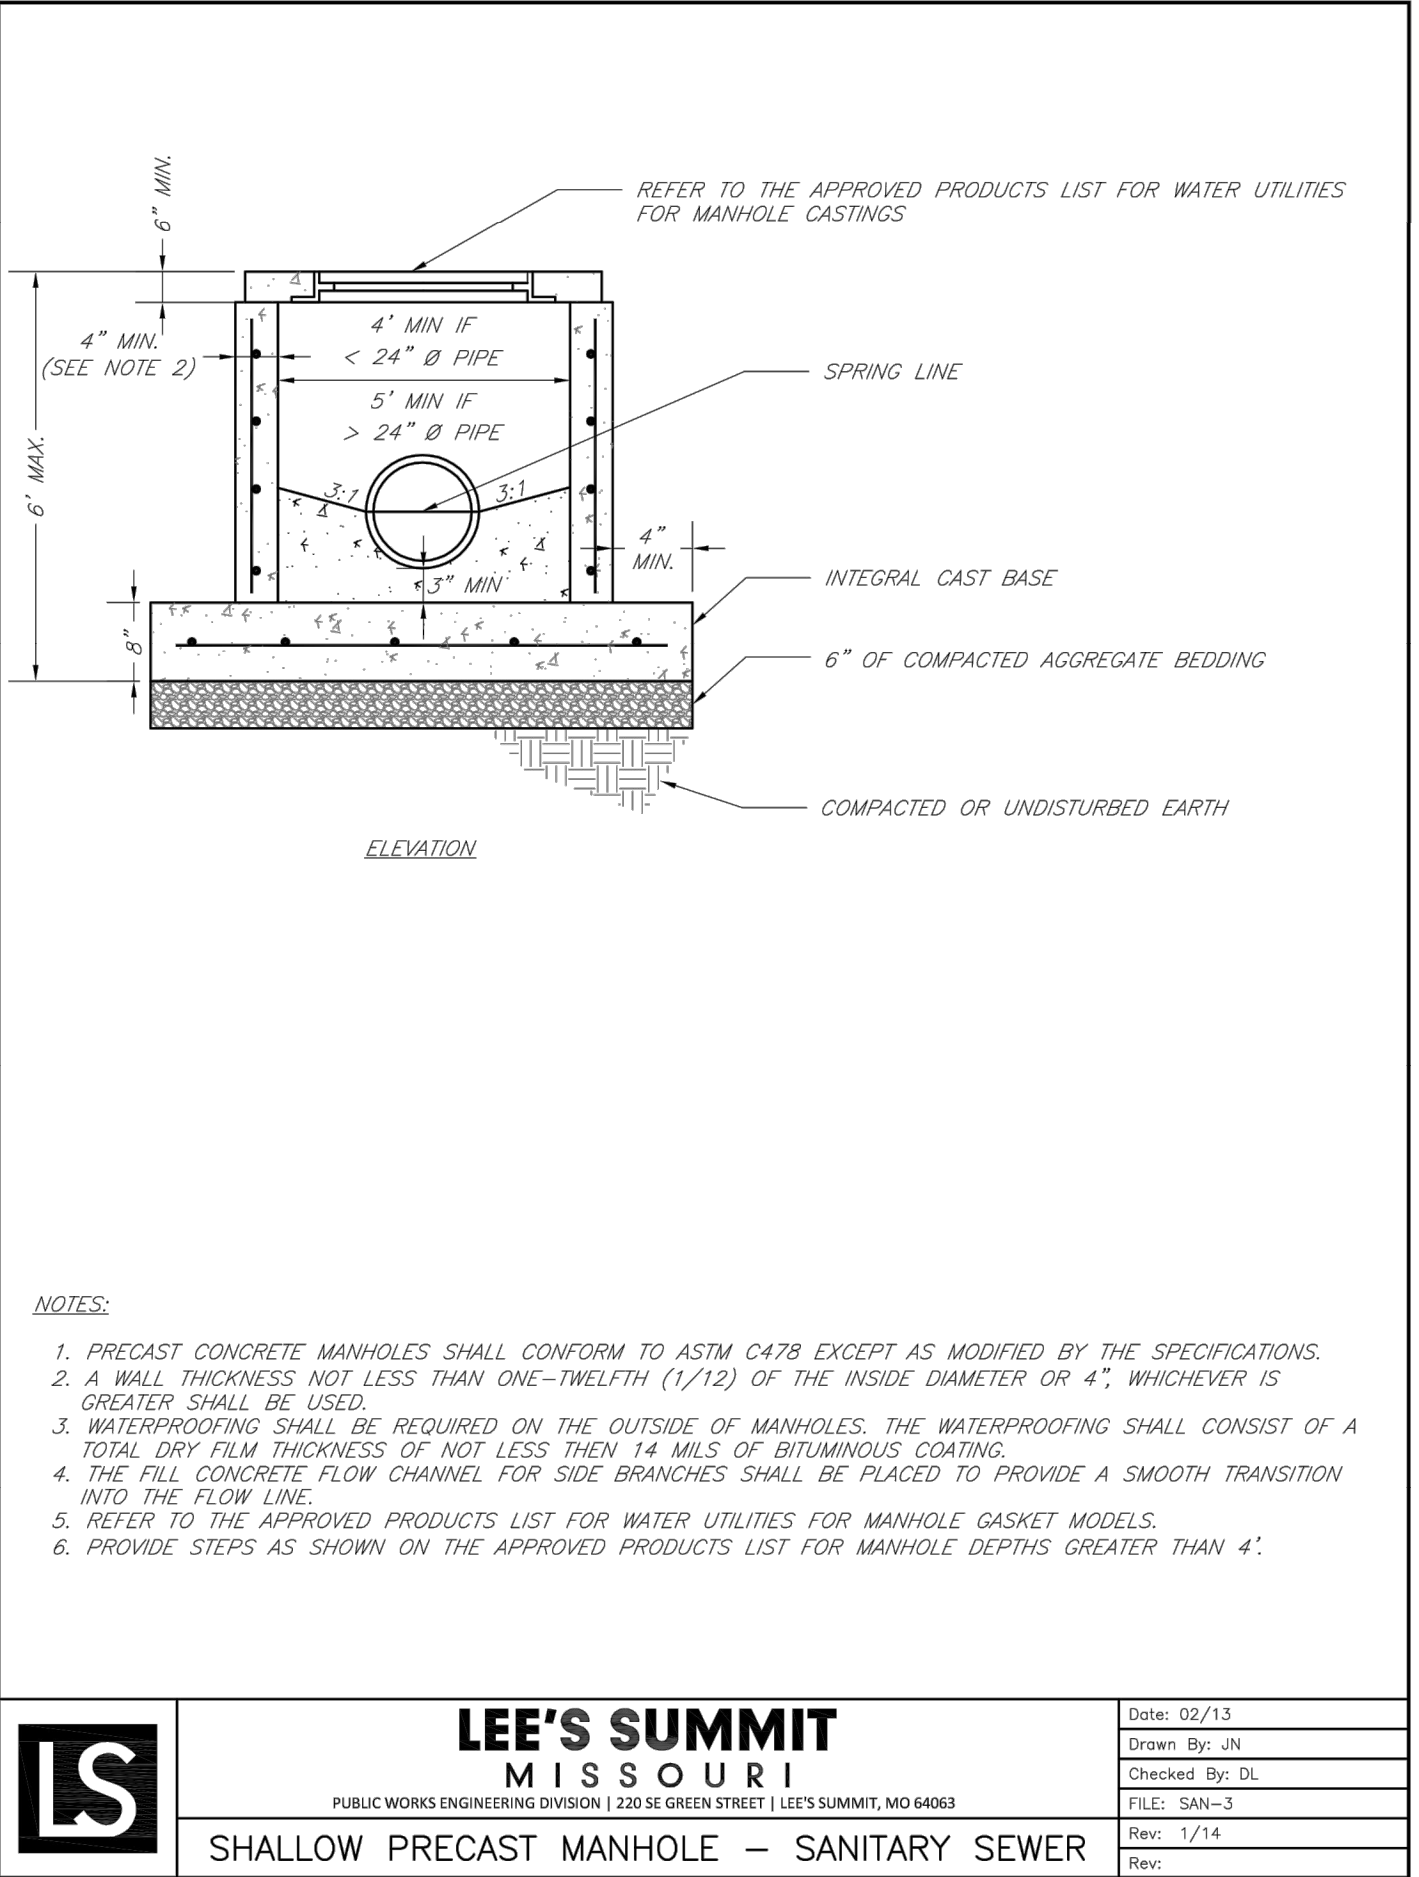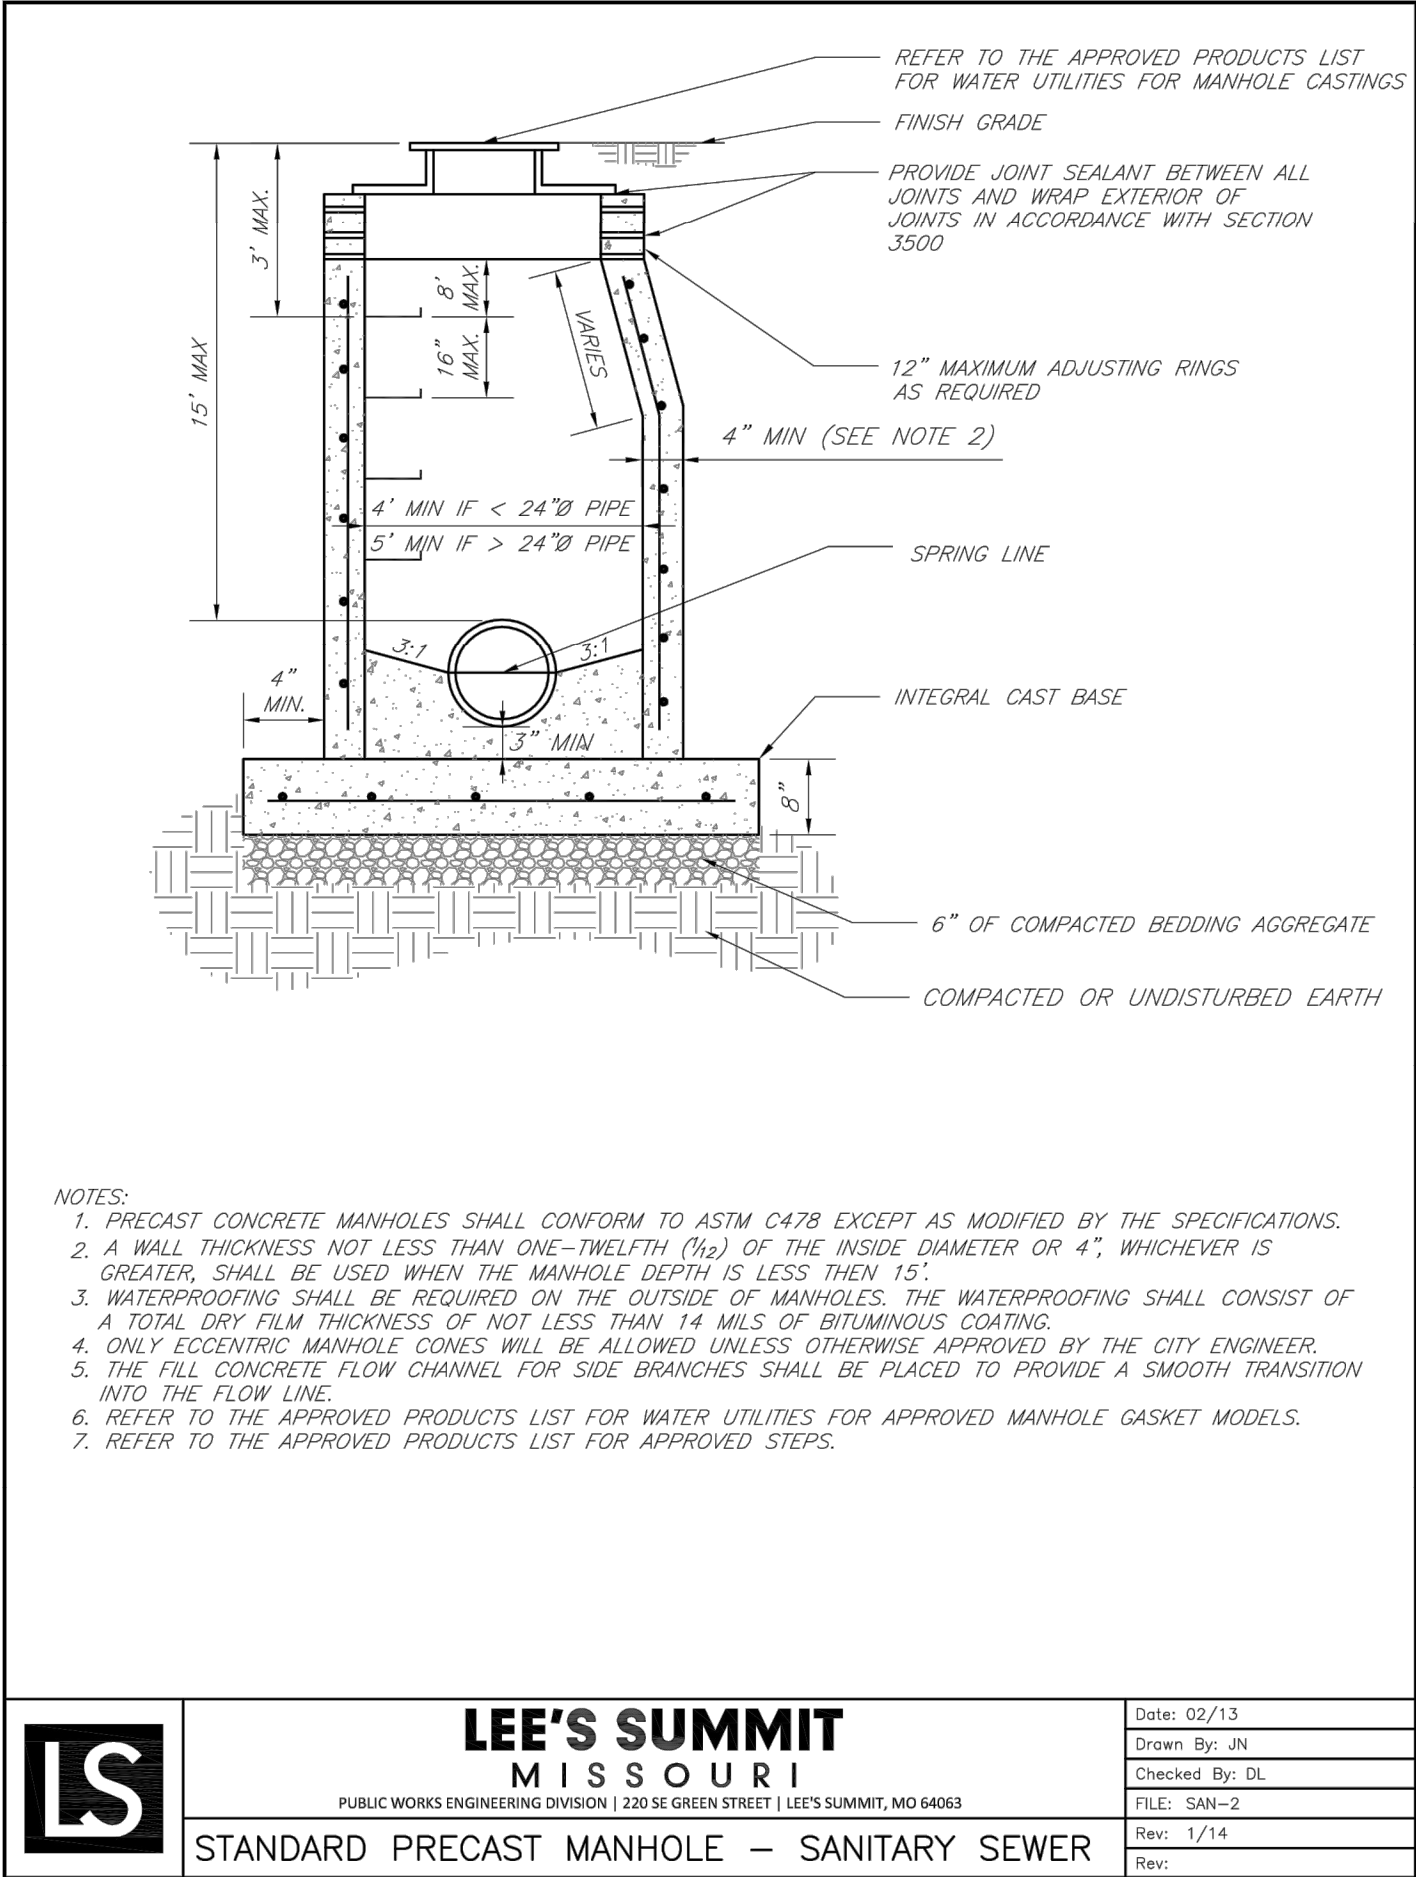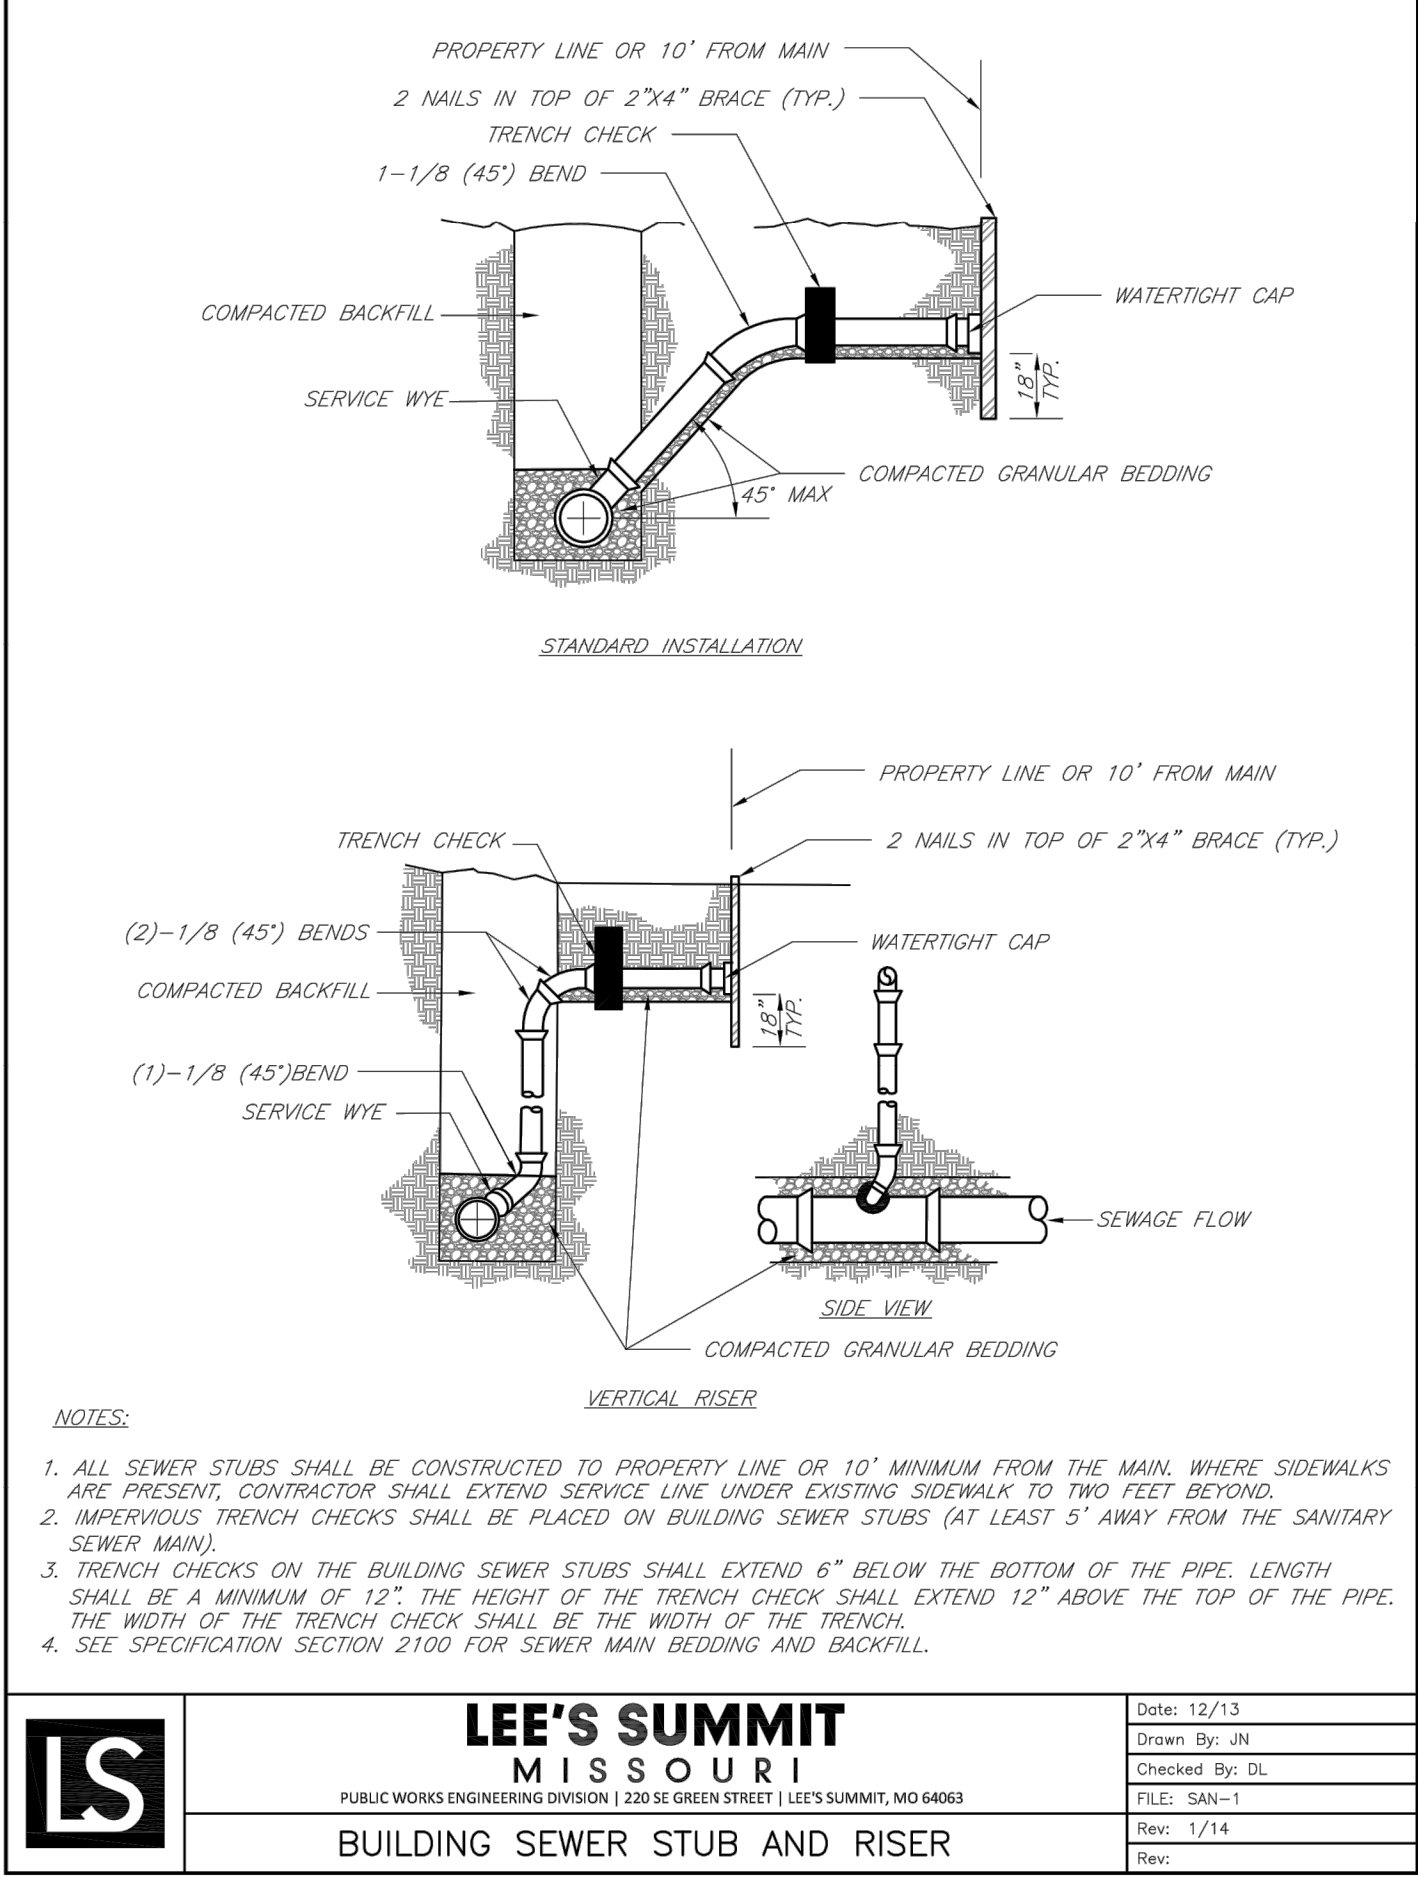

GENERAL NOTE:  
1 ~ ALL CONSTRUCTION SHALL CONFORM TO THE CITY OF LEE'S SUMMIT DESIGN AND CONSTRUCTION MANUAL AS ADOPTED BY ORDINANCE 5813.  
2 ~ TRENCH CHECKS SHALL BE INSTALL AT ALL SANITARY WYES LOCATION.  
3 ~ ALL SANITARY LINES SHALL BE INSTALL WITH TRACER WIRE.

Record Drawing

"AS-BUILT"

900.10  
900.00 Indicates data replaced with "As-Built" information. All other data is as designed and has not been field verified.