CONSTRUCTION PLANS FOR NW PRYOR ROAD SIGNAL IMPROVEMENTS & LANE WIDENING STREETS OF WEST PRYOR

OCTOBER 2019

LEE'S SUMMIT, MISSOURI

RECORD DRAWINGS

ELECTRIC- SERVICE NATHAN MICHAEL

Katie.Darnell@spireenergy.com

WATER, SANITARY/STORM SEWER SERVICE CITY OF LEE'S SUMMIT KENT MONTER (816) 969-1900 Kent.Monter@cityofls.net

CALL BEFORE YOU DIG - DRILL - BLAST

UTILITY STATEMENT:

1-800-344-7483 (TOLL FREE)

MISSOURI ONE CALL SYSTEM, INC.

THE UNDERGROUND UTILITIES SHOWN HEREON ARE FROM FIELD SURVEY INFORMATION OF ONE-CALL LOCATED UTILITIES, FIELD SURVEY INFORMATION OF ABOVE GROUND OBSERVABLE EVIDENCE, AND/OR THE SCALING AND PLOTTING OF EXISTING UTILITY MAPS AND DRAWINGS AVAILABLE TO THE SURVEYOR AT THE TIME OF SURVEY. THE SURVEYOR MAKES NO GUARANTEE THAT THE UNDERGROUND UTILITIES SHOWN COMPRISE ALL SUCH UTILITIES IN THE AREA, EITHER IN SERVICE OR ABANDONED. FURTHERMORE, THE SURVEYOR DOES NOT WARRANT THAT THE UNDERGROUND UTILITIES SHOWN ARE IN THE EXACT LOCATION INDICATED ALTHOUGH HE DOES CERTIFY THAT THEY ARE LOCATED AS ACCURATELY AS POSSIBLE FROM INFORMATION AVAILABLE. THE SURVEYOR HAS NOT PHYSICALLY LOCATED THE UNDERGROUND UTILITIES BY EXCAVATION UNLESS

COMMUNICATION SERVICE

OMMUNICATION SERVICE

TIME WARNER CABLE

Steve.Baxter@charter.com

Ryan. Alkire@cable.comcast.com

KC-Google-UC@google.com

rebeccadavis@google.com

913) 643-1928

COMMUNICATION SERVICE

(816) 795-2218

COMMUNICATION SERVICE

COMCAST

RYAN ALKIRE

GOOGLE FIBER

BECKY DAVIS (913) 725-8745

CARRIE CILKE (816) 703-4386

CAUTION - NOTICE TO CONTRACTOR

OTHERWISE NOTED ON THIS SURVEY.

THE CONTRACTOR IS SPECIFICALLY CAUTIONED THAT THE LOCATION AND/OR ELEVATION OF EXISTING UTILITIES AS SHOWN ON THESE PLANS IS BASED ON RECORDS OF THE VARIOUS UTILITY COMPANIES AND, WHERE POSSIBLE, MEASUREMENTS TAKEN IN THE FIELD. THE INFORMATION IS NOT TO BE RELIED ON AS BEING EXACT OR COMPLETE. THE CONTRACTOR MUST CALL THE APPROPRIATE UTILITY COMPANY AT LEAST 72 HOURS BEFORE ANY EXCAVATION TO REQUEST EXACT FIELD LOCATION OF UTILITIES. IT SHALL BE THE RESPONSIBILITY OF THE CONTRACTOR TO RELOCATE ALL EXISTING UTILITIES WHICH CONFLICT WITH PROPOSED IMPROVEMENTS SHOWN ON THE PLANS. THE CONTRACTOR SHALL EXPOSE EXISTING UTILITIES AT LOCATIONS OF POSSIBLE CONFLICTS PRIOR TO ANY CONSTRUCTION.

SAFETY NOTICE TO CONTRACTOR

IN ACCORDANCE WITH GENERALLY ACCEPTED CONSTRUCTION PRACTICES, THE CONTRACTOR WILL BE SOLELY AND COMPLETELY RESPONSIBLE FOR CONDITIONS OF THE JOB SITE, INCLUDING SAFETY OF ALL PERSONS AND PROPERTY DURING PERFORMANCE OF THE WORK. THIS REQUIREMENT WILL APPLY CONTINUOUSLY AND NOT BE LIMITED TO NORMAL WORKING HOURS.

WARRANTY / DISCLAIMER

THE DESIGNS REPRESENTED IN THESE PLANS ARE IN ACCORDANCE WITH ESTABLISHED PRACTICES OF CIVIL ENGINEERING FOR THE DESIGN FUNCTIONS AND USES INTENDED BY THE OWNER AT THIS TIME. HOWEVER, NEITHER KAW VALLEY ENGINEERING, INC NOR ITS PERSONNEL CAN OR DO WARRANTY THESE DESIGNS OR PLANS AS CONSTRUCTED, EXCEPT IN THE SPECIFIC CASES WHERE KAW VALLEY ENGINEERING PERSONNEL INSPECT AND CONTROL THE PHYSICAL CONSTRUCTION ON A CONTEMPORARY BASIS AT THE SITE.


	SUMMARY OF QUAN	NTITIES	
<u>Pavir</u>	<u>ng</u>		
ltem No.	ltem	Estimated Quantity	Unit
1	2' Curb & Gutter (CG-1)	1080	L.F.
2	Asphaltic Cement Concrete Surface (2")	1240	S.Y.
3	Asphaltic Cement Concrete Surface (7.5")	1240	S.Y.
4	MoDOT Type 5 Base (Pavement)(12")	1570	S.Y.
5	Terragrid SX2020	1570	S.Y.
6	Concrete Entrance (Commercial)(8")	679	S.Y.
7	Aggregate Base (Commercial)(Driveway)(4")	679	S.Y.
8	Handicap Ramp	4	Ea.
9	Modular Block Retaining Wall	34	L.F.
10	Island Concrete (6")	54	S.F.
11	Concrete Sidewalk (4" KCCMB 4K Concrete)	484	S.Y.
12	Detectable Warning pad (pad only)	2'X3'	Size
へ			✓
Eros	ion Control		

ltem			
No.	ltem	Estimated Quantity	Unit
1	Erosion Control Devices, Sedimentation Fence	1148	L.F.
2	Erosion Control Devices, Curb Inlet Protection	4	Ea.
3	Erosion Control Devices, Area Inlet & Junction Box Protection	4	Ea.
4	Seeding	1	S.F.

Pavment Marking & Signing

1 Pavement Marking, High-build Paint (Solid White)(4")

2	Pavement Marking, High-build Paint (Dashed White)(Extension)(6")	82	L.F.
3	Pavement Marking, High-build Paint (Solid White)(Cross-walk)(6")	220	L.F.
4	Pavement Marking, Thermoplastic (Solid White)(Stop Bar)(24")	62	L.F.
5	Pavement Marking, Thermoplastic (White)(Left/Right Arrow)	17	Ea.
6	Permanent Signs	32	S.F.
7	Sign Post (Square Steel Tube)	3	L.F.
Stor	m Sewer		
Item			
No.	ltem	Estimated Quantity	Unit
1	Setback Curb Inlet (4'x3')	1	Ea.
2	RCP (24")(CLASS 3)	42	L.F.
Traff	<u>ic Signal</u>		
Item			
No.	ltem	Estimated Quantity	Unit
1	Traffic Signal System, NW Pryor & NW Summit Woods	1	L.S.
2	Traffic Signal System, NW Pryor & NW Lowenstein	1	L.S.
3	Interconnect Cable	2370	L.F.
Ligh	<u>ting</u>		
ltem	ltem	Estimated Quantity	Unit
1	Light Pole Base	2	Ea.

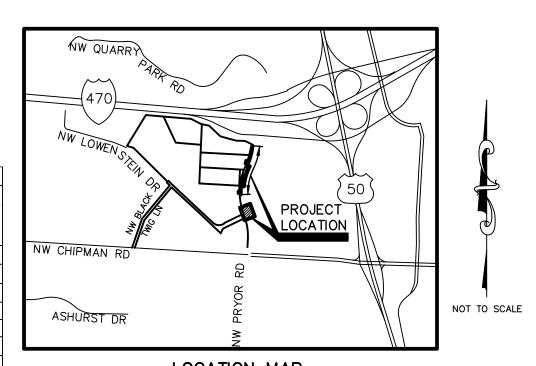

LOCATION MAP CITY OF LEE'S SUMMIT, MISSOURI

I certify that I have reviewed the as built information provided on these record drawings and take no exception to the information provided by Emery Sapp and Sons, Inc.

Leon D. Osborn September 2, 2020

APPROVED THIS _____ _DAY OF_ OWNER: MATT PENNINGTON APPROVED THIS ___ CITY APPROVAL

OWNER:STREETS OF WEST PRYOR, LLC 7200 WEST 132ND STREET OVERLAND PARK, KS 66213 CONTACT: MATT PENNINGTON email: matt@drakekc.com

PREPARED BY:
KAW VALLEY ENGINEERING, INC. 2319 N. JACKSON JUNCTION CITY, KS 66441 785-762-5040 CONTACT: LEON D OSBOURN EMAIL: Ido@kveng.com

7200 WEST 132ND STREET AGENT: DAVID N. OLSON

email: daveolson@monarchprojectllc.com

INDEX TO SHEETS

DEMOLITION PLAN

GENERAL LAYOUT SHEET

2 TYPICAL SECTIONS & GENERAL CONSTRUCTION NOTES

NW PRYOR DRIVE WIDENING - PLAN & PROFILE

NW PRYOR DRIVE WIDENING - PLAN & PROFILE

14 NW PRYOR ROAD PAVEMENT MARKING PLAN

15 NW PRYOR ROAD PAVEMENT MARKING PLAN

10 GEOMETRIC LAYOUT - NW PRYOR ROAD AT NW SUMMIT WOODS

11 GEOMETRIC LAYOUT - NW PRYOR ROAD AT PROPOSED PRIVATE ROAD - C

16 TRAFFIC SIGNAL GENERAL NOTES, SIGNS & CONSTRUCTION SEQUENCING

19 TRAFFIC SIGNAL WIRE DIAGRAM - NW PRYOR RD & NW LOWENSTEIN DR

20 TRAFFIC SIGNAL QUANTITIES - NW PRYOR RD & NW LOWENSTEIN DR

22 TRAFFIC SIGNAL WIRE DIAGRAM - NW PRYOR RD & NW SUMMIT WOODS

23 TRAFFIC SIGNAL QUANTITIES - NW PRYOR RD & NW SUMMIT WOODS

18 TRAFFIC SIGNAL PLAN - NW PRYOR RD & NW LOWENSTEIN DR

21 TRAFFIC SIGNAL PLAN - NW PRYOR RD & NW SUMMIT WOODS

32 TRAFFIC SIGNAL & STREET LIGHT STANDARD CITY DETAILS

24 TRAFFIC INTERCONNECT PLAN, NOTES AND WIRING

TITLE SHEET

12 GRADING PLAN

17 SHEET NOT USED

13 EROSION CONTROL PLAN

25 STORM SEWER DETAIL SHEET

28 STREET DETAIL SHEET

29 STREET DETAIL SHEET

35 SHEET NOT USED

26 PAVEMENT MARKING DETAIL SHEET

27 SIGN AND TRAFFIC CONTROL DETAIL SHEET

30 TRAFFIC SIGNAL STANDARD CITY DETAILS

31 TRAFFIC SIGNAL STANDARD CITY DETAILS

33 STREET LIGHT STANDARD CITY DETAILS

36 NW PRYOR ROAD - CROSS-SECTIONS

37 NW PRYOR ROAD - CROSS-SECTIONS

34 EROSION CONTROL DETAIL SHEET

<u>DATUM BENCHMARK:</u>
VERTICAL DATUM IS NAVD 88 ESTABLISHED USING OPUS PROJECTS ON PROJECT CONTROL.

BM #1: CHISELED "SQUARE" ON TOP OF CURB POINT OF INTERSECTION OF WEST PARK PARKING LOT AT EAST DRIVE ENTRANCE.

BM #2: CHISELED "SQUARE" ON NORTHWEST CORNER AREA INLET, 25'± EAST OF CURB

ELEV=970.98

LINE AND ON-LINE WITH SOUTH CURB OF LOWENSTEIN DRIVE AT 90° BEND IN ROAD.


LEON D. OSBOURN ENGINEER MO # 021726

ENG G

DR TEIN PRYOR / LOWENST EETS OF NW PRYOF SUMMIT, I

A14_7067-1 LDO JT/BKR

7067-1SIG_TS

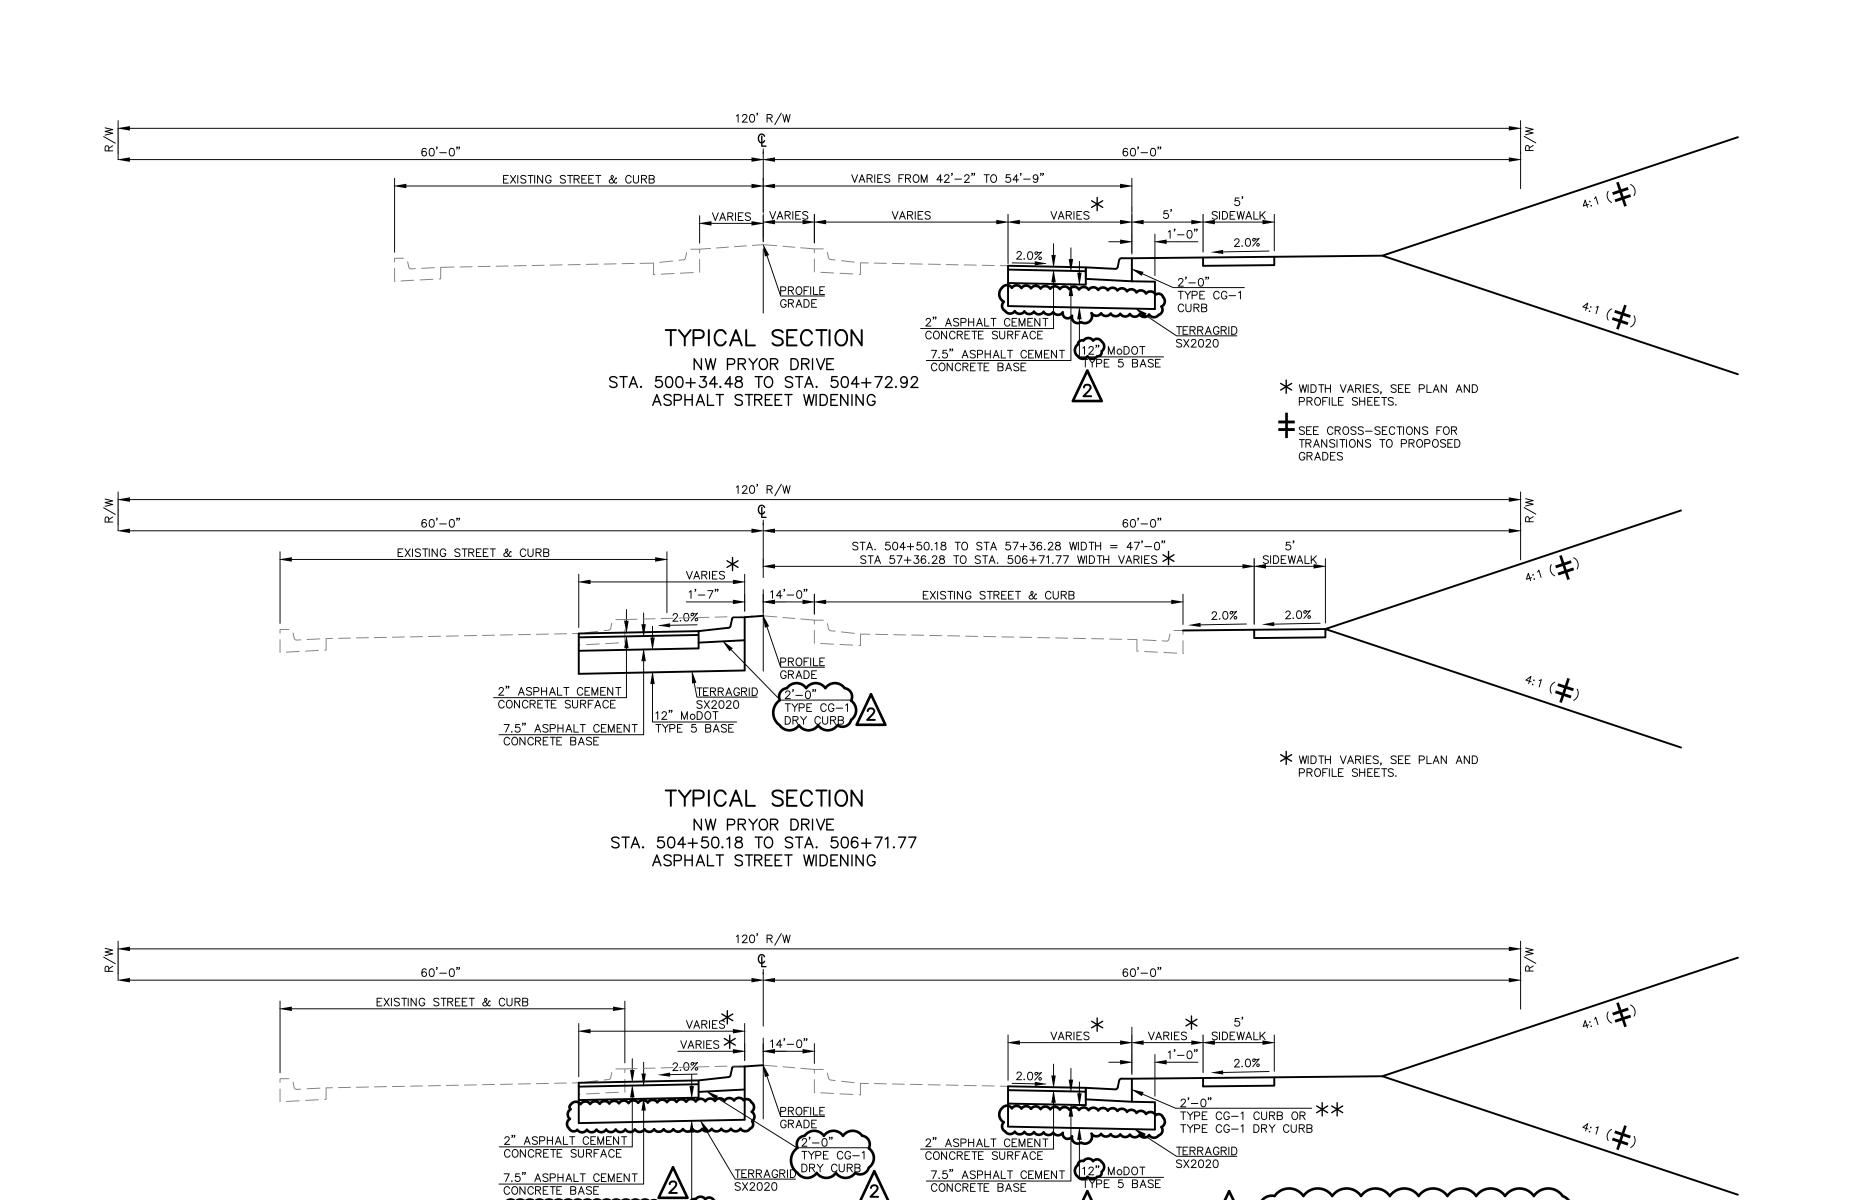

CONSTRUCTION NOTES:

1. EXCESS EXCAVATION SHALL BE DEPOSITED IN AREAS AS DIRECTED BY THE OWNER.

2. THE CONTRACTOR SHALL TAKE CARE NOT TO DAMAGE EXISTING SURFACING ON STREETS NEEDED TO BE TRAVELED UPON BY EQUIPMENT DURING CONSTRUCTION, AND IF DAMAGED, HE SHALL REPLACE THE SURFACING AND REPAIR THE STREET TO THE ORIGINAL CONDITION. NO TYPE OF EARTH MOVING EQUIPMENT WILL BE PERMITTED TO HAUL ON OR OVER ANY EXISTING

TYPICAL SECTION

NW PRYOR DRIVE STA. 506+71.77 TO STA. 510+49.39 ASPHALT STREET WIDENING

- 3. THE CONTRACTOR SHALL TAKE CARE IN PROTECTING EXISTING TREES AND SHRUBS OUTSIDE OF THE PROPOSED CONSTRUCTION. CARE SHALL BE TAKEN NOT TO DISTURB LAWNS OR EXISTING STRUCTURES OUTSIDE OF THE CONSTRUCTION LIMITS.
- 4. THE CONTRACTOR SHALL BE RESPONSIBLE FOR THE CONTROL OF DUST AND DIRT RISING AND SCATTERING IN THE AIR DURING CONSTRUCTION AND SHALL PROVIDE WATER SPRINKLING OR OTHER SUITABLE METHODS OF CONTROL. THE CONTRACTOR SHALL COMPLY WITH ALL GOVERNING REGULATIONS PERTAINING TO ENVIRONMENTAL PROTECTION.
- 5. CONTRACTOR SHALL SEED ALL DISTURBED AREAS IN ACCORDANCE TO REQUIREMENTS OF TECHNICAL SPECIFICATIONS. BUILDING LOTS WILL NOT REQUIRE SEEDING BUT ALL SLOPES AND BACKFILL BEHIND CURBS SHALL BE SEEDED WITHIN RIGHT-OF-WAY LIMITS, AND ON SLOPES OF EMBANKMENTS. AREAS SHALL BE SEEDED WITHIN 28 DAYS OF FINISH GRADING OR AS DIRECTED
- 6. JOINT SPACING FOR CONCRETE PAVEMENT SHALL BE MODIFIED TO MEET THE CONTRACTOR'S CONSTRUCTION EQUIPMENT AND METHODS OF POURING. CONTRACTOR TO DRILL AND INSERT EPOXY-COATED DOWEL BARS INTO CONSTRUCTION JOINTS AND HEADERS. CONTRACTOR TO SAW-CUT CLEAN VERTICAL EDGE AT JOINT LOCATION. SAWED CONTRACTION JOINTS SHALL BE REQUIRED ON MAXIMUM 12'-0" CENTERS.
- 7. CONTRACTOR SHALL SUBMIT A JOINTING PLAN AND RECEIVE APPROVAL FROM THE ENGINEER AND CITY PRIOR TO CONCRETE PAVING OPERATIONS.
- 8. ALL SANITARY SEWER, WATER MAINS AND STORM SEWER UNDER PAVEMENTS SHALL BE BACKFILLED WITH MODOT TYPE 5 AGGREGATE IN TRENCHES GREATER THAN 24" AND FLOWABLE IN TRENCHES LESS THAN 24".
- 9. CONTRACTOR SHALL INSTALL SILT FENCE TO PREVENT SEDIMENT FROM LEAVING CONSTRUCTION LIMITS. SILT FENCE IS REQUIRED AT BOTTOM OF SLOPE ON ALL EMBANKMENTS AND AT DISCHARGE POINTS OF STREETS, STORM SEWER INLETS AND PIPE END SECTIONS.

10. PIPE LENGTHS ARE CENTER TO CENTER OF STRUCTURE OR TO END OF END SECTIONS.

* WIDTH AND SLOPE VARIES.

FSEE CROSS-SECTIONS FOR TRANSITIONS TO PROPOSED

 $f{st}$ $f{st}$ curb type varies.

GRADES

SEE PLAN AND PROFILE SHEETS, GEOMETRIC LAYOUT SHEET AND CROSS-SECTIONS.

SEE GEOMETRIC LAYOUT SHEETS AND

11. THE CONSTRUCTION AREA SHALL BE CLEARED, GRUBBED, AND STRIPPED OF TOPSOIL AND ORGANIC MATTER FROM ALL AREAS TO BE OCCUPIED BY PAVING. TOPSOIL FOR REPLACEMENT ON SLOPES MAY BE STOCKPILED ON-SITE. EXCESS TOPSOIL MAY BE WASTED IN FILL SLOPES PROVIDED THAT NO TOPSOIL WILL BE WASTED WITHIN 10 FEET OF THE EDGE OF THE BUILDING OR PARKING AREA. BURNING OF TIMBER WILL NOT BE PERMITTED UNLESS APPROVAL IS OBTAINED FROM GOVERNING OFFICIALS. STRIPPING EXISTING TOPSOIL AND ORGANIC MATTER SHALL BE TO A MINIMUM DEPTH OF 6 INCHES.

12. CONTRACTOR SHALL COMPLETE ROUGH SITE AND STREET GRADING PRIOR TO INSTALLATION OF UTILITIES.

13. EROSION CONTROL SEDIMENT FENCE SHALL BE INSTALLED 1'-0" BEHIND CURB & GUTTER UPON COMPLETION OF BACKFILL OF CURB IN ALL AREAS WHERE SLOPES FROM LOT DRAIN TOWARDS CURB. UPON COMPLETION OF FINAL GRADING THE TOES OF ALL EMBANKMENTS IN EXCESS OF TWO FEET IN HEIGHT SHALL HAVE EROSION CONTROL SEDIMENT FENCE INSTALLED.

14. CUT AND FILL SECTIONS ARE TYPICAL ONLY. NEITHER ALTERNATE PAVEMENT TYPE IS SPECIFIED FOR EXCLUSIVE USE WITH CUT OR FILL SECTIONS. REFER TO SPECIFICATIONS FOR INFORMATION ON FLY ASH TREATED SUBGRADE, CRUSHED AGGREGATE BASE COURSE, AND PAVEMENT UNDERDRAINS.


15. WHERE CURB AND GUTTER IS MONOLITHIC WITH THE STREET, THE CURVE SHALL BE POURED AT THE SAME DEPTH AS THE STREET.

16. UNLESS SPECIFIED OTHERWISE, KCMMB 4K IS REQUIRED FOR ALL CONCRETE.

20. THE STANDARD SPECIFICATIONS AND DESIGN CRITERIA OF THE CITY OF LEE'S SUMMIT SHALL GOVERN THE CONSTRUCTION OF ALL PUBLIC IMPROVEMENTS FOR THIS PROJECT.

LEGEND SECTION CORNER, ORIGIN UNKNOWN UNLESS STORM SEWER MANHOLE OTHERWISE NOTED TELEPHONE SIGN O MONUMENT FOUND, ORIGIN UNCERTAIN UNLESS OTHERWISE NOTED TELEPHONE MANHOLE (D) DESCRIBED TELEPHONE PEDESTAL (M) MEASURED UNDERGROUND TELEPHONE LINE (C) CALCULATED □ SPLICE BOX (P) PLATTED FOC FIBER OPTIC CABLE SIGN FOC ---- UNDERGROUND FIBER OPTIC CABLE → STREET SIGN TRAFFIC CONTROL POLE □ UTILITY POLE PULL BOX UTILITY POLE W/ LIGHT FLAG POLE ■ UTILITY POLE W/TRANSFORMER MAILBOX □ LIGHT POLE ADA HANDICAP SIGN ← DEADMAN ANCHOR HANDICAP PAINTED SYMBOL OVERHEAD UTILITY - # LINES ■ LEFT TURN ARROW AIR CONDITIONING UNIT → STRAIGHT ARROW E ELECTRIC PEDESTAL RIGHT TURN ARROW E ELECTRIC METER GPO GATE POST ——— E ——— UNDERGROUND ELECTRIC LINE FENCE POST UTILITY MANHOLE --- WOOD FENCE CTV CABLE TV SIGN CABLE TV PEDESTAL BARBED WIRE FENCE GAS SIGN DECIDUOUS TREE W/SIZE & DRIP LINE G GAS METER ----- G ----- UNDERGROUND GAS LINE EVERGREEN TREE W/SIZE & DRIP LINE GTS GAS CATHODIC PROTECTION STATION SAPPLING TREE ----- W ----- WATER LINE P STUMP ⊗ WATER LINE GATE VALVE WS WATER SPIGOT TREE LINE W WATER METER (10) PARKING STALL COUNT WELL ____ 970 ___ 1' CONTOUR INTERVAL TIRE HYDRANT S SANITARY SEWER MANHOLE | RESTRICTED ACCESS SANITARY SEWER LINE B/B BACK OF CURB TO BACK OF CURB

E/E EDGE TO EDGE

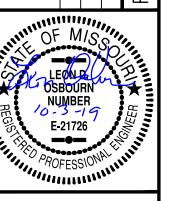


LEON D. OSBOURN ENGINEER MO # 021726

NEERING P.O. BOX 1304 ANSAS 66441 AX (785) 762-Ž

EIN AND LANE RUCTION NO

PRY

STRI NWQ I LEE'S A14_7067-1 DESIGNER | DRAWN B LDO JT/BKR 7067-1SIG_TYP

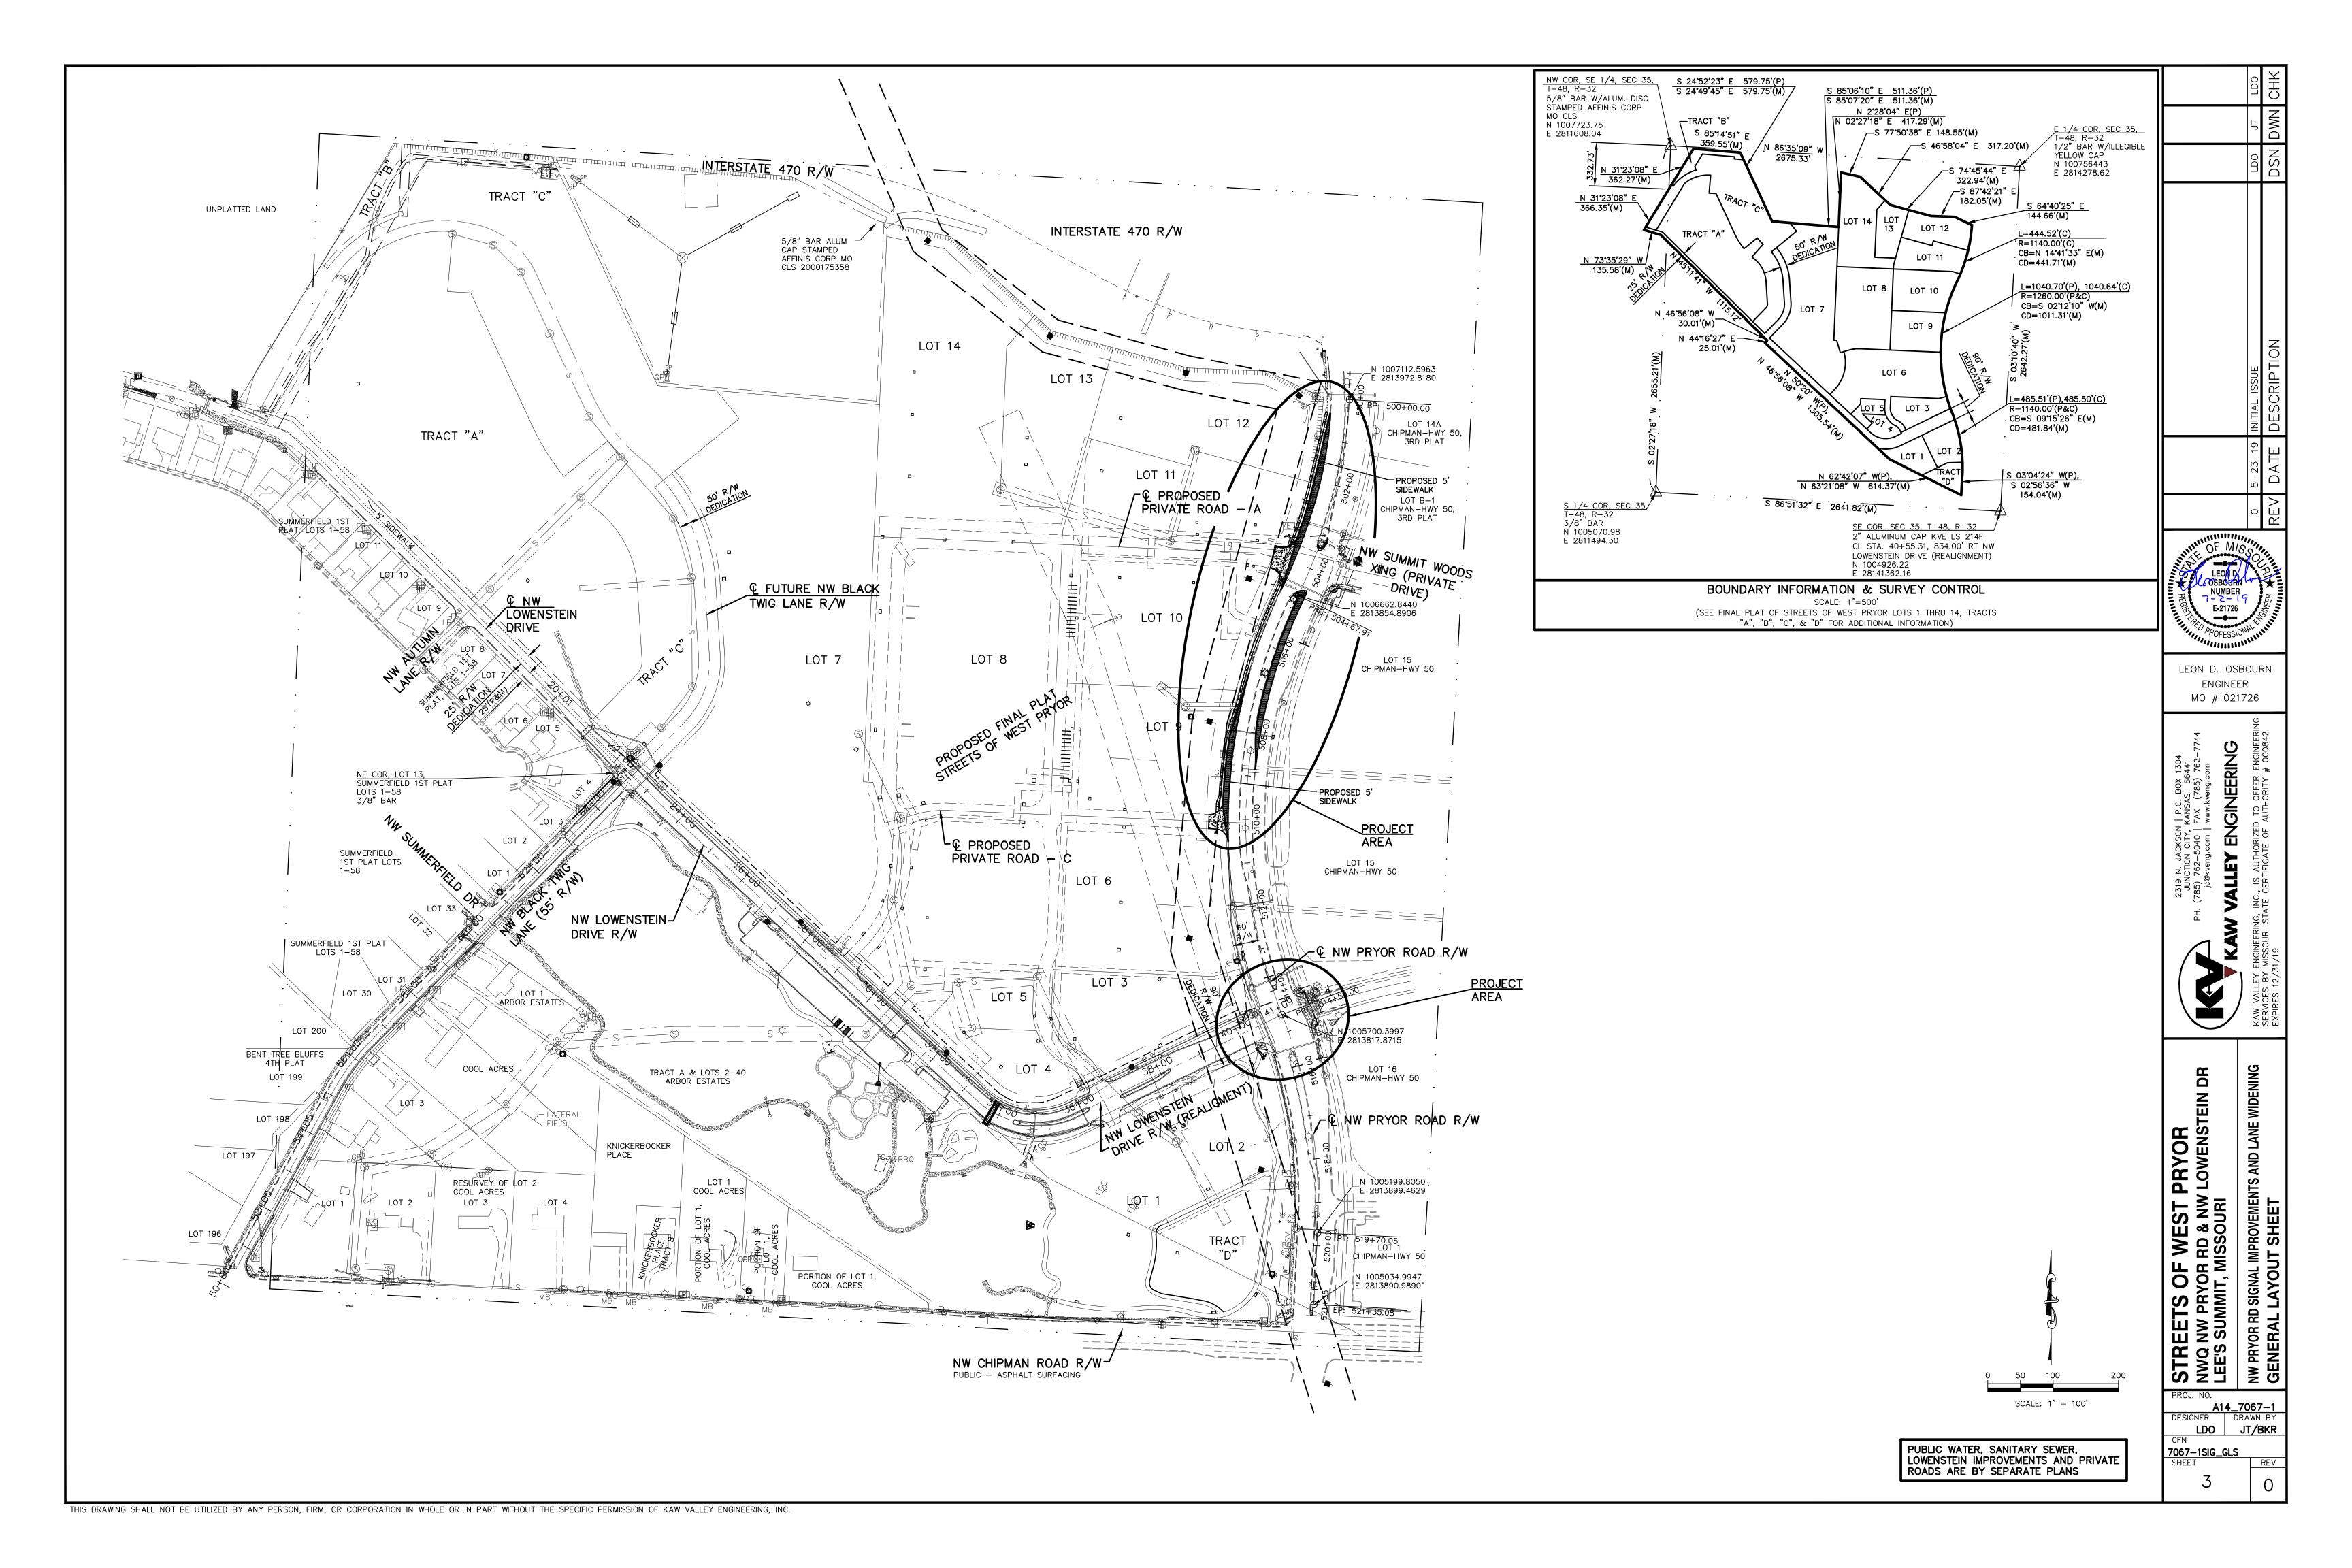

GENERAL NOTES:

STATE REGULATIONS.

FEDERAL REGULATIONS.

CONFLICT WITH PROPOSED IMPROVEMENTS SHOWN ON THE PLANS. SHALL BE REMOVED AS NECESSARY TO CONSTRUCT IMPROVEMENTS SHOWN ON THESE

LOT 14A CHIPMAN-HWY 50, 3RD PLAT

3.5' DIA MANHOLE

OF THE WORK. THIS REQUIREMENT WILL APPLY CONTINUOUSLY AND NOT BE LIMITED TO NORMAL WORKING HOURS.

CAUTION - NOTICE TO CONTRACTOR

THE CONTRACTOR IS SPECIFICALLY CAUTIONED THAT THE

ON THESE PLANS IS BASED ON RECORDS OF THE VARIOUS

UTILITY COMPANIES AND, WHERE POSSIBLE, MEASUREMENTS

ON AS BEING EXACT OR COMPLETE. THE CONTRACTOR MUST CALL THE APPROPRIATE UTILITY COMPANY AT LEAST 72 HOURS

OF UTILITIES. IT SHALL BE THE RESPONSIBILITY OF THE

THE CONTRACTOR SHALL EXPOSE EXISTING UTILITIES AT

LOCATIONS OF POSSIBLE CONFLICTS PRIOR TO ANY

CONSTRUCTION.

CONTRACTOR TO RELOCATE ALL EXISTING UTILITIES WHICH

TAKEN IN THE FIELD. THE INFORMATION IS NOT TO BE RELIED

BEFORE ANY EXCAVATION TO REQUEST EXACT FIELD LOCATION

LOCATION AND/OR ELEVATION OF EXISTING UTILITIES AS SHOWN

IN(E) 15"RCP=962.89

L OÙT(NW) 15"RCP=962.32

SAW CUT-

ELECTRIC BOX MARKED MODOT LIGHTING CONTROL - CONCRETE

SIDEWALK

LINE

4. ALL PAVING WITHIN PROPERTY TO BE REMOVED AND DISPOSED OF IN CONFORMANCE WITH LOCAL, STATE AND FEDERAL REGULATIONS. SAFETY NOTICE TO CONTRACTOR IN ACCORDANCE WITH GENERALLY ACCEPTED CONSTRUCTION 5. ALL HAZARDOUS ASBESTOS AND OTHER HAZARDOUS MATERIALS MUST BE PRACTICES, THE CONTRACTOR WILL BE SOLELY AND COMPLETELY IDENTIFIED AND REMOVED PRIOR TO ANY BUILDING DEMOLITION, IN STRICT RESPONSIBLE FOR CONDITIONS OF THE JOB SITE, INCLUDING SAFETY OF ALL PERSONS AND PROPERTY DURING PERFORMANCE

CONFORMANCE WITH LOCAL, STATE AND FEDERAL REGULATIONS. BEEN DISCONNECTED PRIOR TO COMMENCING DEMOLITION.

6. CONTRACTOR SHALL VERIFY THAT ALL UTILITIES TO EXISTING STRUCTURES HAVE

CONTRACTOR SHALL VERIFY SITE CONDITIONS PRIOR TO BIDDING. CONTRACTOR

AND ALL OTHER STRUCTURES FROM WITHIN PROPERTY LINES EXCEPT AS DESIGNATED

SHALL REMOVE ALL BUILDINGS, UTILITIES, PAVEMENT, FOUNDATIONS, FENCES, CURBS

SPECIFICATIONS AND THE CITY OF LEE'S SUMMIT AND STATE REGULATIONS. SITE

2. ALL UTILITY PIPE LINES TO BE ABANDONED SHALL BE PLUGGED PER CITY AND

3. DRIVES, PAVING AND OTHER STRUCTURES ON STREET OR HIGHWAY RIGHT-OF-WAY

PLANS. REMOVAL AND DISPOSAL SHALL BE IN CONFORMANCE WITH LOCAL, STATE AND

"TO REMAIN" OR "TO BE REMOVED BY OTHERS", IN ACCORDANCE WITH THE

CONDITIONS SHOWN WERE AS OF MARCH 30, 2018.

POWER & LIGHT.

DEMOLITION.

11. KCP&L TRANSMISSION MAIN SHALL REMAIN IN PLACE DURING DEMOLITION. FOLLOW ALL KCP&L REQUIREMENTS CONCERNING WORK IN THEIR EASEMENT AND IN PROXIMITY TO THEIR LINES, INCLUDING PROTECTION OF POLES AND SAFE WORKING DISTANCES FROM

9. COORDINATE WITH KAW VALLEY ENGINEERING PRIOR TO REMOVAL OF SECTION MONUMENTS AND PROPERTY PINS. KAW VALLEY ENGINEERING WILL RESET NECESSARY MONUMENTS WITHIN THE DISTURBED AREAS FOLLOWING DEMOLITION. CARE SHALL BE TAKEN TO PRESERVE PROPERTY PINS ALONG THE OUTSIDE PERIMETER OF THE SITE.

7. EXISTING POWER LINES AND APPURTENANCES TO BE RELOCATED BY KANSAS CITY

INITIAL CLEARING AND GRUBBING HAS BEEN COMPLETED. CONTRACTOR SHALL REMOVE

8. TREE LINES AND INDIVIDUAL TREES SHOWN ARE BASED ON ORIGINAL SURVEY.

ANY ADDITIONAL TREES AND SHRUB IN AREAS INDICATED FOR GRADING AND

TEMPORARY 15'
CONSTRUCTION ESMT

INST. NO. 2019E0024032

EDGE OF LANDSCAPING

FIBER OPTIC -

4.5' TALL TRAFFIC CONTROLLER CABINET

ON CONCRETE PAD

SANITARY M.
TOP=972.71
FL IN(S) 8"PMO
FL OLIT

PULL BOX

20' UTILITY &
SETBACK EASEMENT

20' WATER EASEMENT

FL IN(W) 42"RCP=956.07 FL OUT(E) 42"RCP=954.77

FL IN(SW) 42"RCP=958.86

CONCRETE -

SIDEWALK

L OÙT(ŚE) 42"RCP=958.66

TRACT B-1 CHIPMAN-HWY 50, 3RD PLAT

PAVING TO REMAIN

CONCRETE.

€ NW PRYOR ROAD¬

(120' R/W)
PUBLIC - ASPHALT STREET

MAINTENANCE BEGINS

LACK OF
ABUTTERS RIGHTS

LOT 12

DOC NO. 2007E0074065

10. CONTRACTOR SHALL OBTAIN DEMOLITION PERMITS FOR EACH INDIVIDUAL HOUSE WITHIN THE AREA SHOWN. ALL SERVICE LINE SHUT-OFFS, WELL PLUGGING, SEPTIC TANK REMOVALS AND OTHER UTILITY REMOVALS SHALL BE HANDLED IN ACCORDANCE WITH STATE AND CITY CODES.

LEGEND NOT A PART OF DEMOLITION ACTIVITIES --- SAW CUT LIMITS

(65) TRAFFIC POLE TO BE RELOCATED. (SEE PLANS)

DATUM BENCHMARK:
VERTICAL DATUM IS NAVD 88 ESTABLISHED USING OPUS PROJECTS ON PROJECT CONTROL. **BENCHMARKS:**

BEND IN ROAD.

BM #1: CHISELED "SQUARE" ON TOP OF CURB POINT OF INTERSECTION OF WEST PARK PARKING LOT AT EAST DRIVE ENTRANCE. ELEV=984.97 BM #2: CHISELED "SQUARE" ON NORTHWEST CORNER

SCALE: 1" = 20'

AREA INLET, 25'± EAST OF CURB LINE AND ON-LINE WITH SOUTH CURB OF LOWENSTEIN DRIVE AT 90°

ELEV=970.98

7067-1SIG_DEMO

A14_7067-1DESIGNER DRAWN BY LDO JT/BKR

STRI NWQ I LEE'S

F WEST I NW PRYOF SUMMIT, I

PRY LOWI

EIN

Ž

ENGINEER MO # 021726

LEON D. OSBOURN

506+00

SAW CUT LINE

SANITARY MANHOLE TOP=975.91

L IN(S) 8"PVC=966.22

OUT(N) 8"PVC=966.16

CHIPMAN-HWY 50

INST. NO. 2019E0024032

TEMPORARY 33'
CONSTRUCTION ESMT

PAVING TO REMAIN

1/2" BAR -OLSSON CAP

LOT 10

(8) PORTION OF RETAINING WALL TO BE REMOVED (SEE PLANS)

(50) CONTRACTOR TO SAND BLAST STRIPING (SEE PAVEMENT MARKING SHEETS)

(66) TRAFFIC POLE TO BE REMOVED AND RETURNED TO THE CITY OF LEES SUMMIT

-SAW CUT LINE

DEMOLITION NOTES:

(2) REMOVE TREE (SEE PLANS)

(7) SIGN TO BE RELOCATED

(11) TO BE REMOVED BY ELECTRIC COMPANY

(39) CONTRACTOR TO REMOVE (CURBS)

(46) CONTRACTOR TO REMOVE (PAVING)

(44) CONTRACTOR TO REMOVE (SIDEWALK)

(24) STREET LIGHT TO BE RELOCATED (SEE PLANS)

(3) TREES TO REMAIN

 \langle 1 \rangle to remain

-SAW CUT LINE

CONCRETI

FL OUT(E) 8"PVC=964.66


FL IN(S)30"RCP=968.00 FL OUT(W)30"RCP=967.75 CURB_INLET_(CONCRETE)
RIM=973.14
FL_IN(E)30"RCP=965.34 FL OUT(W)36"RCP=964.14


1/2" BAR


FL IN(S) 42"RCP=960.45 FL IN(E) 30"RCP=961.25


FL OUT(N) 42"RCP=960.40


W/OLSSON KSLC 114 MO LC 366 CAP

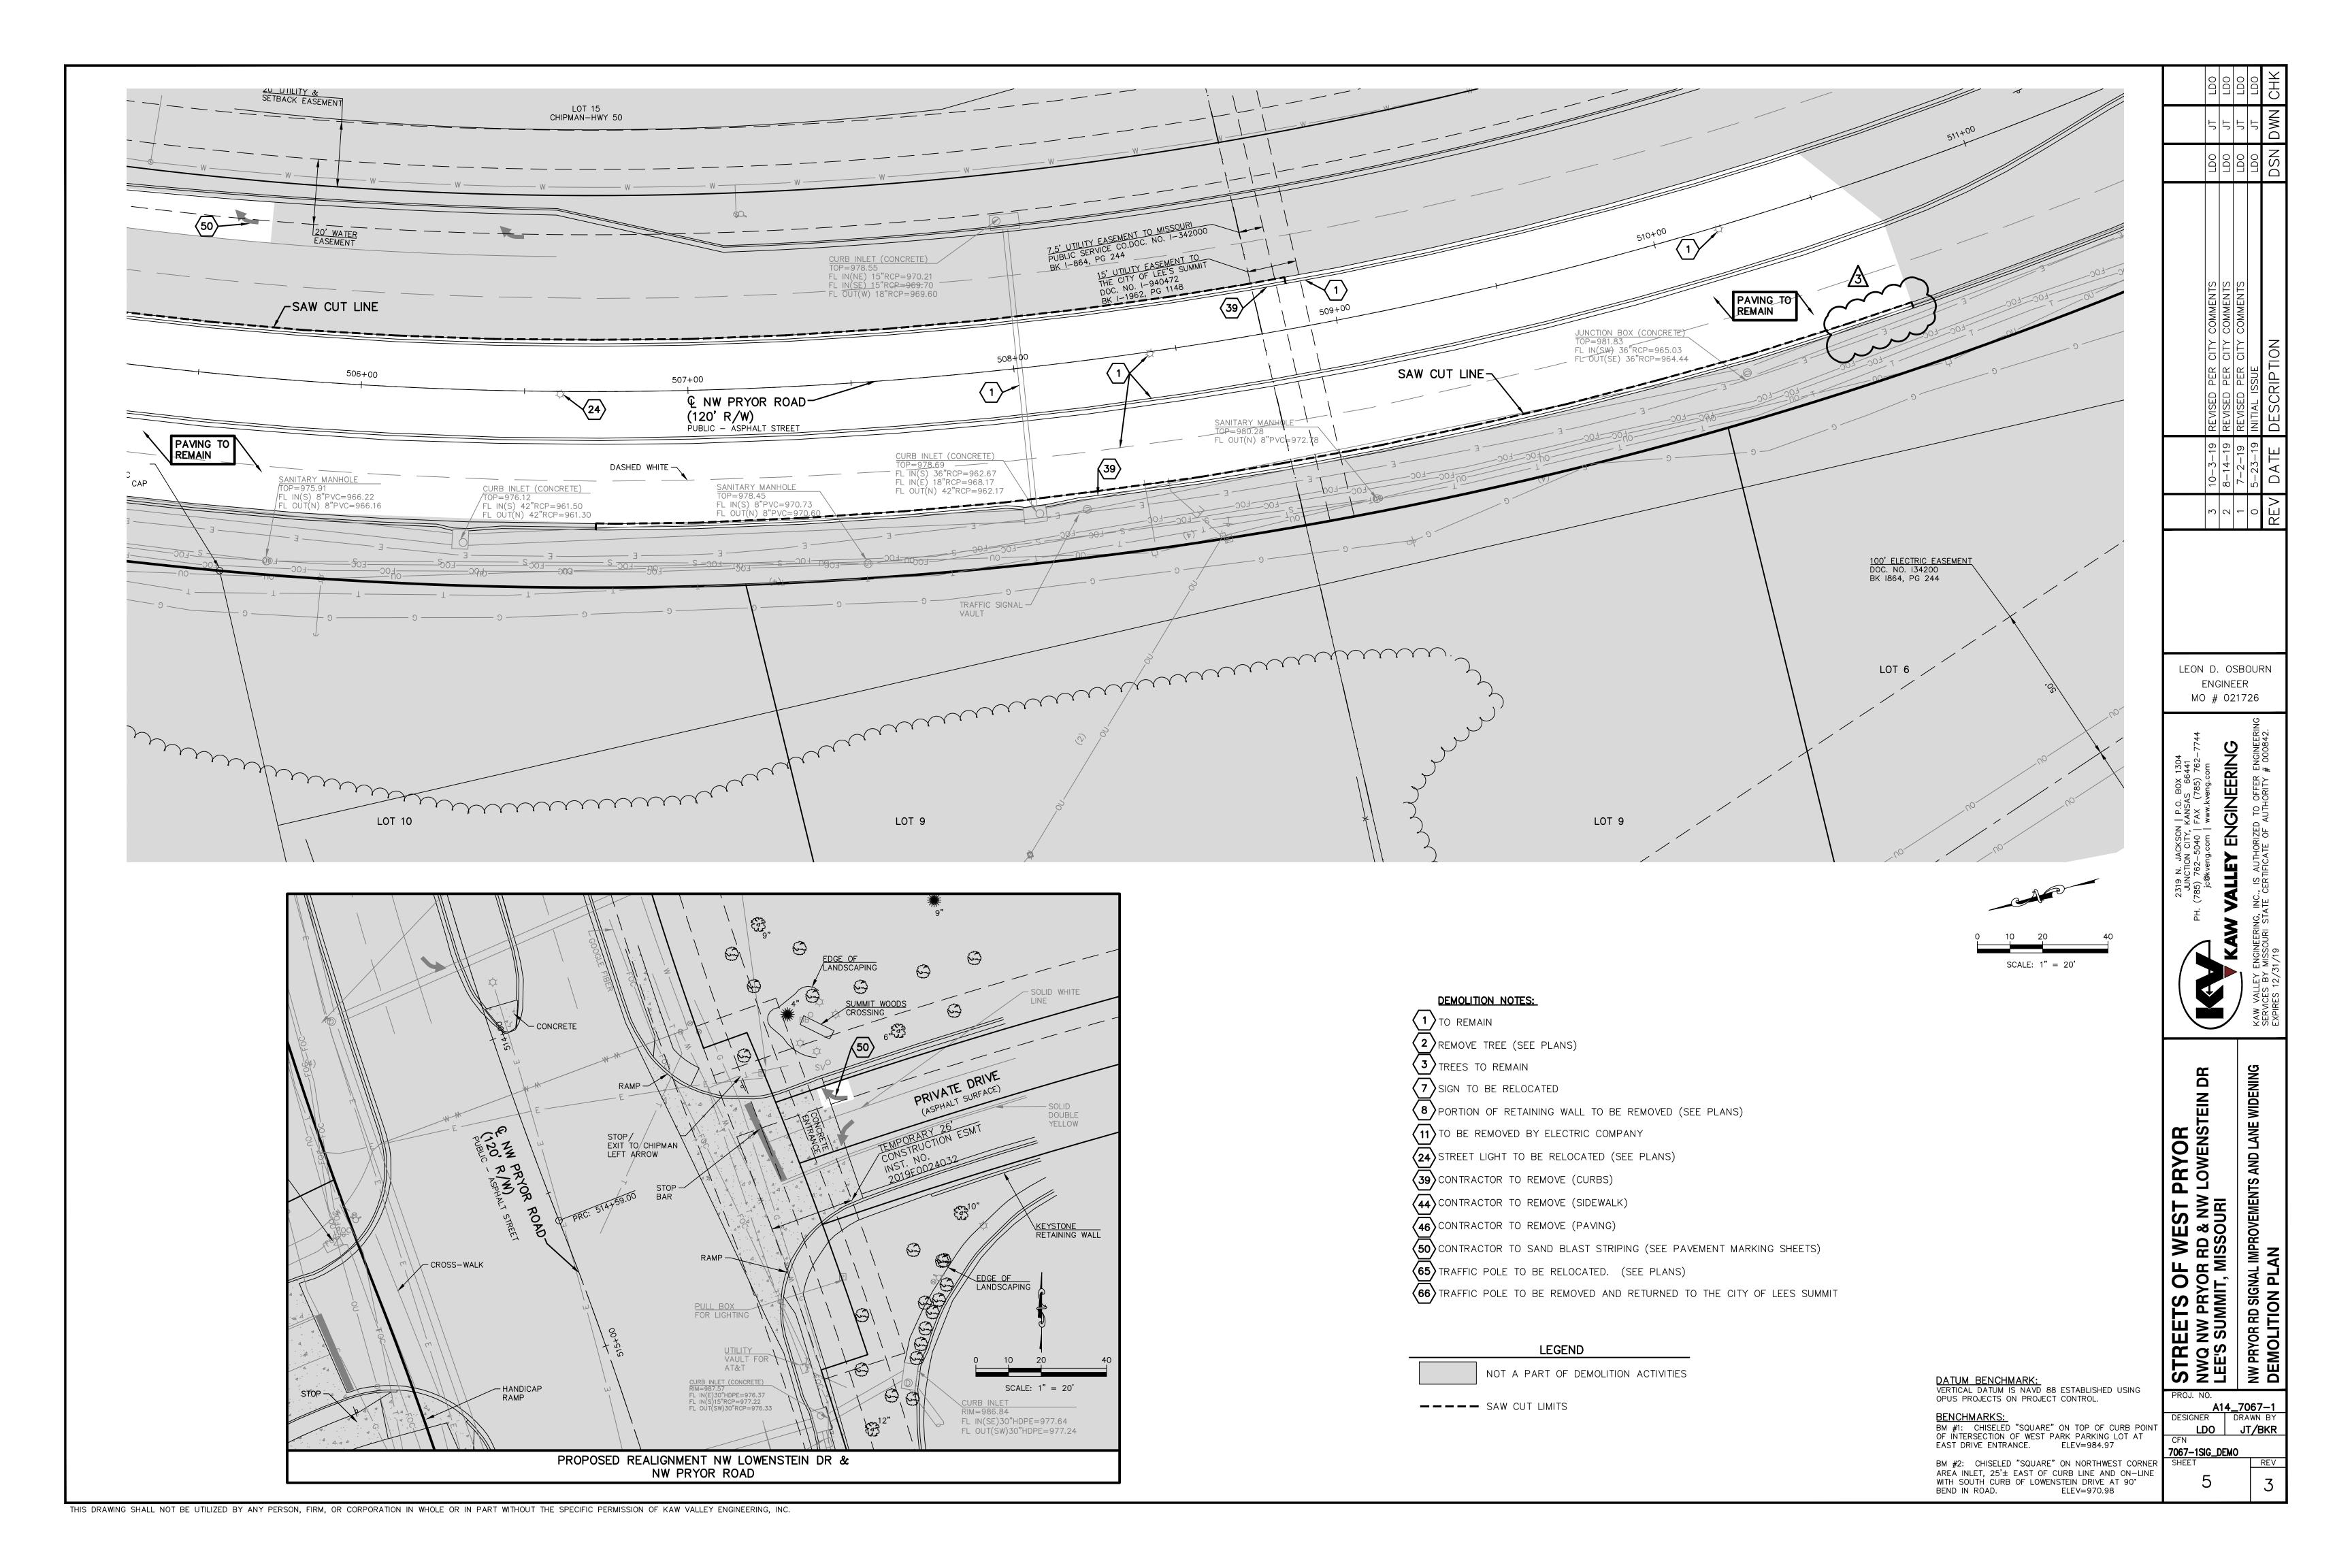


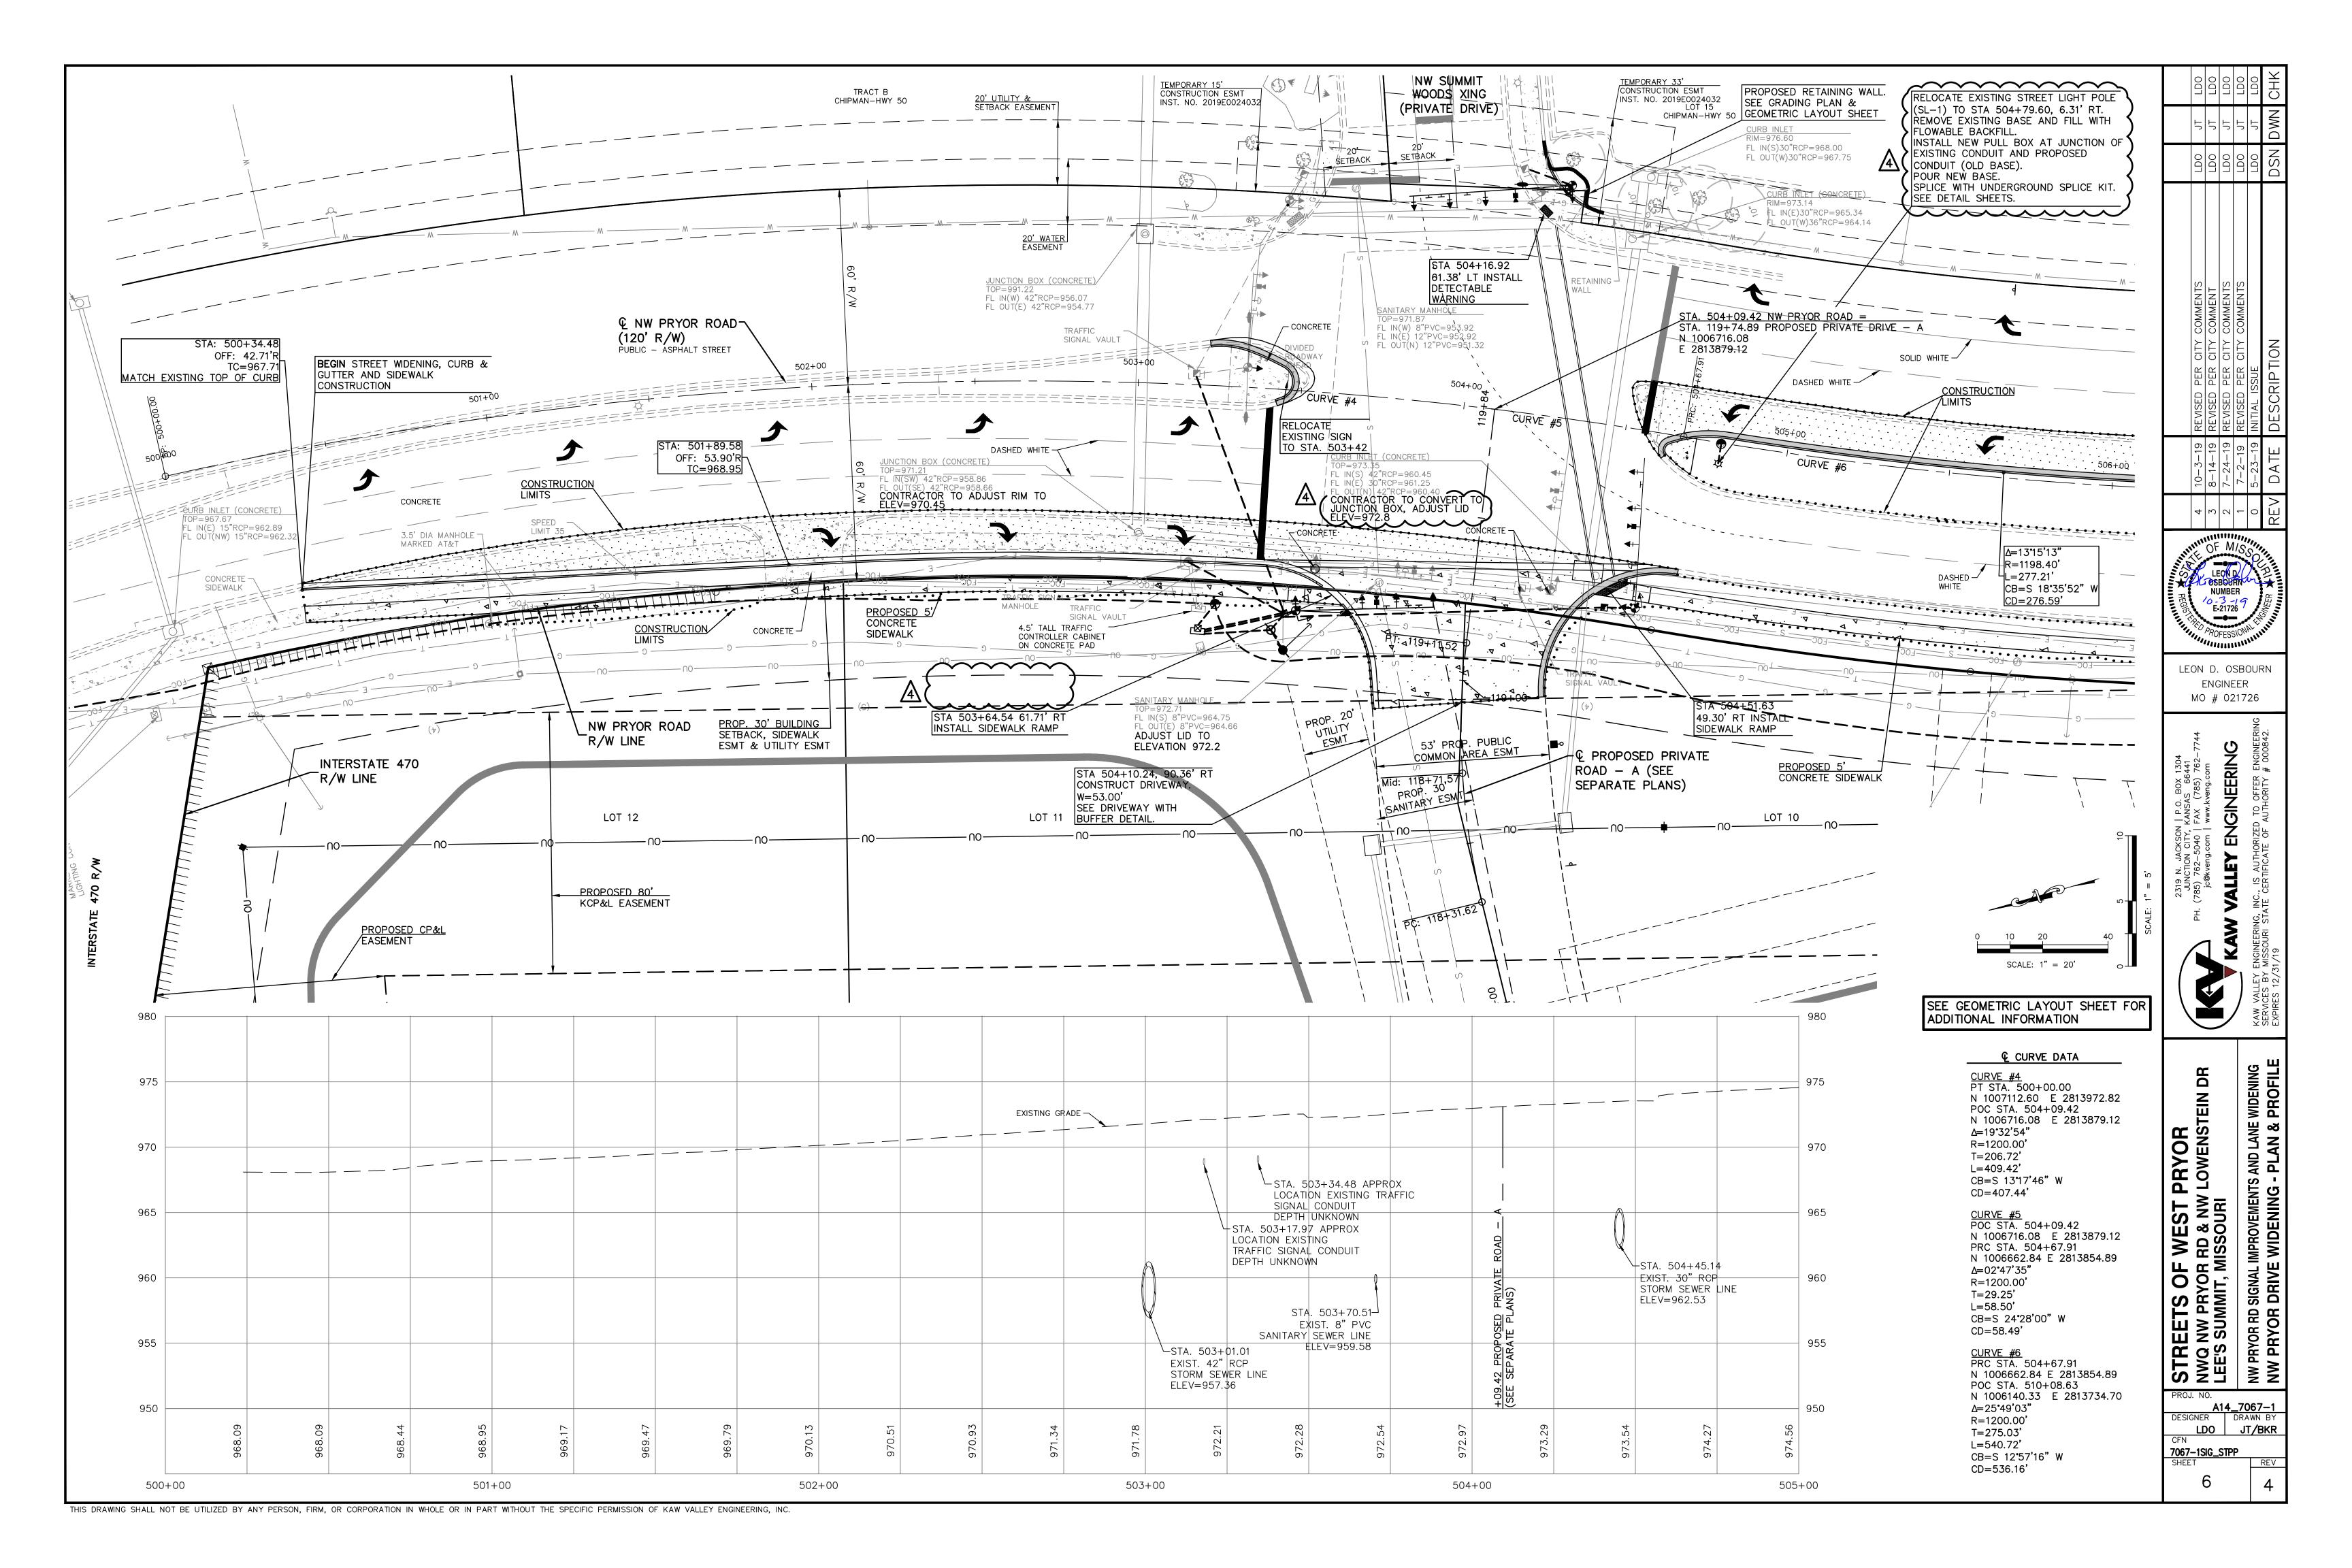


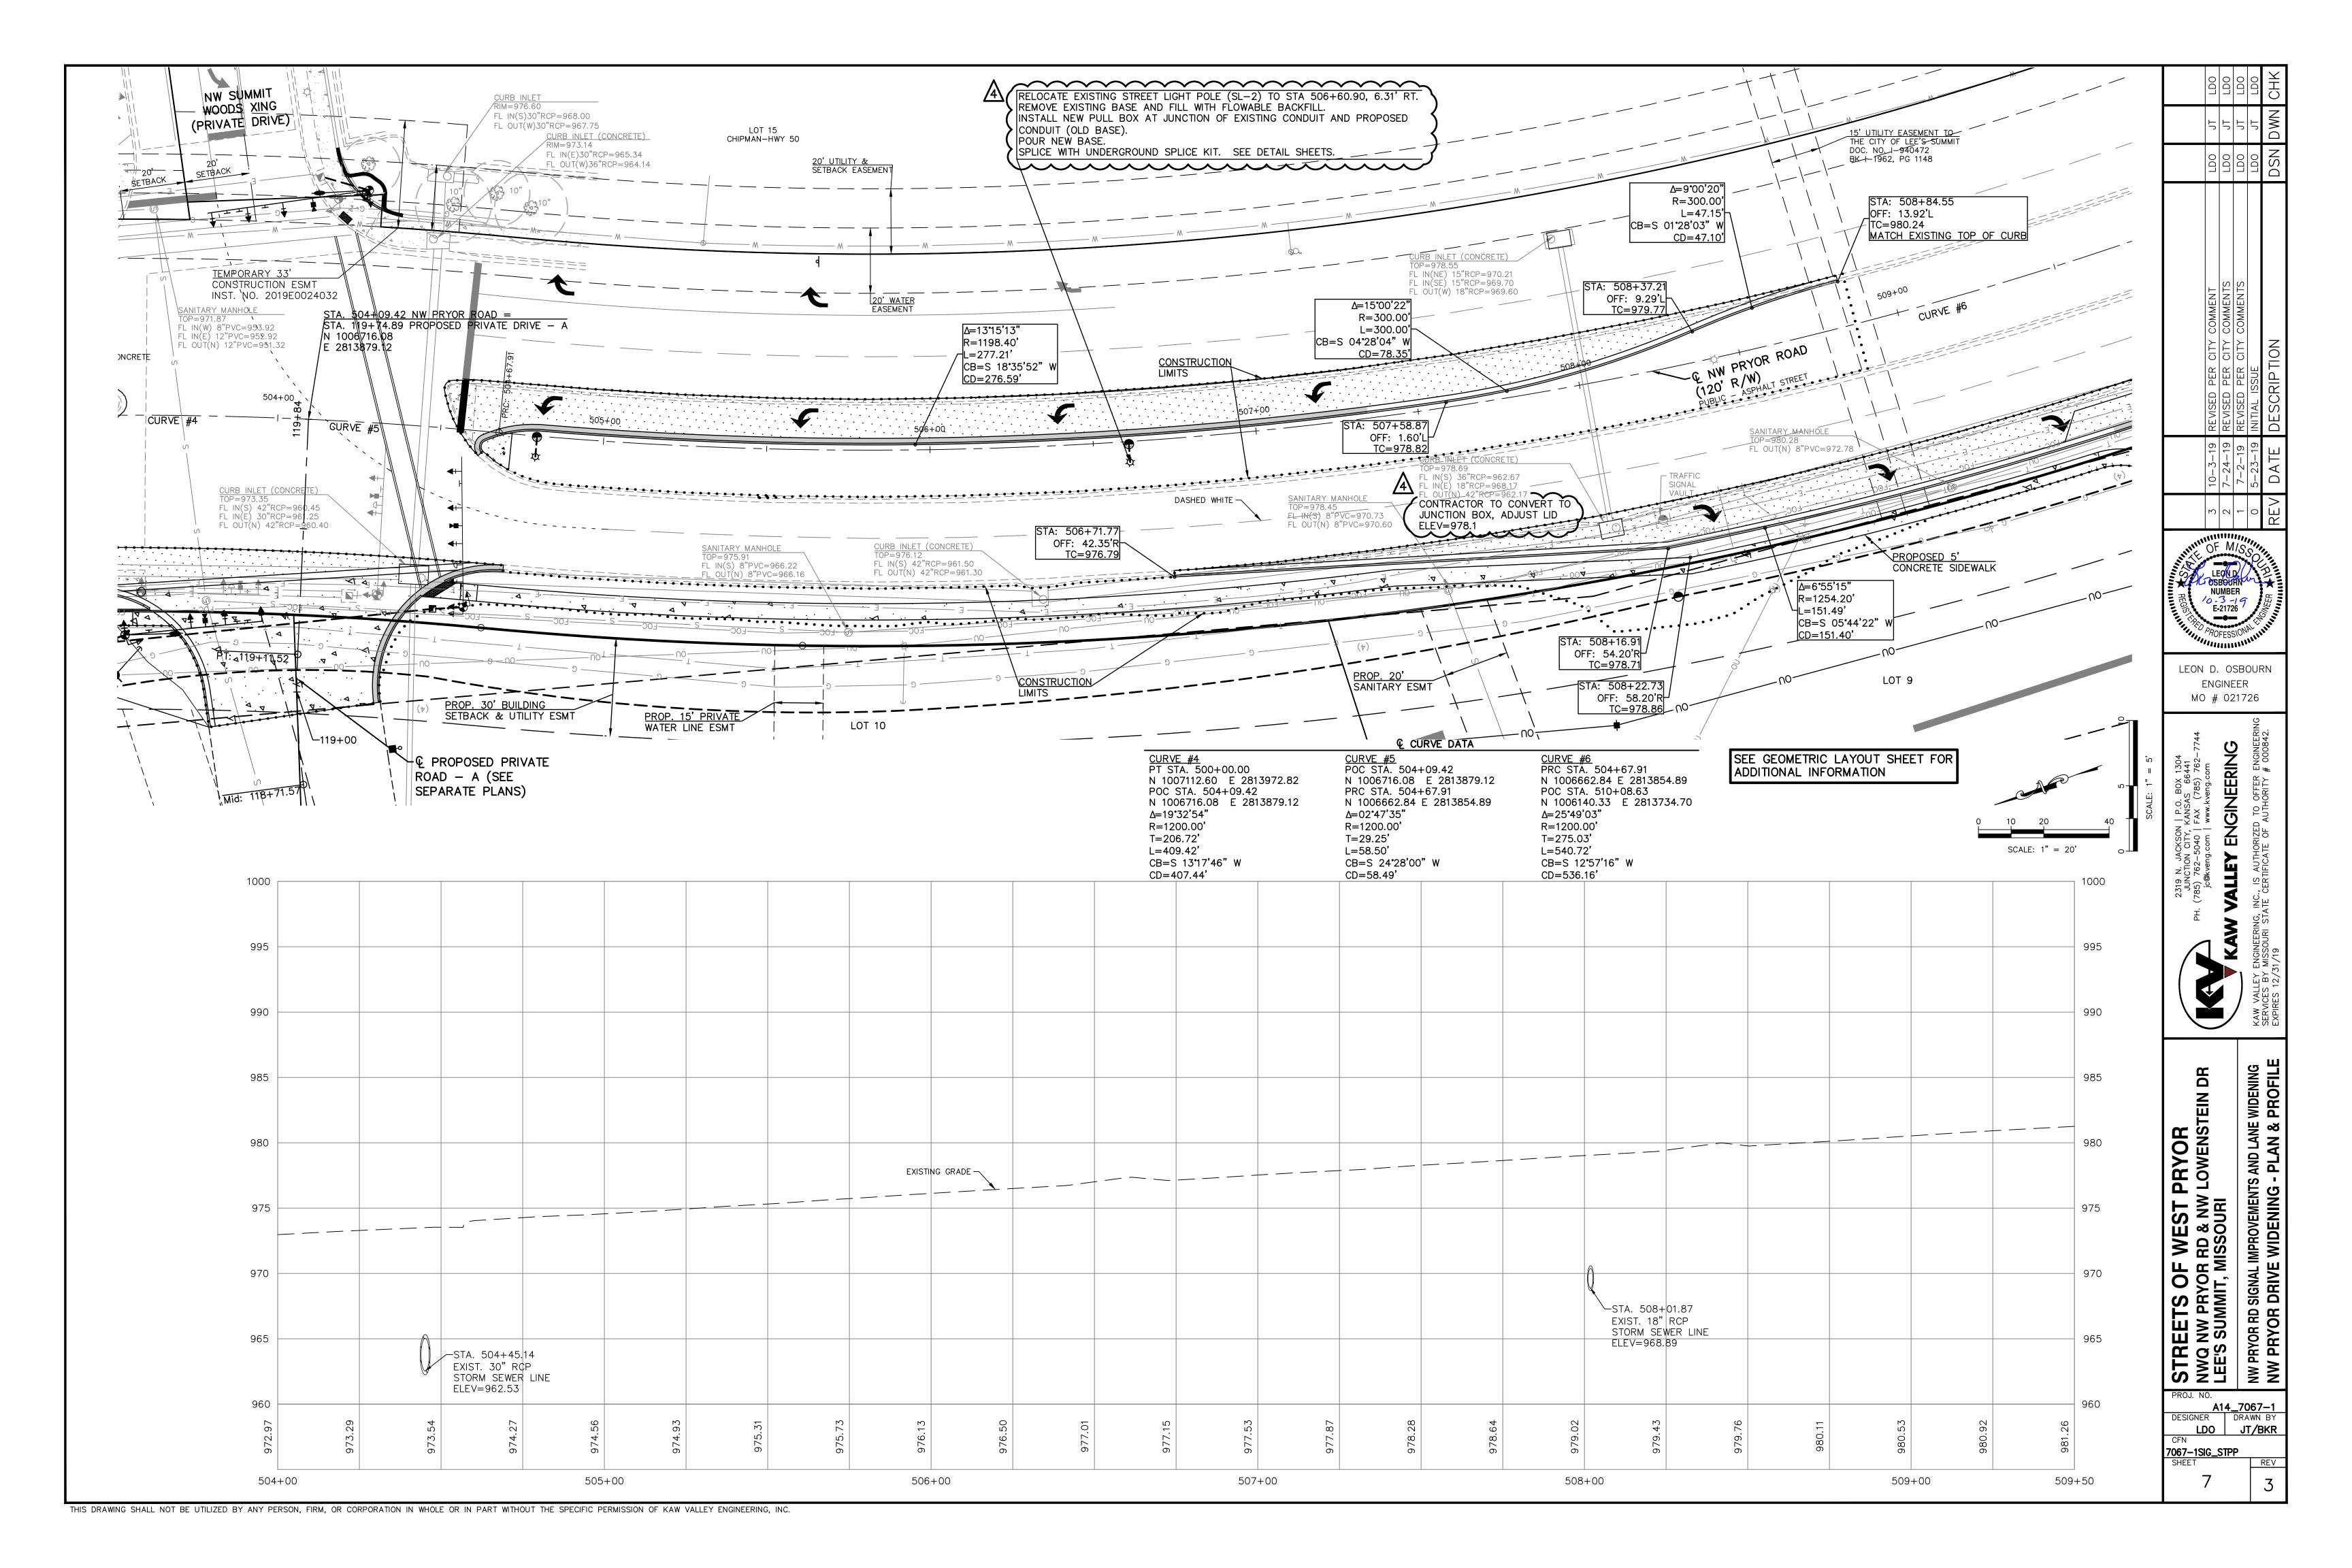


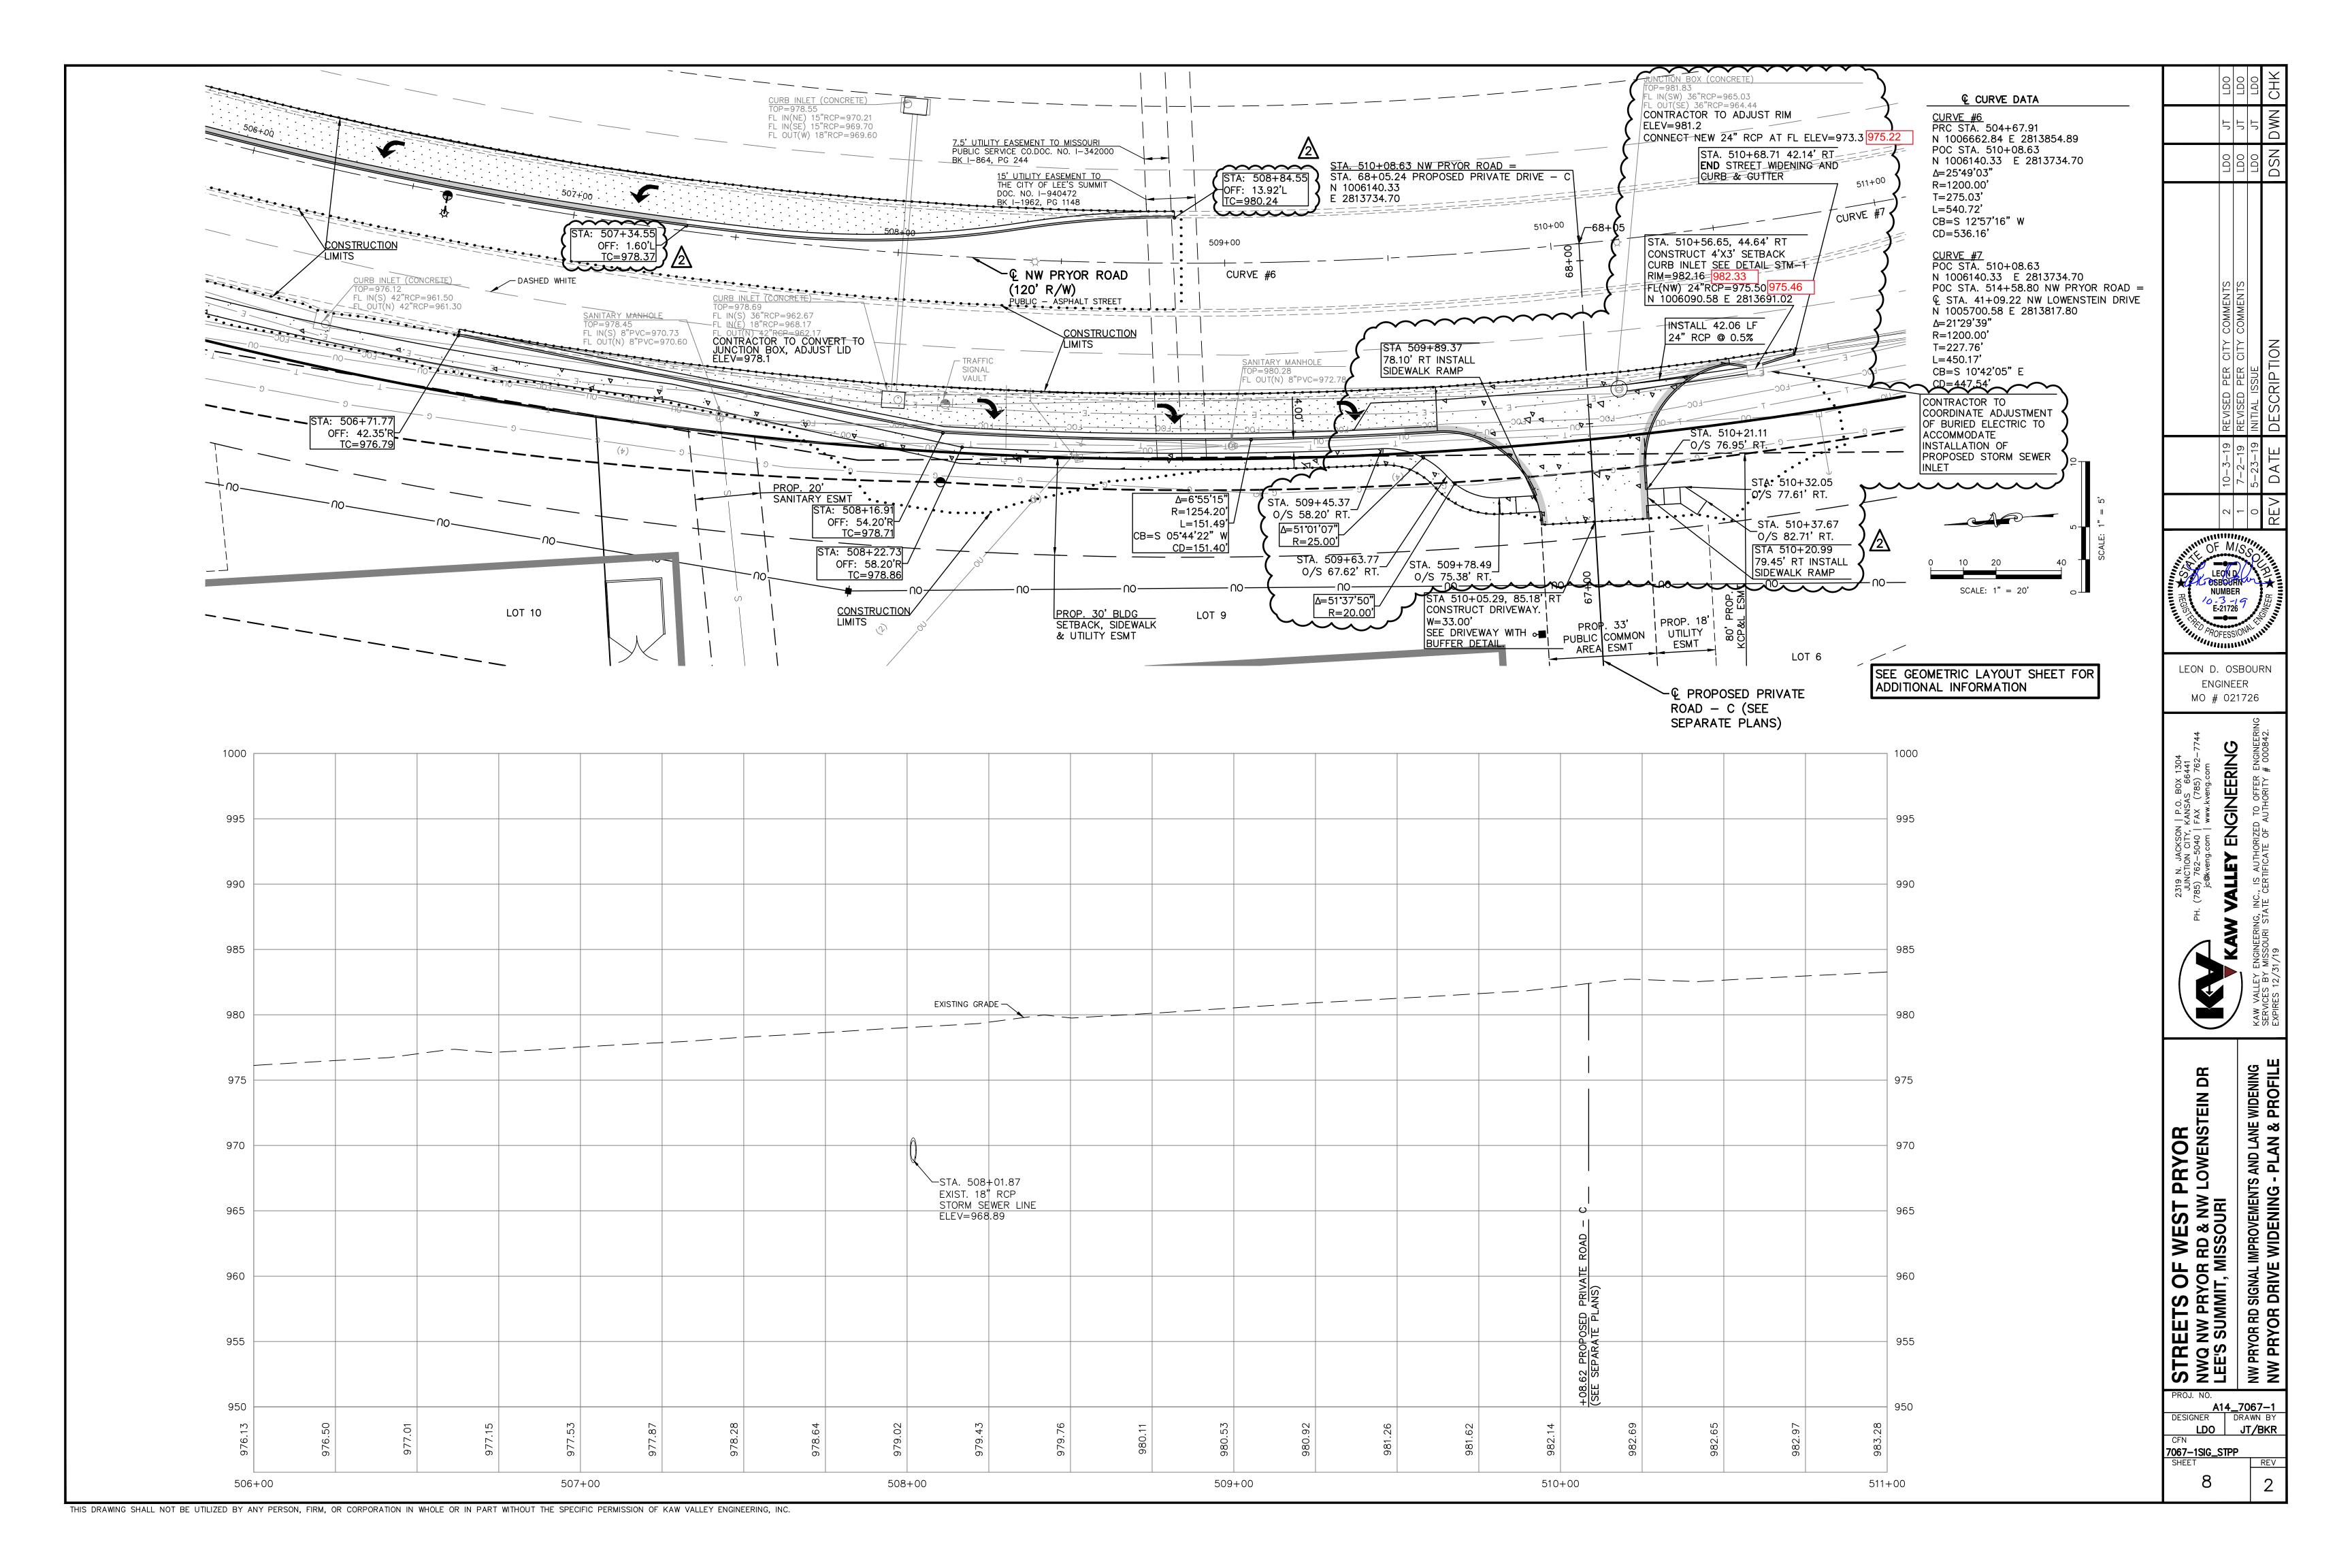


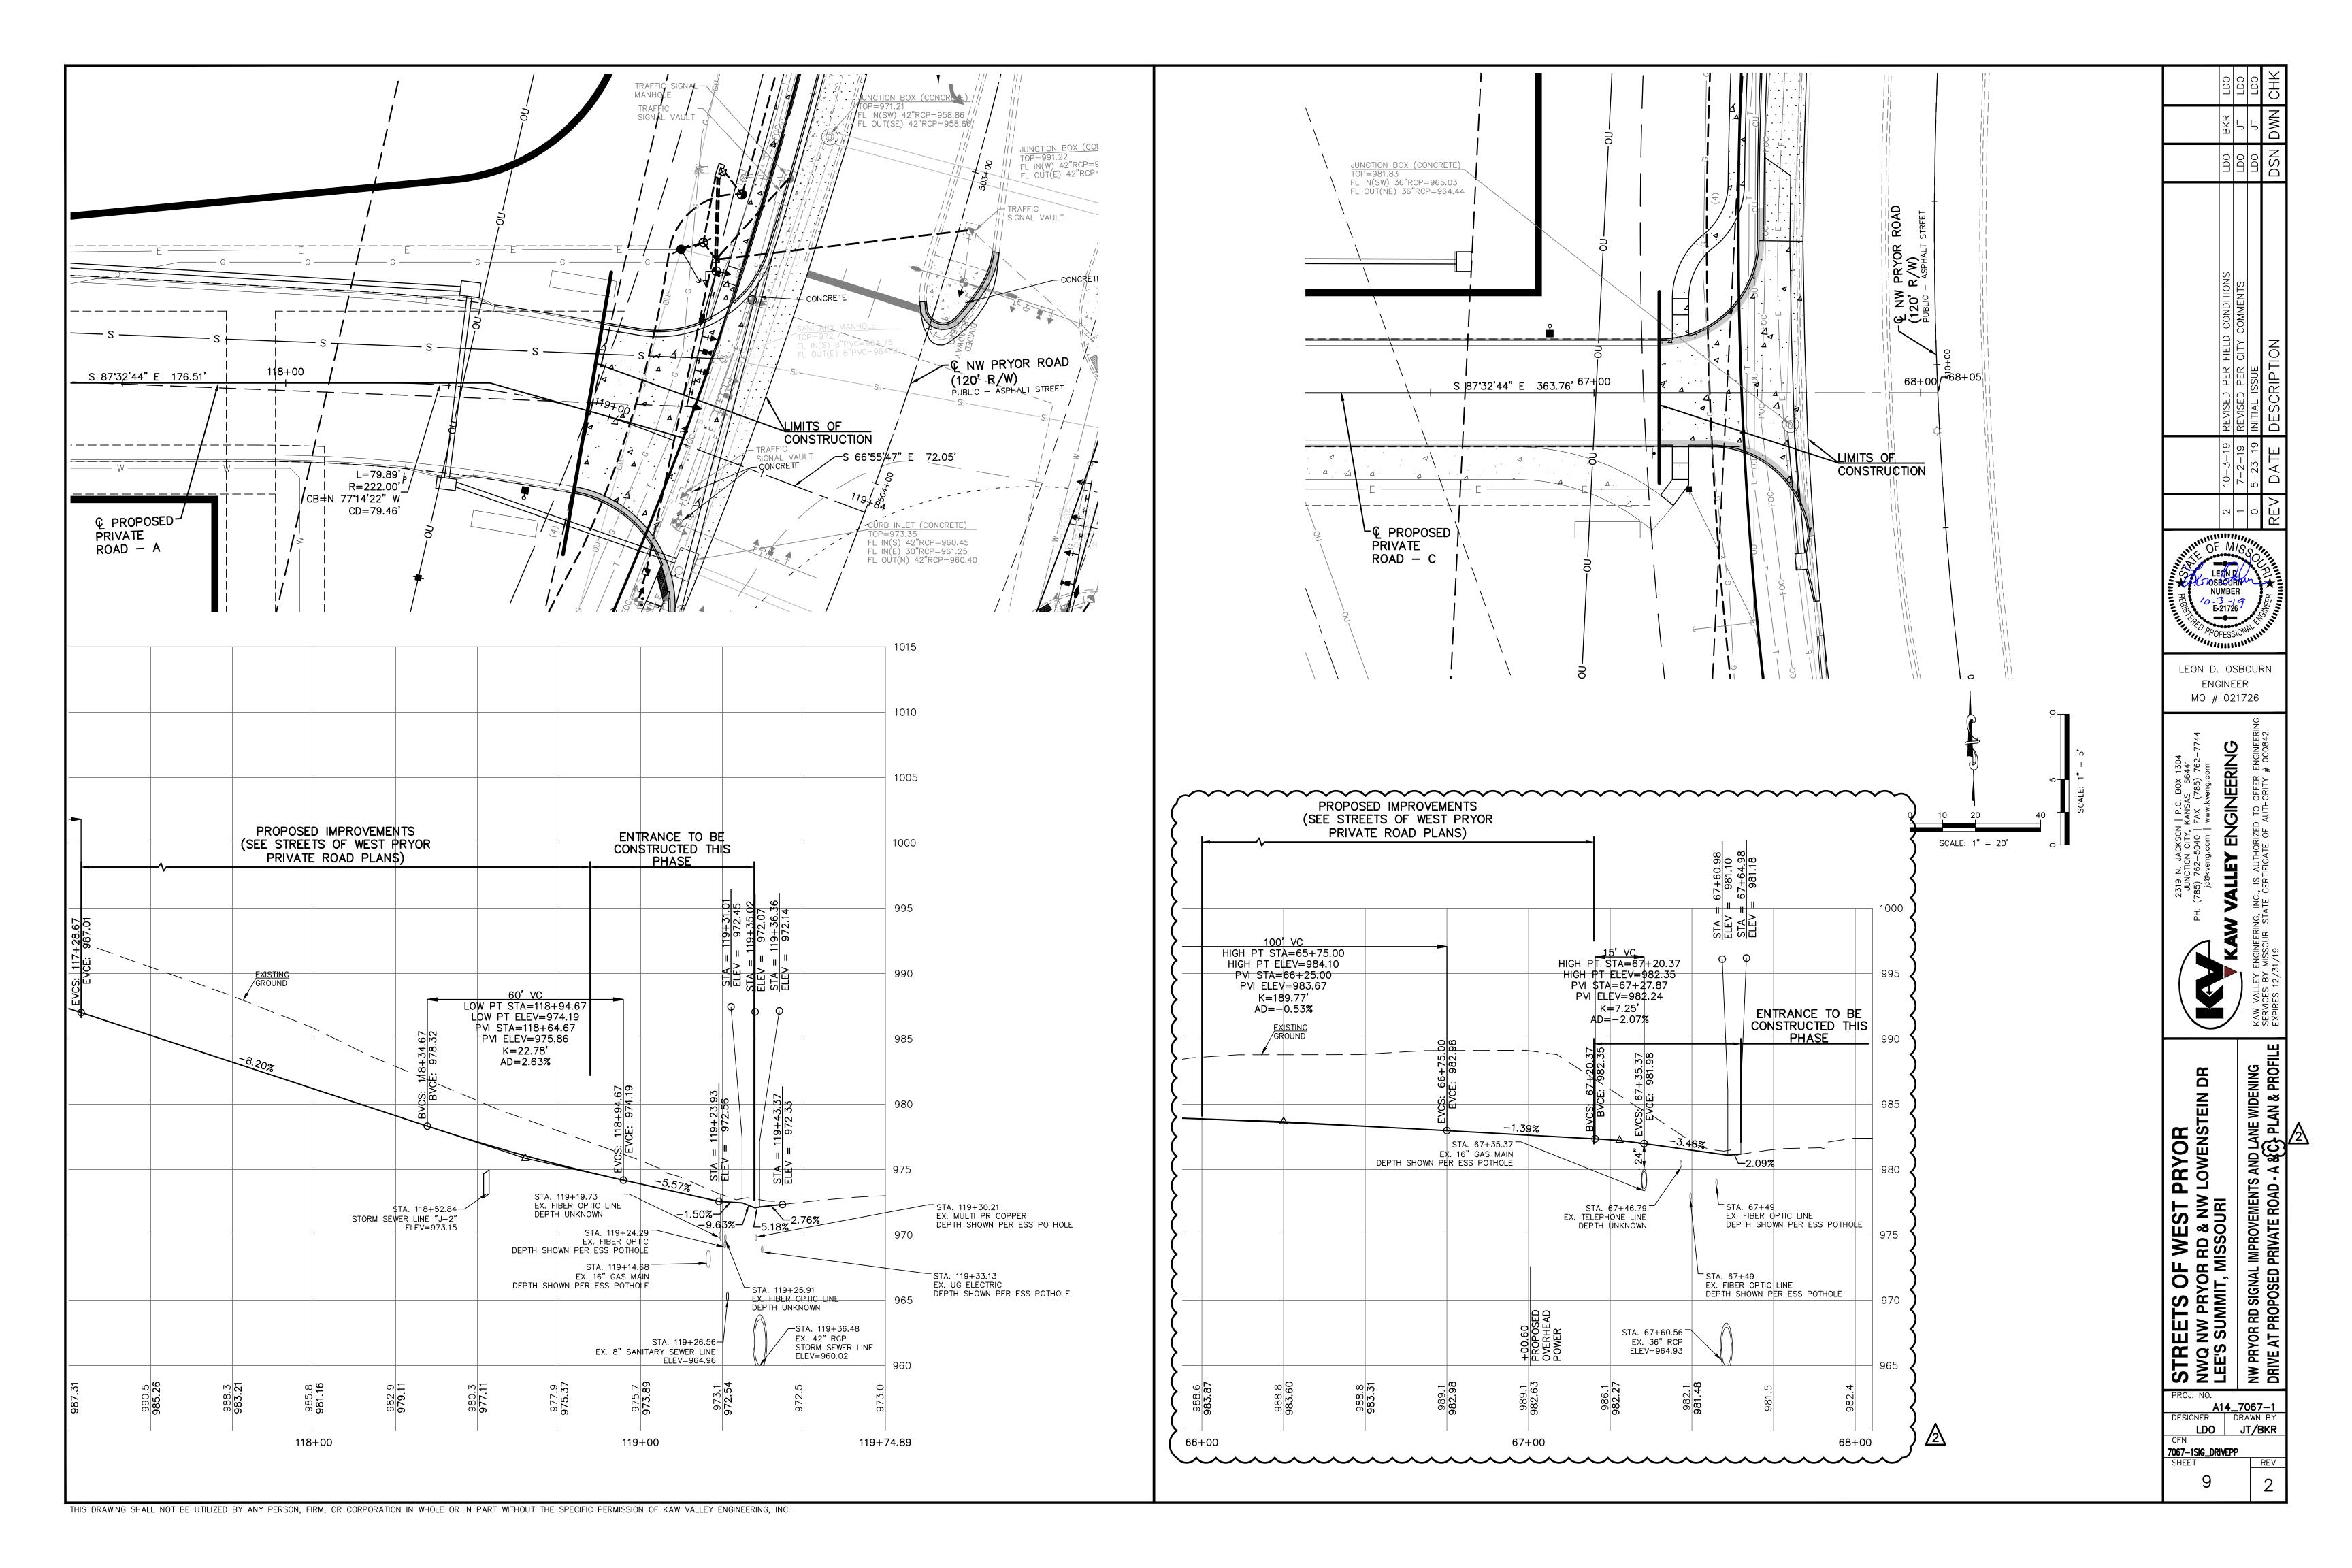


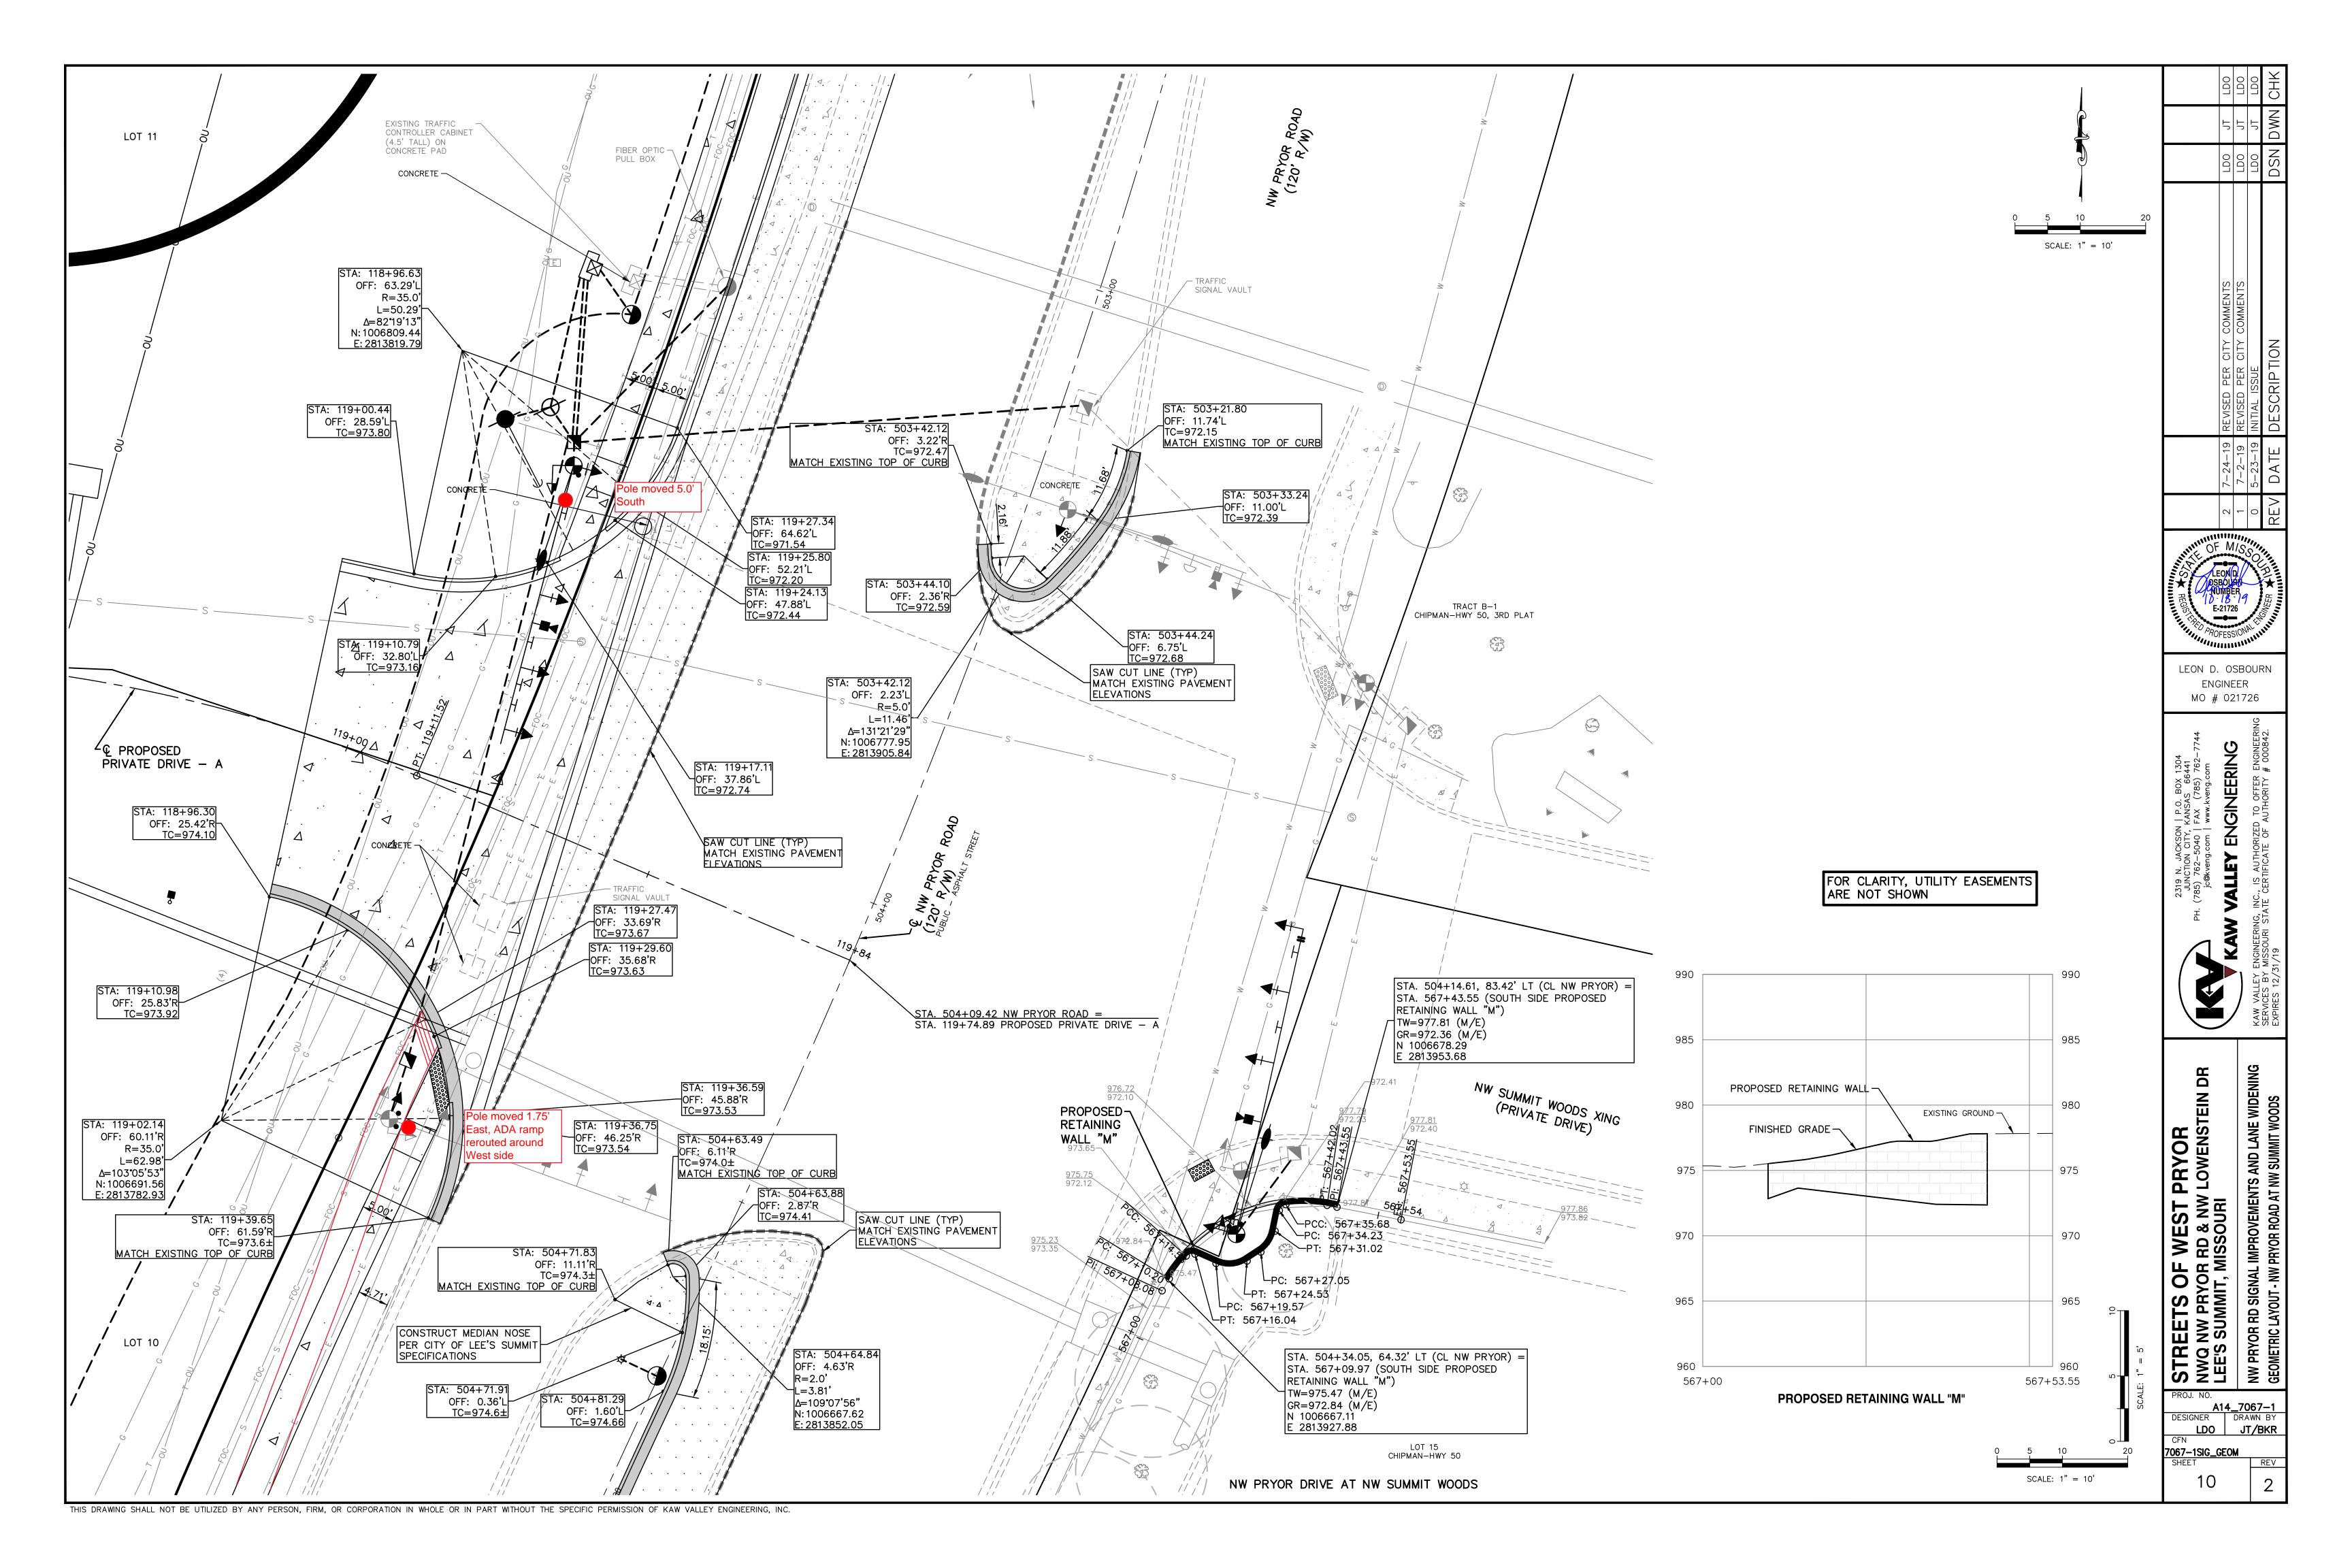


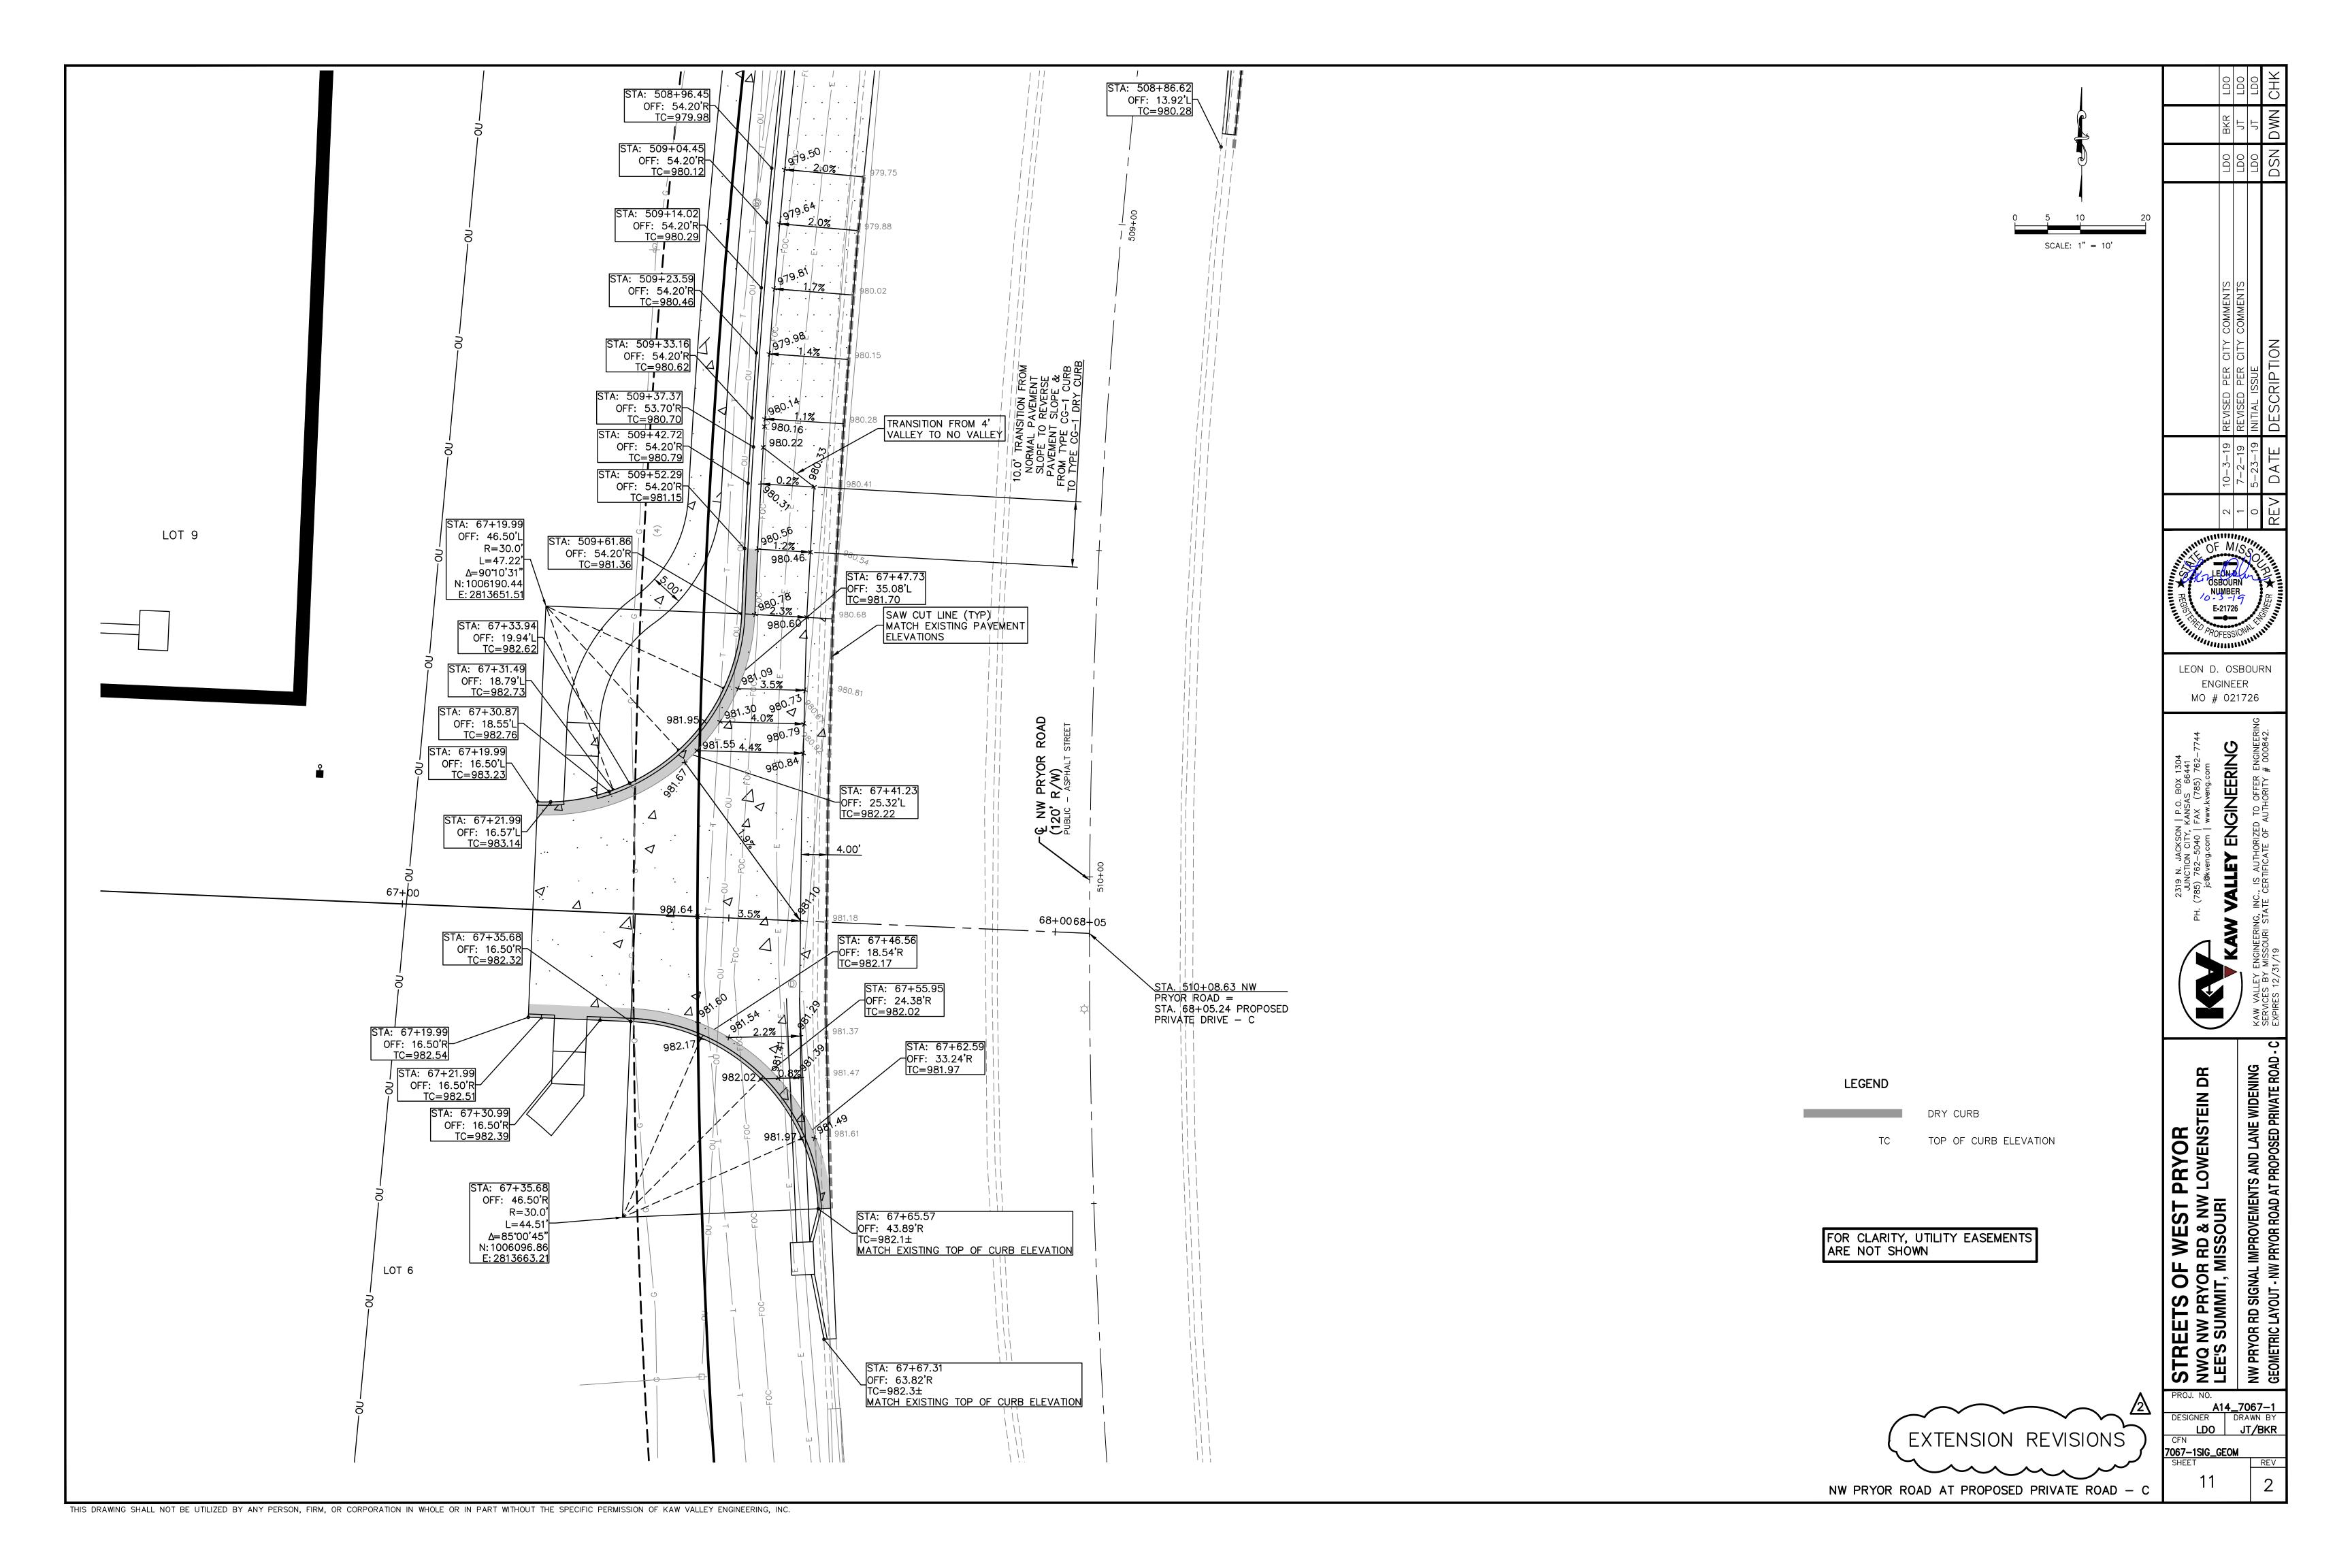


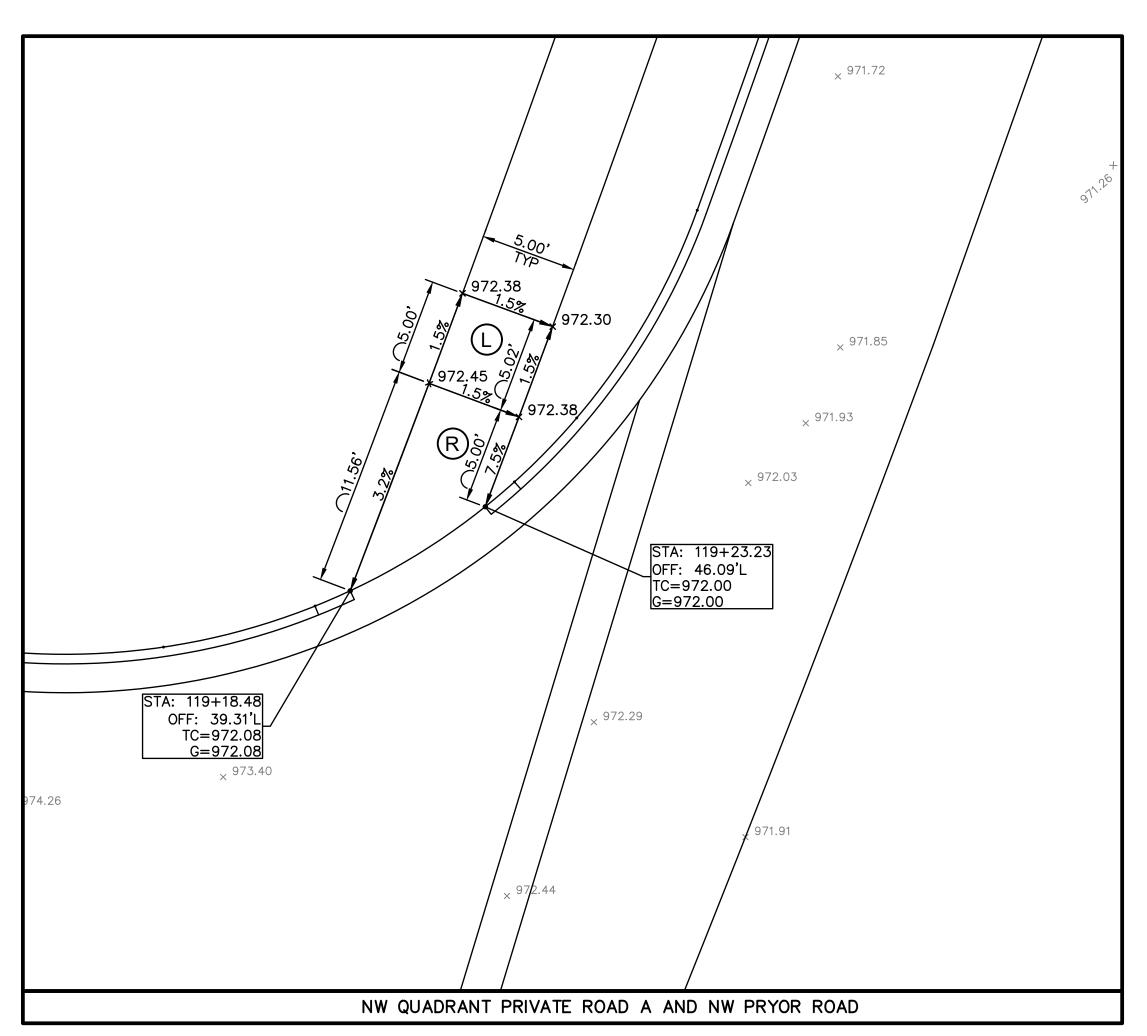


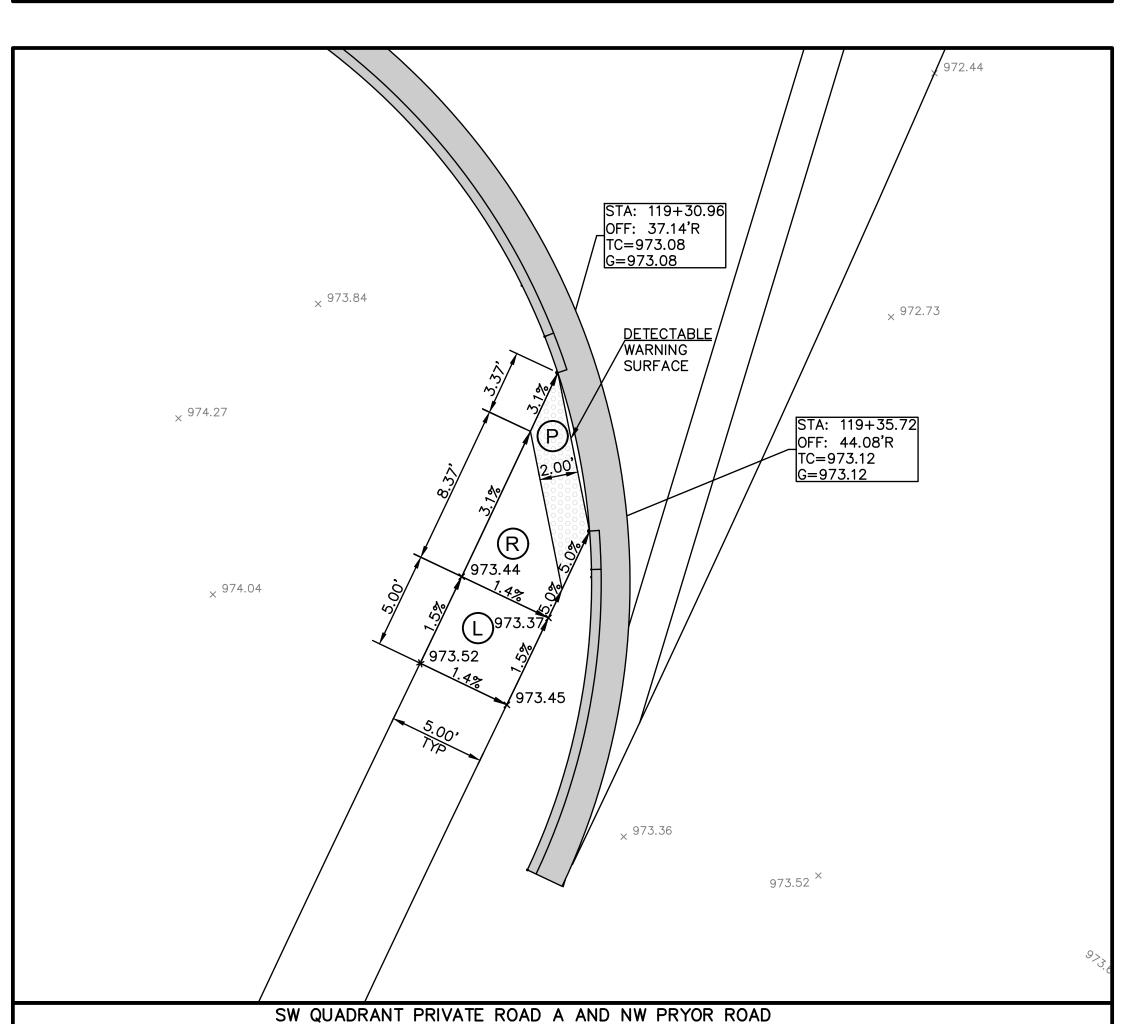

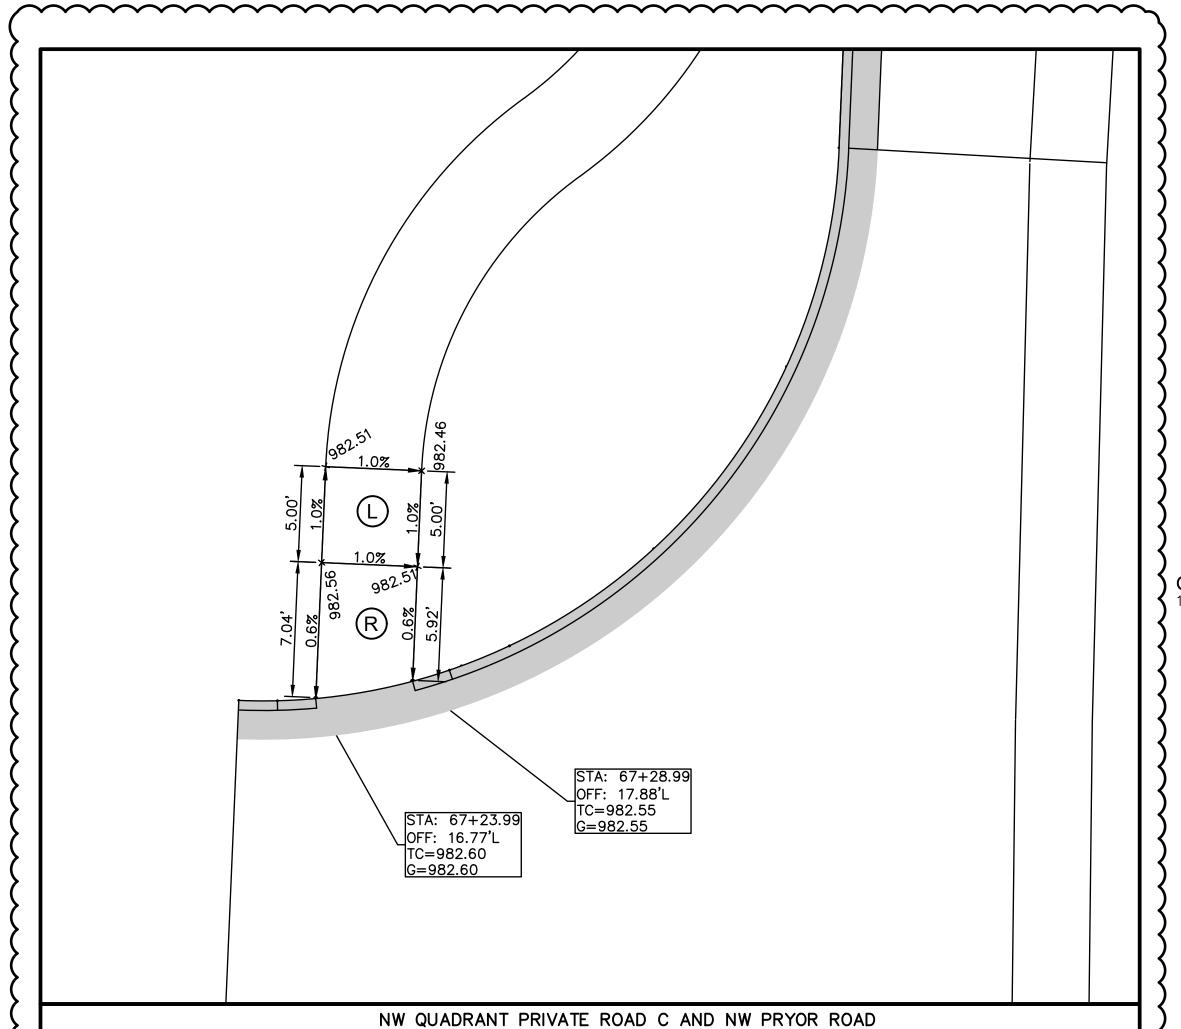

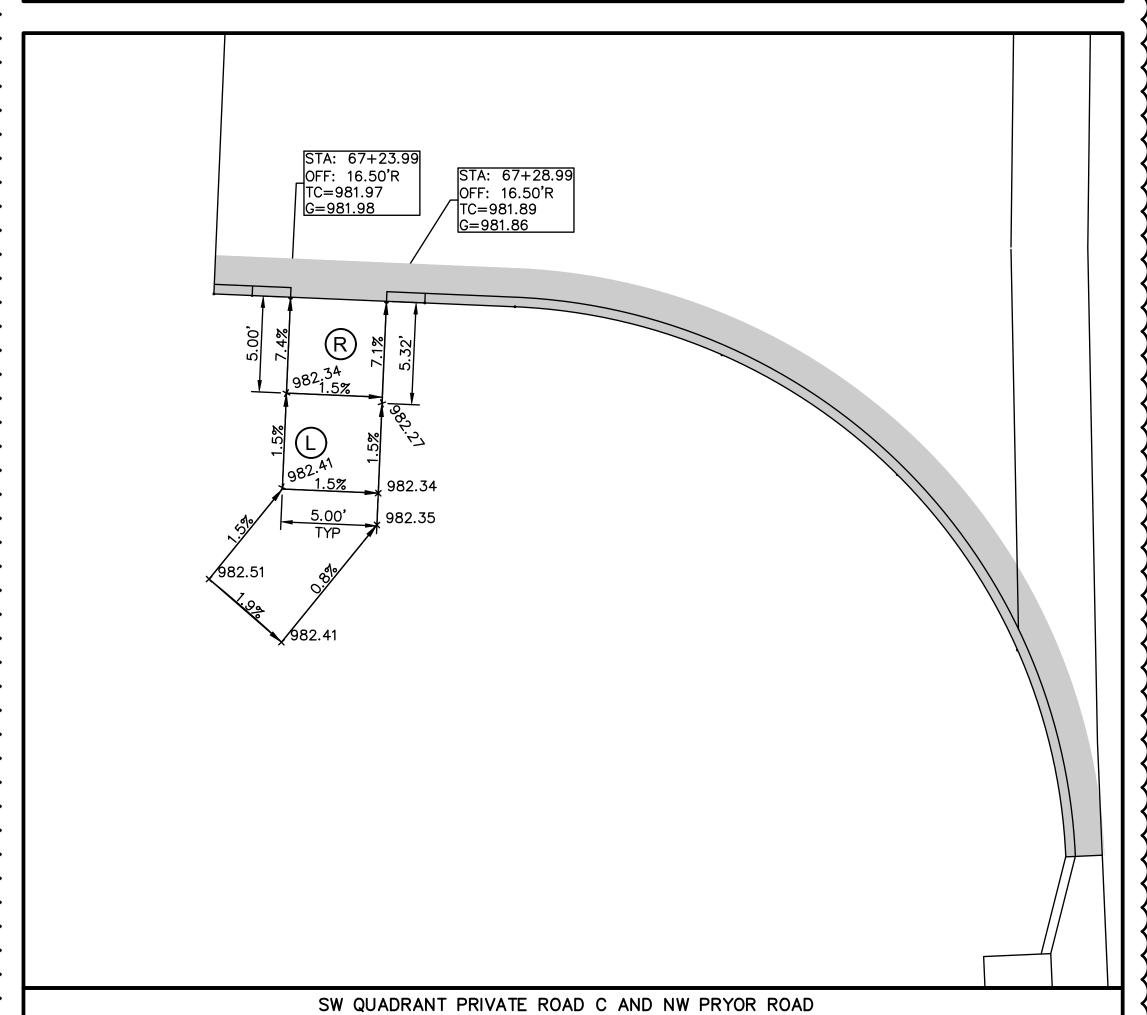

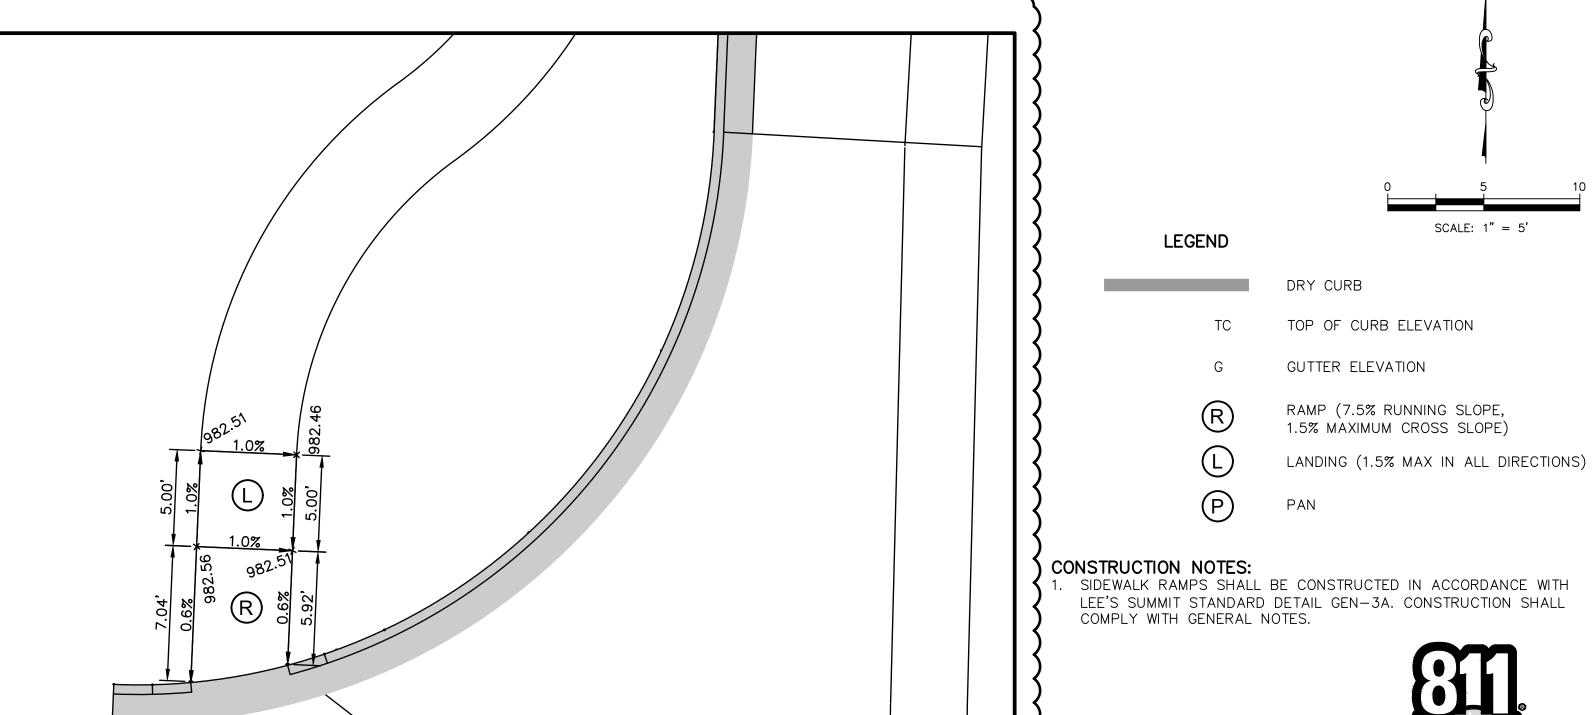

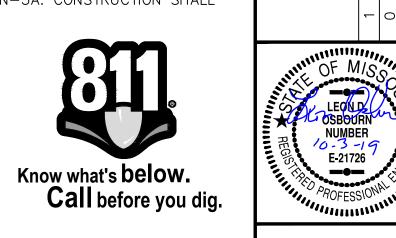

LEON D. OSBOURN ENGINEER

MO # 021726


VALLEY ENGINEERING


STREETS OF WEST PRYOR
NWQ NW PRYOR RD & NW LOWENSTEIN DR
LEE'S SUMMIT, MISSOURI


A14_7067-1

DESIGNER DRAWN BY

LDO JT/BKR

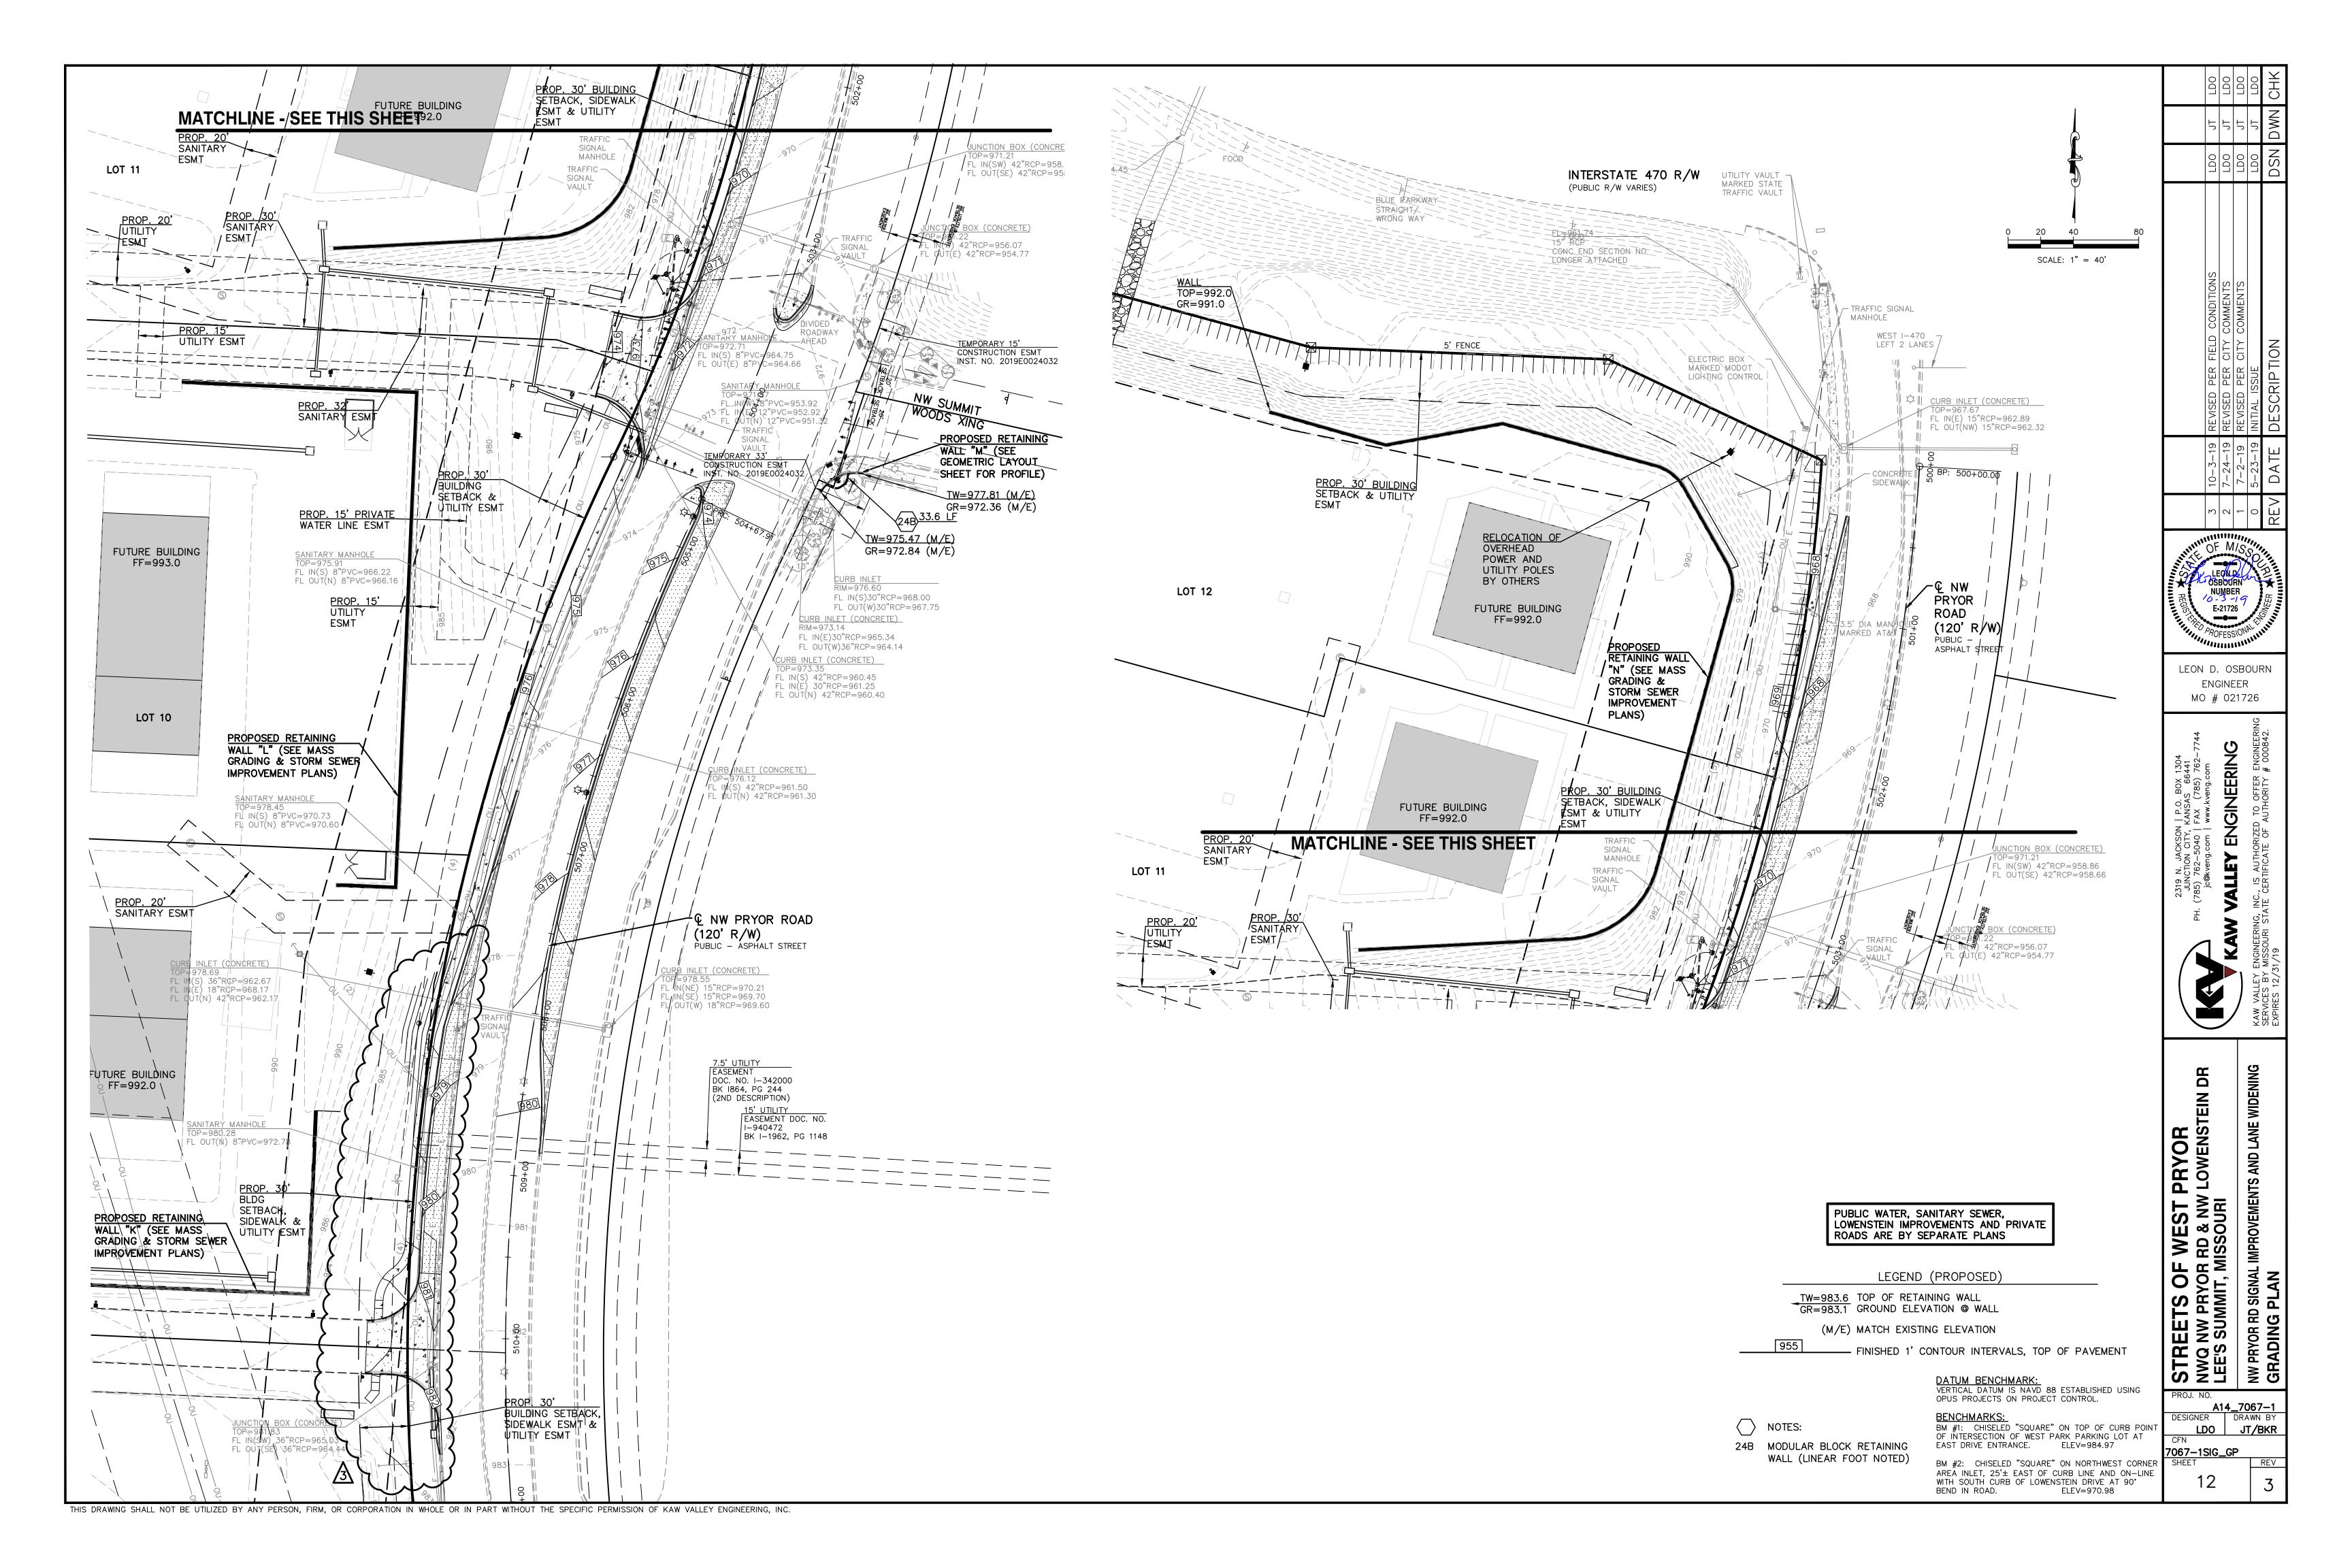

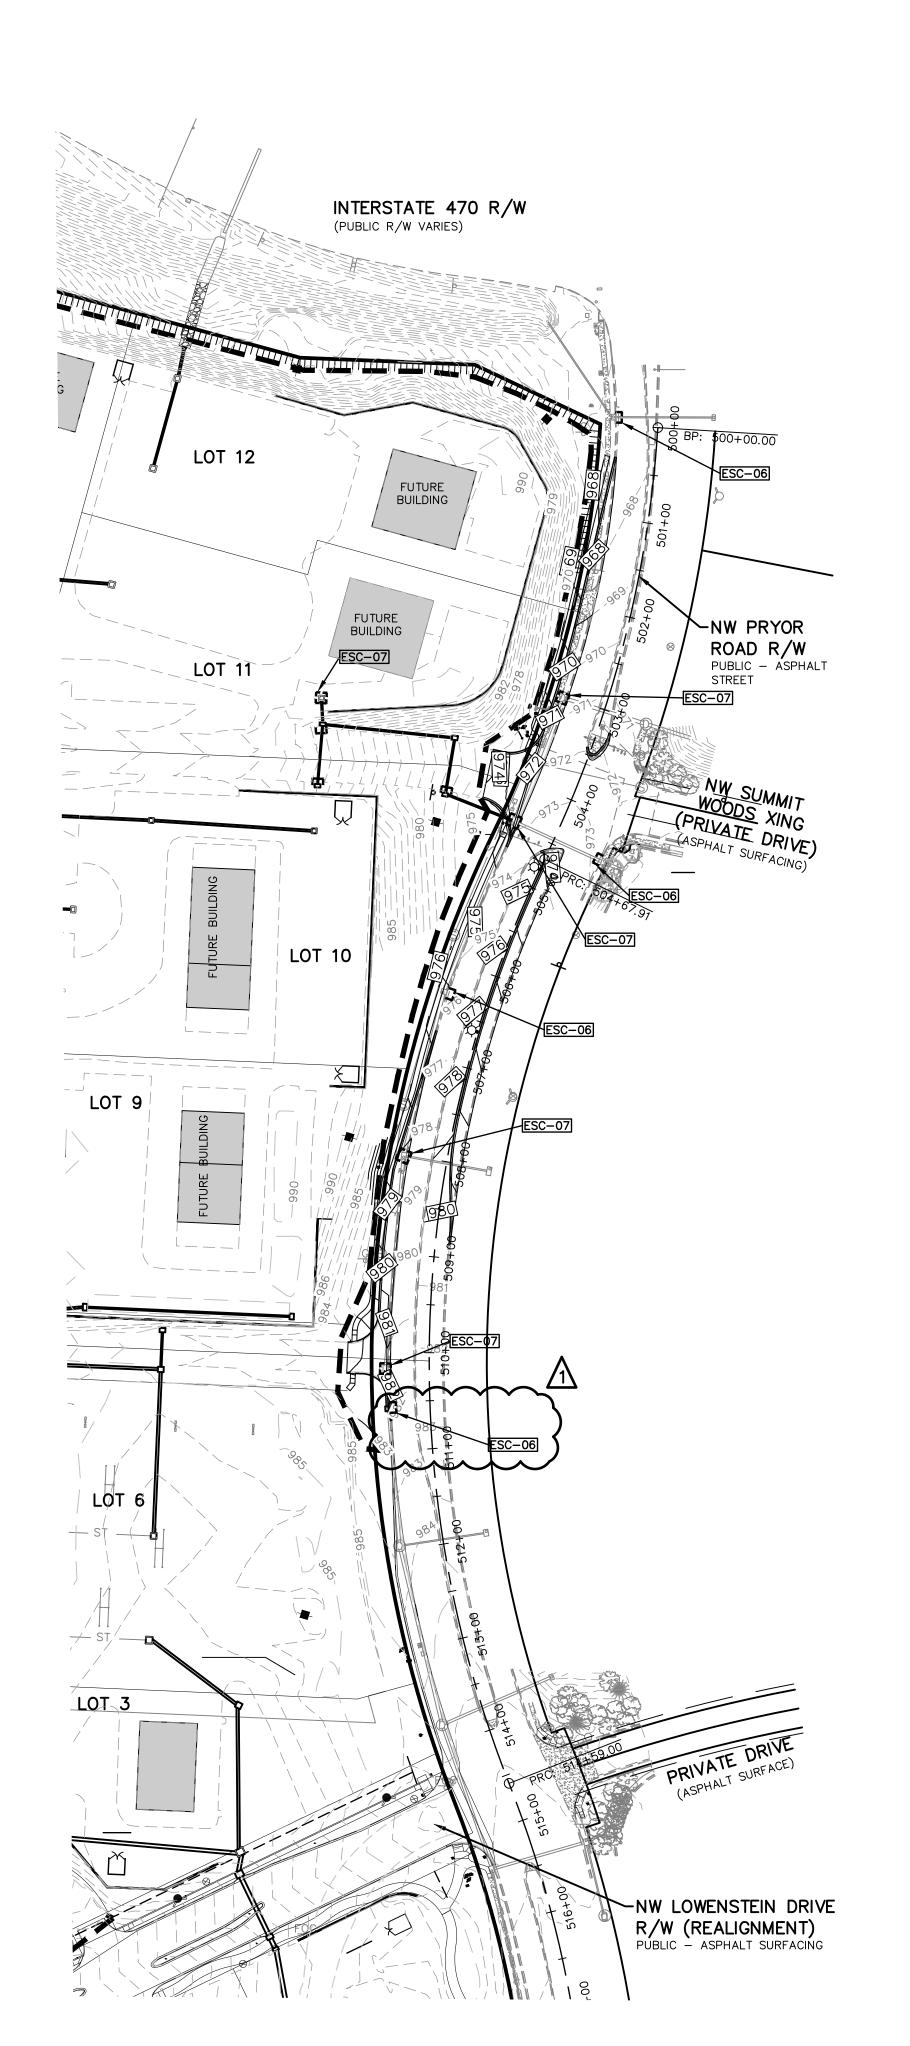

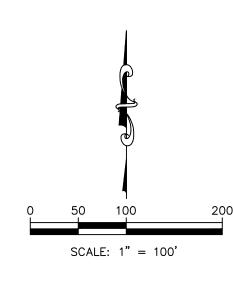

DETAILS — SEE EROSION CONTROL DETAIL SHEETS FOR THE FOLLOWING DETAILS

ESC-03 SILT FENCE ESC-06 CURB INLET PROTECTION ESC-07 AREA INLET AND JUNCTION BOX PROTECTION

EROSION & PROPOSED IMPROVEMENTS LEGEND:

---970 — — EXISTING GROUND CONTOUR (1' INTERVALS) PROPOSED FINISHED GROUND CONTOUR (1' INTERVALS) SEDIMENTATION FENCE

GENERAL NOTES:

1. PROPERTY LINE IS LIMITS OF CONSTRUCTION EXCEPT AS SHOWN.

2. THE CONTRACTOR SHALL INSTALL EROSION CONTROL MEASURES AS SHOWN ON THE DRAWINGS PRIOR TO BEGINNING EARTHWORK OPERATIONS.

- 3. THE CONTRACTOR SHALL MAINTAIN ALL SILT CONTROL MEASURES DURING CONSTRUCTION.
- 4. ALL SILT SHALL REMAIN ON SITE AND SURROUNDING STREETS SHALL BE KEPT CLEAR OF ALL MUD AND DEBRIS.
- 5. A SEDIMENTATION BARRIER IS TO BE INSTALLED AS SHOWN.
- 6. ACCUMULATED SEDIMENT SHALL BE REMOVED AND THE SEDIMENTATION BARRIERS MAINTAINED AS NEEDED TO PREVENT SEDIMENTATION BYPASS OF THE BARRIER.
- 7. SLOPES ARE TO BE LEFT IN A ROUGH CONDITION DURING GRADING.
- 8. CURB INLET SEDIMENTATION BARRIERS ARE TO BE INSTALLED AROUND INLETS AND WEIRS WHERE SEDIMENTATION IS A CONCERN. INLET BARRIERS SHALL BE EITHER BLOCK AND GRAVEL, OR SECURED STRAW BALES, OR SILT FENCE.
- 9. SEDIMENT IS TO BE REMOVED FROM STORM WATER DRAINAGE SYSTEMS.
- 10. RIPRAP IS TO BE INSTALLED AT AREAS OF CONCENTRATED FLOW (I.E. CULVERT OUTLETS).
- 11. CONTRACTOR IS RESPONSIBLE FOR INSTALLING ANY ADDITIONAL EROSION CONTROL AS HE/SHE DEEMS NECESSARY.
- 12. THE CONTRACTOR SHALL PROVIDE ALL MATERIALS, TOOLS, EQUIPMENT AND LABOR AS NECESSARY TO INSTALL AND MAINTAIN ADEQUATE EROSION AND SILTATION CONTROLS REQUIRED TO PREVENT SOIL EROSION FROM LEAVING THE PROJECT SITE. IT SHALL BE THE CONTRACTOR'S SOLE RESPONSIBILITY TO ENSURE THAT METHODS UTILIZED ARE ADEQUATE AND COMPLY WITH REQUIREMENTS OF THE SPECIFICATIONS AND GOVERNMENTAL AGENCIES HAVING JURISDICTION OVER THE WORK.
- 13. TEMPORARY SEDIMENT FENCE TO REMAIN UNTIL ADEQUATE VEGETATION IS ESTABLISHED.
- 14. MUD AND DEBRIS SHALL BE CLEANED UP AT THE CONCLUSION OF EACH WORKING DAY, OR AFTER EACH RAINFALL IF SILT IS PRESENT.
- 15. INSPECTION, MAINTENANCE AND REPAIR OF EROSION CONTROL DEVICES SHALL BE ON GOING THROUGHOUT THE LIFE OF BUILDING CONSTRUCTION TO KEEP THE DEVICES IN OPERABLE CONDITION AT ALL TIMES. ADDITIONAL MEASURES SHALL BE INSTALLED AS REQUIRED BY ACTUAL FIELD CONDITIONS AND/OR GOVERNING INSPECTION AGENCIES.
- 16. INSTALL CONSTRUCTION ENTRANCE AT ANY POINT WHERE TRAFFIC WILL BE ENTERING OR LEAVING THE SITE AND AS SHOWN ON PLANS.

- 17. AT COMPLETION OF SITE GRADING AND OTHER RELATED CONSTRUCTION ACTIVITIES, ALL DISTURBED AREAS WITHIN THE PROJECT SITE SHALL BE SEEDED, SODDED, OR LANDSCAPED AS SHOWN ON THE LANDSCAPE PLAN WITHIN 14 DAYS.
- 18. TOPSOIL IS TO BE PLACED IN AREAS UNSUITABLE FOR VEGETATIVE GROWTH.
- 19. STRIP TOPSOIL PRIOR TO EXCAVATION, STOCKPILE AND SPREAD ONTO DISKED SUBGRADE (4" MIN) A THICKNESS OF 4 INCHES.
- 20. ROCK LINING (RIPRAP) SHALL BE DURABLE STONE CONTAINING A COMBINED TOTAL OF NOT MORE THAN 10 PERCENT OF EARTH, SAND, SHALE AND NON-DURABLE ROCK. AT LEAST 60 PERCENT OF THE MASS SHALL BE OF PIECES HAVING A MINIMUM WEIGHT OF 150 POUNDS OR MORE PER CUBIC FOOT.
- 21. THE CONTRACTOR SHALL HAVE THE RESPONSIBILITY FOR RESOLVING COMPLAINTS IN THE EVENT THAT COMPLAINTS OR DAMAGE CLAIMS ARE FILED DUE TO DAMAGES OCCURRING ADJACENT TO OR DOWNSTREAM FROM PROPERTY BY SEDIMENT RESULTING FROM EROSION ON THE PROJECT SITE.
- 22. GOOD HOUSEKEEPING PRACTICES SHALL BE MAINTAINED ON SITE TO KEEP SOLID WASTE FROM ENTRY INTO WATERS.
- 23. ALL FUELING FACILITIES PRESENT ON SITE SHALL ADHERE TO APPLICABLE FEDERAL AND STATE REQUIREMENTS CONCERNING UNDERGROUND STORAGE, ABOVE GROUND STORAGE AND DISPENSERS, INCLUDING SPILL PREVENTION, CONTROL AND COUNTER MEASURES.
- 24. RIGHT OF WAY TO BE STABILIZED AS REQUIRED BY APWA SECTION 2400.
- 25. EROSION CONTROL IS TO BE PLACED IN PHASING AS CONSTRUCTION PROGRESSES.
- 26. MINIMAL WASHING OF CONCRETE EQUIPMENT ALLOWED, CHUTE ETC. CONCRETE WASHOUT OF THE DRUM IS NOT ALLOWED. ANY PIT/WASHOUT AREA NEEDS TO BE MAINTAINED IN A NON-DISCHARGING MANNER AND ANY WASTE RESIDUE WILL NEED TO BE CLEANED OUT AND REMOVED AT THE END OF PROJECT.
- 27. EROSION CONTROL SEDIMENT FENCE TO BE INSTALLED 1'-0" BEHIND CURB & GUTTER UPON COMPLETION OF BACKFILL OF CURB IN ALL AREAS WHERE SLOPES FROM LOT DRAIN TOWARDS CURB. UPON COMPLETION OF FINAL GRADING THE TOES OF ALL EMBANKMENTS IN EXCESS OF TWO FEET IN HEIGHT WILL HAVE EROSION CONTROL SEDIMENT FENCE INSTALLED.

LEON D. OSBOURN ENGINEER MO # 021726


ENG G


DR EIN RY ow

EETS OF NW PRYOF SUMMIT, I

A14_7067-1 DESIGNER | DRAWN B

7067-1SIG_ECP

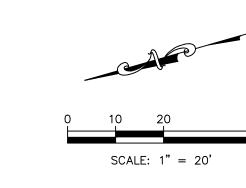

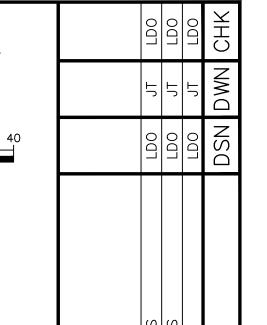

LEON D. OSBOURN ENGINEER MO # 021726

VALLEY ENGINEERING

LOT 14A CHIPMAN—HWY 50, 3RD PLAT	TRACT B—1 CHIPMAN—HWY 50, 3RD PI	PLAT	NW SUMMIT WOODS XING (PRIVATE DRIVE)
501±00. = = = = = = = = = = = = = = = = = =	© NW PRYOR ROAD (120' R/W) PUBLIC - ASPHALT STREET ==502±00================================	DIVIDED ROADWAY ANEAD 503+00 HH)±10 (H)±11 (AA)±40	
LOT 12		LOT 11	© PROPOSED PRIVATE ROAD - A (SEE SEPARATE PLANS) ■

NOTE:

1. PAVEMENT MARKING SHALL BE PROVIDED AND INSTALLED IN ACCORDANCE WITH THE CURRENT CITY OF LEE'S SUMMIT PAVEMENT MARKING STANDARDS.

2. ALL DIMENSIONS REFERENCING DOUBLE YELLOW LINES REFERS TO THE CENTER OF THE SPACE BETWEEN THE TWO DOUBLE YELLOW LINES.

3. CONTRACTOR TO GRIND OFF CONFLICTING PAVEMENT MARKING.

LIST	OF	PAVEMENT	MARKIN

MARK

ITEM

(AA) 4" SOLID WHITE LINE (HIGH BUILD PAINT)

(DD) 6" DASHED WHITE EXTENSION LINE (THERMOPLASTIC)

(JJ) TURN ARROW WHITE (RIGHT) (THERMOPLASTIC)

(EE) 6" SOLID WHITE CROSS-WALK LINE (THERMOPLASTIC) GG 24" STOP BAR (THERMOPLASTIC) (HH) TURN ARROW WHITE (LEFT) (THERMOPLASTIC)

STREETS OF WEST PRYOR

NWQ NW PRYOR RD & NW LOWENSTEIN DR
LEE'S SUMMIT, MISSOURI

NW PRYOR RD SIGNAL IMPROVEMENTS AND LANE WIDENING

NW PRYOR ROAD PAVEMENT MARKING PLAN


A14_7067-1

DESIGNER DRAWN BY

LDO JT/BKR

CFN

7067-1SIG_PMP SHEET

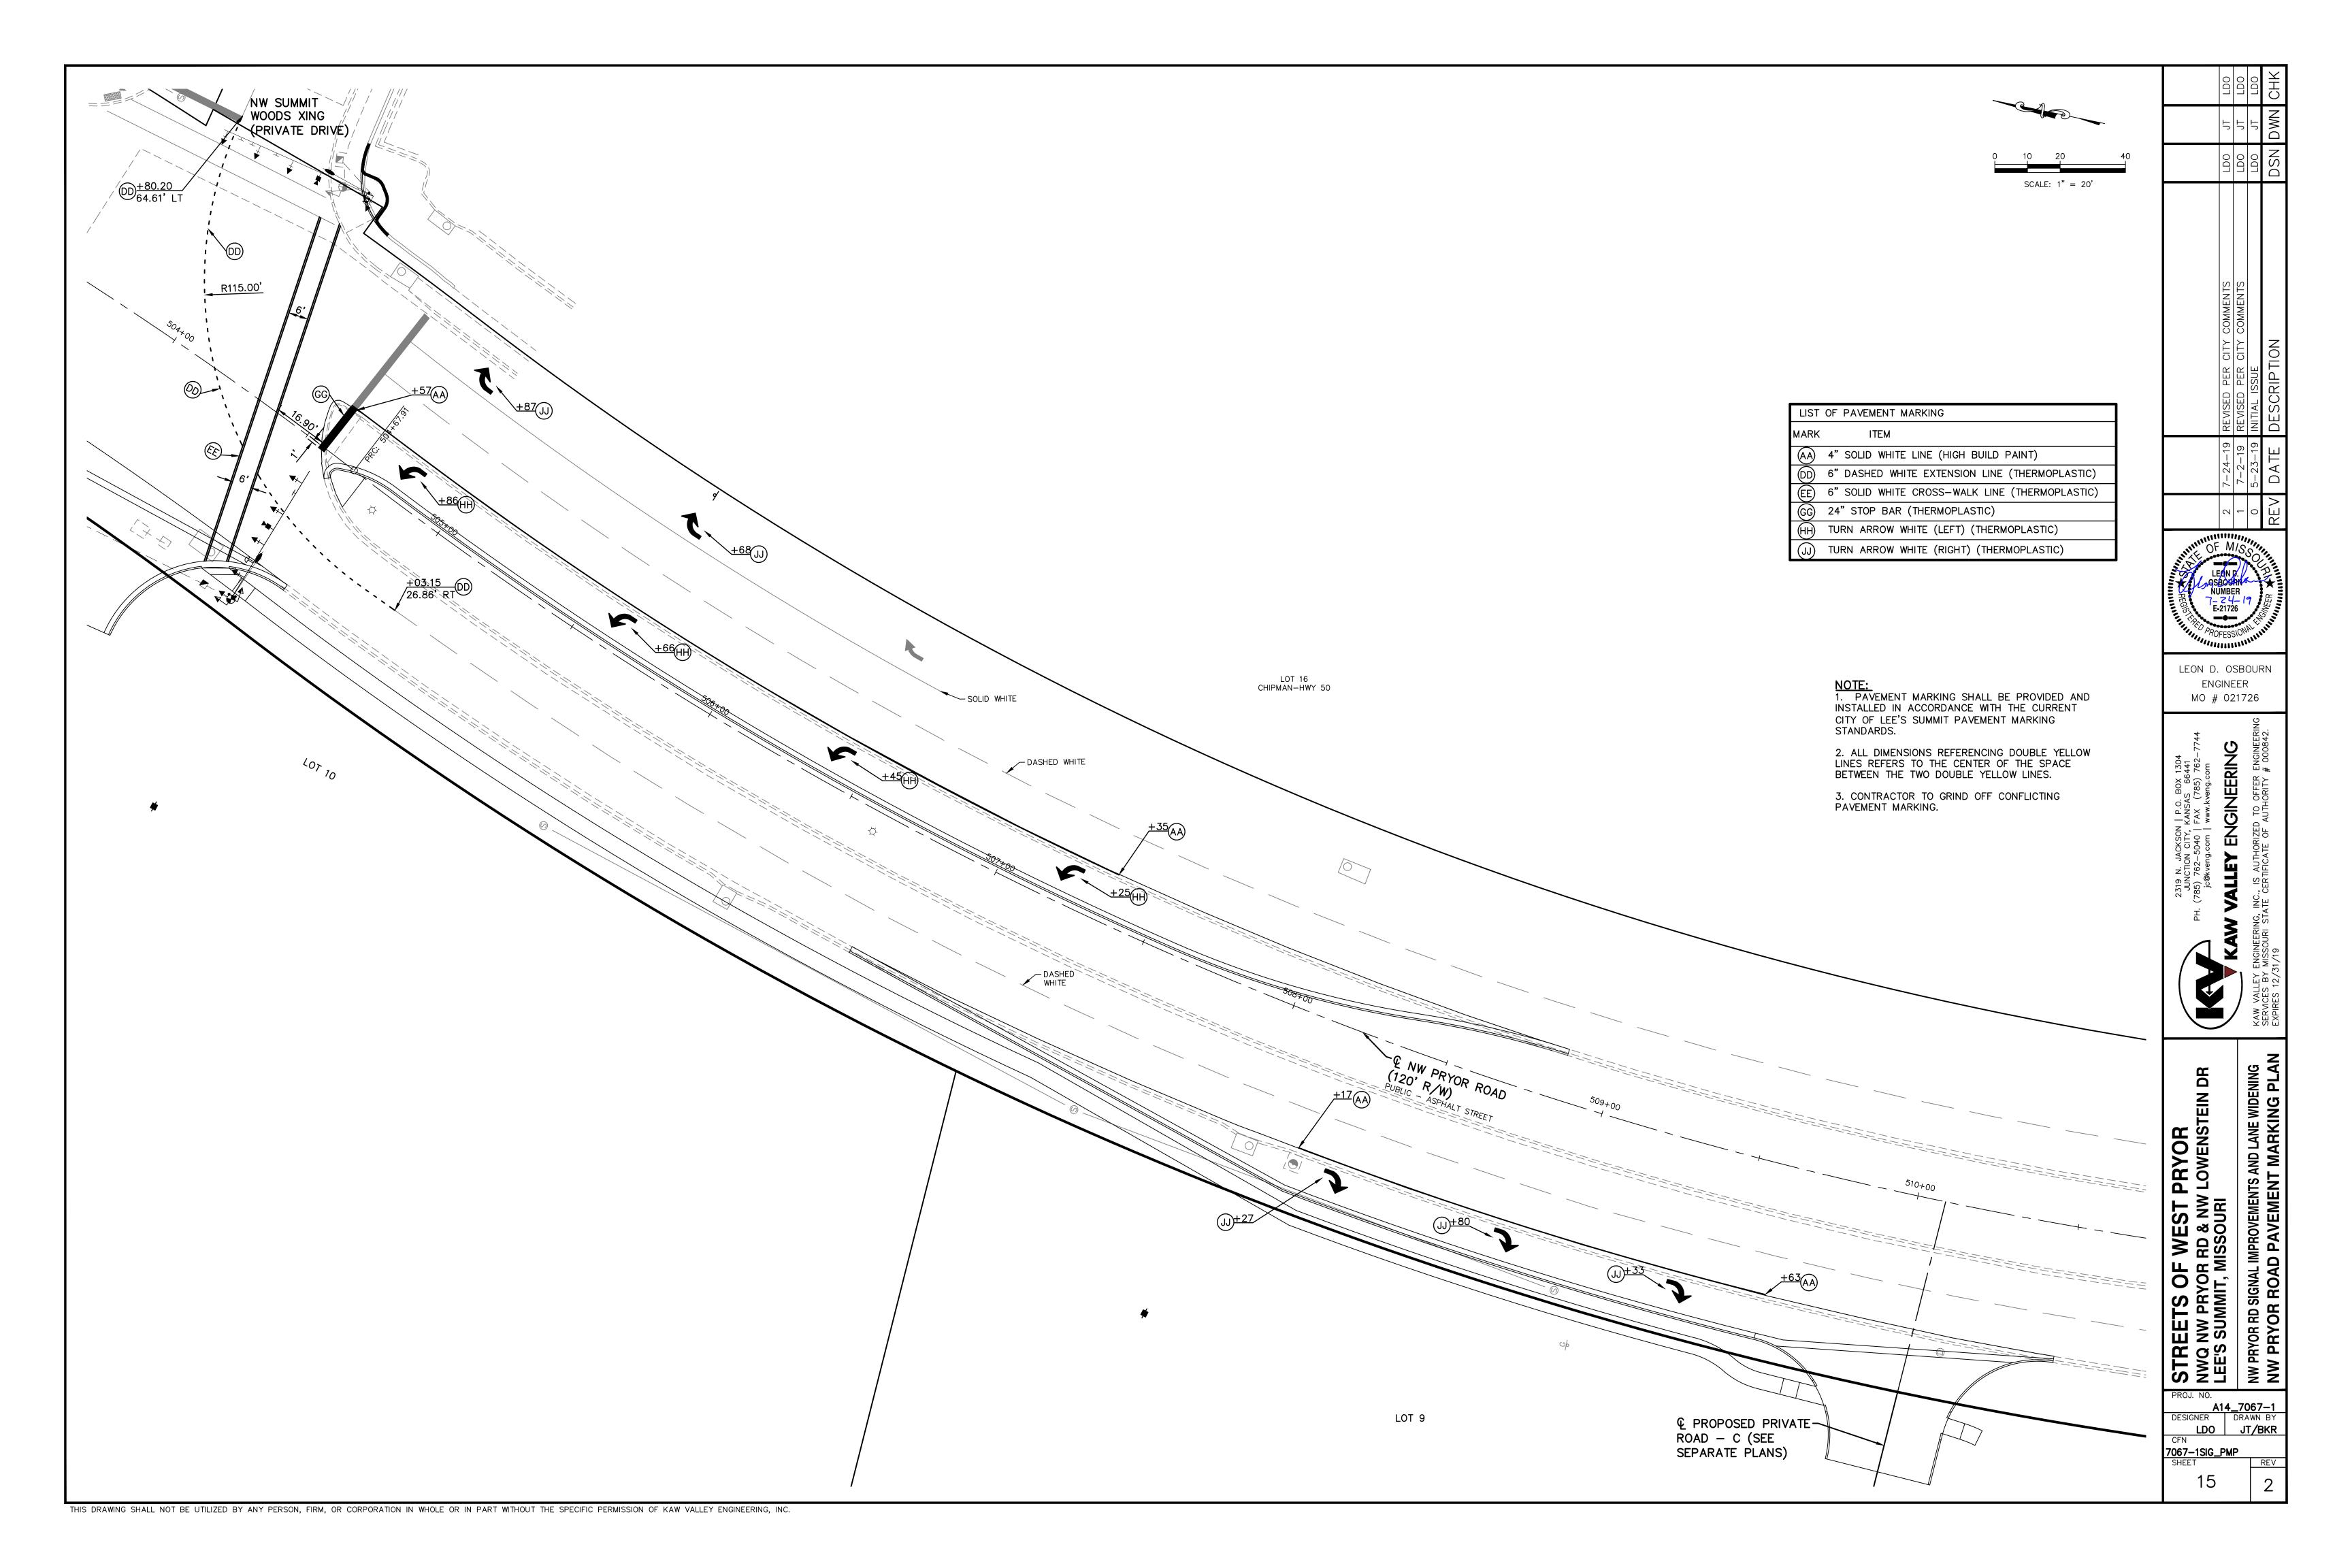

GENERAL NOTES:

1. THE CONTRACTOR SHALL HAVE ONE (1) SIGNED COPY OF THE PLANS (APPROVED BY THE CITY OF LEE'S SUMMIT) AND ONE (1) COPY OF THE APPROPRIATE DESIGN AND CONSTRUCTION STANDARDS AND SPECIFICATIONS AT THE JOB SITE AT ALL TIMES.

2. CONSTRUCTION OF THE IMPROVEMENTS SHOWN OR IMPLIED BY THIS SET OF DRAWINGS SHALL NOT BE INITIATED OR ANY PART THEREOF UNDERTAKEN UNTIL THE DIRECTOR OF PUBLIC WORKS OR HIS AGENT IS NOTIFIED OF SUCH INTENT, AND ALL REQUIRED AND PROPERLY EXECUTED BONDS AND CONTRACT AGREEMENTS ARE RECEIVED AND APPROVED BY THE CITY.

3. THE CONSTRUCTION COVERED BY THESE PLANS SHALL CONFORM TO ALL APPLICABLE STANDARDS AND SPECIFICATIONS OF THE PUBLIC WORKS DEPARTMENT OF THE CITY OF LEE'S SUMMIT, MISSOURI, IN CURRENT USE. SPECIFICALLY, BUT NOT EXCLUSIVE TO: TRAFFIC SIGNAL SPECIFICATION: SECTION 2900. TRAFFIC SIGNAL STANDARD DRAWINGS: TS-1 THROUGH TS-10.

- 4. ALL WORKMANSHIP AND MATERIALS SHALL BE SUBJECT TO THE INSPECTION AND APPROVAL OF THE PUBLIC WORKS DEPARTMENT OF THE CITY OF LEE'S SUMMIT, MISSOURI.
- RIGHT-OF-WAY LIMITS SHOULD BE CROSS CHECKED BY THE CONTRACTOR AND APPROVED BY THE FIELD INSPECTOR BEFORE UNDERTAKING ANY EXCAVATIONS AT THE
- THE CONTRACTOR SHALL STAKE THE LOCATION OF ALL POLE BASES, PULL BOXES, AND CONTROLLER CABINET BASE, THEN PROVIDE THE CITY ONE WEEK NOTICE PRIOR TO THE START OF CONSTRUCTION, AND SUBSEQUENT CONSTRUCTION ACTIVITIES, FOR INSPECTION AND APPROVAL. THE CONTRACTOR SHALL PROVIDE A WORK SCHEDULE, CONTACT NAMES, AND PHONE NUMBERS.
- 7. ALL LOCATIONS INDICATED IN DRAWINGS, INCLUDING CONDUIT RUNS ARE SUBJECT TO ADJUSTMENT TO CLEAR OBSTRUCTIONS AND TO MEET SITE CONDITIONS, IF ANY BY THE CITY.
- 8. EXISTENCE AND LOCATION OF ANY UNDERGROUND OR OVERHEAD FACILITIES SHOWN ON THESE DRAWINGS OR REFERENCE TO ANY SOIL CONDITIONS, IF MADE, ARE APPROXIMATE ONLY. IT IS THE CONTRACTOR'S RESPONSIBILITY TO VERIFY ALL SITE CONDITIONS AND TO LOCATE ALL UTILITIES, INCLUDING DEPTH, BEFORE STARTING CONSTRUCTION SO THAT ANY ADJUSTMENTS TO DESIGN CAN BE MADE PRIOR TO POLE ORDERING OR FABRICATION. IN ADDITION, THE CONTRACTOR SHALL AVOID DISRUPTION OF SERVICES PROVIDED BY THE UTILITIES AND SHALL INSURE THAT PROPER CLEARANCES (OVERHEAD AND UNDERGROUND) ARE MAINTAINED FOR THE DURATION OF CONSTRUCTION. THE CONTRACTOR SHALL BE FULLY RESPONSIBLE FOR ANY AND ALL DAMAGES CAUSED BY FAILURE TO EXACTLY LOCATE AND PRESERVE ALL UTILITIES.
- 9. THE CONTRACTOR SHALL COORDINATE WITH THE CITY TRAFFIC ENGINEER FOR ANY NECESSARY CHANGES TO THE TRAFFIC SIGNALS RESULTING FROM EXISTING UTILITIES OR OTHER CONSTRUCTION ISSUES.
- 10. ANY EQUIPMENT DAMAGED DURING CONSTRUCTION SHALL BE REPLACED AT THE CONTRACTOR'S EXPENSE.

11. SIGNAL EQUIPMENT SHALL NOT FORM AN OBSTRUCTION TO THE MOVEMENT OF PEDESTRIAN AND WHEELCHAIR TRAFFIC AND SHALL BE ADA ACCESSIBLE. WHERE SIDEWALKS ARE PRESENT, A MINIMUM CLEAR WIDTH OF 48 INCHES SHALL BE AVAILABLE FOR PEDESTRIAN AND WHEELCHAIR MOVEMENT. PULL BOXES SHALL NOT BE INSTALLED ON WHEELCHAIR RAMPS.

12. CONDUITS TO BE PLACED OUTSIDE OF PAVED AREAS SHALL BE TRENCHED IN PLACE. IF THE PROJECT INCLUDES ROADWAY IMPROVEMENTS, THE CONDUIT SHALL BE TRENCHED AFTER THE ROADWAY ROUGH GRADE IS ESTABLISHED AND PRIOR TO ANY FINAL ROADWAY PAVING, CURB & GUTTER, MEDIAN OR SIDEWALK SECTIONS ARE PLACED. ALL COMPACTION AND BACKFILL SHALL MEET CITY OF LEE'S SUMMIT REQUIREMENTS. AT THE OPTION OF THE CONTRACTOR, CONDUITS MAY BE BORED OUTSIDE PAVED AREAS, BUT THERE WILL BE NO ADJUSTMENT TO THE UNIT PRICES FOR CONDUIT INSTALLATION AND ANY CHANGE IN COST WOULD BE THE CONTRACTOR'S RESPONSIBILITY. ANY CONDUIT BORE OUTSIDE THE PAVED AREAS SHALL BE DONE AFTER ROADWAY IMPROVEMENTS ARE COMPLETE. CONDUITS TO BE PLACED WITHIN THE LIMITS OF PAVEMENT SHALL BE BORED UNLESS OTHERWISE AUTHORIZED BY THE CITY TRAFFIC ENGINEER. IF THE PROJECT INCLUDES ROADWAY IMPROVEMENTS, THE CONDUIT SHALL BE BORED PRIOR TO ANY FINAL ROADWAY PAVING. POTHOLING FOR UTILITIES ON ROAD BORES AFTER FINAL PAVING WILL NOT BE ALLOWED.

13. THE TRAFFIC SIGNAL CONTROLLER, CABINET AND RELATED EQUIPMENT, AS SPECIFIED FOR THIS PROJECT, SHALL BE DELIVERED TO THE CITY FOR TESTING PRIOR TO INSTALLATION. ALL SIGNAL TIMINGS WILL BE PROVIDED BY THE CITY TRAFFIC ENGINEER. THE CONTRACTOR SHALL COORDINATE MATERIAL DELIVERY AND PICK-UP WITH THE PUBLIC WORKS OPERATIONS DEPARTMENT (969-1870) AT LEAST 48 HOURS PRIOR TO TRANSPORTATION. THE CONTRACTOR ASSUMES ALL DAMAGE LIABILITY AND SHOULD INSPECT ALL MATERIALS BEFORE AND AFTER TRANSPORTATION OF EQUIPMENT.

14. THE CONTRACTOR SHALL COORDINATE ALL ELECTRICAL POWER REQUIREMENTS AND CONNECTION ACTIVITIES WITH THE UTILITY COMPANY. INCLUDING LOCATION OF THE METER, CIRCUITRY AND CONNECTION REQUIREMENTS, AND POWER UP THE COMPLETE

15. ALL DISTURBED SURFACES SHALL BE MADE GOOD TO MATCH EXISTING AT THE CONTRACTOR'S EXPENSE.

16. CONTRACTOR SHALL MAINTAIN AT ALL TIMES ACCESS FOR EMERGENCY VEHICLES AND RESIDENTS ALONG THE ENTIRE PROJECT.

17. SUBSTANTIAL COMPLETION OF THE TRAFFIC SIGNALS SHALL BE DEFINED AS ALL COMPONENTS OF THE TRAFFIC SIGNAL OPERATED FULLY AND SATISFACTORILY WITH RED, YELLOW, AND GREEN CYCLES. SUBSTANTIAL COMPLETION SHALL ALLOW FOR TESTING OF THE SIGNALS, INCLUDING A FLASH PERIOD, PRIOR TO SIGNALS OPERATING WITH CYCLES.

18. FINAL ACCEPTANCE OF TRAFFIC SIGNALS SHALL BE DEFINED AS FINAL WRITTEN APPROVAL AND ACCEPTANCE BY THE CITY, INCLUDING COMPLETION OR CORRECTIONS OF ALL PUNCH LIST ITEMS AND THE TRAFFIC SIGNALS FULLY OPERATIONAL FOR A TIME PERIOD OF FIFTEEN (15) DAYS, WITHOUT ANY PROBLEM, AS NOTED IN THE SPECIFICATIONS. AS-BUILT PLANS SHALL BE SUBMITTED PRIOR TO FINAL ACCEPTANCE

19. THE CONTRACTOR SHALL VERIFY AND/OR COORDINATE WITH THE VARIOUS SERVICE PROVIDERS ON THE EXACT LOCATIONS OF METERS, CONNECTION POINTS AND OTHER SPECIFIC PROJECT REQUIREMENTS. THE PROPOSED SERVICE LINE LOCATIONS THAT ARE SHOWN ARE CONCEPTUAL AND ARE NOT WARRANTED.

PROJECT SPECIFIC NOTES:

 THE CONTRACTOR SHALL SUPPLY THE TRAFFIC SIGNAL CONTROLLER, CABINET, SIGNAL POLES WITH MAST ARMS AND POWER SUPPLY ASSEMBLY, AND THE CONTRACTOR SHALL INSTALL THE EQUIPMENT. THE CONTRACTOR WILL BE

YNC COMPONENTS. WILL REQUIRE NEW CAMERA AND CARD.

2. THE VIDEO DETECTION SYSTEM SHALL BE AN IN SYNC ADAPTIVE TRAFFIC CONTROL SYSTEM SUPPLIED BY RHYTHM ENGINEERING, 12351 W 96TH TERRACE, SUITE 107, LENEXA, KANSAS 66215, PHONE (913)227-0603. MATERIALS SUPPLIED BY RHYTHM ENGINEERING SHALL CONSIST OF AN IN SYNC PROCESSOR, VIDEO CAMERAS, TRANSFORMER, RG CABLE, DETECTOR CARDS AND CABLES, SITE EQUIPMENT PANELS, MONITOR, KEYBOARD AND CAMERA MOUNTING HARDWARE.

3. CABLES FOR THE VIDEO DETECTION SYSTEM SHALL BE ONE CONTINUOUS 3c-#14 CABLE AND ONE CONTINUOUS CATEGORY 5E+ CABLE (SHIELDED OUTDOOR RATED) BETWEEN THE CONTROLLER AND EACH CAMERA. THE 3c-#14 CABLE SHALL MEET REQUIREMENTS OF IMSA 20-1. CABLES ARE INCLUDED IN THE LUMP SUM PRICE FOR THE VIDEO DETECTION SYSTEM. NO ADDITIONAL PAYMENTS WILL BE MADE.

CONSTRUCTION SEQUENCING:

 CONTRACTOR TO OBTAIN AND FOLLOW TEMPORARY TRAFFIC CONTROL PERMIT (TTCP) CONDITION REQUIREMENTS.

2. CONTRACTOR TO SUBMIT FOR APPROVAL BY CITY OF LEE'S SUMMIT TRAFFIC ENGINEER A DETAILED TRAFFIC SEQUENCING PHASING PLAN.

3. CONTRACTOR TO MAINTAIN EXISTING SIGNAL OPERATIONS UNTIL NEW SYSTEM, HAS BEEN TESTED AND OPERATIONAL.

4. PER TTCP, CONTRACTOR TO INSTALL TRAFFIC CONTROL, CHANNELIZATION DEVICES AND TEMPORARY PAVEMENT MARKING AROUND WORK ZONE.

5. CONTRACTOR TO PROVIDE PEDESTRIAN DETOUR PLAN ALONG WITH TRAFFIC SEQUENCING PLAN.

6. CONTRACTOR TO INSTALL CONSTRUCTION FENCING AROUND AREAS WHERE PEDESTRIAN MOVEMENTS MAY CONFLICT WITH CONSTRUCTION ACTIVITIES.

7. NO COLLECTOR OR ARTERIAL STREETS SHALL HAVE LANE(S) REDUCED OR CLOSED BEFORE 9 A.M. AND AFTER 4 P.M. MONDAY THRU FRIDAY. NO WORK ON SATURDAY, SUNDAYS OR HOLIDAYS OBSERVED BY THE CITY.

8. ALL TRAVEL LANES SHALL BE A MINIMUM OF 11.00 FEET WIDE EXCLUDING CURB AND GUTTER. ALL SIDEWALKS SHALL HAVE A MINIMUM CLEAR PATH OF 3.5 FEET. ALL MULTI-USE PATHS SHALL HAVE A MINIMUM CLEAR PATH OF 8.00 FEET.

9. CONTRACTOR SHOULD REVIEW TTCP AND MEET REQUIREMENTS PER CITY OF LEE'S SUMMIT REGULATIONS.

LEGEND

- OPTICALLY LIMITING TRAFFIC SIGNAL HEAD
- TRAFFIC SIGNAL HEAD
- TRAFFIC SIGNAL HEAD WITH BACKPLATE
- PEDESTRIAN SIGNAL HEAD



- ☆ STREET LIGHT POLE
- ◆ MAST ARM POLE
- SIGNAL PEDESTAL
- TRAFFIC CONTROLLER CABINET
- STREET LIGHT CONTROLLER CABINET
- PULL BOX
- FIBER OPTIC PULL BOX

POWER SUPPLY (DISCONNECT)

SUGGESTED VEHICLE DETECTION ZONE

 PUSH BUTTON DETECTOR OPTICOM DETECTOR

✓ SECONDARY SERVICE POINT

--- CONDUIT SIGNAL FACE NUMBER

POST NUMBER


DETECTOR NUMBER

PULL BOX NUMBER


PB24 PUSH BUTTON NUMBER

COBRA HEAD LUMINAIRE VIDEO DETECTION CAMERA

→ SIGN

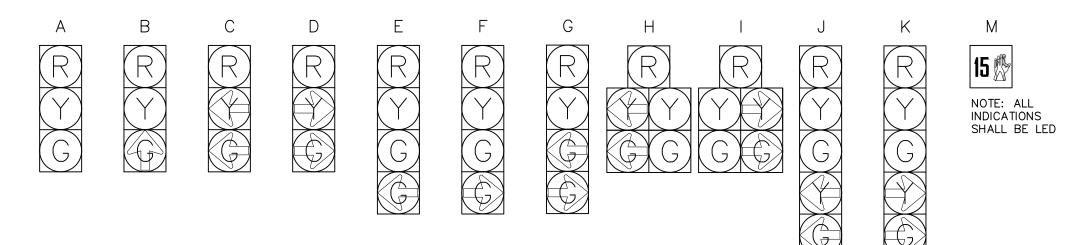



TYPICAL REGULATORY SIGN DETAIL

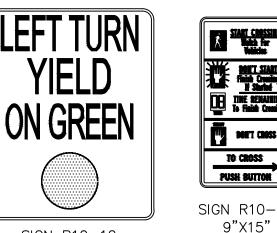

SIGN R10-12

12"X30"

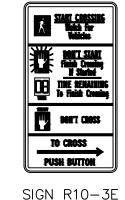


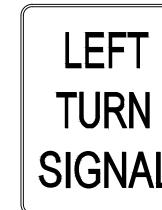



SIGN R10-10L

24"X30"

NOTE: SIGN R10-3E SHALL BE PROVIDED FOR EACH PUSH BUTTON

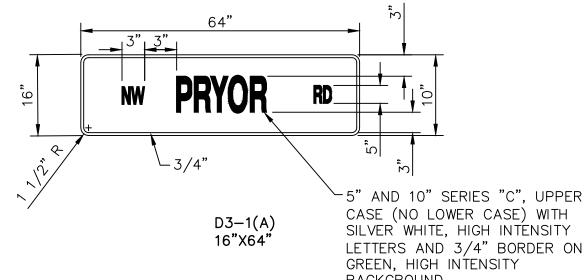

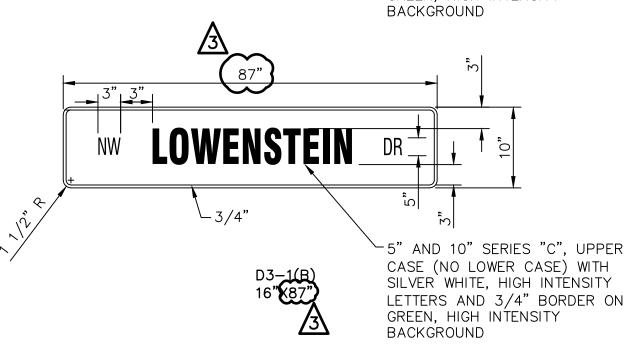

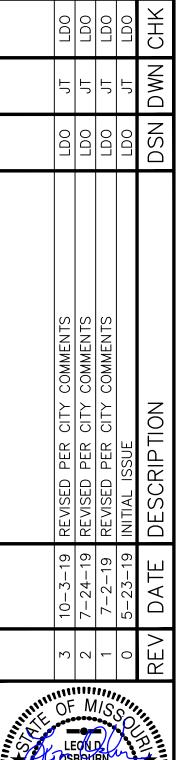

NUMBER E-21726

LEON D. OSBOURN ENGINEER MO # 021726


LEERIN BOX S 66 785) ENG


DR TEIN NTS AND LANE \
& CONSTRUCTION

PRYOR / NW PRYOF SUMMIT, I

A14_7067-1 DESIGNER | DRAWN B LDO JT/BKR

7067-1SIG_GN

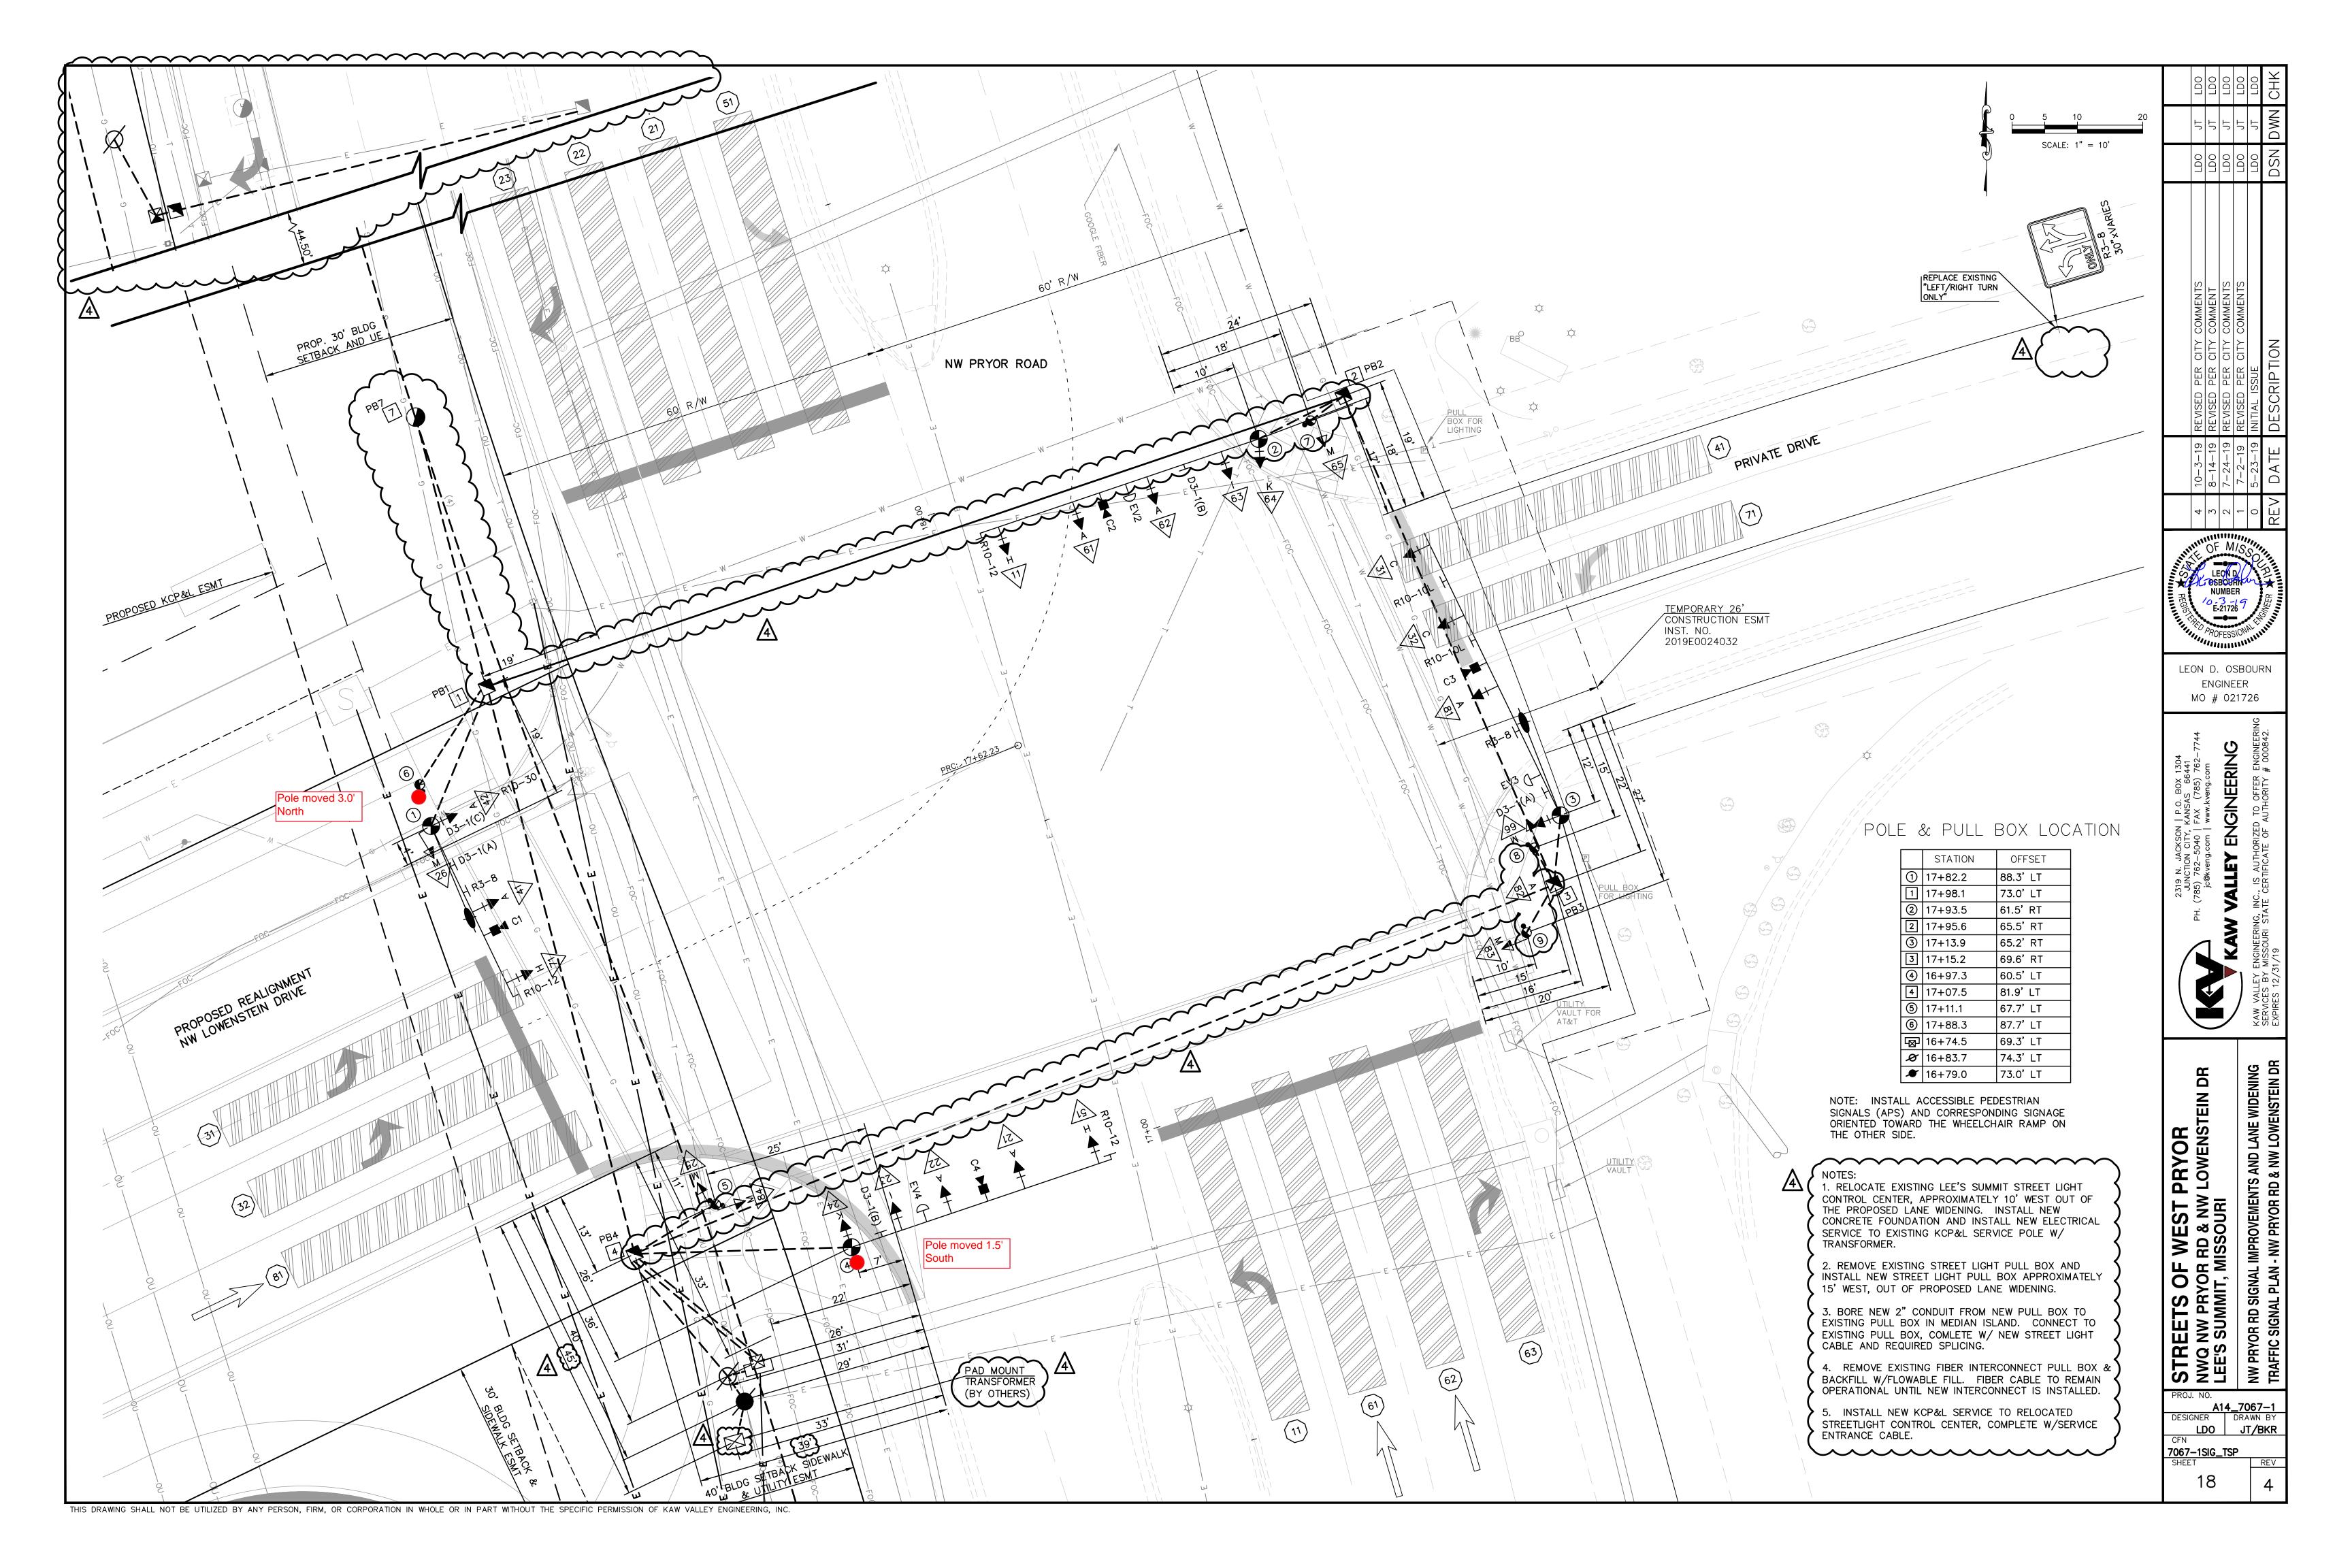

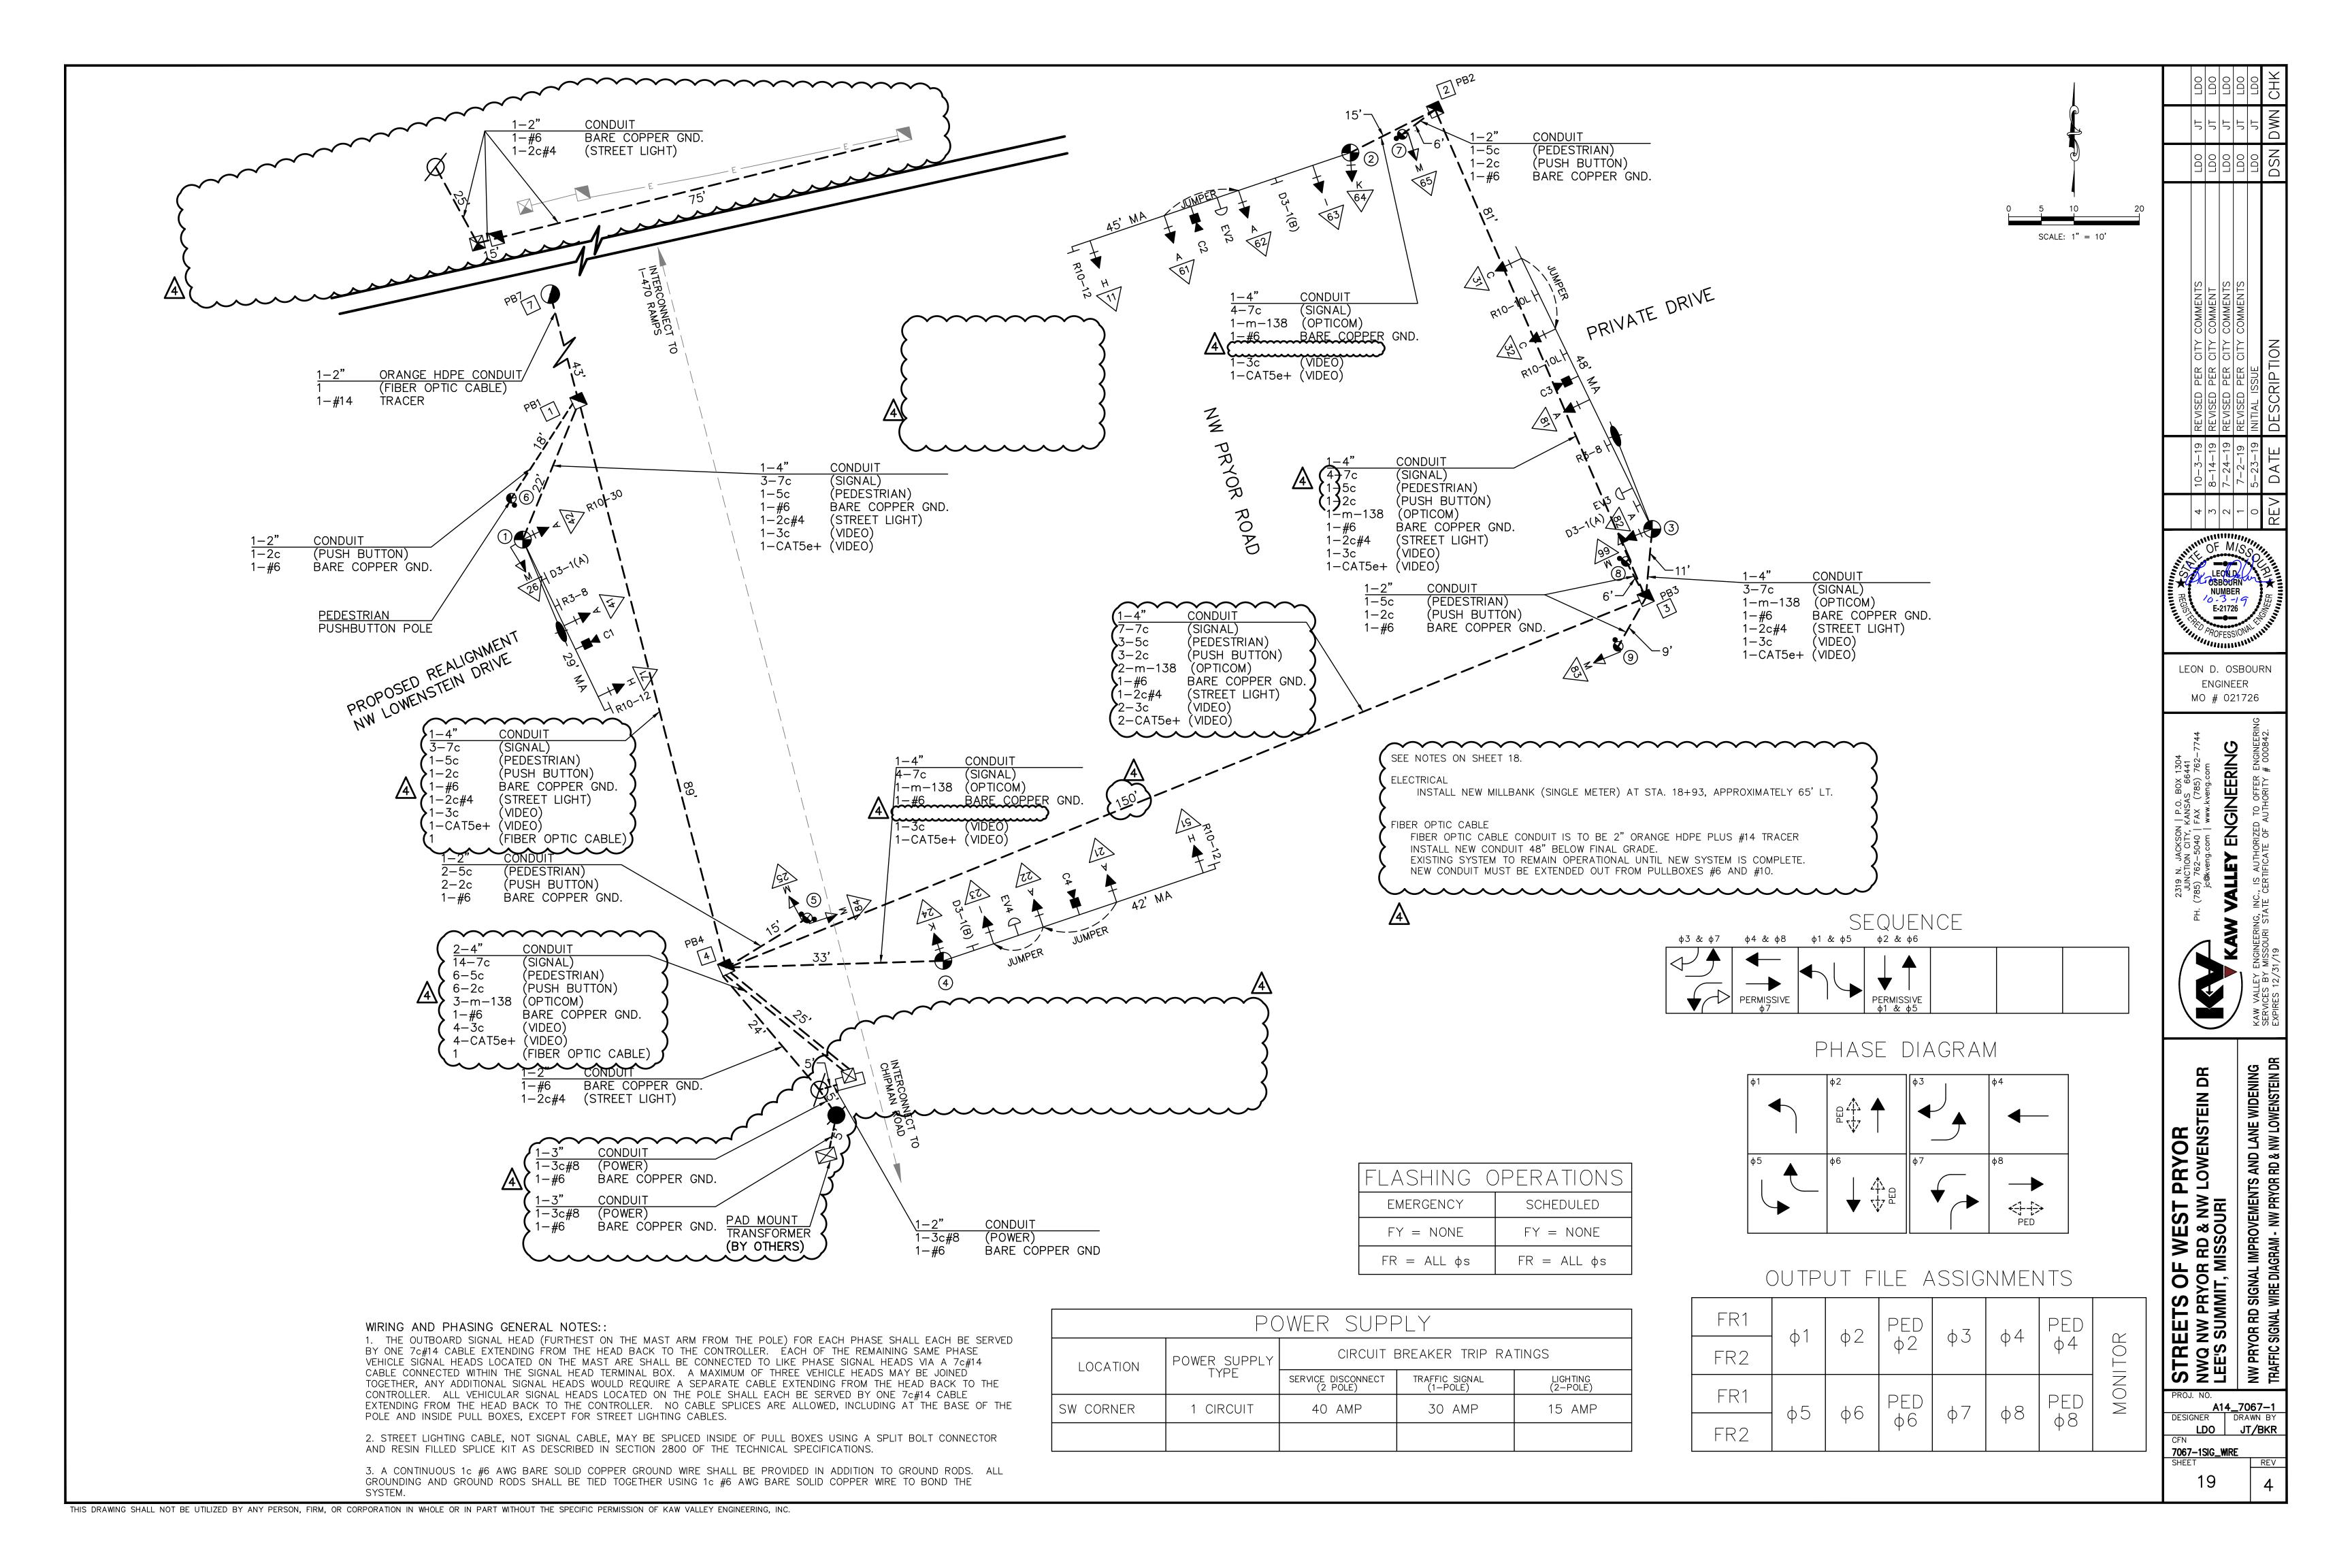

	1			ı				<u> </u>				POLES				
O Z		DES POL	Ε		Αŀ	AST RM		S		. HEA CING	D		LIGHTING	Т		
POLE 1	1	HEIGH (FEE				IGTH EET)		Α	В	С	D	MOUNTING 4 HEIGHT	4\150 W L.E.D		CKET .ENGTH	REMARKS
مَ	4	8	15	29	35			E	F	G	Н		LUMINAIRES	LEFT	RIGHT	
1 2 3						4	29 - 45 48	12' 6' 22'	15' 12' 12'	12' 12'	12'	40	ACT 1	10	4	
4							42	8'	8'	12'	12'	4	4		4	
5		1	1													
6 7	1		1													
8			1													
9			1													
	1															
	1															
TOTALS		1	4													

*	SIGNAL HEAD SPACING (FEET) MAY BE ADJUSTED TO SITE	
	CONDITIONS AS APPROVED BY THE PROJECT INSPECTOR.	

												SIG	NAL	_	IEA	DS																
	10								INDIC	`	NIC							V	ISORS					(SEC	CTIC	SNC	<u> </u>				
	10.								INDIC	AIIO	110				Ļ				TYPE													
	ACE	AD TYPE	. LIMITED	LOUVERS	BACKPLATE				12"	LED	S			\ \ \	FLASH DON' WALK	WQ/	INTDOWN CATIONS	_;	CUTAWAY		₁		, T	N	10L 	TNU T	TIN(G 			5	
POLE	FA(HEAD	OPT.	0	3A(R	Y	G	Y	G 	G	Y	G-	WALK]/M	COUNT INDICA	TUN		P	S	P		Р	1	S	Р		S		- 1	S
1	71	H			Х	1	1	1	1	1	G	-	G					5			3		3		1	3		101	3	\dashv	101	$\stackrel{\circ}{\dashv}$
'	41	A			X	1	1	1	'	'								3							$\frac{1}{1}$			_		十		\dashv
	42	Α			Χ	1	1	1				1	1					5						1						寸		
	26	М															1							1								
2	11	Н			Χ	1	1	1	1	1								5							1							
	61	Α			Χ	1	1	1										3							1							
	62	Α			Χ	1	1	1										3							1					\Box		
	63				Χ	1	1	1				1	1					5							1							
	64	K			Χ	1	1	1				1	1					5						1								
	65	М															1							1								
3	66	М															1							1						\perp		
	31	С			Χ	1			1	1															1					ightharpoonup		
	32	С			Χ	1			1	1															1			_		\dashv	$ \bot $	
	81	Α			Х	1	1	1																	1					\dashv		
	82	Α			Χ	1	1	1																1						\dashv		
	83	M				4											1						_	1	_	_	_	_	_	\dashv	_	
4	51	H			X	1	1	1	1	1								5						_	1	_	_			\dashv	_	
	21	A			X	1	1	1												_			_	_	1	_	\dashv		_	\dashv	\dashv	
	22	A			X	1	1	1					1					_		_			_	_	1	_	\dashv	\dashv	\dashv	\dashv	\dashv	
	23				X	1	1	1				1 1	1					5		_			\dashv	1	1	\dashv	\dashv	\dashv	\dashv	\dashv	\dashv	
	24	K			Χ												1	5		-		_	_	1	\dashv	\dashv	\dashv	\dashv	\dashv	\dashv	\dashv	
5	25	M															1 1			-		-	\dashv	1	\dashv	\dashv	\dashv	\dashv	\dashv	\dashv	\dashv	
	84	М																		_			\dashv	-	\dashv	\dashv	\dashv	\dashv		\dashv	\dashv	
TOT	ALS					17	15	15	5	5		5	5				6	49						10	13							

- P POLE MOUNTED SIGNAL HEAD
- M MAST ARM MOUNTED SIGNAL HEAD
- S SPAN WIRE MOUNTED SIGNAL HEAD

1. QUANTITES SHOWN HEREON ARE FOR REFERENCE ONLY.

- ALIGN FACES OF PEDESTRIAN PUSHBUTTONS PARALLEL TO CROSS-WALK.
- 3. ALL PULL BOXES LOCATED IN TRAVEL WAY SHALL BE TRAFFIC RATED.

4. THE TRAFFIC SIGNAL SYSTEM SHALL BE COMPLETE AND THE CONTRACTOR SHALL FURNISH AND INSTALL ALL EQUIPMENT AND MATERIALS NECESSARY FOR THE SATISFACTORY OPERATION OF ELECTRICAL APPARATUS AND FOR COMPLETE OPERATION OF THE TRAFFIC SIGNAL SYSTEM WHETHER SPECIFICALLY MENTIONED OR NOT.

Ν	Ο.			В	ASE:	S			PULL	BOXES	
POLE	PULL BOX	B10	B13	С	EV	POWER SUPPLY	CONC. (C.Y.)	CLASS 1	CLASS 2	CLASS 3	FIBER OPTIC
1			1				3.0 3.4				
3 4			1				3.4 3.4				
5				1			0.44				
	1			'			0.11				
	3										
7	5			1		5	·····	3 <u>4</u>			1
8				1			0.44	}			
9				1			0.44	3			
CON						£	1				
<u>POV</u> tot	VER ALS		4	 5			15.08	\$			2

	CONTROLLER AND EQUIPMENT	TOTALS
	CABINET AND ACCESSORIES: NEMA TYPE P TS1 CABINET	1
	CONTROLLER: TYPE 3608 M 52 EAGLE EPAC COMPLETE PER PLANS, INCLUDING SOFTWARE	1
	EMERGENCY VEHICLE DETECTION SYSTEM (COMPLETE): 3M	2
	VIDEO DETECTION SYSTEM (COMPLETE (4 CAMERAS): 1NSYNC ADAPTIVE TRAFFIC CONTROL SYSTEM	1
	FIBER OPTIC DATA LINK SWITCH: KYLAND SICOM 3170	1
	1-CIRCUIT POWER SUPPLY (MoDOT TYPE II POWER SUPPLY WITH LIGHTING CIRCUITS)) 1
	GROUND RODS	9
	PUSHBUTTON DETECTORS	6
•		

	Ρ(OWER/	ĹIGHTI	NG		CAB Contro YPE 20	L	LEAD-IN CABLE	EMERGENCY PRE-EMPTION	VIE CA	EO BLE*	REMARKS
	c-8	2c-4				~~	7c-14	\sim	CABLE * V m-138		CAT5e+	~~~
_		20 1					255	20 11				
							0.75			255	255	
							235 225					
						225	220					
							367					
						12	352					JUMPER
						12				348	348	OOWII EIX
									343			
							325 318					
					307	307	310					
						00,	243					
						12				050	050	JUMPER
_							245			250	250	
							2+5		228			
							220					
_					218	218						
					214	214	161					
							147					
						12						JUMPER
						8				147	147	JUMPER
									147	1 7 7	1 7	
							100					
					79 79	79 79						
_		209			79	79						
		265										
	35											
	35 17											
	1 /											
_												
_												
_	0.7	4				4400	7407		740	4000	4000	
2	87	474			897	1166	3193		718	1000	1000	
	100	550			1030	1340	3670		820	1150	1150	


CABLE


FI	BEF	R OPTIC	INTER	CONNECT							
		CONDUIT & CABLE									
FROM	10	2" HDPE (ORANGE)	FIBER OPTIC CABLE	#14 STRANDED COPPER TRACER WIRE							
1	2										
2	3										
<u>3</u>	<u>4</u> <u>5</u>										
5	6	4007	1007	1007							
6 7	7 8	400' 600'	400' 600'	400' 600'							
8	9	515'	515'	515'							
9 7	10	375' 55'	375' 55'	375' 55'							
1	4		55' 89'								
4	\boxtimes		25'								
	STOTAL EET)	1945	2059	1945							
BID	TOTAL EET)	2240	2370	2240							

	SI	GNAL	CONDU			SIGNS			
FROM) TO	3" PVC	2" HDPE (GREY)	4" HDPE	SIGN	LEGEND	NO.	SF.	TOTAL S.F.
1	Ø	10			R10-10L	LEFT TURN SIGNAL	2	5.0	10.0
Ø			10		R10-10R	LT TUDN VIELD ON ODEEN			45.0
	4		10 30		R10-12 R10-3E	LT TURN YIELD ON GREEN	3	5.0	15.0
	4		30	75 30 100	R10-30	RIGHT TURN ON RED MUST YIELD TO U-TURN	1	7.5	7.5
1	(6)		30)		^		
2	2 3 7			20 100	R3-8	VARIES	2	10.0	20.0
3 3	(3)		12	18	D3-1(A) D3-1(B)	NW PRYOR RD LOWENSTEIN DR.	2 2		
3	8		15		()	LOWLINGTEIN DIX.			
4	(4)		10	40	\				
4	5		20)				
4	3			175					
}									
	TOTAL EET)	10	139	558	TOTAL				52.5
	TOTAL EET)	20	160	640	S				

STREETS OF WEST PRYOR
NWQ NW PRYOR RD & NW LOWENSTEIN DR
LEE'S SUMMIT, MISSOURI

LEON D. OSBOURN ENGINEER MO # 021726

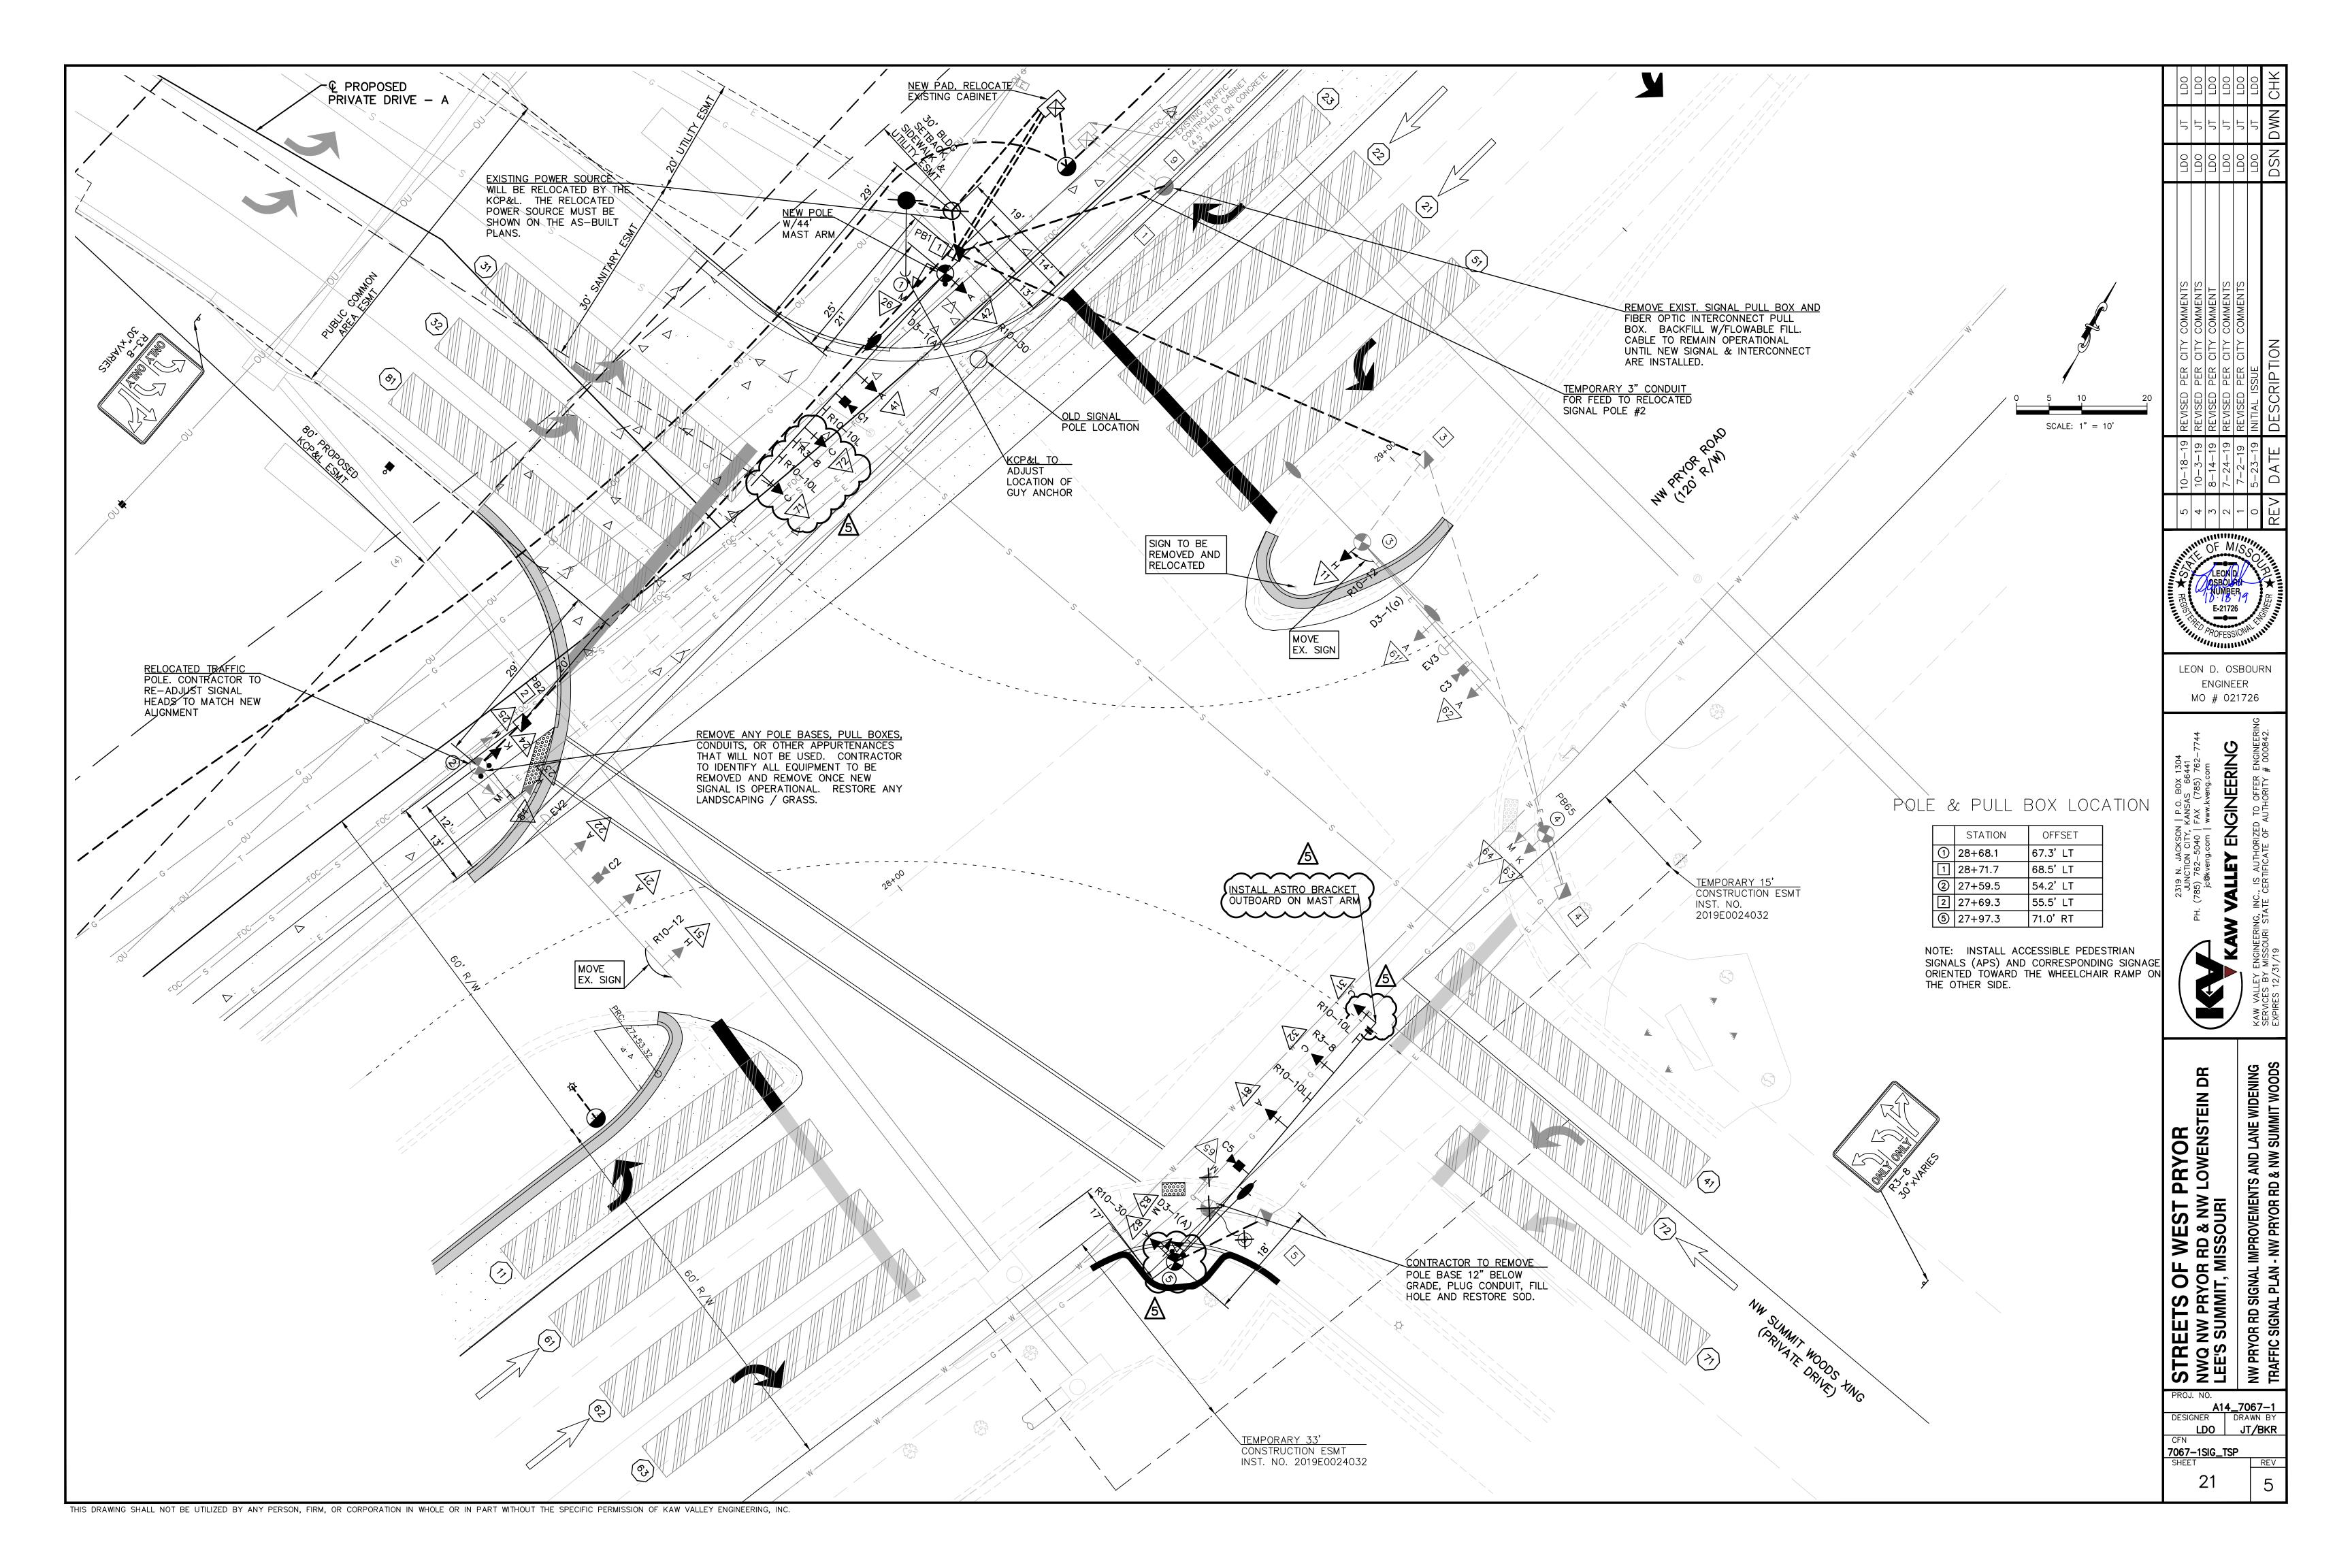

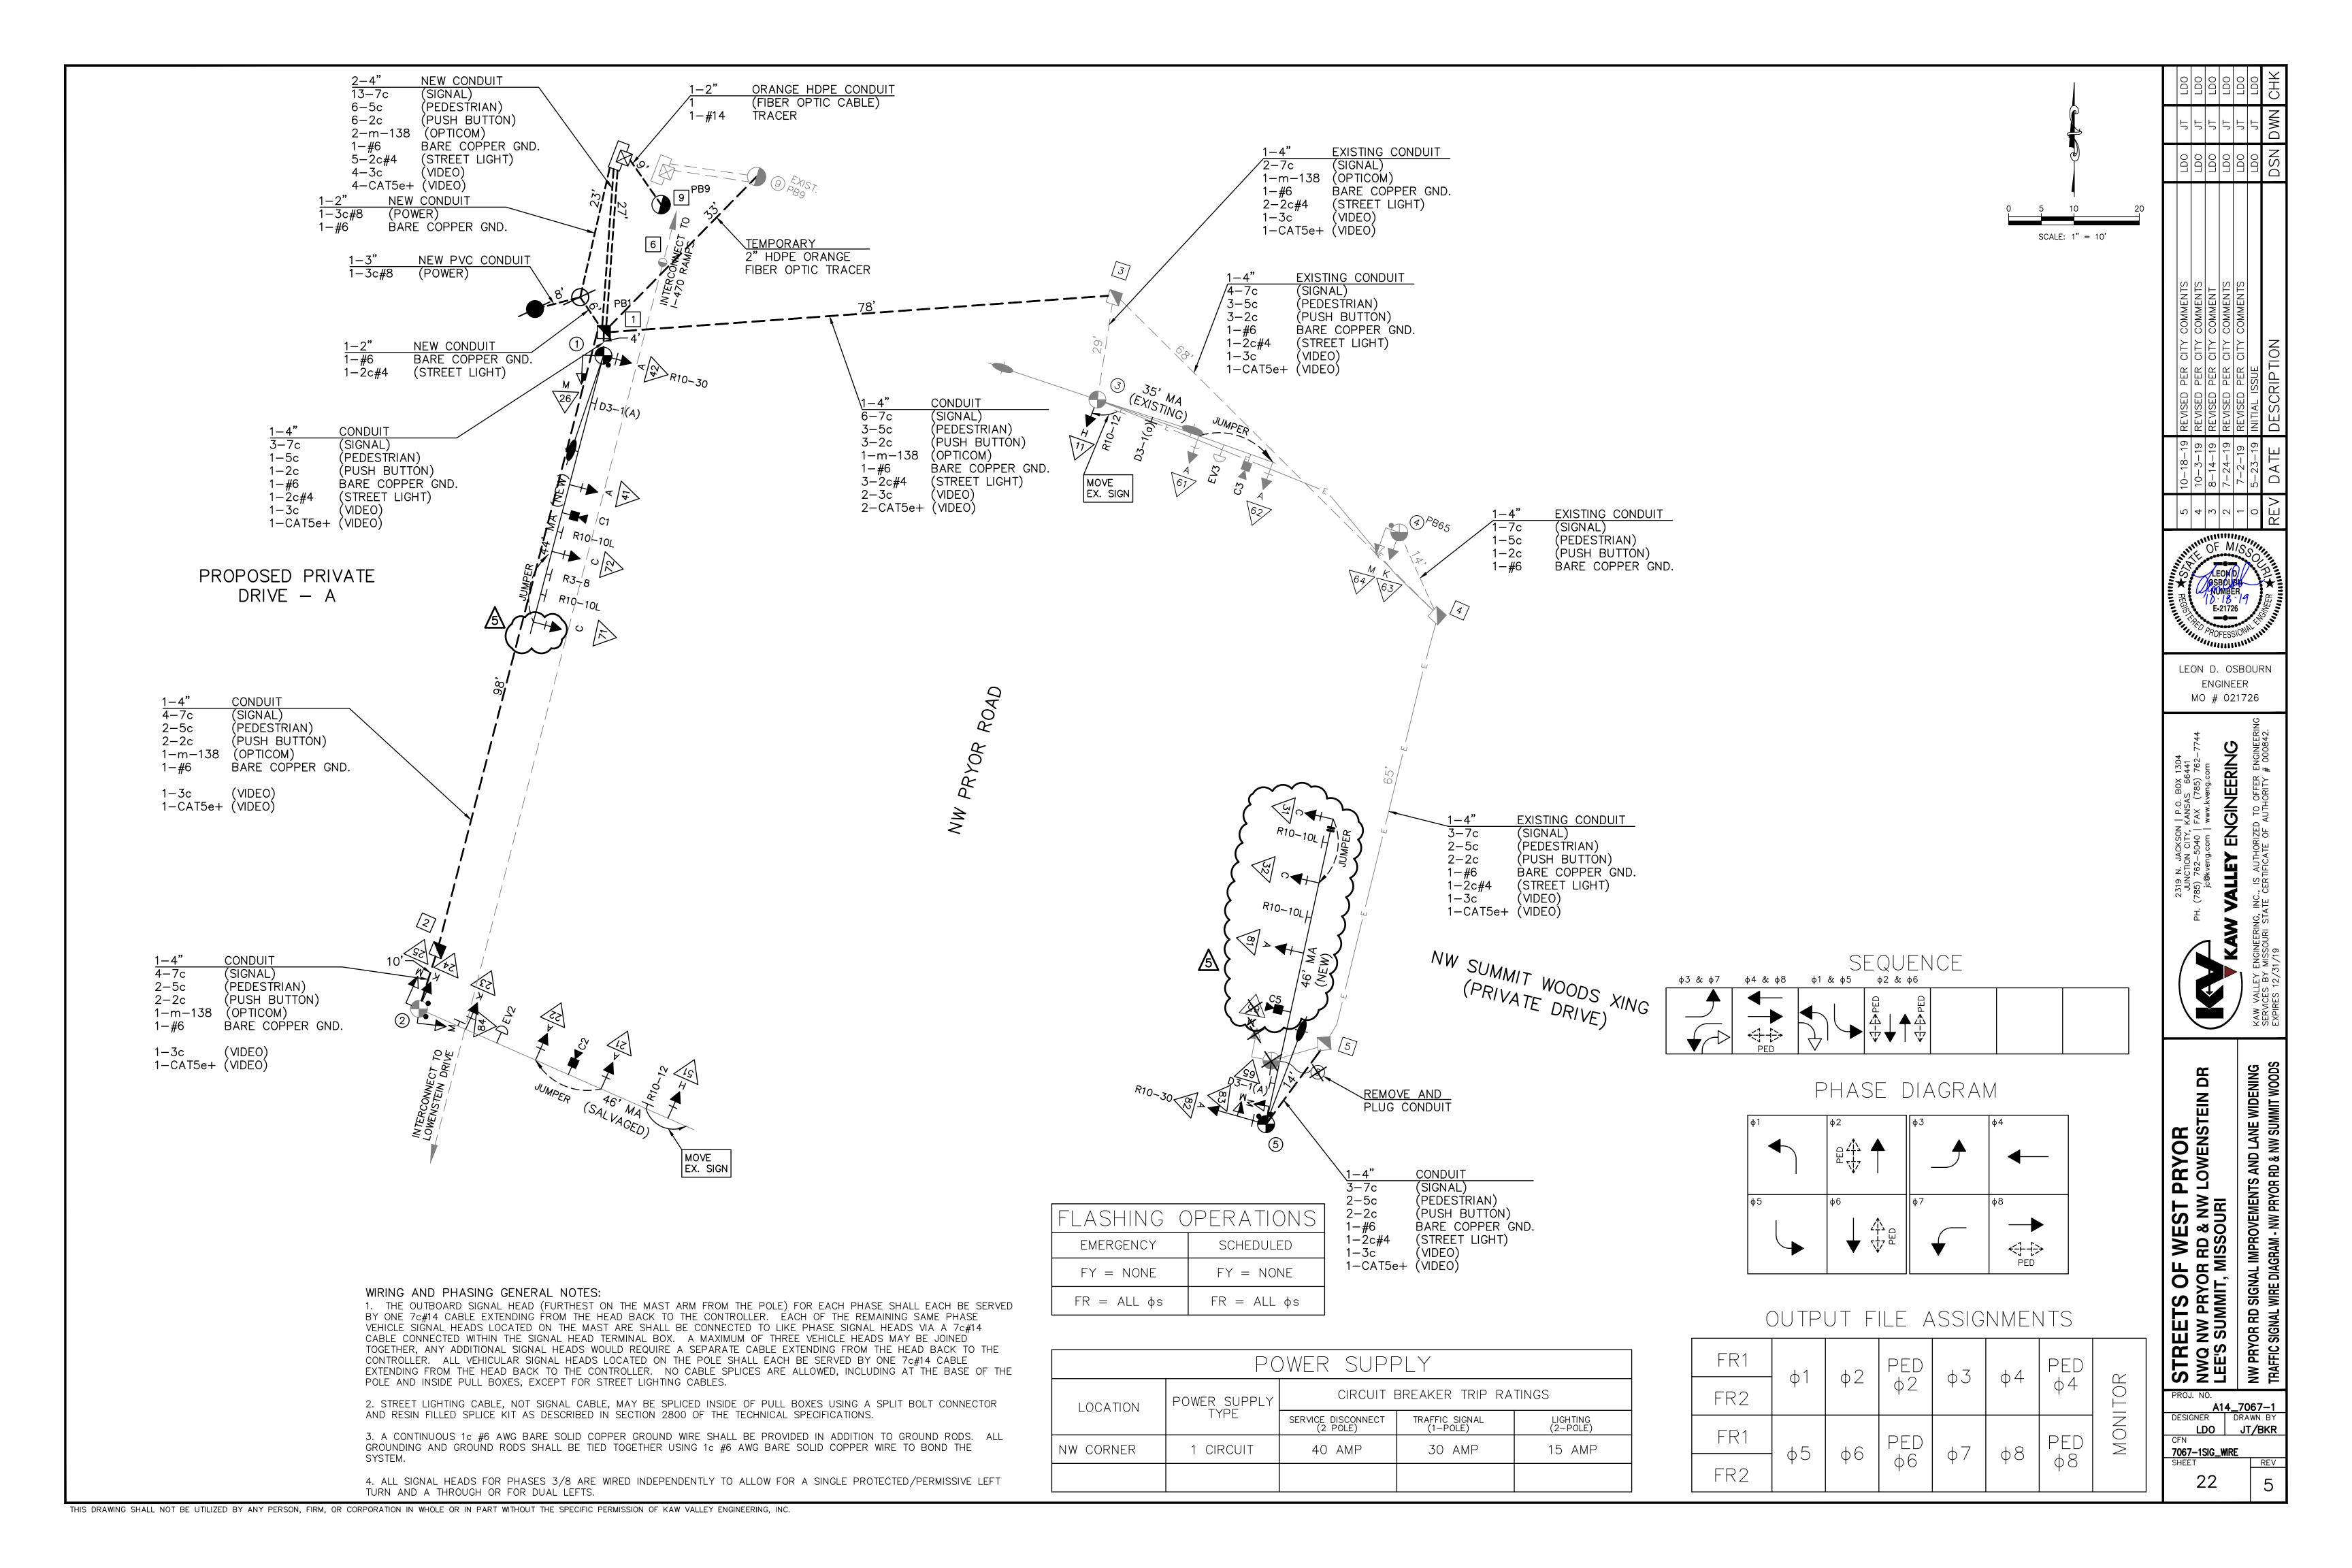

												POLES				
O Z	1	DES POLE			M A A F	ST RM		S		_ HEA CING	D		LIGHTING			
	1	HEIGH (FEE			LEN (FE			A	В	C C	D	MOUNTING	150 W		CKET LENGTH	REMARKS
POLE	4	8	15	29	35	44	46	E	F	G	Н	HEIGHT	L.E.D. LUMINAIRES	LEFT	RIGHT	
1						1			CEN	1		40'		10'		NEW POLE
2							1	0,		ANES		REUSE 2 46' MAST ARM				EXISTING — RELOCATED
5							1					40'		10'		NEW POLE
	-	\vdash														
)TALS						1	2									
л ALS						ı										

				<u> </u>	<u> </u>	LL B	<u>UXES</u>				
٨	10.			В	ASE:			PULL	BOXES		
1	PULL BOX	B10	B13	С	EV	POWER SUPPLY	3.4	CLASS 1	CLASS 2	CLASS 3	FIBER OPTIC
2 3 4		XIST					3.4				
5	1 2 3		XIST				3.4		1	1	
	4 5 6	—E	XIST	ING-						1	1
CON	NTR.						1				
	WER ALS		3				11.2		1	2	1

CONTROLLER AND EQUIPMENT

CABINET AND ACCESSORIES:

FIBER DISTRIBUTION UNIT:

WITH LIGHTING CIRCUITS)

PUSHBUTTON DETECTORS

KYLAND SICOM 3170

PUSHBUTTON DETECTORS

GROUND RODS

GROUND RODS: REUSE EXISTING

FIBER OPTIC DATA LINK SWITCH:

NEMA TYPE P TS1 CABINET

CONTROLLER: TYPE 3608 M 52 EAGLE EPAC

VIDEO DETECTION SYSTEM (COMPLETE):

COMPLETE PER PLANS, INCLUDING SOFTWARE

INSYNC ADAPTIVE TRAFFIC CONTROL SYSTEM

EMERGENCY VEHICLE DETECTION SYSTEM (COMPLETE):

3M REMOVE FROM PRIVATE DRIVE FOR LOWENSTEIN

1-CIRCUIT POWER SUPPLY (MODOT TYPE II POWER SUPPLY

TOTALS

-EXISTING-

-EXISTING-

-1

+1

INSYNC

FROM	10	GROUND	P	OWER/LI	GHTING		ONTR YPE 2	OL	LEAD-IN CABLE	EMERGENCY PRE-EMPTION CABLE		DEO BLE	REMARKS
FR	L	#6	3c-8	2c-4		2c-14	5c-1	4 7c-14	2c-14	m-138	3c#14	CAT5e+	
71	71 72						11	91					JUMPER
/	12						11						JOINT LIX
	C1							74			54	54	
	41 42							71 51					
\boxtimes	26					51	51						
	51 21							195 181					
21	22						11	101					JUMPER
	C2										175	175	
	EV2									161			
\boxtimes	23							157					
\boxtimes	24 84					146	146	146					
	25					146	146						
	C3										164	164	
	EV3									159	104	104	
	61						17	153					
61	62 11						13	135					JUMPER
	63							196					
	64 31					196	196	310					
31	32						12	010					JUMPER
	C5										289	289	
	81							284			203	203	
	82					0.71	0.71	271					
	83 65					271 271	271 271						
Ø	1			25									
Ø	② ③ ⑤			288 270									
Ø	<u>5</u>			268									
Ø	\boxtimes		19 41	-									
			1 1										
				+									
				-									
CVC	STEM	475											
SUB	OTAL	475	60	851		1081	1128	2241		320	682	682	
	ET) FOTAL							+					
	ET)	490	70	960		1240	1290	2240		370	790	790	

CABLE

												SIG	NAL		HEA	.DS																	
									INIDIO	CATIO	MIC							V	ISOF	RS					(SEC	TI(ONS	 S				
	NO.								וועטונ	JATIO	1N 3				<u></u>				TYPE														
	1.1	TYPE (LIMITED	OUVERS	CKPLATE		12" LEDS								SH DON,	>	COUNTDOWN		CUTAWAY						N	101	JN ⁻	TIN	G 				
POIF	FACE	AD	OPT.		Ş			_						WALK	FLASH	W/DW		TUN.	<u> </u>			1	2	2		3		<u> </u>	4			5	
ا مَ	'L	H	9		BA	R	Y	G	Y	G-	G	Y	G-	>	-				ರ		Р	S	Р	S	Р	М	S	Р	М	S	Р	М	S
1	71	С			Χ	1			1	1								3								X						\Box	
	72	С			Χ	1			1	1								3								X							
	41	Α			Χ	1	1	1										3								Χ							
	42	Α			Χ	1	1	1										3							Χ								
2	51	Н			Χ	1	1	1	1	1								5								Χ							
	21	Α			Χ	1	1	1										3								Χ							
	22	Α			Χ	1	1	1										3								Χ							
	23				Χ	1	1	1				1	1					5								Χ							
	24	K			Χ	1	1	1				1	1					5							Χ						\perp		
	25	M															1								Χ								
1	26	M															1								Χ						\perp		
3	11	H			Χ	1	1	1	1	1								5							Χ								
5	31	С			Χ	1			1	1								3								Х							
	32	С			Χ	1			1	1								3								Х							
	81	A			Χ	1	1	1										3								Χ			\Box		\perp	\Box	
	82	Α			Χ	1	1	1										3							Χ								
	83	М															1								Χ								
	84	Ιм															1 1								Х			ıT	. T		T		

	Ο.								IIIDIC		1113				<u></u>				TYPE	-												
		TYPE	LIMITED	LOUVERS	PLATE				12"	LED	S				SH DON' WALK		COUNTDOWN		CUTAWAY		MOUNTING											
POLE	FACE	HEAD	OPT.	\ ()	BACKPL		i	i						WALK	FLASH WA	W/DW	NOC/	TUN.	JTA		1		2		-	3		4			5	
			Ъ			R	Υ	G	Y	G-	G	Y-	G-	>		>	SZ		7		Р	S	Р	SI	> N		i P	М	S	Р	M S	S
1	71	С			Χ	1			1	1								3)							
	72	С			Χ	1			1	1								3								(
	41	Α			Χ	1	1	1										3														
	42	Α			Χ	1	1	1										3							X							
2	51	Н			Χ	1	1	1	1	1								5												\perp		
	21	Α			Χ	1	1	1										3							<u> </u>					\perp		
	22	Α			Χ	1	1	1										3								<				ightharpoonup	\bot	
	23				Χ	1	1	1				1	1					5							_					\perp		
	24	K			Χ	1	1	1				1	1					5							X L					\perp		
	25	М															1								X					\perp		
1	26	М															1								X					\perp		
3	11	\perp			Χ	1	1	1	1	1								5							X					\perp		
5	31	С			Χ	1			1	1								3								<				\perp	\perp	
	32	\cup			Χ	1			1	1								3												ightharpoonup	\bot	
	81	Α			Χ	1	1	1										3												\perp		
	82	Α			Χ	1	1	1										3							X L		\perp			ightharpoonup	\bot	
	83	М															1								X					\perp		
	84	М															1								X		\perp			ightharpoonup	\bot	
	65	М															1								X					ightharpoonup		
																									\perp		\perp	1		\perp		
																							\perp		\perp		\perp			\perp	\perp	
																					Ш				\perp		\perp				\bot	
ТОТ	ALS				14	14	10	10	6	6		2	2				5	50							9 1	0						

P - POLE MOUNTED SIGNAL HEAD

M — MAST ARM MOUNTED SIGNAL HEAD

CONDITIONS AS APPROVED BY THE PROJECT INSPECTOR.


S - SPAN WIRE MOUNTED SIGNAL HEAD

1. QUANTITES SHOWN HEREON ARE FOR REFERENCE ONLY.

ALIGN FACES OF PEDESTRIAN PUSHBUTTONS PARALLEL TO CROSS-WALK.

3. ALL PULL BOXES LOCATED IN TRAVEL WAY SHALL BE TRAFFIC RATED.

THE TRAFFIC SIGNAL SYSTEM SHALL BE COMPLETE AND THE CONTRACTOR SHALL FURNISH AND INSTALL ALL EQUIPMENT AND MATERIALS NECESSARY FOR THE SATISFACTORY OPERATION OF ELECTRICAL APPARATUS AND FOR COMPLETE OPERATION OF THE TRAFFIC SIGNAL SYSTEM WHETHER SPECIFICALLY MENTIONED OR NOT.

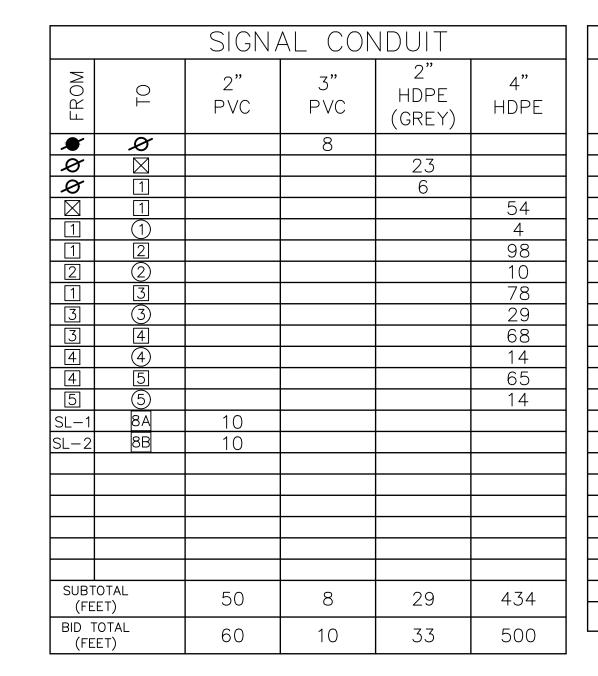

SIGN	LEGEND	NO.	SF.	TOTAL S.F.	
R10-10L	LEFT TURN	4	5.0	20.0	
R10-12	LTYOG	2	5.0	10.0	
R10-3E	PED CROSSING	6		-	
R10-30	RTORMYTUT	2	7.5	15.0	
D3-1(A)	NW PRYOR RD	1	7.1	7.1	
R3-8	LANE USAGE	2	, . 1	7 . 1	
1.0	E/TIVE CO/TOE				
					-
TOTAL				52.1	

SIGNS

	MO #	0217	'26
	2319 N. JACKSON P.O. BOX 1304 JUNCTION CITY, KANSAS 66441 PH. (785) 762-5040 FAX (785) 762-7744 jc@kveng.com www.kveng.com	KAW VALLEY ENGINEERING	KAW VALLEY ENGINEERING, INC., IS AUTHORIZED TO OFFER ENGINEERING SERVICES BY MISSOLIRE STATE CERTIFICATE OF ALLHORITY # DOOR42
1		I	

LEON D. OSBOURN


ENGINEER


REVISED PER CITY COMMENTS
REVISED PER CITY COMMENTS
REVISED PER CITY COMMENT
REVISED PER CITY COMMENTS
REVISED PER CITY COMMENTS


STREETS OF WEST PRYOR
NWQ NW PRYOR RD & NW LOWENSTEIN DR
LEE'S SUMMIT, MISSOURI


A14_7067-1
DESIGNER DRAWN BY


7067-1SIG_QTY SHEET

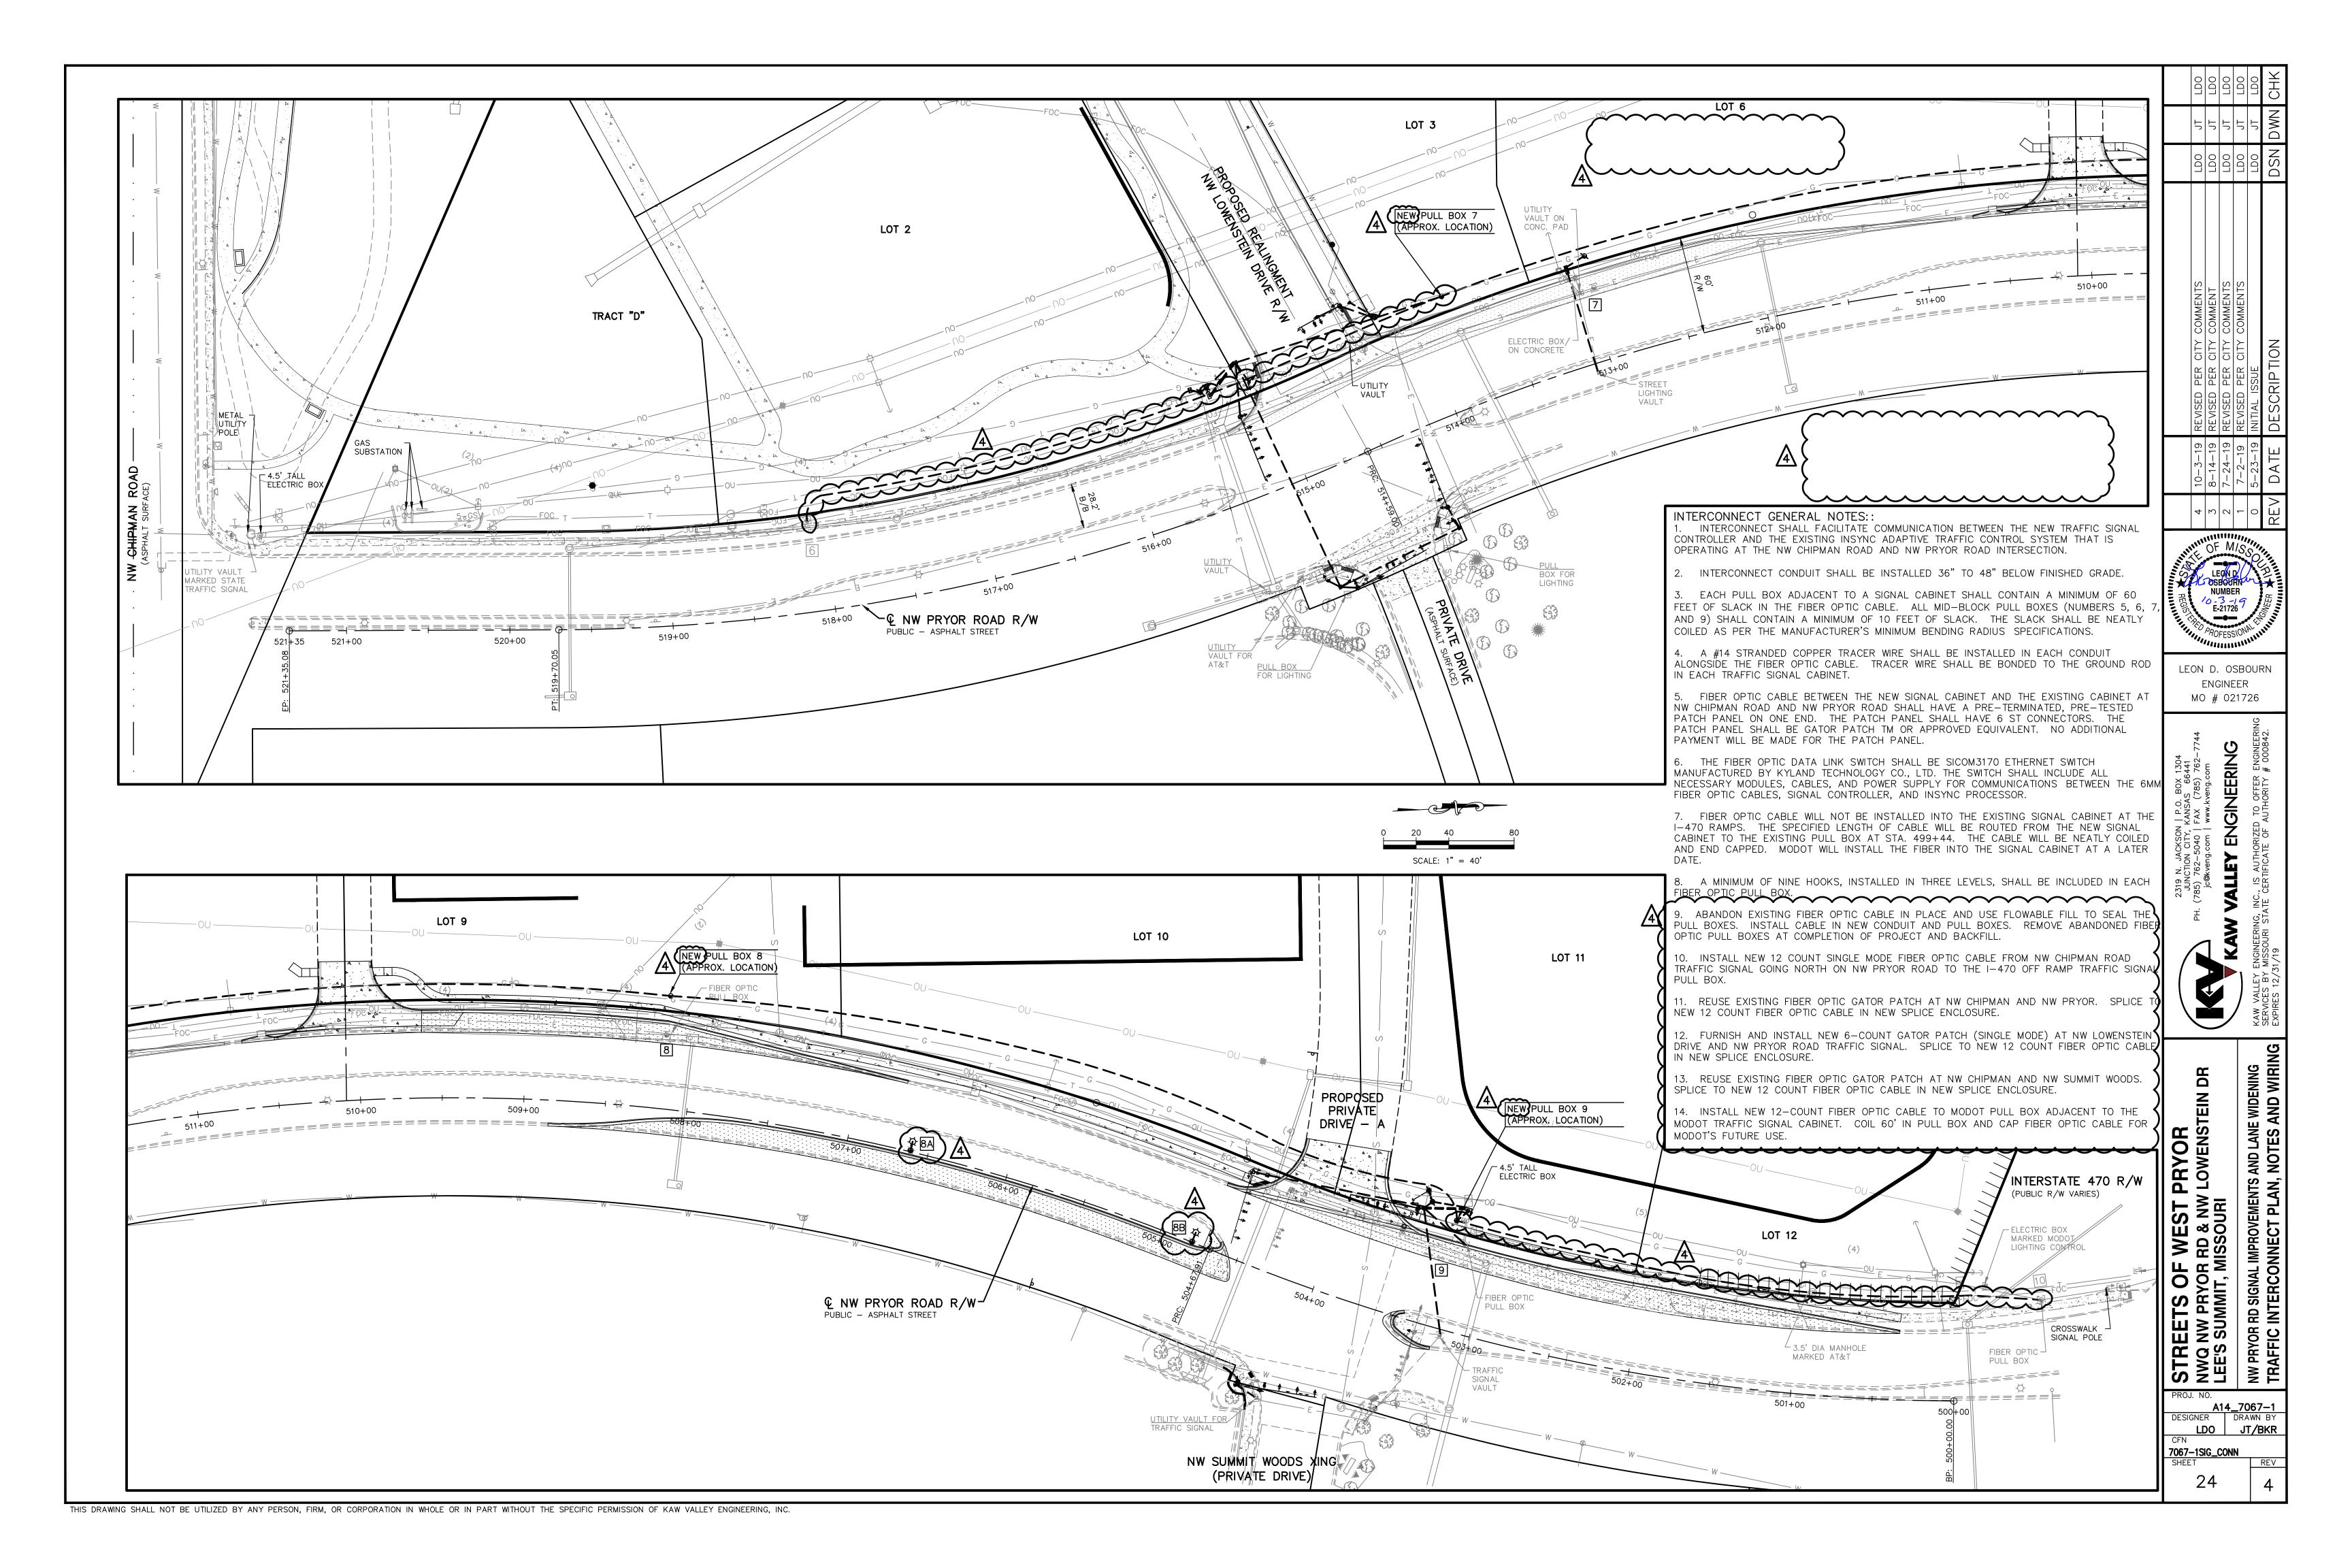


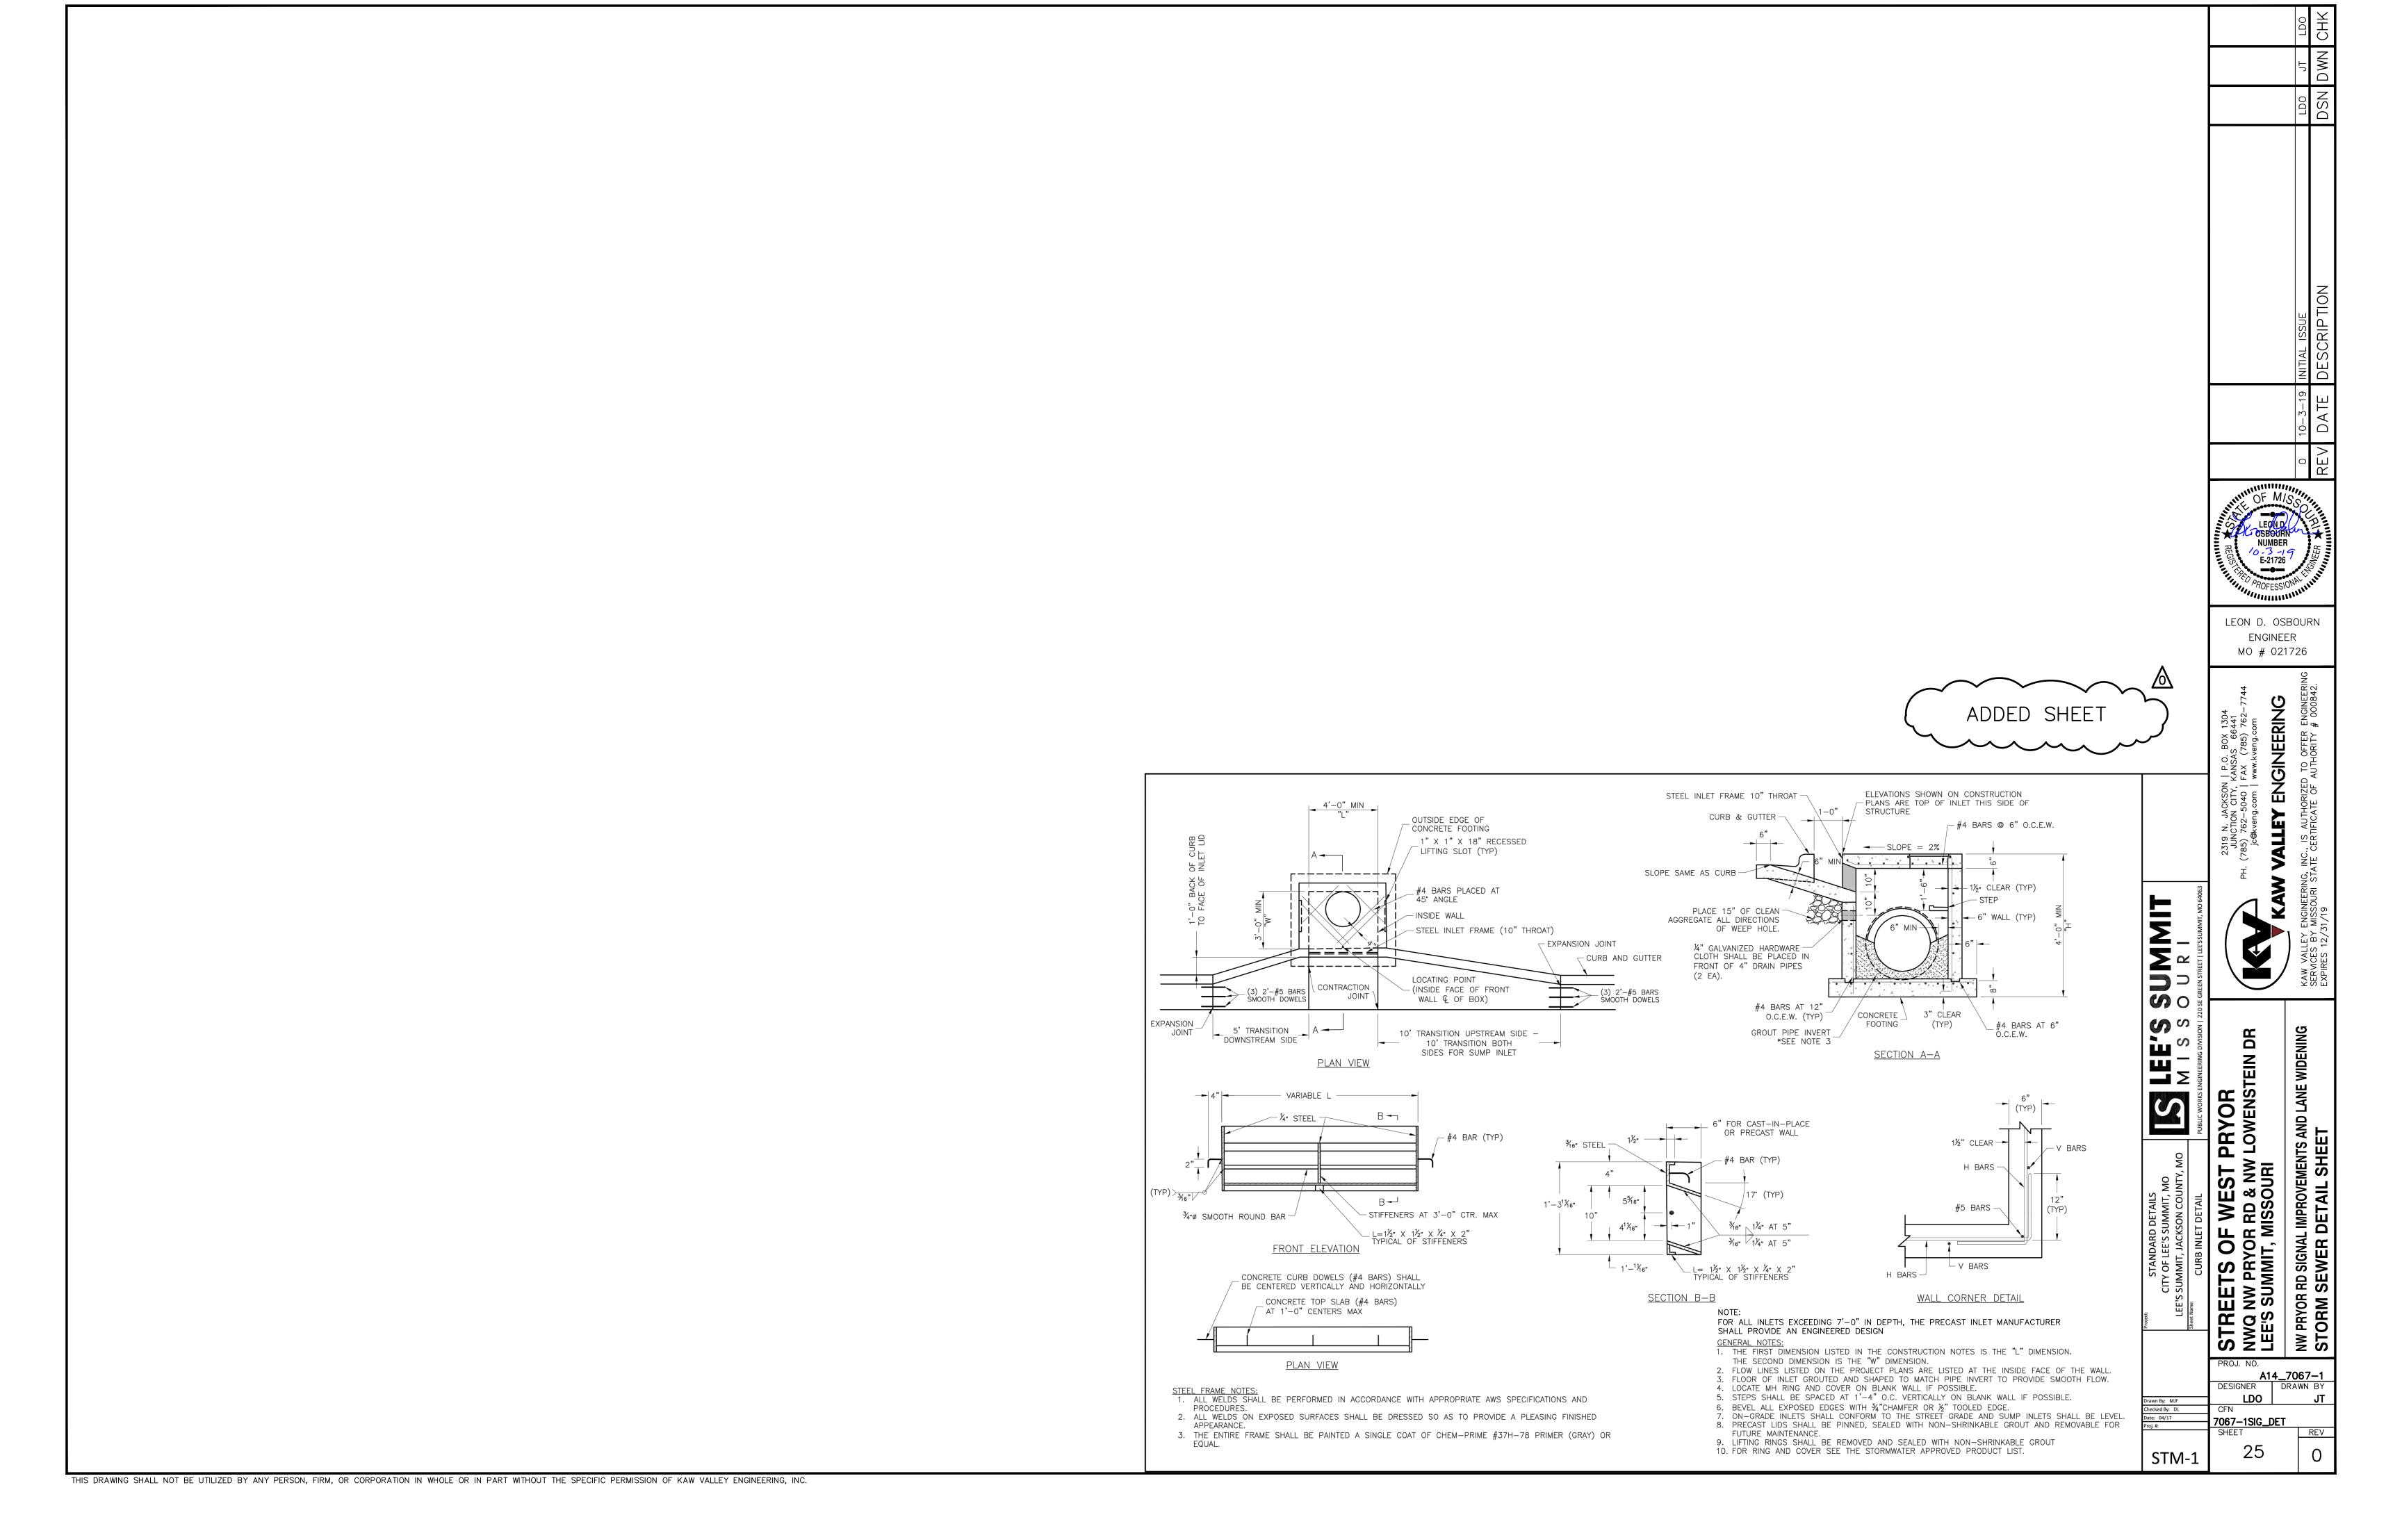

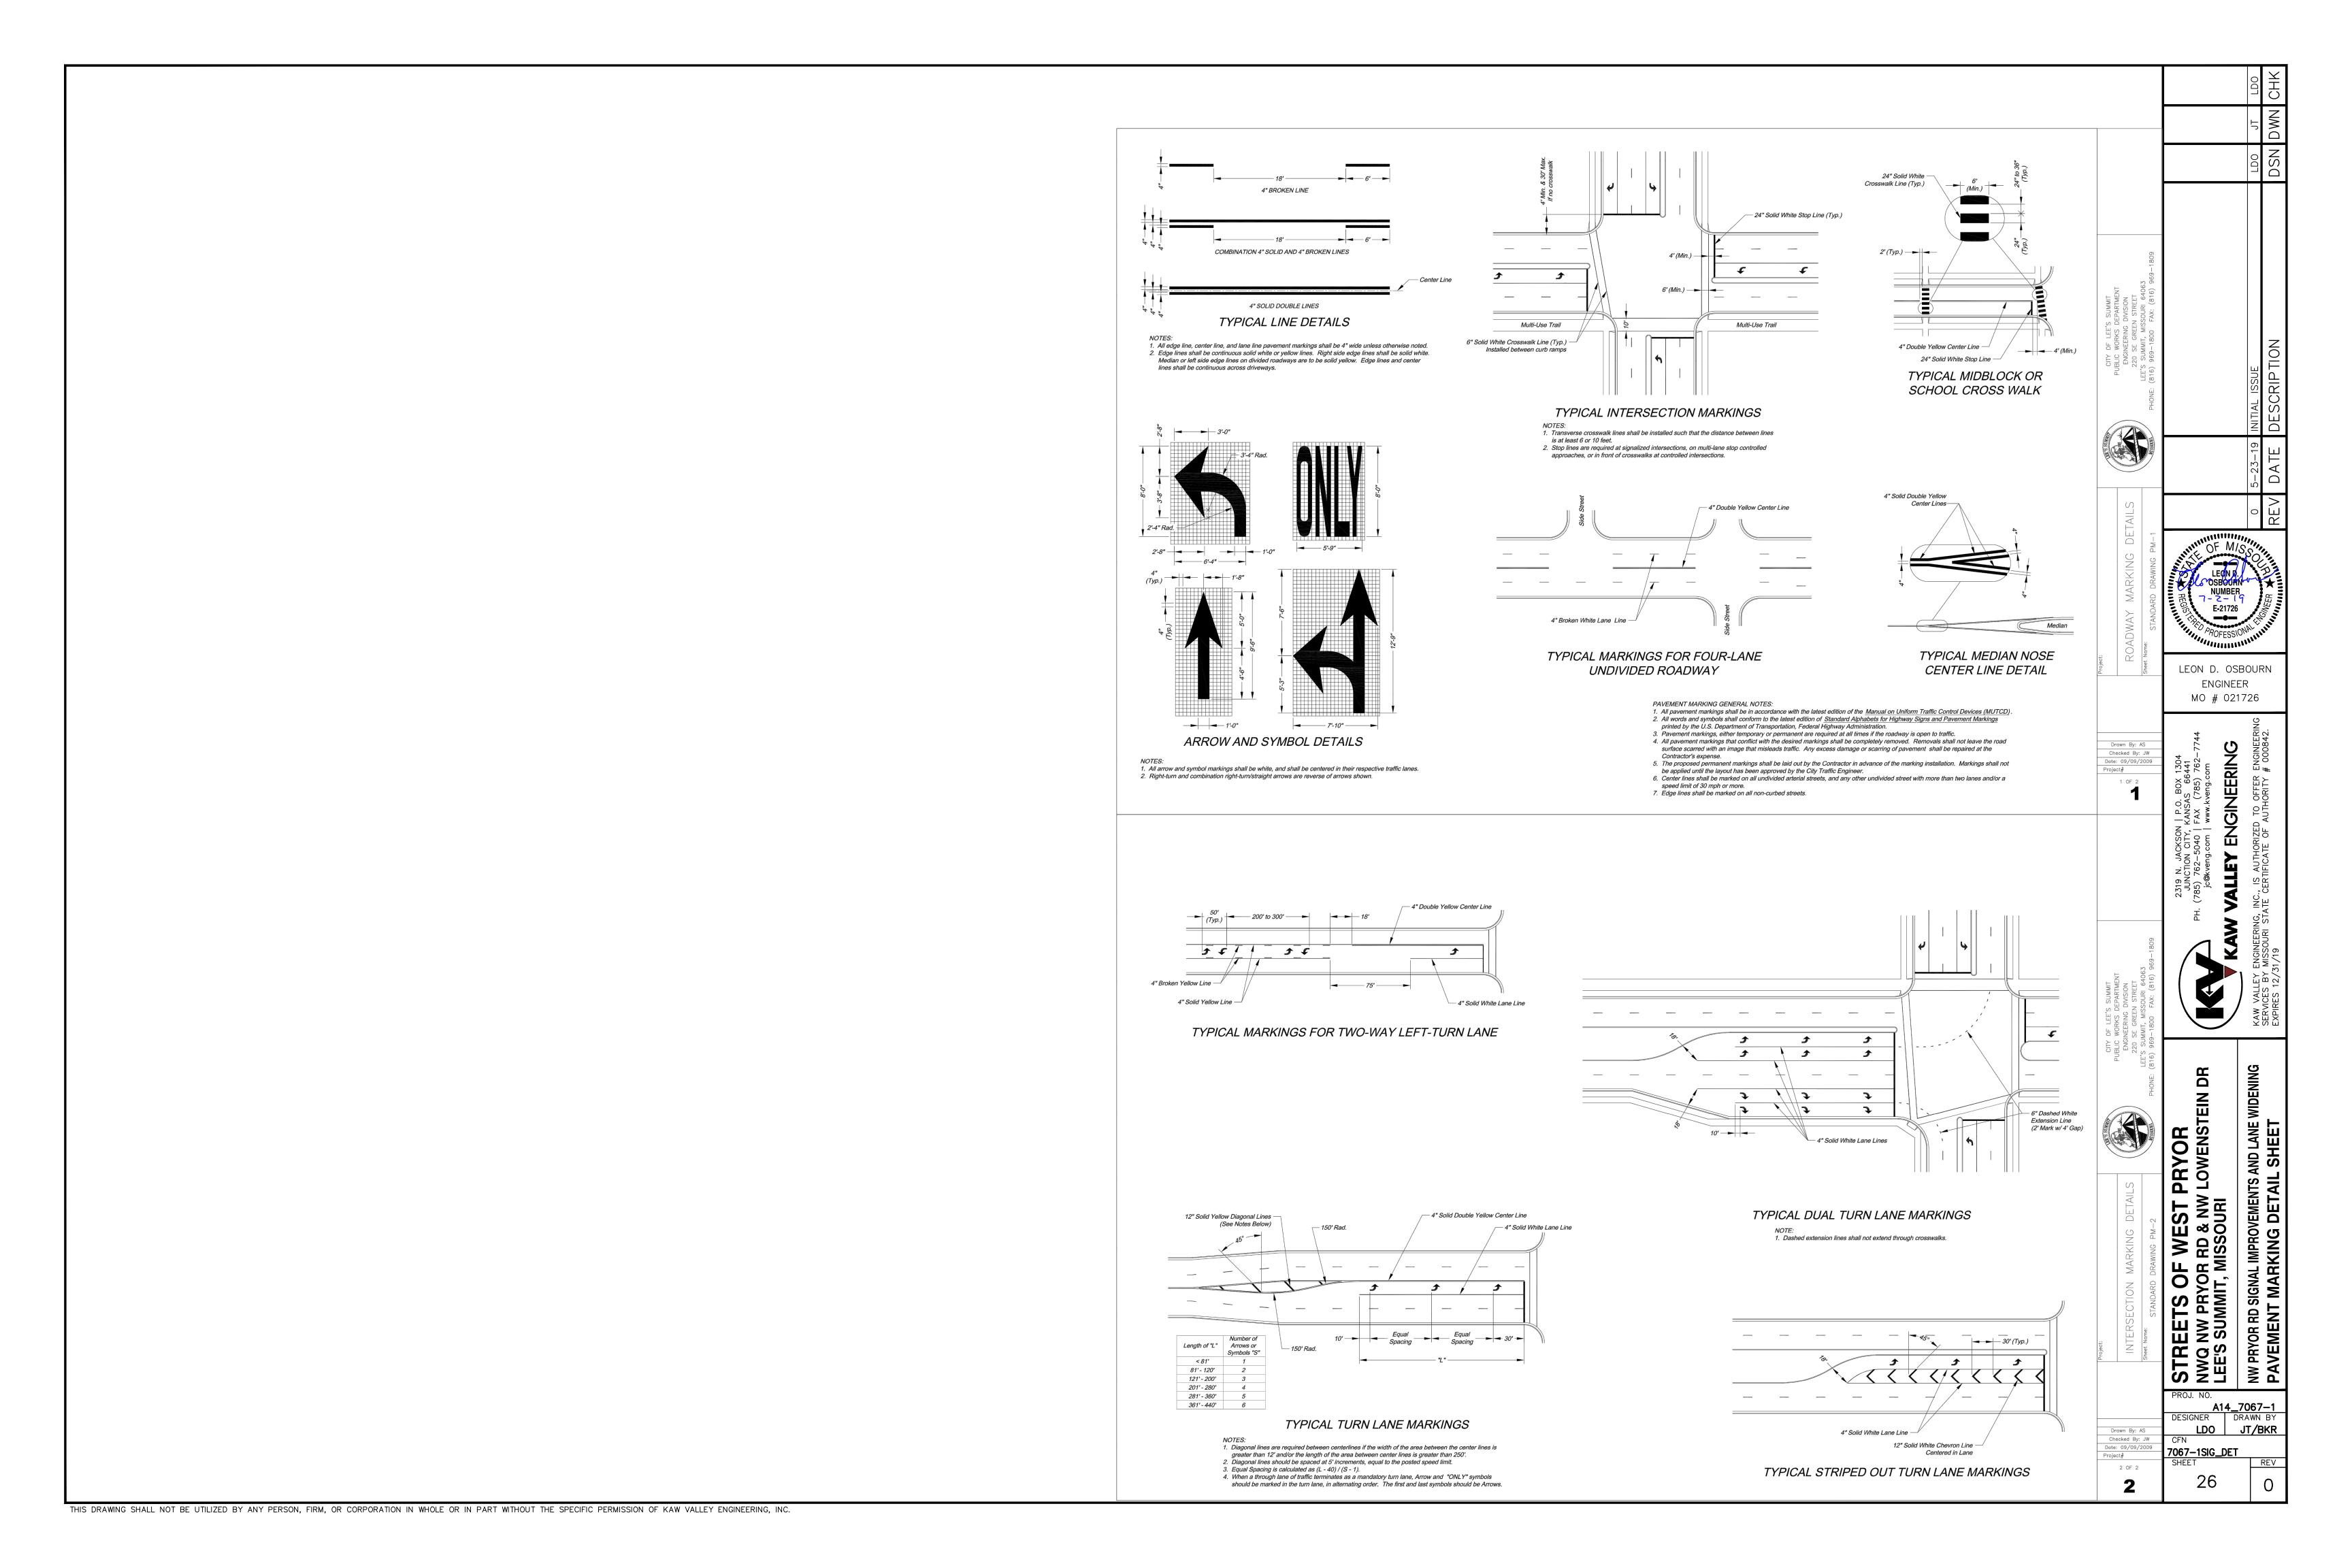

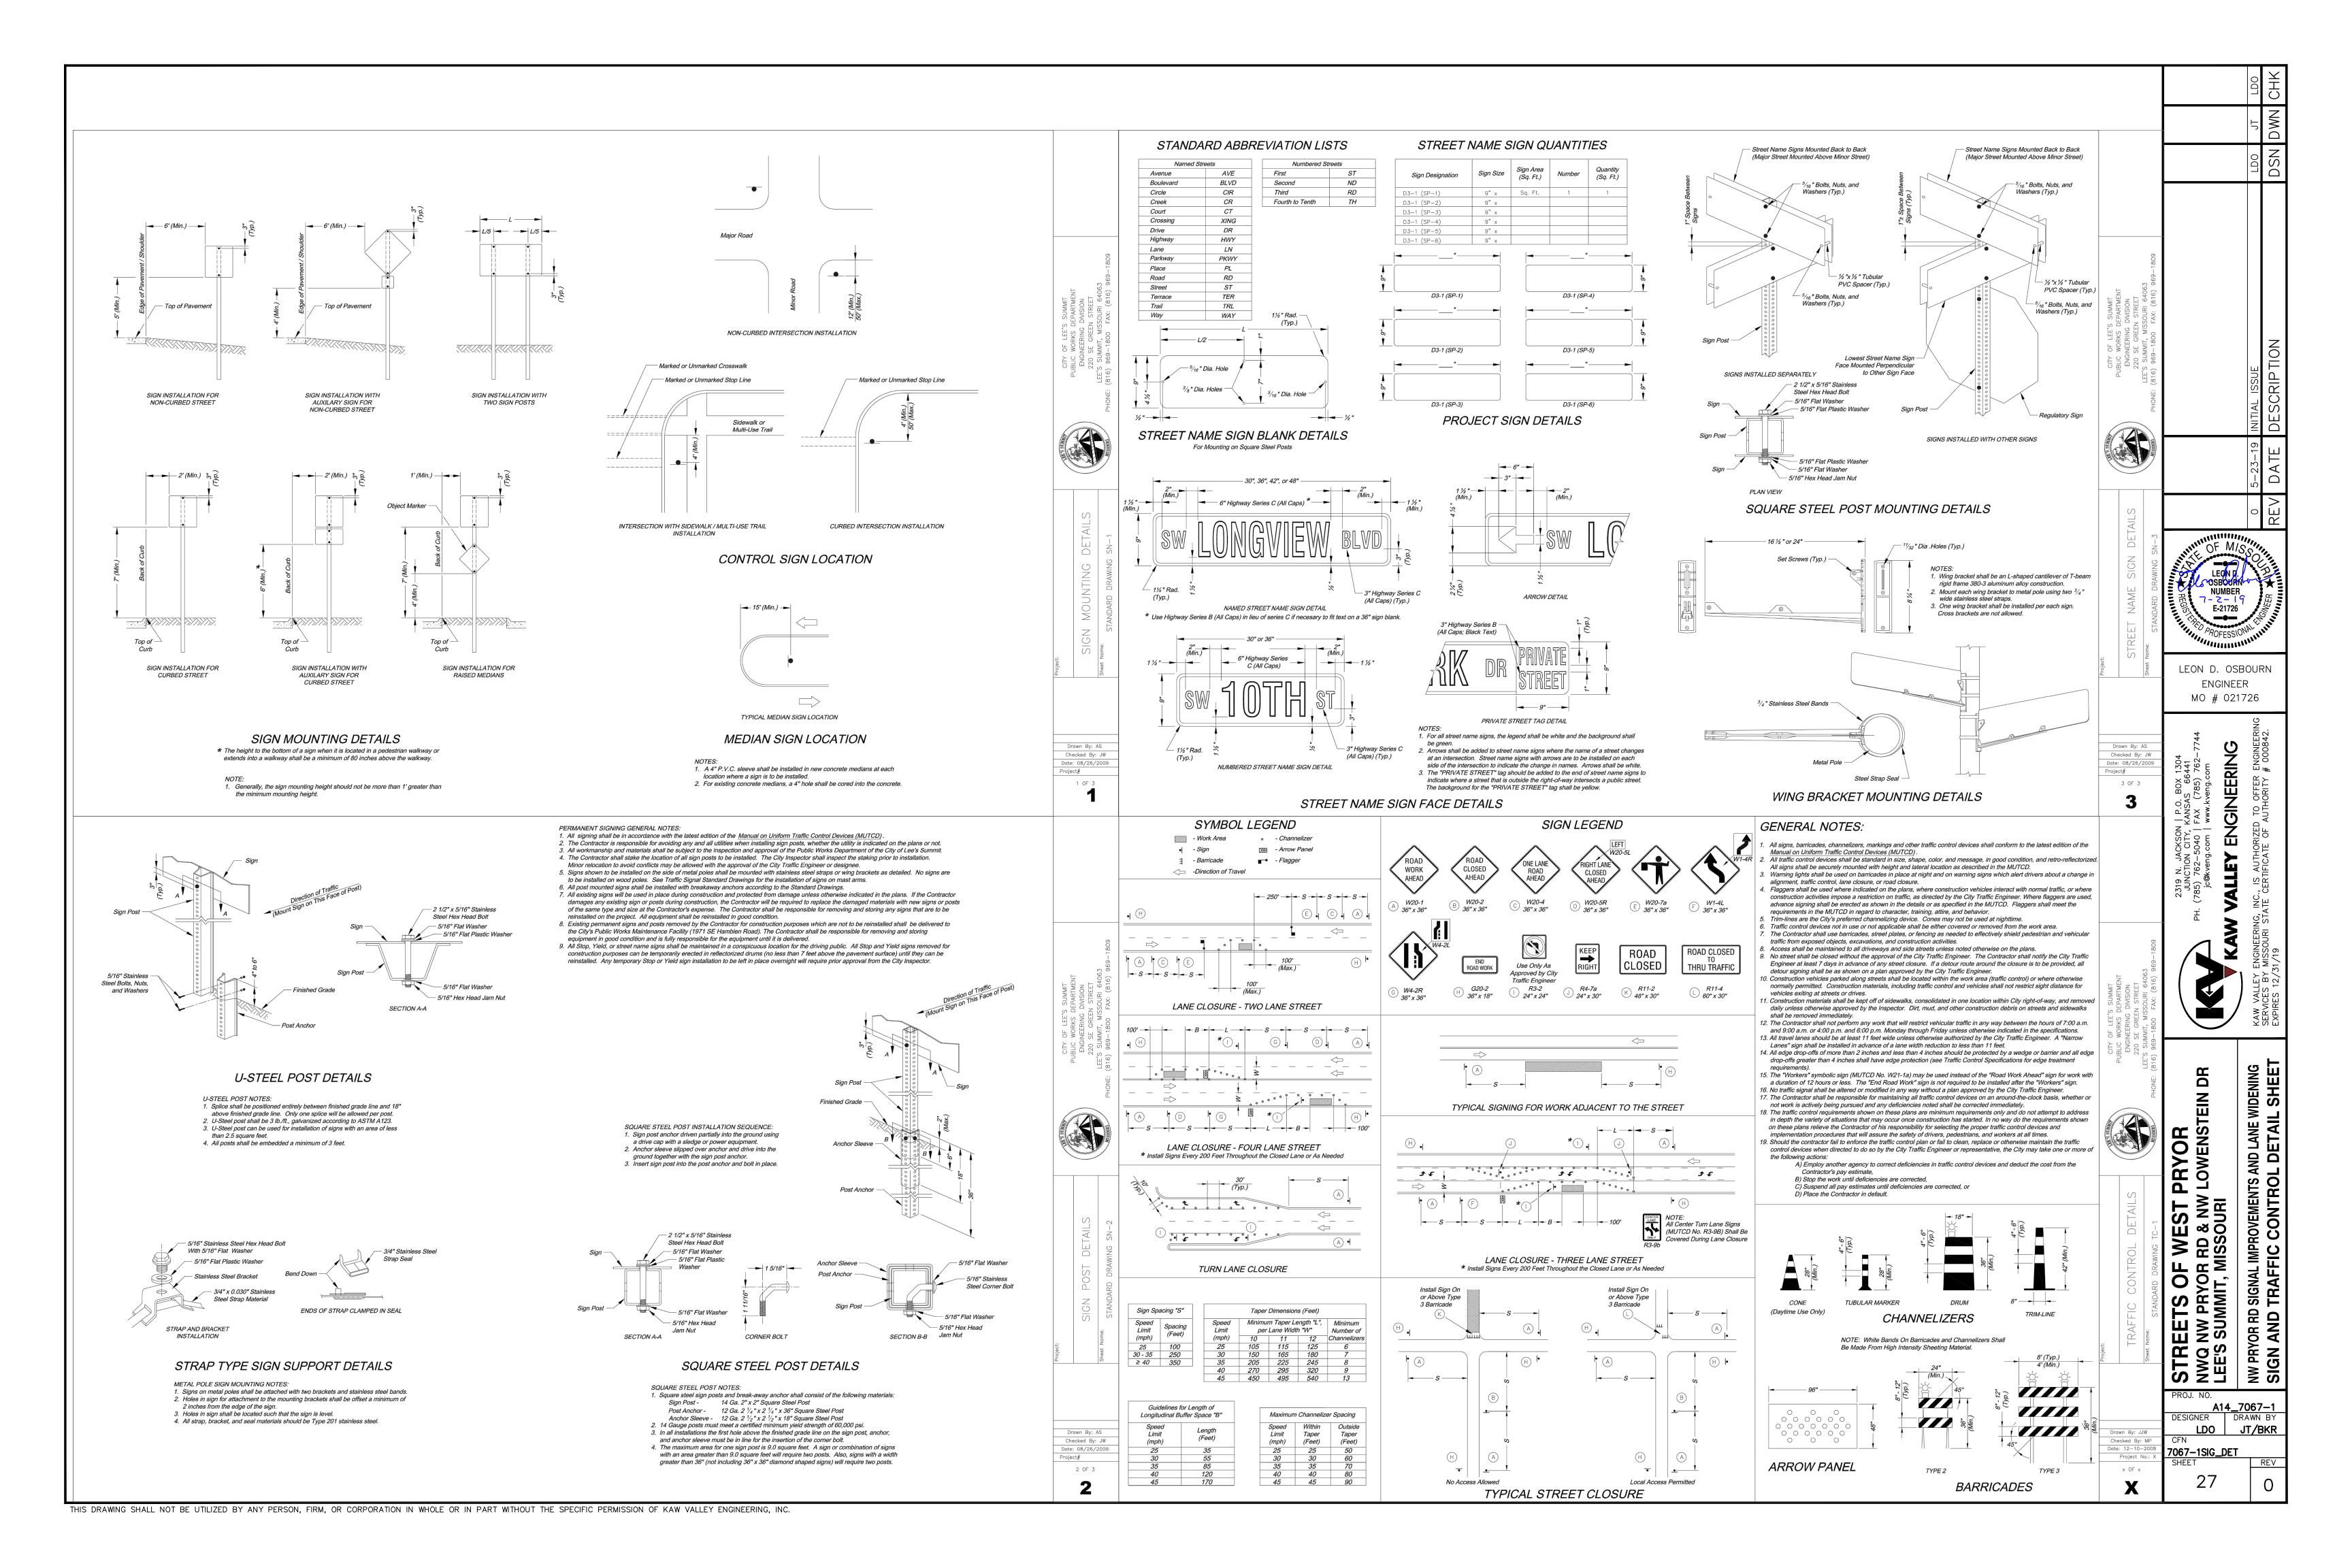

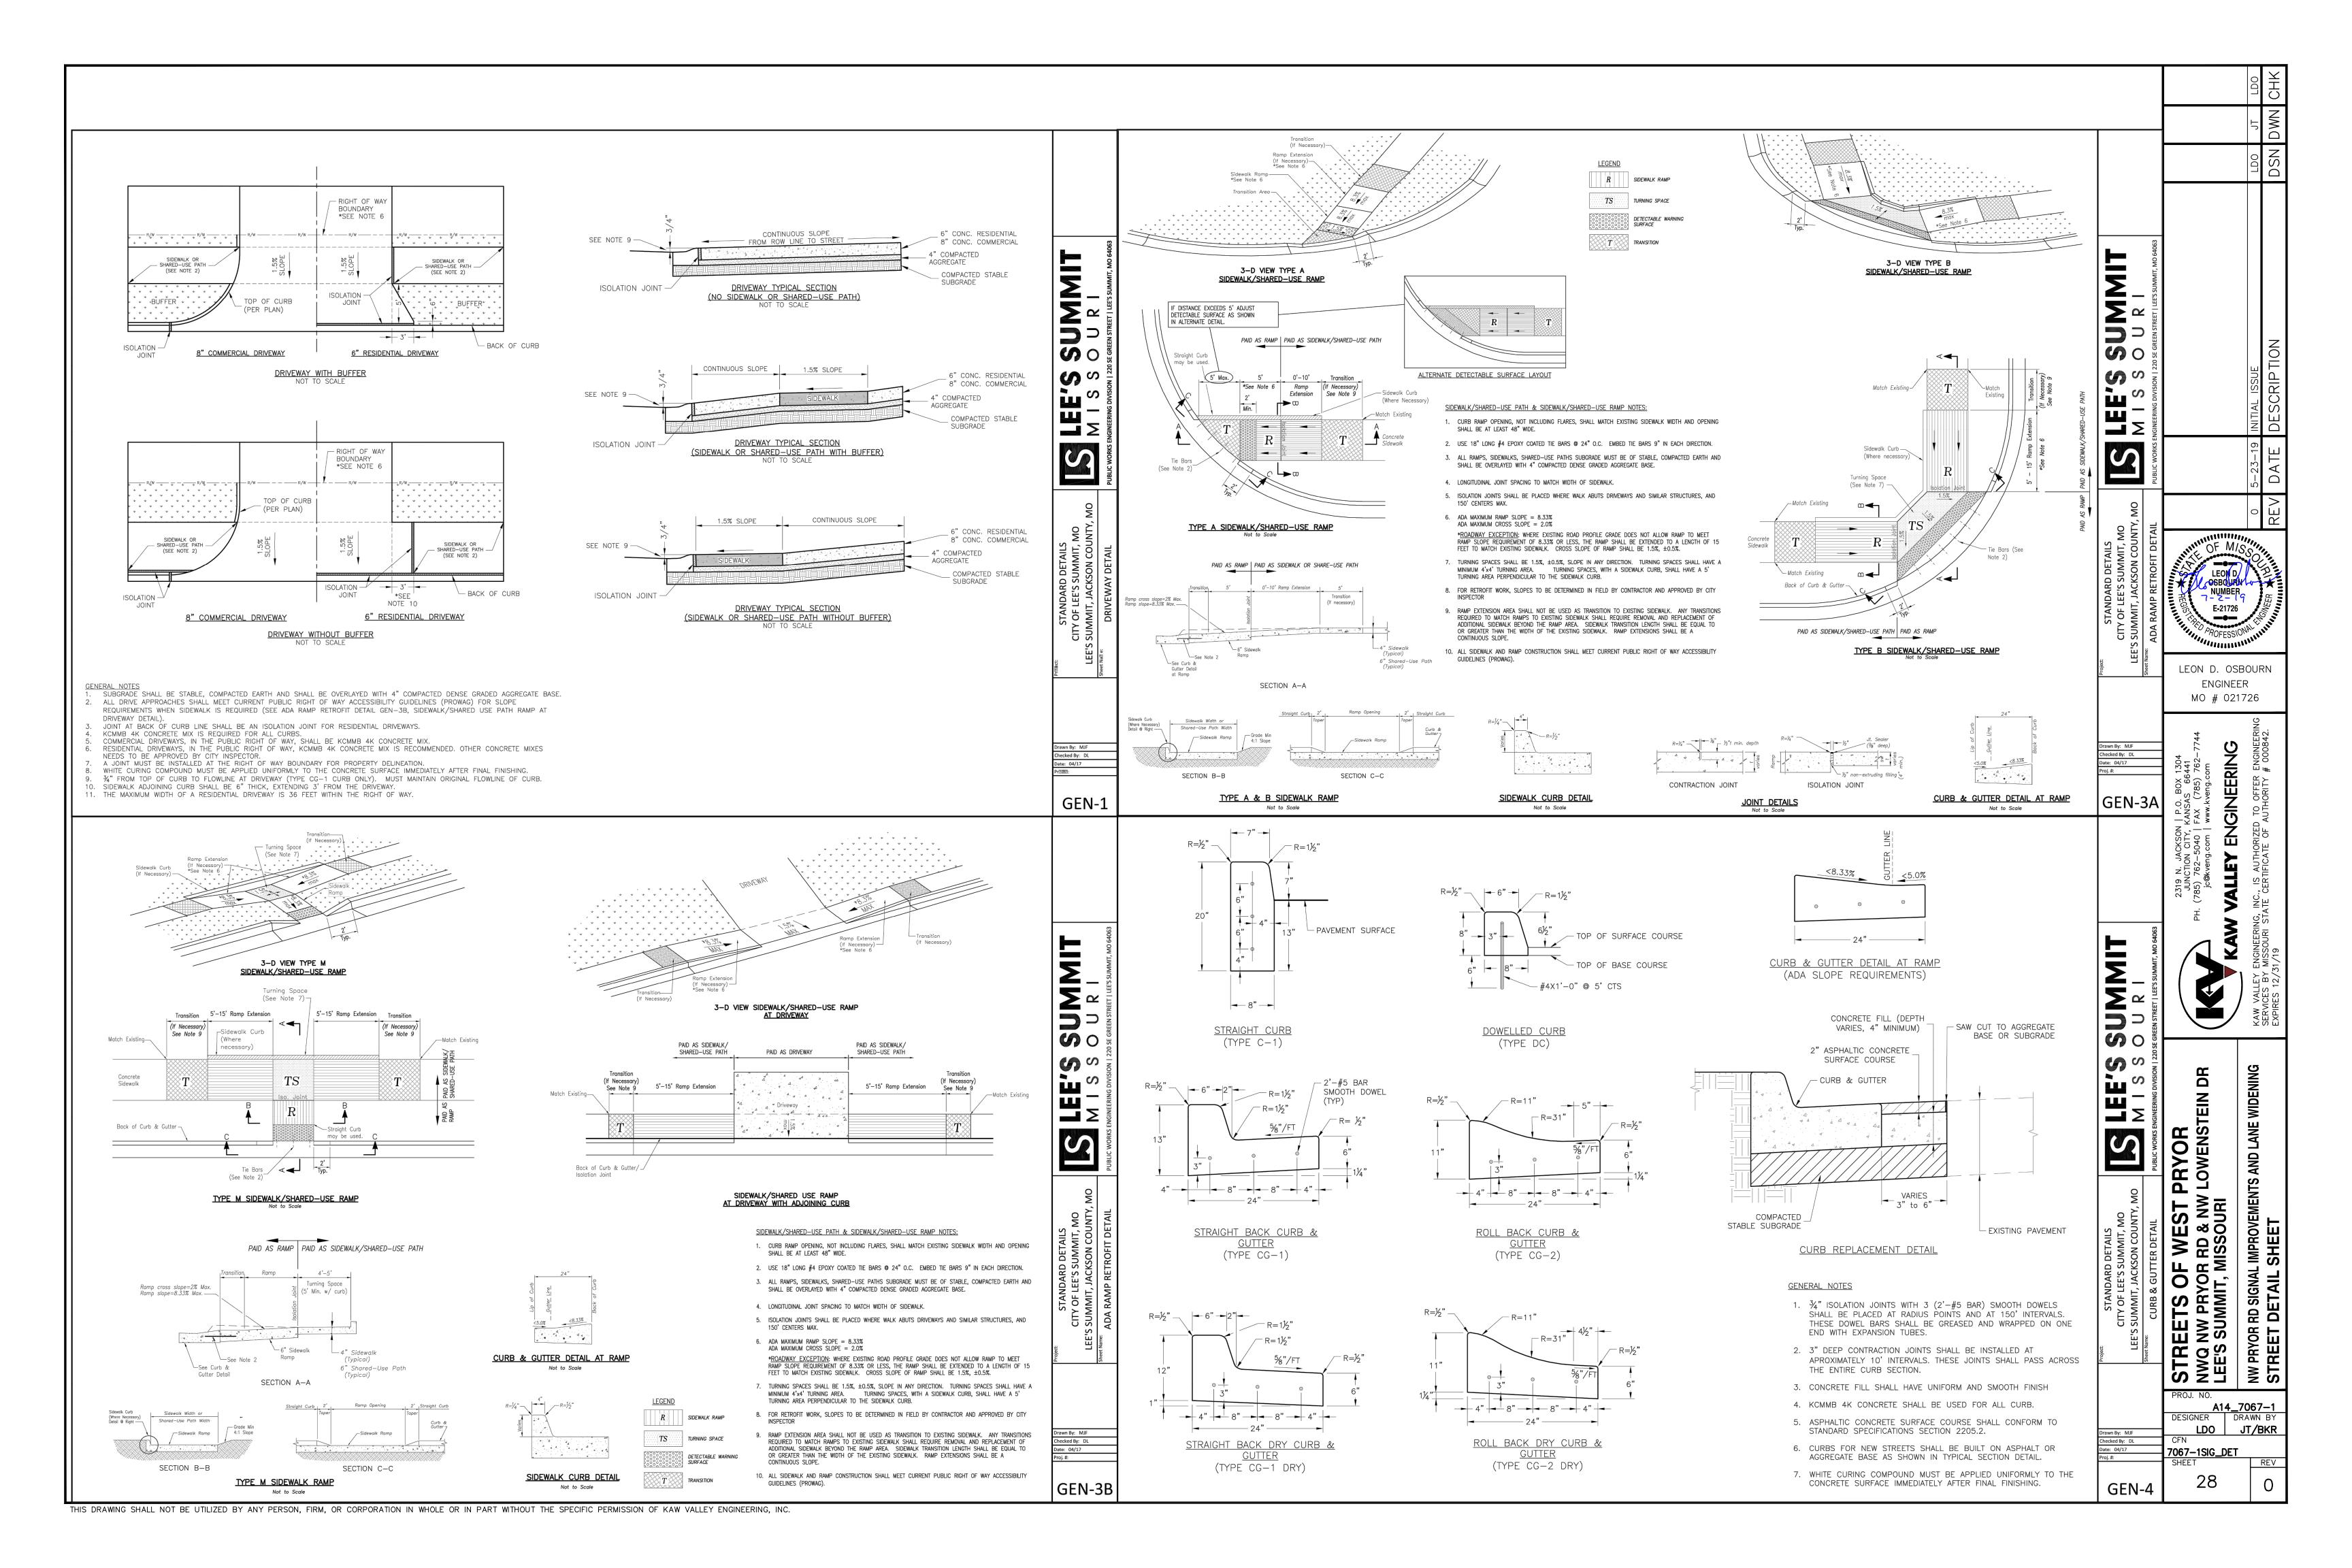

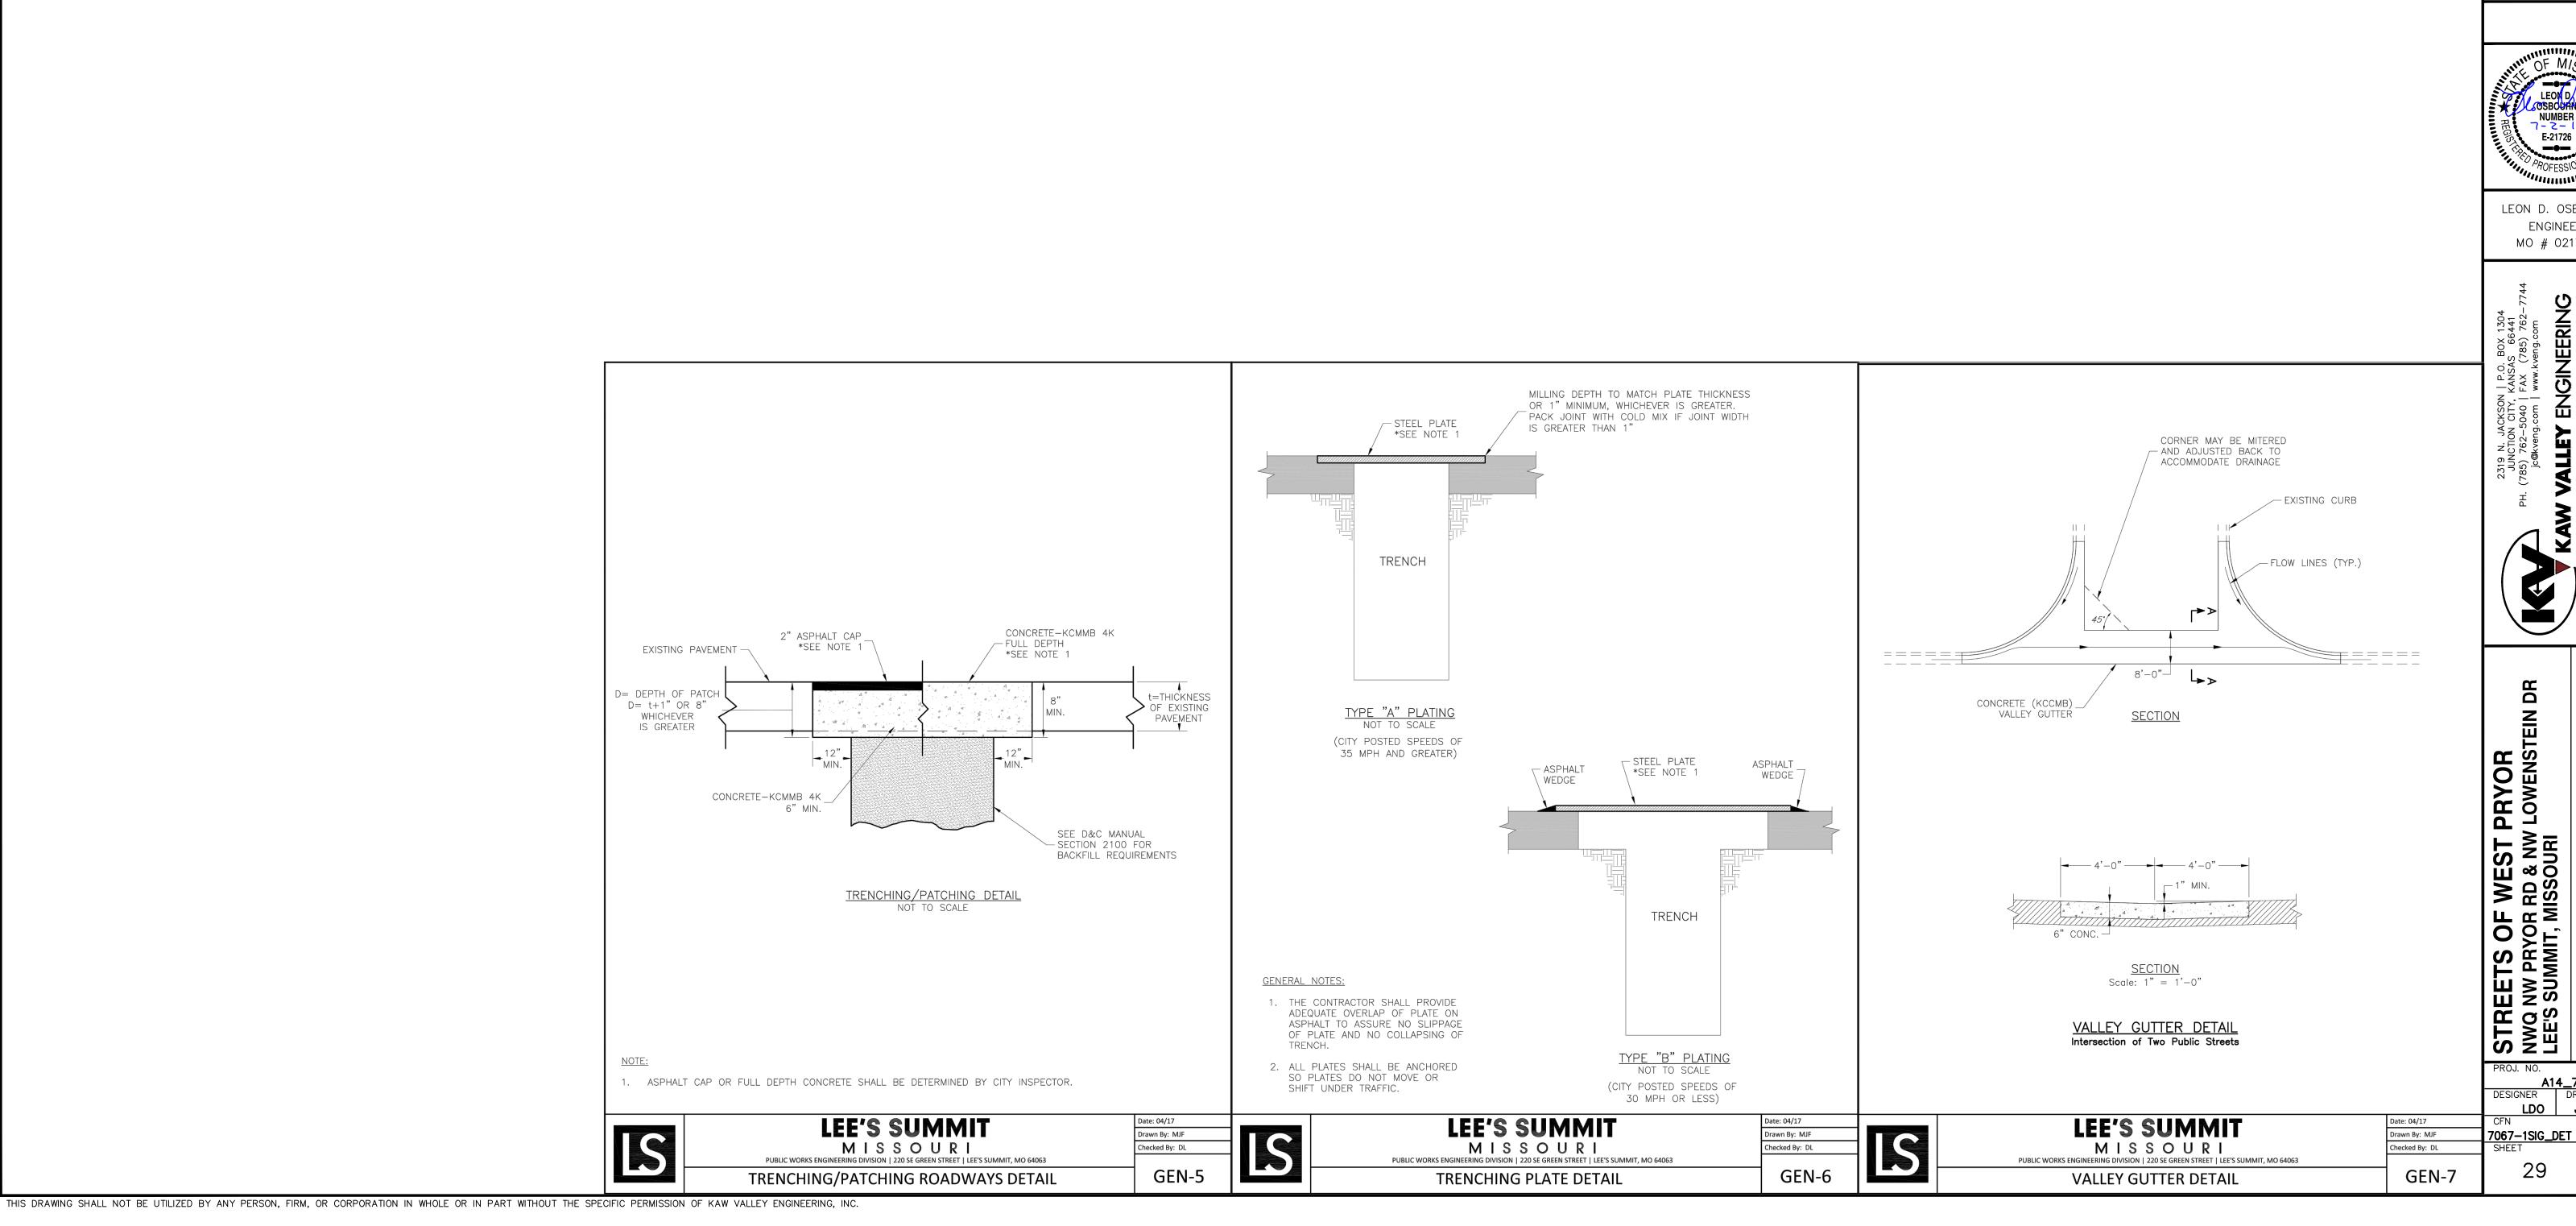

LEON D. OSBOURN **ENGINEER**

MO # 021726

VALLEY ENGINEERING

A14_7067-1

DESIGNER DRAWN BY

LDO JT/BKR

