


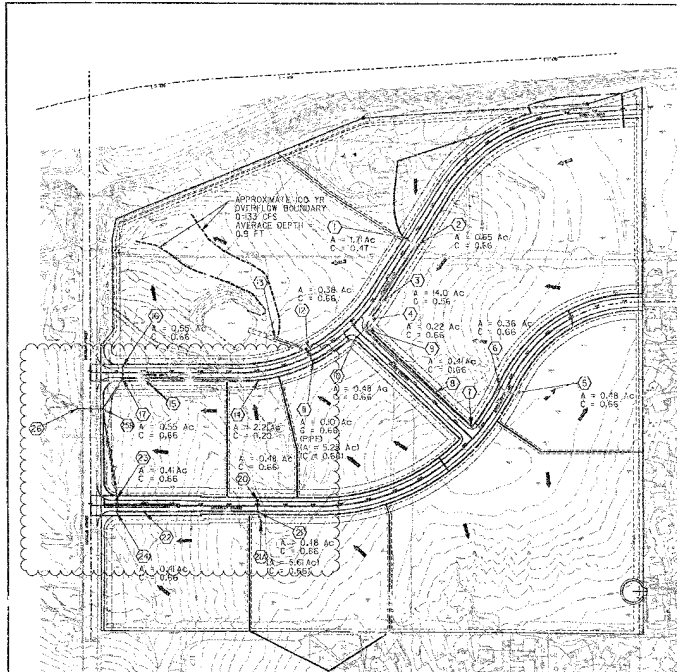

Design Notes:

- 10 year design storm.
- Time of Concentration (Curb Inlets) is minutes max.
- 10 = inlet flow + flow time in pipe
- Pipe lengths measured along G of pipe from inside face to inside face of structures
- Pipe lengths exclude end sections
- Roughness Coefficient = 0.013 RCP
- Station offsets for curb inlets are measured from centerline to the center of the nearest face of structure.
- Station offsets for manholes, drop inlets, field inlets and junction boxes are measured from centerline to center of structure.
- Station offsets for and sections are measured from centerline to farthest edge of and section at pipe centerline.
- Gutter Spread is measured from the back of curb.
- Curb inlets on longitudinal grades steeper than 4.0% shall include gutter deflectors.
- C values are weighted based on 0.2 for turf and 0.85 for pavement. Pipes to receive side drainage from on-site detention basins at the developed peak runoff.
- The system is designed to receive partial discharge from Lot 15 due to the limited development on Lot 15, discharges from Lots 3, 4 and 7 and also from A flows from the remainder of Lot 15, Lots 2, 5, 6, 8 and 9 discharge off-site to existing systems.
- The system from structure 6 to structure 9 is sized for 600 to eliminate the need for flow across Lot 3. All other discharges in excess of system design capacity will be carried by the streets.

1" = 200'

200 0 200 400 Feet

STRUCTURE				DRAINAGE CALCULATION TABLE																								TOTAL RUNOFF				PIPE			
SHEET	STATION OFFSET	STRUCT. NO.	TYPE	DIRECT RUNOFF				INLET CAPACITY												SUMM. Q. WRT.	CVA	TOTAL Q. CFS	PIPE DIA.	PIPE SLOPE %	PIPE LENGTH LF	PIPE CAP. CFS	VELOCITY (FT/SEC)	DEPTH OF FLOW INCHES							
				AREA ACROSS CURB	RUNOFF COEFF. 'C'	INCHES	FEET	CVA	K	I	IN/HR	O	CFS	GUTTER FLOW CAPACITY	GUTTER SLOPE	GUTTER SPREAD FT	GUTTER INLET SIZE INCH	WET P. CAP. CFS	BOX CAP.										BY-PASS DOWNST.	STRUCT. NO.					
MISSOURI	23+50.00, 19.50' Lt.	1	CI	1.1	0.47	5.0	0.80	1.0	7.4	5.92	0	5.92	2.1	10.1	5x3	7.4	5.9	0.02	1	5.00	0.80	7.4	5.92	15	1.0	39.00	6.1	6.0	9.6						
MISSOURI	23+50.00, 19.50' Rt.	2	CI	0.65	0.66	5.0	0.43	1.0	7.4	3.77	0	3.77	2.1	9.6	5x3	7.4	5.9	0	2	5.14	1.23	7.4	9.10	15	2.1	246.75	5.5	8.5	11.0						
MISSOURI	24+00.00, 19.50' Rt.	3	MH	14.0	0.56	5.0	7.84	1.0	7.4	---	---	---	---	---	---	---	---	---	---	5.63	9.07	7.4	64.40	30	2.5	61.46	69.0	15.0	24.0						
MISSOURI	20+35.00, 19.50' Rt.	4	CI	0.22	0.66	5.0	0.25	1.0	7.4	1.07	0	1.07	2.1	5.3	5x4	7.4	5.9	0	4	5.73	9.22	7.0	64.54	30	2.5	3.41	65.0	15.0	24.0						
		9	SEE DATA BELOW																																
MULBERRY	26+46.57, 19.50' Rt.	5	SI	0.48	0.66	5.0	0.32	1.0	10.0	3.17	0	3.17	SUMP	10.1	5x3	8.6	6.8	0	5	5.0	0.32	10.0	3.20	15	0.5	39.0	4.5	4.1	8.4						
MULBERRY	26+46.57, 19.50' Lt.	6	SI	0.36	0.66	5.0	0.24	1.0	10.0	2.38	0	2.38	SUMP	2.9	5x3	8.6	6.8	0	6	5.3	0.55	10.0	5.60	15	0.8	170.47	5.8	5.4	12.0						
MULBERRY	21+65.63, 31.27' Lt.	7	MH	---	---	---	---	---	---	---	---	---	---	---	---	---	---	---	---	---	---	---	---	---	---	---	---	---	---	---					
GRAND	13+75.00, 25.00' Lt.	8	MH	---	---	---	---	---	---	---	---	---	---	---	---	---	---	---	---	---	---	---	---	---	---	---	---	---	---	---					
GRAND	10+39.85, 21.20' Lt.	9	SI	0.41	0.66	5.0	0.27	1.0	7.4	2.00	0	2.00	SUMP	10.1	5x3	8.6	6.8	0	9	---	---	---	---	---	---	---	---	---	---	---					
GRAND	10+39.85, 21.20' Rt.	10	SI	0.48	0.66	5.0	0.32	1.0	7.4	2.34	0	2.34	SUMP	10.6	5x3	8.6	6.8	0	10	6.48	10.05	7.0	70.35	36	1.0	42.40	70.5	15.0	28.8						
MISSOURI	18+00.00, 19.50' Rt.	11	CI	0.10	0.66	5.0	0.07	1.0	7.4	0.32	0	0.32	2.1	4.2	6x4	7.4	5.1	0	11	6.55	10.37	7.0	75.99	36	1.5	116.00	90.0	11.0	26.4						
MISSOURI	18+00.00, 19.50' Lt.	12	CI	0.38	0.66	5.0	0.25	1.0	7.4	1.85	0.02	1.87	2.1	7.7	6x3	7.4	5.9	0	12	6.94	13.84	6.5	95.50	36	0.8	39.00	95.0	11.0	26.4						
MISSOURI	16+05.84, 100.00' Lt.	13	ES	---	---	---	---	---	---	---	---	---	---	---	---	---	---	---	---	6.99	14.09	6.8	95.81	36	0.8	10.00	95.0	11.0	26.4						
MISSOURI	16+00.00, 30.00' Rt.	14	AI	2.21	0.20	5.0	0.44	1.0	7.4	3.26	0	3.26	---	---	4x4	6.0	4.6	0	14	---	---	---	---	---	---	---	---	---	---	---					
MISSOURI	12+00.00, 22.00' Rt.	15	MH	---	---	---	---	---	---	---	---	---	---	---	---	---	---	---	---	---	---	---	---	---	---	---	---	---	---	---					
		17	SEE DATA BELOW																---	---	---	---	---	---	---	---	---	---	---	---					
MISSOURI	14+24.84, 19.50' Lt.	16	SI	0.55	0.66	5.0	0.36	1.0	7.4	2.66	0	2.66	SUMP	11.5	5x3	8.6	6.8	0	16	---	---	---	---	---	---	---	---	---	---	---					
MISSOURI	14+24.84, 19.50' Rt.	17	SI	0.55	0.66	5.0	0.36	1.0	7.4	2.66	0	2.66	SUMP	11.5	5x3	8.6	6.8	0	17	5.0	0.36	7.4	2.66	15	0.5	39.00	9.7	3.2	9.6						
		17	SEE DATA BELOW																---	---	---	---	---	---	---	---	---	---	---	---					
MULBERRY	16+00.00, 19.50' Lt.	20	CI	0.48	0.66	5.0	0.32	1.0	7.4	2.37	0	2.37	3.30	2.9	5x3	6.8	5.4	0	20	5.0	0.32	7.4	2.37	16	0.4	39.00	4.0	1.5	7.9						
MULBERRY	16+00.00, 19.50' Rt.	21	CI	SEE DATA BELOW															---	---	---	---	---	---	---	---	---	---	---	---					
MULBERRY	16+12.00, 35.00' Rt.	21A	AI	5.61	0.56	5.0	3.7	1.0	7.4	27.40	0	27.40	---	---	6x4	6.0	4.6	0	21A	5.0	3.70	7.4	27.40	24	1.5	32.8	27.1	10.02	19.4						
MULBERRY	16+00.00, 19.50' Rt.	21	CI	0.48	0.66	5.0	0.32	1.0	7.4	2.37	0	2.37	3.30	6.7	5x3	6.8	5.4	0	21	5.9	4.34	7.2	3.25	24	5.0	396.00	90.0	17.0	13.2						
MULBERRY	21+00.00, 21.50' Lt.	22	MH	---	---	---	---	---	---	---	---	---	---	---	---	---	---	---	---	---	---	---	---	---	---	---	---	---	---	---	---				
MULBERRY	30+14.98, 21.50' Rt.	24	SI	0.41	0.66	5.0	0.27	1.0	7.4	2.00	0	2.00	SUMP	10.1	6x3	9.6	6.8	0	24	---	---	---	---	---	---	---	---	---	---	---					
MULBERRY	10+14.98, 21.50' Lt.	23	CI	0.41	0.66	5.0	0.27	1.0	7.4	2.00	0	2.00	SUMP	9.1	5x3	8.6	6.8	0	23	5.63	4.61	7.1	32.73	24	2.0	41.00	34.0	11.0	19.2						
MISSOURI	10+46.20, 128.10' Rt.	25R	JB	---	---	---	---	---	---	---	---	---	---	---	---	---	---	---	---	5.70	4.88	7.1	34.65	30	0.7	373.00	35.0	11.0	26.0						
DOUGLAS		26	ES	---	---	---	---	---	---	---	---	---	---	---	---	---	---	---	---	6.59	6.04	7.0	42.28	30	0.4	104.00	43.0	6.0	24.0						

- * Spread is calculated at a point upstream of sump with a longitudinal grade of 0.50% and is calculated on the side of the sump receiving the greatest flow.
- * Sump inlet capacity is calculated at maximum spread
- * 100 year design storm for structures 5 and 6 (d.d.)
- * 10 year design storm for balance of structures (d.d.)
- * All pipes are RCP (10.00) unless noted otherwise
- * Structures 3, 1 and 2 are receiving points for detention basin discharge. Structure 14 receives discharge from the watershed common Area. Structure 1 receives partial flow from Lot 15 because limited grading is provided for this lot.

Keys:

- (31) - existing structures
- (CI) - curb inlet
- (SI) - curb inlet in sump
- (DI) - single drop inlet
- (DSI) - double drop inlet
- (33) - precast concrete end section
- (JB) - junction box
- (I) - yard inlet
- (OI) - orod inlet
- (MI) - manhole
- (R) - red curb
- (FI) - field inlet
- (BEND) - precast concrete vertical bend

AS-BUILT
FEBRUARY 11, 1990

THESE CONSTRUCTION RECORD DRAWINGS HAVE BEEN PREPARED BASED ON INFORMATION PROVIDED BY OTHERS. THE ENGINEER HAS NOT VERIFIED THE ACCURACY AND/OR COMPLETENESS OF THIS INFORMATION AND SHALL NOT BE RESPONSIBLE FOR ANY ERRORS OR OMISSIONS WHICH MAY BE INCORPORATED HEREIN AS A RESULT.

4	MOG	2/9/98	AS BUILT
5	KEW	1/17/91	REVISED STORM SEWER
2	KEW	10/10/96	REVISED STORM SEWER
1	KEW	9/6/96	PER CITY COMMENTS
NO. MADE DATE		REVISION	
ROLLINS MEADOWS			
BUSINESS PARK SUBDIVISION PHASE I			
STORM DRAINAGE CALCULATIONS			
3010 BROWN ST. & CAMBERN CHICAGO, ILL. 60618			
DATE: 9/6/96			

FILE NO. 3035-00



DATE: 9/6/96

18