


DWG: F:\2019\4001-4500\019-4061-BV40-Design\AutoCAD\Asbuilt\Sheets\GNCA\Street & Storm Plans\C_TL01_B194061.dwg
DATE: Oct 11, 2022 3:25pm XREFS: C_PTBK_B194061 USER: ssaylor



- ☐ NOT FOR CONSTRUCTION
- ☐ REVIEWED FOR CONSTRUCTION

PROJECT TEAM & UTILITY CONTACT LIST	
OWNER / DEVELOPER HUNT MIDWEST REAL ESTATE DEVELOPMENT, INC. 8300 NE UNDERGROUND DRIVE KANSAS CITY, MO 64161 CONTACT: AARON SCHMIDT PHONE: 816.455.2500	UTILITY SERVICE NUMBERS NAME: LEE'S SUMMIT PUBLIC WORKS PHONE: 816-969-1800 NAME: LEE'S SUMMIT WATER & SERVICES DEPARTMENT PHONE: 816-969-1940 NAME: SPIRE (MGE) PHONE: 314-342-0500 NAME: AT&T PHONE: 800-286-8313 NAME: EVERGY PHONE: 816-471-5275 NAME: SPECTRUM (TWC) PHONE: 877-772-2253 NAME: GOOGLE FIBER PHONE: 877-454-6959
ENGINEER OLSSON 1301 BURLINGTON, SUITE 100 NORTH KANSAS CITY, MO 64116 CONTACT: JULIE E. SELLERS, P.E. PHONE: 816.361.1177 EMAIL: JSSELLERS@OLSSON.COM	
SURVEYOR OLSSON 1301 BURLINGTON, SUITE 100 NORTH KANSAS CITY, MO 64116 CONTACT: JASON ROUDEBUSH, P.L.S. PHONE: 816.361.1177 EMAIL: JROUDEBOUSH@OLSSON.COM	

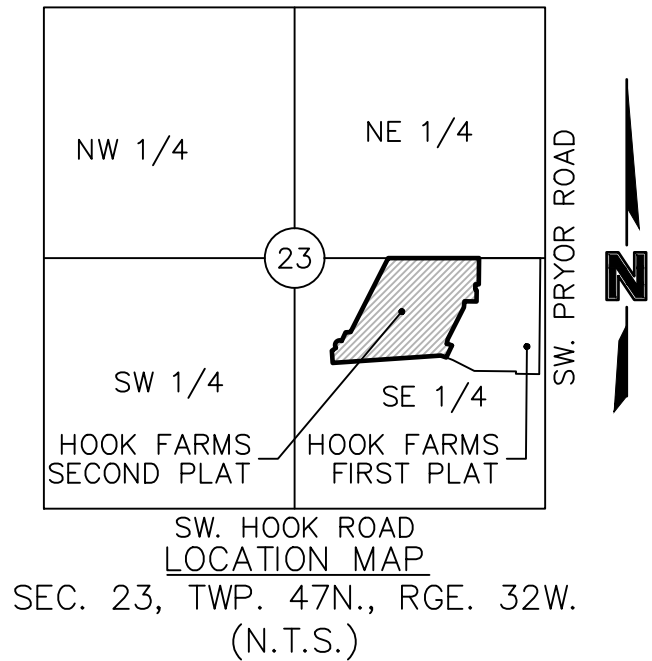


PROPERTY DESCRIPTION

A TRACT OF LAND IN THE SOUTHEAST QUARTER OF SECTION 23, TOWNSHIP 47 NORTH, RANGE 32 WEST OF THE 5TH PRINCIPAL MERIDIAN IN LEE'S SUMMIT, JACKSON COUNTY, MISSOURI BEING BOUNDED AND DESCRIBED BY OR UNDER THE DIRECT SUPERVISION OF JASON S. ROUDEBUSH, P.L.S. 2002014092 AS FOLLOWS: COMMENCING AT THE SOUTHEAST CORNER OF SAID SOUTHEAST QUARTER; THENCE NORTH 02°45'34" EAST, ON THE EAST LINE OF SAID SOUTHEAST QUARTER, 2,635.08 FEET TO THE NORTHEAST CORNER OF SAID SOUTHEAST QUARTER; THENCE NORTH 87°45'24" WEST, ON THE NORTH LINE OF SAID SOUTHEAST QUARTER, 50.00 FEET TO THE SOUTHEAST CORNER OF LOT 3, EAGLE CREEK-FIRST PLAT, A SUBDIVISION IN SAID LEE'S SUMMIT RECORDED AS INSTRUMENT NUMBER 110409 IN BOOK 165 AT PAGE 01 IN JACKSON COUNTY RECORDER OF DEEDS OFFICE, ALSO BEING THE NORTHWEST CORNER OF PROPOSED HOOK FARMS FIRST PLAT; THENCE CONTINUING NORTH 87°45'24" WEST ON SAID NORTH LINE, ALSO BEING THE PROPOSED NORTH LINE OF SAID PROPOSED HOOK FARMS FIRST PLAT, ALSO BEING THE SOUTH LINE OF SAID EAGLE CREEK-FIRST PLAT, 643.83 FEET TO THE POINT OF BEGINNING OF THE TRACT OF LAND TO BE HEREIN DESCRIBED; THENCE LEAVING SAID NORTH AND SOUTH LINES, SOUTH 02°59'10" WEST, ALONG THE PROPOSED WESTERLY LINE OF PROPOSED HOOK FARMS FIRST PLAT, 277.38 FEET; THENCE NORTH 87°00'50" WEST, ALONG SAID PROPOSED WESTERLY LINE, 36.00 FEET; THENCE SOUTH 02°59'10" WEST, ALONG SAID PROPOSED WESTERLY LINE, 50.00 FEET; THENCE SOUTH 42°00'50" EAST, ALONG SAID PROPOSED WESTERLY LINE, 19.80 FEET; THENCE SOUTH 02°59'10" WEST, ALONG SAID PROPOSED WESTERLY LINE, 116.00 FEET; THENCE NORTH 87°00'50" WEST, ALONG SAID PROPOSED WESTERLY LINE, 126.12 FEET; THENCE SOUTH 07°19'52" WEST, ALONG SAID PROPOSED WESTERLY LINE, 64.17 FEET; THENCE SOUTH 29°10'47" WEST, ALONG SAID PROPOSED WESTERLY LINE, 375.17 FEET; THENCE SOUTH 15°20'56" WEST, ALONG SAID PROPOSED WESTERLY LINE, 50.00 FEET; THENCE ALONG SAID PROPOSED WESTERLY LINE, EASTERLY ALONG A CURVE TO THE RIGHT HAVING AN INITIAL TANGENT BEARING OF SOUTH 74°39'04" EAST WITH A RADIUS OF 275.00 FEET, A CENTRAL ANGLE OF 11°57'16" AND AN ARC DISTANCE OF 57.38 FEET; THENCE SOUTH 27°18'12" WEST, ALONG SAID PROPOSED WESTERLY LINE, 138.17 FEET; THENCE LEAVING SAID PROPOSED WESTERLY LINE, NORTH 67°11'53" WEST, 61.05 FEET; THENCE SOUTH 88°21'16" WEST, 1,139.83 FEET; THENCE NORTH 01°38'44" WEST, 128.09 FEET; THENCE NORTH 57°02'58" EAST, 49.90 FEET; THENCE NORTHEASTERLY ALONG A CURVE TO THE RIGHT HAVING AN INITIAL TANGENT BEARING OF NORTH 32°57'02" WEST WITH A RADIUS OF 50.00 FEET, A CENTRAL ANGLE OF 150°22'53" AND AN ARC DISTANCE OF 131.23 FEET; THENCE NORTH 27°25'51" EAST, 98.75 FEET; THENCE NORTH 88°21'16" EAST, 52.12 FEET; THENCE NORTH 29°10'47" EAST, 873.51 FEET TO A POINT ON SAID NORTH LINE OF SAID SOUTHEAST QUARTER, ALSO BEING THE SOUTH LINE OF EAGLE CREEK-SECOND PLAT, A SUBDIVISION IN SAID LEE'S SUMMIT RECORDED AS INSTRUMENT NUMBER 200100058889 IN BOOK 165 AT PAGE 09 IN SAID JACKSON COUNTY RECORDER OF DEEDS OFFICE; THENCE SOUTH 87°45'24" EAST, ON SAID NORTH LINE AND SAID SOUTH LINE, 682.19 FEET TO THE SOUTHEAST CORNER OF SAID EAGLE CREEK-SECOND PLAT, ALSO BEING THE SOUTHWEST CORNER OF SAID EAGLE CREEK-FIRST PLAT; THENCE SOUTH 87°45'24" EAST ON SAID NORTH LINE, AND SAID SOUTH LINE OF EAGLE CREEK-FIRST PLAT, 273.64 FEET TO THE POINT OF BEGINNING. CONTAINING 1,157,274 SQUARE FEET OR 26.57 ACRES, MORE OR LESS.

BENCHMARK

JA-74
ELEVATION: 1058.10
N: 978461-2779
E: 2809447-9650
DESCRIPTION: KC METRO ALUMINUM GRS DISK SET IN CONCRETE. THE STATION IS STAMPED JA-74, 1988, AND PROJECTS ABOUT 1 INCH

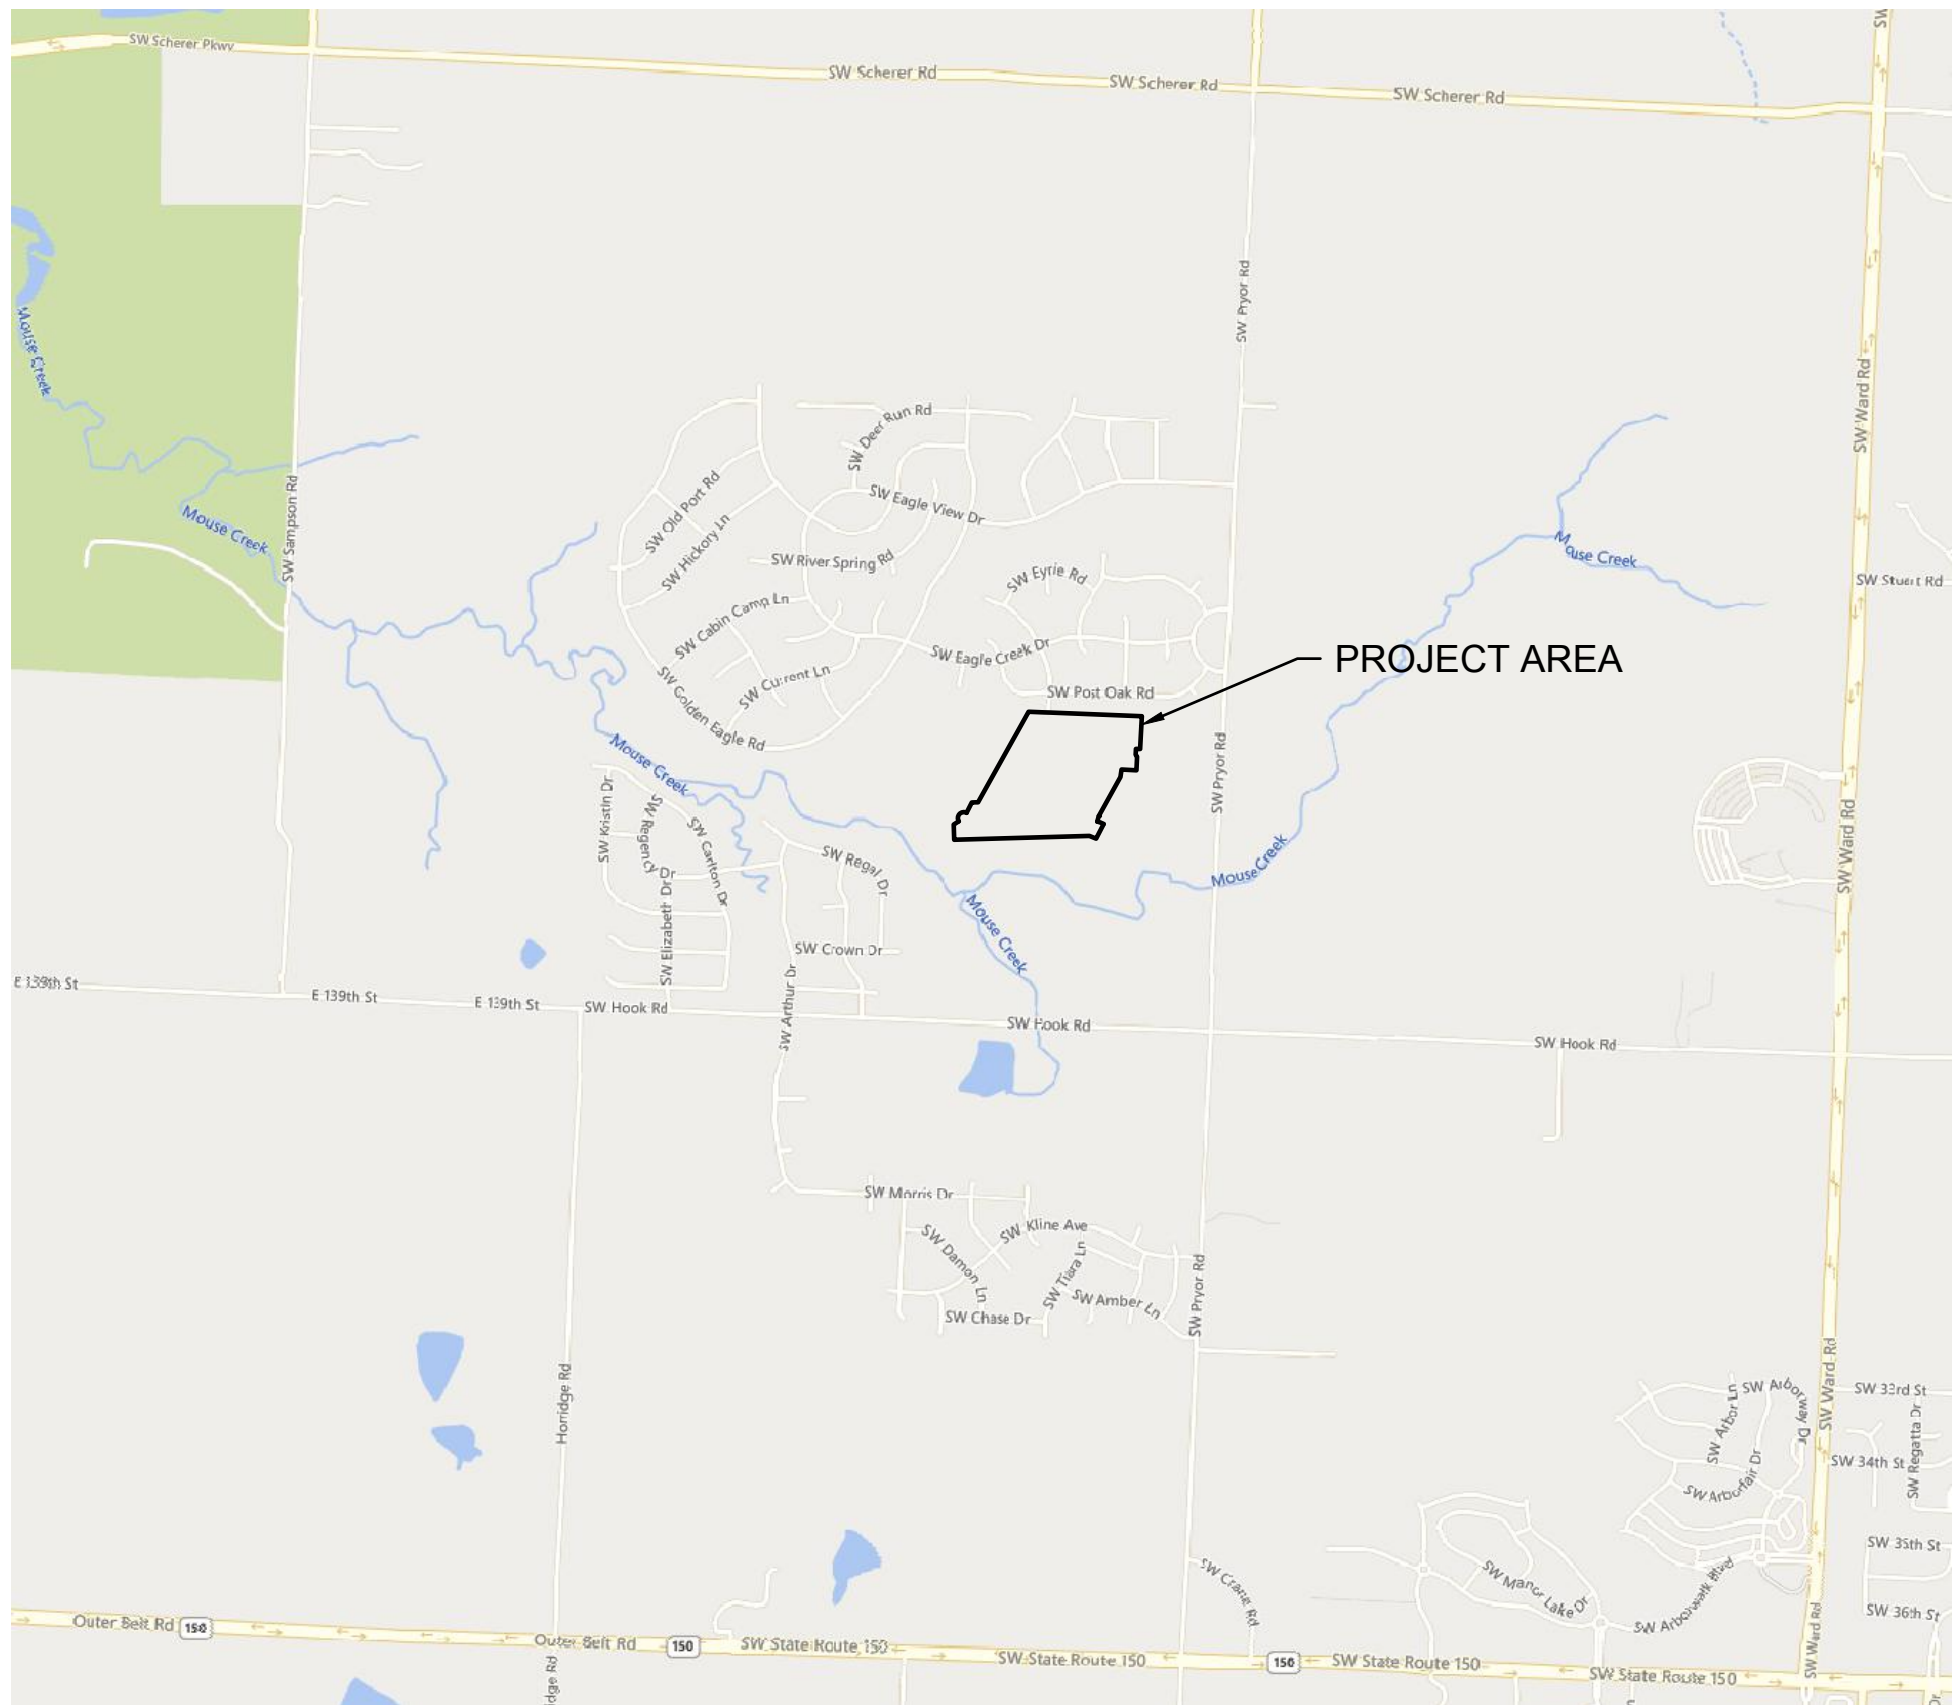

HOOK FARMS SECOND PLAT STREET & STORM SEWER PLANS

SECTION 23, TOWNSHIP 47 N, RANGE 32 W
IN LEE'S SUMMIT, JACKSON COUNTY, MO

Digitally signed by
Gene Williams
DN: CN=Gene
Williams,
OU=Development,
OU=LS Users,
DC=COLS,
DC=LOC
Reason: I have
reviewed this
document
Date: 2022.12.14
07:51:28-0600'

Accepted
Record Drawings

These plans have been reviewed for
accuracy and are accepted for basic
conformance to the approved
construction drawings.

SHEET LIST	
NUMBER	TITLE
C101	TITLE SHEET
C102	GENERAL NOTES
C103	GENERAL LAYOUT
C104	TYPICAL SECTIONS
C105	GRADING PLAN (FOR REFERENCE)
C106	GRADING PLAN (FOR REFERENCE)
C107	SWALE 1 PLAN & PROFILE
C108	SWALE 2 PLAN & PROFILE
C109	SWALE 2 PLAN & PROFILE
C110	ROADWAY PLAN & PROFILE (SW HOOK FARM DRIVE)
C111	ROADWAY PLAN & PROFILE (SW HOOK FARM DRIVE)
C112	ROADWAY PLAN & PROFILE (SW HOOK FARM DRIVE)
C113	ROADWAY PLAN & PROFILE (SW WHEATFIELD COURT)
C114	ROADWAY PLAN & PROFILE (SW WHEATFIELD COURT)
C115	ROADWAY PLAN & PROFILE (SW TRACKER LANE)
C116	ROADWAY PLAN & PROFILE (SW TRACKER LANE)
C117	ROADWAY PLAN & PROFILE (SW TRACKER LANE)
C118	ROADWAY PLAN & PROFILE (SW FARMHOUSE ROAD)
C119	ROADWAY PLAN & PROFILE (SW FIREFLY LANE)
C120	ROADWAY PLAN & PROFILE (SW FIREFLY LANE)
C121	ROADWAY PLAN & PROFILE (SW BARLEY FIELD DRIVE)
C122	ROADWAY PLAN & PROFILE (SW BARLEY FIELD DRIVE)
C123	TRAFFIC CONTROL PLAN
C124	SW TRACKER LANE & SW HOOK FARM DRIVE
C125	SW FIREFLY LANE & SW HOOK FARM DRIVE
C126	SW BARLEY FIELD DRIVE & SW HOOK FARM DRIVE
C127	SW FARMHOUSE ROAD & SW TRACKER LANE
C128	SW WHEATFIELD COURT & SW TRACKER LANE
C129	SW FIREFLY LANE & SW WHEATFIELD COURT
C130	SW BARLEY FIELD DRIVE & SW WHEATFIELD COURT
C131	SW HOOK FARM DRIVE CUL-DE-SAC
C132	STORM SEWER PLAN & PROFILE (LINE 1)
C133	STORM SEWER PLAN & PROFILE (LINE 1)
C134	STORM SEWER PLAN & PROFILE (LINE 2)
C135	STORM SEWER PLAN & PROFILE (LINE 2)
C136	STORM SEWER PLAN & PROFILE (LINES 3 & 4)
C137	STORM SEWER PLAN & PROFILE (LINES 5 & 7)
C138	STORM SEWER PLAN & PROFILE (LINE 6)
C139	STORM SEWER PLAN & PROFILE (LINE 8)
C140	STORM SEWER PLAN & PROFILE (LINE 9)
C141	STORM SEWER PLAN & PROFILE (LINE 10)
C142	STORM SEWER PLAN & PROFILE (LINES 11 & 12)
C143	WATER QUALITY BASIN PLAN
C144	MASTER DRAINAGE PLAN
C145	DRAINAGE PLAN
C146	DRAINAGE TABLES
C147	DRAINAGE TABLES
C148	DETAIL SHEET
C149	DETAIL SHEET
C150	DETAIL SHEET

OLSSON HAS BEEN RETAINED TO PROVIDE AS-BUILT DRAWINGS FOR THIS PROJECT.

Julie E. Sellers
JULIE E. SELLERS, P.E.
CIVIL ENGINEER
MO # PE-2017000367

12/7/22

DATE

AS BUILT

DATE SURVEYED: 2022-05-26

I HEREBY CERTIFY THAT THE CONDITIONS SHOWN ARE CORRECT
AND THE SEWER ARE ACCEPTABLY LOCATED WITHIN EXISTING
EASEMENTS OR RIGHT OF WAYS.

olsson

Olsson - Civil Engineering
Missouri Certificate of Authority #001592
1301 Burlington Street
North Kansas City MO 64116
TEL 816.361.1177
FAX 816.361.1888
www.olsson.com

STATE OF MISSOURI
JULIE ELAINE SELLERS
NUMBER PE-2017000367
12/7/22
PROFESSIONAL ENGINEER

BY
REV. NO. DATE REVISIONS DESCRIPTION
1 03-23-2021 REVISED PER CITY COMMENTS
2 04-16-2021 REVISED PER CITY COMMENTS
3 09-30-2021 CHANGES TO APPROVED PLANS
2021
LEE'S SUMMIT, MO


TITLE SHEET
STREET & STORM SEWER PLANS
HOOK FARMS
SECOND PLAT

drawn by: B.M.W./A.A.
checked by: B.M.W./A.A.
designed by: J.E.S.
QA/QC by: B19-4061
project no.: 01-08-2021

SHEET
C101

DWG: F:\2019
DATE: Oct 11,

These plans have been reviewed for accuracy and are accepted for basic conformance to the approved construction drawings.

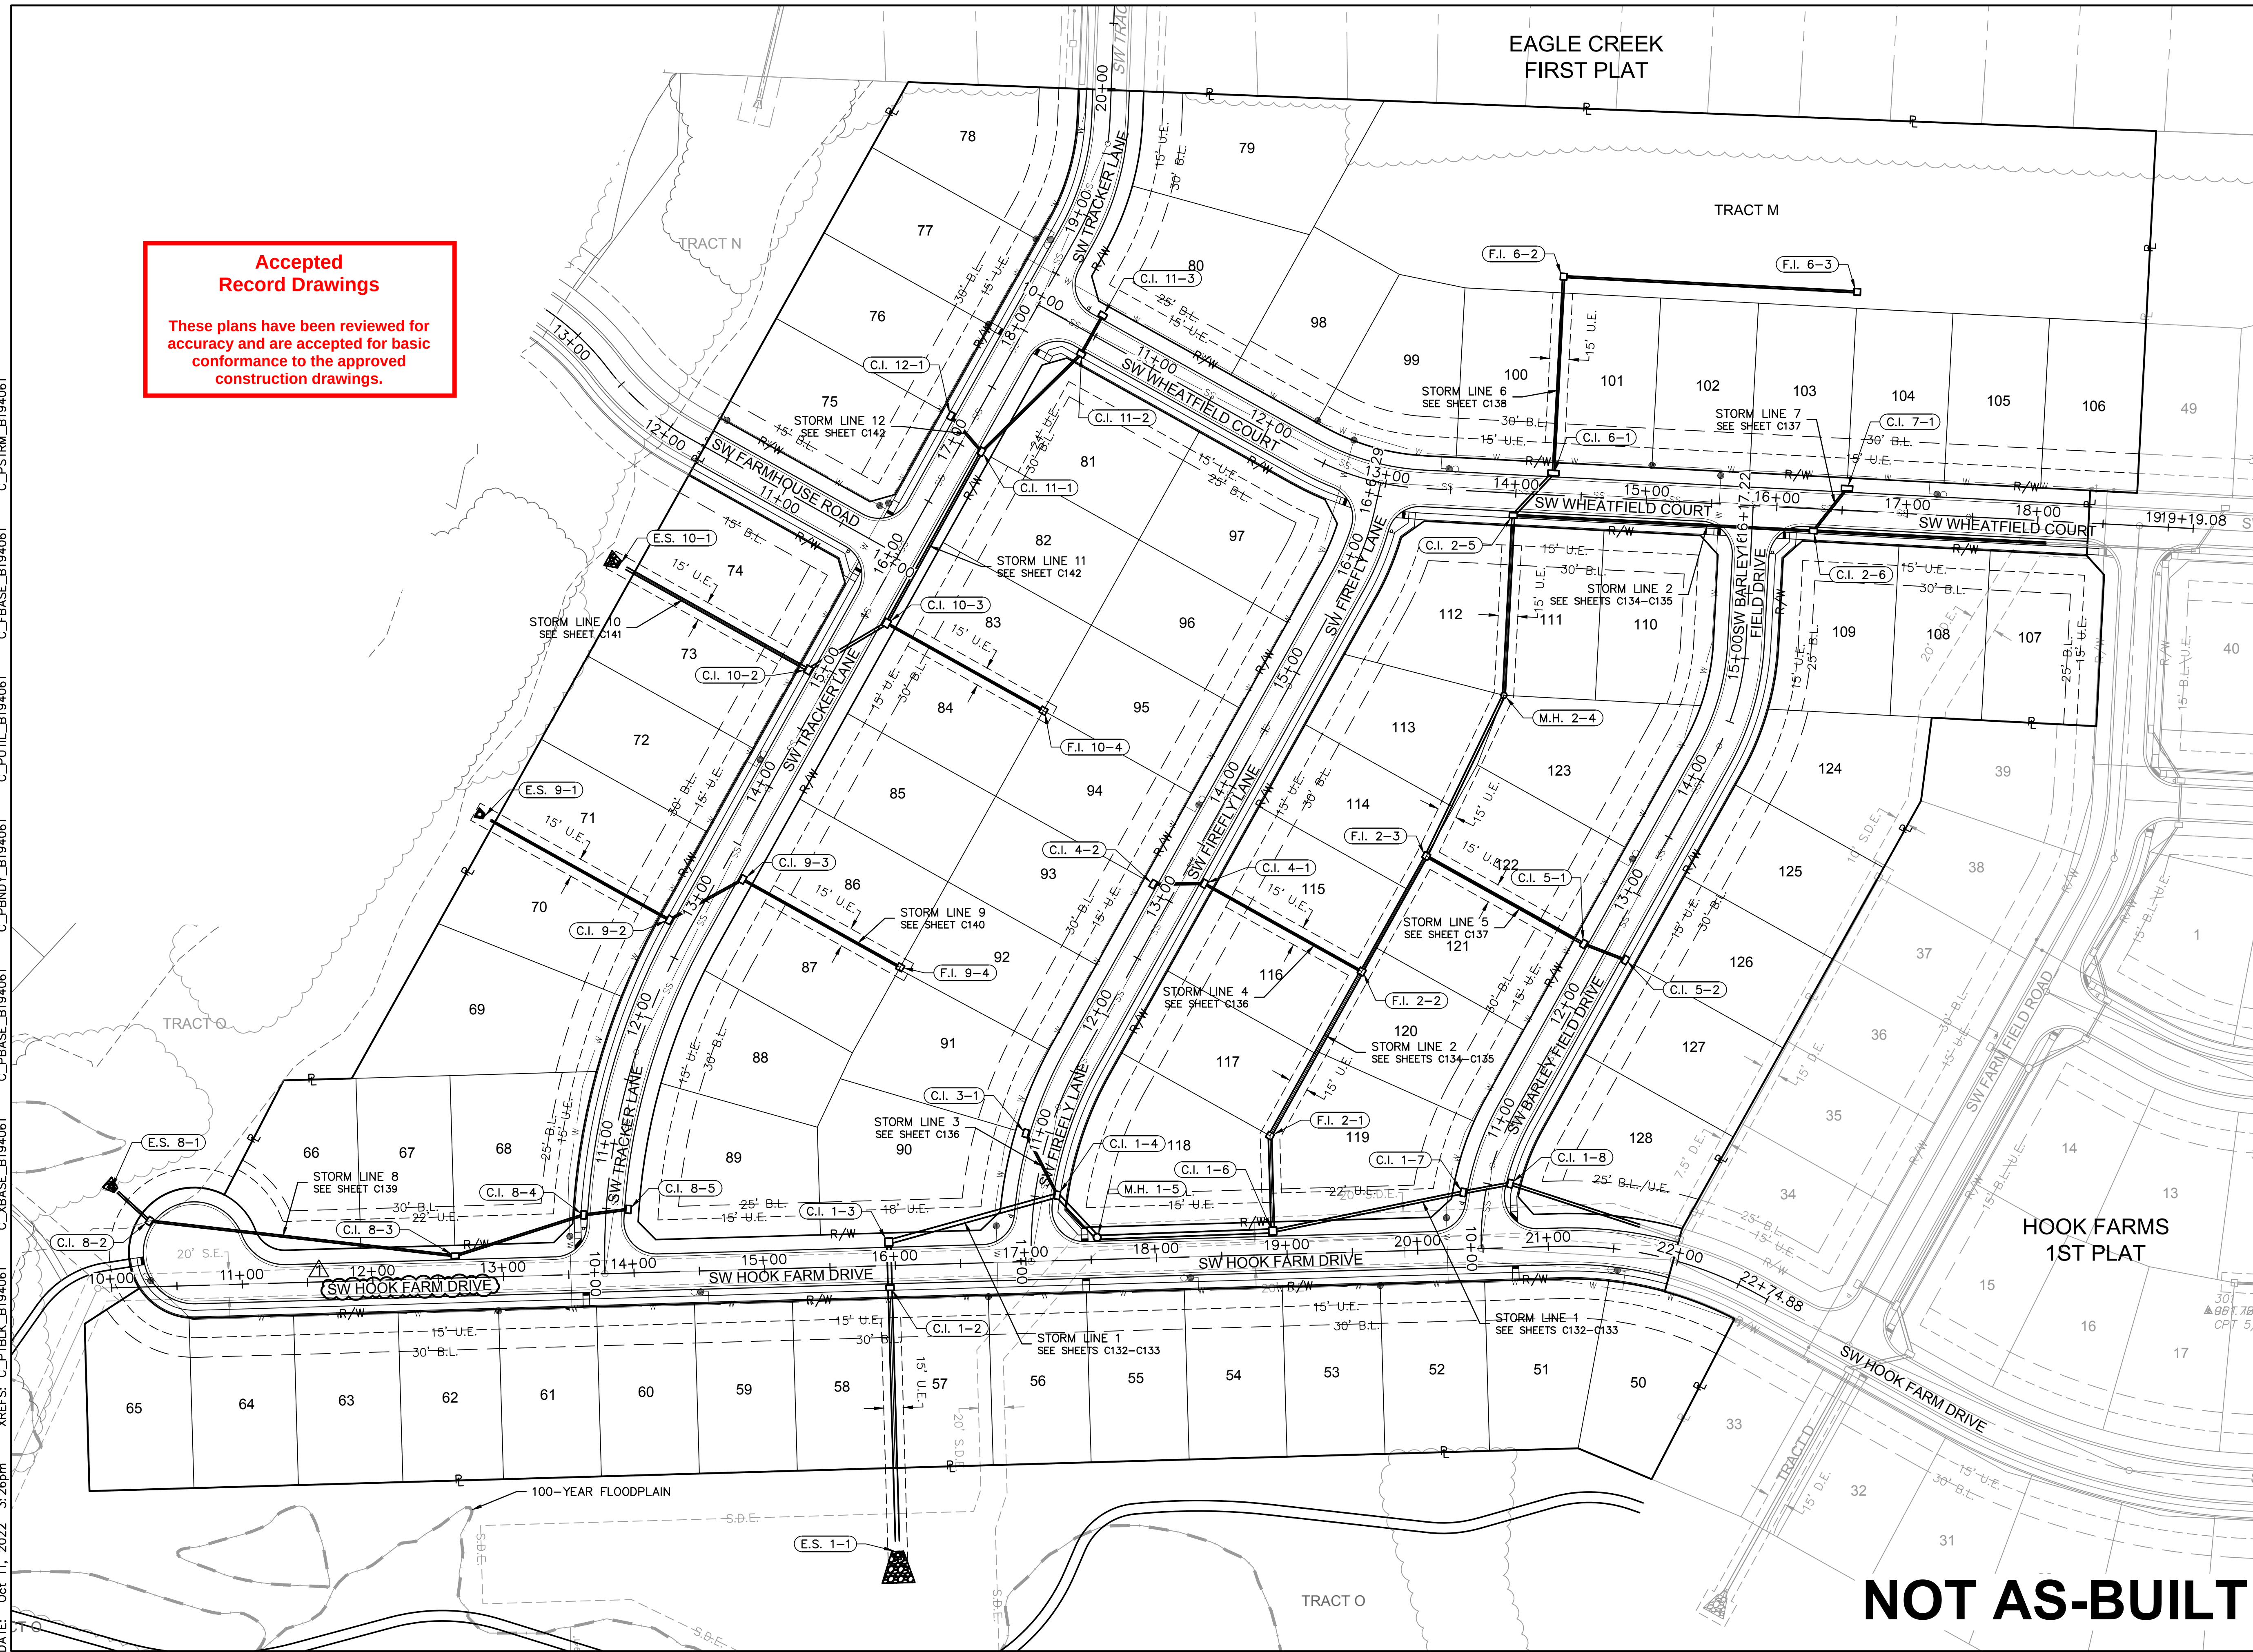

TRACT M


HOOK FARMS
1ST PLAT

NOT AS-BUILT

LEE'S SUMMIT, MO

REVISIONS

www.olsson.com

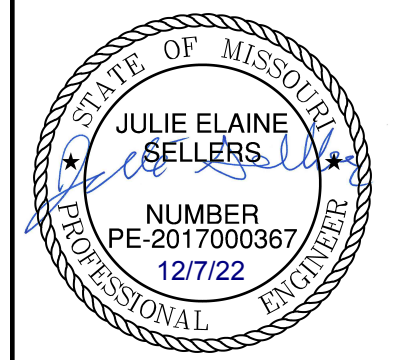



61-B\40-Design\AutoCAD\Asbuilt\Sheets\GNV\Street & Storm Plans\C_TYP01_B194061.dwg
XREFS: C_PTBK_B194061

NOT AS-BUILT

These plans have been reviewed for accuracy and are accepted for basic conformance to the approved construction drawings.

These plans have been reviewed for accuracy and are accepted for basic conformance to the approved construction drawings.

Olsson - Civil Engineering
Missouri Certificate of Authority #001592
1301 Burlington Street
North Kansas City, MO 64116
TEL 816.361.1177
FAX 816.361.1888
www.olsson.com

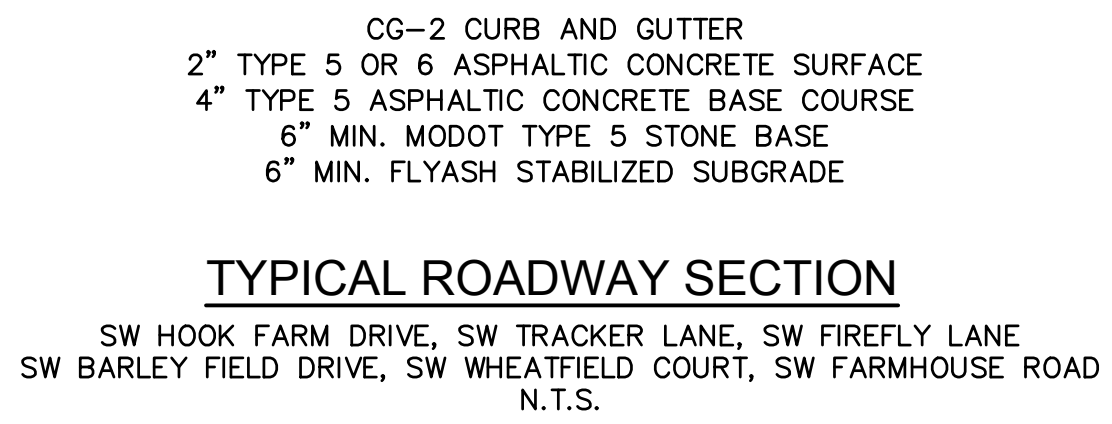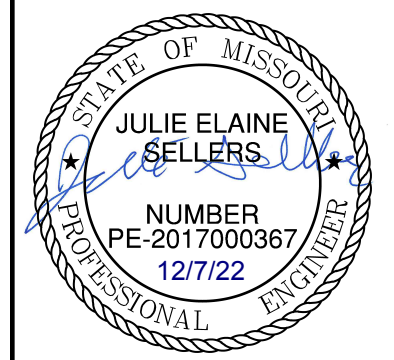


TYPICAL SECTIONS STREET & STORM SEWER PLANS	drawn by: _____	B.M.W./A.A.
	checked by: _____	B.M.W.
	designed by: _____	B.M.W./A.A.
	QA/QC by: _____	J.E.S.
	project no.: _____	B19-4061
HOOK FARMS SECOND PLAT	date: _____	01-08-2021
	2021	
	LEE'S SUMMIT, MO	
	REVISIONS	
	REVISIONS	
SHEET C104		


3. ALL EMBANKMENT OUTSIDE OF RIGHT-OF-WAY SHOULD BE PLACED IN CONTROLLED LIFTS HAVING A MAXIMUM LOOSE LIFT THICKNESS OF 8". EMBANKMENT SHOULD BE COMPACTED TO A MINIMUM OF 95% OF THE MATERIALS MAXIMUM DRY DENSITY AS DETERMINED BY ASTM D-698 (STANDARD PROCTOR COMPACTION). MOISTURE CONTENT OF THE FILL AT THE TIME OF COMPACTION SHALL BE WITHIN A RANGE OF -0 TO +4 PERCENT OF OPTIMUM MOISTURE CONTENT.

EARTHWORK QUANTITIES		
LOCATION	CUT (C.Y.)	FILL (C.Y.)
STREET	26,149	25,993
SITE	117,707	77,137
FUTURE PHASE	0	54,547
TOTAL	143,856	157,677

2. EARTHWORK QUANTITIES DO NOT TAKE INTO CONSIDERATION EXCAVATION, REMOVAL AND DISPOSAL OF MATERIAL DEEMED UNSUITABLE BY A GEOTECHNICAL ENGINEER. THE EARTHWORK CONTRACTOR IS RESPONSIBLE FOR EXCAVATION, REMOVAL AND DISPOSAL OF UNSUITABLE MATERIAL AND FOR REPLACING IT WITH SUITABLE MATERIAL.

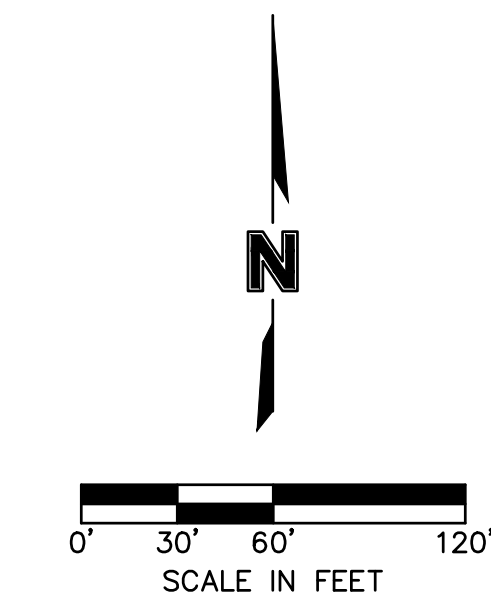

These plans have been reviewed for accuracy and are accepted for basic conformance to the approved construction drawings.

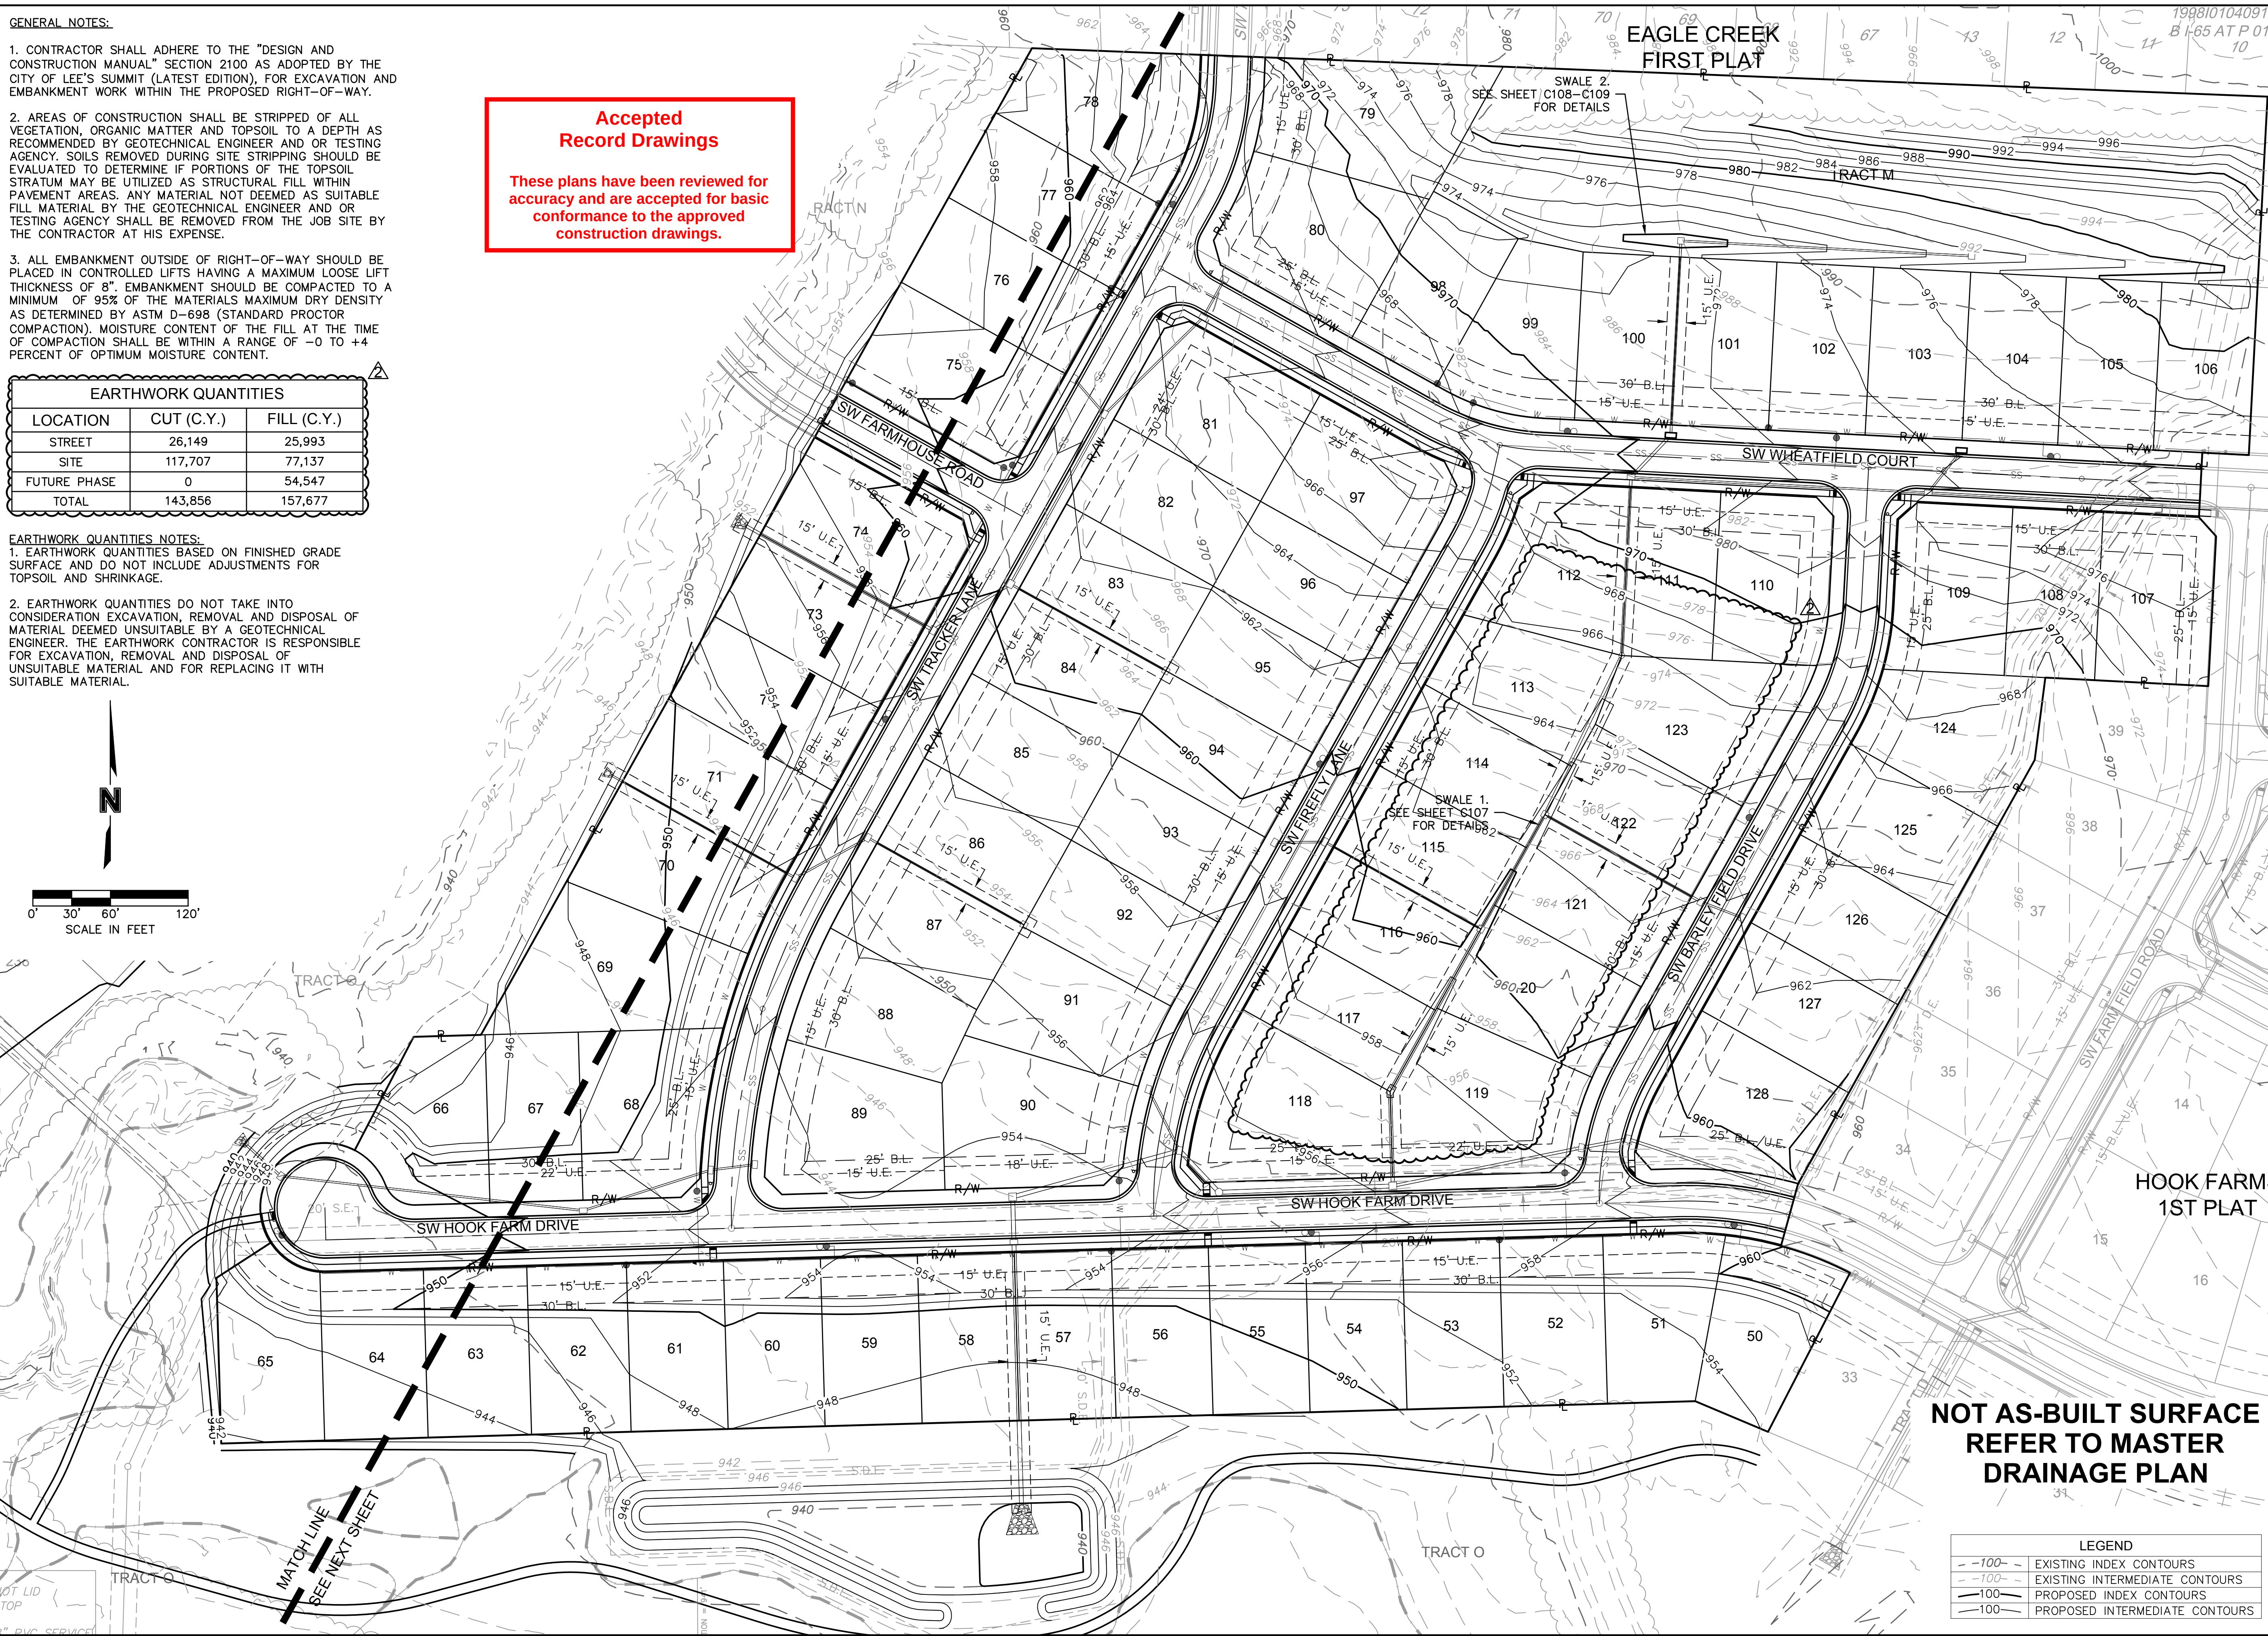[illegible]

GRADING PLAN (FOR REFERENCE) STREET & STORM SEWER PLANS	HOOK FARMS SECOND PLAT	2024
--	---------------------------	------

drawn by: B.M.W./A.
checked by: B.M.W.
designed by: B.M.W./A.
QA/QC by: J.E.S.
project no.: B19-406
date: 01-08-202

SHEET
C105



Olson - Civil Engineering
Missouri Certificate of Authority #001592
1301 Burlington Street
TEL 816.361.1177

1. CONTRACTOR SHALL ADHERE TO THE "DESIGN AND CONSTRUCTION MANUAL" SECTION 2100 AS ADOPTED BY THE CITY OF LEE'S SUMMIT (LATEST EDITION), FOR EXCAVATION AND EMBANKMENT WORK WITHIN THE PROPOSED RIGHT-OF-WAY.

3. ALL EMBANKMENT OUTSIDE OF RIGHT-OF-WAY SHOULD BE PLACED IN CONTROLLED LIFTS HAVING A MAXIMUM LOOSE LIFT THICKNESS OF 8". EMBANKMENT SHOULD BE COMPACTED TO A MINIMUM OF 95% OF THE MATERIALS MAXIMUM DRY DENSITY AS DETERMINED BY ASTM D-698 (STANDARD PROCTOR COMPACTION). MOISTURE CONTENT OF THE FILL AT THE TIME OF COMPACTION SHALL BE WITHIN A RANGE OF -0 TO +4 PERCENT OF OPTIMUM MOISTURE CONTENT.

3. ALL EMBANKMENT OUTSIDE OF RIGHT-OF-WAY SHOULD BE PLACED IN CONTROLLED LIFTS HAVING A MAXIMUM LOOSE LIFT THICKNESS OF 8". EMBANKMENT SHOULD BE COMPACTED TO A MINIMUM OF 95% OF THE MATERIALS MAXIMUM DRY DENSITY AS DETERMINED BY ASTM D-698 (STANDARD PROCTOR COMPACTION). MOISTURE CONTENT OF THE FILL AT THE TIME OF COMPACTION SHALL BE WITHIN A RANGE OF -0 TO +4 PERCENT OF OPTIMUM MOISTURE CONTENT.

EARTHWORK QUANTITIES		
LOCATION	CUT (C.Y.)	FILL (C.Y.)
STREET	26,149	25,993
SITE	117,707	77,137
FUTURE PHASE	0	54,547
TOTAL	143,856	157,677

1. EARTHWORK QUANTITIES BASED ON FINISHED GRADE SURFACE AND DO NOT INCLUDE ADJUSTMENTS FOR TOPSOIL AND SHRINKAGE.

2. EARTHWORK QUANTITIES DO NOT TAKE INTO CONSIDERATION EXCAVATION, REMOVAL AND DISPOSAL OF MATERIAL DEEMED UNSUITABLE BY A GEOTECHNICAL ENGINEER. THE EARTHWORK CONTRACTOR IS RESPONSIBLE FOR EXCAVATION, REMOVAL AND DISPOSAL OF UNSUITABLE MATERIAL AND FOR REPLACING IT WITH SUITABLE MATERIAL.

LOT FILL INFORMATION			
LOT NUMBER	MAX DEPTH OF FILL (OVER 2' PLACED)	FILL PLACED ON EXISTING SLOPES > 5:1	PROPOSED SLOPES > 3:1
50	5.5'		
51	4.8'		
52	4.9'		
53	5.2'		
54	7.5'		
55	8.2'		
56	9.7'	X	
57	8.7'	X	
58	10.7'		
59	11.6'		
60	11.6'		
61	11.4'		
62	11.1'		
63	11.0'		
64	10.8'		
65	10.8'		
66	9.8'		
67	10.0'		
68	11.2'		
69	10.7'		
70	9.1'		
71	8.3'		
72	7.1'		
73	5.9'		
74	5.7'		
75	4.7'		
76	3.5'		
77	2.9'		
78	3.1'		
84	2.5'		
85	3.5'		
86	5.8'		
87	6.8'		
88	8.6'		
89	10.3'		
90	8.2'		
91	6.7'		
92	4.3'		
107	8.1'	X	
108	7.8'	X	
118	7.3'	X	
119	7.5'	X	
120	2.7'		
128	8.4'	X	

Accepted
Record Drawings

These plans have
accuracy and are in
conformance to
construction


X Indicates condition applies to lot

X Indicates condition applies to lot

**Accepted
Record Drawings**

These plans have been reviewed for accuracy and are accepted for basic conformance to the approved construction drawings.

**NOT AS-BUILT SURFACE
REFER TO MASTER
DRAINAGE PLAN**

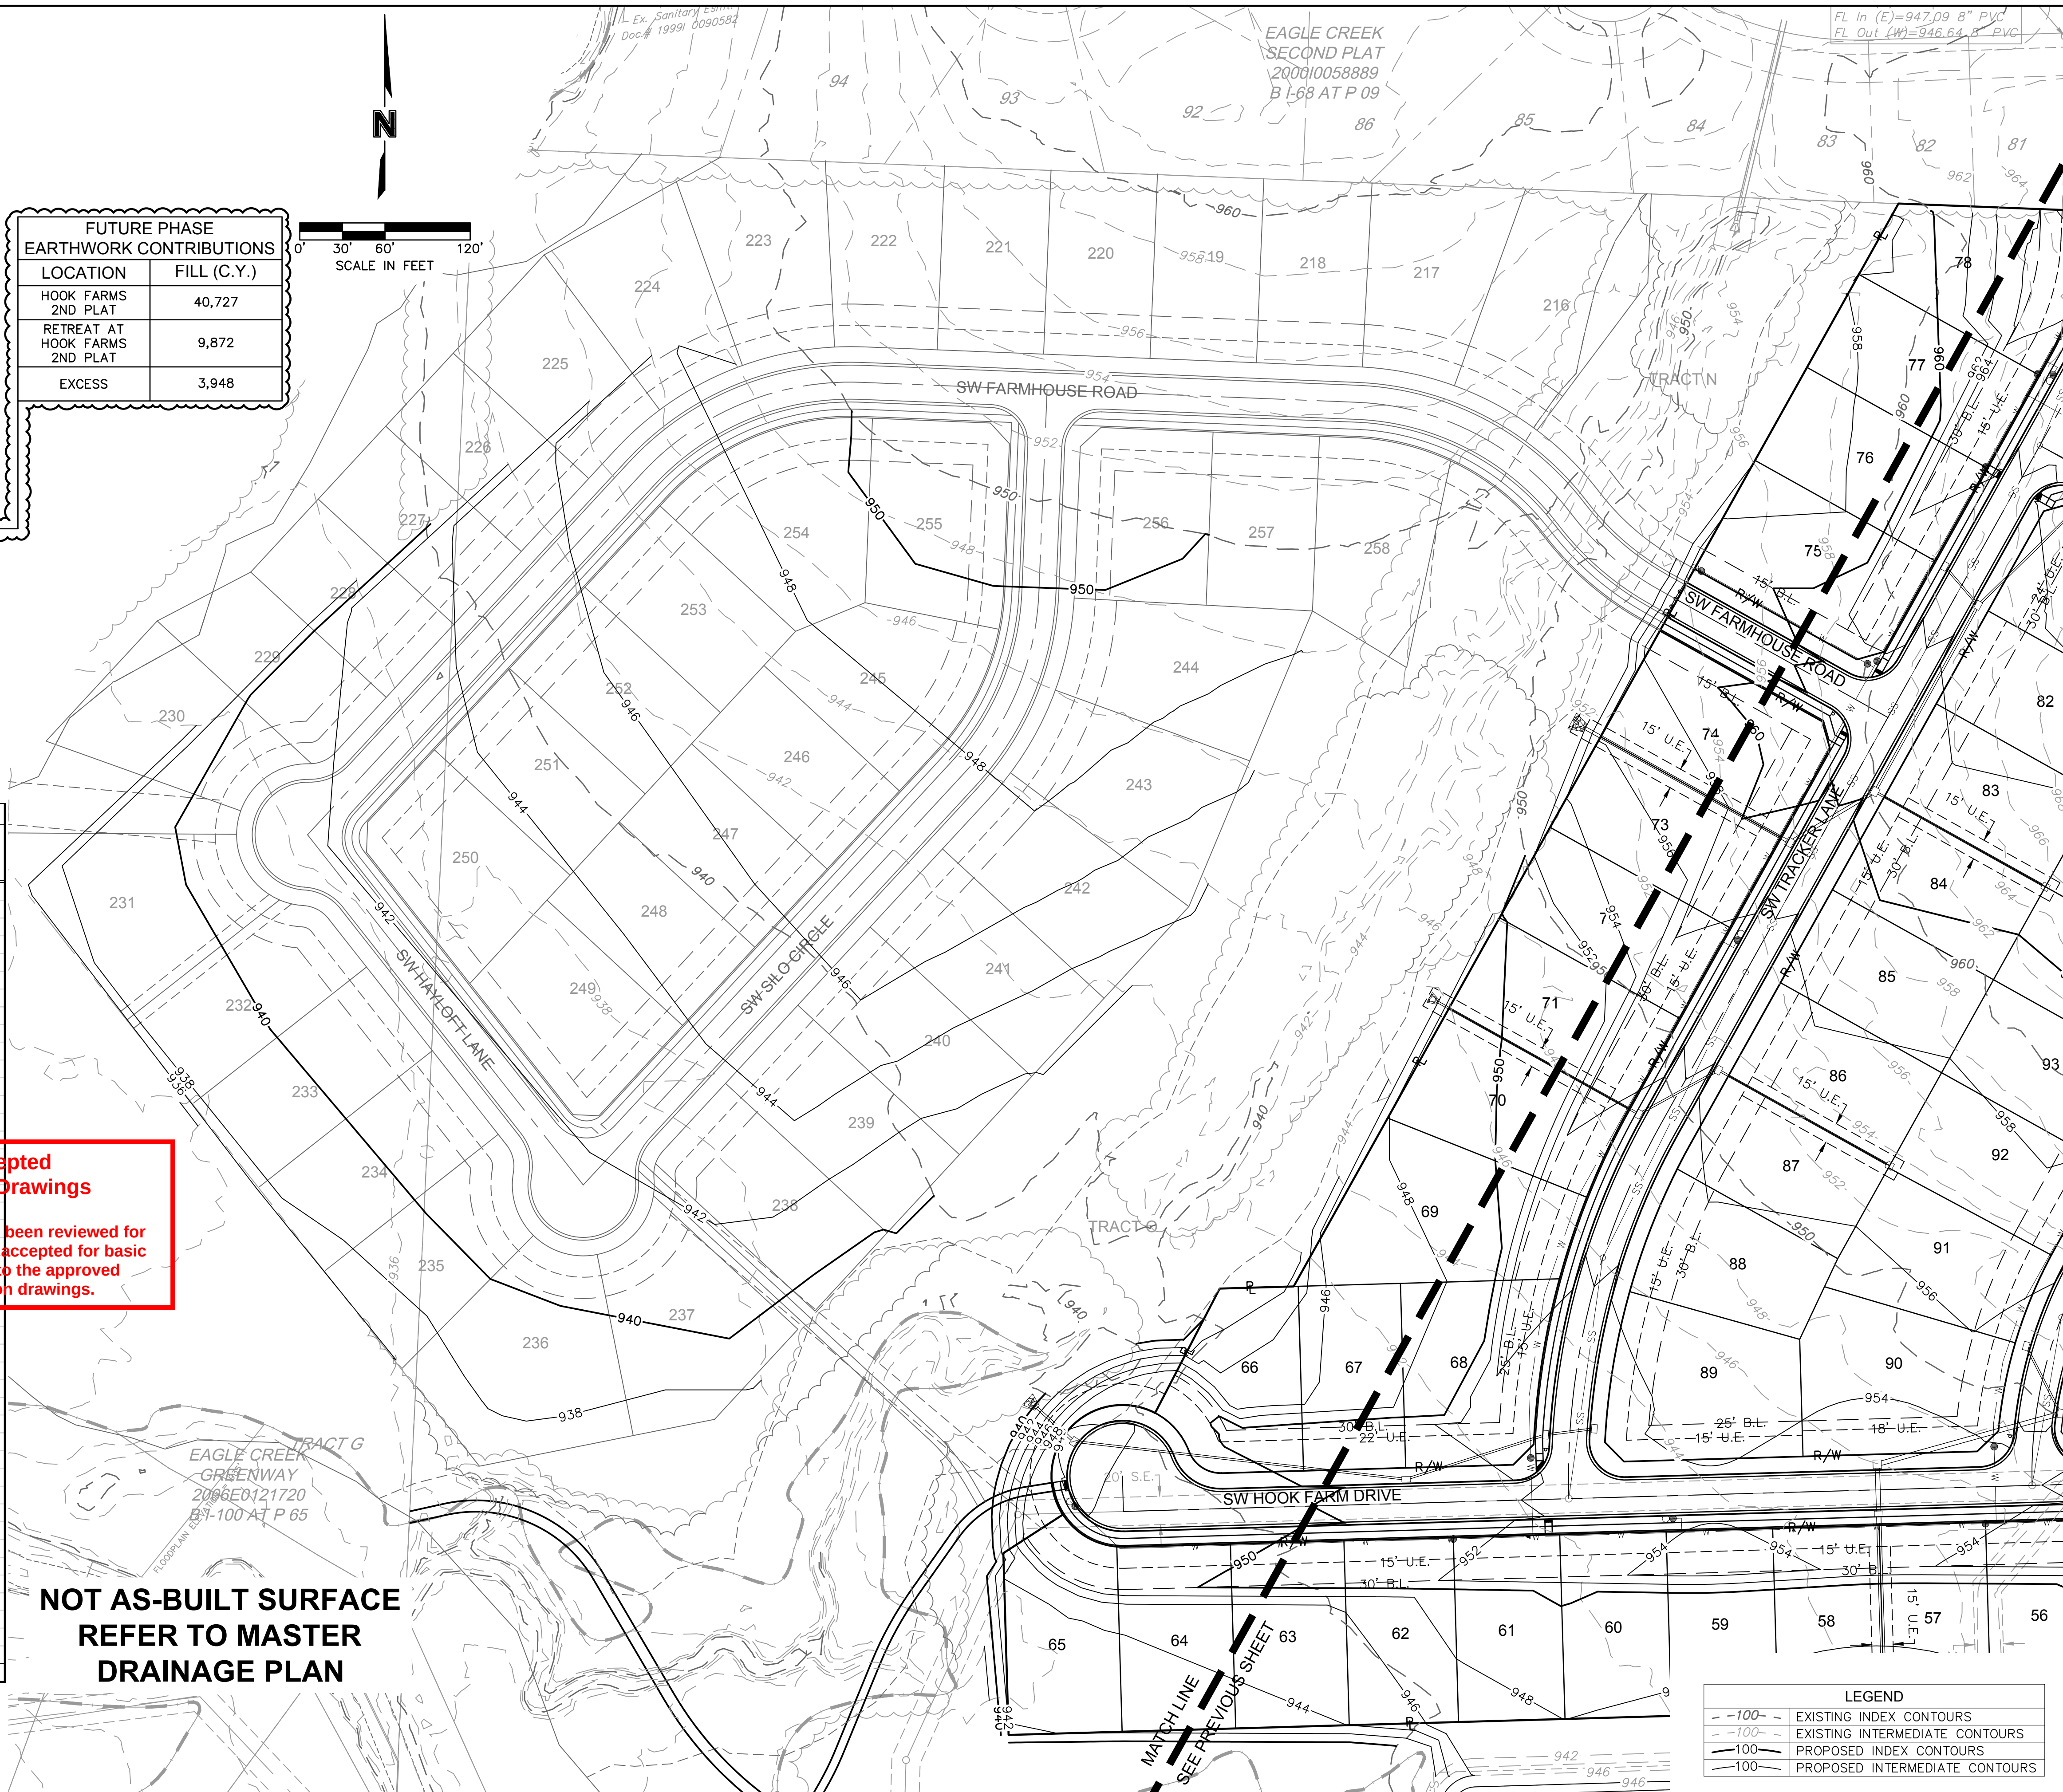

GRADING PLAN (FOR REFERENCE)
STREET & STORM SEWER PLANS

HOOK FARMS
SECOND PLAT

LEE'S SUMMIT, MO

drawn by: B.M.W./A.A.
checked by: B.M.W.
designed by: B.M.W./A.A.
QA/QC by: J.E.S.
project no.: B19-4061
date: 01-08-2021

SHEET
C106

STATE OF MISSOURI
JULIE ELAINE SELLERS
NUMBER
PE-2017000367
12/7/22
PROFESSIONAL ENGINEER


REV. NO.	DATE	REVISIONS DESCRIPTION	BY
1	03-23-2021	REVISED PER CITY COMMENTS	
2	04-20-2021	REVISED PER CITY COMMENTS	
3	09-30-2021	CHANGES TO APPROVED PLANS	
REVISIONS			

DEVISIONS

2021



 Olson

Olsson - Civil Engineering
Missouri Certificate of Authority #001592
1301 Burlington Street
North Kansas City MO 64116
TEL 816.361.1177
FAX 816.361.1888
www.olsson.com

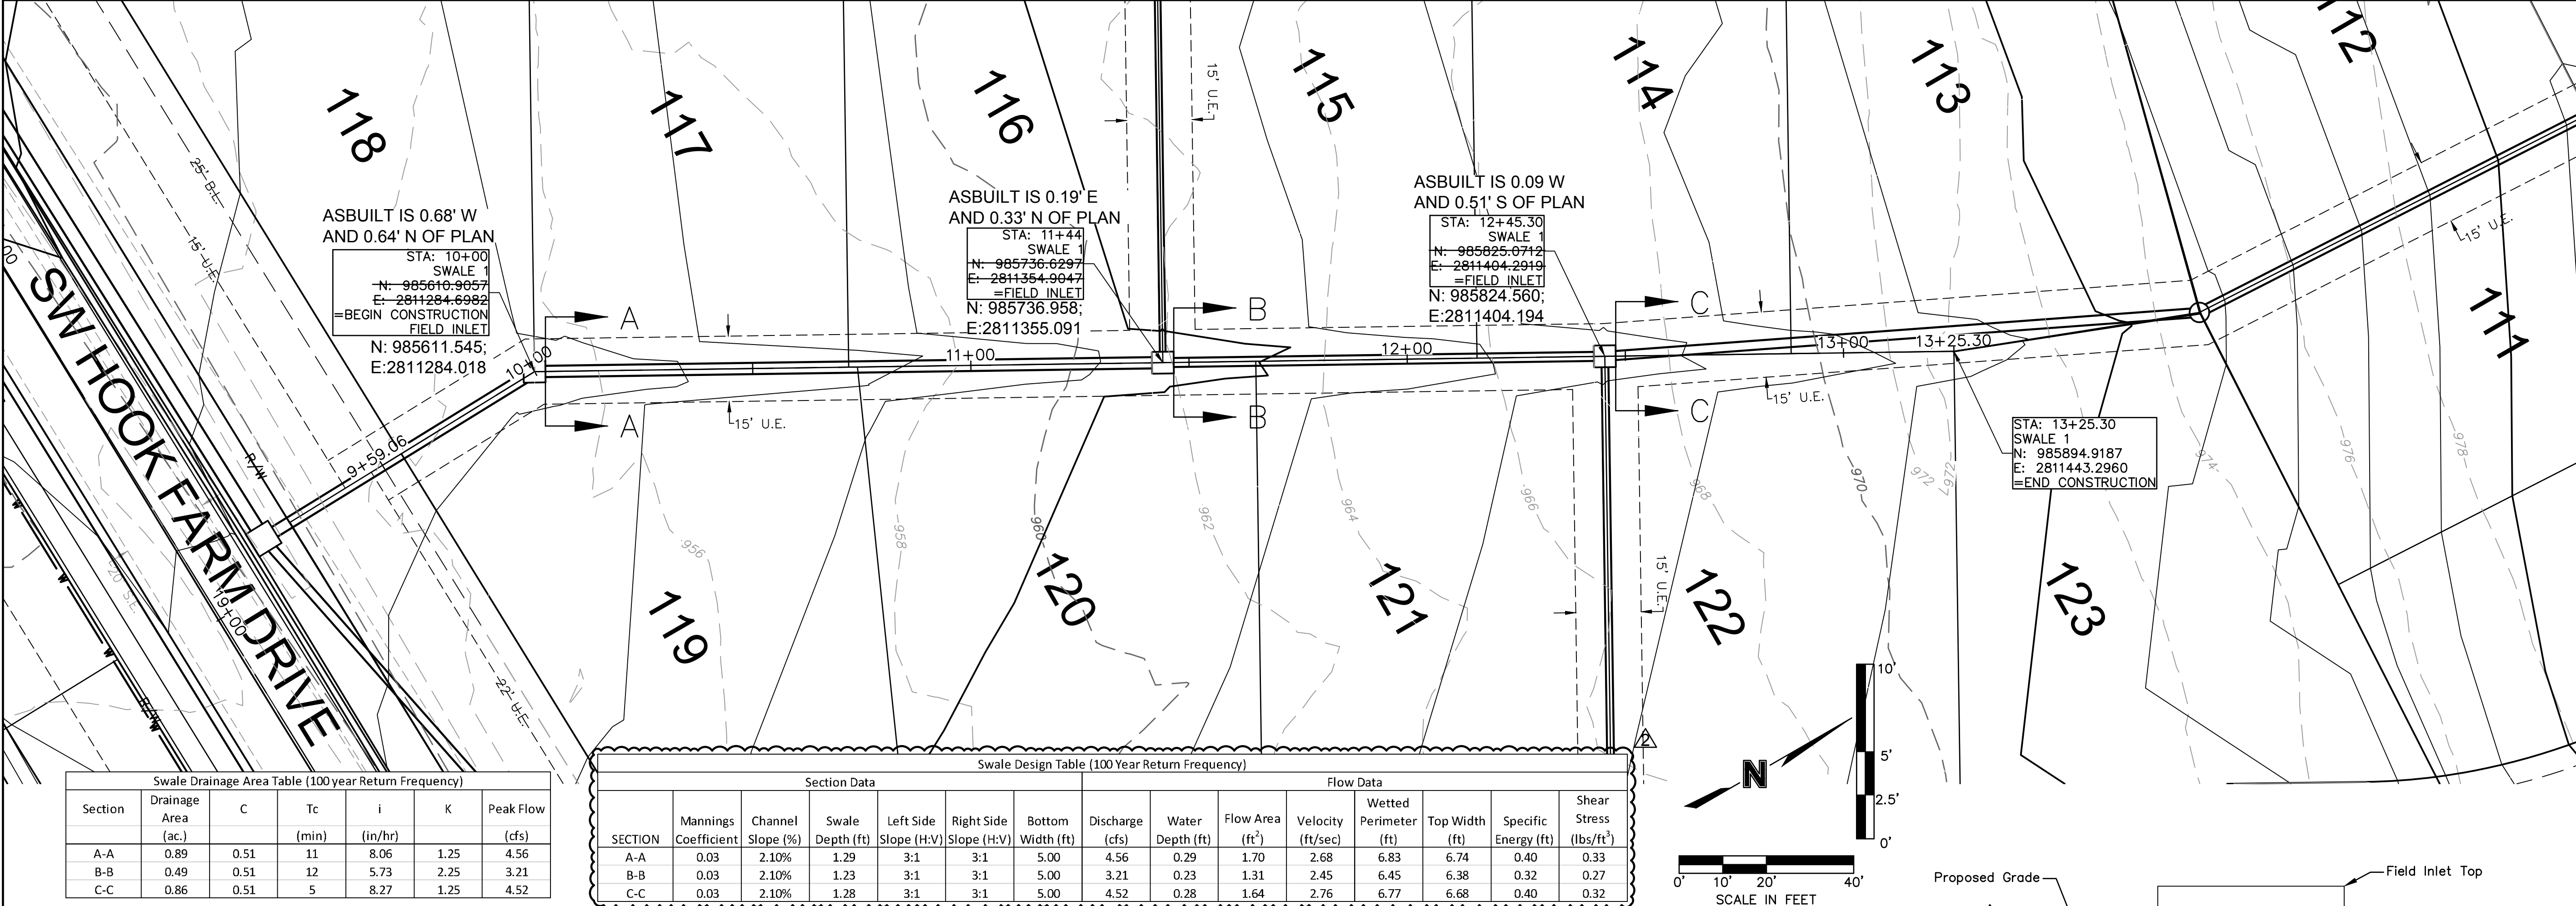

Swale Drainage Area Table (100 year Return Frequency)						
Section	Drainage Area (ac.)	C	Tc (min)	i (in/hr)	K	Peak Flow (cfs)
A-A	0.89	0.51	11	8.06	1.25	4.56
B-B	0.49	0.51	12	5.73	2.25	3.21
C-C	0.86	0.51	5	8.27	1.25	4.52

Swale Design Table (100 Year Return Frequency)														
Section Data							Flow Data							
SECTION	Mannings Coefficient	Channel Slope (%)	Swale Depth (ft)	Left Side Slope (H:V)	Right Side Slope (H:V)	Bottom Width (ft)	Discharge (cfs)	Water Depth (ft)	Flow Area (ft ²)	Velocity (ft/sec)	Wetted Perimeter (ft)	Top Width (ft)	Specific Energy (ft)	Shear Stress (lbs/ft ²)
A-A	0.03	2.10%	1.29	3:1	3:1	5.00	4.56	0.29	1.70	2.68	6.83	6.74	0.40	0.33
B-B	0.03	2.10%	1.23	3:1	3:1	5.00	3.21	0.23	1.31	2.45	6.45	6.38	0.32	0.27
C-C	0.03	2.10%	1.28	3:1	3:1	5.00	4.52	0.28	1.64	2.76	6.77	6.68	0.40	0.32

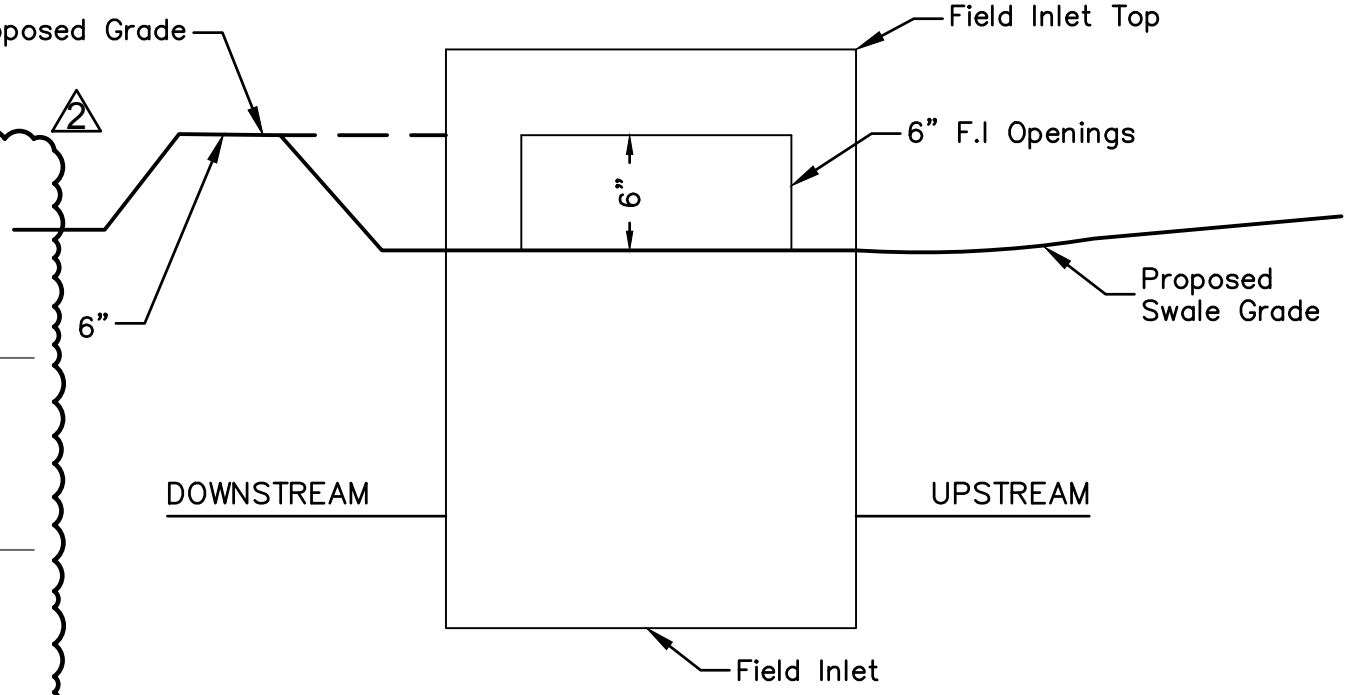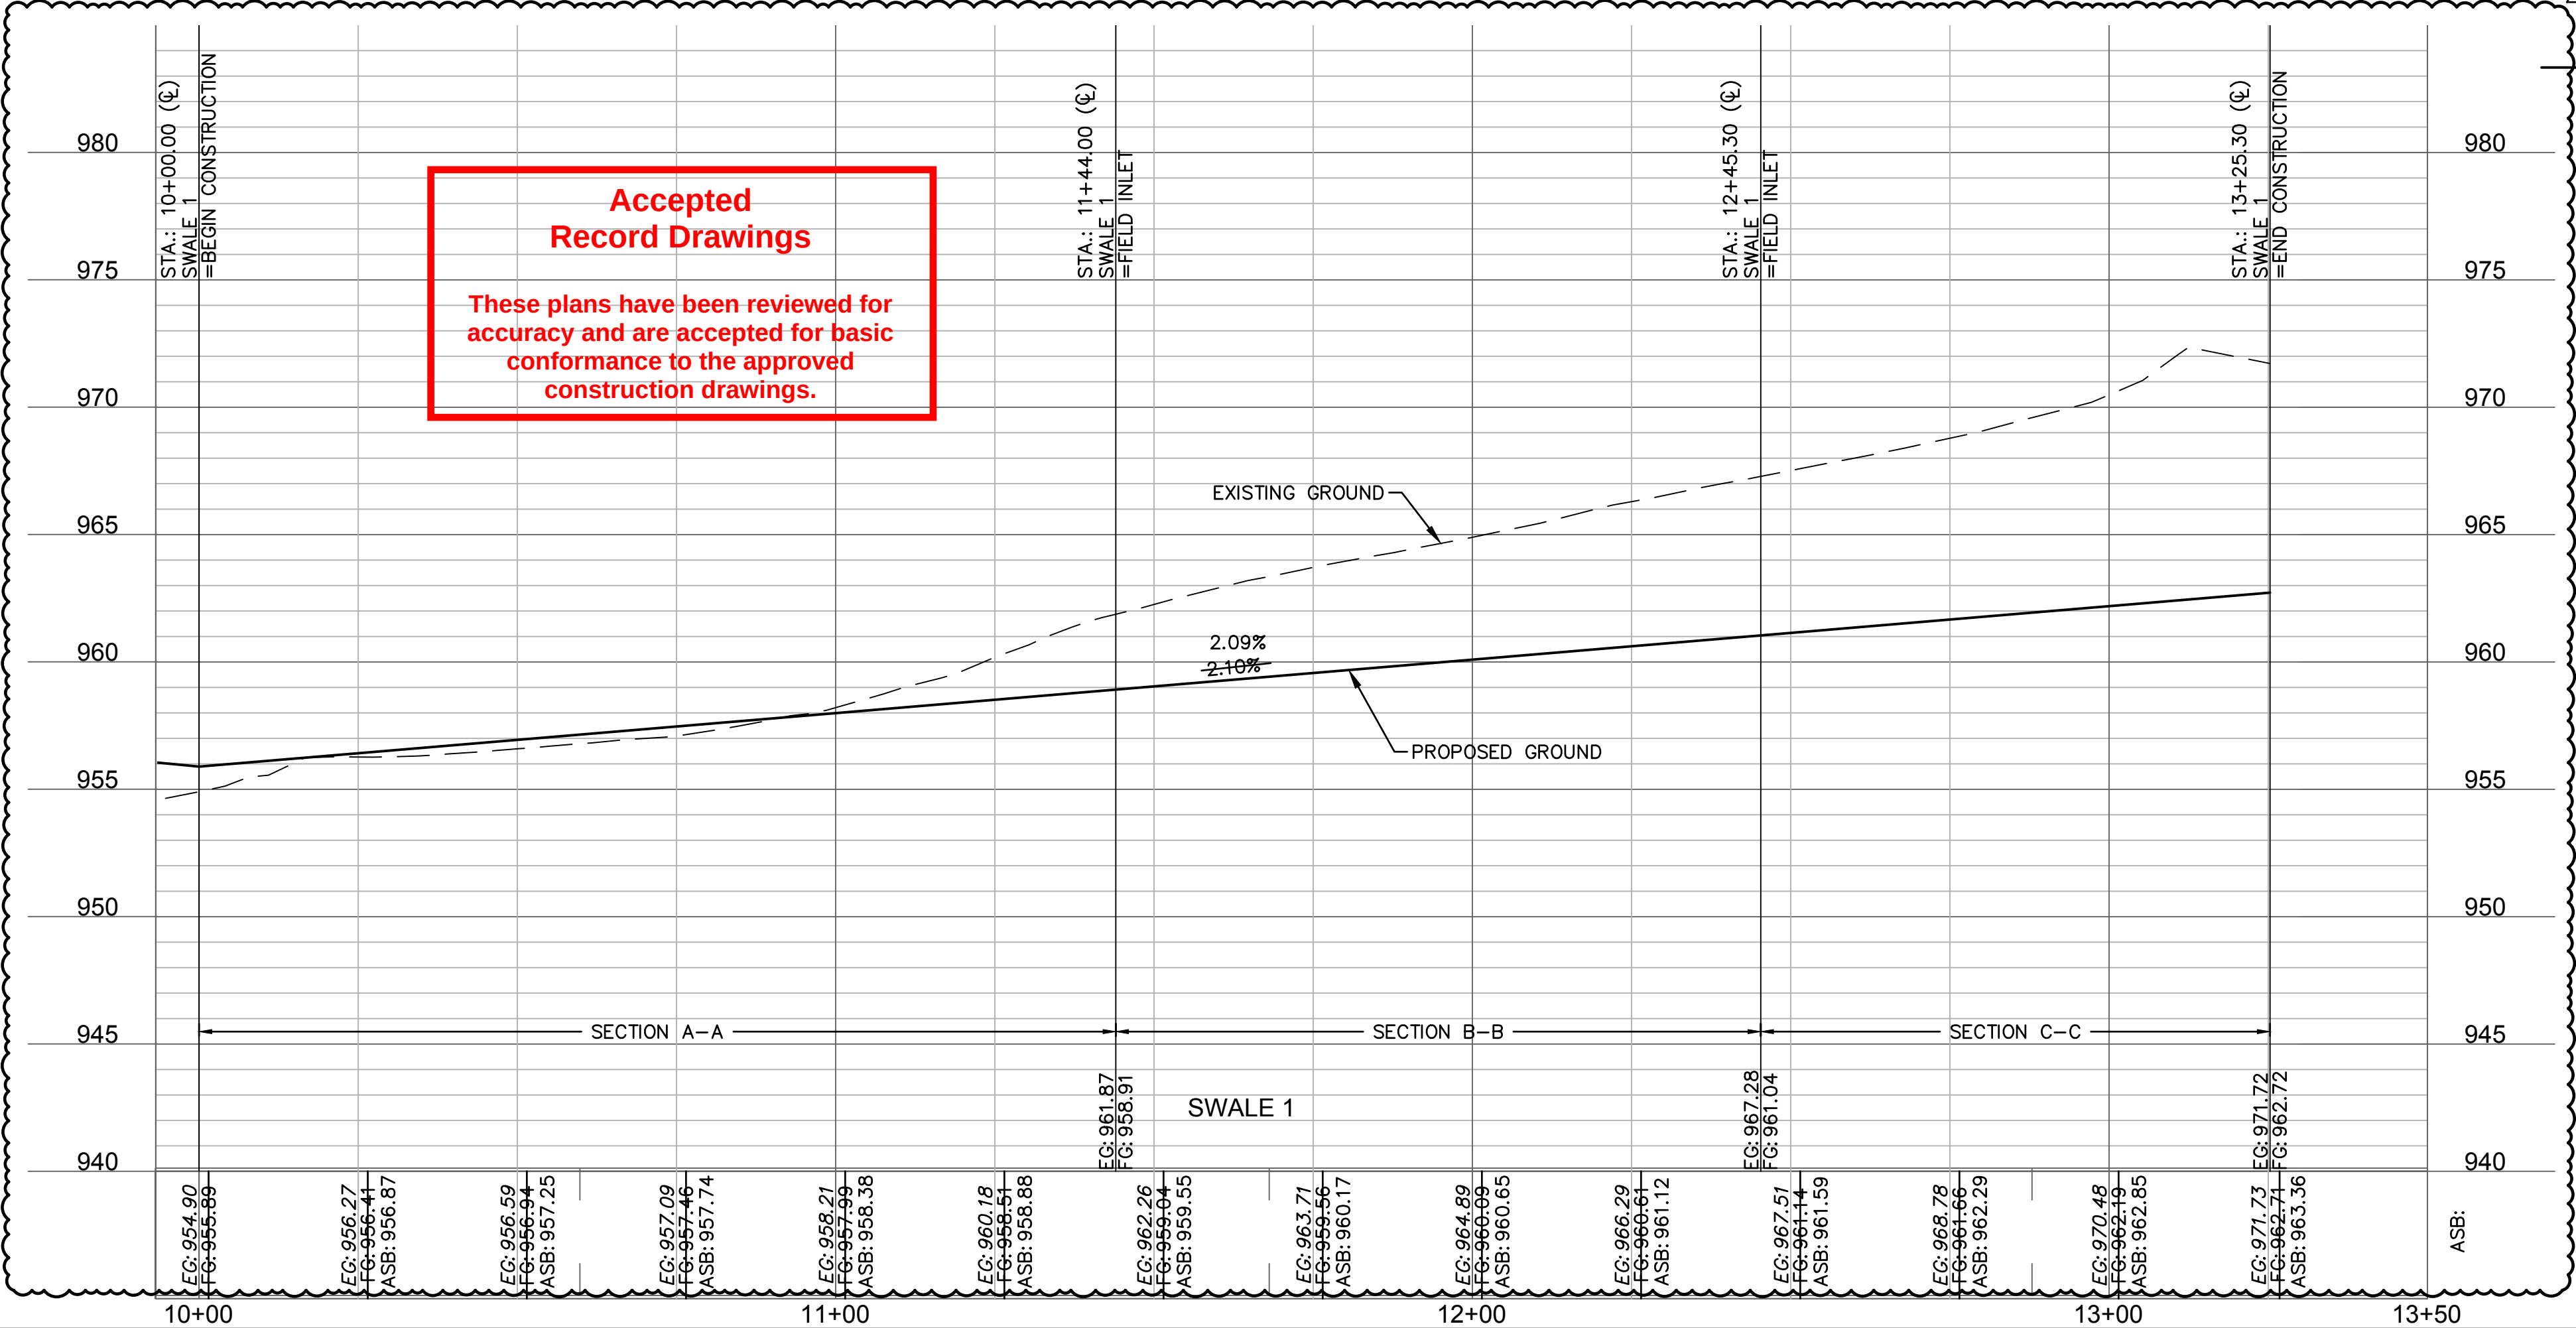


NOTE: INCLUDE SUMP PER ABOVE DETAIL WHERE FIELD INLETS ARE LOCATED WITHIN SWALES.

SUMP DETAIL
N.T.S.

AS BUILT

DATE SURVEYED: 2022-05-26

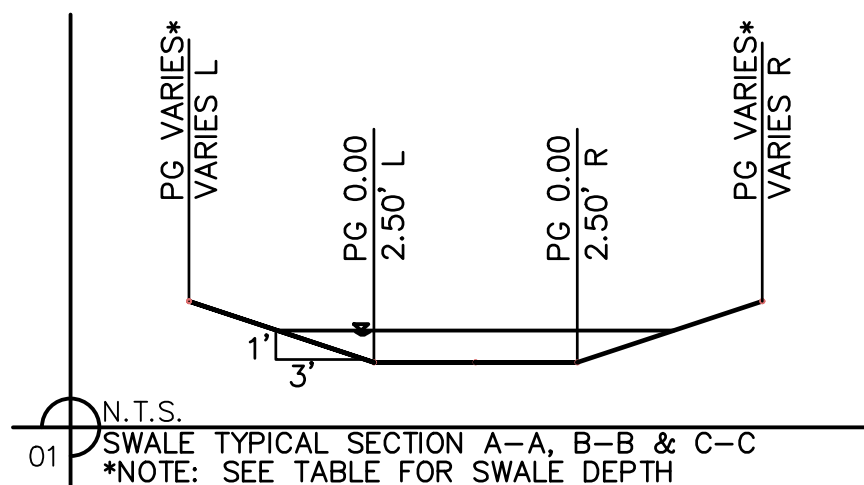

SWALE GRADING NOTES:

- CONTRACTOR SHALL CONSTRUCT SWALES WITH MINIMUM SLOPE, WIDTH AND DEPTH AS SHOWN IN THE SWALE DESIGN TABLES.
- AS-BUILT SURVEY IS REQUIRED/APPROVED BY CITY FOR ALL SWALES AND PRIOR TO APPROVAL FOR ANY BUILDING FOUNDATION PERMIT. CONTRACTOR SHALL BE REQUIRED TO REGRADE SWALES AT CONTRACTOR'S EXPENSE IF ABOVE REQUIREMENTS ARE NOT MET.

olsson

Olsson - Civil Engineering
Missouri Certificate of Authority #001592
1301 Burlington Street
North Kansas City, MO 64116
TEL 816.361.1177
FAX 816.361.1888
www.olsson.com

STATE OF MISSOURI
JULIE ELAINE SELLERS
NUMBER PE-2017000367
12/7/22
PROFESSIONAL ENGINEER

BY
REVISIONS
REV. NO. DATE REVISIONS DESCRIPTION
1 03-23-2021 REVISED PER CITY COMMENTS
2 04-16-2021 REVISED PER CITY COMMENTS
3 09-30-2021 CHANGES TO APPROVED PLANS



SWALE 1 PLAN & PROFILE
STREET & STORM SEWER PLANS
HOOK FARMS
SECOND PLAT
LEE'S SUMMIT, MO
2021

drawn by: B.M.W./A.A.
checked by: B.M.W.
designed by: B.M.W./A.A.
QA/QC by: J.E.S.
project no.: B19-4061
date: 01-08-2021

SHEET
C107




Swale Design Table (100 Year Return Frequency)														
Section Data							Flow Data							
SECTION	Mannings Coefficient	Channel Slope (%)	Swale Depth (ft)	Left Side Slope (H:V)	Right Side Slope (H:V)	Bottom Width (ft)	Discharge (cfs)	Water Depth (ft)	Flow Area (ft²)	Velocity (ft/sec)	Wetted Perimeter (ft)	Top Width (ft)	Specific Energy (ft)	Shear Stress (lbs/ft²)
D-D	0.03	2.10%	2.50	3:1	3:1	5.00	5.37	0.31	1.84	2.92	6.96	6.86	0.44	0.35
E-E	0.03	2.60%	2.50	3:1	3:1	5.00	6.88	0.34	2.05	3.36	7.15	7.04	0.52	0.46
F-F	0.03	2.60%	2.50	3:1	3:1	5.00	6.78	0.34	2.05	3.31	7.15	7.04	0.52	0.46

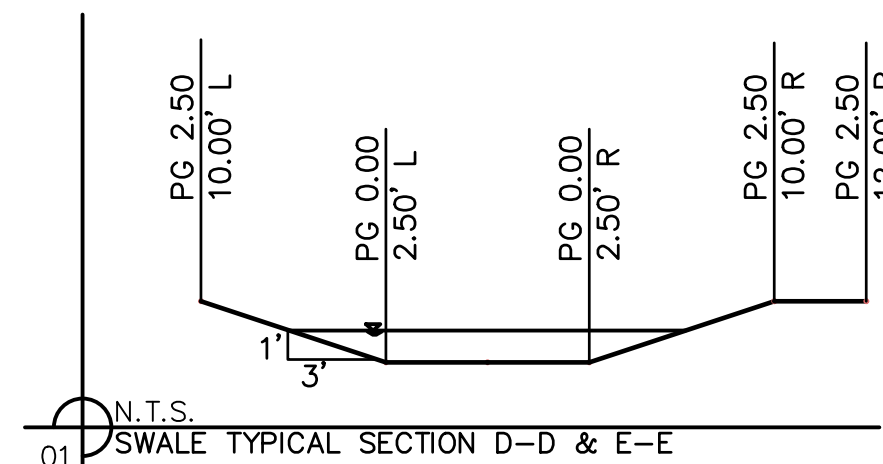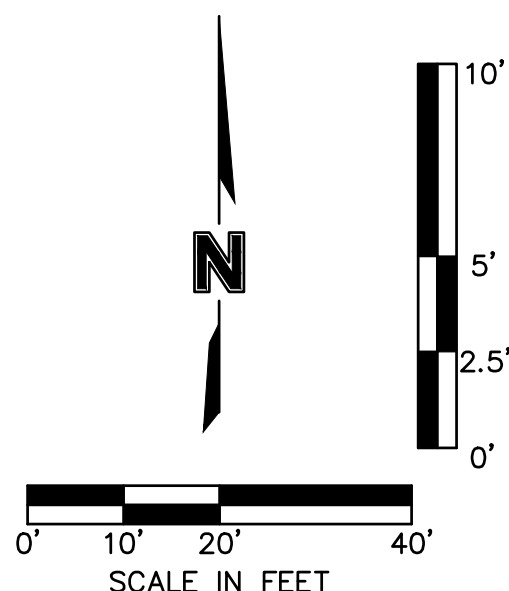

DATE SURVEYED: 2022-05-26



SWALE GRADING NOTES:

1. CONTRACTOR SHALL CONSTRUCT SWALES WITH MINIMUM SLOPE, WIDTH AND DEPTH AS SHOWN IN THE SWALE DESIGN TABLES.
2. AS-BUILT SURVEY IS REQUIRED/APPROVED BY CITY FOR ALL SWALES AND PRIOR TO APPROVAL FOR ANY BUILDING FOUNDATION PERMIT. CONTRACTOR SHALL BE REQUIRED TO REGRADE SWALES AT CONTRACTOR'S EXPENSE IF ABOVE REQUIREMENTS ARE NOT MET.

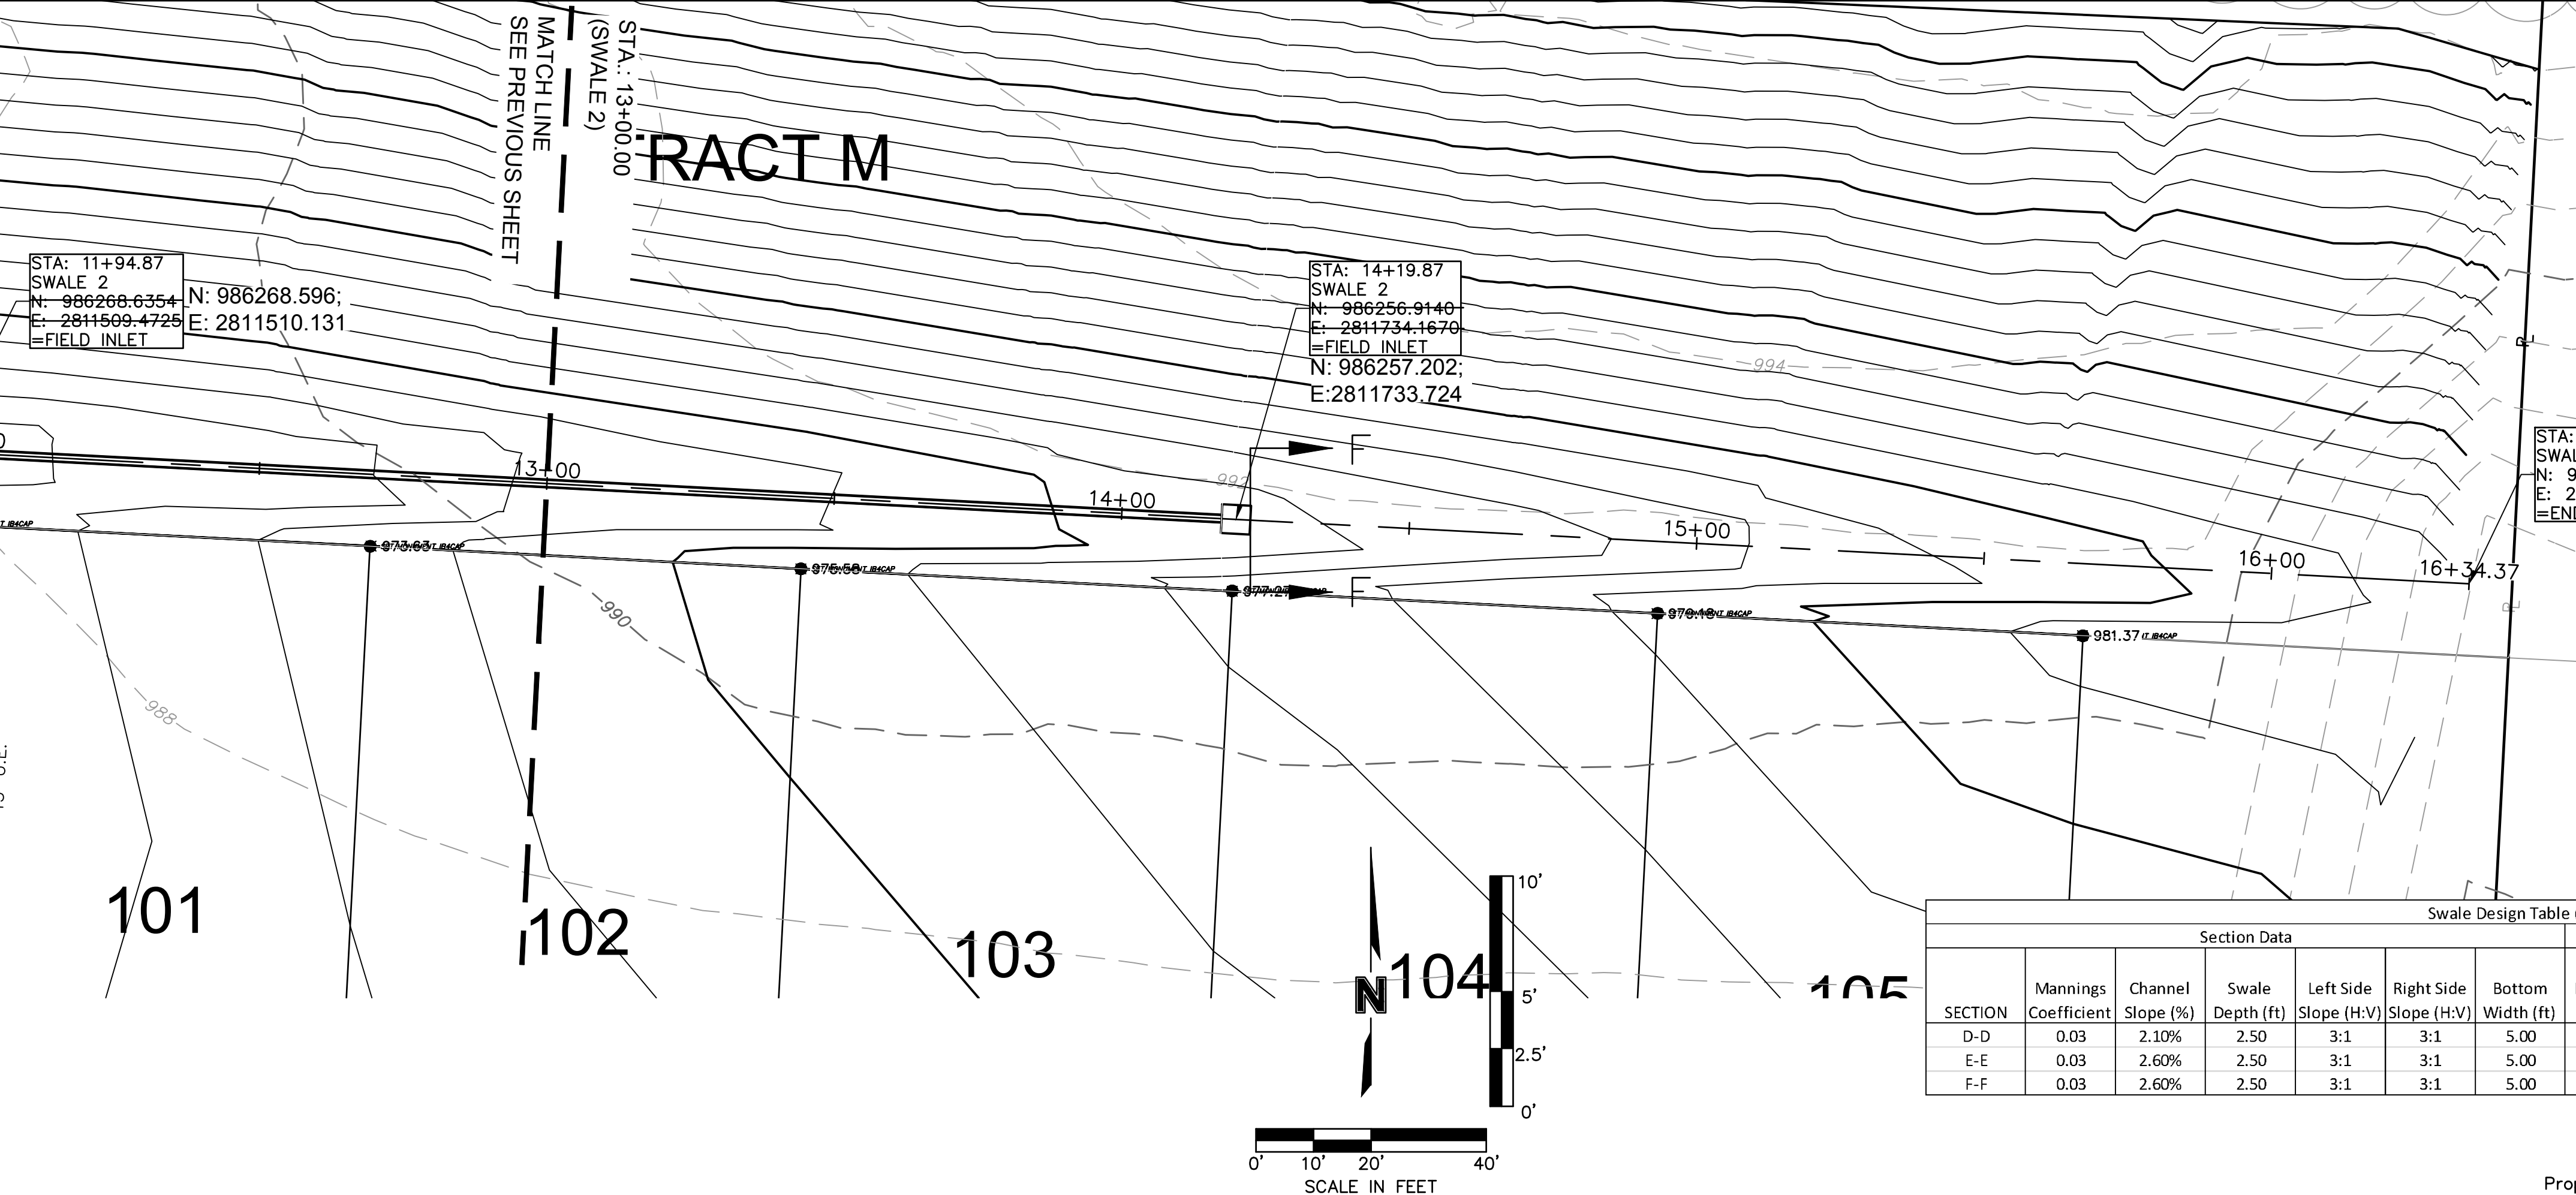

Swale Drainage Area Table (100 year Return Frequency)						
Section	Drainage Area (ac.)	C	Tc (min)	i (in/hr)	K	Peak Flow (cfs)
D-D	1.02	0.51	5	8.27	1.25	5.37
E-E	1.30	0.51	5	4.60	2.25	6.88
F-F	1.29	0.51	5	3.18	3.25	6.78

Swale Design Table (100 Year Return Frequency)														
Section Data							Flow Data							
SECTION	Mannings Coefficient	Channel Slope (%)	Swale Depth (ft)	Left Side Slope (H:V)	Right Side Slope (H:V)	Bottom Width (ft)	Discharge (cfs)	Water Depth (ft)	Flow Area (ft ²)	Velocity (ft/sec)	Wetted Perimeter (ft)	Top Width (ft)	Specific Energy (ft)	Shear Stress (lbs/ft ²)
D-D	0.03	2.10%	2.50	3:1	3:1	5.00	5.37	0.31	1.84	2.92	6.96	6.86	0.44	0.35
E-E	0.03	2.60%	2.50	3:1	3:1	5.00	6.88	0.34	2.05	3.36	7.15	7.04	0.52	0.46
F-F	0.03	2.60%	2.50	3:1	3:1	5.00	6.78	0.34	2.05	3.31	7.15	7.04	0.52	0.46

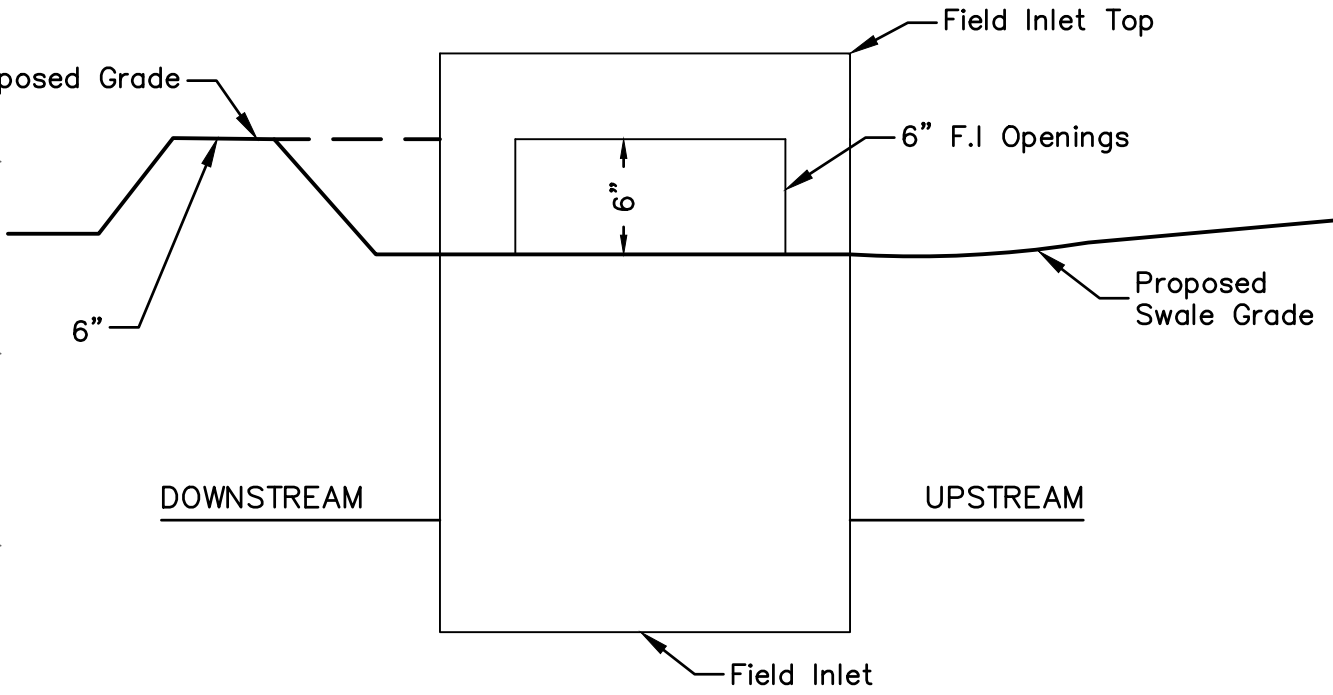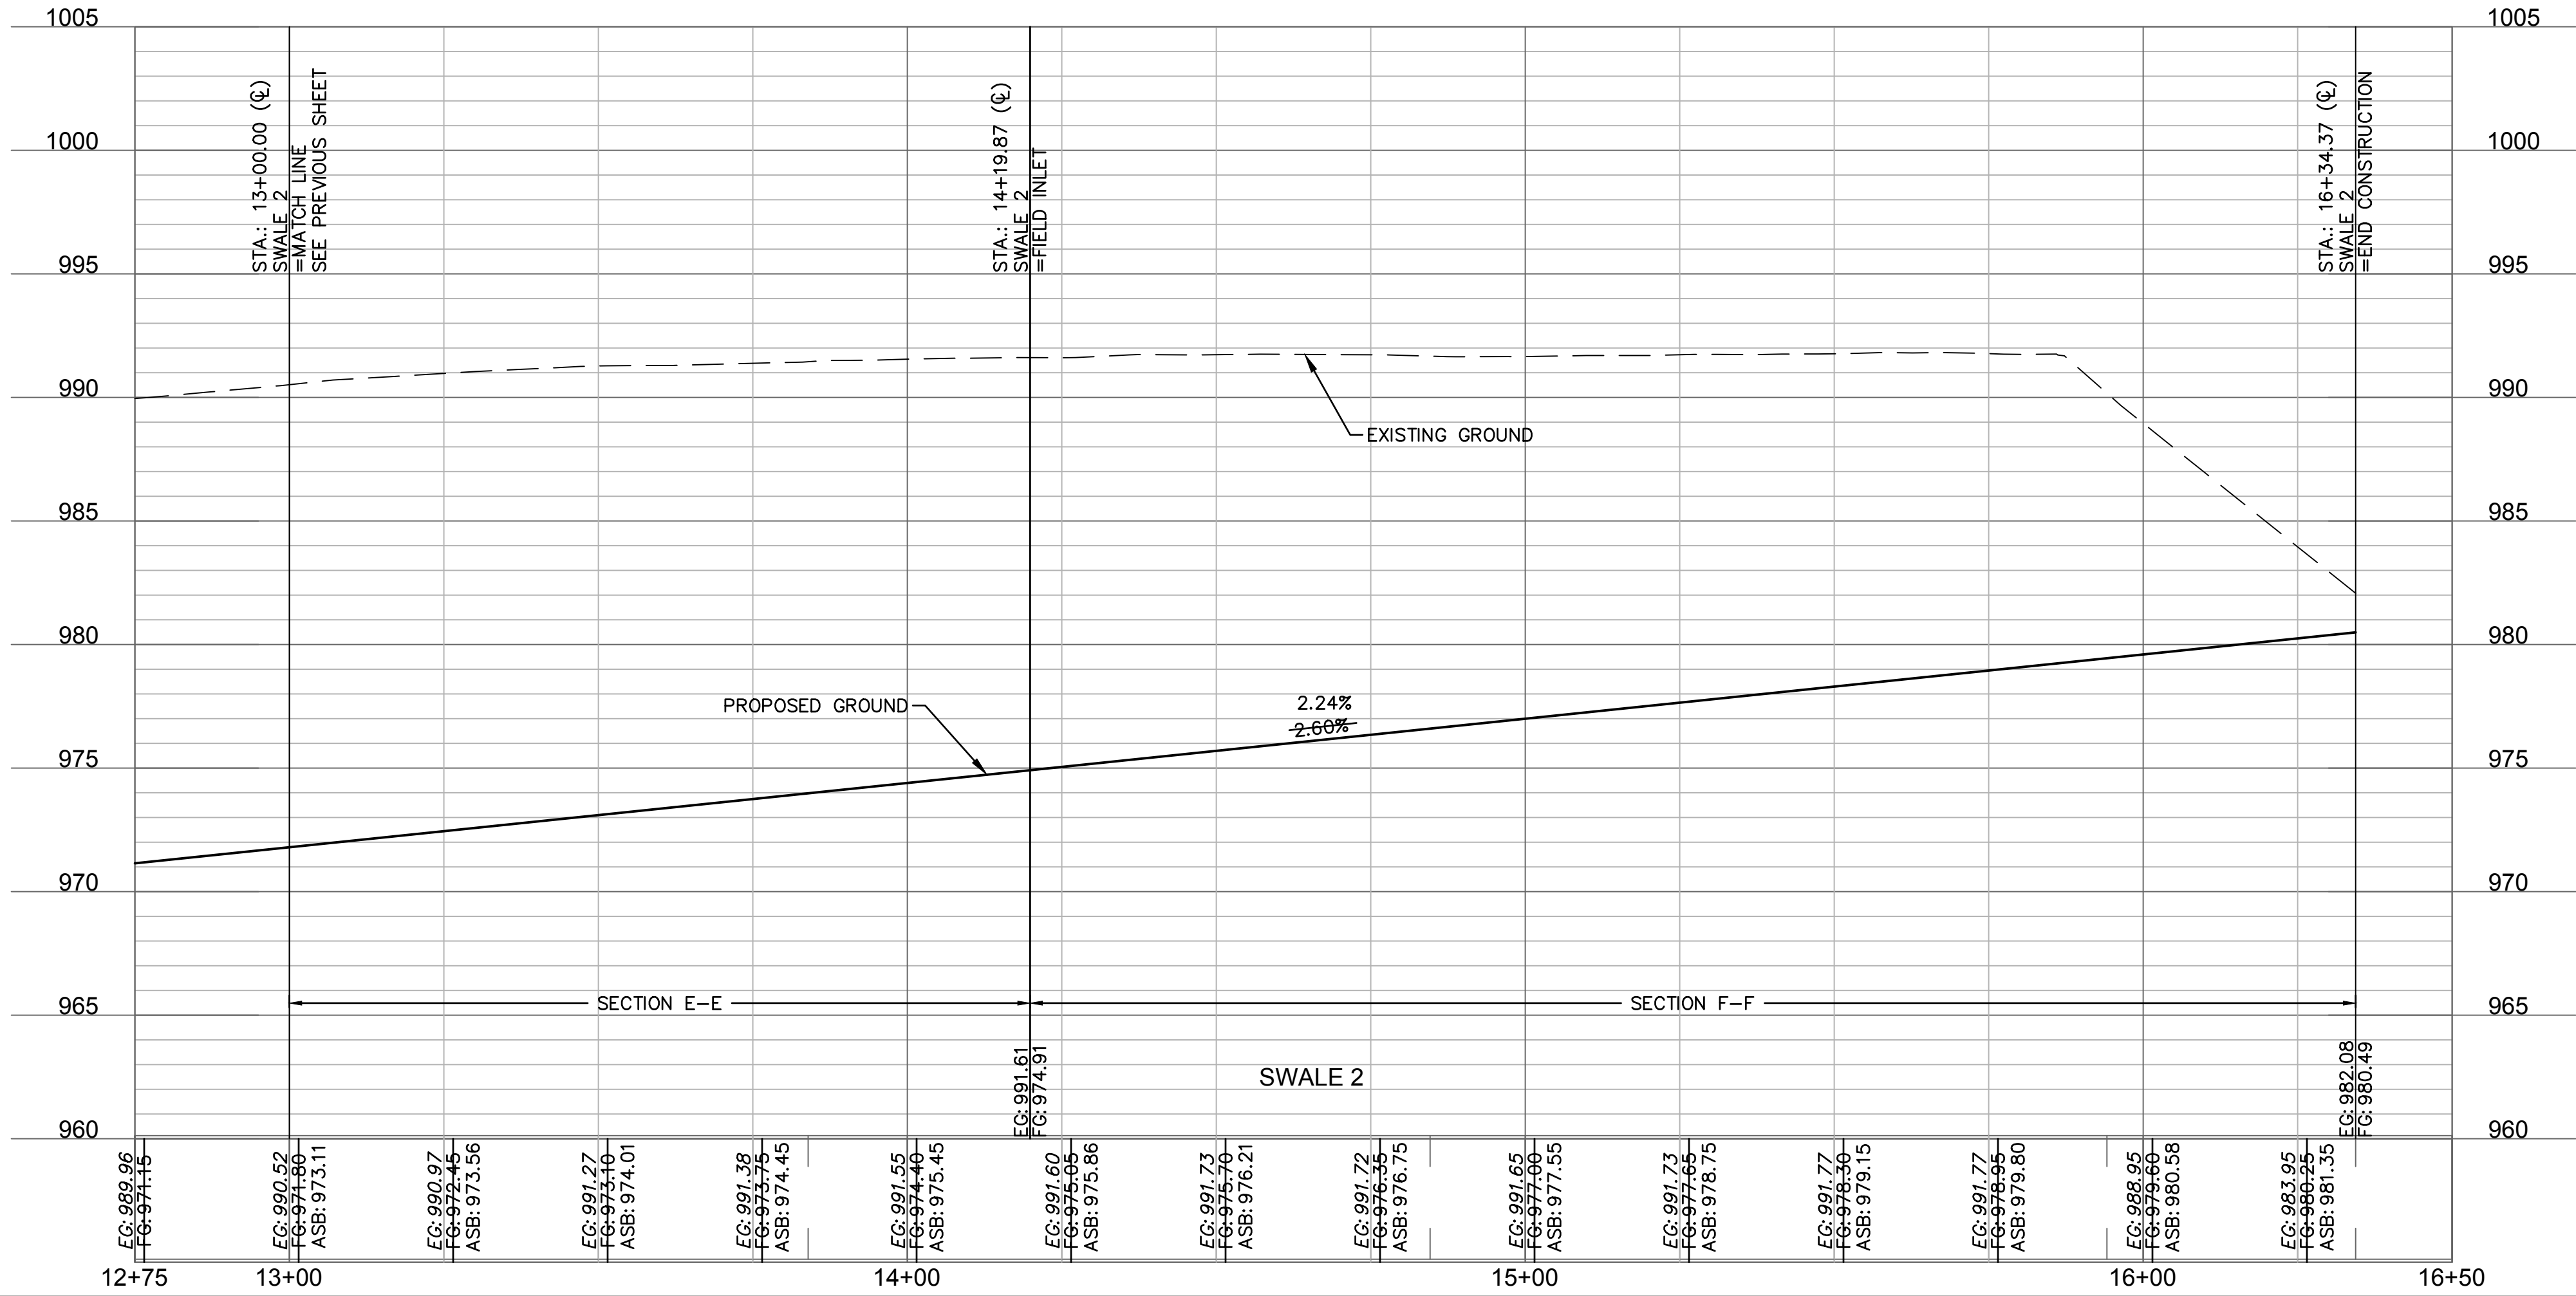


NOTE: INCLUDE SUMP PER ABOVE DETAIL WHERE FIELD INLETS ARE LOCATED WITHIN SWALES.

SUMP DETAIL
N.T.S.

AS BUILT

DATE SURVEYED: 2022-05-26

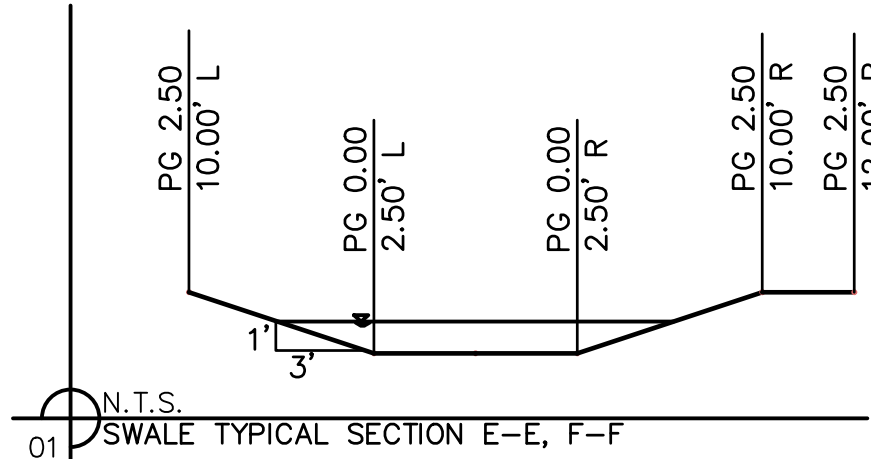

SWALE GRADING NOTES:

- CONTRACTOR SHALL CONSTRUCT SWALES WITH MINIMUM SLOPE, WIDTH AND DEPTH AS SHOWN IN THE SWALE DESIGN TABLES.
- AS-BUILT SURVEY IS REQUIRED/APPROVED BY CITY FOR ALL SWALES AND PRIOR TO APPROVAL FOR ANY BUILDING FOUNDATION PERMIT. CONTRACTOR SHALL BE REQUIRED TO REGRADE SWALES AT CONTRACTOR'S EXPENSE IF ABOVE REQUIREMENTS ARE NOT MET.

Accepted
Record Drawings

These plans have been reviewed for accuracy and are accepted for basic conformance to the approved construction drawings.

olsson

Olsson - Civil Engineering
Missouri Certificate of Authority #001592
1301 Burlington Street
North Kansas City, MO 64116
TEL 816.361.1177
FAX 816.361.1888
www.olsson.com

JULIE ELAINE
SELLERS
NUMBER
PE-2017000367
12/7/22
PROFESSIONAL ENGINEER

STATE OF MISSOURI


BY

REVISIONS

SWALE 2 PLAN & PROFILE
STREET & STORM SEWER PLANS
HOOK FARMS
SECOND PLAT
LEE'S SUMMIT, MO

drawn by: B.M.W./A.A.
checked by: B.M.W.
designed by: B.M.W./A.A.
QA/QC by: J.E.S.
project no.: B19-4061
date: 01-08-2021

SHEET
C109

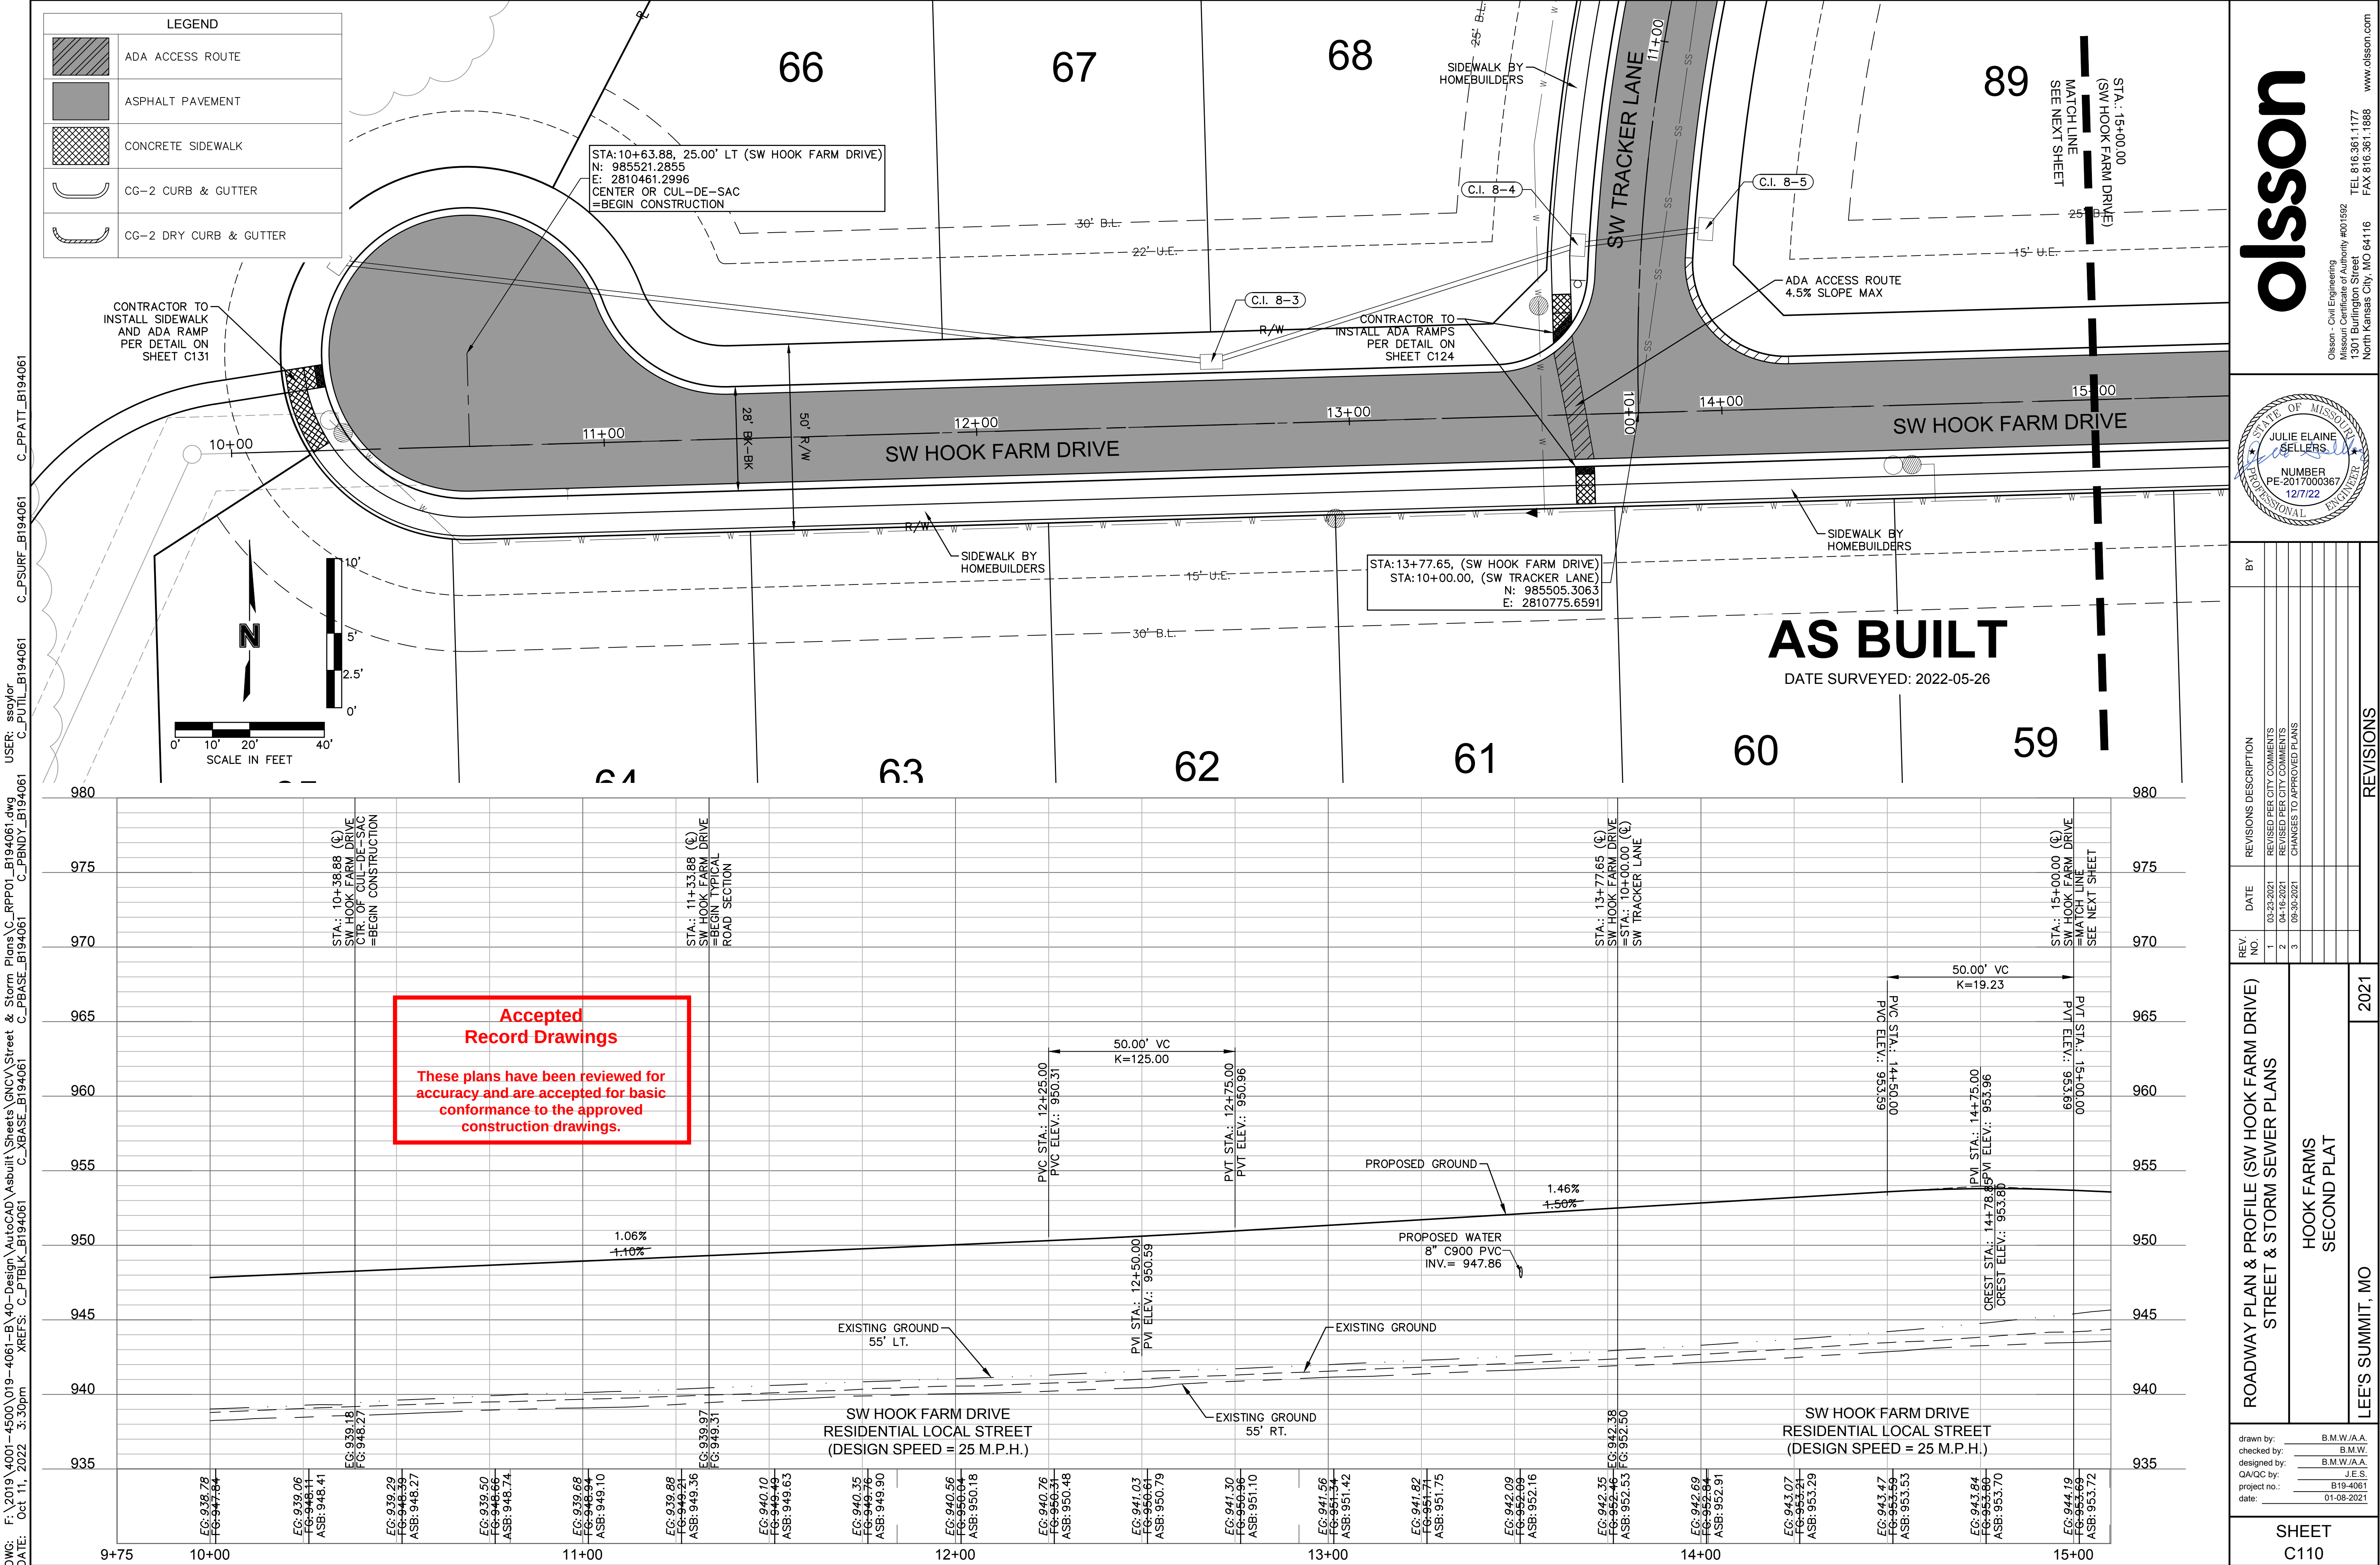

olsson

Olsson - Civil Engineering
Missouri Certificate of Authority #001592
1301 Burlington Street
North Kansas City, MO 64116
TEL 816.361.1177
FAX 816.361.1888
www.olsson.com

STATE OF MISSOURI
JULIE ELAINE
SELLERS
NUMBER
PE-2017000367
12/7/22
PROFESSIONAL ENGINEER

REV. NO.	DATE	REVISIONS DESCRIPTION
1	03-23-2021	REVISED PER CITY COMMENTS
2	04-16-2021	REVISED PER CITY COMMENTS
3	09-30-2021	CHANGES TO APPROVED PLANS

BY


ROADWAY PLAN & PROFILE (SW HOOK FARM DRIVE)
STREET & STORM SEWER PLANS

HOOK FARMS
SECOND PLAT

LEE'S SUMMIT, MO

2021

SHEET
C110

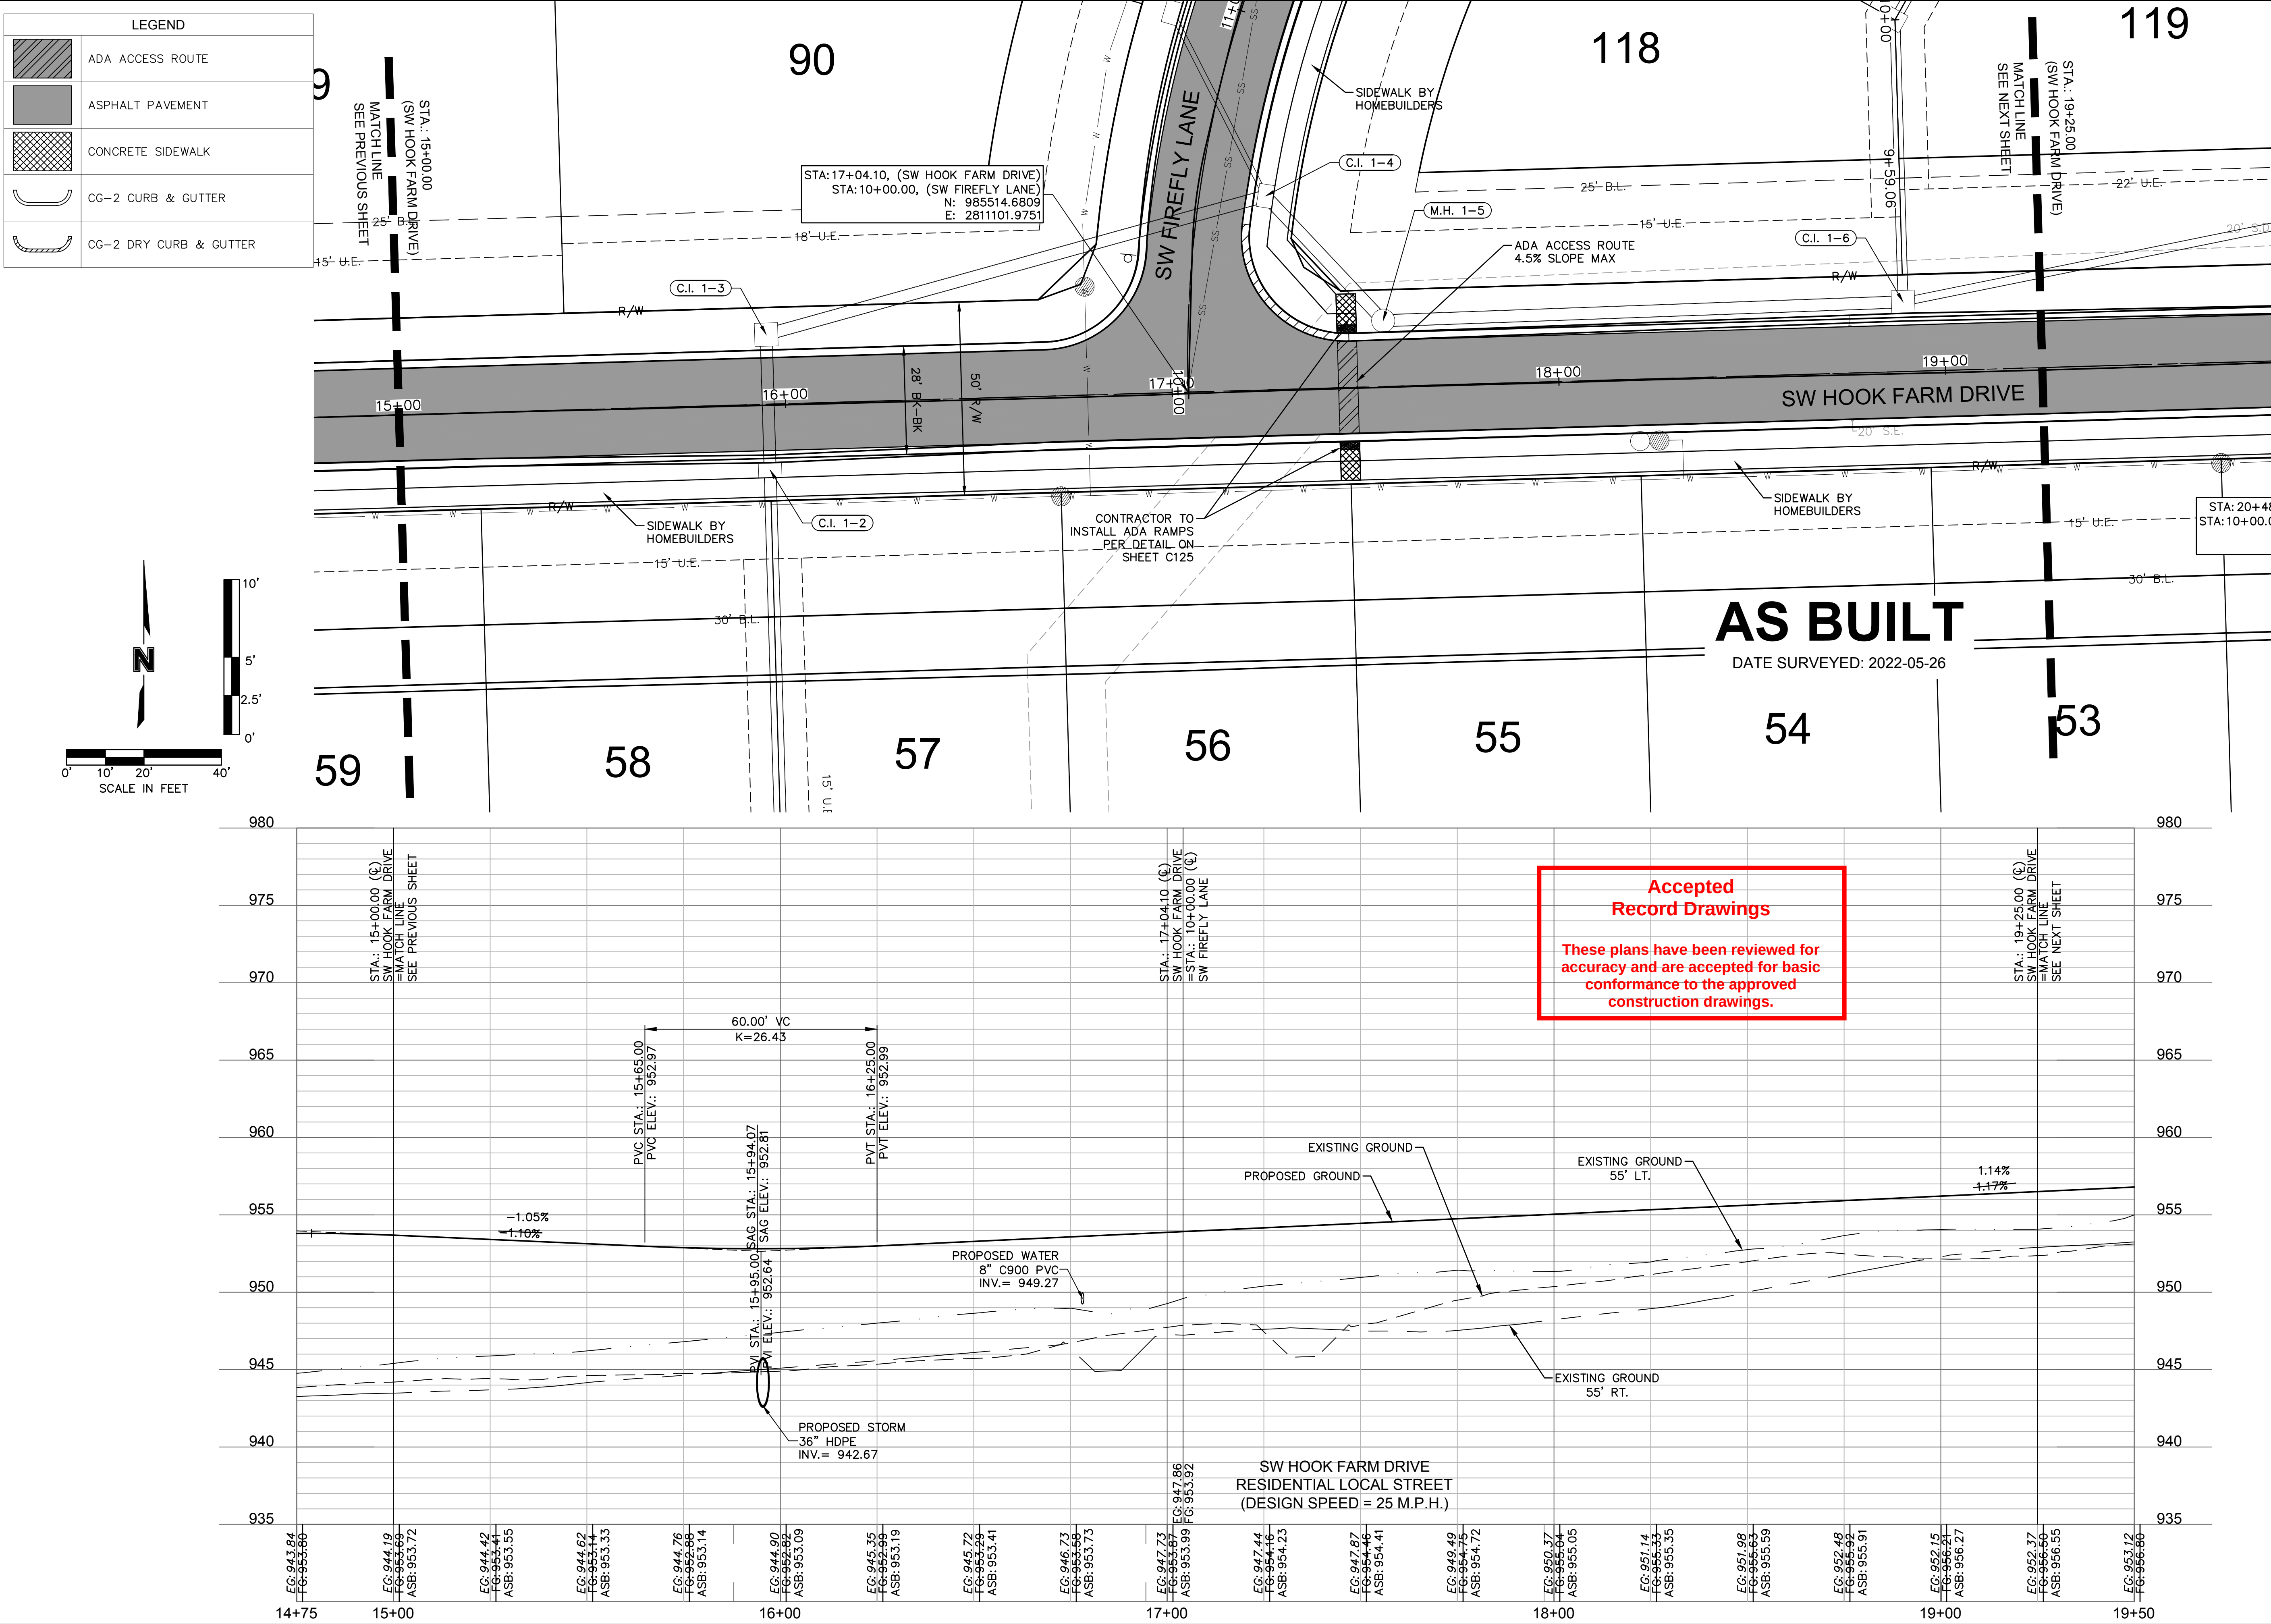

olsson

Olsson - Civil Engineering
Missouri Certificate of Authority #001592
1301 Burlington Street
North Kansas City, MO 64116
TEL 816.361.1177
FAX 816.361.1888
www.olsson.com


STATE OF MISSOURI
JULIE ELAINE SELLERS
NUMBER PE-2017000367
12/7/22
PROFESSIONAL ENGINEER

BY
DATE
REV. NO.
1 03-23-2021
2 04-16-2021
3 09-30-2021
REVISIONS DESCRIPTION
REVISED PER CITY COMMENTS
REVISED PER CITY COMMENTS
CHANGES TO APPROVED PLANS



ROADWAY PLAN & PROFILE (SW HOOK FARM DRIVE)
STREET & STORM SEWER PLANS
HOOK FARMS
SECOND PLAT
LEE'S SUMMIT, MO
2021

drawn by: B.M.W./A.A.
checked by: B.M.W.
designed by: B.M.W./A.A.
QA/QC by: J.E.S.
project no.: B19-4061
date: 01-08-2021

LEGEND	
	ADA ACCESS ROUTE
	MILL & OVERLAY
	ASPHALT PAVEMENT
	CONCRETE SIDEWALK
	CG-2 CURB & GUTTER
	CG-2 DRY CURB & GUTTER

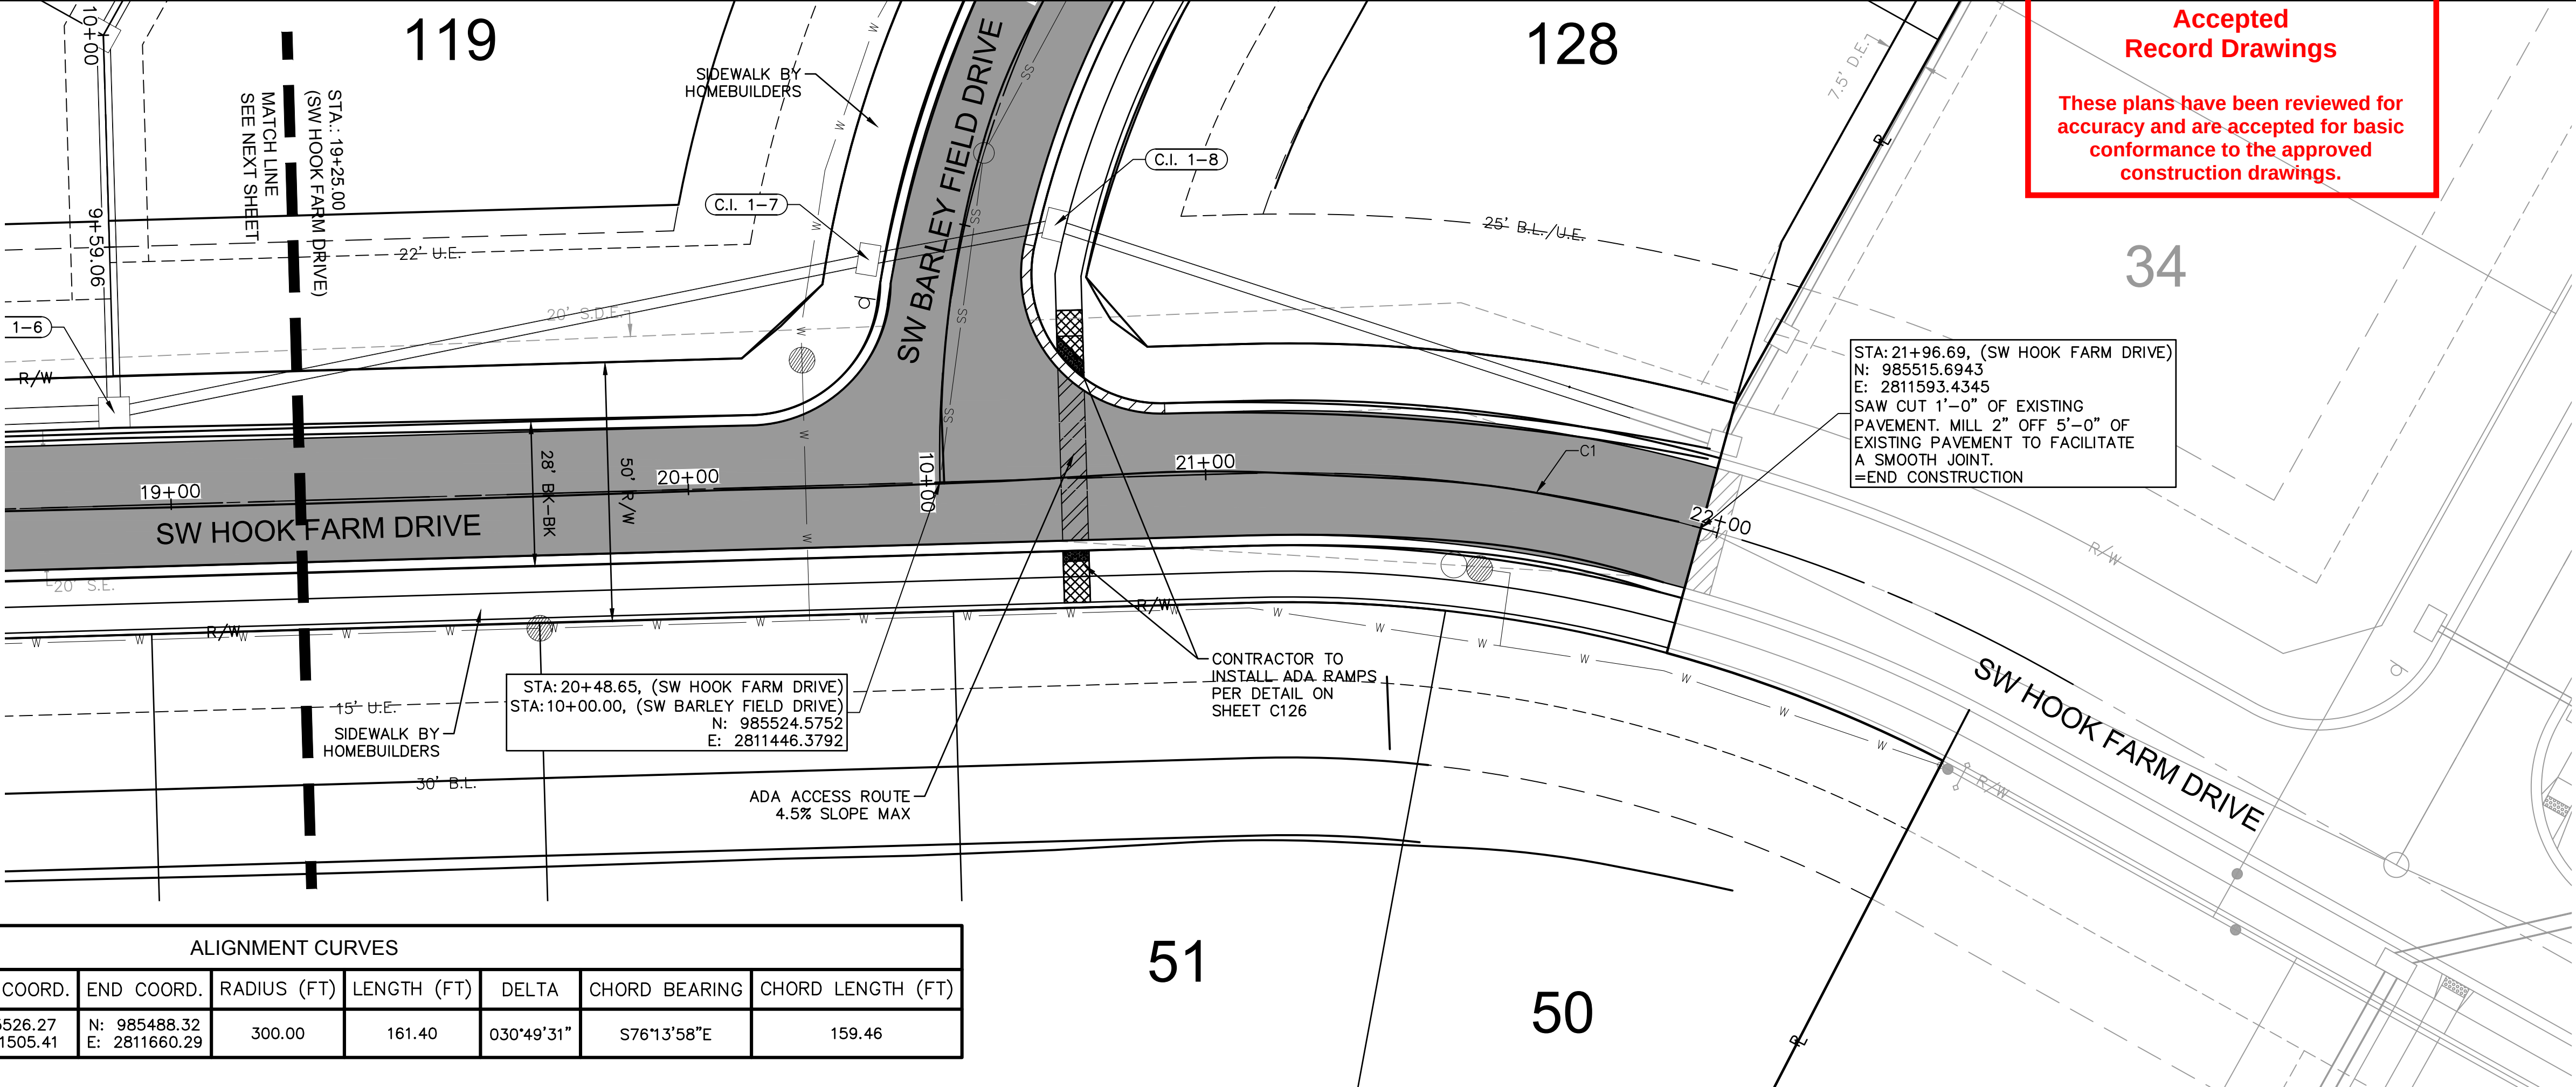

ALIGNMENT CURVES								
CURVE ID #	STATION RANGE	START COORD.	END COORD.	RADIUS (FT)	LENGTH (FT)	DELTA	CHORD BEARING	CHORD LENGTH (FT)
C1	21+07.71 22+69.11	N: 985526.27 E: 2811505.41	N: 985488.32 E: 2811660.29	300.00	161.40	030°49'31"	S76°13'58"E	159.46

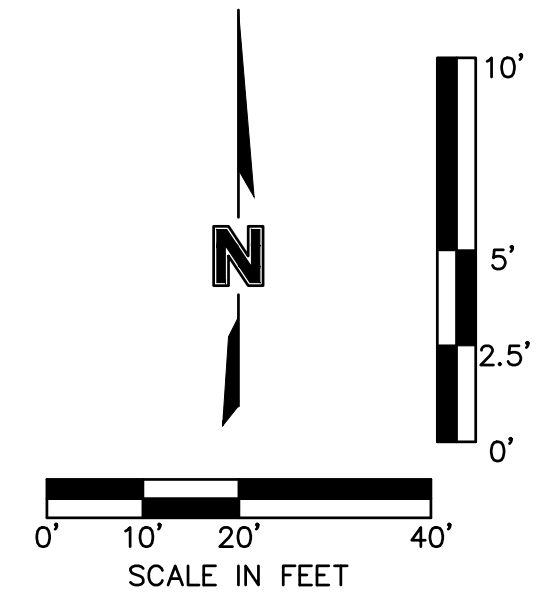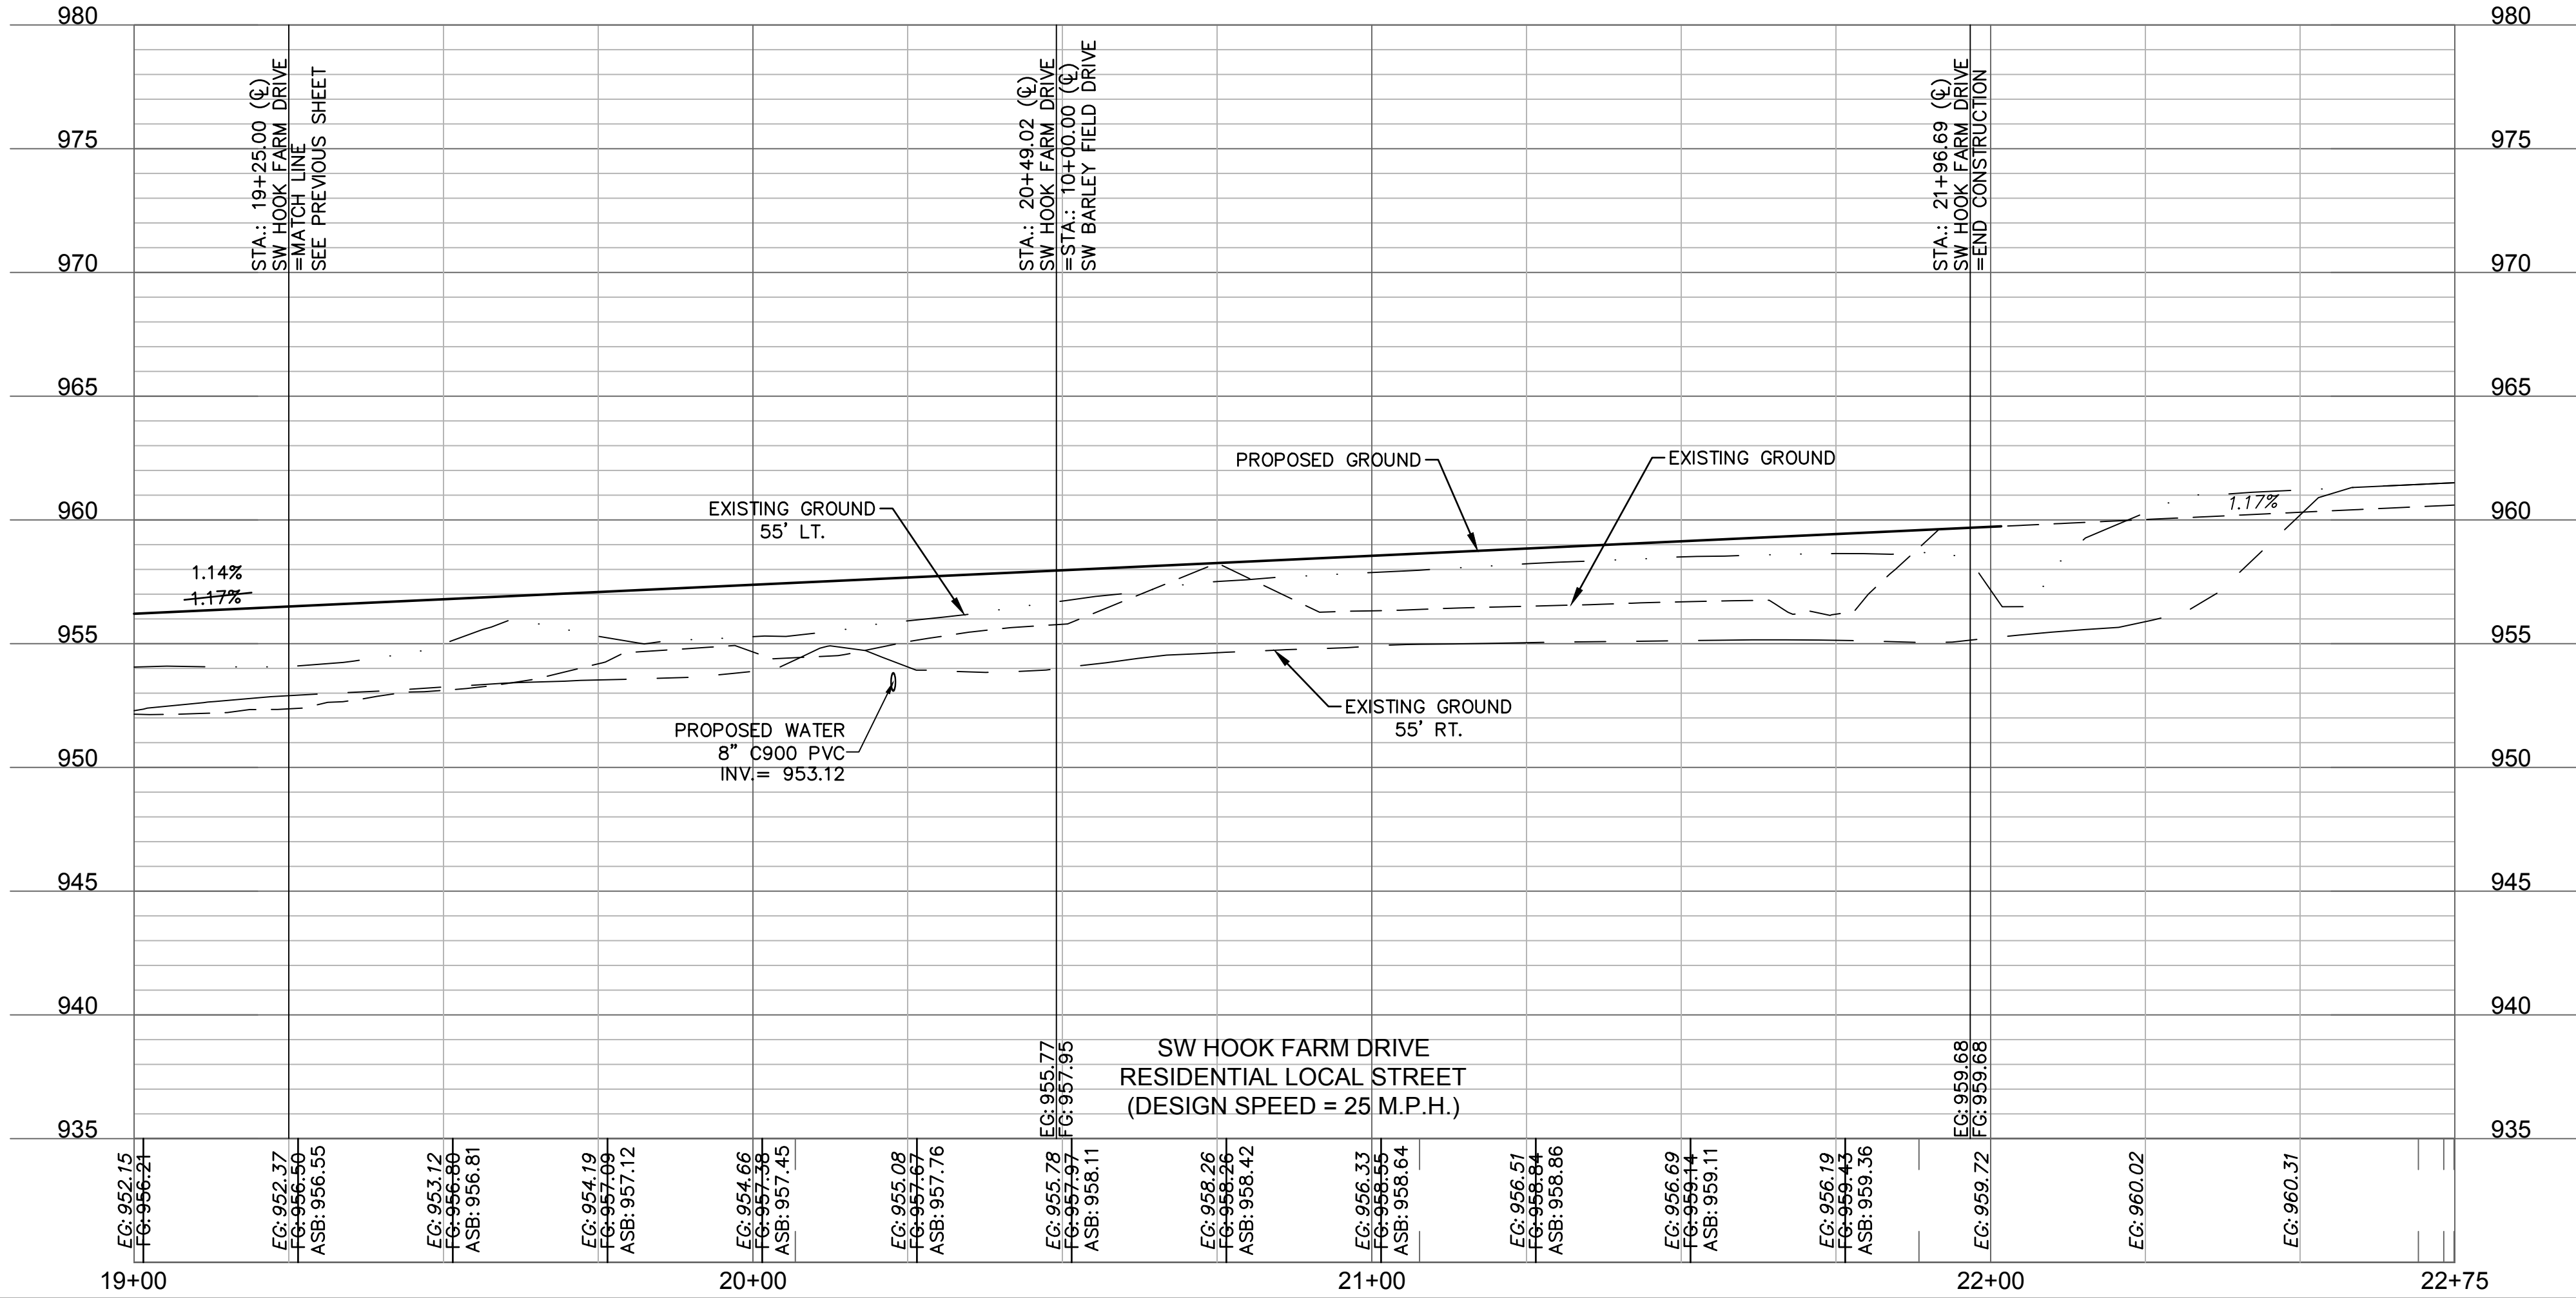

Accepted
Record Drawings

These plans have been reviewed for accuracy and are accepted for basic conformance to the approved construction drawings.

AS BUILT
DATE SURVEYED: 2022-05-26

Olsson - Civil Engineering
Missouri Certificate of Authority #001592
1301 Burlington Street
North Kansas City, MO 64116
TEL 816.361.1177
FAX 816.361.1888
www.olsson.com

JULIE ELAINE SELLERS
NUMBER PE-2017000367
12/7/22
PROFESSIONAL ENGINEER

REVISIONS				2021	
REV. NO.	DATE	REVISIONS DESCRIPTION	BY		
1	03-23-2021	REVISED PER CITY COMMENTS			
2	04-16-2021	REVISED PER CITY COMMENTS			
3	09-30-2021	CHANGES TO APPROVED PLANS			



ROADWAY PLAN & PROFILE (SW HOOK FARM DRIVE)
STREET & STORM SEWER PLANS


HOOK FARMS
SECOND PLAT

LEE'S SUMMIT, MO

drawn by: B.M.W./A.A.
checked by: B.M.W.
designed by: B.M.W./A.A.
QA/QC by: J.E.S.
project no.: B19-4061
date: 01-08-2021

SHEET
C112

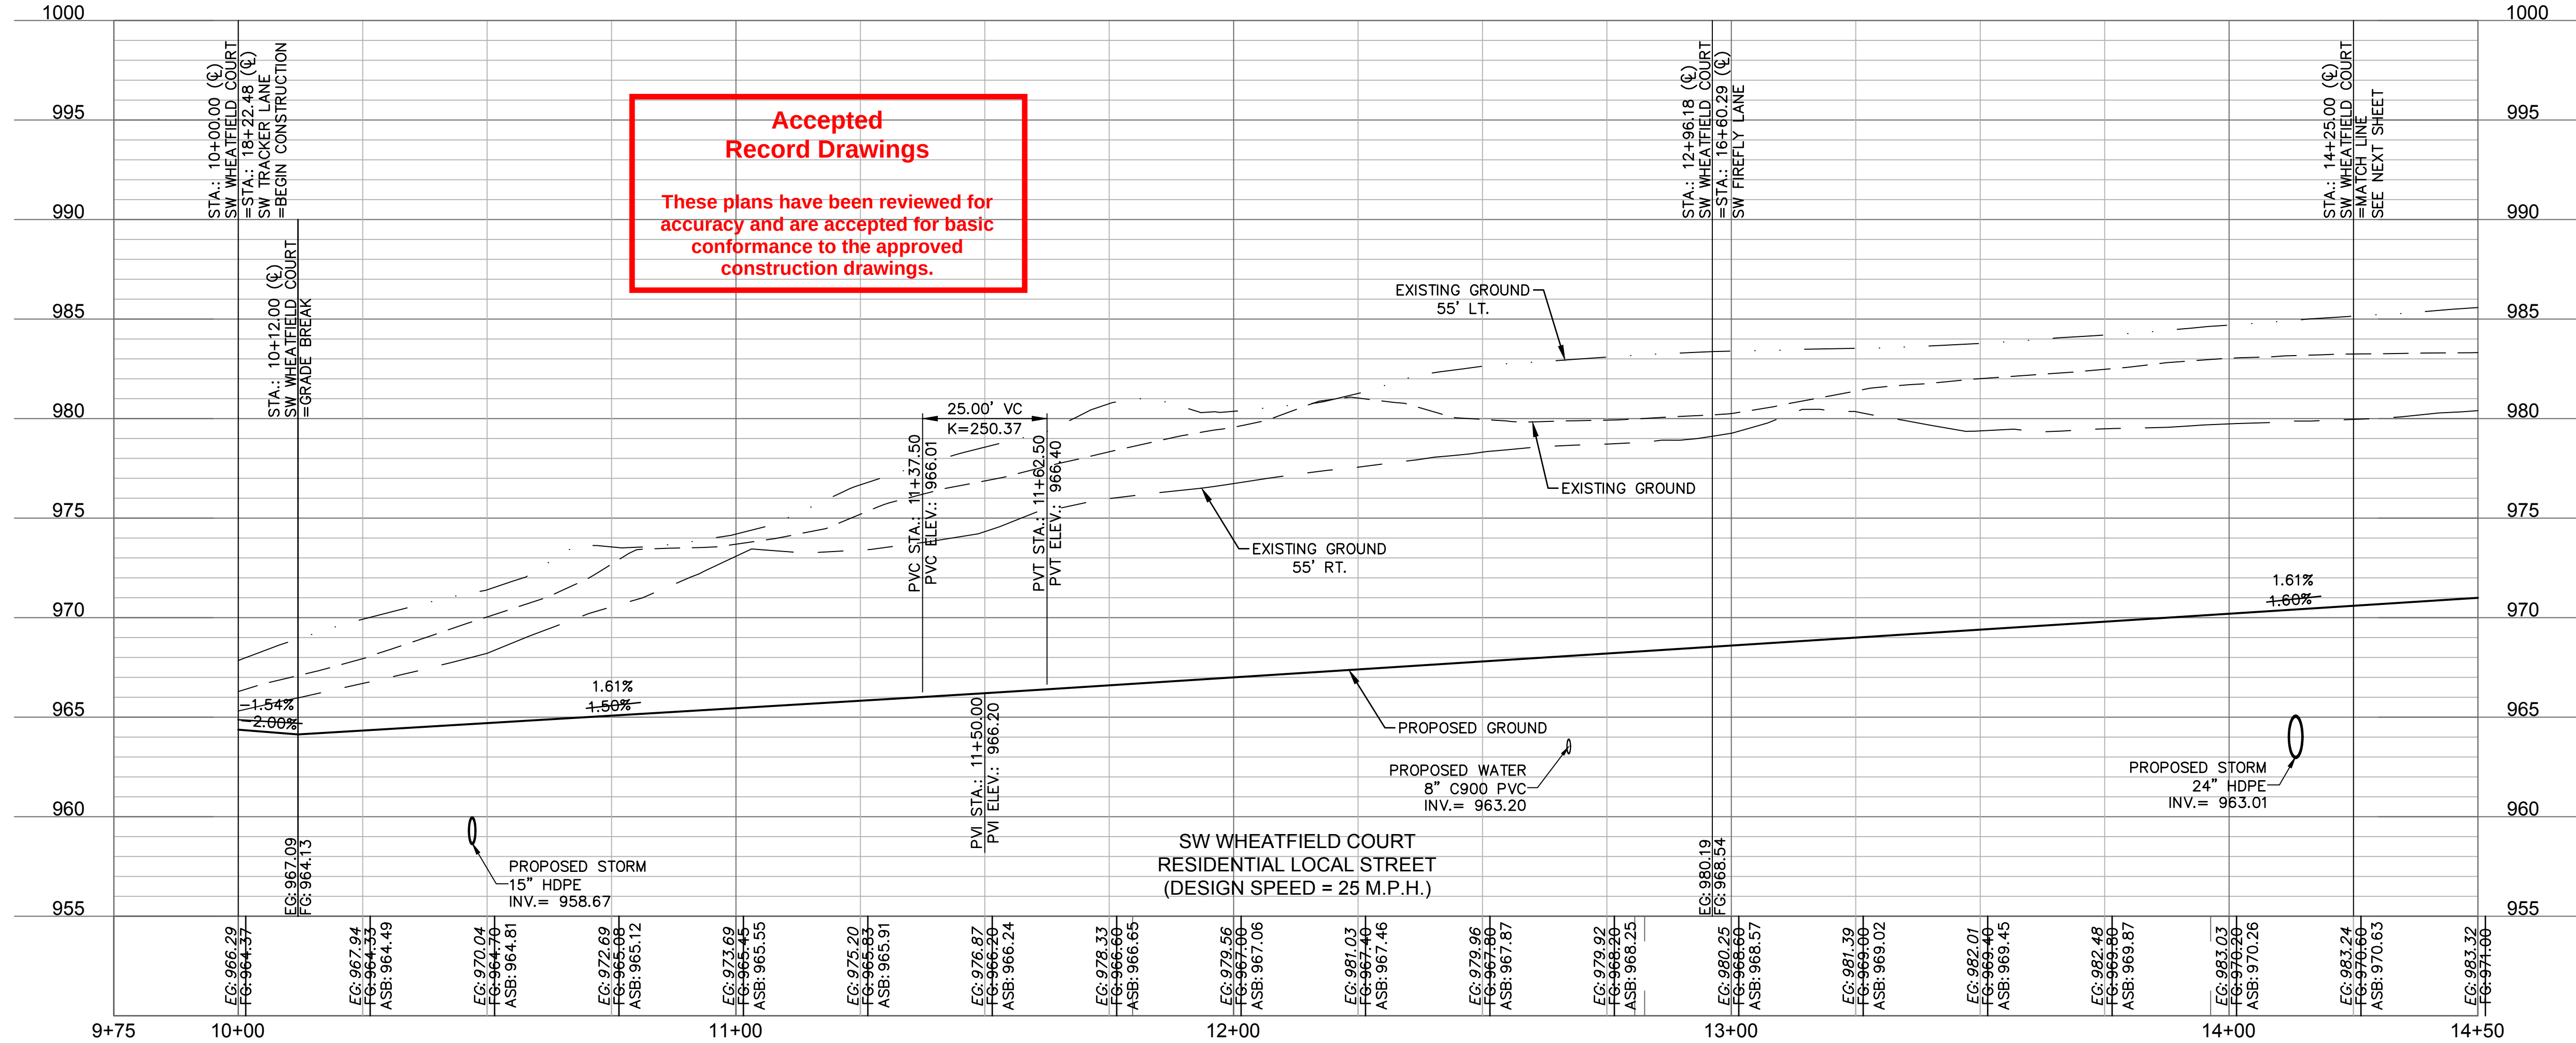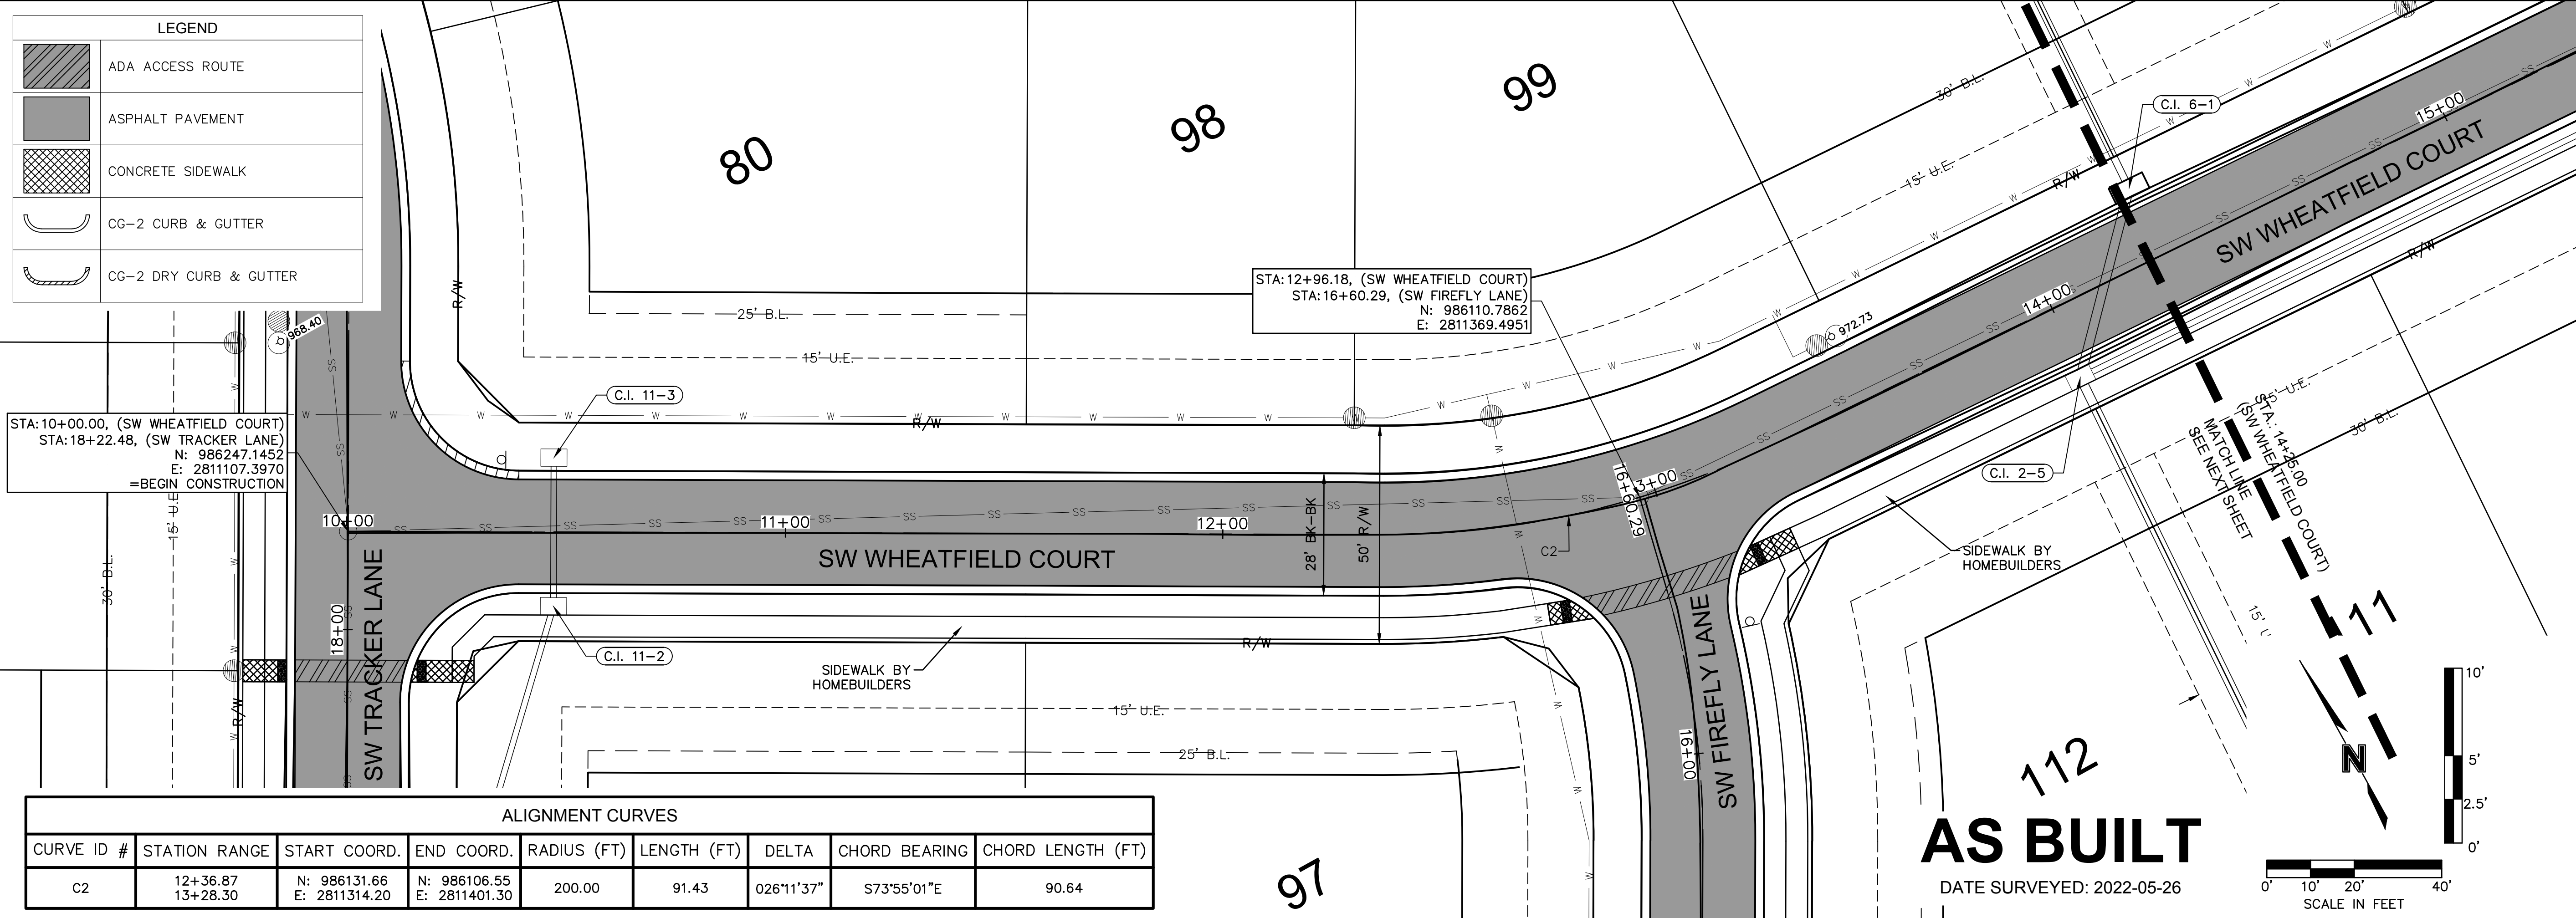

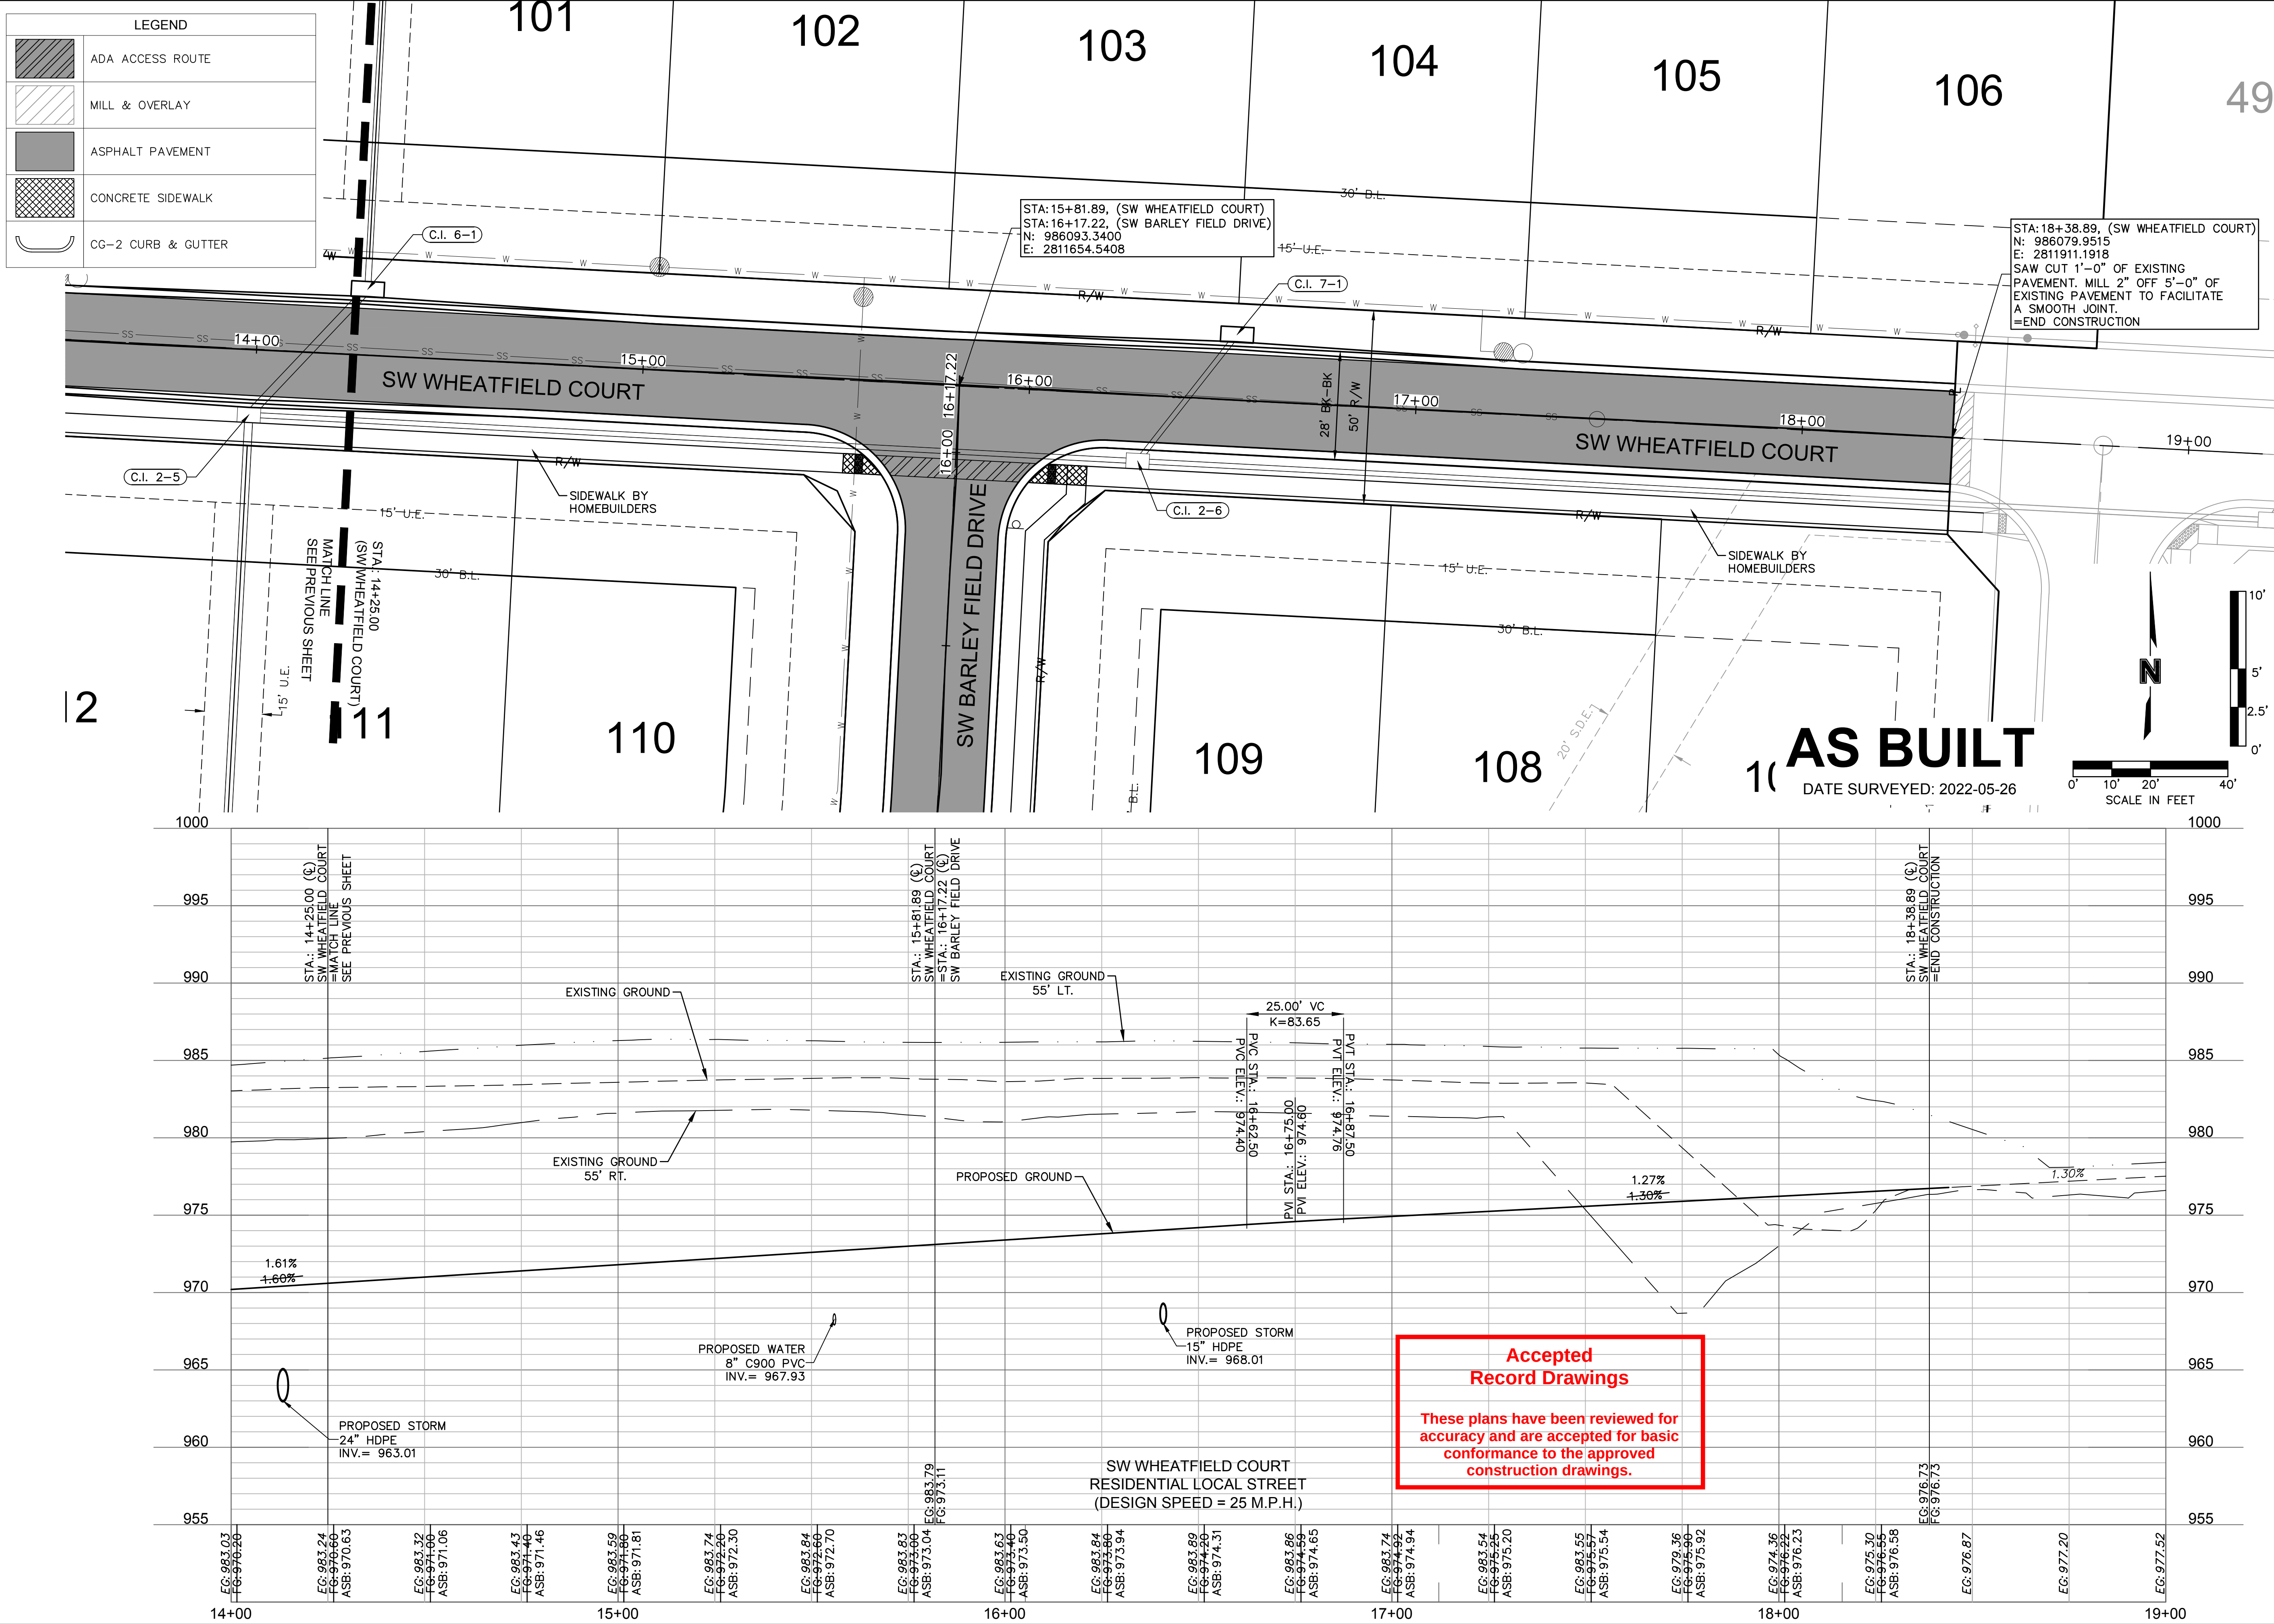

olsson

Olsson - Civil Engineering
Missouri Certificate of Authority #001592
1301 Burlington Street
North Kansas City, MO 64116
TEL 816.361.1177
FAX 816.361.1888
www.olsson.com

STATE OF MISSOURI
JULIE ELAINE SELLERS
NUMBER PE-2017000367
12/7/22
PROFESSIONAL ENGINEER

REV. NO.	DATE	REVISIONS DESCRIPTION	BY
1	03-23-2021	REVISED PER CITY COMMENTS	
2	04-16-2021	REVISED PER CITY COMMENTS	
3	09-30-2021	CHANGES TO APPROVED PLANS	

ROADWAY PLAN & PROFILE (SW WHEATFIELD COURT)
STREET & STORM SEWER PLANS


HOOK FARMS
SECOND PLAT

LEE'S SUMMIT, MO

2021

drawn by: B.M.W./A.A.
checked by: B.M.W./A.A.
designed by: B.M.W./A.A.
QA/QC by: J.E.S.
project no.: B19-4061
date: 01-08-2021




SHEET C114

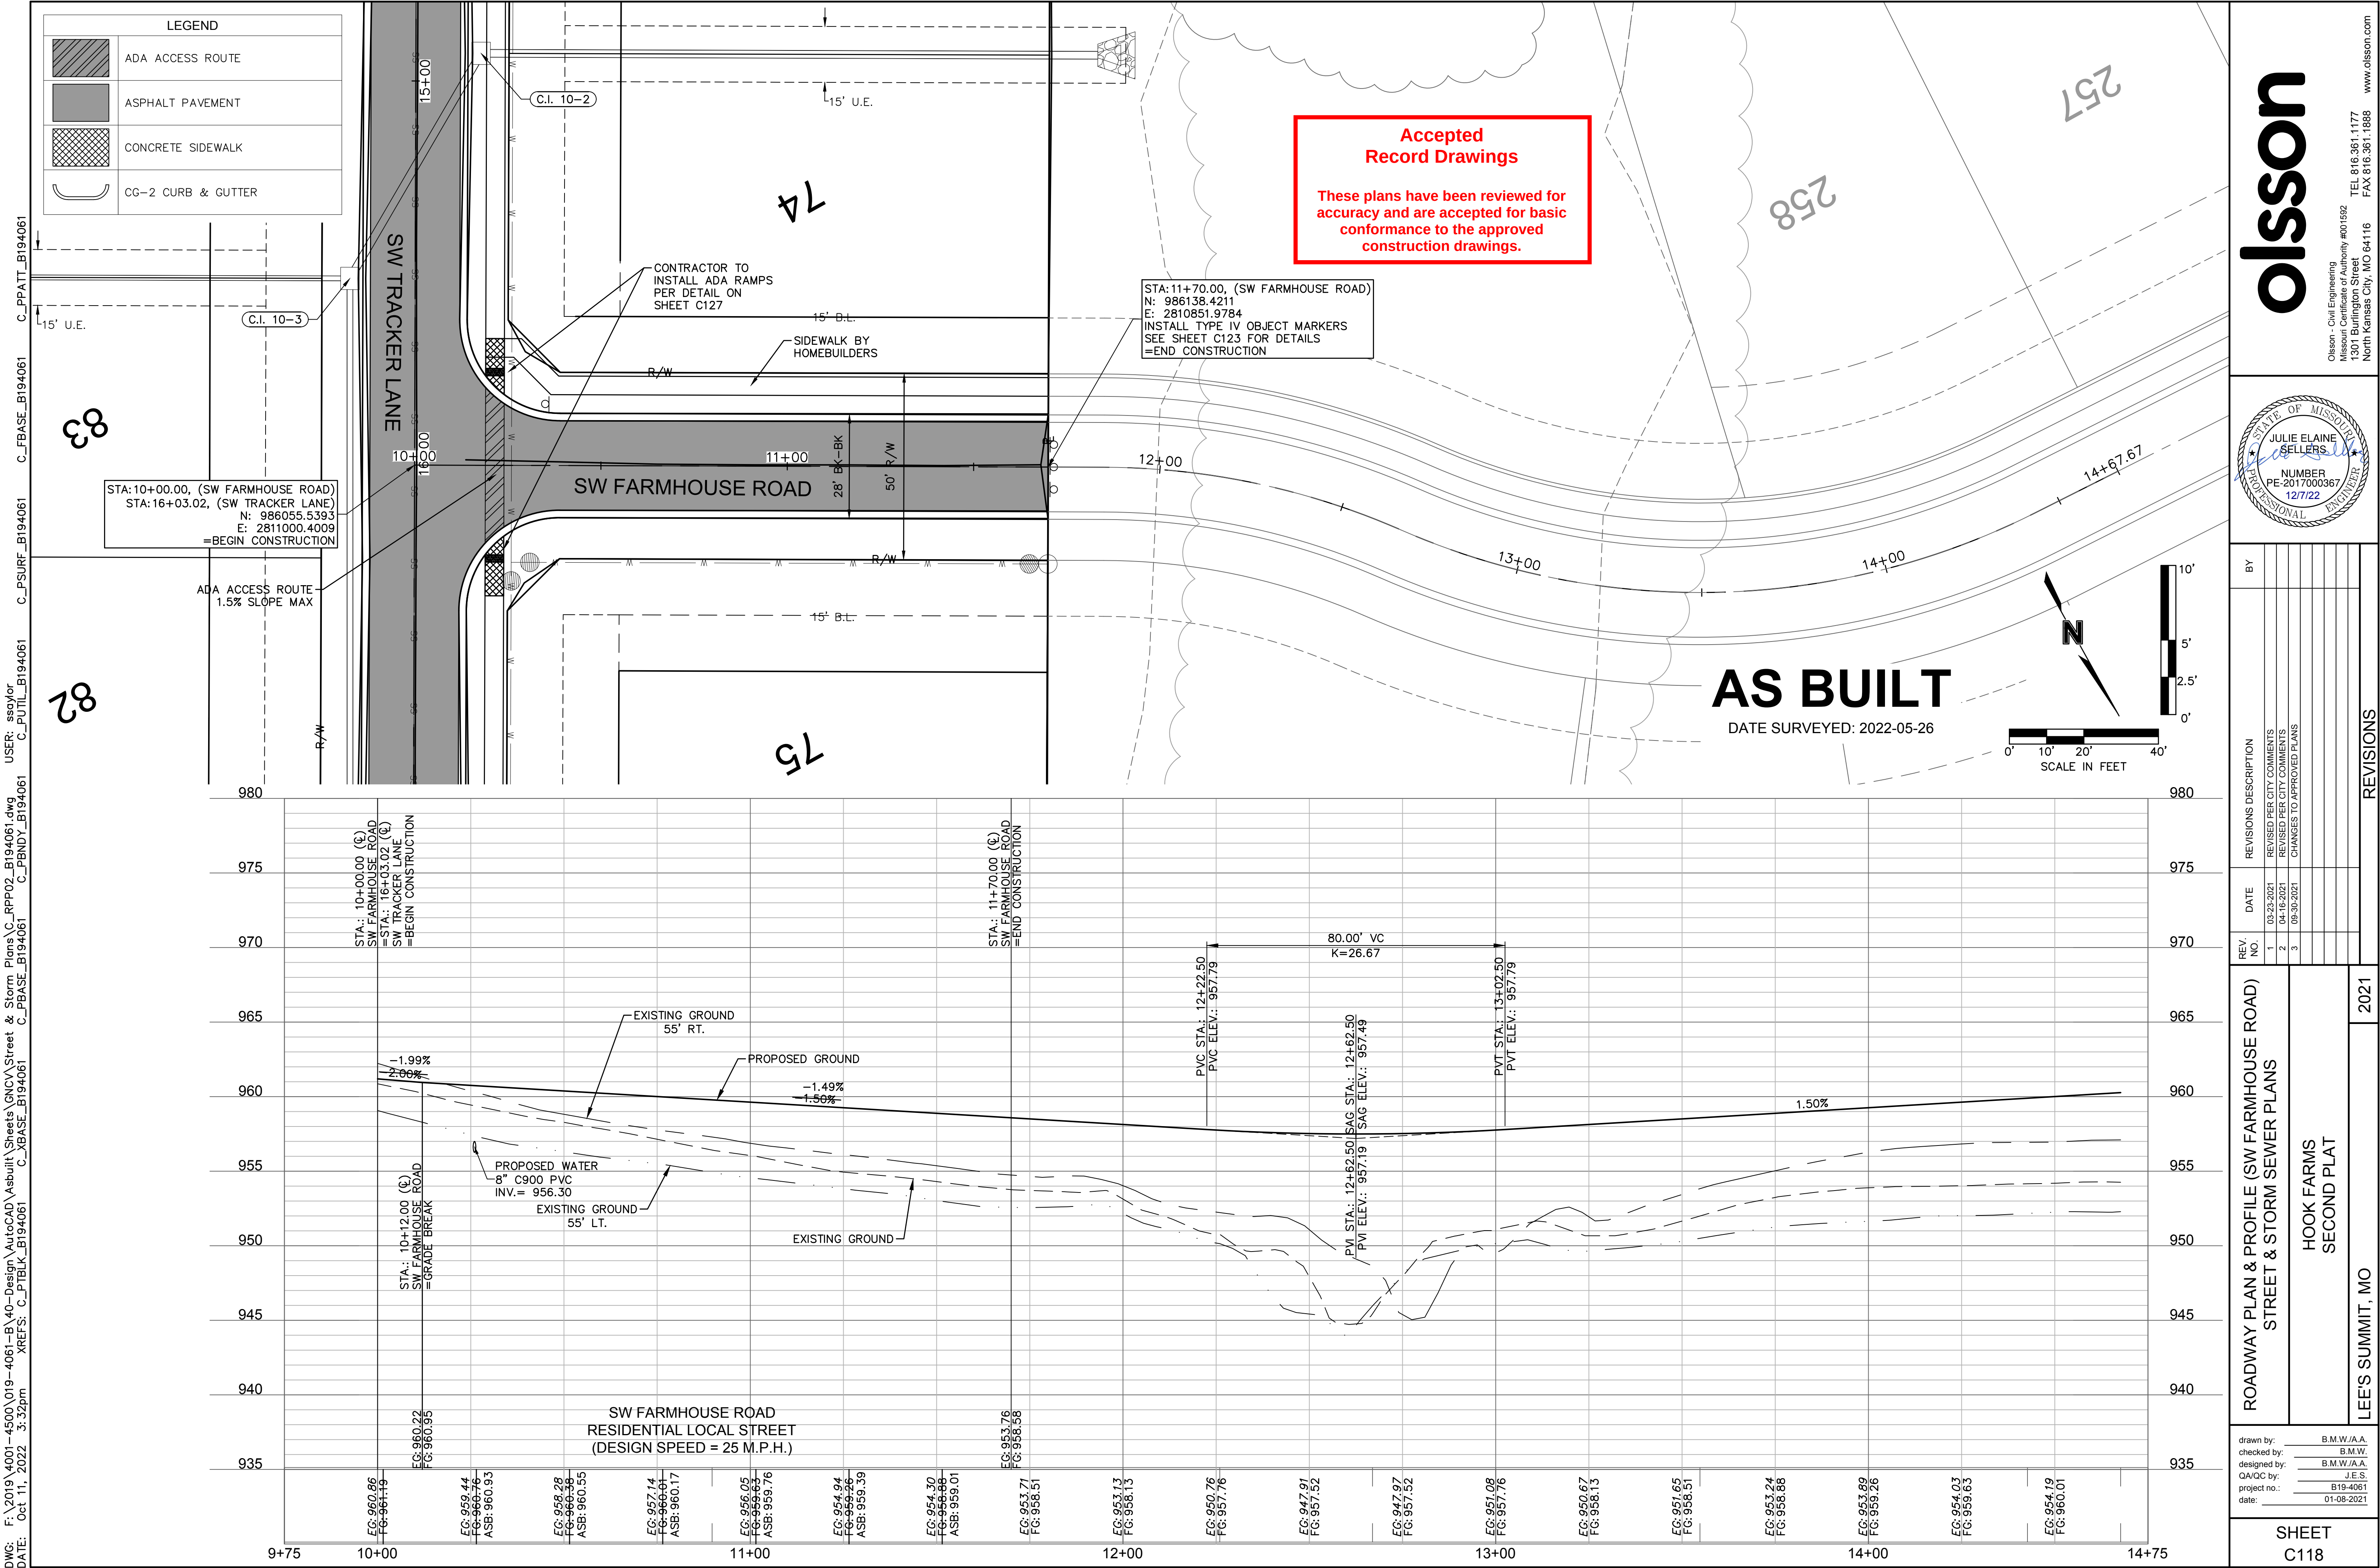

DWG: F:\2019\4001-4500\019-4061-BV40-Design\AutoCAD\Asbuilt\Sheets\GNCV\Street & Storm Plans\C_RPP03_B194061.dwg
DATE: Oct 11, 2022 3:33pm XREFS: C_PTBK_B194061 C_XBASE_B194061 C_PBASE_B194061 C_PBDY_B194061 C_PUTIL_B194061 C_PSURF_B194061 C_FBASE_B194061 C_PPATT_B194061 USER: ssaylor

LEGEND	
	ADA ACCESS ROUTE
	ASPHALT PAVEMENT
	CONCRETE SIDEWALK
	CG-2 CURB & GUTTER
	CG-2 DRY CURB & GUTTER

ALIGNMENT CURVES								
CURVE ID #	STATION RANGE	START COORD. N: 985553.66 E: 2811103.39	END COORD. N: 985669.56 E: 2811139.92	RADIUS (FT)	LENGTH (FT)	DELTA	CHORD BEARING	CHORD LENGTH (FT)
C1	10+39.03 11+61.40			300.00	122.37	023°22'17"	N17°29'39"E	121.53

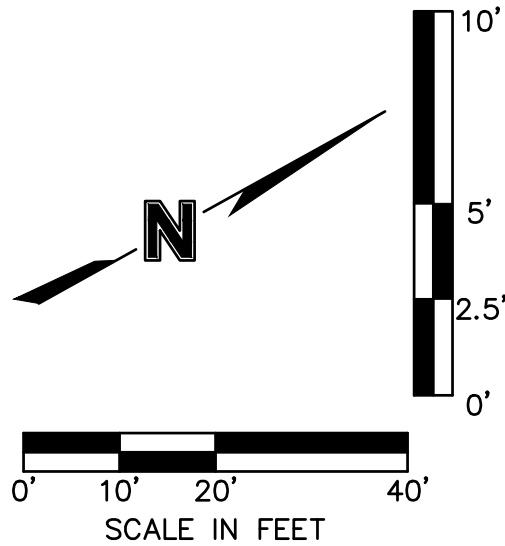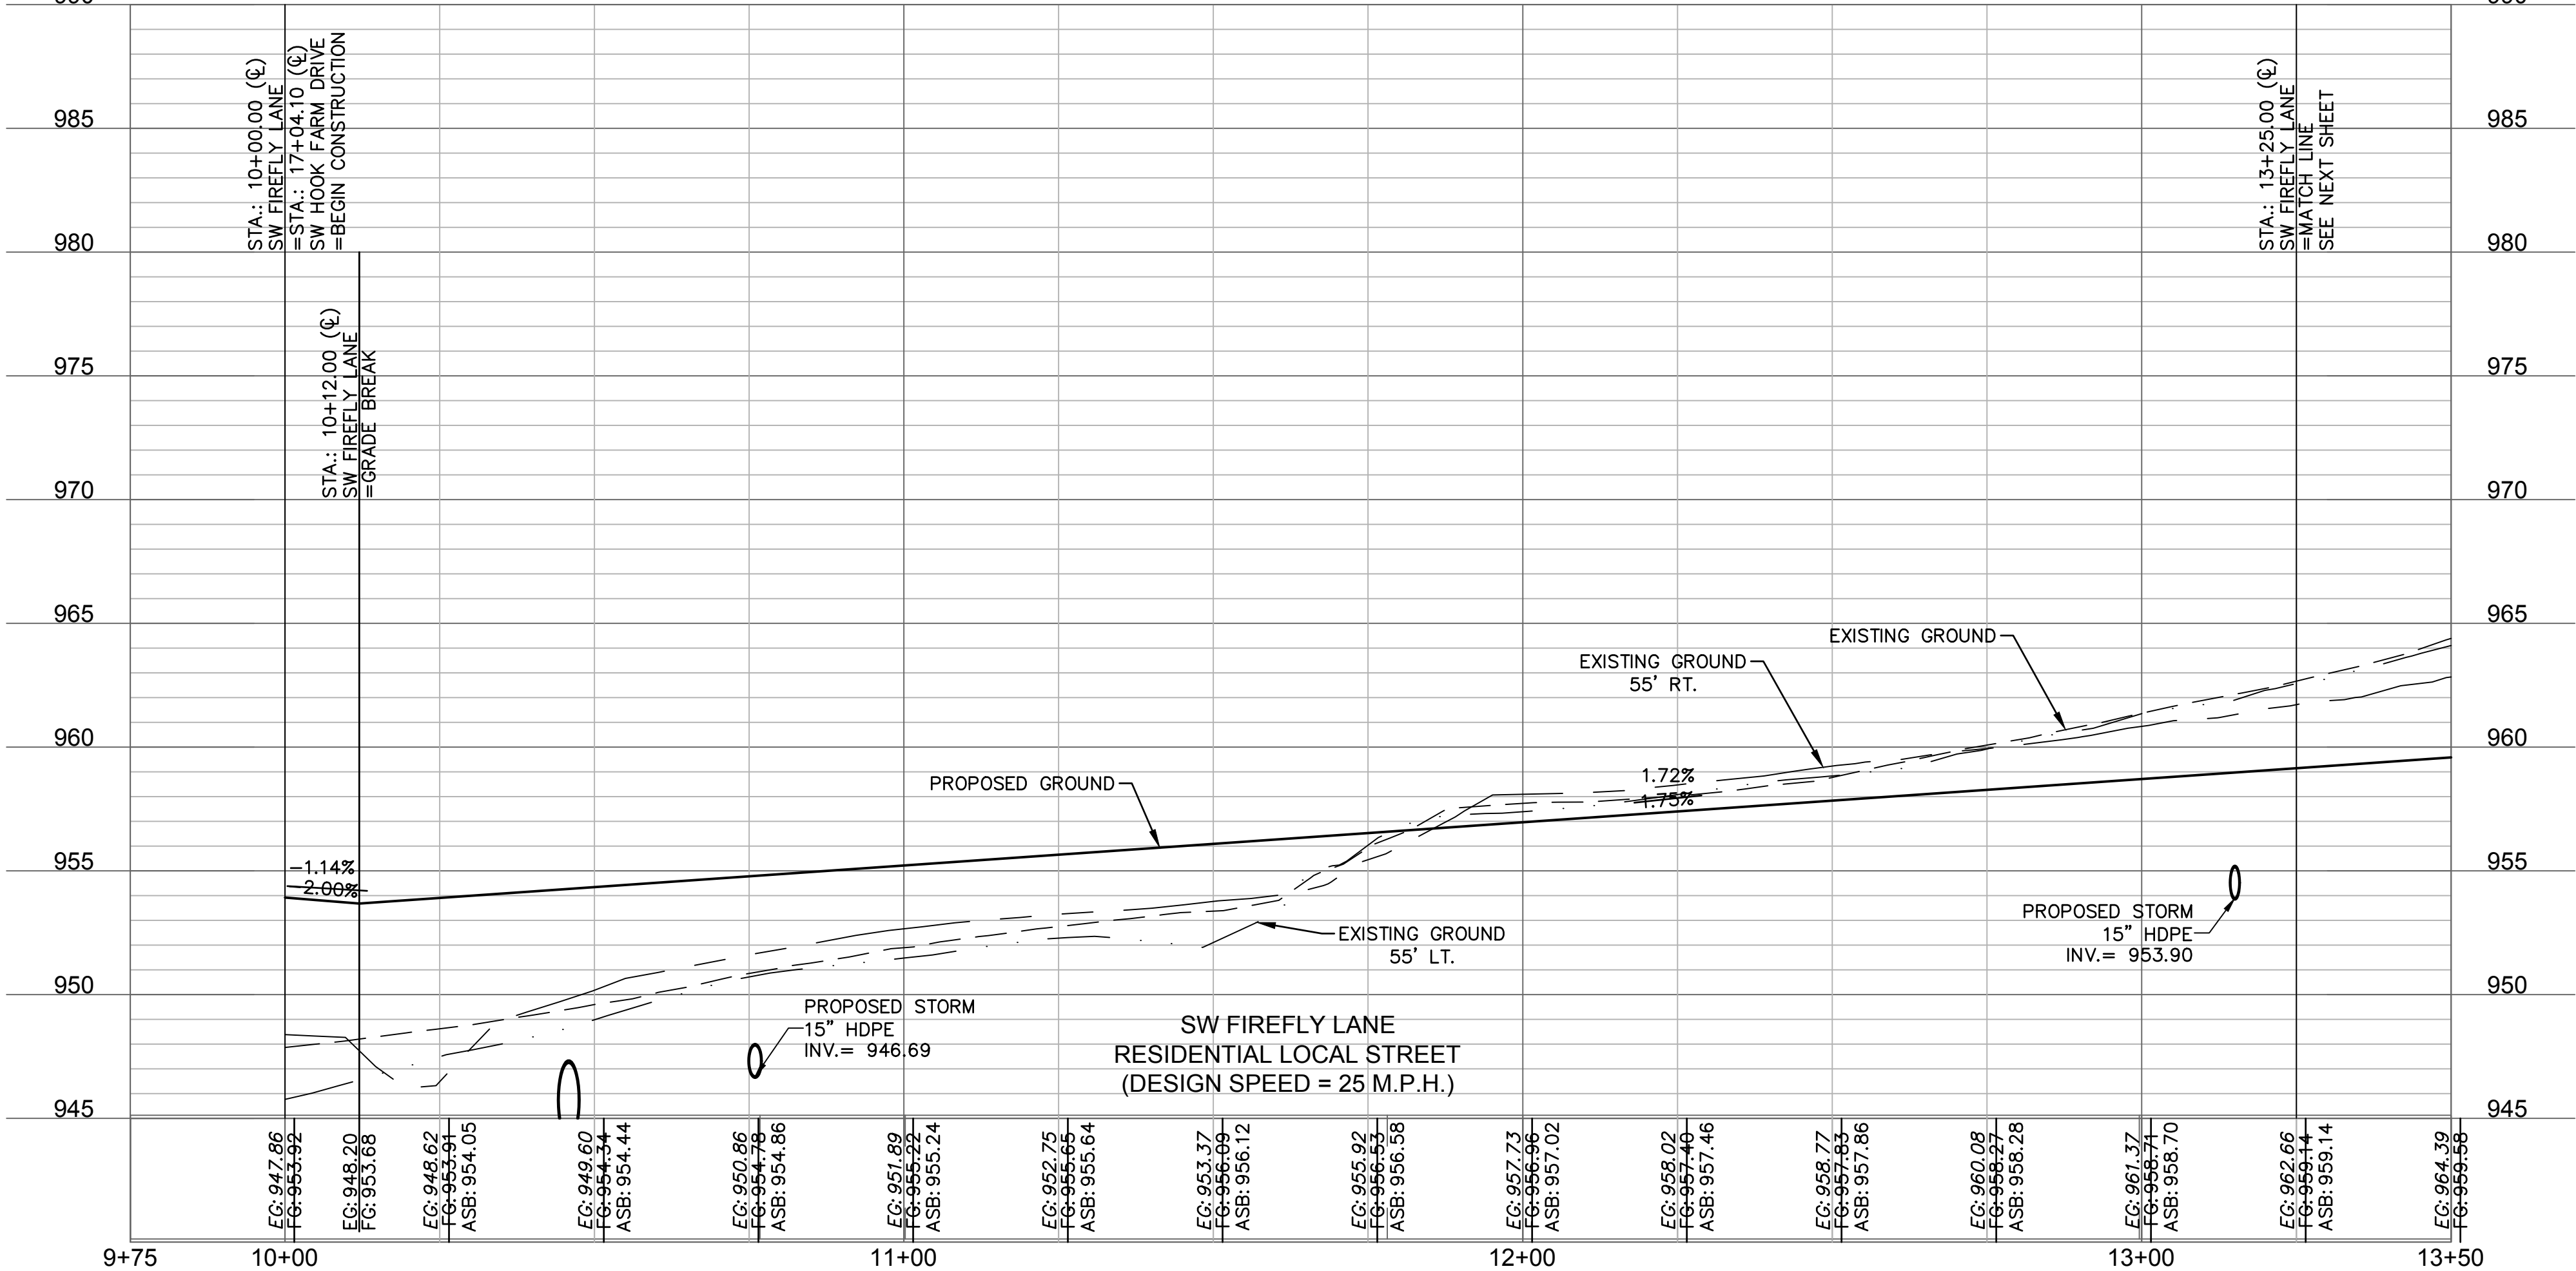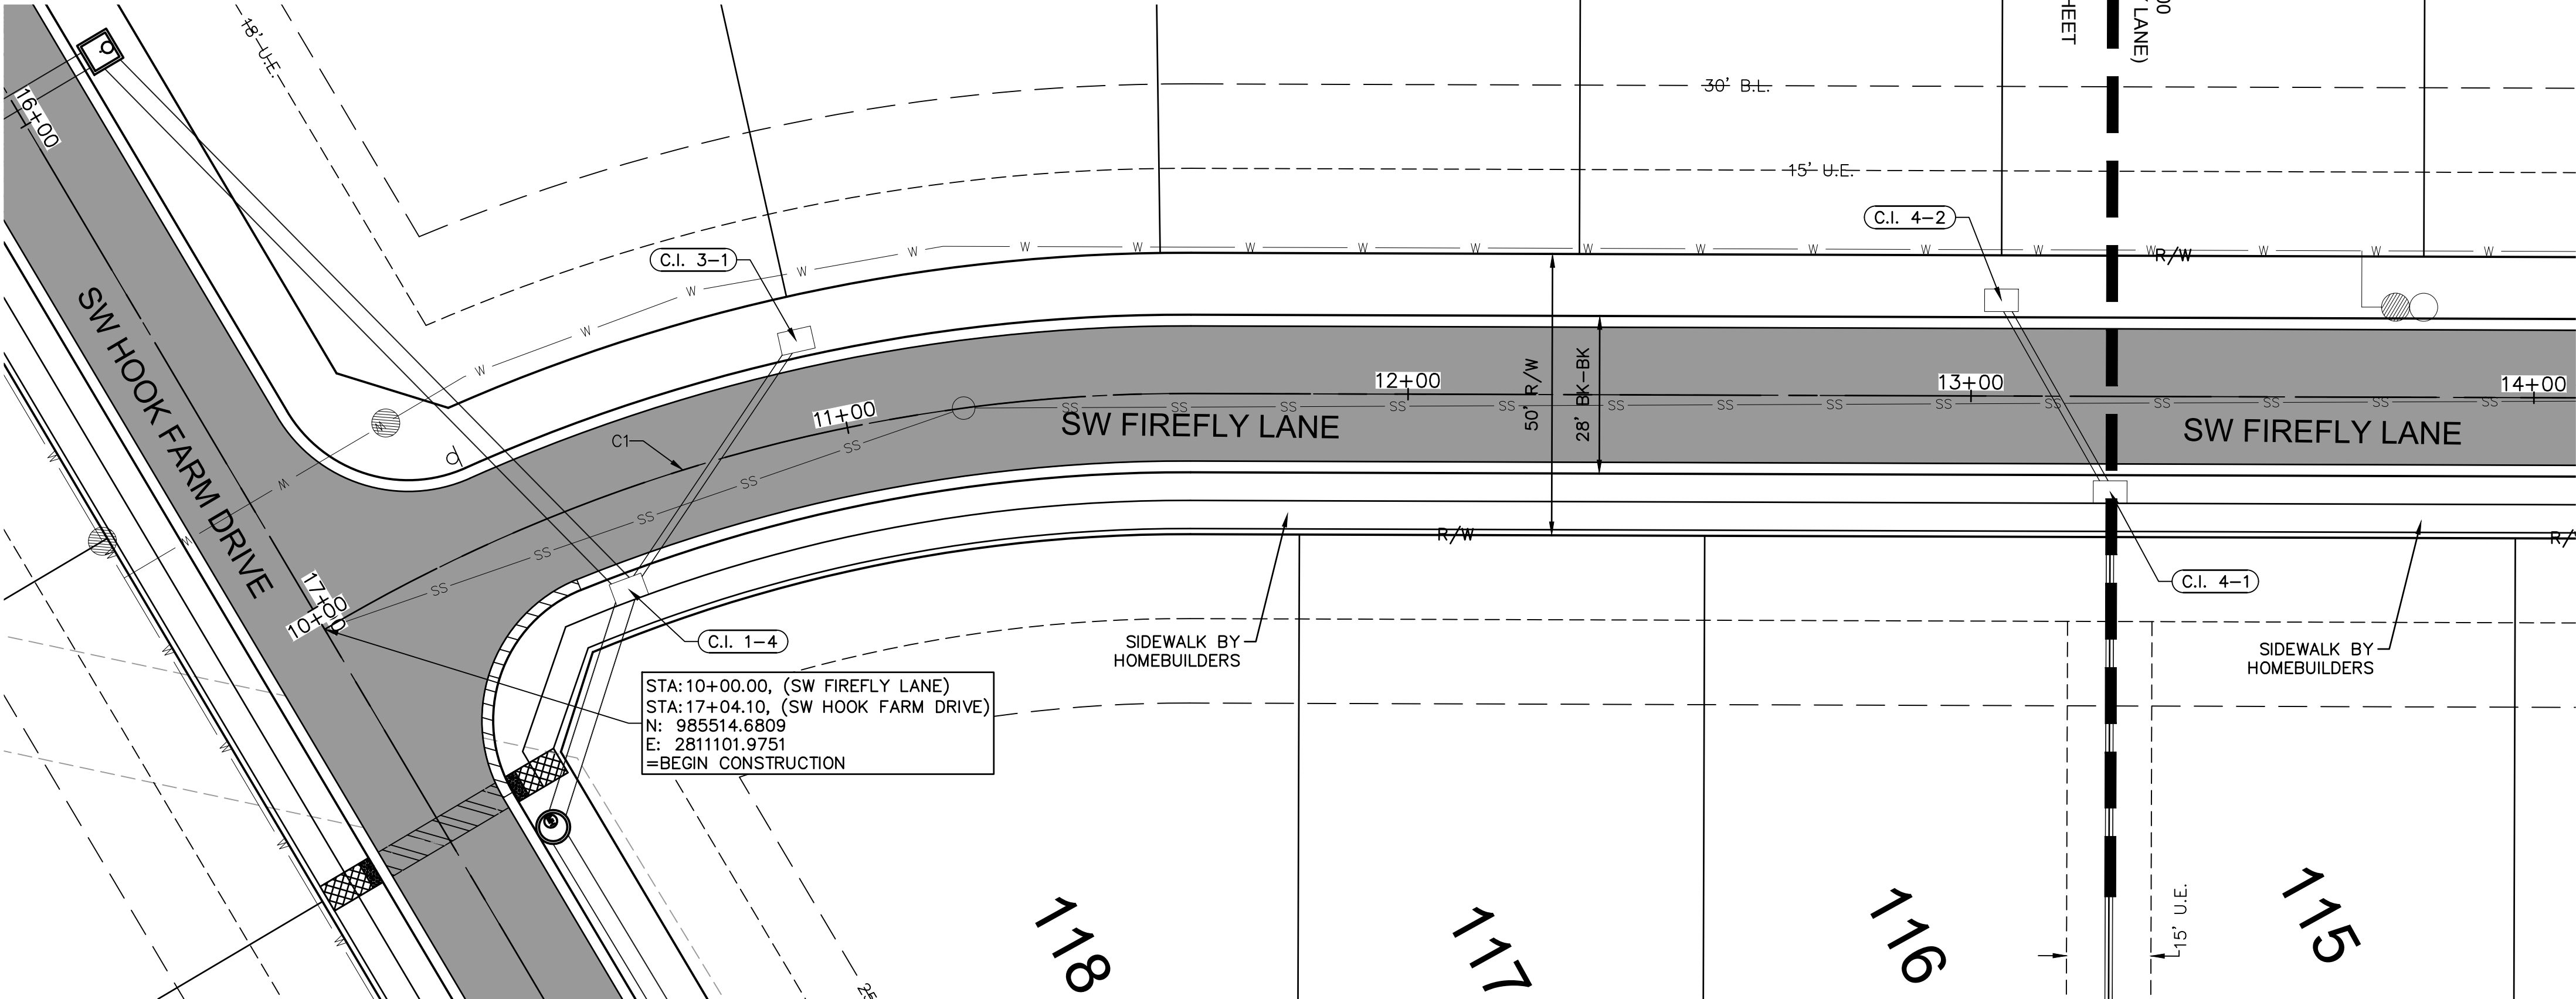

AS BUILT
DATE SURVEYED: 2022-05-26

**Accepted
Record Drawings**

These plans have been reviewed for accuracy and are accepted for basic conformance to the approved construction drawings.

Olsson - Civil Engineering
Missouri Certificate of Authority #001592
1301 Burlington Street
North Kansas City, MO 64116
TEL 816.361.1177
FAX 816.361.1888
www.olsson.com

REV. NO.	DATE	REVISIONS DESCRIPTION
1	03-23-2021	REVISED PER CITY COMMENTS
2	04-16-2021	REVISED PER CITY COMMENTS
3	09-30-2021	CHANGES TO APPROVED PLANS

BY	
DATE	
REVISIONS	




ROADWAY PLAN & PROFILE (SW FIREFLY LANE)
STREET & STORM SEWER PLANS


HOOK FARMS
SECOND PLAT

LEE'S SUMMIT, MO


drawn by: B.M.W./A.A.
checked by: B.M.W.
designed by: B.M.W./A.A.
QA/QC by: J.E.S.
project no.: B19-4061
date: 01-08-2021

SHEET
C119

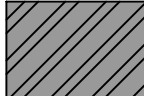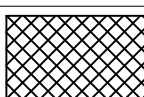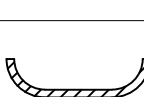LEGEND	
	ADA ACCESS ROUTE
	ASPHALT PAVEMENT
	CONCRETE SIDEWALK
	CG-2 CURB & GUTTER
	CG-2 DRY CURB & GUTTER

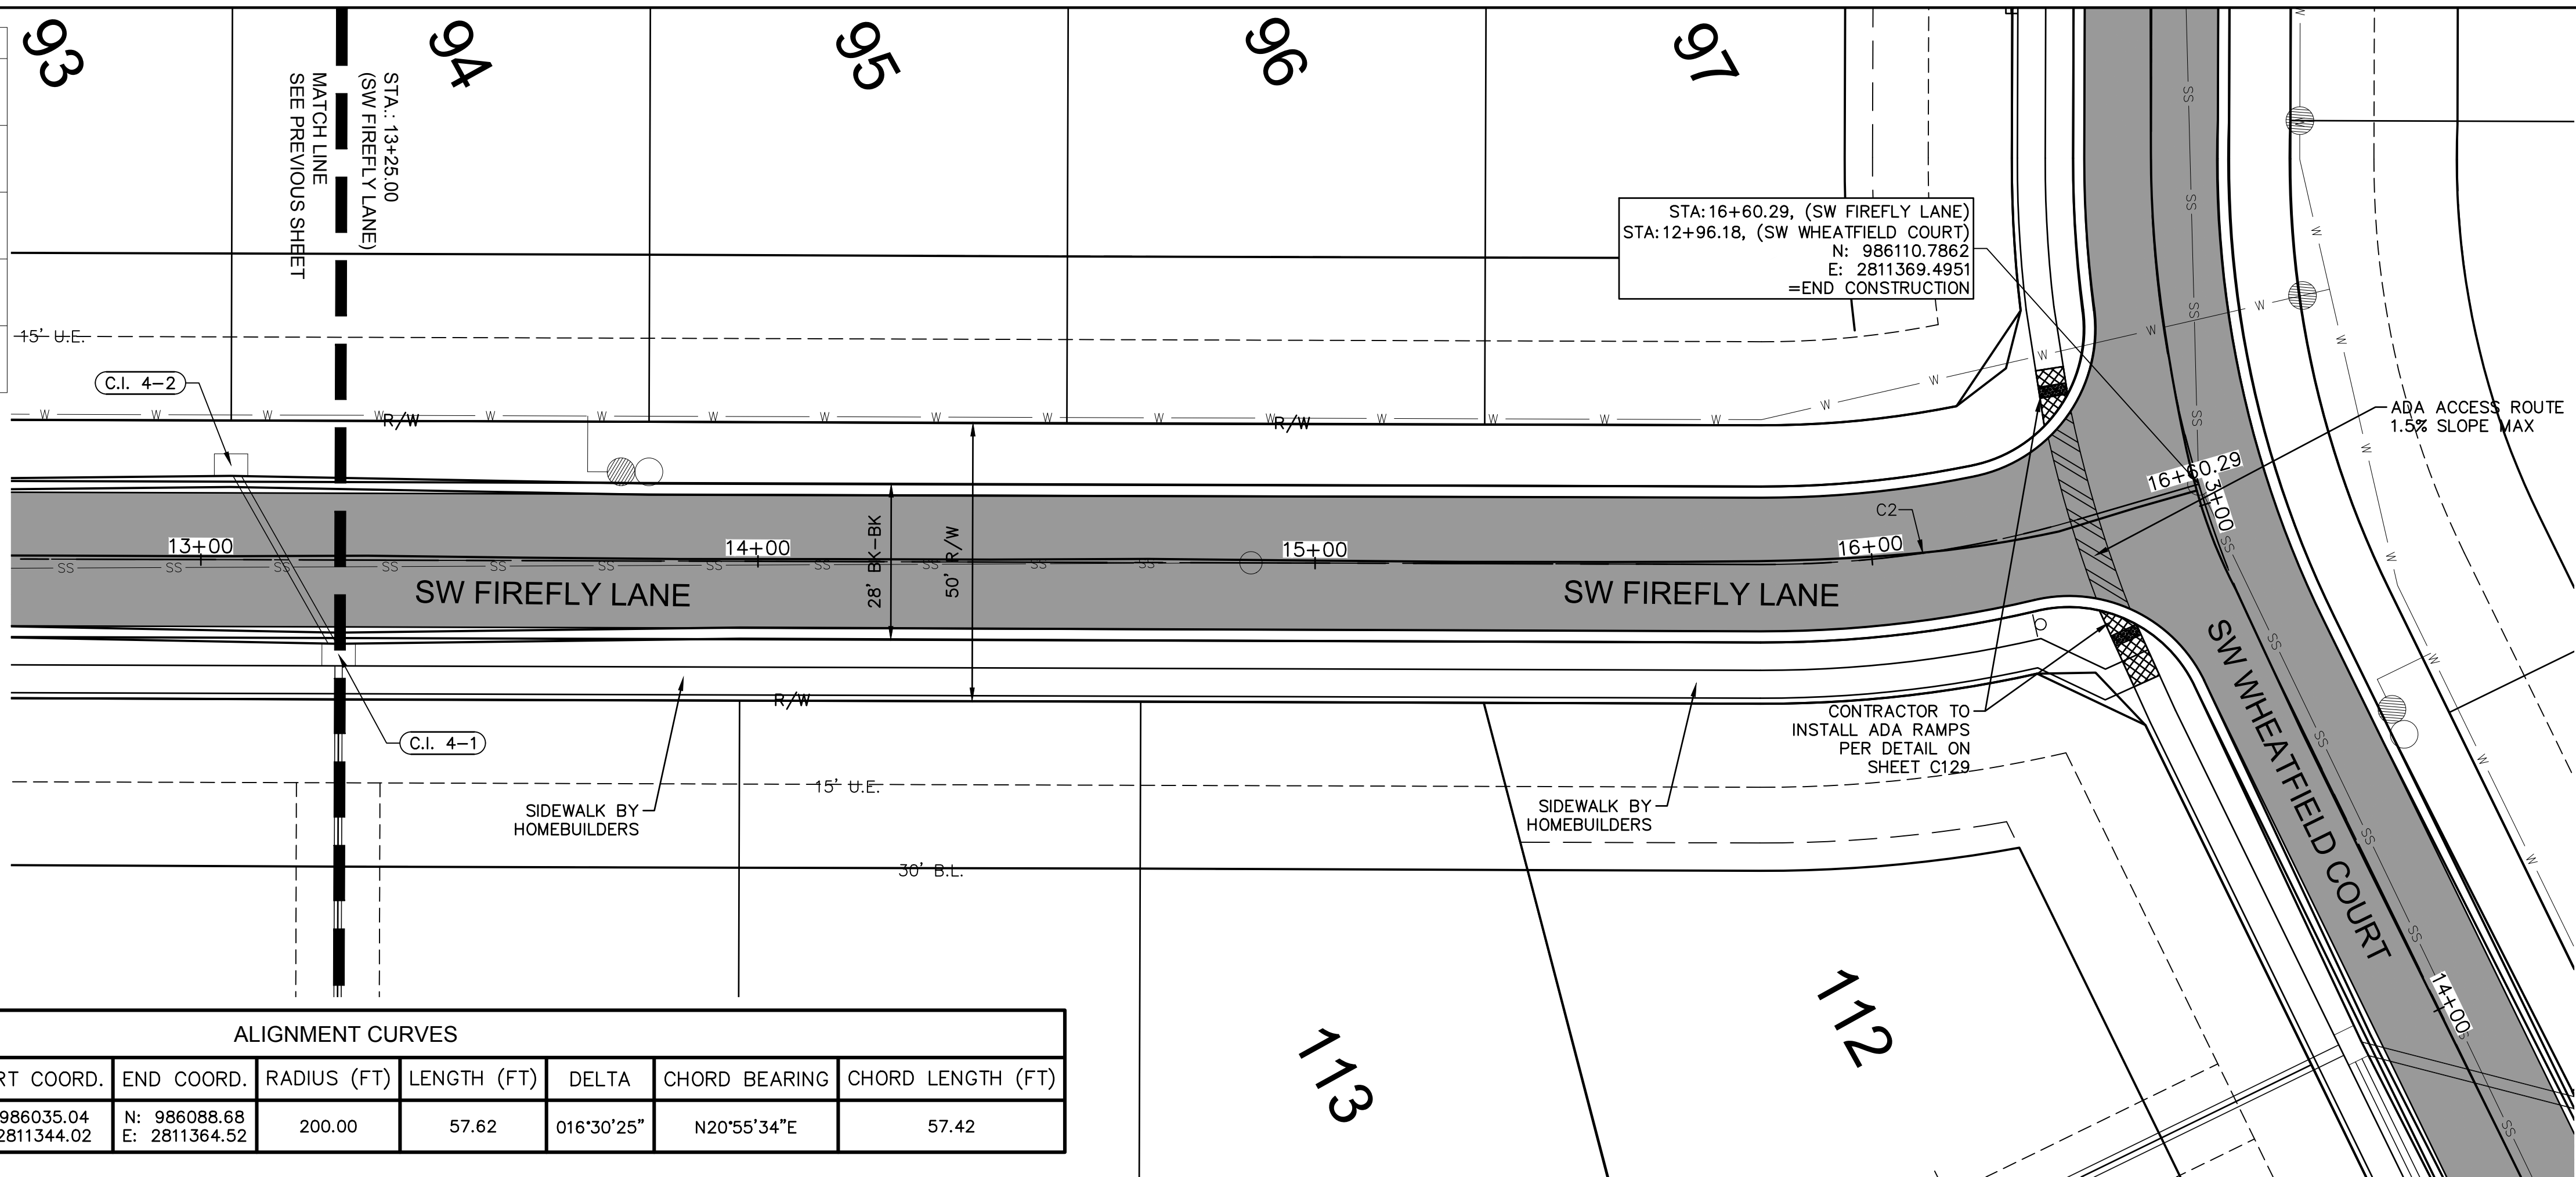

ALIGNMENT CURVES								
CURVE ID #	STATION RANGE	START COORD.	END COORD.	RADIUS (FT)	LENGTH (FT)	DELTA	CHORD BEARING	CHORD LENGTH (FT)
C2	15+80.01 16+37.63	N: 986035.04 E: 2811344.02	N: 986088.68 E: 2811364.52	200.00	57.62	016°30'25"	N20°55'34"E	57.42

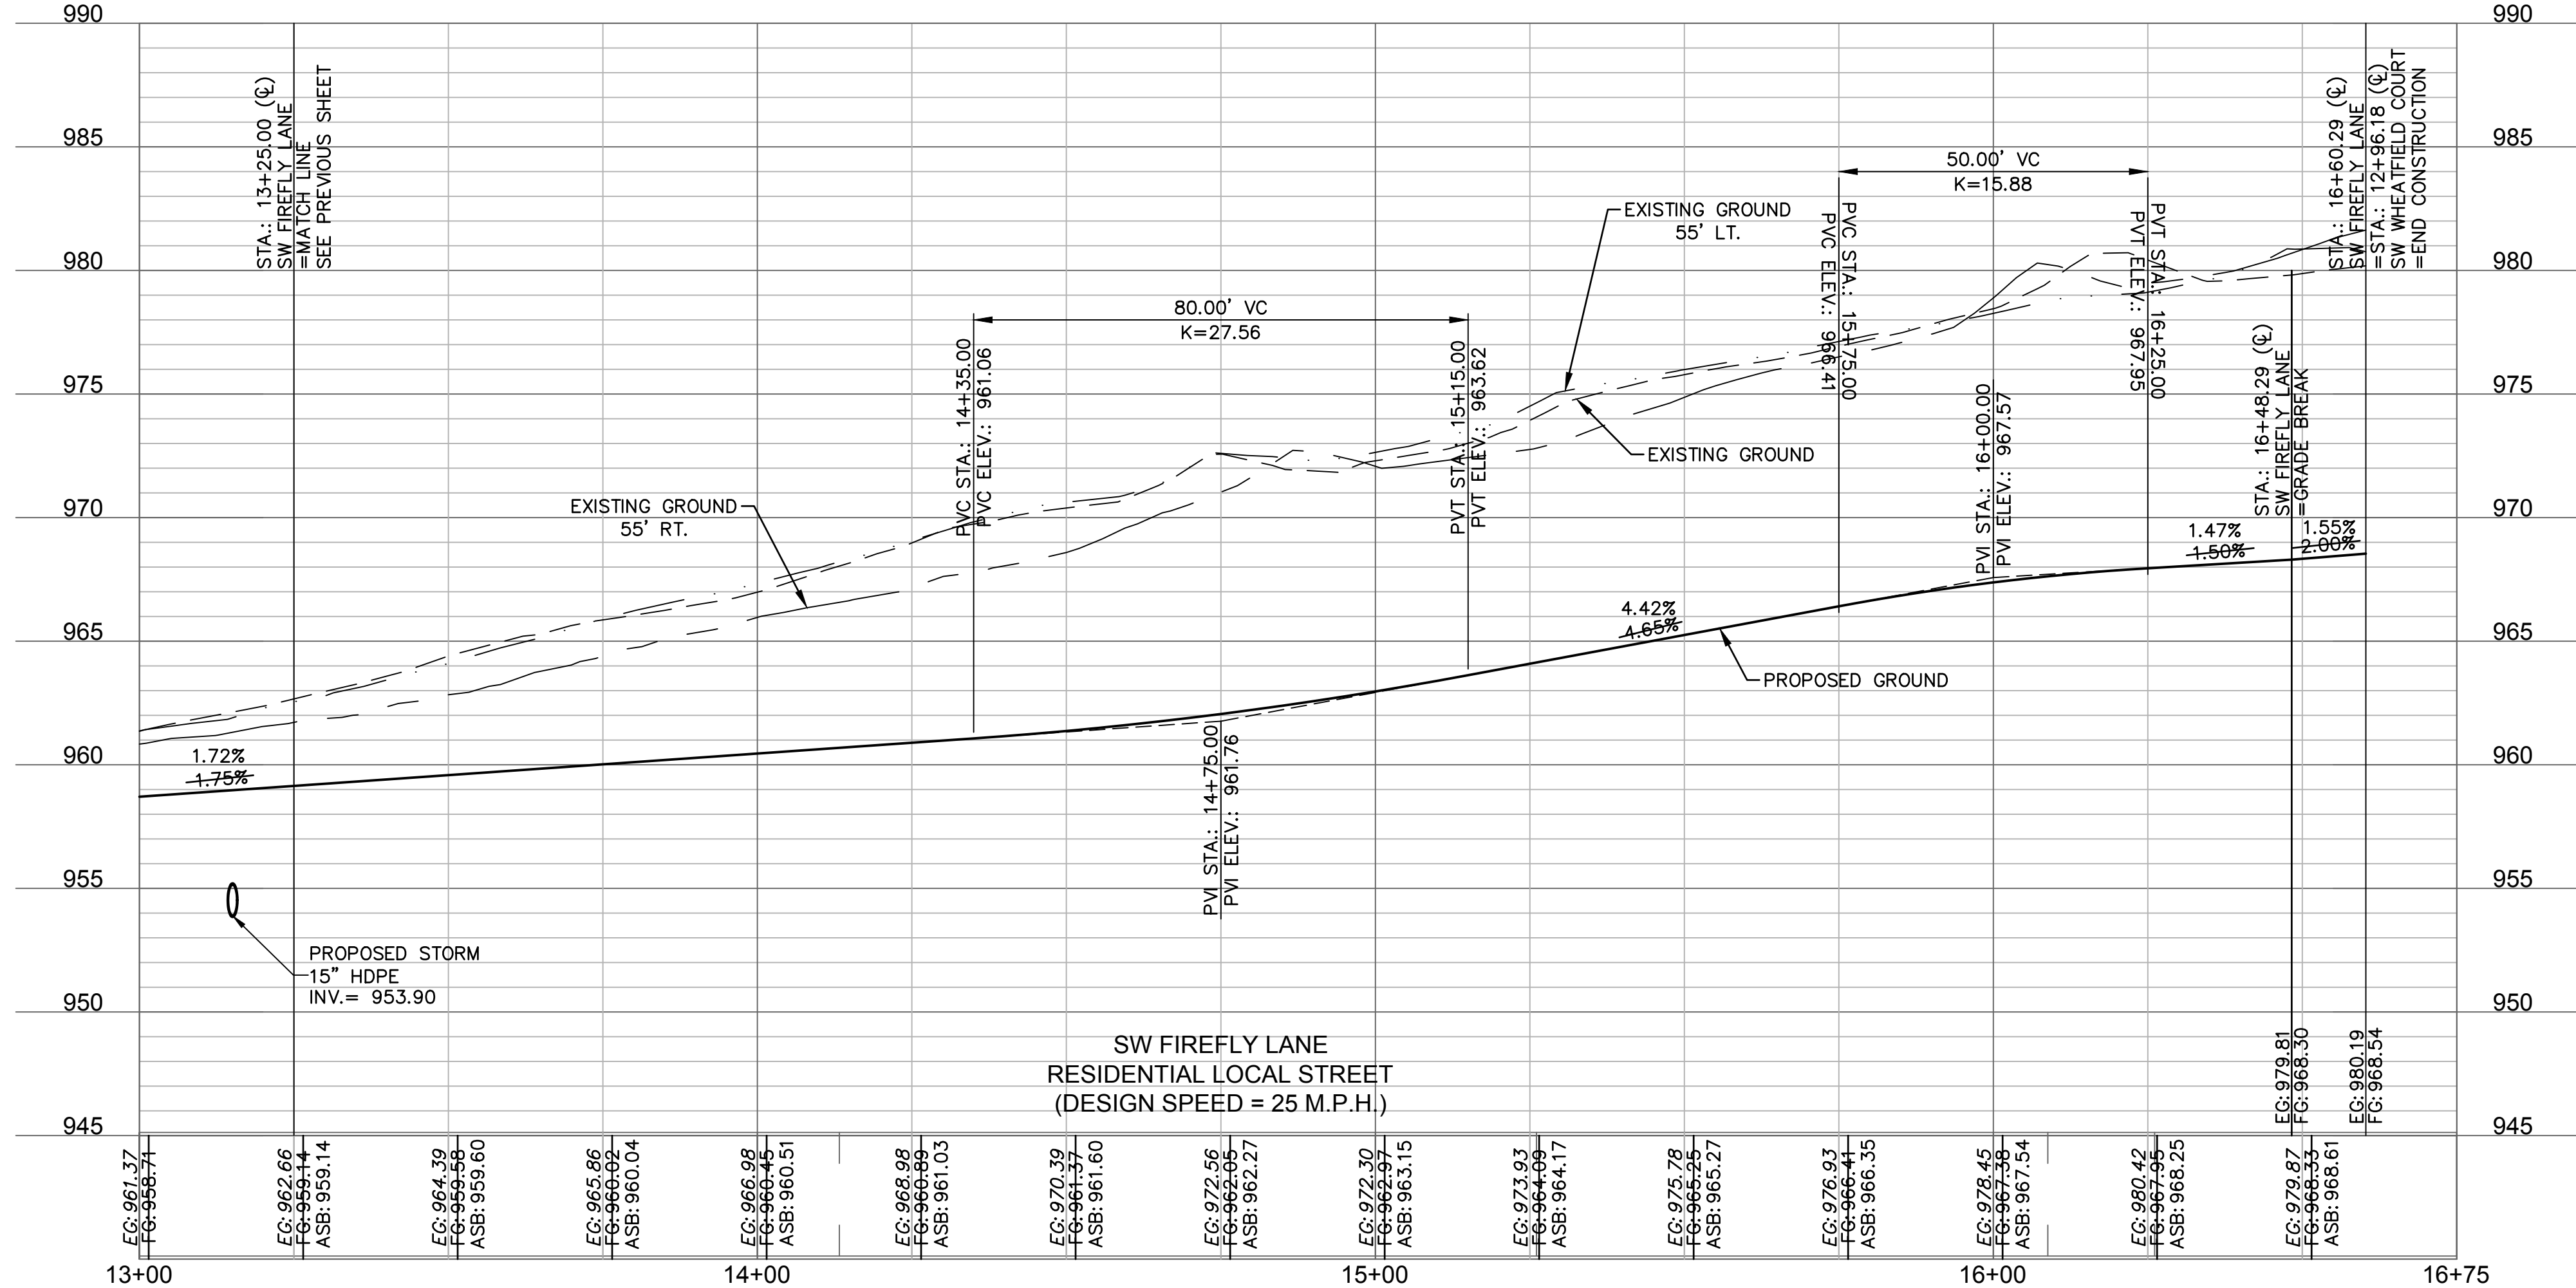


**Accepted
Record Drawings**


These plans have been reviewed for accuracy and are accepted for basic conformance to the approved construction drawings.

AS BUILT

DATE SURVEYED: 2022-05-26

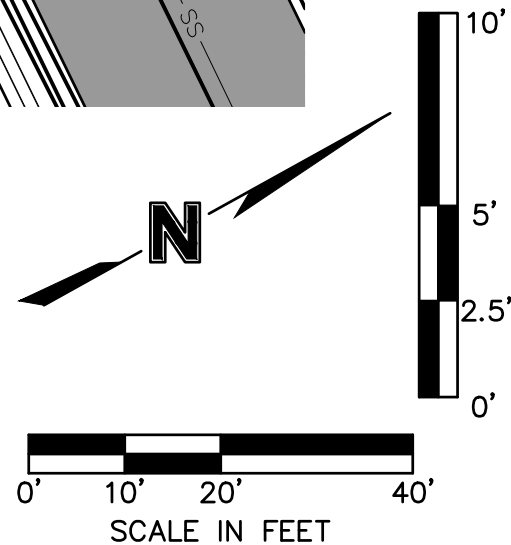

LEGEND	
	ADA ACCESS ROUTE
	ASPHALT PAVEMENT
	CONCRETE SIDEWALK
	CG-2 CURB & GUTTER
	CG-2 DRY CURB & GUTTER


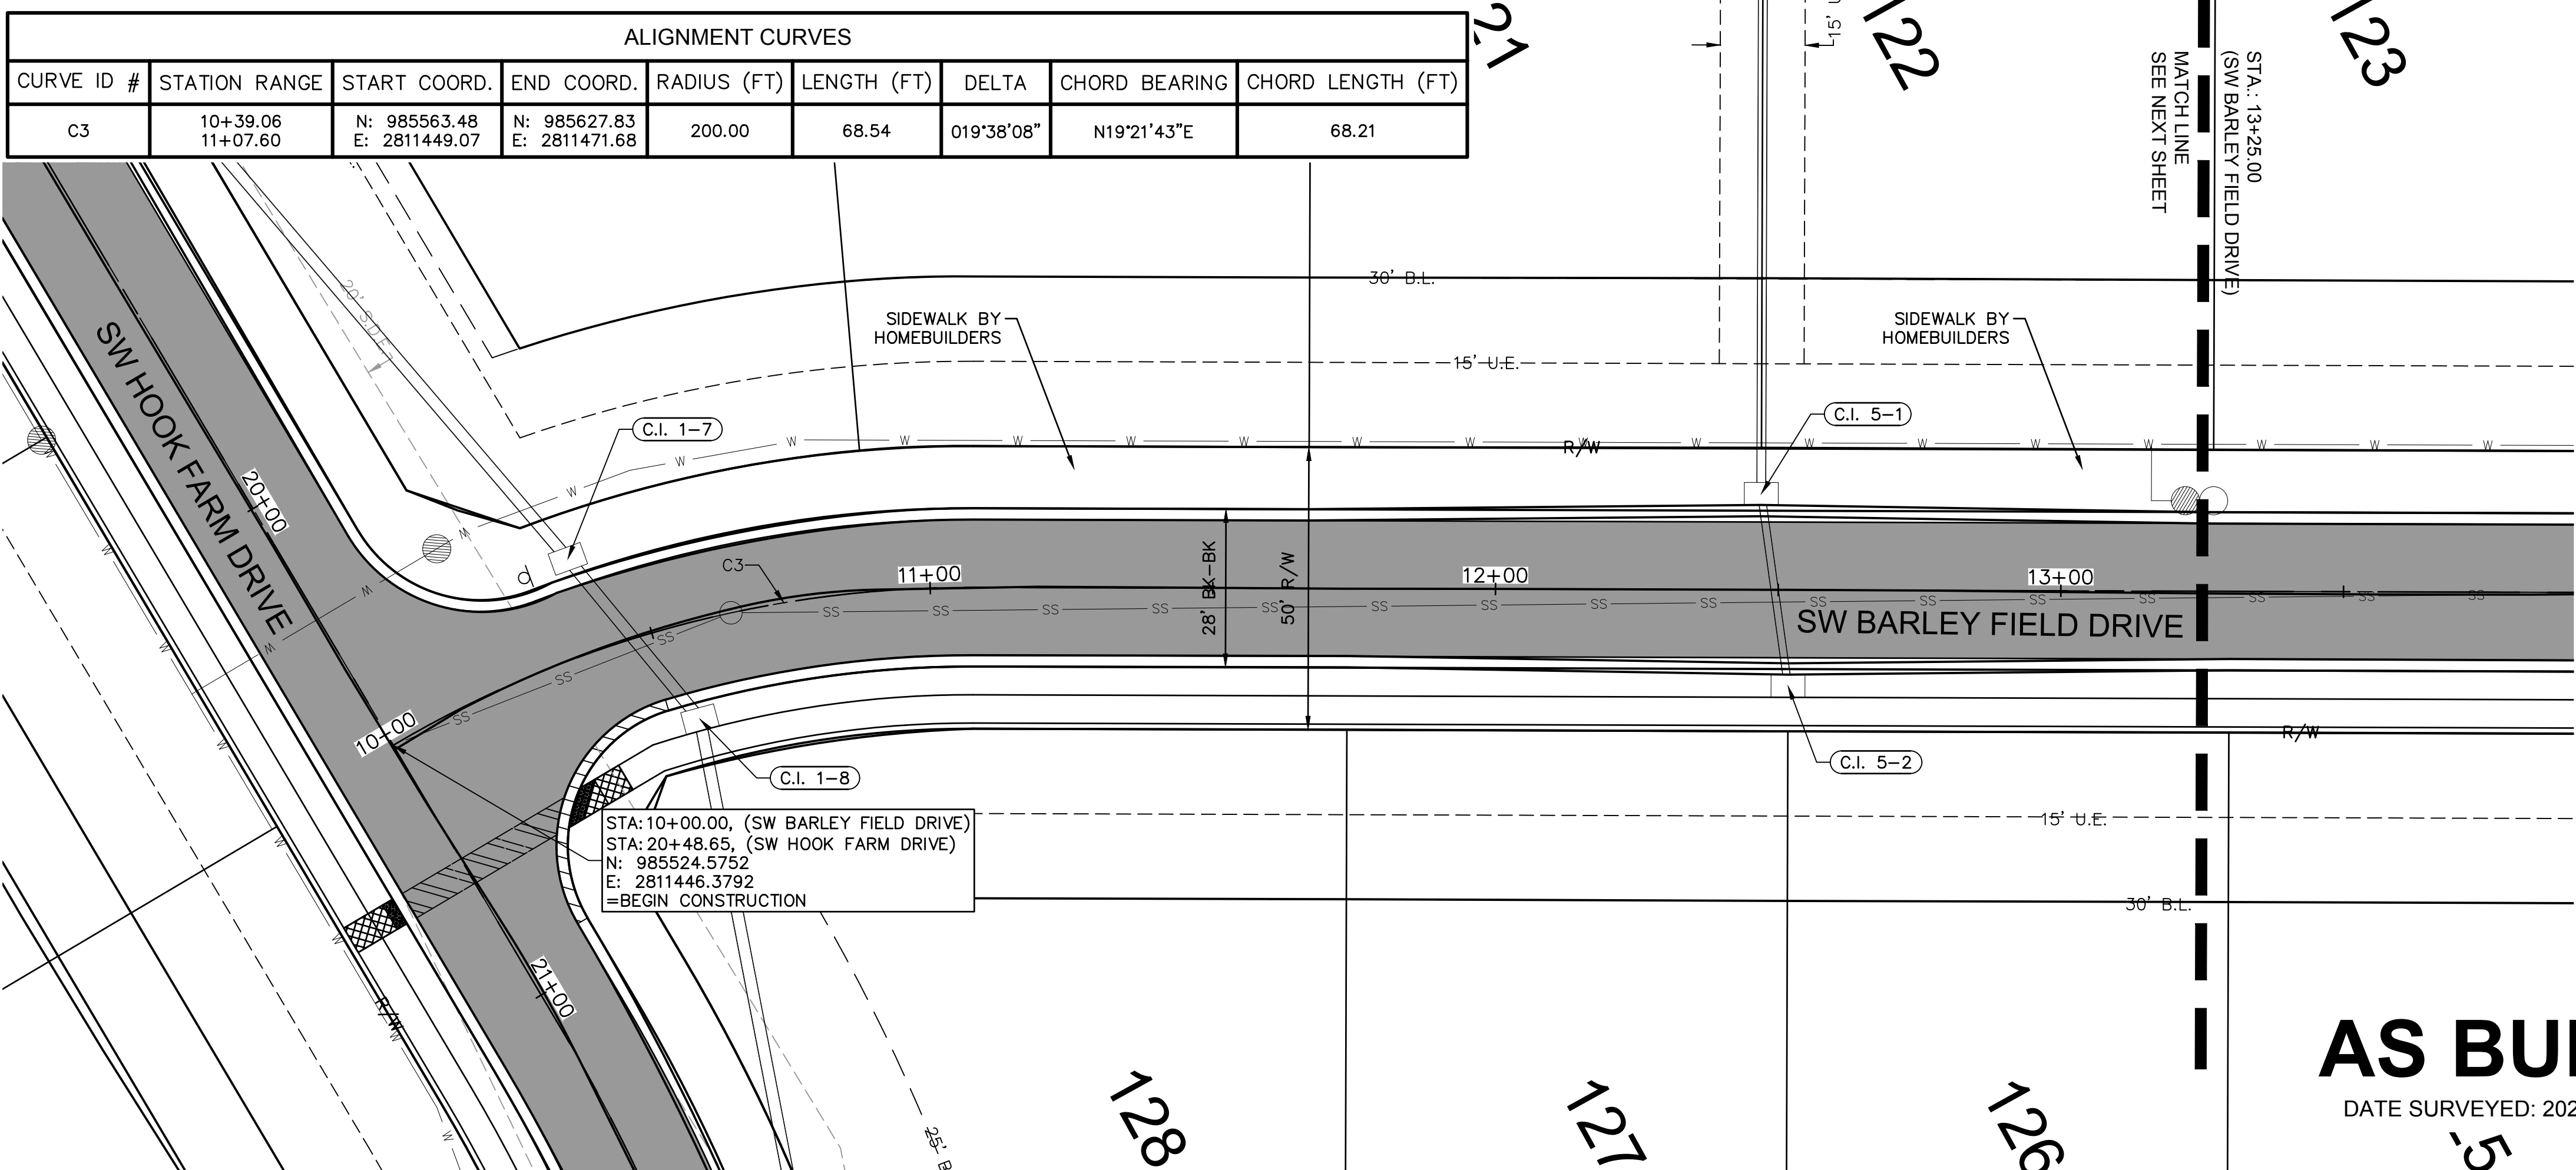


AS BUILT

DATE SURVEYED: 2022-05-26

Accepted
Record Drawings

These plans have been reviewed for accuracy and are accepted for basic conformance to the approved construction drawings.

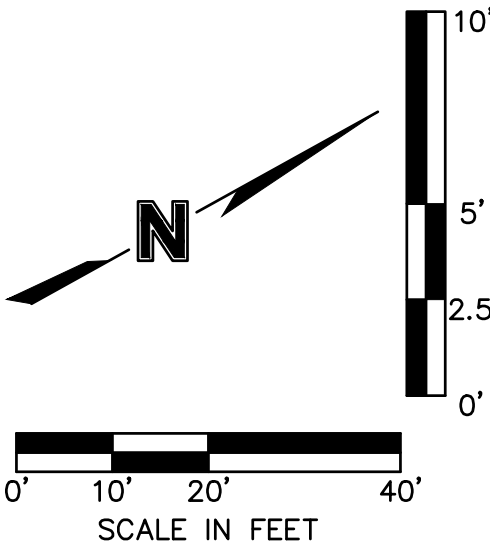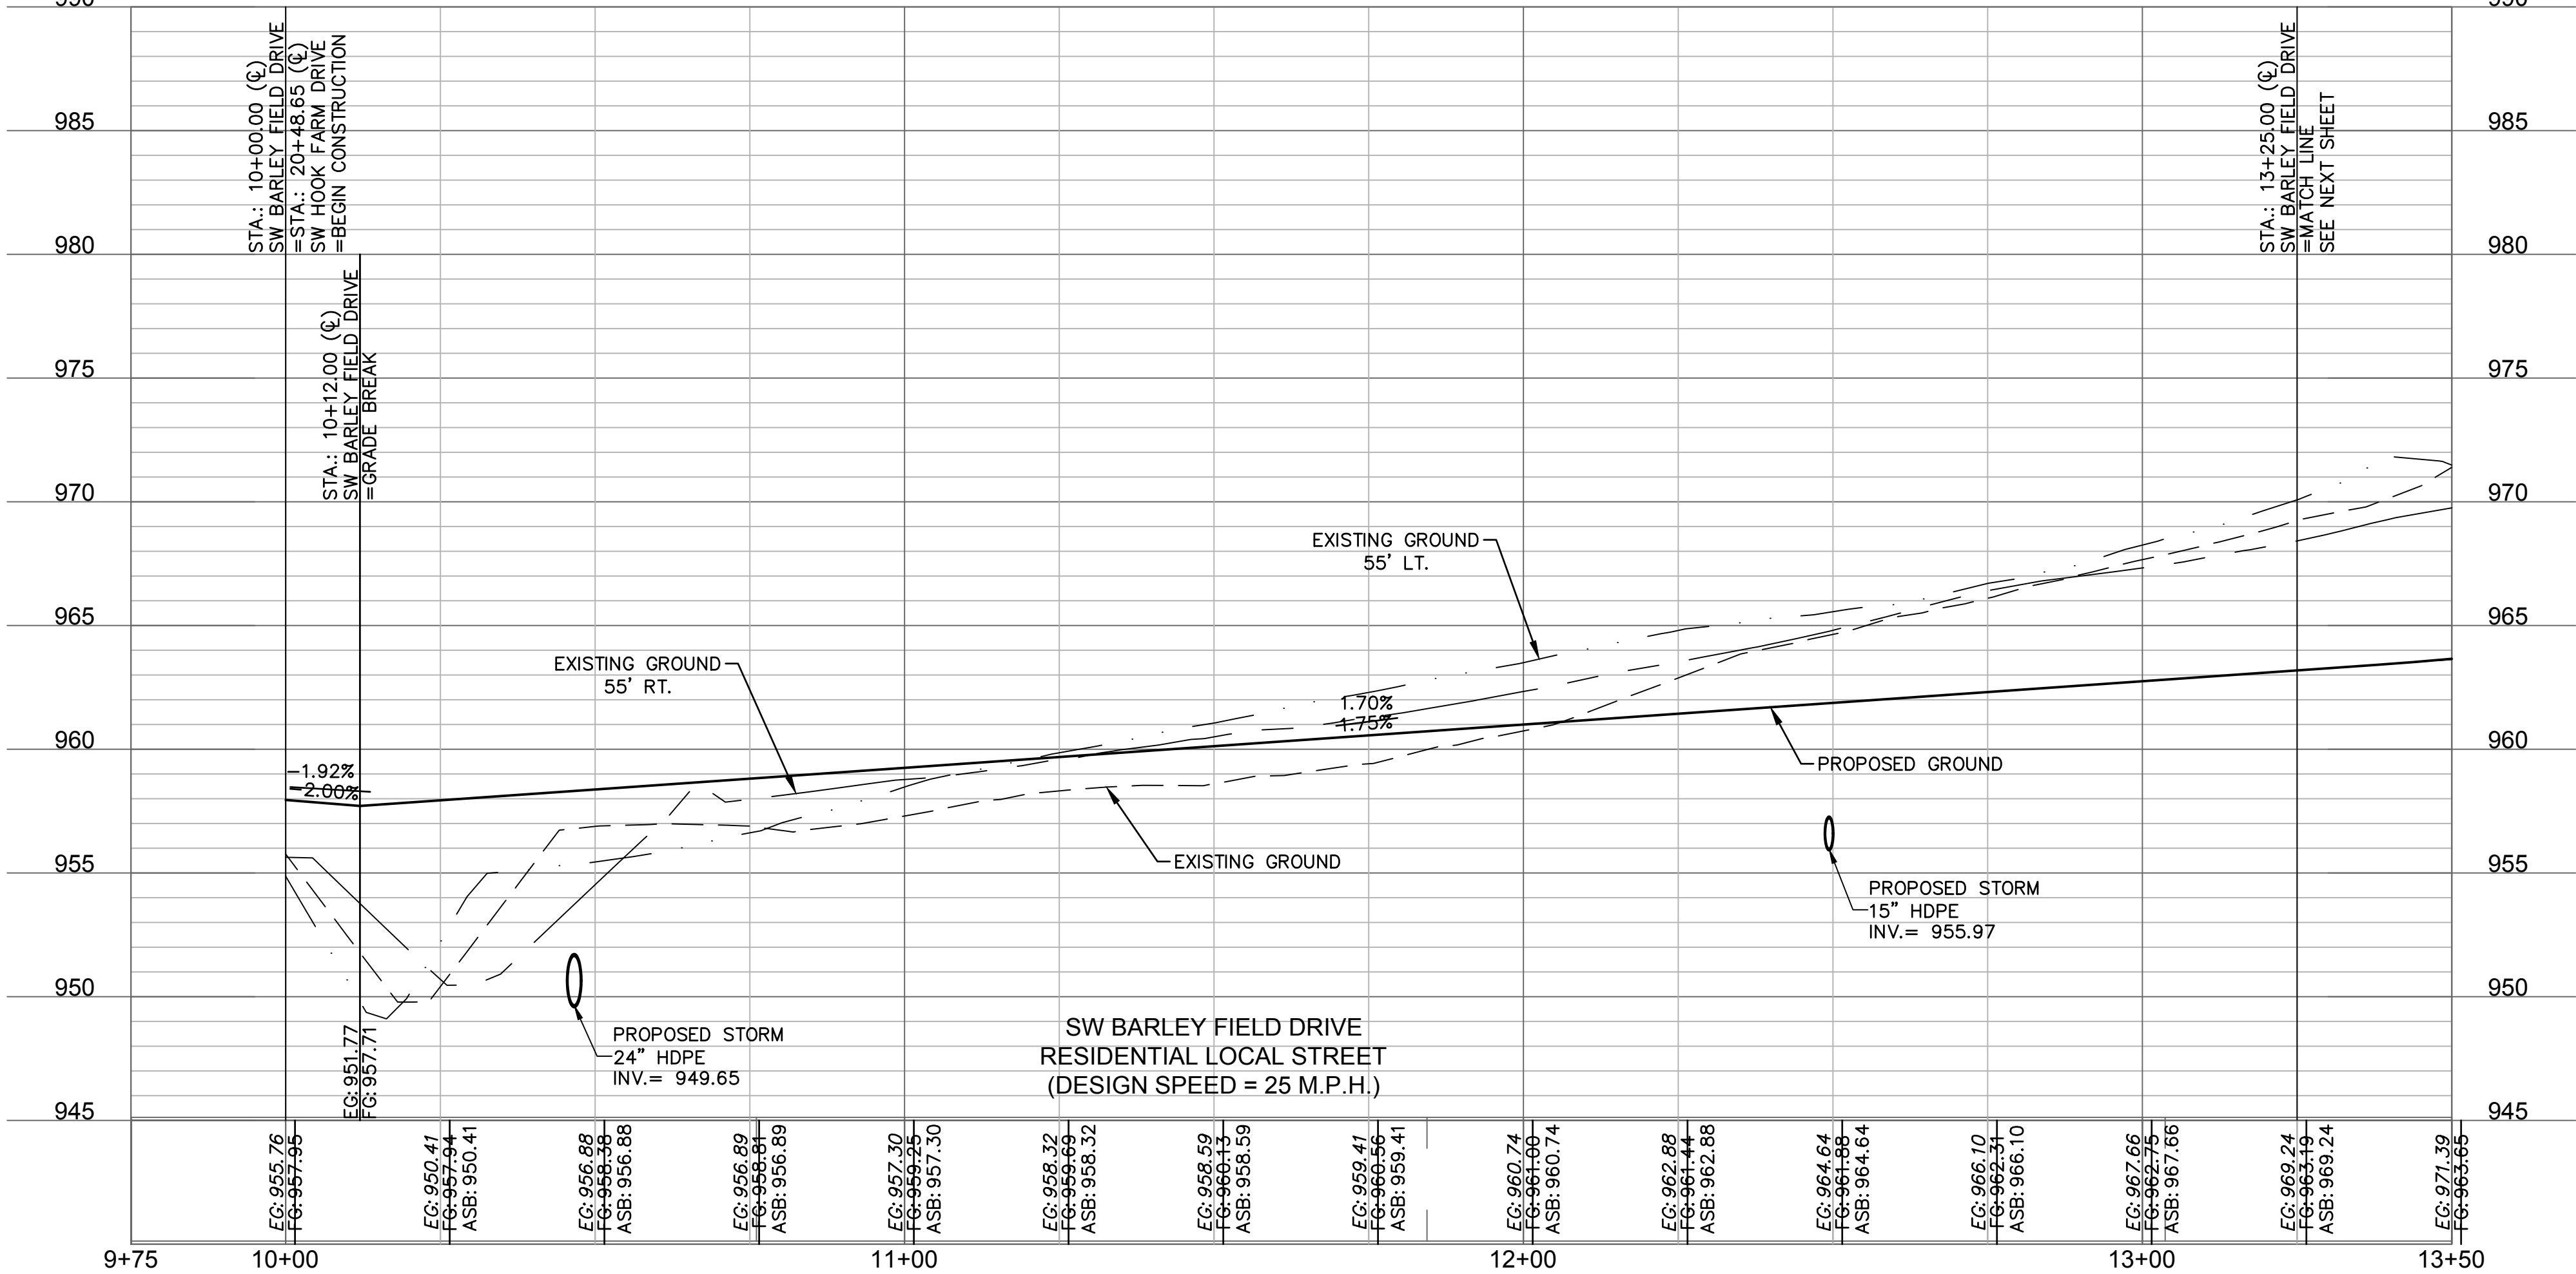

Olsson - Civil Engineering
Missouri Certificate of Authority #001592
1301 Burlington Street
North Kansas City, MO 64116
TEL 816.361.1177
FAX 816.361.1888
www.olsson.com

REVISIONS				BY	
REV. NO.	DATE	REVISIONS DESCRIPTION			
1	03-23-2021	REVISED PER CITY COMMENTS			
2	04-16-2021	REVISED PER CITY COMMENTS			
3	09-30-2021	CHANGES TO APPROVED PLANS			


ROADWAY PLAN & PROFILE (SW BARLEY FIELD DRIVE)
STREET & STORM SEWER PLANS


HOOK FARMS
SECOND PLAT

LEE'S SUMMIT, MO



drawn by: B.M.W./A.A.
checked by: B.M.W.
designed by: B.M.W./A.A.
QA/QC by: J.E.S.
project no.: B19-4061
date: 01-08-2021

SHEET
C121

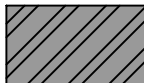LEGEND	
	ADA ACCESS ROUTE
	ASPHALT PAVEMENT
	CONCRETE SIDEWALK
	CG-2 CURB & GUTTER

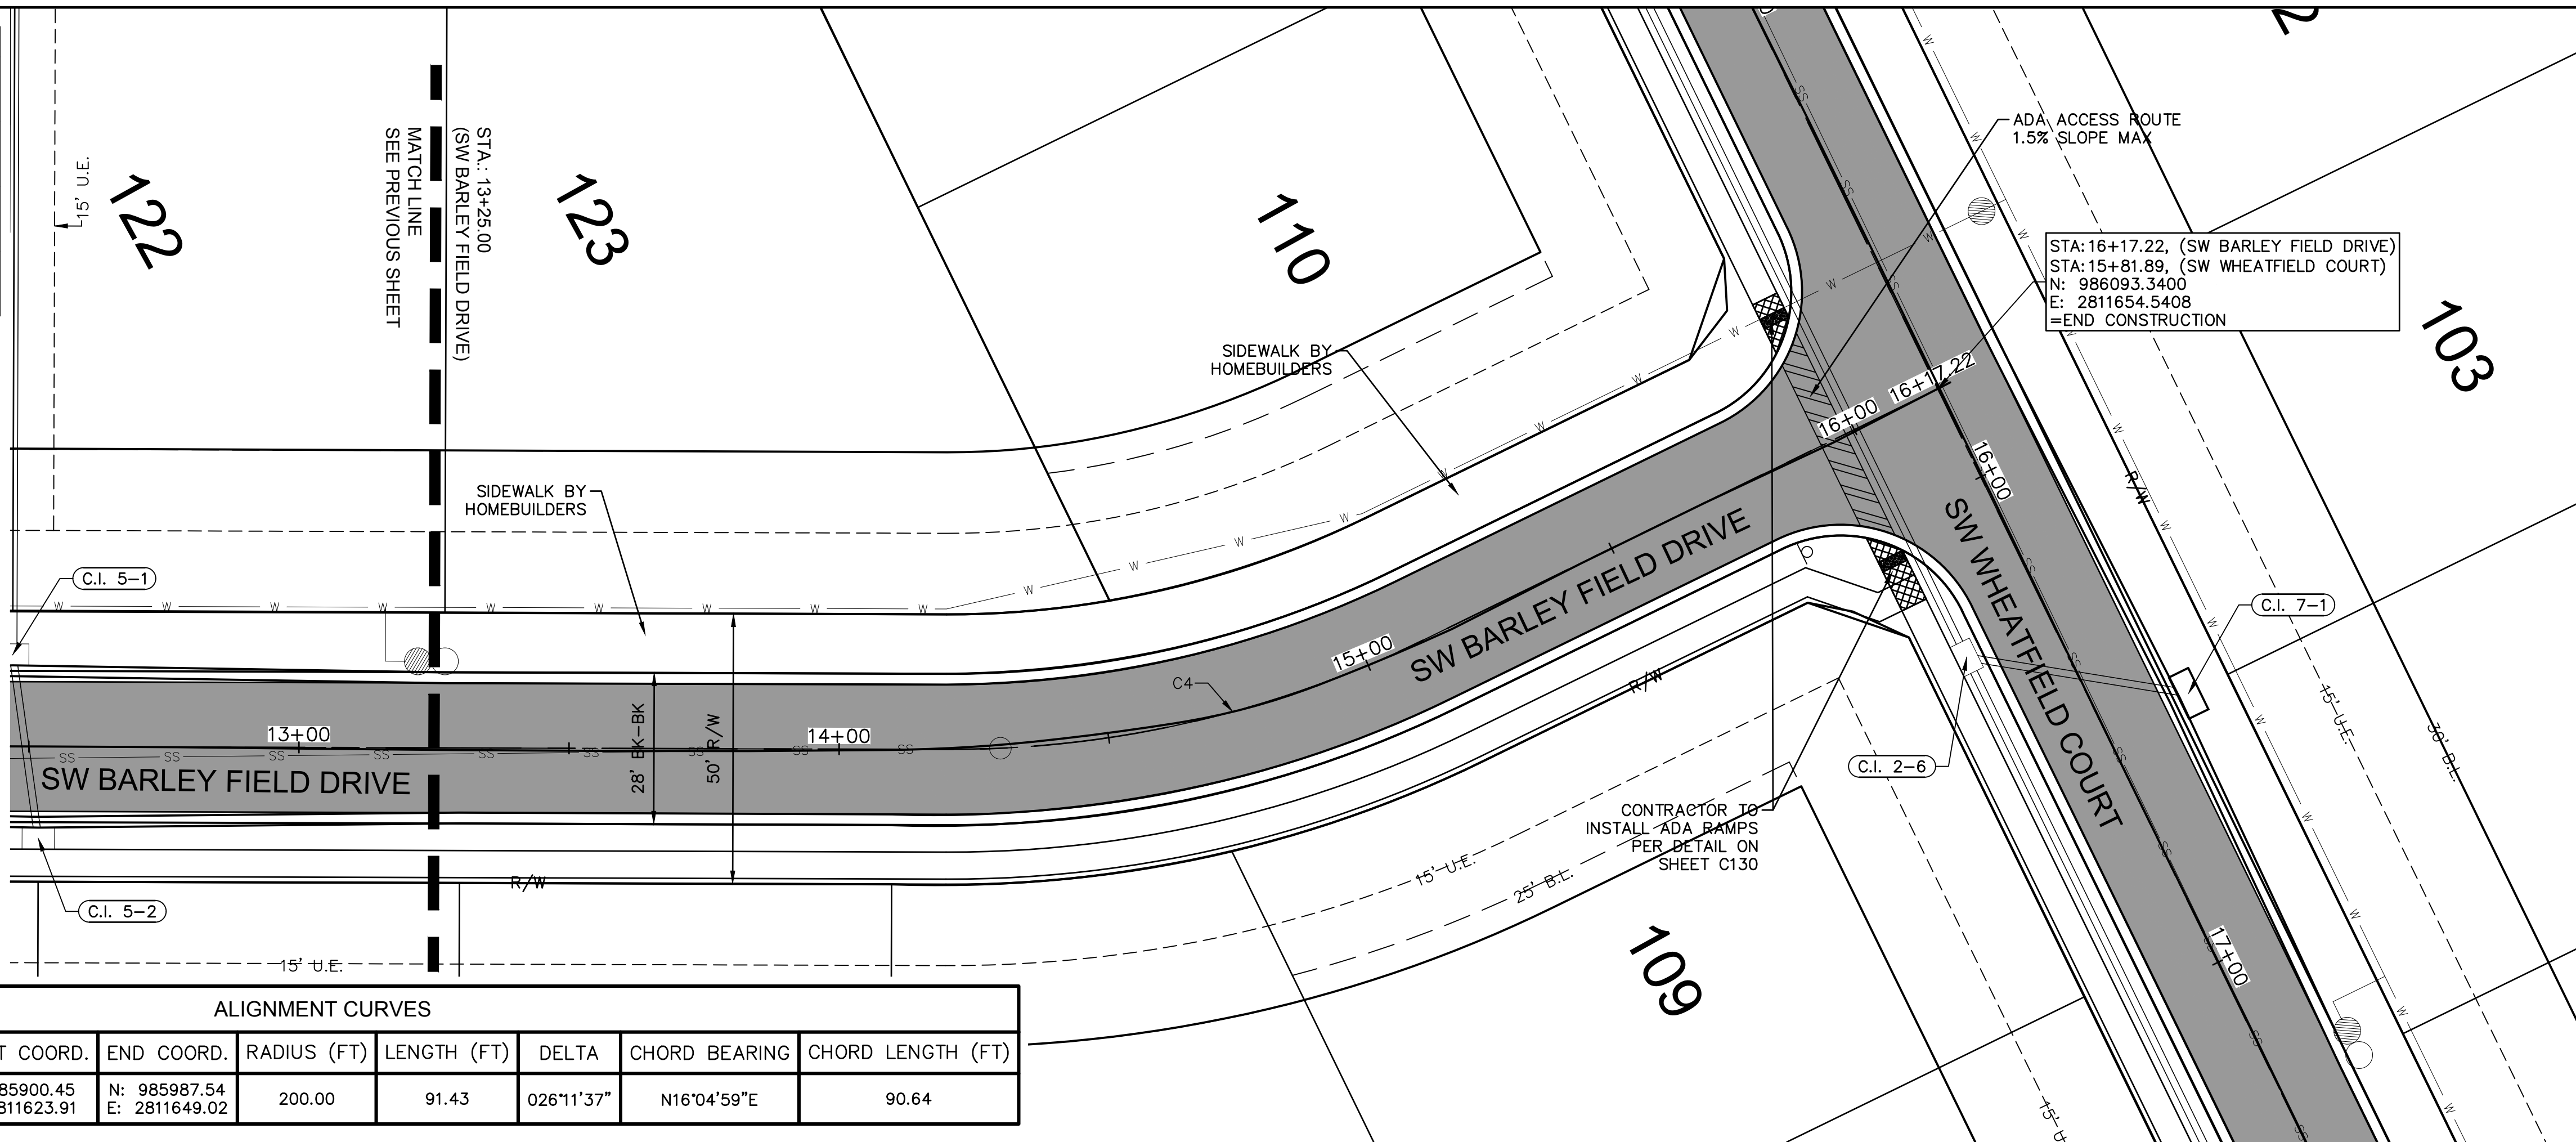

ALIGNMENT CURVES								
CURVE ID #	STATION RANGE	START COORD.	END COORD.	RADIUS (FT)	LENGTH (FT)	DELTA	CHORD BEARING	CHORD LENGTH (FT)
C4	14+19.84 15+11.28	N: 985900.45 E: 2811623.91	N: 985987.54 E: 2811649.02	200.00	91.43	026°11'37"	N16°04'59"E	90.64

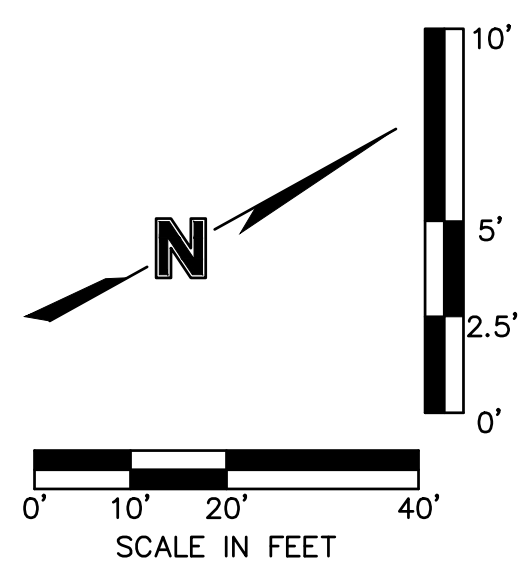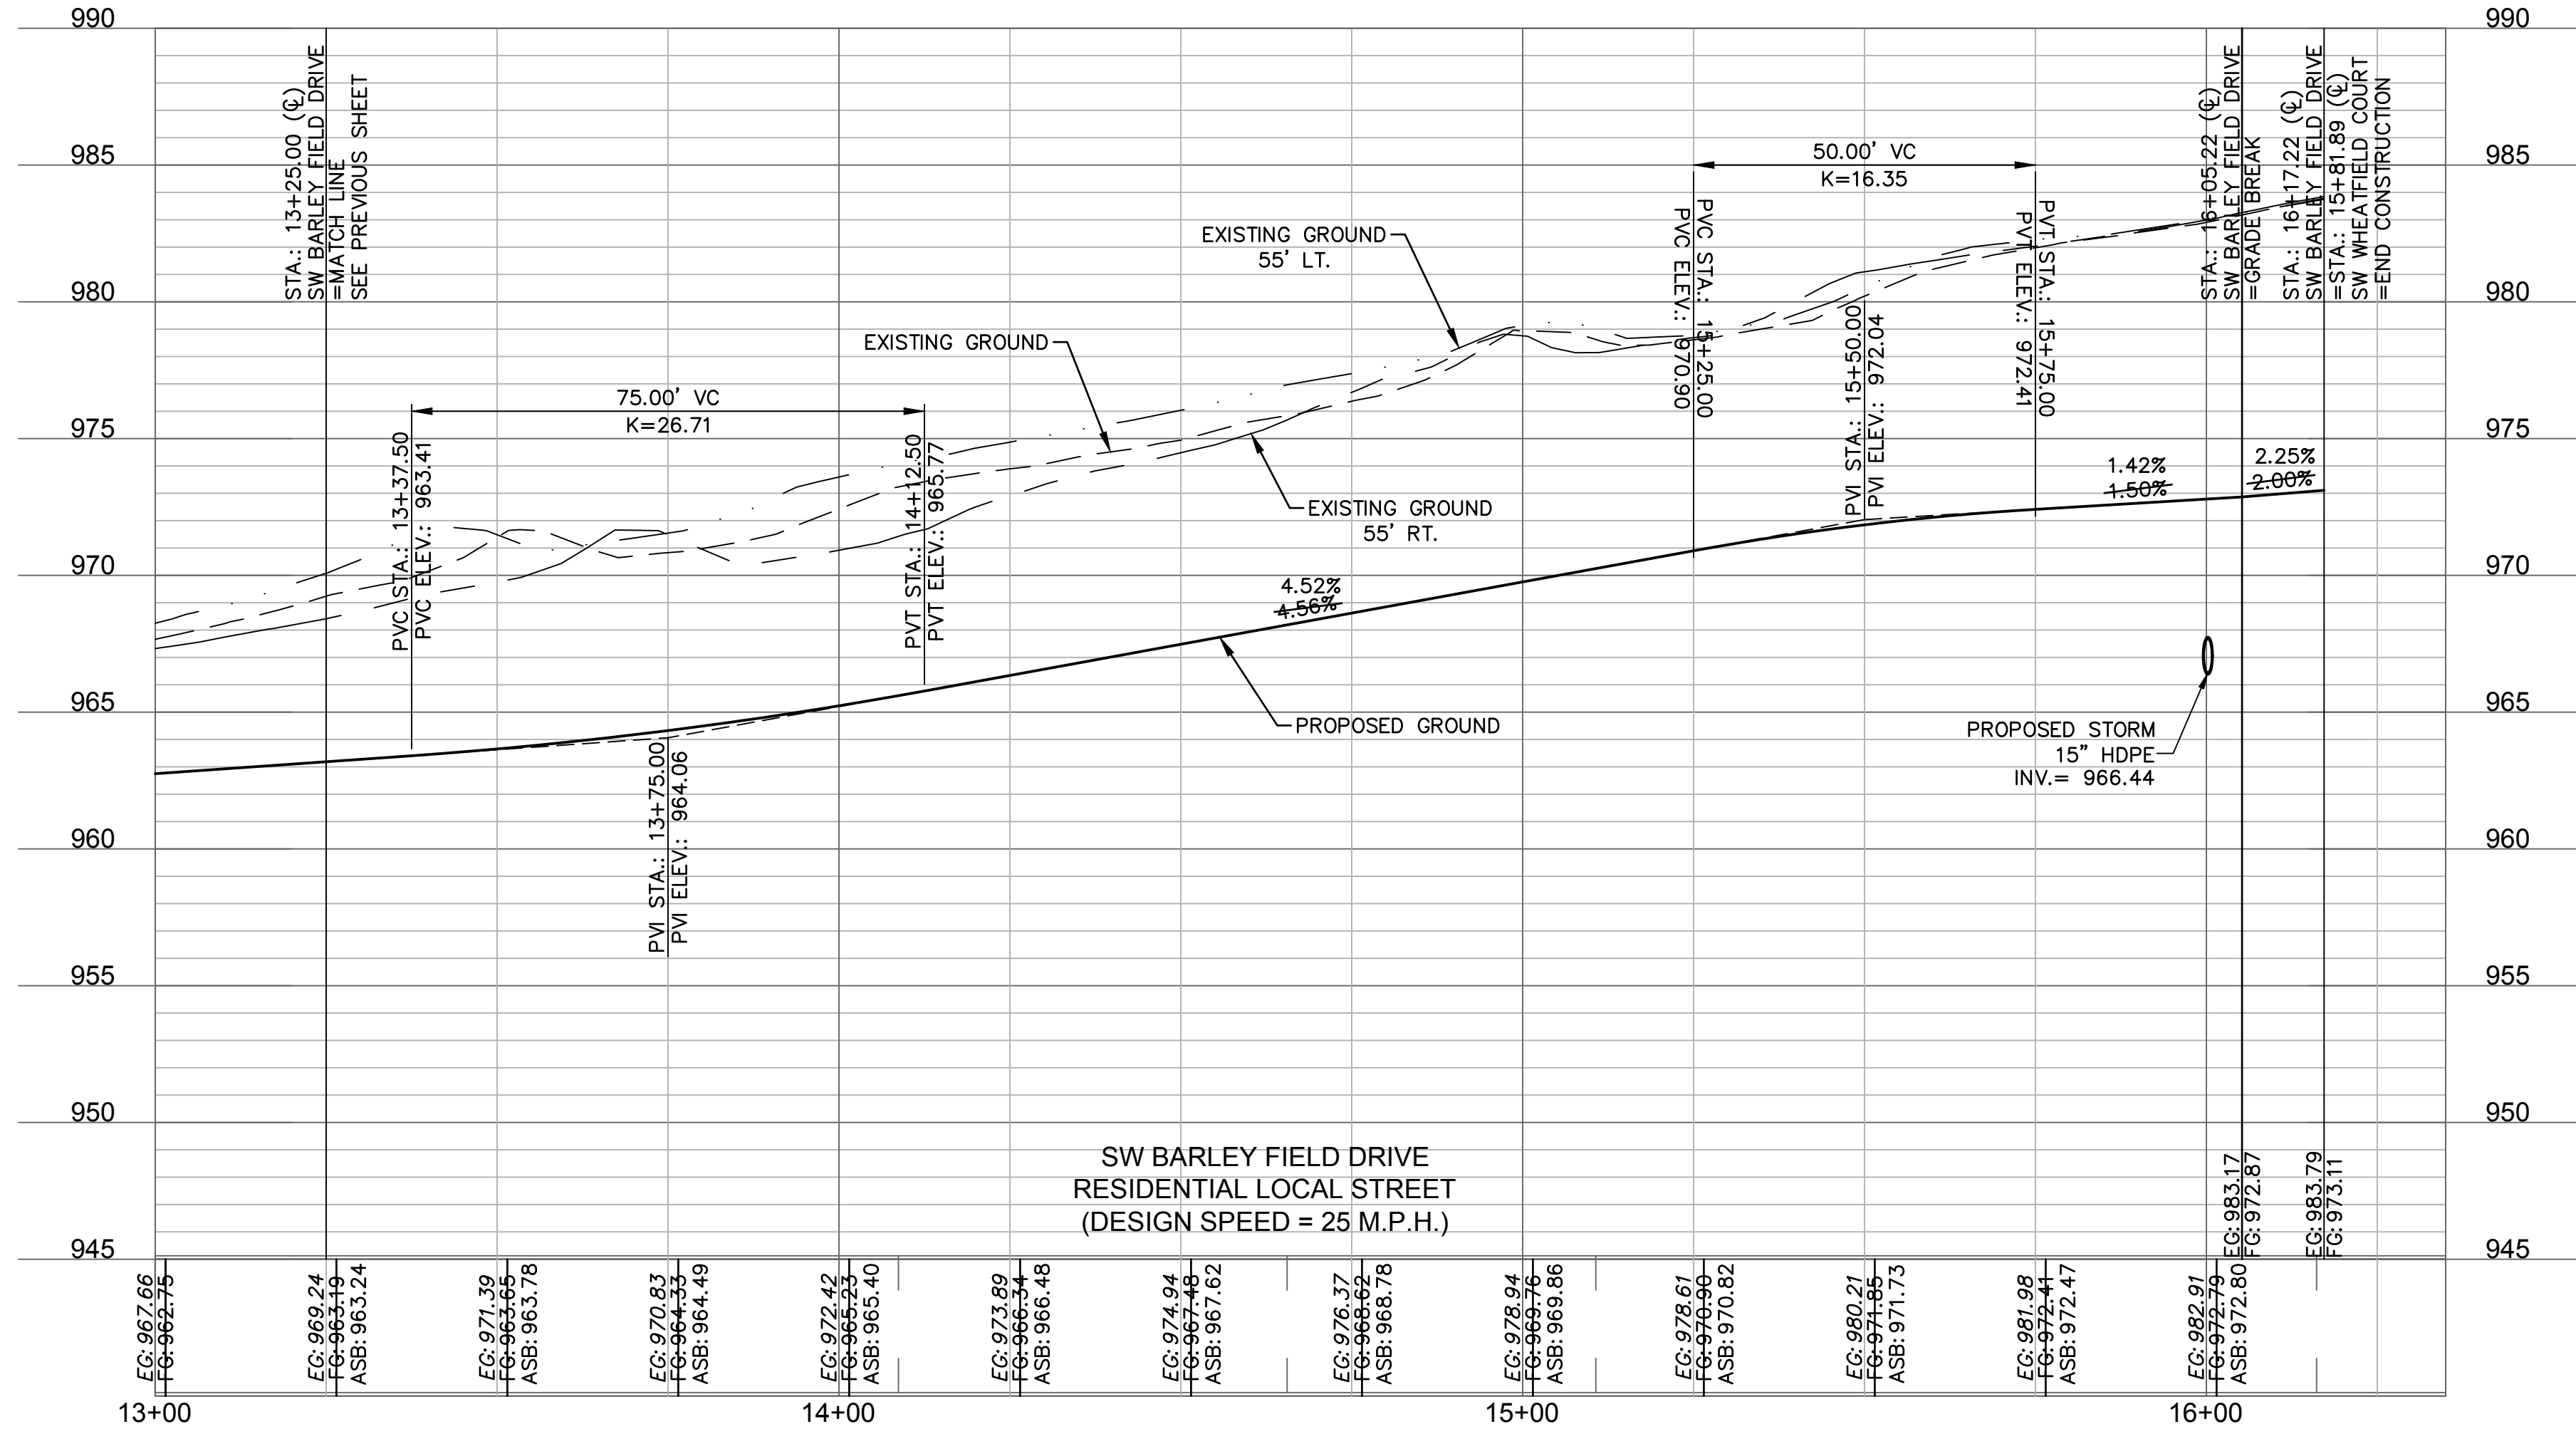

**Accepted
Record Drawings**

These plans have been reviewed for accuracy and are accepted for basic conformance to the approved construction drawings.

AS BUILT

DATE SURVEYED: 2022-05-26



Olsson - Civil Engineering
Missouri Certificate of Authority #001592
1301 Burlington Street
North Kansas City, MO 64116

oslo

[illegible]

REVISIONS

ROADWAY PLAN & PROFILE (SW BARLEY FIELD DRIVE) STREET & STORM SEWER PLANS


STREET & STORM SEWER PLANS

HOOK FARMS SECOND PLAT

LEE'S SUMMIT: MO

drawn by: _____ B.M.W./A.A.
checked by: _____ B.M.W.
designed by: _____ B.M.W./A.A.
QA/QC by: _____ J.E.S.
project no.: _____ B19-406
date: _____ 01-08-202

SHEET
C122

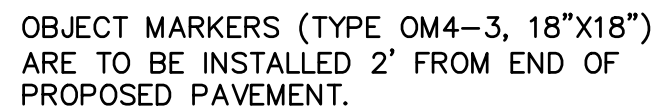

These plans have been reviewed for accuracy and are accepted for basic conformance to the approved construction drawings.

USER: ssaylor
C_PUTIL_E

EAGLE CREEK
FIRST PLAT

TRACT M

HOOK FARMS
1ST PLAT

TRAFFIC CONTROL PLAN STREET & STORM SEWER PLANS

HOOK FARMS
SECOND PLAT

LEE'S SUMMIT: MO

drawn by: B.M.W./J.A.
checked by: B.M.W.
designed by: B.M.W./J.A.
QA/QC by: J.E.S.
project no.: B19-406
date: 01-08-202

SHEET
C123

REV. NO.	DATE	REVISIONS DESCRIPTION	BY
1	03-23-2021	REVISED PER CITY COMMENTS	
2	04-16-2021	REVISED PER CITY COMMENTS	
3	09-30-2021	CHANGES TO APPROVED PLANS	


REVISIONS



oslo

Olsson - Civil Engineering
Missouri Certificate of Authority #001592
301 Burlington Street
North Kansas City, MO 64116
TEL 816.361.1177
FAX 816.361.1888
www.olsson.com

DWG: F:\2019\4001-4500\019-4061-BV40-Design\AutoCAD\Asbuilt\Sheets\GNCV\Street & Storm Plans\C_INT01_B194061.dwg
DATE: Oct 11, 2022 3:34pm
XREFS: C_PTBK_B194061 C_XBASE_B194061 C_PBASE_B194061 C_PSTRM_B194061 C_PSURF_B194061 C_PPATT_B194061
USER: sso\or

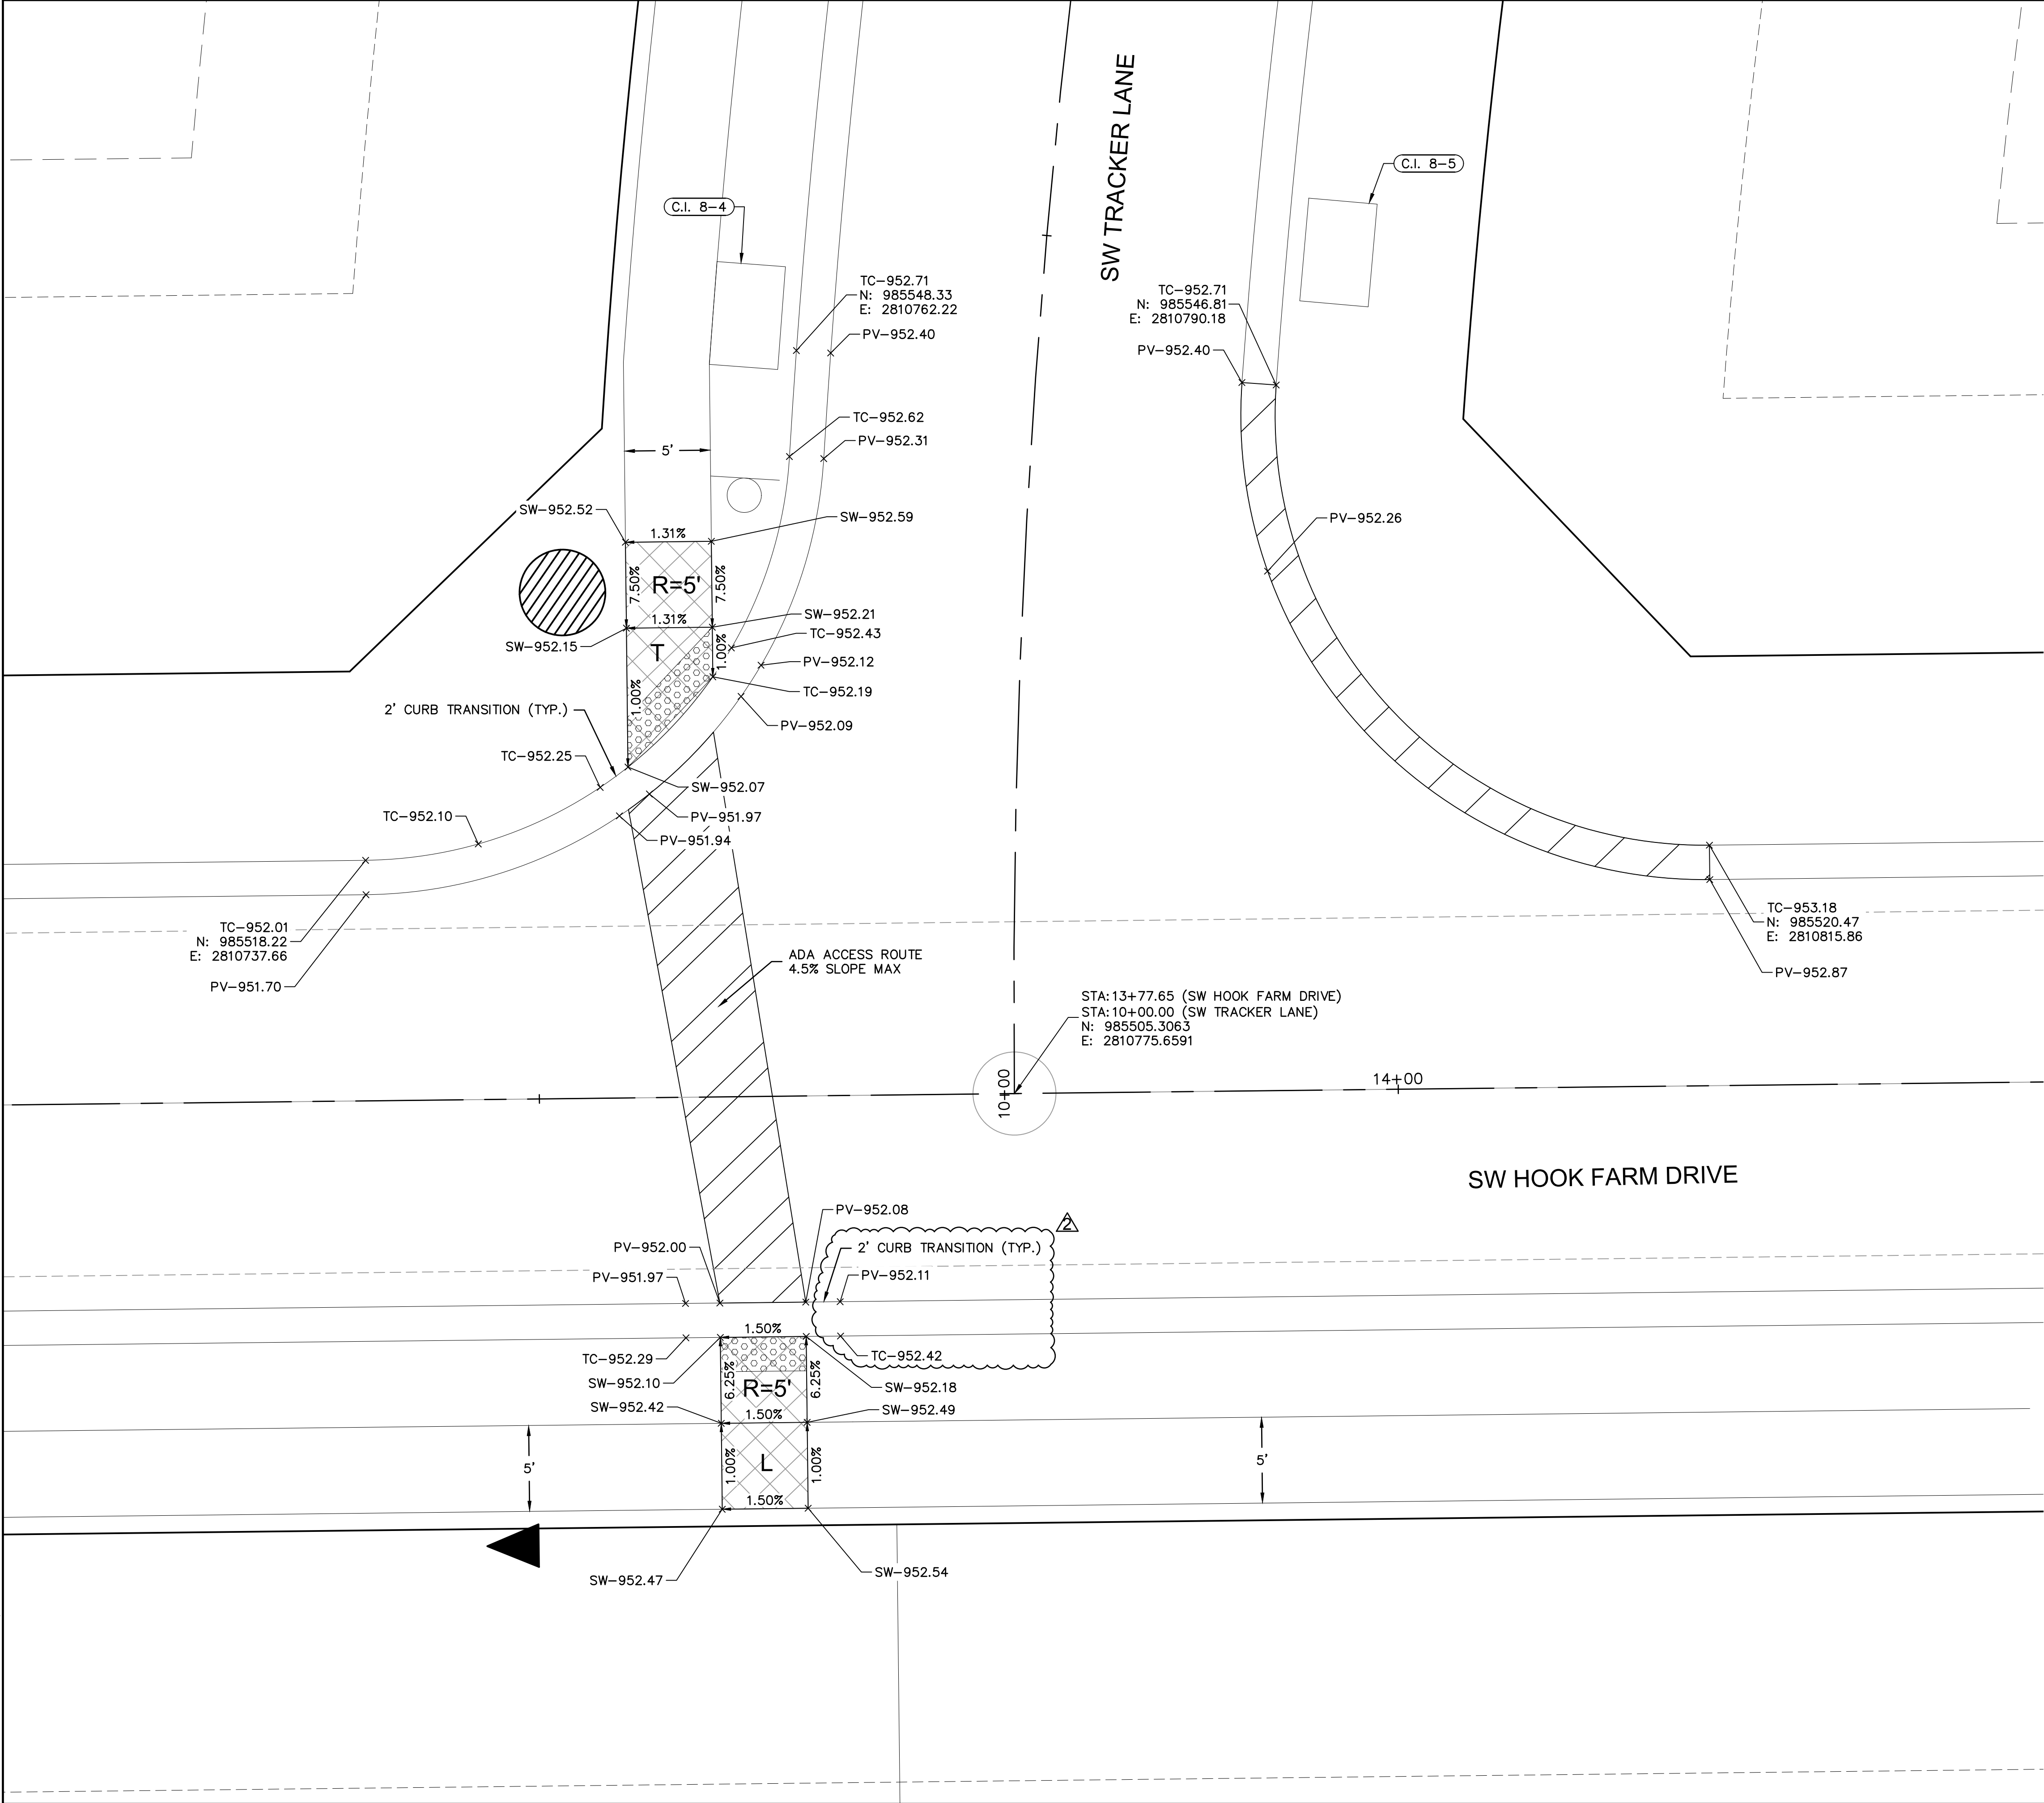


- INTERSECTION AND ADA DETAIL NOTES:
1. ALL ADA CURB RAMPS SHALL BE BUILT PER CURRENT MUNICIPALITY ADOPTED ADA STANDARDS.
 2. CURB RAMP FLARES SHALL NOT BE STEEPER THAN 1:10 MAX SLOPES.
 3. LANDING SHALL BE PROVIDED WHERE INDICATED ON PLAN SHEET OR BY PROWAG STANDARDS. LANDING SHALL BE 4'X4' MINIMUM.
 4. RAMP RUNS SHALL HAVE A MAXIMUM RUNNING SLOPE OF 1:12 UNLESS THE RAMP LENGTH IS OVER 15 FEET, THEN THE SLOPE CAN BE GREATER AS INDICATED IN DETAILS TO REACH STREET GRADES.
 5. LANDINGS SHALL HAVE A MAXIMUM SLOPE OF 2% IN ANY DIRECTION.
 6. CROSS SLOPE FOR RAMPS AND SIDEWALK SHALL NOT EXCEED 2%.
 7. AFTER CURBS HAVE BEEN CONSTRUCTED, AND BEFORE ASPHALT OR CONCRETE PAVEMENT IS POURED, CURBS SHOULD BE MEASURED WITH A LEVEL TO ENSURE CURB ALONG ADA RAMPS AND LANDINGS WILL MEET ADA REQUIREMENTS.
 8. ADA RAMP CONSTRUCTION WILL BE INSPECTED THOROUGHLY BY THE CITY INSPECTOR. CONTRACTOR SHALL BE REQUIRED TO RECONSTRUCT RAMPS, CURBS AND/OR PAVEMENT AT CONTRACTOR'S EXPENSE IF ADA RAMPS AND LANDINGS CANNOT MEET THE ADA REQUIREMENTS, PER APPROVED PLAN OR APPROVED ALTERNATIVE.
 9. CURVE DATA IS FOR BACK OF CURB.

LEGEND	
TC--	TOP OF CURB
PV--	TOP OF PAVEMENT
SW--	SIDEWALK
L	LANDING AREA
R	RAMP AREA
T	TRANSITION AREA
	ADA ACCESS ROUTE
	CG-2 CURB & GUTTER
	CG-2 DRY CURB & GUTTER
	ADA RAMP (CONSTRUCTED BY CONTRACTOR)

**Accepted
Record Drawings**

These plans have been reviewed for accuracy and are accepted for basic conformance to the approved construction drawings.

NOT AS-BUILT

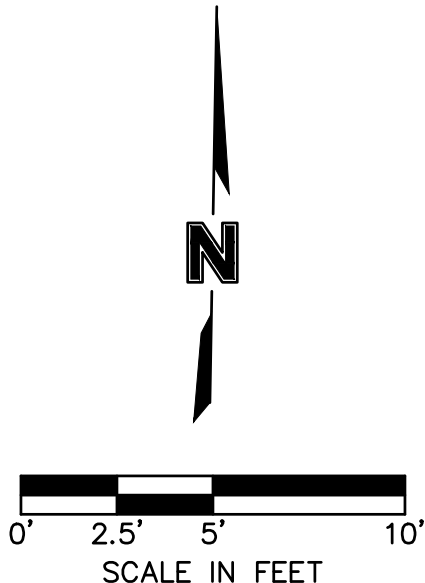

olsson

Olsson - Civil Engineering
Missouri Certificate of Authority #001592
1301 Burlington Street
North Kansas City, MO 64116
TEL 816.361.1177
FAX 816.361.1888
www.olsson.com

STATE OF MISSOURI
JULIE ELAINE SELLERS
NUMBER PE-2017000367
12/7/22
PROFESSIONAL ENGINEER

REV.	NO.	DATE	REVISIONS DESCRIPTION	BY
1		03-23-2021	REVISED PER CITY COMMENTS	
2		04-16-2021	REVISED PER CITY COMMENTS	
3		09-30-2021	CHANGES TO APPROVED PLANS	

SW TRACKER LANE & SW HOOK FARM DRIVE
STREET & STORM SEWER PLANS

HOOK FARMS
SECOND PLAT


LEE'S SUMMIT, MO

2021

drawn by: B.M.W./A.A.
checked by: B.M.W.
designed by: B.M.W./A.A.
QA/QC by: J.E.S.
project no.: B19-4061
date: 01-08-2021

SHEET
C124

USER: ssaylor
C_PUTITL_B194061 C_FBASE_B194061 C_PSTRM_B194061 C_PSURF_B194061 C_PPATT_B194061

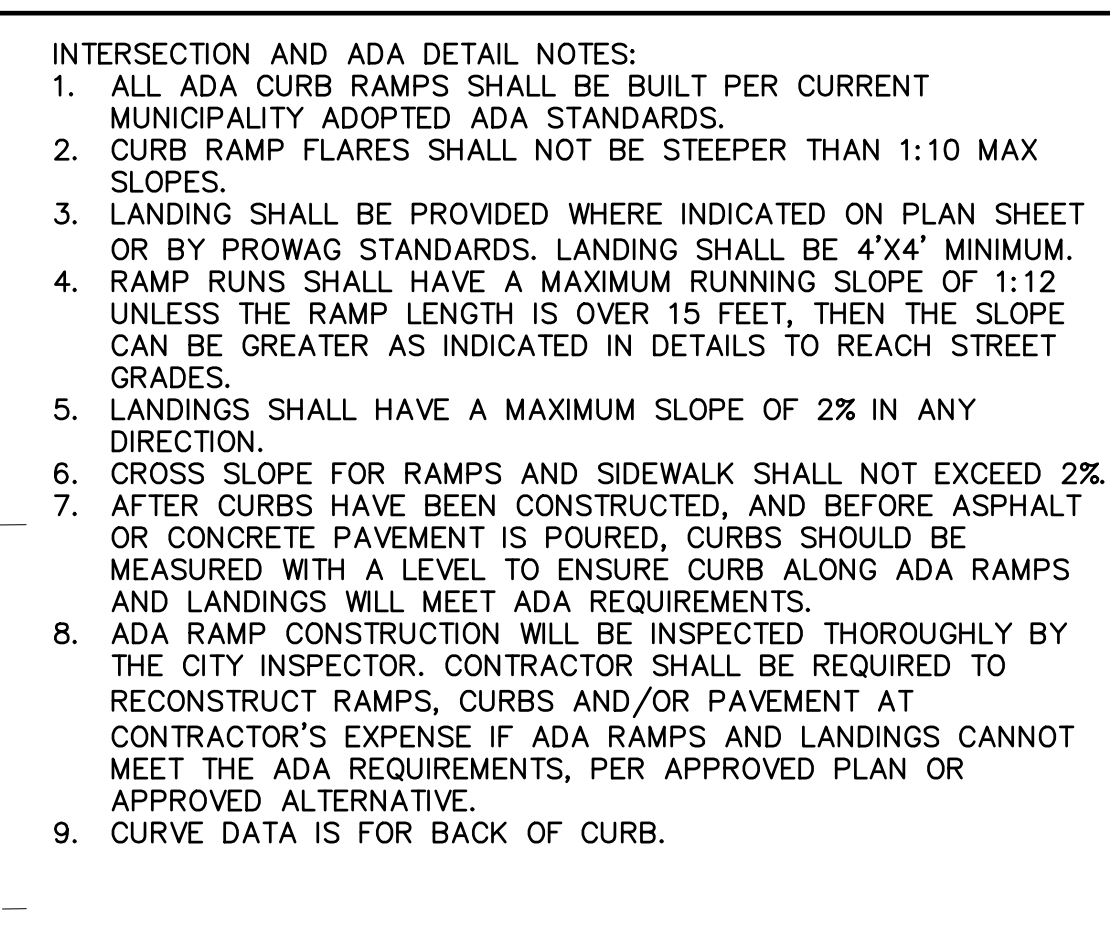

**Accepted
Record Drawings**


These plans have been reviewed for accuracy and are accepted for basic conformance to the approved construction drawings.

A north arrow pointing upwards with the letter 'N' in the center. Below it is a scale bar marked from 0' to 10' in increments of 2.5'.




olsson

Olsson - Civil Engineering
Missouri Certificate of Authority #001592
301 Burlington Street
North Kansas City, MO 64116
TEL 816.361.1177
FAX 816.361.1888
www.olsson.com

Storm Plans\C\INT01_B194061.dwg	USER: ssoylor	
PBASE_B194061	C_PBN DY_B194061	C_PPUTIL_B194061
	C_FBASE_B194061	C_PSTRM_B194061
		C_PSURF_B194061
		C_PPATT_B194061

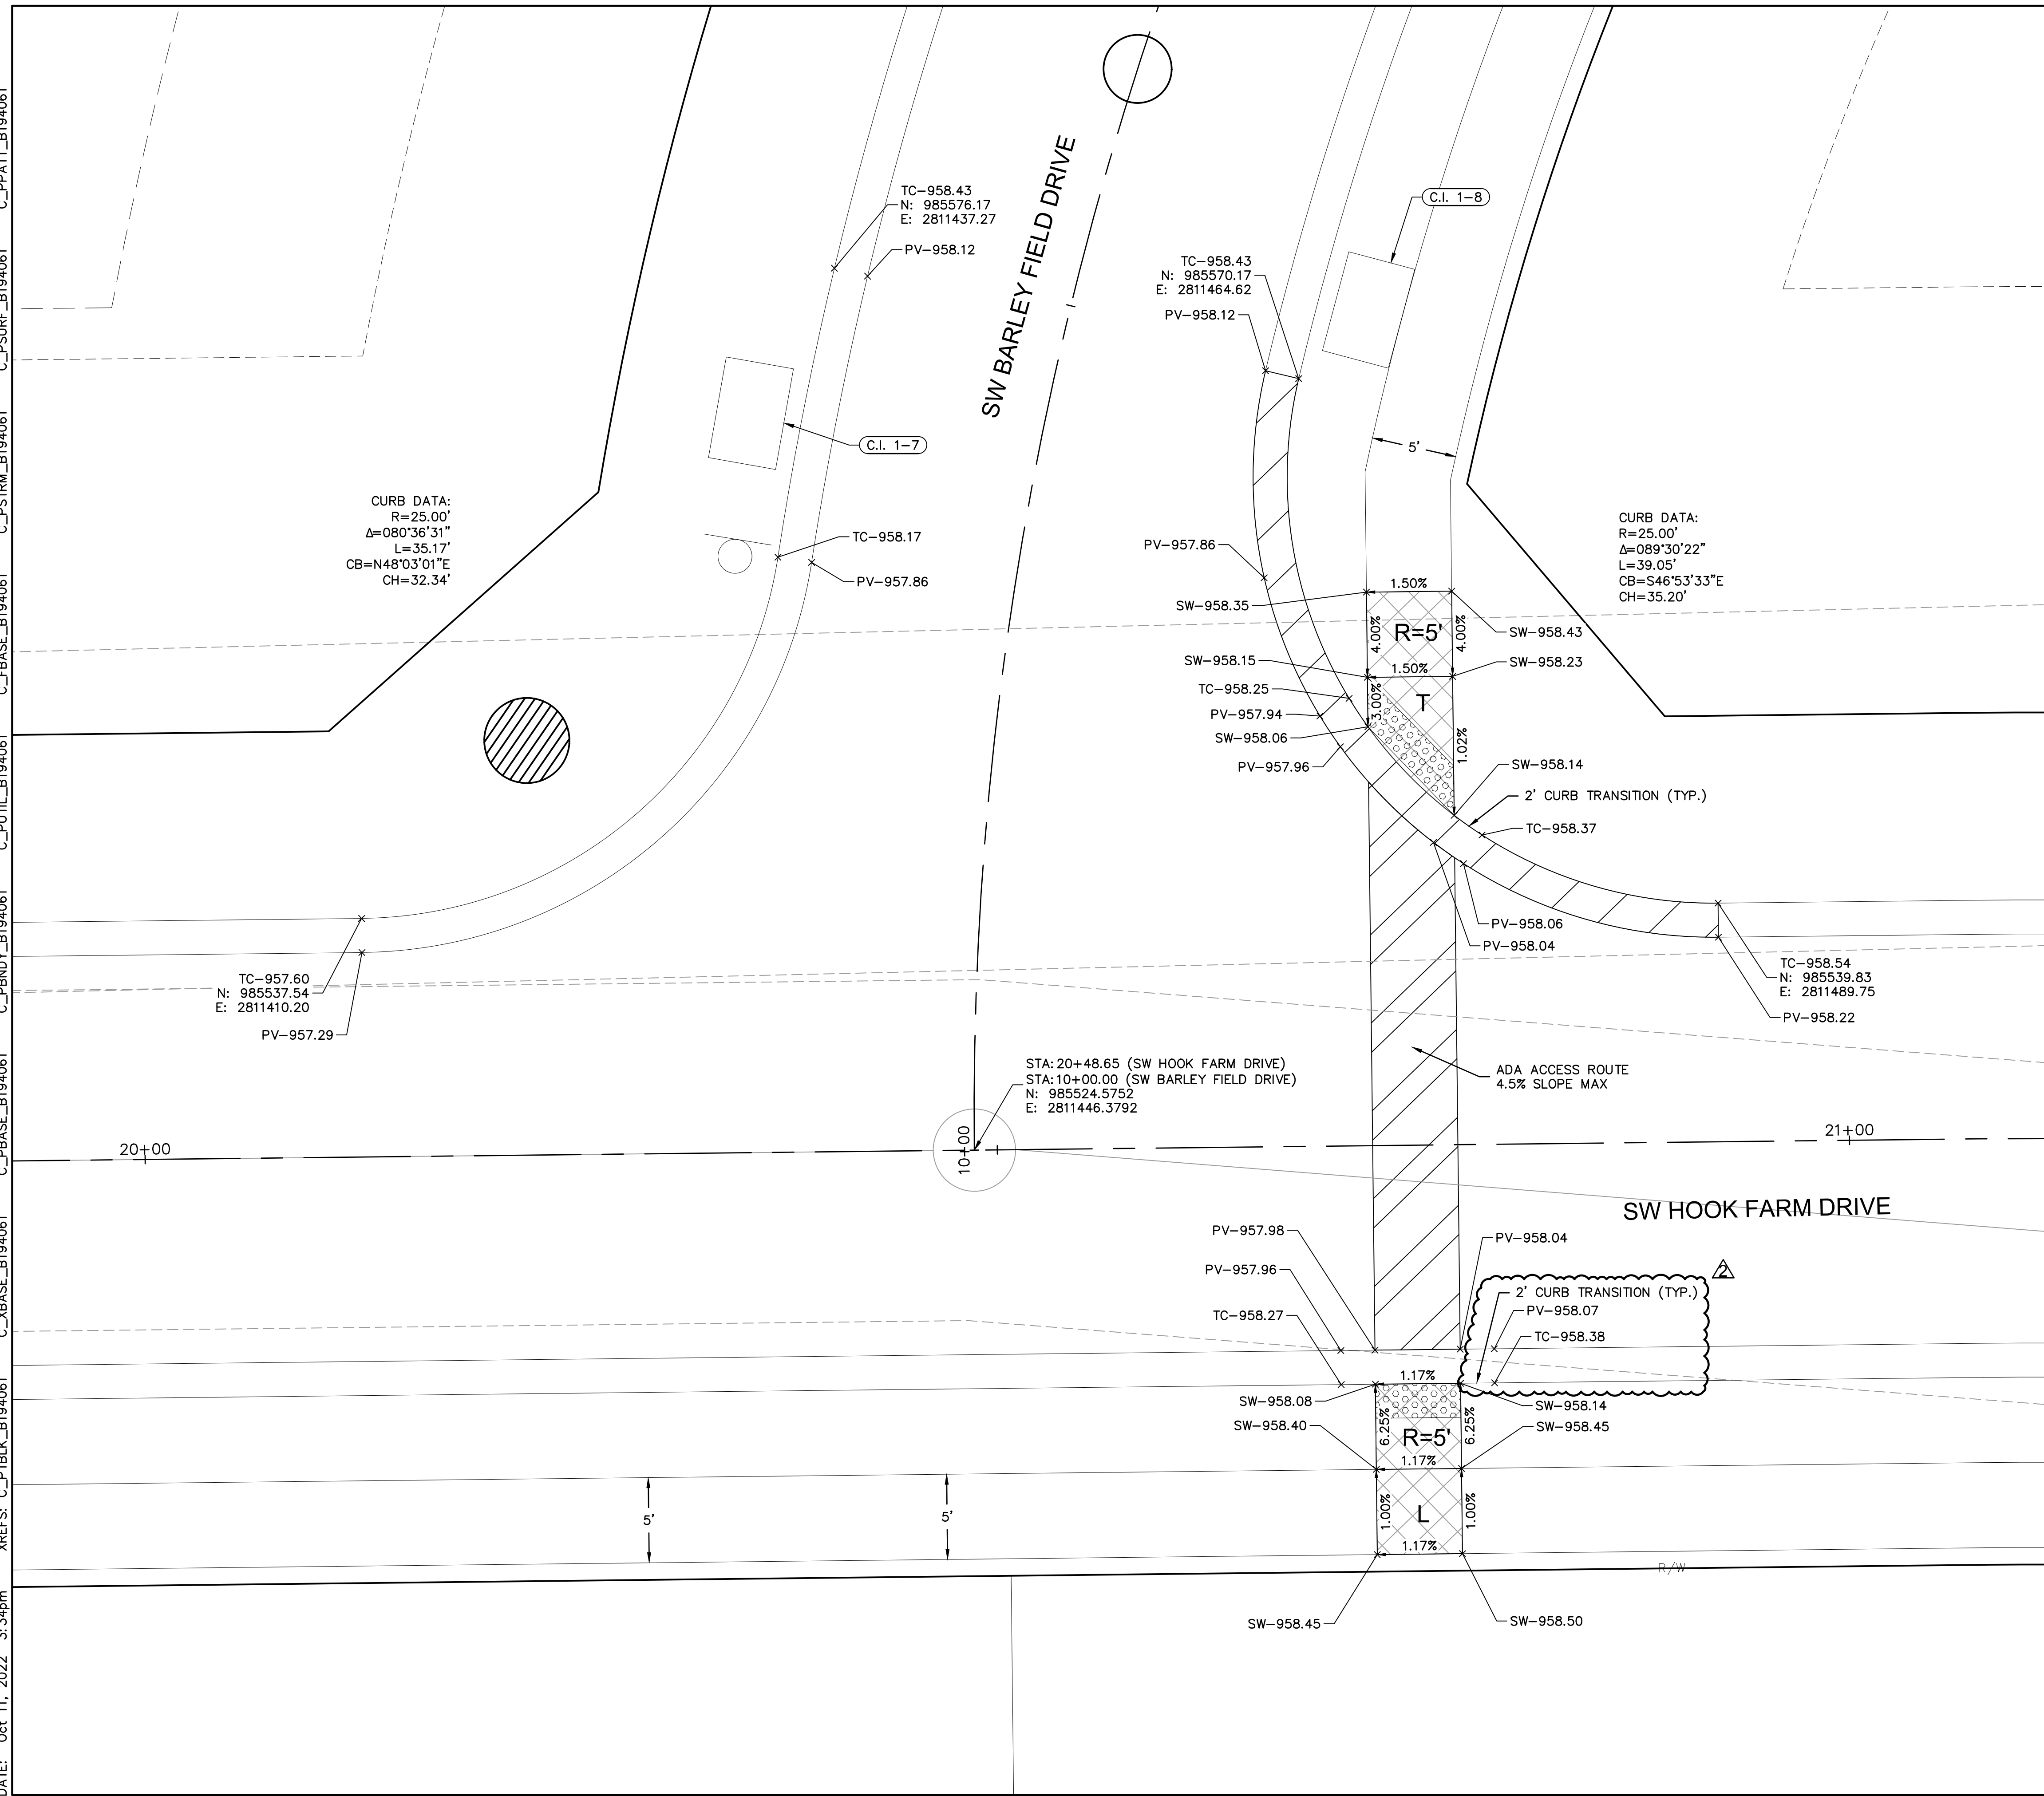


- INTERSECTION AND ADA DETAIL NOTES:
1. ALL ADA CURB RAMPS SHALL BE BUILT PER CURRENT MUNICIPALITY ADOPTED ADA STANDARDS.
2. CURB RAMP FLARES SHALL NOT BE STEEPER THAN 1:10 MAX SLOPES.
3. LANDING SHALL BE PROVIDED WHERE INDICATED ON PLAN SHEET OR BY PROWAG STANDARDS. LANDING SHALL BE 4'x4' MINIMUM.
4. RAMP RUNS SHALL HAVE A MAXIMUM RUNNING SLOPE OF 1:12 UNLESS THE RAMP LENGTH IS OVER 15 FEET, THEN THE SLOPE CAN BE GREATER AS INDICATED IN DETAILS TO REACH STREET GRADES.
5. LANDINGS SHALL HAVE A MAXIMUM SLOPE OF 2% IN ANY DIRECTION.
6. CROSS SLOPE FOR RAMPS AND SIDEWALK SHALL NOT EXCEED 2%.
7. AFTER CURBS HAVE BEEN CONSTRUCTED, AND BEFORE ASPHALT OR CONCRETE PAVEMENT IS LAYED, CURBS SHOULD BE MEASURED WITH A LEVEL TO ENSURE CURB ALONG ADA RAMPS AND LANDINGS WILL MEET ADA REQUIREMENTS.
8. ADA RAMP CONSTRUCTION WILL BE INSPECTED THOROUGHLY BY THE CITY INSPECTOR. CONTRACTOR SHALL BE REQUIRED TO RECONSTRUCT RAMPS, CURBS AND/OR PAVEMENT AT CONTRACTOR'S EXPENSE IF ADA RAMPS AND LANDINGS CANNOT MEET THE ADA REQUIREMENTS, PER APPROVED PLAN OR APPROVED ALTERNATIVE.
9. CURVE DATA IS FOR BACK OF CURB.

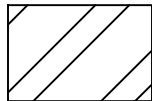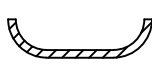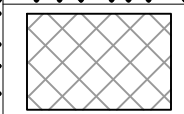LEGEND	
TC—	TOP OF CURB
PV—	TOP OF PAVEMENT
SW—	SIDEWALK
L	LANDING AREA
R	RAMP AREA
T	TRANSITION AREA
	ADA ACCESS ROUTE
	CG-2 CURB & GUTTER
	CG-2 DRY CURB & GUTTER
	ADA RAMP (CONSTRUCTED BY CONTRACTOR)

**Accepted
Record Drawings**


These plans have been reviewed for accuracy and are accepted for basic conformance to the approved construction drawings.

NOT AS-BUILT

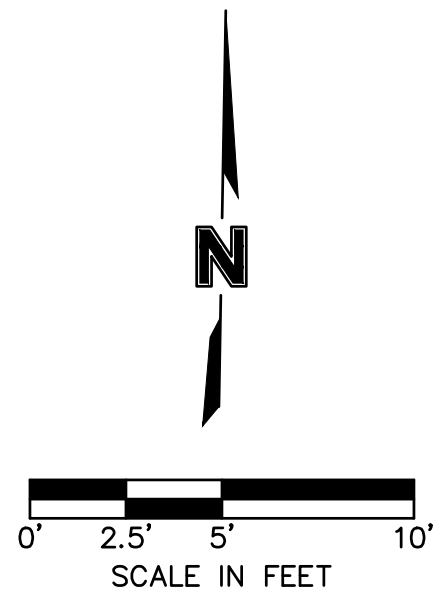


SW BARLEY FIELD DRIVE & SW HOOK FARM DRIVE STREET & STORM SEWER PLANS		HOOK FARMS SECOND PLAT		2021	
				LEE'S SUMMIT, MO	
drawn by: _____		B.M.W./A.A.			
checked by: _____		B.M.W.			
designed by: _____		B.M.W./A.A.			
QA/QC by: _____		J.E.S.			
project no.: _____		B19-4061			
date: _____		01-08-2021			
SHEET C126					

DWG: F:\2019\4001-4500\019-4061-B\40-Design\AutoCAD\Asbuilt\Sheets\GNCV\Street & Storm Plans\C_INT01_B194061.dwg	USER: ssayor
XREFS: C:\PTBLK\B194061	C_PBASE_B194061
DATE: Oct 11, 2022 3:34pm	C_PENDY_B194061
	C_PUTITL_B194061
	C_PSTRM_B194061
	C_PBASE_B194061
	C_PSTRM_B194061
	C_PSURF_B194061
	C_PPATT_B194061

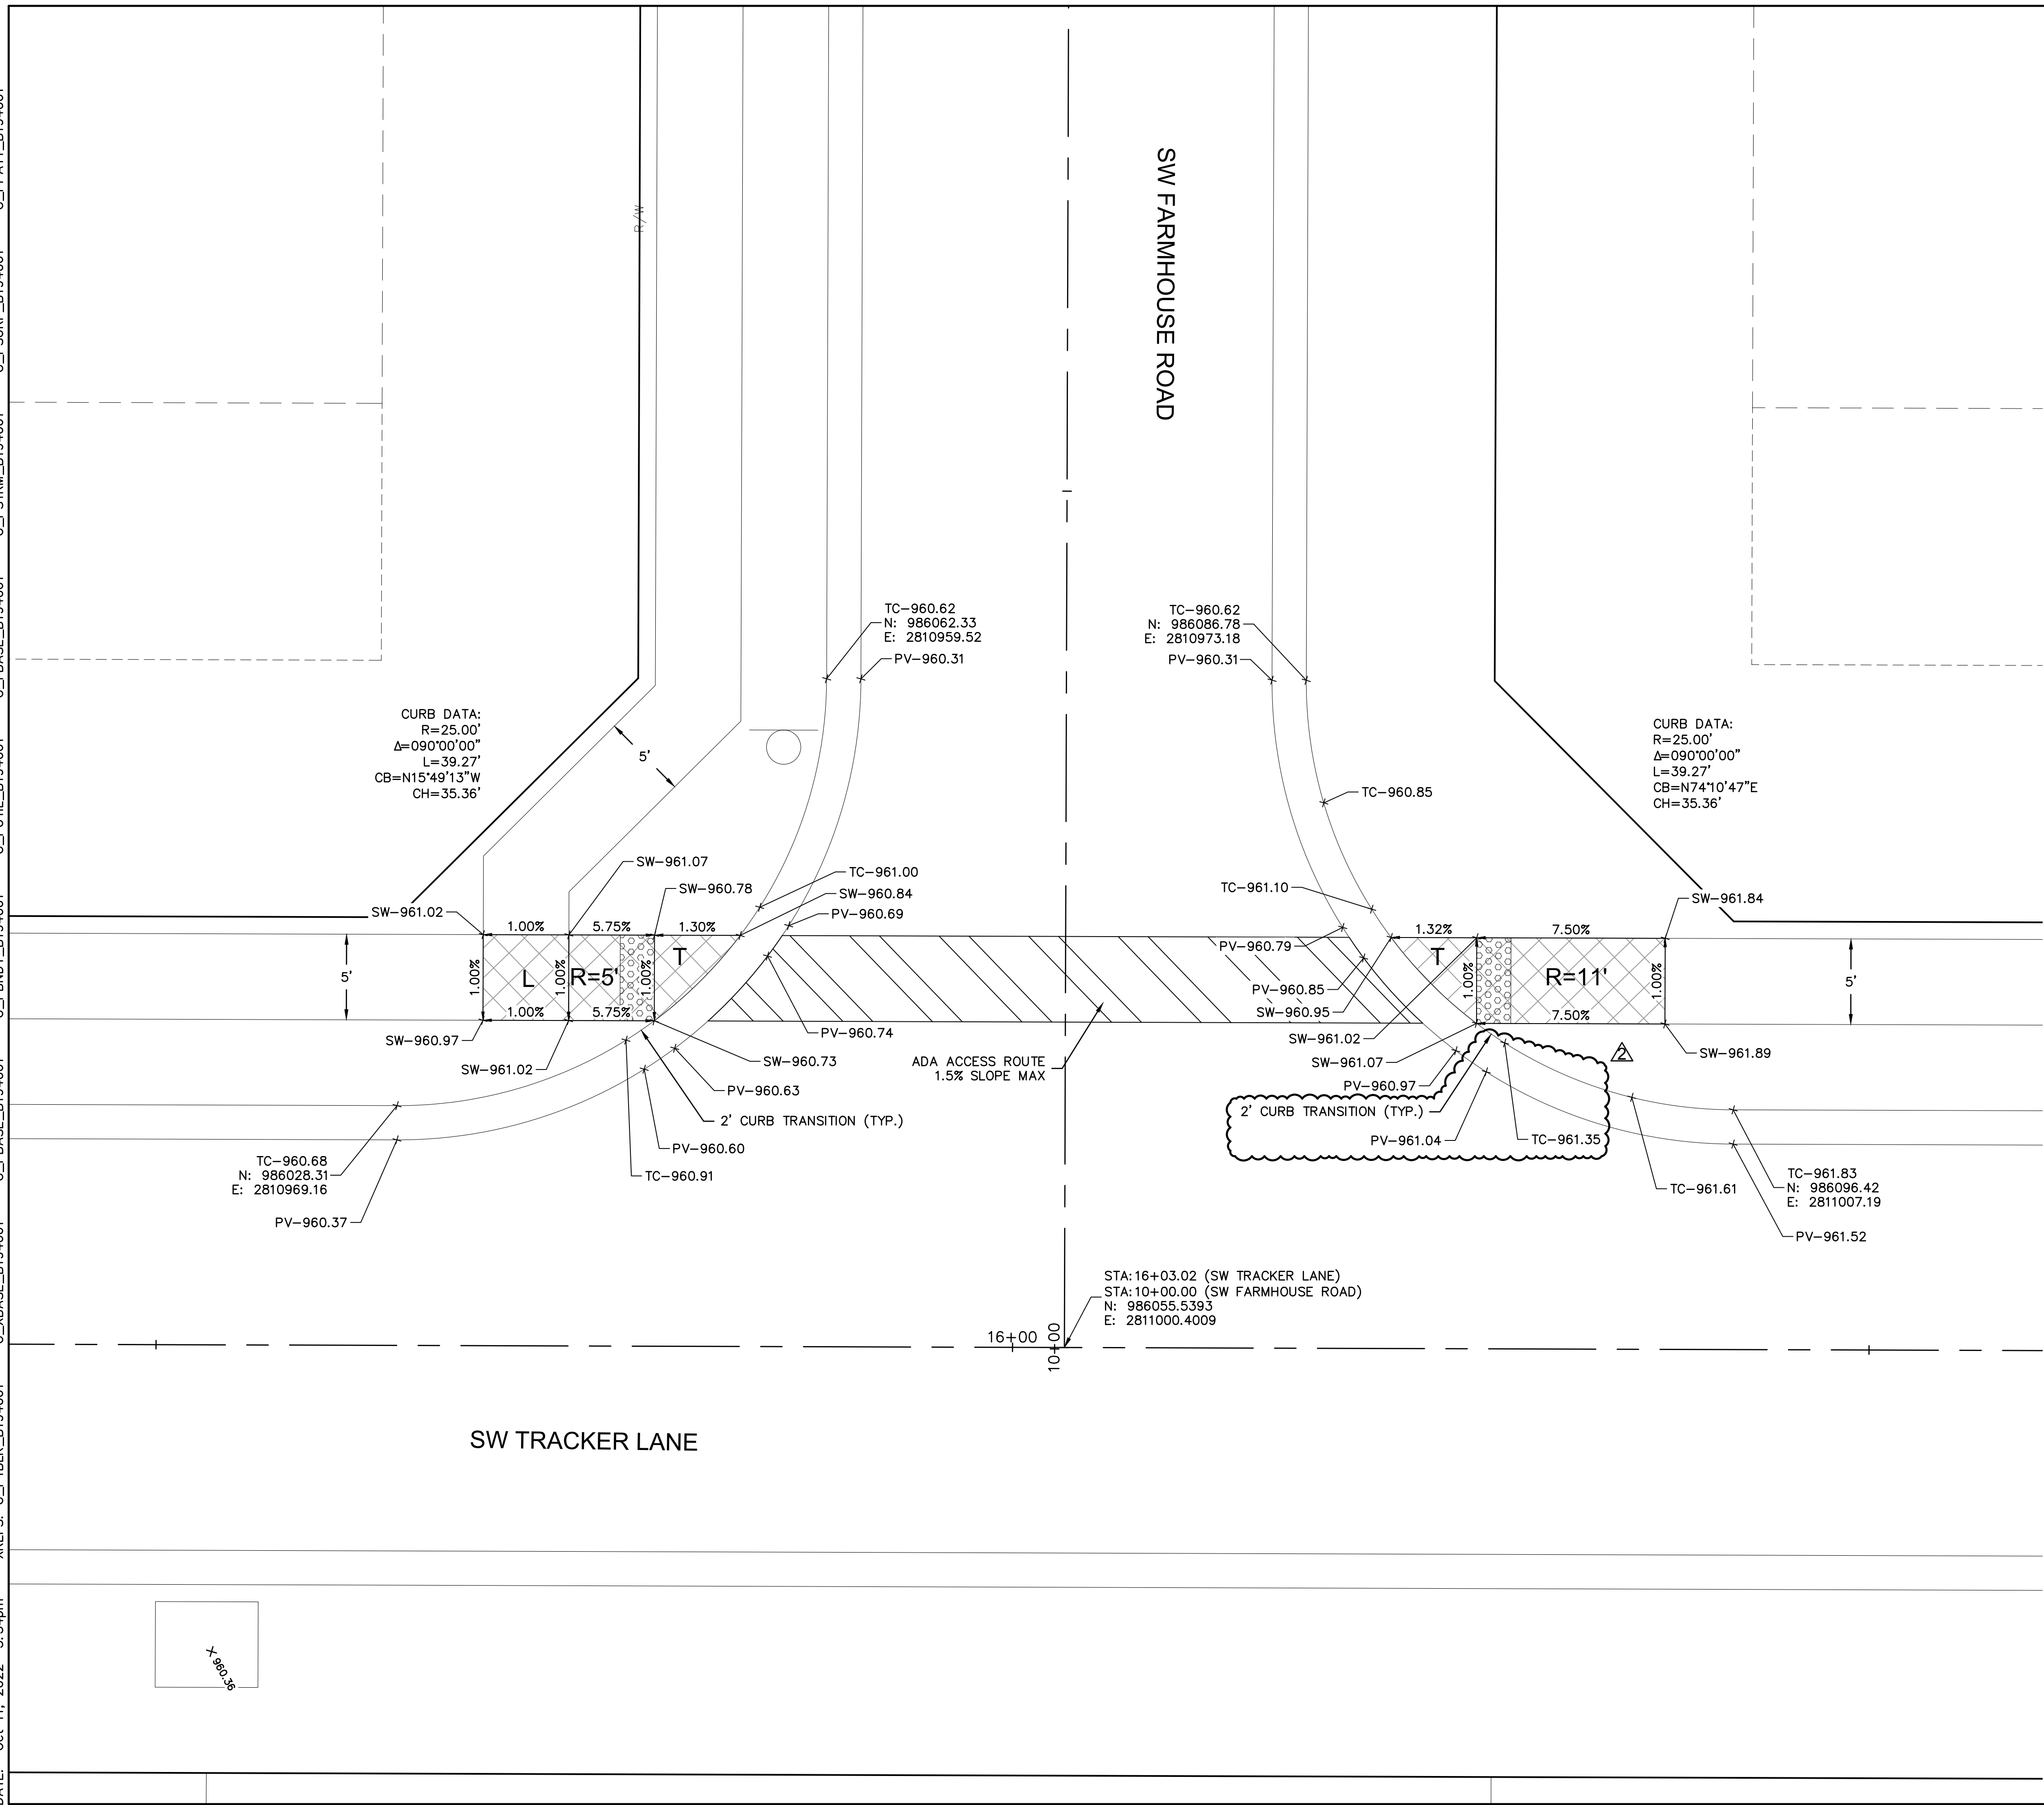


- INTERSECTION AND ADA DETAIL NOTES:
1. ALL ADA CURB RAMPS SHALL BE BUILT PER CURRENT MUNICIPALITY ADOPTED ADA STANDARDS.
2. CURB RAMP FLARES SHALL NOT BE STEEPER THAN 1:10 MAX SLOPES.
3. LANDING SHALL BE PROVIDED WHERE INDICATED ON PLAN SHEET OR BY PROWAG STANDARDS. LANDING SHALL BE 4'x4' MINIMUM.
4. RAMP RUNS SHALL HAVE A MAXIMUM RUNNING SLOPE OF 1:12 UNLESS THE RAMP LENGTH IS OVER 15 FEET, THEN THE SLOPE CAN BE GREATER AS INDICATED IN DETAILS TO REACH STREET GRADES.
5. LANDINGS SHALL HAVE A MAXIMUM SLOPE OF 2% IN ANY DIRECTION.
6. CROSS SLOPE FOR RAMPS AND SIDEWALK SHALL NOT EXCEED 2%.
7. AFTERBAYS HAVE BEEN CONSTRUCTED AND BEFORE ASPHALT OR CONCRETE PAVEMENT IS LAYED, CURBS SHOULD BE MEASURED WITH A LEVEL TO ENSURE CURB ALONG ADA RAMPS AND LANDINGS WILL MEET ADA REQUIREMENTS.
8. ADA RAMP CONSTRUCTION WILL BE INSPECTED THOROUGHLY BY THE CITY INSPECTOR. CONTRACTOR SHALL BE REQUIRED TO RECONSTRUCT RAMPS, CURBS AND/OR PAVEMENT AT CONTRACTOR'S EXPENSE IF ADA RAMPS AND LANDINGS CANNOT MEET THE ADA REQUIREMENTS, PER APPROVED PLAN OR APPROVED ALTERNATIVE.
9. CURVE DATA IS FOR BACK OF CURB.

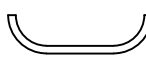LEGEND	
TC-	TOP OF CURB
PV-	TOP OF PAVEMENT
SW-	SIDEWALK
L	LANDING AREA
R	RAMP AREA
T	TRANSITION AREA
	ADA ACCESS ROUTE
	CG-2 CURB & GUTTER
	CG-2 DRY CURB & GUTTER
	ADA RAMP (CONSTRUCTED BY CONTRACTOR)

**Accepted
Record Drawings**


These plans have been reviewed for accuracy and are accepted for basic conformance to the approved construction drawings.

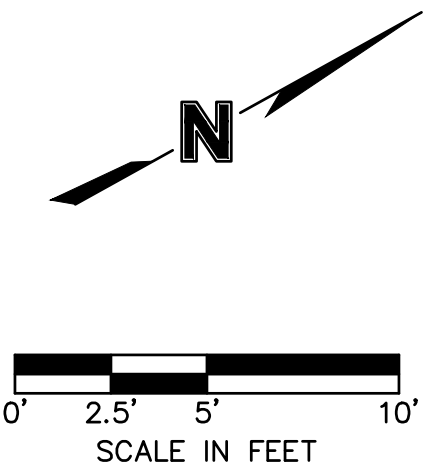


NOT AS-BUILT

SW FARMHOUSE ROAD & SW TRACKER LANE STREET & STORM SEWER PLANS		HOOK FARMS SECOND PLAT		2021	
				LEE'S SUMMIT, MO	
drawn by: _____ B.M.W./A.A.					
checked by: _____ B.M.W.					
designed by: _____ B.M.W./A.A.					
QA/QC by: _____ J.E.S.					
project no.: _____ B19-4061					
date: _____ 01-08-2021					
SHEET C127					

USER: ssayfor			
C_PUTIL_B194061	C_FBASE_B194061	C_PSTRM_B194061	C_PSURF_B194061
C_PPATT_B194061			

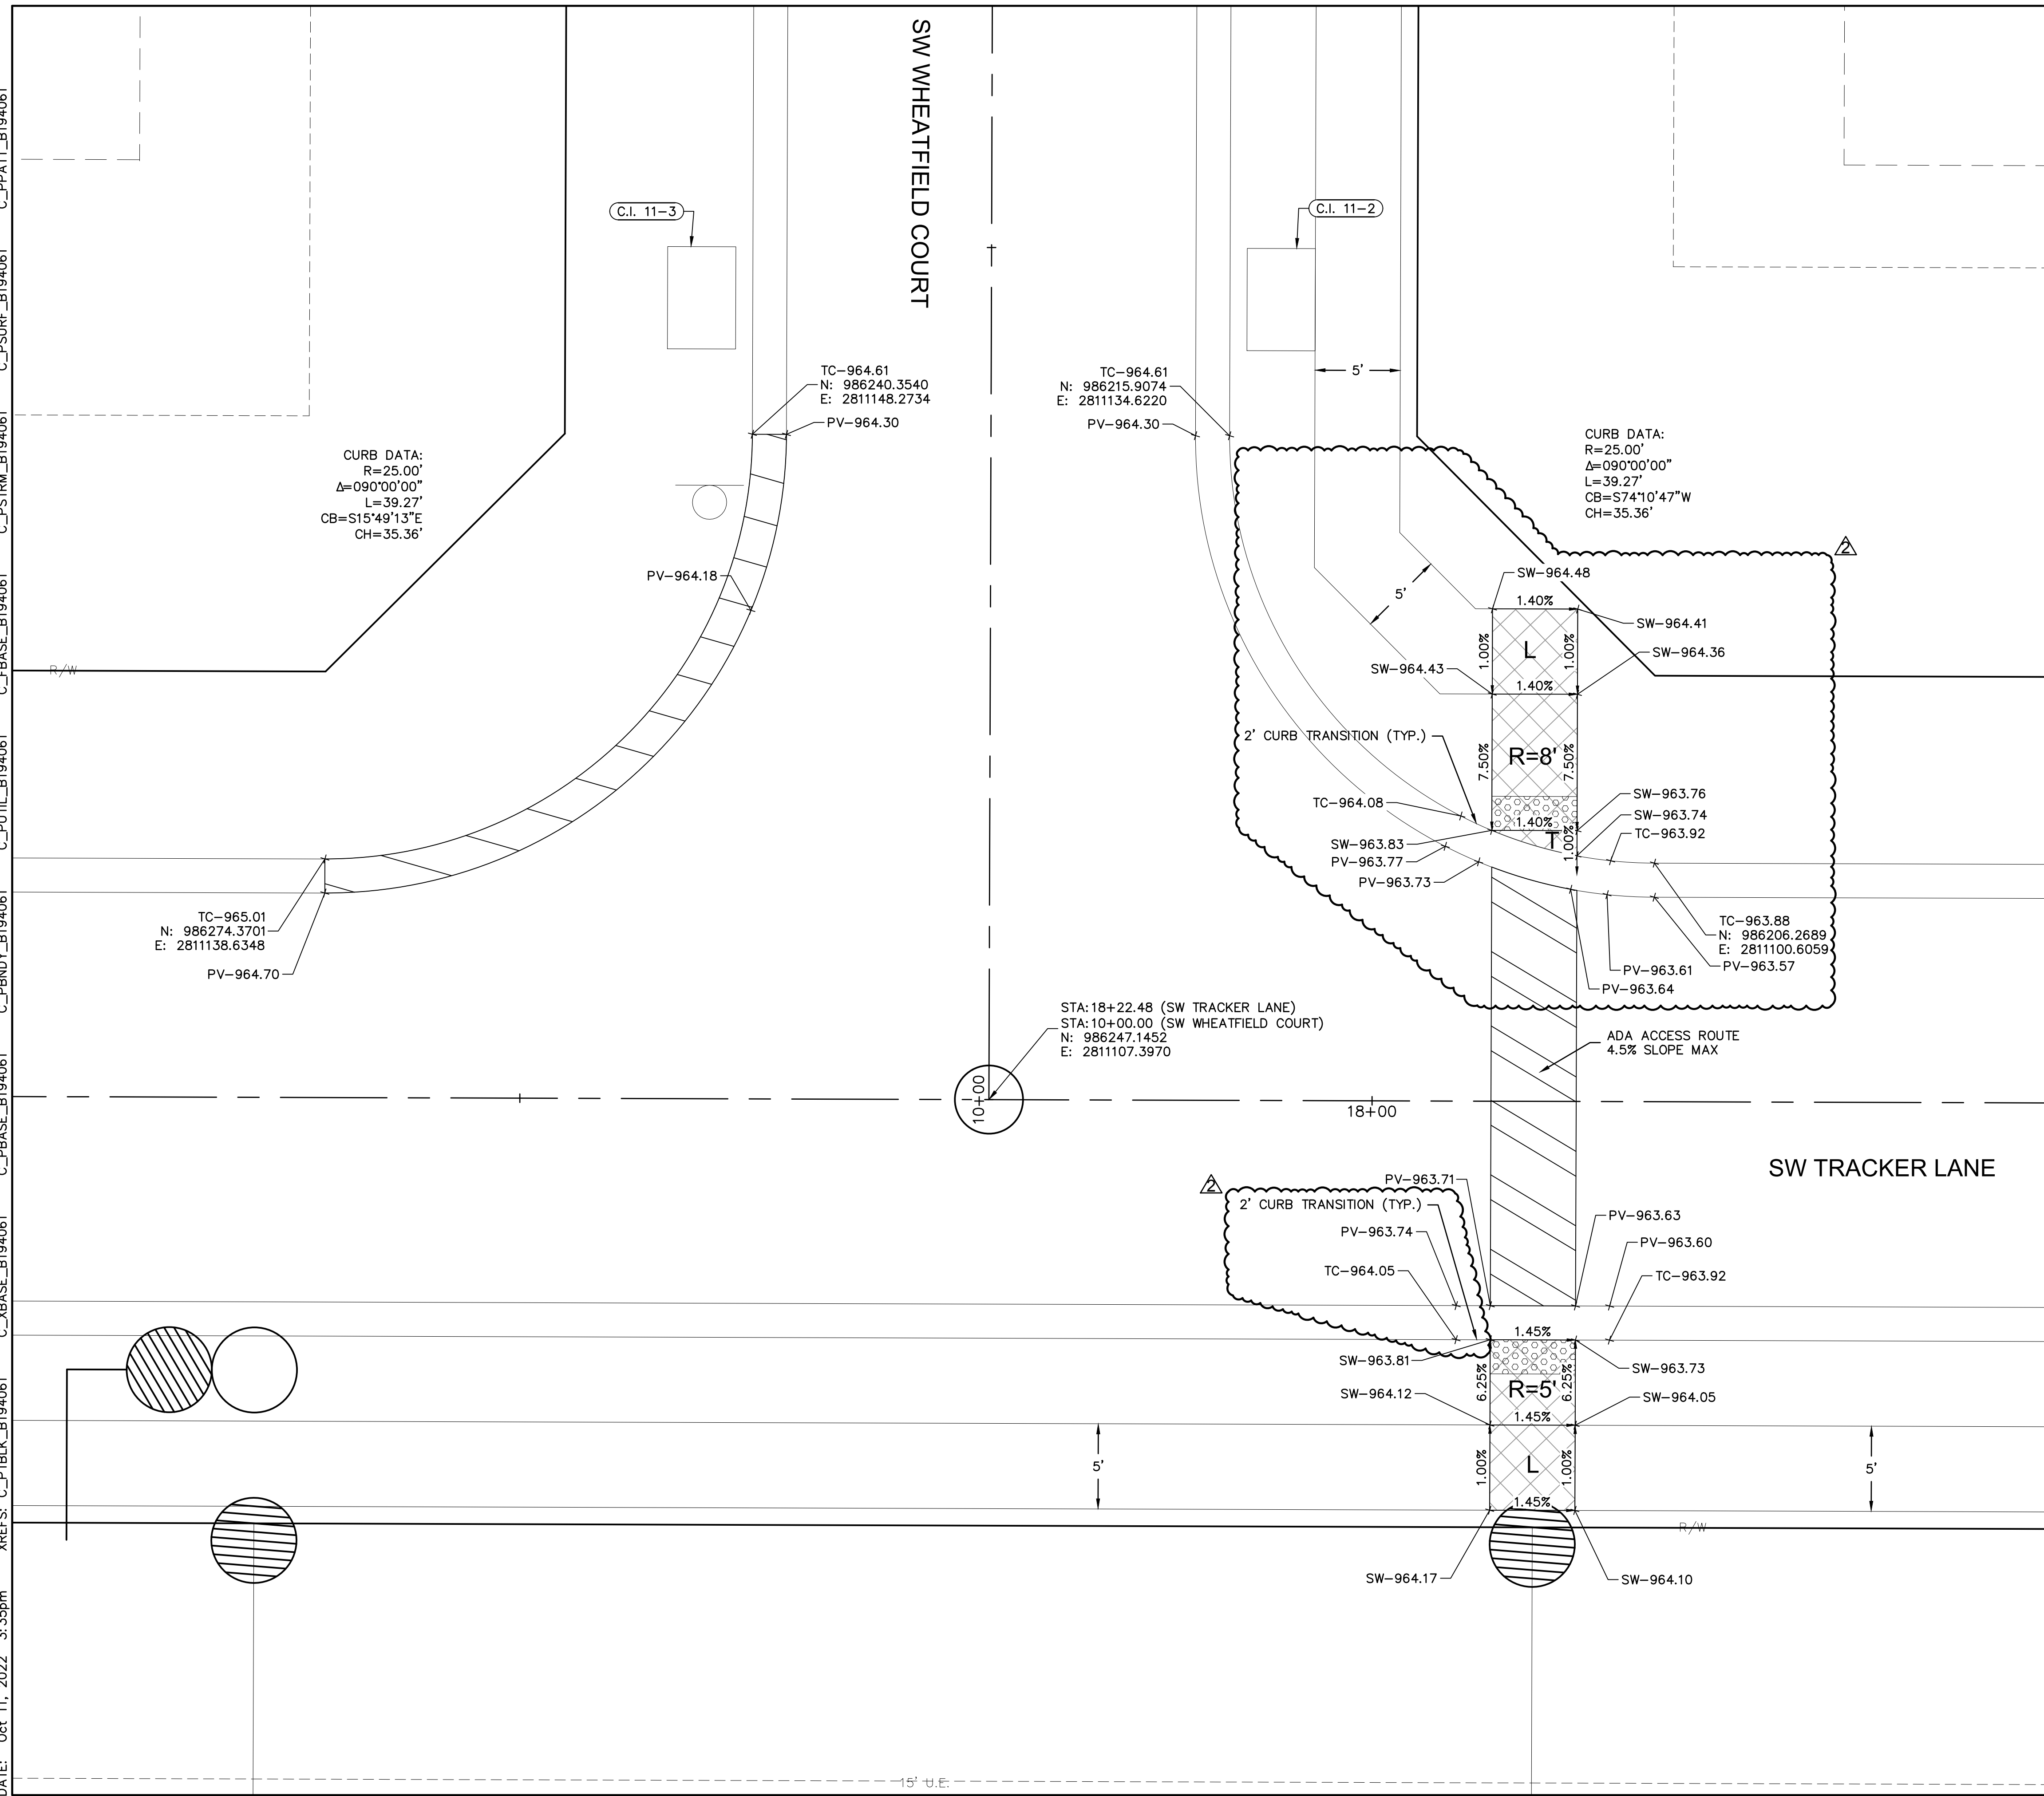


- INTERSECTION AND ADA DETAIL NOTES:
1. ALL ADA CURB RAMPS SHALL BE BUILT PER CURRENT MUNICIPALITY ADOPTED ADA STANDARDS.
2. CURB RAMP FLARES SHALL NOT BE STEEPER THAN 1:10 MAX SLOPES.
3. LANDING SHALL BE PROVIDED WHERE INDICATED ON PLAN SHEET OR BY PROWAG STANDARDS. LANDING SHALL BE 4'x4' MINIMUM.
4. RAMP RUNS SHALL HAVE A MAXIMUM RUNNING SLOPE OF 1:12 UNLESS THE RAMP LENGTH IS OVER 15 FEET, THEN THE SLOPE CAN BE GREATER AS INDICATED IN DETAILS TO REACH STREET GRADES.
5. LANDINGS SHALL HAVE A MAXIMUM SLOPE OF 2% IN ANY DIRECTION.
6. CROSS SLOPE FOR RAMPS AND SIDEWALK SHALL NOT EXCEED 2%.
7. AFTER CURBS HAVE BEEN CONSTRUCTED, AND BEFORE SPHALT OR CONCRETE PAVEMENT IS POURED, CURBS SHOULD BE MEASURED WITH A LEVEL TO ENSURE CURB ALONG ADA RAMPS AND LANDINGS WILL MEET ADA REQUIREMENTS.
8. ADA RAMP CONSTRUCTION WILL BE INSPECTED THOROUGHLY BY THE CITY INSPECTOR. CONTRACTOR SHALL BE REQUIRED TO RECONSTRUCT RAMPS, CURBS AND/OR PAVEMENT AT CONTRACTOR'S EXPENSE IF ADA RAMPS AND LANDINGS CANNOT MEET THE ADA REQUIREMENTS, PER APPROVED PLAN OR APPROVED ALTERNATIVE.
9. CURVE DATA IS FOR BACK OF CURB.

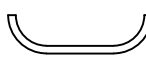LEGEND	
TC-	TOP OF CURB
PV-	TOP OF PAVEMENT
SW-	SIDEWALK
L	LANDING AREA
R	RAMP AREA
T	TRANSITION AREA
	ADA ACCESS ROUTE
	CG-2 CURB & GUTTER
	CG-2 DRY CURB & GUTTER
	ADA RAMP (CONSTRUCTED BY CONTRACTOR)

**Accepted
Record Drawings**


These plans have been reviewed for accuracy and are accepted for basic conformance to the approved construction drawings.

NOT AS-BUILT

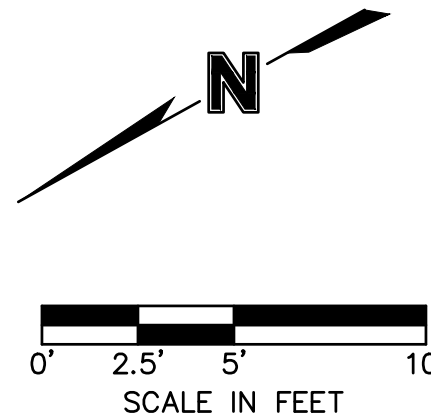

SW WHEATFIELD COURT & SW TRACKER LANE STREET & STORM SEWER PLANS		HOOK FARMS SECOND PLAT		2021	
				LEE'S SUMMIT, MO	
drawn by: _____		B.M.W./A.A.			
checked by: _____		B.M.W.			
designed by: _____		B.M.W./A.A.			
QA/QC by: _____		J.E.S.			
project no.: _____		B19-4061			
date: _____		01-08-2021			
SHEET C128					

DWG: F:\2019\4001-4500\019-4061-BV40-Design\AutoCAD\Asbuilt\Sheets\GNCV\Street & Storm Plans\B194061.dwg
DATE: Oct 11, 2022 3:35pm
XREFS: C_PTBK_B194061 C_XBASE_B194061 C_PBASE_B194061 C_PSTRM_B194061 C_PSURF_B194061 C_PPATT_B194061
USER: ssc\or C_PUTIL_B194061

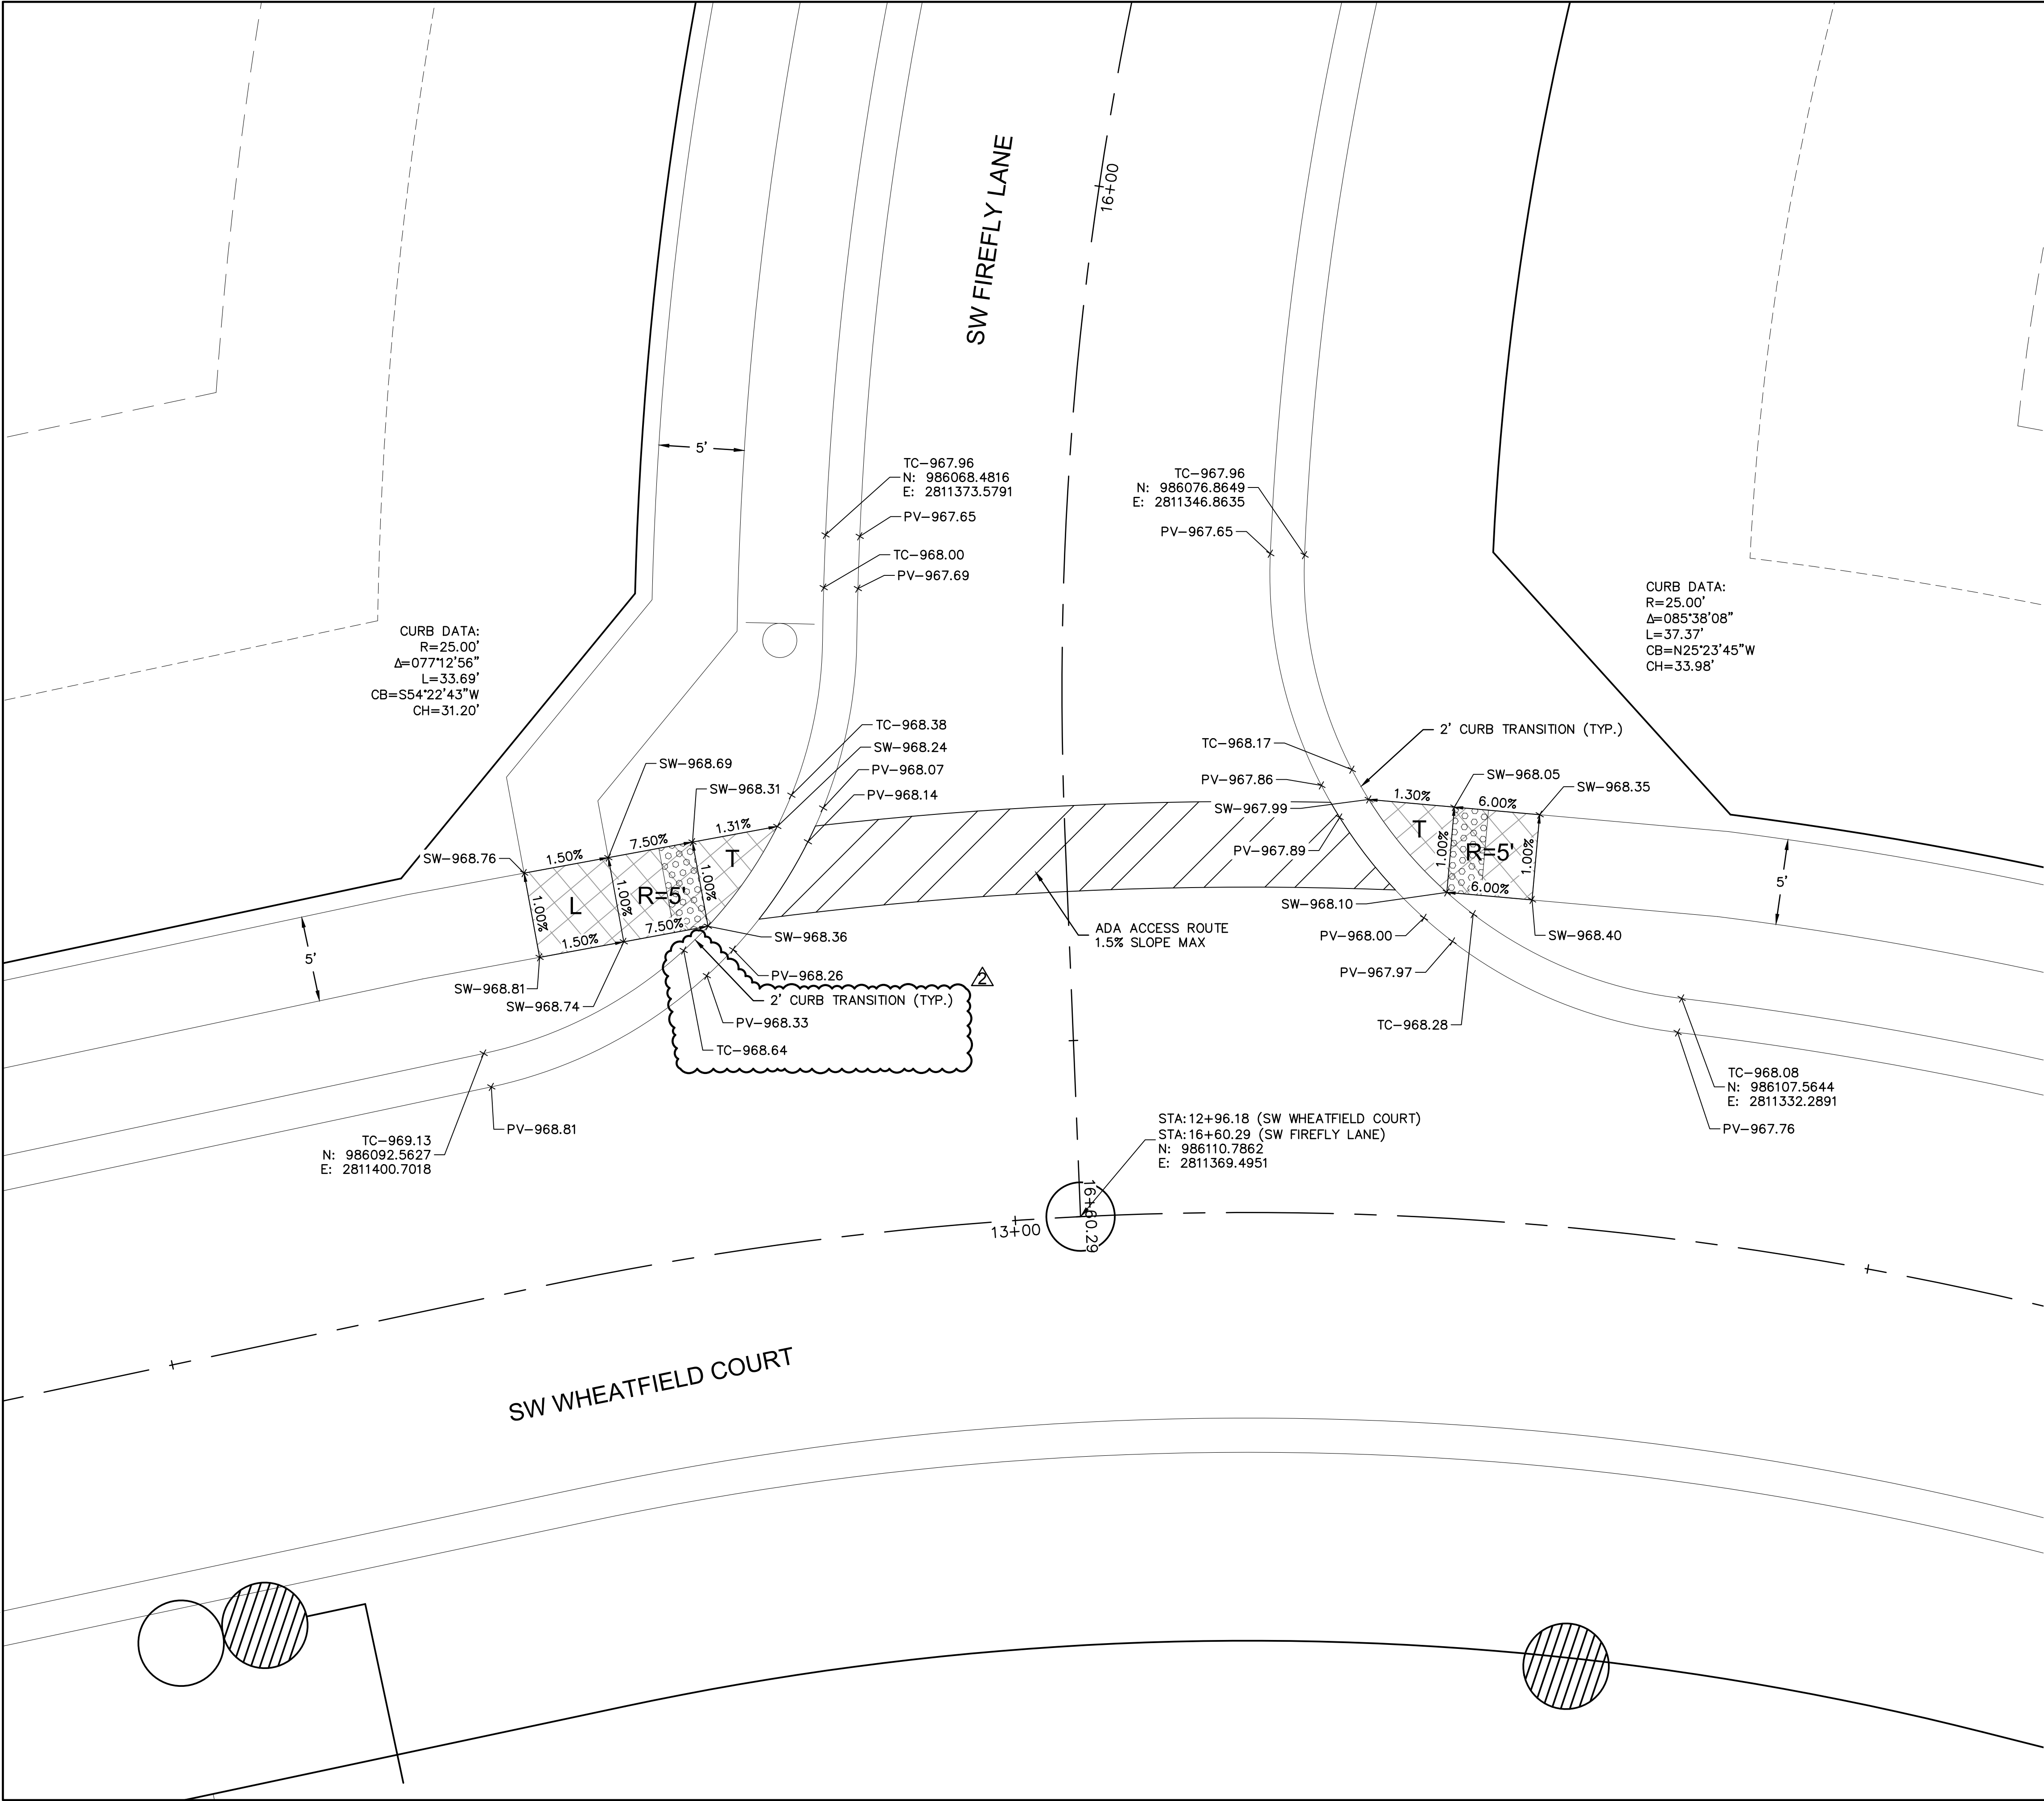

- INTERSECTION AND ADA DETAIL NOTES:
1. ALL ADA CURB RAMP SHALL BE BUILT PER CURRENT MUNICIPALITY ADOPTED ADA STANDARDS.
 2. CURB RAMP FLARES SHALL NOT BE STEEPER THAN 1:10 MAX SLOPES.
 3. LANDING SHALL BE PROVIDED WHERE INDICATED ON PLAN SHEET OR BY PROWAG STANDARDS. LANDING SHALL BE 4'X4' MINIMUM.
 4. RAMP RUNS SHALL HAVE A MAXIMUM RUNNING SLOPE OF 1:12 UNLESS THE RAMP LENGTH IS OVER 15 FEET, THEN THE SLOPE CAN BE GREATER AS INDICATED IN DETAILS TO REACH STREET GRADES.
 5. LANDINGS SHALL HAVE A MAXIMUM SLOPE OF 2% IN ANY DIRECTION.
 6. CROSS SLOPE FOR RAMP AND SIDEWALK SHALL NOT EXCEED 2%.
 7. AFTER CURBS HAVE BEEN CONSTRUCTED, AND BEFORE ASPHALT OR CONCRETE PAVEMENT IS POURED, CURBS SHOULD BE MEASURED WITH A LEVEL TO ENSURE CURB ALONG ADA RAMP AND LANDINGS WILL MEET ADA REQUIREMENTS.
 8. ADA RAMP CONSTRUCTION WILL BE INSPECTED THOROUGHLY BY THE CITY INSPECTOR. CONTRACTOR SHALL BE REQUIRED TO RECONSTRUCT RAMP, CURBS AND/OR PAVEMENT AT CONTRACTOR'S EXPENSE IF ADA RAMP AND LANDINGS CANNOT MEET THE ADA REQUIREMENTS, PER APPROVED PLAN OR APPROVED ALTERNATIVE.
 9. CURVE DATA IS FOR BACK OF CURB.

LEGEND	
TC--	TOP OF CURB
PV--	TOP OF PAVEMENT
SW--	SIDEWALK
L	LANDING AREA
R	RAMP AREA
T	TRANSITION AREA
	ADA ACCESS ROUTE
	CG-2 CURB & GUTTER
	CG-2 DRY CURB & GUTTER
	ADA RAMP (CONSTRUCTED BY CONTRACTOR)

**Accepted
Record Drawings**

These plans have been reviewed for accuracy and are accepted for basic conformance to the approved construction drawings.

SW FIREFLY LANE & SW WHEATFIELD COURT
STREET & STORM SEWER PLANS

HOOK FARMS
SECOND PLAT

LEE'S SUMMIT, MO

DATE: 03-23-2021
REVISED PER CITY COMMENTS

DATE: 04-16-2021
REVISED PER CITY COMMENTS

DATE: 09-30-2021
CHANGES TO APPROVED PLANS

DATE: 2021

REVISIONS

BY

STATE OF MISSOURI
JULIE ELAINE SELLERS
PROFESSIONAL ENGINEER
NUMBER PE-2017000367
12/7/22

Olsson - Civil Engineering
Missouri Certificate of Authority #001592
1301 Burlington Street
North Kansas City, MO 64116
TEL 816.361.1177
FAX 816.361.1888
www.olson.com

olsson



drawn by: B.M.W./A.A.
checked by: B.M.W.
designed by: B.M.W./A.A.
QA/QC by: J.E.S.
project no.: B19-4061
date: 01-08-2021

SHEET
C129

& Storm Plans\C_INT02_B194061.dwg	USER: ssaylor		
C_PBASE_B194061	C_PBN DY_B194061	C_PSTRM_B194061	C_PSURF_B194061
		C_FBASE_B194061	C_PPATT_B194061




3. LANDING SHALL BE PROVIDED WHERE INDICATED ON PLAN SHEET OR BY PROWAG STANDARDS. LANDING SHALL BE 4'x4' MINIMUM.
4. RAMP RUNS SHALL HAVE A MAXIMUM RUNNING SLOPE OF 1:12 UNLESS THE RAMP LENGTH IS OVER 15 FEET, THEN THE SLOPE CAN BE GREATER AS INDICATED IN DETAILS TO REACH STREET GRADES.
5. LANDINGS SHALL HAVE A MAXIMUM SLOPE OF 2% IN ANY DIRECTION.
6. CROSS SLOPE FOR RAMPS AND SIDEWALK SHALL NOT EXCEED 2%.
7. AFTER CURBS HAVE BEEN CONSTRUCTED, AND BEFORE ASPHALT OR CONCRETE PAVEMENT IS POURED, CURBS SHOULD BE MEASURED WITH A LEVEL TO ENSURE CURB ALONG ADA RAMPS AND LANDINGS WILL MEET ADA REQUIREMENTS.
8. ADA RAMP CONSTRUCTION WILL BE INSPECTED THOROUGHLY BY THE CITY INSPECTOR. CONTRACTOR SHALL BE REQUIRED TO RECONSTRUCT RAMPS, CURBS AND/OR PAVEMENT AT CONTRACTOR'S EXPENSE IF ADA RAMPS AND LANDINGS CANNOT MEET THE ADA REQUIREMENTS, PER APPROVED PLAN OR APPROVED ALTERNATIVE.
9. CURVE DATA IS FOR BACK OF CURB.

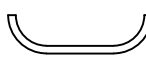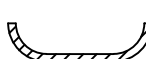LEGEND	
TC-	TOP OF CURB
PV-	TOP OF PAVEMENT
SW-	SIDEWALK
L	LANDING AREA
R	RAMP AREA
T	TRANSITION AREA
	ADA ACCESS ROUTE
	CG-2 CURB & GUTTER
	CG-2 DRY CURB & GUTTER
	ADA RAMP (CONSTRUCTED BY CONTRACTOR)


**Accepted
Record Drawings**

These plans have been reviewed for accuracy and are accepted for basic conformance to the approved construction drawings.

NOT AS-BUILT

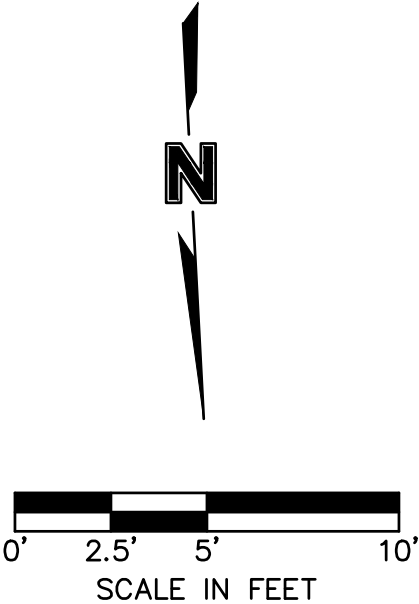[illegible]

DWG: F:\2019\4001-4500\019-4061-B\40-Design\AutoCAD\Asbuilt\Sheets\GNCV\Street & Storm Plans\C_INT02_B194061.dwg	USER: ssaylor
XREFS: C:\PTBLK_B194061	C_PBASE_B194061
DATE: Oct 11, 2022 3:35pm	C_PENDY_B194061
	C_PUTIL_B194061
	C_FBASE_B194061
	C_PSTRM_B194061
	C_PSURF_B194061
	C_PPATT_B194061

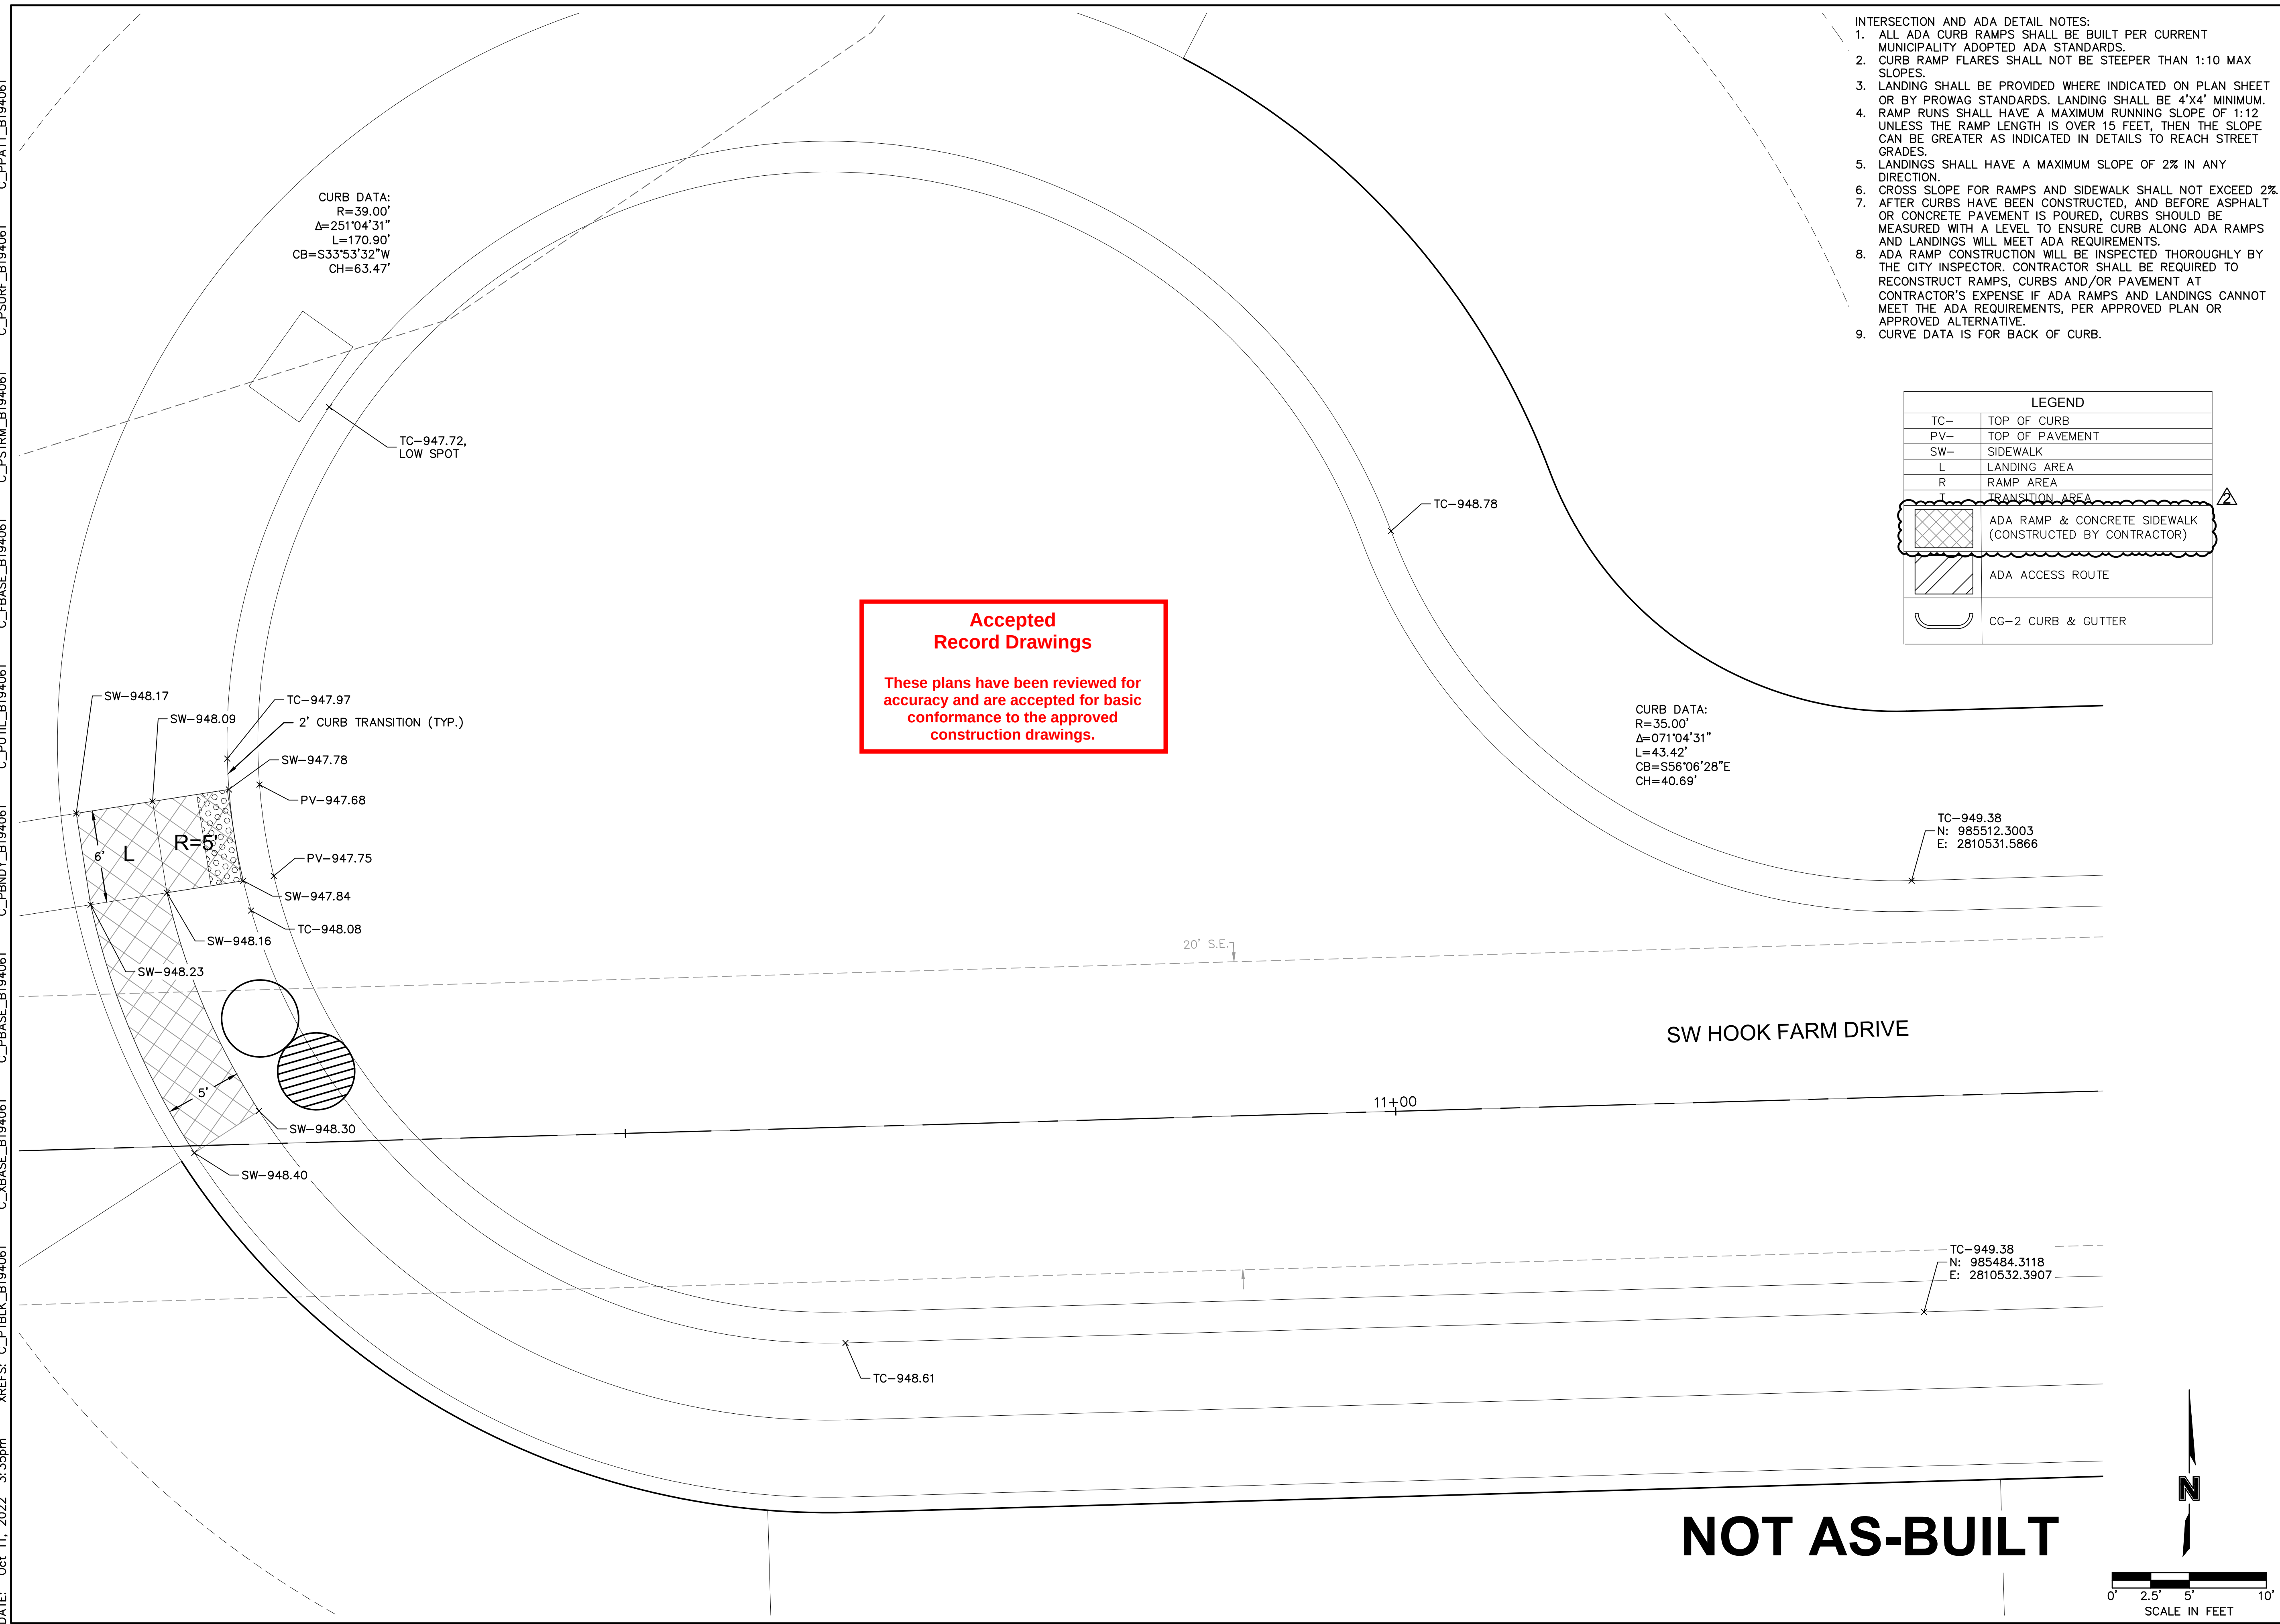


- INTERSECTION AND ADA DETAIL NOTES:
1. ALL ADA CURB RAMPS SHALL BE BUILT PER CURRENT MUNICIPALITY ADOPTED ADA STANDARDS.
2. CURB RAMP FLARES SHALL NOT BE STEEPER THAN 1:10 MAX SLOPES.
3. LANDING SHALL BE PROVIDED WHERE INDICATED ON PLAN SHEET OR BY PROWAG STANDARDS. LANDING SHALL BE 4'x4' MINIMUM.
4. RAMP RUNS SHALL HAVE A MAXIMUM RUNNING SLOPE OF 1:12 UNLESS THE RAMP LENGTH IS OVER 15 FEET, THEN THE SLOPE CAN BE GREATER AS INDICATED IN DETAILS TO REACH STREET GRADES.
5. LANDINGS SHALL HAVE A MAXIMUM SLOPE OF 2% IN ANY DIRECTION.
6. CROSS SLOPE FOR RAMPS AND SIDEWALK SHALL NOT EXCEED 2%.
7. AFTER CURBS HAVE BEEN CONSTRUCTED, AND BEFORE ASPHALT OR CONCRETE PAVEMENT IS POURED, CURBS SHOULD BE MEASURED WITH A LEVEL TO ENSURE CURB ALONG ADA RAMPS AND LANDINGS WILL MEET ADA REQUIREMENTS.
8. ADA RAMP CONSTRUCTION WILL BE INSPECTED THOROUGHLY BY THE CITY INSPECTOR. CONTRACTOR SHALL BE REQUIRED TO RECONSTRUCT RAMPS, CURBS AND/OR PAVEMENT AT CONTRACTOR'S EXPENSE IF ADA RAMPS AND LANDINGS CANNOT MEET THE ADA REQUIREMENTS, PER APPROVED PLAN OR APPROVED ALTERNATIVE.
9. CURVE DATA IS FOR BACK OF CURB.

LEGEND	
TC-	TOP OF CURB
PV-	TOP OF PAVEMENT
SW-	SIDEWALK
L	LANDING AREA
R	RAMP AREA
T	TRANSITION AREA
	ADA RAMP & CONCRETE SIDEWALK (CONSTRUCTED BY CONTRACTOR)
	ADA ACCESS ROUTE
	CG-2 CURB & GUTTER


olsson


Olsson - Civil Engineering
Missouri Certificate of Authority #001832
1301 Burlington Street
North Kansas City, MO 64116
TEL 816.361.1177
FAX 816.361.1888
www.olsson.com

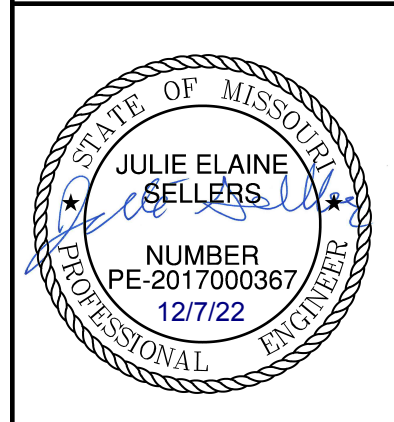
[illegible]


SW HOOK FARM DRIVE CUL-DE-SAC STREET & STORM SEWER PLANS	HOOK FARMS SECOND PLAT	2021
		LEE'S SUMMIT, MO
drawn by: _____ B.M.W./J.A. designed by: _____ B.M.W./J.A. O&O/C by: _____ J.E.S. project no.: _____ B19-4061 date: _____ 01-08-2021		
SHEET C131		

NOT AS-BUILT

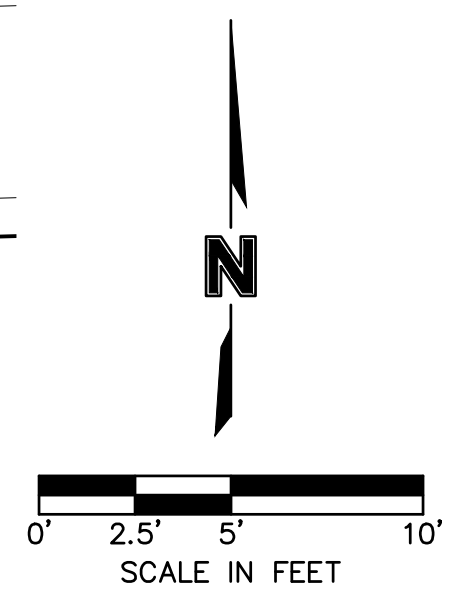

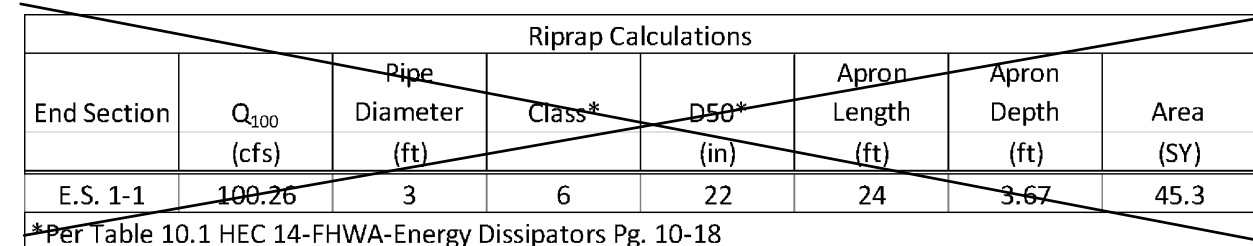

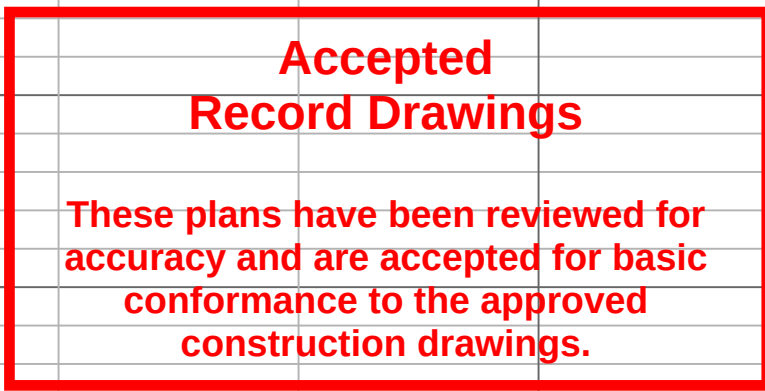

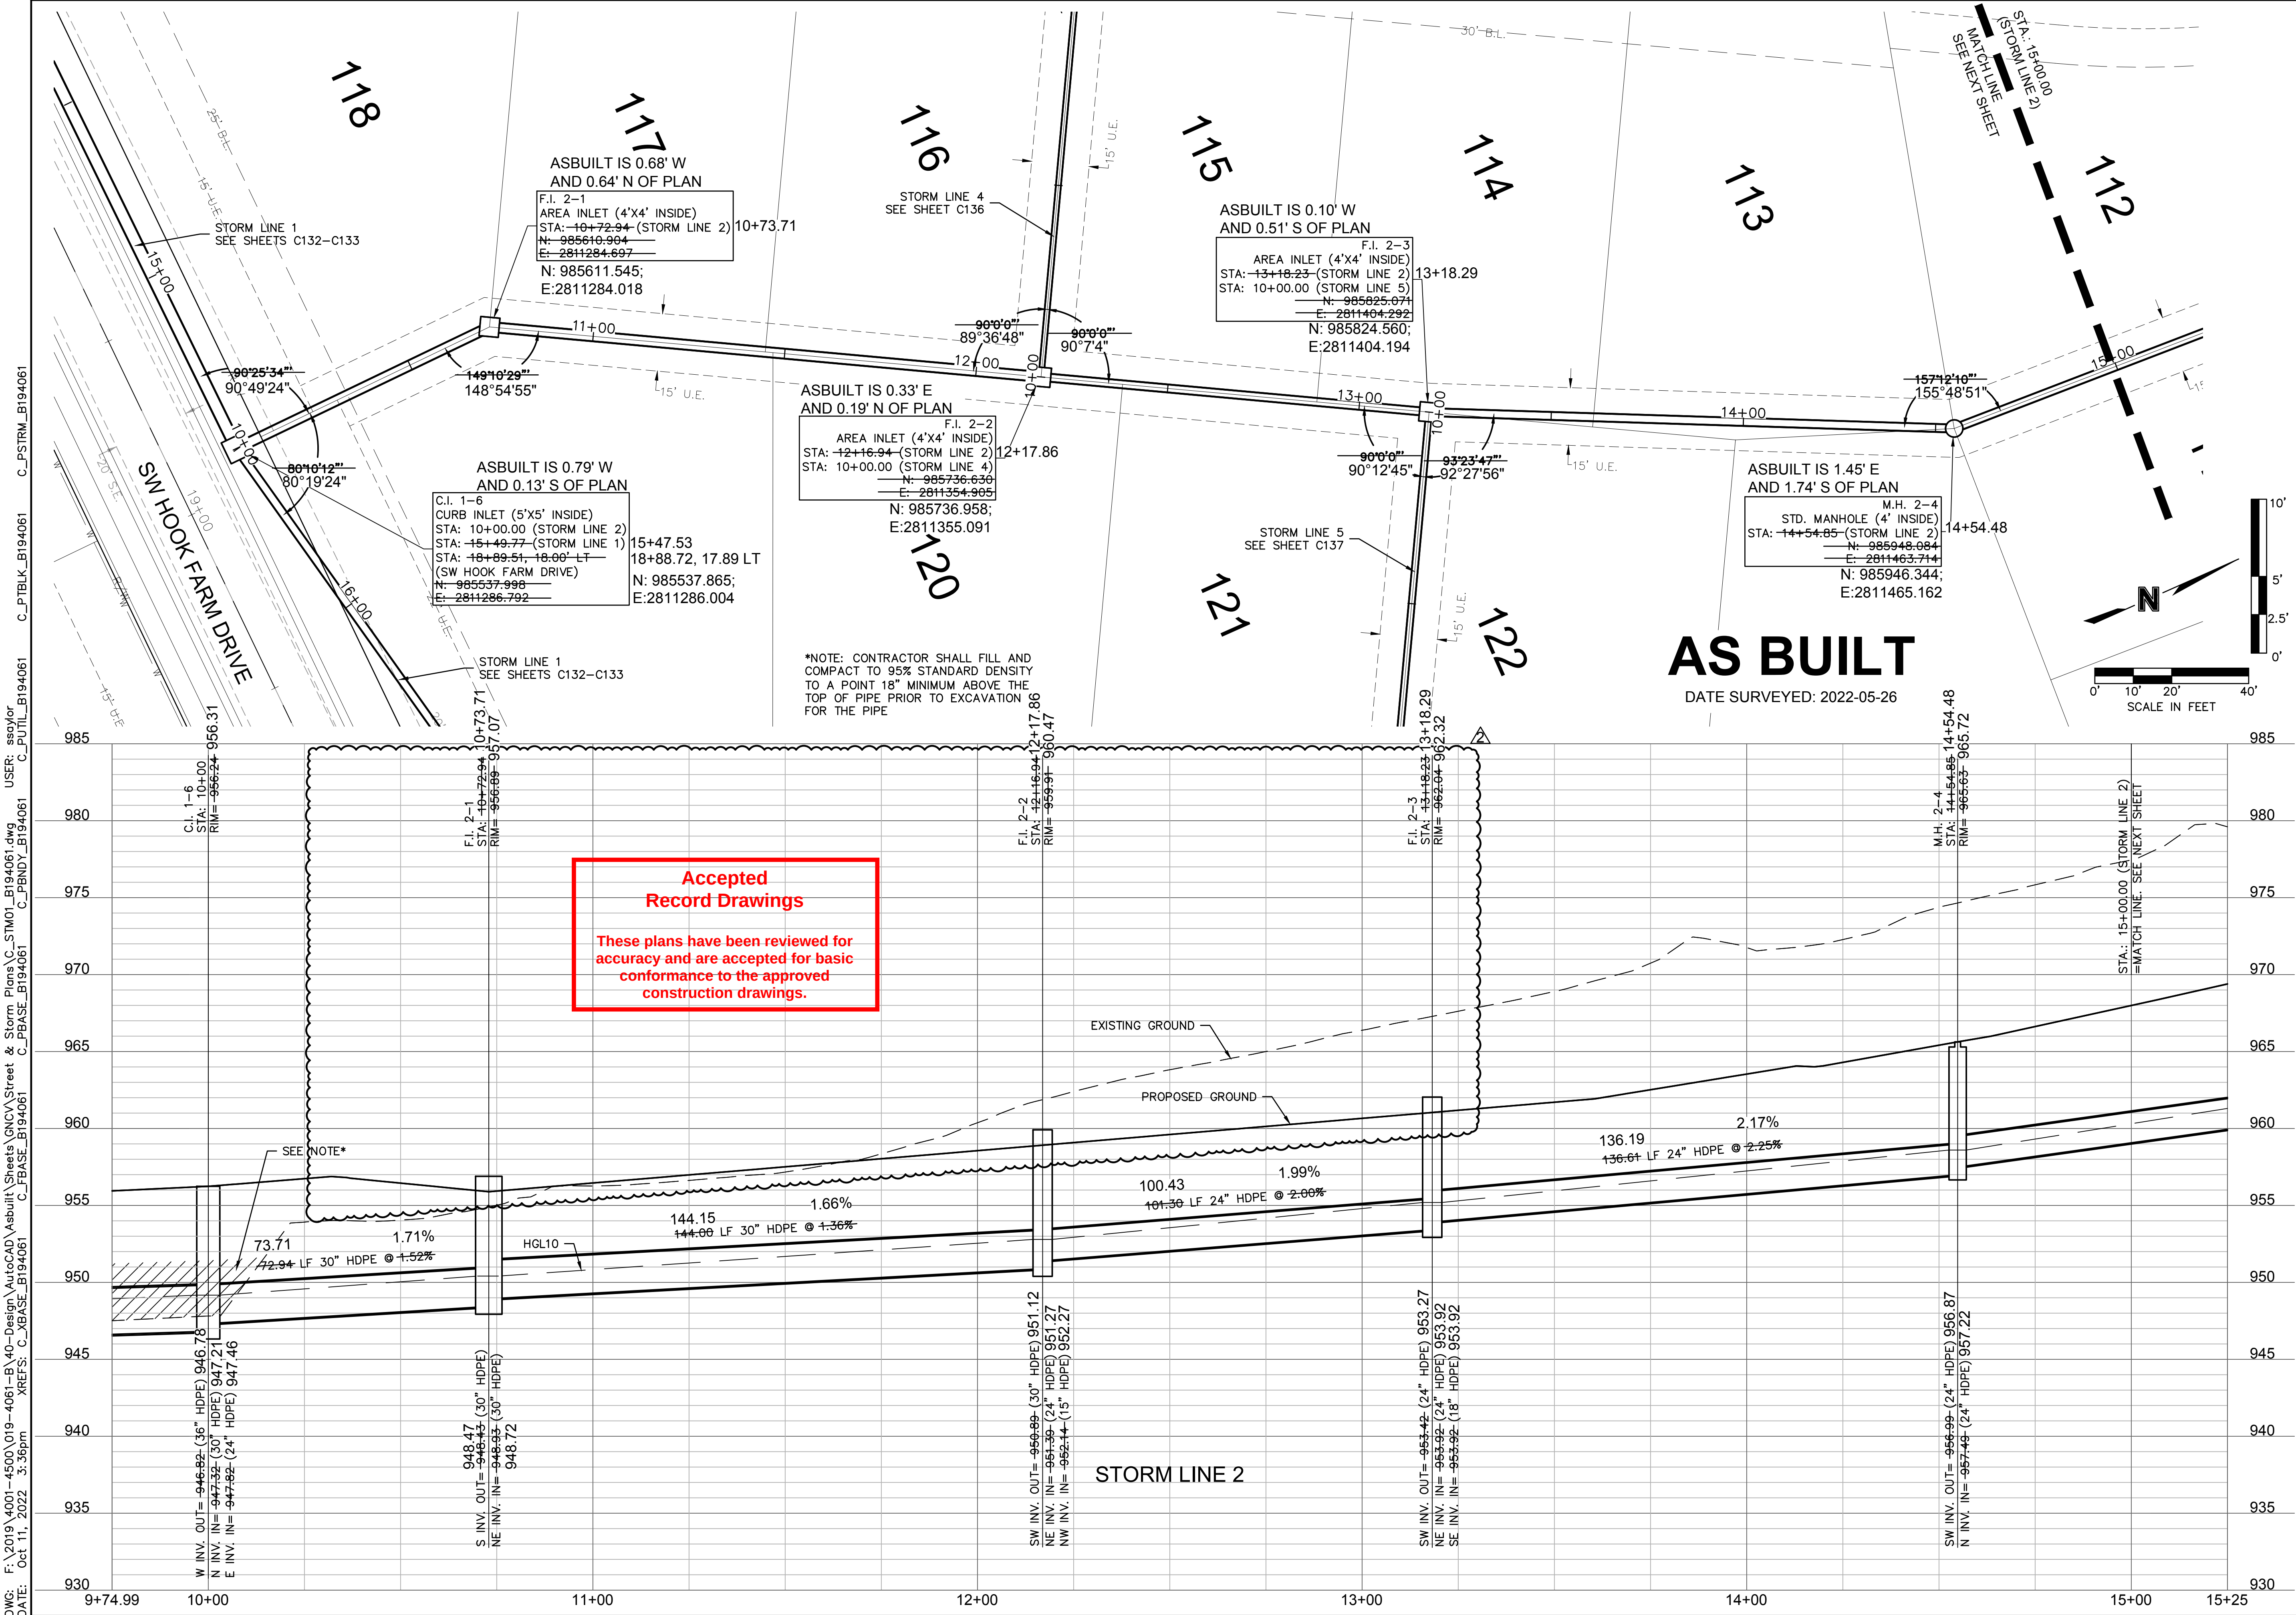

olsson

Olsson - Civil Engineering
Missouri Certificate of Authority #001592
1301 Burlington Street
North Kansas City, MO 64116
TEL 816.361.1177
FAX 816.361.1888
www.olsson.com

JULIE ELAINE SELLERS
PROFESSIONAL ENGINEER
NUMBER PE-2017000367
12/7/22

REV.	NO.	DATE	DESCRIPTION
1	03-23-2021	REVISED PER CITY COMMENTS	
2	04-16-2021	REVISED PER CITY COMMENTS	
3	09-30-2021	CHANGES TO APPROVED PLANS	

STORM SEWER PLAN & PROFILE (LINE 2)
STREET & STORM SEWER PLANS

HOOK FARMS
SECOND PLAT


LEE'S SUMMIT, MO




2021

REVISIONS

drawn by: B.M.W./A.A.
checked by: B.M.W./
designed by: B.M.W./A.A.
QA/QC by: J.E.S.
project no.: B19-4061
date: 01-08-2021




SHEET C134






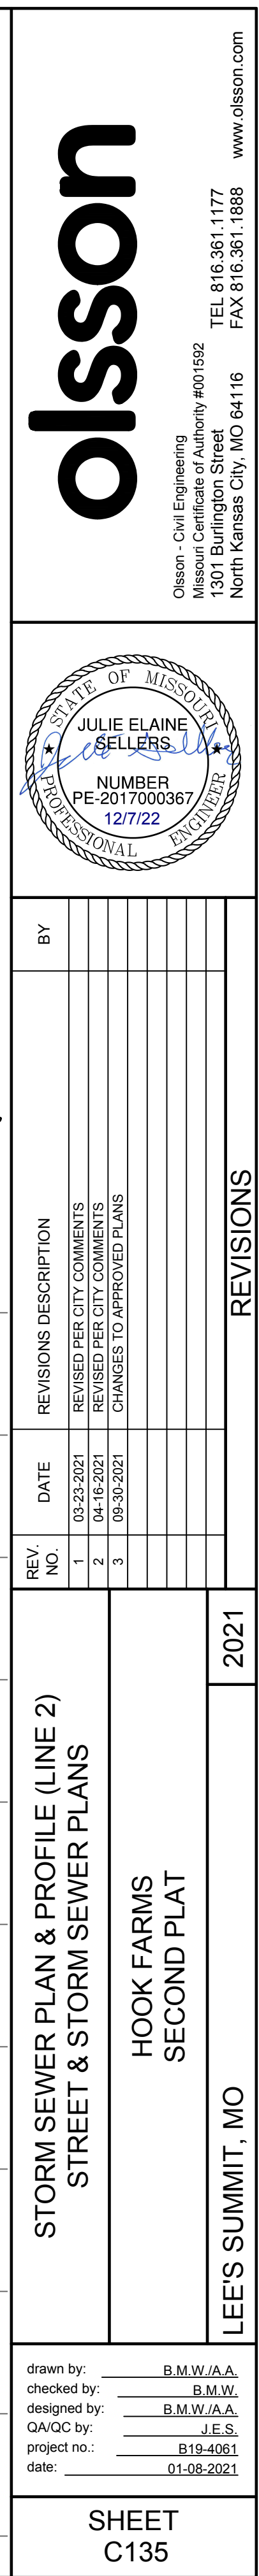


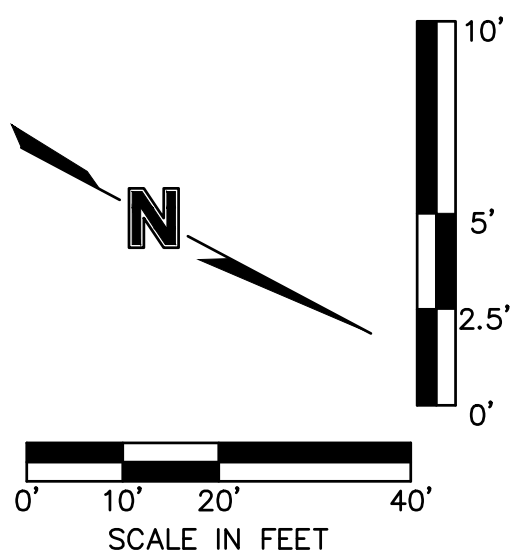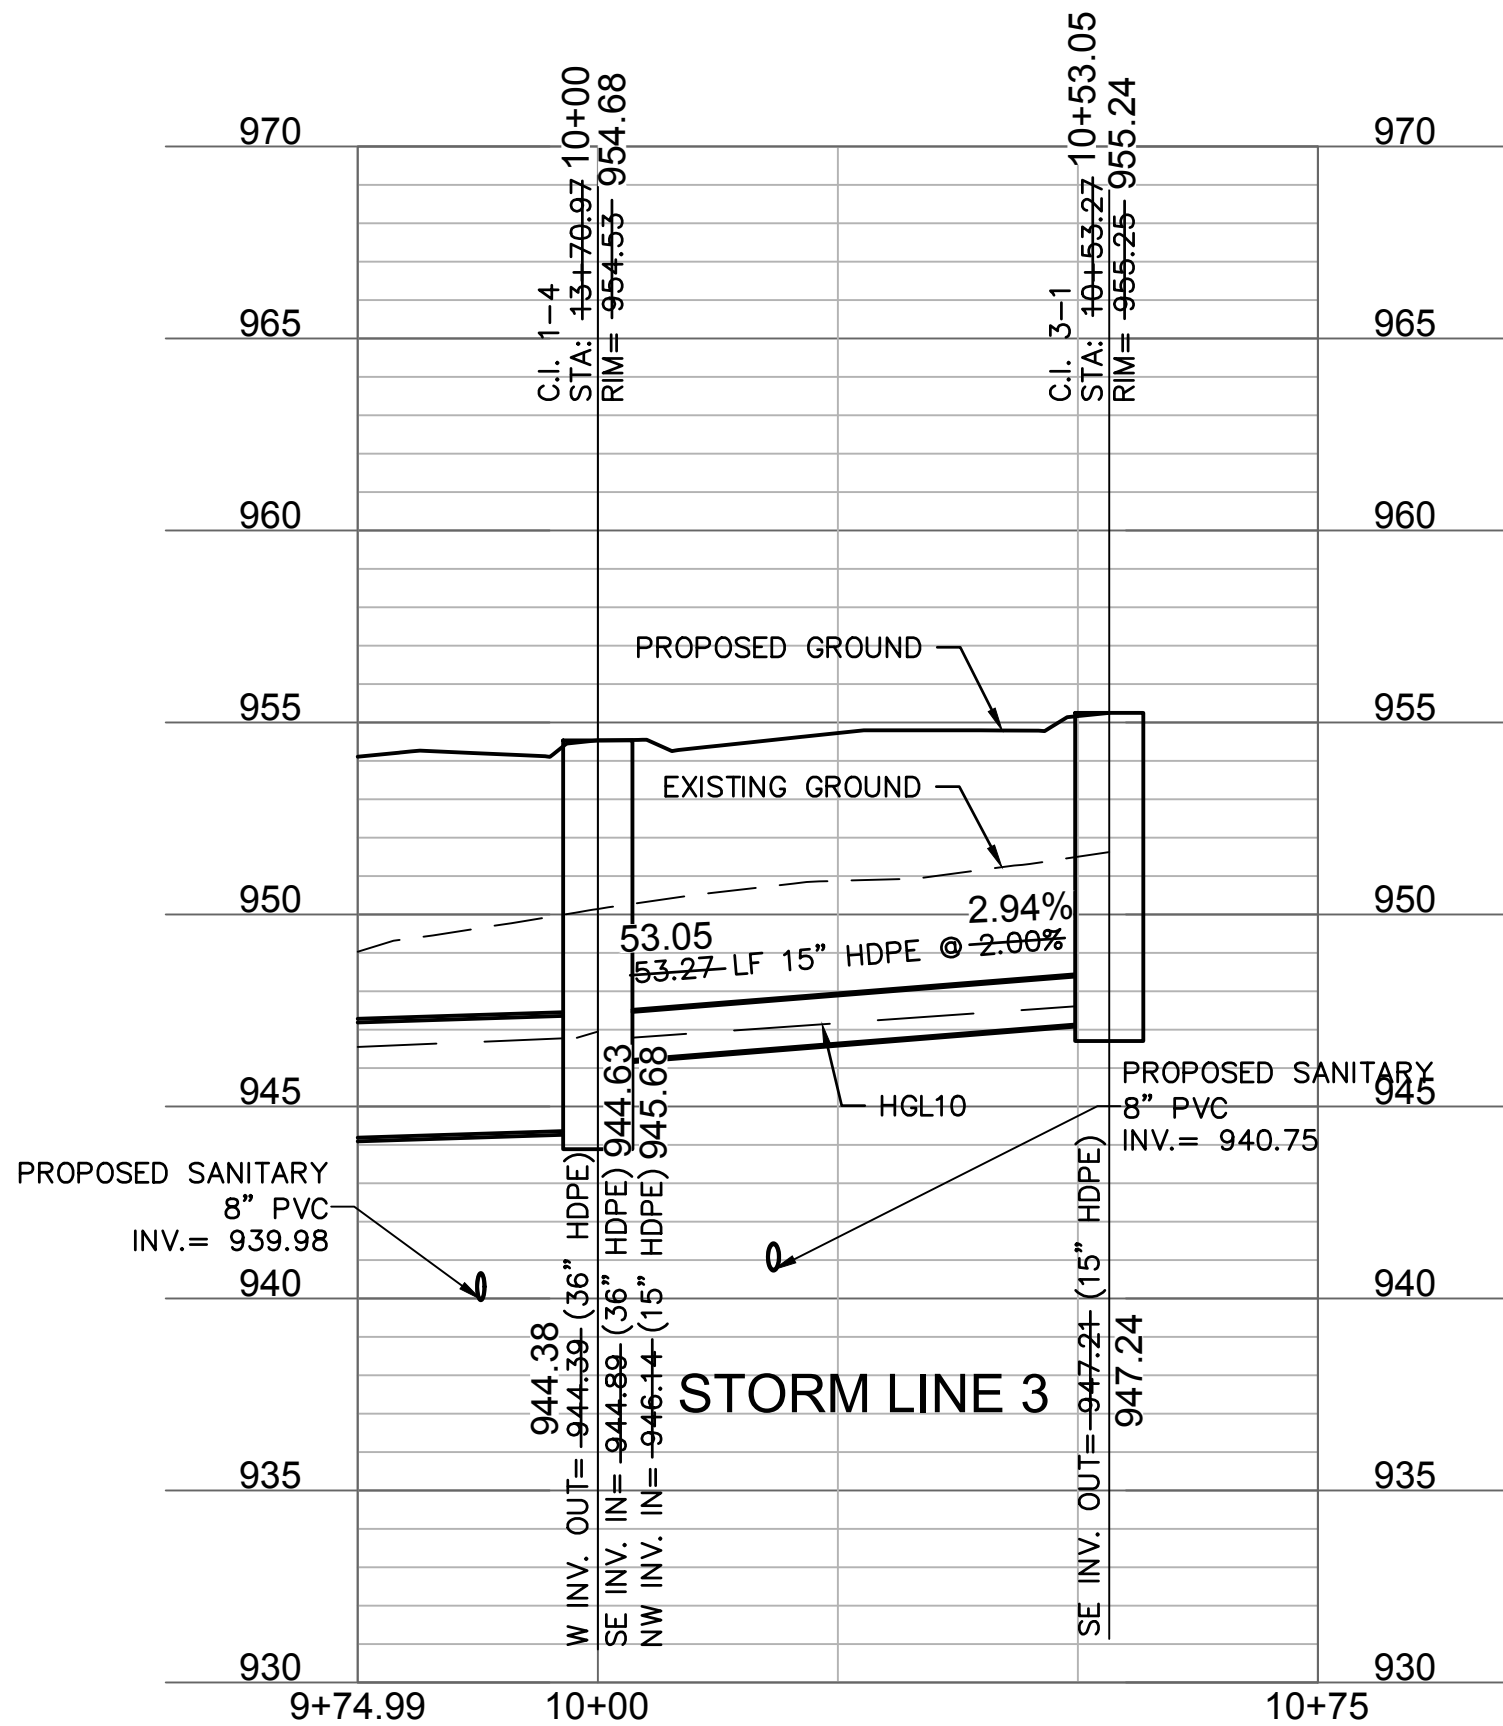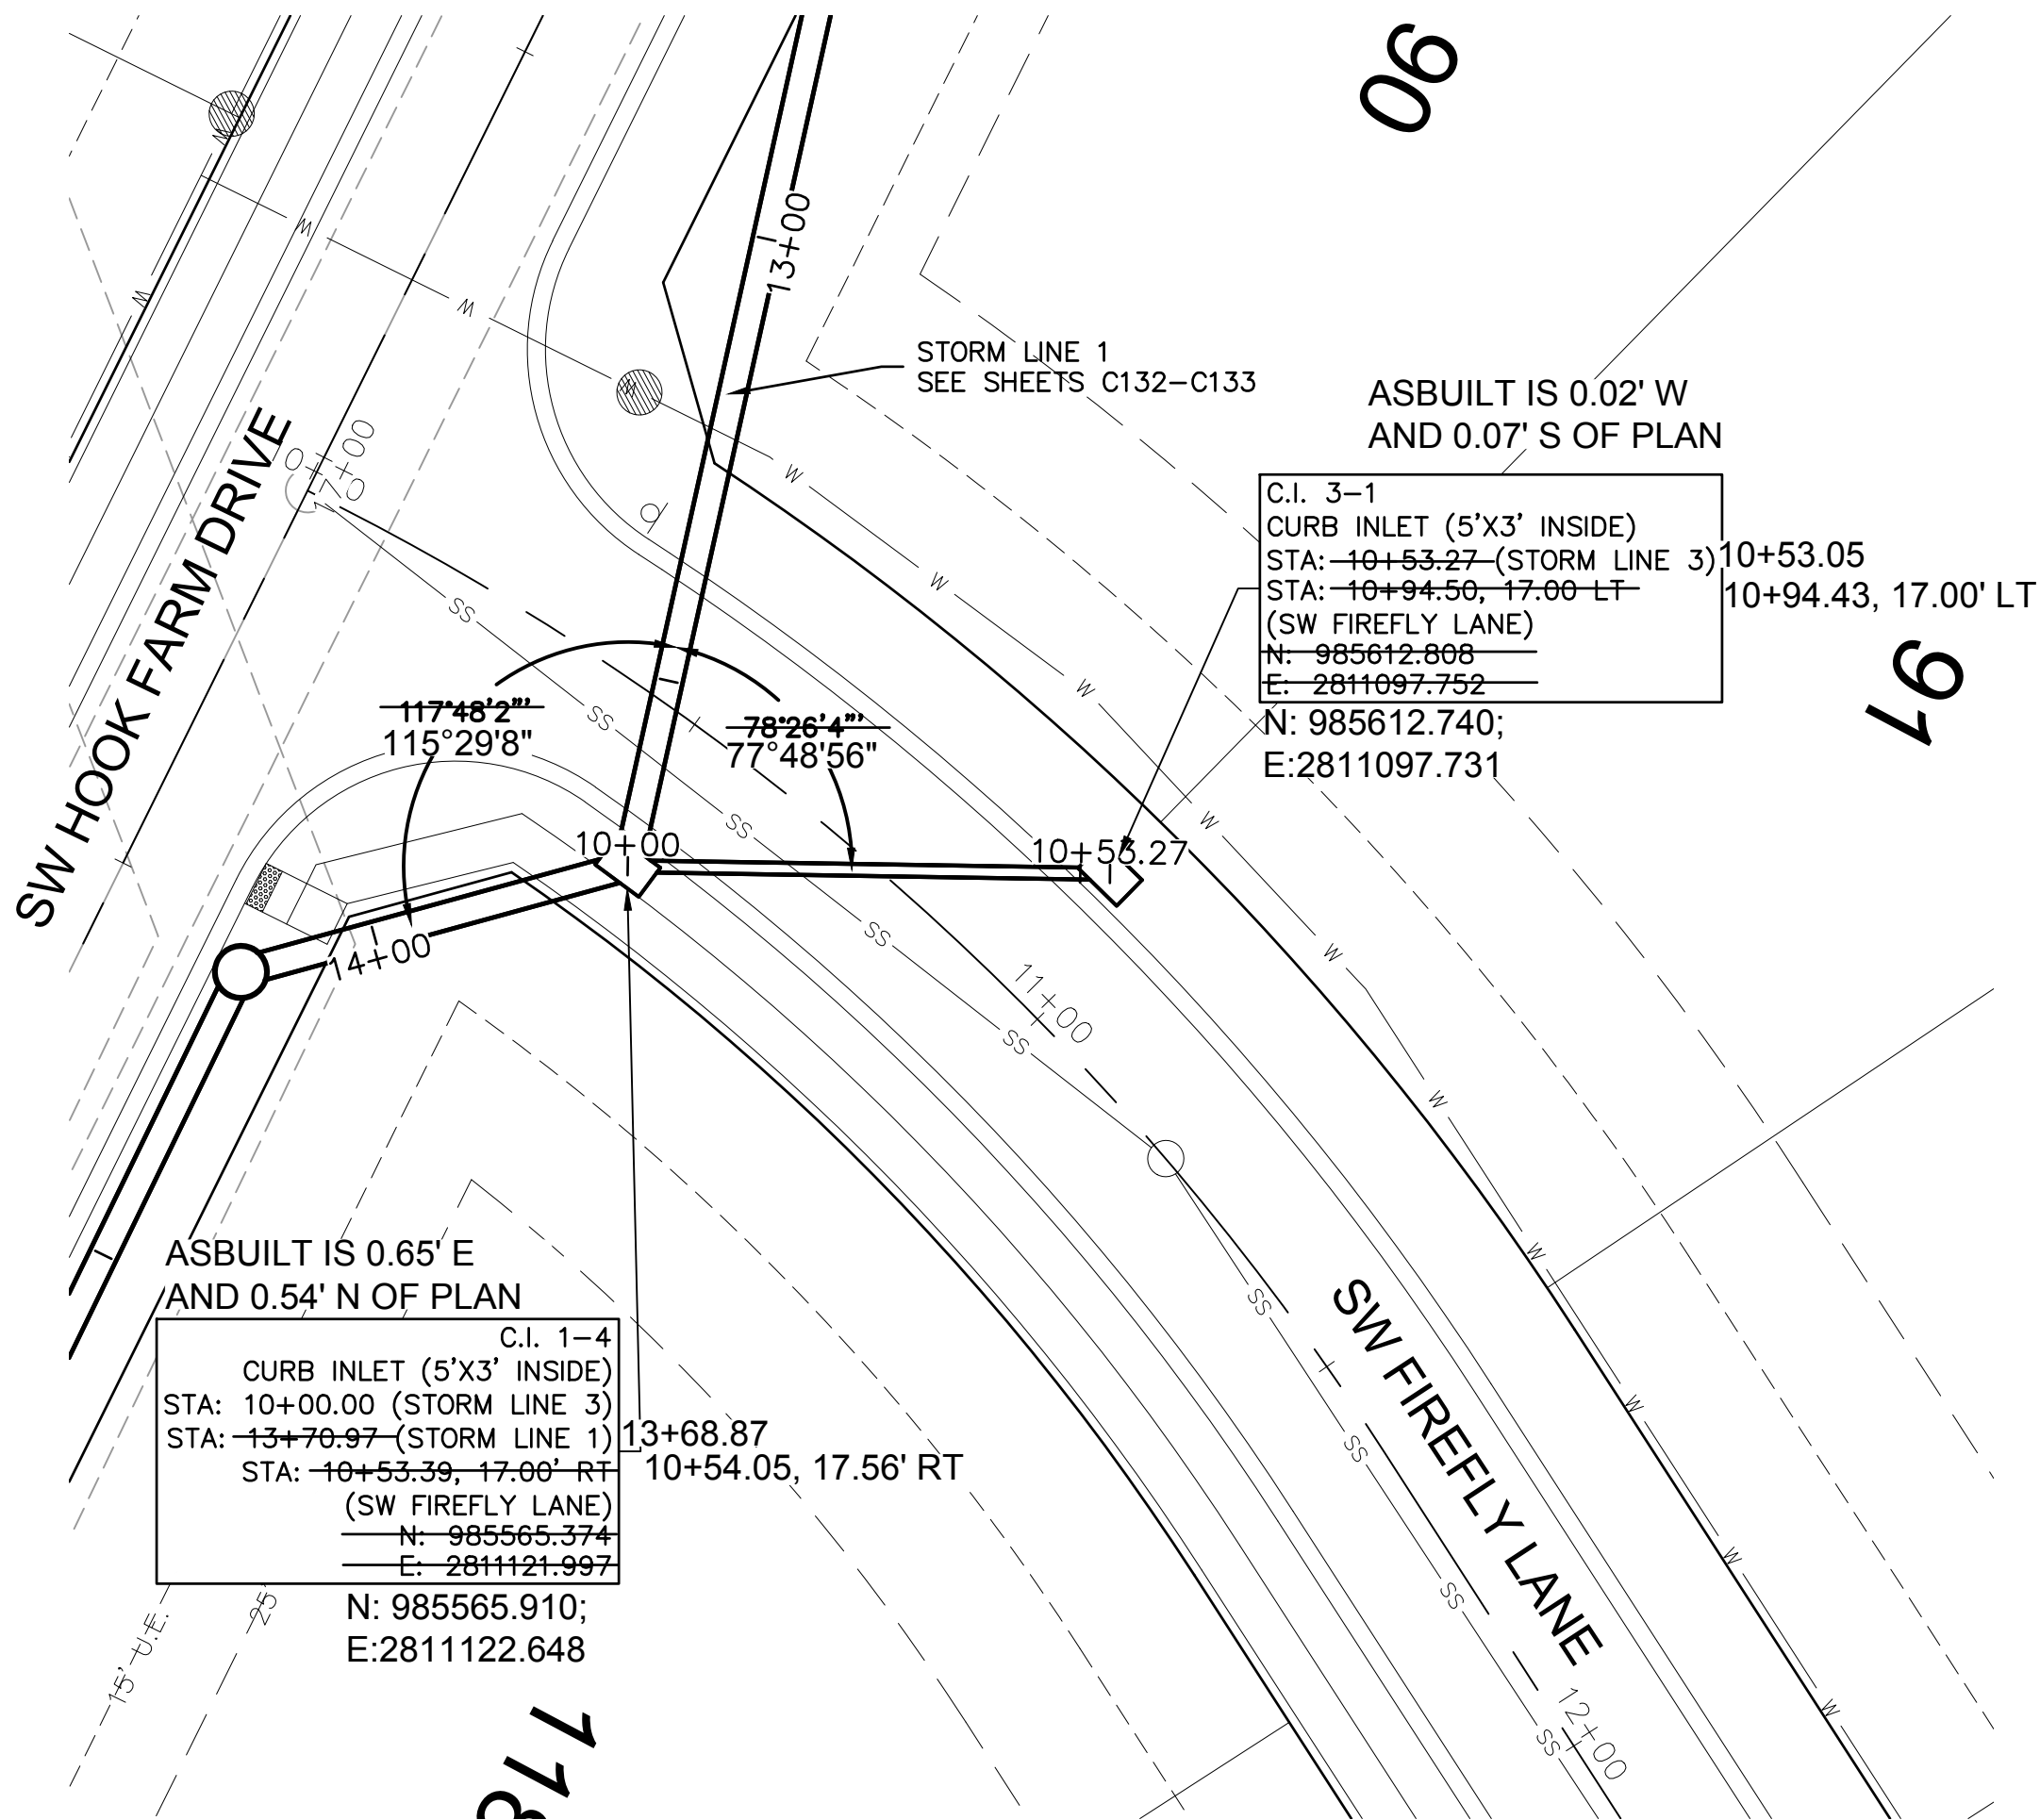

**Accepted
Record Drawings**

These plans have been reviewed for accuracy and are accepted for basic conformance to the approved construction drawings.

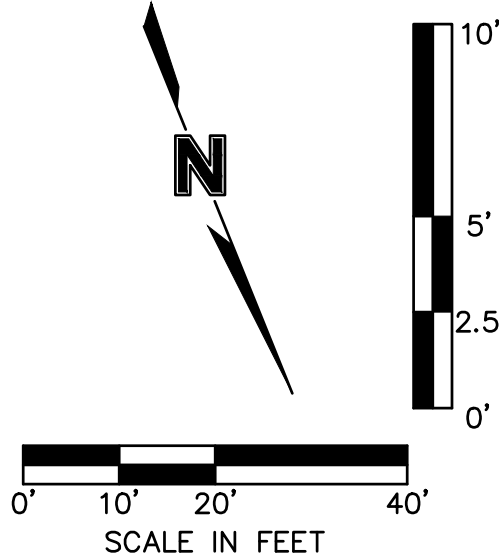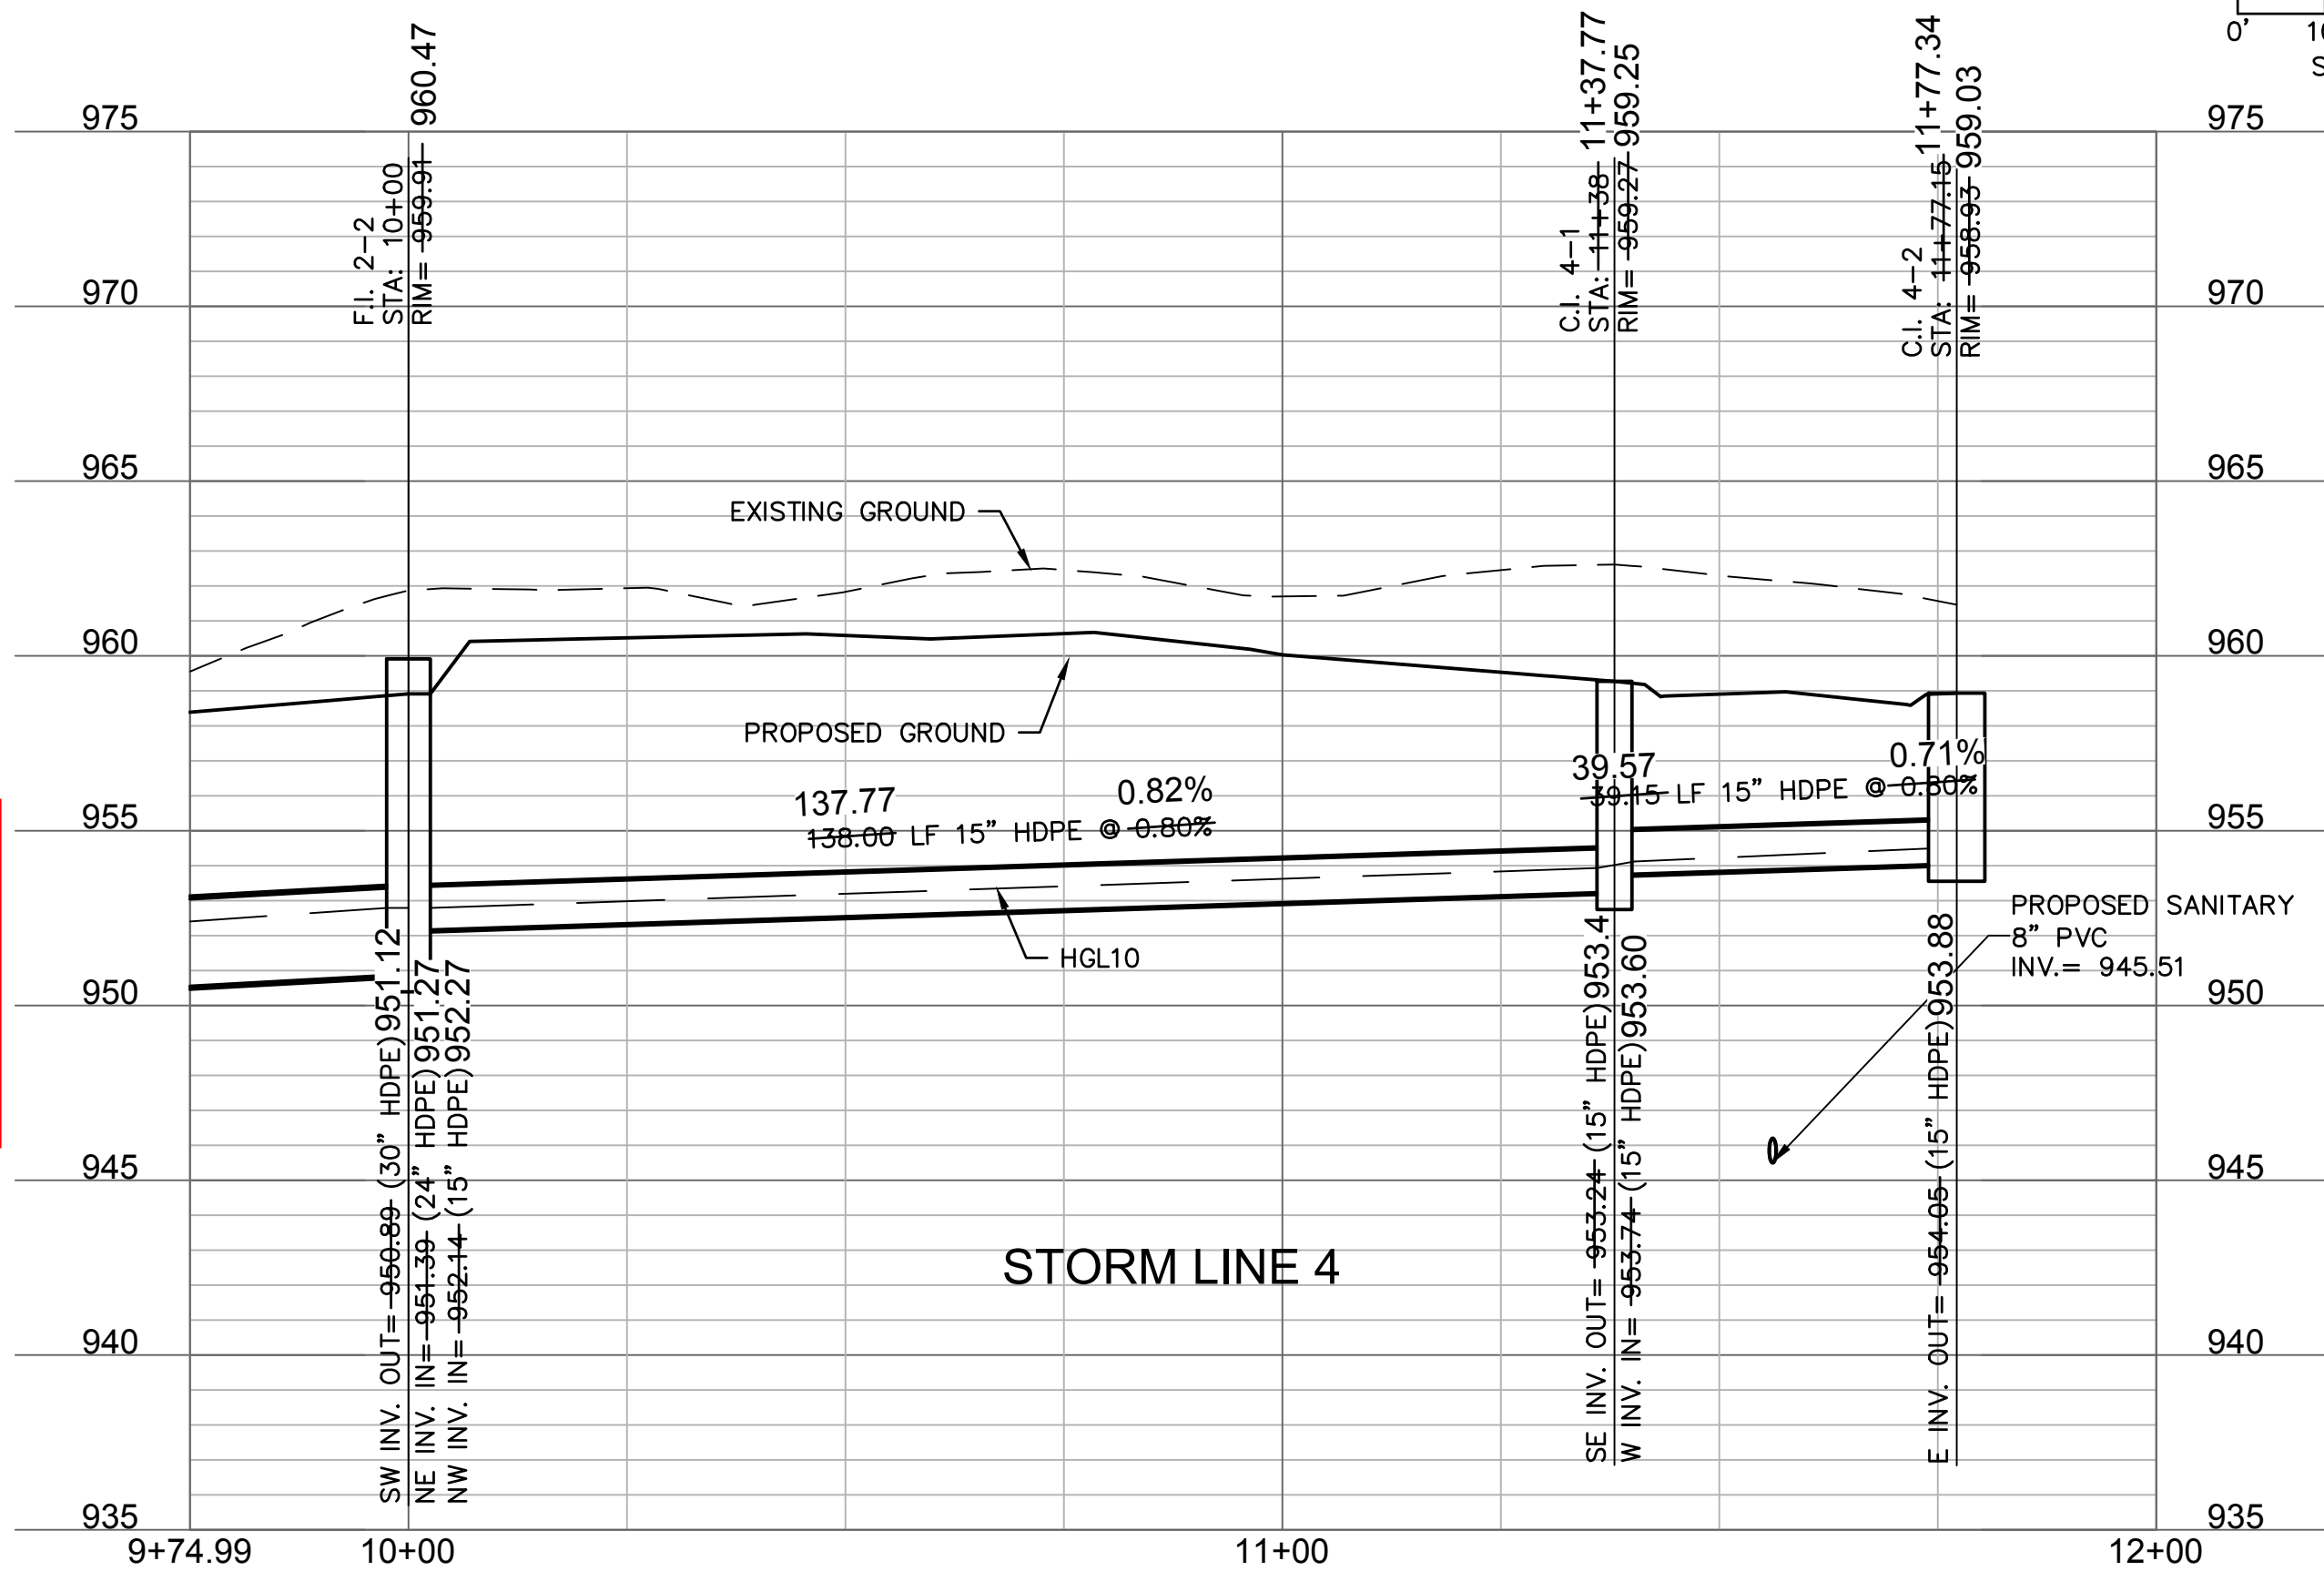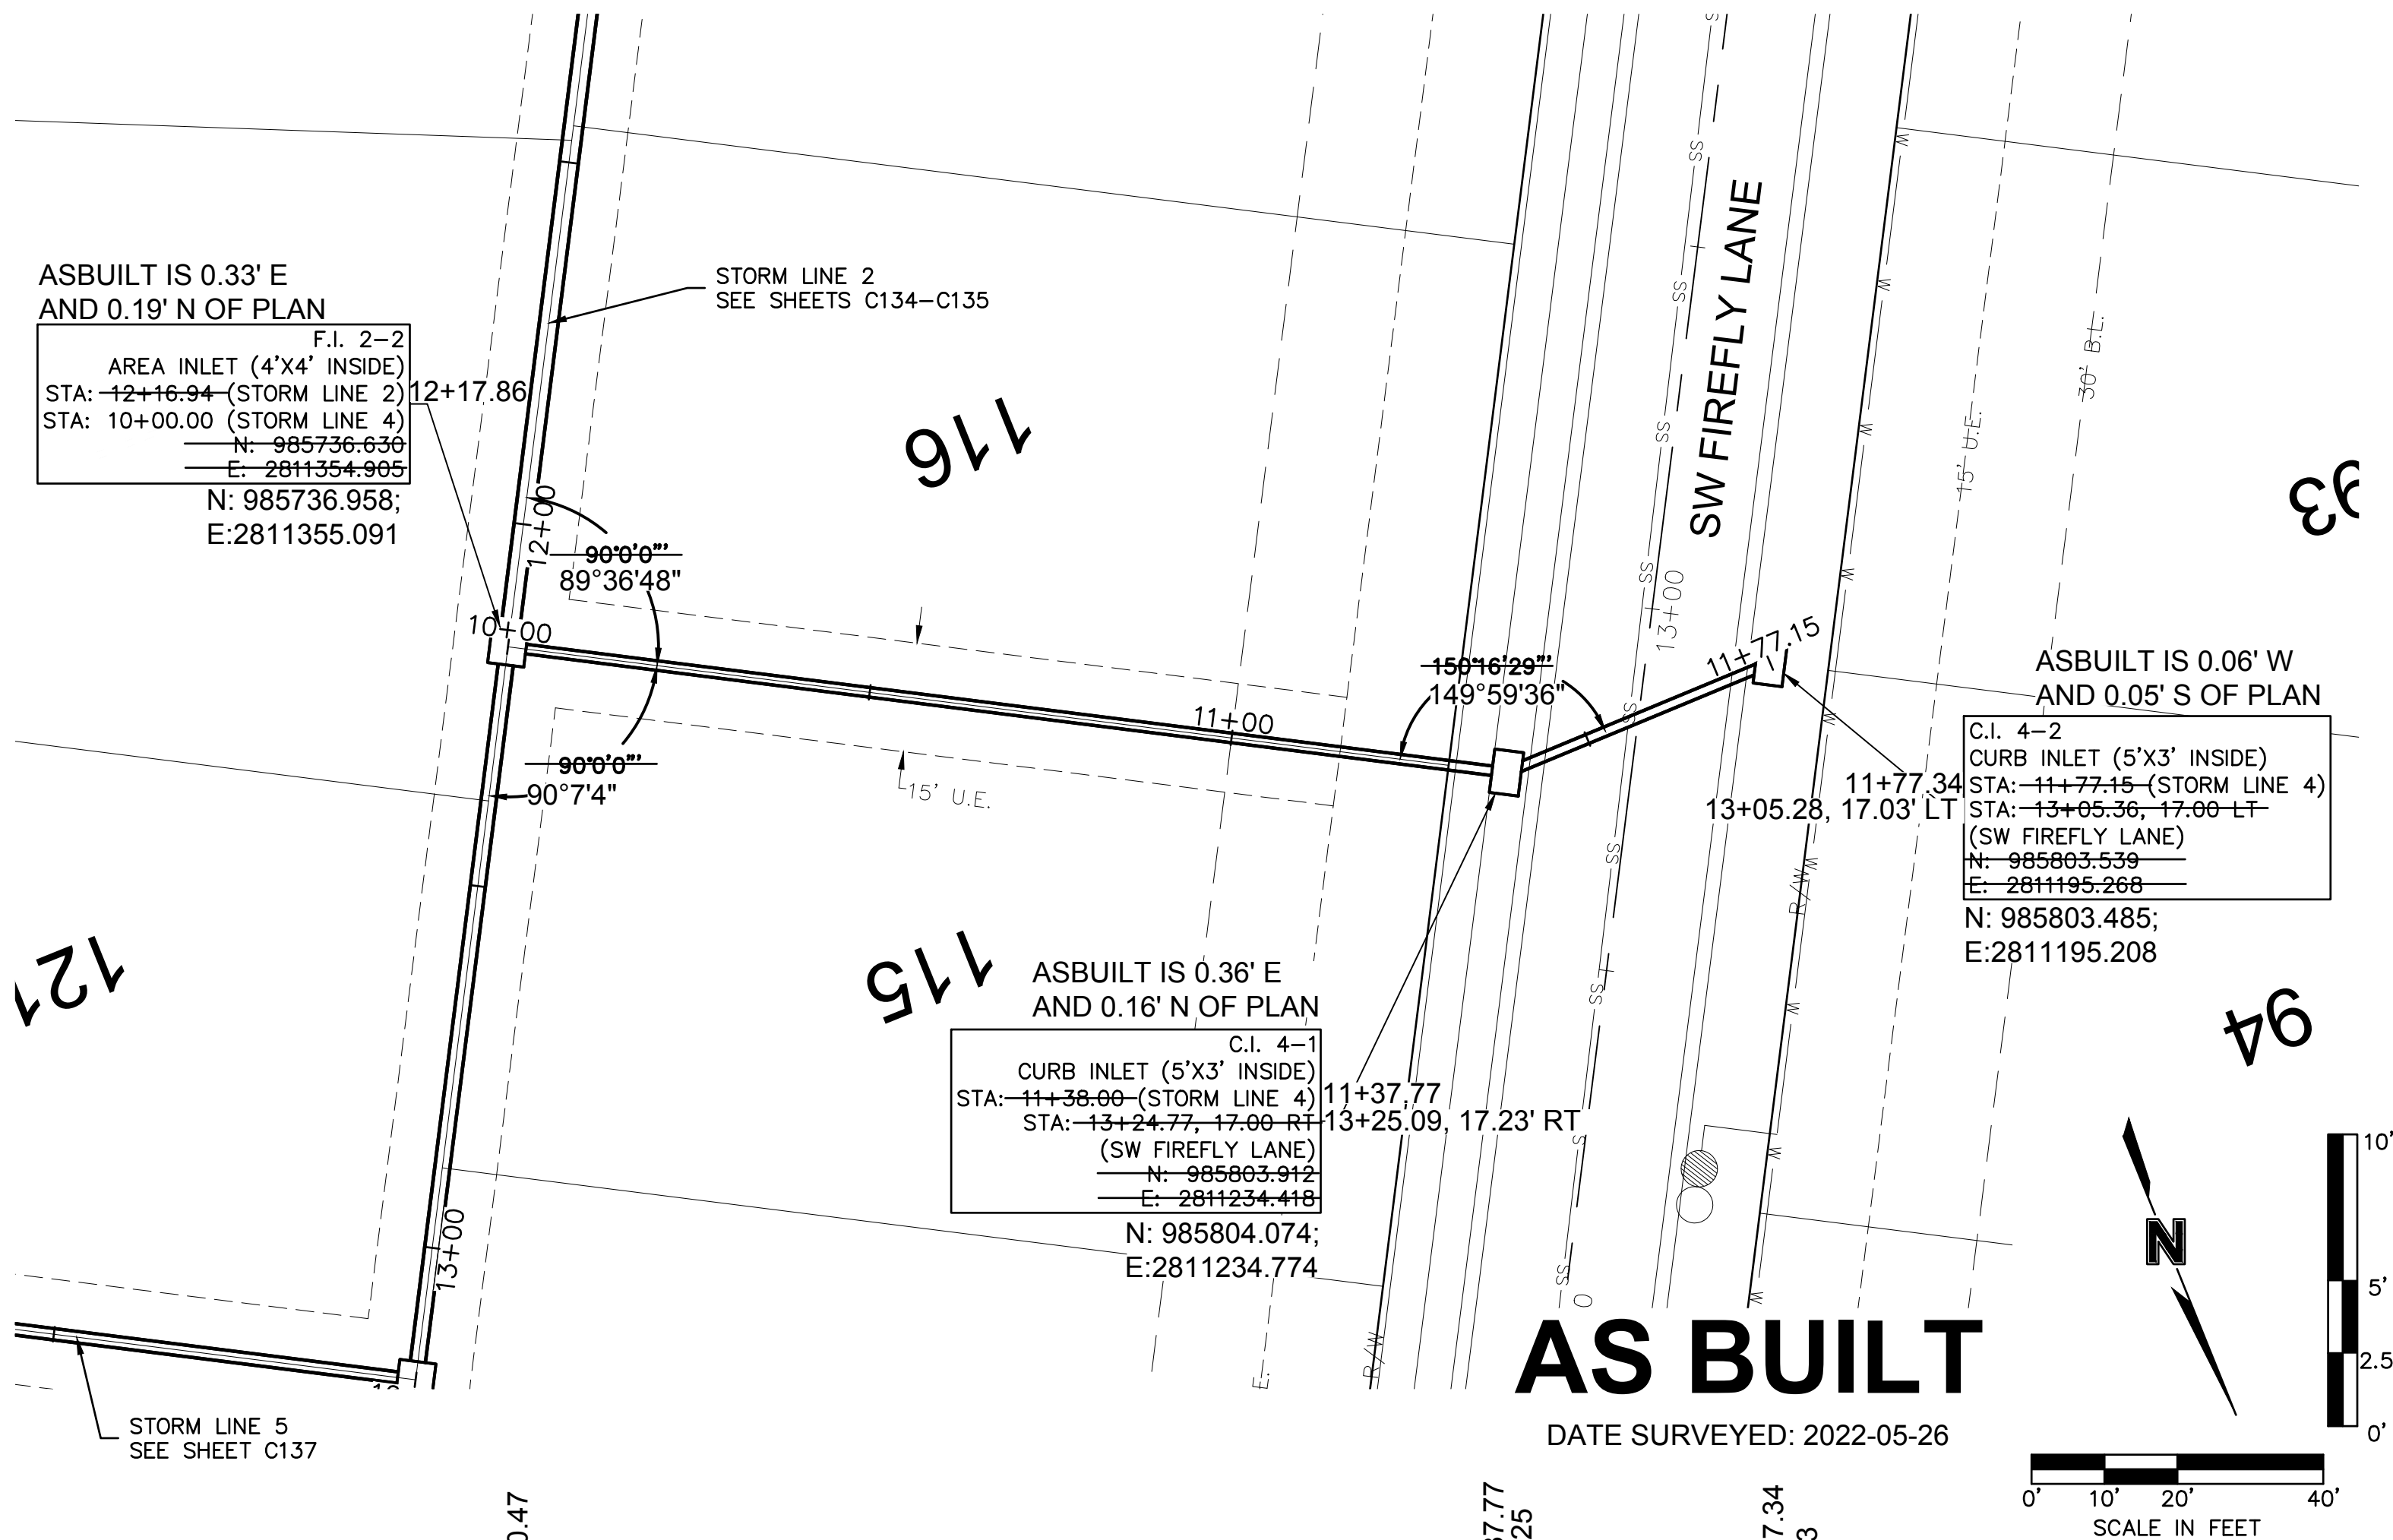

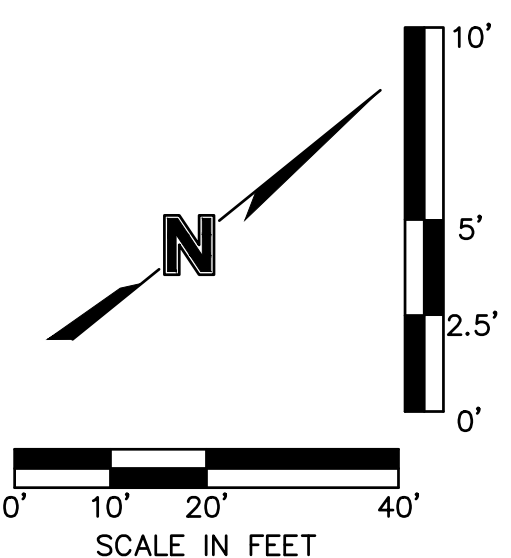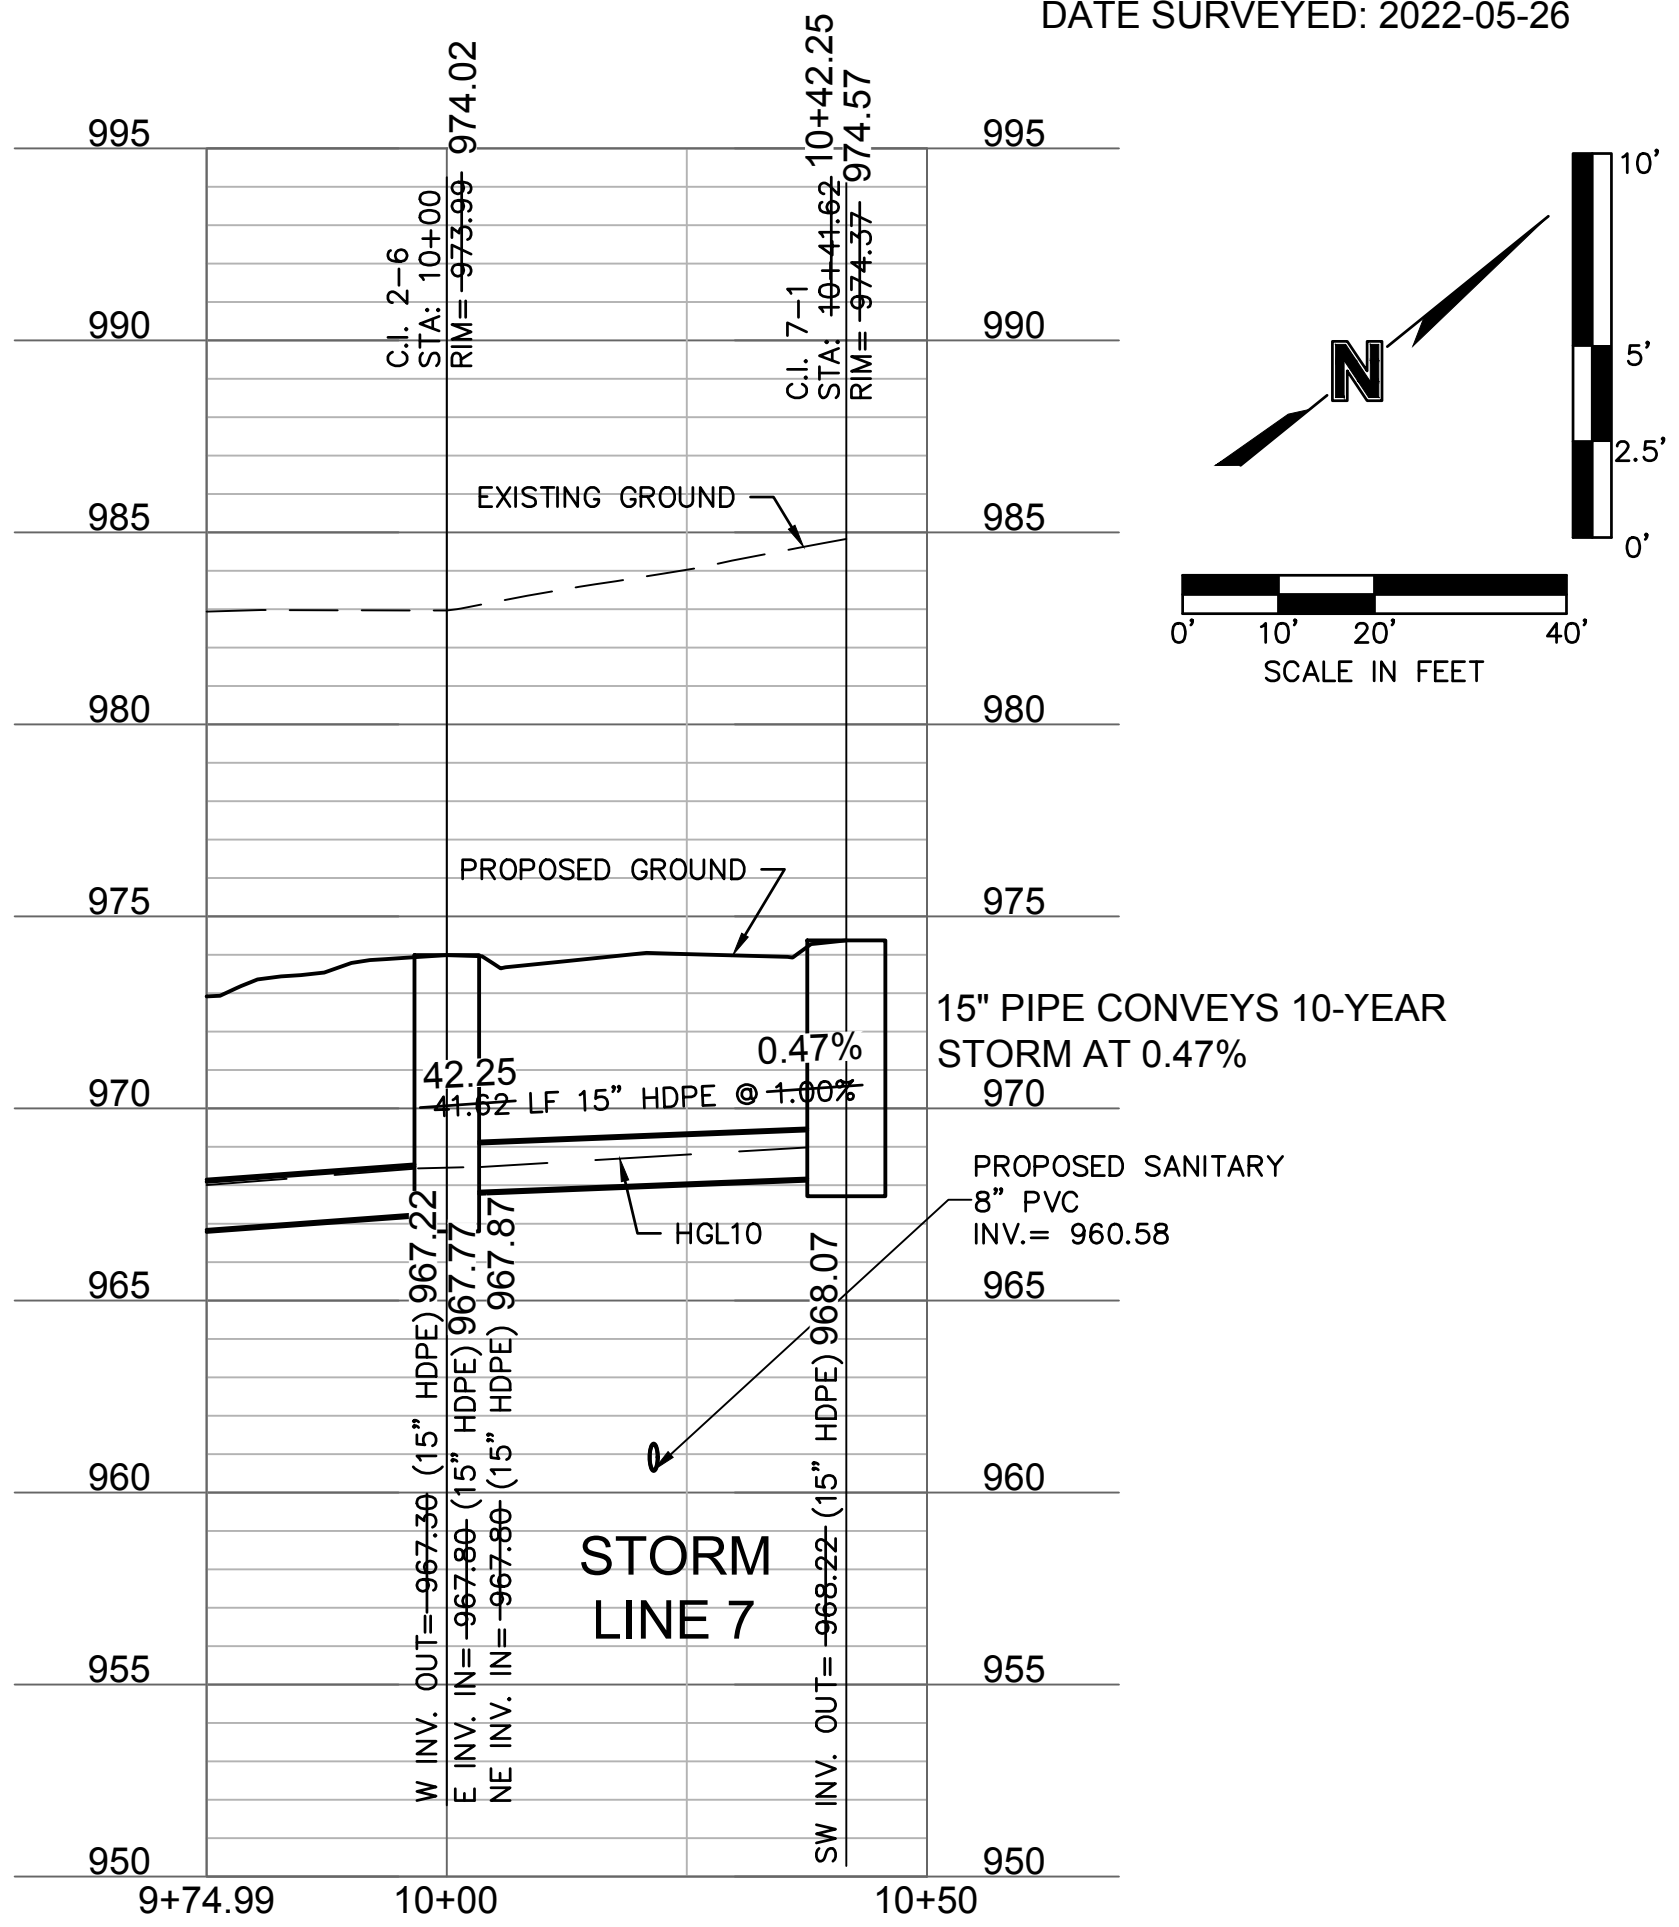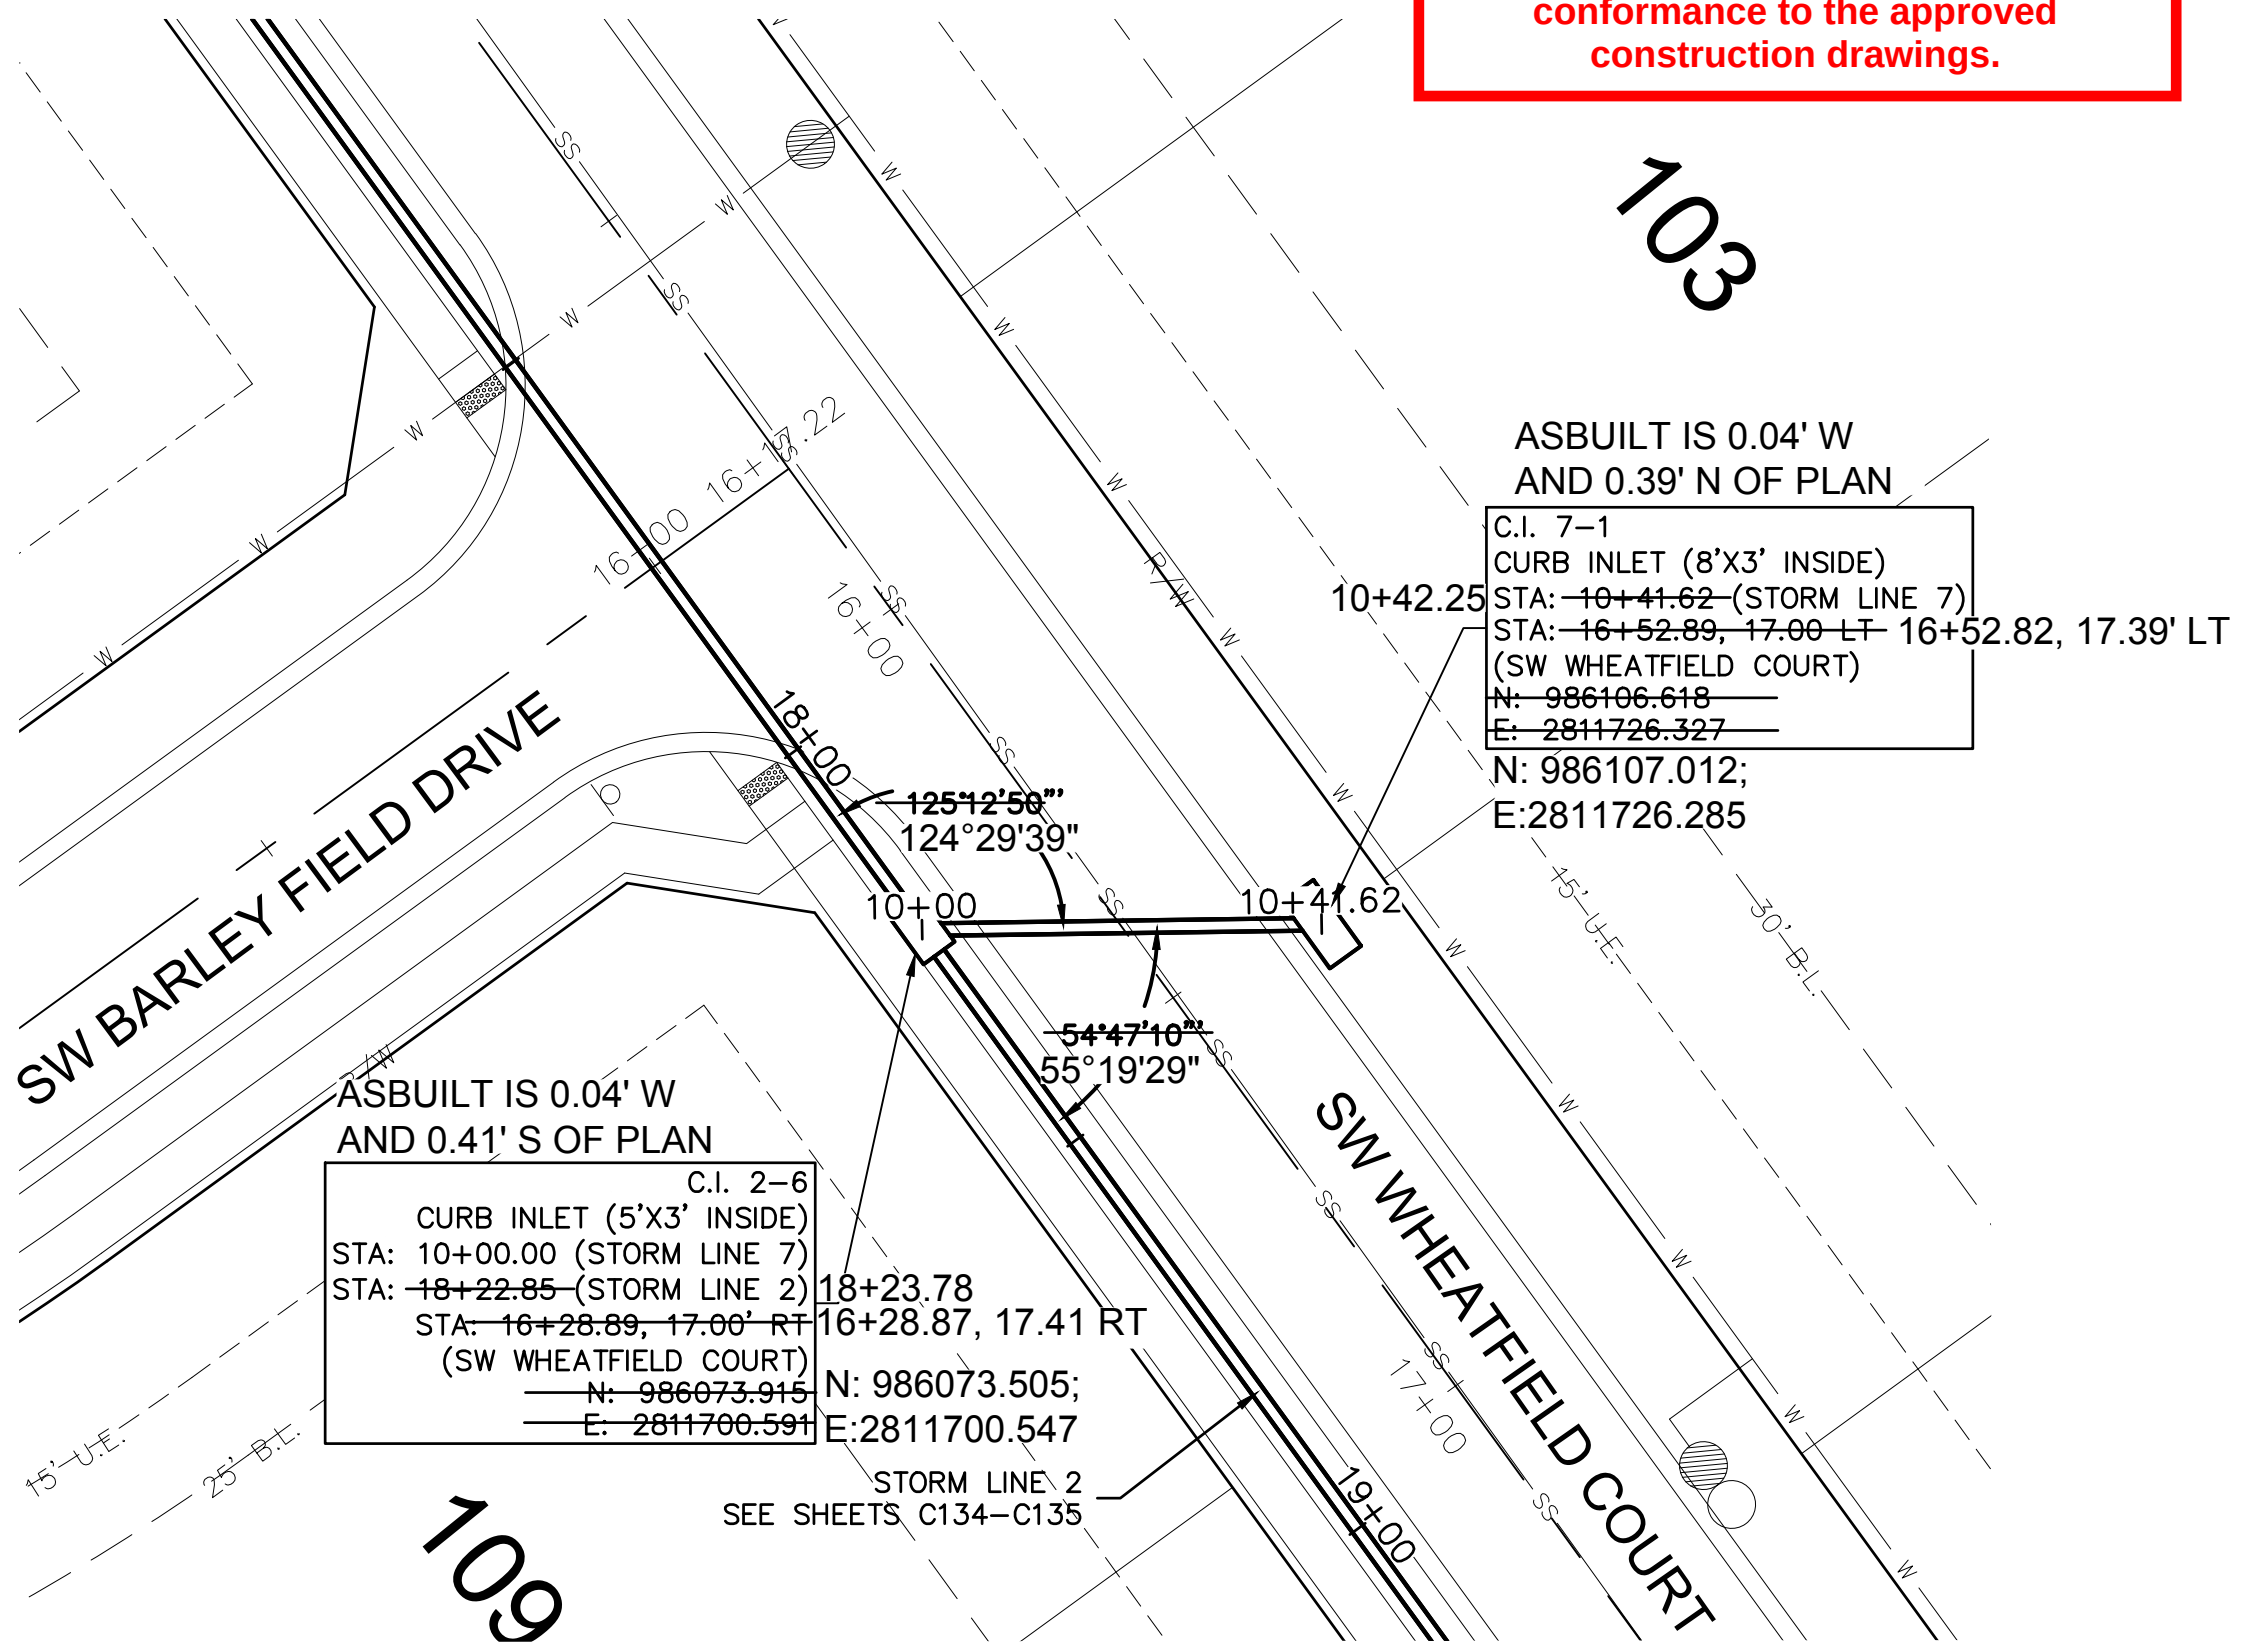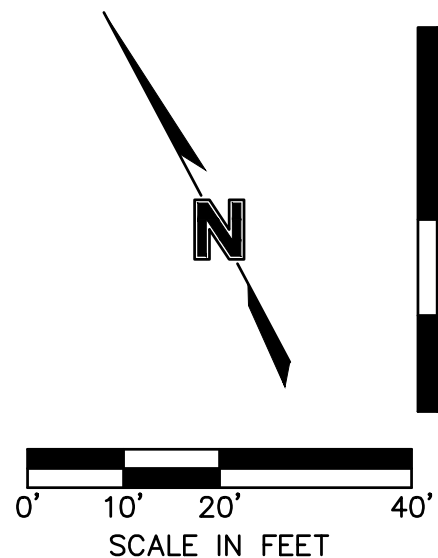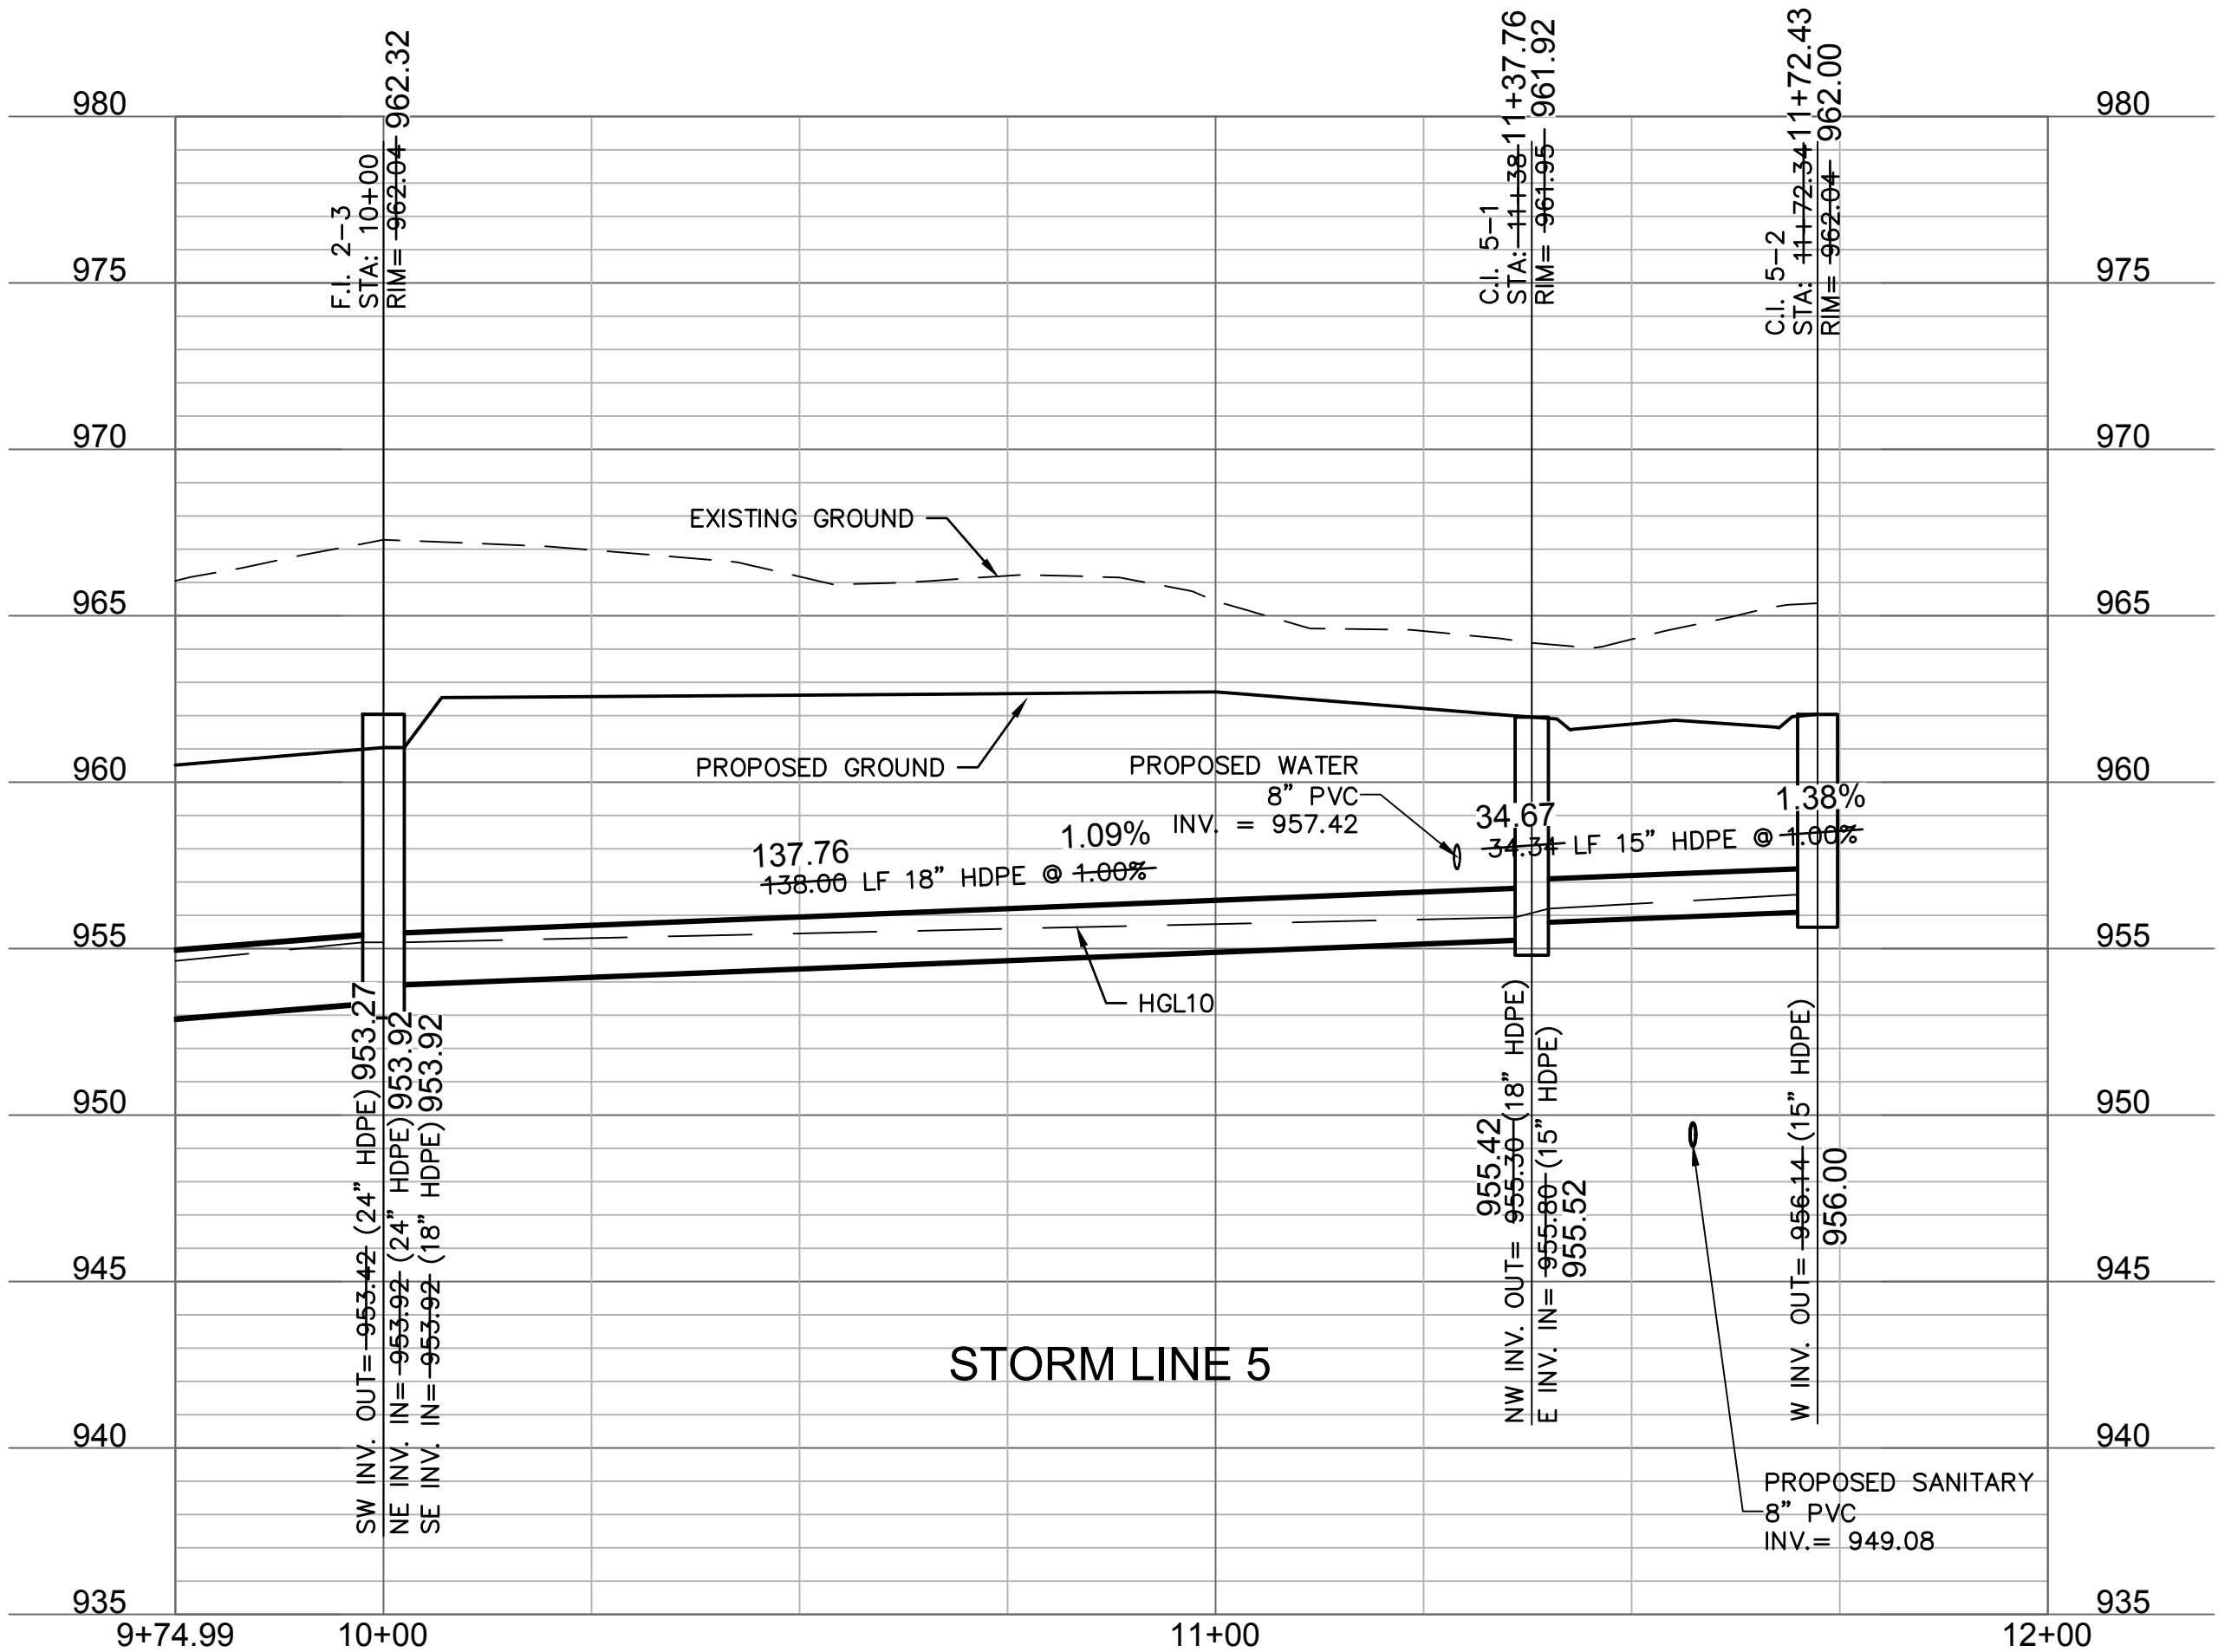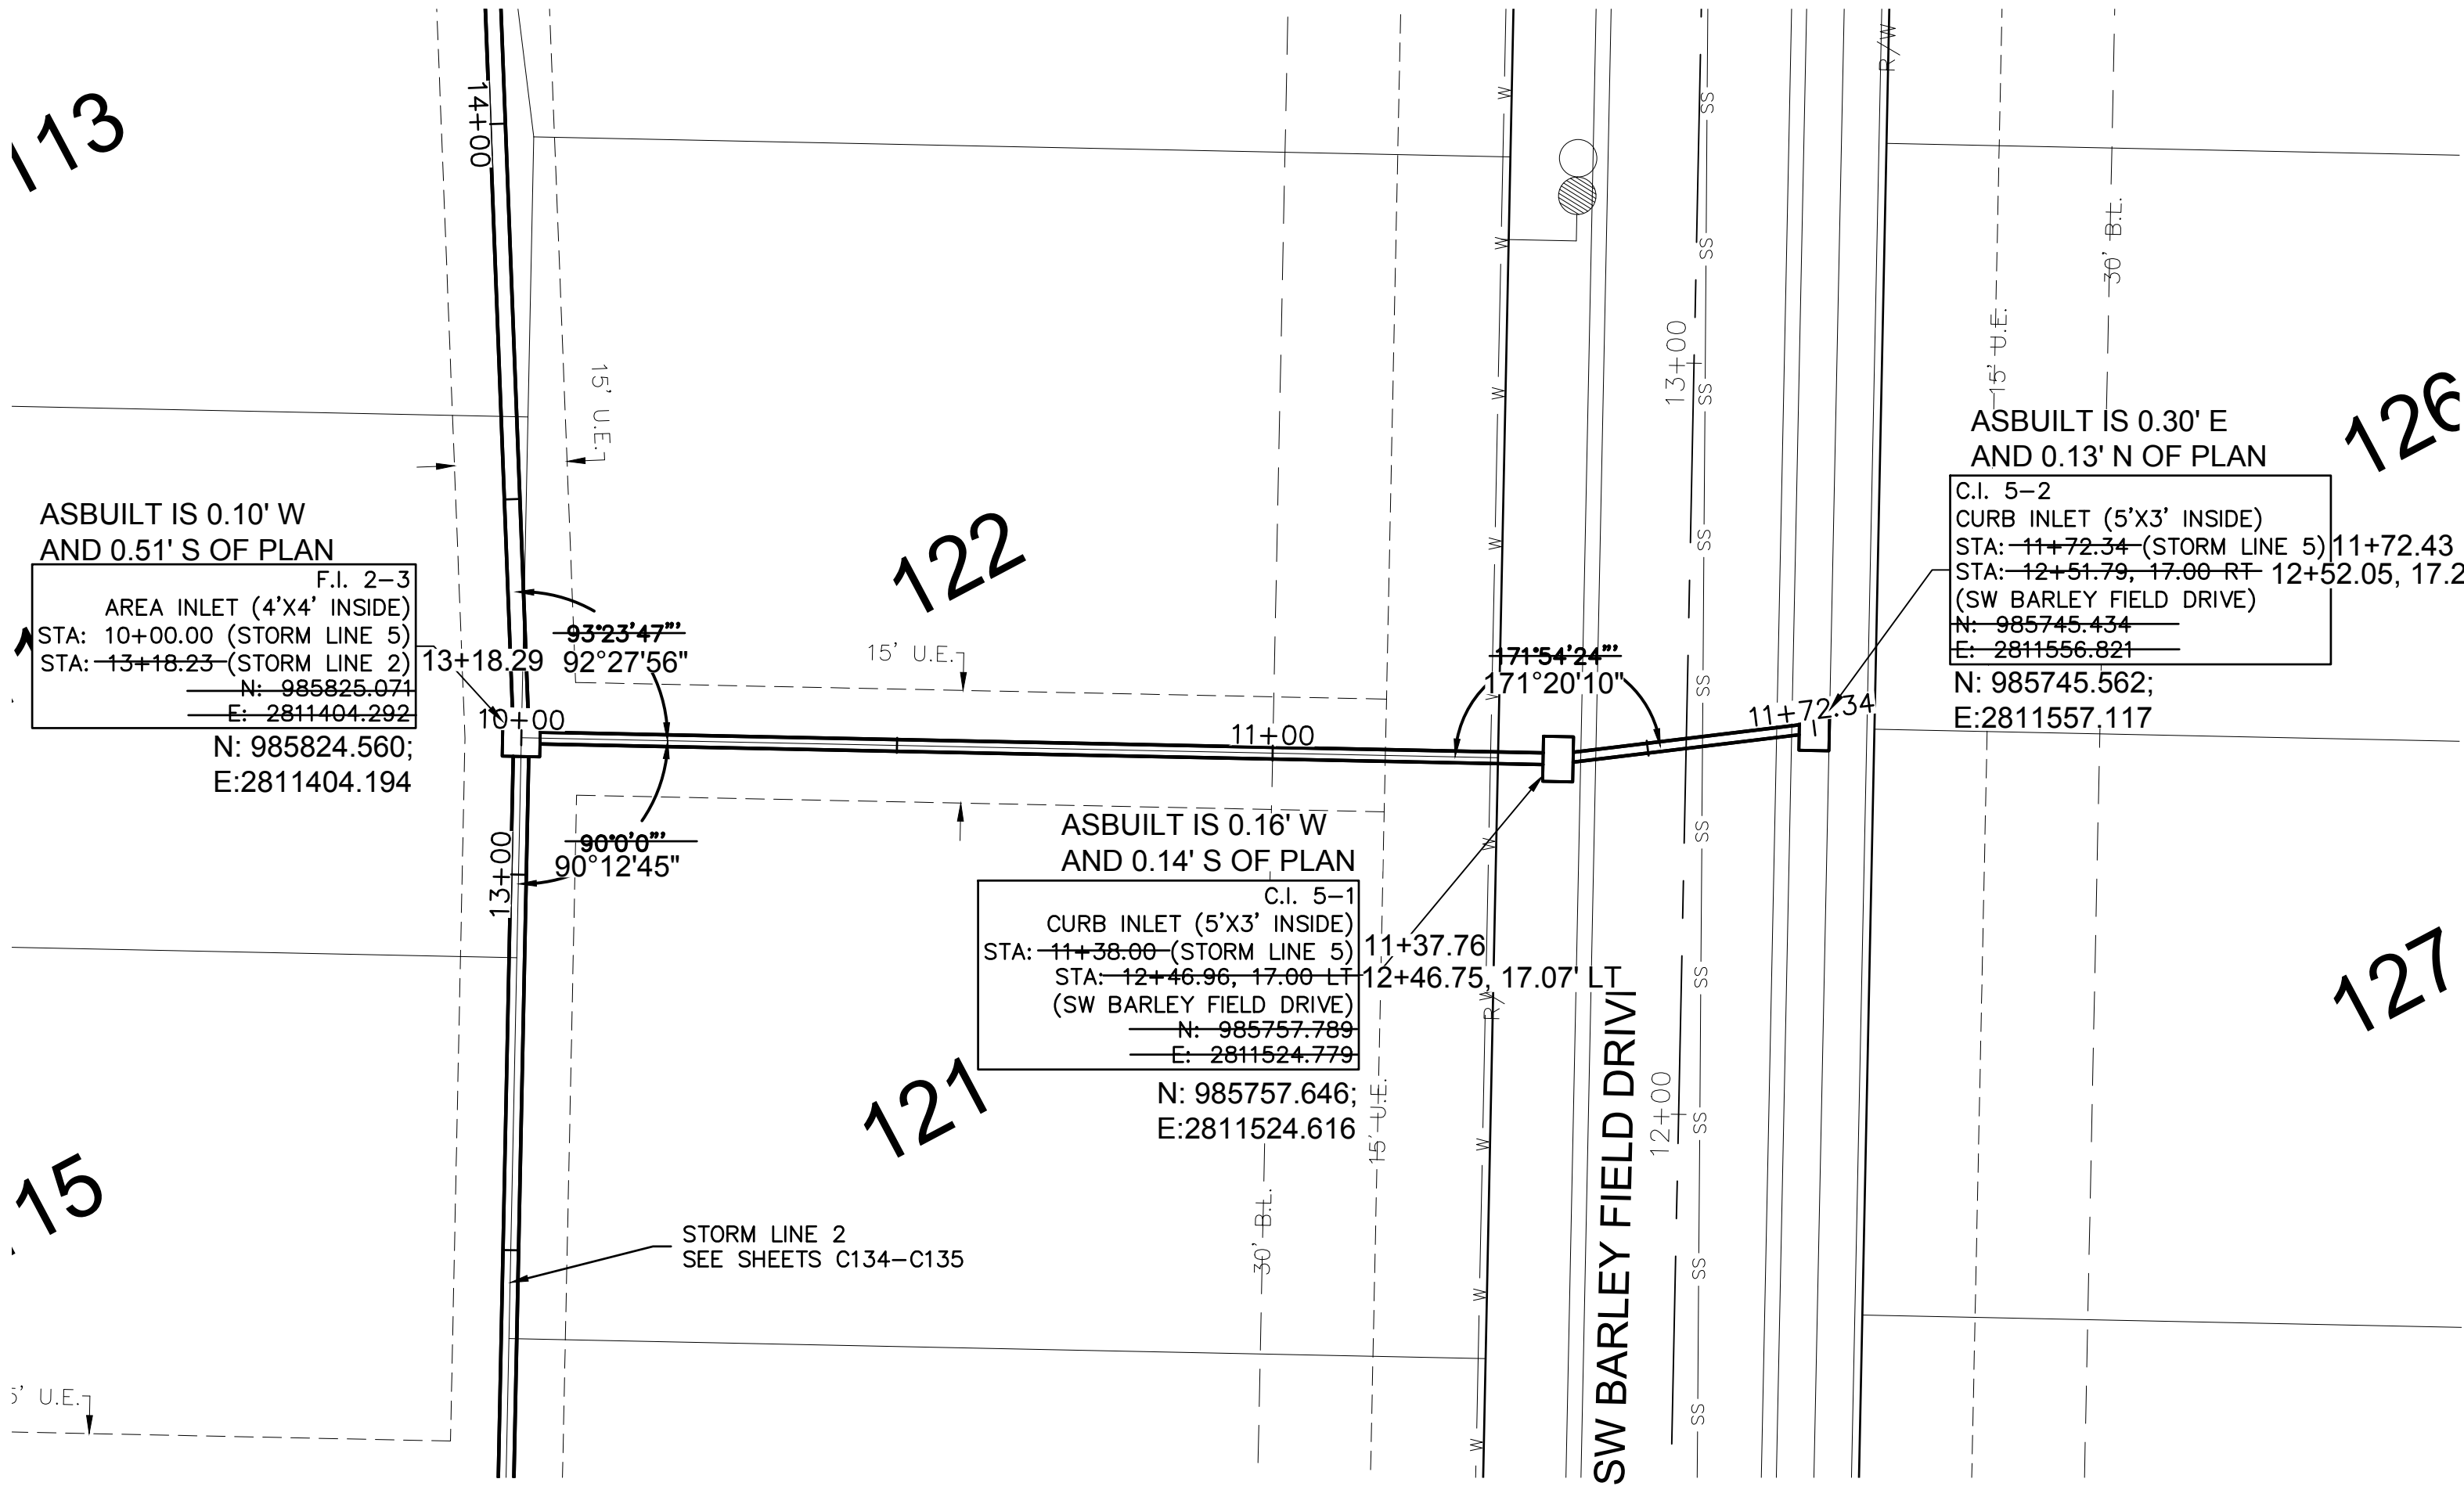

Accepted
Record Drawings

These plans have been reviewed for
accuracy and are accepted for basic
conformance to the approved
construction drawings.

AS BUILT

DATE SURVEYED: 2022-05-26

olsson

Olsson - Civil Engineering
Missouri Certificate of Authority #001592
1301 Burlington Street
North Kansas City, MO 64116
TEL 816.361.1177
FAX 816.361.1888
www.olsson.com


STATE OF MISSOURI
JULIE ELAINE
SELLERS
PROFESSIONAL ENGINEER
NUMBER
PE-2017000367
12/7/22

BY
REV. NO. DATE REVISIONS DESCRIPTION
1 03-23-2021 REVISED PER CITY COMMENTS
2 04-16-2021 REVISED PER CITY COMMENTS
3 09-30-2021 CHANGES TO APPROVED PLANS

STORM SEWER PLAN & PROFILE (LINES 5 & 7)
STREET & STORM SEWER PLANS
HOOK FARMS
SECOND PLAT
LEE'S SUMMIT, MO
2021


drawn by: B.M.W./A.A.
checked by: B.M.W.
designed by: B.M.W./A.A.
QA/QC by: J.E.S.
project no.: B19-4061
date: 01-08-2021




SHEET
C137

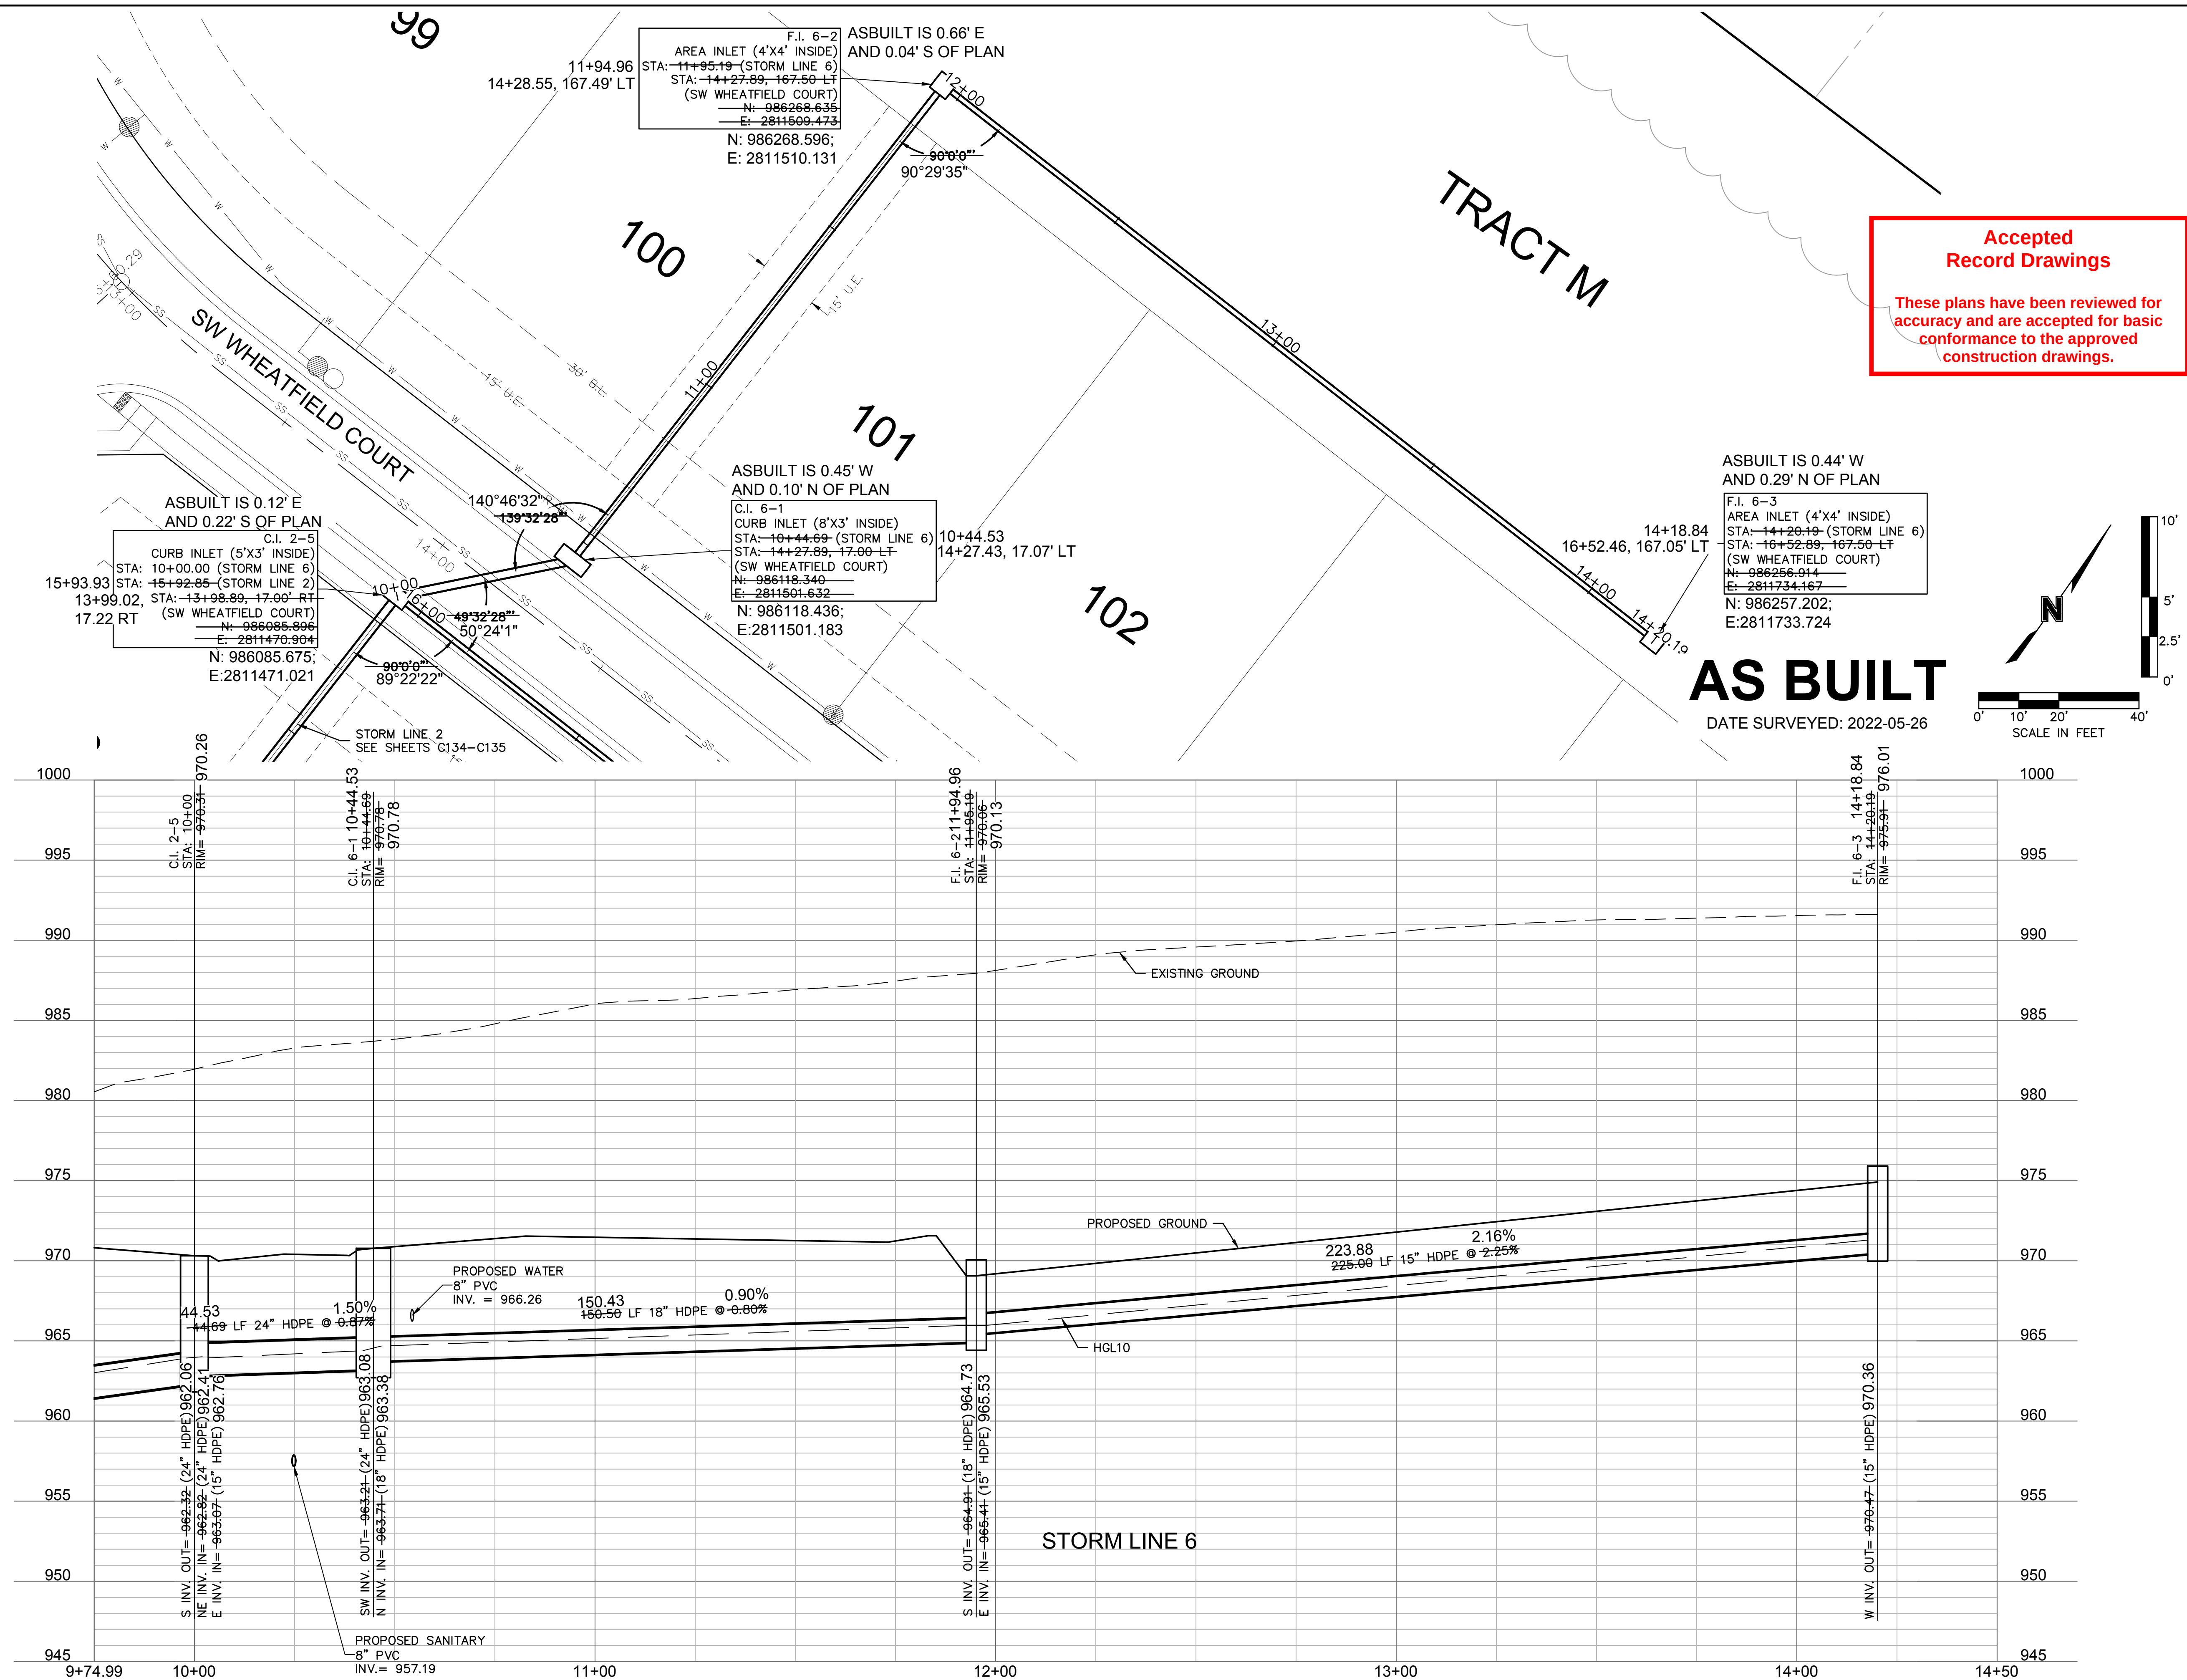

Accepted Record Drawings

These plans have been reviewed for accuracy and are accepted for basic conformance to the approved construction drawings.

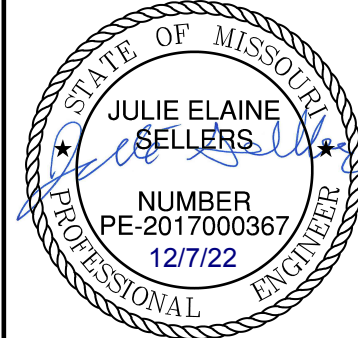[illegible]

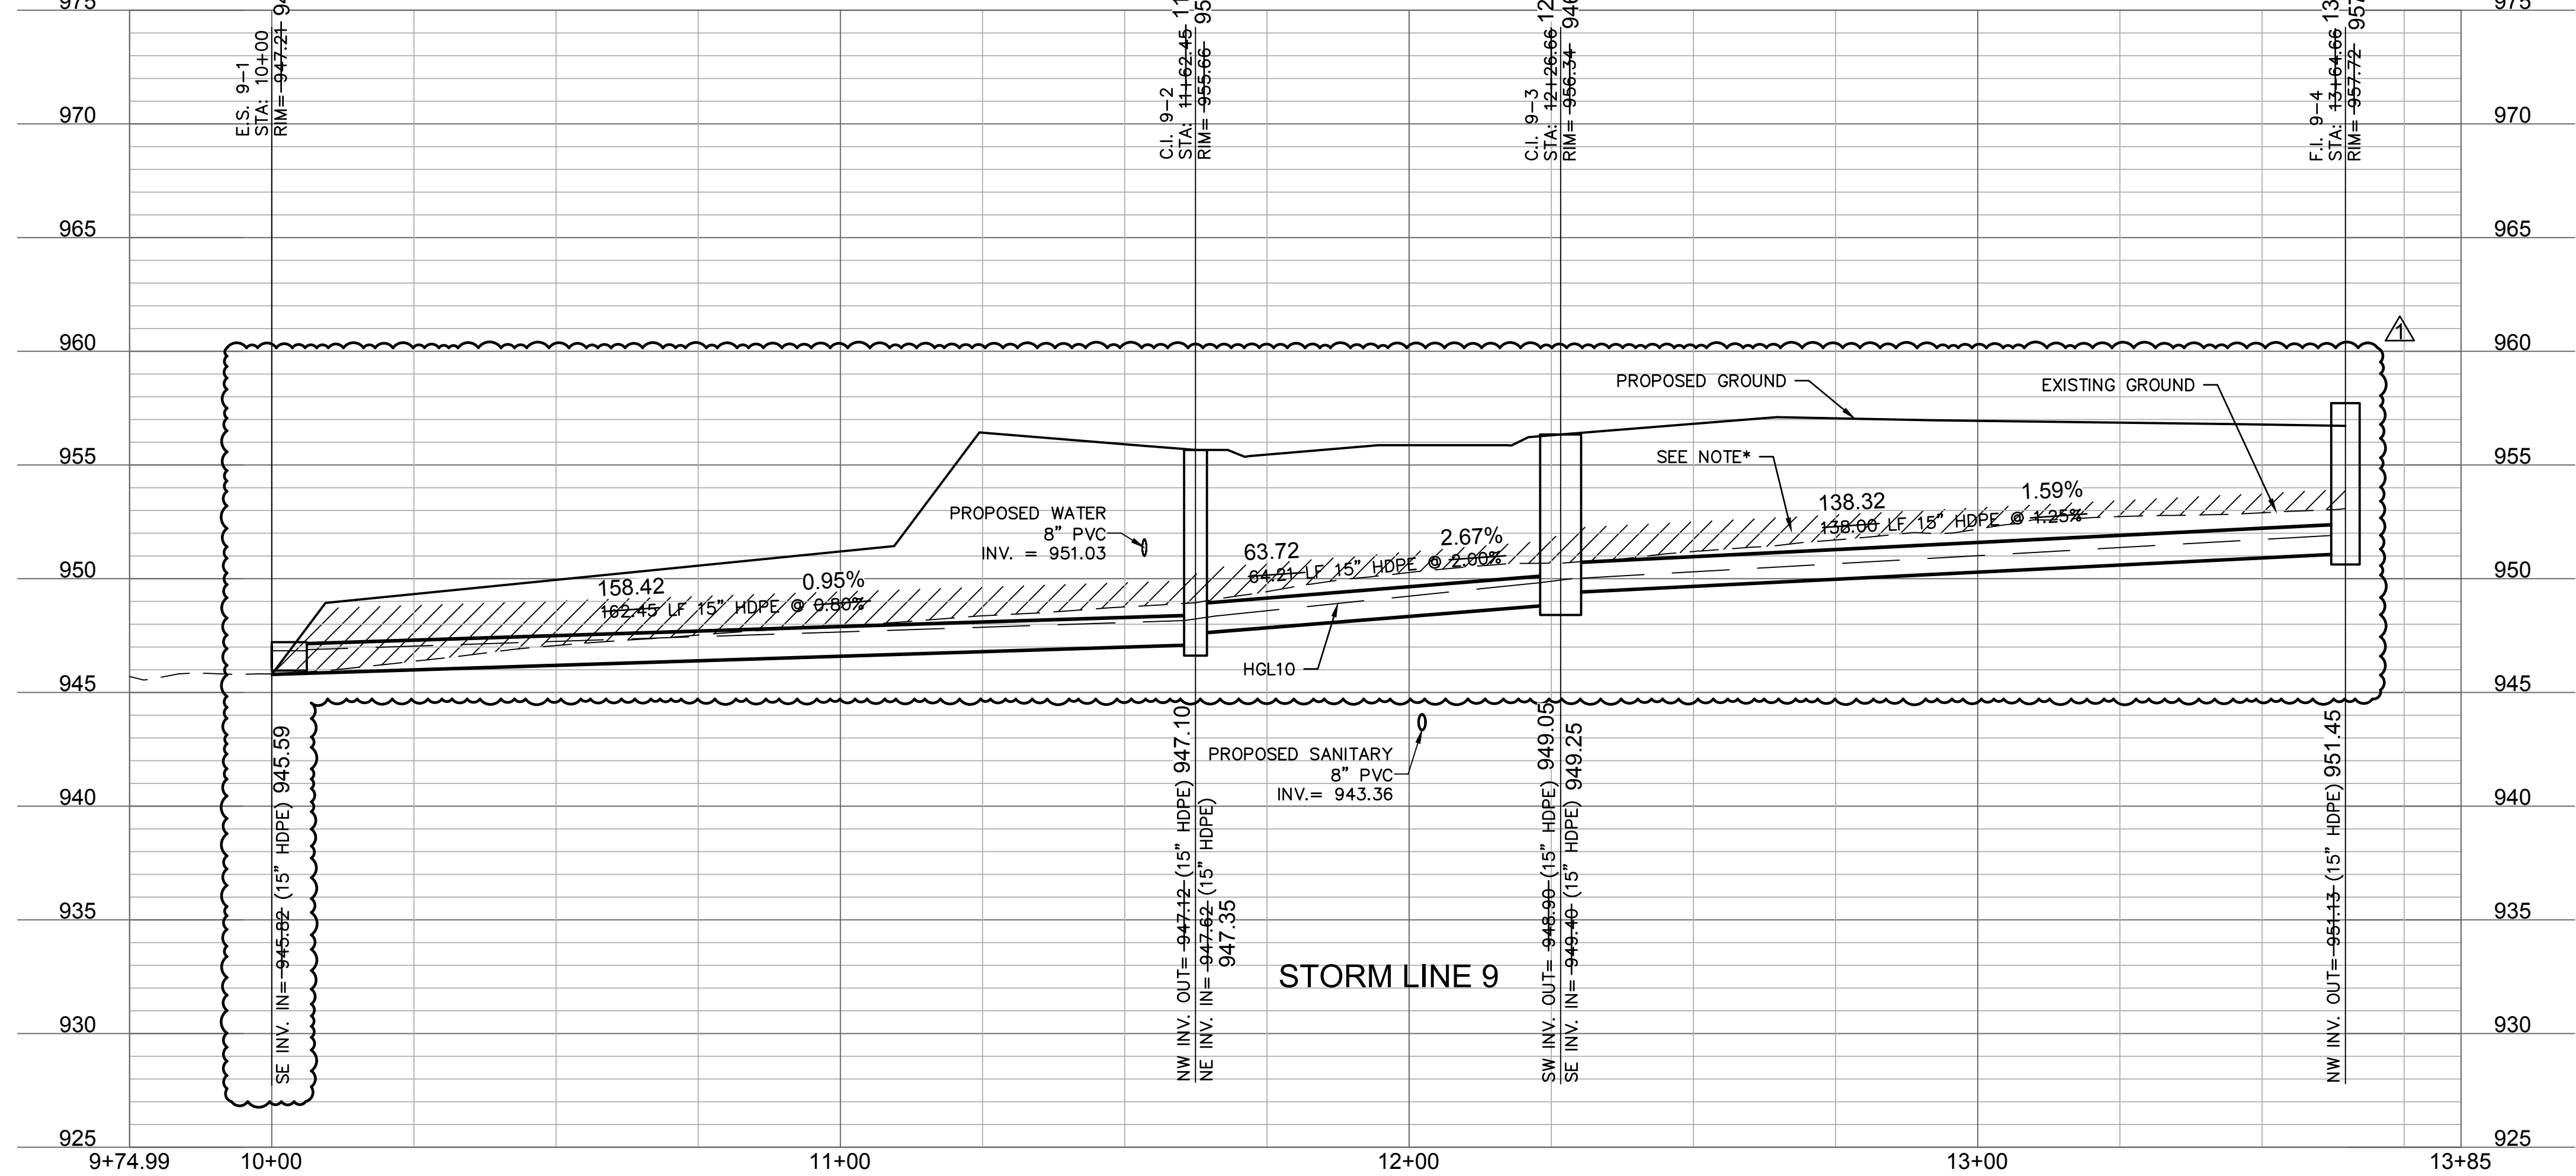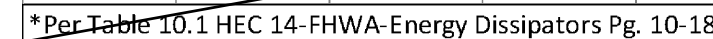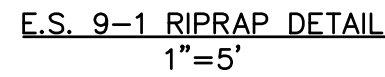

These plans have been reviewed for accuracy and are accepted for basic conformance to the approved construction drawings.

DATE SURVEYED: 2022-05-26



*NOTE: CONTRACTOR SHALL FILL AND COMPACT TO 95% STANDARD DENSITY TO A POINT 18" MINIMUM ABOVE THE TOP OF PIPE PRIOR TO EXCAVATION FOR THE PIPE


STORM SEWER PLAN & PROFILE (LINE)

HOOK FARMS
SECOND PLAT

LEE'S SUMMIT. MO.


drawn by: B.M.W./A.A.
checked by: B.M.W.
designed by: B.M.W./A.A.
QA/QC by: J.E.S.
project no.: B19-4061
date: 01-08-2021

SHEET
C140

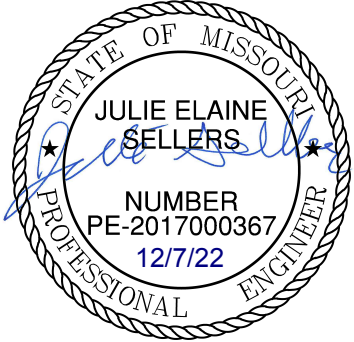[illegible]

Olsson - Civil Engineering
Missouri Certificate of Authority #001592
1301 Burlington Street
North Kansas City, MO 64116
TEL 816.361.1177
FAX 816.361.1888
www.olsson.com

olson

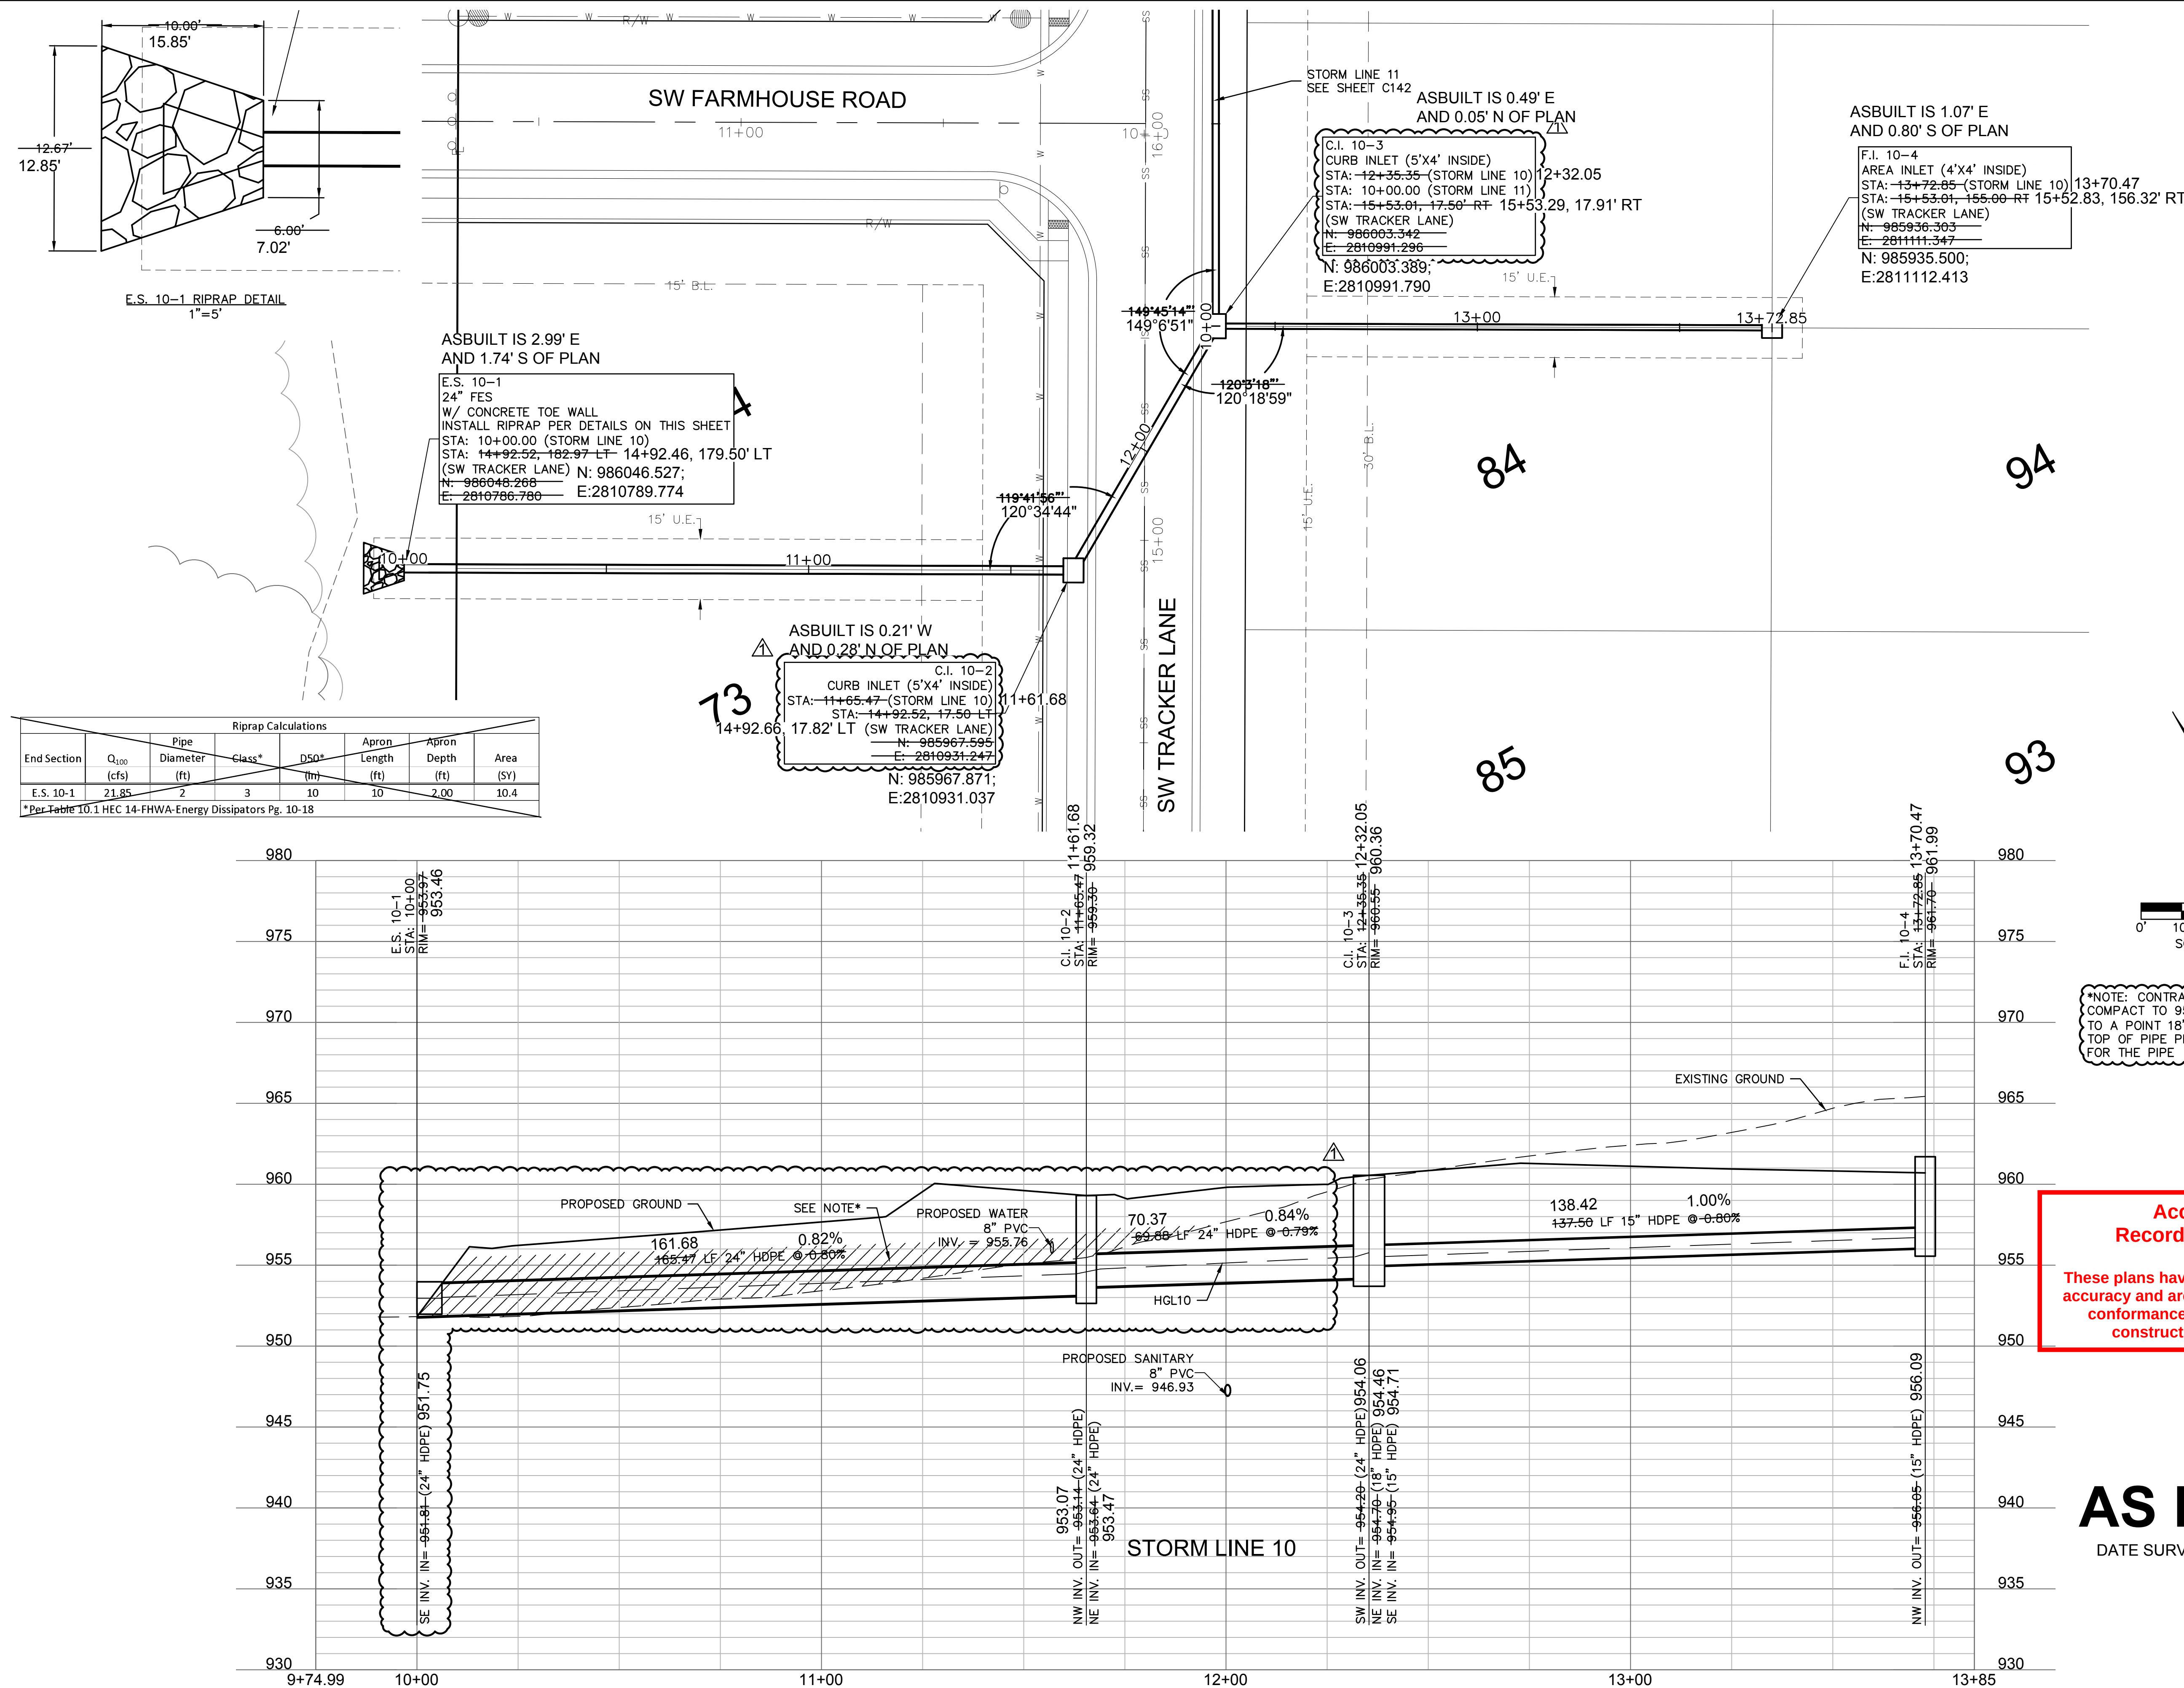


*NOTE: CONTRACTOR SHALL FILL AND COMPACT TO 95% STANDARD DENSITY TO A POINT 18" MINIMUM ABOVE THE TOP OF PIPE PRIOR TO EXCAVATION FOR THE PIPE

**Accepted
Record Drawings**




These plans have been reviewed for accuracy and are accepted for basic conformance to the approved construction drawings.

AS BUILT
DATE SURVEYED: 2022-05-26

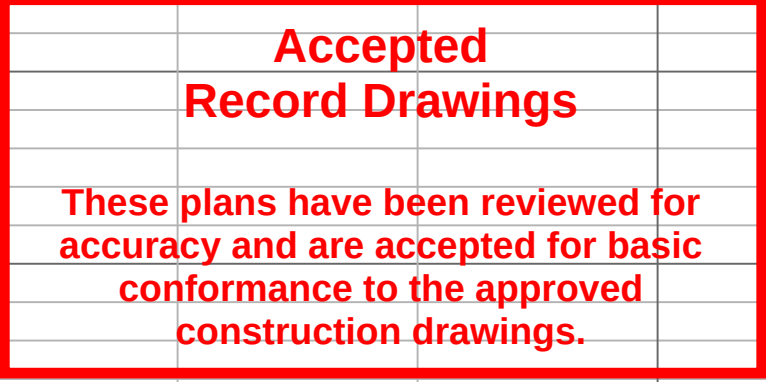

drawn by: B.M.W./A.A.
 checked by: B.M.W.
 designed by: B.M.W./A.A.
 QA/QC by: J.E.S.
 project no.: B19-4061
 date: 01-08-2021



DWG: F:\2019\4001-4500\019-4061-BV40-Design\AutoCAD\Asbuilt\Sheets\GNCV\Street & Storm Plans\C_DBP01_B194061.dwg
DATE: Dec 07, 2022 4:36pm XREFS: C_PTBULK_B194061 C_XBASE_B194061 C_PBNDY_B194061 C_PBTIL_B194061 C_FBASE_B194061
USER: ssoylor

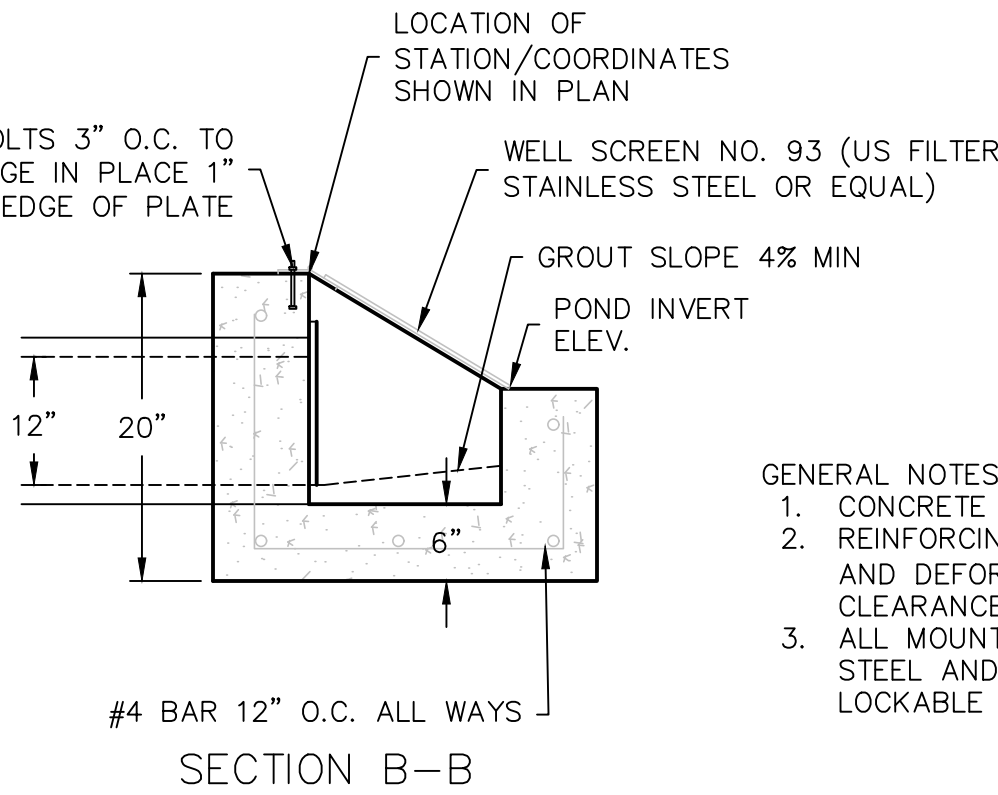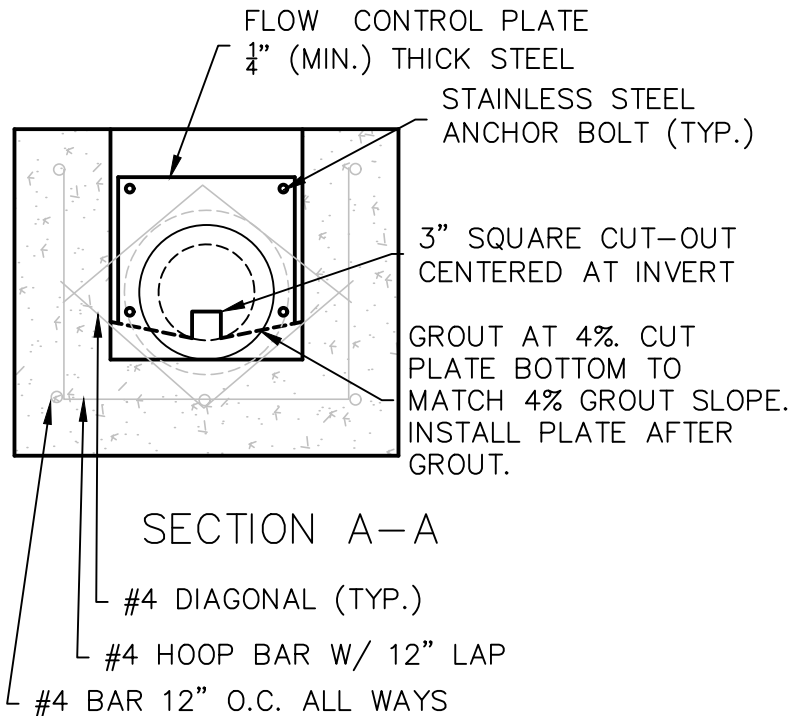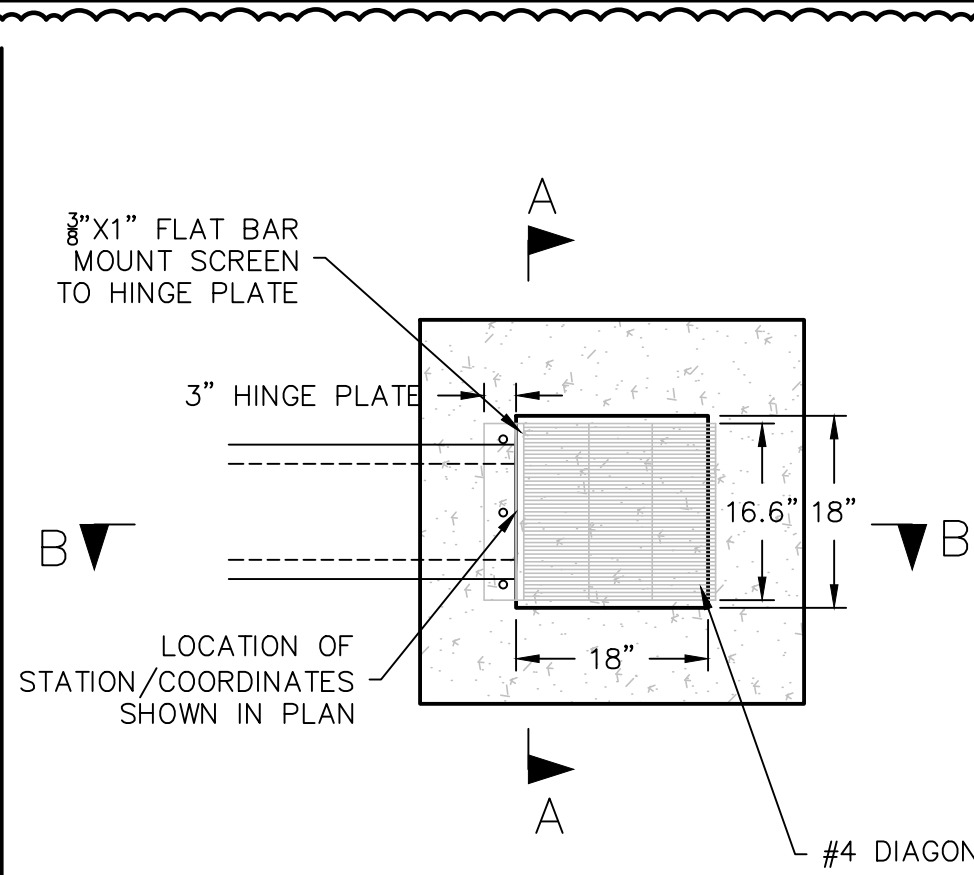

**Accepted
Record Drawings**

These plans have been reviewed for accuracy and are accepted for basic conformance to the approved construction drawings.

- GENERAL NOTES:
1. CONCRETE SHALL BE CLASS B
 2. REINFORCING BARS SHALL BE EPOXY COATED AND DEFORMED, AND SHALL HAVE MINIMUM 2" CLEARANCE.
 3. ALL MOUNTING HARDWARE TO BE STAINLESS STEEL AND PROVIDED WITH HINGES AND LOCKABLE OR BOLTABLE ACCESS.

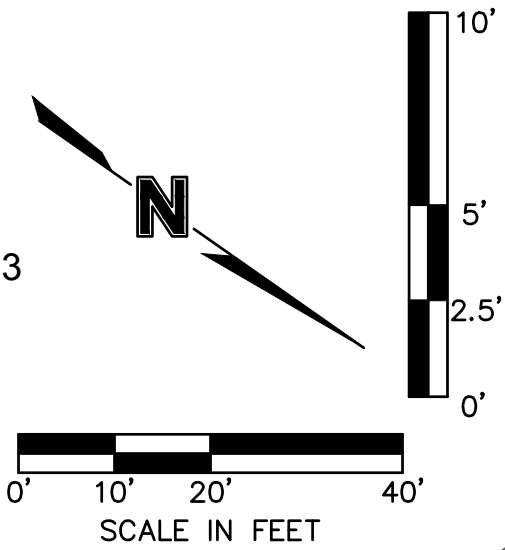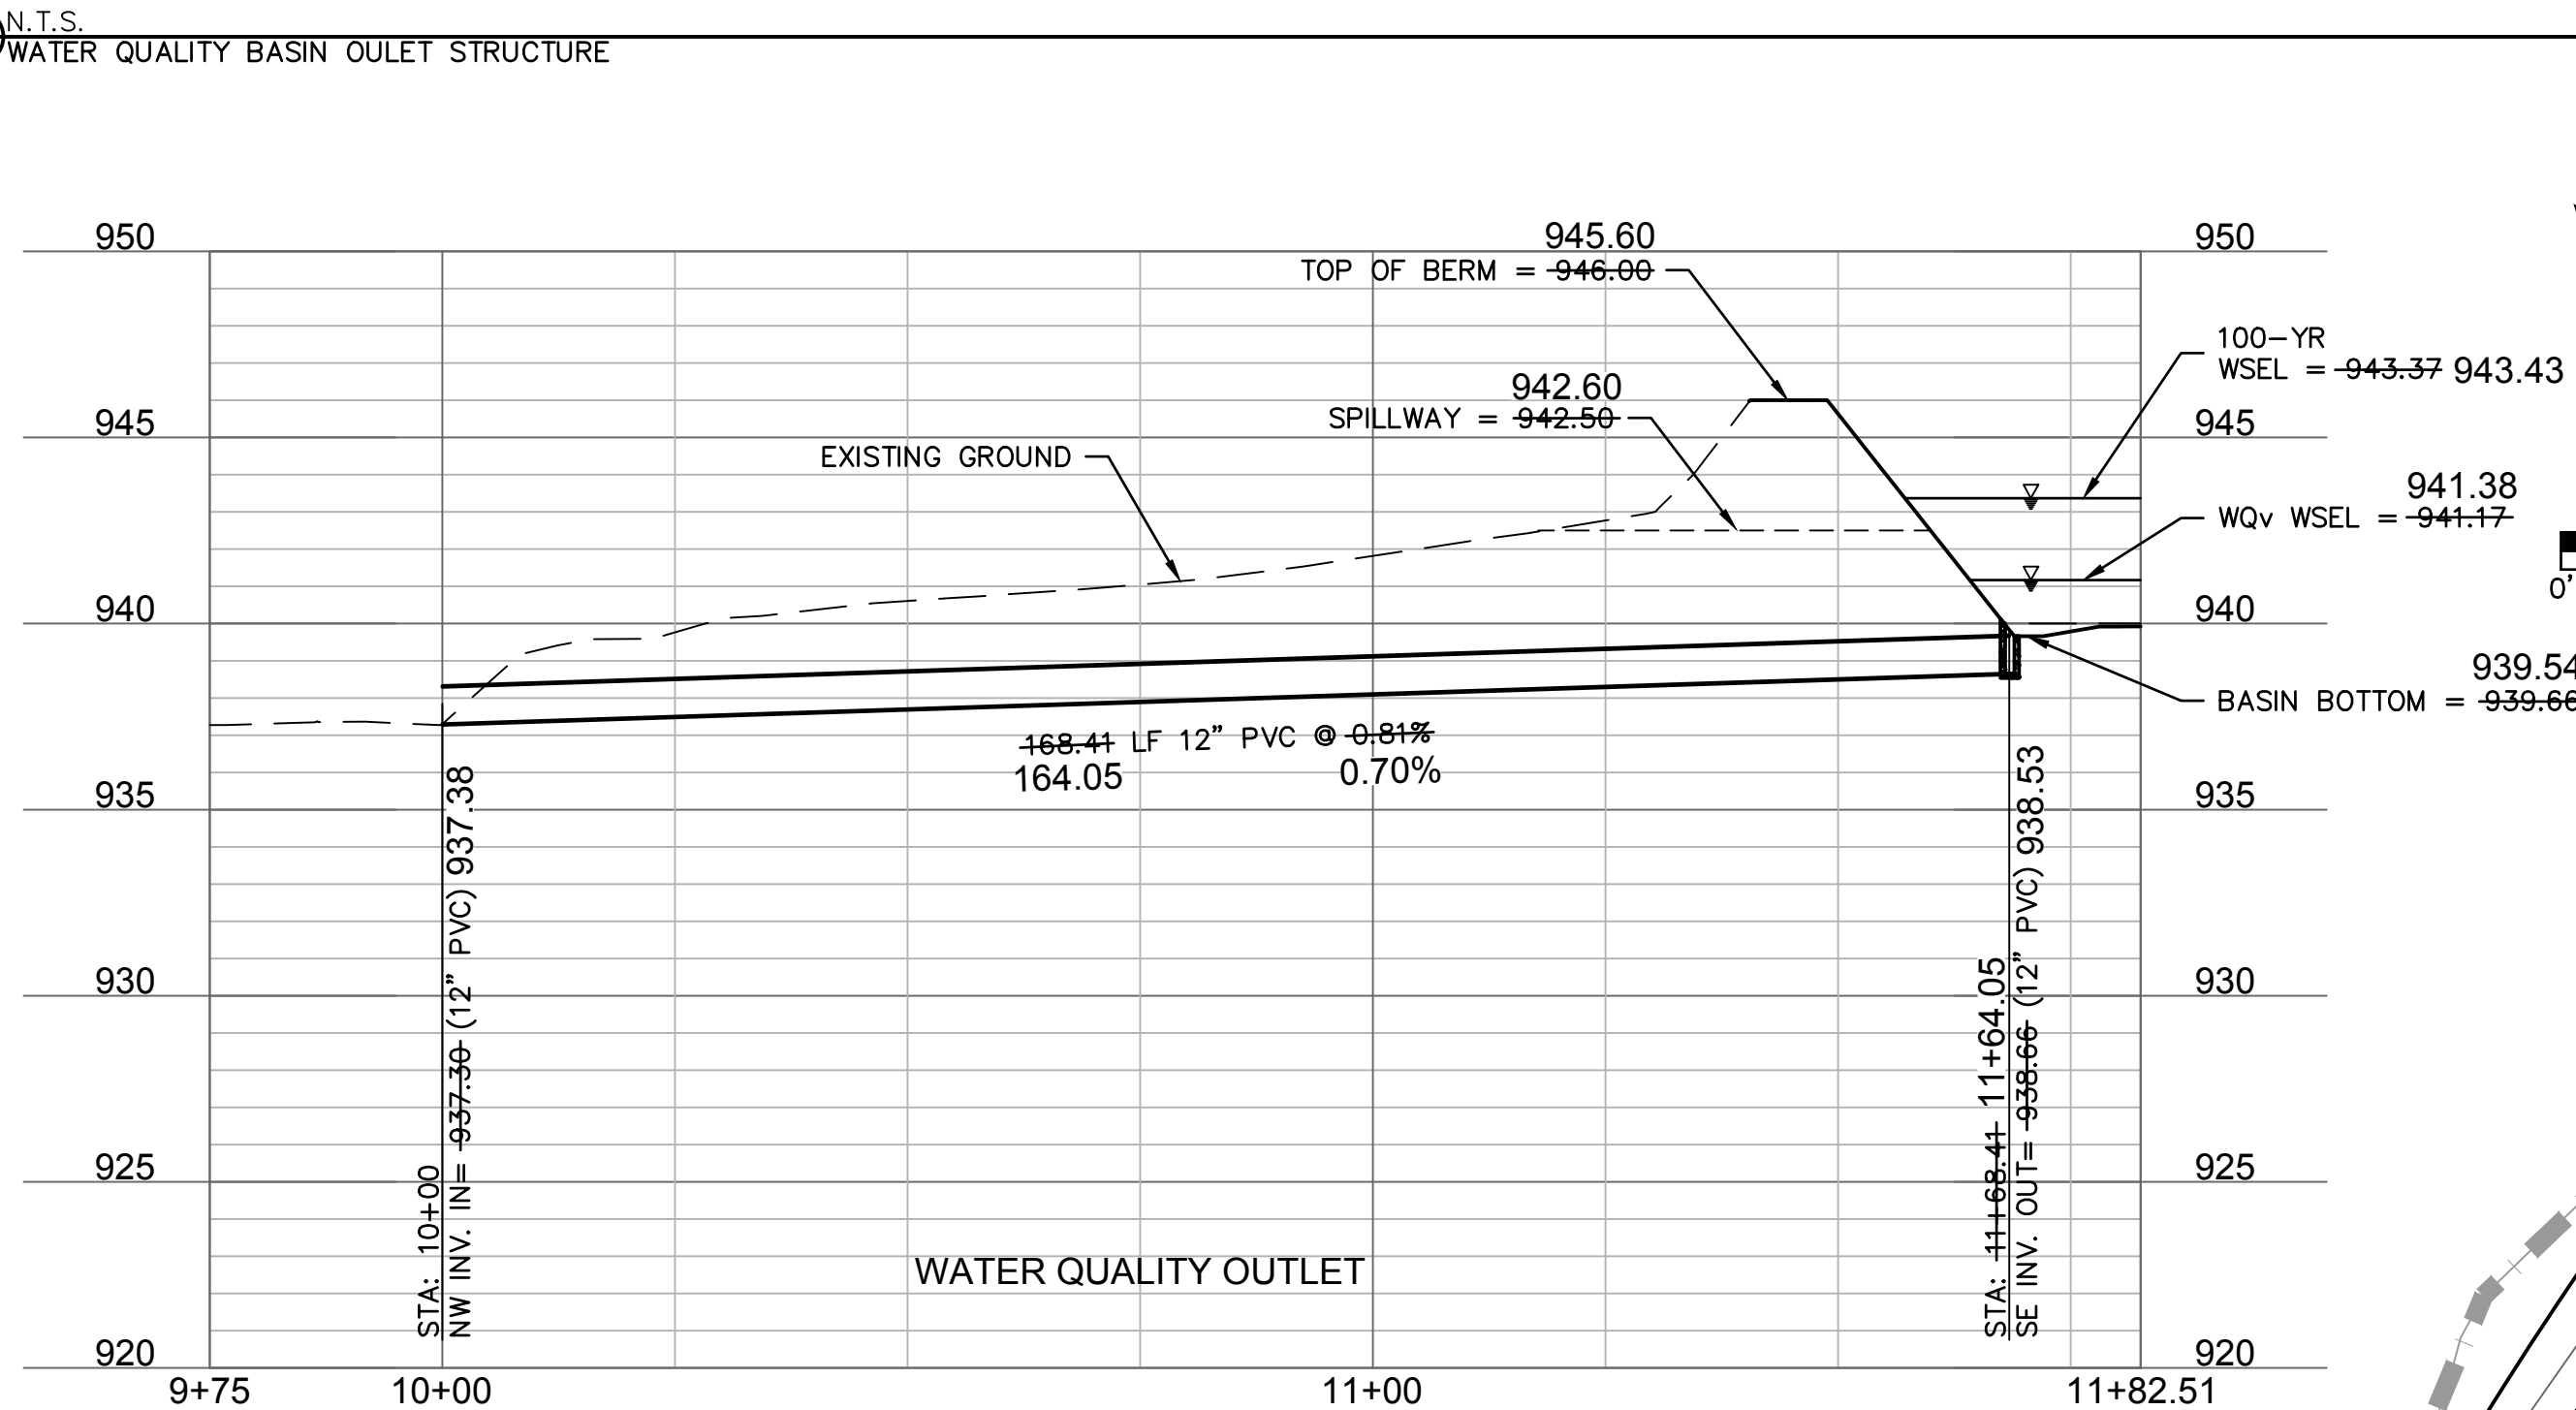


INSTALL 1731 S.F. OF NORTH AMERICAN GREEN SC250 TURF REINFORCEMENT MATTING OVER SPILLWAY

BASIN DETAILS	
SPILLWAY TYPE	BROAD CRESTED WEIR
SPILLWAY LENGTH	75 58 FT
SPILLWAY ELEVATION	942.60 942.50 FT
SPILLWAY DEPTH	3.00 3.50 FT
DAM ELEVATION	945.60 946.00 FT
WATER QUALITY STORM WATER SURFACE ELEVATION	941.38 941.47 FT
100-YR DESIGN WATER SURFACE ELEVATION	943.43 943.37 FT
DESIGN STORAGE	80,201 409,935 CF

Riprap Calculations						
End Section	Q ₁₀₀ (cfs)	Pipe Diameter (ft)	Class*	D50* (in)	Apron Length (ft)	Apron Depth (ft)
WQv Outlet	4.154	1	1	5	4	1.46

*Per Table 10.1 HEC 14-FHWA-Energy Dissipators Pg. 10-18

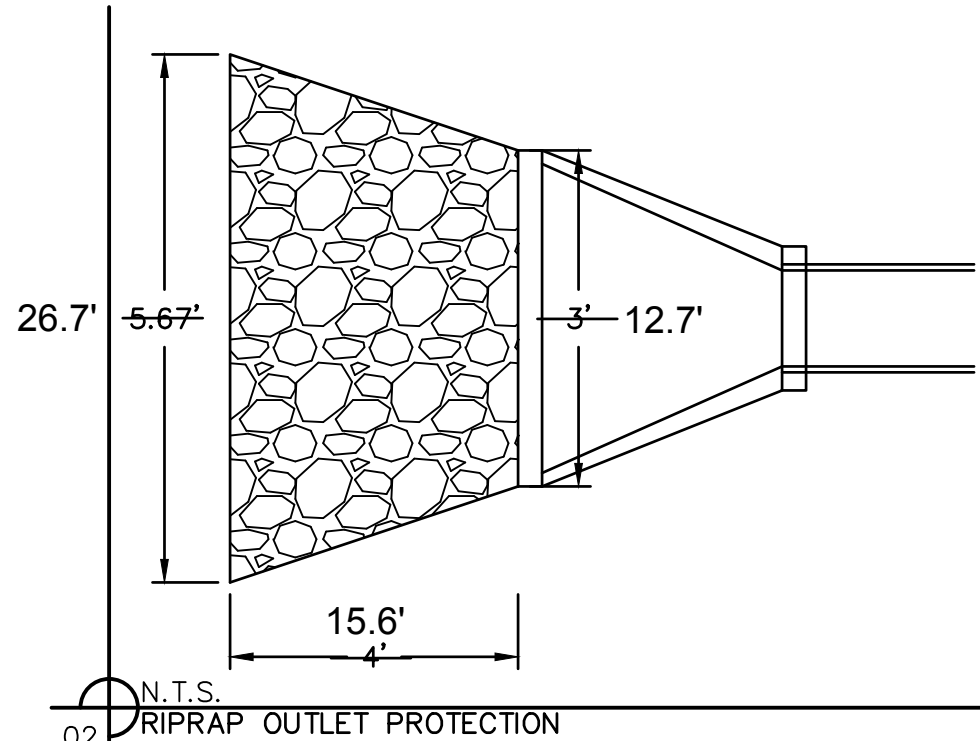

AS BUILT
DATE SURVEYED: 2022-05-26

STA.: 10+00.00
INSTALL 12" HDPE END SECTION W/ CONCRETE TOE WALL.
INSTALL RIPRAP PER DETAILS ON THIS SHEET.
N: 985095.415
E: 2811129.828
N: 985097.57
E: 2811128.71

STA.: 11+64.05
WATER QUALITY BASIN OUTLET STRUCTURE, SEE DETAIL ON THIS SHEET
N: 985236.846
E: 2811041.573
N: 985097.57
E: 2811128.71

olsson

Olsson - Civil Engineering
Missouri Certificate of Authority #001592
1301 Burlington Street
North Kansas City, MO 64116
TEL 816.361.1177
FAX 816.361.1888
www.olsson.com

STATE OF MISSOURI
JULIE ELAINE SELLERS
NUMBER PE-2017000367
12/7/22
PROFESSIONAL ENGINEER

BY
DATE
REV. NO.
REVISIONS DESCRIPTION
1 03-23-2021 REVISED PER CITY COMMENTS
2 04-16-2021 REVISED PER CITY COMMENTS
3 09-30-2021 CHANGES TO APPROVED PLANS

2021

WATER QUALITY BASIN PLAN
STREET & STORM SEWER PLANS
HOOK FARMS
SECOND PLAT
LEE'S SUMMIT, MO

drawn by: B.M.W./A.A.
checked by: B.M.W./A.A.
designed by: B.M.W./A.A.
QA/QC by: J.E.S.
project no.: B19-4061
date: 01-08-2021


SHEET
C143

DWG: F:\2019\4001-4500\019-4061-BV40-Design\AutoCAD\Asbuilt\Sheets\GNCV\Street & Storm Plans\B194061.dwg
DATE: Oct 11, 2022 3:40pm
USER: ssaylor
C_PSTRM_B194061
C_PTBLK_B194061
C_PBDY_B194061
C_PBASE_B194061

LEGEND	
	FINISHED INDEX CONTOURS
	FINISHED INTERMEDIATE CONTOURS
	RIDGE LINE
	DRAINAGE AREA
	RUNOFF COEFFICIENT
	STORM STRUCTURE NUMBER

**Accepted
Record Drawings**

These plans have been reviewed for accuracy and are accepted for basic conformance to the approved construction drawings.

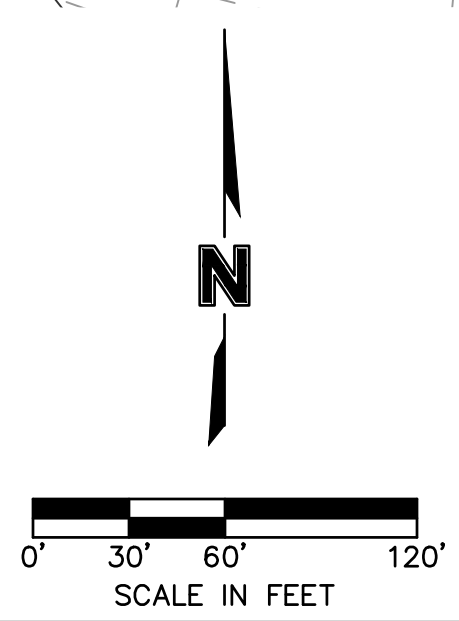

olsson

Olsson - Civil Engineering
Missouri Certificate of Authority #001592
1301 Burlington Street
North Kansas City, MO 64116
TEL 816.361.1177
FAX 816.361.1888
www.olsson.com

STATE OF MISSOURI
JULIE ELAINE SELLERS
NUMBER
PE-2017000367
12/7/22
PROFESSIONAL ENGINEER

BY

REVISIONS DESCRIPTION

DATE

REV. NO.

1

REVISED PER CITY COMMENTS

03-23-2021

1

2

REVISED PER CITY COMMENTS

04-16-2021

2

3

CHANGES TO APPROVED PLANS

09-30-2021

3

DRAINAGE PLAN
STREET & STORM SEWER PLANS
HOOK FARMS
SECOND PLAT

2021

LEE'S SUMMIT, MO

SHEET
C145

drawn by: B.M.W./A.A.
checked by: B.M.W.
designed by: B.M.W./A.A.
QA/QC by: J.E.S.
project no.: B19-4061
date: 01-08-2021

Inlet Design Table						
10 Year Return Frequency						
Inlet ID	Captured Flow	Bypass Flow	Inlet Efficiency (Note 2)	Gutter Depth	Gutter Spread	Ponding Depth
	(cfs)	(cfs)	(%)	(ft)	(ft)	(ft)
C.I. 1-2(L)	3.36	0.00	100.00%	0.20	10.20	...
C.I. 1-2(R)	0.23	0.00	100.00%	0.07	3.74	...
C.I. 1-2	4.19	0.00	100.00%	...	...	...
C.I. 1-3(L)	0.34	0.00	100.00%	0.09	4.36	...
C.I. 1-3(R)	2.74	0.00	100.00%	0.19	9.44	...
C.I. 1-3	7.20	0.00	100.00%	...	...	...
C.I. 1-4	1.43	0.24	85.63%	0.14	7.21	...
C.I. 1-6	1.94	0.32	85.85%	0.18	8.79	...
C.I. 1-7	1.08	0.13	89.48%	0.13	6.36	...
C.I. 1-8	1.05	0.12	89.77%	0.13	6.28	...
F.I. 2-1	3.04	0.00	100.00%	...	...	0.15
F.I. 2-2	2.59	0.00	100.00%	...	...	0.13
F.I. 2-3	2.48	0.00	100.00%	...	...	0.13
C.I. 2-5	0.64	0.03	95.13%	0.11	5.27	...
C.I. 2-6	0.97	0.08	91.95%	0.12	6.22	...
C.I. 3-1	1.08	0.11	90.54%	0.13	6.47	...
C.I. 4-1	1.66	0.32	83.66%	0.16	7.76	...
C.I. 4-2	1.28	0.18	87.85%	0.14	6.92	...
C.I. 5-1	1.34	0.20	87.27%	0.14	7.05	...
C.I. 5-2	1.54	0.27	85.02%	0.15	7.50	...
C.I. 6-1	3.22	0.90	78.18%	0.21	10.38	...
F.I. 6-2	3.41	0.00	100.00%	...	...	0.16
F.I. 6-3	4.16	0.00	100.00%	...	...	0.18
C.I. 7-1	3.80	1.42	72.80%	0.23	11.35	...
C.I. 8-2(L)	2.06	0.00	100.00%	0.15	7.65	...
C.I. 8-2(R)	0.99	0.00	100.00%	0.13	6.25	...
C.I. 8-2	3.99	0.00	100.00%	...	...	...
C.I. 8-3	1.51	0.17	89.96%	0.16	7.96	...
C.I. 8-4	1.10	0.14	88.79%	0.13	6.37	...
C.I. 8-5	1.86	0.38	83.08%	0.17	8.31	...
C.I. 9-2	0.98	0.08	92.39%	0.13	6.34	...
C.I. 9-3	1.59	0.25	86.30%	0.16	7.76	...
F.I. 9-4	3.68	0.00	100.00%	...	...	0.17
C.I. 10-2	0.33	0.01	97.51%	0.08	3.88	...
C.I. 10-3	1.85	0.41	81.75%	0.16	8.20	...
F.I. 10-4	2.63	0.00	100.00%	...	...	0.14
C.I. 11-1	3.20	1.41	69.52%	0.22	11.03	...
C.I. 11-2	0.91	0.07	92.93%	0.12	6.12	...
C.I. 11-3	3.67	2.18	62.75%	0.24	11.98	...
C.I. 12-1	0.94	0.07	92.82%	0.12	6.25	...

Drainage Area Design Table						
10 Year Return Frequency						
Inlet ID	Drainage Area	C	Tc	i	K	Peak Flow
	(ac)		(min)	(in/hr)		(cfs)
C.I. 1-2(L)	0.87	0.51	5.00	7.35	1.00	3.26
C.I. 1-2(R)	0.06	0.51	5.00	7.35	1.00	0.23
C.I. 1-2(B)	0.16	0.51	5.00	7.35	1.00	0.60
C.I. 1-2	1.09	0.51	5.00	7.35	1.00	4.09
C.I. 1-3(L)	0.09	0.51	5.00	7.35	1.00	0.34
C.I. 1-3(R)	0.55	0.51	5.00	7.35	1.00	2.06
C.I. 1-3(B)	1.10	0.51	5.00	7.35	1.00	4.13
C.I. 1-3	1.74	0.51	5.00	7.35	1.00	6.53
C.I. 1-4	0.36	0.51	5.00	7.35	1.00	1.35
C.I. 1-6	0.50	0.51	5.00	7.35	1.00	1.88
C.I. 1-7	0.27	0.51	5.00	7.35	1.00	1.01
C.I. 1-8	0.24	0.51	5.00	7.35	1.00	0.90
F.I. 2-1	0.81	0.51	5.00	7.35	1.00	3.04
F.I. 2-2	0.69	0.51	5.00	7.35	1.00	2.59
F.I. 2-3	0.66	0.51	5.00	7.35	1.00	2.48
C.I. 2-5	0.18	0.51	5.00	7.35	1.00	0.68
C.I. 2-6	0.28	0.51	5.00	7.35	1.00	1.05
C.I. 3-1	0.27	0.51	5.00	7.35	1.00	1.01
C.I. 4-1	0.52	0.51	5.00	7.35	1.00	1.95
C.I. 4-2	0.39	0.51	5.00	7.35	1.00	1.46
C.I. 5-1	0.40	0.51	5.00	7.35	1.00	1.50
C.I. 5-2	0.46	0.51	5.00	7.35	1.00	1.73
C.I. 6-1	0.72	0.51	5.00	7.35	1.00	2.70
F.I. 6-2	0.91	0.51	5.00	7.35	1.00	3.41
F.I. 6-3	1.11	0.51	5.00	7.35	1.00	4.16
C.I. 7-1	1.02	0.51	5.00	7.35	1.00	3.83
C.I. 8-2(L)	0.55	0.51	5.00	7.35	1.00	2.06
C.I. 8-2(R)	0.22	0.51	5.00	7.35	1.00	0.83
C.I. 8-2(B)	0.25	0.51	5.00	7.35	1.00	0.94
C.I. 8-2	1.02	0.51	5.00	7.35	1.00	3.83
C.I. 8-3	0.31	0.51	5.00	7.35	1.00	1.16
C.I. 8-4	0.31	0.51	5.00	7.35	1.00	1.16
C.I. 8-5	0.53	0.51	5.00	7.35	1.00	1.99
C.I. 9-2	0.28	0.51	5.00	7.35	1.00	1.05
C.I. 9-3	0.38	0.51	5.00	7.35	1.00	1.43
F.I. 9-4	0.98	0.51	5.00	7.35	1.00	3.68
C.I. 10-2	0.09	0.51	5.00	7.35	1.00	0.34
C.I. 10-3	0.23	0.51	5.00	7.35	1.00	0.86
F.I. 10-4	0.70	0.51	5.00	7.35	1.00	2.63
C.I. 11-1	0.63	0.51	5.00	7.35	1.00	2.36
C.I. 11-2	0.26	0.51	5.00	7.35	1.00	0.98
C.I. 11-3	1.32	0.51	5.00	7.35	1.00	4.95
C.I. 12-1	0.27	0.51	5.00	7.35	1.00	1.01

Storm Sewer Design Calculation Table													
10 Year Return Frequency													
Upstream Structure	Downstream Structure	Length (ft)	Upstream Invert (ft)	Downstream Invert (ft)	Slope (%)	Diameter (in)	Manning's n	Total Flow (cfs)	Velocity (ft/s)	Capacity (cfs)	Flow Depth (ft)	Upstream Struct. HGL (ft)	Upstream Top Elev. (ft)
C.I. 1-2	E.S. 1-1	202.00	942.02	940.00	1.00	36	0.012	65.27	10.82	72.25	2.23	944.61	952.95
C.I. 1-3	C.I. 1-2	35.00	942.83	942.52	0.86	36	0.012	61.08	10.33	68.99	2.19	945.35	952.95
C.I. 1-4	C.I. 1-3	133.97	944.39	943.32	0.80	36	0.012	53.88	9.58	64.51	2.10	946.77	954.53
M.H. 1-5	C.I. 1-4	44.30	945.24	944.89	0.79	36	0.012	51.37	9.41	64.22	2.03	947.57	954.65
C.I. 1-6	M.H. 1-5	134.49	946.82	945.74	0.80	36	0.012	51.37	9.44	64.75	2.02	949.15	956.22
C.I. 1-7	C.I. 1-6	148.70	949.01	947.82	0.80	24	0.012	16.30	7.01	21.91	1.33	950.46	958.22
C.I. 1-8	C.I. 1-7	36.74	949.80	949.51	0.79	24	0.012	15.22	6.97	21.77	1.23	951.21	958.58
NULL ON LINE 1	C.I. 1-8	104.17	951.34	950.30	1.00	24	0.012	14.17	7.17	24.48	1.09	952.69	953.52
F.I. 2-1	C.I. 1-6	72.94	948.43	947.32	1.52	30	0.012	34.08	8.46	54.44	1.85	950.41	956.89
F.I. 2-2	F.I. 2-1	144.00	950.89	948.93	1.36	30	0.012	30.54	8.99	51.83	1.46	952.77	959.91
F.I. 2-3	F.I. 2-2	101.30	953.42	951.39	2.00	24	0.012	25.01	9.67	34.69	1.38	955.18	962.04
M.H. 2-4	F.I. 2-3	136.61	956.99	953.92	2.25	24	0.012	19.65	8.37	36.73	1.26	958.58	965.63
C.I. 2-5	M.H. 2-4	138.00	962.32	957.49	3.50	24	0.012	19.65	9.27	45.84	1.09	963.91	970.31
C.I. 2-6	C.I. 2-5	230.00	967.30	963.07	1.84	15	0.012	8.72	8.09	9.49	0.94	968.44	973.99
NULL ON LINE 2	C.I. 2-6	178.30	969.58	967.80	1.00	15	0.012	3.95	5.30	6.99	0.67	970.38	970.95
C.I. 3-1	C.I. 1-4	53.27	947.21	946.14	2.01	15	0.012	1.08	2.42	9.91	0.63	947.62	955.25
C.I. 4-1	F.I. 2-2	138.00	953.24	952.14	0.80	15	0.012	2.94	4.48	6.25	0.63	953.93	959.27
C.I. 4-2	C.I. 4-1	39.15	954.05	953.74	0.79	15	0.012	1.28	3.62	6.22	0.38	954.50	958.93
C.I. 5-1	F.I. 2-3	138.00	955.30	953.92	1.00	18	0.012	2.88	2.89	11.38	1.26	955.94	961.95
C.I. 5-2	C.I. 5-1	34.34	956.14	955.80	0.99	15	0.012	1.54	4.00	6.96	0.40	956.63	962.04
C.I. 6-1	C.I. 2-5	44.69	963.21	962.82	0.87	24	0.012	10.29	5.69	22.89	1.09	964.36	970.78
F.I. 6-2	C.I. 6-1	150.50	964.91	963.71	0.80	18	0.012	7.57	5.97	10.16	0.96	965.97	970.06
F.I. 6-3	F.I. 6-2	225.00	970.47	965.41	2.25	15	0.012	4.16	6.45	10.49	0.55	971.29	975.91
C.I. 7-1	C.I. 2-6	41.62	968.22	967.80	1.01	15	0.012	3.80	5.25	7.03	0.66	969.04	974.37
C.I. 8-2	E.S. 8-1	38.74	939.82	939.57	0.65	18	0.012	8.46	5.88	9.14	1.13	940.97	946.73
C.I. 8-3	C.I. 8-2	235.47	942.67	940.32	1.00	15	0.012	4.47	4.98	6.99	0.86	943.53	950.92
C.I. 8-4	C.I. 8-3	103.13	944.46	943.17	1.25	15	0.012	2.96	5.09	7.82	0.53	945.15	952.80
C.I. 8-5	C.I. 8-4	34.61	945.39	944.96	1.24	15	0.012	1.86	4.43	7.80	0.42	945.93	952.88
C.I. 9-2	E.S. 9-1	162.45	947.12	945.82	0.80	15	0.012	5.73	5.70	6.26	0.94	948.09	955.66
C.I. 9-3	C.I. 9-2	64.21	948.90	947.62	1.99	15	0.012	4.75	6.55	9.88	0.61	949.78	956.35
F.I. 9-4	C.I. 9-3	138.00	951.13	949.40	1.25	15	0.012	3.68	5.44	7.83	0.60	951.90	957.72
C.I. 10-2	E.S. 10-1	165.47	953.14	951.81	0.80	24	0.012	13.10	6.67	21.93	1.11	954.44	959.29
C.I. 10-3	C.I. 10-2	69.88	954.20	953.64	0.79	24	0.012	12.77	6.63	22.01	1.09	955.48	960.55
F.I. 10-4	C.I. 10-3	137.50	956.05	954.95	0.80	15	0.012	2.63	4.48	6.25	0.57	956.70	961.70
C.I. 11-1	C.I. 10-3	150.00	955.90	954.70	0.80	18	0.012	8.72	6.26	10.18	1.07	957.04	962.77
C.I. 11-2	C.I. 11-1	106.77	958.00	956.40	1.50	15	0.012	4.58	6.07	8.56	0.65	958.87	964.79
C.I. 11-3	C.I. 11-2	34.00	958.84	958.50	1.00	15	0.012	3.67	5.19	7.00	0.64	959.61	964.79
C.I. 12-1	C.I. 11-1	36.23	956.76	956.40	0.99	15	0.012	0.94	2.23	6.97	0.64	957.14	962.95

NOT AS-BUILT

Accepted
Record Drawings

These plans have been reviewed for accuracy and are accepted for basic conformance to the approved construction drawings.

olsson

Olsson - Civil Engineering
Missouri Certificate of Authority #001592
1301 Burlington Street
North Kansas City MO 64116
TEL 816.361.1177
FAX 816.361.1888
www

Inlet Design Table						
100 Year Return Frequency						
Inlet ID	Captured Flow	Bypass Flow	Inlet Efficiency (Note 2)	Gutter Depth	Gutter Spread	Ponding Depth
	(cfs)	(cfs)	(%)	(ft)	(ft)	(ft)
C.I. 1-2(L)	6.19	0.00	100.00%	0.26	12.82	...
C.I. 1-2(R)	0.39	0.00	100.00%	0.09	4.62	...
C.I. 1-2	7.63	0.00	100.00%	...	...	...
C.I. 1-3(L)	0.59	0.00	100.00%	0.11	5.38	...
C.I. 1-3(R)	6.36	0.00	100.00%	0.26	12.96	...
C.I. 1-3	14.19	0.00	100.00%	...	...	...
C.I. 1-4	2.44	0.89	73.20%	0.19	9.34	...
C.I. 1-6	3.55	1.43	71.29%	0.24	11.81	...
C.I. 1-7	1.90	0.48	79.74%	0.16	8.20	...
C.I. 1-8	1.92	0.50	79.31%	0.17	8.25	...
F.I. 2-1	5.33	0.00	100.00%	...	...	0.22
F.I. 2-2	4.54	0.00	100.00%	...	...	0.19
F.I. 2-3	4.34	0.00	100.00%	...	...	0.19
C.I. 2-5	1.08	0.11	90.84%	0.13	6.50	...
C.I. 2-6	1.58	0.26	85.66%	0.15	7.68	...
C.I. 3-1	1.89	0.42	81.80%	0.17	8.30	...
C.I. 4-1	2.57	0.96	72.69%	0.19	9.63	...
C.I. 4-2	2.03	0.53	79.27%	0.17	8.55	...
C.I. 5-1	2.14	0.60	78.02%	0.18	8.76	...
C.I. 5-2	2.44	0.85	74.25%	0.19	9.38	...
C.I. 6-1	5.35	4.17	56.23%	0.28	14.21	...
F.I. 6-2	5.99	0.00	100.00%	...	...	0.23
F.I. 6-3	7.30	0.00	100.00%	...	...	0.27
C.I. 7-1	5.55	4.78	53.73%	0.29	14.65	...
C.I. 8-2(L)	3.62	0.00	100.00%	0.19	9.45	...
C.I. 8-2(R)	2.87	0.00	100.00%	0.19	9.30	...
C.I. 8-2	8.13	0.00	100.00%	...	...	...
C.I. 8-3	3.64	1.42	71.92%	0.24	12.02	...
C.I. 8-4	1.83	0.46	79.78%	0.16	8.02	...
C.I. 8-5	3.80	2.55	59.83%	0.25	12.28	...
C.I. 9-2	1.62	0.26	86.25%	0.16	7.85	...
C.I. 9-3	4.00	2.86	58.28%	0.25	12.72	...
F.I. 9-4	6.45	0.00	100.00%	...	...	0.25
C.I. 10-2	0.56	0.03	94.87%	0.10	4.79	...
C.I. 10-3	4.19	4.36	49.04%	0.27	13.48	...
F.I. 10-4	4.61	0.00	100.00%	...	...	0.20
C.I. 11-1	5.09	7.04	41.98%	0.32	15.85	...
C.I. 11-2	1.49	0.22	87.24%	0.15	7.56	...
C.I. 11-3	5.08	7.77	39.56%	0.32	16.10	...
C.I. 12-1	1.55	0.23	87.07%	0.15	7.71	...


Drainage Area Design Table						
100 Year Return Frequency						
Inlet ID	Drainage Area	C	Tc	i	K	Peak Flow
	(ac)		(min)	(in/hr)		(cfs)
C.I. 1-2(L)	0.87	0.51	5.00	10.32	1.25	5.73
C.I. 1-2(R)	0.06	0.51	5.00	10.32	1.25	0.39
C.I. 1-2(B)	0.16	0.51	5.00	10.32	1.25	1.05
C.I. 1-2	1.09	0.51	5.00	10.32	1.25	7.17
C.I. 1-3(L)	0.09	0.51	5.00	10.32	1.25	0.59
C.I. 1-3(R)	0.55	0.51	5.00	10.32	1.25	3.62
C.I. 1-3(B)	1.10	0.51	5.00	10.32	1.25	7.24
C.I. 1-3	1.74	0.51	5.00	10.32	1.25	11.45
C.I. 1-4	0.36	0.51	5.00	10.32	1.25	2.37
C.I. 1-6	0.50	0.51	5.00	10.32	1.25	3.29
C.I. 1-7	0.27	0.51	5.00	10.32	1.25	1.78
C.I. 1-8	0.24	0.51	5.00	10.32	1.25	1.58
F.I. 2-1	0.81	0.51	5.00	10.32	1.25	5.33
F.I. 2-2	0.69	0.51	5.00	10.32	1.25	4.54
F.I. 2-3	0.66	0.51	5.00	10.32	1.25	4.34
C.I. 2-5	0.18	0.51	5.00	10.32	1.25	1.18
C.I. 2-6	0.28	0.51	5.00	10.32	1.25	1.84
C.I. 3-1	0.27	0.51	5.00	10.32	1.25	1.78
C.I. 4-1	0.52	0.51	5.00	10.32	1.25	3.42
C.I. 4-2	0.39	0.51	5.00	10.32	1.25	2.57
C.I. 5-1	0.40	0.51	5.00	10.32	1.25	2.63
C.I. 5-2	0.46	0.51	5.00	10.32	1.25	3.03
C.I. 6-1	0.72	0.51	5.00	10.32	1.25	4.74
F.I. 6-2	0.91	0.51	5.00	10.32	1.25	5.99
F.I. 6-3	1.11	0.51	5.00	10.32	1.25	7.30
C.I. 7-1	1.02	0.51	5.00	10.32	1.25	6.71
C.I. 8-2(L)	0.55	0.51	5.00	10.32	1.25	3.62
C.I. 8-2(R)	0.22	0.51	5.00	10.32	1.25	1.45
C.I. 8-2(B)	0.25	0.51	5.00	10.32	1.25	1.65
C.I. 8-2	1.02	0.51	5.00	10.32	1.25	6.71
C.I. 8-3	0.31	0.51	5.00	10.32	1.25	2.04
C.I. 8-4	0.31	0.51	5.00	10.32	1.25	2.04
C.I. 8-5	0.53	0.51	5.00	10.32	1.25	3.49
C.I. 9-2	0.28	0.51	5.00	10.32	1.25	1.84
C.I. 9-3	0.38	0.51	5.00	10.32	1.25	2.50
F.I. 9-4	0.98	0.51	5.00	10.32	1.25	6.45
C.I. 10-2	0.09	0.51	5.00	10.32	1.25	0.59
C.I. 10-3	0.23	0.51	5.00	10.32	1.25	1.51
F.I. 10-4	0.70	0.51	5.00	10.32	1.25	4.61
C.I. 11-1	0.63	0.51	5.00	10.32	1.25	4.15
C.I. 11-2	0.26	0.51	5.00	10.32	1.25	1.71
C.I. 11-3	1.32	0.51	5.00	10.32	1.25	8.69
C.I. 12-1	0.27	0.51	5.00	10.32	1.25	1.78

Storm Sewer Design Calculation Table													
100 Year Return Frequency													
Upstream Structure	Downstream Structure	Length (ft)	Upstream Invert (ft)	Downstream Invert (ft)	Slope (%)	Diameter (in)	Manning's n	Total Flow (cfs)	Velocity (ft/s)	Capacity (cfs)	Flow Depth (ft)	Upstream Struct. HGL (ft)	Upstream Top Elev. (ft)
C.I. 1-2	E.S. 1-1	202.00	942.02	940.00	1.00	36	0.012	100.26	14.26	72.25	2.90	946.61	952.95
C.I. 1-3	C.I. 1-2	35.00	942.83	942.52	0.66	36	0.012	92.63	13.11	68.99	3.00	946.11	952.95
C.I. 1-4	C.I. 1-3	133.97	944.39	943.32	0.80	36	0.012	78.44	11.10	64.51	3.00	950.76	954.53
M.H. 1-5	C.I. 1-4	44.30	945.24	944.89	0.79	36	0.012	74.11	10.49	64.22	3.00	951.99	954.65
C.I. 1-6	M.H. 1-5	134.49	946.82	945.74	0.80	36	0.012	74.11	10.49	64.75	3.00	954.09	956.22
C.I. 1-7	C.I. 1-6	148.70	949.01	947.82	0.80	24	0.012	17.99	5.73	21.91	2.00	955.58	958.22
C.I. 1-8	C.I. 1-7	36.74	949.80	949.51	0.79	24	0.012	16.09	5.12	21.77	2.00	955.89	958.58
NULL ON LINE 1	C.I. 1-8	104.17	951.34	950.30	1.00	24	0.012	14.17	4.51	24.48	2.00	956.36	953.52
F.I. 2-1	C.I. 1-6	72.94	948.43	947.32	1.52	30	0.012	54.19	11.04	54.44	2.50	956.33	956.89
F.I. 2-2	F.I. 2-1	144.00	950.89	948.93	1.36	30	0.012	48.00	9.78	51.83	2.50	958.21	959.91
F.I. 2-3	F.I. 2-2	101.30	953.42	951.39	2.00	24	0.012	38.86	12.37	34.69	2.00	961.35	962.04
M.H. 2-4	F.I. 2-3	136.61	956.99	953.92	2.25	24	0.012	29.94	9.53	36.73	2.00	964.35	965.63
C.I. 2-5	M.H. 2-4	138.00	962.32	957.49	3.50	24	0.012	29.94	9.53	45.84	2.00	966.83	970.31
C.I. 2-6	C.I. 2-5	230.00	967.30	963.07	1.84	15	0.012	11.08	9.03	9.49	1.25	973.17	973.99
NULL ON LINE 2	C.I. 2-6	178.30	969.58	967.80	1.00	15	0.012	3.95	3.22	6.99	1.25	974.24	970.95
C.I. 3-1	C.I. 1-4	53.27	947.21	946.14	2.01	15	0.012	1.89	1.54	9.91	1.25	951.57	955.25
C.I. 4-1	F.I. 2-2	138.00	953.24	952.14	0.80	15	0.012	4.60	3.75	6.25	1.25	959.40	959.27
C.I. 4-2	C.I. 4-1	39.15	954.05	953.74	0.79	15	0.012	2.03	1.65	6.22	1.25	959.50	958.93
C.I. 5-1	F.I. 2-3	138.00	955.30	953.92	1.00	18	0.012	4.58	2.59	11.38	1.50	962.53	961.95
C.I. 5-2	C.I. 5-1	34.34	956.14	955.80	0.99	15	0.012	2.44	1.99	6.96	1.25	962.60	962.04
C.I. 6-1	C.I. 2-5	44.69	963.21	962.82	0.87	24	0.012	17.78	5.66	22.89	2.00	967.63	970.78
F.I. 6-2	C.I. 6-1	150.50	964.91	963.71	0.80	18	0.012	13.29	7.52	10.16	1.50	971.03	970.06
F.I. 6-3	F.I. 6-2	225.00	970.47	965.41	2.25	15	0.012	7.30	5.95	10.49	1.25	972.39	975.91
C.I. 7-1	C.I. 2-6	41.62	968.22	967.80	1.01	15	0.012	5.55	4.52	7.63	1.25	973.94	974.37
C.I. 8-2	E.S. 8-1	38.74	939.82	939.57	0.65	18	0.012	17.40	9.91	9.14	1.44	941.90	946.73
C.I. 8-3	C.I. 8-2	235.47	942.67	940.32	1.00	15	0.012	9.27	7.55	6.99	1.25	946.64	950.92
C.I. 8-4	C.I. 8-3	103.13	944.46	943.17	1.25	15	0.012	5.63	4.59	7.82	1.25	947.57	952.80
C.I. 8-5	C.I. 8-4	34.61	945.39	944.96	1.24	15	0.012	3.80	3.10	7.80	1.25	947.77	952.88
C.I. 9-2	E.S. 9-1	162.45	947.12	945.82	0.80	15	0.012	11.20	9.13	6.26	1.25	952.40	955.66
C.I. 9-3	C.I. 9-2	64.21	948.90	947.62	1.99	15	0.012	9.58	7.81	9.88	1.25	954.12	956.35
F.I. 9-4	C.I. 9-3	138.00	951.13	949.40	1.25	15	0.012	6.45	5.26	7.83	1.25	956.73	957.72
C.I. 10-2	E.S. 10-1	165.47	953.14	951.81	0.80	24	0.012	21.85	7.88	21.93	1.63	954.81	959.29
C.I. 10-3	C.I. 10-2	69.88	954.20	953.64	0.79	24	0.012	21.29	7.83	22.01	1.58	955.85	960.55
F.I. 10-4	C.I. 10-3	137.50	956.05	954.95	0.80	15	0.012	4.61	4.90	6.25	0.92	956.92	961.70
C.I. 11-1	C.I. 10-3	150.00	955.90	954.70	0.80	18	0.012	13.21	7.48	10.18	1.50	958.22	962.77
C.I. 11-2	C.I. 11-1	106.77	958.00	956.40	1.50	15	0.012	6.57	5.35	8.56	1.25	959.51	964.79
C.I. 11-3	C.I. 11-2	34.00	958.84	958.50	1.00	15	0.012	5.08	4.80	7.00	1.15	959.75	964.79
C.I. 12-1	C.I. 11-1	36.23	956.76	956.40	0.99	15	0.012	1.55	1.26	6.97	1.25	958.59	962.95

NOT AS-BUILT

Accepted
Record Drawings

These plans have been reviewed for accuracy and are accepted for basic conformance to the approved construction drawings.

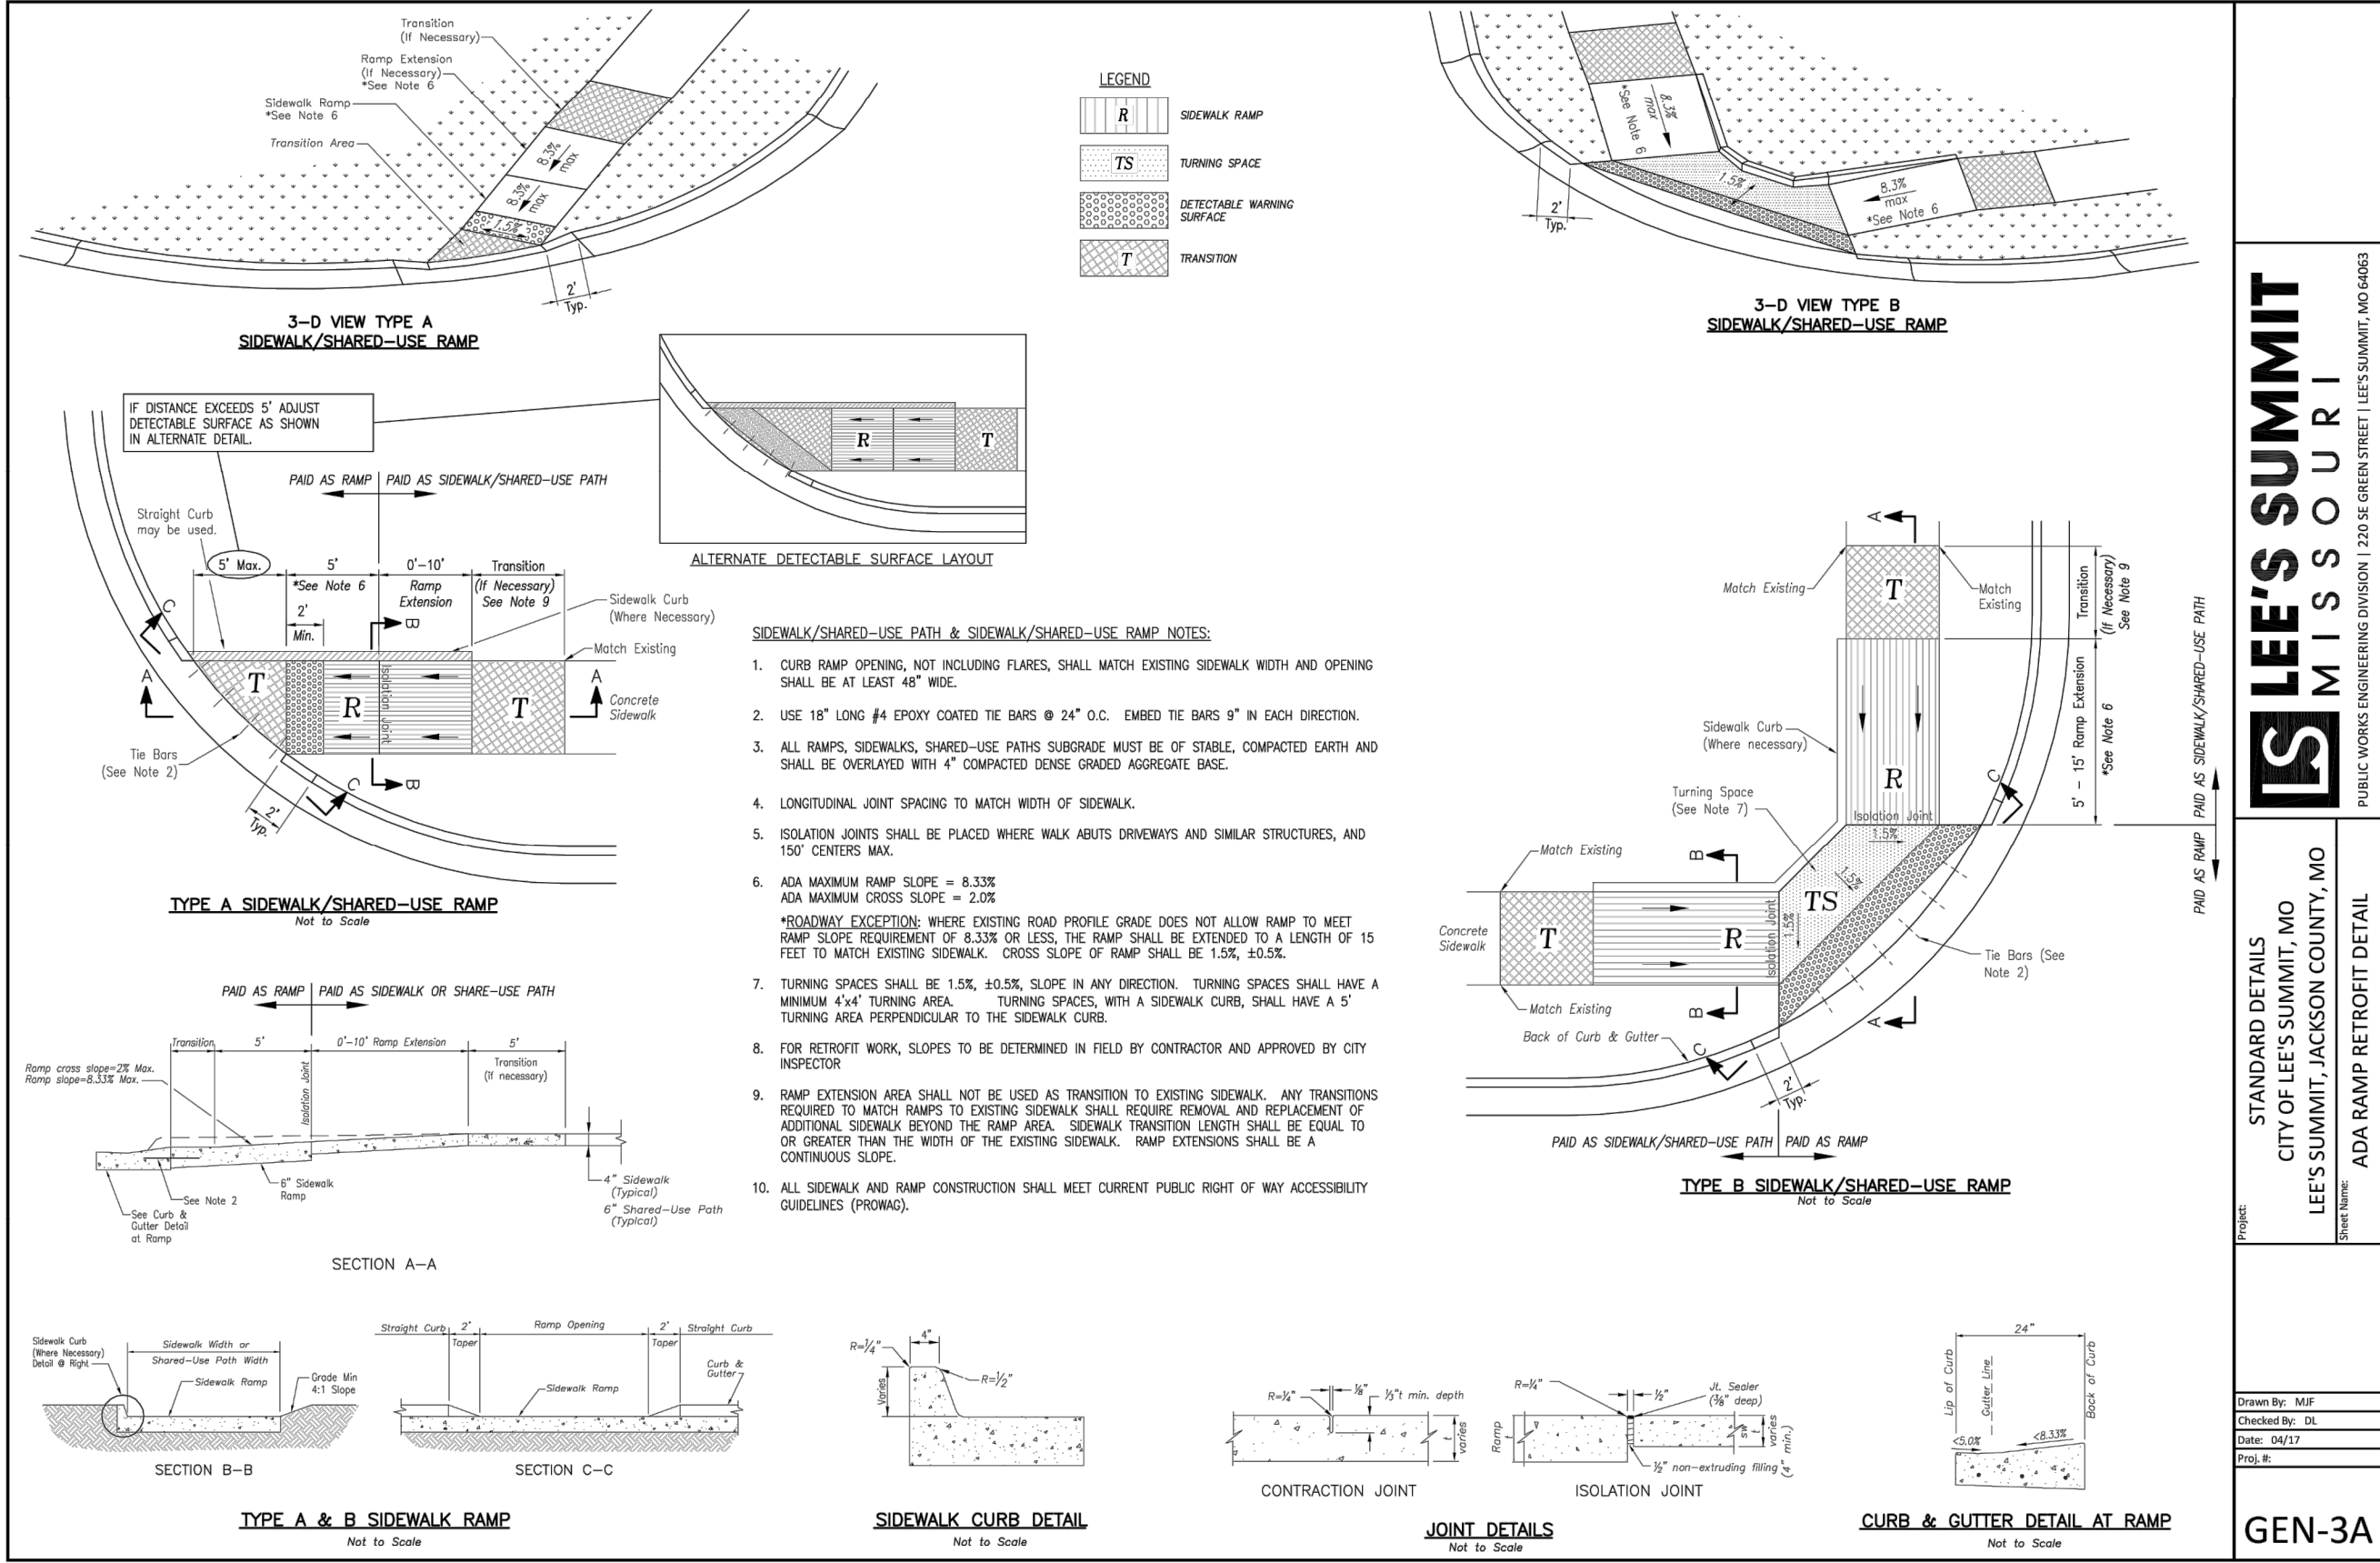


LEE'S SUMMIT
MISSOURI


STANDARD DETAILS
CITY OF LEE'S SUMMIT, MO
LEE'S SUMMIT, JACKSON COUNTY, MO

Sheet No. 001
Checked By: SS
Date: 06/17
Proj. 6

GEN-3A

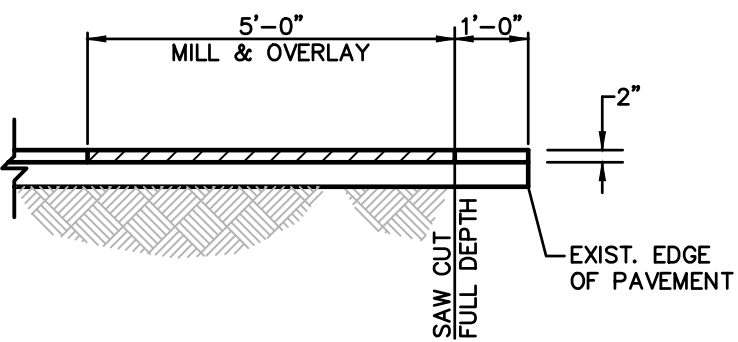


MILL & OVERLAY DETAIL
N.T.S.

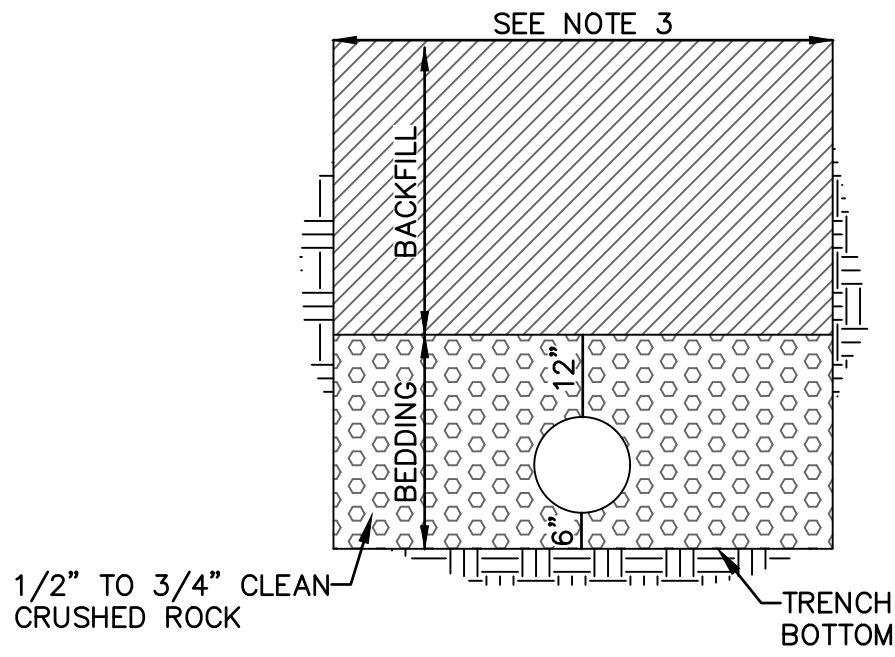

TYPICAL SECTION FOR PLASTIC PIPE
(IN ROCK OR SOIL)

UNDERGROUND PIPE INSTALLATION FOR STORM SEWER LINES
N.T.S.

- BACKFILL SHALL BE JOB EXECAVATED MATERIAL FREE FROM DEBRIS AND STONES COMPACTED TO 90% OF MAXIMUM DENSITY AT OPTIMUM MOISTURE CONTENT AS DETERMINED BY ASTM D698. BACKFILL UNDER PAVEMENT (EXISTING OR PROPOSED), SHALL BE FLOWABLE FILL.
- TRENCH BANKS MAY BE CUT BACK ON SLOPES IN ACCORDANCE WITH CURRENT OSHA REGULATIONS, BUT ONLY IN AREAS WHERE THE INCREASED TRENCH WIDTH WILL NOT INTERFERE WITH SURFACE FEATURES. SLOPES MUST NOT EXTEND BELOW TOP OF BEDDING.
- MINIMUM AND MAXIMUM WIDTHS SHALL BE IN ACCORDANCE WITH PIPE MANUFACTURER'S RECOMMENDATION AS APPROVED ON ENGINEERING PLANS.

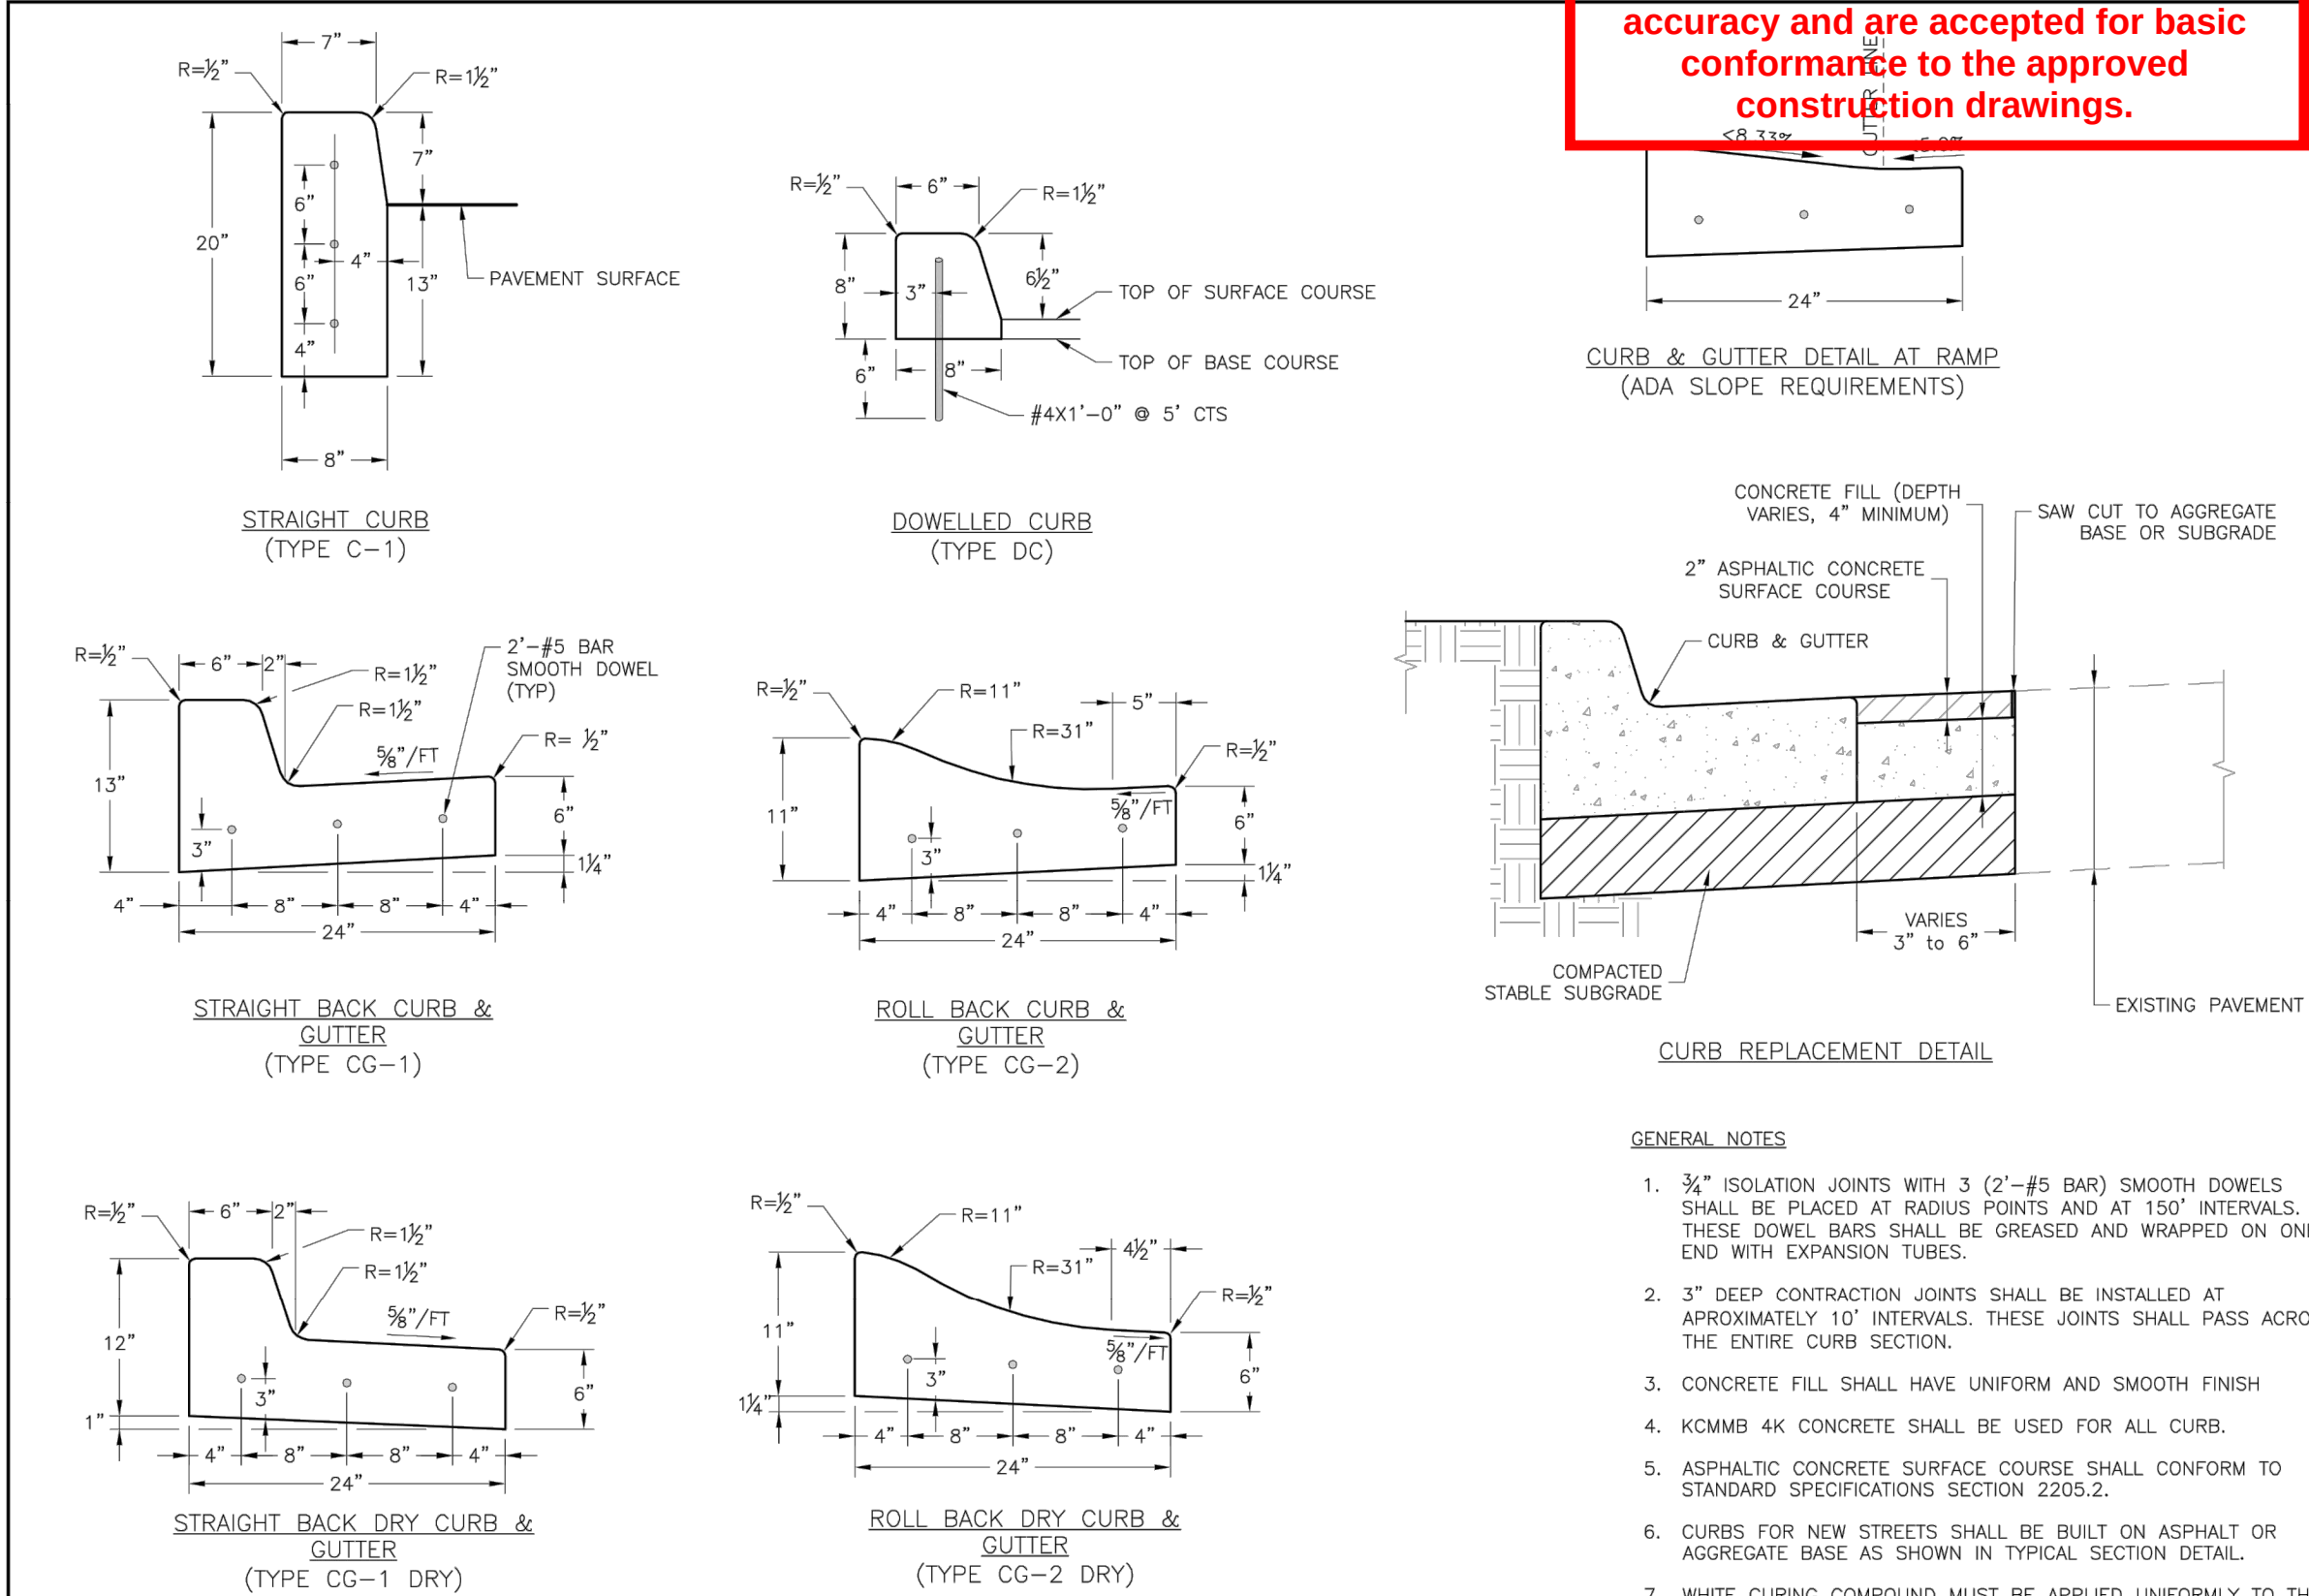

Accepted
Record Drawings

These plans have been reviewed for
accuracy and are accepted for basic
conformance to the approved
construction drawings.

LEE'S SUMMIT
MISSOURI

STANDARD DETAILS
CITY OF LEE'S SUMMIT, MO
LEE'S SUMMIT, JACKSON COUNTY, MO

Sheet No. 001
Checked By: SS
Date: 06/17
Proj. 6

GEN-4



REV. NO.	DATE	REVISIONS DESCRIPTION	BY
1	03-23-2021	REVISED PER CITY COMMENTS	
2	04-16-2021	REVISED PER CITY COMMENTS	
3	09-30-2021	CHANGES TO APPROVED PLANS	

DETAIL SHEET
STREET & STORM SEWER PLANS

HOOK FARMS
SECOND PLAT

LEE'S SUMMIT, MO



2021

drawn by: B.M.W./A.A.
checked by: B.M.W.
designed by: B.M.W./A.A.
QA/QC by: J.E.S.
project no.: B19-4061
date: 01-08-2021




SHEET
C148

olsson

Olsson - Civil Engineering
Missouri Certificate of Authority #001592
1301 Burlington Street
North Kansas City, MO 64116
TEL 816.361.1177
FAX 816.361.1888
www.olson.com

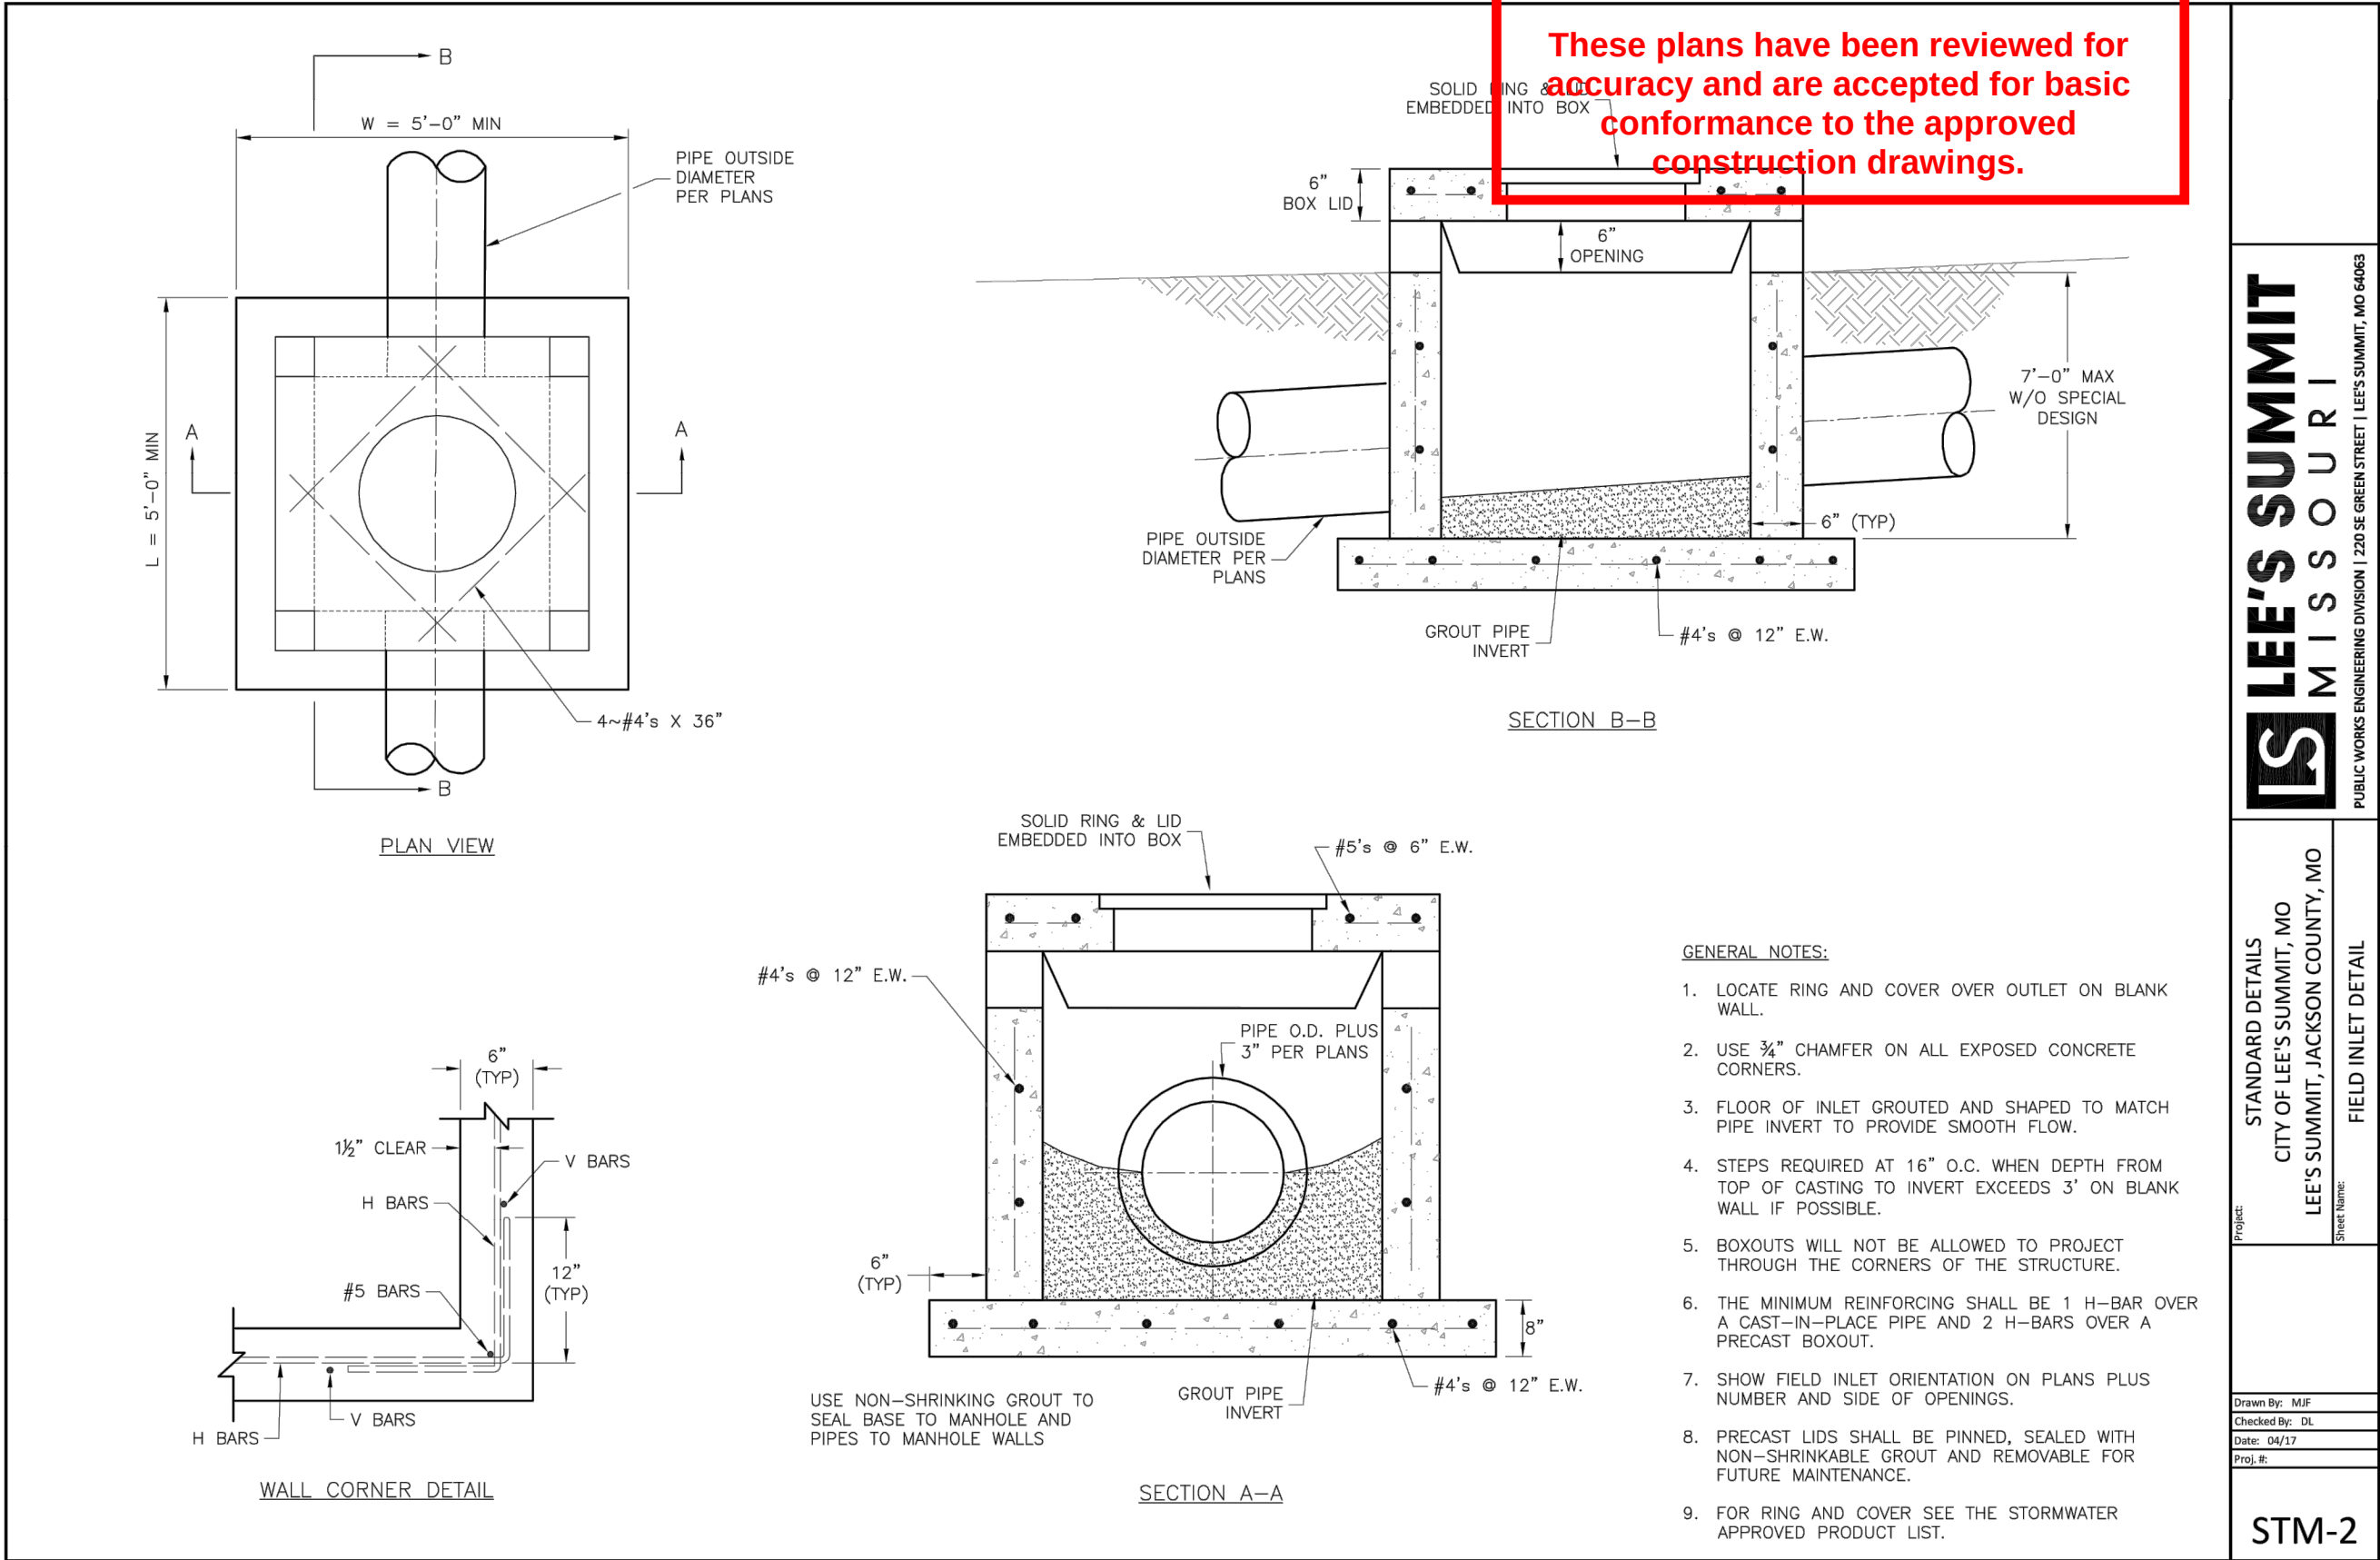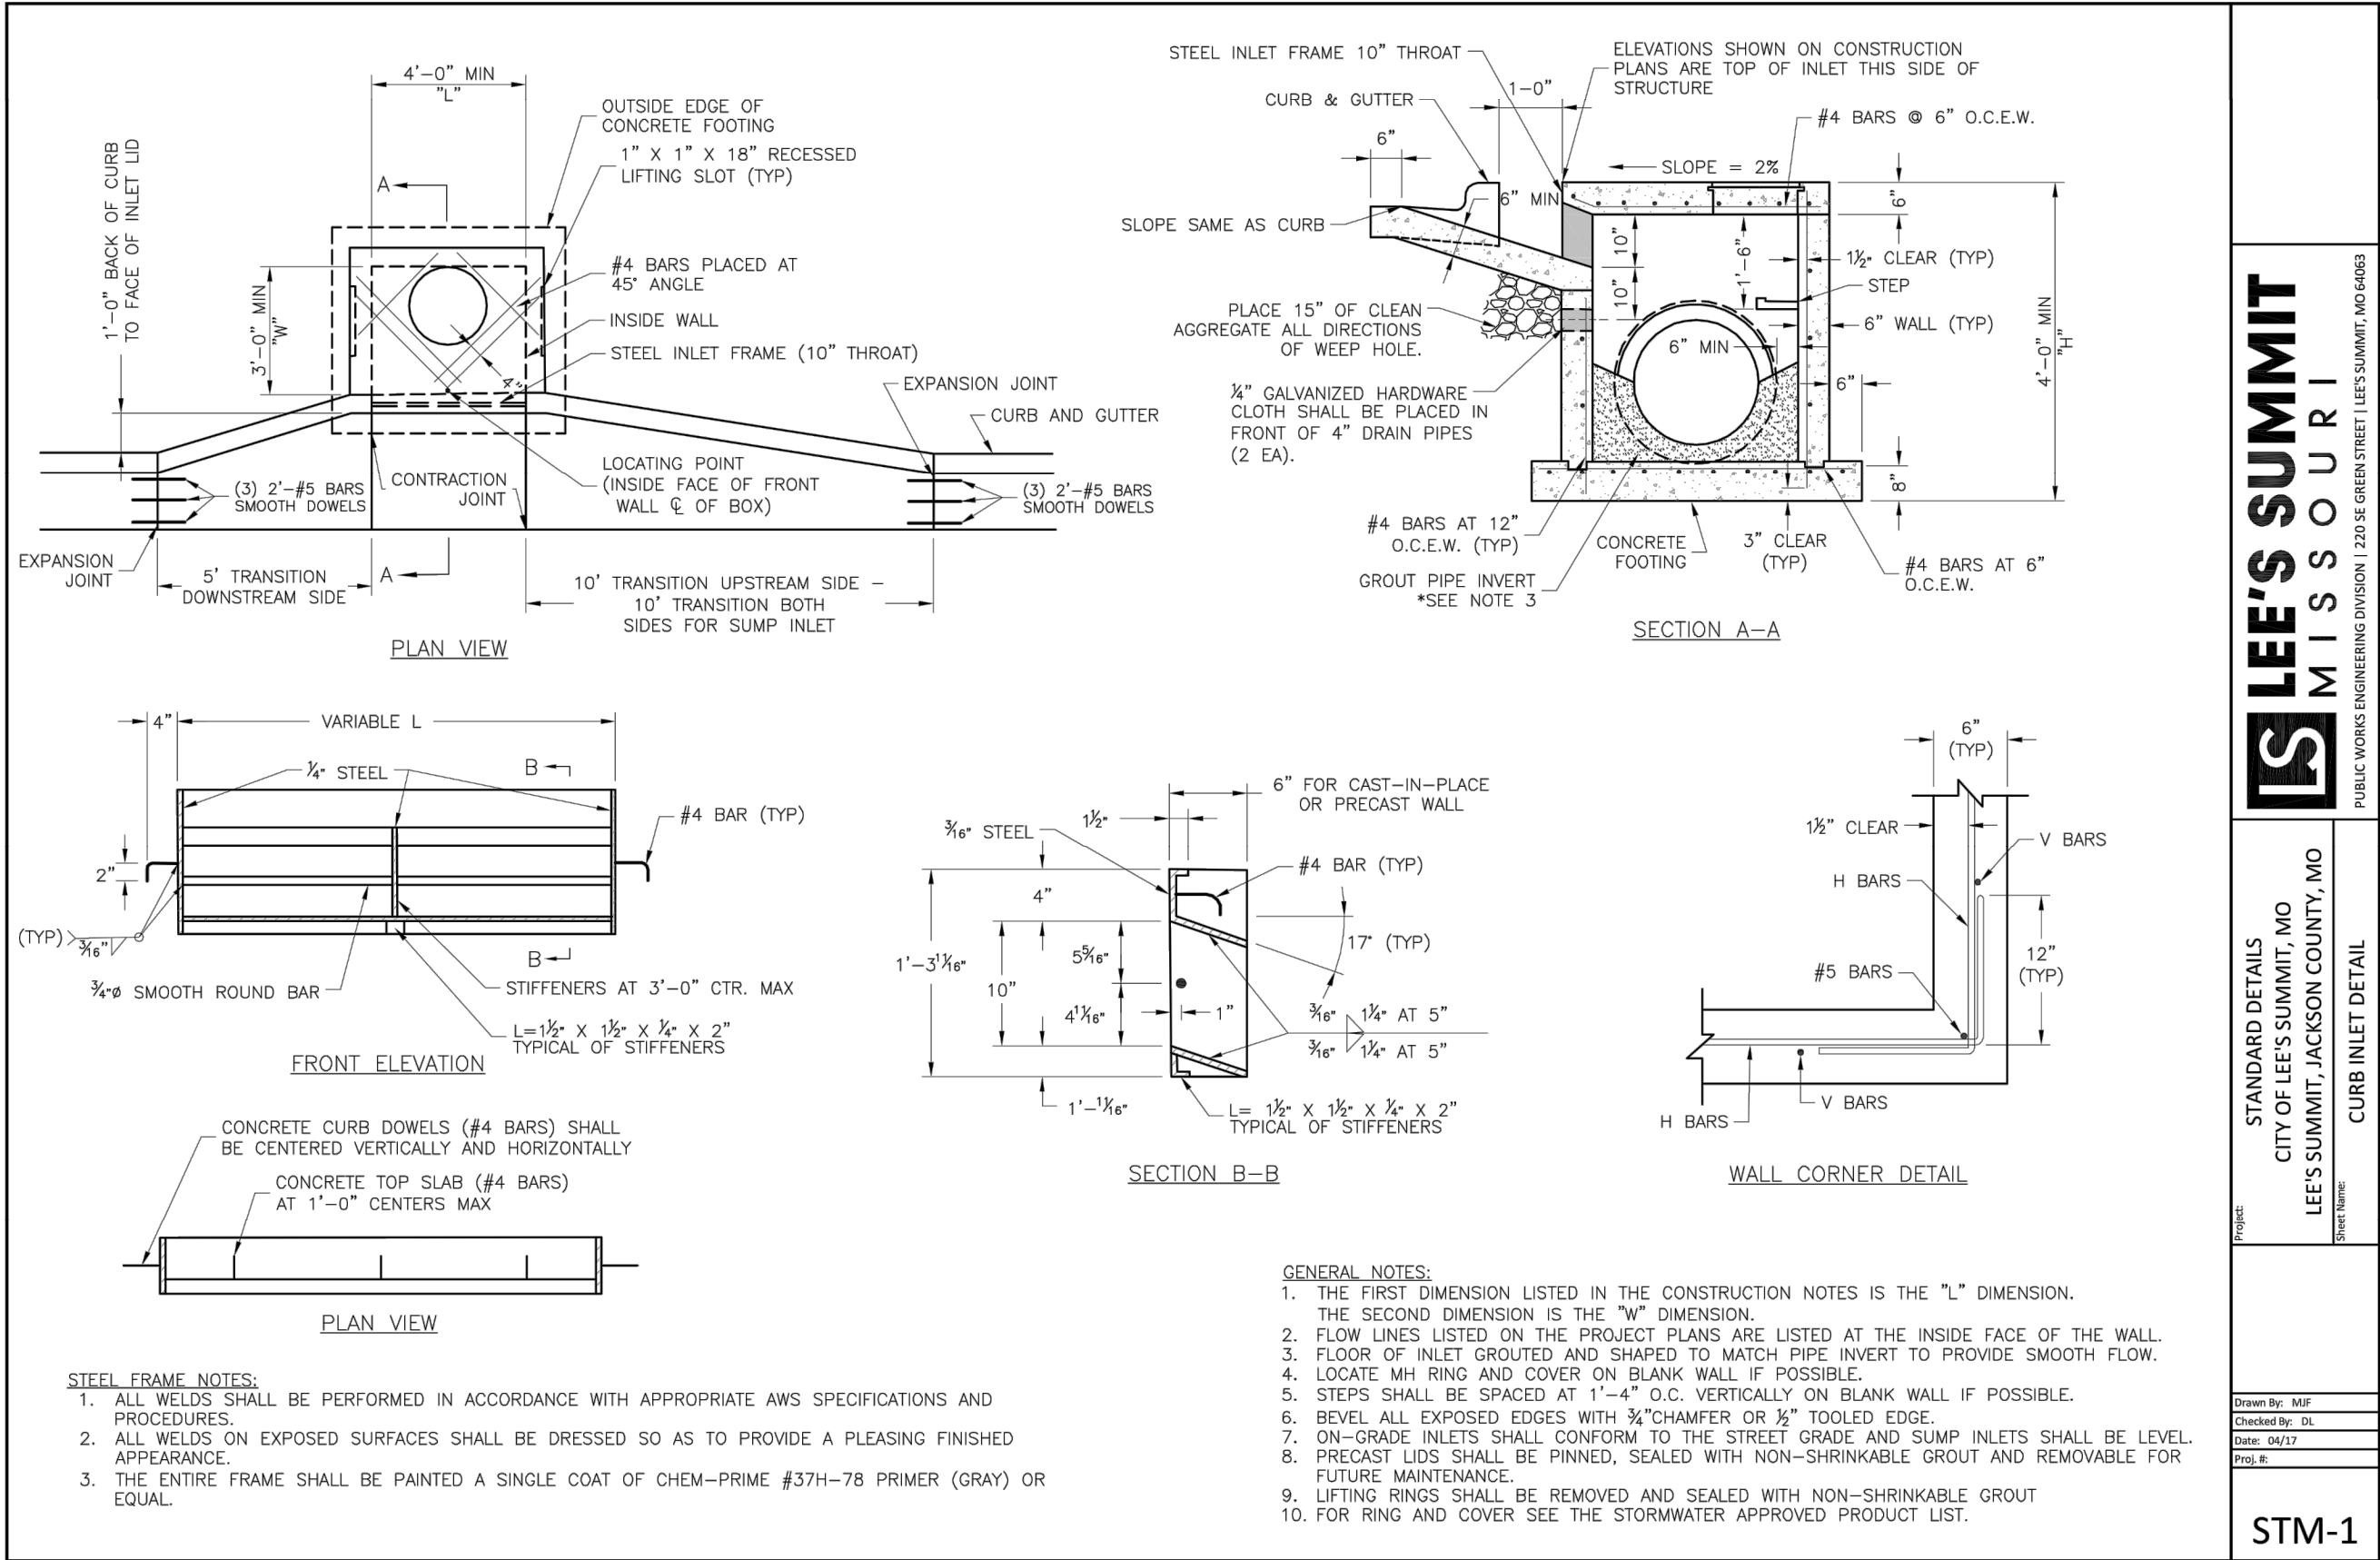

NOT AS-BUILT

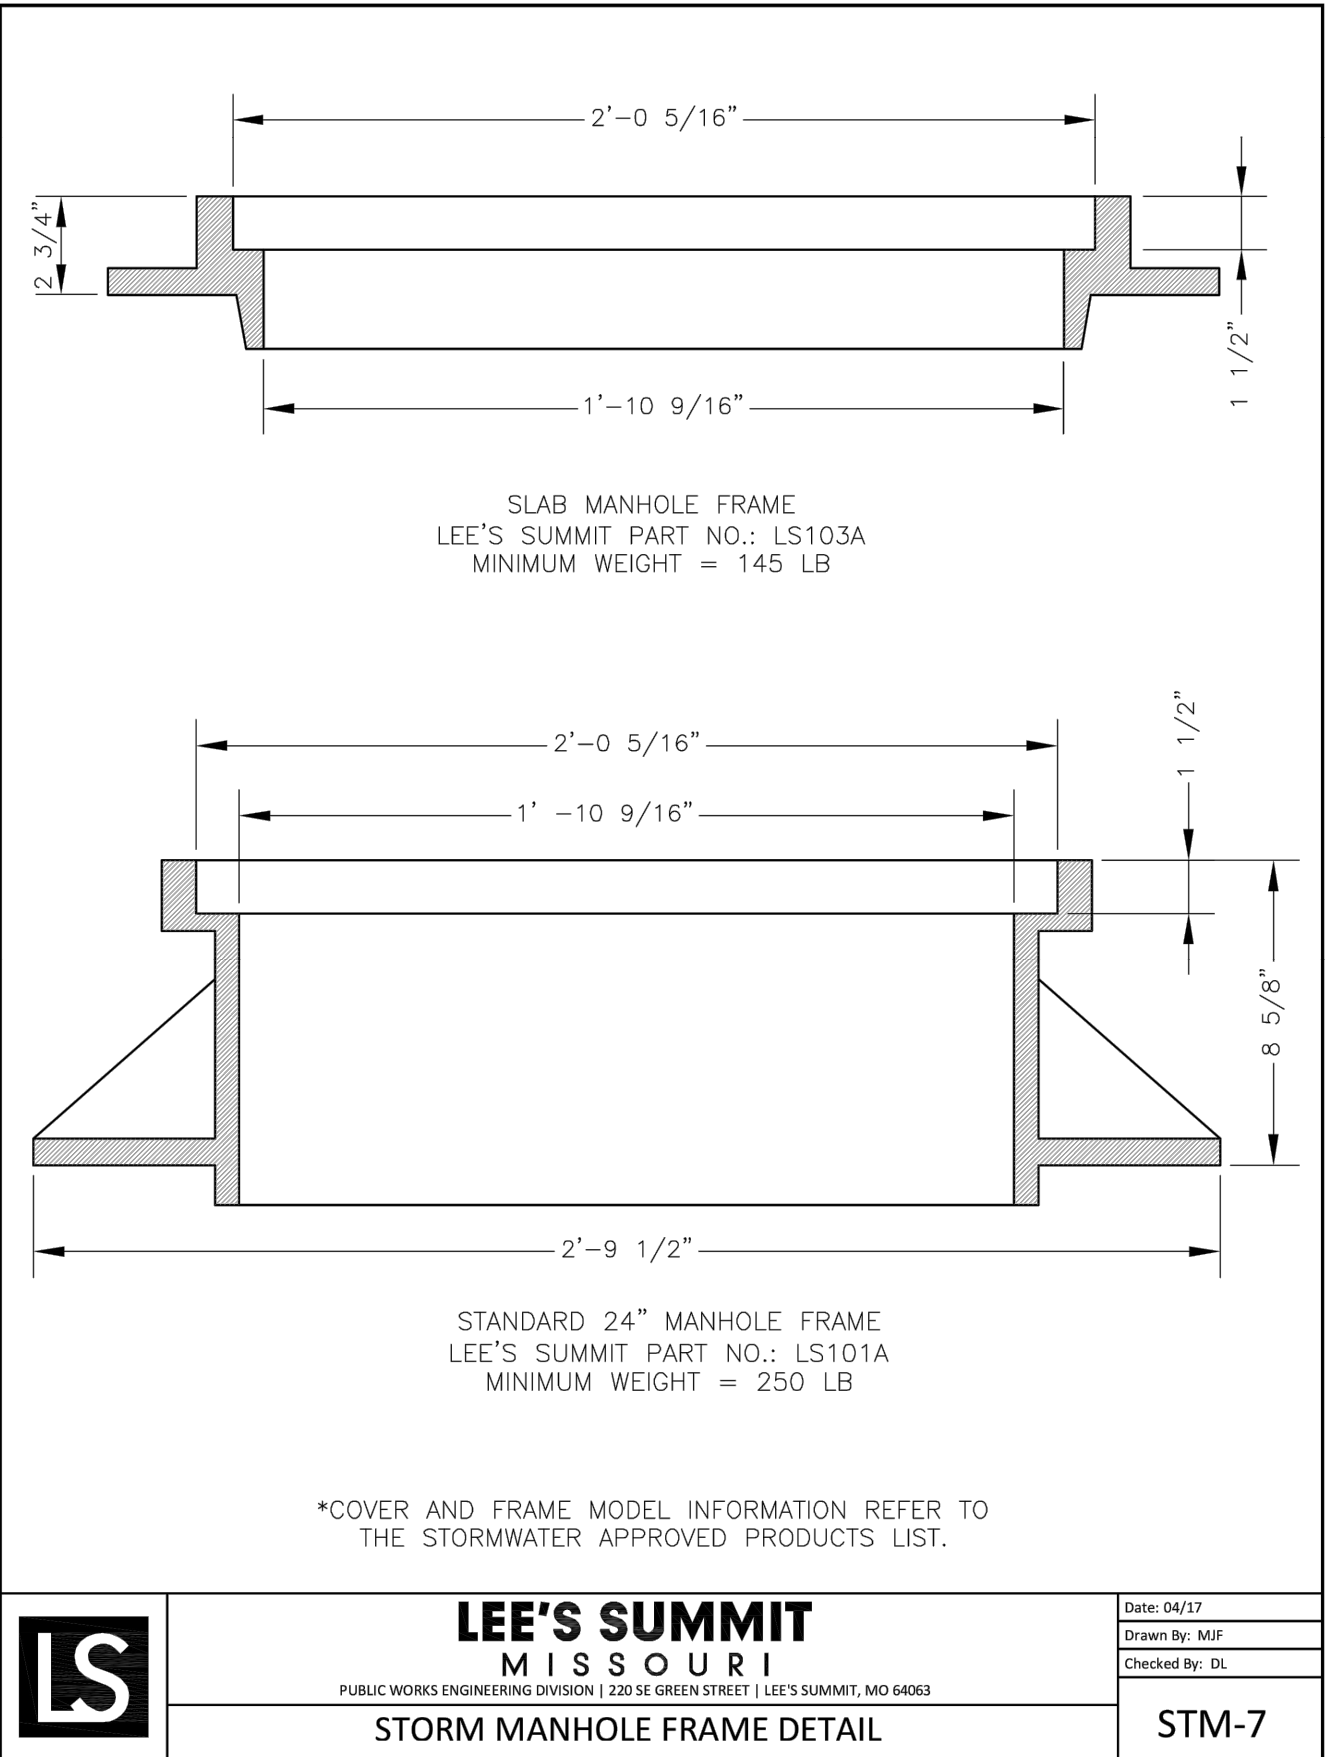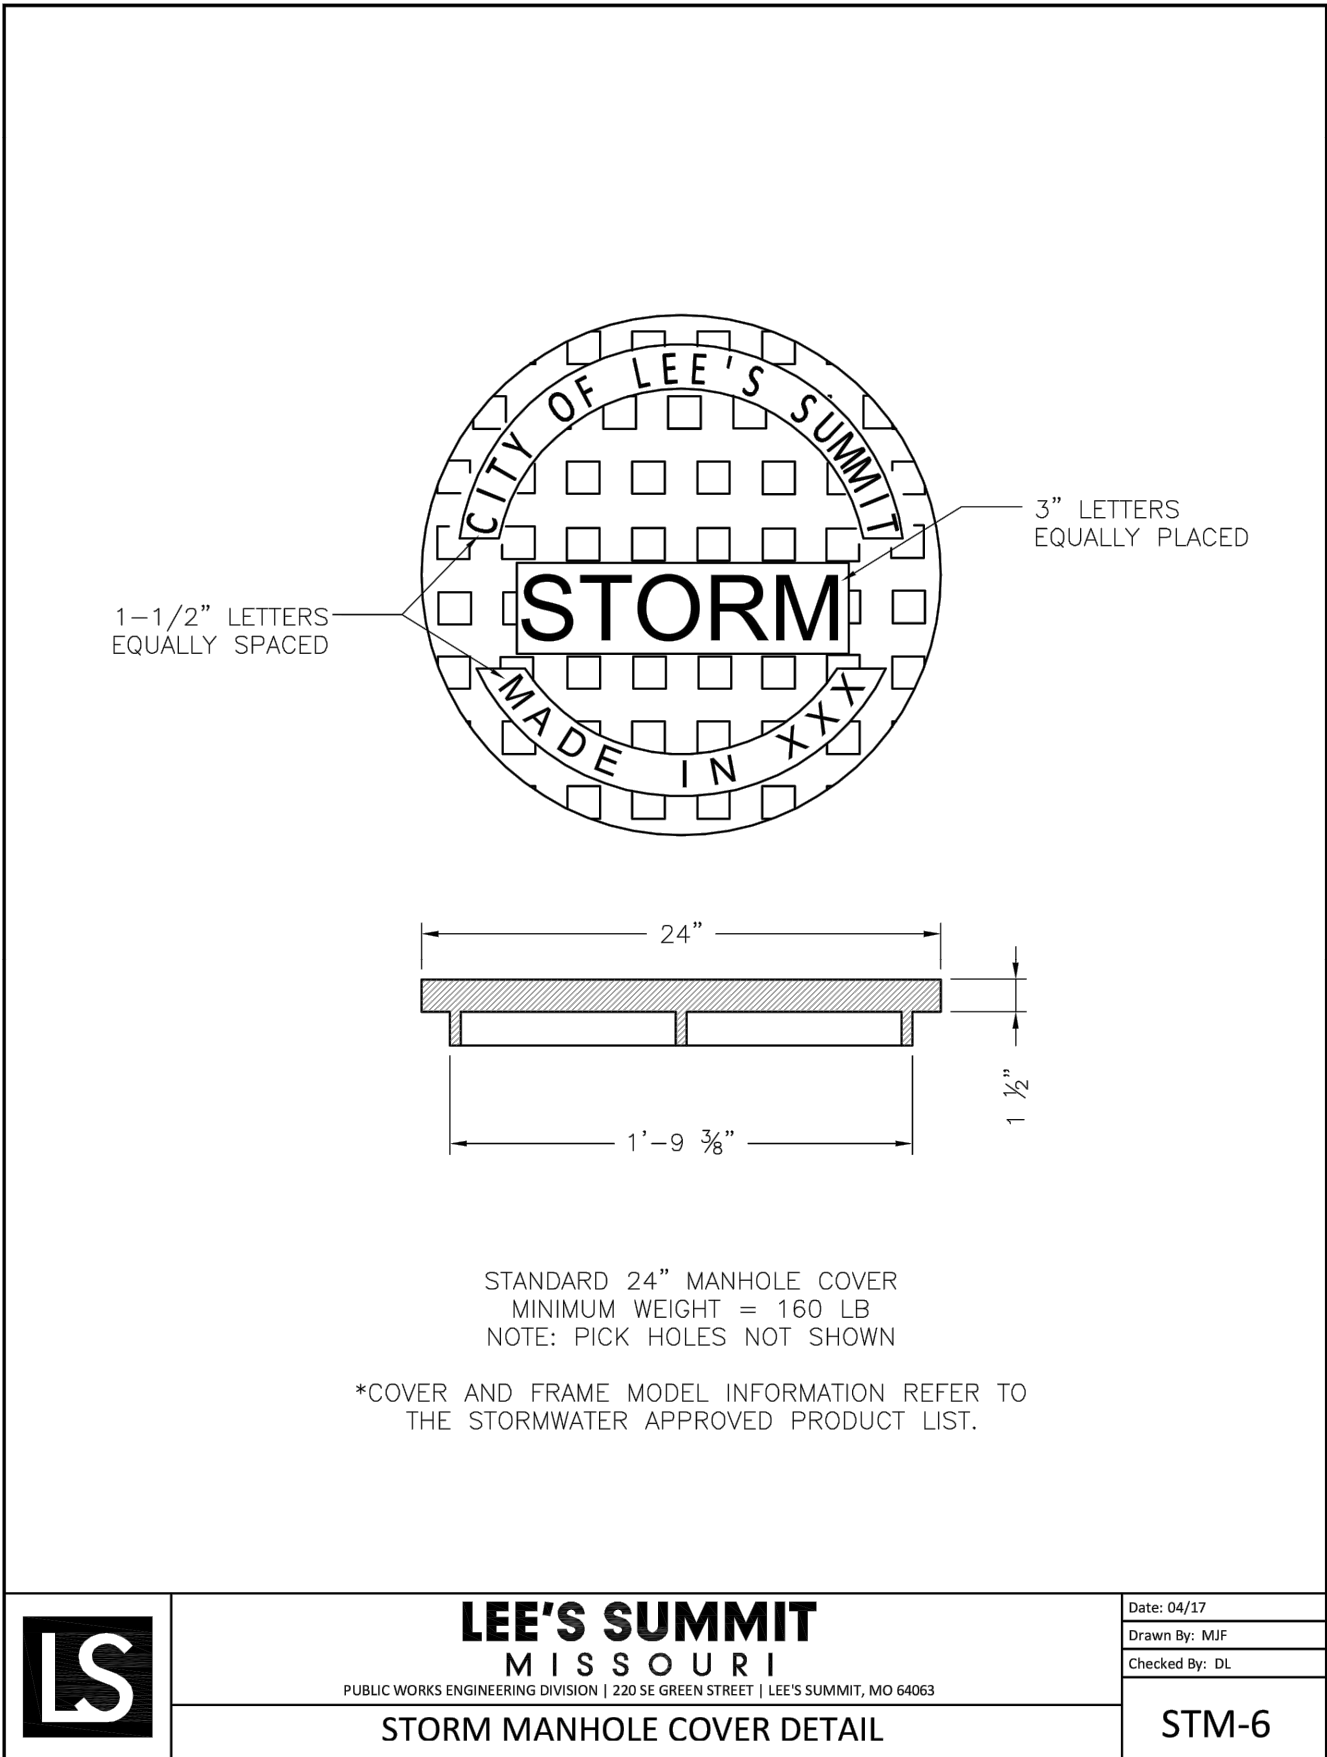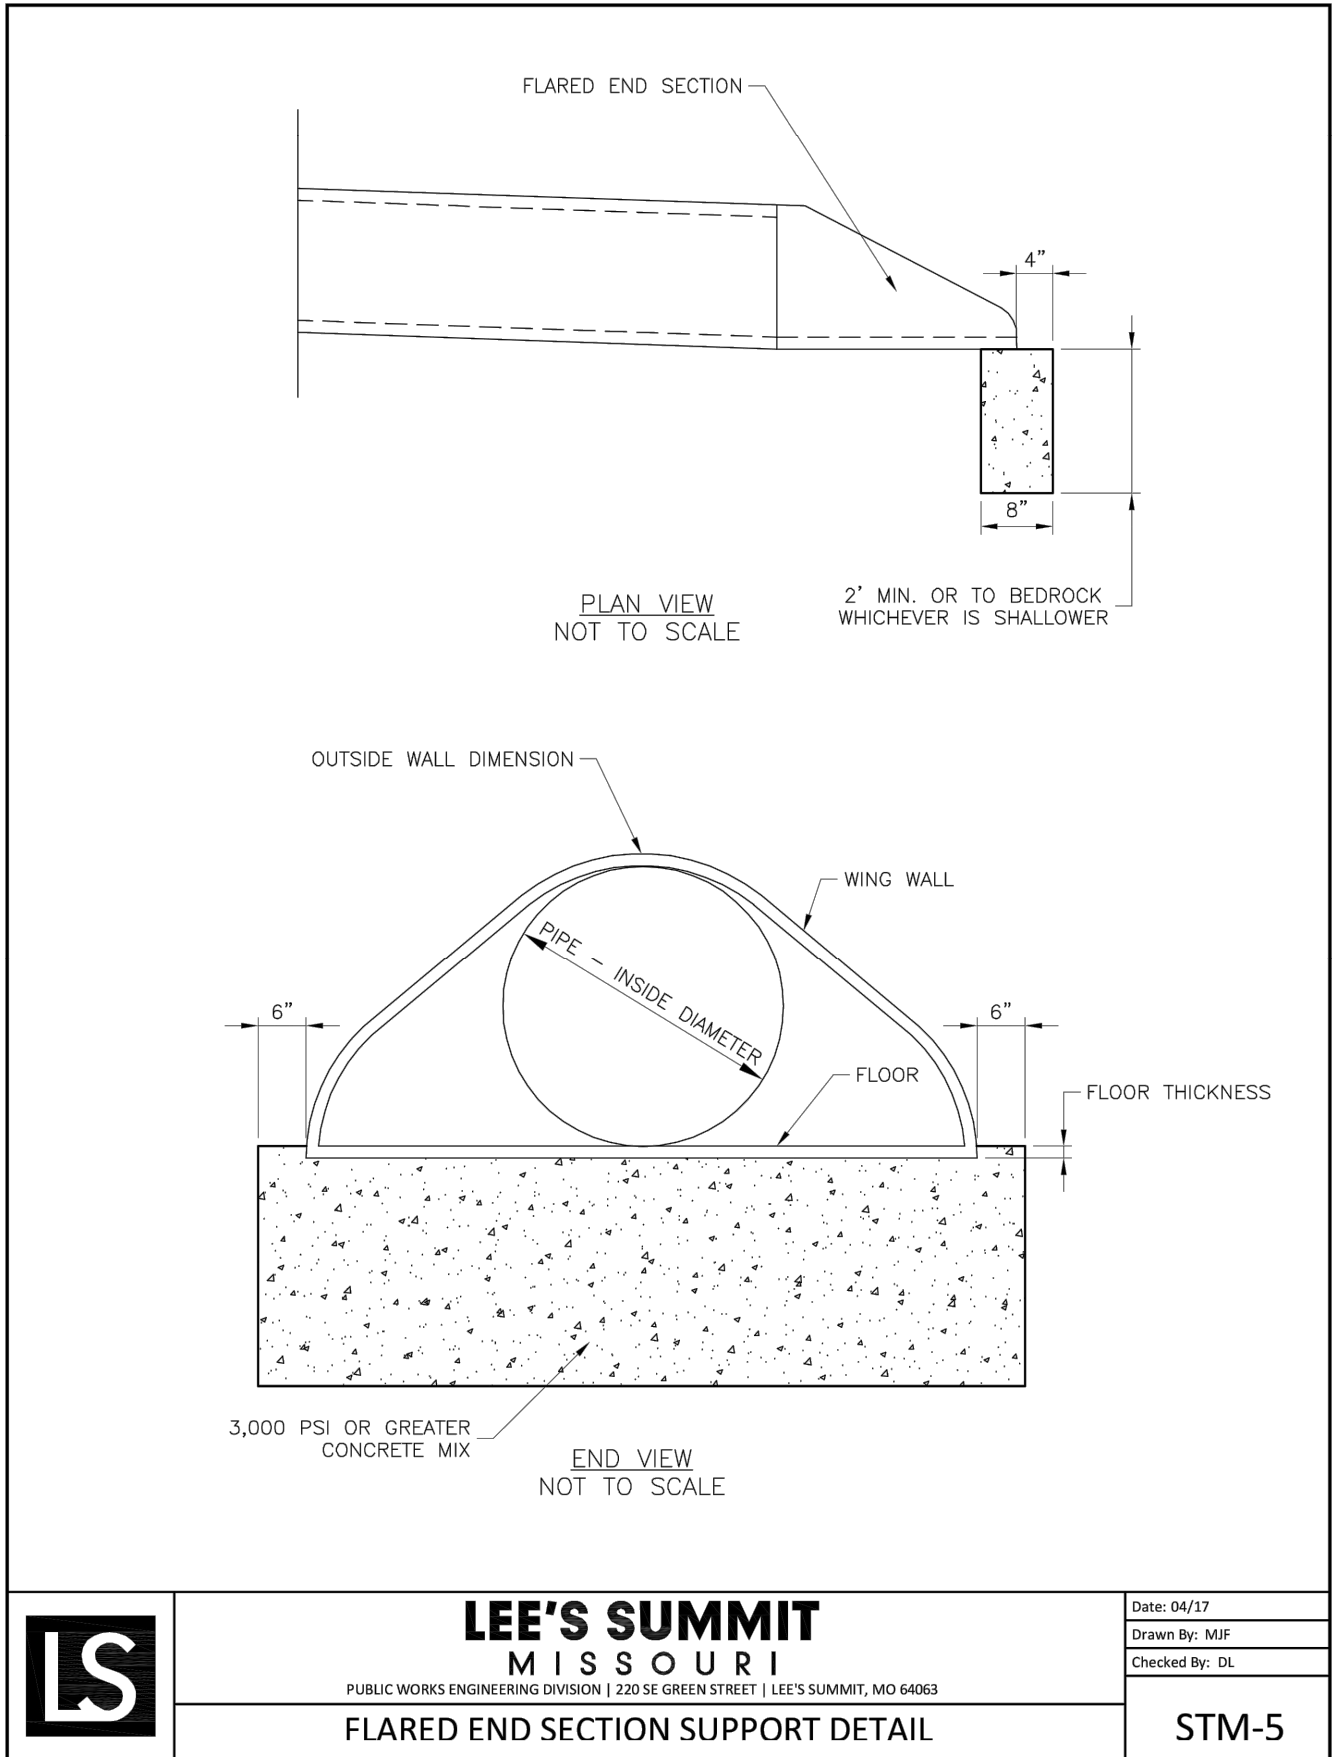

Accepted
Record Drawings

These plans have been reviewed for
accuracy and are accepted for basic
conformance to the approved
construction drawings.

LEE'S SUMMIT MISSOURI

STANDARD DETAILS
CITY OF LEE'S SUMMIT, MO
LEE'S SUMMIT, JACKSON COUNTY, MO

FIELD INLET DETAIL

Drawn By: MJF
Checked By: DL
Date: 04/17
Title: B

STM-2

BY

REVISIONS DESCRIPTION

DATE

REV. NO.

1

2

3

03-23-2021

04-16-2021

09-30-2021

REVISED PER CITY COMMENTS

REVISED PER CITY COMMENTS

CHANGES TO APPROVED PLANS

2021

DETAIL SHEET

STREET & STORM SEWER PLANS

HOOK FARMS
SECOND PLAT

LEE'S SUMMIT, MO

drawn by:

checked by:

designed by:

QA/QC by:

project no.:

date:

B.M.W./A.A.

B.M.W.

B.M.W./A.A.

J.E.S.

B19-4061

01-08-2021

SHEET

C149

olsson

Olsson - Civil Engineering
Missouri Certificate of Authority #001592
1301 Burlington Street
North Kansas City, MO 64116
TEL 816.361.1177
FAX 816.361.1888
www.olsson.com





STATE OF MISSOURI

JULIE ELAINE SELLERS

NUMBER
PE-2017000367
12/17/22

PROFESSIONAL ENGINEER

REVISIONS

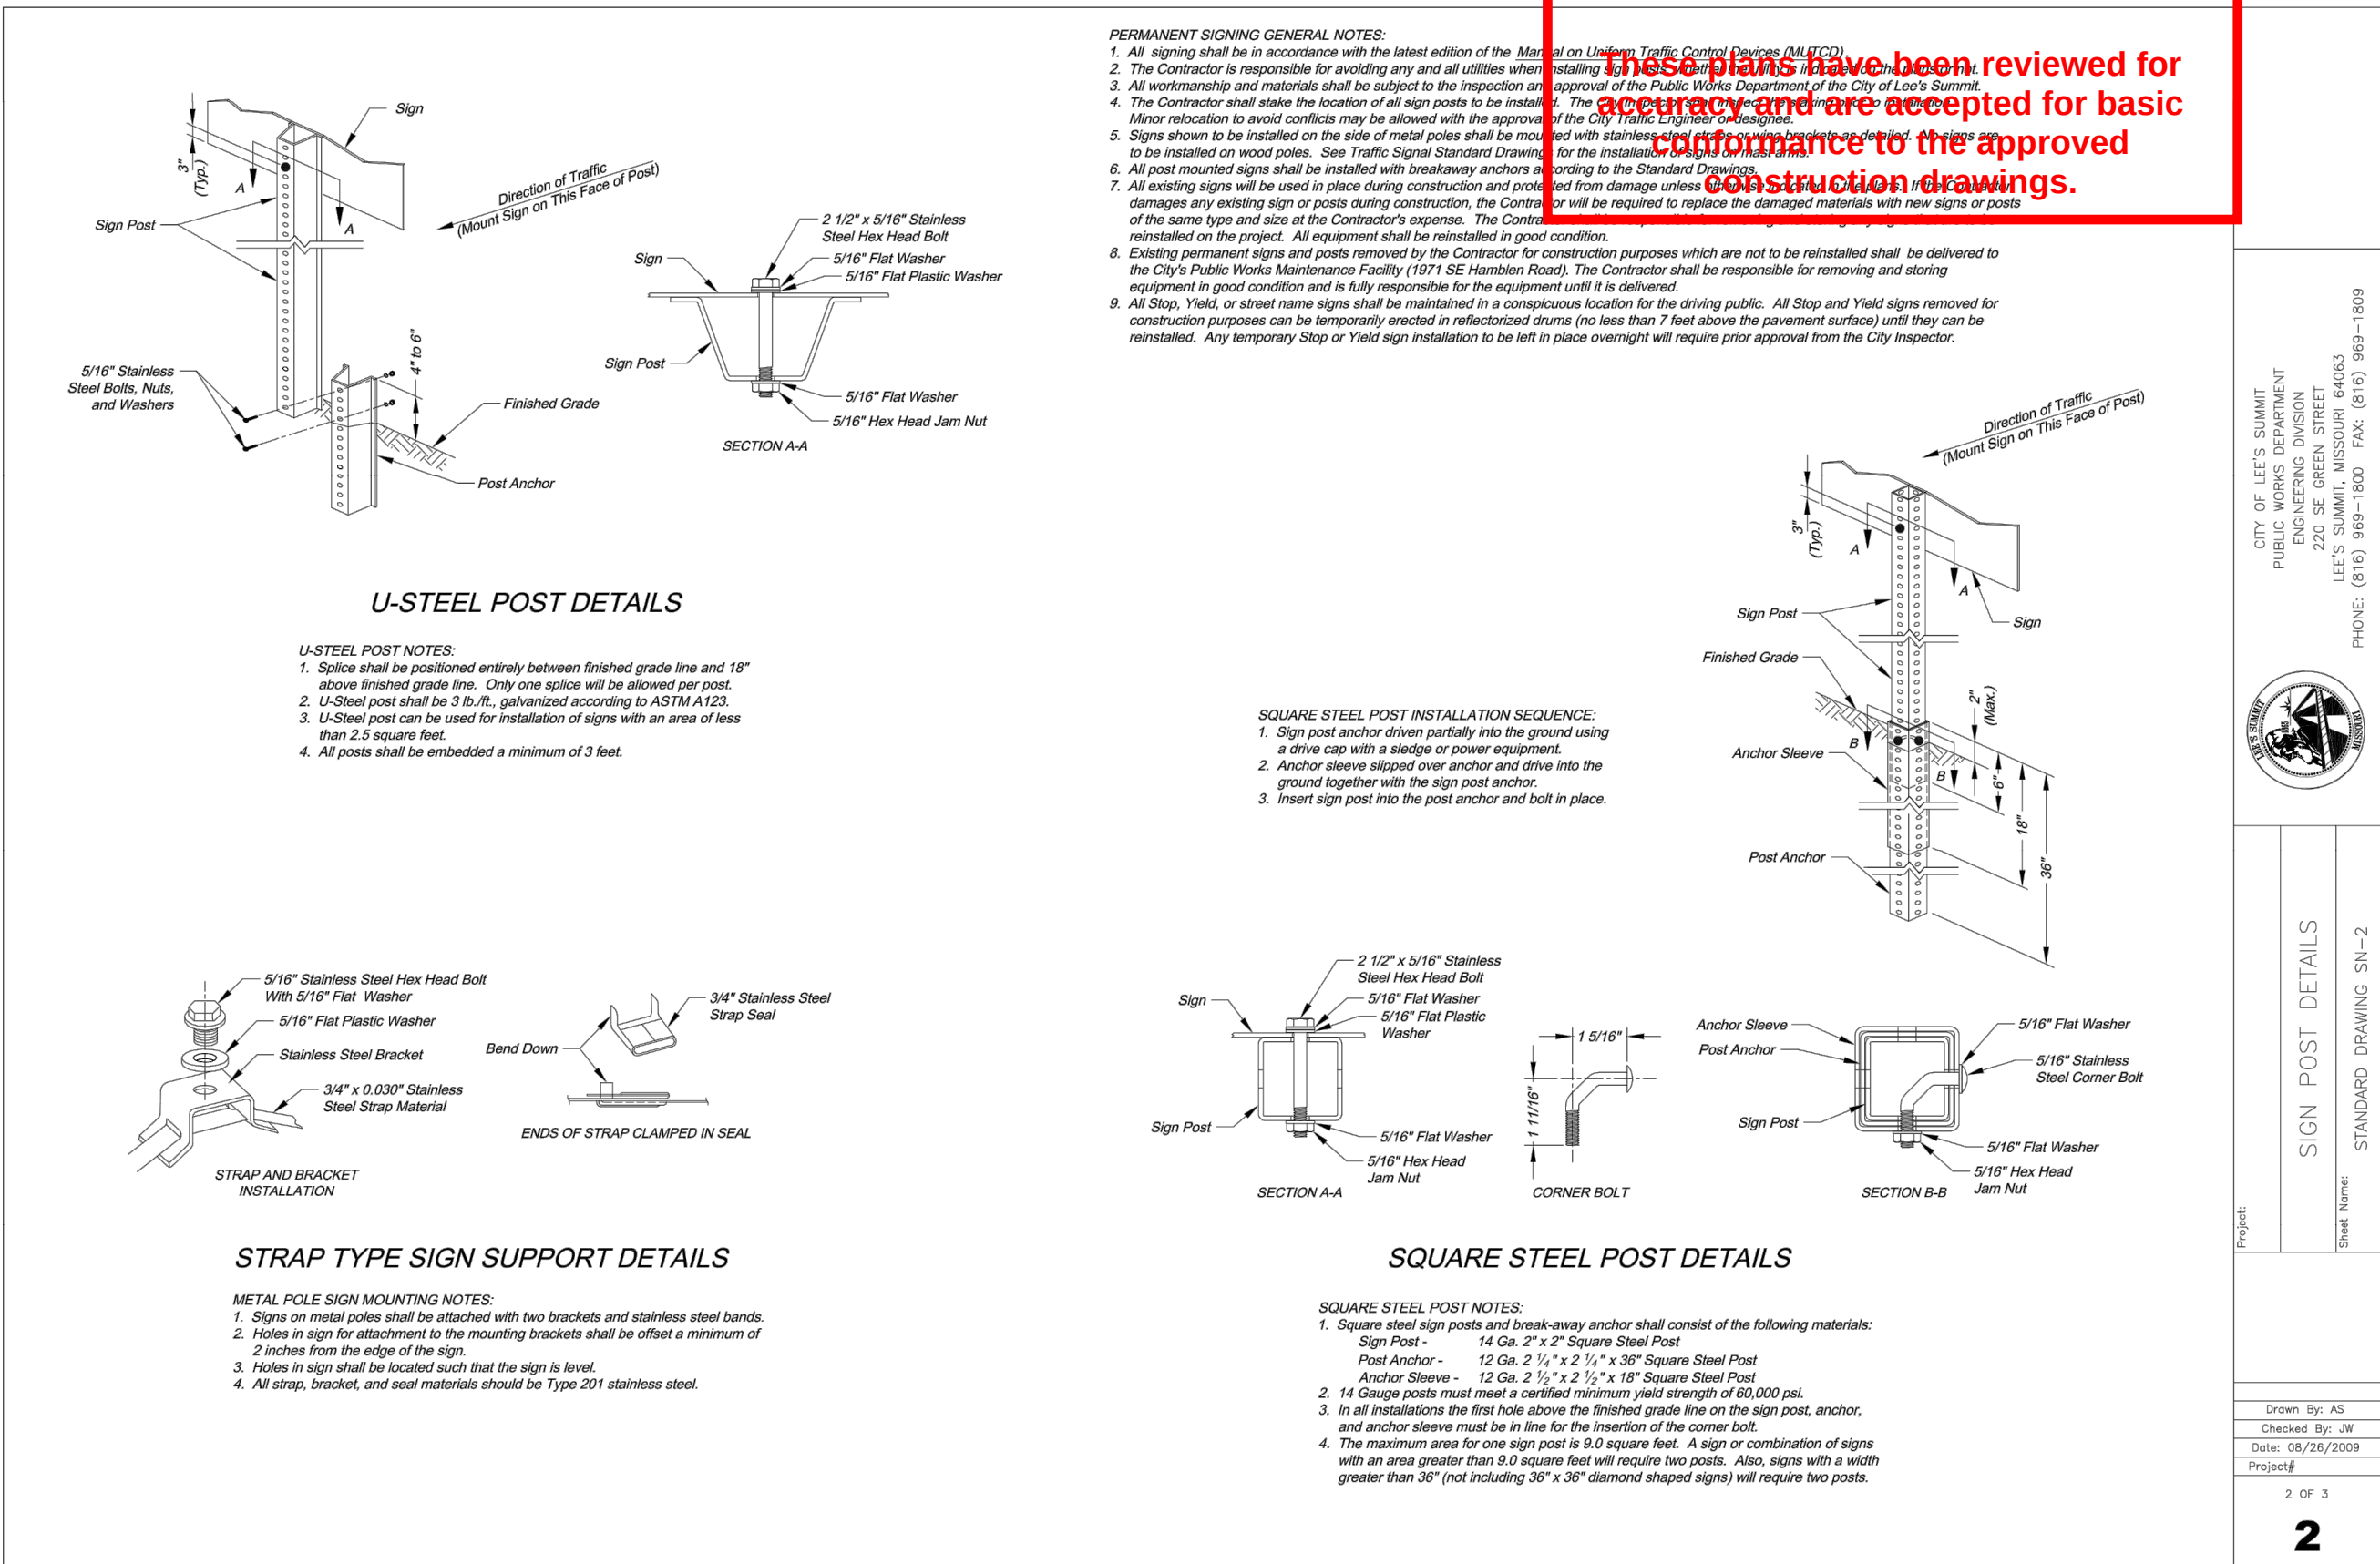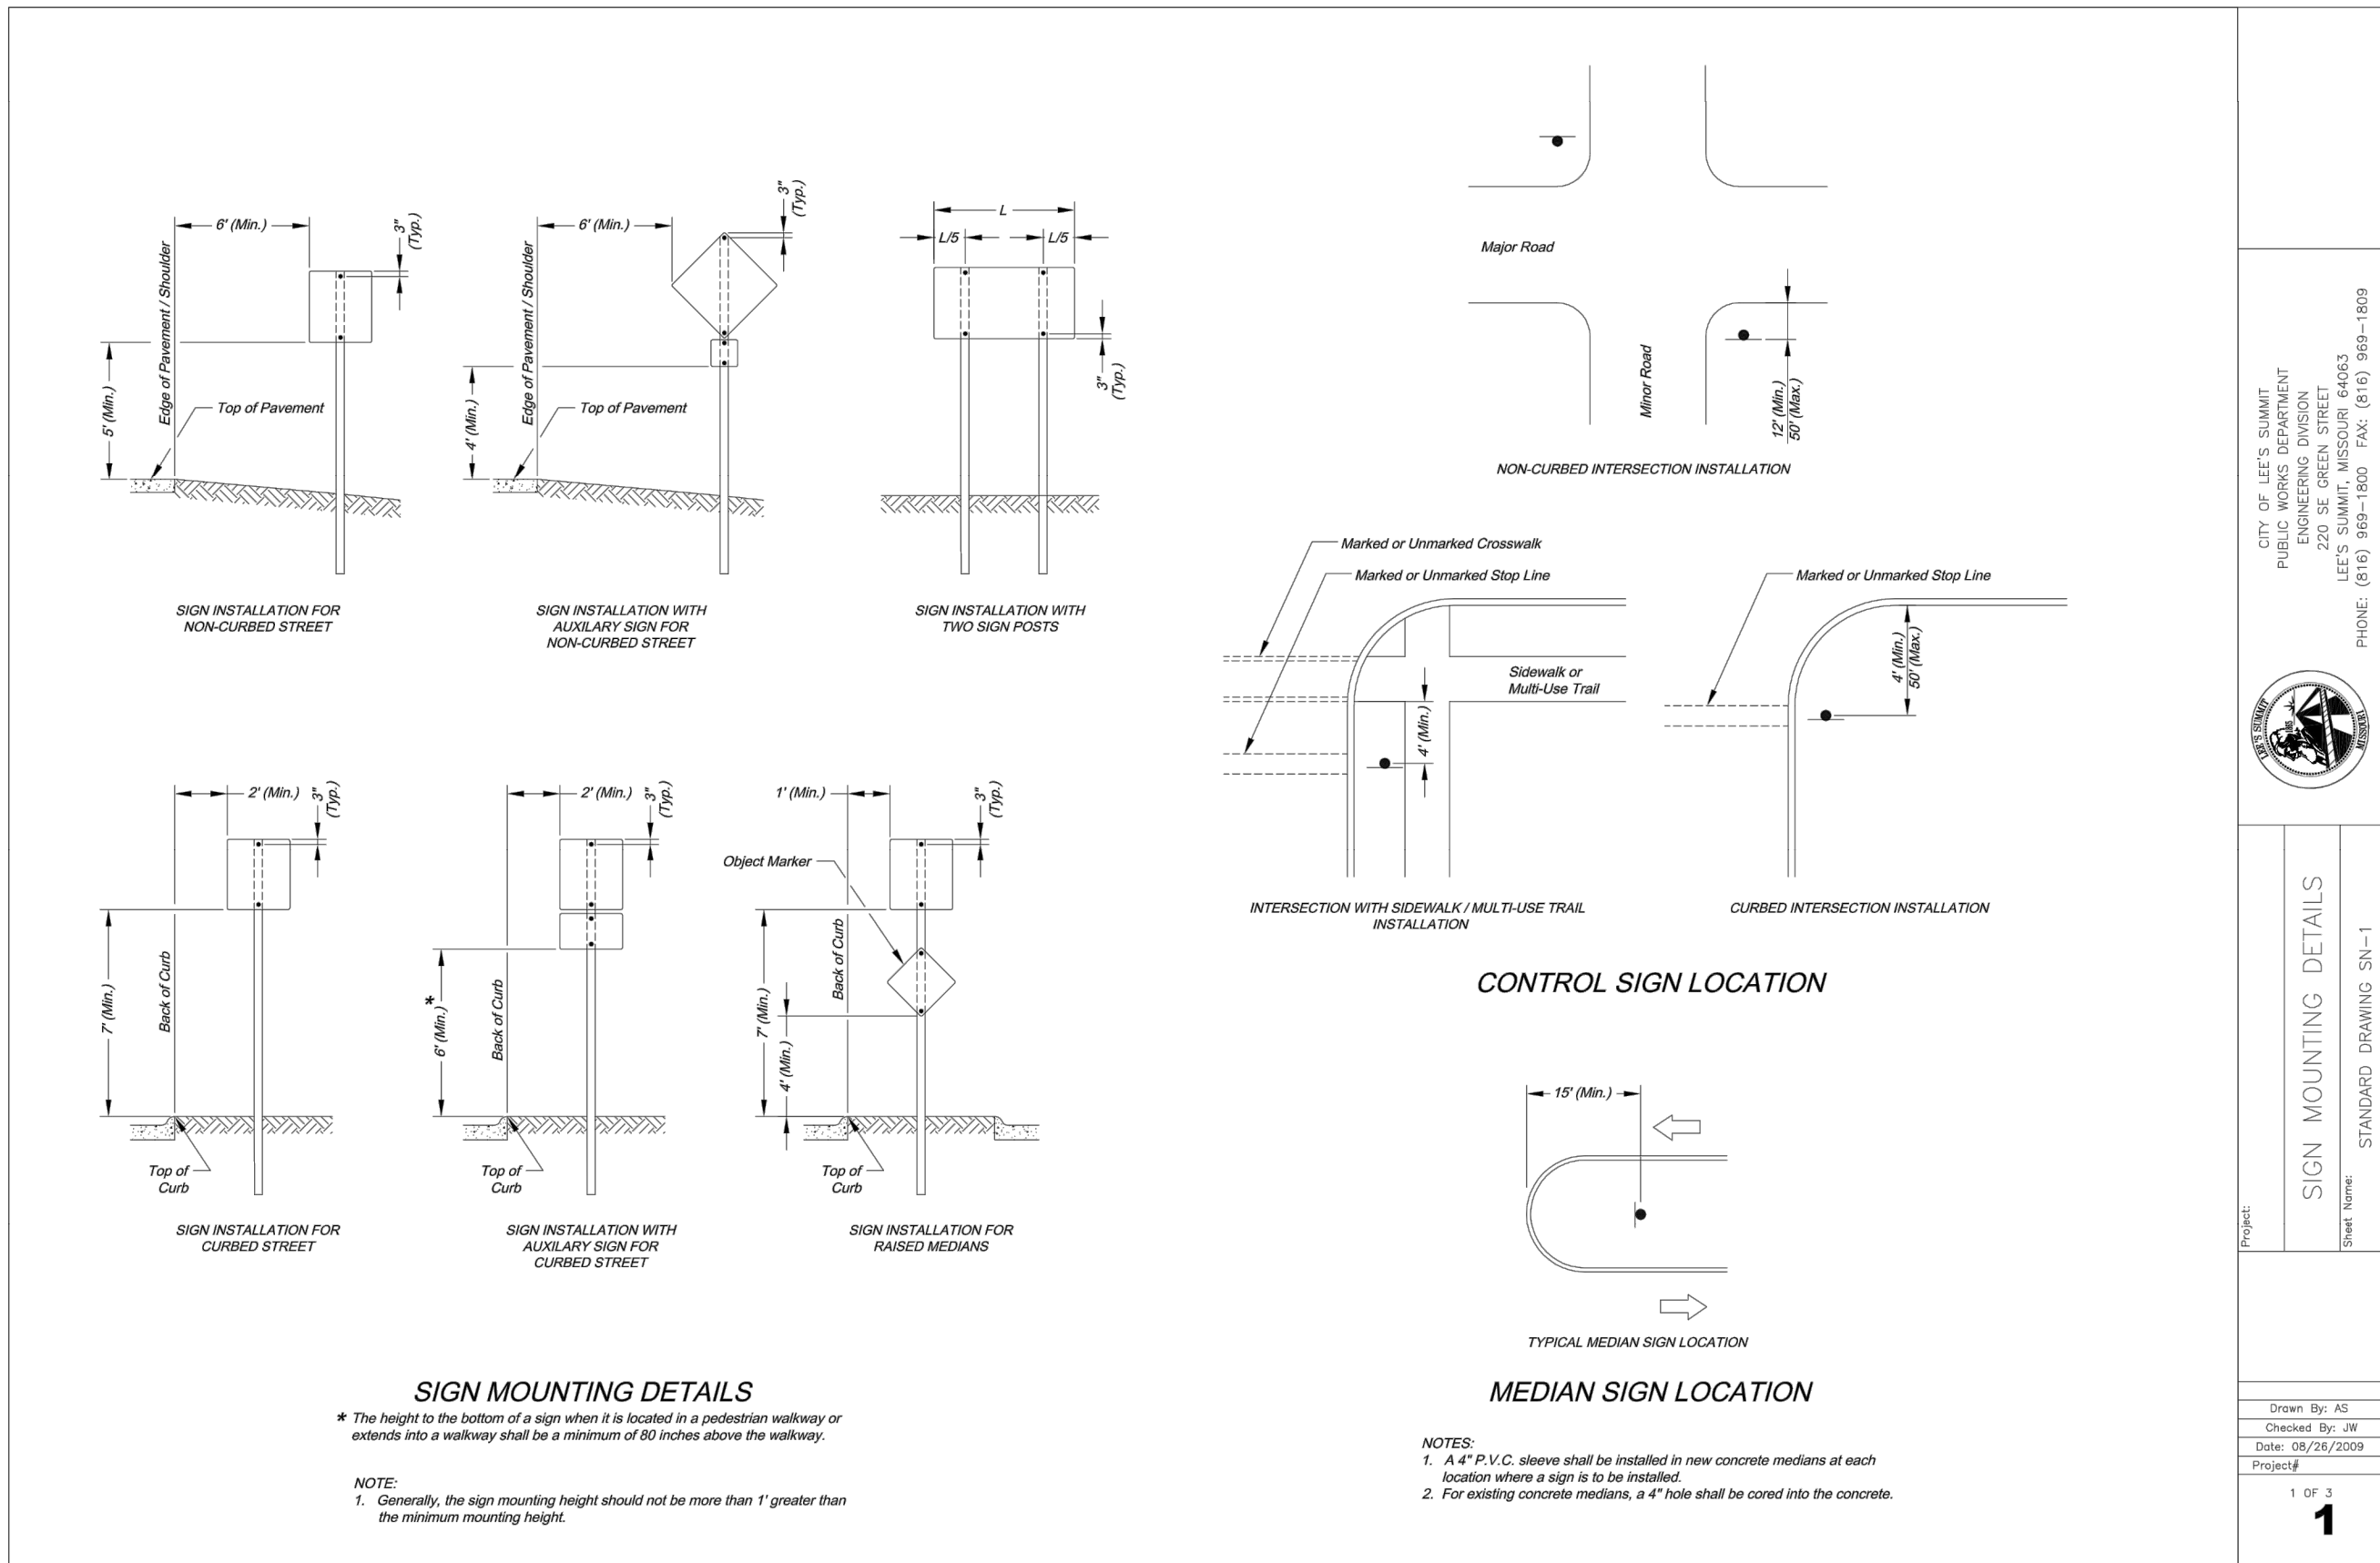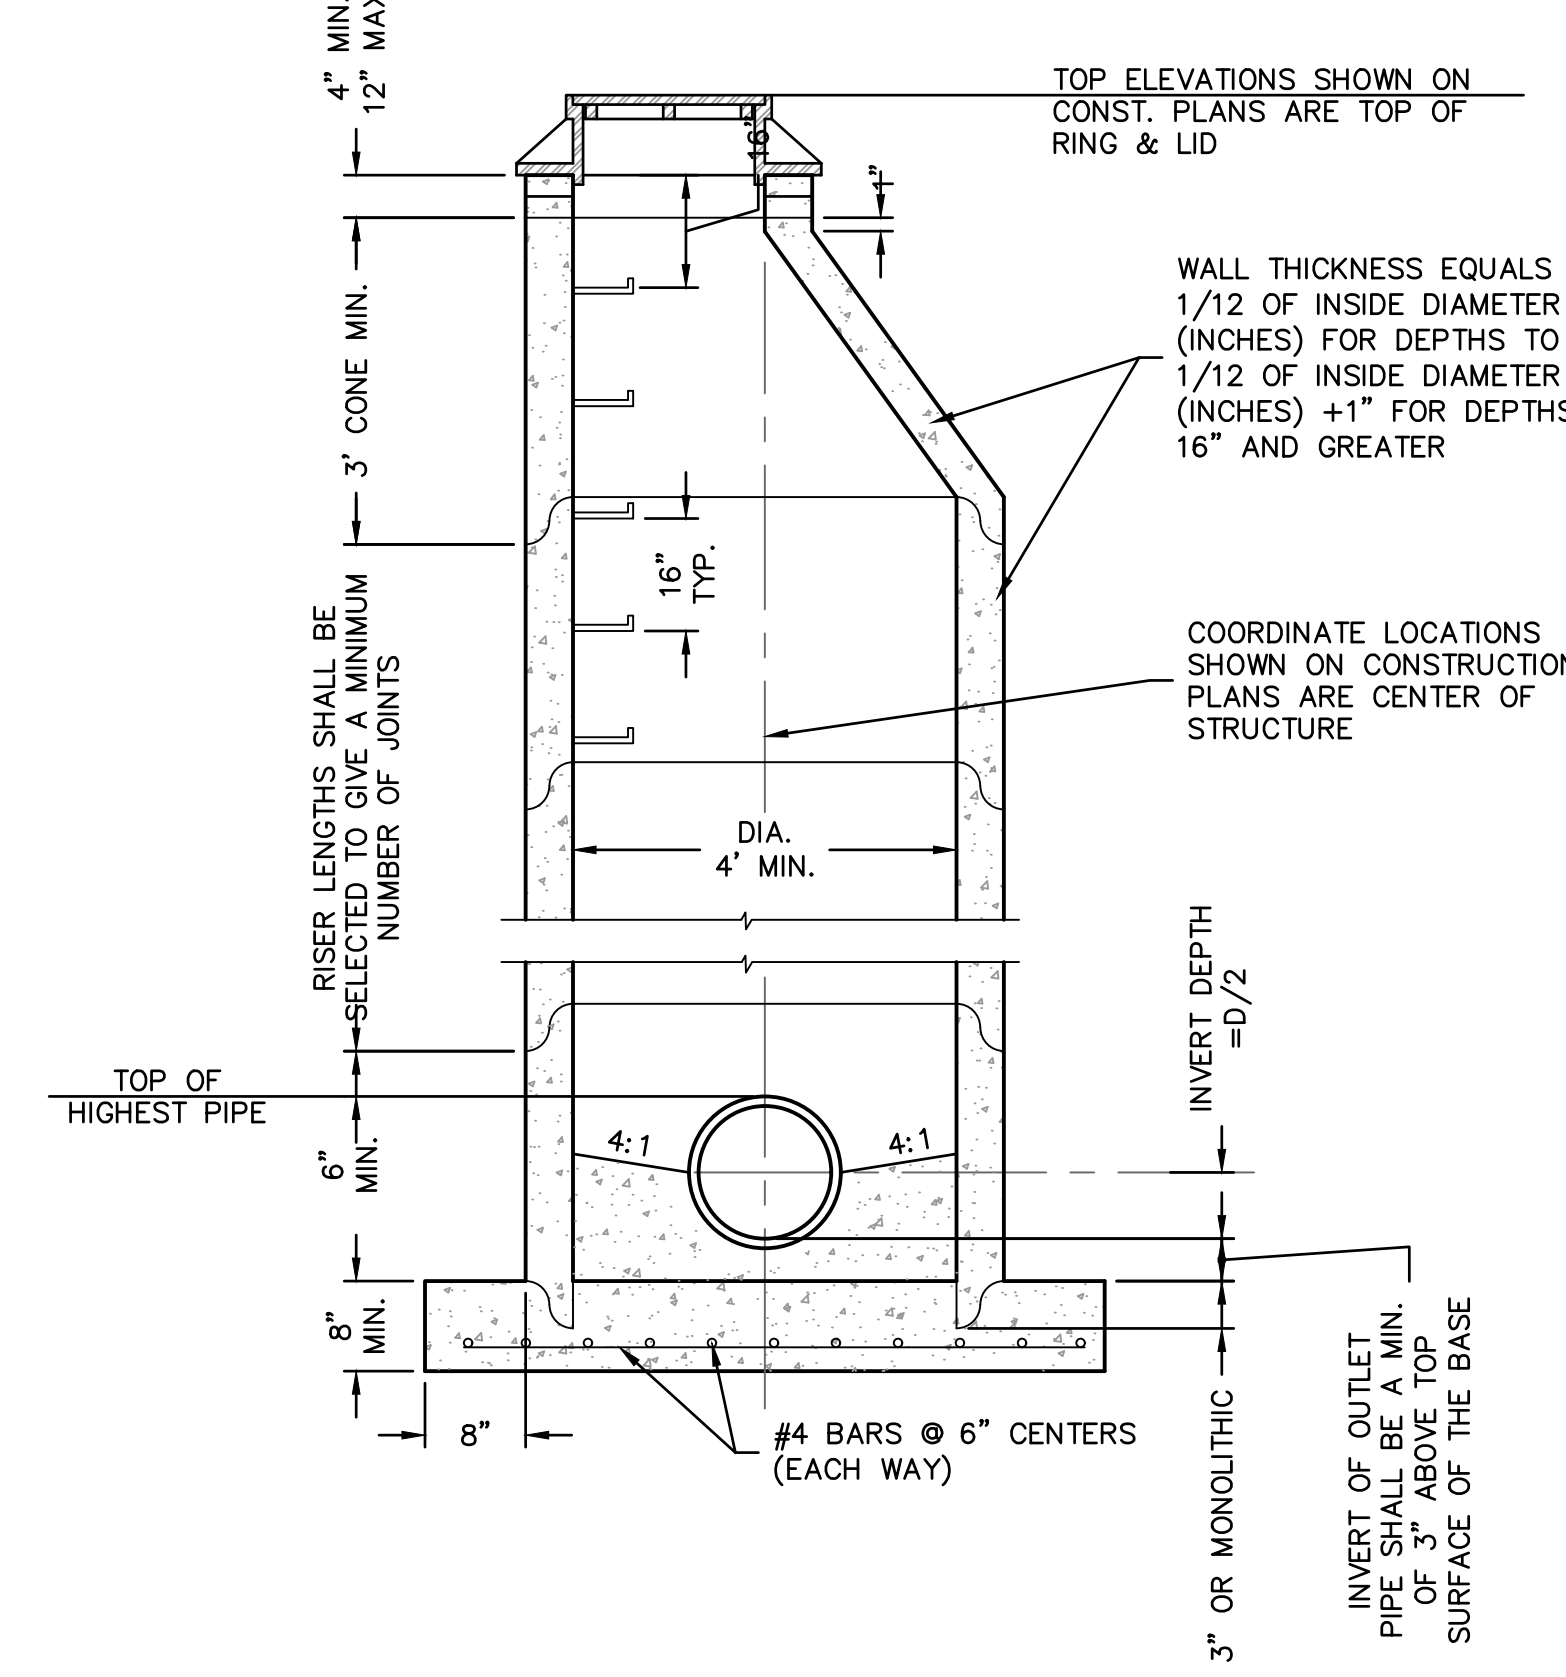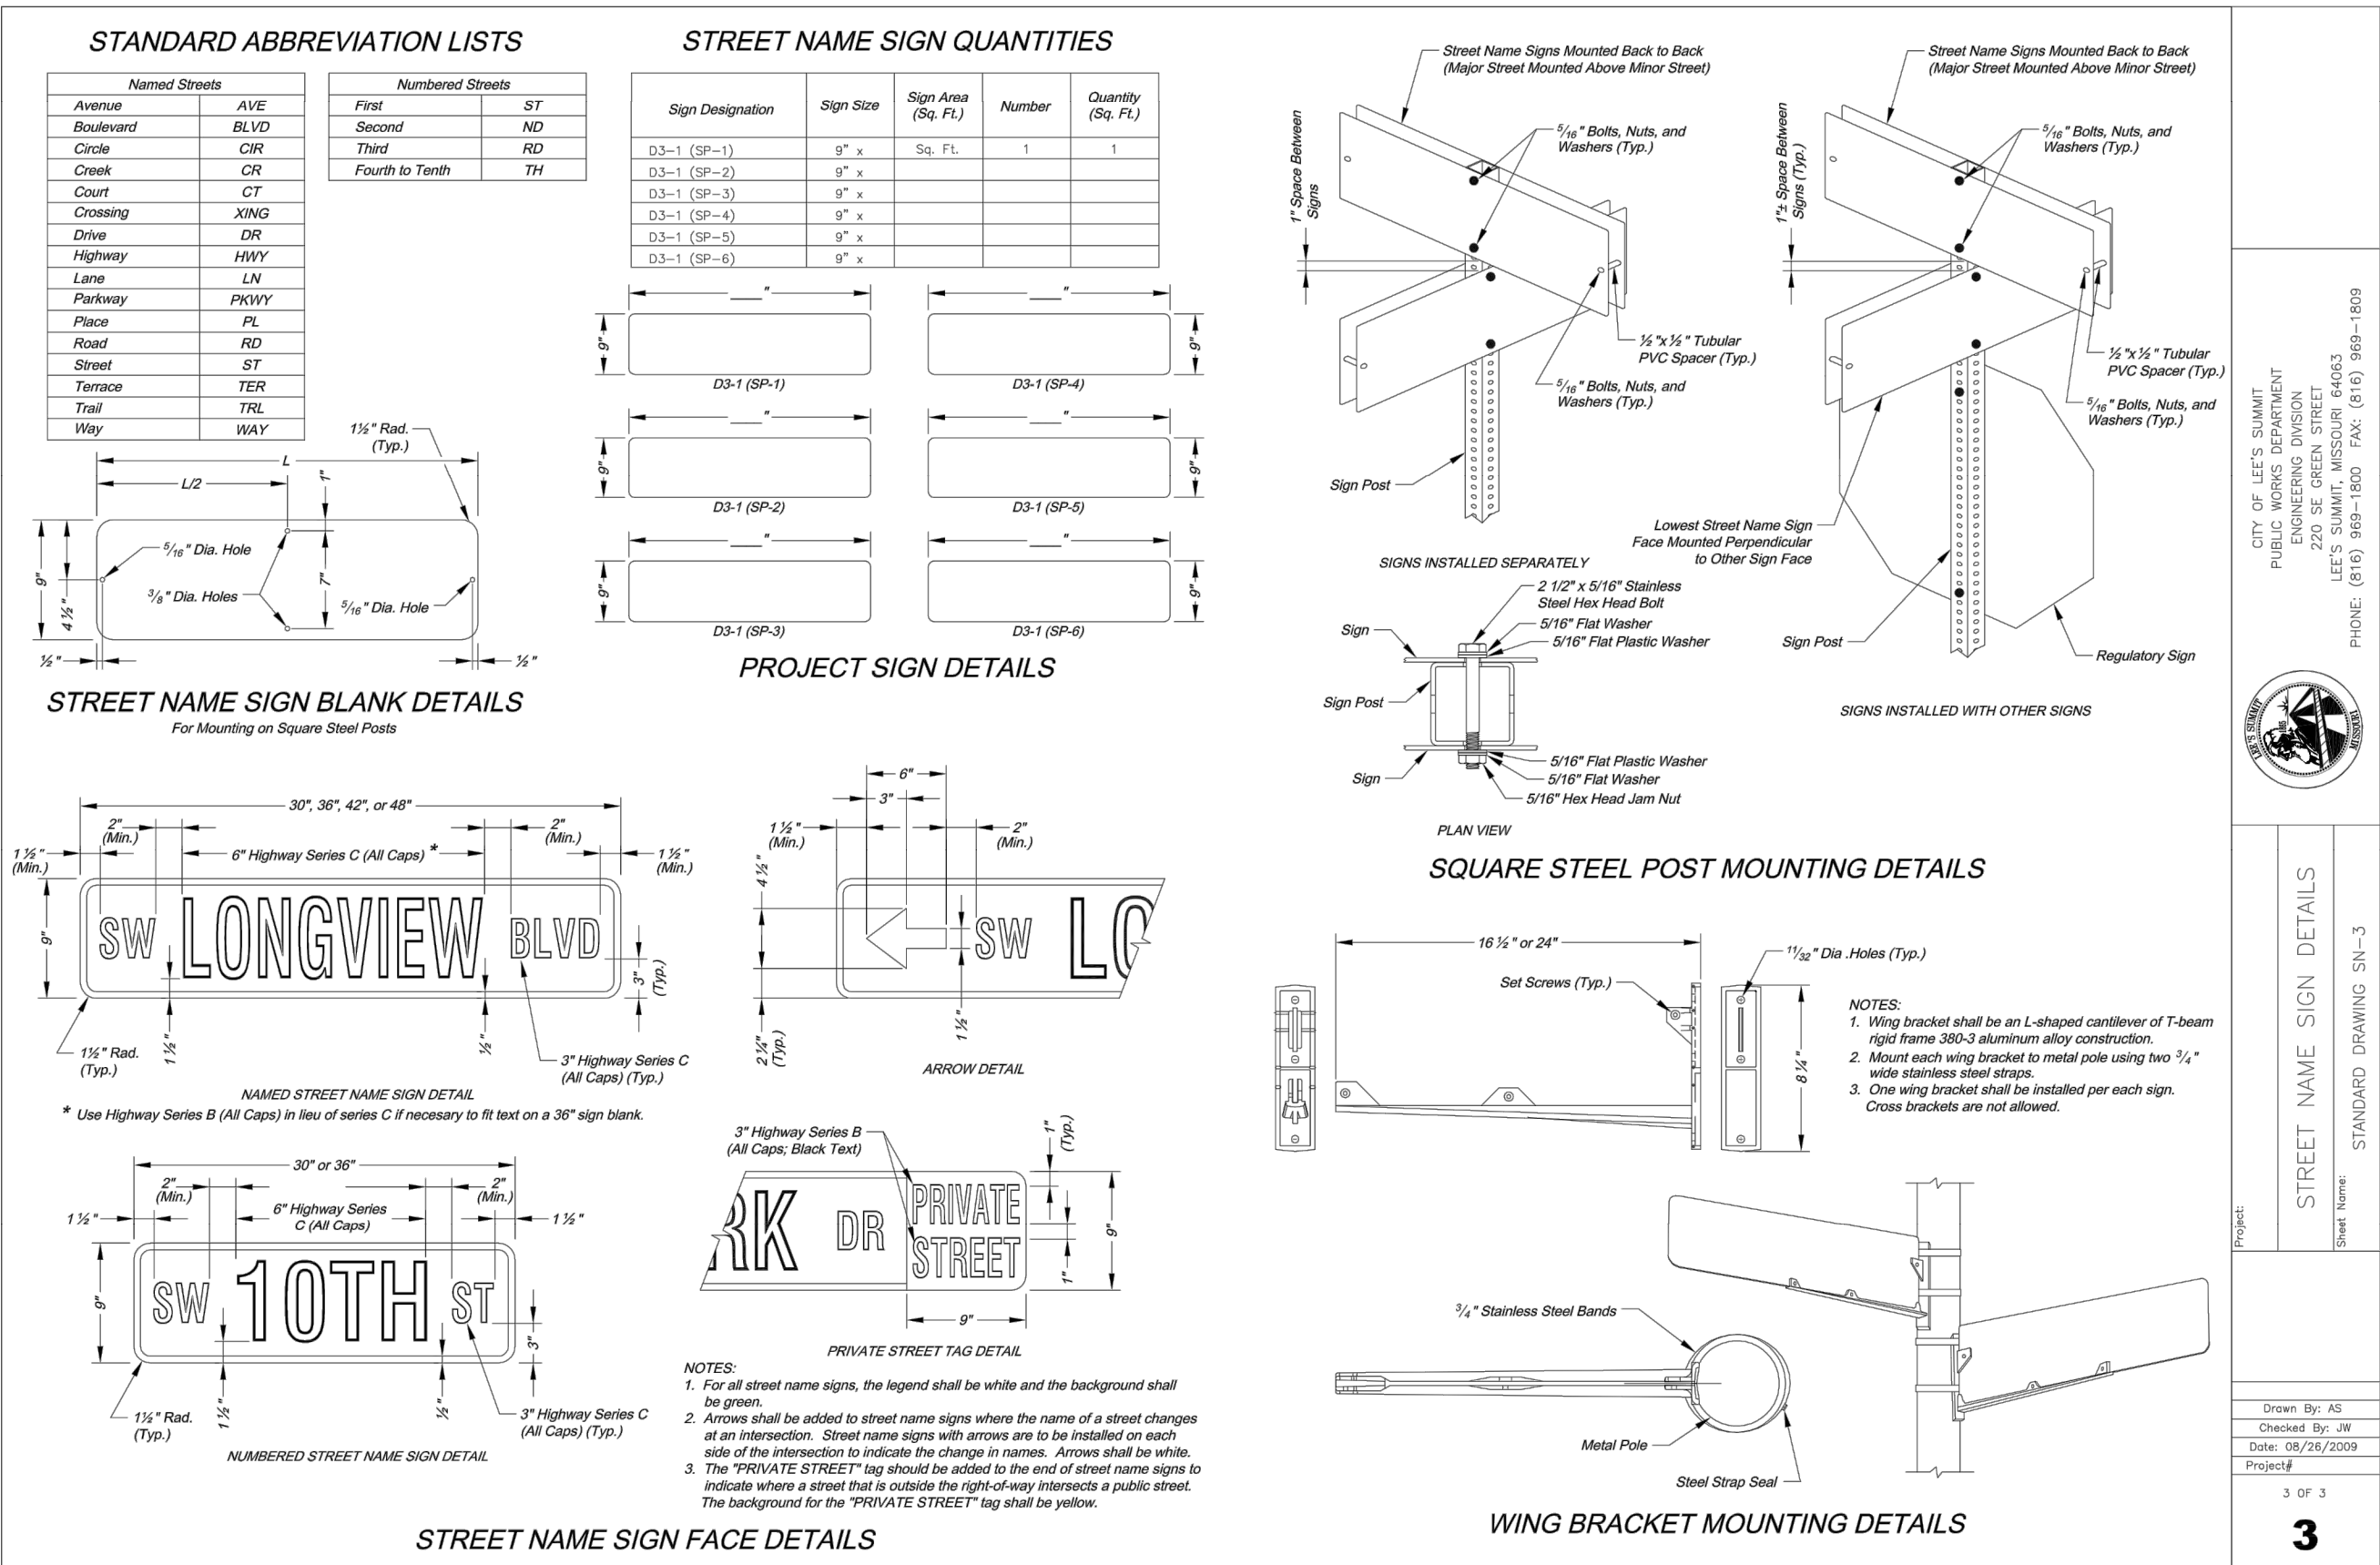

Accepted
Record Drawings

olsson
Olsson - Civil Engineering
Missouri Certificate of Authority #001592
1301 Burlington Street
North Kansas City MO 64116
TEL 816.361.1177
FAX 816.361.1888
www.olsson.com

JULIE ELAINE SELLERS
PROFESSIONAL ENGINEER
NUMBER PE-2017000367
12/17/22

REV.	NO.	DATE	REVISIONS DESCRIPTION
1	03-23-2021	REVISED PER CITY COMMENTS	
2	04-16-2021	CHANGES TO APPROVED PLANS	
3	09-30-2021		

2021

drawn by: B.M.W./A.A.
checked by: B.M.W./
designed by: B.M.W./A.A.
QA/QC by: J.E.S.
project no.: B19-4061
date: 01-08-2021

SHEET
C150