



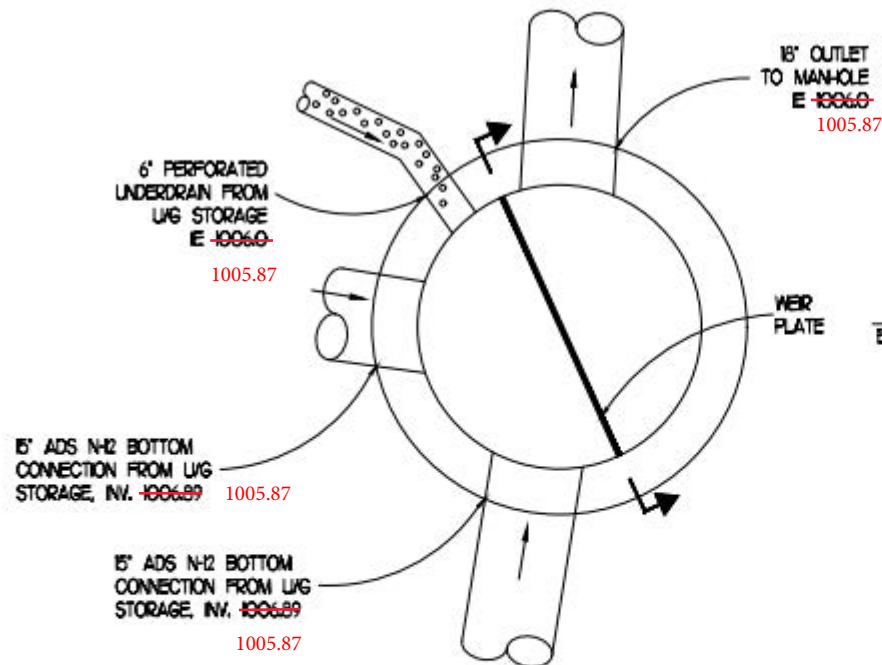

PLAN

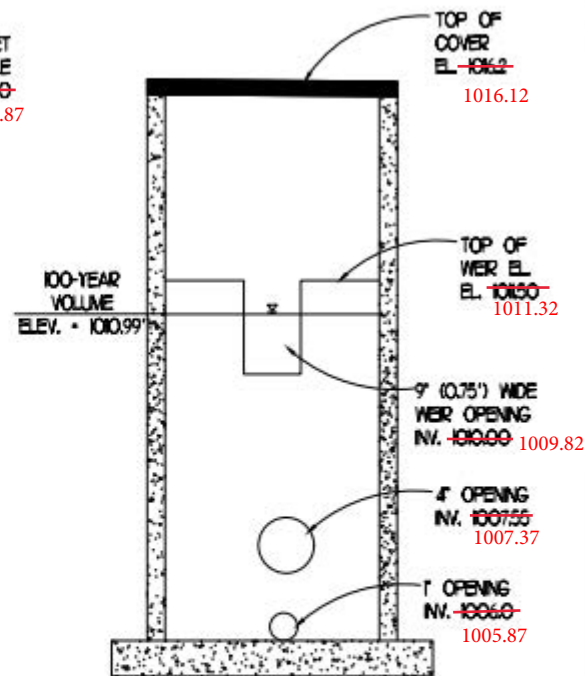

SECTION

Record Drawing

OUTLET CONTROL STRUCTURE

N.T.S.