

I:\PROJECTS\2021\17-134\3.0 Design\3.0 DWG Plans\6.0 SS\17-134-SS-COVER.dwg, 10/23/2019 11:43:59 AM, 11

LEGEND:

A/E

BC

B/B

BM

BL or B.L.

CO

TJB

C&G

D/E

E/E

EL

FL

G/E

HDPE

L/E

MSFE

PVC

P/L

PUB/E

RCP

ROW or R/W

S/E

SL

S/W

TE

U/E

WSE

W/E

ACCESS EASEMENT

BACK OF CURB

BACK TO BACK

BENCHMARK

BUILDING LINE

CLEANOUT

TELEPHONE JUNCTION BOX

CURB AND GUTTER

DRAINAGE EASEMENT

ELECTRICAL EASEMENT

ELEVATION

FLOW LINE

GAS LINE EASEMENT

HIGH-DENSITY POLYETHYLENE

LANDSCAPE EASEMENT

MINIMUM SERVICEABLE FLOOR ELEVATION

POLYVINYL CHLORIDE

PROPERTY LINE

PUBLIC EASEMENT

REINFORCED CONCRETE PIPE

RIGHT-OF-WAY

SANITARY SEWER EASEMENT

SERVICE LINE

SIDEWALK

TOP ELEVATION

UTILITY EASEMENT

WATER SURFACE ELEVATION

WATERLINE EASEMENT

ASPHALT PAVEMENT - EXISTING

ASPHALT PAVEMENT - PROPOSED

CONCRETE PAVEMENT - EXISTING

CONCRETE SIDEWALK - EXISTING

CONCRETE SIDEWALK - PROPOSED

CURB & GUTTER

CURB & GUTTER - EXISTING

TREELINE

EXISTING LOT AND R/W LINES

EXISTING PLAT LINES

P/L

PROPERTY LINES

RIGHT-OF-WAY

SANITARY SEWER MAIN

SANITARY SEWER MAIN - EXIST.

STO

STORM SEWER

STORM SEWER - EXISTING

CATV_x

Fiber Optic Cable - EXISTING

TELEPHONE LINE - EXIST.

ELECTRIC LINE - EXISTING

OVERHEAD POWER LINE - EXIST.

UNDERGROUND ELECTRIC - EX.

UG_x

G_x

W_x

WATERLINE - EXISTING

LIGHT - EXISTING

EXISTING MANHOLE

CLEANOUT

EXISTING SANITARY MANHOLE

PROPOSED SANITARY MANHOLE

EXISTING AREA INLET

EXISTING CURB INLET

EXISTING GRATE INLET

EXISTING JUNCTION BOX

EXISTING STORM MANHOLE

CHIPMAN RD

NW 1/4

NE 1/4

SW 1/4

SE 1/4

8TH

12TH

11TH

1ST

3RD ST

VIEW HIGH DR

PROJECT LOCATION

1.99 MI.

MGRS BM JA-136

SECTION 3-47N-32W

LOCATION MAP

SCALE 1" = 2000'

UTILITY CONTACTS:

MISSOURI DEPARTMENT OF TRANSPORTATION (MODOT)

Steve Holloway

600 NE Colbern Road

Lee's Summit, MO 64086

(816) 607-2186

MISSOURI GAS ENERGY (MGE)

Brent Jones

3025 SE Clover Drive

Lee's Summit, MO 64082

(816) 399-9633

brent.jones@spireenergy.com

KANSAS CITY POWER & LIGHT COMPANY (KCP&L)

Ron Dejanette

1300 SE Hamblin Road

Lee's Summit, MO 64081

Office: (816) 347-4316

Cell: (816) 810-5234

ron.dejanette@kcpl.com

CITY OF LEES SUMMIT PUBLIC WORKS

Dena Mezger

220 SE Green Street

Lee's Summit, MO 64063

(816) 969-1800

AT&T

Mark Manion or Marty Loper

500 E. 8th Street, Room 370

Kansas City, MO 64106

Cell: (816) 275-2341 or (816) 275-1550

COMCAST CABLE

John Meadows

4700 Little Blue Parkway

Independence, MO 64057

(816) 795-2257

PUBLIC WATER SUPPLY DISTRICT

Mark Schautler

220 SE Green Street

Lee's Summit, MO 64063

(816) 969-1900

STREET, STORMWATER, MASTER DRAINAGE PLAN AND EROSION AND SEDIMENT CONTROL

FOR

WINTERSET VALLEY, 12TH PLAT

IN THE CITY OF LEE'S SUMMIT

JACKSON COUNTY, MO

CONFORMING TO CONSTRUCTION RECORDS AS FURNISHED BY OTHERS.

KSC

BY

7-23-19

DATE

EARTHWORK:

1. IT IS RECOMMENDED THAT A GEOTECHNICAL ENGINEER OBSERVE AND DOCUMENT ALL EARTHWORK ACTIVITIES.

2. CONTOURS HAVE BEEN SHOWN AT 1-FOOT OR 2-FOOT INTERVALS, AS INDICATED. GRADING SHALL CONSIST OF COMPLETING THE EARTHWORK REQUIRED TO BRING THE PHYSICAL GROUND ELEVATIONS OF THE EXISTING SITE TO THE FINISHED GRADE (OR SUB-GRADE) ELEVATIONS PROVIDED ON THE PLANS AS SPOT GRADES. CONTOURS OR OTHERS MEANS AS INDICATED ON THE PLANS.

3. THE EXISTING SITE TOPOGRAPHY DEPICTED ON THE PLANS BY CONTOURING HAS BEEN ESTABLISHED BY AERIAL PHOTOGRAPHY AND FIELD VERIFIED BY G.P.S. OBSERVATION NEAR JULY 18TH, 2016. THE CONTOUR ELEVATIONS PROVIDED MAY NOT BE EXACT GROUND ELEVATIONS, BUT RATHER INTERPRETATIONS OF SUCH. ACCURACY SHALL BE CONSIDERED TO BE SUCH THAT NOT MORE THAN 10 PERCENT OF SPOT ELEVATION CHECKS SHALL BE IN ERROR BY MORE THAN ONE-HALF THE CONTOUR INTERVAL PROVIDED, AS DEFINED BY THE NATIONAL MAP ACCURACY STANDARDS. ANY QUANTITIES PROVIDED FOR EARTHWORK VOLUMES ARE ESTABLISHED USING THIS TOPOGRAPHY CONTOUR ACCURACY, AND THEREFORE THE INHERENT ACCURACY OF ANY EARTHWORK QUANTITY IS ASSUMED FROM THE TOPOGRAPHY ACCURACY.

4. PROPOSED CONTOURS ARE TO APPROXIMATE FINISHED GRADE.

5. UNLESS OTHERWISE NOTED, PAYMENT FOR EARTHWORK SHALL INCLUDE BACKFILLING OF THE CURB AND GUTTER, SIDEWALK AND FURTHER MANIPULATION OF UTILITY TRENCH SPOILS. THE SITE SHALL BE LEFT IN A MOWABLE CONDITION AND POSITIVE DRAINAGE MAINTAINED THROUGHOUT.

6. UNLESS OTHERWISE NOTED, ALL EARTHWORK IS CONSIDERED UNCLASSIFIED. NO ADDITIONAL COMPENSATION WILL BE PROVIDED FOR ROCK OR SHALE EXCAVATION, UNLESS SPECIFICALLY STATED OTHERWISE.

7. PRIOR TO EARTHWORK ACTIVITIES, PRE-DISTURBANCE EROSION AND SEDIMENT CONTROL DEVICES SHALL BE IN PLACE PER THE STORM WATER POLLUTION PREVENTION PLAN AND/OR THE EROSION AND SEDIMENT CONTROL PLAN PREPARED FOR THIS SITE.

8. ALL TOPSOIL SHALL BE STRIPPED FROM ALL AREAS TO BE GRADED AND STOCKPILED ADJACENT TO THE SITE AT AN AREA SPECIFIED BY THE PROJECT OWNER OR HIS APPOINTED REPRESENTATIVE. VEGETATION, TRASH, TREES, BRUSH, TREE ROOTS AND LIMBS, ROCK FRAGMENTS GREATER THEN 6-INCHES AND OTHER DELETERIOUS MATERIALS SHALL BE REMOVED AND PROPERLY DISPOSED OF OFFSITE OR AS DIRECTED BY THE OWNER OR HIS APPOINTED REPRESENTATIVE.

9. UNLESS OTHERWISE SPECIFIED IN THE GEOTECHNICAL REPORT, ALL FILLS SHALL BE PLACED IN MAXIMUM 6-INCH LIFTS AND COMPACTED TO 95-PERCENT OF MAXIMUM DENSITY AS DEFINED USING A STANDARD PROCTOR TEST (AASHTO T99/ASTM 698).

10. FILL MATERIALS SHALL BE PER GEOTECHNICAL REPORT AND SHALL NOT INCLUDE ORGANIC MATTER, DEBRIS OR TOPSOIL. ALL FILLS PLACED ON SLOPES GREATER THAN 6:1 SHALL BE BENCHED.

11. THE CONTRACTOR SHALL BE RESPONSIBLE FOR REDISTRIBUTING THE TOPSOIL OVER PROPOSED TURF AND LANDSCAPED AREAS TO A MINIMUM DEPTH OF 6-INCHES BELOW FINAL GRADE.

12. ALL AREAS SHALL BE GRADED FOR POSITIVE DRAINAGE. UNLESS NOTED OTHERWISE THE FOLLOWING GRADES SHALL APPLY:

A. TURF AREAS – 2.5% MINIMUM, 4H:1V MAXIMUM

B. PAVED AREAS – 1.2% MINIMUM, 5% MAXIMUM

13. ALL DISTURBED AREAS SHALL BE FERTILIZED, SEEDED AND MULCHED IMMEDIATELY AFTER EARTHWORK ACTIVITIES HAVE CEASED. SEEDING SHALL BE PER THE EROSION AND SEDIMENT CONTROL PLAN AND/OR LANDSCAPE PLAN. IF NOT SPECIFIED SEEDING SHALL BE PER APWA SECTION 2400, LATEST EDITION. UNLESS OTHERWISE NOTED, SEEDING SHALL BE SUBSIDIARY TO THE CONTRACT PRICE FOR EARTHWORK AND GRADING ACTIVITIES.

14. ALL DISTURBED AREAS IN THE RIGHT-OF-WAY SHALL BE SODDED.

15. UNDERDRAINS ARE RECOMMENDED FOR ALL PAVED AREAS ADJACENT TO IRRIGATED TURF AND LANDSCAPED BEDS.

16. CONTRACTOR SHALL ADHERE TO THE REPORTING REQUIREMENTS OUTLINED IN THE STORM WATER POLLUTION PREVENTION PLAN (SWPPP) PREPARED FOR THIS PROJECT. EROSION AND SEDIMENT CONTROL DEVICES SHALL BE PROPERLY MAINTAINED AND KEPT CLEAN OF SILT AND DEBRIS AND IN GOOD WORKING ORDER. ADDITIONAL EROSION AND SEDIMENT CONTROL MEASURES SHALL BE INSTALLED AS REQUIRED.

UTILITIES:

1. EXISTING UTILITIES HAVE BEEN SHOWN TO THE GREATEST EXTENT POSSIBLE BASED UPON INFORMATION PROVIDED TO THE ENGINEER. THE CONTRACTOR IS RESPONSIBLE FOR CONTACTING THE RESPECTIVE UTILITY COMPANIES AND FIELD LOCATING UTILITIES PRIOR TO CONSTRUCTION AND IDENTIFYING ANY POTENTIAL CONFLICTS. ALL CONFLICTS SHALL IMMEDIATELY BE BROUGHT TO THE ATTENTION OF THE ENGINEER.

2. THE CONTRACTOR SHALL BE RESPONSIBLE FOR COORDINATING ANY REQUIRED UTILITY RELOCATIONS. UTILITIES DAMAGED THROUGH THE NEGLIGENCE OF THE CONTRACTOR SHALL BE REPAIRED AT THE CONTRACTOR'S EXPENSE.

3. CONTRACTOR SHALL VERIFY FLOW-LINES AND STRUCTURE TOPS PRIOR TO CONSTRUCTION, AND SHALL NOTIFY ENGINEER OF ANY DISCREPANCIES. PROVIDE SHOP DRAWINGS FOR ALL PRECAST AND MANUFACTURED UTILITY STRUCTURES FOR REVIEW BY THE ENGINEER PRIOR TO CONSTRUCTION OF THE STRUCTURES.

4. UTILITY SEPARATION: WATERLINES SHALL HAVE A MINIMUM OF 10 FEET HORIZONTAL AND 2 FEET VERTICAL SEPARATION FROM ALL SANITARY AND STORM SEWER LINES. IF MINIMUM SEPARATIONS CAN NOT BE OBTAINED, CONCRETE ENCASEMENT OF THE SANITARY OR STORM SEWER LINE SHALL BE REQUIRED 10 FEET IN EACH DIRECTION OF THE CONFLICT.

5. PAYMENT FOR TRENCHING, BACKFILLING, PIPE EMBEDMENT, FLOWABLE FILL, BACKFILL MATERIALS, CLEAN UP, SEEDING, SODDING AND ANY OTHER ITEMS NECESSARY FOR THE CONSTRUCTION OF THE UTILITY LINE SHALL BE INCLUDED IN THE CONTRACT PRICE FOR THE UTILITY INSTALLATION.

6. THE CONTRACTOR SHALL BE RESPONSIBLE FOR CONTACTING RESPECTIVE UTILITY COMPANIES 48-HOURS IN ADVANCE FOR THE INSPECTION OF ANY PROPOSED UTILITY MAIN EXTENSION OR SERVICE LINE OR SERVICE CONNECTION TO ANY EXISTING MAIN.

7. TRENCH SPOILS SHALL BE NEATLY PLACED ONSITE ADJACENT TO THE TRENCH, AND COMPACTED TO PREVENT SATURATION AND EXCESS SEDIMENT RUNOFF. UNSUITABLE MATERIALS, EXCESS ROCK AND SHALE, ASPHALT, CONCRETE, TREES, BRUSH ETC. SHALL BE PROPERLY DISPOSED OF OFFSITE. MATERIALS MAY BE WASTED ONSITE AT THE DIRECTION OF THE OWNER OR HIS APPOINTED REPRESENTATIVE.

GENERAL NOTES:

1. ALL CONSTRUCTION TO FOLLOW THE CITY OF LEE'S SUMMIT DESIGN AND CONSTRUCTION MANUAL AS ADOPTED BY ORDINANCE 5813.

2. ALL WORKMANSHIP AND MATERIALS SHALL BE SUBJECT TO THE INSPECTION AND APPROVAL OF THE ENGINEERING DEPARTMENT OF THE CITY OF LEE'S SUMMIT, MISSOURI.

3. LINEAL FOOT MEASUREMENTS SHOWN ON THE PLANS ARE HORIZONTAL MEASUREMENTS, NOT SLOPE MEASUREMENTS. ALL PAYMENTS SHALL BE MADE ON HORIZONTAL MEASUREMENTS.

4. NO GEOLOGICAL INVESTIGATION HAS BEEN PERFORMED ON THE SITE.

5. THE UTILITY LOCATIONS SHOWN ON THESE PLANS ARE TAKEN FROM UTILITY COMPANY RECORDS AND APPARENT FIELD LOCATIONS. THE CONTRACTOR SHALL VERIFY THE LOCATION AND DEPTH OF ALL UTILITIES PRIOR TO CONSTRUCTION.

6. THE CONTRACTOR SHALL ADHERE TO THE PROVISIONS OF THE SENATE BILL NUMBER 583, 78TH GENERAL ASSEMBLY OF THE STATE OF MISSOURI. THE BILL REQUIRES THAT ANY PERSON OR FIRM DOING EXCAVATION ON PUBLIC RIGHT OF WAY DO SO ONLY AFTER GIVING NOTICE TO, AND OBTAINING INFORMATION FROM, UTILITY COMPANIES. STATE LAW REQUIRES 48 HOURS ADVANCE NOTICE. THE CONTRACTOR MAY ALSO UTILIZE THE FOLLOWING TOLL FREE PHONE NUMBER PROVIDED BY "MISSOURI ONE CALL SYSTEM, INC.": 1-800-DIG-RITE. THIS PHONE NUMBER IS APPLICABLE ANYWHERE WITHIN THE STATE OF MISSOURI. PRIOR TO COMMENCEMENT OF WORK, THE CONTRACTOR SHALL NOTIFY ALL THOSE COMPANIES WHICH HAVE FACILITIES IN THE NEAR VICINITY OF THE CONSTRUCTION TO BE PERFORMED.

7. PRIOR TO ORDERING PRECAST STRUCTURES, SHOP DRAWING SHALL BE SUBMITTED TO THE DESIGN ENGINEER FOR APPROVAL. AFTER APPROVAL OF THE SHOP DRAWINGS, A COPY OF THE APPROVED AND SIGNED SHOP DRAWINGS SHALL BE PROVIDED TO THE CITY INSPECTOR UPON REQUEST.

8. THE CONTRACTOR SHALL PROTECT ALL MAJOR TREES FROM DAMAGE. NO TREE SHALL BE REMOVED WITHOUT PERMISSION OF THE OWNER, UNLESS SHOWN OTHERWISE.

9. CLEARING AND GRUBBING OPERATIONS AND DISPOSAL OF ALL DEBRIS THEREFROM SHALL BE PERFORMED BY THE CONTRACTOR IN STRICT ACCORDANCE WITH ALL LOCAL CODES AND ORDINANCES.

10. ALL WASTE MATERIAL RESULTING FROM THE PROJECT SHALL BE DISPOSED OF OFF-SITE BY THE CONTRACTOR, OR AS DIRECTED BY THE OWNER.

11. ALL EXCAVATIONS SHALL BE UNCLASSIFIED. NO SEPARATE PAYMENT WILL BE MADE FOR ROCK EXCAVATION.

12. THE CONTRACTOR SHALL CONTROL THE EROSION AND SILTATION DURING ALL PHASED OF CONSTRUCTION, AND SHALL KEEP THE STREETS CLEAN OF MUD AND DEBRIS.

13. ALL MANHOLES, CATCH BASINS, UTILITY VALVES AND METER PITS TO BE ADJUSTED OR REBUILT TO GRADE AS REQUIRED.

14. THE CONTRACTOR SHALL CONTACT DEVELOPMENT SERVICES INSPECTIONS AT: 816-969-1800 TO OBTAIN A DEVELOPMENT SERVICES CONSTRUCTION PERMIT. A MINIMUM 48 HOUR NOTICE SHALL BE GIVEN PRIOR TO PERMIT ISSUANCE.

15. THE CONTRACTOR SHALL CONTACT THE CITY'S EROSION CONTROL SPECIALIST AT: 816-969-1800 PRIOR TO ANY LAND DISTURBANCE.

16. THE CONTRACTOR SHALL CONTACT THE RIGHT OF WAY INSPECTOR AT 816-969-1800 PRIOR TO ANY LAND DISTURBANCE ACTIVITIES WITHIN THE RIGHT OF WAY. THESE ACTIVITIES MAY REQUIRE A PERMIT.

17. THE CONTRACTOR SHALL PROVIDE AND MAINTAIN ALL TRAFFIC HANDLING MEASURES NECESSARY TO ENSURE THAT THE GENERAL PUBLIC IS PROTECTED AT ALL TIMES. TRAFFIC CONTROL SHALL CONFORM TO THE MANUAL ON UNIFORM TRAFFIC CONTROL DEVICES (MUTCD-LATEST EDITION).

STREET NOTES:

1. ALL STREET CONSTRUCTION SHALL BE IN ACCORDANCE WITH THE LATEST EDITION OF THE CITY OF LEE'S SUMMIT DESIGN AND CONSTRUCTION MANUAL. ALL APPLICABLE AASHTO STANDARDS HAVE BEEN MET.

2. ALL INSPECTION OF STREET CONSTRUCTION TO BE PERFORMED BY THE CITY OF LEE'S SUMMIT PUBLIC WORKS DEPARTMENT.

3. CURB RETURN RADII SHALL BE 25' AT BACK OF CURB UNLESS OTHERWISE NOTED.

4. SUBGRADE TO BE COMPACTED TO 95% STANDARD PROCTOR DENSITY.

5. ASSUMED DESIGN SPEED = 25 MPH (COLLECTOR).

6. MINIMUM STOPPING SIGHT DISTANCE = 155 FEET.

7. MINIMUM K, SAG CURVE = 26 (14 WITH LIGHTING), CREST CURVE = 12.

8. GRADE INTERSECTIONS TO DRAIN AS SHOWN.

9. SSD = STOPPING SIGHT DISTANCE.

SUMMARY OF QUANTITIES

	ITEM	QUANTITY	UNITS
1	GRADING	1	LS
2	SEEDING AND SODDING	1	LS
3	TYPE "CG-2" CURB AND GUTTER	5,165	LF
4	TYPE "CG-1 DRY" CURB AND GUTTER	127	LF
5	SAWCUT EXISTING PAVEMENT	20	LF
6	2" SURFACE COURSE - TYPE 3	7,888	SY
7	4" BASE COURSE - TYPE 1	7,888	SY
8	10" BASE COURSE - MODOT TYPE 5 (WITH GEOGRID) (OPTION B)	9,608	SY
9	6" BASE COURSE - MODOT TYPE 5 (6" CHEMICAL STABILIZATION) (OPTION A)	9,608	SY
10	15" HDPE	1,015	LF
11	18" HDPE	384	LF
12	24" HDPE	343	LF
13	30" HDPE	196	LF
14	42" HDPE	116	LF
15	15" HDPE END SECTION W/ TOEWALL	1	EA
16	42" HDPE END SECTION W/ TOEWALL	1	EA
17	STD. 6"x4" CURB INLET	13	EA
18	STD. 4"x4" AREA INLET	6	EA
19	STD. 4"x4" JUNCTION BOX	2	EA
20	STD. 5"x5" JUNCTION BOX	1	EA
21	D ₁₆ -15" STONE RIP-RAP W/ FILTER FABRIC	29	CY
22	EROSION CONTROL DEVICES	1	LS
23	A8-3 FOR STREET CROSSING	474	LF
24	SIGNAGE & PAVEMENT MARKING	1	LS
25	CITY PERMIT FEE	1	LS
26	LAND DISTURBANCE CITY FEE	1	LS
27	BONDS	1	LS
28	5' SIDEWALK	2,614	LF
29	TYPE "A" SIDEWALK RAMP	4	EA
30	TYPE "B" SIDEWALK RAMP	1	EA
31	TYPE "M" SIDEWALK RAMP	2	EA
32	4" STACKED STONE RETAINING WALL	297	LF

* NOTE:

QUANTITIES PULLED FOR STREET OPTION A & B FROM CITY OF LEE'S SUMMIT DESIGN CRITERIA, SECTION 5200, TABLE LS-2: MINIMUM ASPHALT PAVEMENT THICKNESSES. EITHER IS ALLOWED AT CONTRACTORS OPTION (SEE TABLE ON DETAIL SHEET 21.)

Sheet List Table

Sheet Number	Sheet Title
1	COVER SHEET
2	PRE-CLEARING PLAN
3	ECP-CONSTRUCTION PLAN
4	FINAL STABILIZATION PLAN
5	EROSION CONTROL DETAILS
6	EROSION CONTROL DETAILS
7	GENERAL LAYOUT
8	MASTER DRAINAGE PLAN - GRADING PLAN
9	MASTER DRAINAGE PLAN - SPOT ELEVATIONS
10	MASTER DRAINAGE PLAN - DRAINAGE AREA MAP
11	NW AUDUBON LANE PLAN AND PROFILE
12	NW THOREAU DRIVE PLAN AND PROFILE
13	MACKENZIE DRIVE PLAN AND PROFILE
14	CARSON DRIVE PLAN AND PROFILE
15	INTERSECTION DETAILS
16	INTERSECTION DETAILS
17	STORM PLAN
18	STORM PROFILE
19	STORM PROFILE
20	DETAILS
21	DETAILS
22	DETAILS
23	DETAILS
24	SIGN PLAN
25	STREET SIGN DETAILS

PREPARED AND SUBMITTED BY:

STATE OF MISSOURI

MARK ALLEN BREUER

PROFESSIONAL ENGINEER

NUMBER

PE-2000007268

10.23.19

SCHLAGEL & ASSOCIATES, P.A.

APPROVED BY:

CITY ENGINEER

APPROVED FOR ONE YEAR FROM THIS DATE

DATE

OWNER/DEVELOPER:

GALE COMMUNITIES, INC.

DAVID GALE

400 SW LONGVIEW BLVD., STE 109

LEE'S SUMMIT, MO 64081

p 816-645-2336

f -

DGALE@GALECOMMUNITIES.COM

MISSOURI GEOGRAPHIC REFERENCE SYSTEM BENCH MARK:

BM JA-136, LOCATED AT INTERSECTION OF SW OLDHAM PARKWAY AND SW WARD ROAD, 61 FT SOUTH OF CL OF OLDHAM PARKWAY AND 28.9 FT EAST OF THE EAST EDGE OF WARD ROAD.

ELEV. 993.11'

PROJECT BENCH MARK:

SANITARY MANHOLE H2 AT NW CORNER OF LOT 1153 WINTERSET VALLEY 1ST PLAT, APPROX. 39' RT. OF CL OF NW PEALE BLVD.

ELEV.935.45'

SCHLAGEL & ASSOCIATES, P.A.

Engineers-Planners-Surveyors-Landscape Architects

14920 West 107th Street • Lenexa, Kansas 66215

(913) 492-5158 • Fax: (913) 492-8400

WWW.SCHLAGELASSOCIATES.COM

Missouri State Certificates of Authority

#E2002003600-F #LAC2001005237 #LS200200859-F

WINTERSET VALLEY, 12TH PLAT

STREET, STORMWATER, MASTER DRAINAGE PLAN AND

EROSION AND SEDIMENT CONTROL

AUDUBON LANE AND CARSON DRIVE

LEE'S SUMMIT, MO

REVISION DATE	DESCRIPTION
06/04/2018	CITY COMMENTS
07/30/2018	CITY COMMENTS
08/28/2018	CITY COMMENTS/SHPD FINDINGS
08/27/2019	REVISE STREET NAMES
8/29/2019	REVISE RETAINING WALLS

DRAWN BY:	CHECKED BY:	DATE PREPARED:	PROJ. NUMBER:
KSC	MAB	4/20/18	17-134


COVER SHEET

SHEET

1

OF 25

I:\PROJECTS\2017\17-1943.0 Design\3.0 DWG Plans\6.0 SS\17-134-SS-EROS CONT PLAN.dwg, 10/23/2019 11:45:46 AM, 1:1

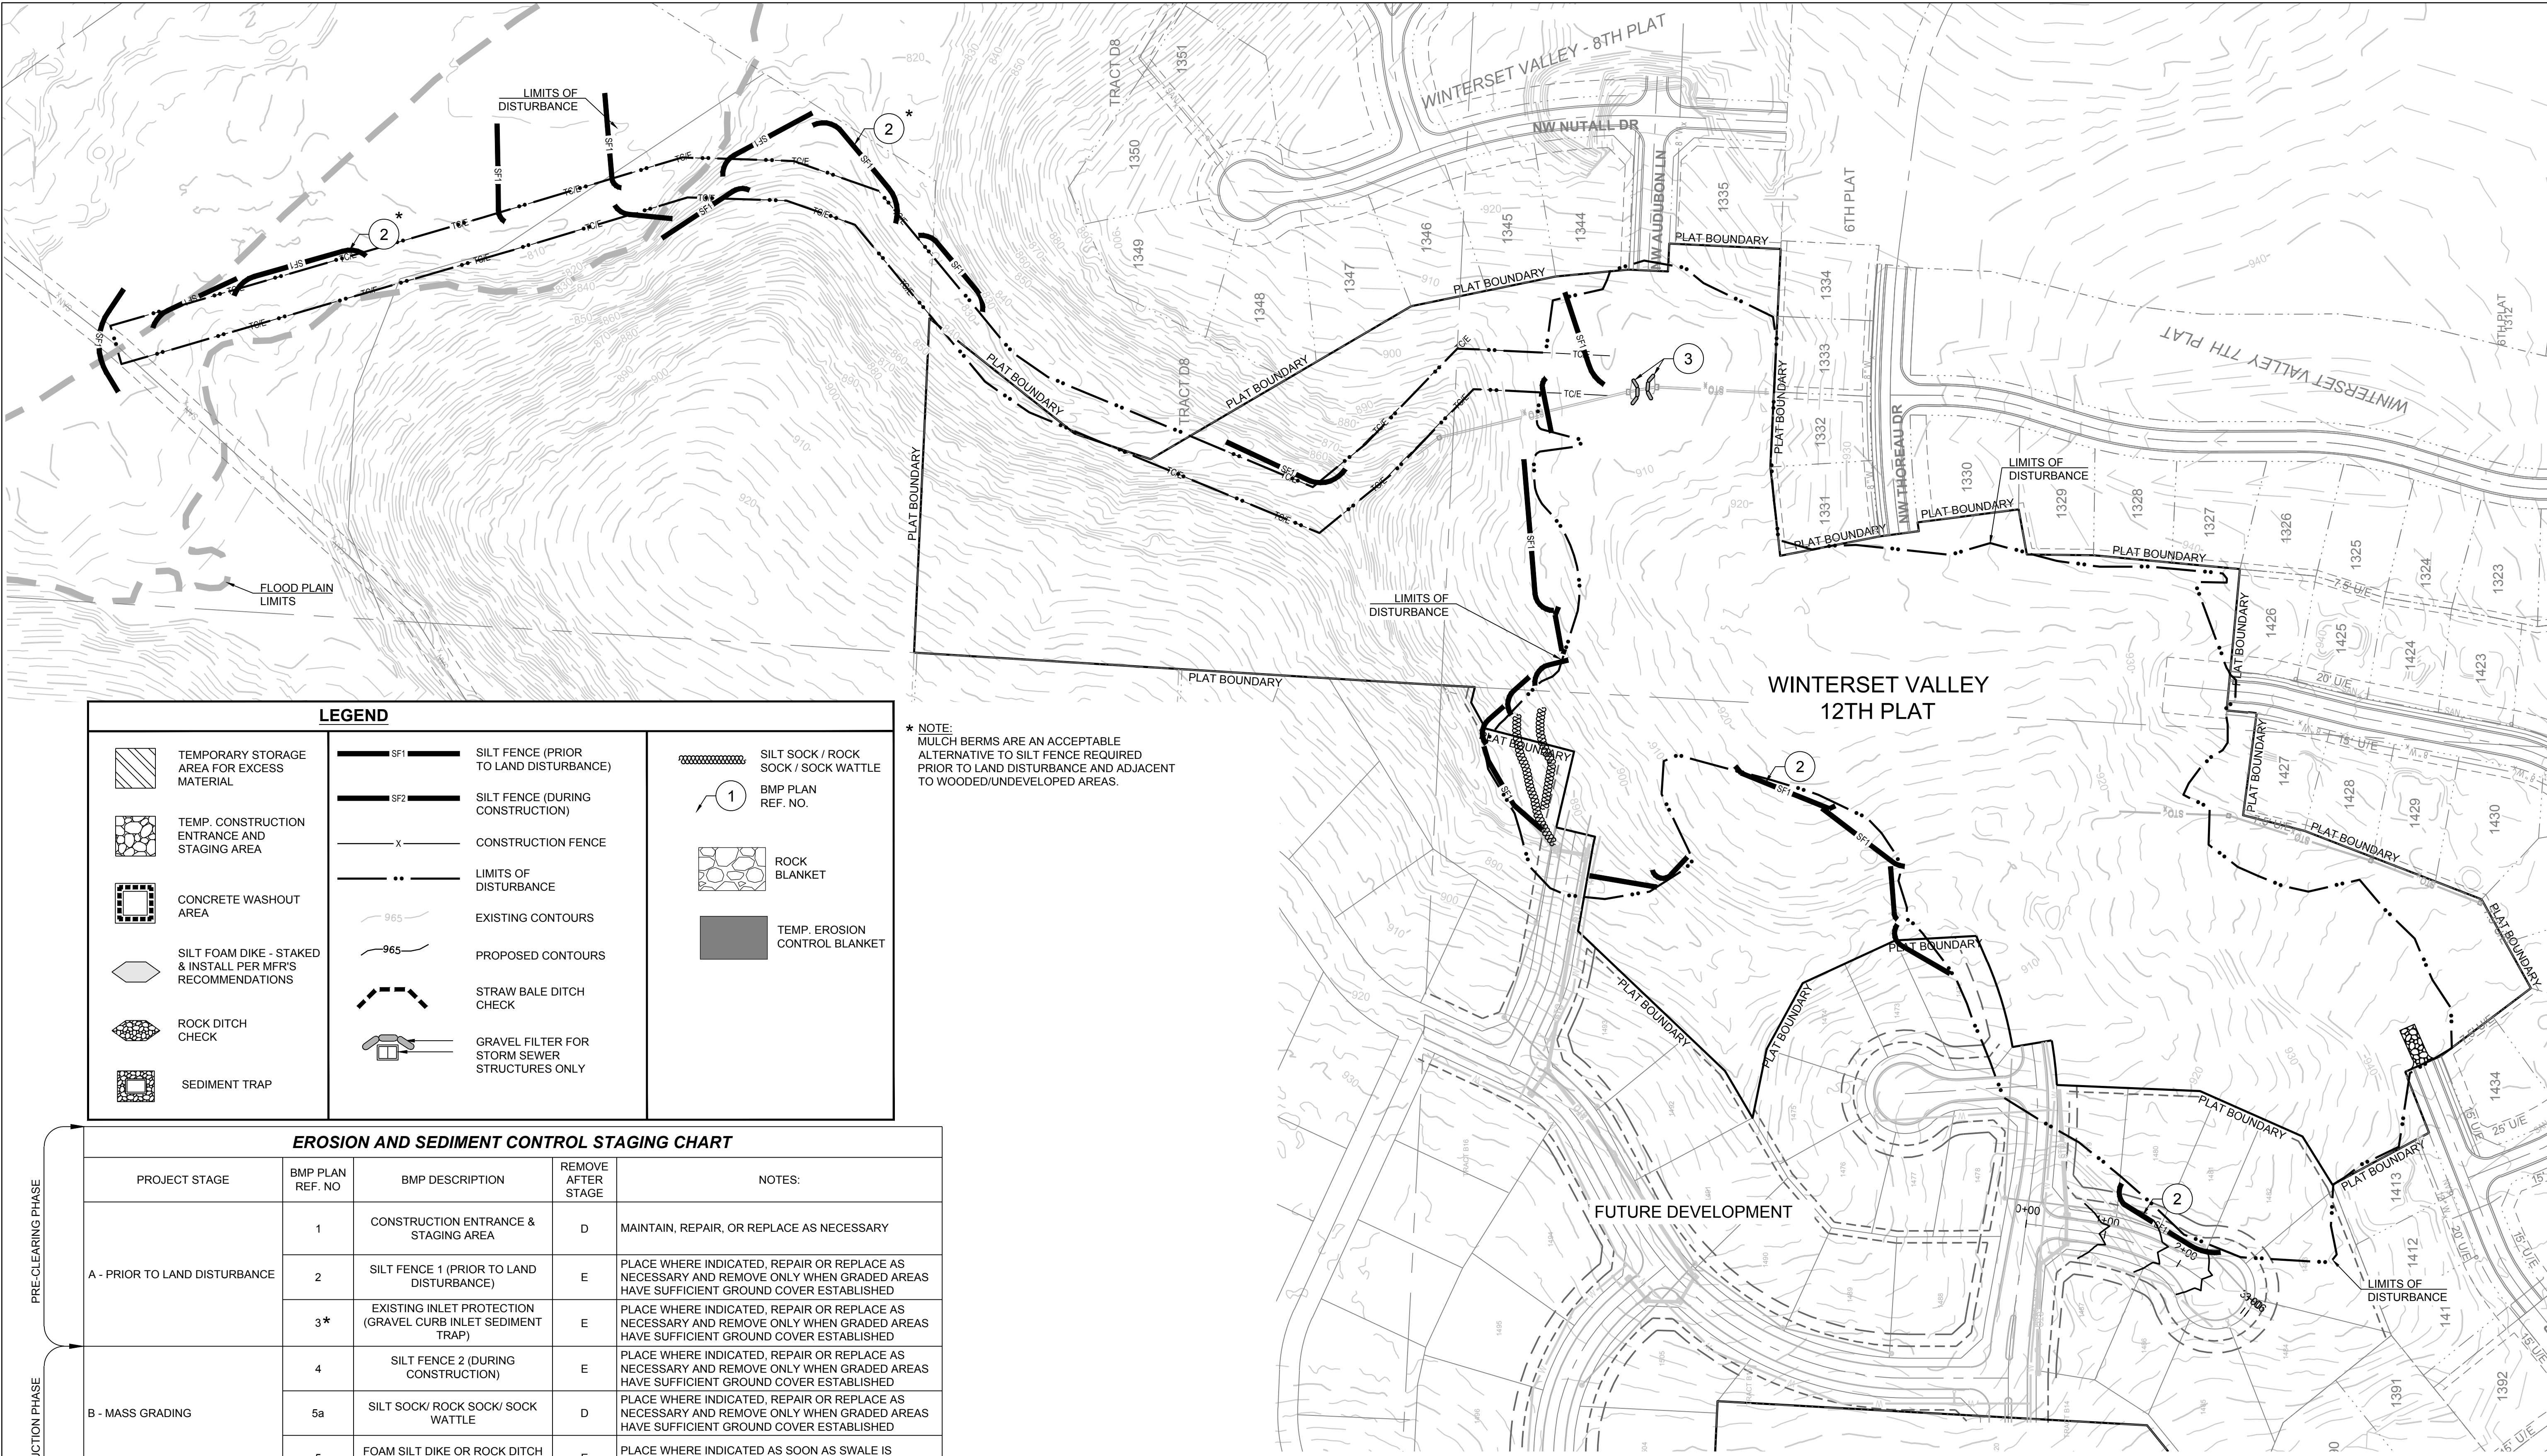

LEGEND

	TEMPORARY STORAGE AREA FOR EXCESS MATERIAL		SILT FENCE (PRIOR TO LAND DISTURBANCE)		SILT SOCK / ROCK SOCK / SOCK WATTLE
	TEMP. CONSTRUCTION ENTRANCE AND STAGING AREA		SILT FENCE (DURING CONSTRUCTION)		BMP PLAN REF. NO.
	CONCRETE WASHOUT AREA		CONSTRUCTION FENCE		ROCK BLANKET
	SILT FOAM DIKE - STAKED & INSTALL PER MFR'S RECOMMENDATIONS		LIMITS OF DISTURBANCE		TEMP. EROSION CONTROL BLANKET
	ROCK DITCH CHECK		EXISTING CONTOURS		
	SEDIMENT TRAP		PROPOSED CONTOURS		
			STRAW BALE DITCH CHECK		
			GRAVEL FILTER FOR STORM SEWER STRUCTURES ONLY		

* NOTE:
MULCH BERMS ARE AN ACCEPTABLE ALTERNATIVE TO SILT FENCE REQUIRED PRIOR TO LAND DISTURBANCE AND ADJACENT TO WOODED/UNDEVELOPED AREAS.

EROSION AND SEDIMENT CONTROL STAGING CHART

	PROJECT STAGE	BMP PLAN REF. NO	BMP DESCRIPTION	REMOVE AFTER STAGE	NOTES:
PRE-CLEARING PHASE	A - PRIOR TO LAND DISTURBANCE	1	CONSTRUCTION ENTRANCE & STAGING AREA	D	MAINTAIN, REPAIR, OR REPLACE AS NECESSARY
		2	SILT FENCE 1 (PRIOR TO LAND DISTURBANCE)	E	PLACE WHERE INDICATED, REPAIR OR REPLACE AS NECESSARY AND REMOVE ONLY WHEN GRADED AREAS HAVE SUFFICIENT GROUND COVER ESTABLISHED
		3*	EXISTING INLET PROTECTION (GRAVEL CURB INLET SEDIMENT TRAP)	E	PLACE WHERE INDICATED, REPAIR OR REPLACE AS NECESSARY AND REMOVE ONLY WHEN GRADED AREAS HAVE SUFFICIENT GROUND COVER ESTABLISHED
CONSTRUCTION PHASE	B - MASS GRADING	4	SILT FENCE 2 (DURING CONSTRUCTION)	E	PLACE WHERE INDICATED, REPAIR OR REPLACE AS NECESSARY AND REMOVE ONLY WHEN GRADED AREAS HAVE SUFFICIENT GROUND COVER ESTABLISHED
		5a	SILT SOCK/ ROCK SOCK/ SOCK WATTLE	D	PLACE WHERE INDICATED, REPAIR OR REPLACE AS NECESSARY AND REMOVE ONLY WHEN GRADED AREAS HAVE SUFFICIENT GROUND COVER ESTABLISHED
		5	FOAM SILT DIKE OR ROCK DITCH CHECK	E	PLACE WHERE INDICATED AS SOON AS SWALE IS ESTABLISHED, REPAIR OR REPLACE AS NECESSARY
FINAL STABILIZATION PHASE	C - UTILITY CONSTRUCTION	6	CONCRETE WASHOUT AREA	E	MAINTAIN, REPAIR, OR REPLACE AS NECESSARY
		7	INLET PROTECTION (SILT FENCE)	D/E	PLACE SILT FENCE AROUND ALL STORM SEWER STRUCTURES / YARD AREA STORM STRUCTURES TO HAVE SILT FENCE REMOVED ONLY WHEN GRADED AREAS HAVE SUFFICIENT GROUND COVER ESTABLISHED
		8	INLET PROTECTION (GRAVEL FILTER BAGS)	E	BOARDS SHALL BE PLACED IN FRONT OF INLET OPENING FROM THE TIME SILT FENCE IS REMOVED UNTIL SUCH TIME THAT THE CURB / THROAT IS POURED. PLACE GRAVEL FILTER BAGS AT THE OPENING OF ALL CURB INLETS IMMEDIATELY AFTER THE INLET THROATS ARE POURED
FINAL STABILIZATION PHASE	D - AFTER PAVING OPERATIONS	9	SILT FENCE 2 (AFTER CURB CONSTRUCTION)	E	PLACE WHERE INDICATED, REPAIR OR REPLACE AS NECESSARY AND REMOVE ONLY WHEN GRADED AREAS HAVE SUFFICIENT GROUND COVER ESTABLISHED
		10	SEEDING AND MULCHING	E	ALL DISTURBED AREAS AFTER 14 DAYS OF CONSTRUCTION INACTIVITY
	E - UNTIL CLOSURE OF LAND DISTURBANCE PERMIT				ADDITIONAL SEDIMENT AND EROSION CONTROL MEASURES MAY BE REQUIRED ANY TIME CURRENT MEASURES ARE FOUND TO BE INEFFECTIVE.


DISTURBED AREA = 17.08 A.C.

SITE SPECIFIC NOTES:

- THE CONTRACTOR IS RESPONSIBLE FOR VERIFYING ALL EXISTING UTILITY LOCATIONS PRIOR TO EXCAVATION.
- THERE ARE NO WETLANDS, NATURAL OR ARTIFICIAL WATER STORAGE DETENTION AREAS IN THE PROJECT AREA.
- NO PART OF THE PROJECT LIES WITHIN THE 100 YEAR FLOOD PLAIN PER FEMA FLOOD INSURANCE RATE MAP NUMBER 29095C0412G DATED JANUARY 20, 2017.
- ALL EROSION AND SEDIMENTATION CONTROL MEASURES SHALL BE IMPLEMENTED ACCORDING TO THE BMP STAGING CHART.
- ADDITIONAL EROSION CONTROL MAY BE REQUIRED BY THE CITY ENGINEER AT ANY TIME EXISTING MEASURES ARE FOUND TO BE INEFFECTIVE OR PROBLEMATIC AREAS ARE NOTED IN THE FIELD.

- STABILIZATION OF DISTURBED AREAS MUST, AT A MINIMUM, BE INITIATED IMMEDIATELY WHENEVER ANY CLEARING, GRADING, EXCAVATING, OR OTHER SOIL DISTURBING ACTIVITIES HAVE PERMANENTLY CEASED ON ANY PORTION OF THE SITE, OR TEMPORARILY CEASED ON ANY PORTION OF THE SITE AND WILL NOT RESUME FOR A PERIOD EXCEEDING 14 CALENDAR DAYS. THE DISTURBED AREAS SHALL BE PROTECTED FROM EROSION BY STABILIZING THE AREA WITH MULCH OR OTHER SIMILARLY EFFECTIVE SOIL STABILIZING BMPs. INITIAL STABILIZATION ACTIVITIES MUST BE COMPLETED WITHIN 14 DAYS AFTER SOIL DISTURBING ACTIVITIES CEASE.
- ALL PERIMETER SILT FENCE, EARTH DIKES, SEDIMENT BASINS, AND ROCK CONSTRUCTION ENTRANCES WILL BE INSTALLED BEFORE GRADING OPERATIONS BEGIN.
- SILT FENCE AND EARTH DIKES THAT ARE PLACED BEFORE GRADING BEGINS WILL BE MAINTAINED BY THE GRADING CONTRACTOR.
- AREAS WITHIN PUBLIC RIGHT-OF-WAY SHALL BE SODDED IMMEDIATELY AFTER CONSTRUCTION IS COMPLETE.

Record Drawing

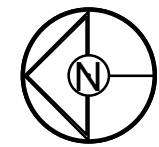


0 100' 200'
SCALE: 1" = 100'

CONFORMING TO CONSTRUCTION RECORDS AS FURNISHED BY OTHERS.

KSC 7-23-19
BY DATE

REVISION DATE	DESCRIPTION
06/04/2018	CITY COMMENTS
07/30/2018	CITY COMMENTS
08/28/2018	CITY COMMENTS/SHPO FINDINGS
08/27/2019	REVISE STREET NAMES
8/29/2019	REVISE RETAINING WALLS
4/20/18	
PROJ. NUMBER:	17-134

I:\PROJECTS\2021\17-134\3.0 Design\3.0 DWG Plans\6.0 SS\17-134-SS-EROS CONT PLAN.dwg, 10/23/2019 11:45:57 AM, 1:1

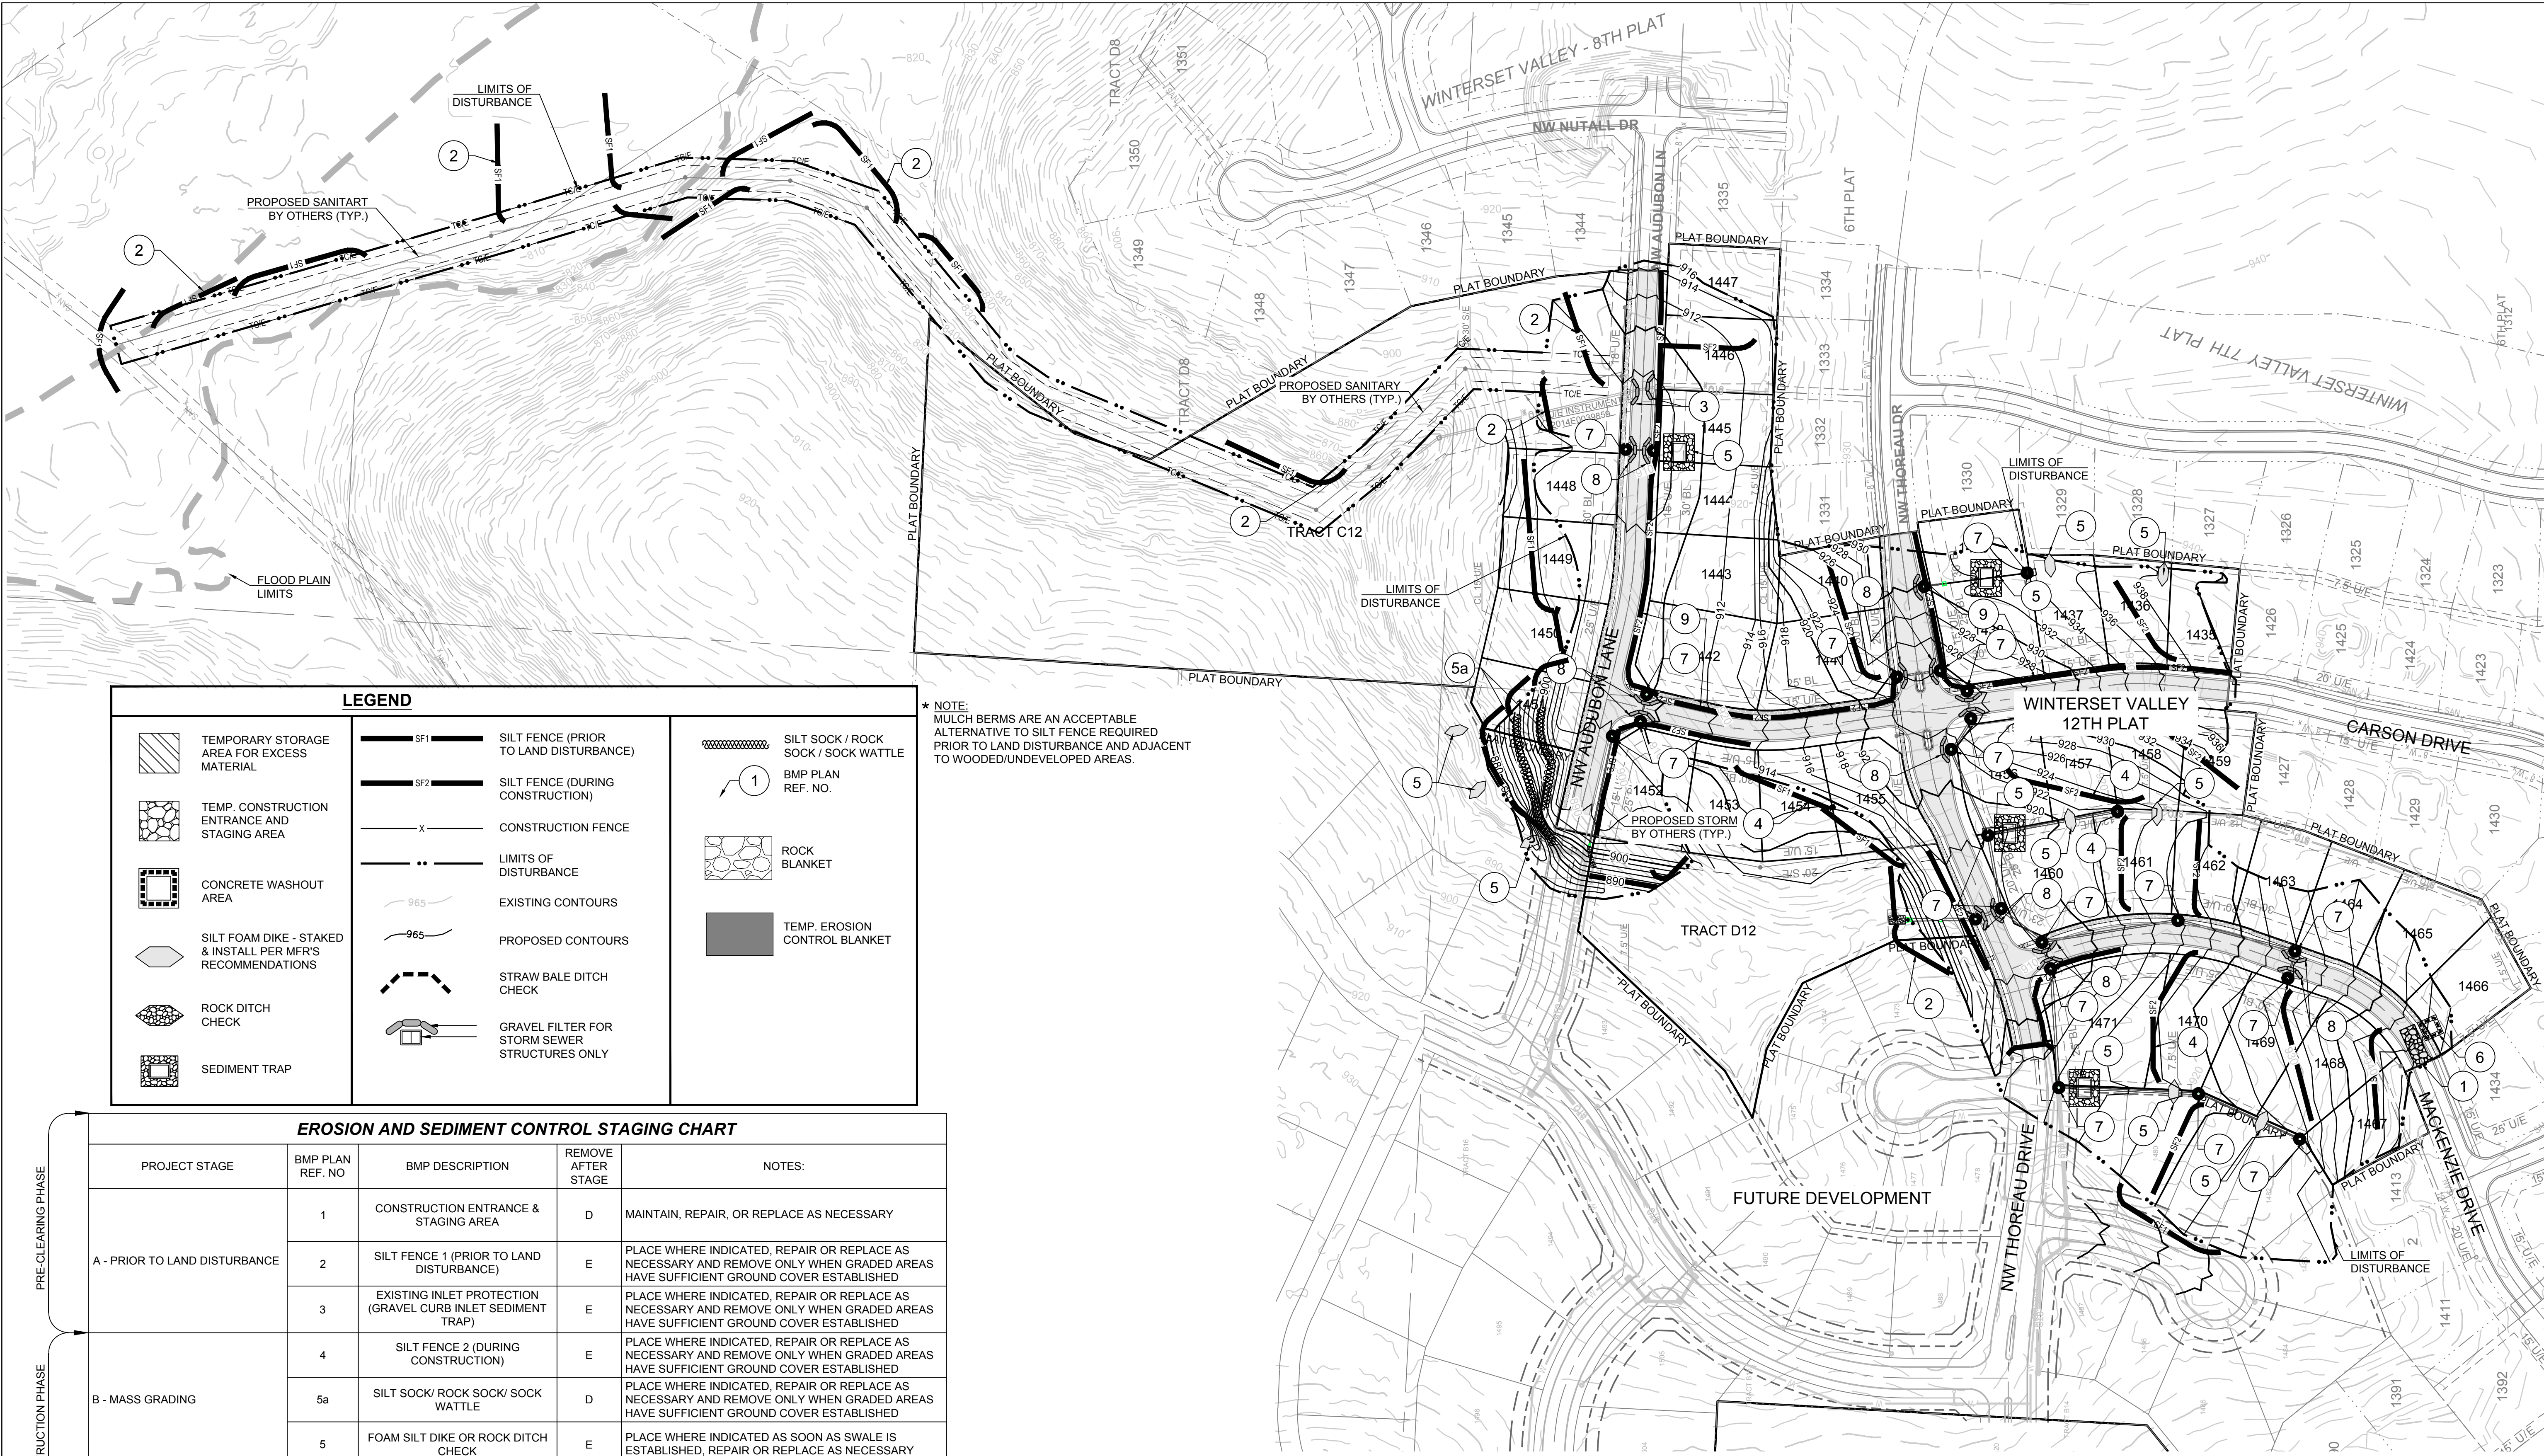

EROSION AND SEDIMENT CONTROL STAGING CHART

	PROJECT STAGE	BMP PLAN REF. NO	BMP DESCRIPTION	REMOVE AFTER STAGE	NOTES:
PRE-CLEARING PHASE	A - PRIOR TO LAND DISTURBANCE	1	CONSTRUCTION ENTRANCE & STAGING AREA	D	MAINTAIN, REPAIR, OR REPLACE AS NECESSARY
		2	SILT FENCE 1 (PRIOR TO LAND DISTURBANCE)	E	PLACE WHERE INDICATED, REPAIR OR REPLACE AS NECESSARY AND REMOVE ONLY WHEN GRADED AREAS HAVE SUFFICIENT GROUND COVER ESTABLISHED
		3	EXISTING INLET PROTECTION (GRAVEL CURB INLET SEDIMENT TRAP)	E	PLACE WHERE INDICATED, REPAIR OR REPLACE AS NECESSARY AND REMOVE ONLY WHEN GRADED AREAS HAVE SUFFICIENT GROUND COVER ESTABLISHED
CONSTRUCTION PHASE	B - MASS GRADING	4	SILT FENCE 2 (DURING CONSTRUCTION)	E	PLACE WHERE INDICATED, REPAIR OR REPLACE AS NECESSARY AND REMOVE ONLY WHEN GRADED AREAS HAVE SUFFICIENT GROUND COVER ESTABLISHED
		5a	SILT SOCK/ ROCK SOCK/ SOCK WATTLE	D	PLACE WHERE INDICATED, REPAIR OR REPLACE AS NECESSARY AND REMOVE ONLY WHEN GRADED AREAS HAVE SUFFICIENT GROUND COVER ESTABLISHED
		5	FOAM SILT DIKE OR ROCK DITCH CHECK	E	PLACE WHERE INDICATED AS SOON AS SWALE IS ESTABLISHED, REPAIR OR REPLACE AS NECESSARY
FINAL PHASE	C - UTILITY CONSTRUCTION	6	CONCRETE WASHOUT AREA	E	MAINTAIN, REPAIR, OR REPLACE AS NECESSARY
		7	INLET PROTECTION (SILT FENCE)	D/E	PLACE SILT FENCE AROUND ALL STORM SEWER STRUCTURES / YARD AREA STORM STRUCTURES TO HAVE SILT FENCE REMOVED ONLY WHEN GRADED AREAS HAVE SUFFICIENT GROUND COVER ESTABLISHED
		8	INLET PROTECTION (GRAVEL FILTER BAGS)	E	BOARDS SHALL BE PLACED IN FRONT OF INLET OPENING FROM THE TIME SILT FENCE IS REMOVED UNTIL SUCH TIME THAT THE CURB / THROAT IS POURED. PLACE GRAVEL FILTER BAGS AT THE OPENING OF ALL CURB INLETS IMMEDIATELY AFTER THE INLET THROATS ARE POURED
FINAL PHASE	D - AFTER PAVING OPERATIONS	9	SILT FENCE 2 (AFTER CURB CONSTRUCTION)	E	PLACE WHERE INDICATED, REPAIR OR REPLACE AS NECESSARY AND REMOVE ONLY WHEN GRADED AREAS HAVE SUFFICIENT GROUND COVER ESTABLISHED
		10	SEEDING AND MULCHING	E	ALL DISTURBED AREAS AFTER 14 DAYS OF CONSTRUCTION INACTIVITY
	E - UNTIL CLOSURE OF LAND DISTURBANCE PERMIT				ADDITIONAL SEDIMENT AND EROSION CONTROL MEASURES MAY BE REQUIRED ANY TIME CURRENT MEASURES ARE FOUND TO BE INEFFECTIVE.


DISTURBED AREA = 17.08 A.C.

SITE SPECIFIC NOTES:

- THE CONTRACTOR IS RESPONSIBLE FOR VERIFYING ALL EXISTING UTILITY LOCATIONS PRIOR TO EXCAVATION.
- THERE ARE NO WETLANDS, NATURAL OR ARTIFICIAL WATER STORAGE DETENTION AREAS IN THE PROJECT AREA.
- NO PART OF THE PROJECT LIES WITHIN THE 100 YEAR FLOOD PLAIN PER FEMA FLOOD INSURANCE RATE MAP NUMBER 29095C0412G DATED JANUARY 20, 2017.
- ALL EROSION AND SEDIMENTATION CONTROL MEASURES SHALL BE IMPLEMENTED ACCORDING TO THE BMP STAGING CHART.
- ADDITIONAL EROSION CONTROL MAY BE REQUIRED BY THE CITY ENGINEER AT ANY TIME EXISTING MEASURES ARE FOUND TO BE INEFFECTIVE OR PROBLEMATIC AREAS ARE NOTED IN THE FIELD.

- STABILIZATION OF DISTURBED AREAS MUST, AT A MINIMUM, BE INITIATED IMMEDIATELY WHENEVER ANY CLEARING, GRADING, EXCAVATING, OR OTHER SOIL DISTURBING ACTIVITIES HAVE PERMANENTLY CEASED ON ANY PORTION OF THE SITE, OR TEMPORARILY CEASED ON ANY PORTION OF THE SITE AND WILL NOT RESUME FOR A PERIOD EXCEEDING 14 CALENDAR DAYS. THE DISTURBED AREAS SHALL BE PROTECTED FROM EROSION BY STABILIZING THE AREA WITH MULCH OR OTHER SIMILARLY EFFECTIVE SOIL STABILIZING BMP'S. INITIAL STABILIZATION ACTIVITIES MUST BE COMPLETED WITHIN 14 DAYS AFTER SOIL DISTURBING ACTIVITIES CEASE.
- ALL PERIMETER SILT FENCE, EARTH DIKES, SEDIMENT BASINS, AND ROCK CONSTRUCTION ENTRANCES WILL BE INSTALLED BEFORE GRADING OPERATIONS BEGIN.
- SILT FENCE AND EARTH DIKES THAT ARE PLACED BEFORE GRADING BEGINS WILL BE MAINTAINED BY THE GRADING CONTRACTOR.
- AREAS WITHIN PUBLIC RIGHT-OF-WAY SHALL BE SODDED IMMEDIATELY AFTER CONSTRUCTION IS COMPLETE.

Record Drawing

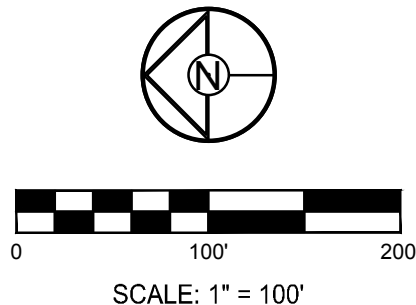





CONFORMING TO CONSTRUCTION RECORDS AS FURNISHED BY OTHERS.

KSC 7-23-19
BY DATE

REVISION DATE	DESCRIPTION
06/04/2018	CITY COMMENTS
07/30/2018	CITY COMMENTS
08/28/2018	CITY COMMENTS/SHPO FINDINGS
08/27/2019	REVISE STREET NAMES
8/29/2019	REVISE RETAINING WALLS

DRAWN BY:	KSC
CHECKED BY:	MAB
DATE PREPARED:	4-23-18
PROJ. NUMBER:	17-134

ECP-CONSTRUCTION PLAN

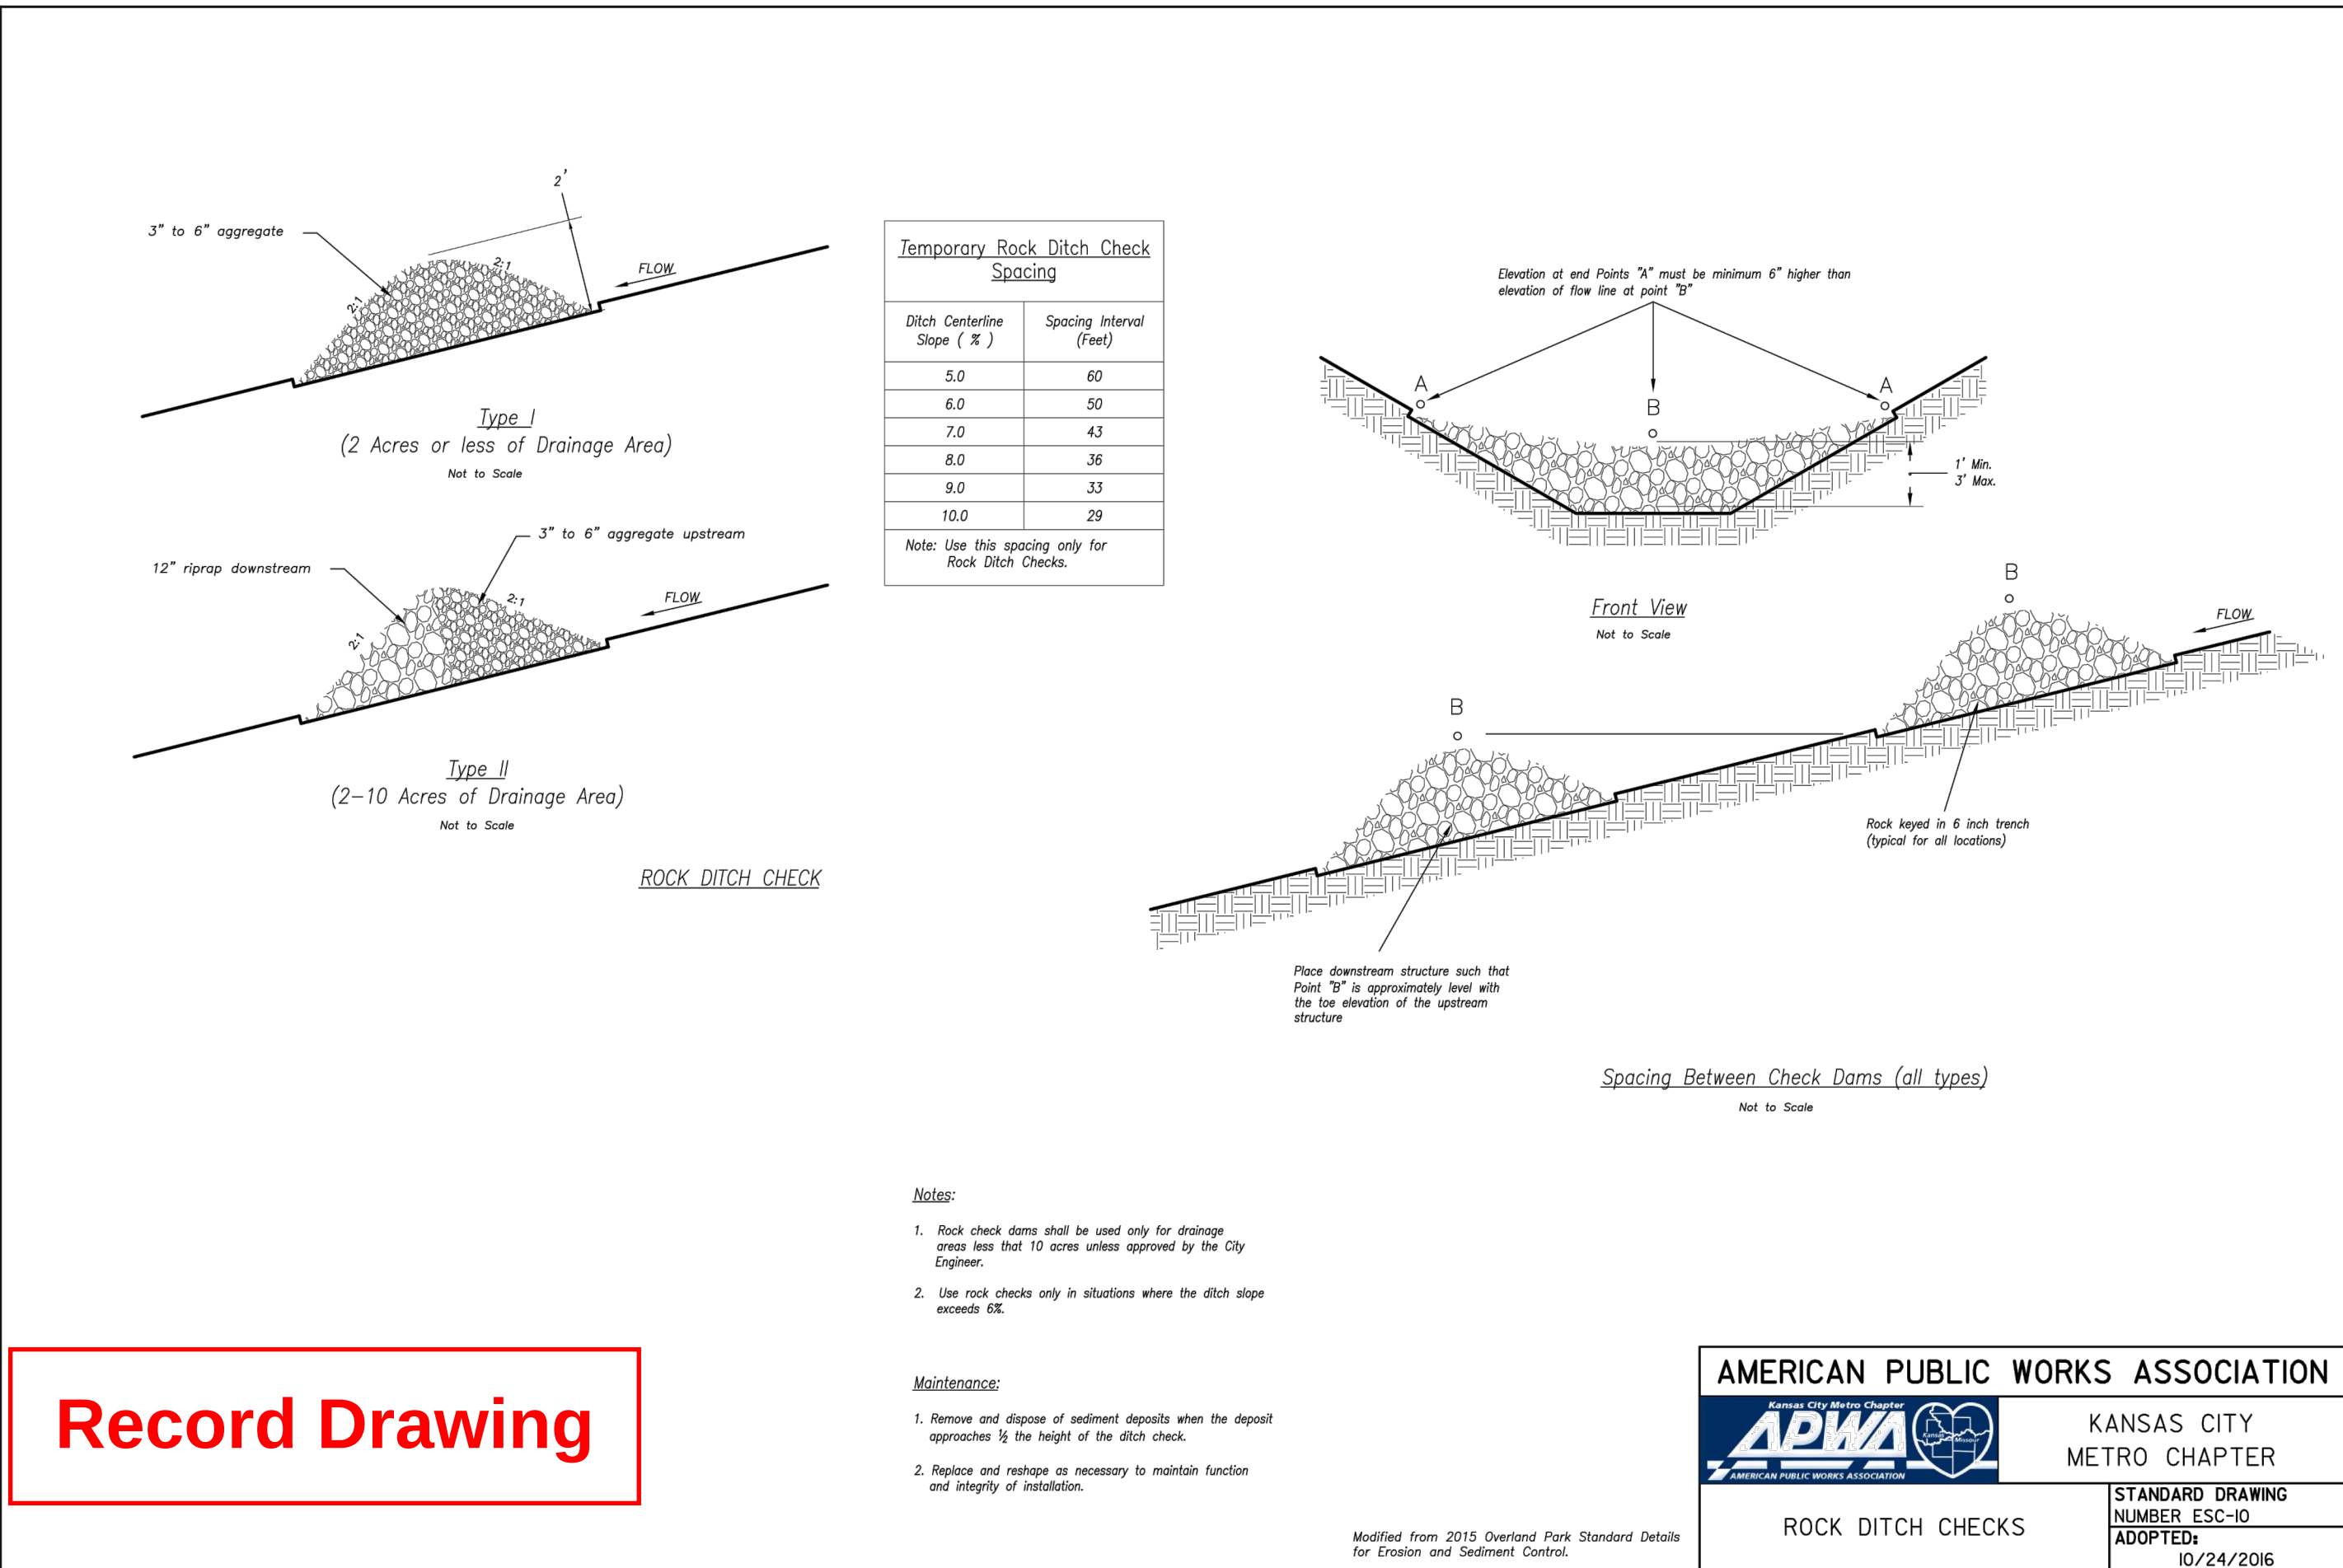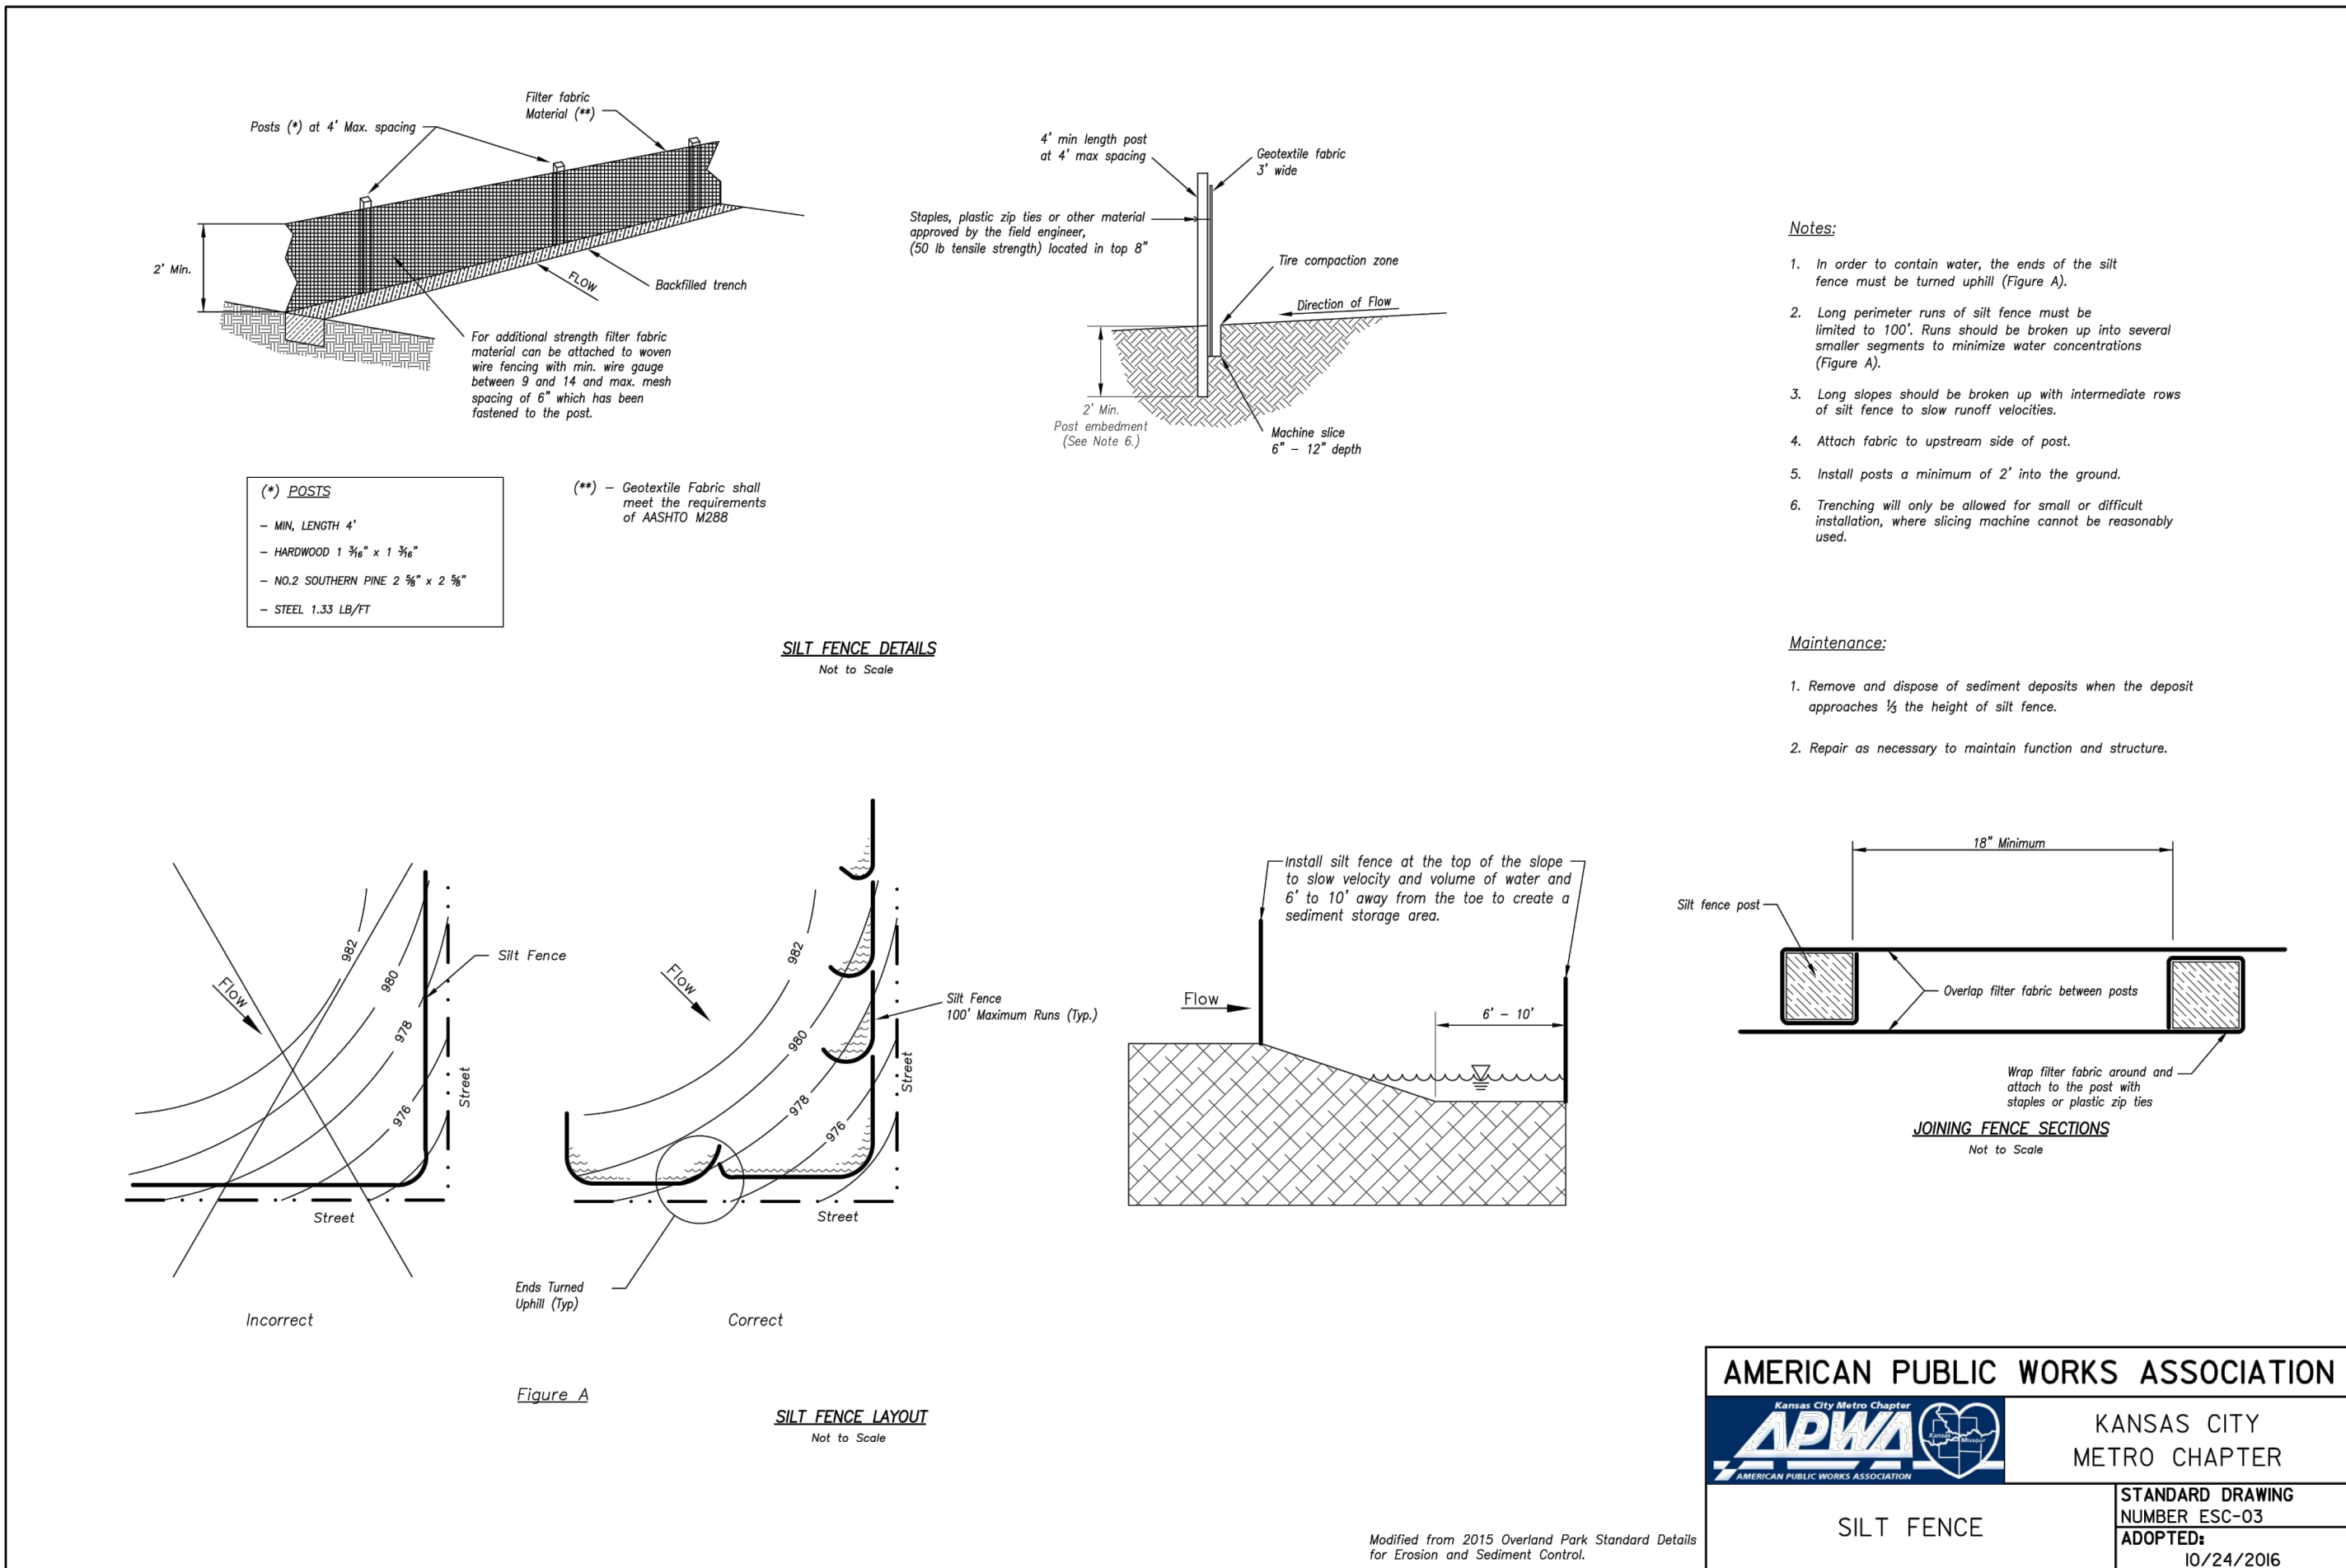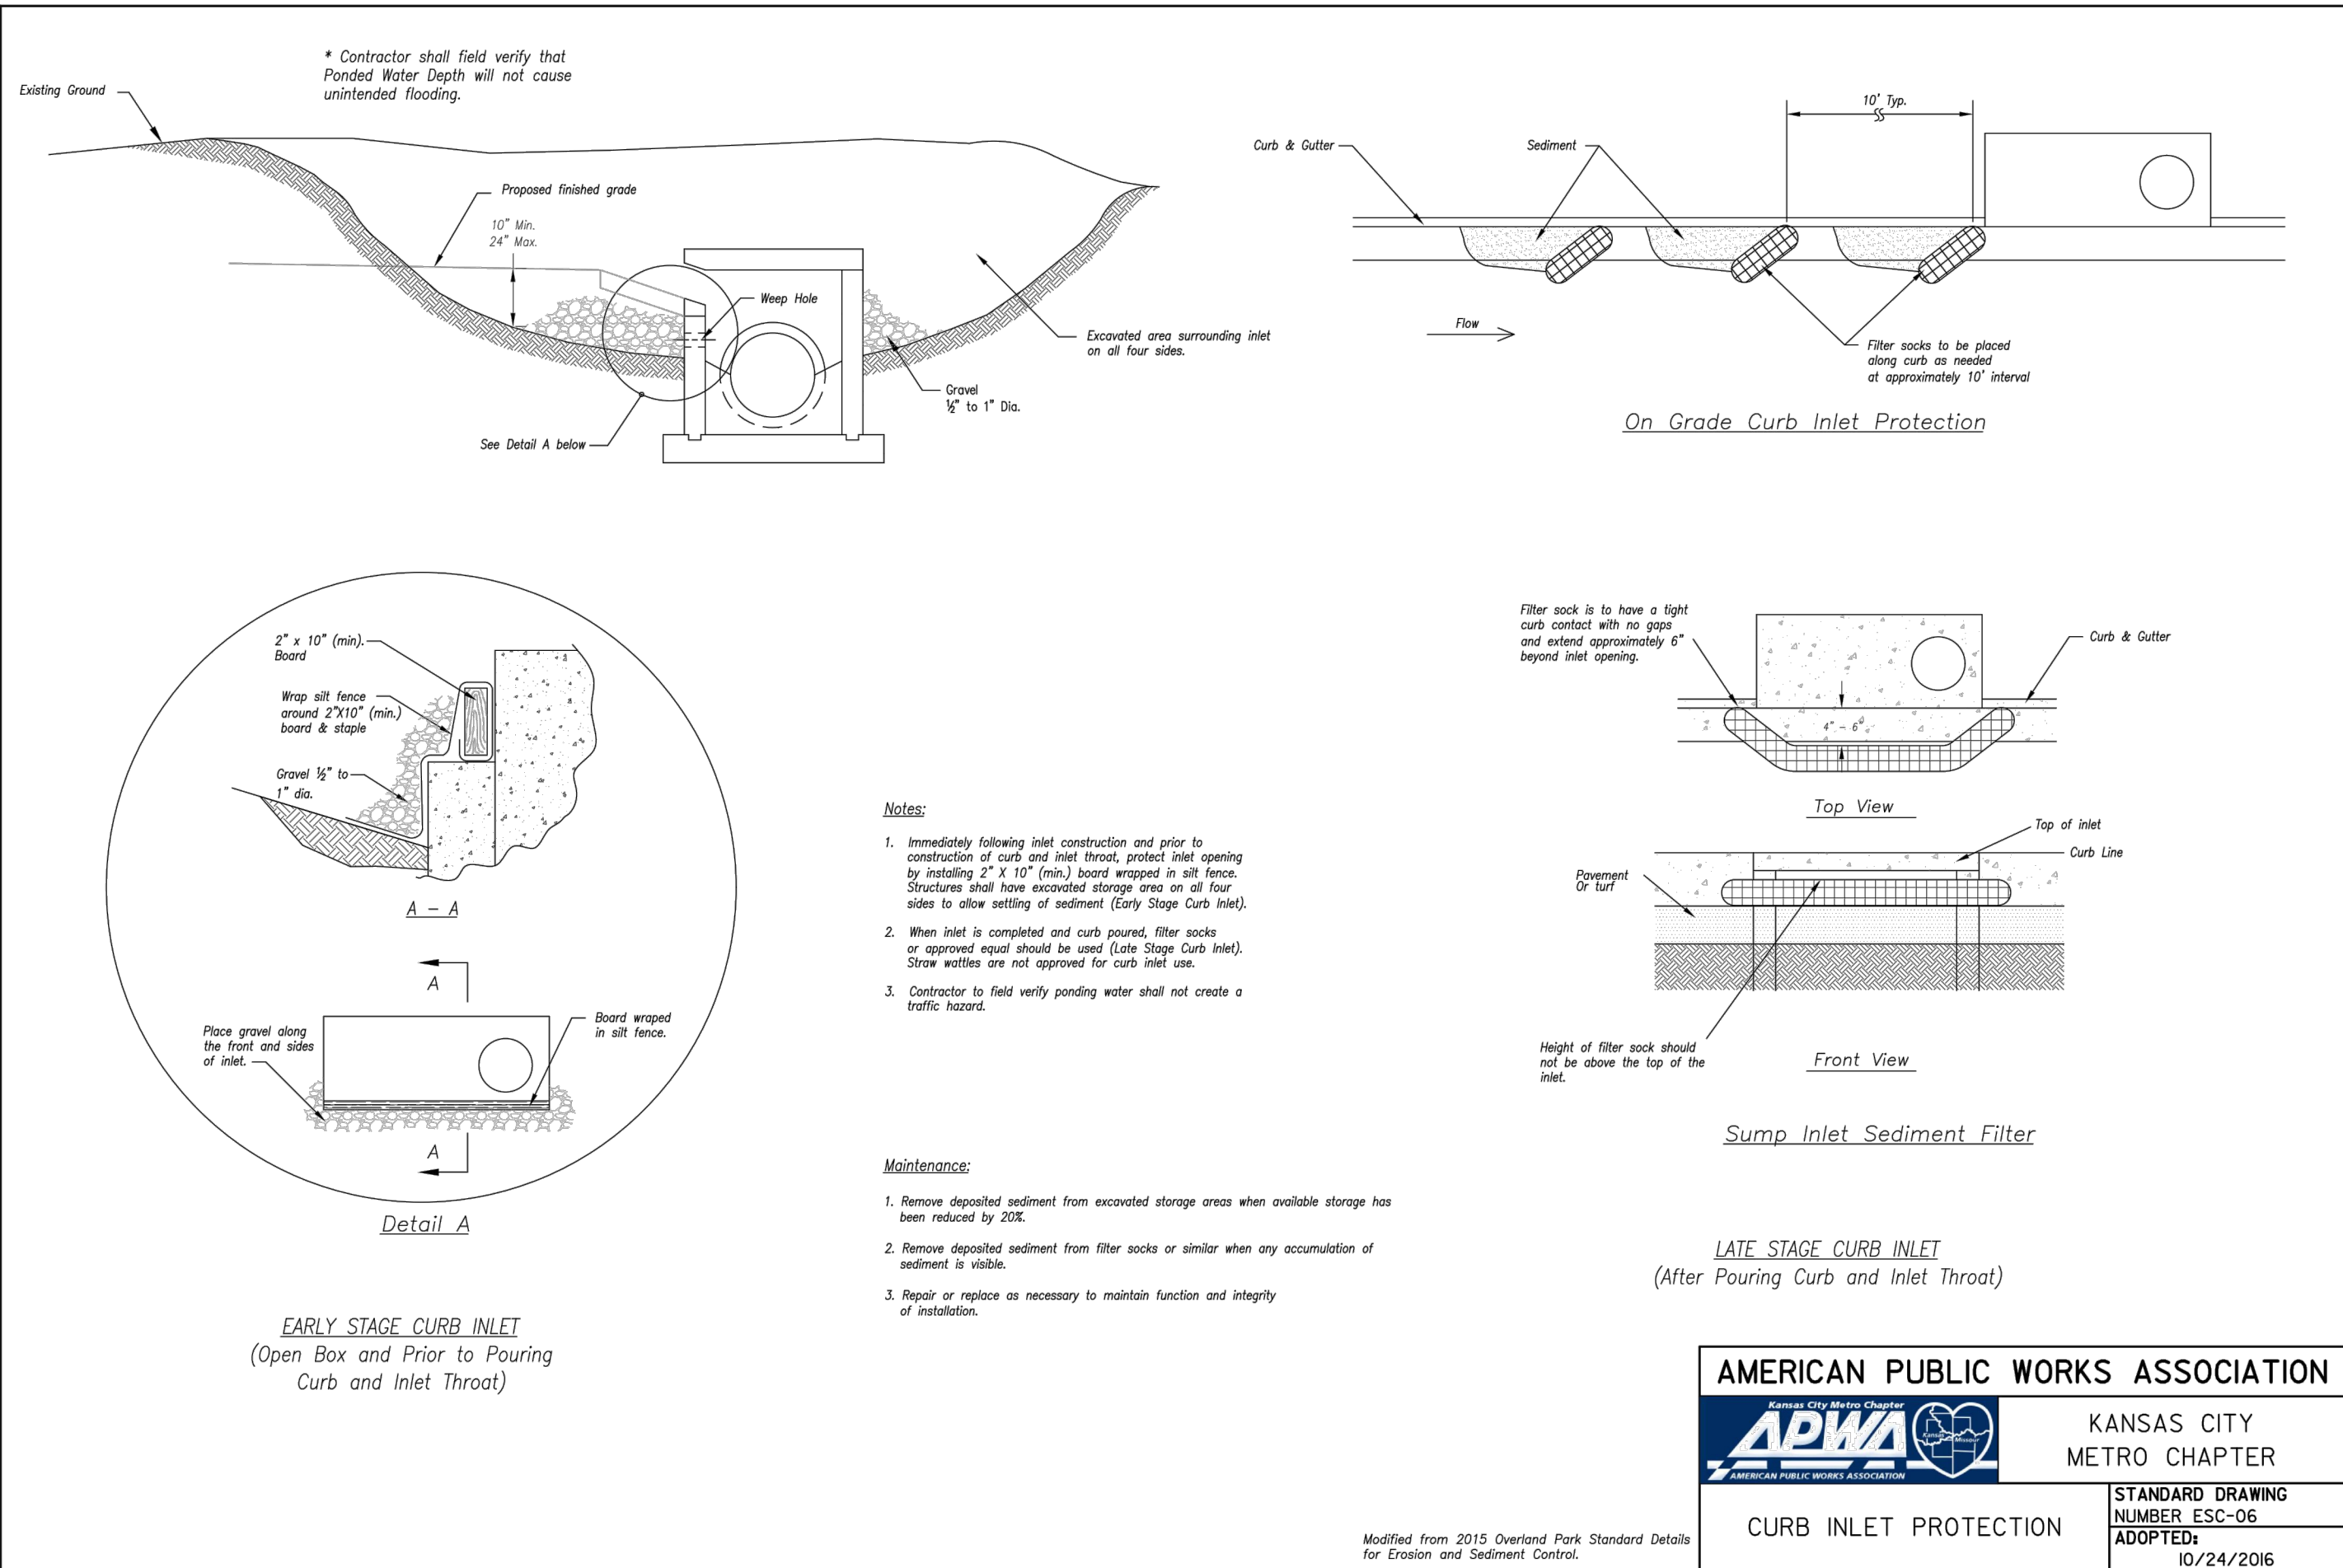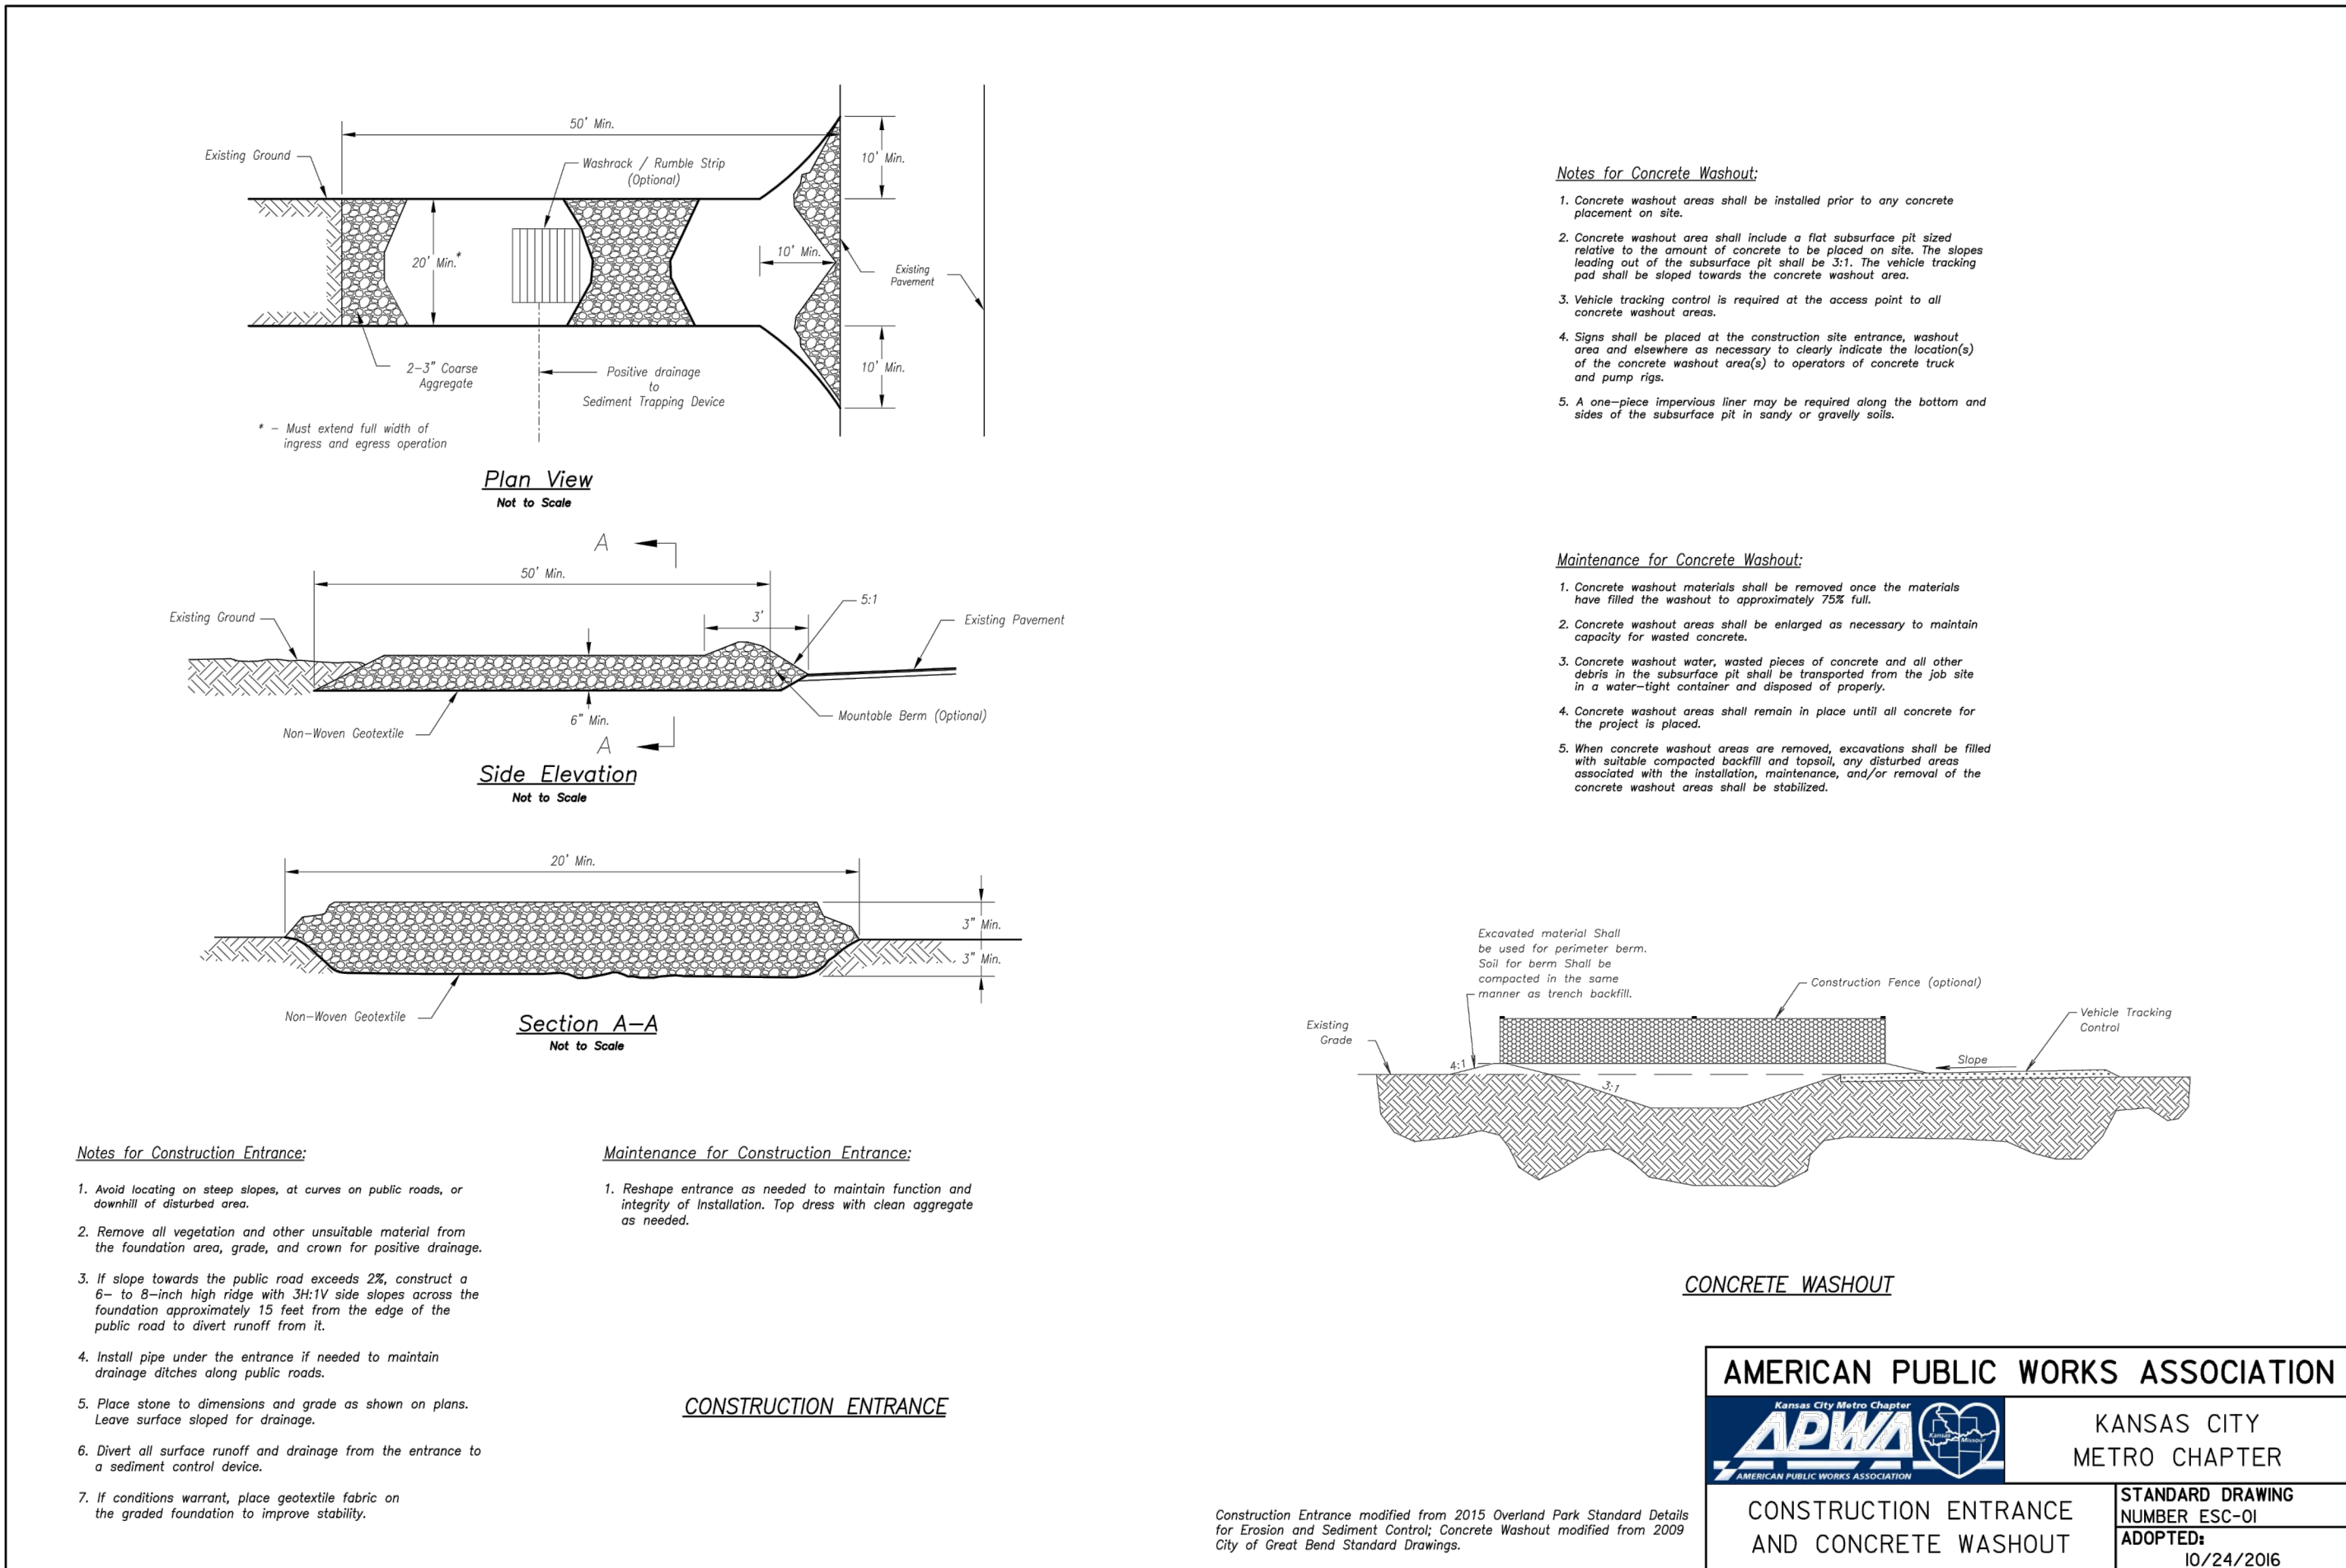



Record Drawing

CONFORMING TO CONSTRUCTION RECORDS AS FURNISHED BY OTHERS.

KSC 7-23-19
BY DATE

REVISION DATE	DESCRIPTION
06/04/2018	CITY COMMENTS
07/30/2018	CITY COMMENTS
08/28/2018	CITY COMMENTS/SHPO FINDINGS
08/27/2019	REVISE STREET NAMES
8/29/2019	REVISE RETAINING WALLS
4/20/18	PROJ. NUMBER:
17-134	


EROSION CONTROL DETAILS

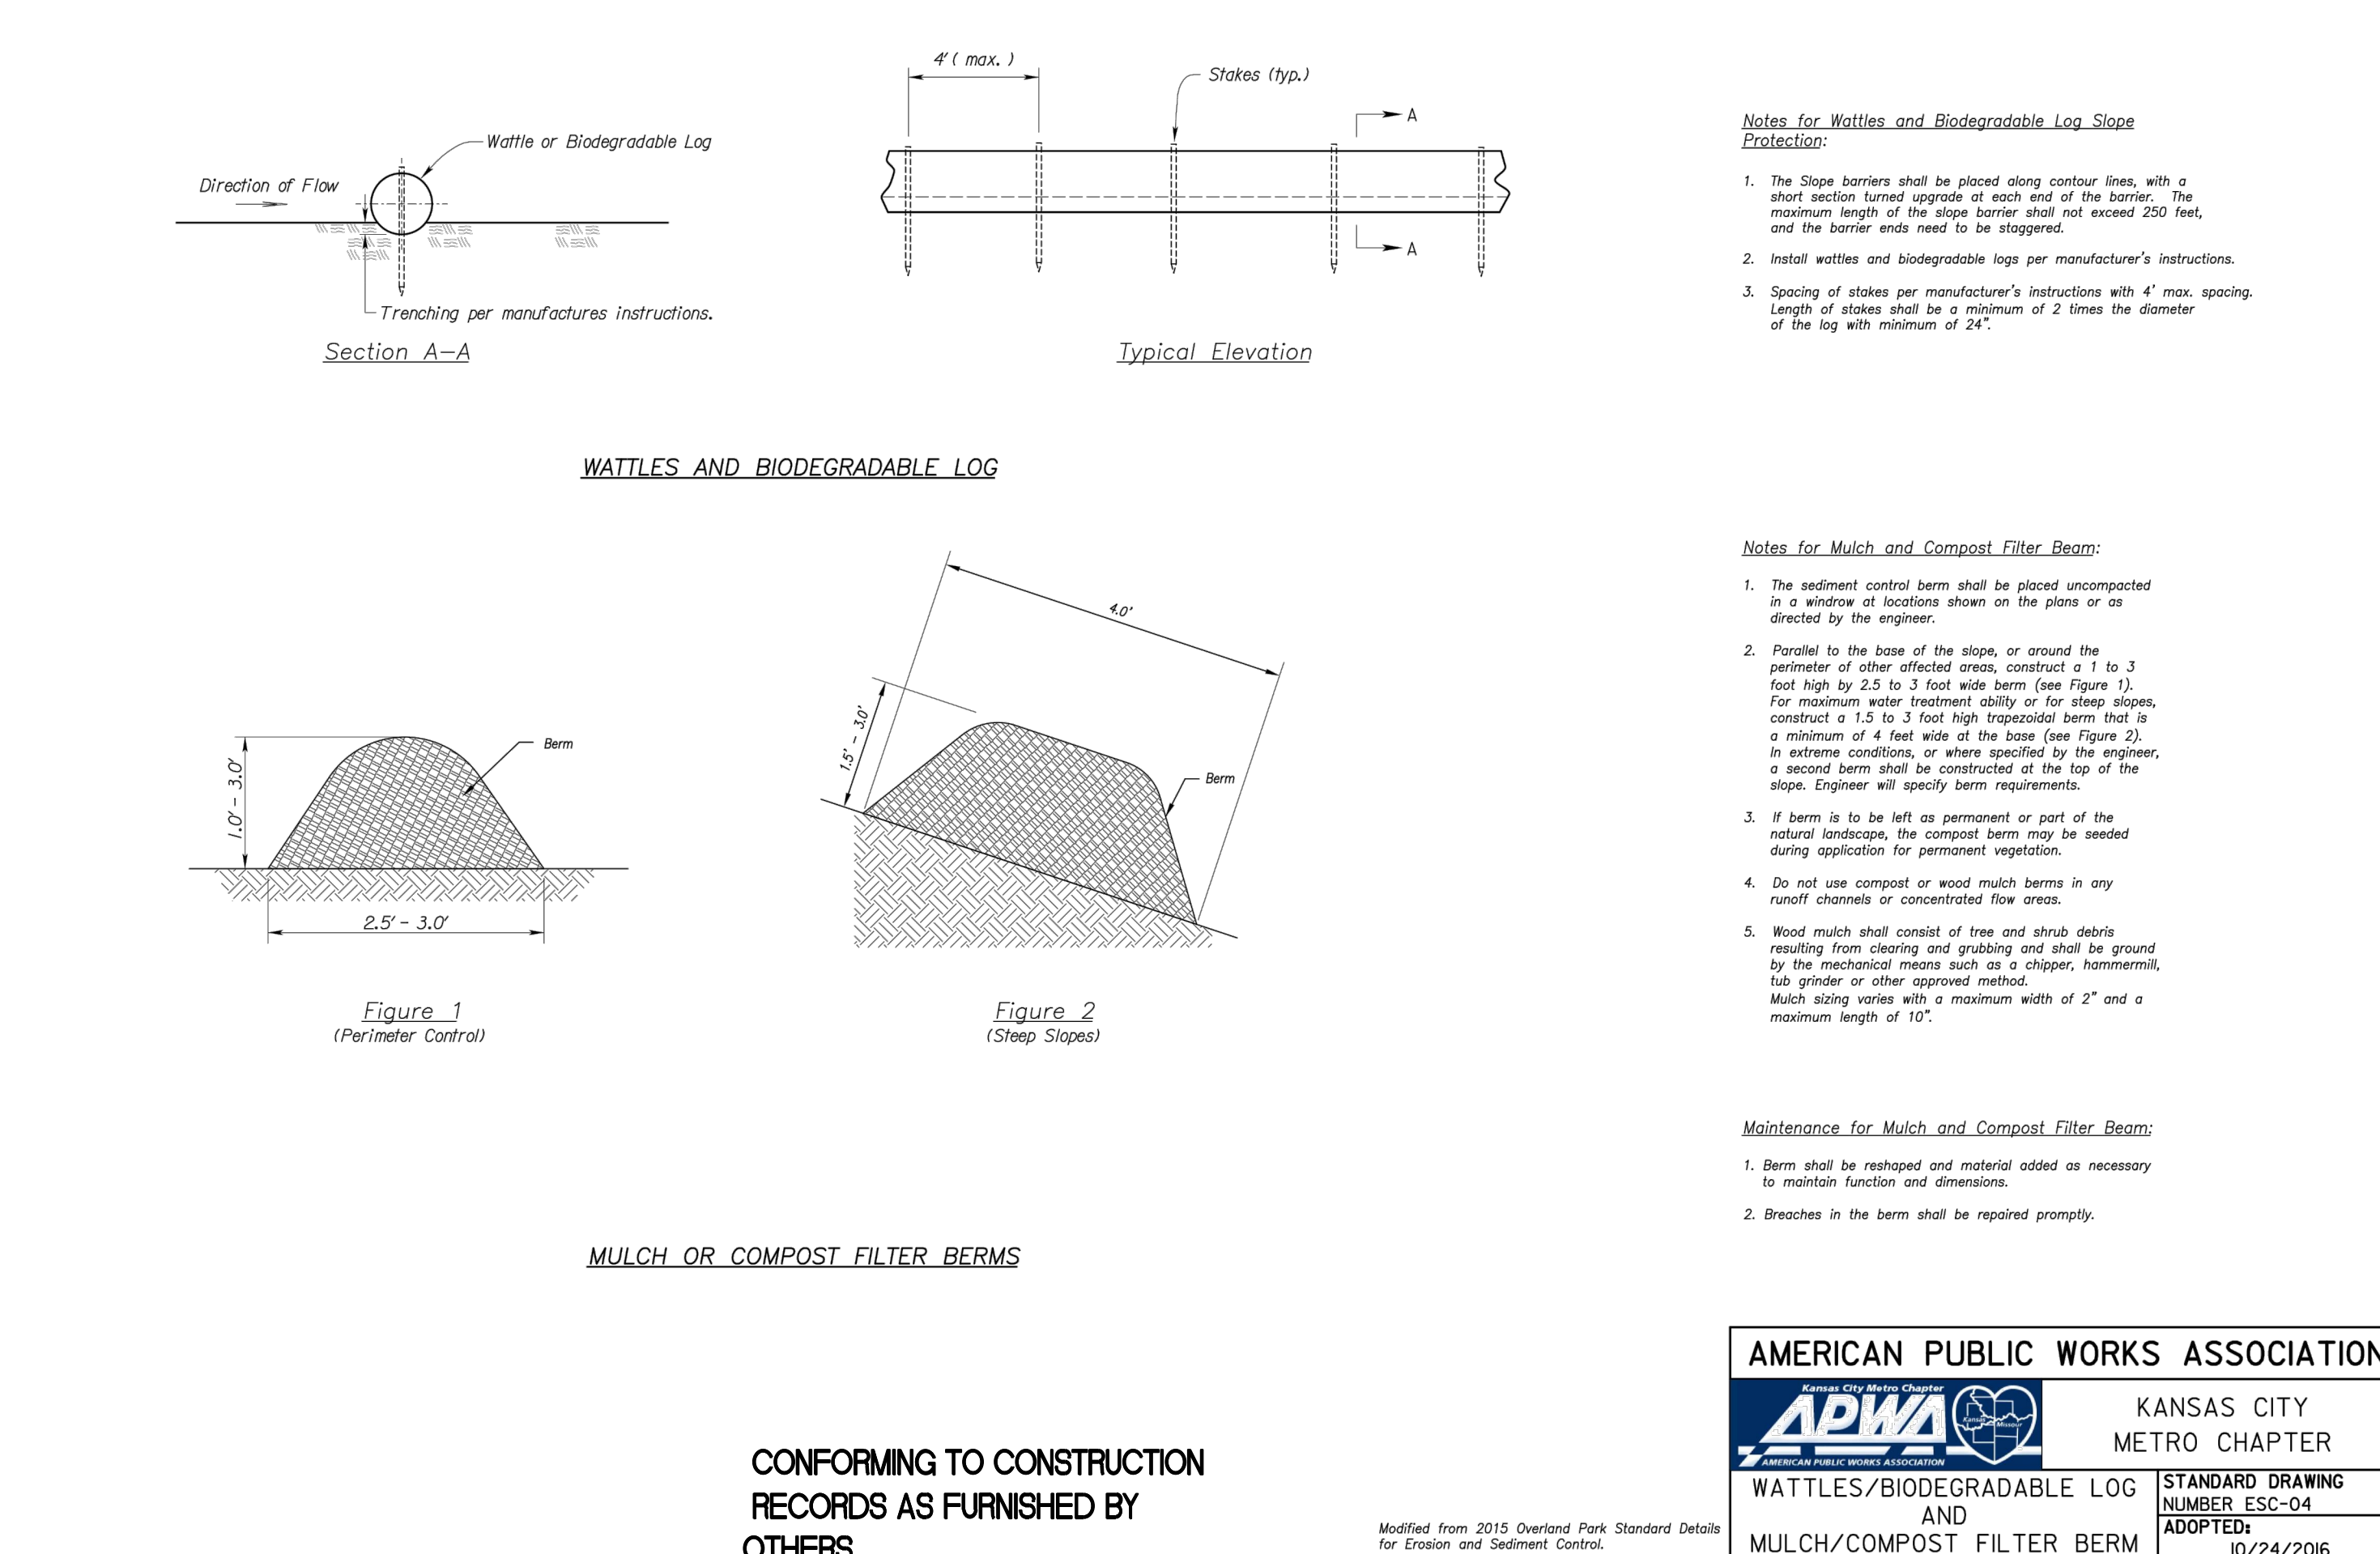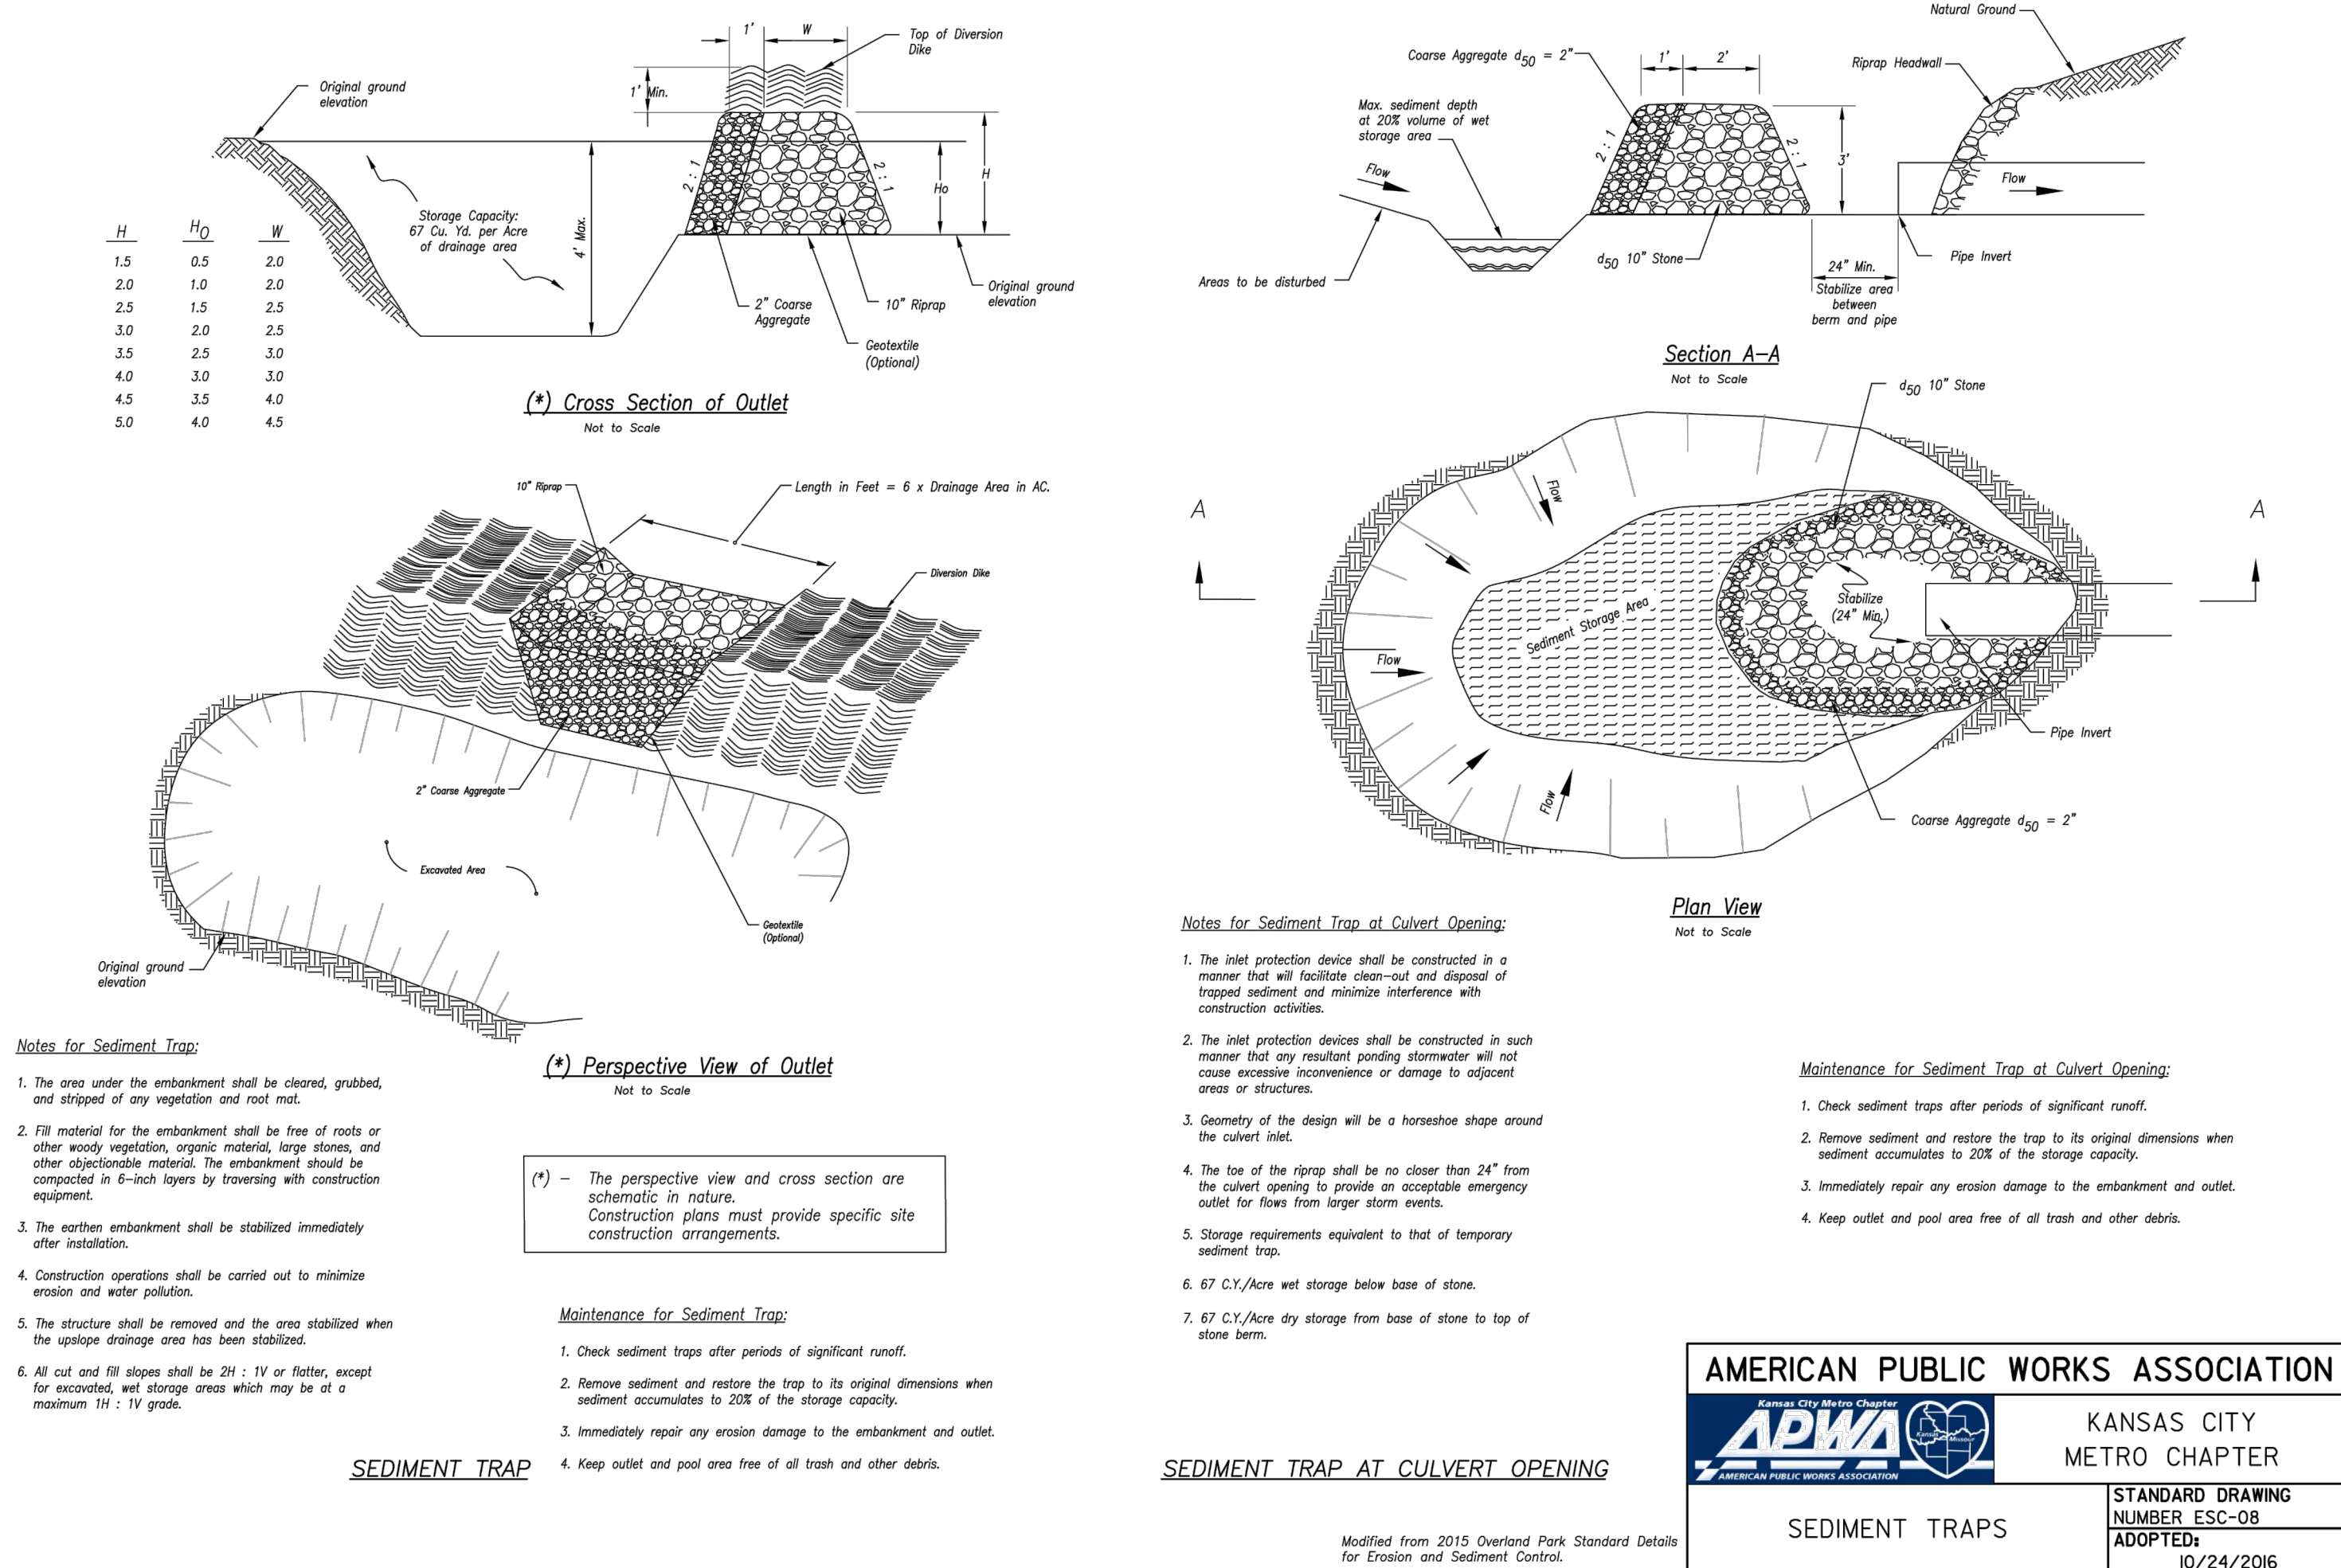

I:\PROJECTS\2021\17-1943-0 Design\3.0 DWG Plans\6.0 SS\17-134-SS-GP GL AND MDP rev 6-26-19.dwg, 10/23/2019 11:45:19 AM, 1:1




Record Drawing

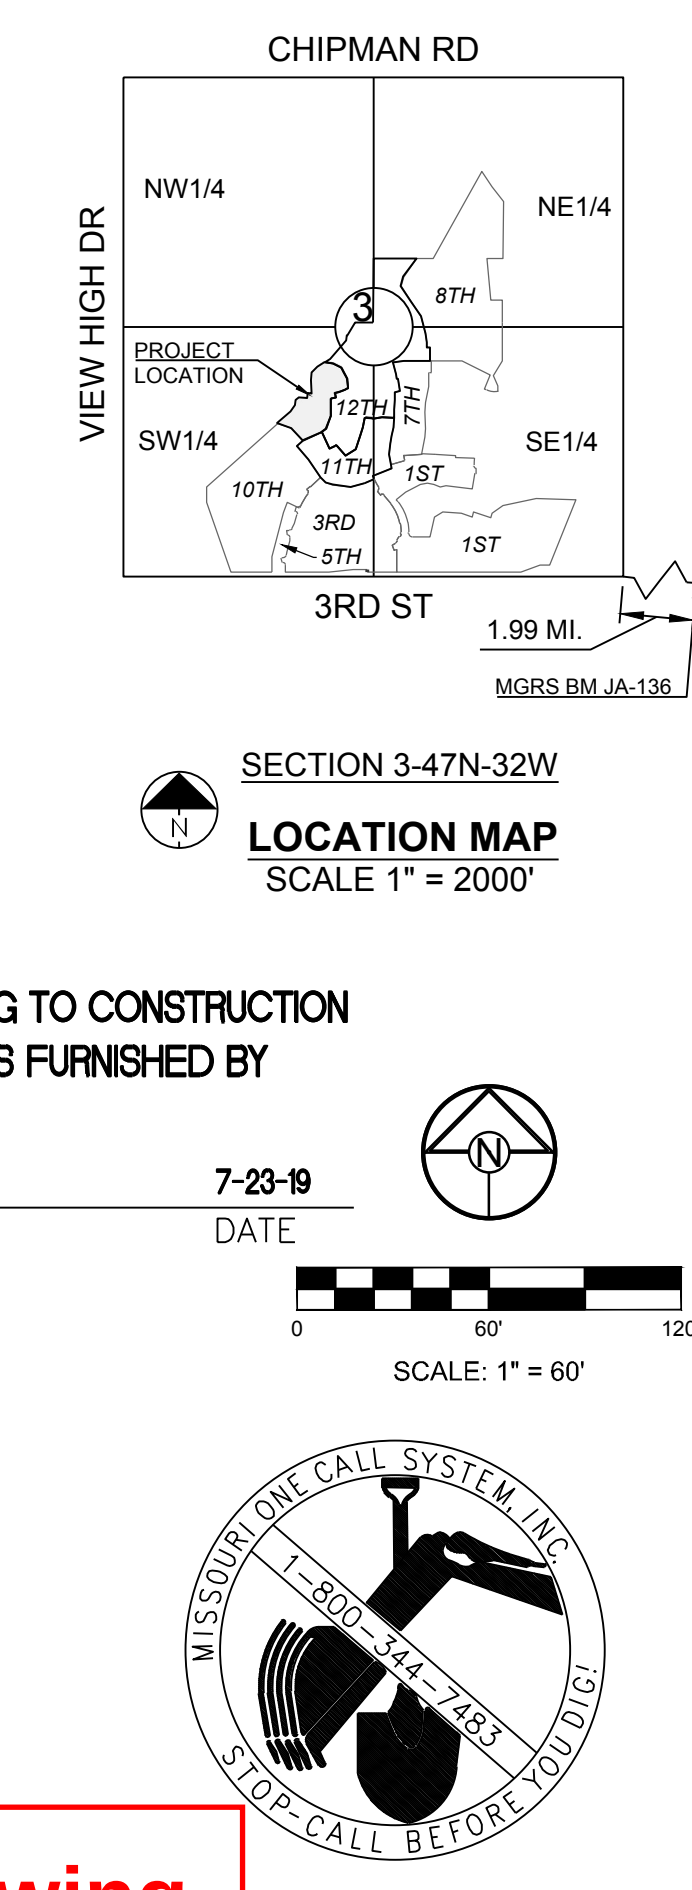

CONFORMING TO CONSTRUCTION RECORDS AS FURNISHED BY OTHERS.

KBC BY 7-23-19 DATE

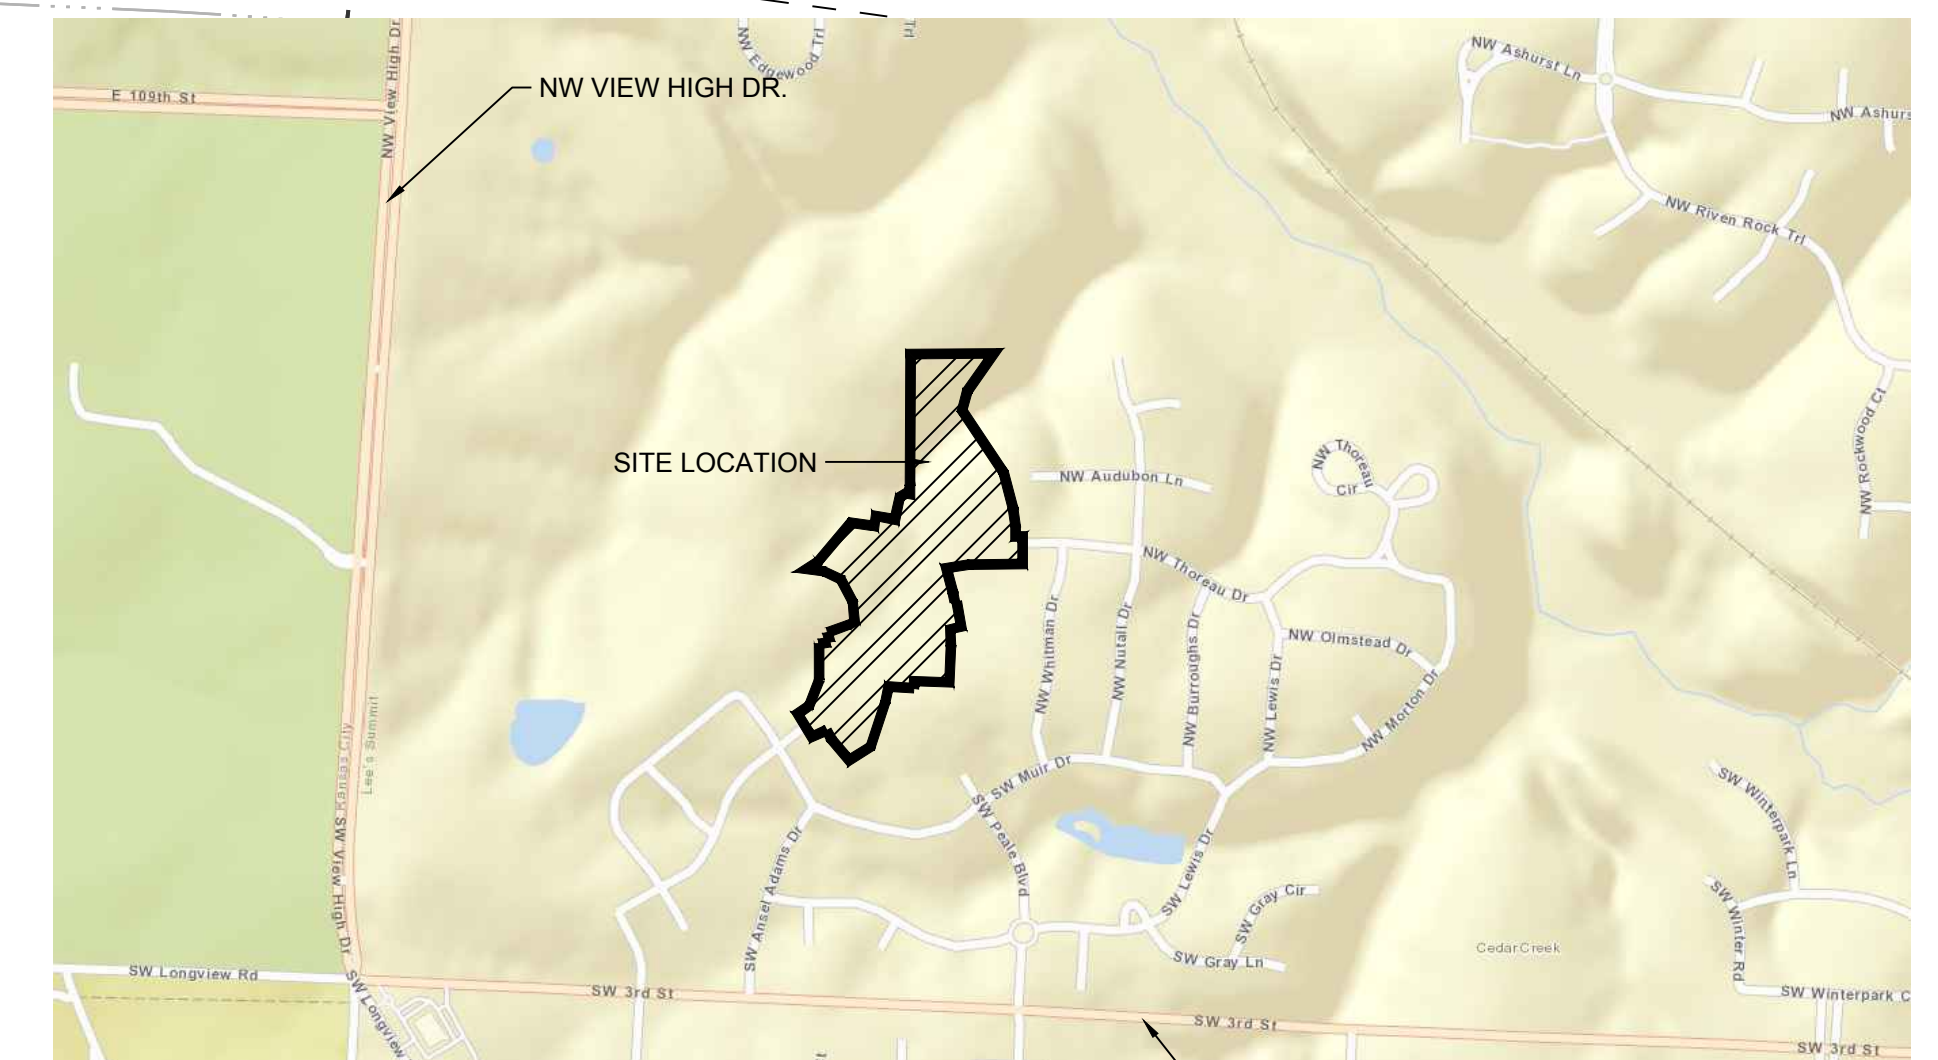

SITE MAP NOT TO SCALE

— DENOTES SIDEWALK TO BE BUILT BY STREET CONTRACTOR
— DENOTES RETAINING WALL

MISSOURI GEOGRAPHIC REFERENCE SYSTEM BENCH MARK:

BM JA-136, LOCATED AT INTERSECTION OF SW OLDHAM PARKWAY AND SW WARD ROAD, 61 FT SOUTH OF CL OF OLDHAM PARKWAY AND 28.9 FT EAST OF THE EAST EDGE OF WARD ROAD.

ELEV. 993.11'

PROJECT BENCH MARK:

SANITARY MANHOLE H2 AT NW CORNER OF LOT 1153 WINTERSET VALLEY 1ST PLAT, APPROX. 39' RT. OF CL OF NW PEALE BLVD.
ELEV. 935.45'

SCHLAGEL & ASSOCIATES, P.A.
Engineers-Planners-Surveyors-Landscape Architects
14920 West 10th Street • Lenexa, Kansas 66215
(913) 492-5158 • Fax: (913) 492-8400
WWW.SCHLAGELASSOCIATES.COM
Missouri State Certificates of Authority
#E2002003600-F #LAC201003237 #LS200200859-F

WINTERSET VALLEY, 12TH PLAT
STREET, STORMWATER, MASTER DRAINAGE PLAN AND
EROSION AND SEDIMENT CONTROL
AUDUBON LANE AND CARSON DRIVE
LEE'S SUMMIT, MO


REVISION DATE	DESCRIPTION
06/04/2018	CITY COMMENTS
07/30/2018	CITY COMMENTS/SHPO FINDINGS
08/28/2018	CITY COMMENTS/SHPO FINDINGS
09/27/2019	REVISE STREET NAMES
6/26/2019	REVISE RETAINING WALLS
4/20/18	
PROJ. NUMBER:	17-134

GENERAL LAYOUT

SHEET

7

OF 25

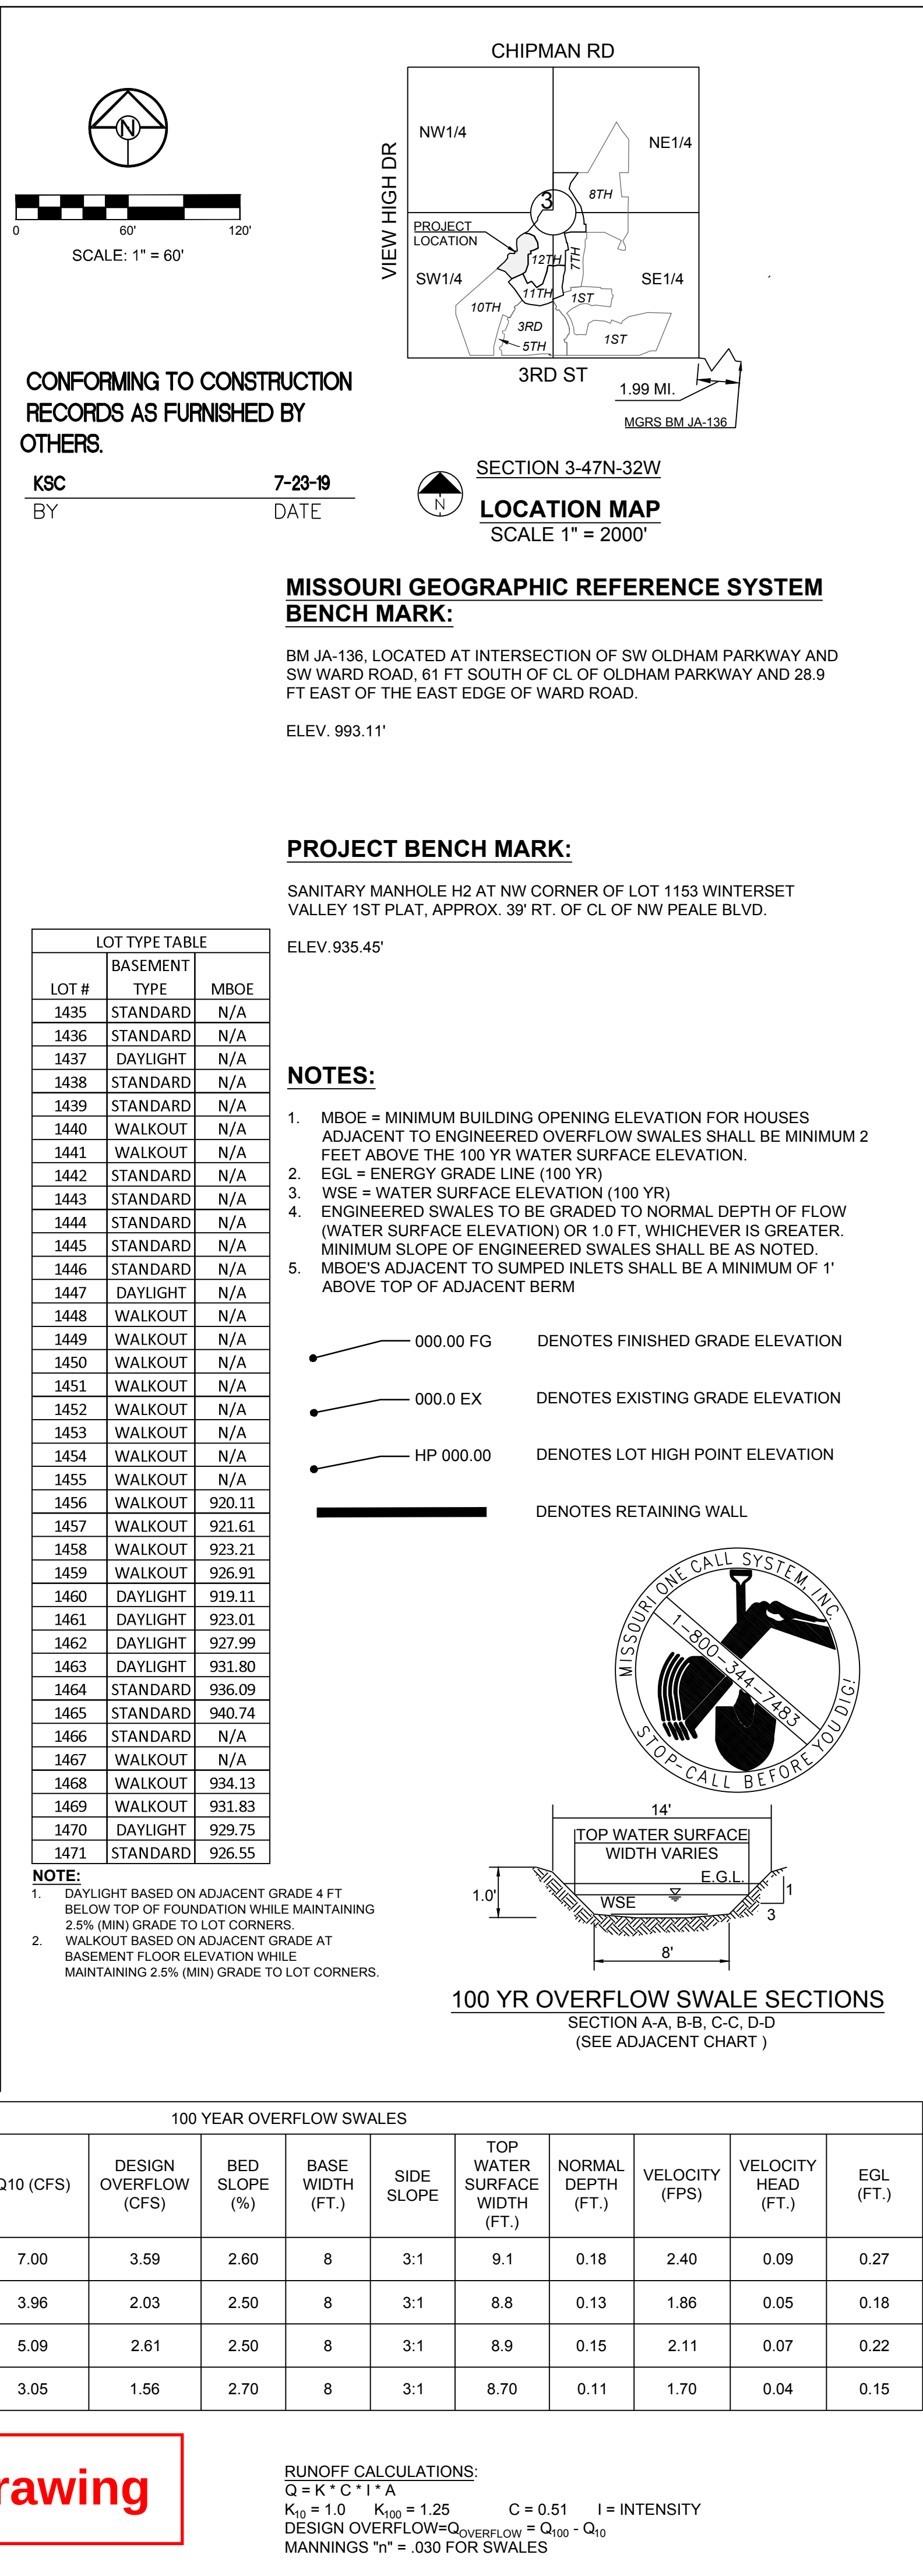

MASTER DRAINAGE PLAN - SPOT ELEVATIONS						SHEET	9	OF 25
DRAWN BY:	KAC	CITY COMMENTS	REVISION STREET NAMES	DATE PREPARED:	PROJ. NUMBER:			
1.	08/04/2018	CITY COMMENTS	1.	08/04/2018	1.			
2.	07/30/2018	CITY COMMENTS	2.	08/28/2018	2.			
3.	08/28/2018	CITY COMMENTS	3.	09/27/2019	3.			
4.	08/27/2019	REVISE RETAINING WALLS	4.	08/29/2019	4.			
5.			5.		5.			
6.			6.		6.			
7.			7.		7.			
8.			8.		8.			

WINTERSET VALLEY, 12TH PLAT
STREET, STORMWATER, MASTER DRAINAGE PLAN AND
EROSION AND SEDIMENT CONTROL

AUDUBON LANE AND CARSON DRIVE
LEE'S SUMMIT, MO



10.23.19

SCHLAGEL & ASSOCIATES, P.A.
Engineers • Planners • Surveyors • Landscape Architects
14920 West 107th Street • Lenexa, Kansas 66215
(913) 482-5158 • Fax: (913) 482-8400
WWW.SCHLAGELASOCIATES.COM
Missouri State Certificates of Authority
#E20020003800.F #IAC2001005237 #LIC20000859.F

9
OF 25



I:\PROJECTS\2017\17-1943\0 Design\3.0 DWG Plans\6.0 SS\17-134-SS-STREET PP.dwg, 10/23/2019 11:52:15 AM, 1:1

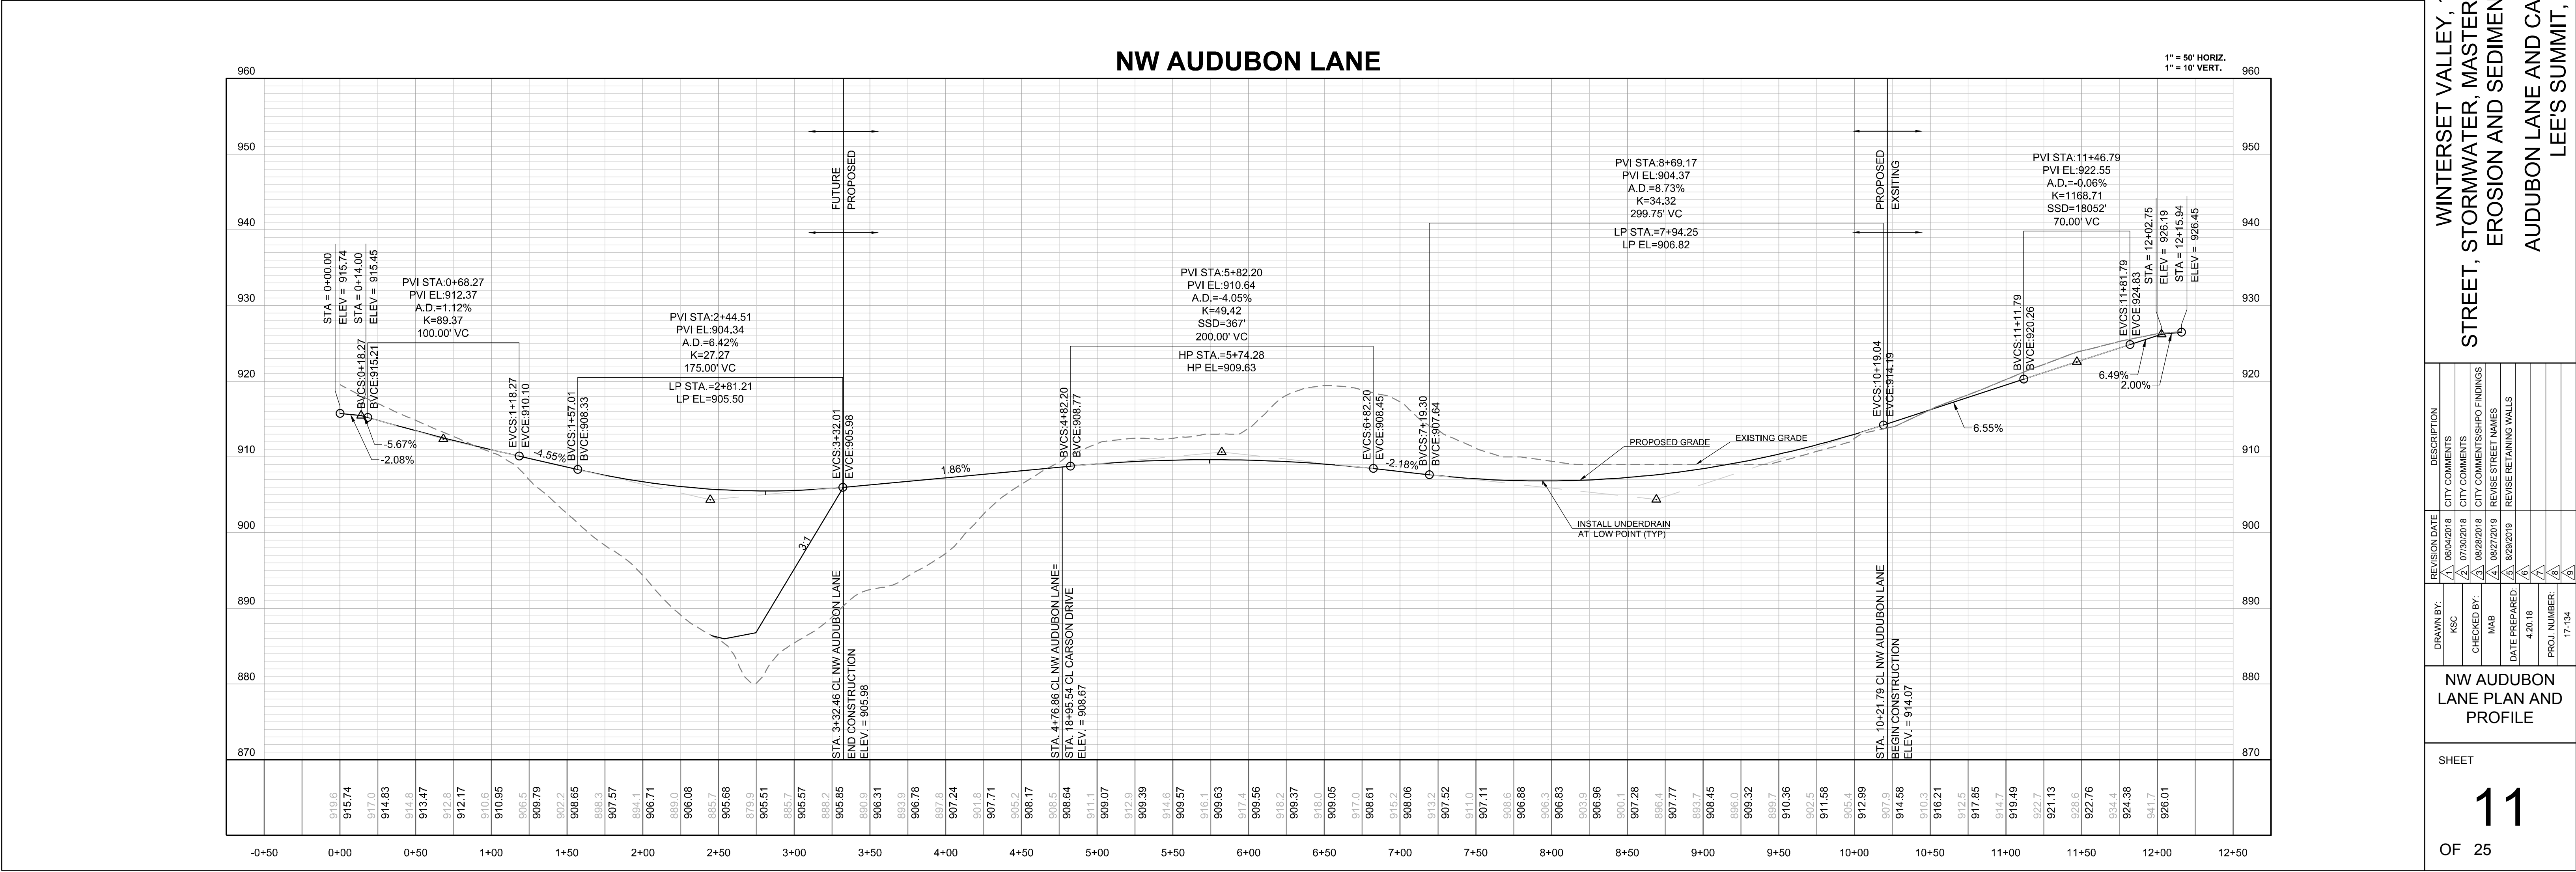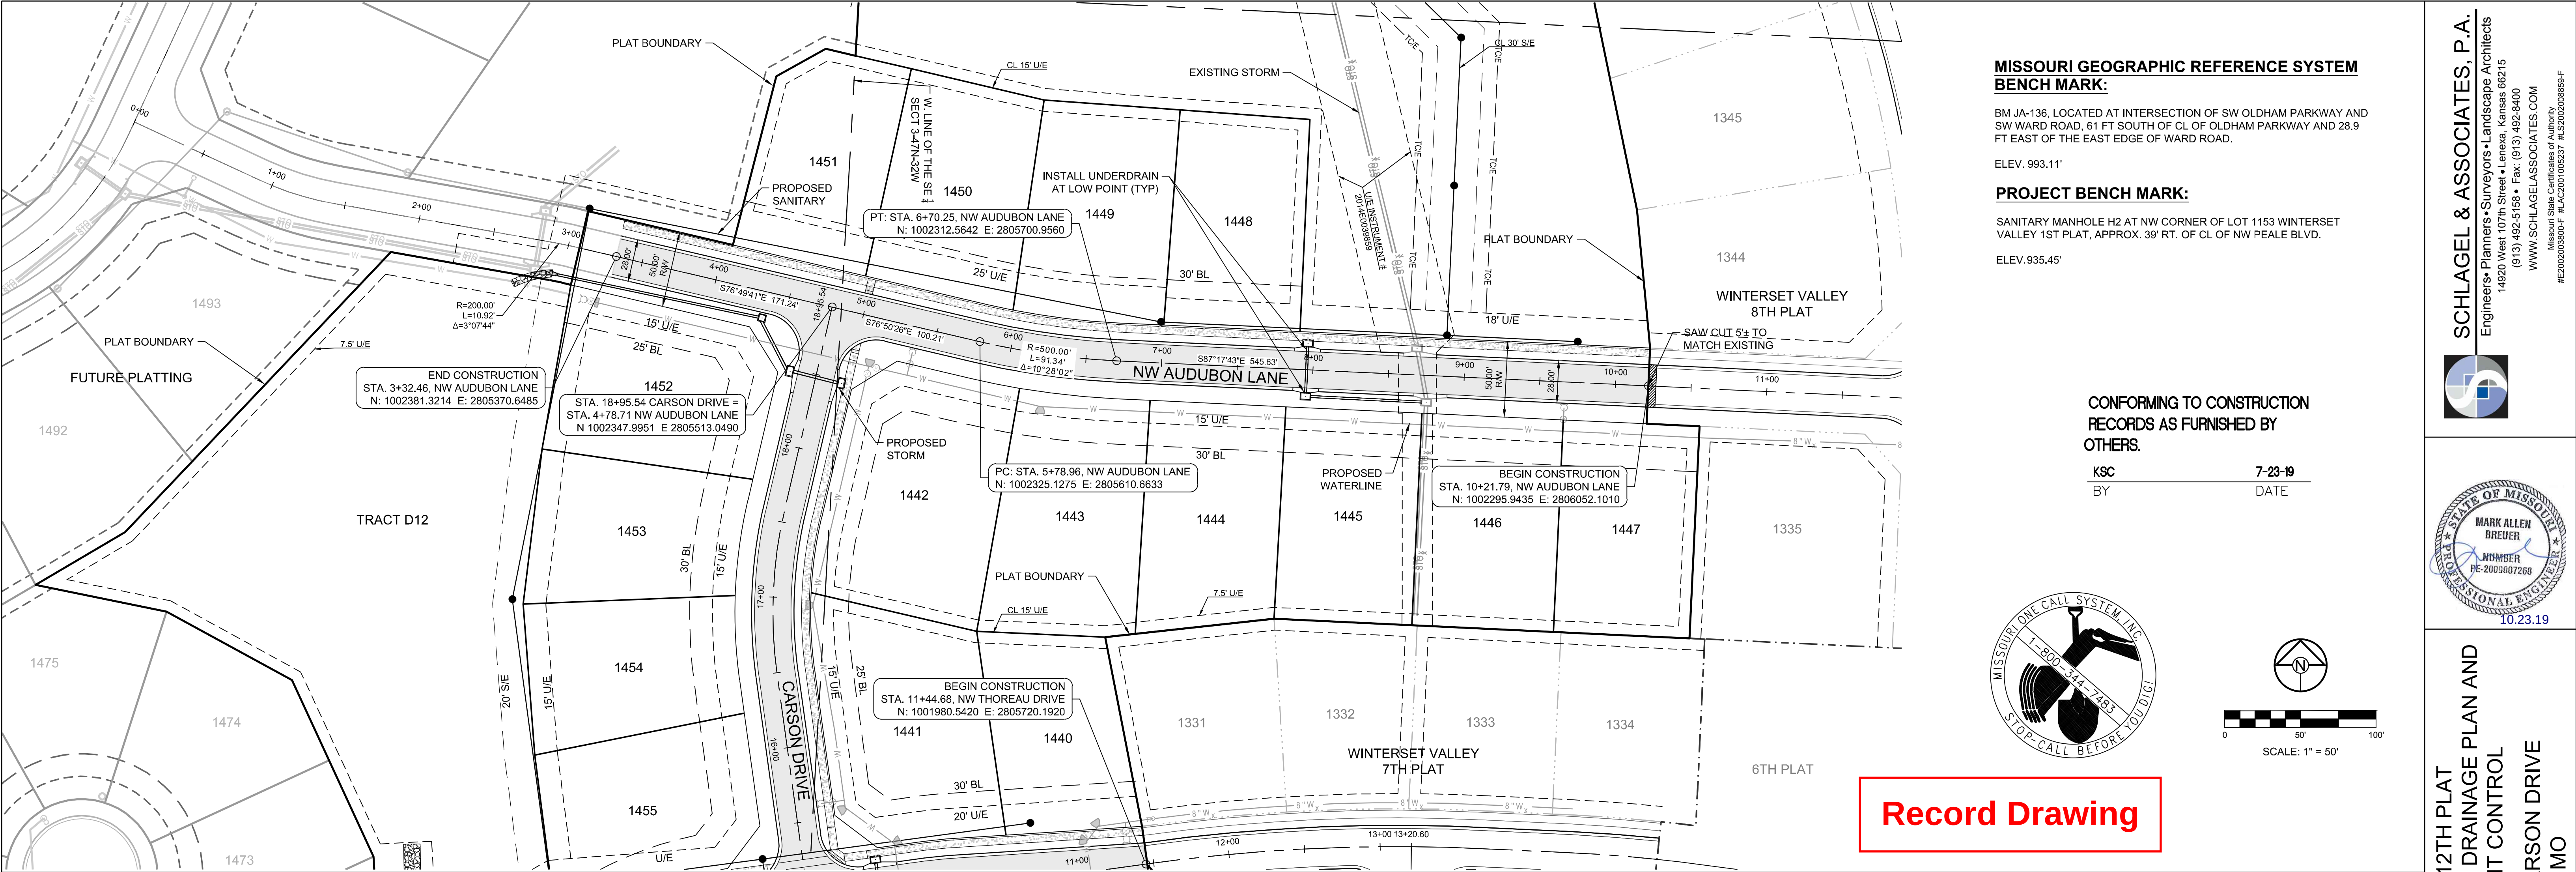

MISSOURI GEOGRAPHIC REFERENCE SYSTEM
BENCH MARK:

BM JA-136, LOCATED AT INTERSECTION OF SW OLDHAM PARKWAY AND SW WARD ROAD, 61 FT SOUTH OF CL OF OLDHAM PARKWAY AND 28.9 FT EAST OF THE EAST EDGE OF WARD ROAD.

ELEV. 993.11'


PROJECT BENCH MARK:

SANITARY MANHOLE H2 AT NW CORNER OF LOT 1153 WINTERSET VALLEY 1ST PLAT, APPROX. 39' RT. OF CL OF NW PEALE BLVD.

ELEV. 935.45'

CONFORMING TO CONSTRUCTION
RECORDS AS FURNISHED BY
OTHERS.

KSC 7-23-19
BY DATE

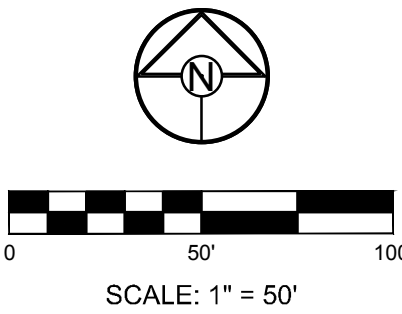

REVISION DATE	DESCRIPTION
06/04/2018	CITY COMMENTS
07/30/2018	CITY COMMENTS
08/28/2018	CITY COMMENTS/SHPO FINDINGS
09/27/2019	REVISE STREET NAMES
8/29/2019	REVISE RETAINING WALLS


DRAWN BY:	KSC
CHECKED BY:	MAB
DATE PREPARED:	4/20/18
PROJ. NUMBER:	17-134

NW THOREAU
DRIVE PLAN AND
PROFILE

SHEET

Record Drawing

NW THOREAU DRIVE

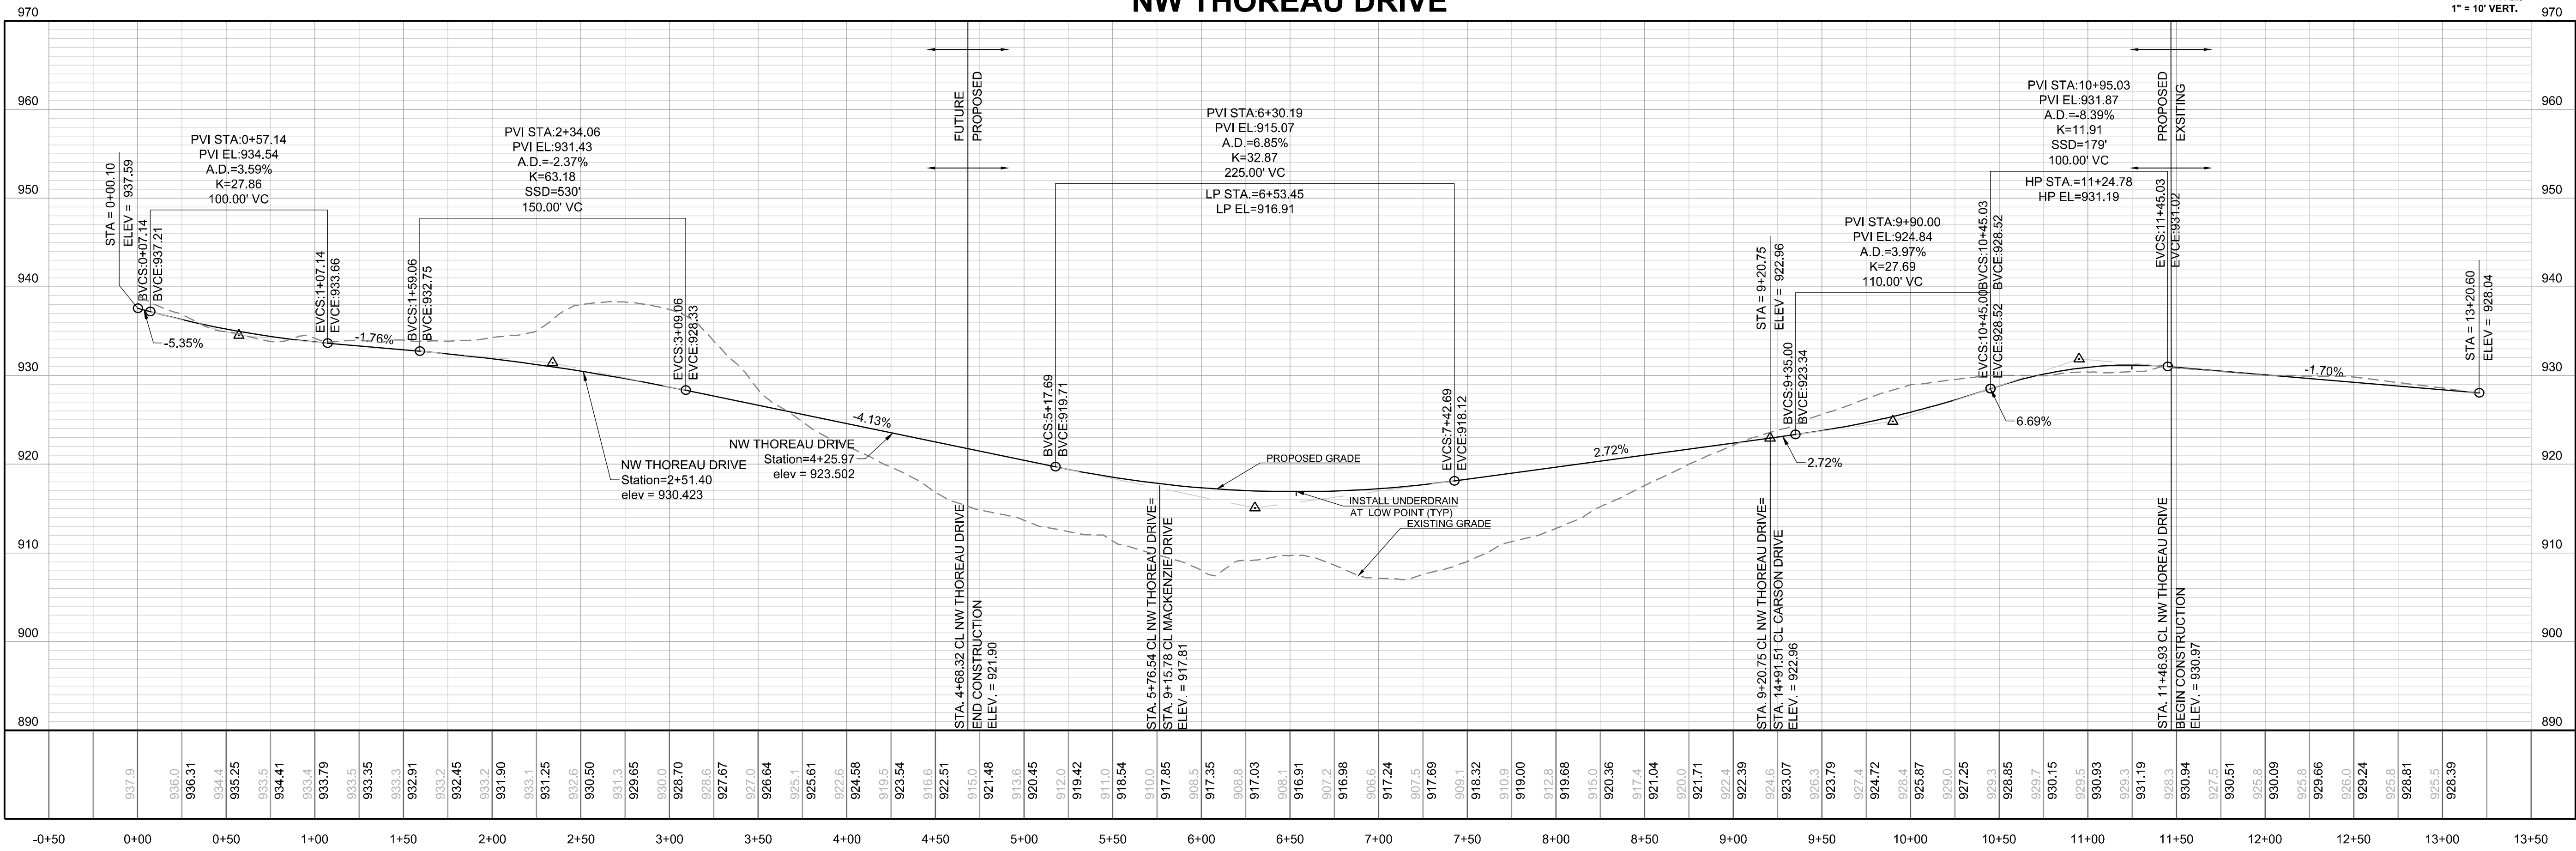

MISSOURI GEOGRAPHIC REFERENCE SYSTEM
BENCH MARK:

BM JA-136, LOCATED AT INTERSECTION OF SW OLDHAM PARKWAY AND SW WARD ROAD, 61 FT SOUTH OF CL OF OLDHAM PARKWAY AND 28.9 FT EAST OF THE EAST EDGE OF WARD ROAD.

ELEV. 993.11'



PROJECT BENCH MARK:

SANITARY MANHOLE H2 AT NW CORNER OF LOT 1153 WINTERSET VALLEY 1ST PLAT, APPROX. 39' RT. OF CL OF NW PEALE BLVD.

ELEV. 935.45'

CONFORMING TO CONSTRUCTION
RECORDS AS FURNISHED BY
OTHERS.


KSC
BY
7-23-19
DATE

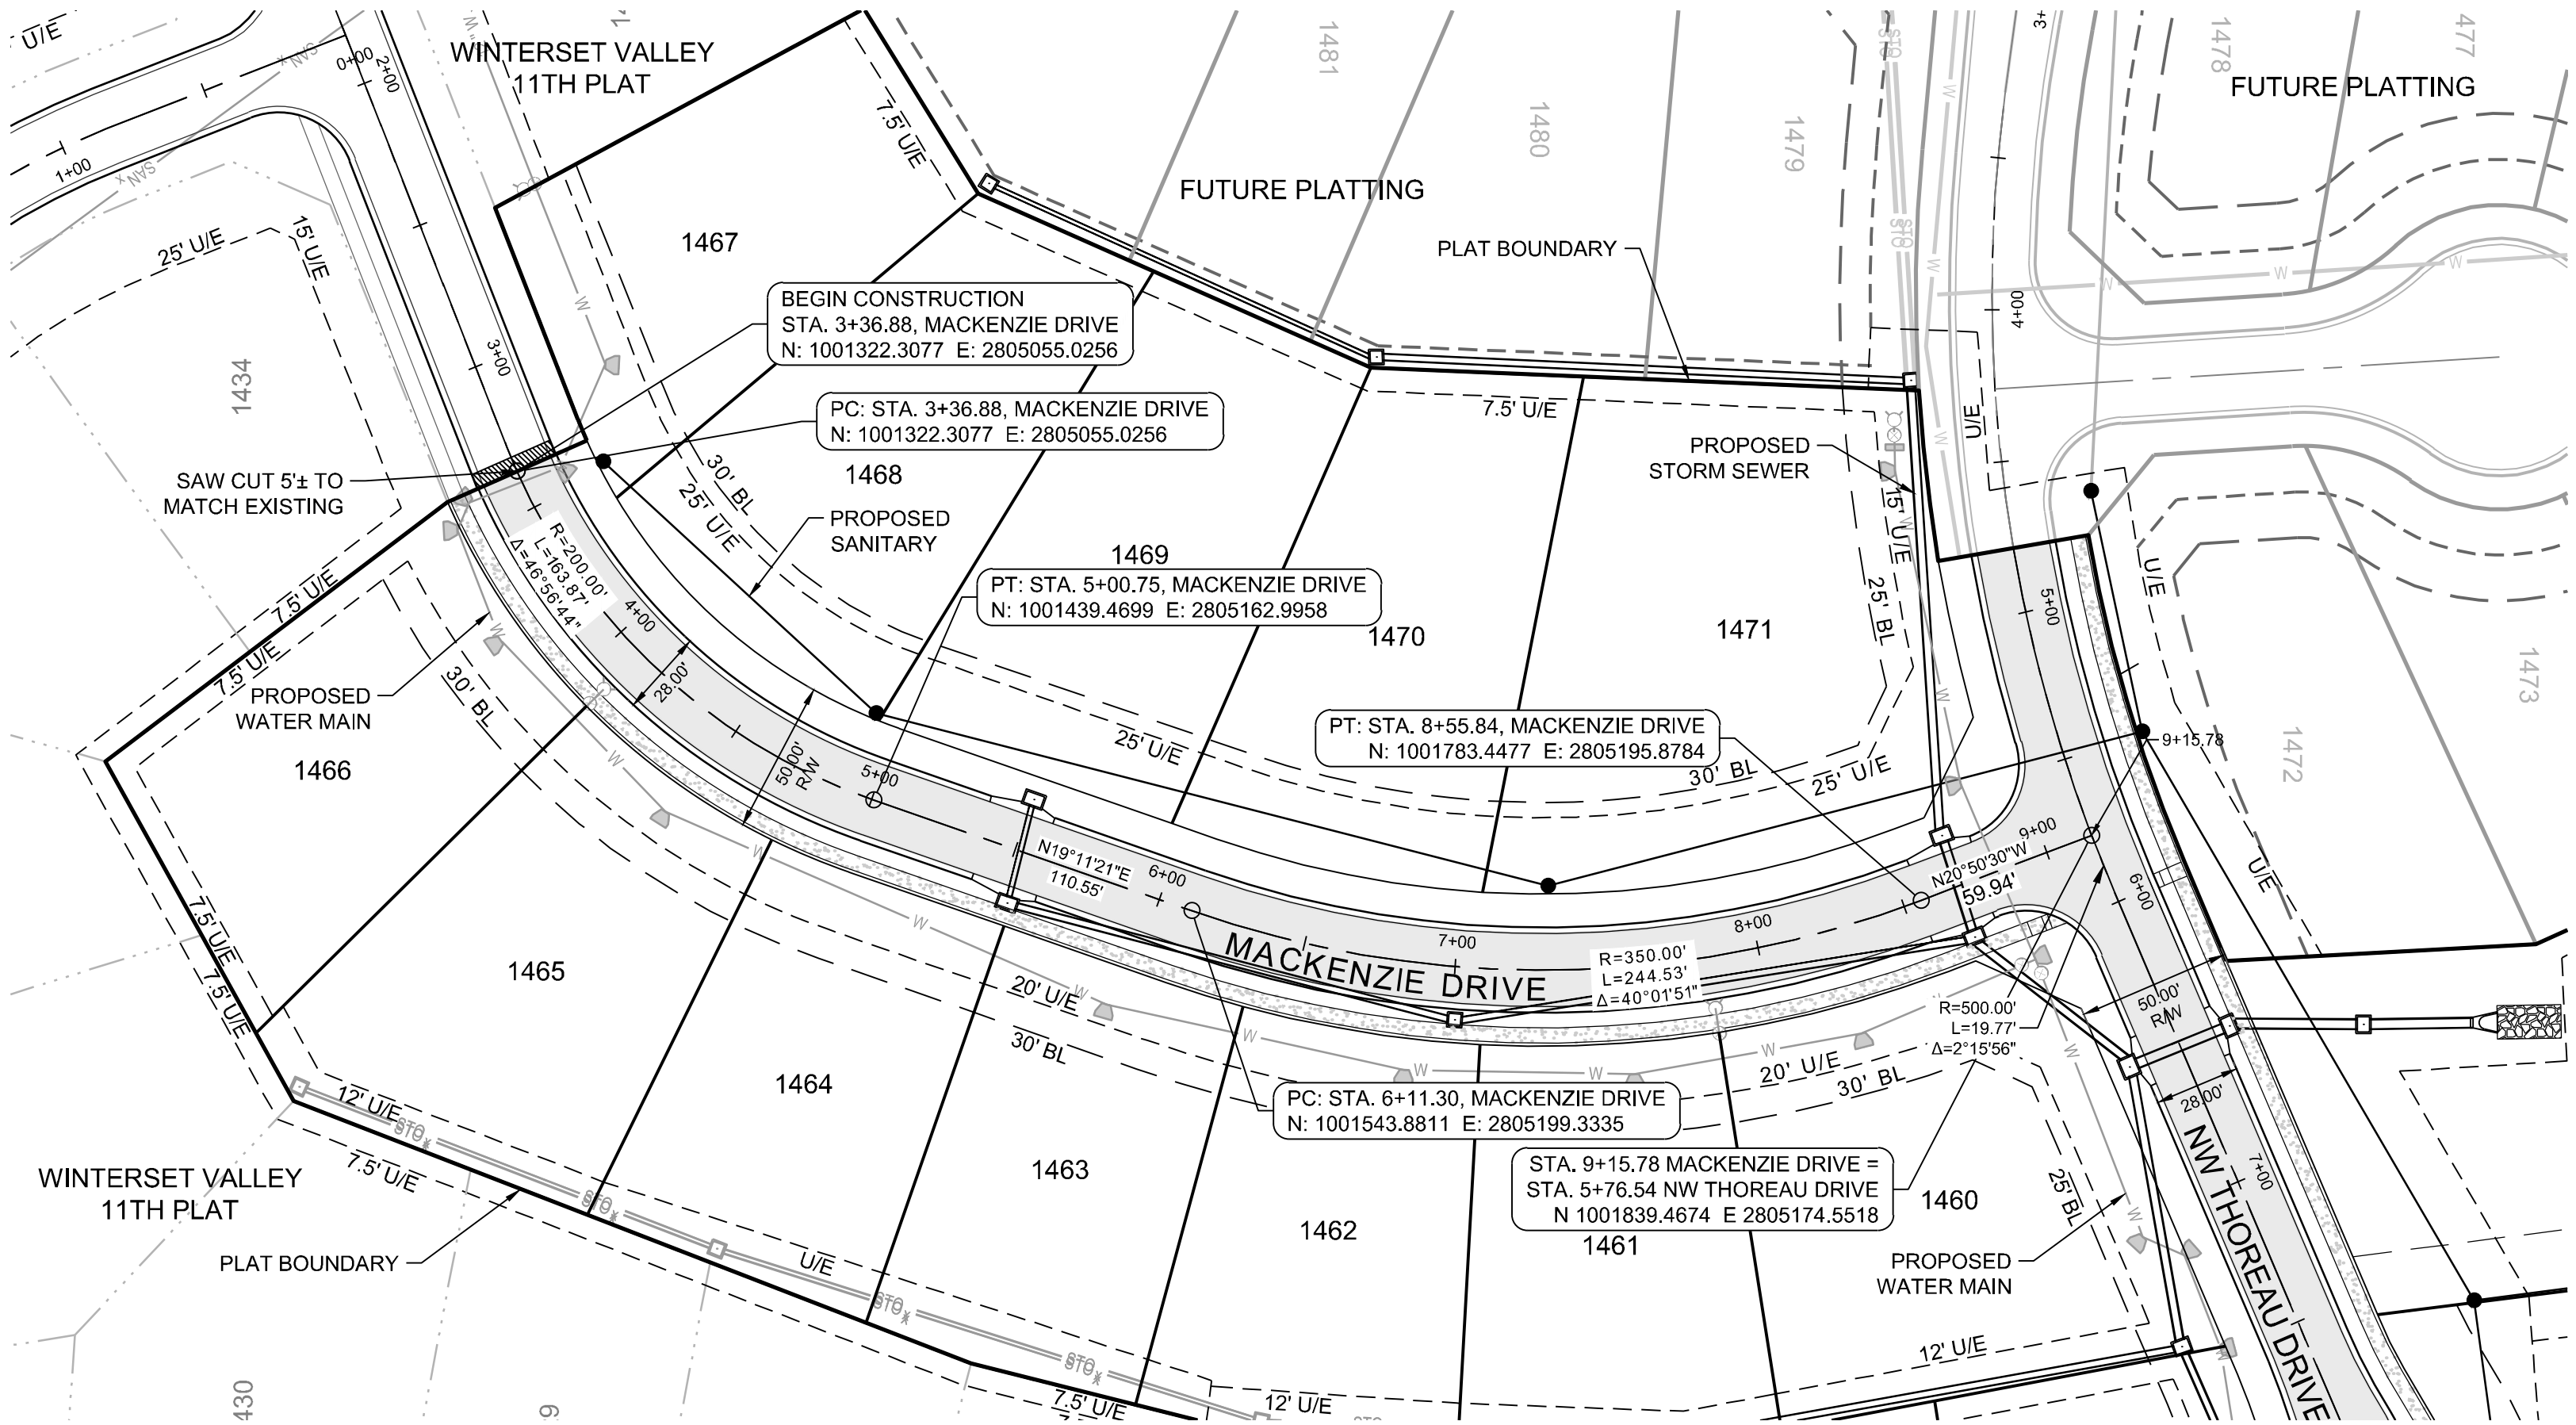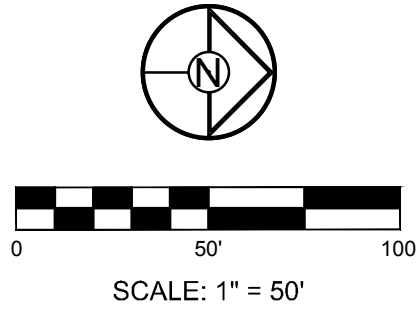

MACKENZIE DRIVE

1" = 50' HORIZ.

1" = 10' VERT.

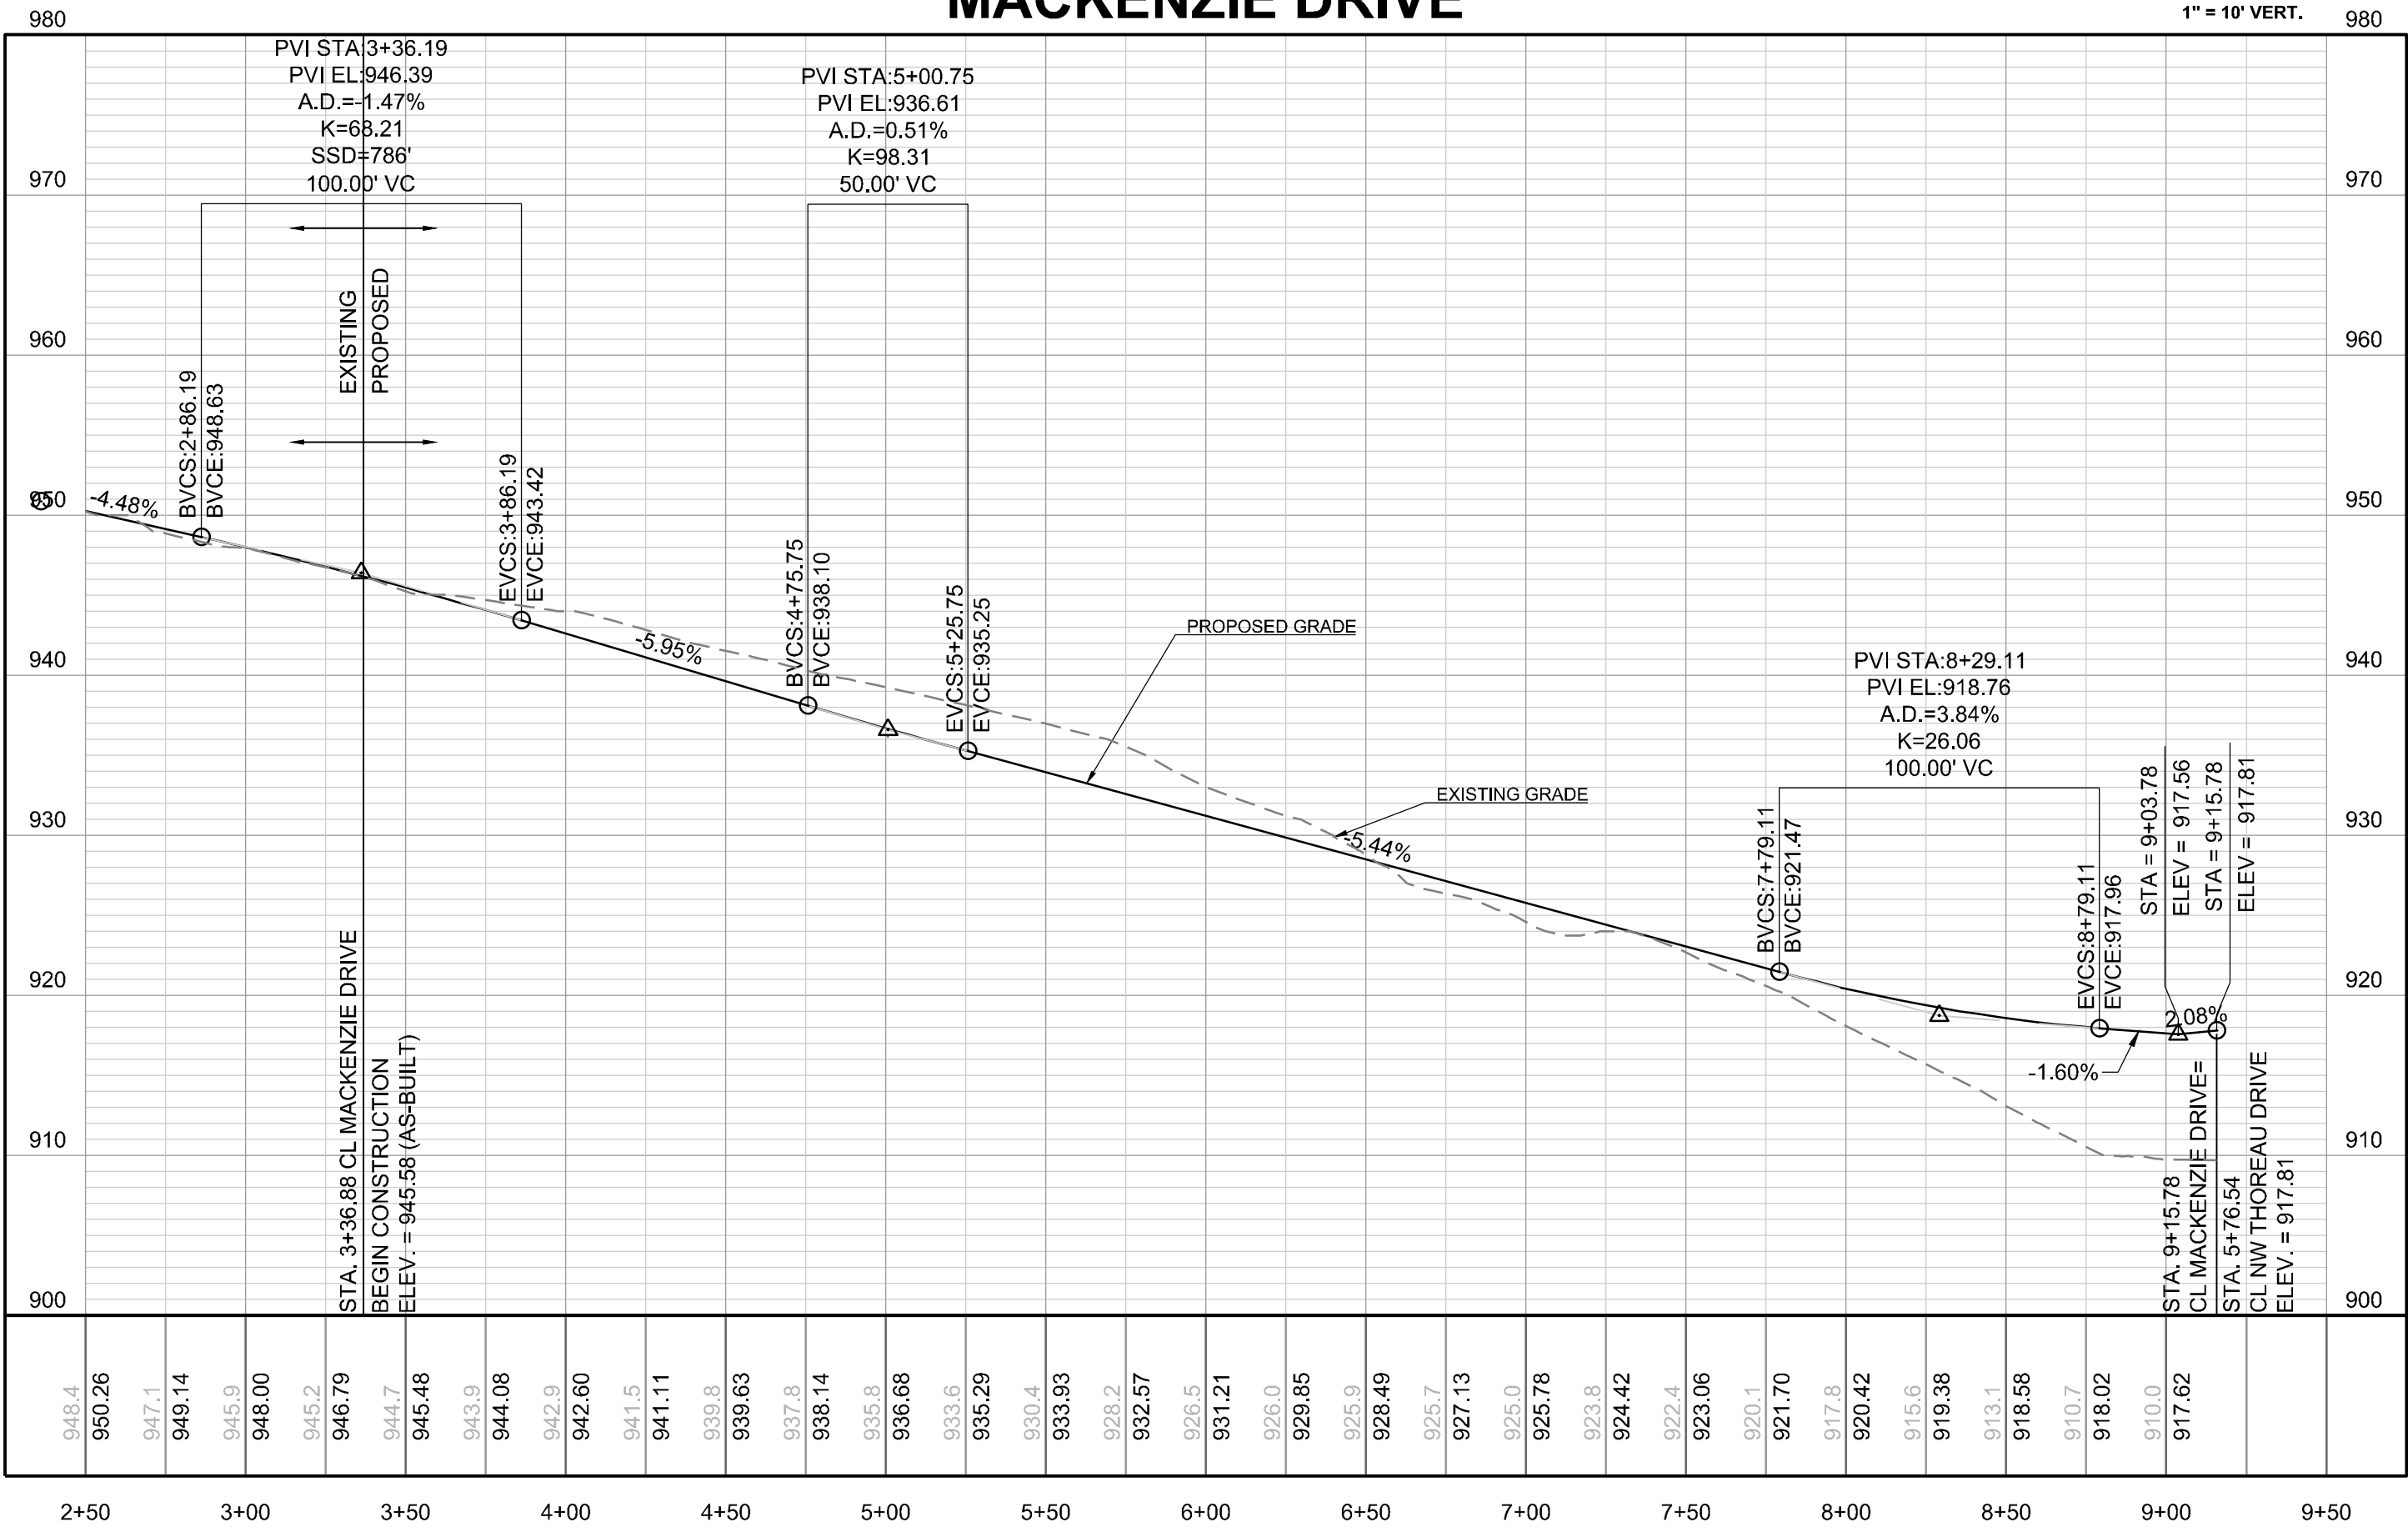

Record Drawing


SCHLAGEL & ASSOCIATES, P.A.
Engineers-Planners-Surveyors-Landscape Architects
14920 West 10th Street • Lenexa, Kansas 66215
(913) 492-5158 • Fax: (913) 492-8400
WWW.SCHLAGELASSOCIATES.COM
Missouri State Certificates of Authority
#E2002003600-F #AC200100237 #LS200200859-F

STATE OF MISSOURI
MARK ALLEN BREUER
PROFESSIONAL ENGINEER
NUMBER
PE-2003007268
10.23.19

WINTERSET VALLEY, 12TH PLAT
STREET, STORMWATER, MASTER DRAINAGE PLAN AND
EROSION AND SEDIMENT CONTROL
AUDUBON LANE AND CARSON DRIVE
LEE'S SUMMIT, MO

REVISION DATE	DESCRIPTION
06/04/2018	CITY COMMENTS
07/30/2018	CITY COMMENTS
08/28/2018	CITY COMMENTS/SHPD FINDINGS
08/27/2019	REVISE STREET NAMES
8/29/2019	REVISE RETAINING WALLS

DRAWN BY:	KSC
CHECKED BY:	MAB
DATE PREPARED:	4-20-18
PROJ. NUMBER:	17-134

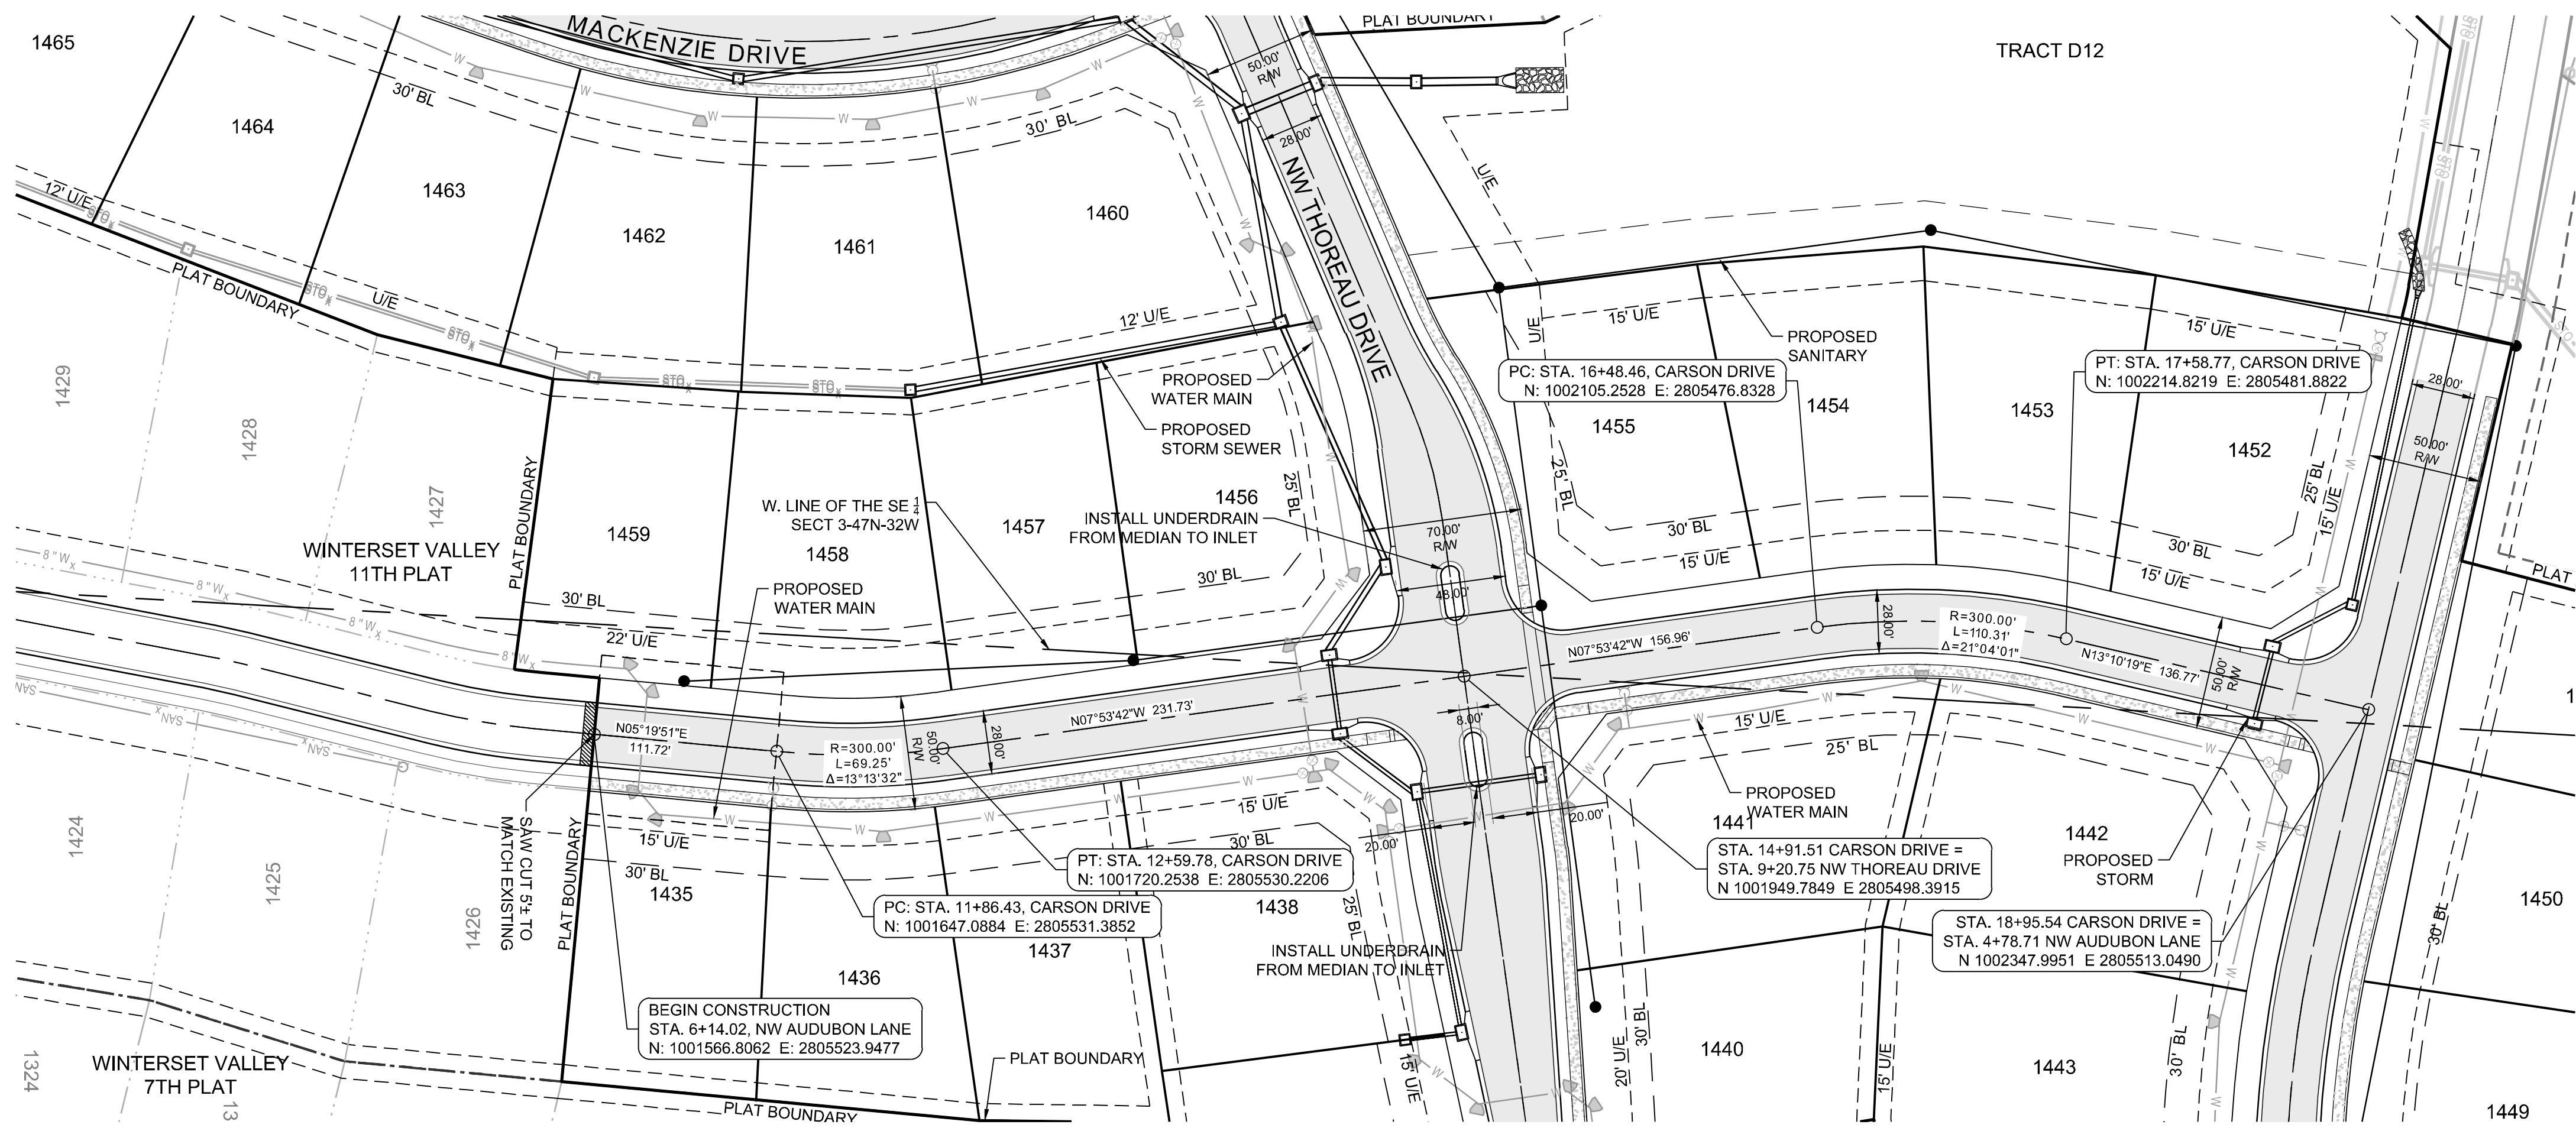

MISSOURI GEOGRAPHIC REFERENCE SYSTEM BENCH MARK:

BM JA-136, LOCATED AT INTERSECTION OF SW OLDHAM PARKWAY AND SW WARD ROAD, 61 FT SOUTH OF CL OF OLDHAM PARKWAY AND 28.9 FT EAST OF THE EAST EDGE OF WARD ROAD.

ELEV. 993.11'


PROJECT BENCH MARK:

SANITARY MANHOLE H2 AT NW CORNER OF LOT 1153 WINTERSET VALLEY 1ST PLAT, APPROX. 39' RT. OF CL OF NW PEALE BLVD.


ELEV. 935.45'

CONFORMING TO CONSTRUCTION RECORDS AS FURNISHED BY OTHERS.

KSC 7-23-19
BY DATE

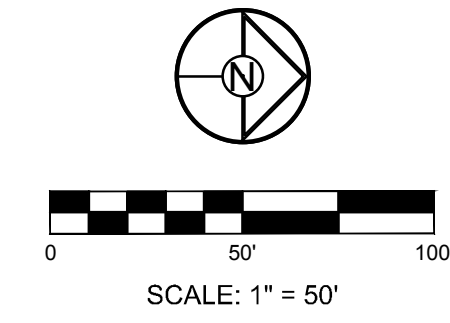


CARSON DRIVE

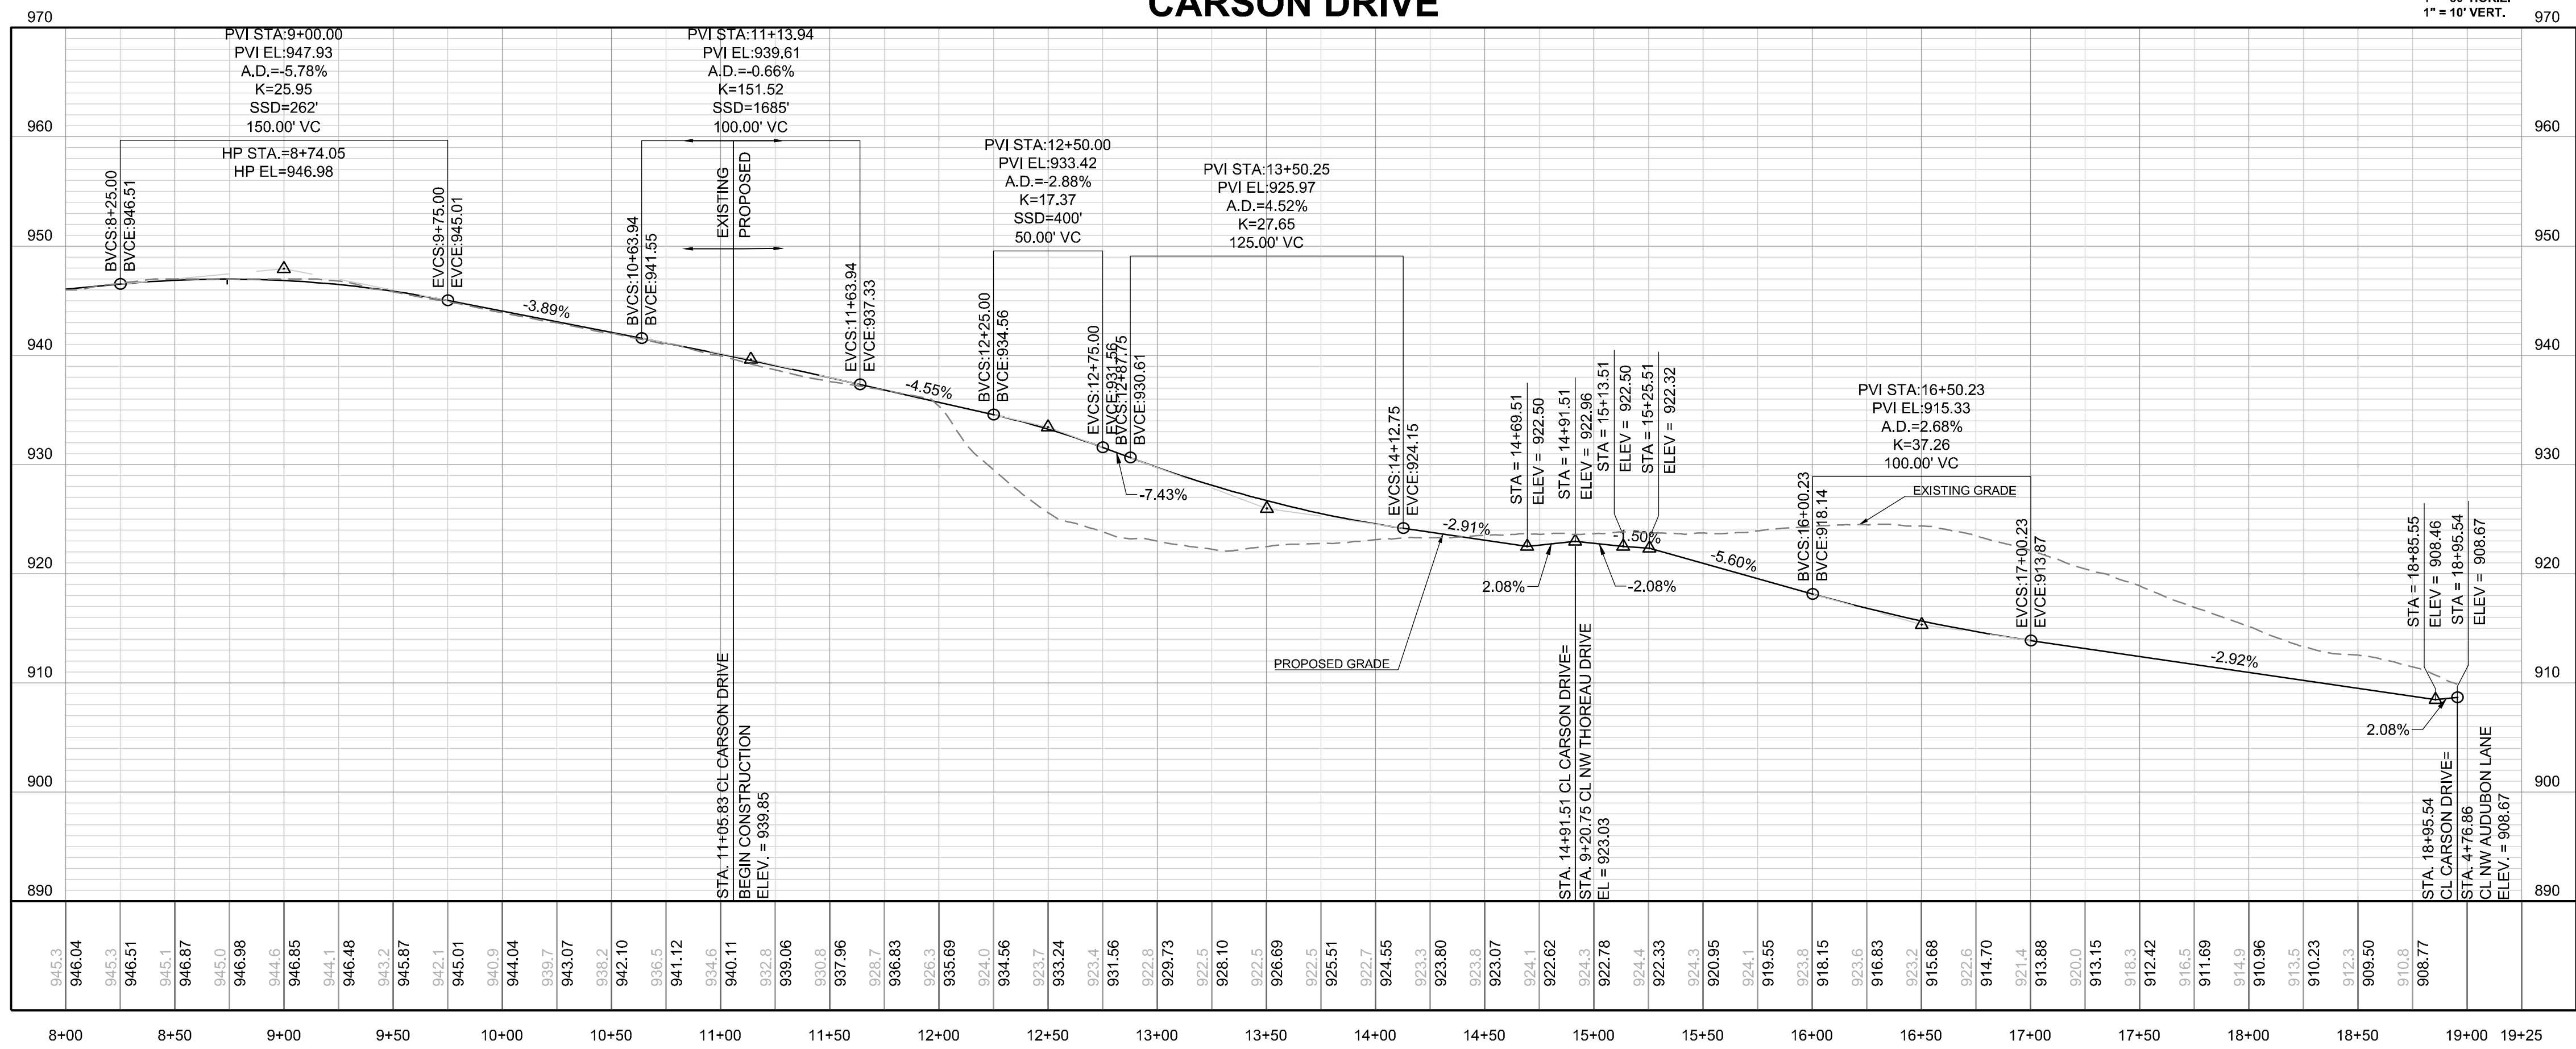

Record Drawing

SCHLAGEL & ASSOCIATES, P.A.
Engineers-Planners-Surveyors-Landscape Architects
14920 West 10th Street • Lenexa, Kansas 66215
(913) 492-5158 • Fax: (913) 492-8400
WWW.SCHLAGELASSOCIATES.COM
Missouri State Certificates of Authority
#E2002003600 F #LAC200100237 #LS200200859 F

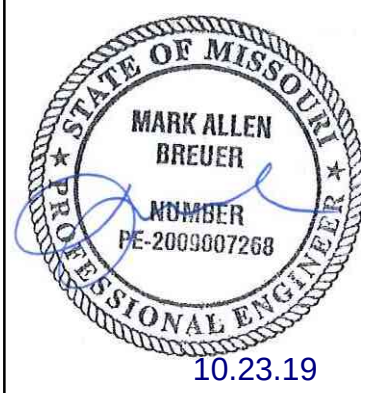



WINTERSET VALLEY, 12TH PLAT
STREET, STORMWATER, MASTER DRAINAGE PLAN AND
EROSION AND SEDIMENT CONTROL
AUDUBON LANE AND CARSON DRIVE
LEE'S SUMMIT, MO

REVISION DATE	DESCRIPTION
06/04/2018	CITY COMMENTS
07/30/2018	CITY COMMENTS
08/28/2018	CITY COMMENTS/SHPO FINDINGS
09/27/2019	REVISE STREET NAMES
8/29/2019	REVISE RETAINING WALLS

DRAWN BY:	KSC
CHECKED BY:	MAB
DATE PREPARED:	4/20/18
PROJ. NUMBER:	17-134


CARSON DRIVE
PLAN AND
PROFILE

I:\PROJECTS\2021\17-1943\0 Design\0.0 DWG Plans\6.0 SS\17-134-SS-INT DETAILS.dwg, 10/23/2019 11:55:08 AM, 11

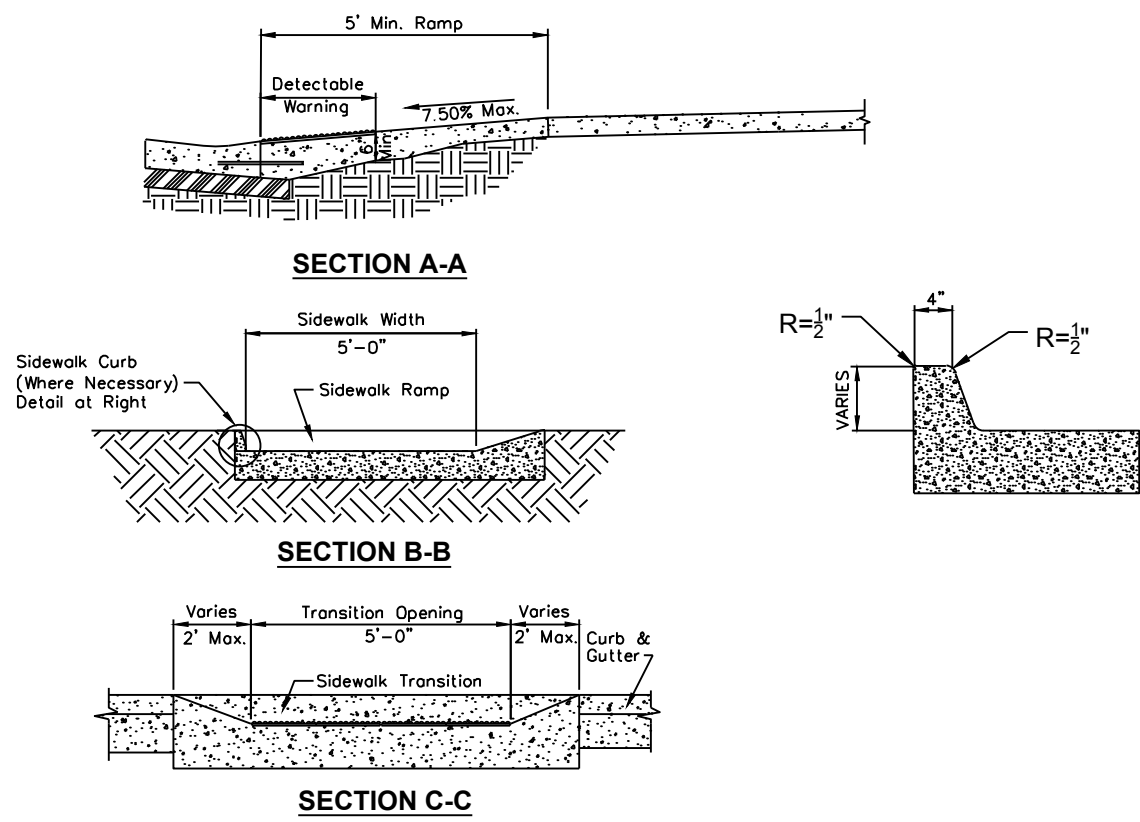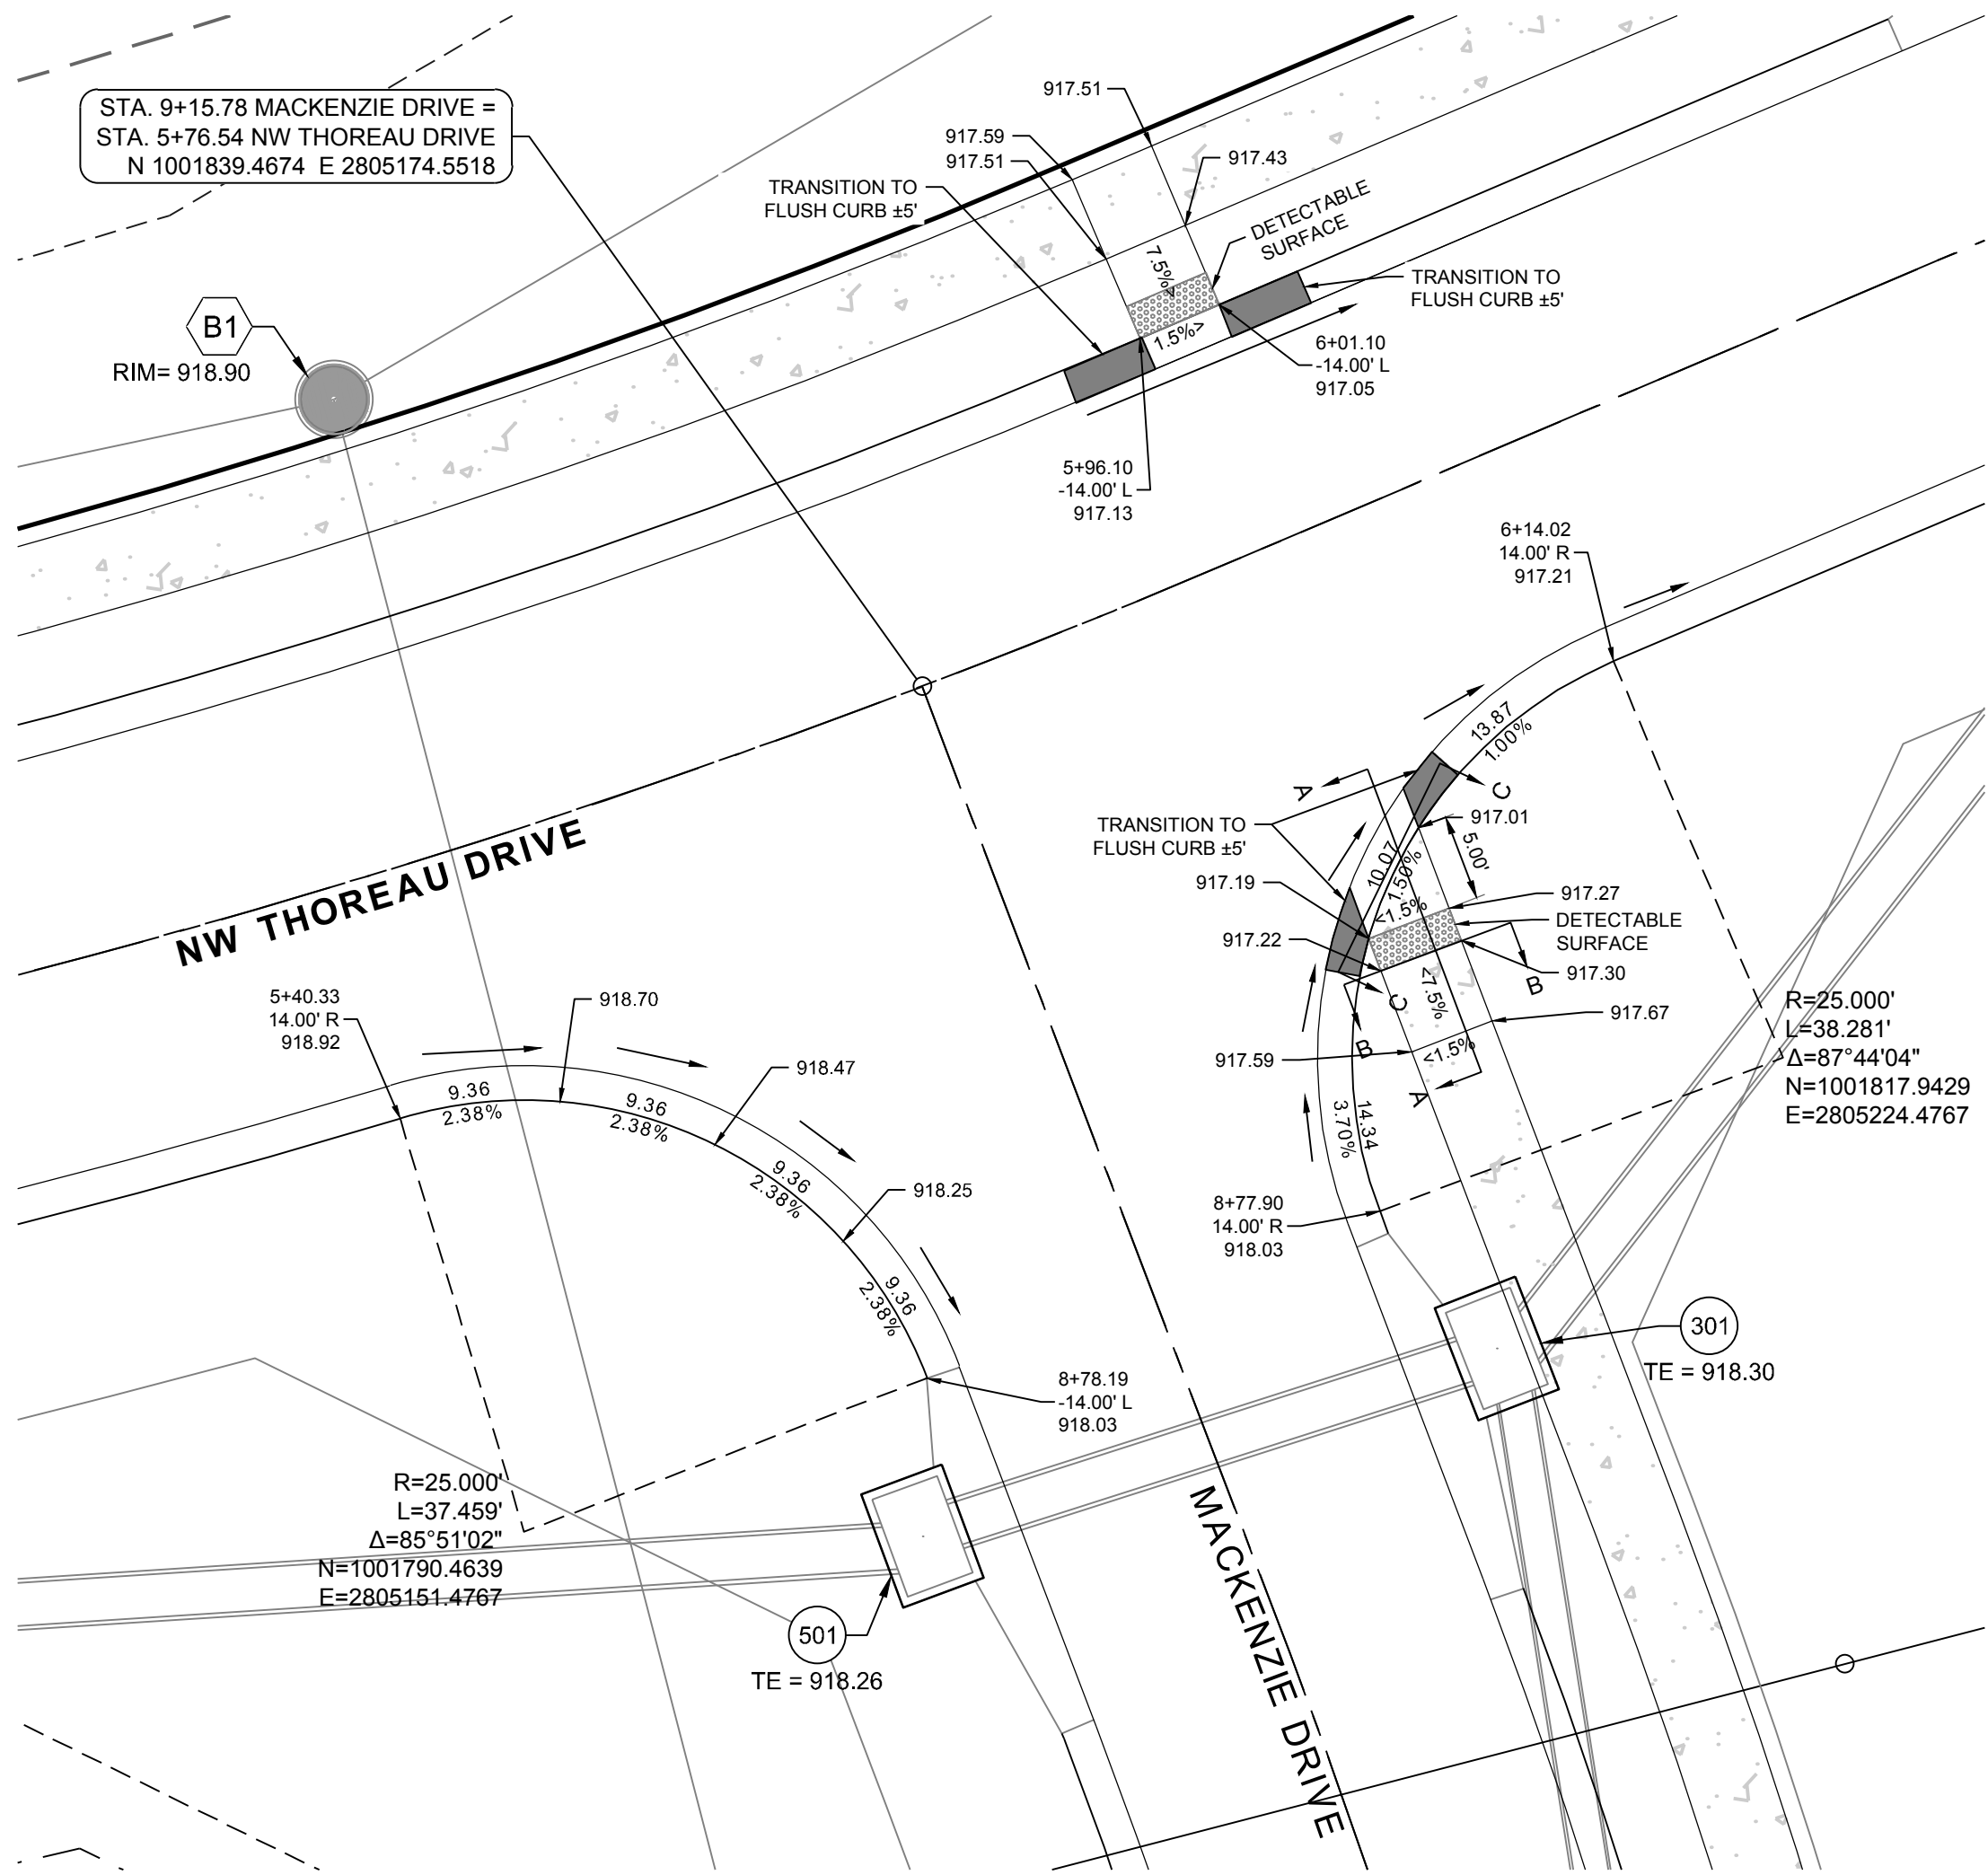


CONFORMING TO CONSTRUCTION
RECORDS AS FURNISHED BY
OTHERS.

KSC 7-23-19
BY DATE

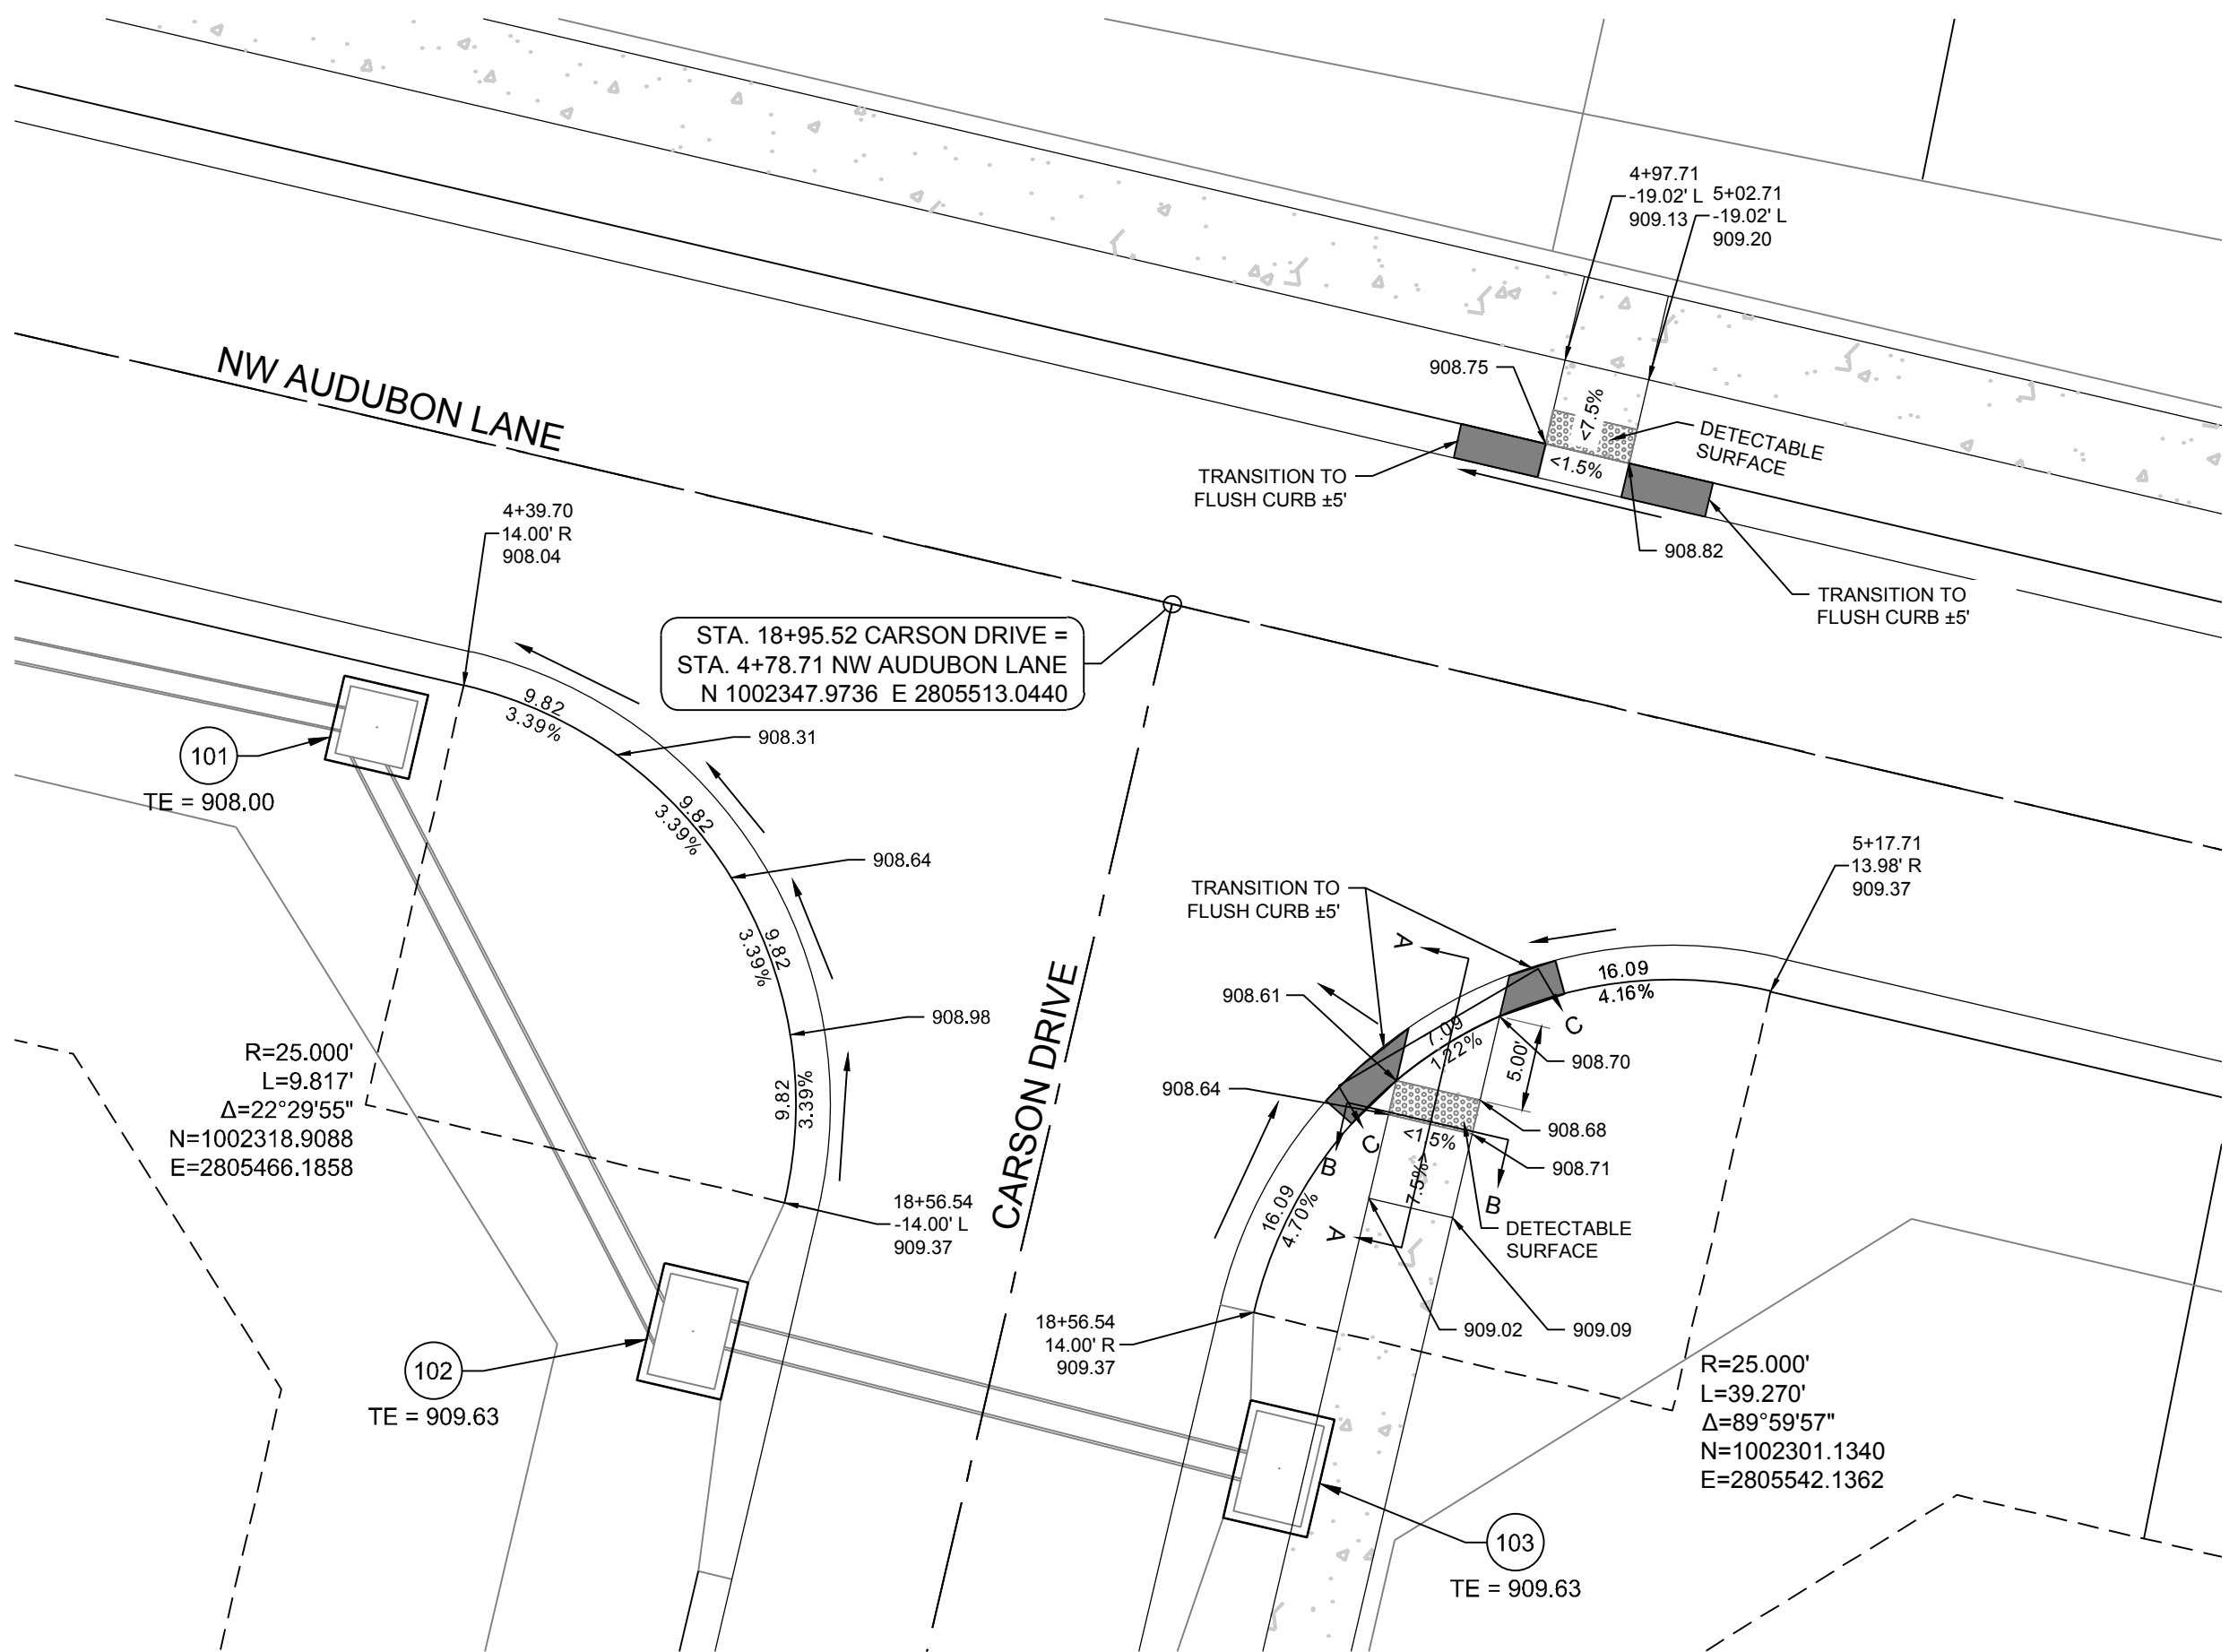

NOTE:
ALL SIDEWALKS ADJACENT TO TRACTS AND UNPLATTED
AREAS, AS WELL AS ALL ADA RAMPS SHALL BE
CONSTRUCTED BY STREET CONTRACTOR. SIDEWALK
ADJACENT TO LOTS SHALL BE CONSTRUCTED BY
INDIVIDUAL HOME BUILDER.

Record Drawing

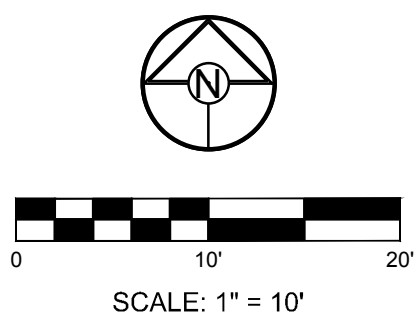

SCHLAGEL & ASSOCIATES, P.A.
Engineers • Planners • Surveyors • Landscape Architects
14920 West 10th Street • Lenexa, Kansas 66215
(913) 492-5158 • Fax: (913) 492-8400
WWW.SCHLAGELASSOCIATES.COM
Missouri State Certificates of Authority
#E200200360-F #AC200100237 #LS200200859-F

STATE OF MISSOURI
MARK ALLEN BREUER
NUMBER
PE-2005007268
10.23.19

WINTERSET VALLEY, 12TH PLAT
STREET, STORMWATER, MASTER DRAINAGE
PLAN AND EROSION AND SEDIMENT CONTROL
AUDUBON LANE AND CARSON DRIVE
LEE'S SUMMIT, MO



REVISION	DATE	DESCRIPTION
1	06/04/2018	CITY COMMENTS
2	07/30/2018	CITY COMMENTS
3	08/28/2018	CITY COMMENTS/SHPO FINDINGS
4	09/27/2019	REVISE STREET NAMES
5	8/29/2019	REVISE RETAINING WALLS
6		
7		
8		

DRAWN BY:	KSC
CHECKED BY:	MAB
DATE PREPARED:	4.23.18
PROJ. NUMBER:	17-134

INTERSECTION
DETAILS

SHEET
15
OF 25

I:\PROJECTS\2017\17-1943\0 Design\0.0 DWG Plans\6.0 SS\17-194-SS-INT DETAILS.dwg, 10/23/2019 11:55:17 AM, 11

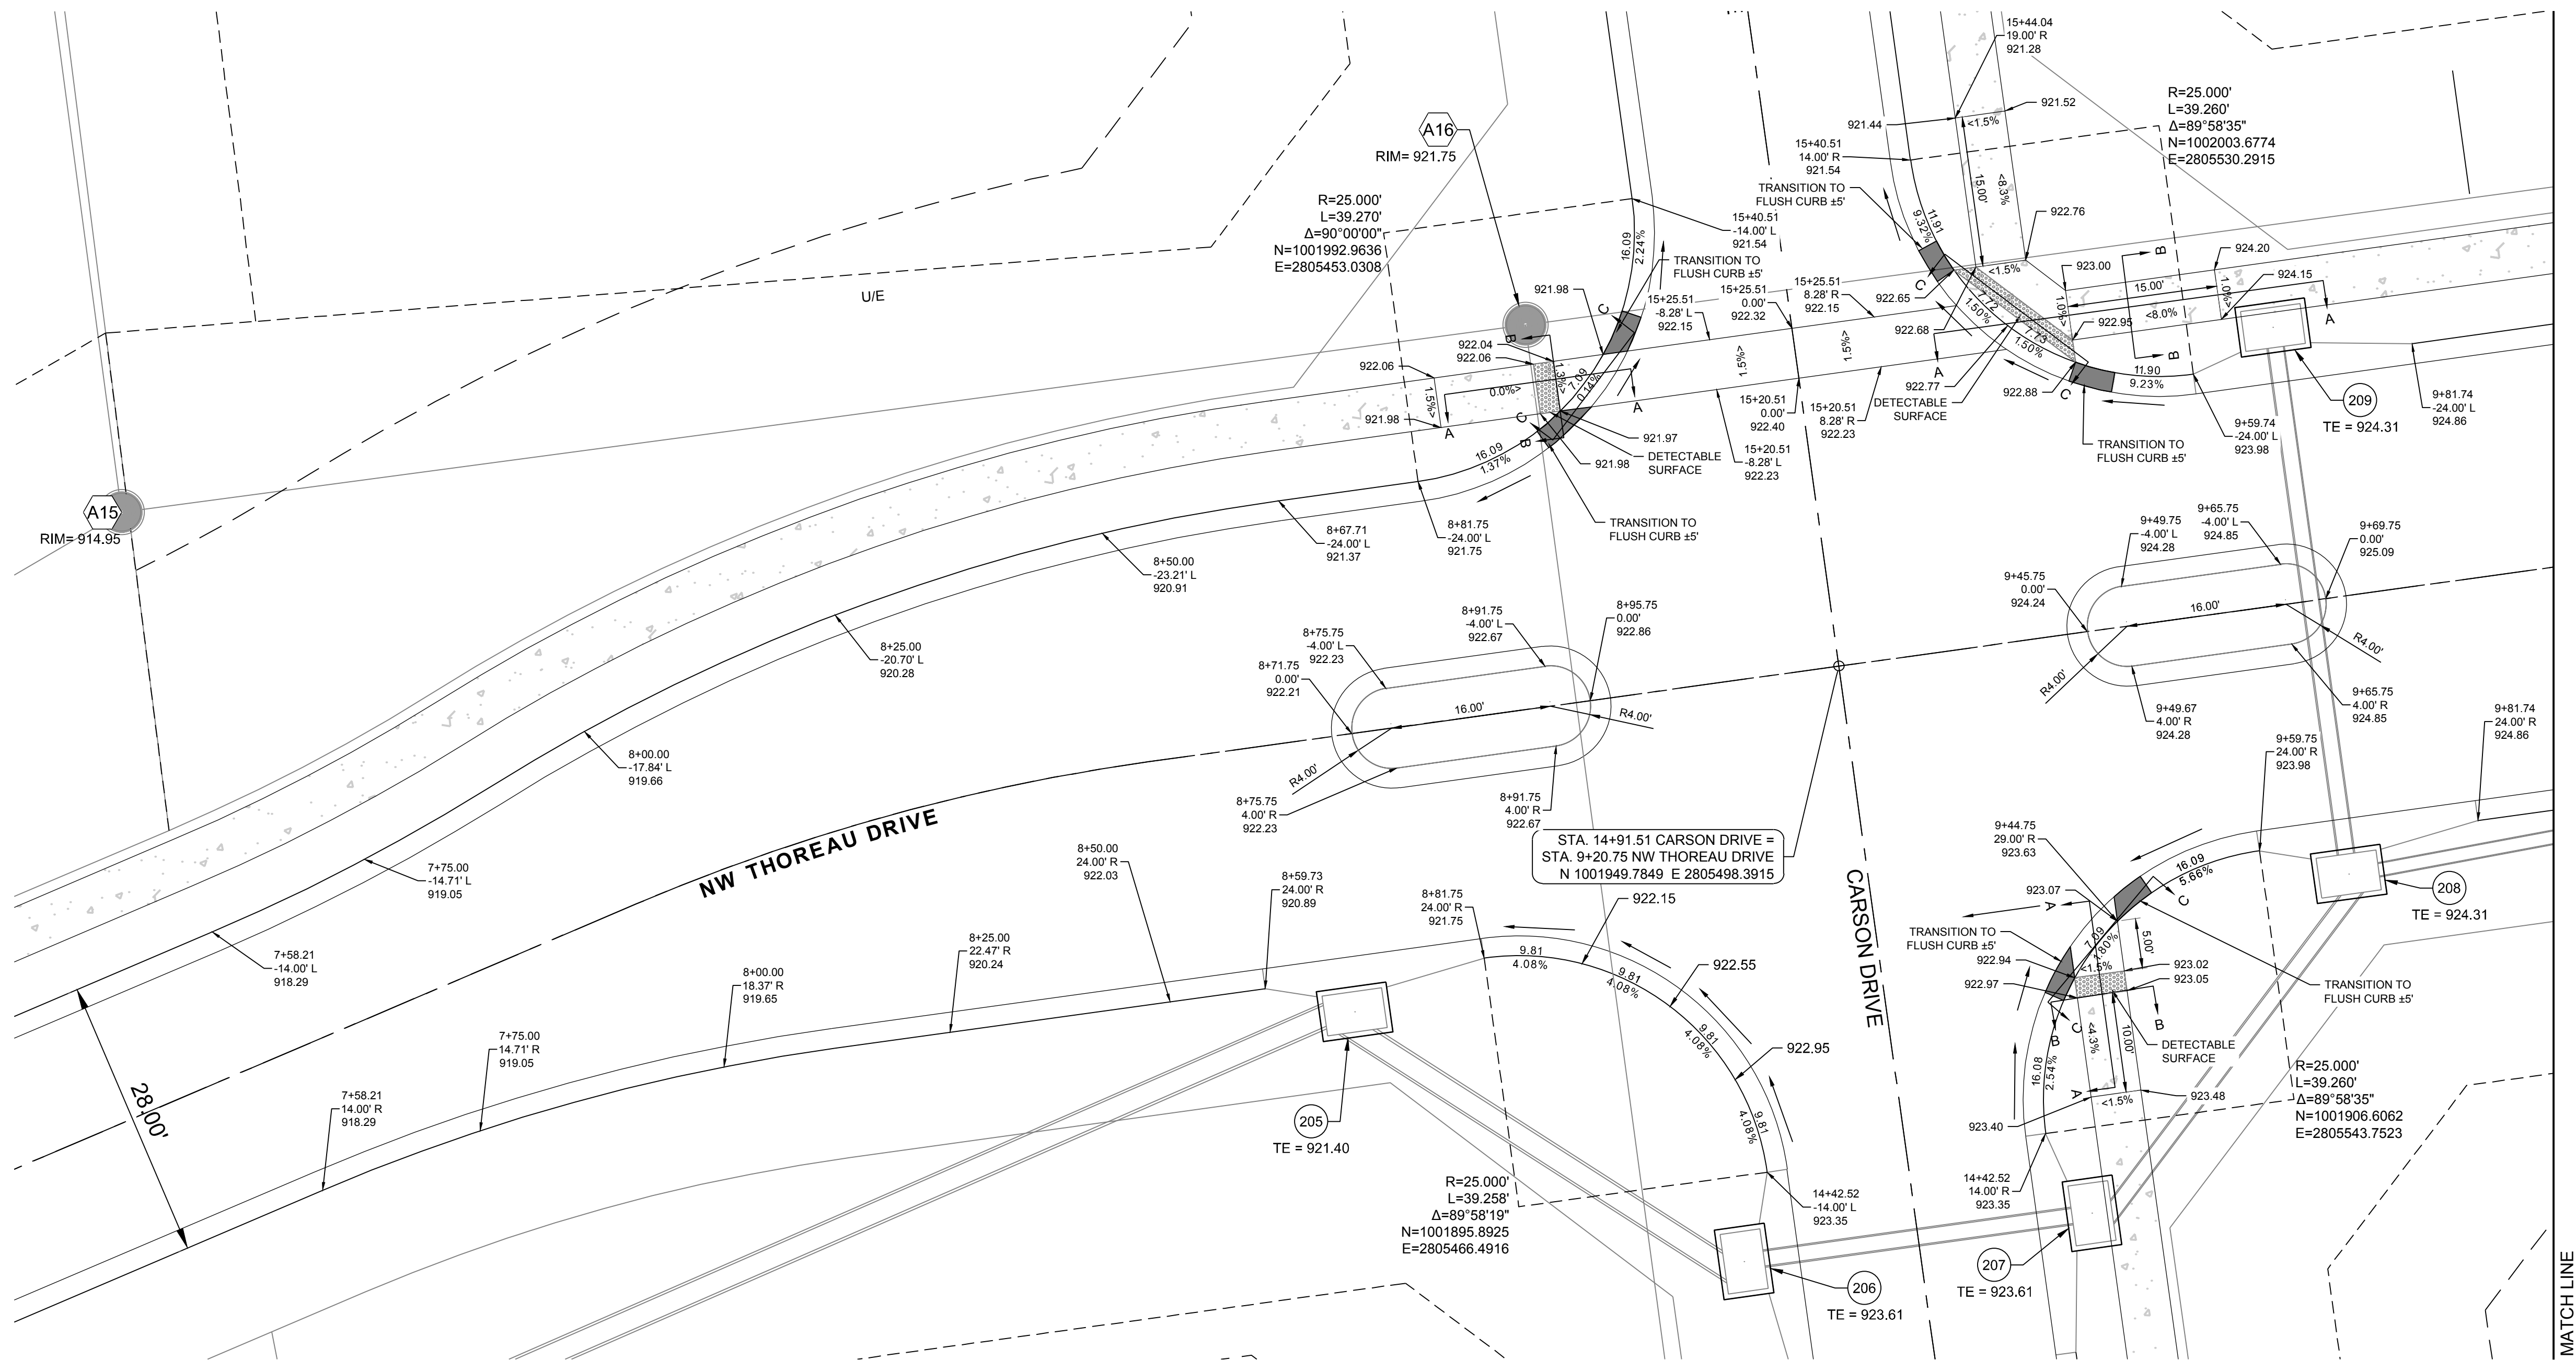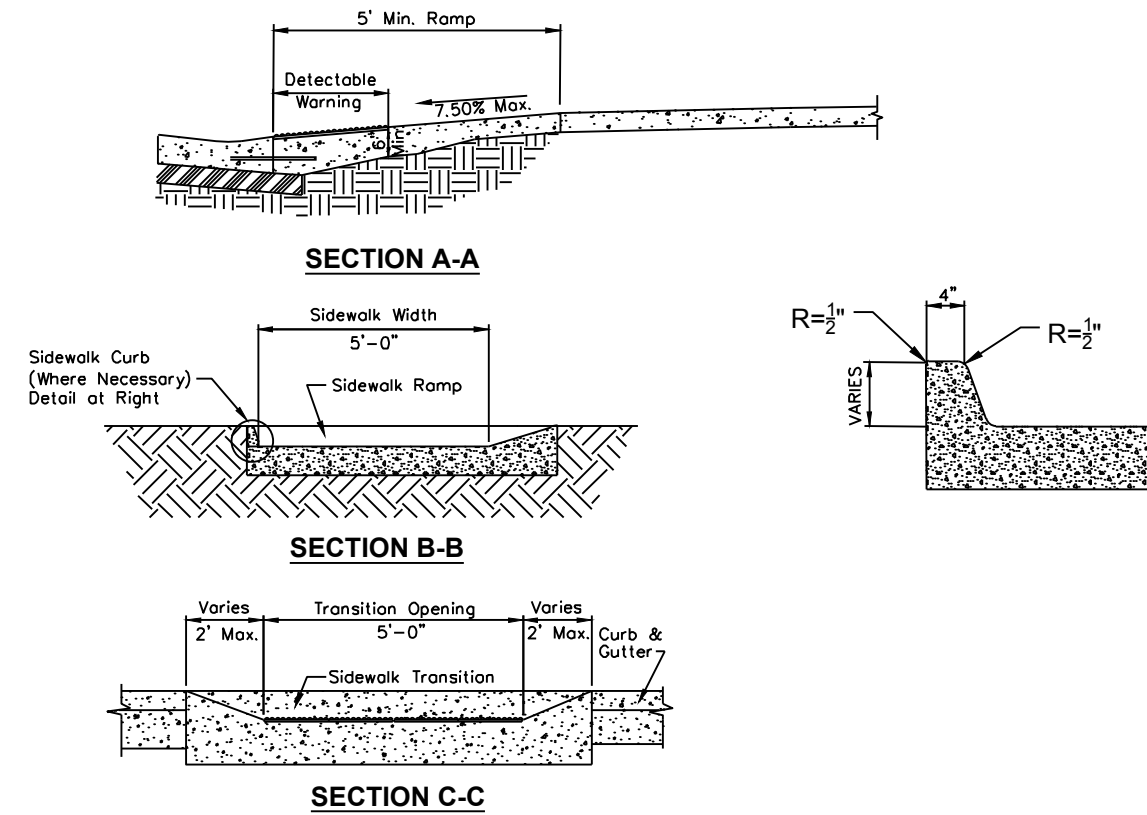


NOTE:
ALL SIDEWALKS ADJACENT TO TRACTS AND UNPLATTED
AREAS, AS WELL AS ALL ADA RAMPS SHALL BE
CONSTRUCTED BY STREET CONTRACTOR. SIDEWALK
ADJACENT TO LOTS SHALL BE CONSTRUCTED BY
INDIVIDUAL HOME BUILDER.

CONFORMING TO CONSTRUCTION
RECORDS AS FURNISHED BY
OTHERS.

KSC 7-23-19
BY DATE

Record Drawing

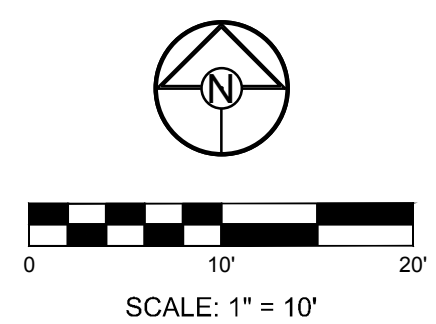


REVISION DATE	DESCRIPTION
06/04/2018	CITY COMMENTS
07/30/2018	CITY COMMENTS
08/28/2018	CITY COMMENTS/SHPO FINDINGS
09/27/2018	REVISE STREET NAMES
08/29/2019	REVISE RETAINING WALLS
4/20/18	DATE PREPARED
17-134	PROJ. NUMBER

INTERSECTION
DETAILS

SHEET

16
OF 25


I:\PROJECTS\2021\17-1943.0 DWG Plans\6.0 SS\17-134-SS-STORM PLAN AND PROFILE.dwg, 10/23/2019 11:58:00 AM, 1:1

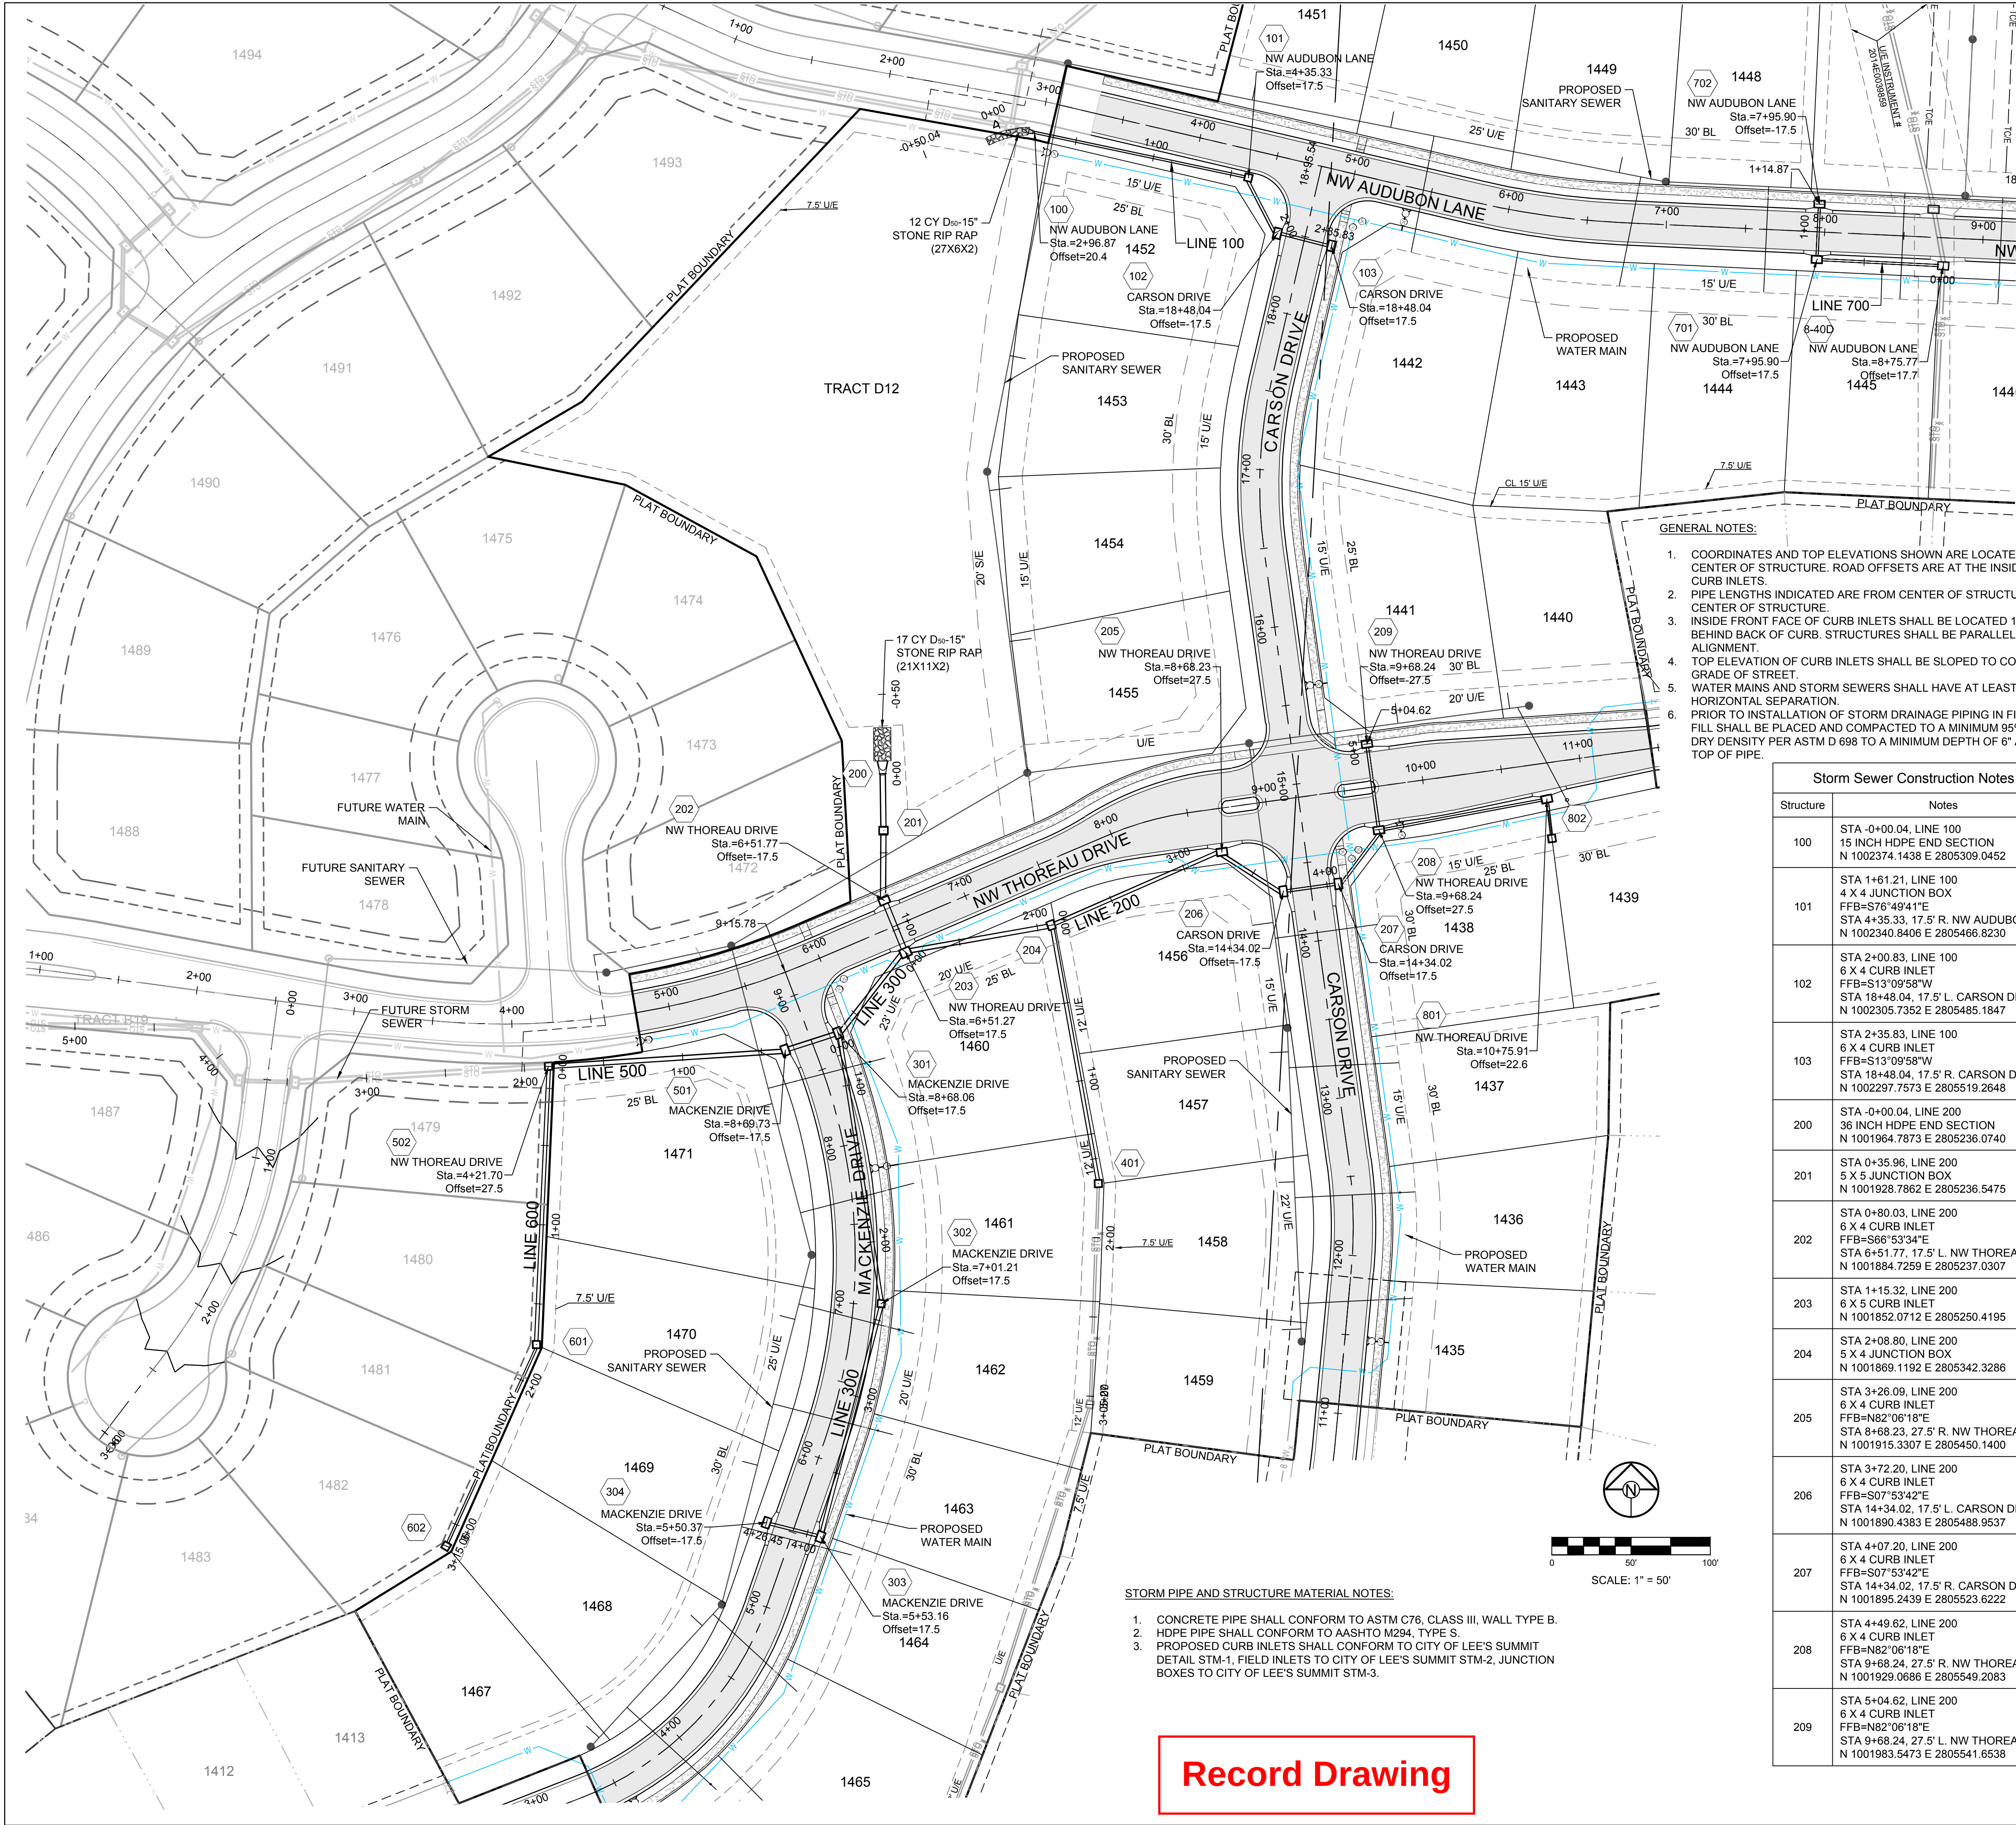

STORM PIPE AND STRUCTURE MATERIAL NOTES:

1. CONCRETE PIPE SHALL CONFORM TO ASTM C76, CLASS III, WALL TYPE B.
2. HDPE PIPE SHALL CONFORM TO AASHTO M294, TYPE S.
3. PROPOSED CURB INLETS SHALL CONFORM TO CITY OF LEE'S SUMMIT DETAIL STM-1, FIELD INLETS TO CITY OF LEE'S SUMMIT STM-2, JUNCTION BOXES TO CITY OF LEE'S SUMMIT STM-3.

Record Drawing

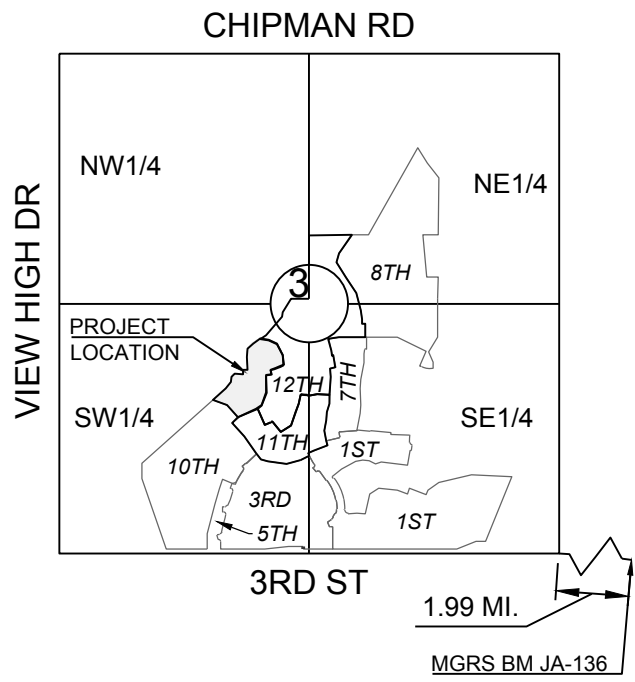

SECTION 3-47N-32W
LOCATION MAP
SCALE 1" = 2000'

MISSOURI GEOGRAPHIC REFERENCE SYSTEM
BENCH MARK:

BM JA-136, LOCATED AT INTERSECTION OF SW OLDHAM PARKWAY AND SW WARD ROAD, 61 FT SOUTH OF CL OF OLDHAM PARKWAY AND 28.9 FT EAST OF THE EAST EDGE OF WARD ROAD.

ELEV. 993.11'

PROJECT BENCH MARK:

SANITARY MANHOLE H2 AT NW CORNER OF LOT 1153 WINTERSET VALLEY 1ST PLAT, APPROX. 39' RT. OF CL OF NW PEALE BLVD.

ELEV. 935.45'

CONFORMING TO CONSTRUCTION
RECORDS AS FURNISHED BY
OTHERS.

KSC 7-23-19
BY DATE

Storm Sewer Construction Notes	
Structure	Notes
100	STA -0+00.04, LINE 100 15 INCH HDPE END SECTION N 1002374.1438 E 2805309.0452
101	STA 1+61.21, LINE 100 4 X 4 JUNCTION BOX FFB=S76°49'41"E STA 4+35.33, 17.5' R. NW AUDUBON LN N 1002340.8406 E 2805466.8230
102	STA 2+00.83, LINE 100 6 X 4 CURB INLET FFB=S13°09'58"W STA 18+48.04, 17.5' L. CARSON DR N 1002305.7352 E 2805485.1847
103	STA 2+35.83, LINE 100 6 X 4 CURB INLET FFB=S13°09'58"W STA 18+48.04, 17.5' R. CARSON DR N 1002297.7573 E 2805519.2648
200	STA -0+00.04, LINE 200 36 INCH HDPE END SECTION N 1001964.7873 E 2805236.0740
201	STA 0+35.96, LINE 200 5 X 5 JUNCTION BOX N 1001928.7862 E 2805236.5475
202	STA 0+80.03, LINE 200 6 X 4 CURB INLET FFB=S66°53'34"E STA 6+51.77, 17.5' L. NW THOREAU DR N 1001884.7259 E 2805237.0307
203	STA 1+15.32, LINE 200 6 X 5 CURB INLET N 1001852.0712 E 2805250.4195
204	STA 2+08.80, LINE 200 5 X 4 JUNCTION BOX N 1001869.1192 E 2805342.3286
205	STA 3+26.09, LINE 200 6 X 4 CURB INLET FFB=N82°06'18"E STA 8+68.23, 27.5' R. NW THOREAU DR N 1001915.3307 E 2805450.1400
206	STA 3+72.20, LINE 200 6 X 4 CURB INLET FFB=S07°53'42"E STA 14+34.02, 17.5' L. CARSON DR N 1001890.4383 E 2805488.9537
207	STA 4+07.20, LINE 200 6 X 4 CURB INLET FFB=S07°53'42"E STA 14+34.02, 17.5' R. CARSON DR N 1001895.2439 E 2805523.6222
208	STA 4+49.62, LINE 200 6 X 4 CURB INLET FFB=N82°06'18"E STA 9+68.24, 27.5' R. NW THOREAU DR N 1001929.0686 E 2805549.2083
209	STA 5+04.62, LINE 200 6 X 4 CURB INLET FFB=N82°06'18"E STA 9+68.24, 27.5' L. NW THOREAU DR N 1001983.5473 E 2805541.6538



Storm Sewer Construction Notes	
Structure	Notes
301	STA 0+00.00, LINE 500 6 X 4 CURB INLET FFB=S21°22'16"E STA 8+68.06, 17.5' R. MACKENZIE DR N 1001801.0916 E 2805207.8841
302	STA 0+27.17, LINE 500 4 X 4 JUNCTION BOX FFB=S04°24'59"W STA 7+01.21, 17.5' R. MACKENZIE DR N 1001630.2709 E 2805235.1504
303	STA 0+35.04, LINE 500 6 X 4 CURB INLET FFB=S19°11'21"W STA 5+50.37, 17.5' R. MACKENZIE DR N 1001483.2165 E 2805196.7502
304	STA 0+67.05, LINE 500 6 X 4 CURB INLET FFB=S19°11'21"W STA 5+50.37, 17.5' L. MACKENZIE DR N 1001492.0827 E 2805162.7969
401	STA 1+65.76, LINE 400 4 X 4 AREA INLET WITH OPENING TO SOUTH FFB=N88°45'40"E N 1001706.0593 E 2805372.1343
501	STA 0+35.04, LINE 500 6 X 4 CURB INLET FFB=S20°17'41"E STA 8+69.73, 17.5' L. MACKENZIE DR N 1001790.2032 E 2805174.5814
502	STA 1+84.79, LINE 500 4 X 4 AREA INLET WITH OPENING TO SOUTH FFB=S68°51'17"W N 1001780.0259 E 2805025.1710
601	STA 1+75.68, LINE 600 4 X 4 AREA INLET WITH OPENING TO SOUTH FFB=N88°45'40"E N 1001604.5187 E 2805017.4848
602	STA 3+15.06, LINE 600 4 X 4 AREA INLET WITH OPENING TO SOUTHWEST FFB=S58°15'04"E N 1001477.2800 E 2804960.5784
701	STA 0+79.87, LINE 700 6 X 4 CURB INLET FFB=S87°17'43"E STA 7+95.90, 17.5' R. NW AUDUBON LN N 1002289.1546 E 2805825.6375
702	STA 1+14.87, LINE 700 6 X 4 CURB INLET FFB=S87°17'43"E STA 7+95.90, 17.5' L. NW AUDUBON LN N 1002324.1156 E 2805827.2891
801	STA 1+07.78, LINE 800 6 X 4 CURB INLET FFB=N77°55'14"E STA 10+75.91, 22.6' R. NW THOREAU DR N 1001948.7381 E 2805655.1796
802	STA 1+32.87, LINE 800 4 X 4 AREA INLET WITH OPENING TO SOUTH FFB=N82°38'33"E N 1001923.8595 E 2805658.3920

REVISION DATE	DESCRIPTION
06/04/2018	CITY COMMENTS
07/30/2018	CITY COMMENTS
08/28/2018	CITY COMMENTS/SHPO FINDINGS
08/27/2019	REVISE STREET NAMES
8/29/2019	REVISE RETAINING WALLS
4/20/18	
PROJ. NUMBER:	17-134

STORM PLAN




SHEET

I:\PROJECTS\2017\17-134-SS-STORM PLAN AND PROFILE.dwg, 10/23/2019 11:56:28 AM, 1:1

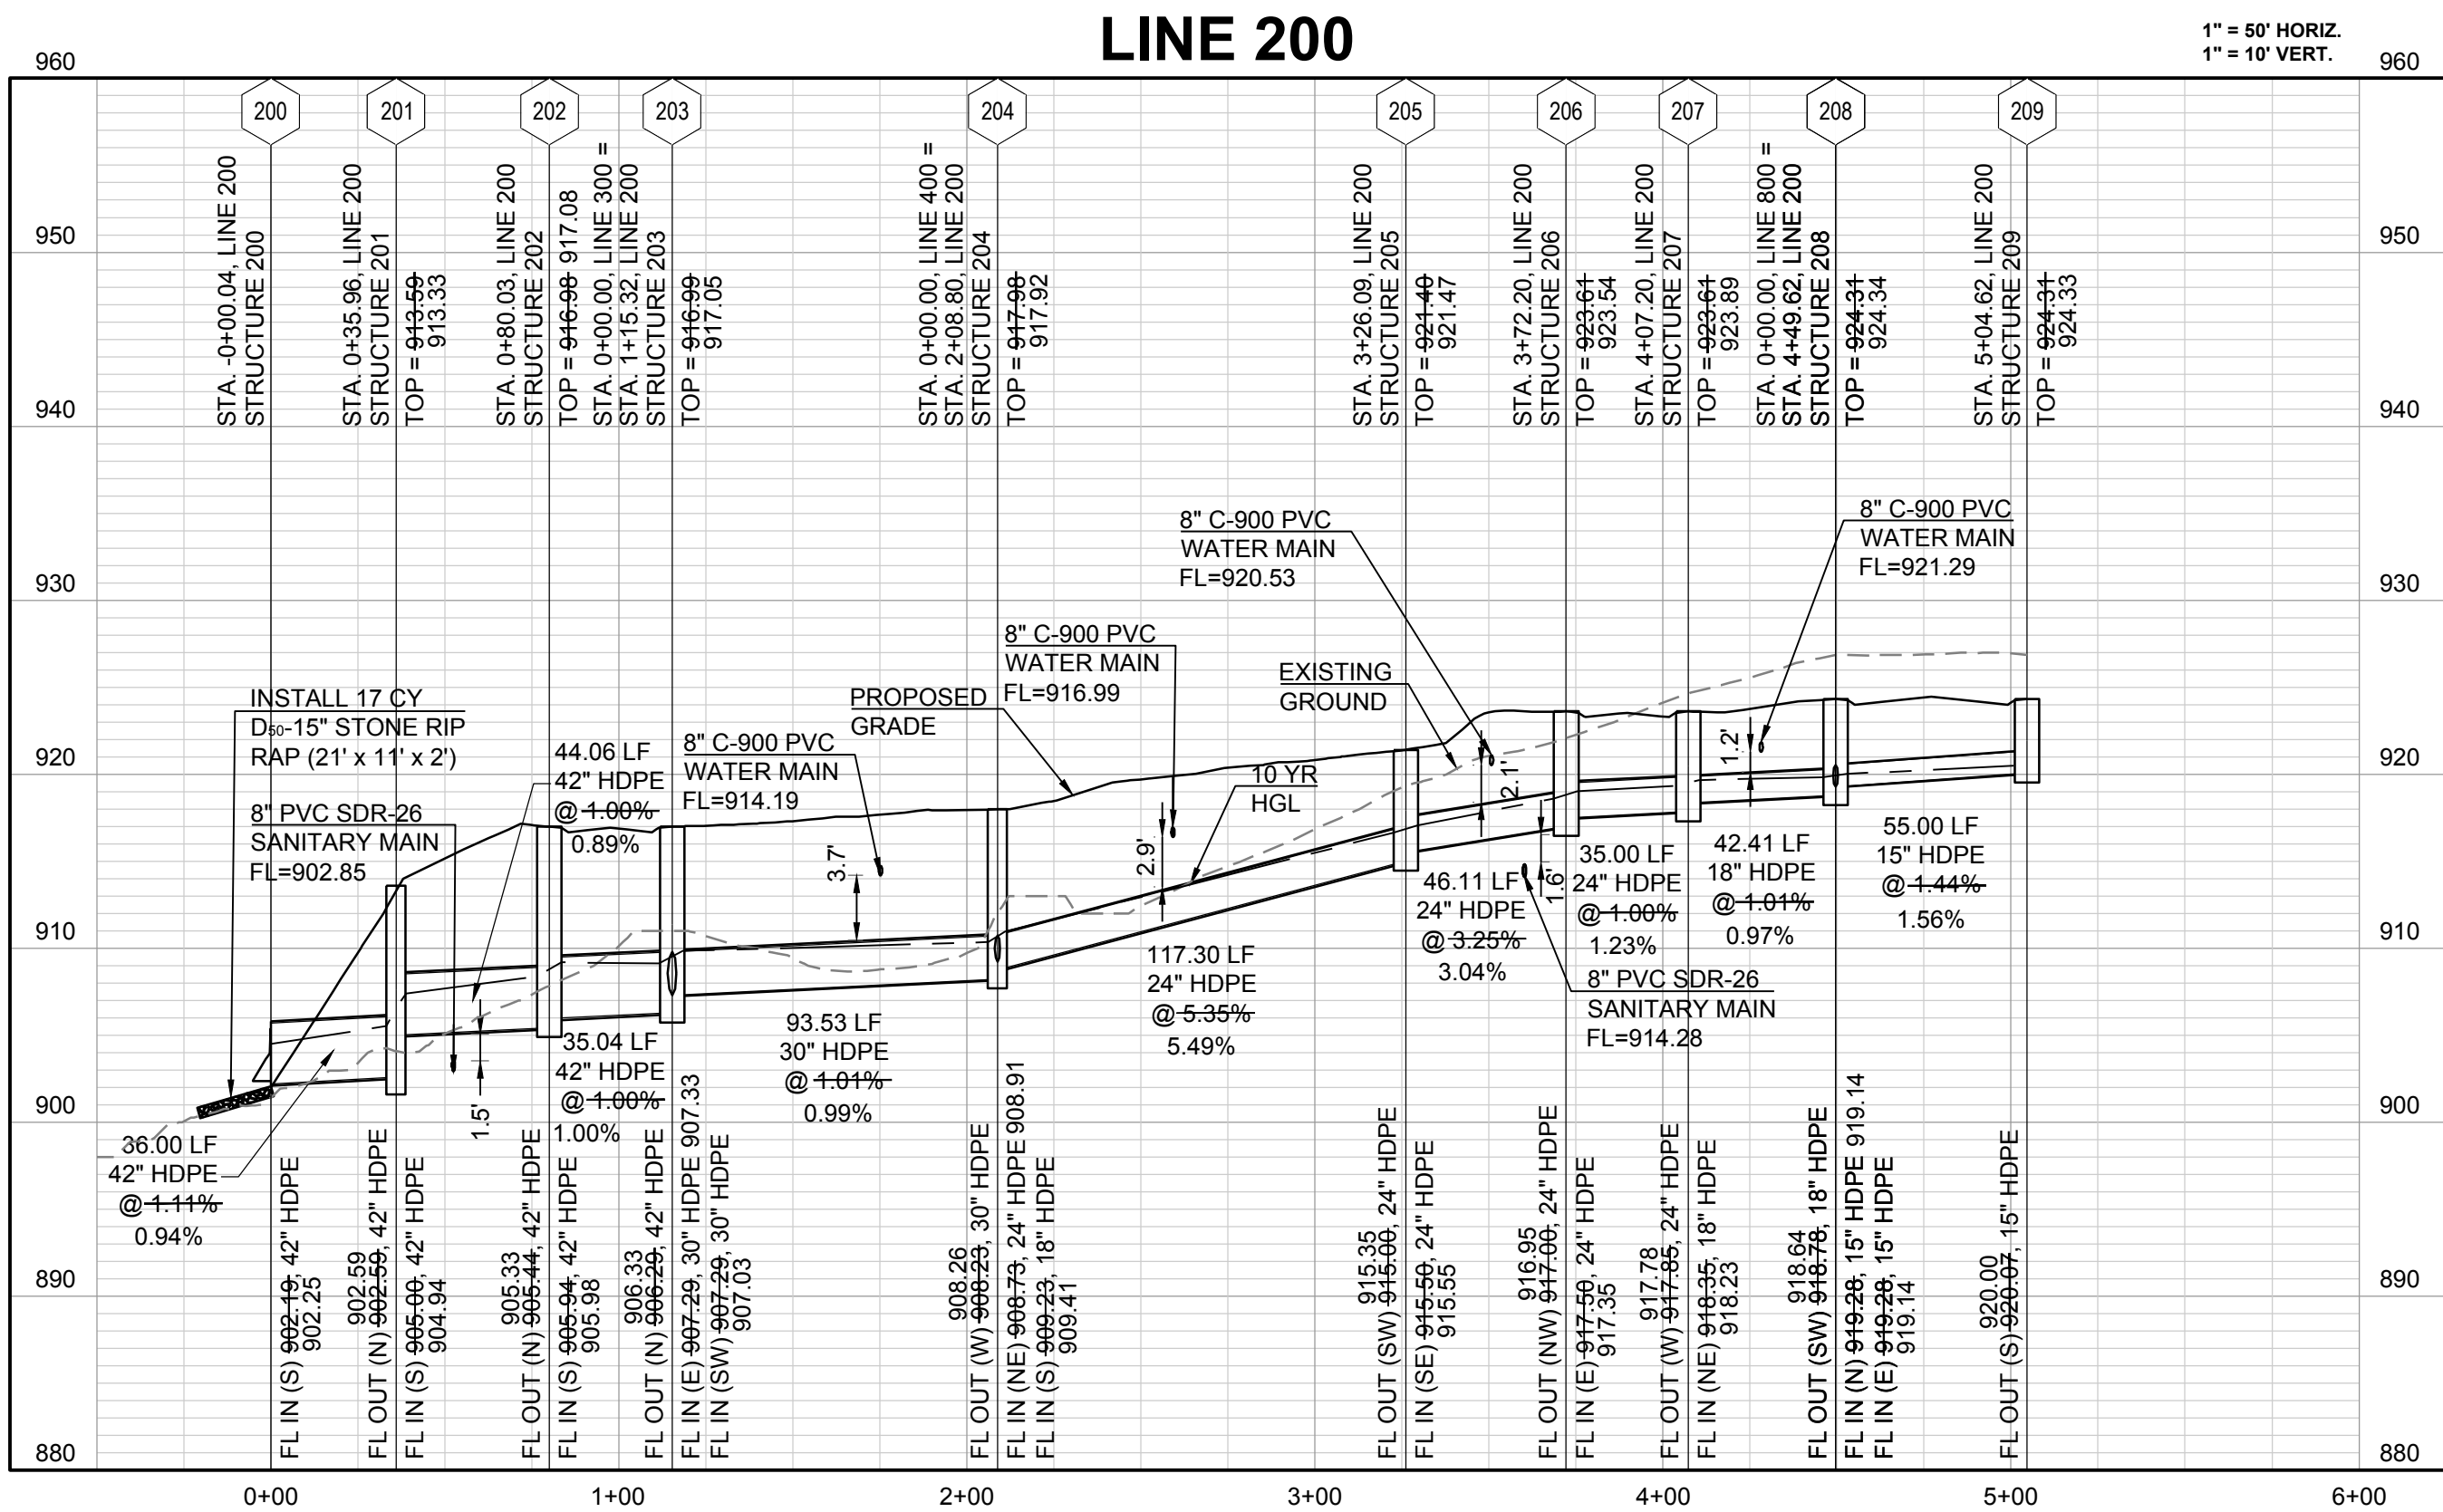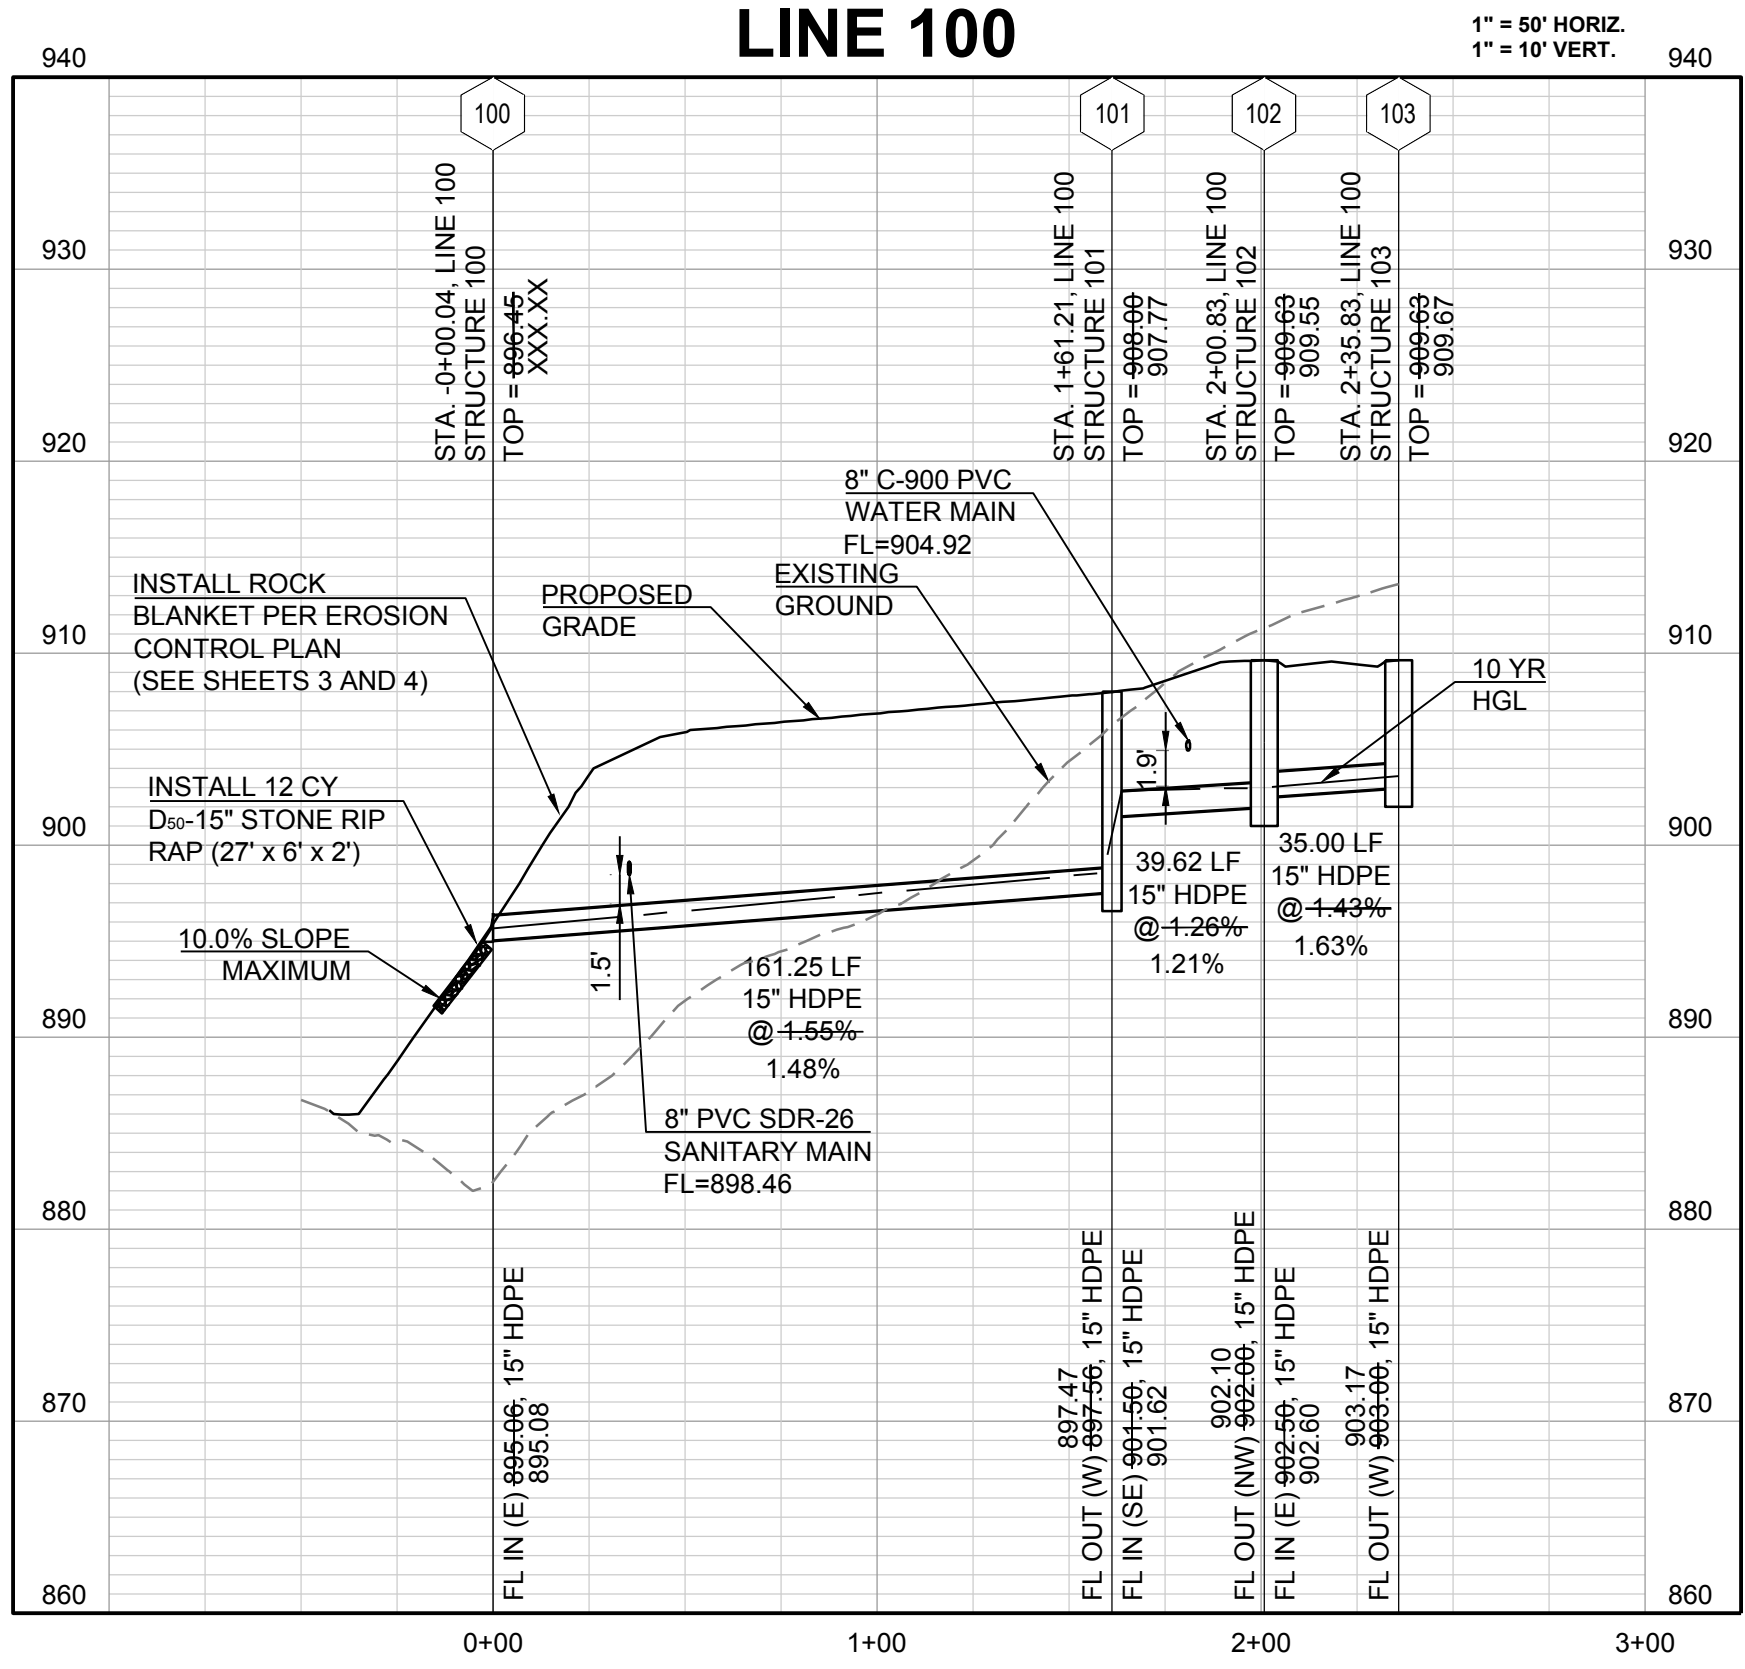

CONFORMING TO CONSTRUCTION RECORDS AS FURNISHED BY OTHERS.

KSC 7-23-19
BY DATE

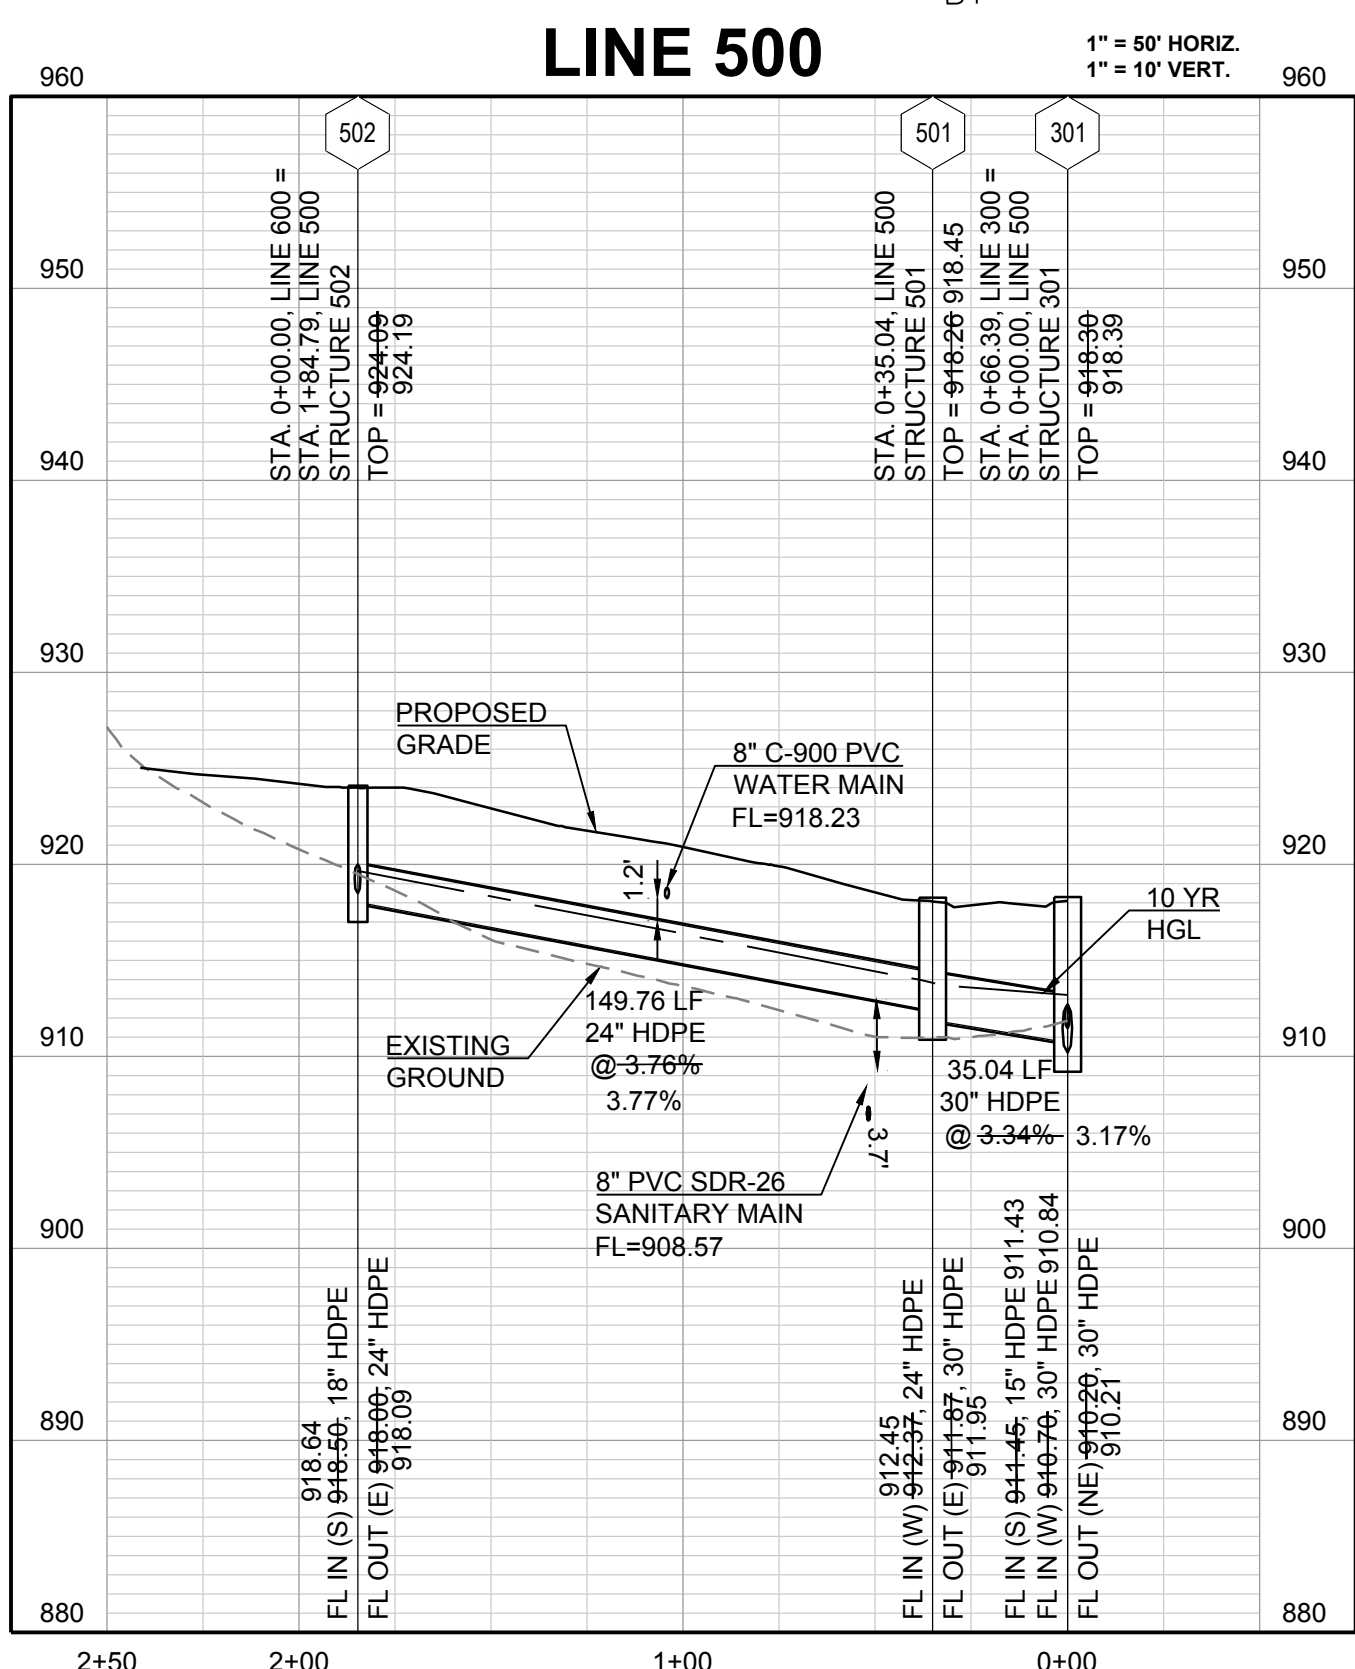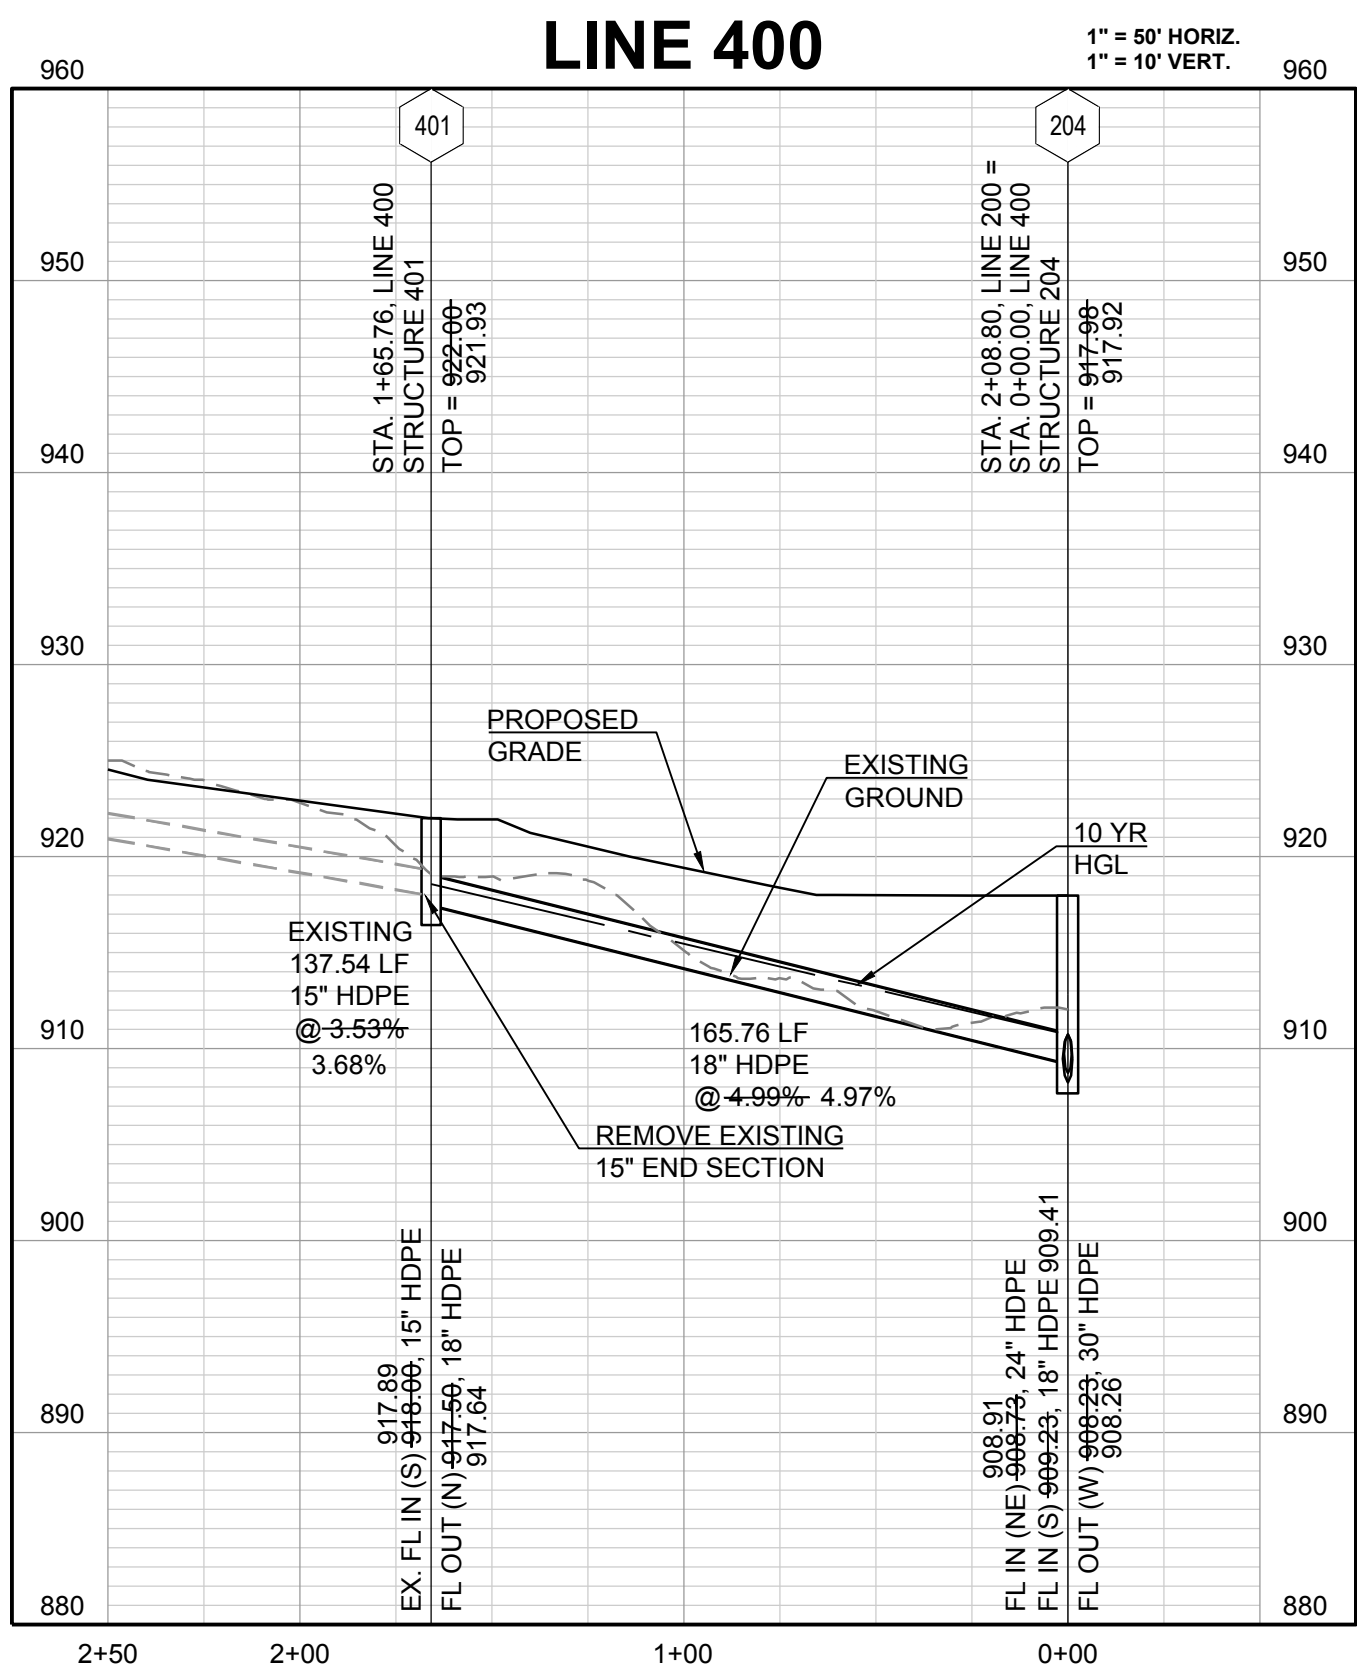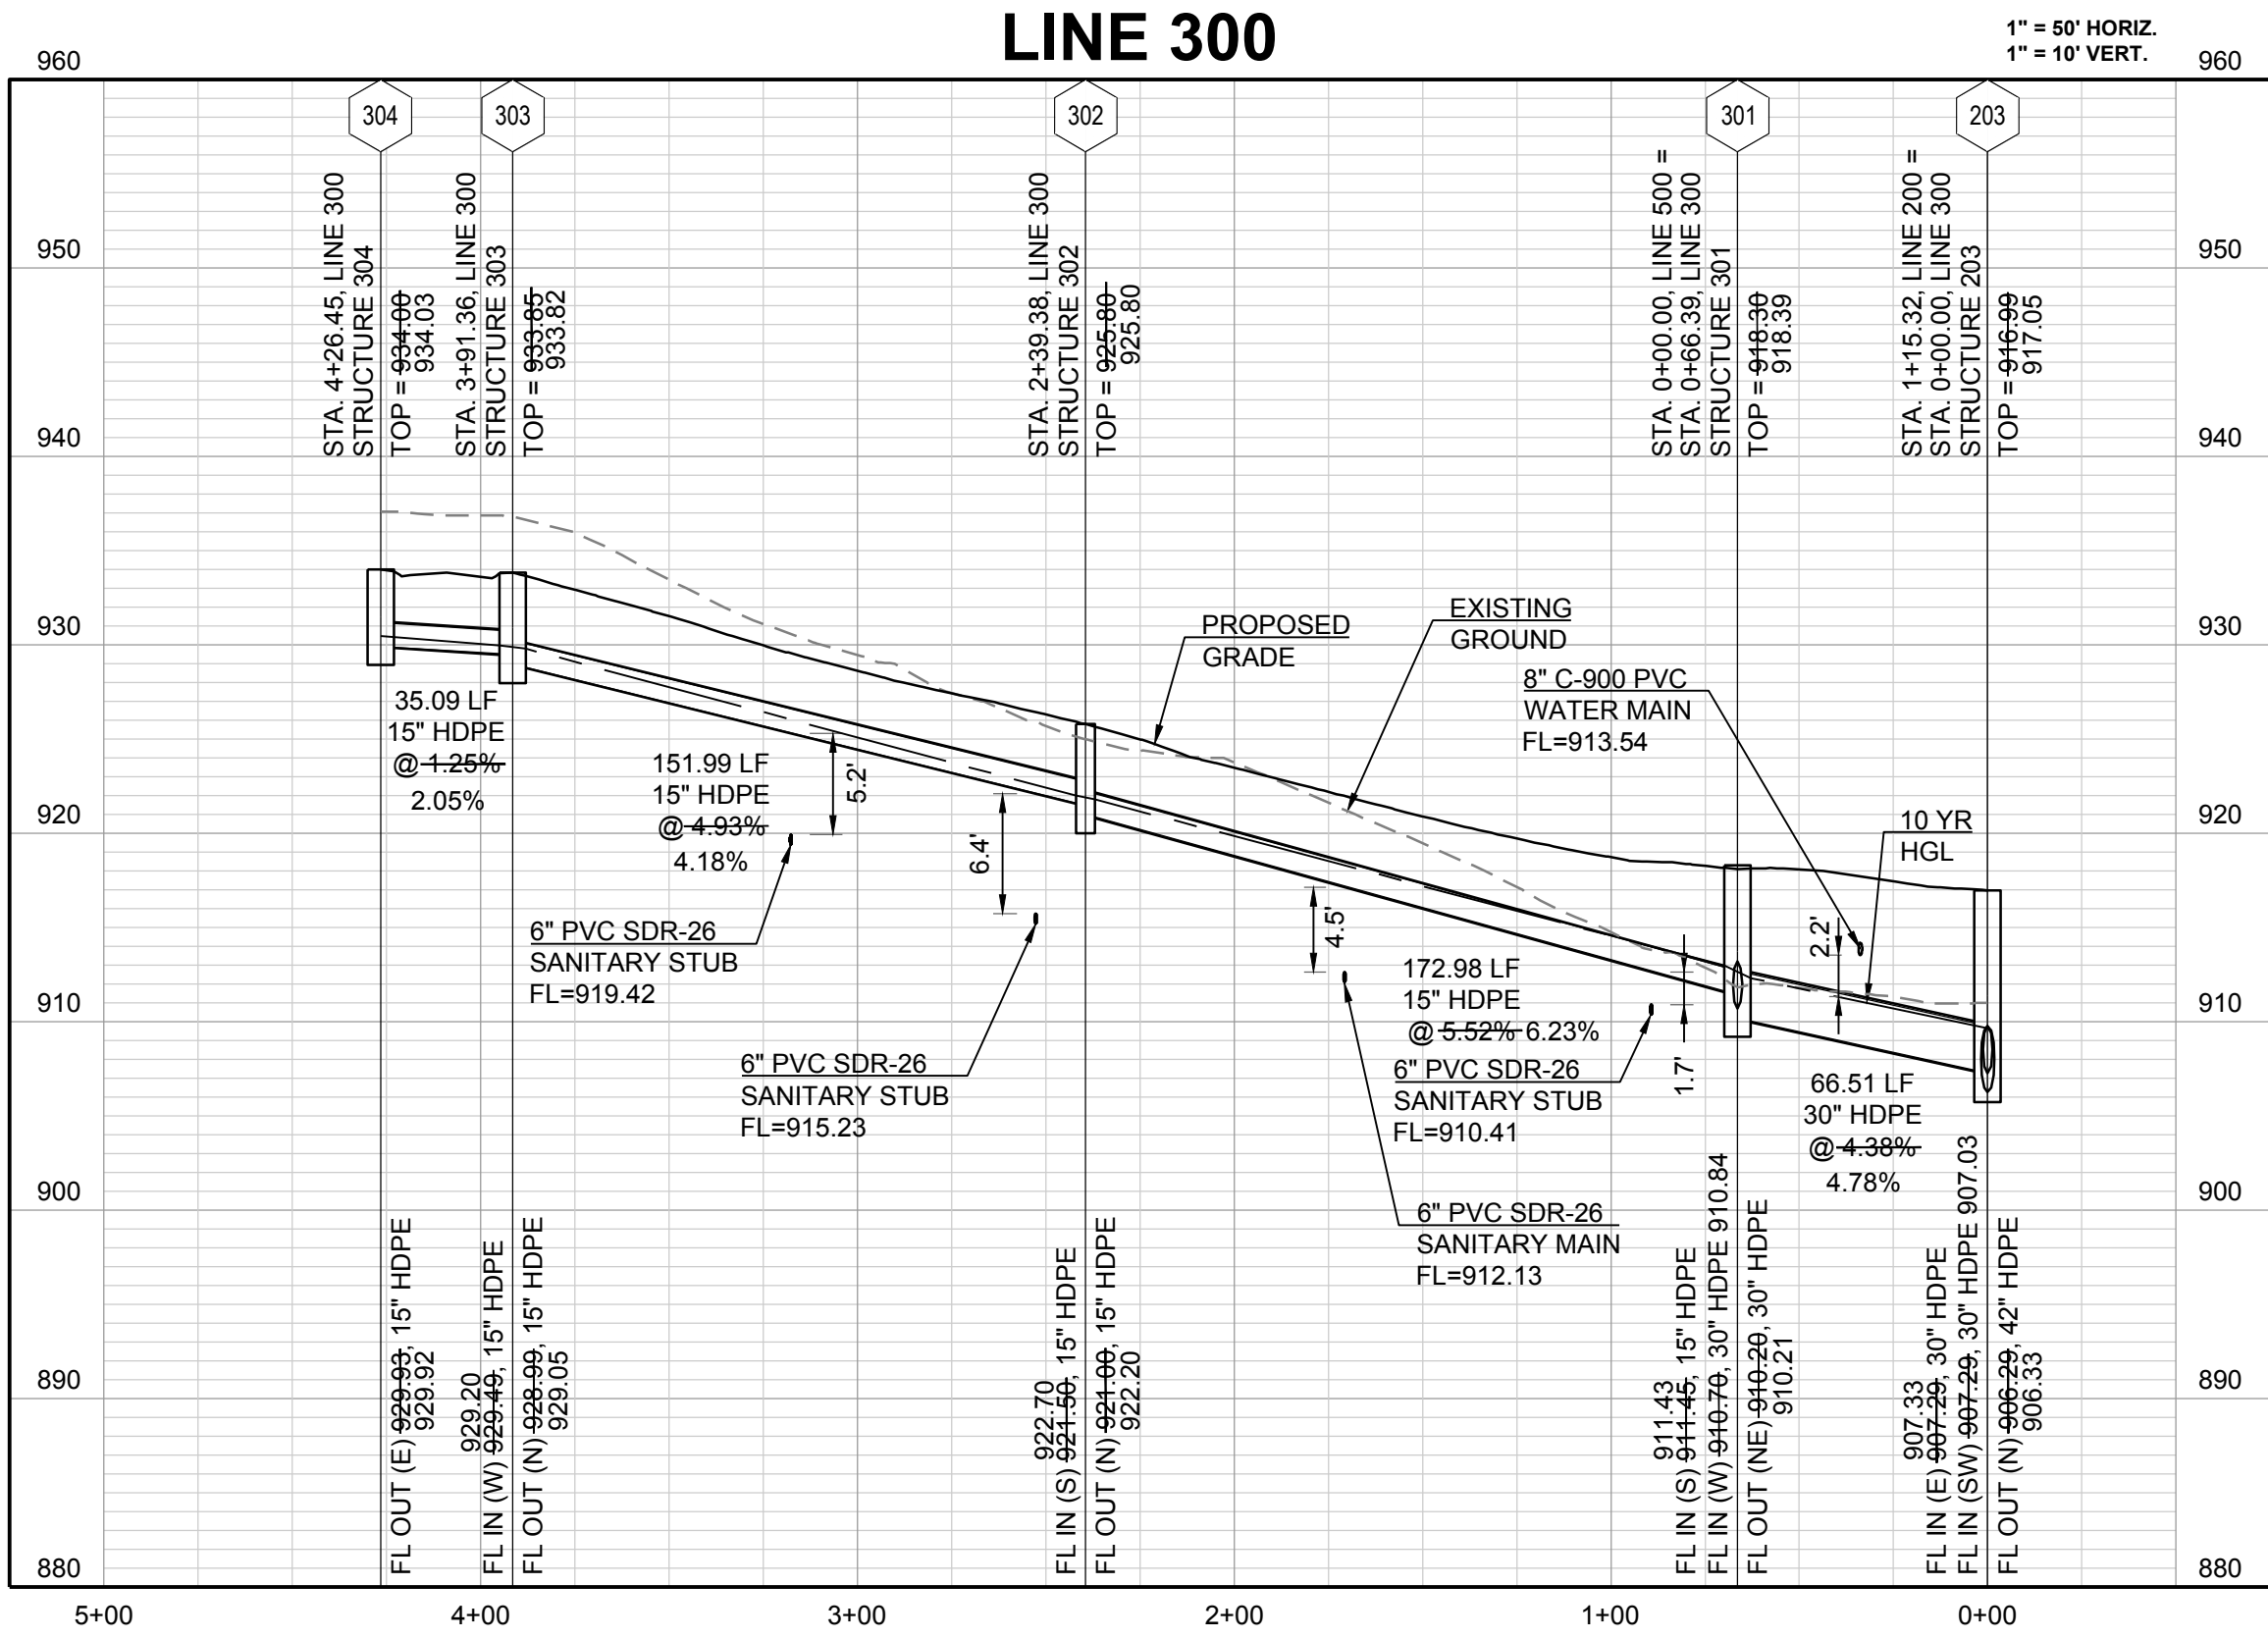

PROJECT BENCH MARK:

SANITARY MANHOLE H2 AT NW CORNER OF LOT 1153 WINTERSET VALLEY 1ST PLAT, APPROX. 39' RT. OF CL OF NW PEALE BLVD.
ELEV. 935.45'

REVISION	DATE	DESCRIPTION
1	06/04/2018	CITY COMMENTS
2	07/30/2018	CITY COMMENTS
3	08/28/2018	CITY COMMENTS/SHPO FINDINGS
4	08/27/2019	REVISE STREET NAMES
5	8/29/2019	REVISE RETAINING WALLS
6		
7		
8		
9		
10		

STORM PROFILE

SHEET

I:\PROJECTS\2017\17-134\3.0 Design\3.0 DWG Plans\6.0 SS\17-134-SS-STORM PLAN AND PROFILE.dwg, 10/23/2019 1:58:40 AM, 1:1

OUTLET RIP-RAP DESIGN WORKSHEET v1.0

Rip-Rap Sizes:	
0.50 (10#)	(ft)
0.75 (25#)	(ft)
1.00 (50#)	(ft)
1.50 (100#)	(ft)
2.00 (200#)	(ft)

DESIGN NOTES:




1. Rip-Rap width calculated to be either D+4'3"D, or top width of channel, whichever is greater
2. Rip-Rap length calculated to be $1/(2*\tan(e))*A/Yt-3$, where e=20°, A=flow area, and Yt=normal depth
3. D50 calculated using $(1/2)(1.384*V^2/(s-1))*2g$ (Eqn. 10, pg.32, HEC-11), where V=Outlet Velocity, s=Specific Gravity of Stone=2.65, and g=32.2
4. Critical Shear Stresses provided by A.P.W.A. 5600
5. Rip-Rap thickness equals 2"D50 for 12" and smaller rip-rap, and 1.5"D50 for larger than 12"

Outlet/Channel Properties						Rip-Rap Dimensions									
Outlet Structure	Pipe Size (ft)	Downstream Channel/Swale Section	V Pipe (ft/s)	V Swale (ft/s)	Average Shear Stress (lb/ft²)	W Calculated (ft)	W USED (ft)	L Calculated (ft)	L (min.) 3"D (ft)	L (max.) 10"D (ft)	L USED (ft)	D50 Calculated (in)	Size (Wt.) USED (d50,in)	Critical Shear Stress (lb/ft²)	T (ft)
100	1.25	N/A	10.85	N/A	N/A	5.25	6	n/a	3.75	12.50	10	0.77	1.00 (50#)	4.00	2.00
200	3.50	N/A	11.94	N/A	N/A	10.50	11	n/a	10.50	35.00	20	0.93	1.00 (50#)	4.00	2.00

CONFORMING TO CONSTRUCTION
RECORDS AS FURNISHED BY
OTHERS.

KSC
BY

7-23-19
DATE

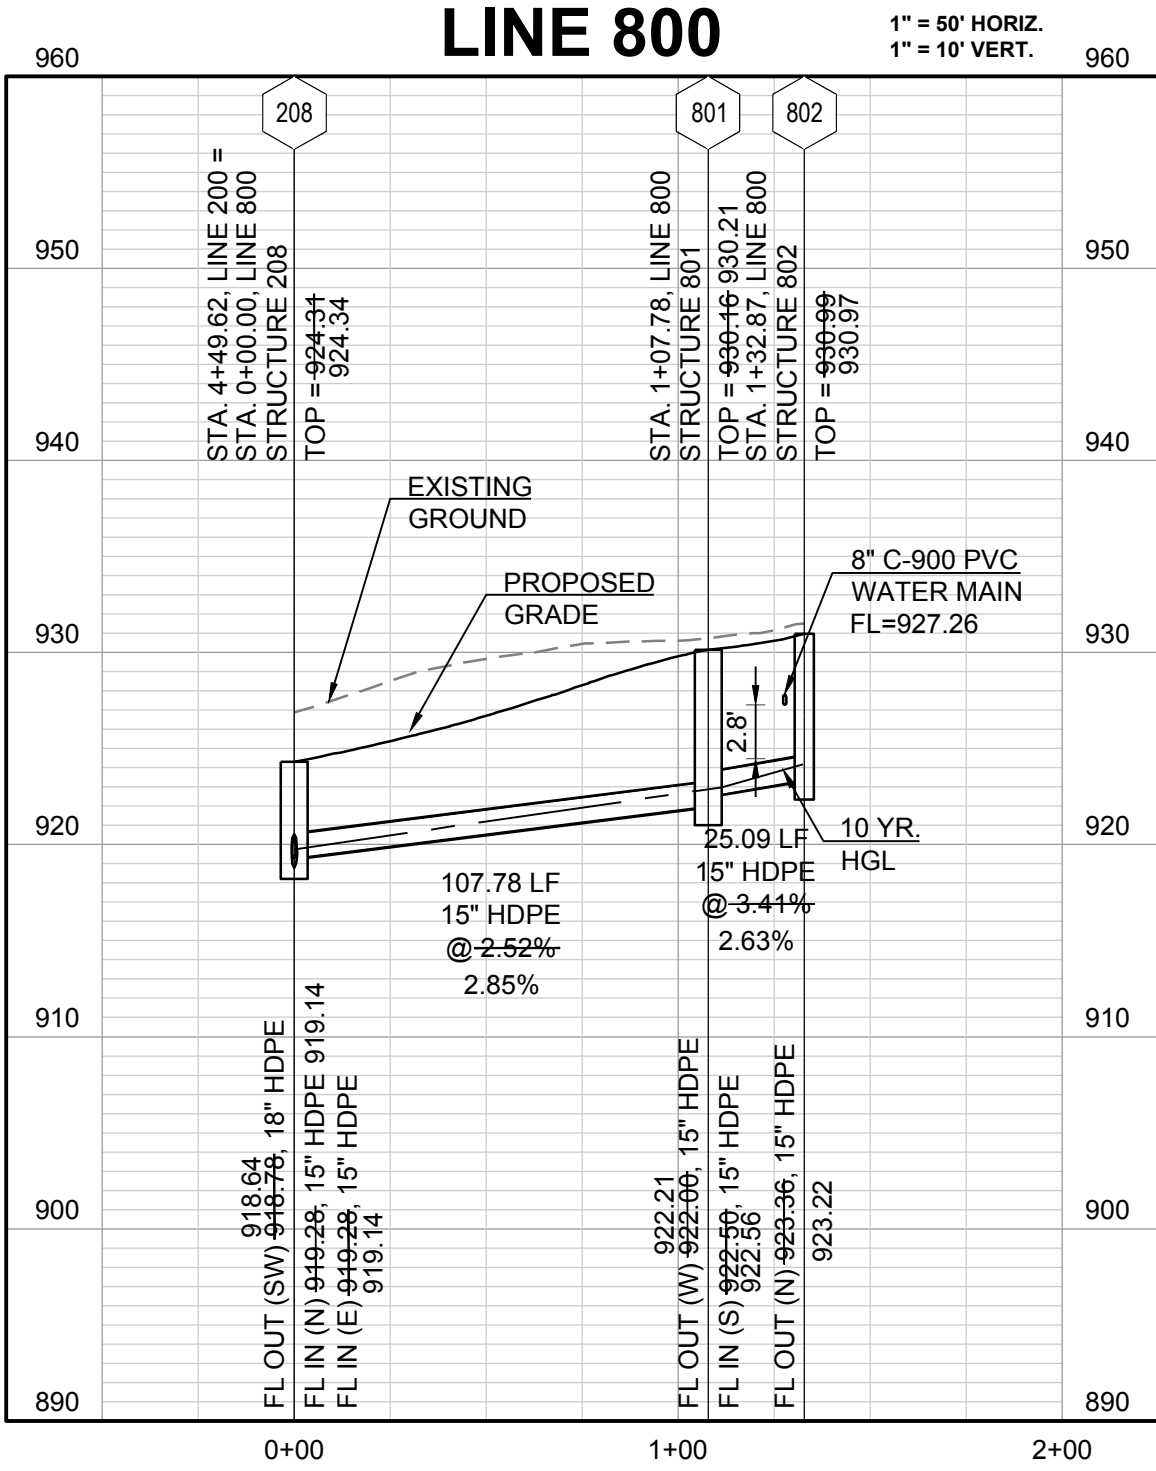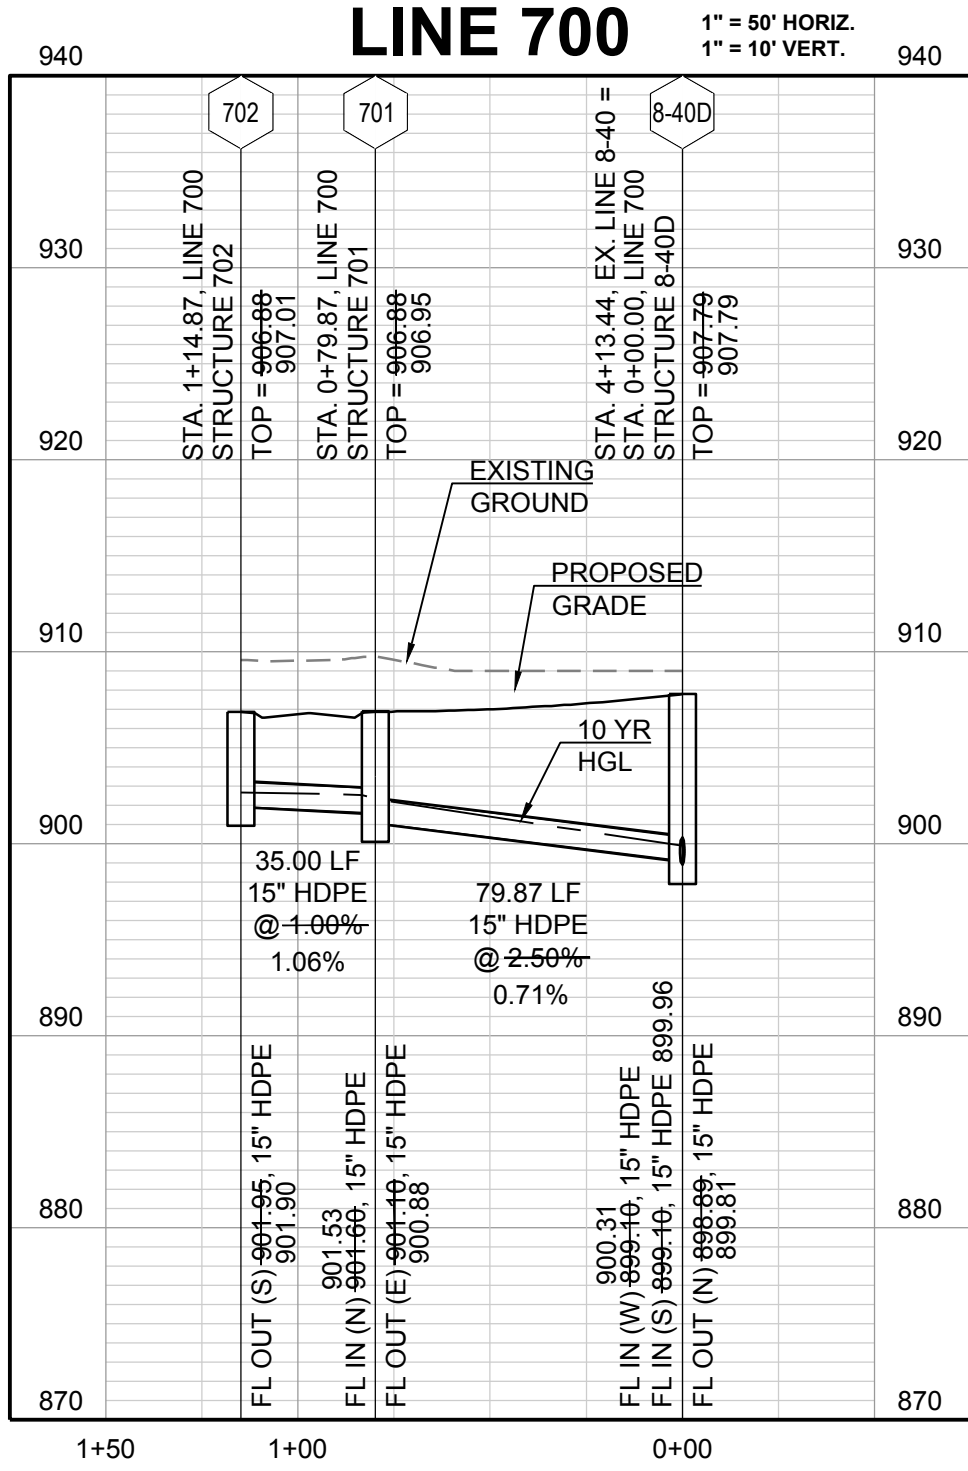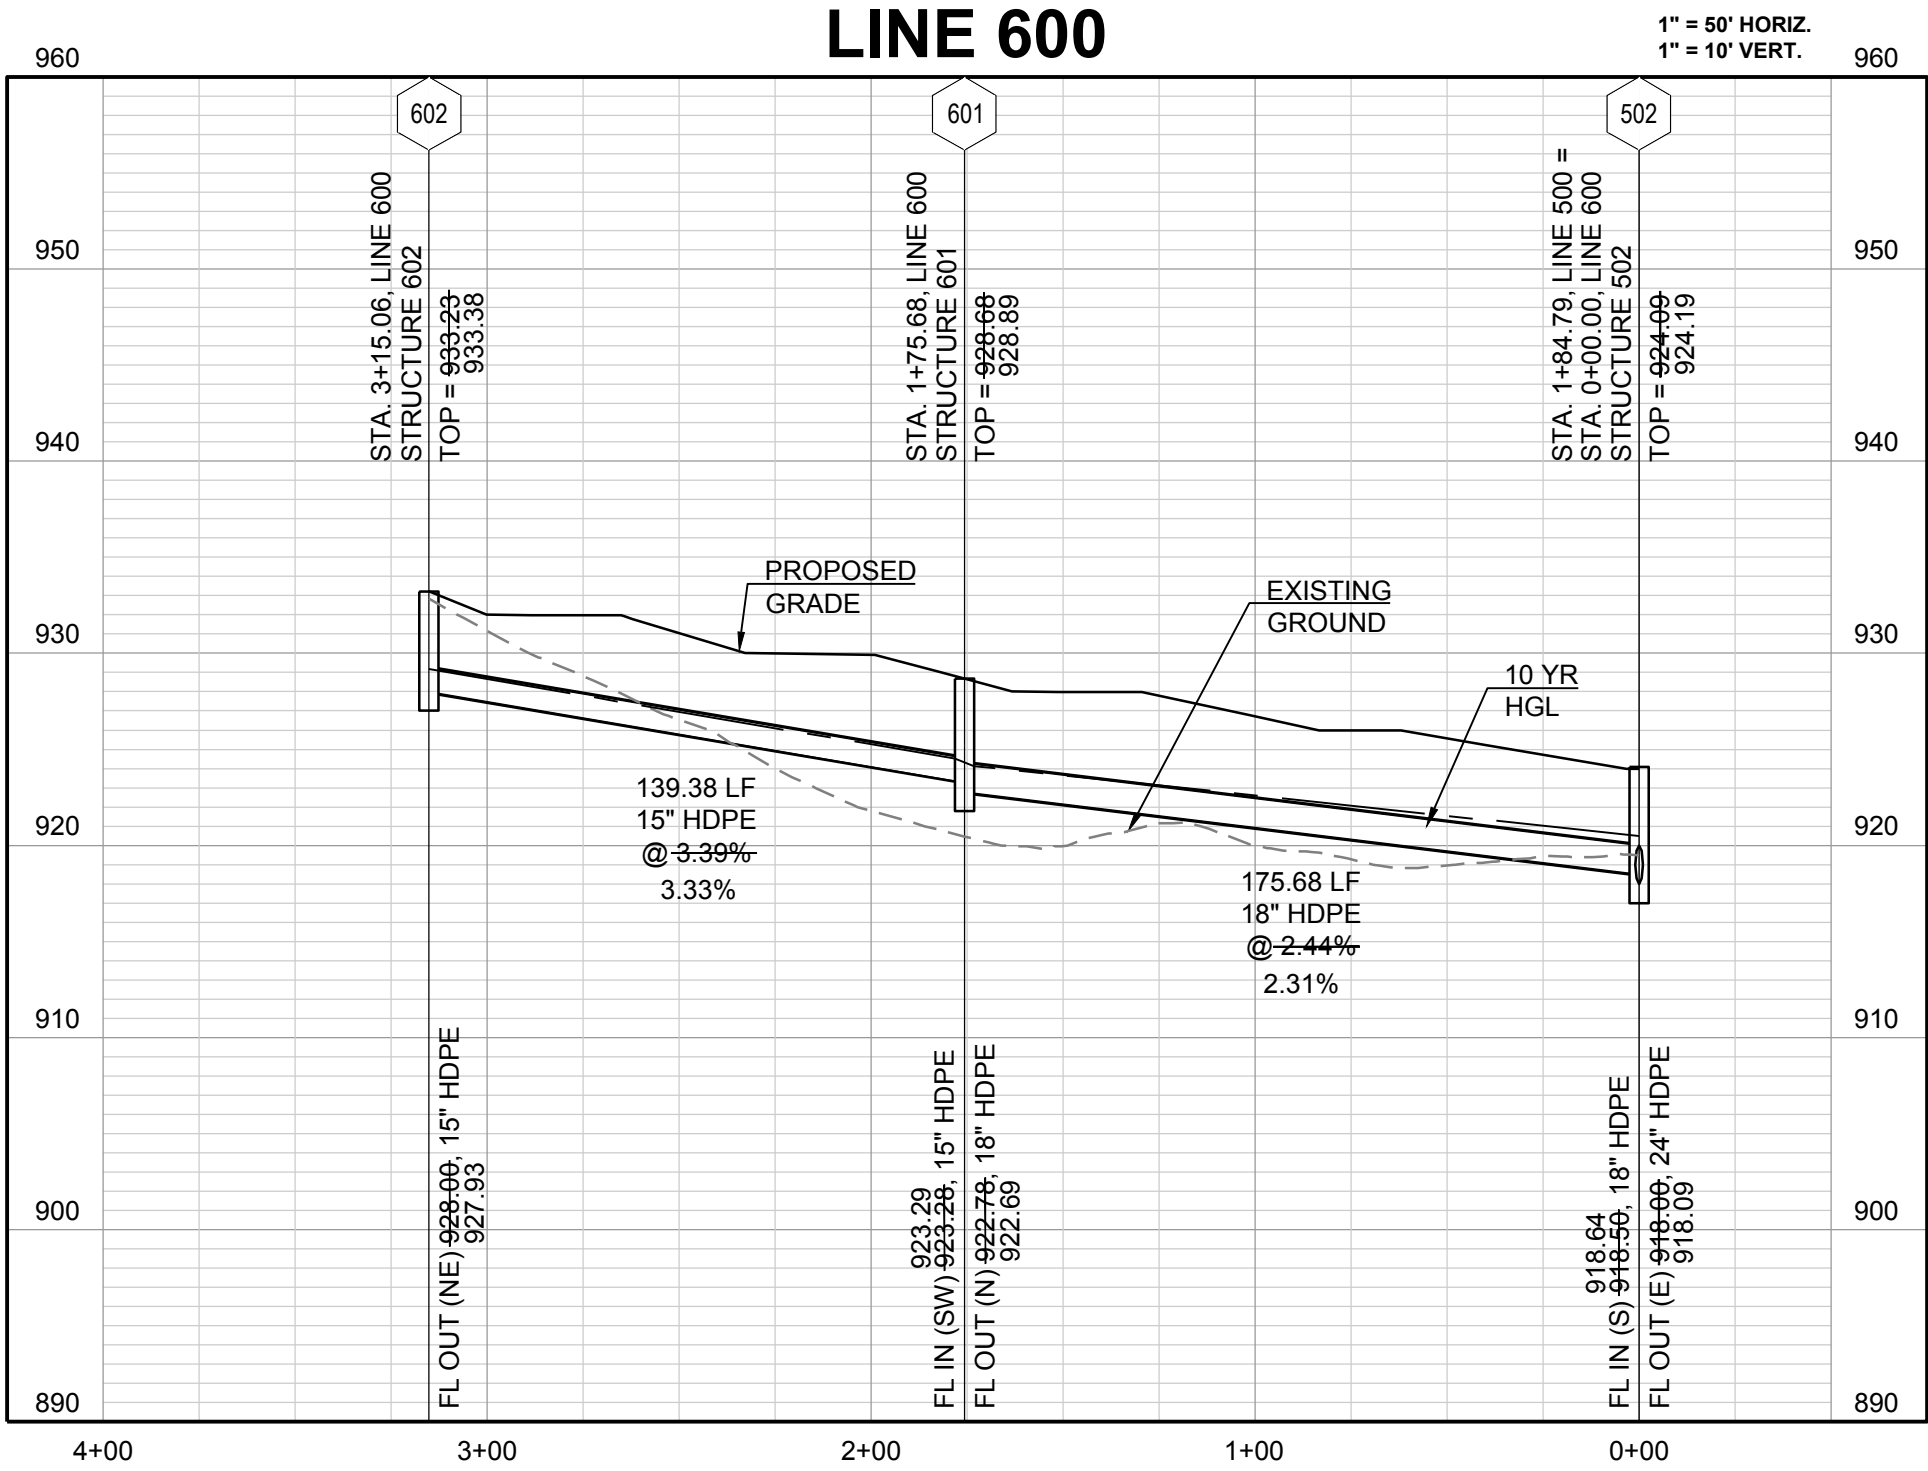

PROJECT BENCH MARK:

SANITARY MANHOLE H2 AT NW CORNER OF LOT 1153 WINTERSET
VALLEY 1ST PLAT, APPROX. 39' RT. OF CL OF NW PEALE BLVD.
ELEV. 935.45'

SCHLAGEL & ASSOCIATES, P.A.
Engineers • Planners • Surveyors • Landscape Architects
14920 West 107th Street • Lenexa, Kansas 66215
(913) 492-5158 • Fax: (913) 492-8400
WWW.SCHLAGELASSOCIATES.COM
Missouri State Certificates of Authority
#E2002003600-F #AC200100237 #LS200200859-F

10.23.19


WINTERSET VALLEY, 12TH PLAT
STREET, STORMWATER, MASTER DRAINAGE PLAN AND
EROSION AND SEDIMENT CONTROL
AUDUBON LANE AND CARSON DRIVE
LEE'S SUMMIT, MO

REVISION DATE	DESCRIPTION
06/04/2018	CITY COMMENTS
07/30/2018	CITY COMMENTS
08/28/2018	CITY COMMENTS/SHPO FINDINGS
08/27/2019	REVISE STREET NAMES
8/29/2019	REVISE RETAINING WALLS
4/20/18	
17-134	

STORM PROFILE

SHEET


19
OF 25

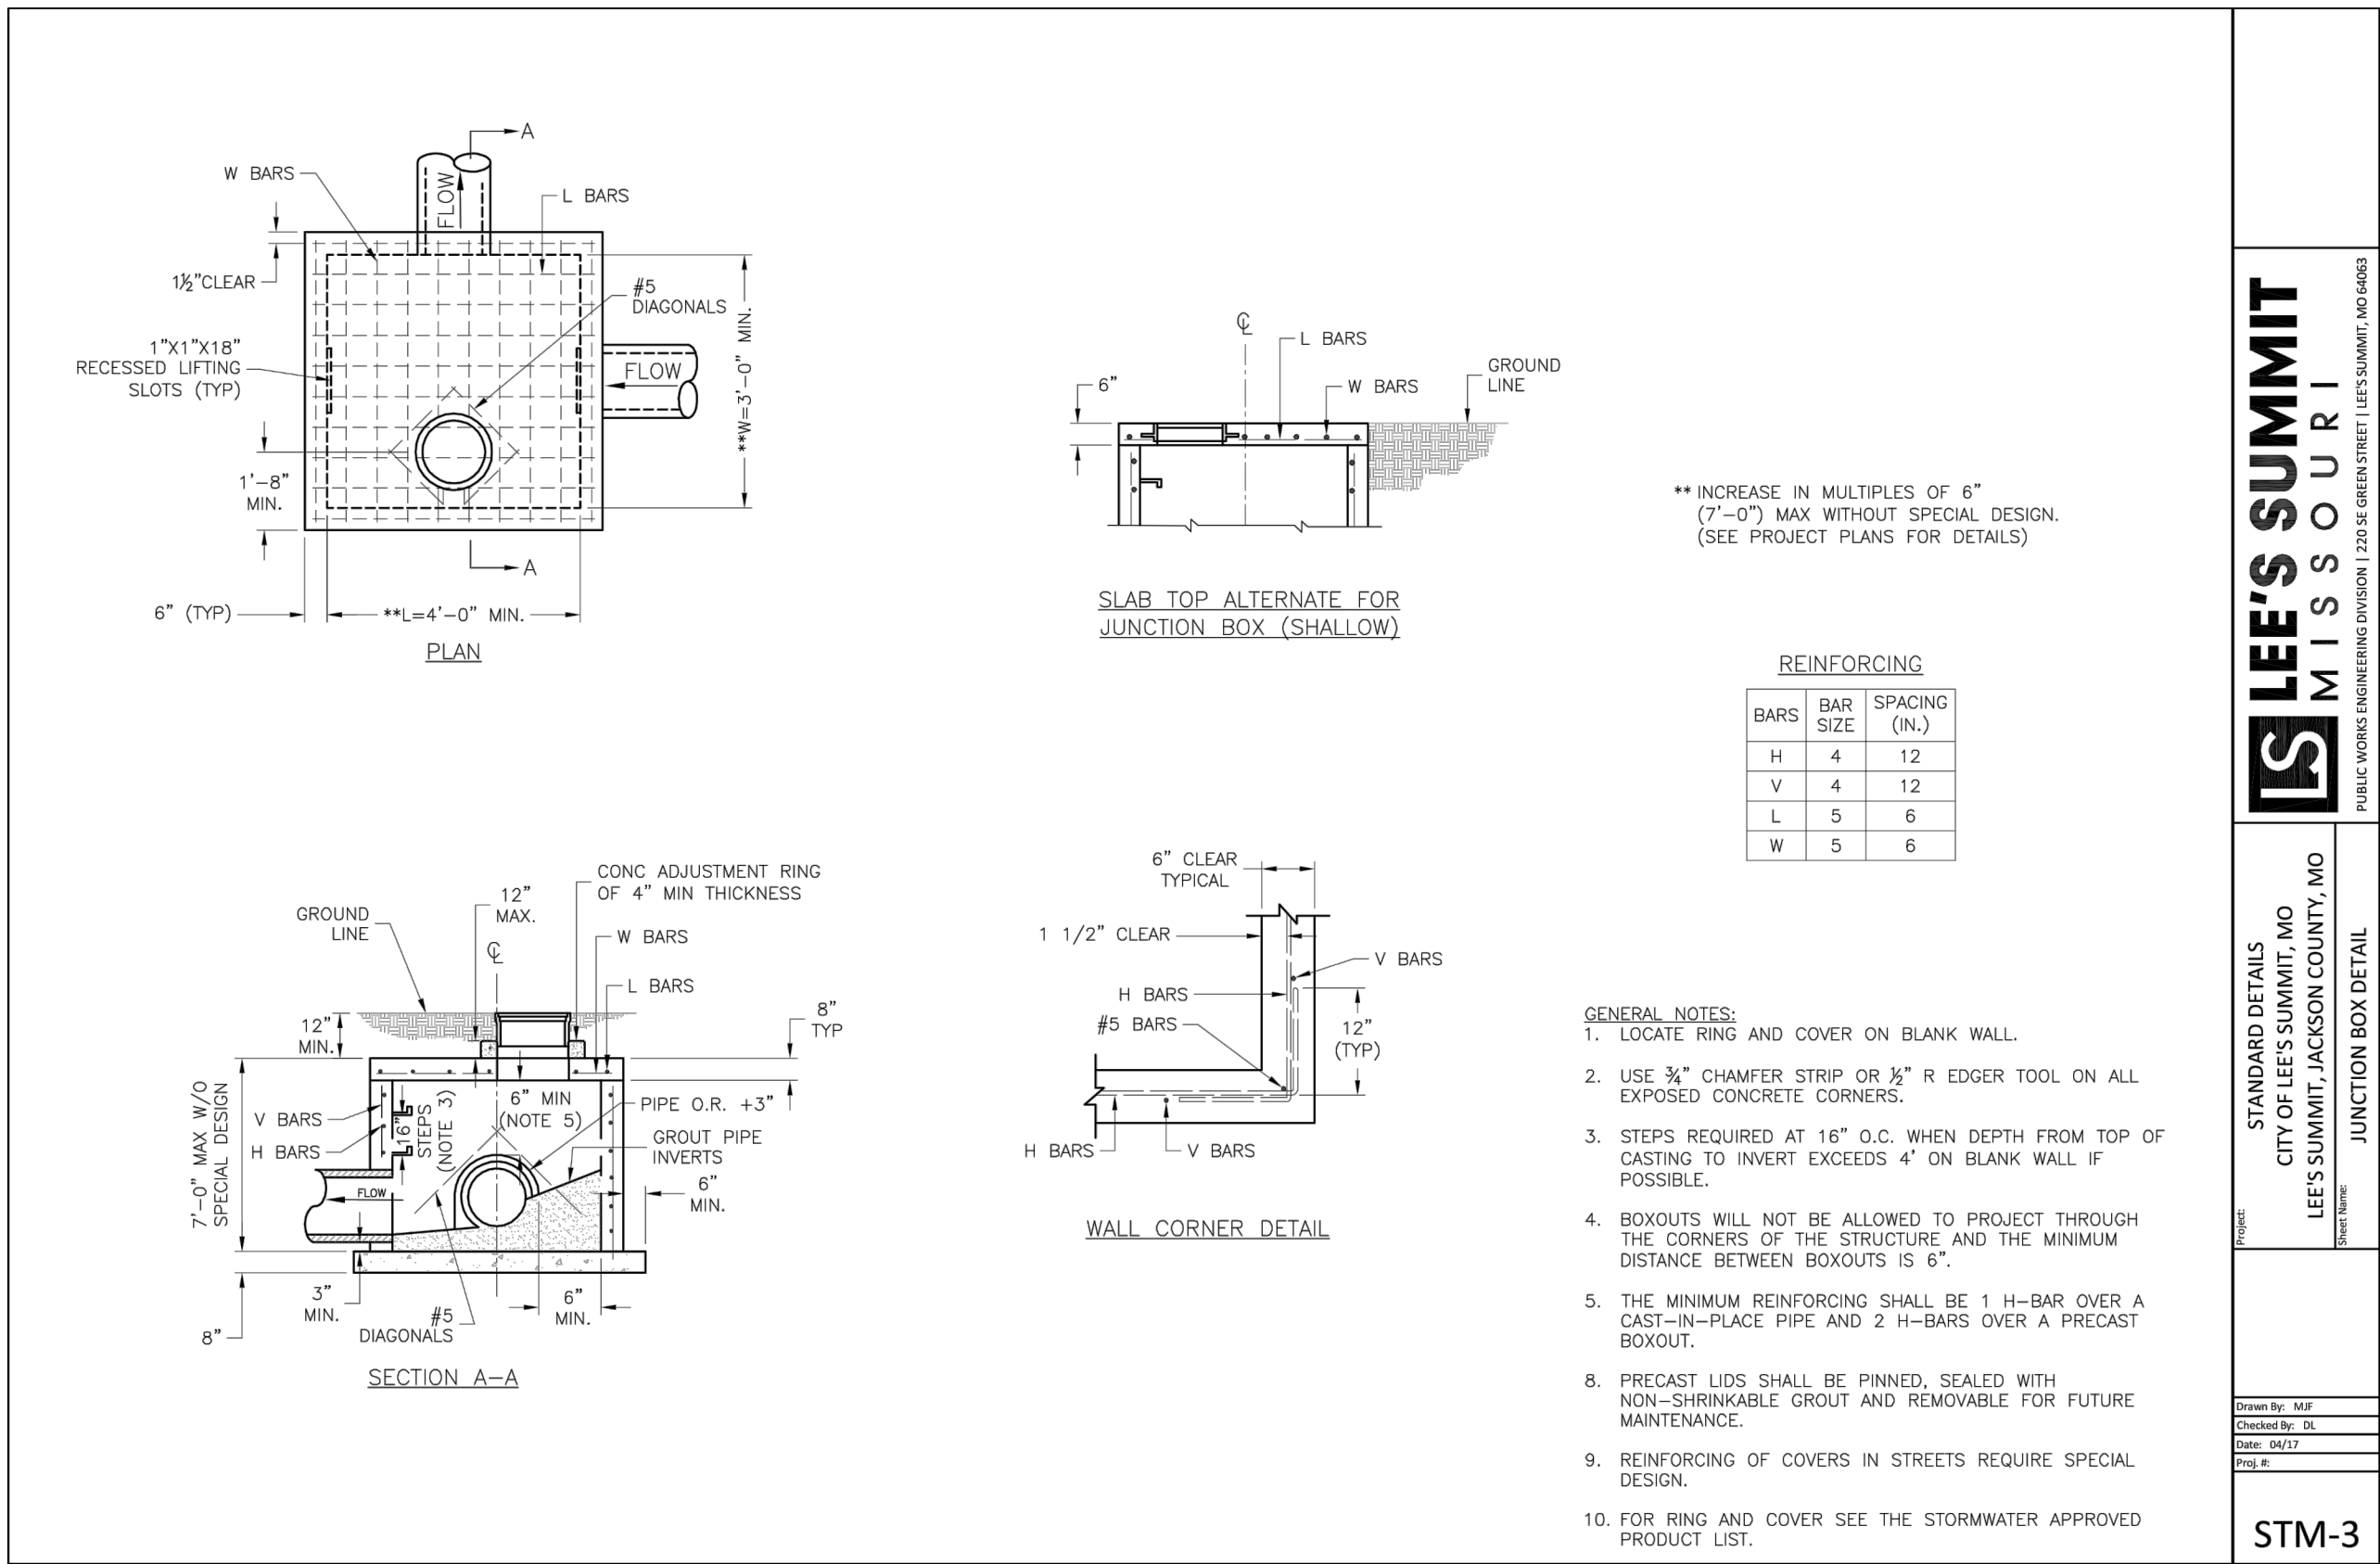

LEE'S SUMMIT
MISSOURI

STANDARD DETAILS
CITY OF LEE'S SUMMIT, MO
LEE'S SUMMIT, JACKSON COUNTY, MO


STM-3

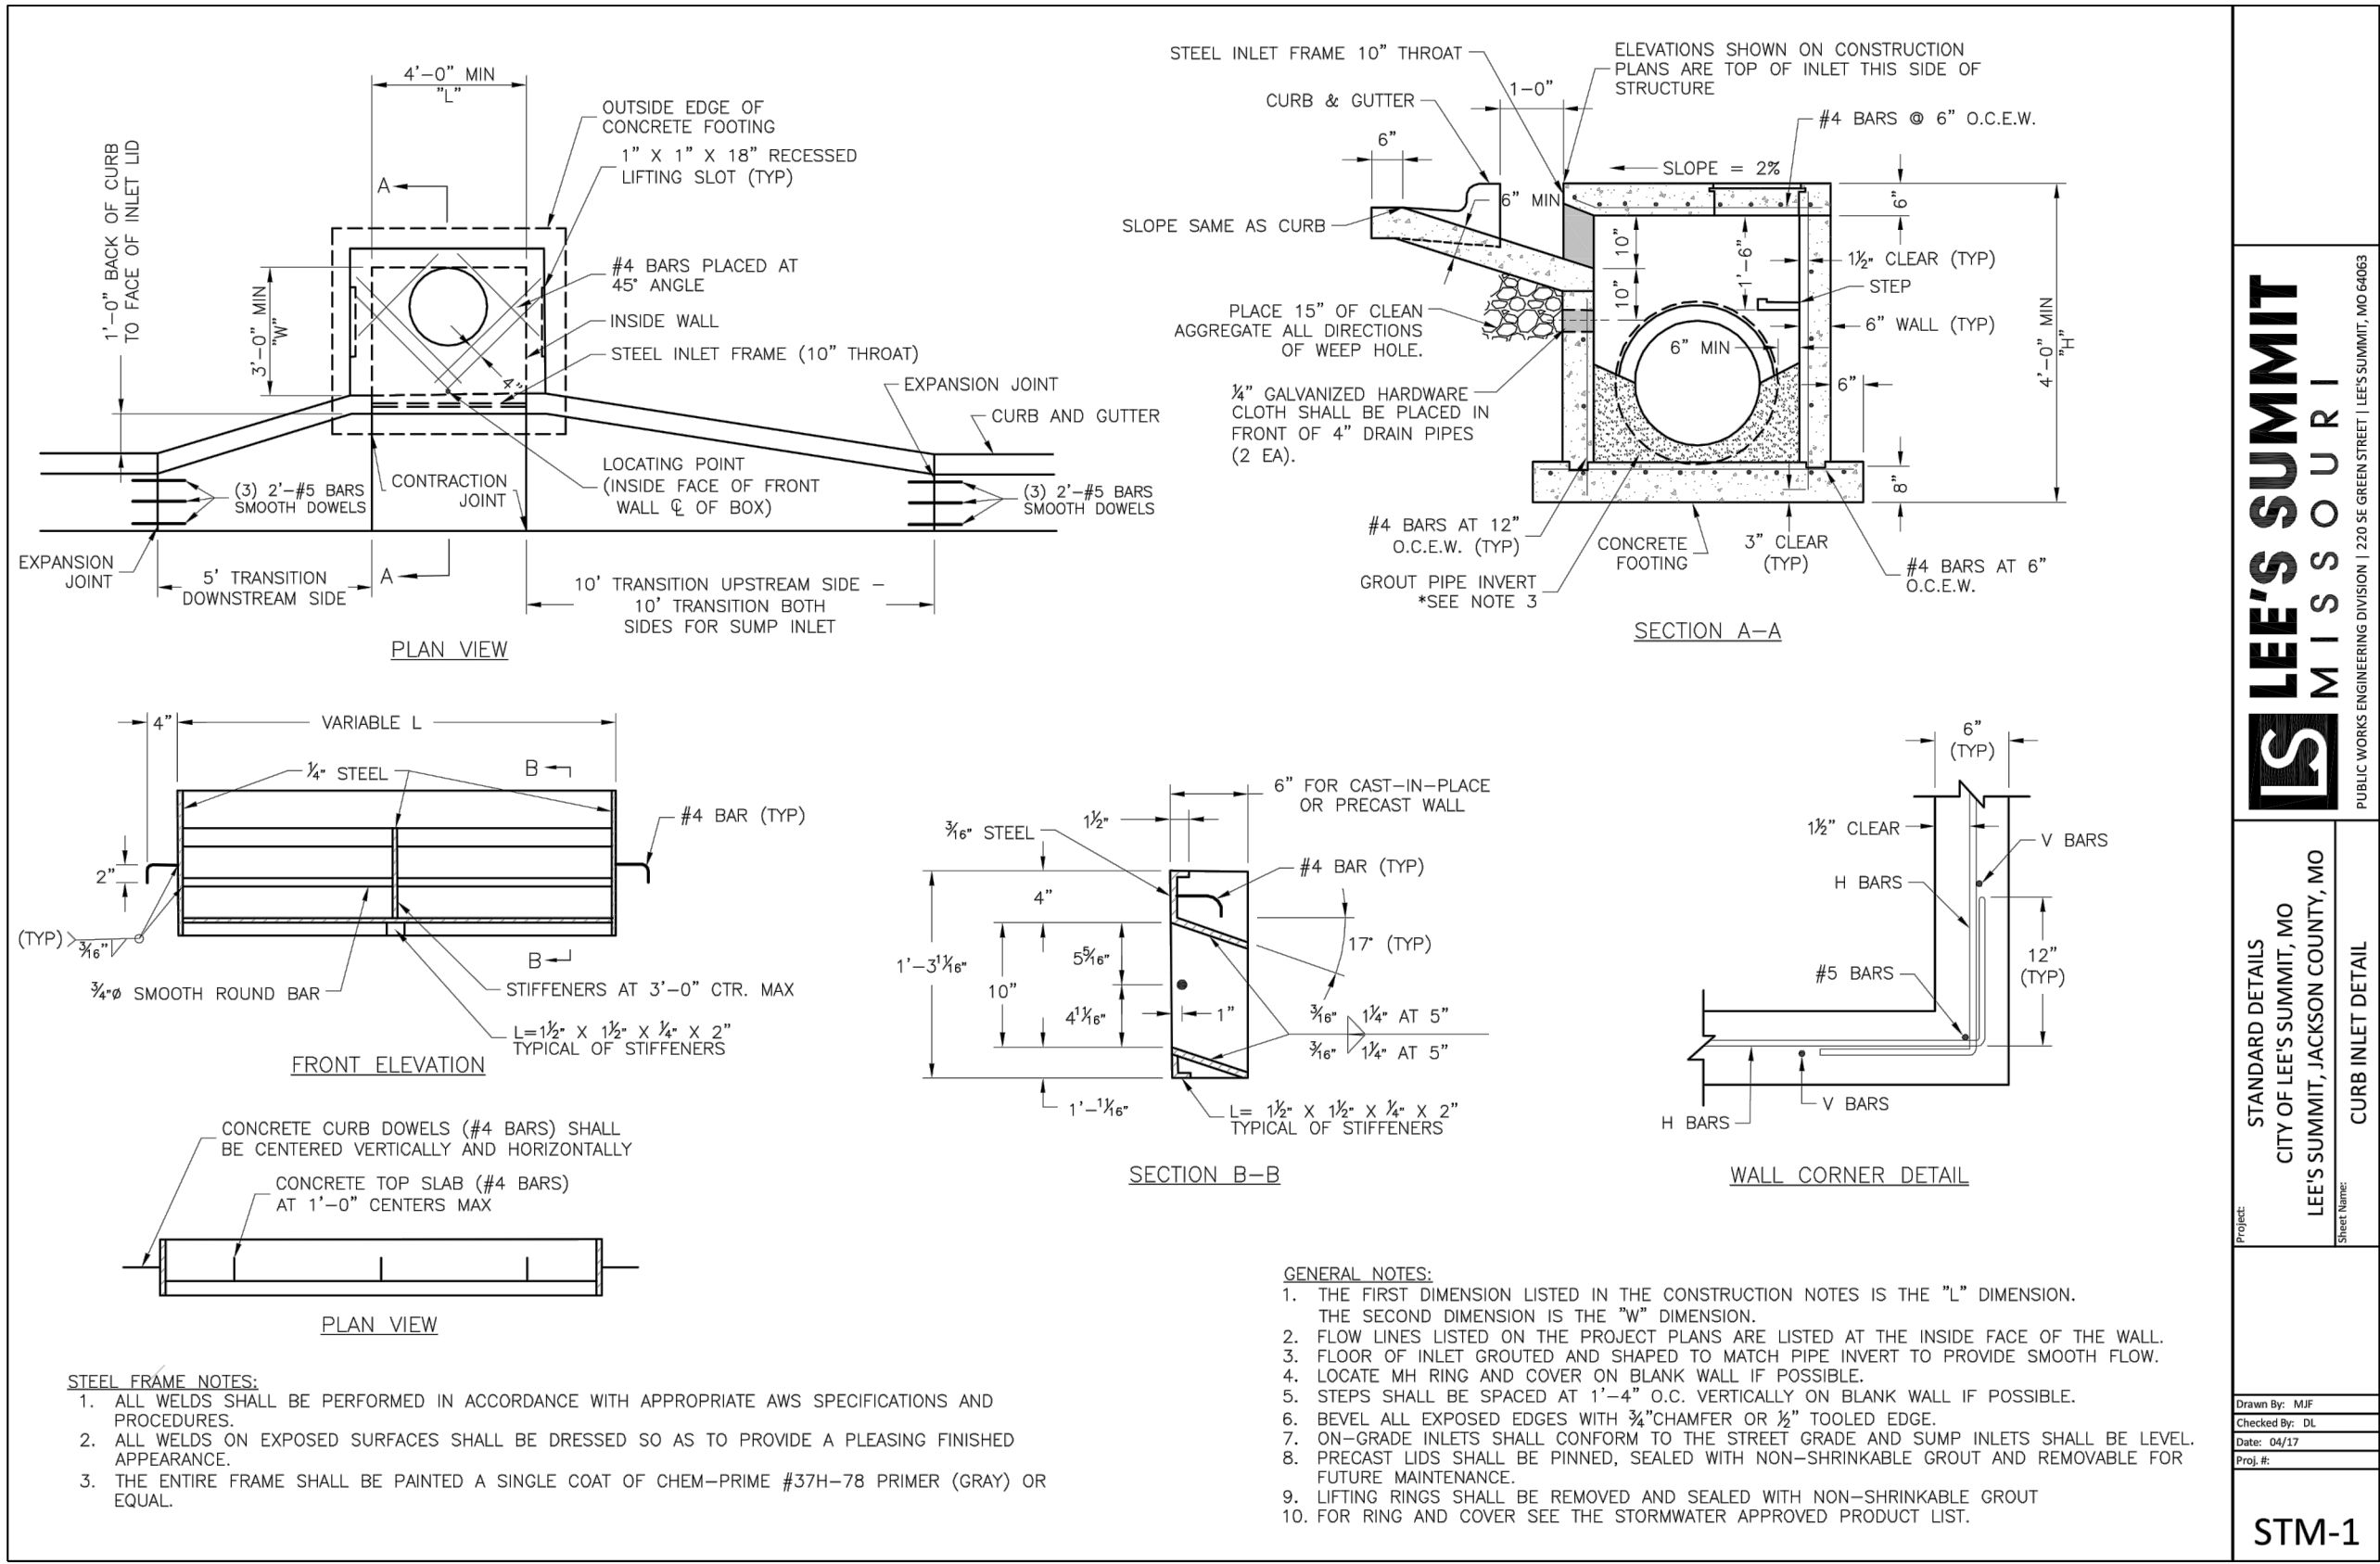

LEE'S SUMMIT
MISSOURI

STANDARD DETAILS
CITY OF LEE'S SUMMIT, MO
LEE'S SUMMIT, JACKSON COUNTY, MO


STM-1

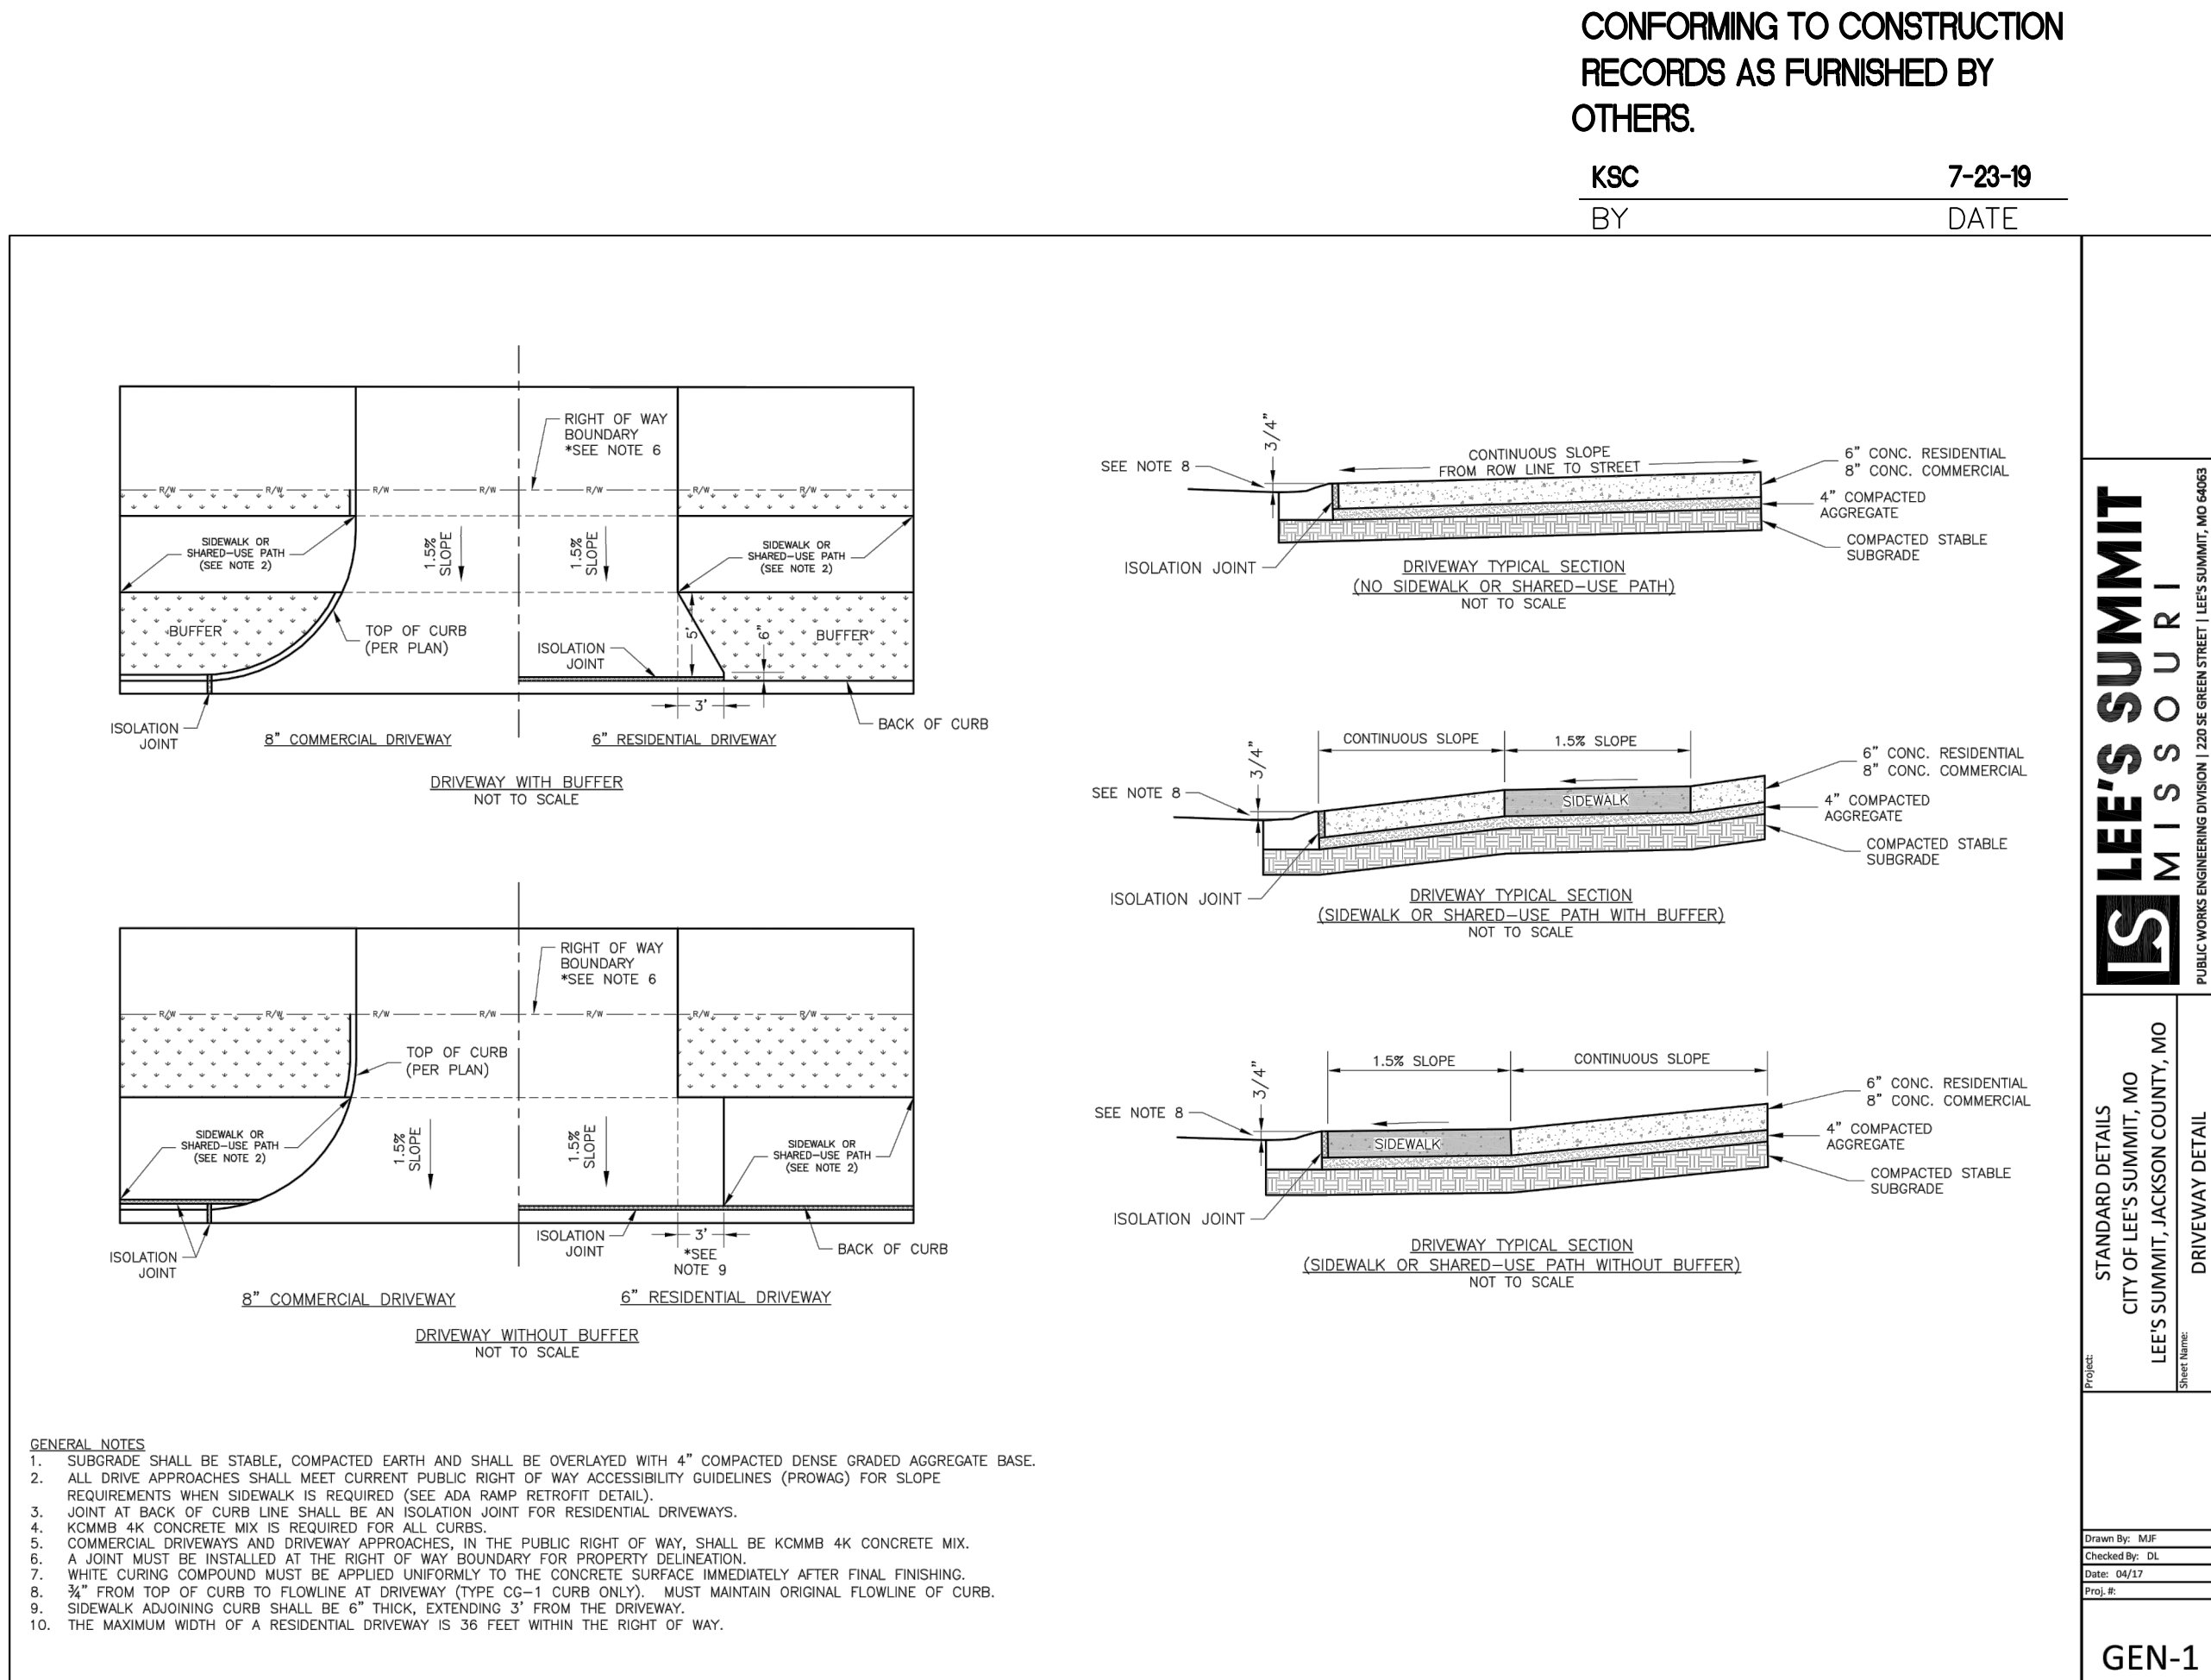

LEE'S SUMMIT
MISSOURI

STANDARD DETAILS
CITY OF LEE'S SUMMIT, MO
LEE'S SUMMIT, JACKSON COUNTY, MO

GEN-1

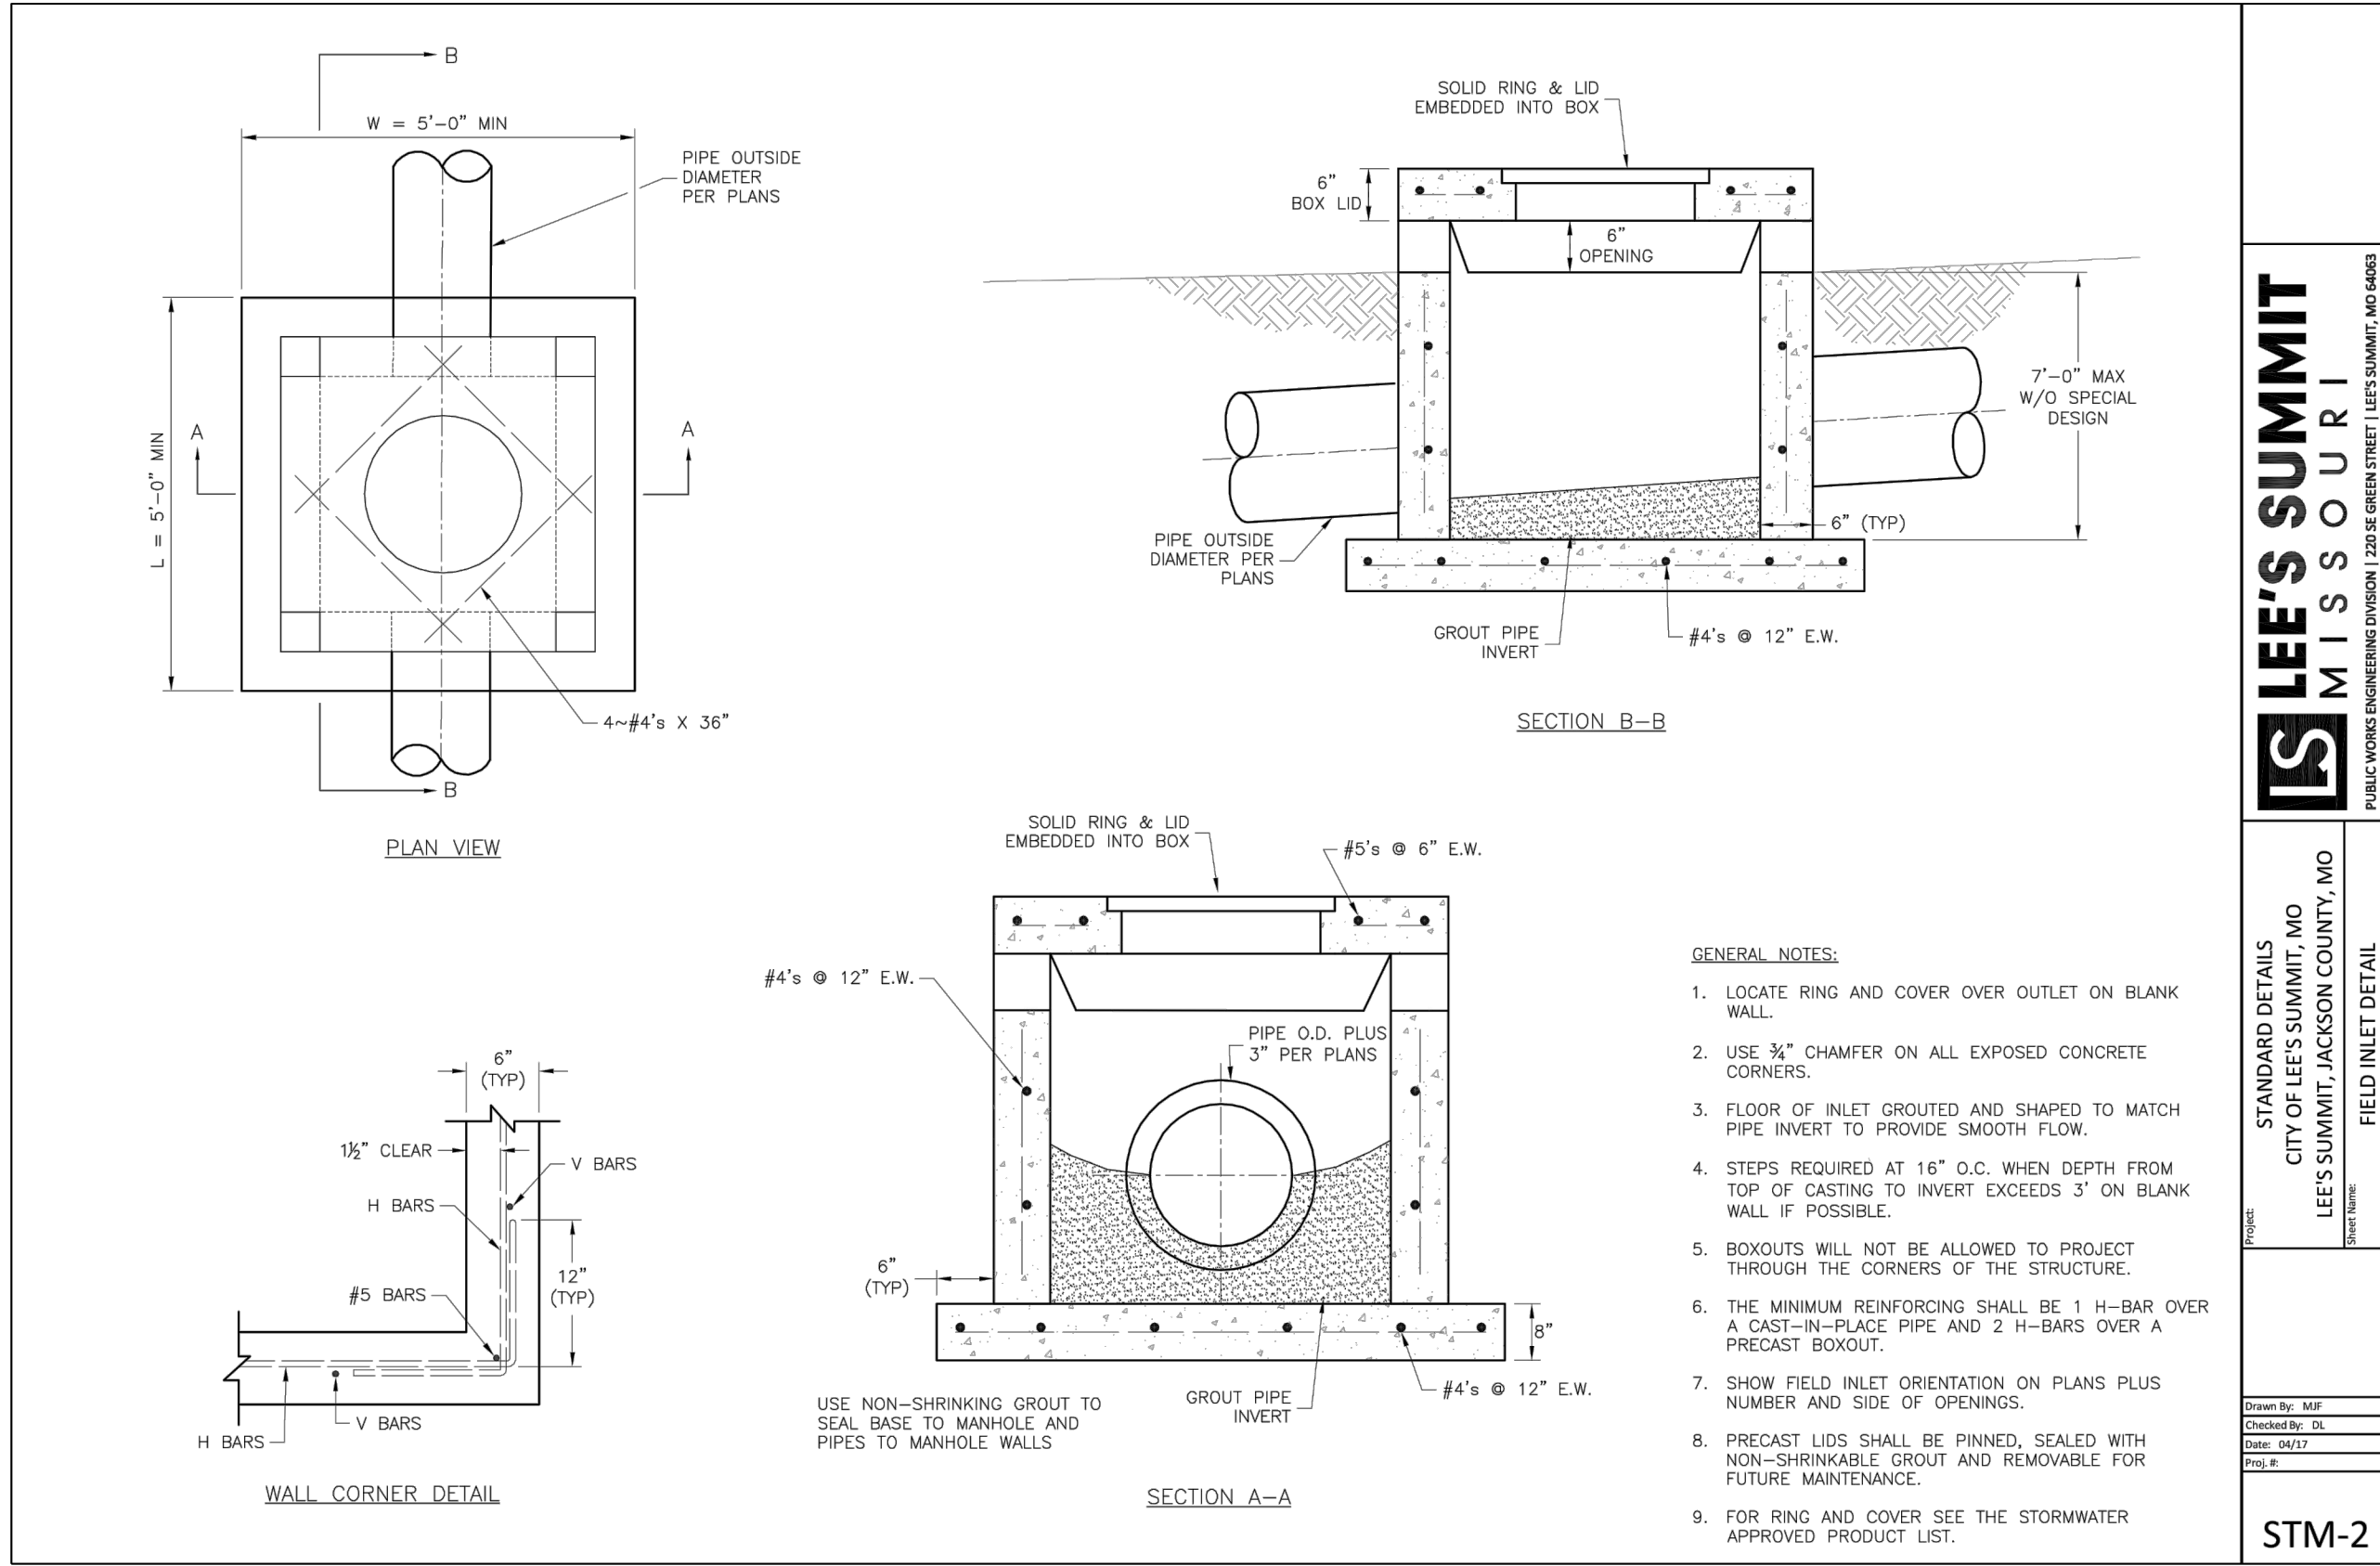

LEE'S SUMMIT
MISSOURI

STANDARD DETAILS
CITY OF LEE'S SUMMIT, MO
LEE'S SUMMIT, JACKSON COUNTY, MO

STM-2

I:\PROJECTS\2021\17-134\3.0 Design\3.0 DWG Plans\6.0 SS\17-134-SS-DETAILS.dwg, 10/23/2019 11:59:20 AM, 11

Record Drawing

TABLE LS-2: MINIMUM ASPHALT PAVEMENT THICKNESSES

Street Classification	Pavement Option	AC Surface (in.)	AC Base (in.)	MoDOT Type 5 Base (in.)	Geogrid(1)	Chemical Subgrade Stabilization(2) (in.)
Residential Local/Access	A	2	4	6	--	6
	B	2	4	10	Geogrid	--
Residential Collector	A	2	5.5	6	--	9
	B	2	5.5	12	Geogrid	--
Commercial Industrial Local/Collector	A	2	7.5	6	--	9
	B	2	7.5	12	Geogrid	--


TABLE LS-3: MINIMUM PCC PAVEMENT THICKNESSES

Street Classification	PCC (in.)	Aggregate Base (in.)	Subgrade Stabilization ⁽¹⁾ (in.)
Residential Local/Access	6	4	--
Residential Collector	6	4	6
Commercial Industrial Local/Collector	8	4	9

(1) Subgrade Stabilization and 4" aggregate base may be replaced by approved geogrid and 6" of aggregate base

CONFORMING TO CONSTRUCTION RECORDS AS FURNISHED BY OTHERS.


KSC 7-23-19
BY DATE

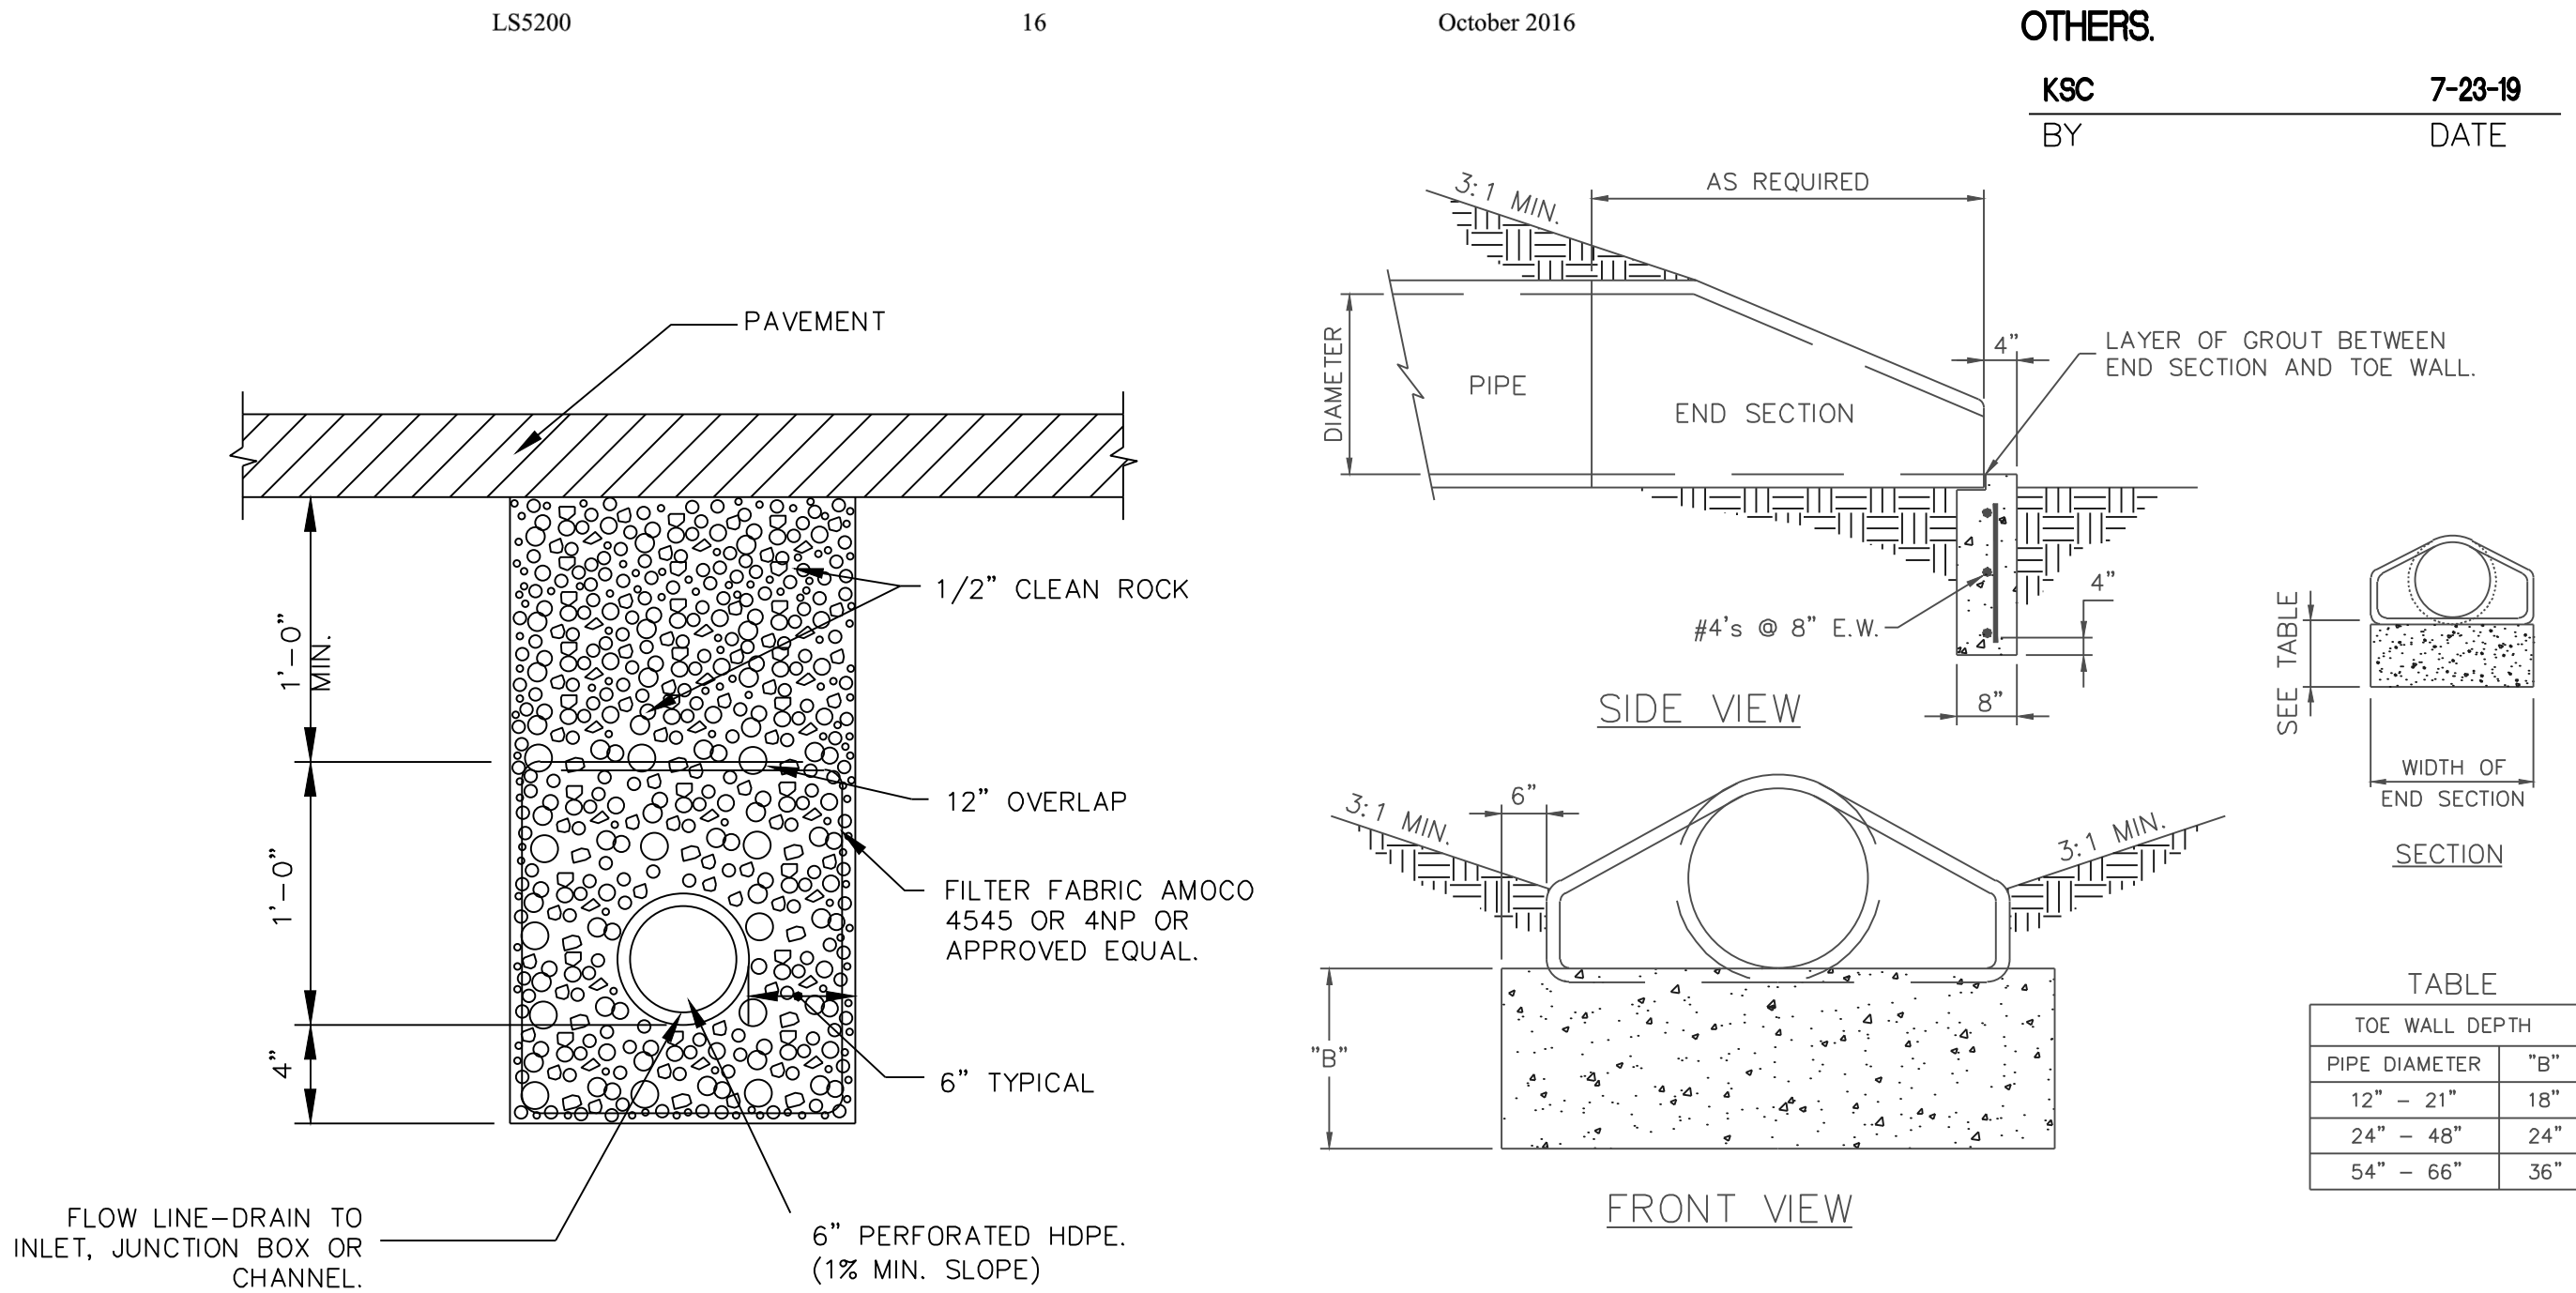

NOTES:

- THE DEPTH OF THE TOE WALL SHALL BE PER TABLE. IF BEDROCK IS ENCOUNTERED A MINIMUM OF 12" INTO BEDROCK IS REQUIRED.
- ALL CONCRETE SHALL CONFORM TO STANDARD SPECIFICATION SECTION 2205.2.

END SECTION AND TOEWALL DETAIL

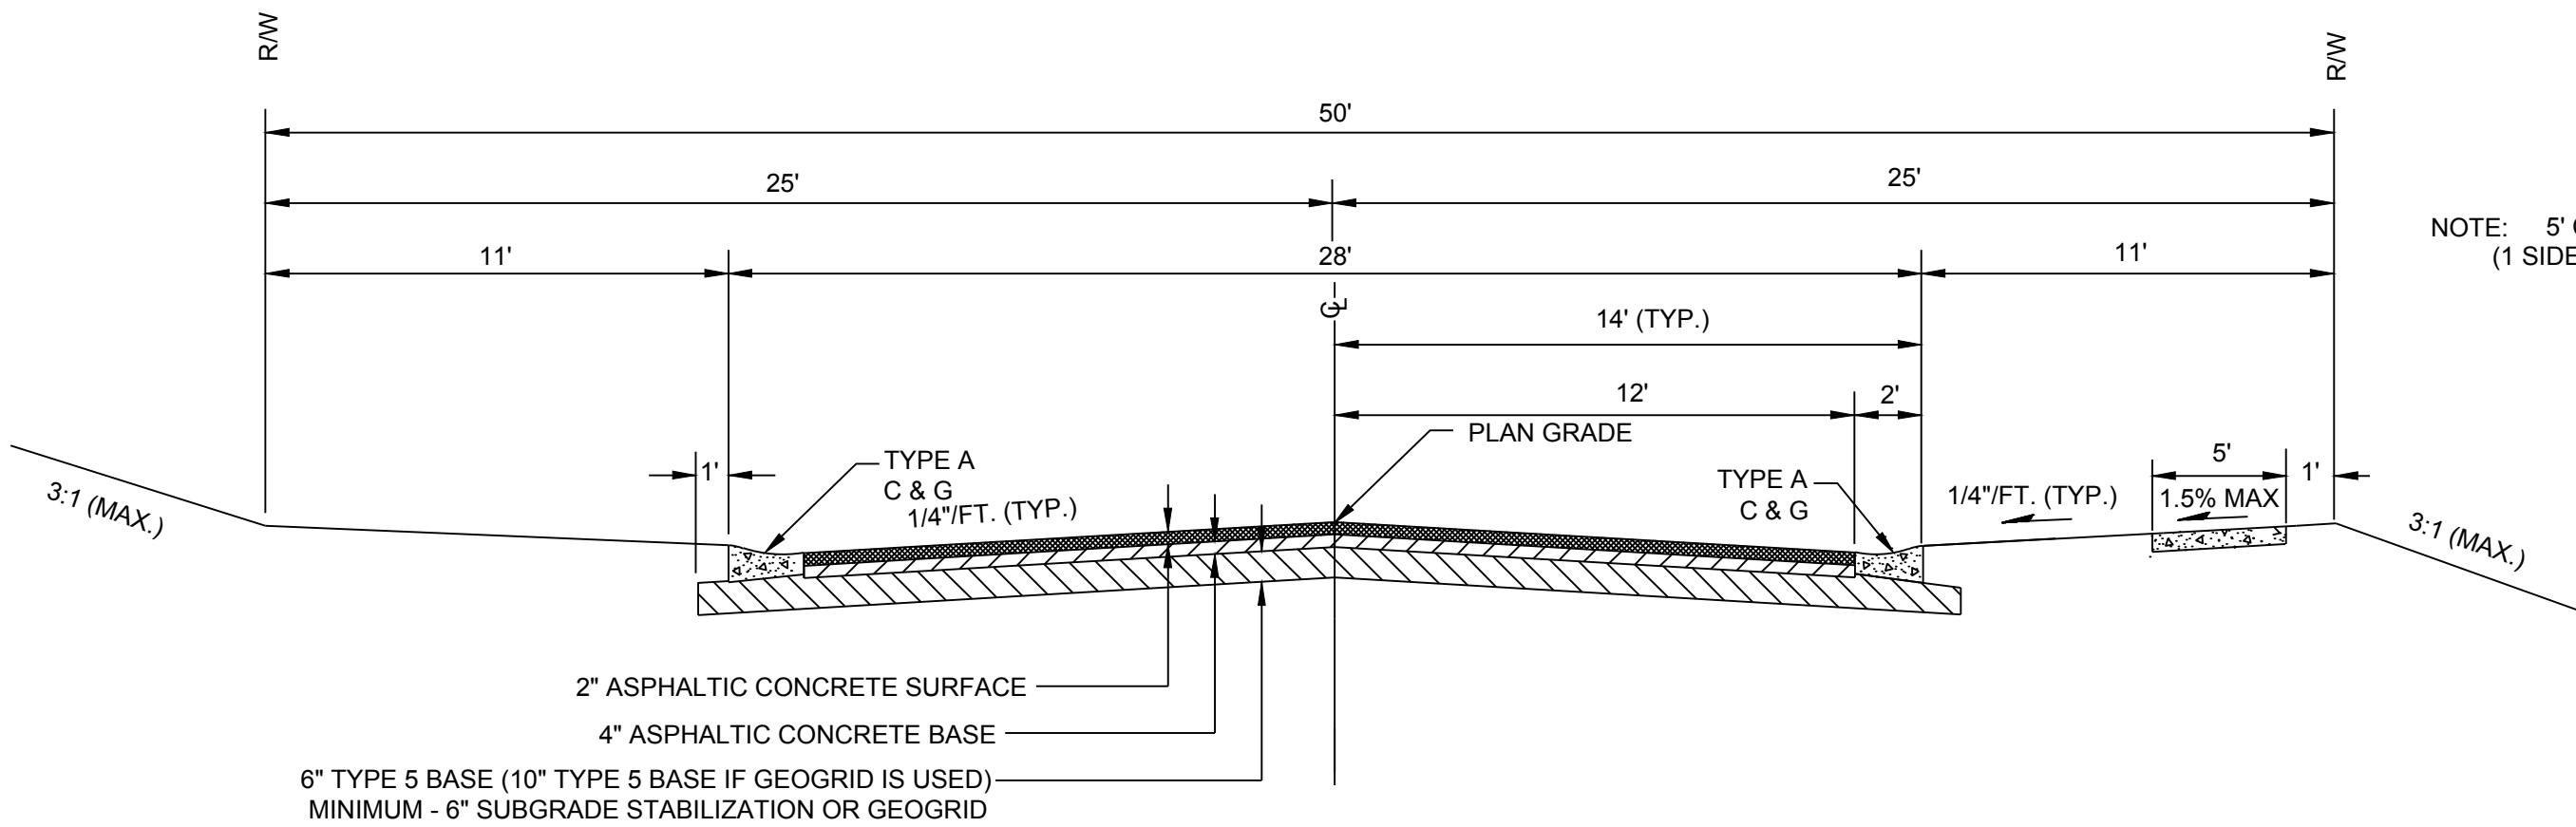

RESIDENTIAL LOCAL/ACCESS
SW MACKENZIE DR STA. 3+36.12 TO STA. 9+03.59
CARSON DR STA. 11+05.83 TO STA. 18+85.55
NW THOREAU DR STA. 4+68.32 TO STA. 11+46.93
NW AUDUBON LN STA. 3+07.51 TO STA. 10+21.79

SCHLAGEL & ASSOCIATES, P.A.
Engineers • Planners • Surveyors • Landscape Architects
14920 West 107th Street • Lenexa, Kansas 66215
(913) 492-5158 • Fax: (913) 492-8400
WWW.SCHLAGELASSOCIATES.COM
Missouri State Certificates of Authority
#E2002003600-F #AC200100237 #LS200200859-F

10.23.19

WINTERSET VALLEY, 12TH PLAT
STREET, STORMWATER, MASTER DRAINAGE PLAN AND
EROSION AND SEDIMENT CONTROL
AUDUBON LANE AND CARSON DRIVE
LEE'S SUMMIT, MO

REVISION	DATE	DESCRIPTION
1	06/04/2018	CITY COMMENTS
2	07/30/2018	CITY COMMENTS
3	08/28/2018	CITY COMMENTS/SHPO FINDINGS
4	08/27/2019	REVISE STREET NAMES
5	8/29/2019	REVISE RETAINING WALLS
6		
7		
8		





DRAWN BY:	KSC
CHECKED BY:	MAB
DATE PREPARED:	4.20.18
PROJ. NUMBER:	17-134

DETAILS



SHEET

21
OF 25

I:\PROJECTS\2021\17-14\3.0 Design\3.0 DWG Plans\6.0 SS\17-134-SS-DETAILS.dwg, 10/23/2019 11:59:31 AM, 1:1

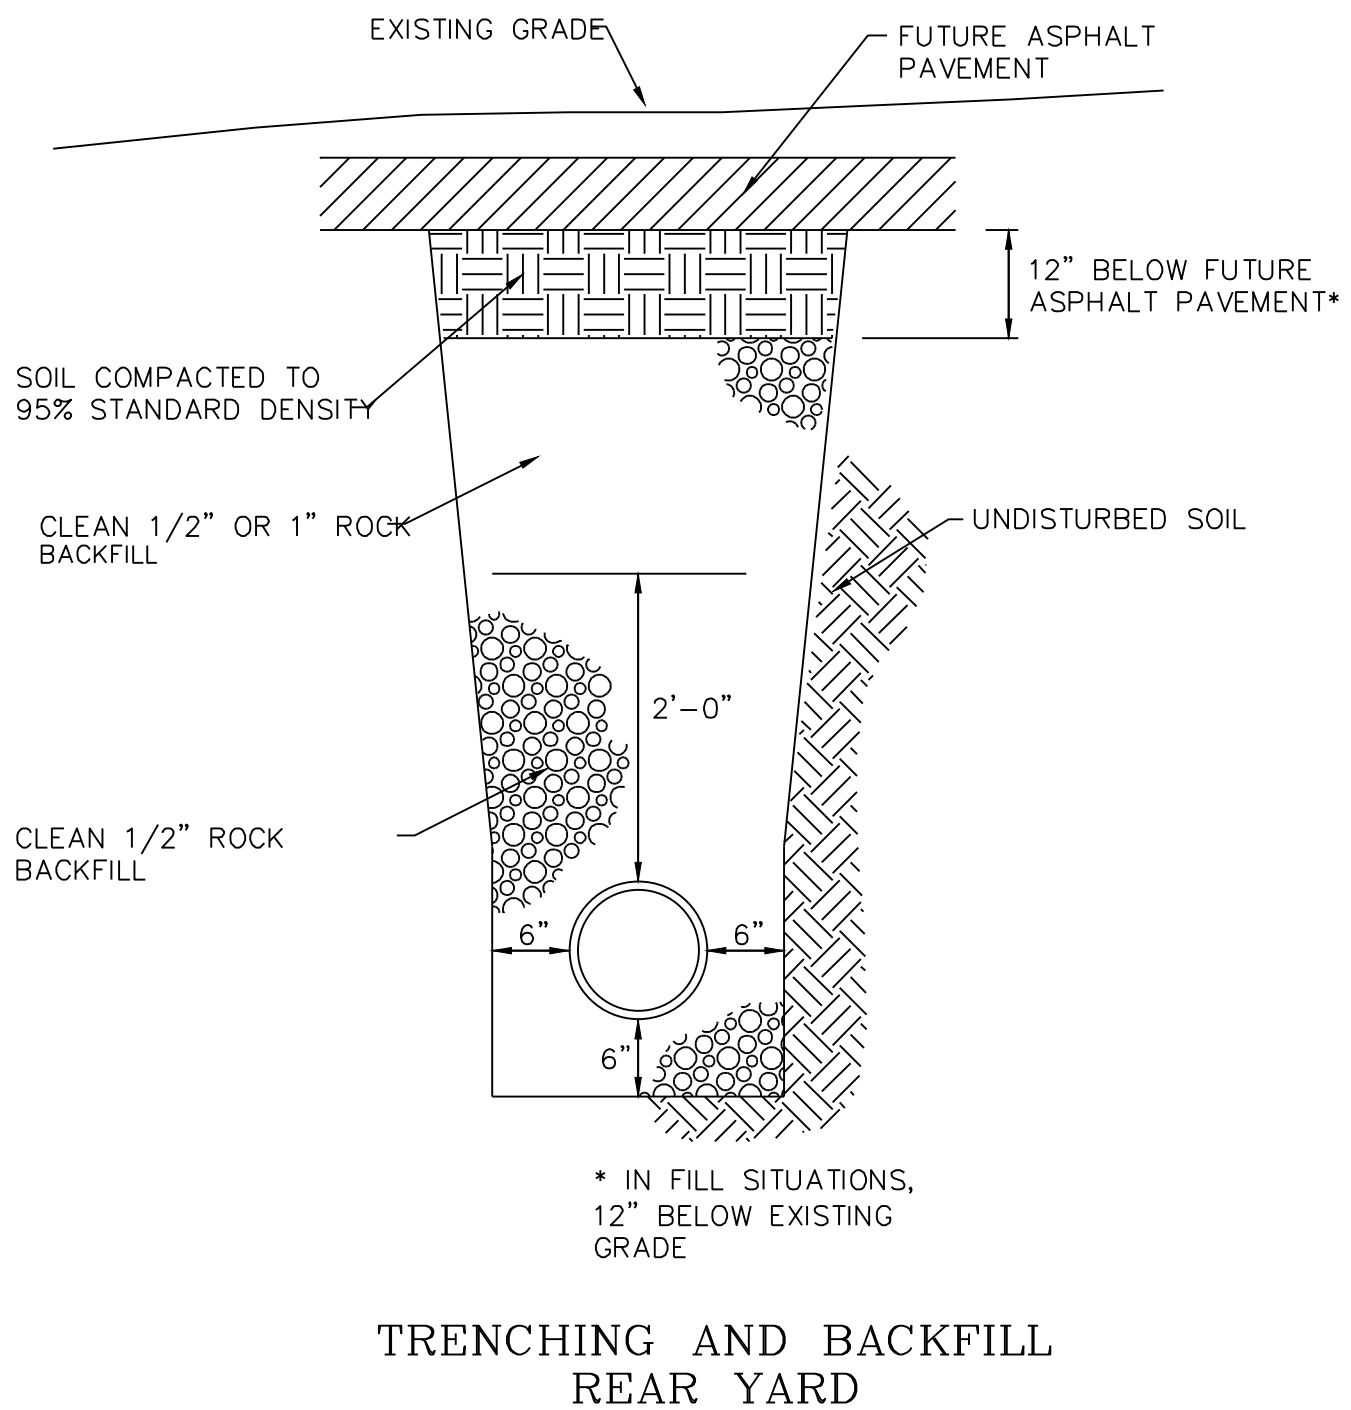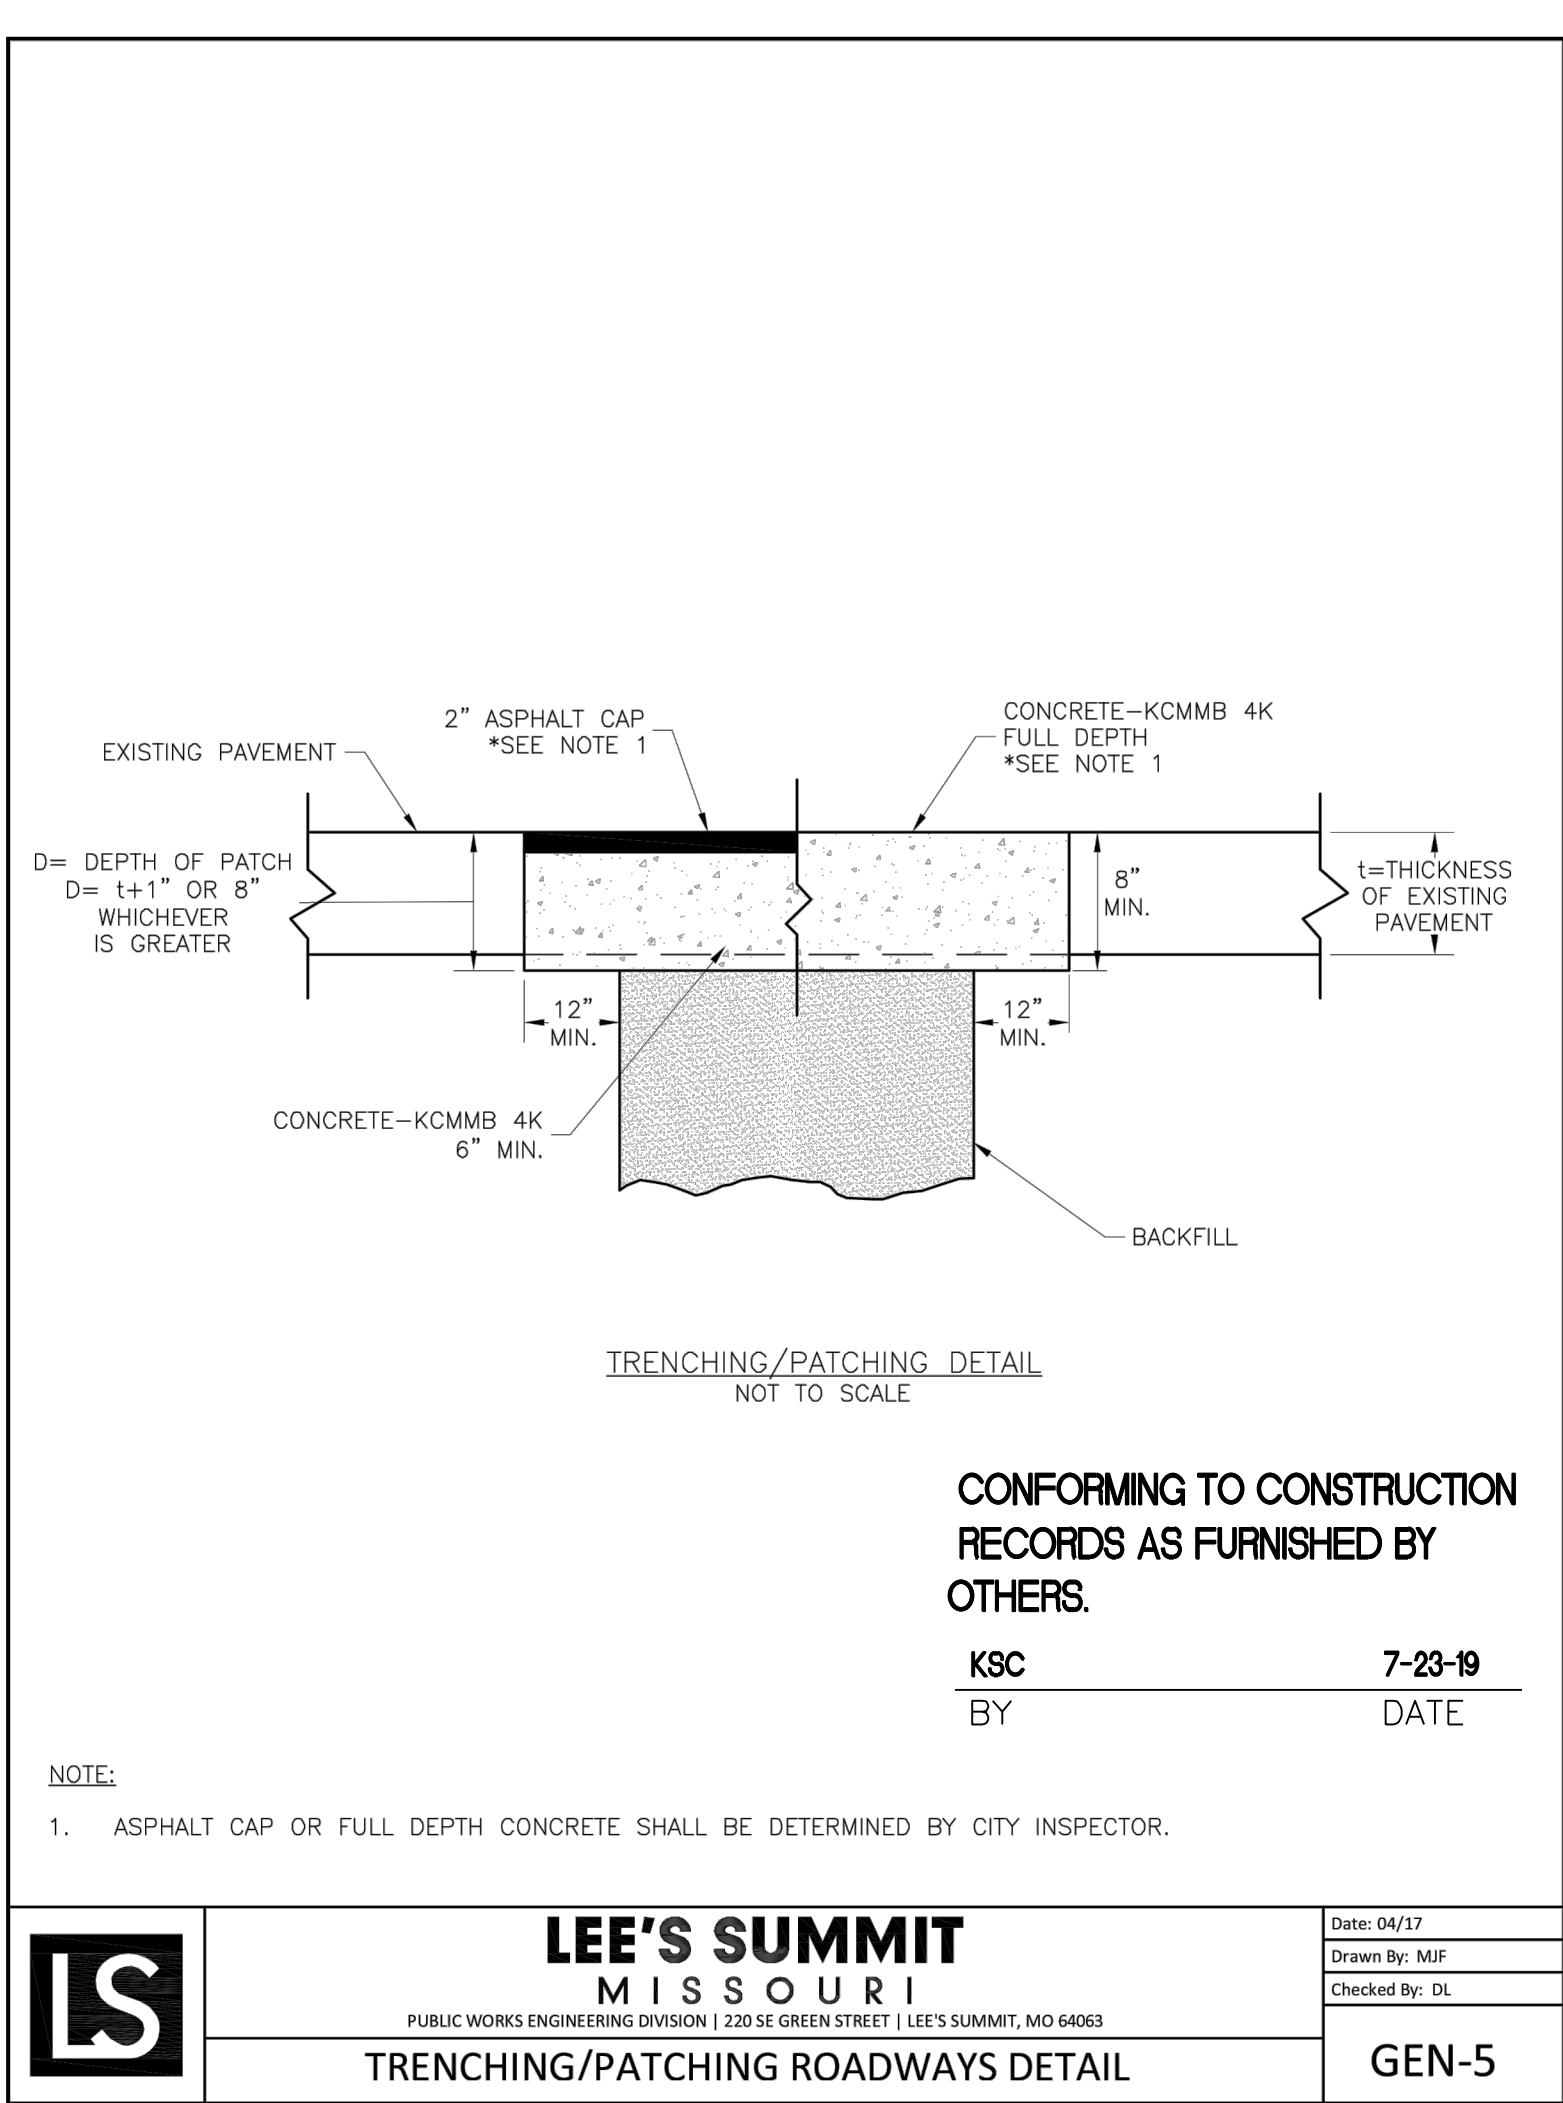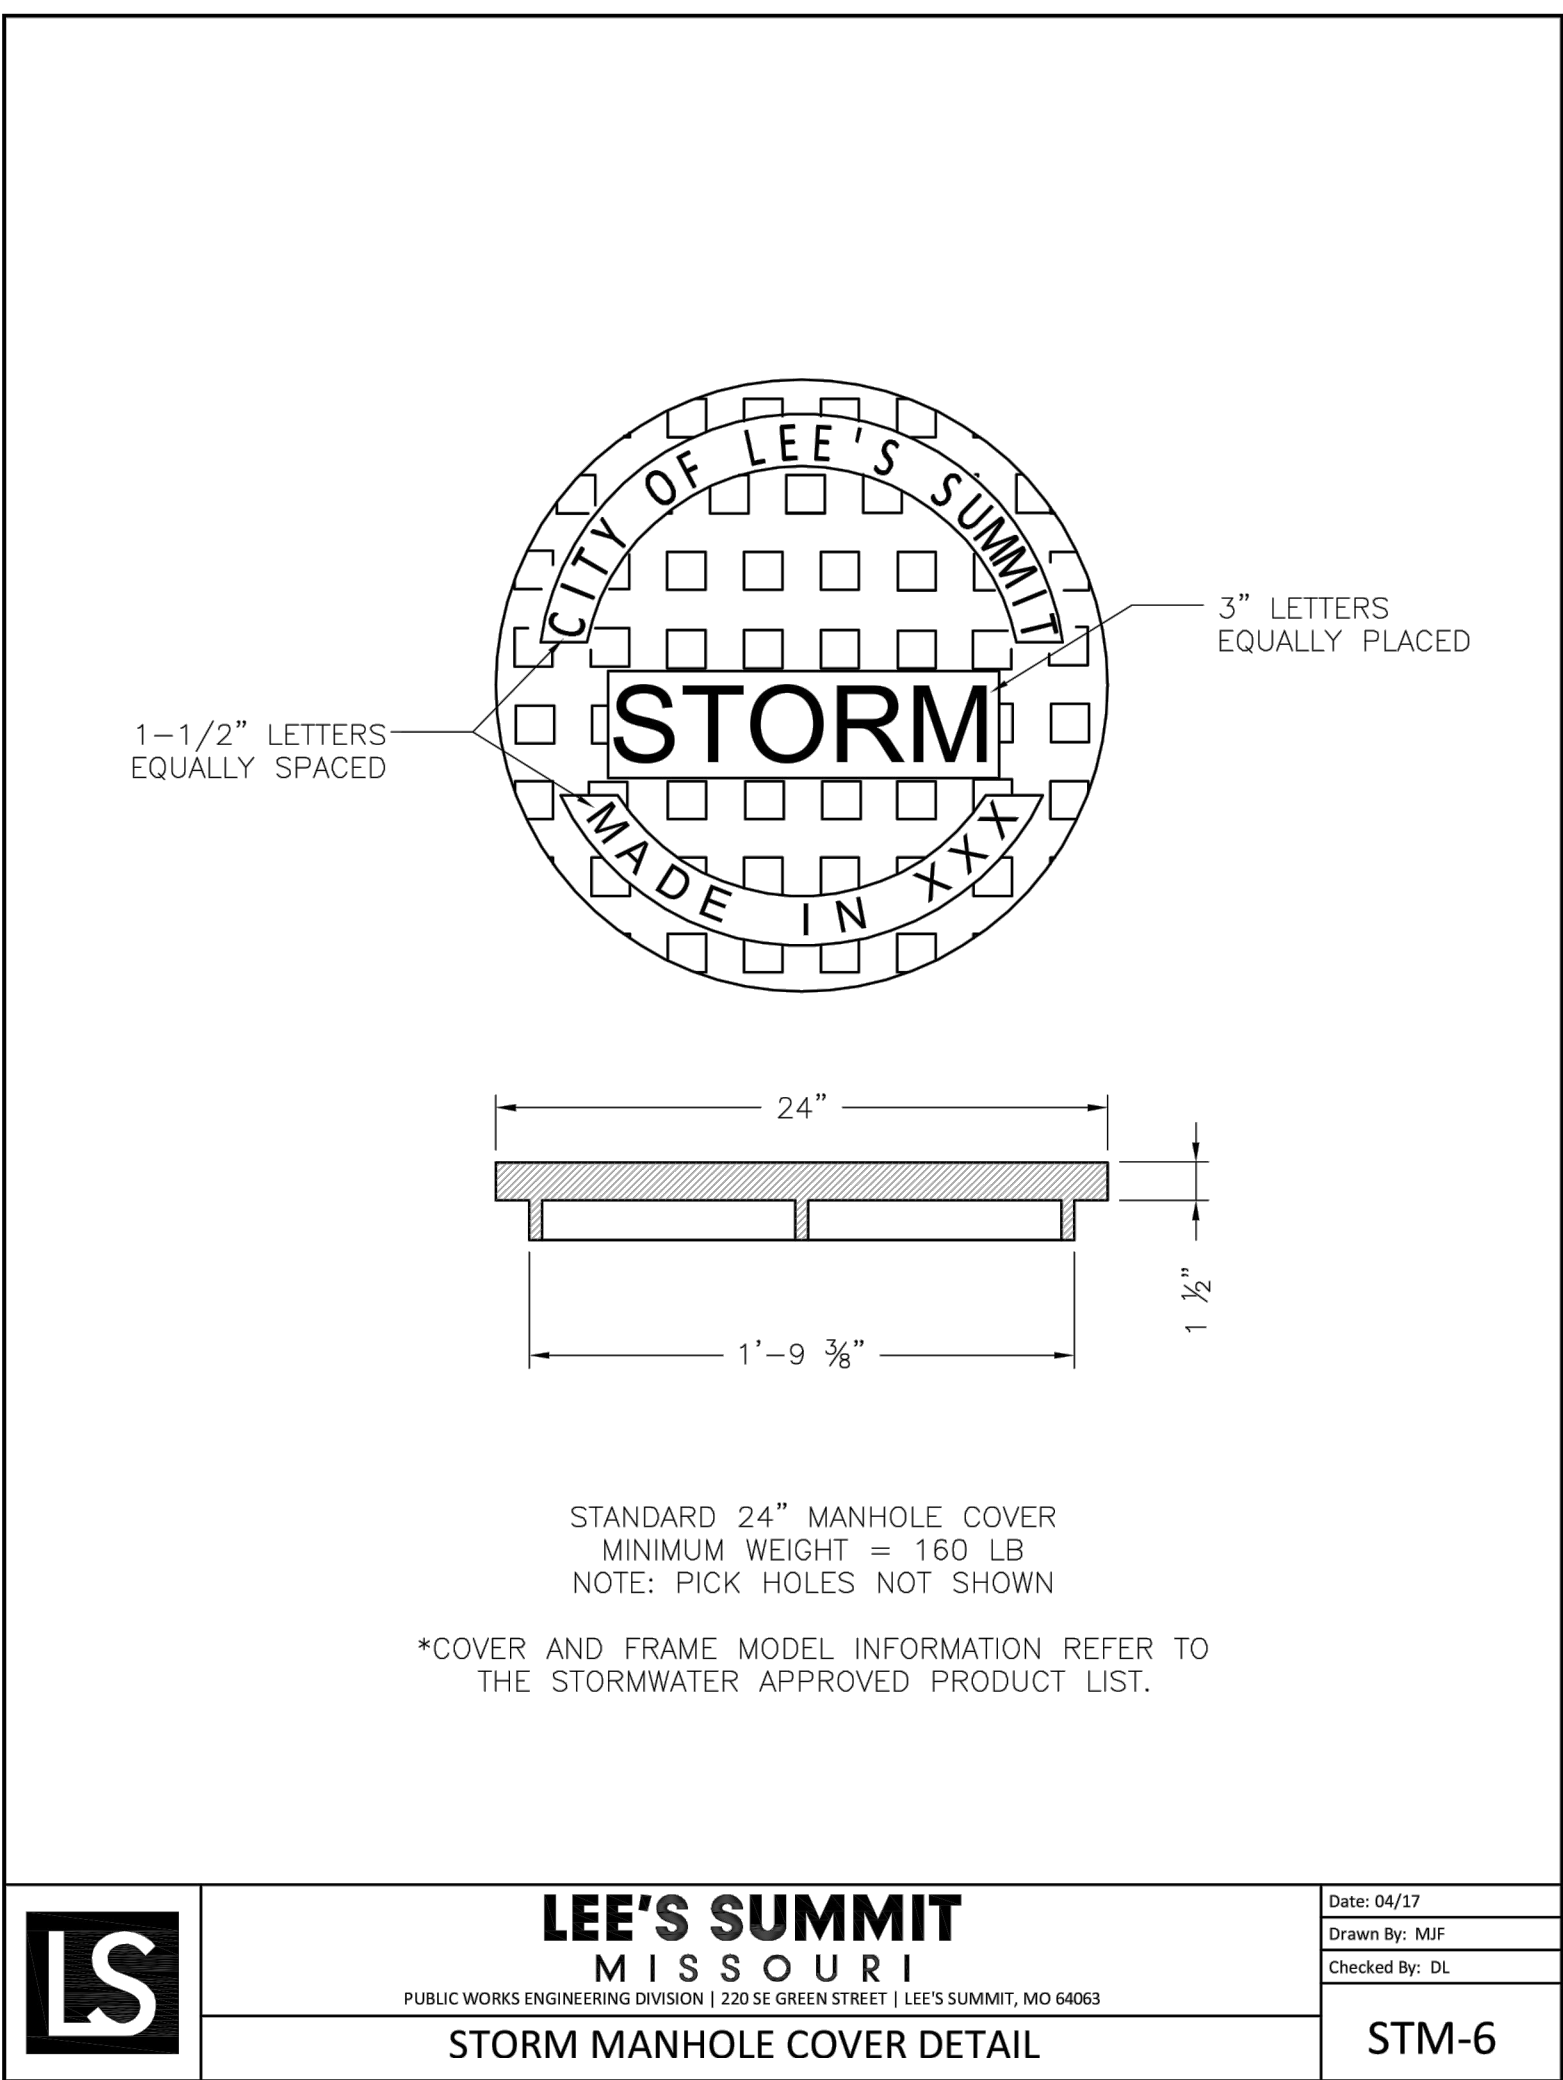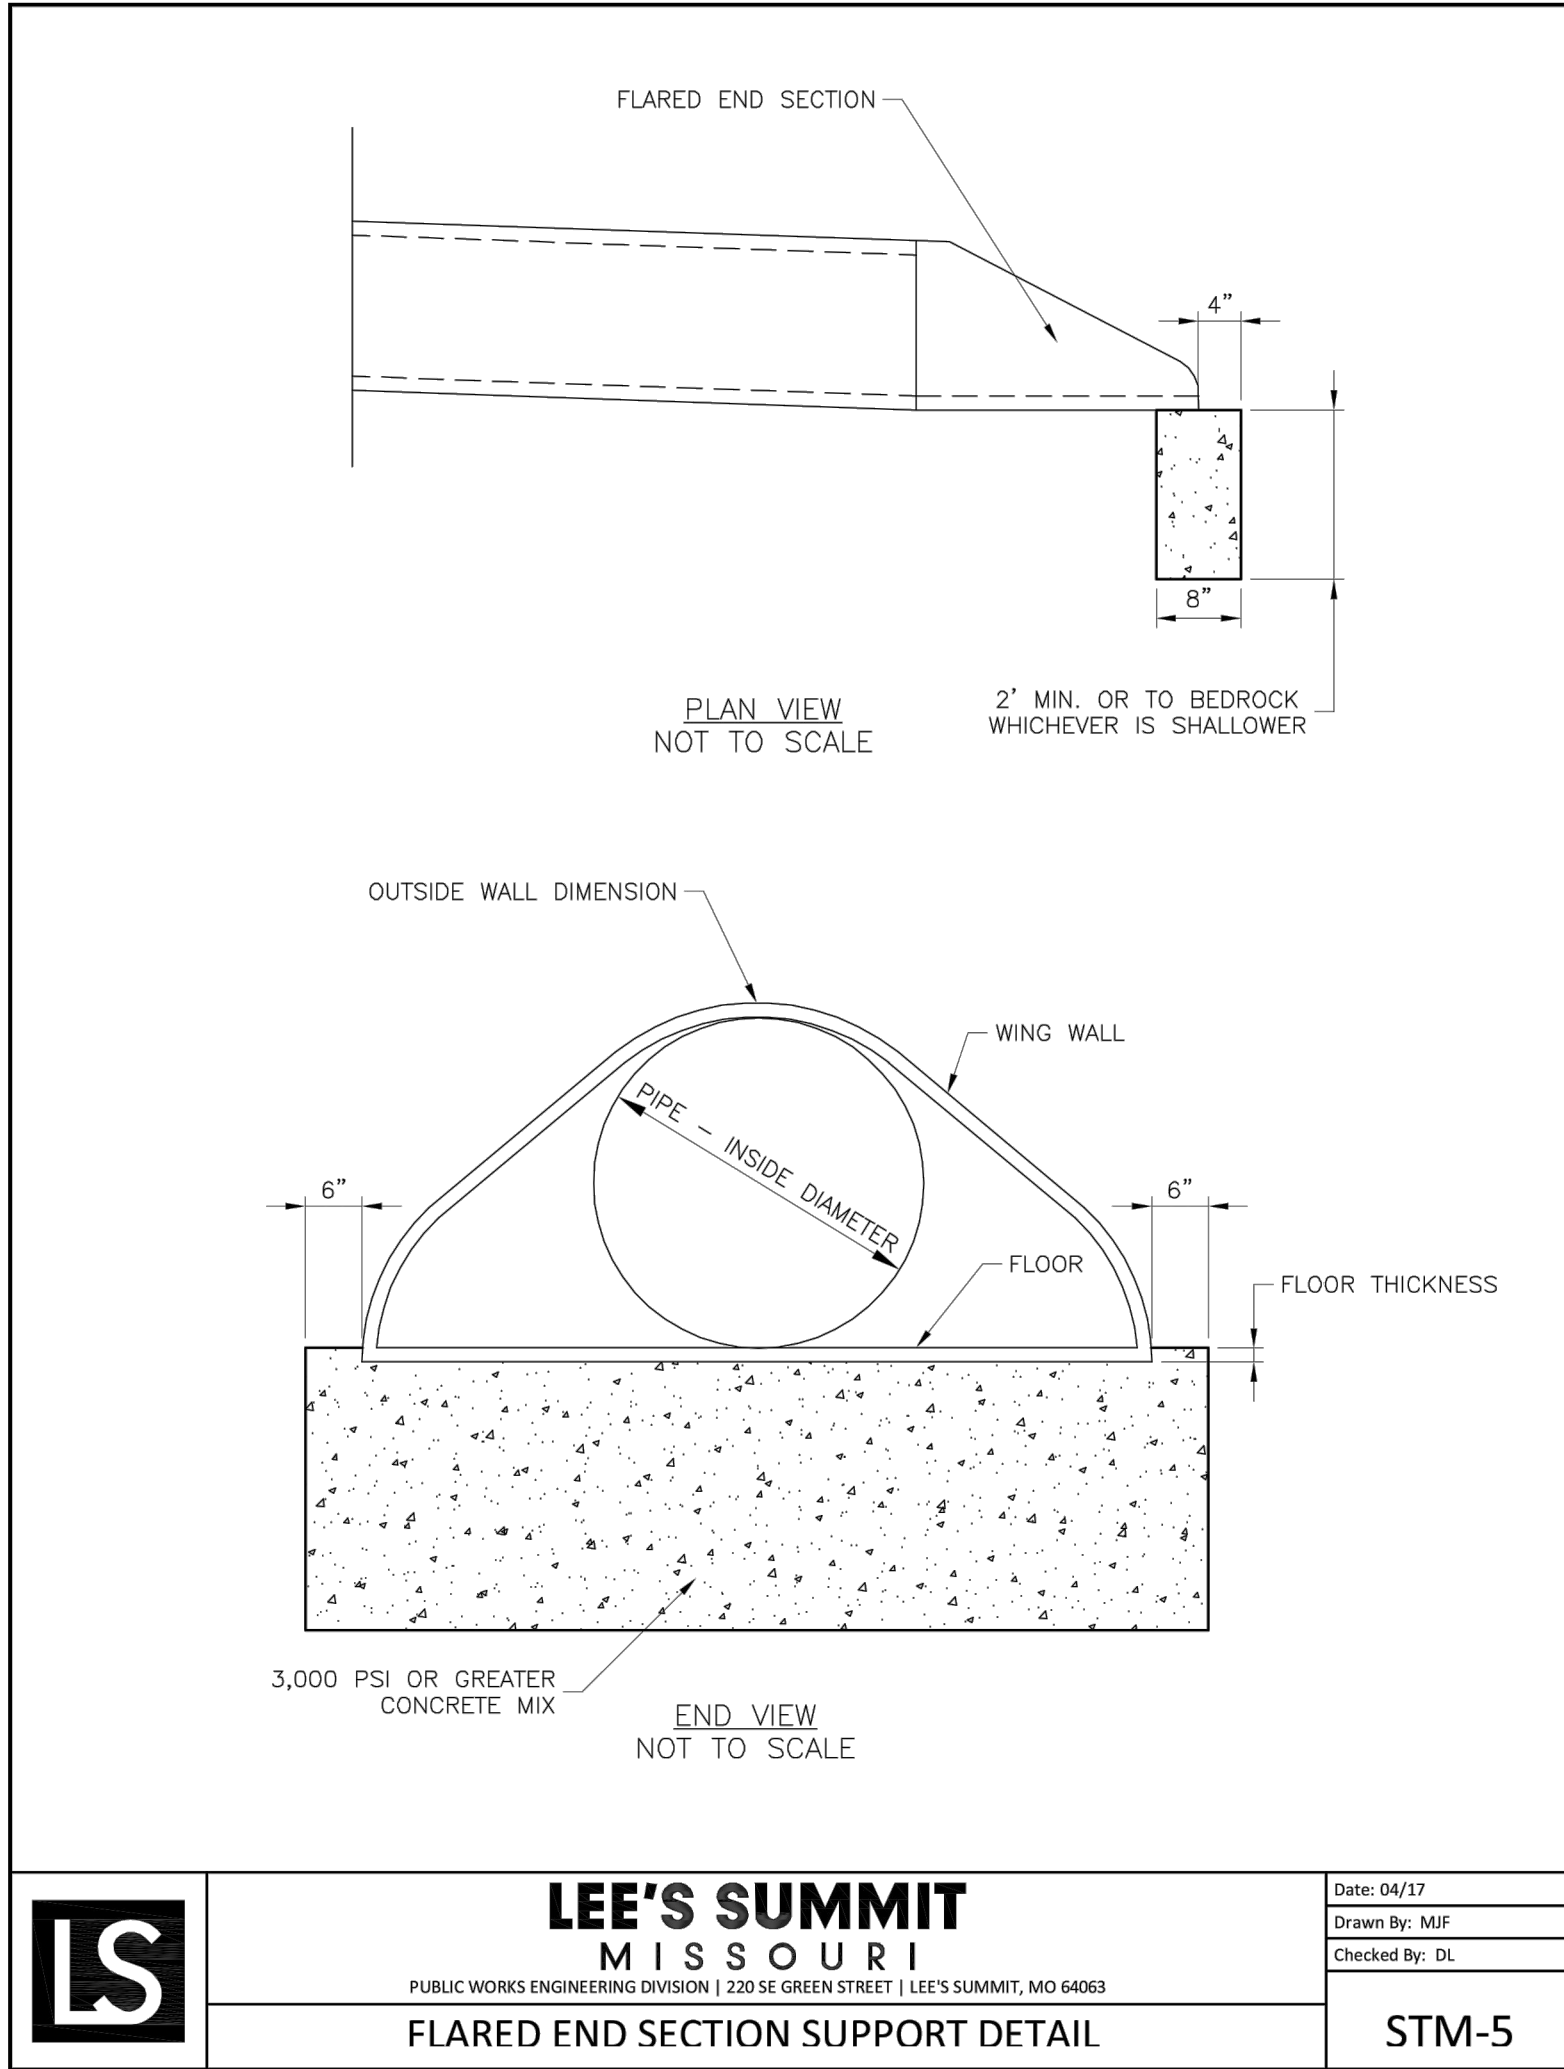





Record Drawing

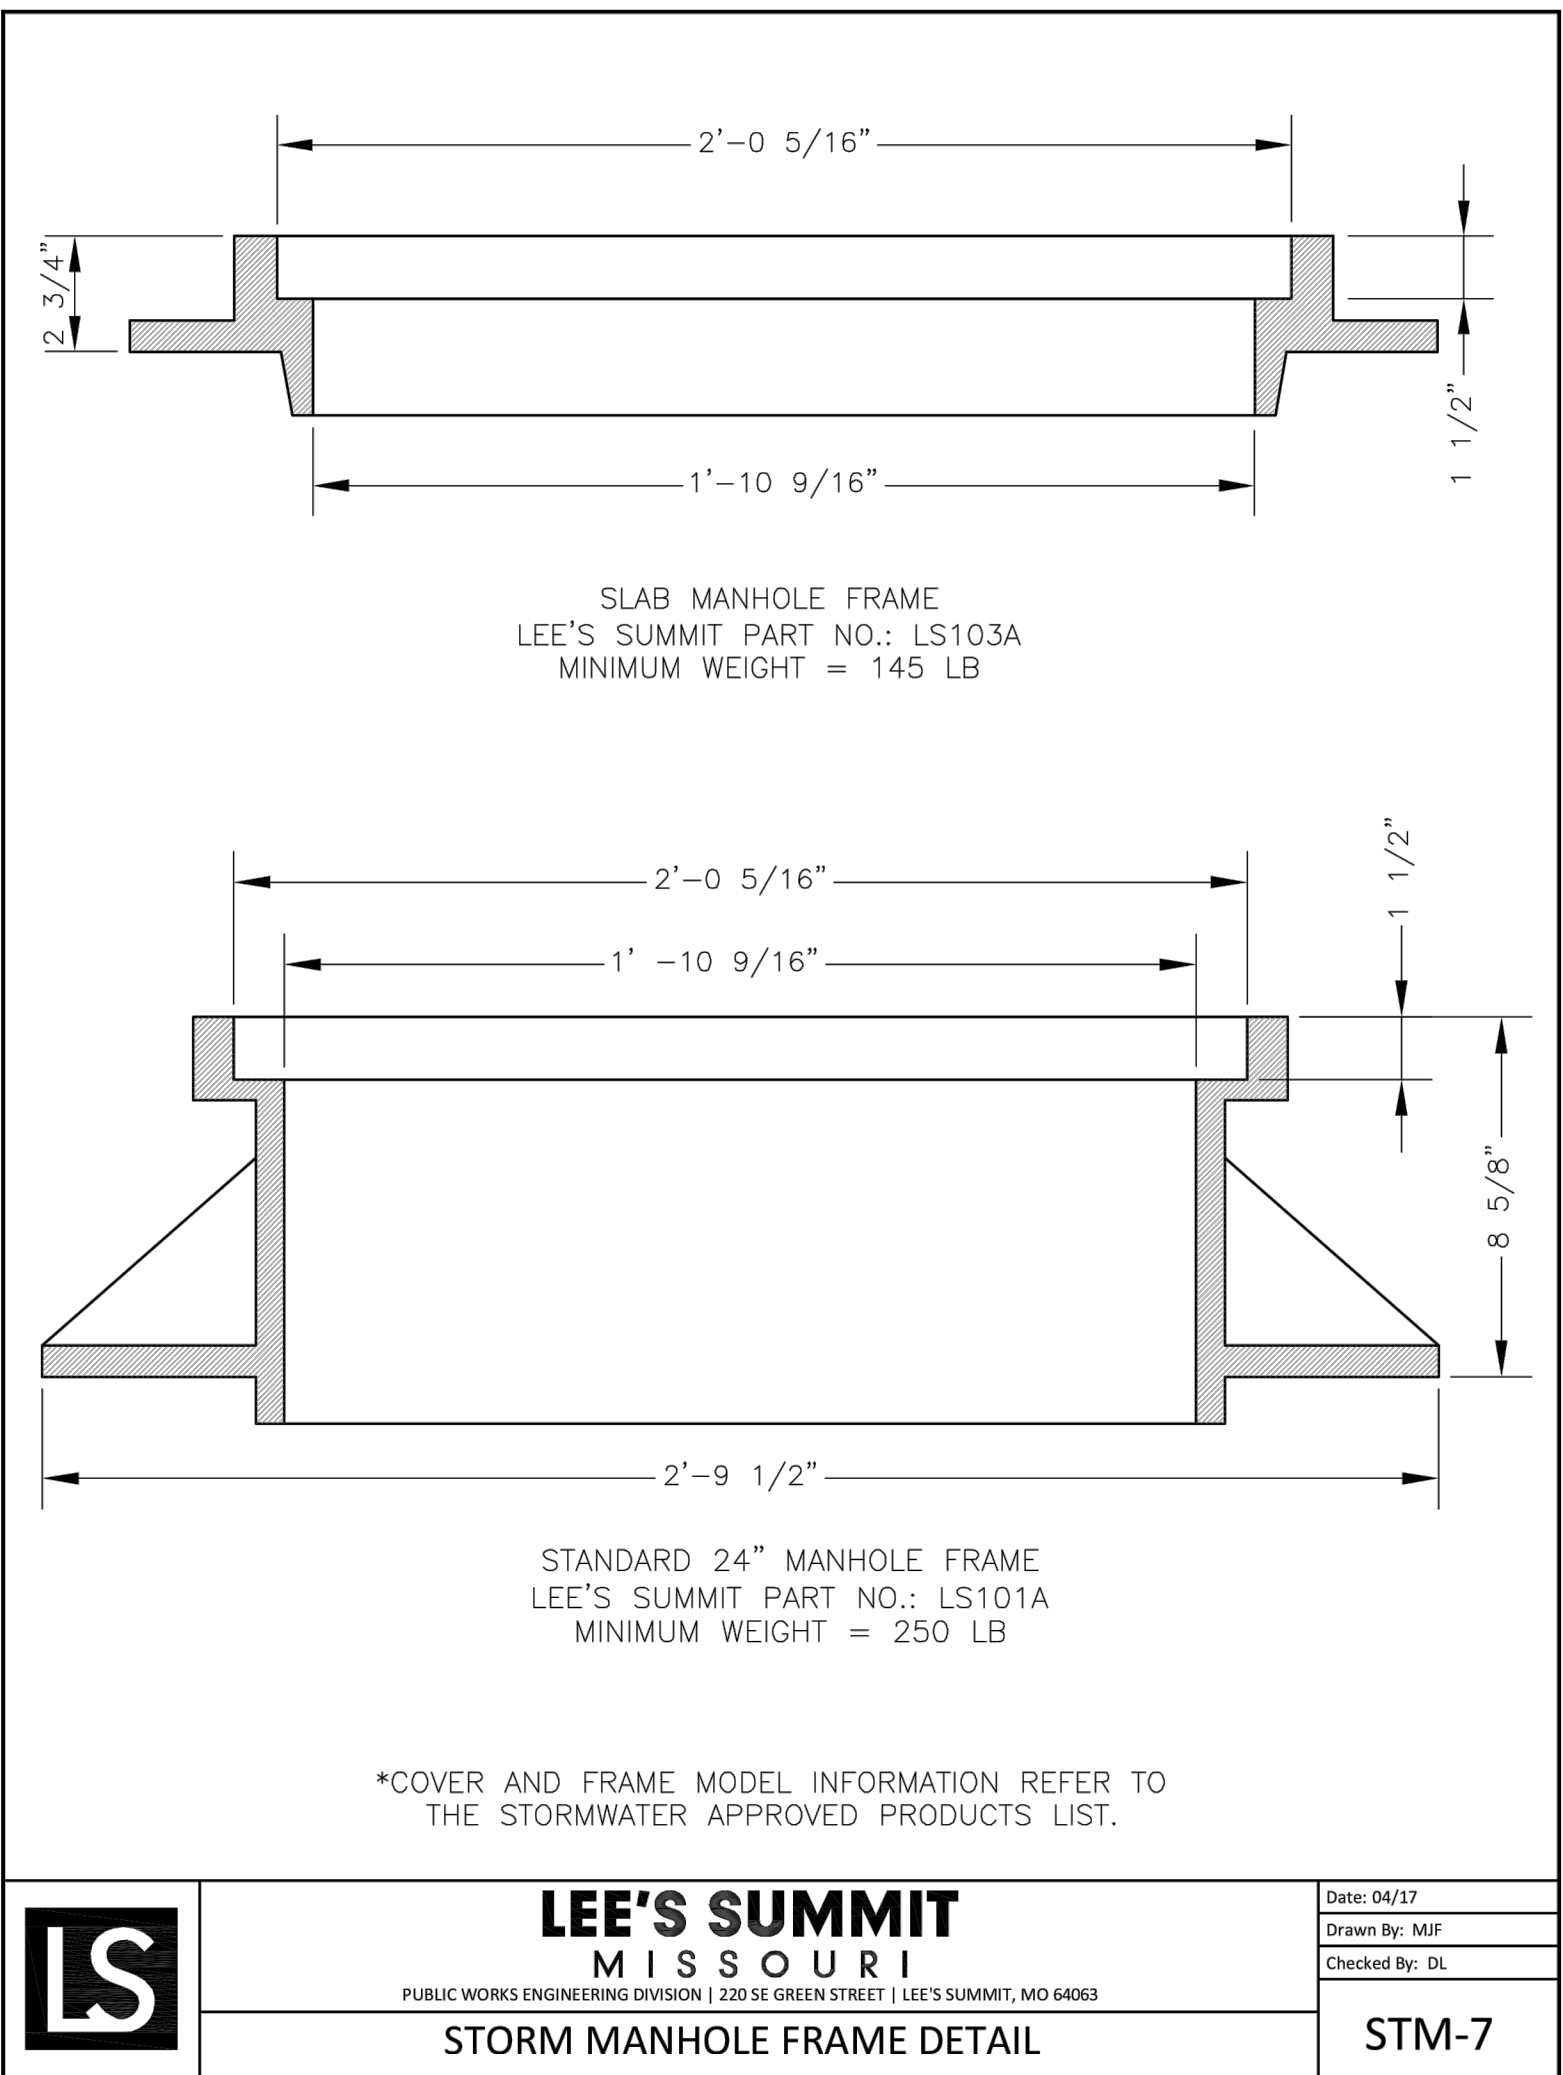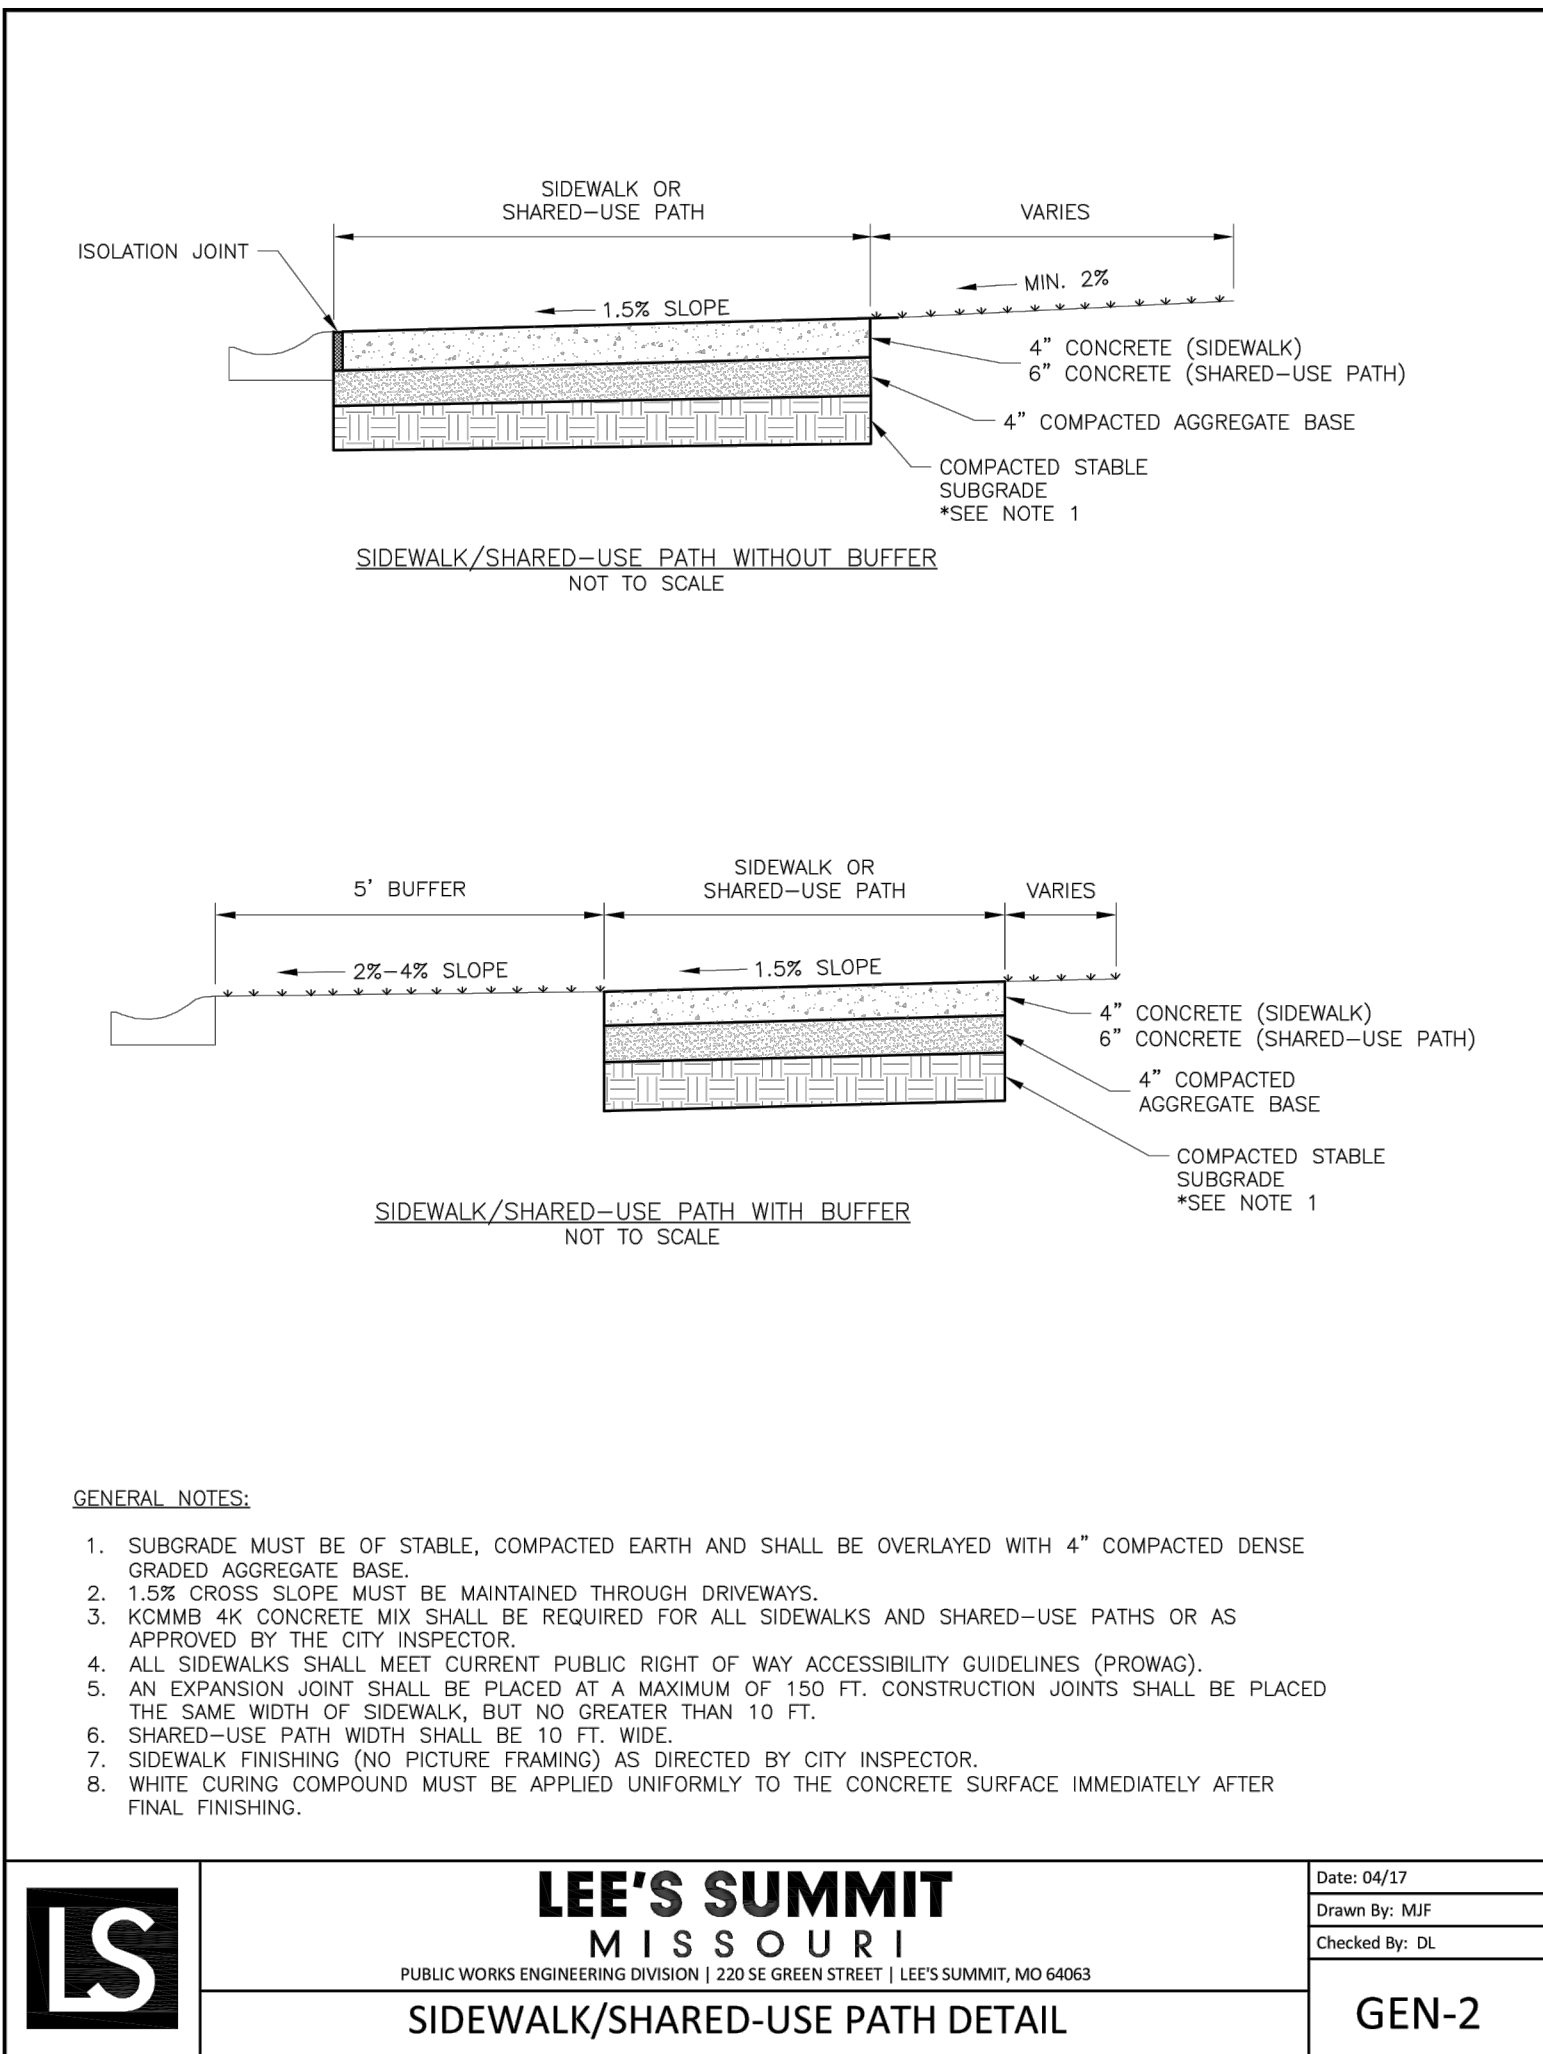

REVISION	DATE	DESCRIPTION
1	06/04/2018	CITY COMMENTS
2	07/30/2018	CITY COMMENTS
3	08/28/2018	CITY COMMENTS/SHPO FINDINGS
4	08/27/2019	REVISE STREET NAMES
5	8/29/2019	REVISE RETAINING WALLS
6		
7		
8		

DRAWN BY:	KSC
CHECKED BY:	MAB
DATE PREPARED:	4-23-18
PROJ. NUMBER:	17-134

I:\PROJECTS\2017\17-134-3.0 Design\3.0 DWG Plans\6.0 SS\17-134-SS-DETAILS.dwg, 10/23/2018 11:59:50 AM, 11

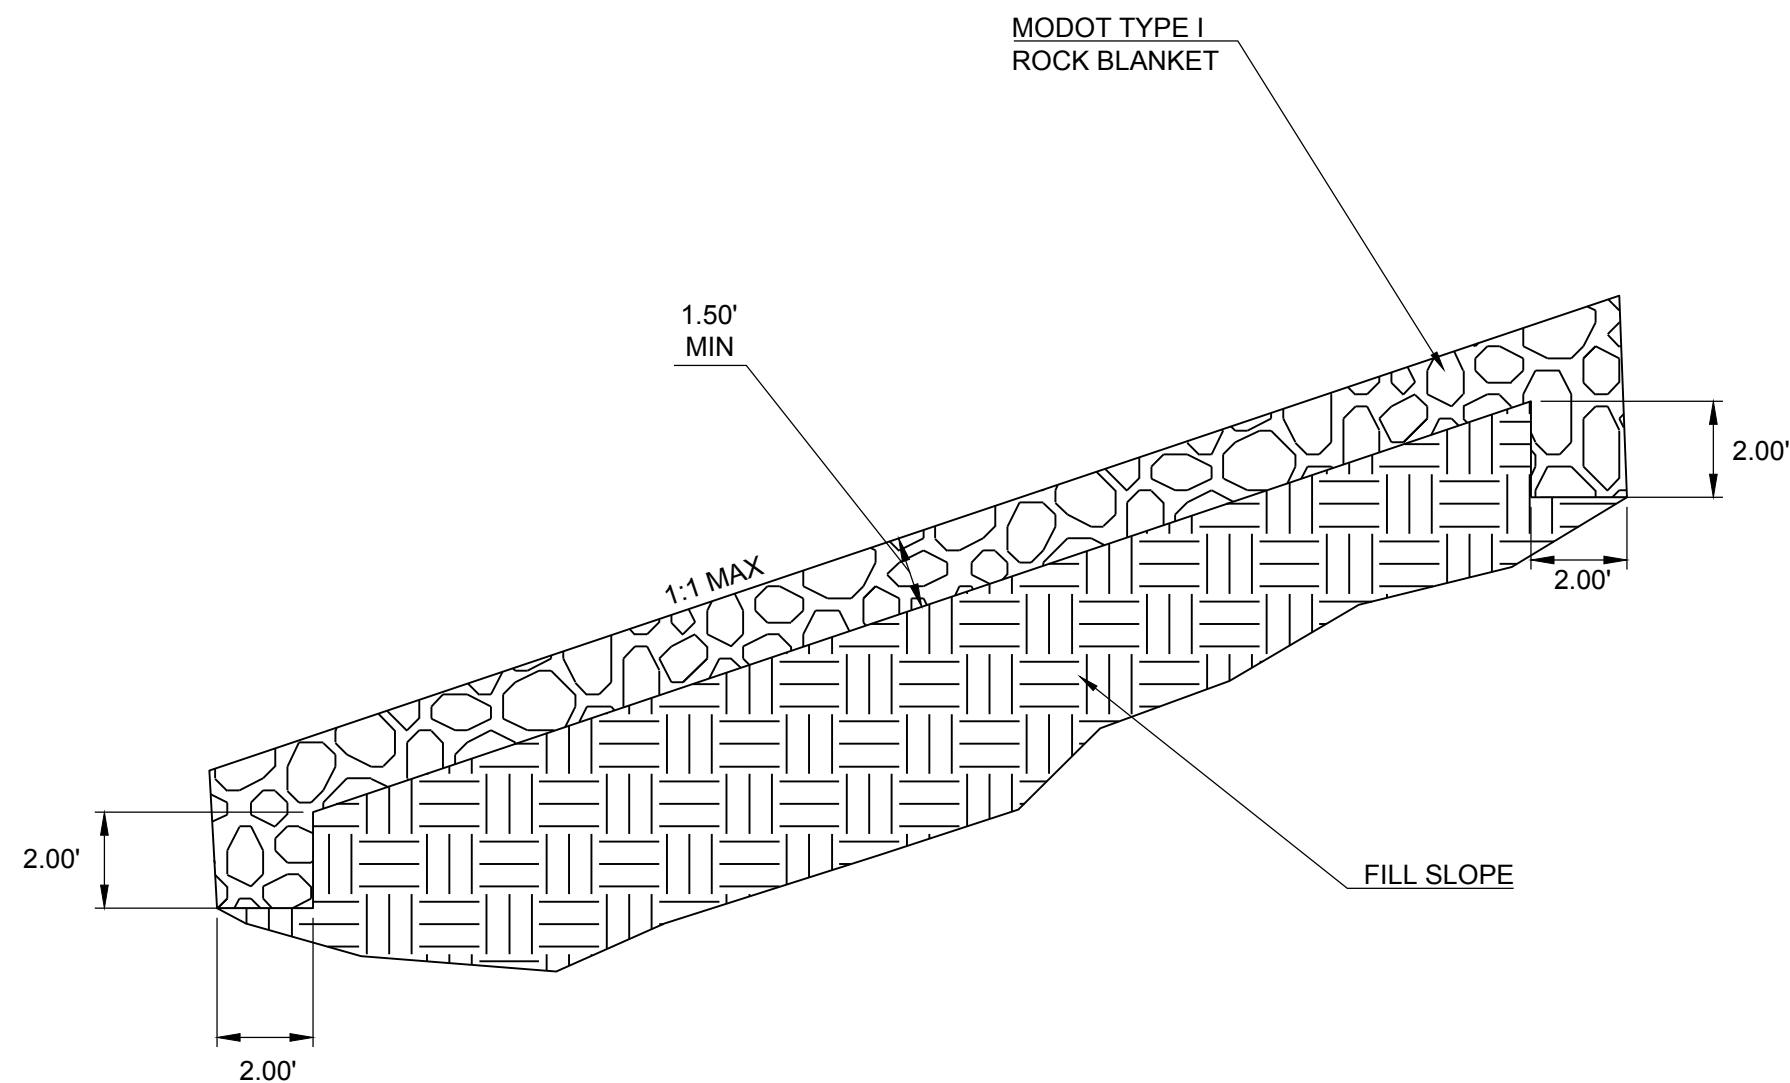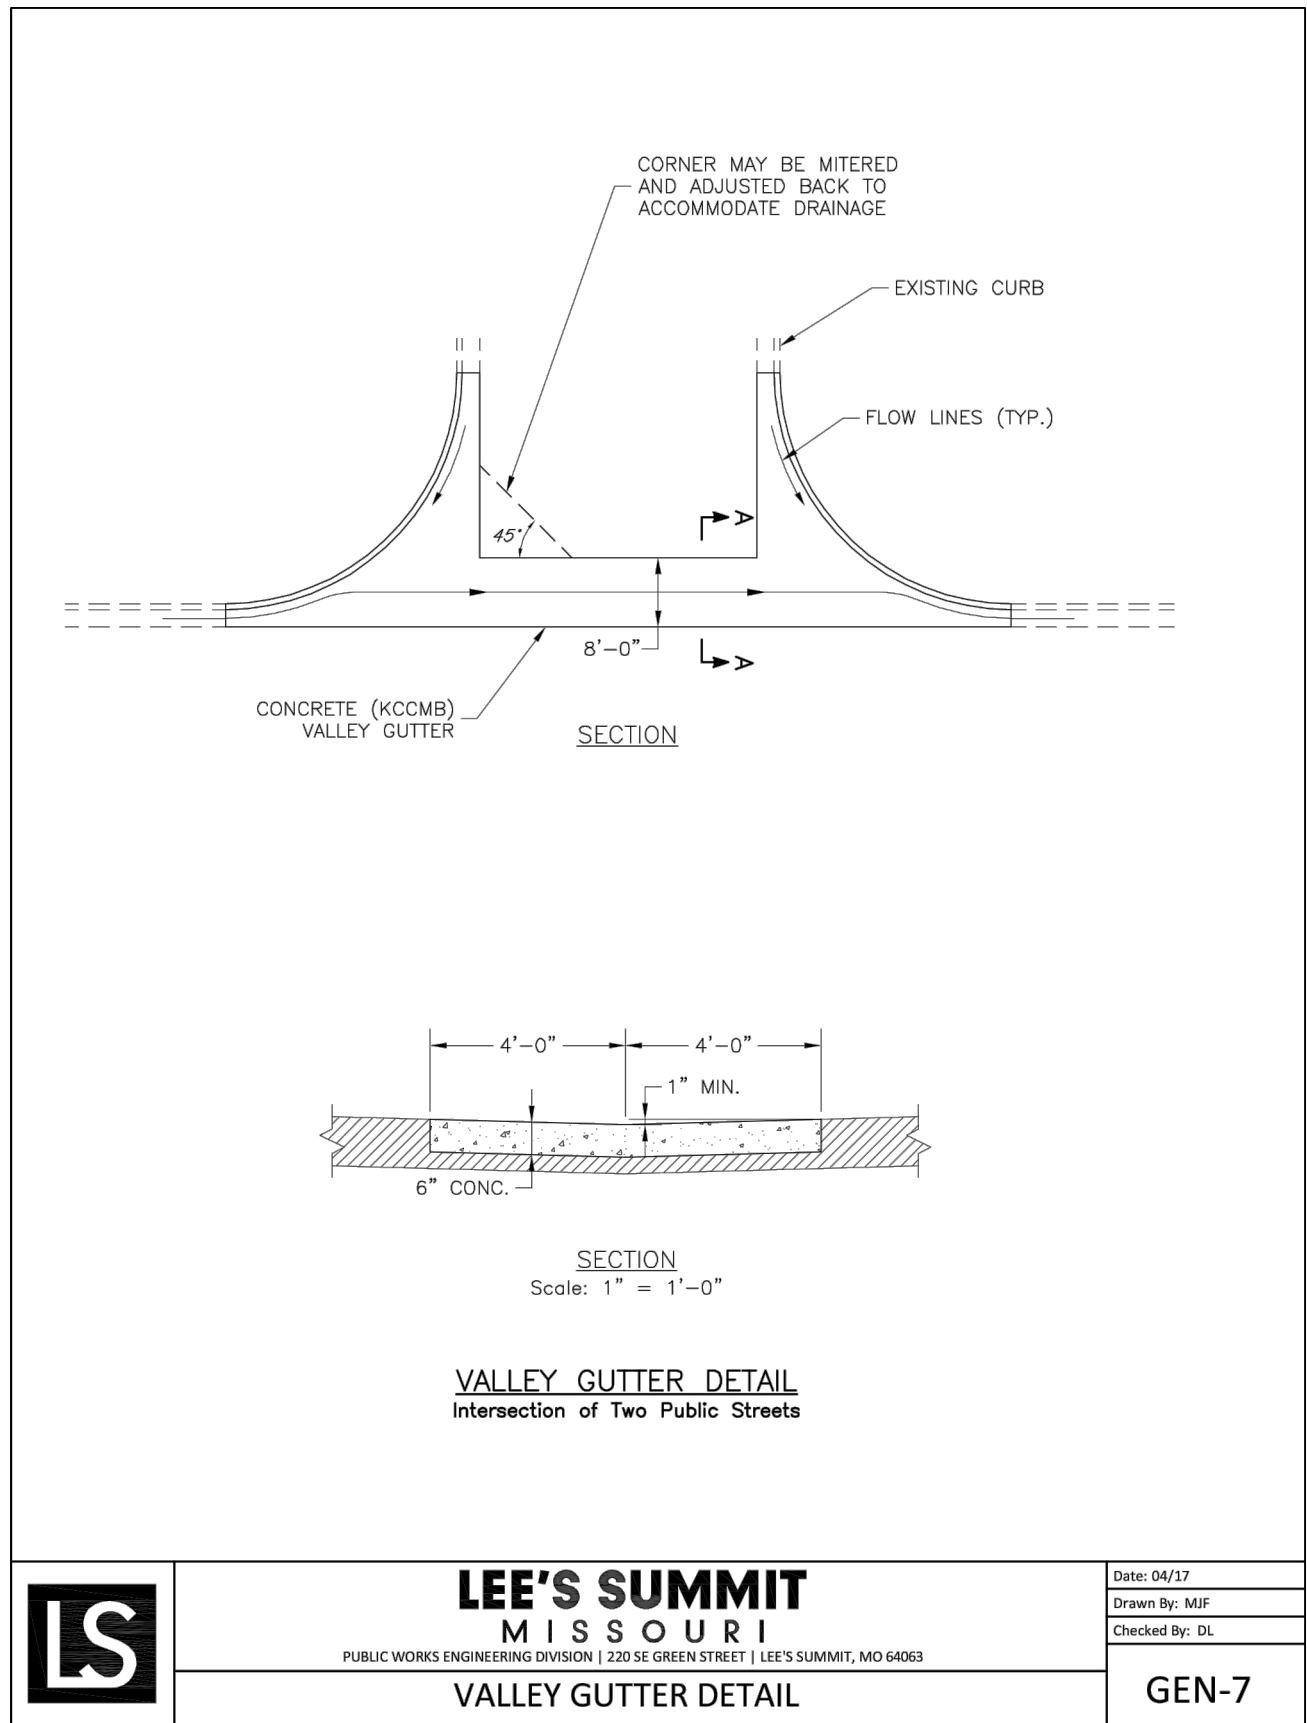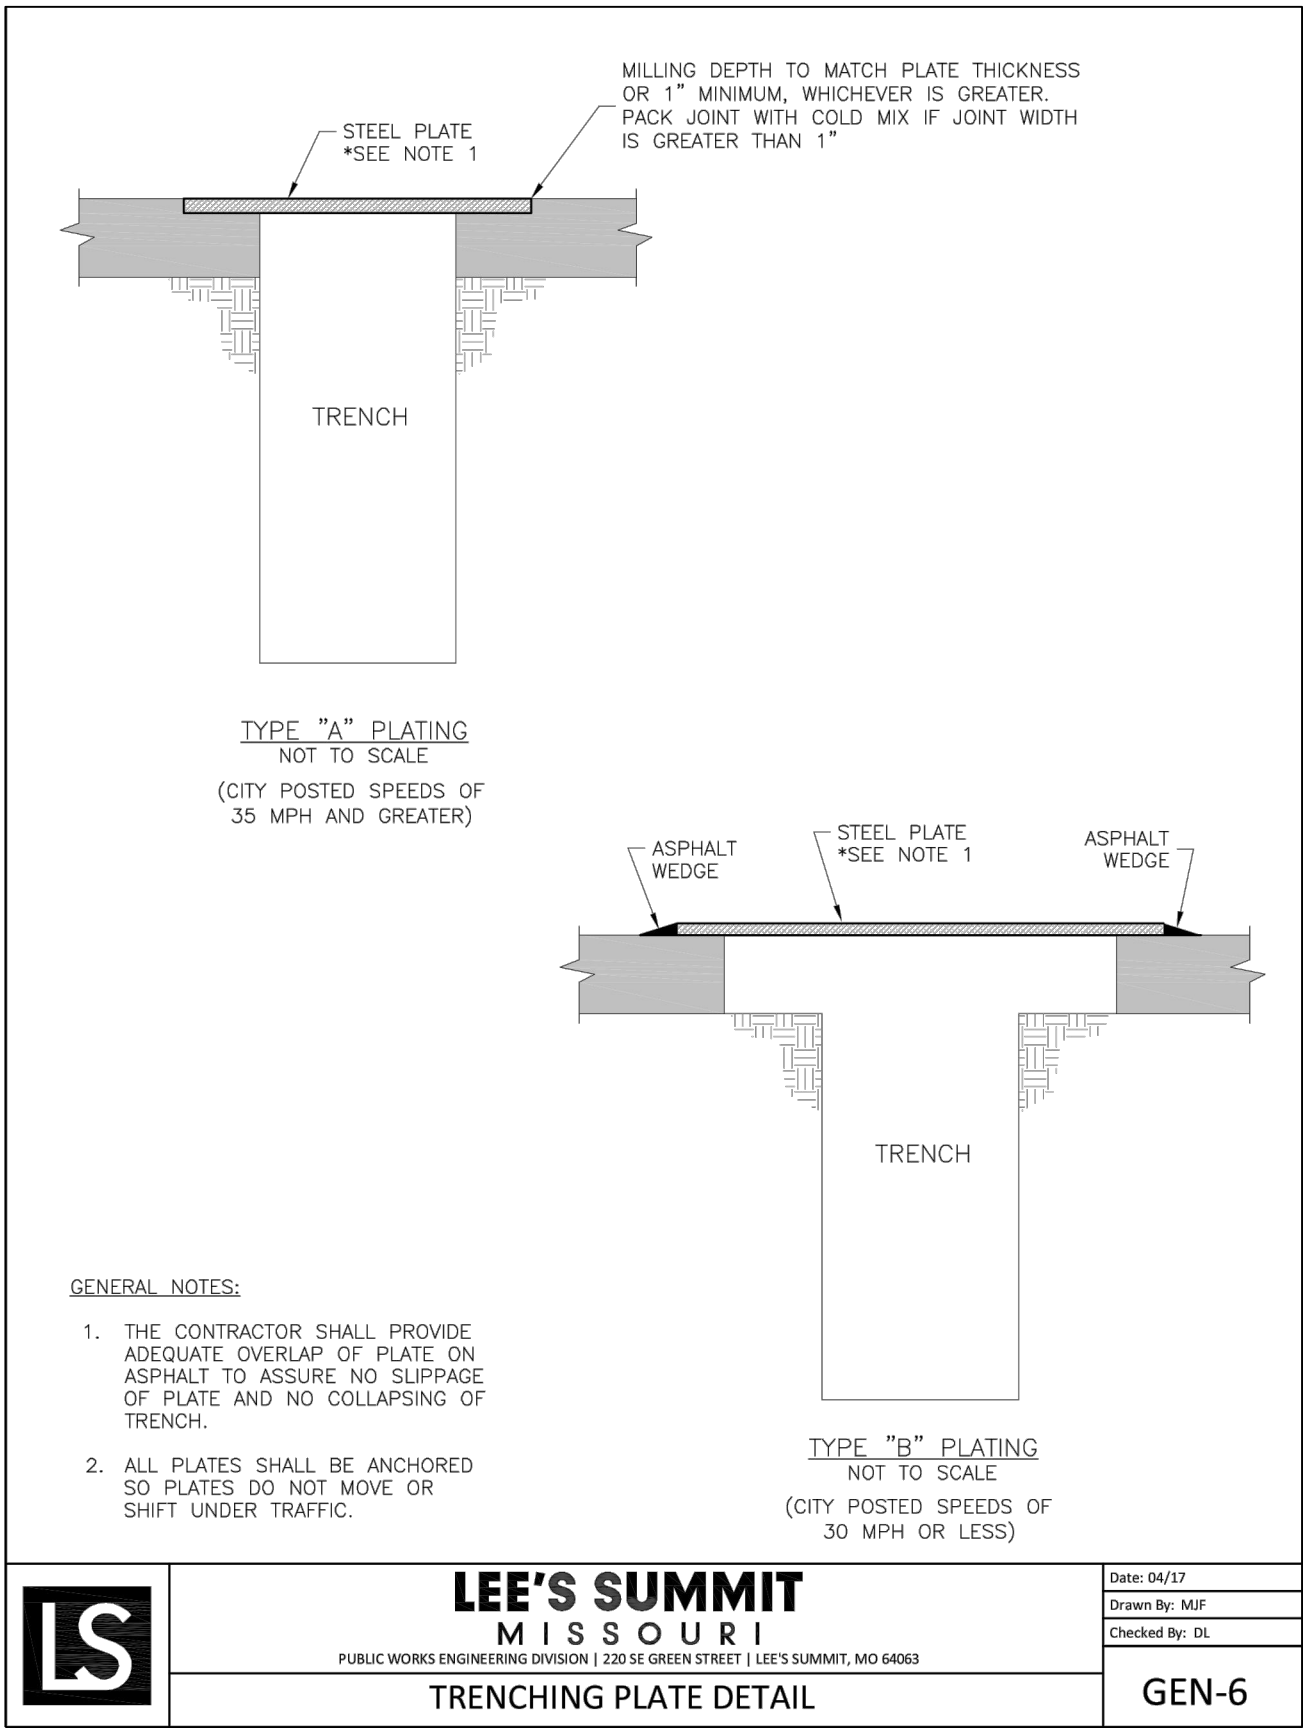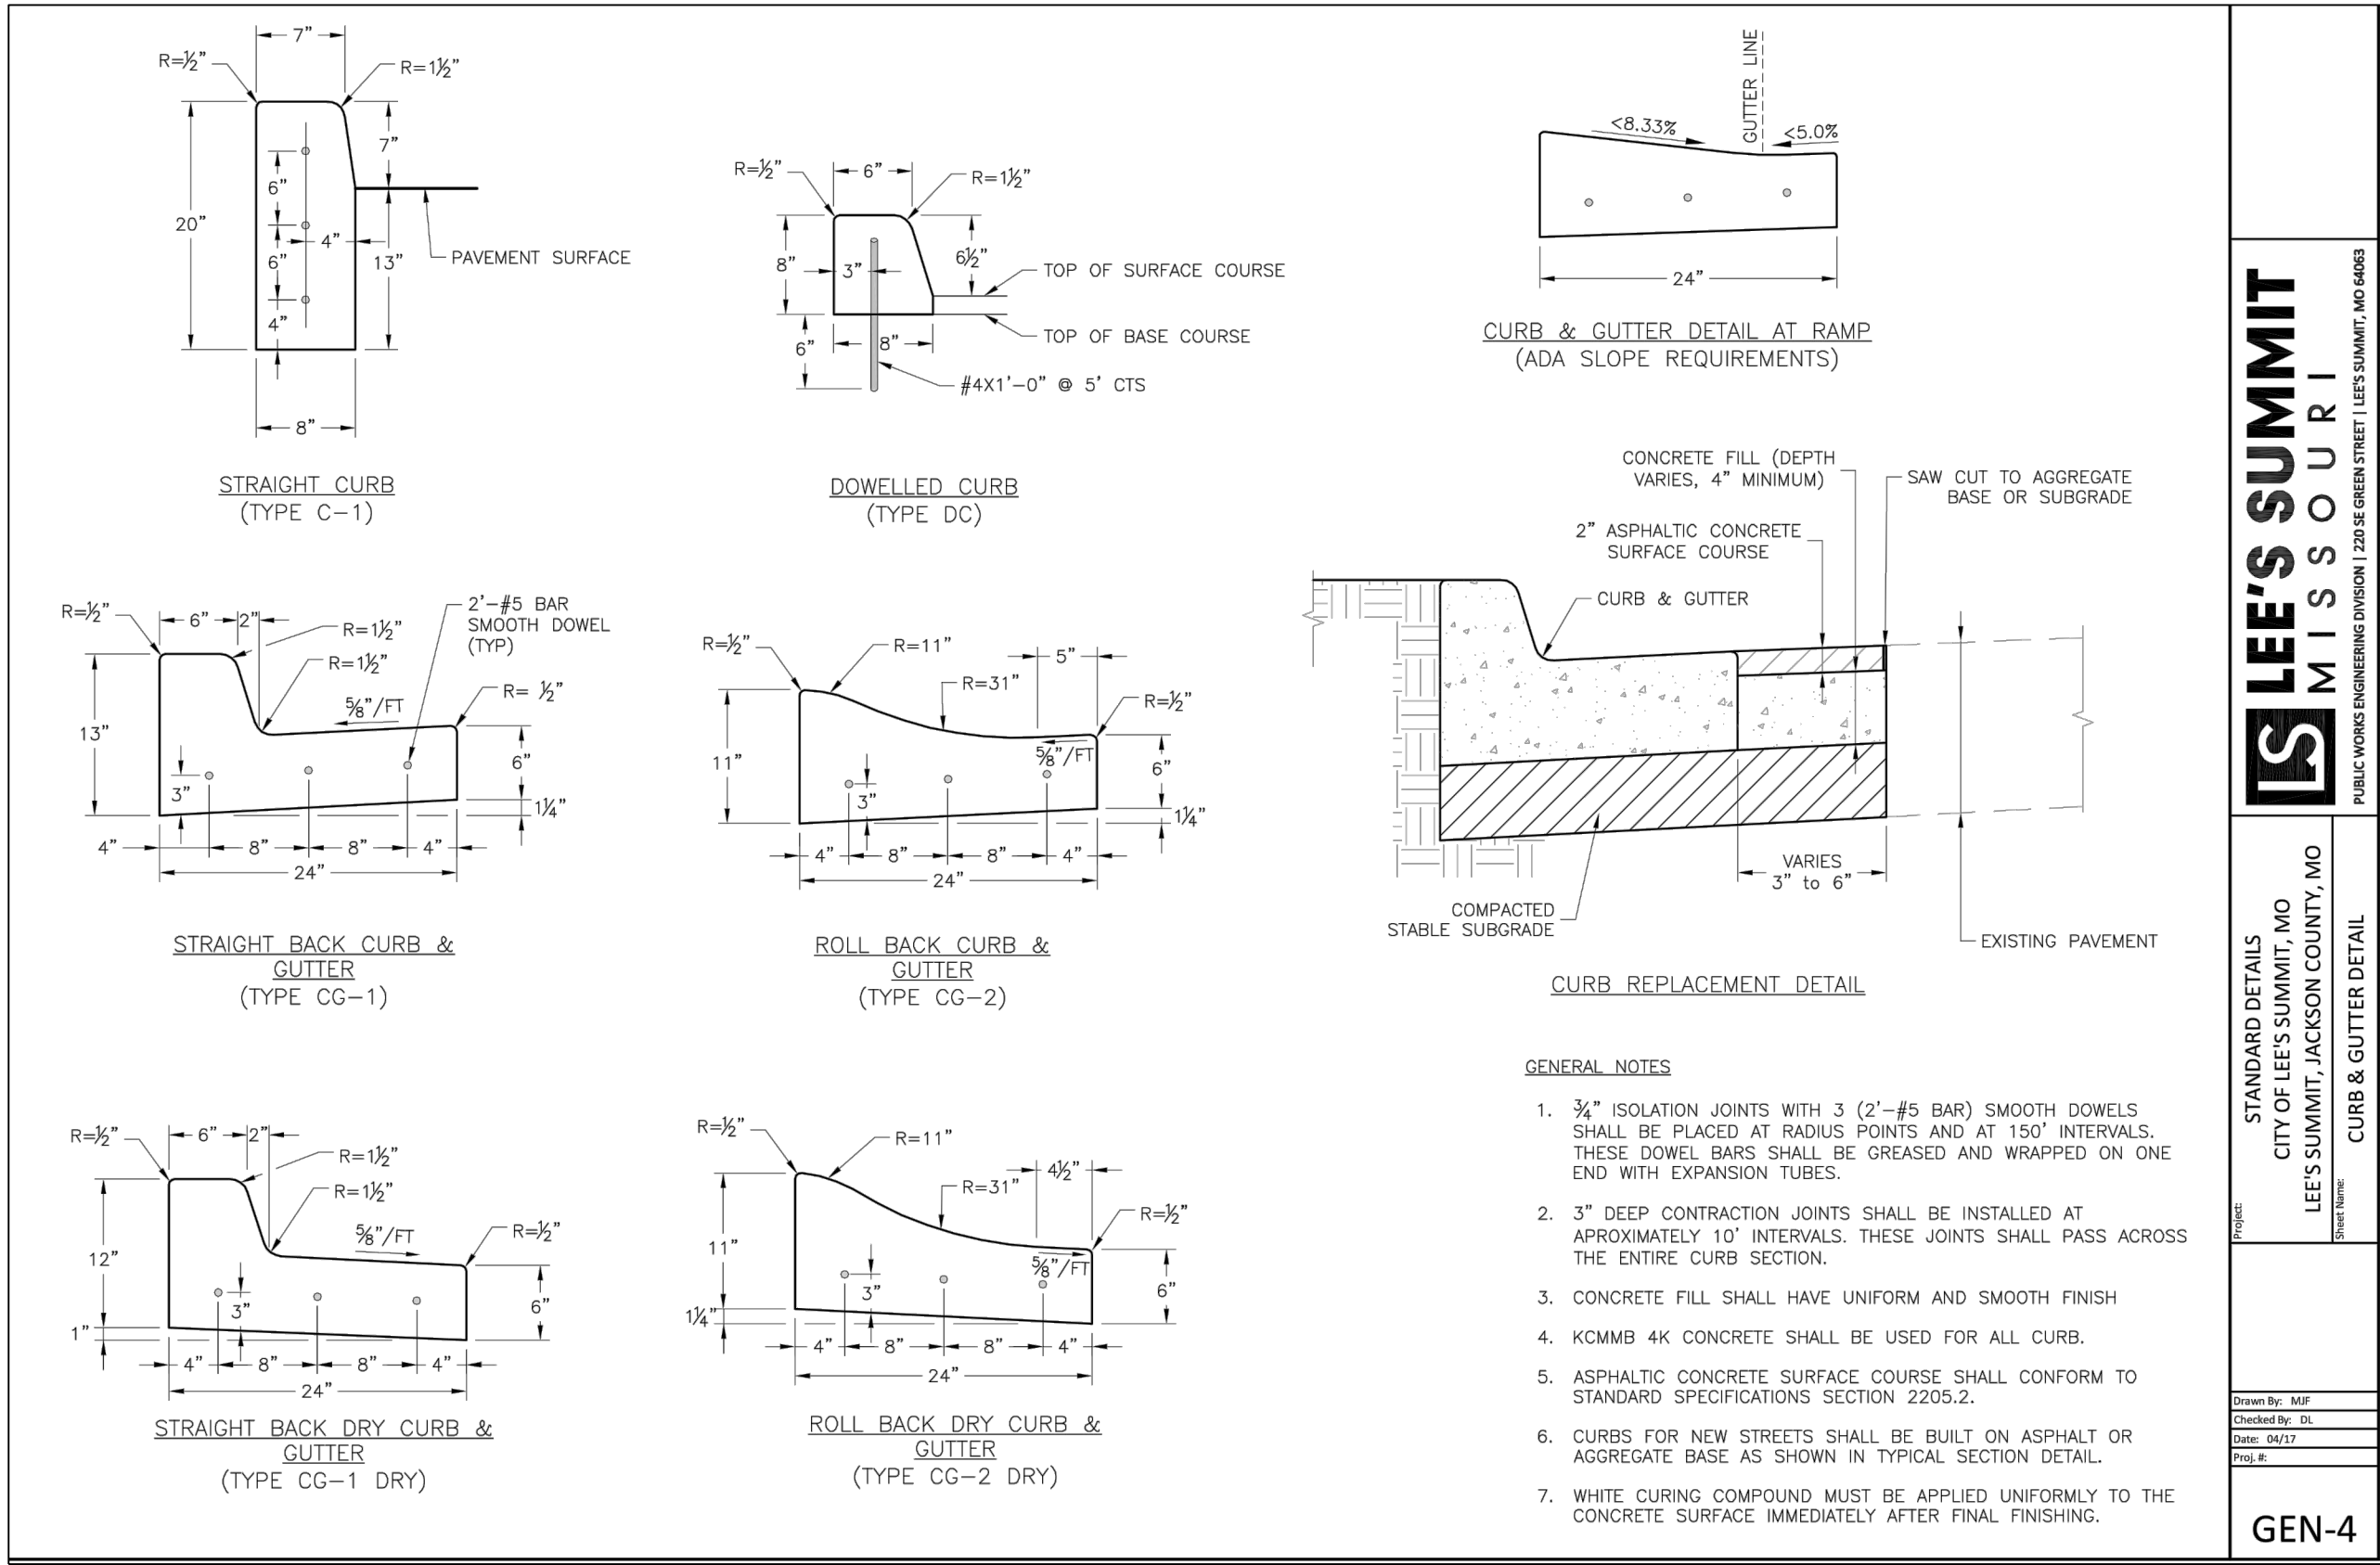

MODOT TYPE I ROCK BLANKET DETAIL

NOTE: SEE MODOT STANDARD SPECIFICATIONS FOR HIGHWAY CONSTRUCTION SECTION 611.30 ROCK BLANKET

Record Drawing


REVISION DATE	DESCRIPTION
06/04/2018	CITY COMMENTS
07/30/2018	CITY COMMENTS
08/28/2018	CITY COMMENTS/SHPO FINDINGS
09/27/2019	REVISE STREET NAMES
8/29/2019	REVISE RETAINING WALLS

DRAWN BY:	KSC
CHECKED BY:	MAB
DATE PREPARED:	4.20.18
PROJ. NUMBER:	17-134

DETAILS



KSC	7-23-19
BY	DATE

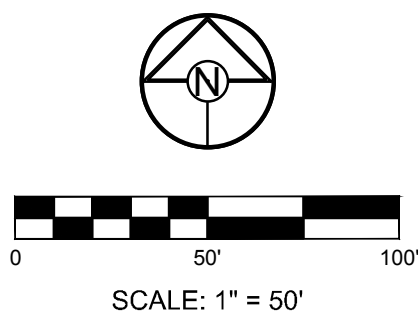

10.23.19

WINTERSET VALLEY, 12TH PLAT
STREET, STORMWATER, MASTER DRAINAGE PLAN AND
EROSION AND SEDIMENT CONTROL
AUDUBON LANE AND CARSON DRIVE
LEE'S SUMMIT, MO

DRAWN BY:	REVISION DATE:	DESCRIPTION:
KSC	06/04/2018	CITY COMMENTS
	07/30/2018	CITY COMMENTS
CHECKED BY:	08/28/2018	CITY COMMENT/SHPO FINDINGS
MAB	08/27/2019	REVISE STREET NAMES
	8/29/2019	REVISE RETAINING WALLS
DATE PREPARED:		
4.20.18		
PROJ. NUMBER:		
17-134		

SIGN PLAN


SHEET

24

OF 25



SCHLAGEL & ASSOCIATES, P.A.
 Engineers • Planners • Surveyors • Landscape Architects
 14920 West 107th Street • Lenexa, Kansas 66215
 (913) 492-5158 • Fax: (913) 492-8400
 WWW.SCHLAGELASSOCIATES.COM
 Missouri State Certificates of Authority
 #E2000003800-F #LAC2001005237 #LS2002008659-F

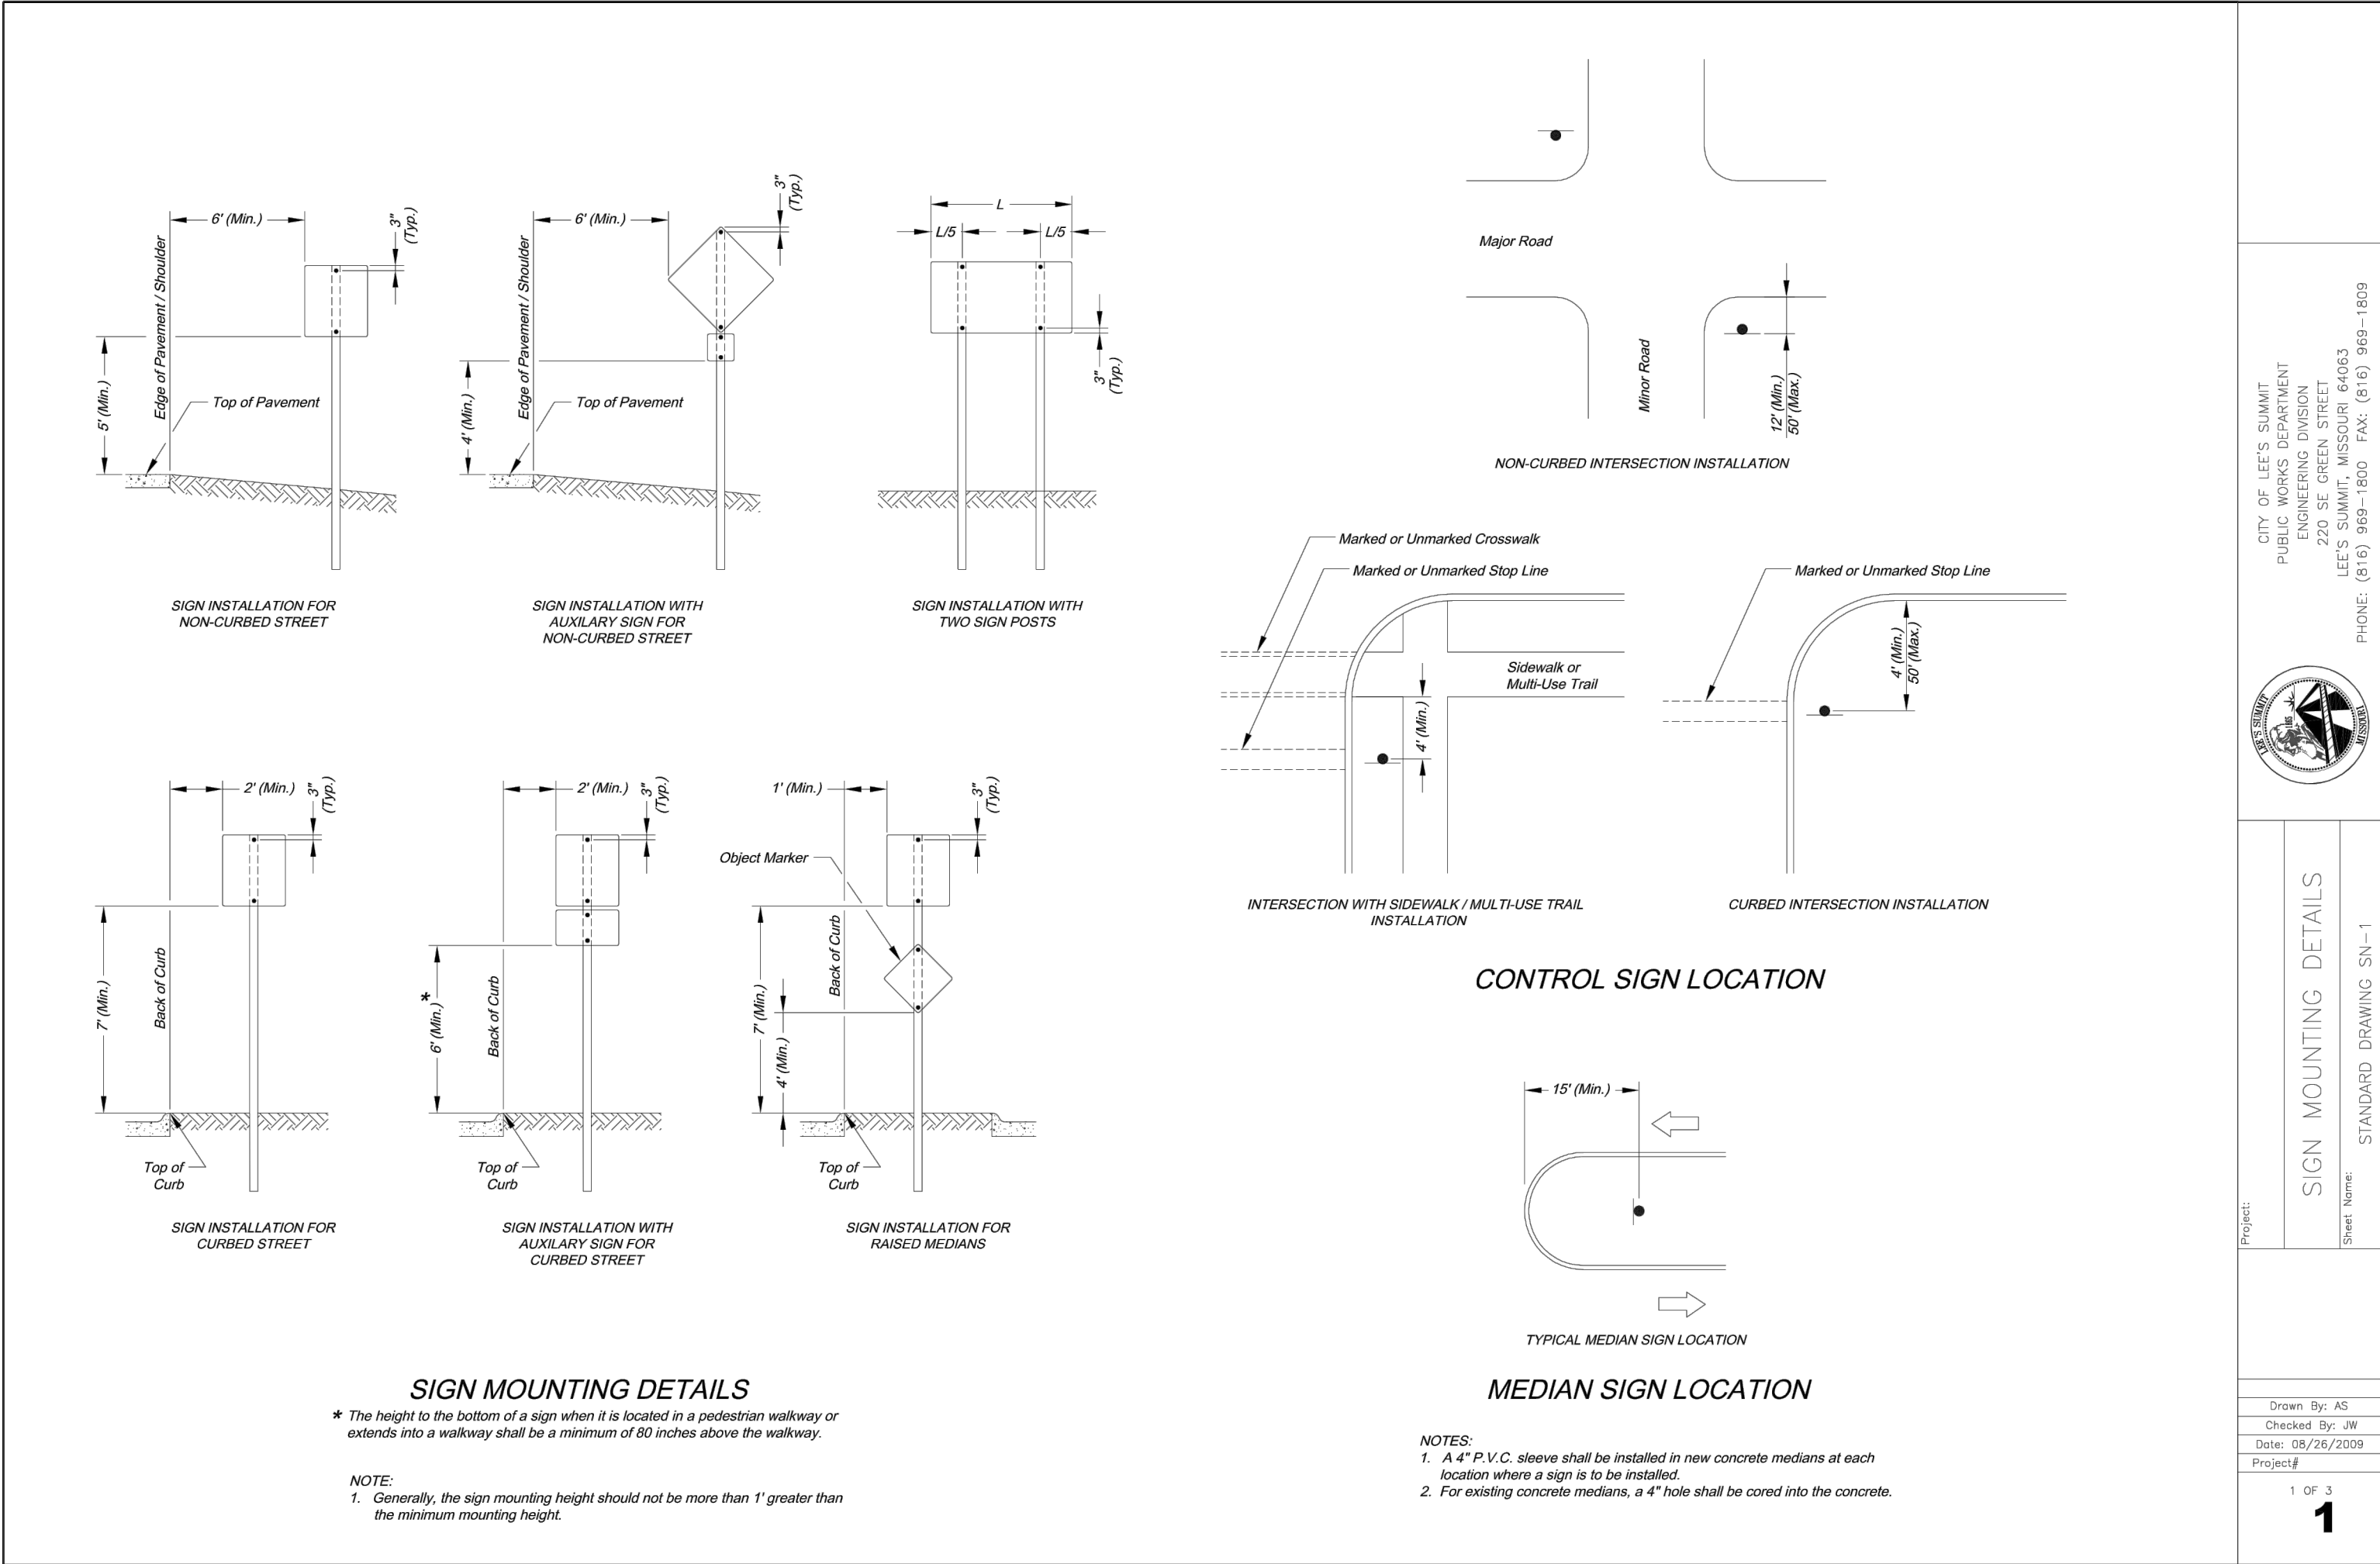


CITY OF LEE'S SUMMIT
PUBLIC WORKS DEPARTMENT
ENGINEERING DIVISION
220 SE GREEN STREET
LEE'S SUMMIT, MISSOURI 64083
PHONE: (816) 969-1800 FAX: (816) 969-1809

PROJECT: STREET NAME SIGN DETAILS
SHEET NAME: STANDARD DRAWING SN-1

Drawn By: AS
Checked By: JW
Date: 08/26/2009
Project: 17-134

1 OF 3

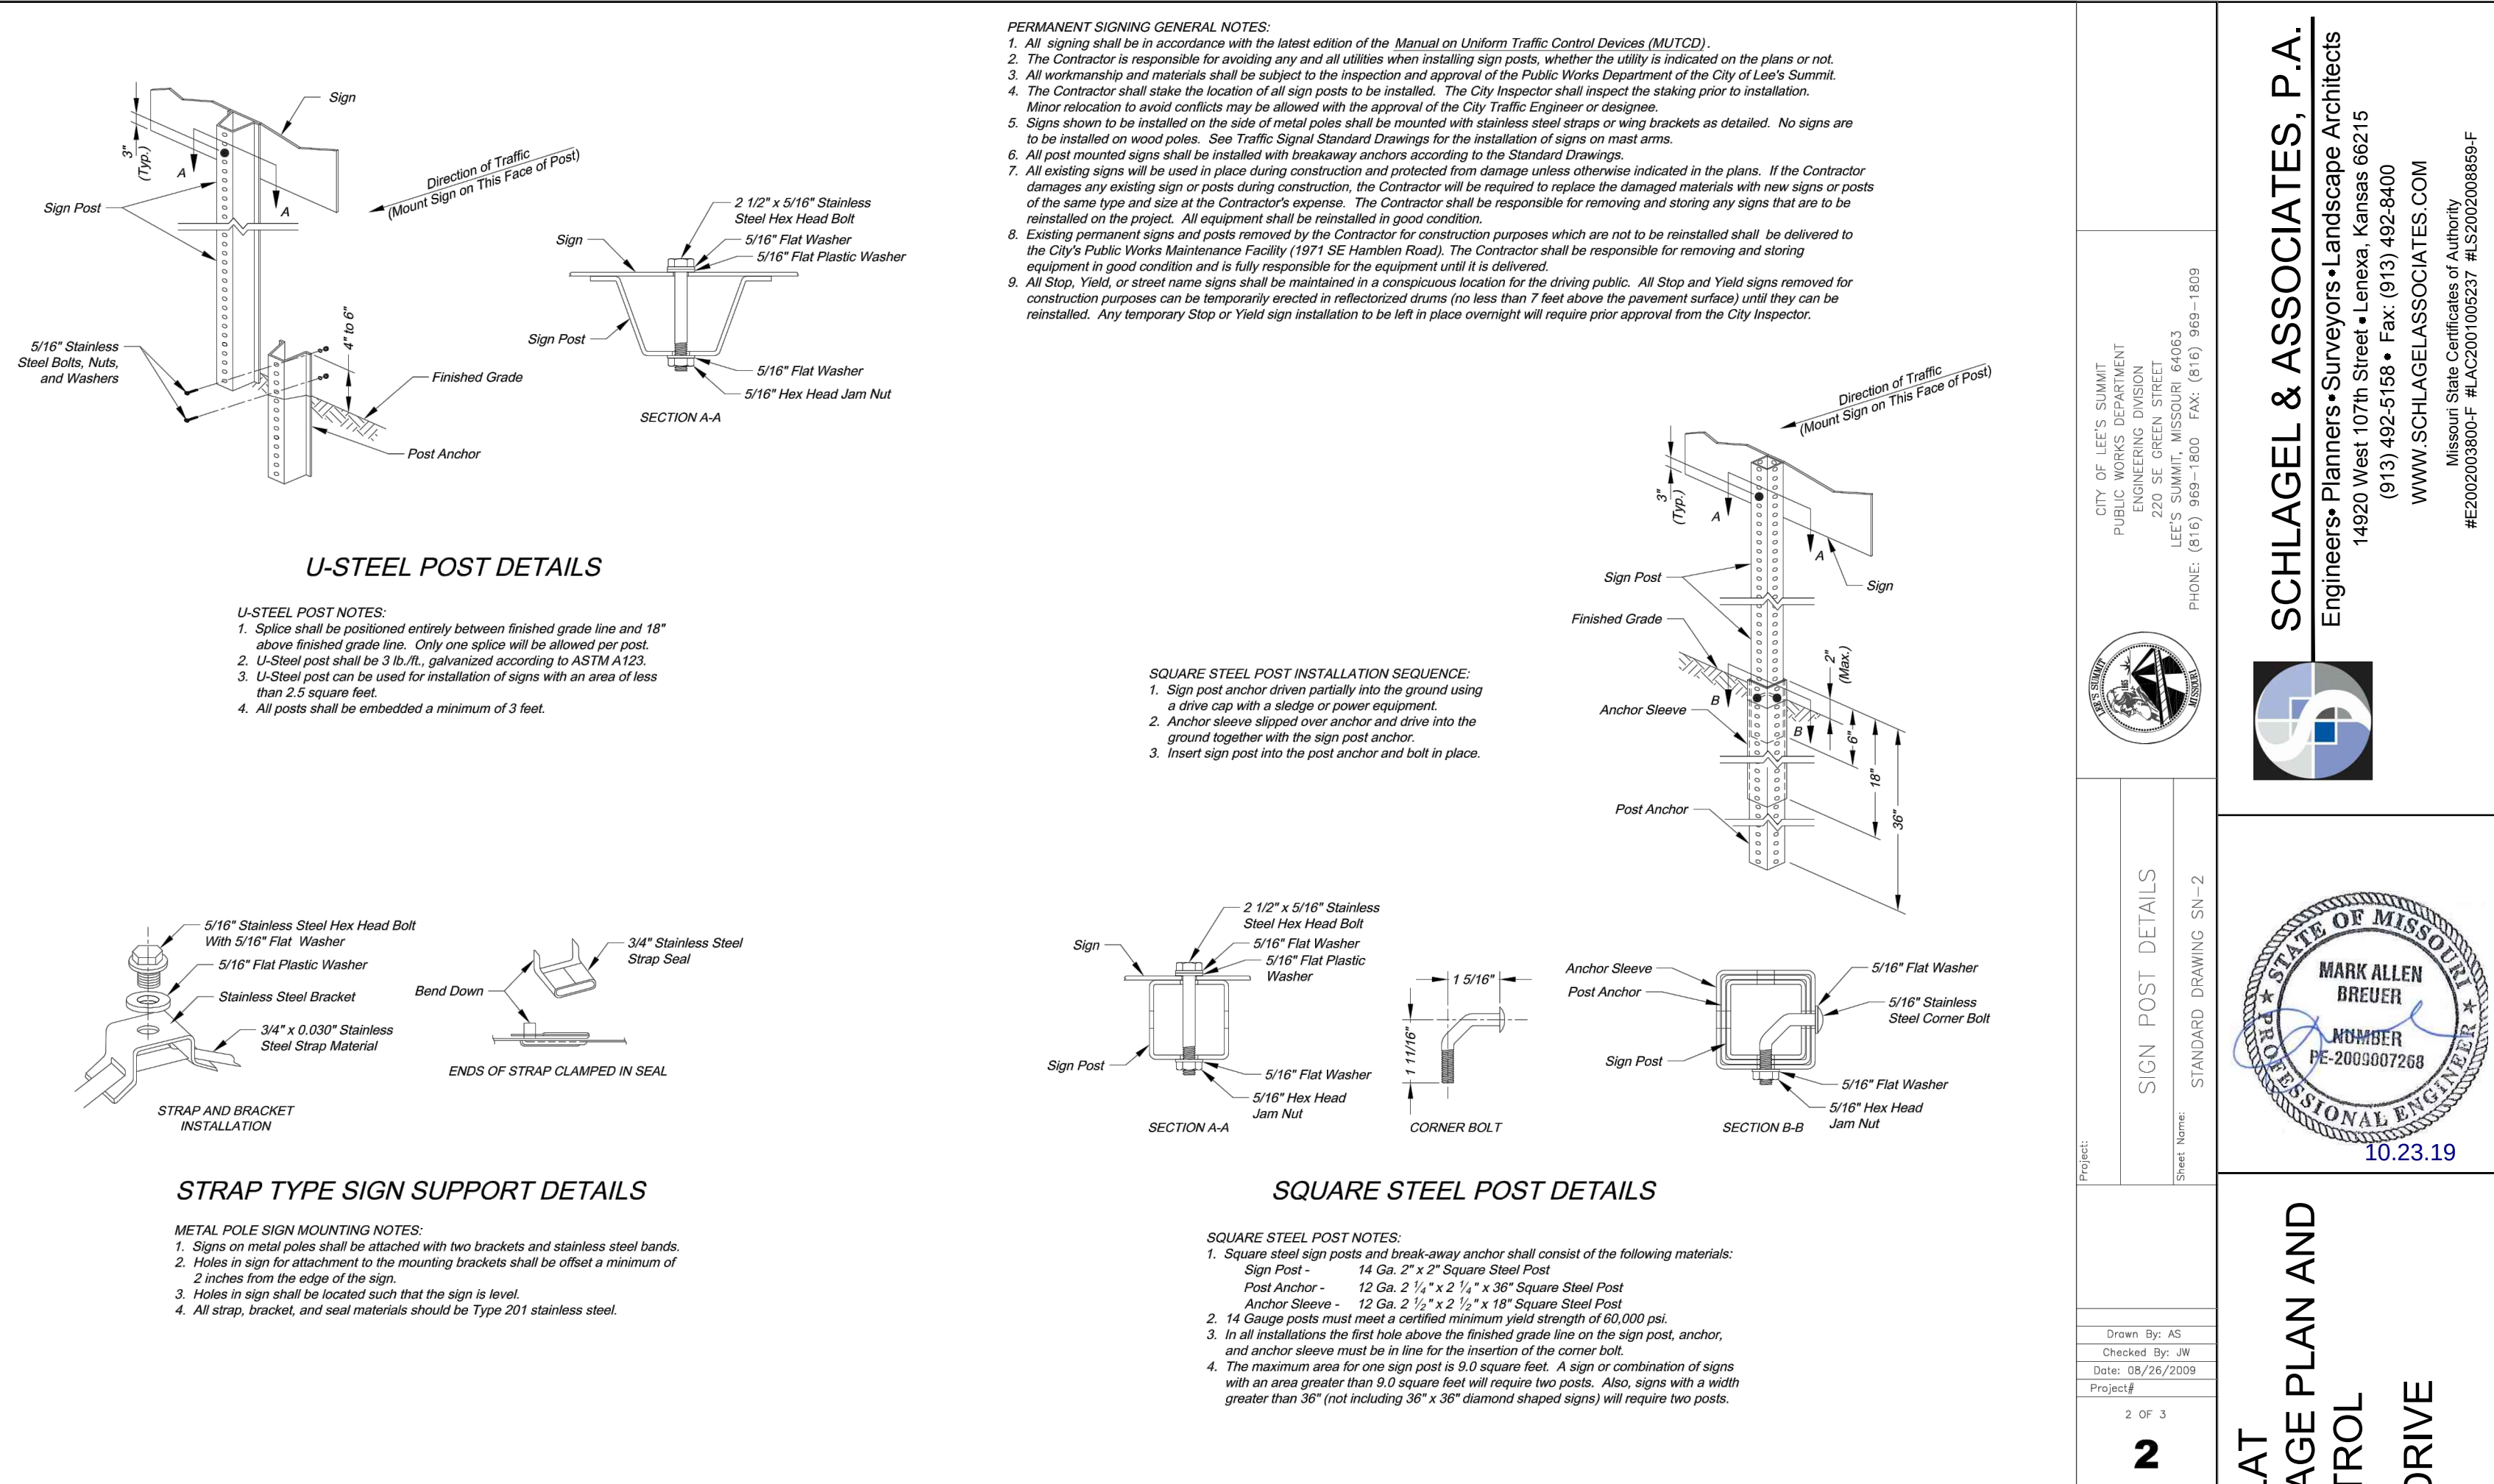


CITY OF LEE'S SUMMIT
PUBLIC WORKS DEPARTMENT
ENGINEERING DIVISION
220 SE GREEN STREET
LEE'S SUMMIT, MISSOURI 64083
PHONE: (816) 969-1800 FAX: (816) 969-1809

PROJECT: STREET NAME SIGN DETAILS
SHEET NAME: STANDARD DRAWING SN-3

Drawn By: AS
Checked By: JW
Date: 08/26/2009
Project: 17-134

3 OF 3

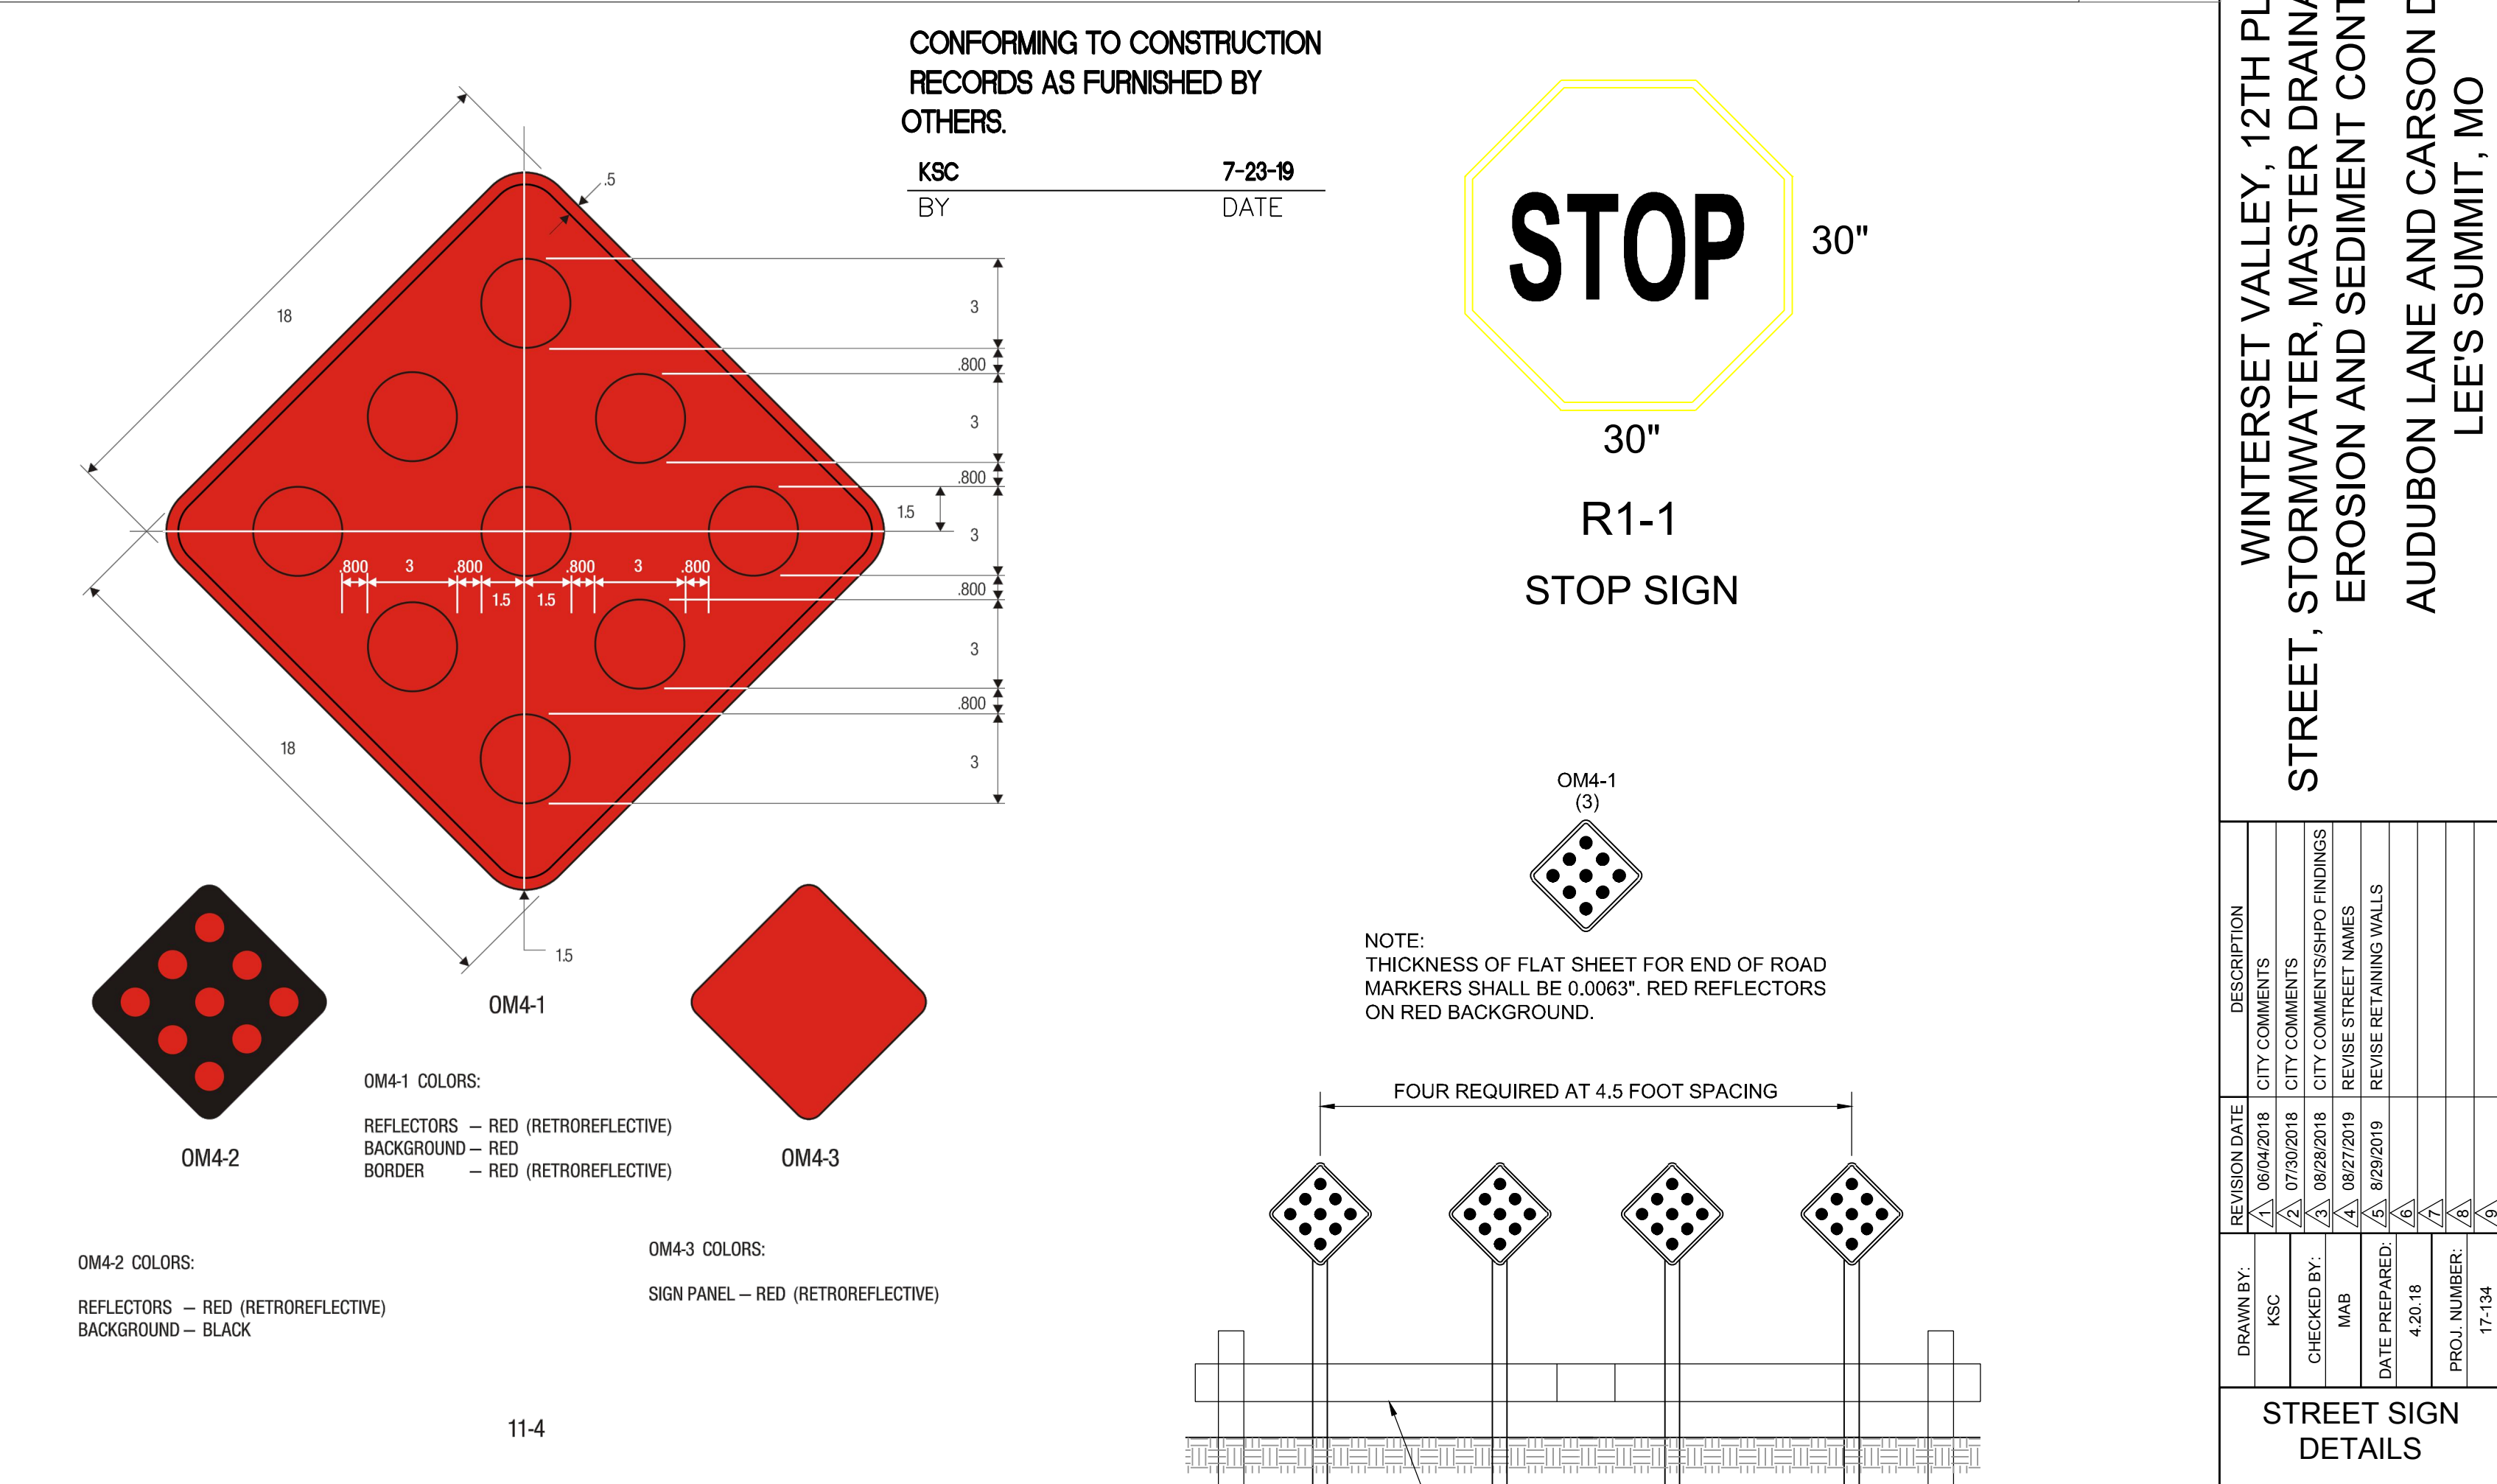

Record Drawing