


HAWTHORN RIDGE 1ST PLAT STREET & STORM SEWER PLANS

SECTION 25, TOWNSHIP 47 N., RANGE 32 W.
IN LEE'S SUMMIT, JACKSON, MO

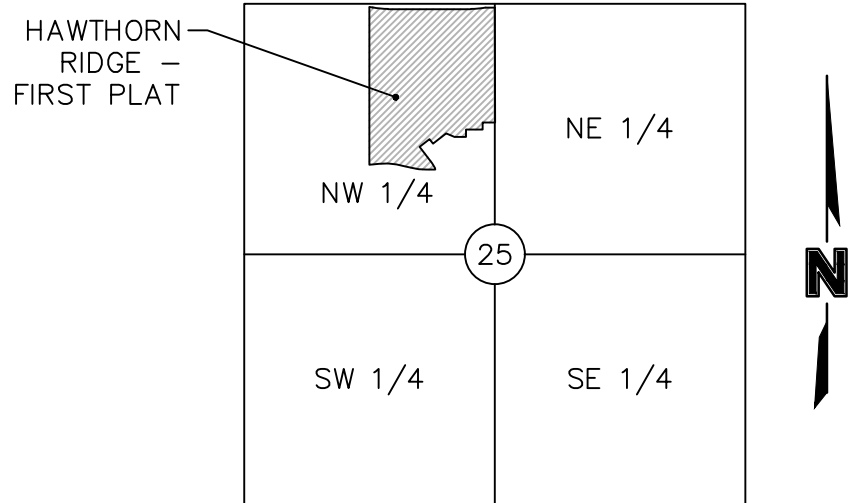

LOCATION MAP

Sec. 25, Twp. 47 N., Rge. 32 W.
(N.T.S.)

Record Drawing

Sue Pyles 2023.03.10
14:46:34-06'00"

AS BUILT

DATE: 12/19/2018


- ☐ NOT FOR CONSTRUCTION
- ☒ REVIEWED FOR CONSTRUCTION

DEVELOPMENT TEAM CONTACT INFORMATION

CIVIL ENGINEER		
	MELISSA G DEGONIA, P.E. OLSSON ASSOCIATES	1301 BURLINGTON, SUITE 100 NORTH KANSAS CITY, MO 64116 TEL: 816.587.4320 FAX: 816.587.1393 MDEGONIA@OLSSONASSOCIATES.COM
OWNER/DEVELOPER		
	DAVID PRICE CMH PARKS, INC. D/B/A SUMMIT CUSTOM HOMES	120 SE 30TH ST LEE'S SUMMIT, MO 64082 TEL: 816.246.6700 DAVID@SUMMITCUSTOMHOMESKC.COM

UTILITY SERVICE NUMBERS

LEE'S SUMMIT PUBLIC WORKS	816-969-1800
LEE'S SUMMIT WATER & SEWER DEPARTMENT	816-969-1940
MISSOURI GAS ENERGY	816-756-5252
AT&T	800-286-8313
KCP&L	816-471-5275
TIME WARNER CABLE	816-358-5360
GOOGLE FIBER	877-454-6959

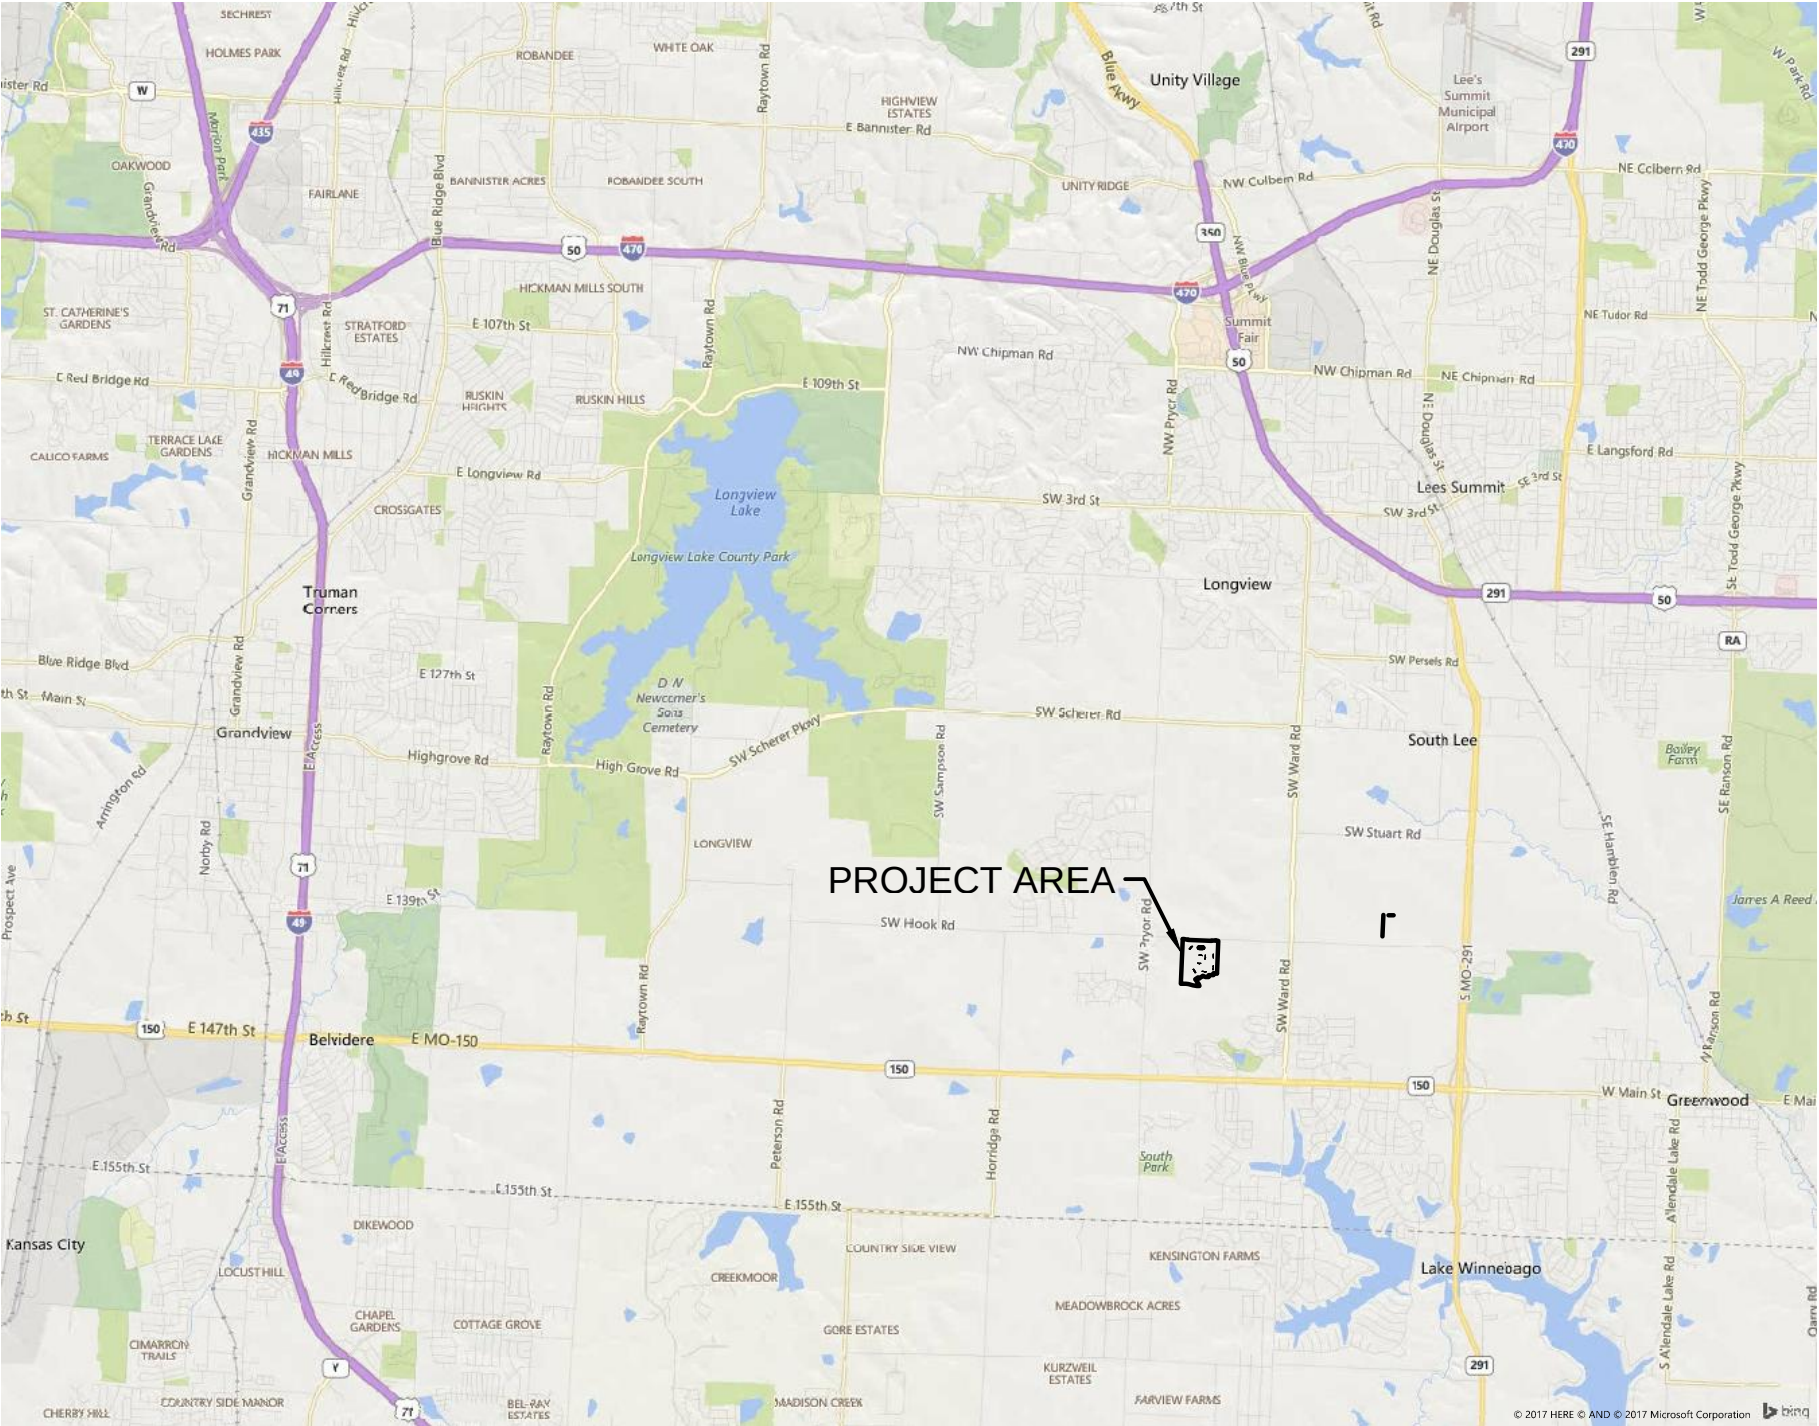

PROPERTY DESCRIPTION:

A tract of land in the Northwest Quarter of Section 25, Township 47 North, Range 32 West of the 5th Principal Meridian in Lee's Summit, Jackson County, Missouri being bounded and described as follows: Commencing at the center of said Section 25; thence North 02°18'36" East, along the West line of said Northwest Quarter, 1,392.58 feet to the Point of Beginning of the tract of land to be herein described; thence North 87°41'24" West, 130.00 feet; thence South 02°18'36" West, 72.00 feet; thence North 87°41'24" West, 175.00 feet; thence South 02°18'36" West, 78.00 feet; thence North 87°41'24" West, 121.73 feet; thence North 65°30'07" West, 95.33 feet; thence South 54°57'38" West, 175.90 feet; thence North 35°02'22" West, 58.00 feet; thence South 54°57'38" West, 130.00 feet; thence South 35°02'22" East, 216.00 feet; thence South 26°05'21" East, 59.04 feet; thence South 11°06'36" East, 18.27 feet; thence North 87°41'24" West, 95.00 feet; thence North 85°13'24" West, 75.61 feet; thence North 77°26'18" West, 74.74 feet; thence North 73°51'15" West, 80.00 feet; thence North 75°24'39" West, 87.64 feet; thence North 81°26'34" West, 91.19 feet; thence North 87°51'30" West, 91.19 feet; thence South 86°06'14" West, 105.62 feet to a point on the West line of the East half said Northwest Quarter; thence North 02°27'15" East, along said West line, 1,661.30 feet to a point on the South right-of-way line of SW Hook Road, as now established; thence Easterly along said South right-of-way line, a along a curve to the right, having an initial tangent bearing of South 80°28'37" East with a radius of 470.00 feet, a central angle of 04°08'23" and an arc distance of 33.96 feet; thence Easterly, continuing along said South right-of-way line, along a curve to the left, having a common tangent with the last described course with a radius of 830.00 feet, a central angle of 11°15'17" and an arc distance of 163.04 feet; thence South 87°35'31" East, continuing along said South right-of-way line, 873.16 feet; thence Easterly continuing along said South right-of-way line, along a curve to the left having an initial tangent bearing of South 87°35'30" East, with a radius of 830.00 feet, a central angle of 10°48'20" and an arc distance of 156.53 feet; thence South 87°45'42" East, continuing along said South right-of-way line, 95.80 feet to a point on said East line; thence South 02°18'36" West, along said East line, 1,210.33 feet to the Point of Beginning. Containing 1,939,986 square feet or 44.54 acres, more or less.

BENCHMARK

RR SPIKE IN SOUTH FACE OF POWER POLE ON NORTH SIDE OF SW. HOOK ROAD, IMMEDIATELY WEST OF DRIVEWAY FOR HOUSE#1622. ELEVATION= 1024.63'

INDEX OF SHEETS	
TITLE SHEET	C101
GENERAL NOTES	C102
GENERAL LAYOUT	C103
TYPICAL SECTIONS	C104
GRADING PLAN	C105
ROADWAY PLAN & PROFILE	C106
ROADWAY PLAN & PROFILE	C107
ROADWAY PLAN & PROFILE	C108
ROADWAY PLAN & PROFILE	C109
ROADWAY PLAN & PROFILE	C110
ROADWAY PLAN & PROFILE	C111
ROADWAY PLAN & PROFILE	C112
ROADWAY PLAN & PROFILE	C113
TRAFFIC CONTROL PLAN	C114
ROADWAY SPOT ELEVATIONS	C115
ROADWAY SPOT ELEVATIONS	C116
STORM SEWER PLAN & PROFILE	C117
STORM SEWER PLAN AND PROFILE	C118
STORM SEWER PLAN AND PROFILE	C119
STORM SEWER PLAN & PROFILE	C120
STORM SEWER PLAN & PROFILE	C121
STORM SEWER PLAN & PROFILE	C122
STORM SEWER PLAN & PROFILE	C123
DETENTION BASIN PLAN	C124
DETENTION BASIN PLAN	C125
DRAINAGE PLAN	C126
DRAINAGE TABLES - 10 YEAR	C127
DRAINAGE TABLES - 100 YEAR	C128
MASTER DRAINAGE PLAN	C129
SITE DISTURBANCE PLAN - PHASE 1	C130
SITE DISTURBANCE PLAN - PHASE 2	C131
SITE DISTURBANCE PLAN - PHASE 3	C132
LAND DISTURBANCE DETAILS	C133
SIGN DETAILS	C134
STORM SEWER DETAILS	C135
ROADWAY MARKING DETAILS	C136

REVIEWED BY:

City of Lee's Summit

Date

Olsson Associates has been retained to provide as-built drawings for this project.

Melissa G DeGonia, P.E.

Civil Engineer

MO# 2011000892

The Policy of the "Plan Preparation Criteria and Procedure" and Policy Document No. 880544 "As-Built Drawings for Sewer Built by Permit" stipulate the following regarding "as-built" drawings: 1. Drawings are to be provided within thirty (30) days after the date the "Request for As-Built" letter is issued by the City to the contractor. 2. Drawings must be accepted by the City before any service connections will be allowed. 3. Drawings are part of the permit obligations making them the responsibility of the permittee. 4. The cost of preparing "as-built" drawings shall be included in the performance bond.

OLSSON ASSOCIATES



REVISIONS	
NO.	DESCRIPTION
1	Revised per city comments
2	Revised per city comments
3	Revised per city comments
4	Revised per city comments
5	Revised per city comments
6	Revised per city comments
7	Revised per city comments

TITLE SHEET	2018
STREET & STORM SEWER PLANS	
HAWTHORN RIDGE	
1ST PLAT	
LEE'S SUMMIT, MO	

drawn by: D.A.H.O.
checked by: M.G.D.
designed by: P.M.L.B.
QA/QC by: K.S.J.
project no.: 017-0188
date: 03.03.2017


SHEET
C101

USER: dhenandez

DWG: F:\2017\0001-0500\017-0188\40-Design\AutoCAD\Final Plans\ASBUILT\CONV\01_Street & Storm_36x24\C_TL01_017-0188.dwg
DATE: Feb 19, 2019 5:48pm

DWG: F:\2017\0001-0500\017-0188\40-Design\AutoCAD\Final Plans\ASBUILT\CONV\01_Street & Storm_36x24\C_GEN02_017-0188.dwg USER: dhernandez

DATE: Feb 19, 2019 5:50pm

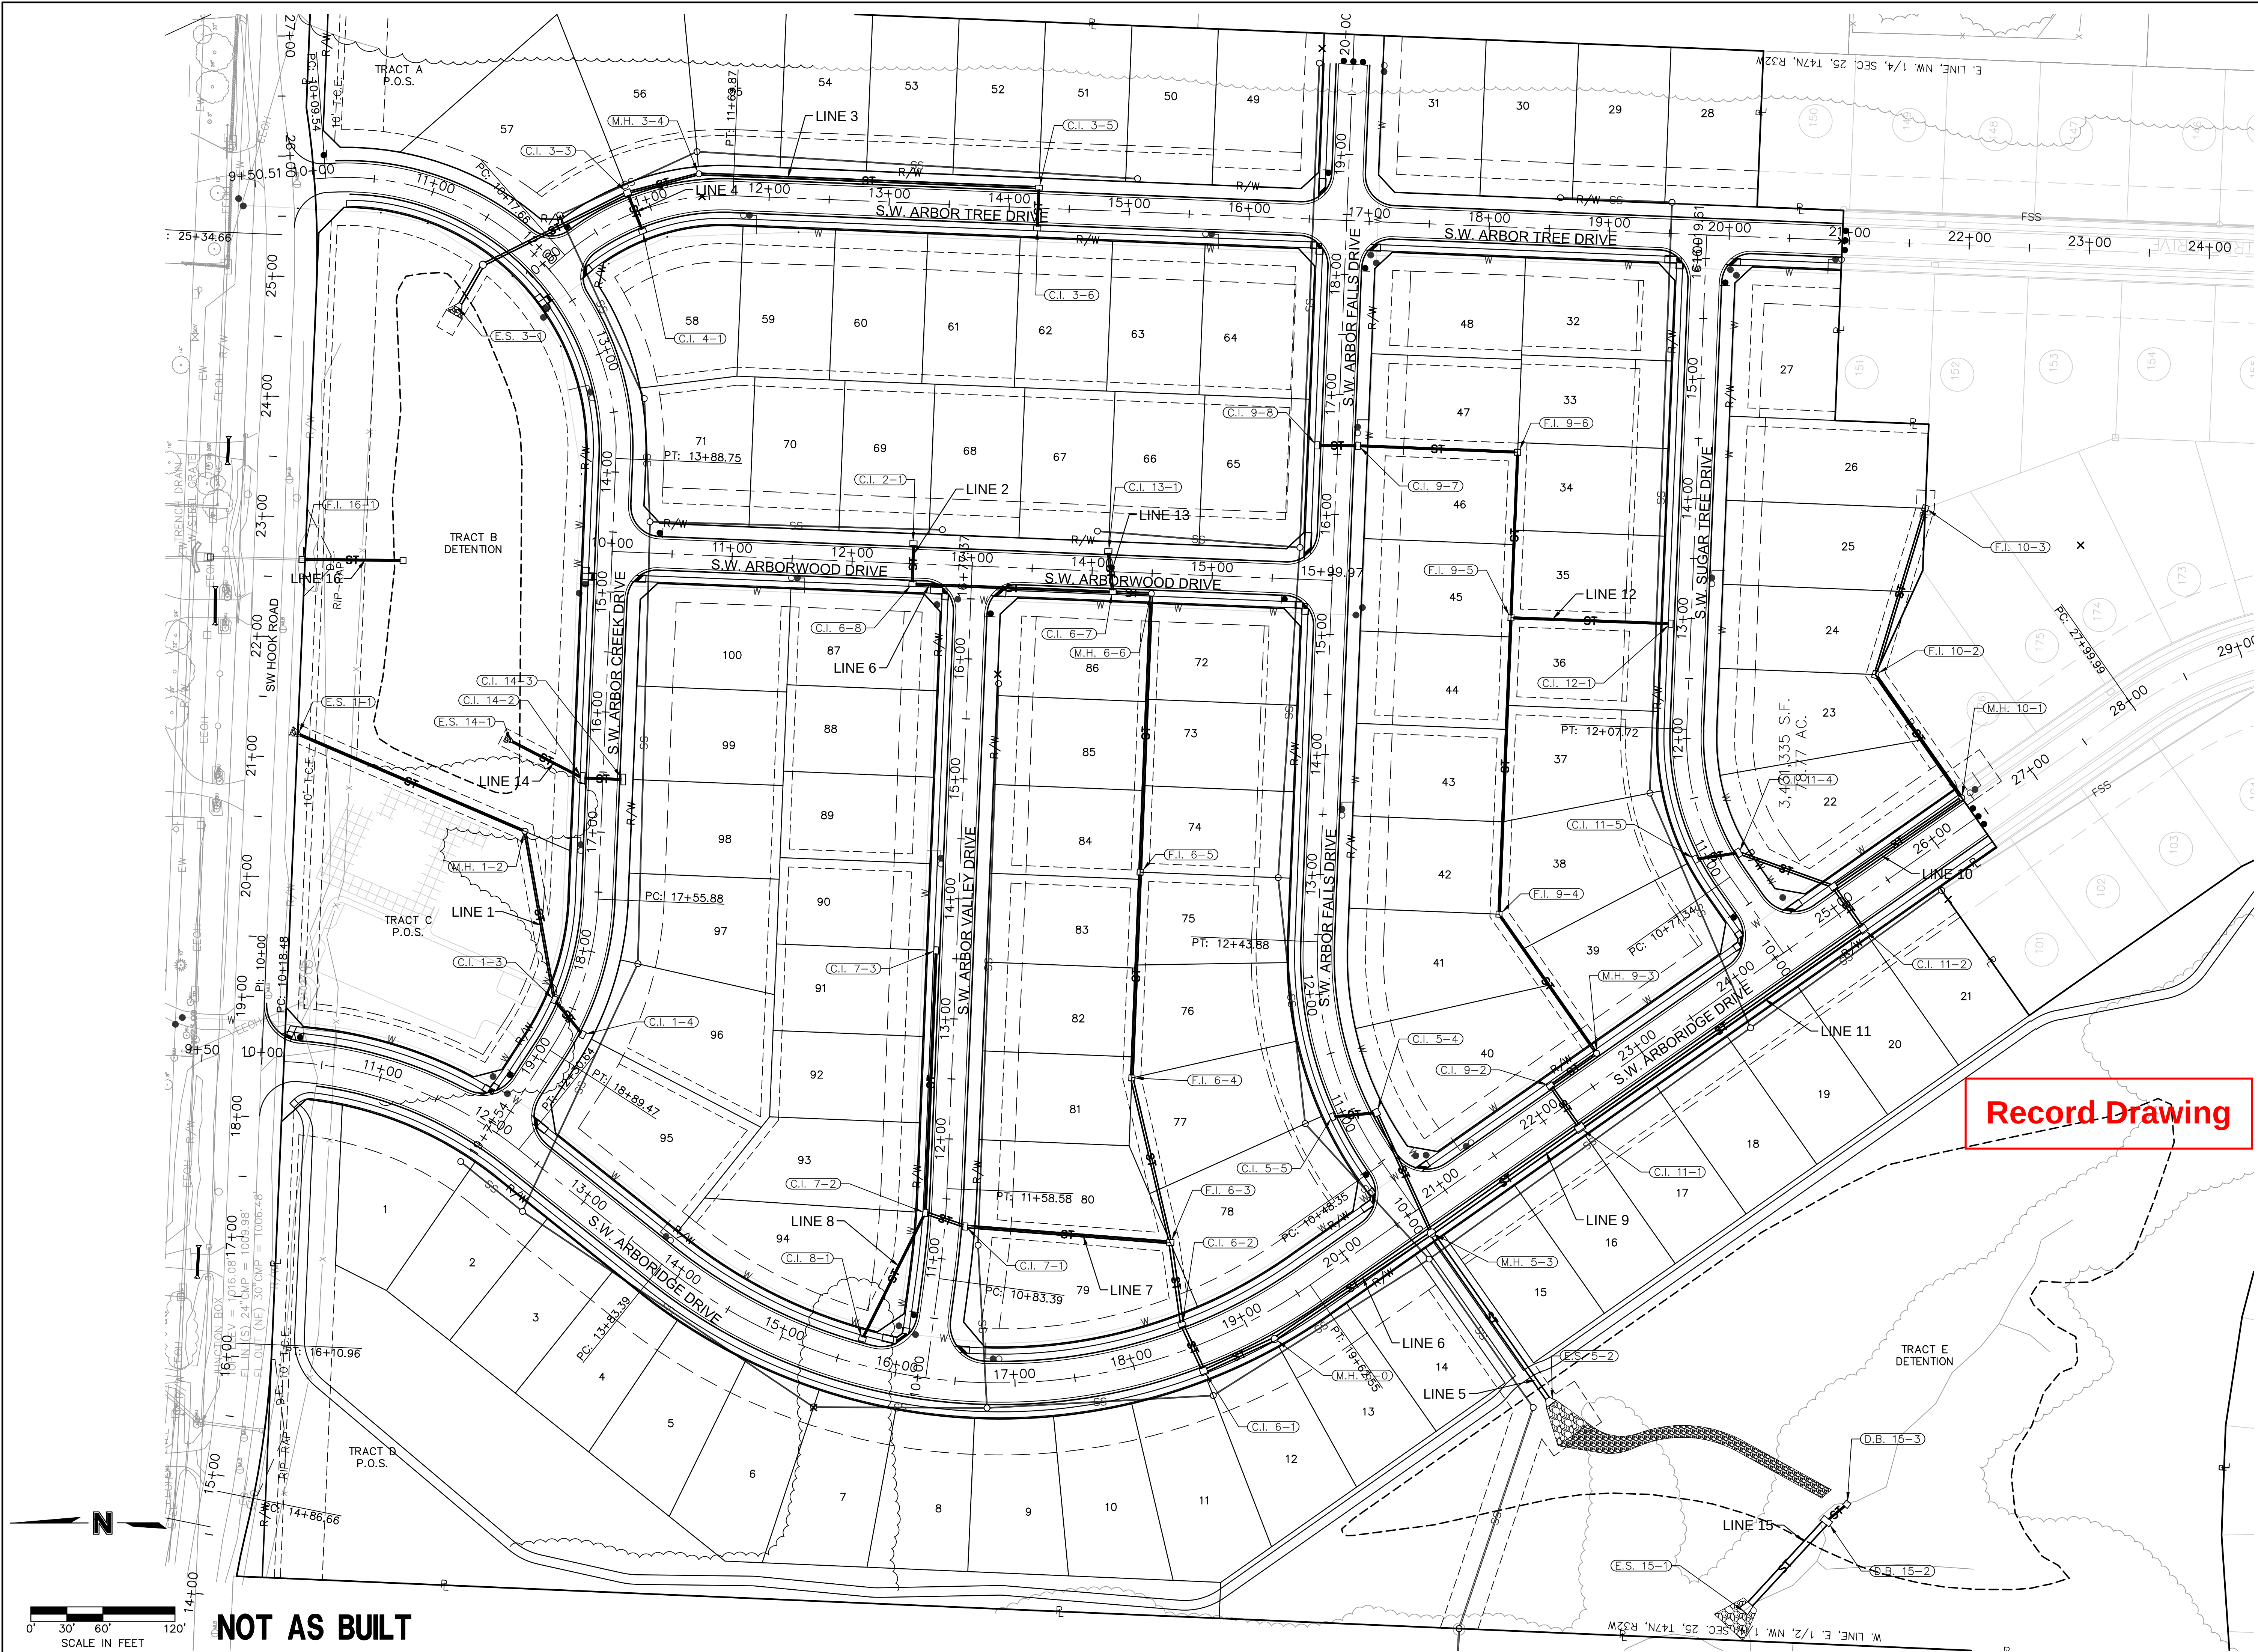

NOT AS BUILT

Record Drawing

OLSSON ASSOCIATES

Olsson Associates - Civil Engineering
Professional Engineer
No. 0000000000
North Kansas City, MO 64116
TEL 816.997.4320
FAX 816.997.1393
www.olssonassociates.com

STATE OF MISSOURI
MELISSA G. DEGENIA
NUMBER
FE-2011000892
08/04/2019
PROFESSIONAL ENGINEER

BY: MGD

REVISIONS DESCRIPTION

NO. REV. DATE

4 01.03.2018 Removed Road Improvements

REVISIONS

2018

#####


HAWTHORN RIDGE
1ST PLAT

LEE'S SUMMIT, MO

drawn by: DAH
checked by: MGD
designed by: PML
QA/QC by: KSL
project no.: 017-0188
date: 03.03.2017

SHEET
C103

NOT AS BUILT

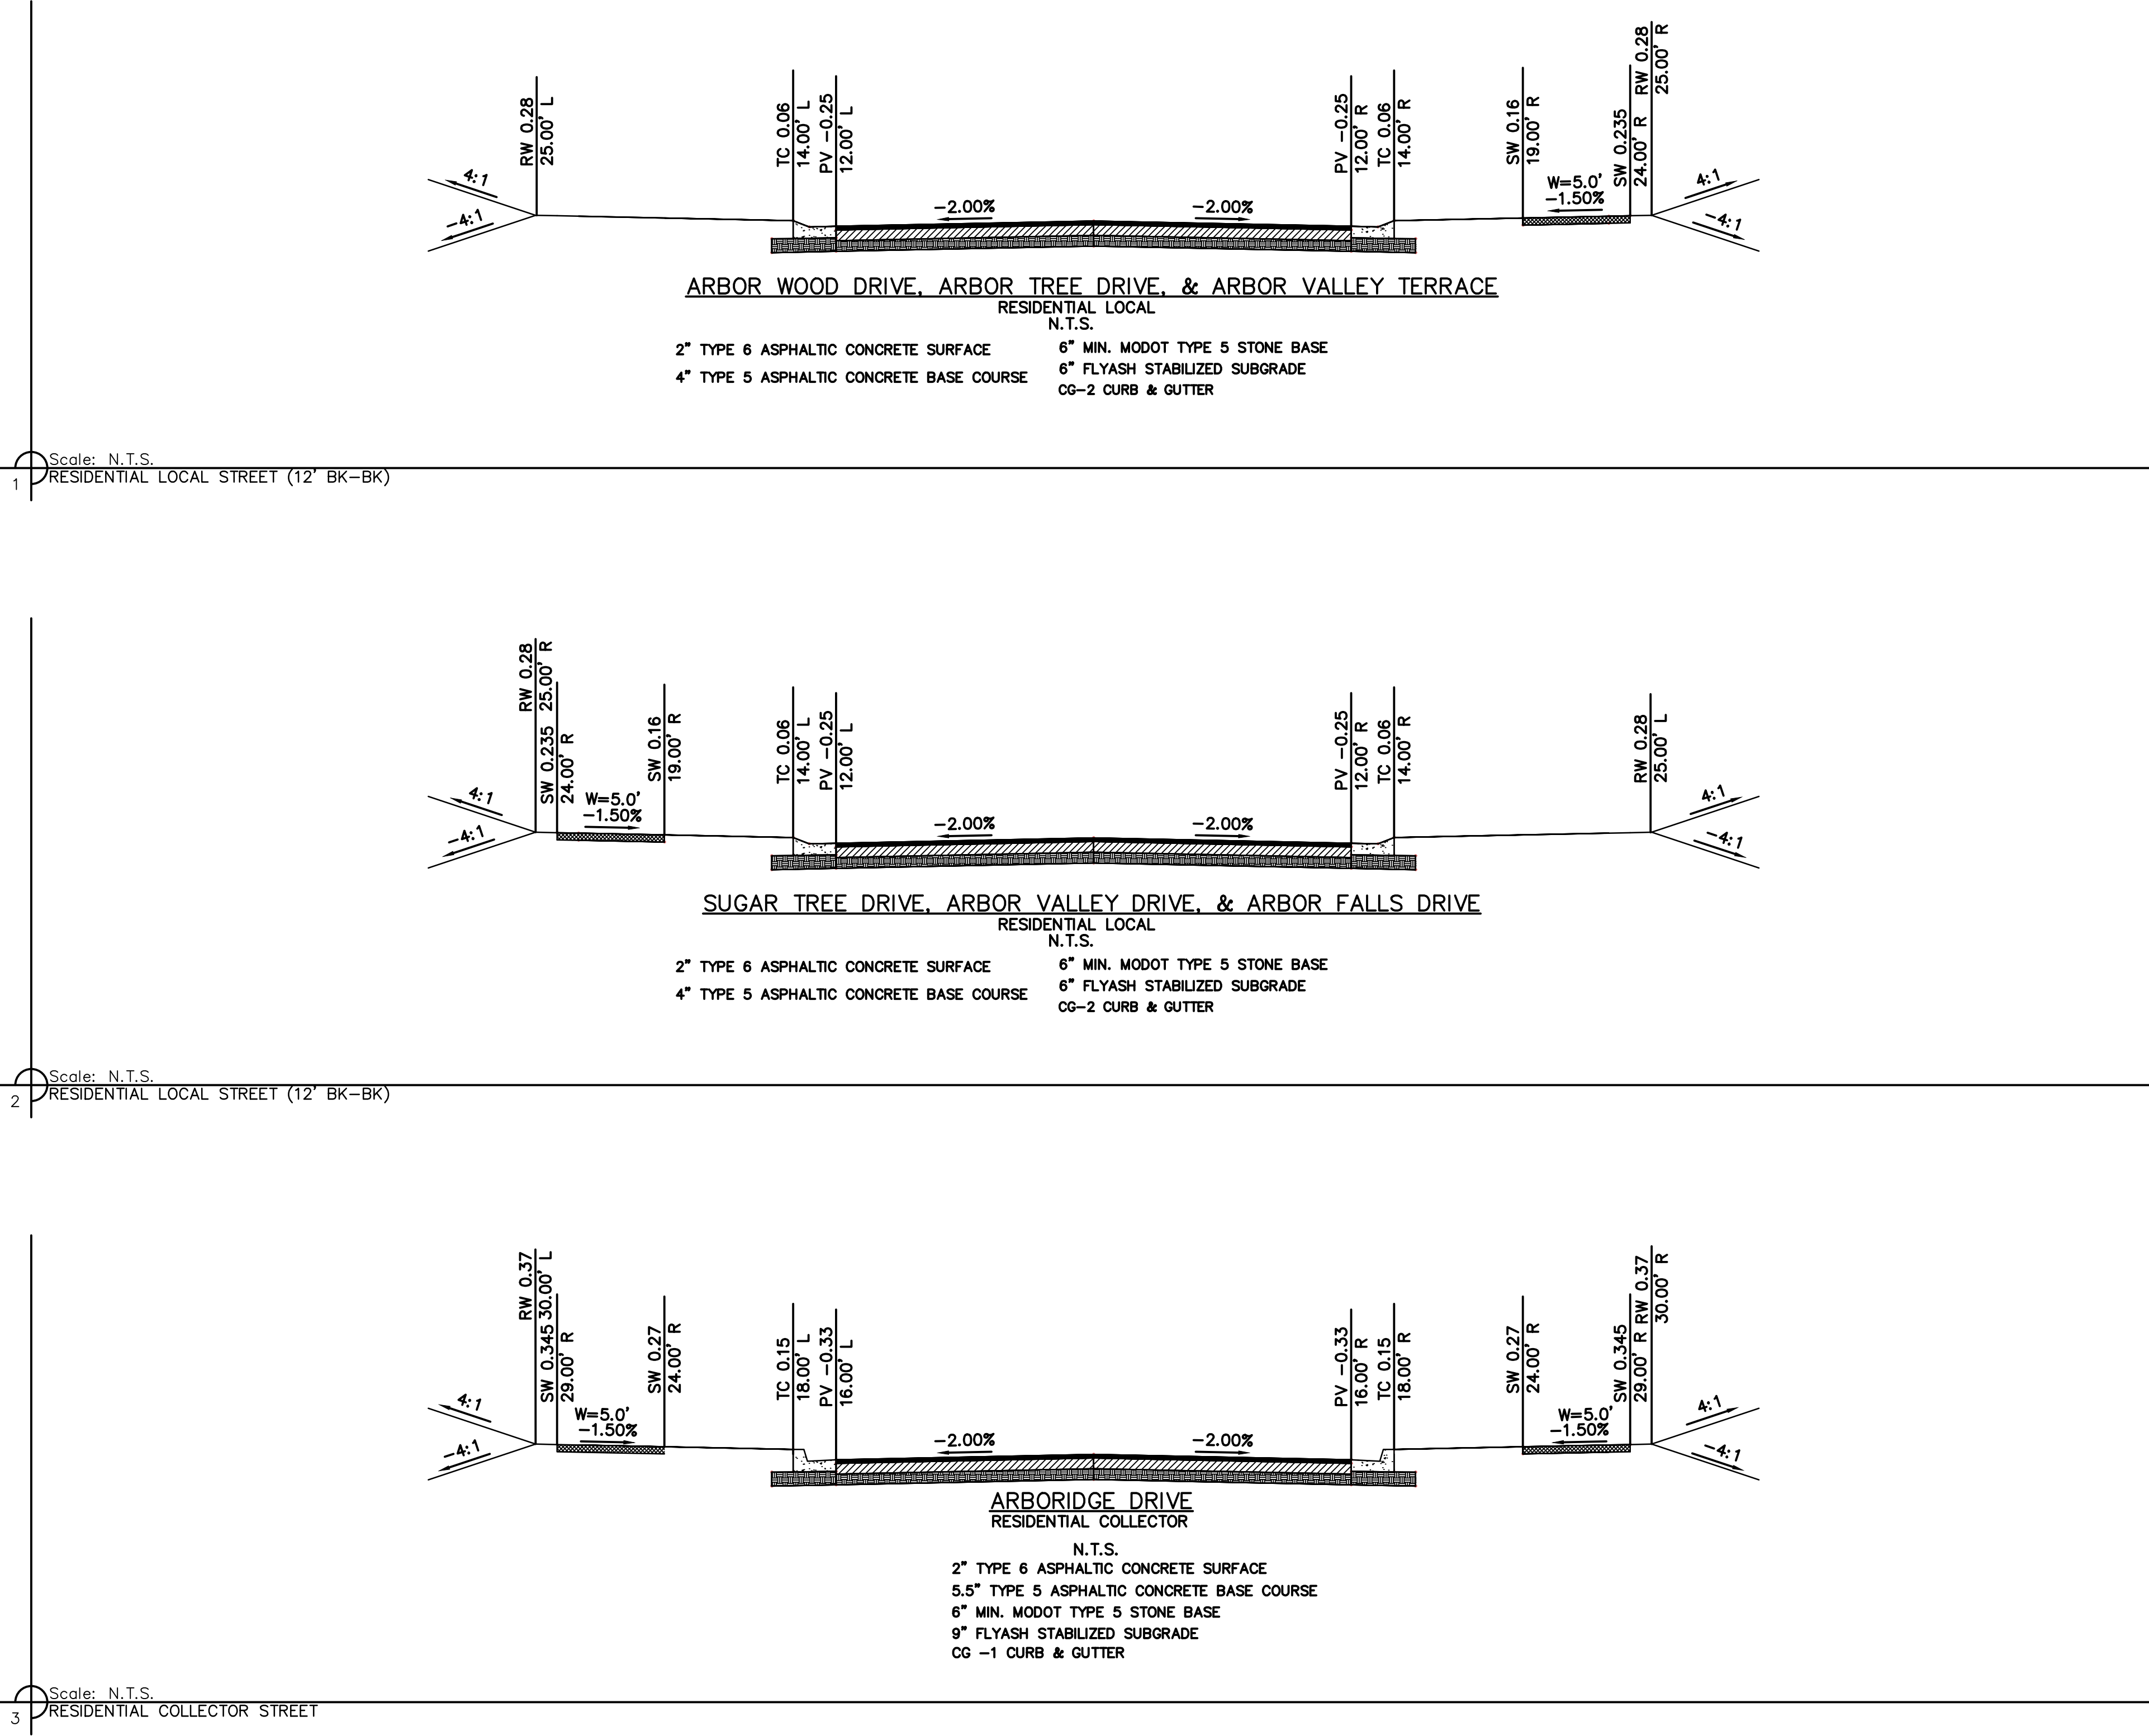

Record Drawing

OLSSON[®]
ASSOCIATES

Olsson Associates - Civil Engineering
180 S. Main Street, Suite 200
North Kansas City, MO 64116
TEL 816.897.4320
FAX 816.897.1393
www.olssonassociates.com

STATE OF MISSOURI
MELISSA G. DEGENIA
NUMBER
FE-2011000892
08/04/2019
PROFESSIONAL ENGINEER

NO.	REV.	DATE	REVISIONS DESCRIPTION	BY
1		04.19.2017	Revised section	MGD
4		01.08.2018	Removed Hook Road section	MGD
5		02.14.2018	Revised asphalt type	

REVISIONS


TYPICAL SECTIONS

HAWTHORN RIDGE
1ST PLAT


LEE'S SUMMIT, MO

drawn by: D.A.H.O.
checked by: M.G.D.
designed by: E.M.L.B.
QA/QC by: K.S.J.
project no.: 017-0188
date: 03.03.2017

SHEET
C104

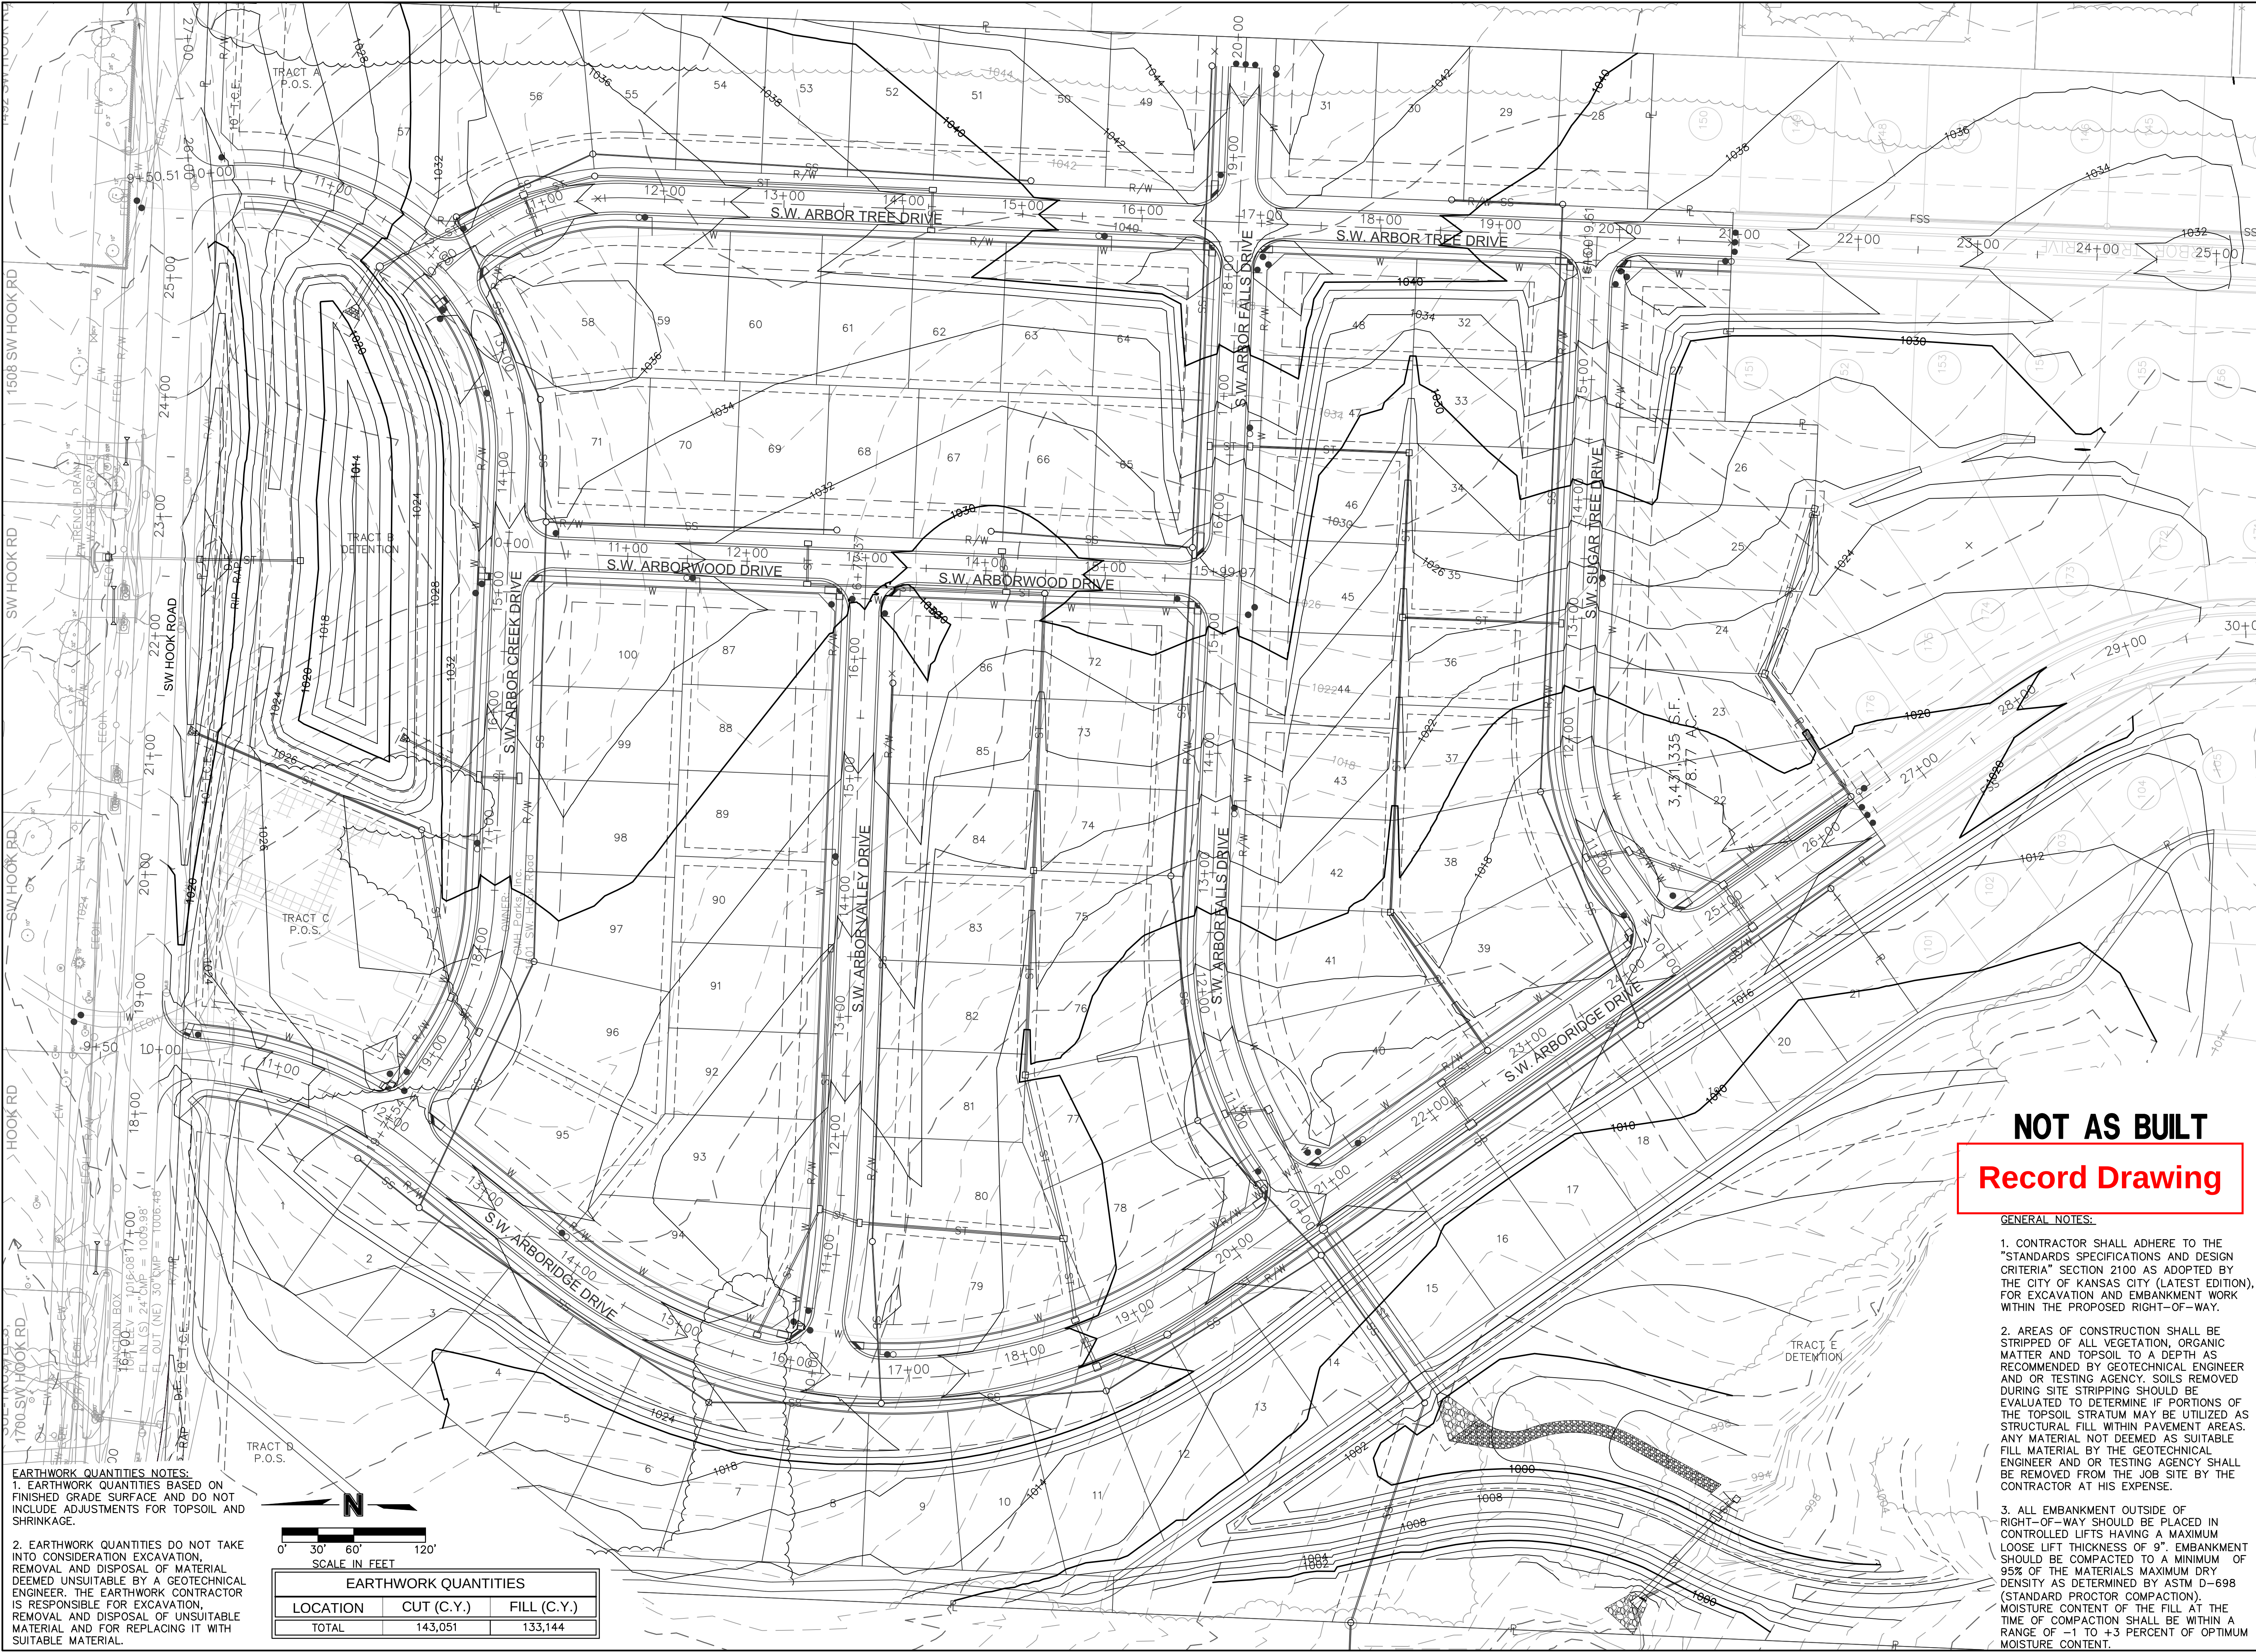

EARTHWORK QUANTITIES NOTES:
1. EARTHWORK QUANTITIES BASED ON FINISHED GRADE SURFACE AND DO NOT INCLUDE ADJUSTMENTS FOR TOPSOIL AND SHRINKAGE.
2. EARTHWORK QUANTITIES DO NOT TAKE INTO CONSIDERATION EXCAVATION, REMOVAL AND DISPOSAL OF MATERIAL DEEMED UNSUITABLE BY A GEOTECHNICAL ENGINEER. THE EARTHWORK CONTRACTOR IS RESPONSIBLE FOR EXCAVATION, REMOVAL AND DISPOSAL OF UNSUITABLE MATERIAL AND FOR REPLACING IT WITH SUITABLE MATERIAL.

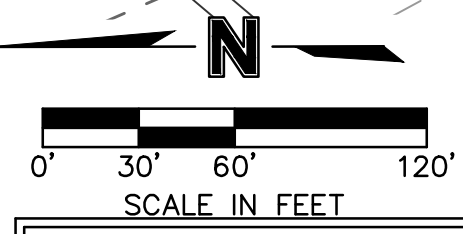

EARTHWORK QUANTITIES		
LOCATION	CUT (C.Y.)	FILL (C.Y.)
TOTAL	143,051	133,144

NOT AS BUILT Record Drawing

GENERAL NOTES:

- CONTRACTOR SHALL ADHERE TO THE "STANDARDS SPECIFICATIONS AND DESIGN CRITERIA" SECTION 2100 AS ADOPTED BY THE CITY OF KANSAS CITY (LATEST EDITION), FOR EXCAVATION AND EMBANKMENT WORK WITHIN THE PROPOSED RIGHT-OF-WAY.
- AREAS OF CONSTRUCTION SHALL BE STRIPPED OF ALL VEGETATION, ORGANIC MATTER AND TOPSOIL TO A DEPTH AS RECOMMENDED BY GEOTECHNICAL ENGINEER AND OR TESTING AGENCY. SOILS REMOVED DURING SITE STRIPPING SHOULD BE EVALUATED TO DETERMINE IF PORTIONS OF THE TOPSOIL STRATUM MAY BE UTILIZED AS STRUCTURAL FILL WITHIN PAVEMENT AREAS. ANY MATERIAL NOT DEEMED AS SUITABLE FILL MATERIAL BY THE GEOTECHNICAL ENGINEER AND OR TESTING AGENCY SHALL BE REMOVED FROM THE JOB SITE BY THE CONTRACTOR AT HIS EXPENSE.
- ALL EMBANKMENT OUTSIDE OF RIGHT-OF-WAY SHOULD BE PLACED IN CONTROLLED LIFTS HAVING A MAXIMUM LOOSE LIFT THICKNESS OF 9". EMBANKMENT SHOULD BE COMPACTED TO A MINIMUM OF 95% OF THE MATERIALS MAXIMUM DRY DENSITY AS DETERMINED BY ASTM D-698 (STANDARD PROCTOR COMPACTION). MOISTURE CONTENT OF THE FILL AT THE TIME OF COMPACTION SHALL BE WITHIN A RANGE OF -1 TO +3 PERCENT OF OPTIMUM MOISTURE CONTENT.

OLSSON[®]

ASSOCIATES

Olsson Associates - Civil Engineering
1800 North Main Street, Suite 100
North Kansas City, MO 64116
TEL 816.997.4320
FAX 816.997.1393
www.olssonassociates.com

STATE OF MISSOURI
MELISSA G. DEGENIA
NUMBER
PE-20111000892
03/04/2019
PROFESSIONAL ENGINEER

BY: MGD

NO. REV. DATE DESCRIPTION

4 01.02.2018 Removed Hook Road Improvements

5 03.02.2018 Grading Quantities revised



REVISIONS

2018

drawn by: D.A.H.O.
checked by: M.G.D.
designed by: E.M.L.
QA/QC by: K.S.J.
project no.: 017-0188
date: 03.03.2017

GRADING PLAN
HAWTHORN RIDGE
1ST PLAT
LEE'S SUMMIT, MO
SHEET
C105

- CONCRETE SIDEWALK
- ADA ACCESS ROUTE
- ASPHALT PAVEMENT
- CG-2 CURB & GUTTER
(See Detail Sheet)
- CG-1 CURB & GUTTER
(See Detail Sheet)

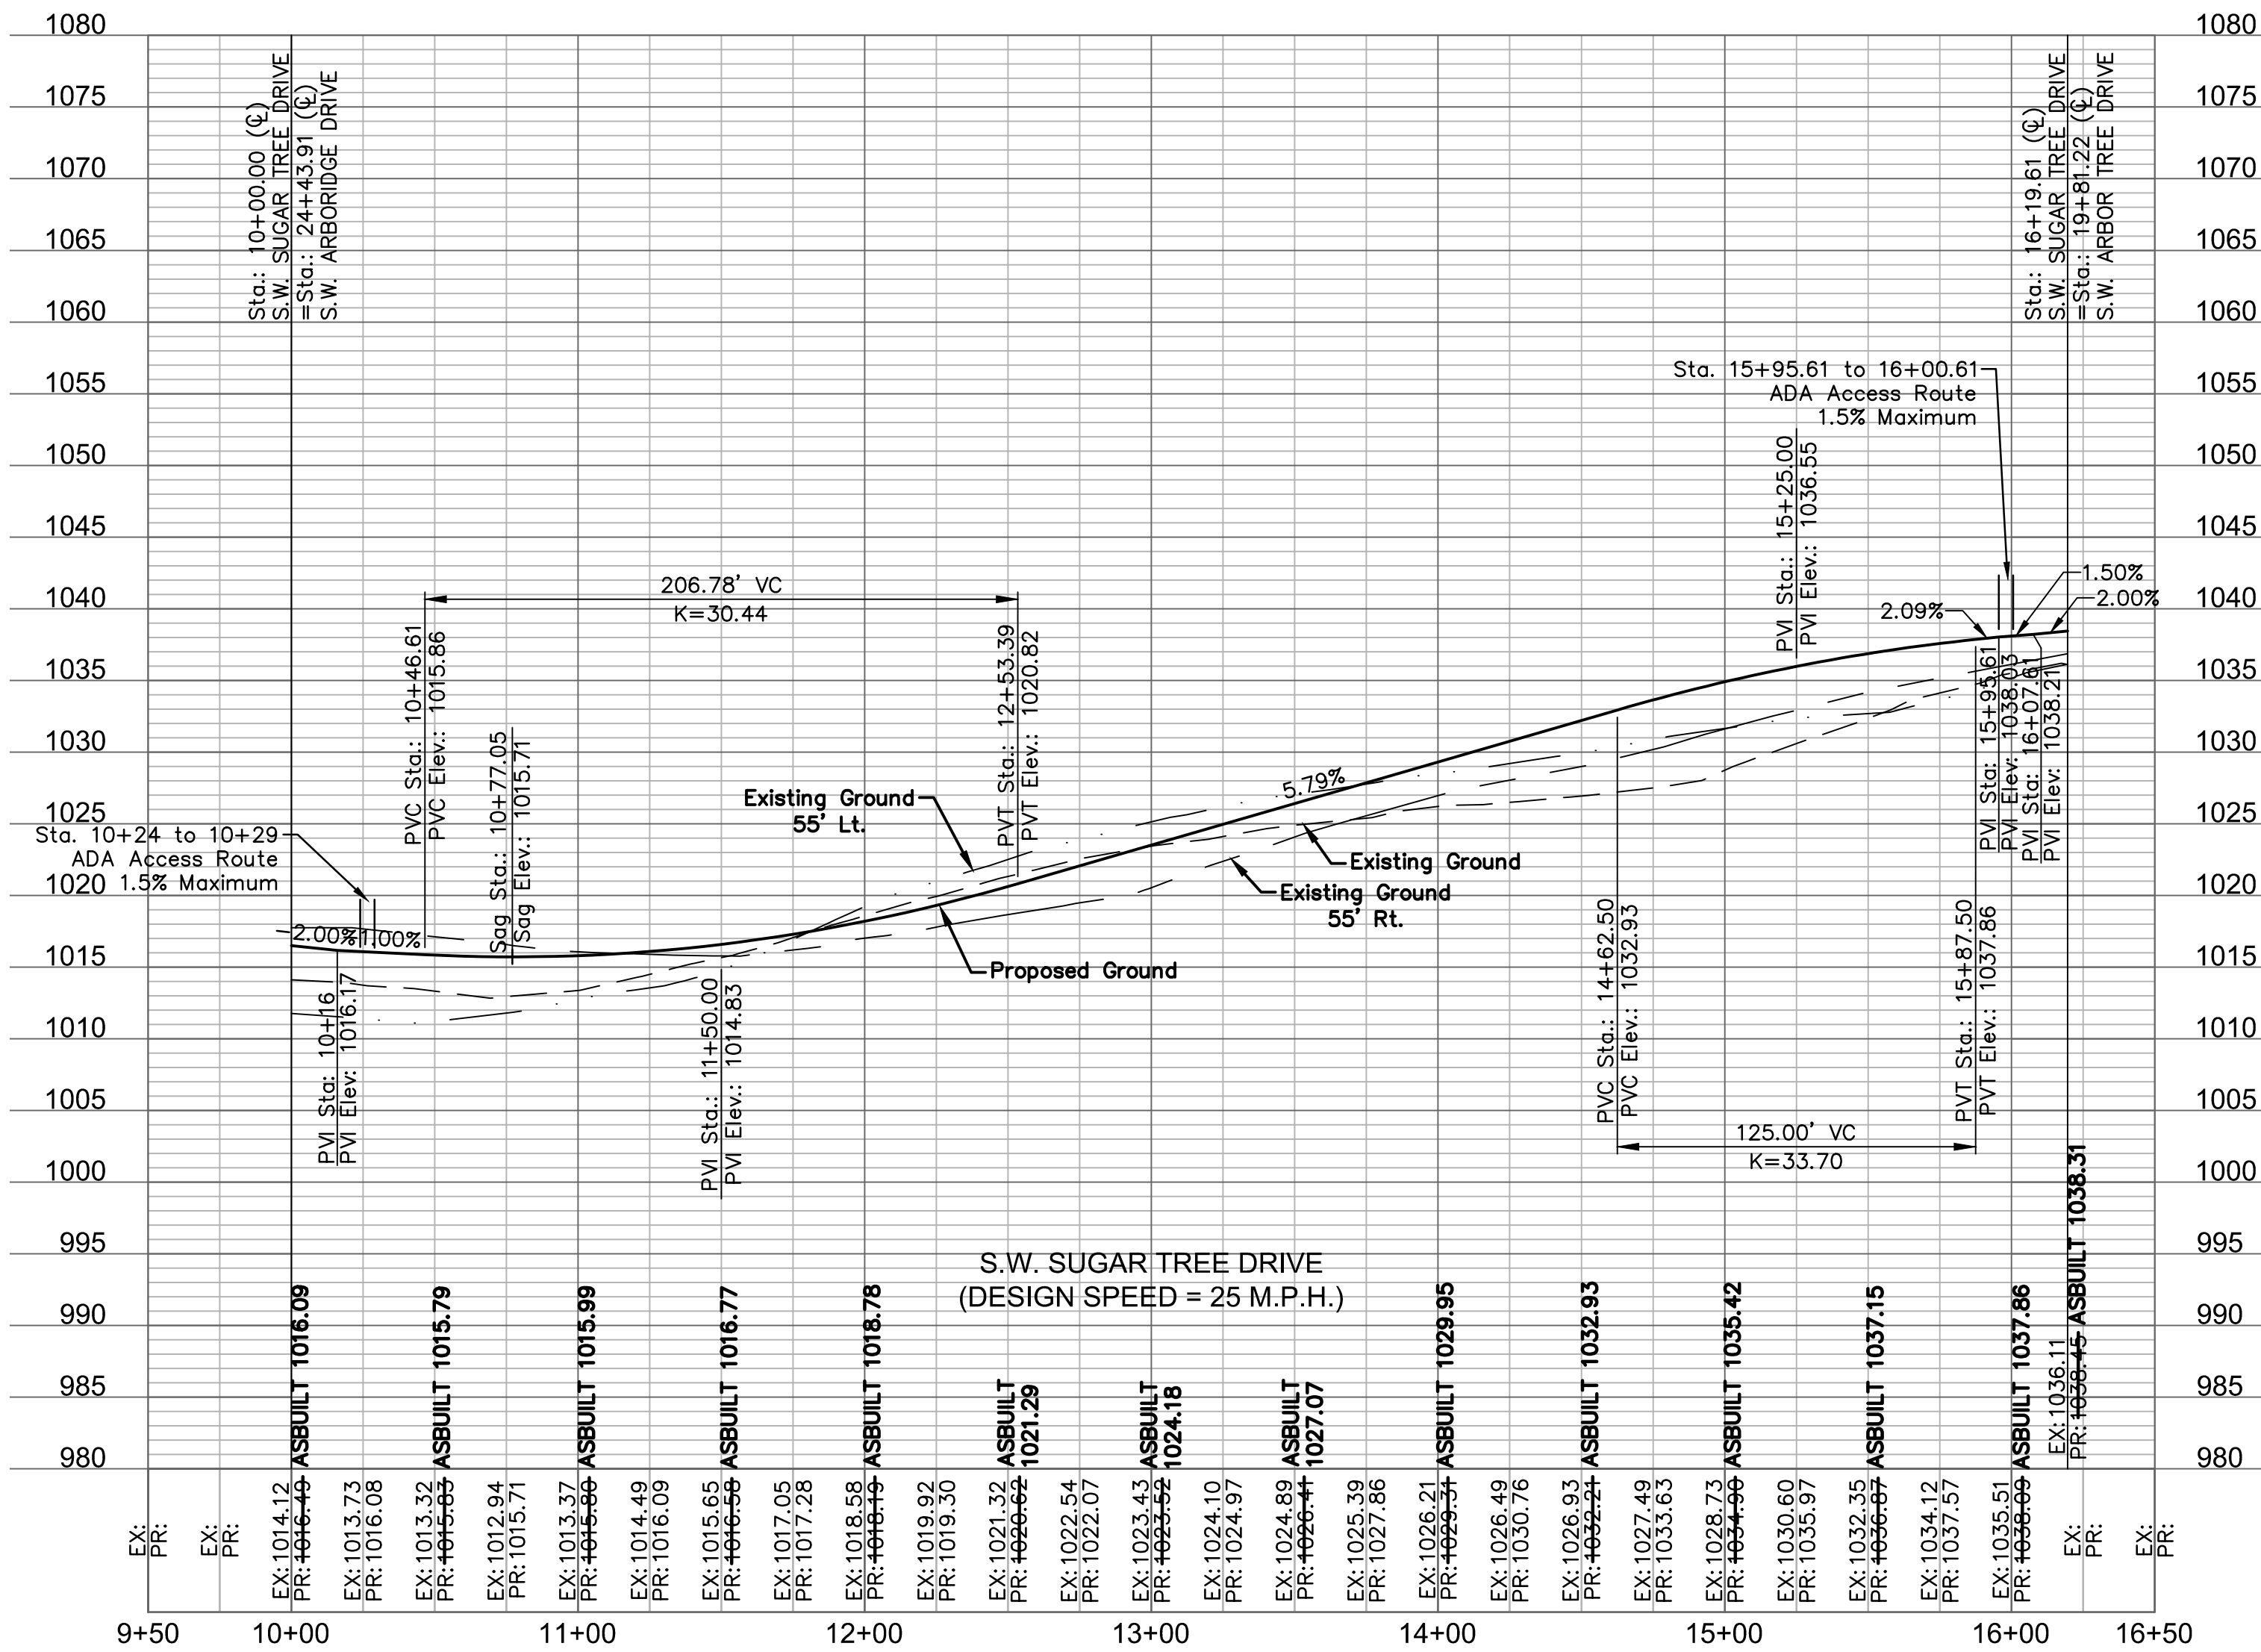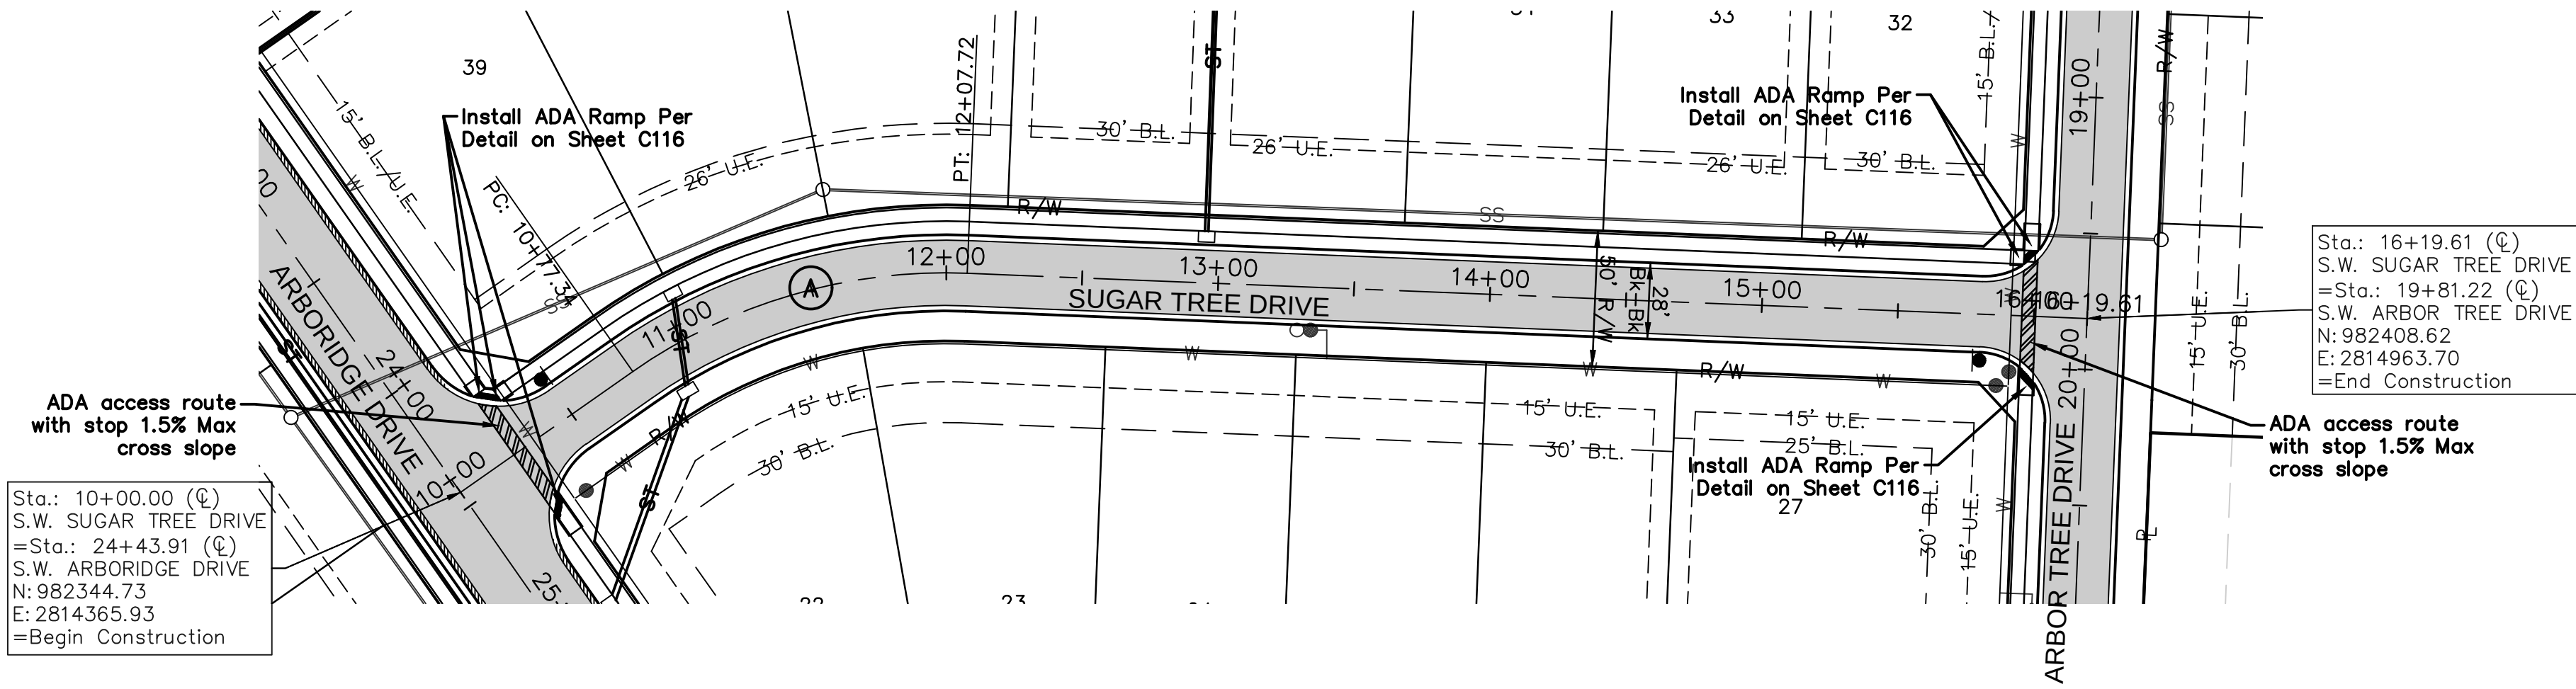

Record Drawing

AS BUILT
DATE: 12/19/2018



CURVE	RADIUS	LENGTH	TANGENT	DELTA	P.I. STA. (BK.)
A	200	130.37	67.60	37°20'57"	11+40.12

drawn by: DAH.D
checked by: M.G.D.
designed by: P.M.L.
QA/QC by: K.S.P.
project no.: 017-0188
date: 03.03.2017

SHEET
C106

ROADWAY PLAN & PROFILE

HAWTHORN RIDGE
1ST PLAT

LEE'S SUMMIT, MO

NO. REV. 5

DATE 02.14.2018

REVISIONS DESCRIPTION Revised ADA access routes


BY MGD

REVISIONS


2018

STATE OF MISSOURI
MELISSA G. DEGONIA
NUMBER
PE-2011000892
03/04/2019
PROFESSIONAL ENGINEER

Olsson Associates - Civil Engineering
1800 S. Main Street
North Kansas City, MO 64116
TEL 816.897.4320
FAX 816.897.1393
www.olssonassociates.com

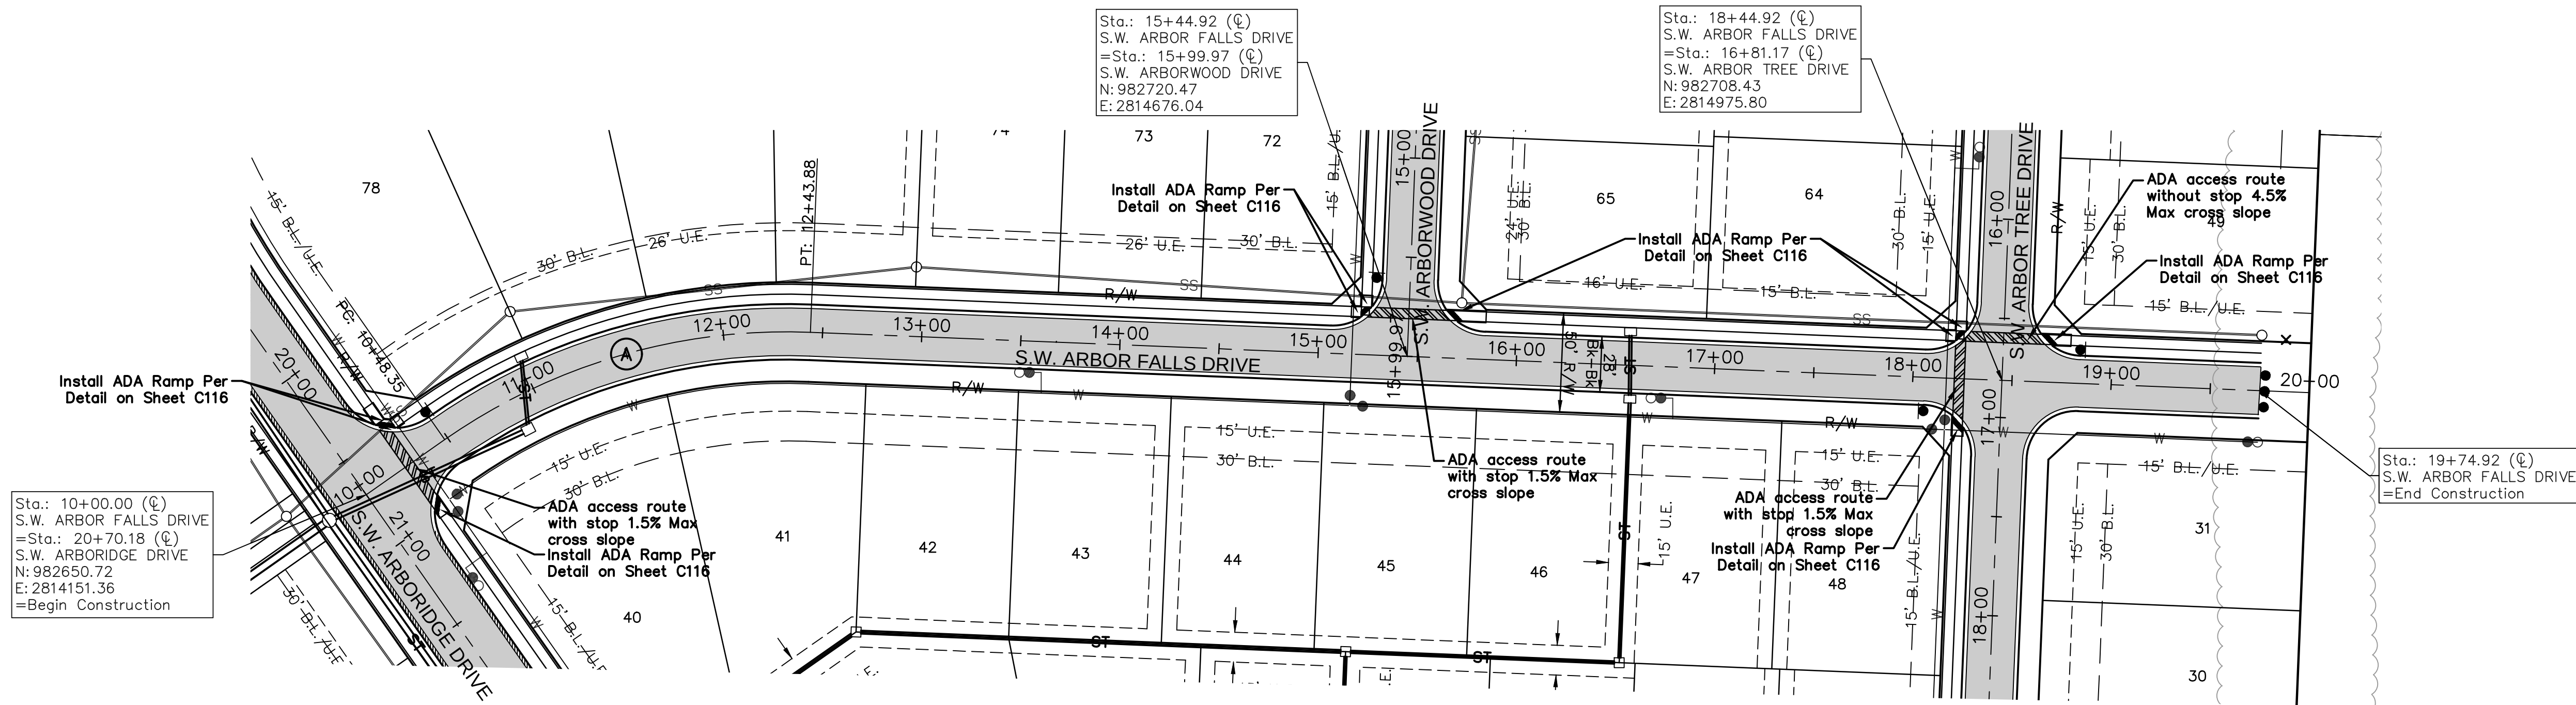

AS BUILT
DATE: 12/19/2018

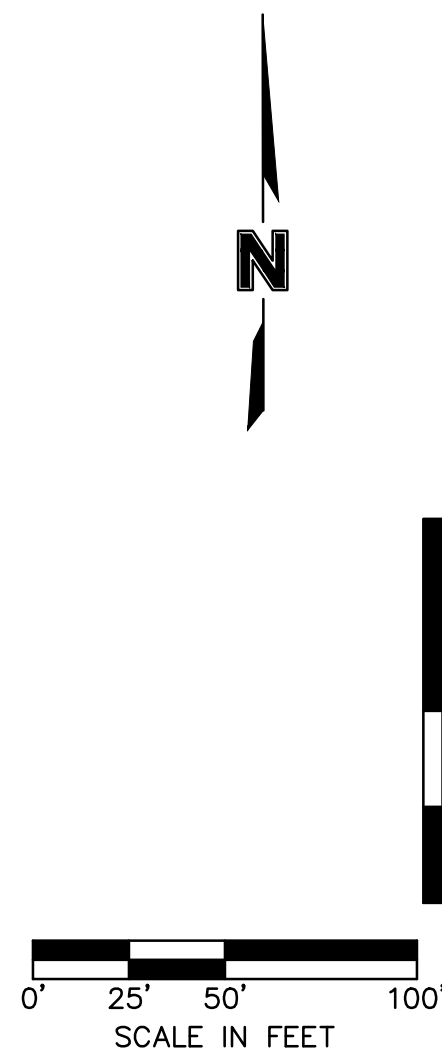



OLSSON[®]
ASSOCIATES
 Olsson Associates - Civil Engineering
 MO Certificate of Authority #1001582
 1301 Burlington, Suite 100
 TEL: 816.587.4320

ROADWAY PLAN & PROFILE HAWTHORN RIDGE 1ST PLAT	2018
	I F E E'S SUMMIT MO

drawn by: _____ D.A.H.O.
 checked by: _____ M.G.D.
 designed by: _____ P.M.D.
 QA/QC by: _____ K.S.J.
 project no.: _____ 017-0188
 date: _____ 03.03.2017

SHEET
 C109

- CONCRETE SIDEWALK
- ADA ACCESS ROUTE
- ASPHALT PAVEMENT
- CG-2 CURB & GUTTER
(See Detail Sheet)
- CG-1 CURB & GUTTER
(See Detail Sheet)

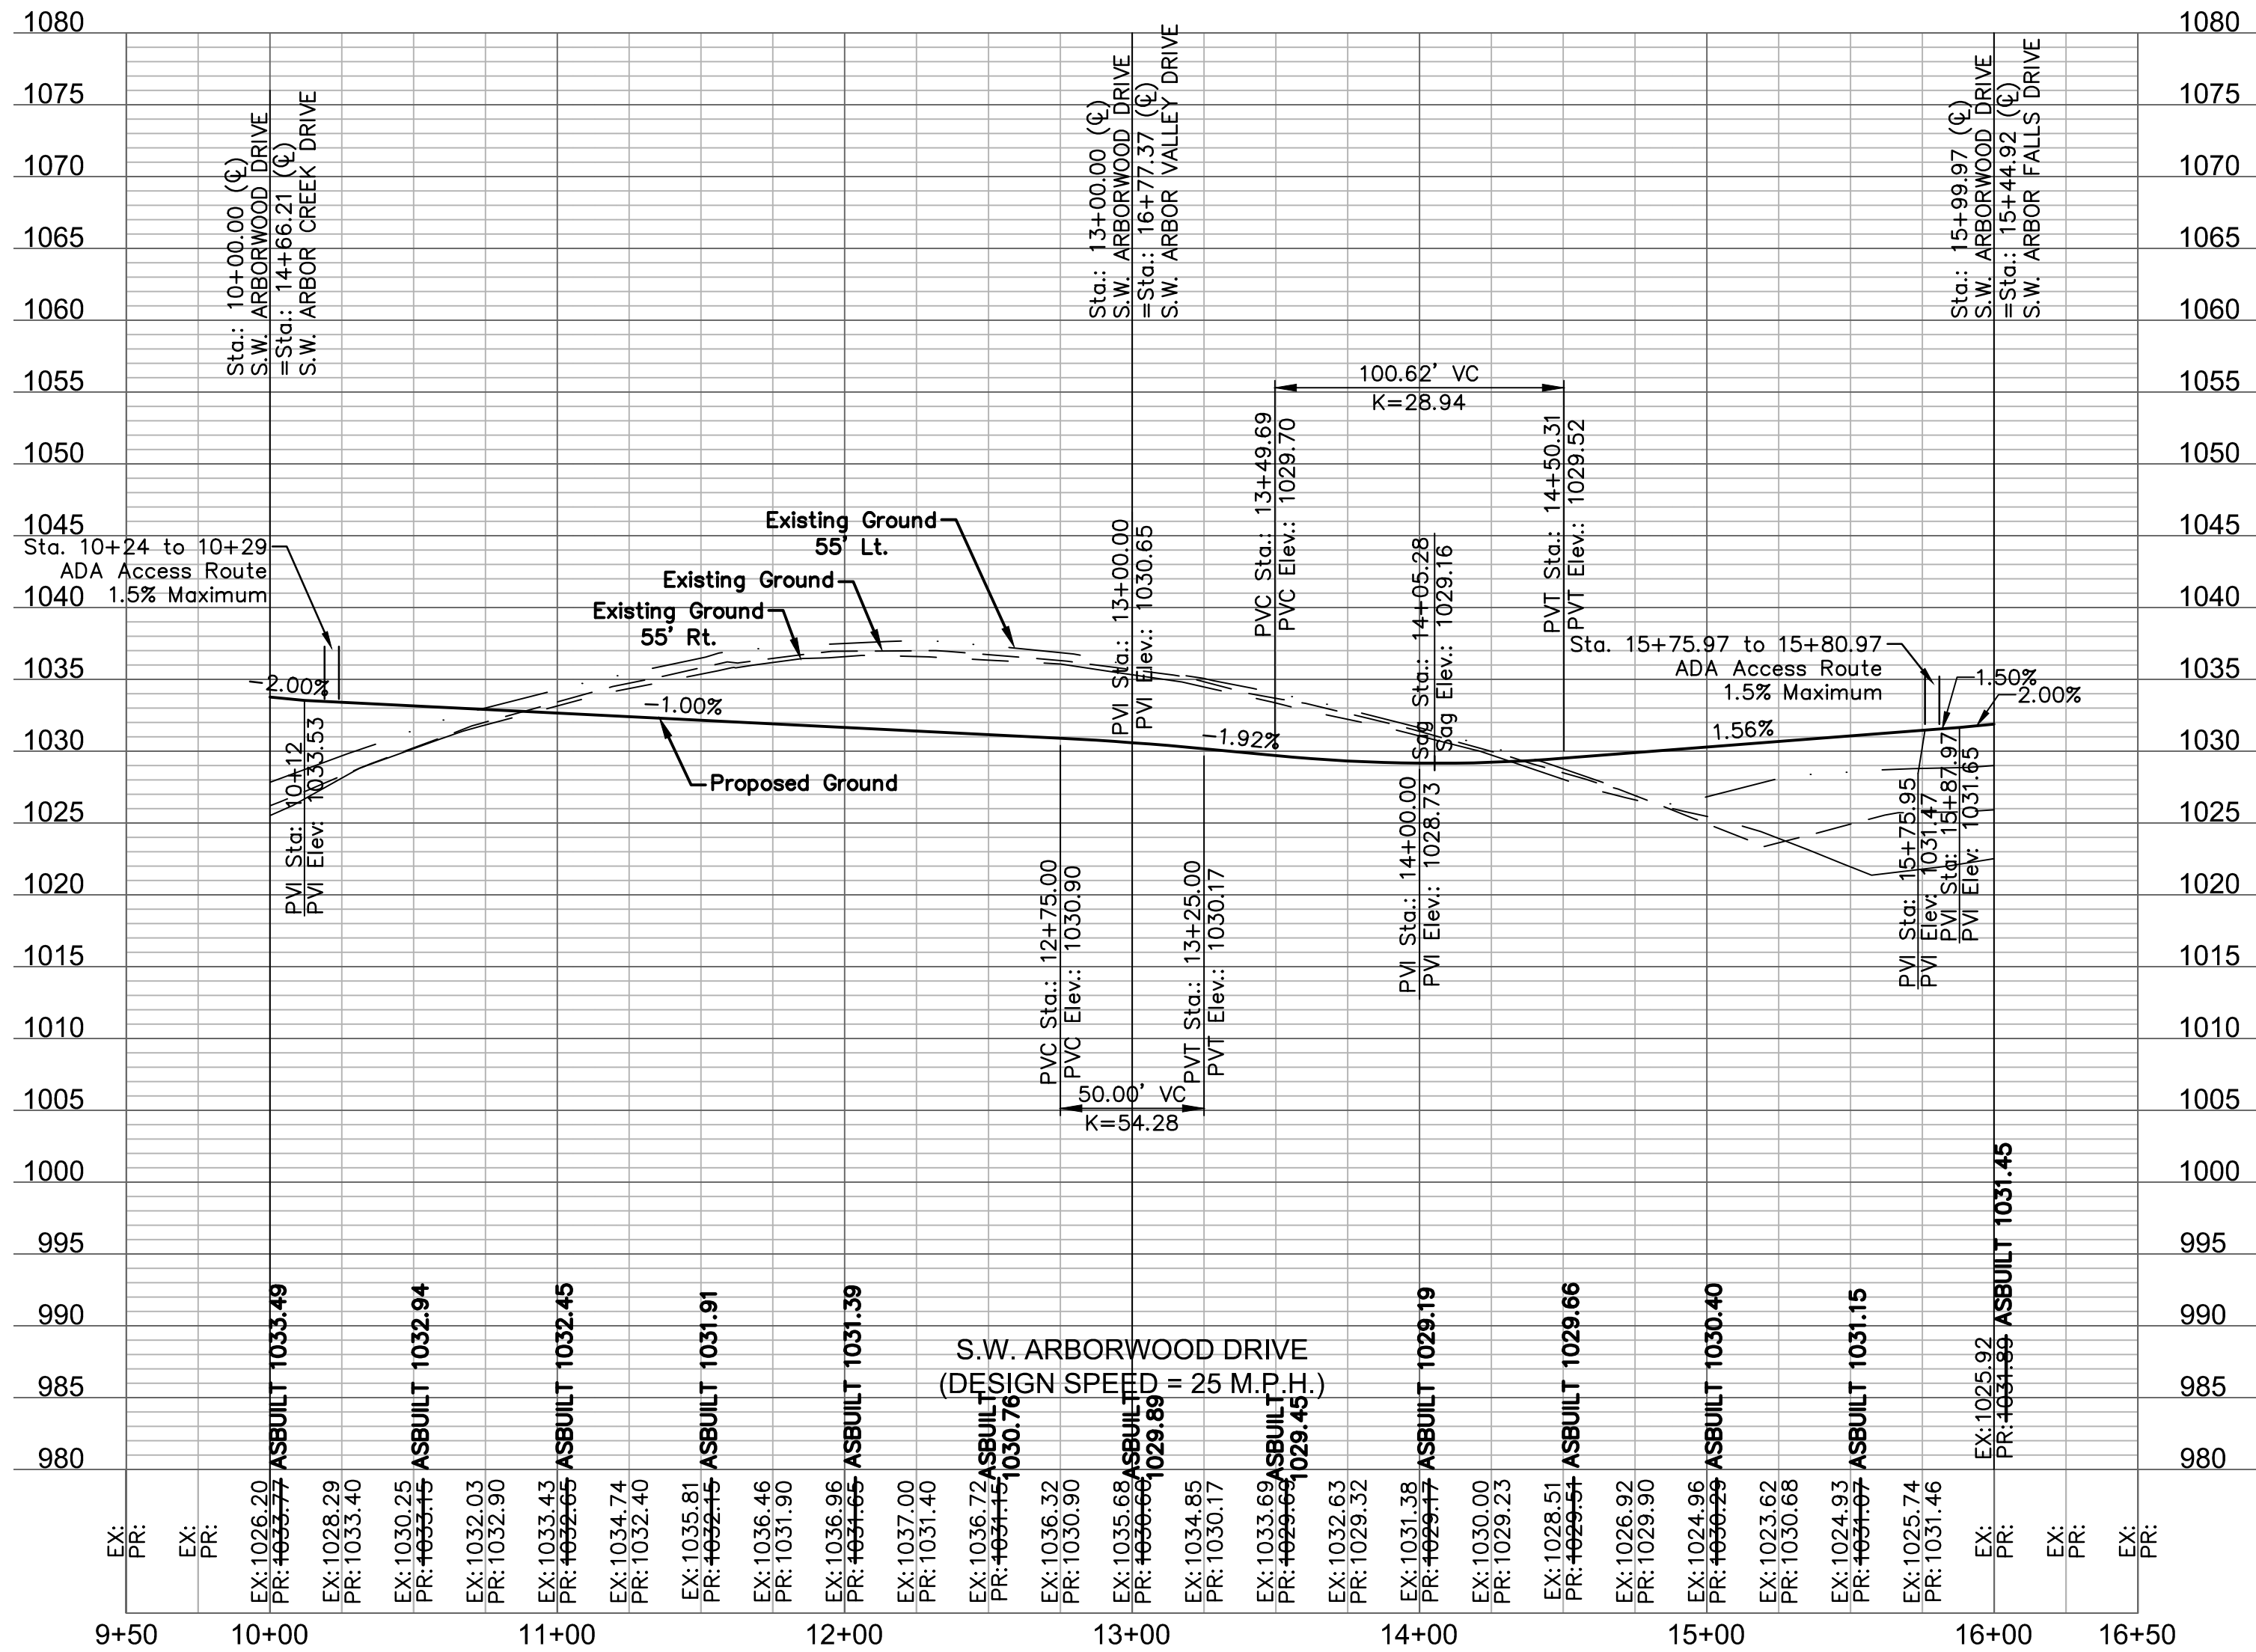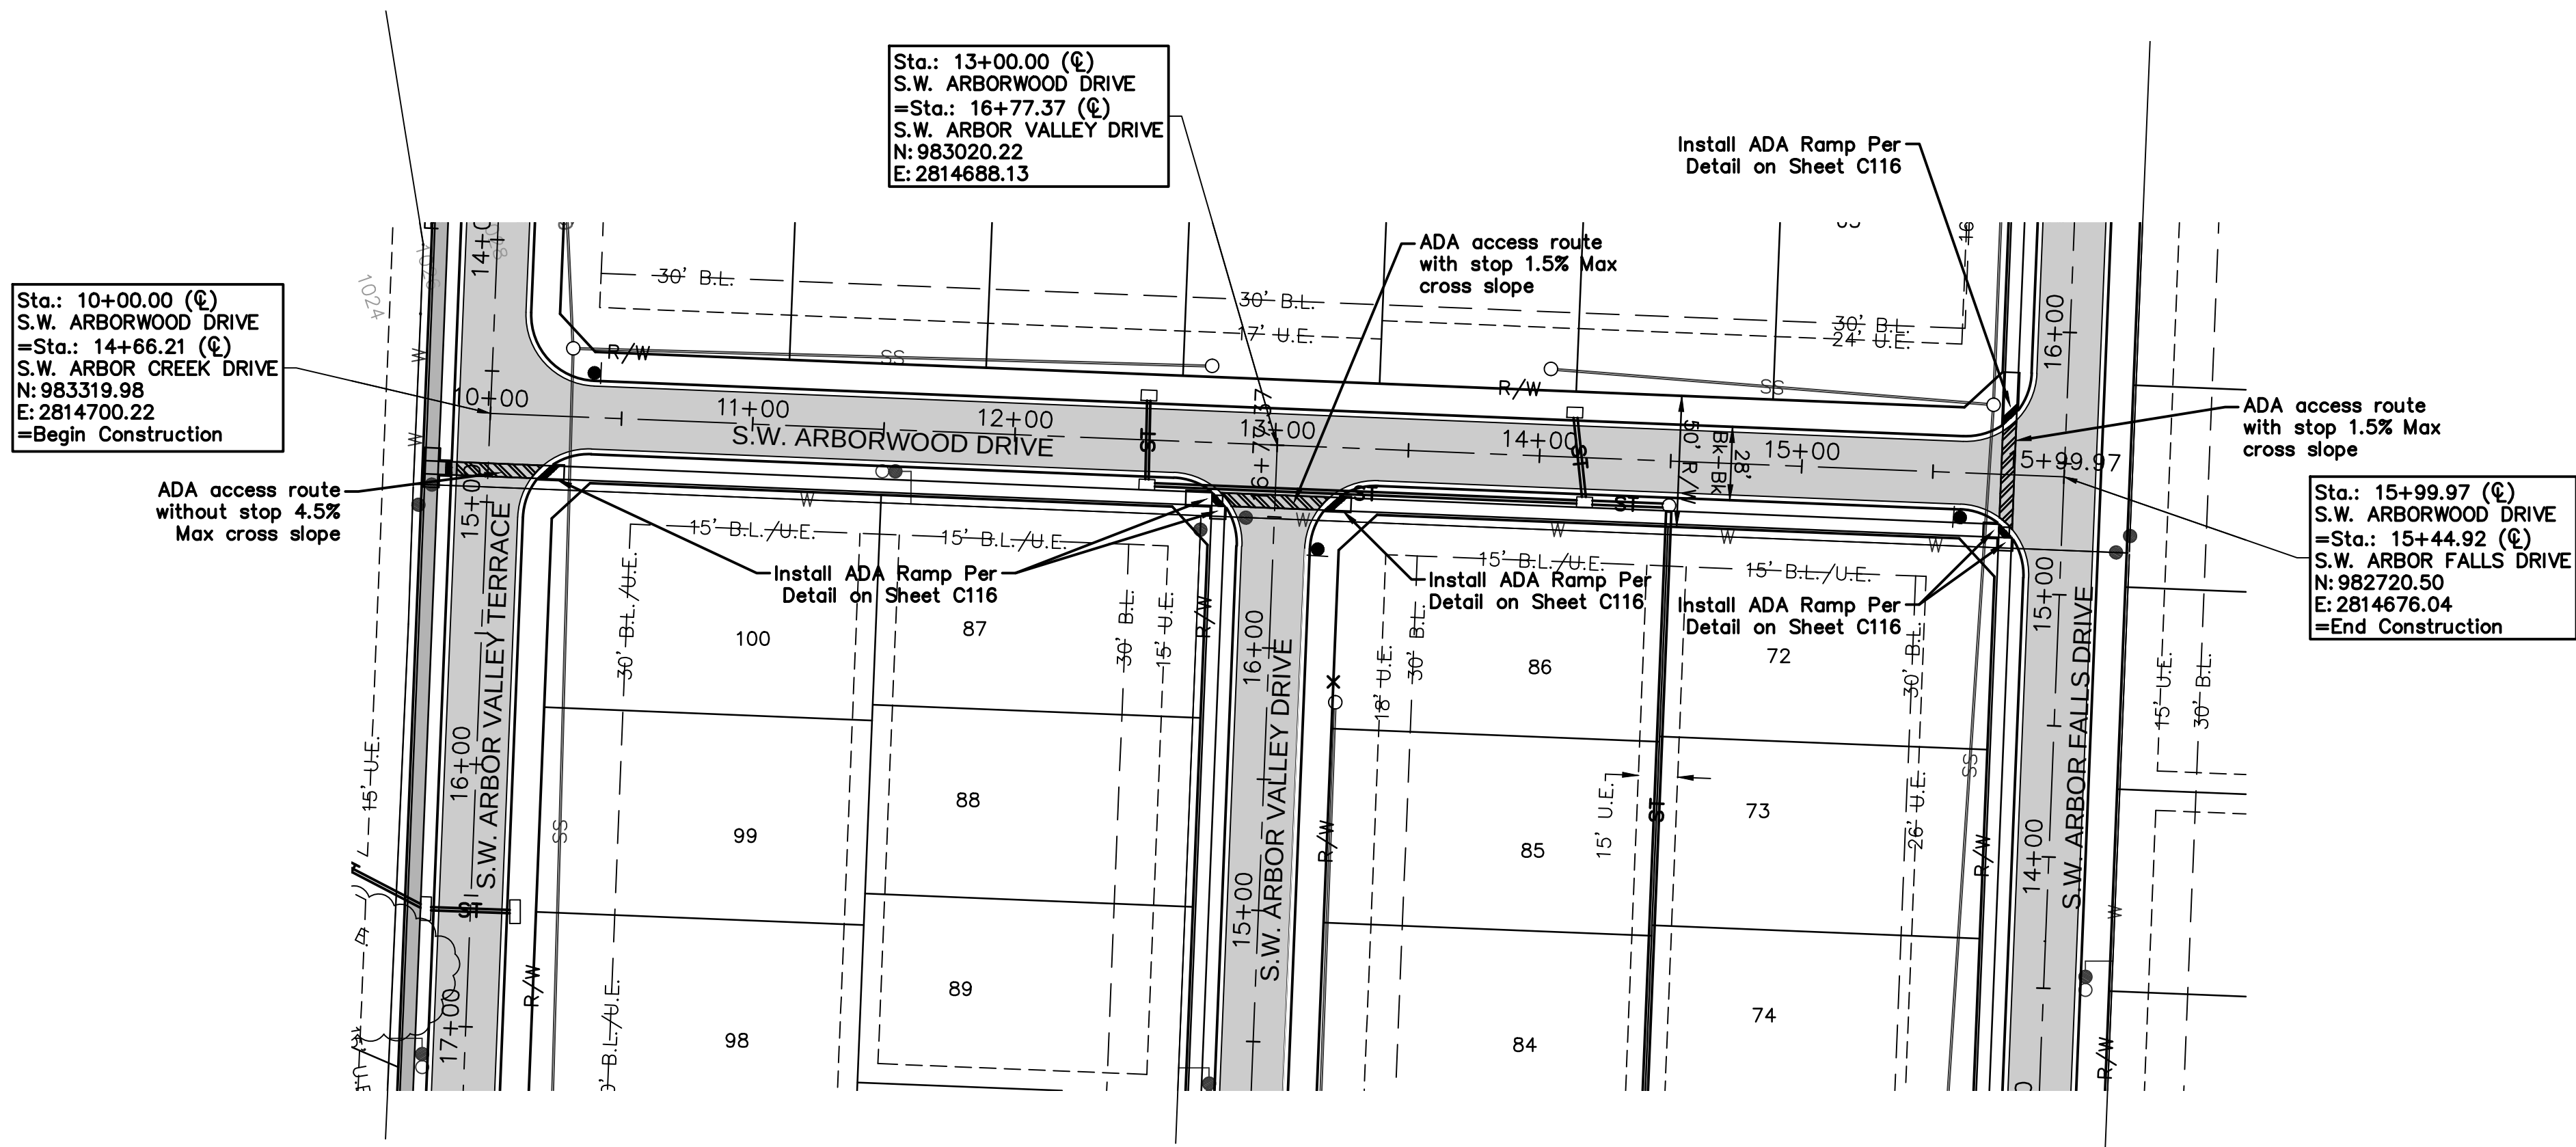

Record Drawing

AS BUILT

DATE: 12/19/2018



drawn by: D.A.H.D.
checked by: M.G.D.
designed by: P.M.L.B.
QA/QC by: K.S.J.
project no.: 017-0188
date: 03.03.2017

SHEET C110

ROADWAY PLAN & PROFILE

HAWTHORN RIDGE 1ST PLAT

LEE'S SUMMIT, MO

2018

REVISIONS

NO.	REV.	DATE	REVISIONS DESCRIPTION
5		02.12.2018	Revised ADA access routes

BY MGD

STATE OF MISSOURI

MELISSA G. DEGENIA


NUMBER

FE-2011000892


08/04/2019

PROFESSIONAL ENGINEER


Olsson Associates - Civil Engineering
180 E. 10th Street, Suite 200
North Kansas City, MO 64116
TEL 816.897.4320
FAX 816.897.1393
www.olssonassociates.com

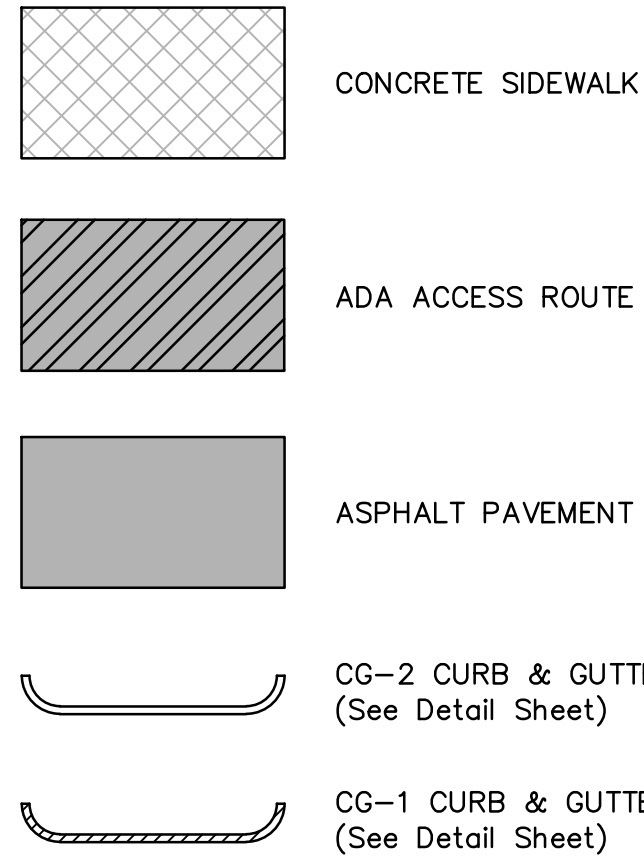


Sta.: 10+00.00 (C)
S.W. ARBOR TREE DRIVE
=Sta.: 12+17.51 (C)
S.W. ARBOR CREEK DRIVE
N: 983372.63
E: 2814935.17
=Begin Construction

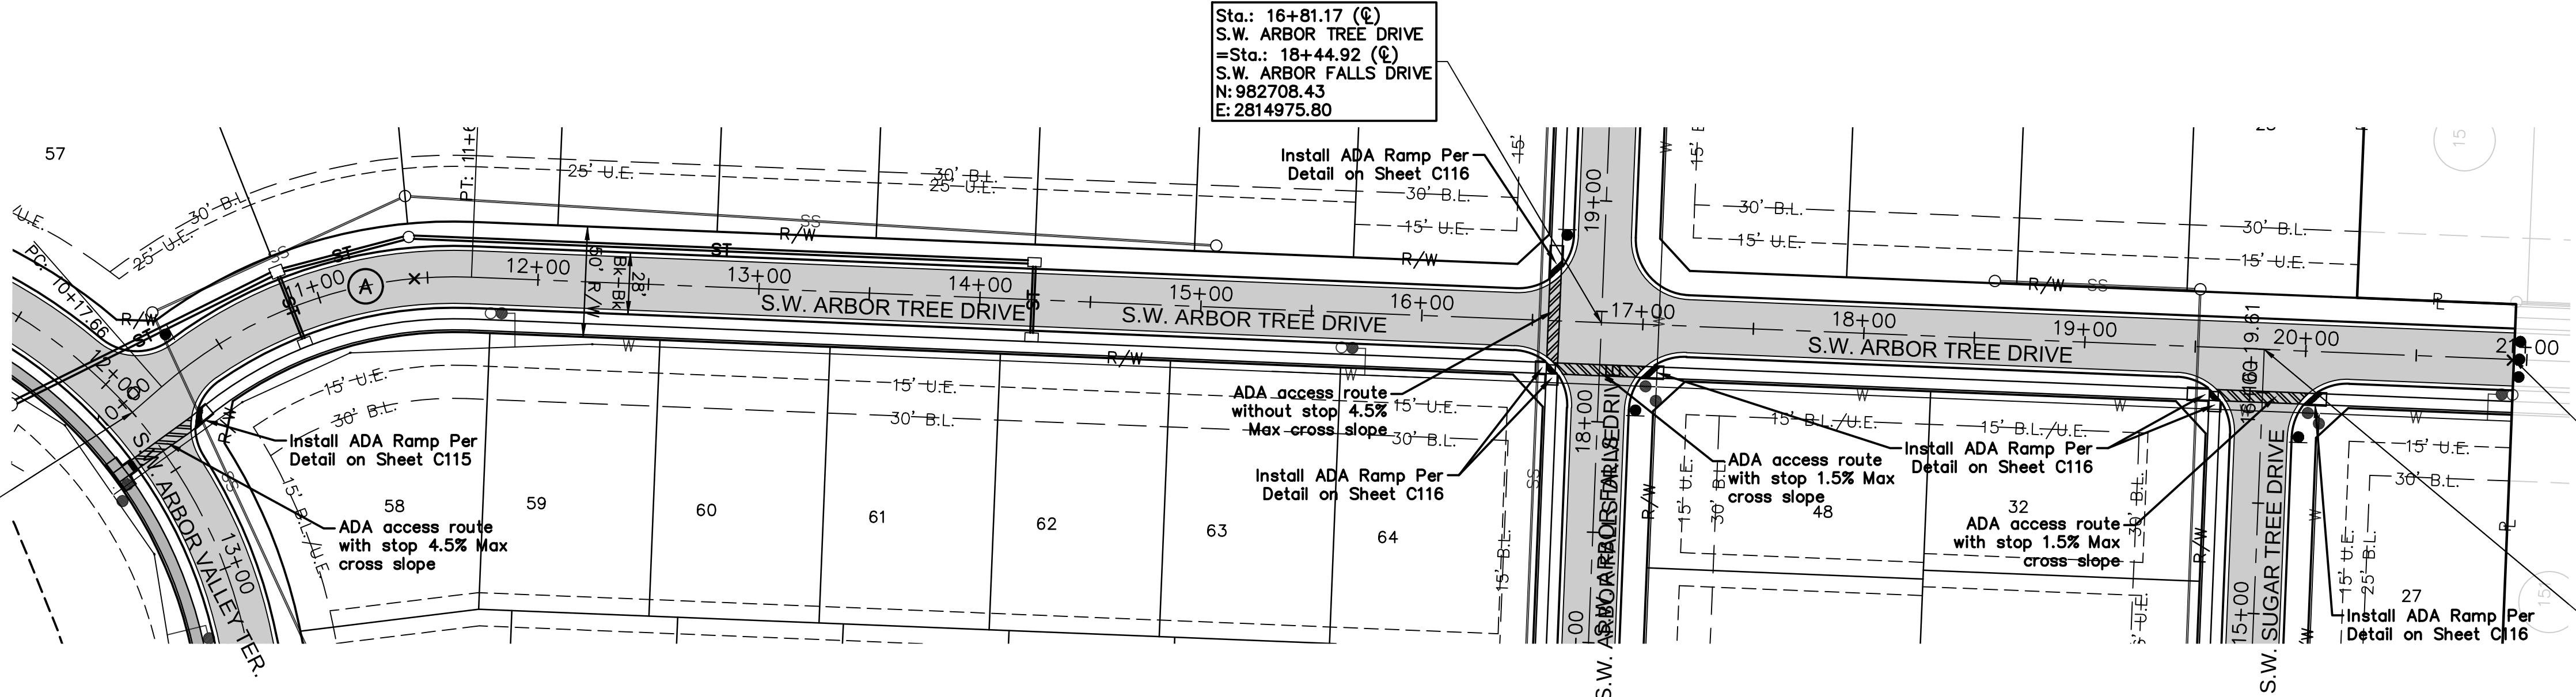

Record Drawing

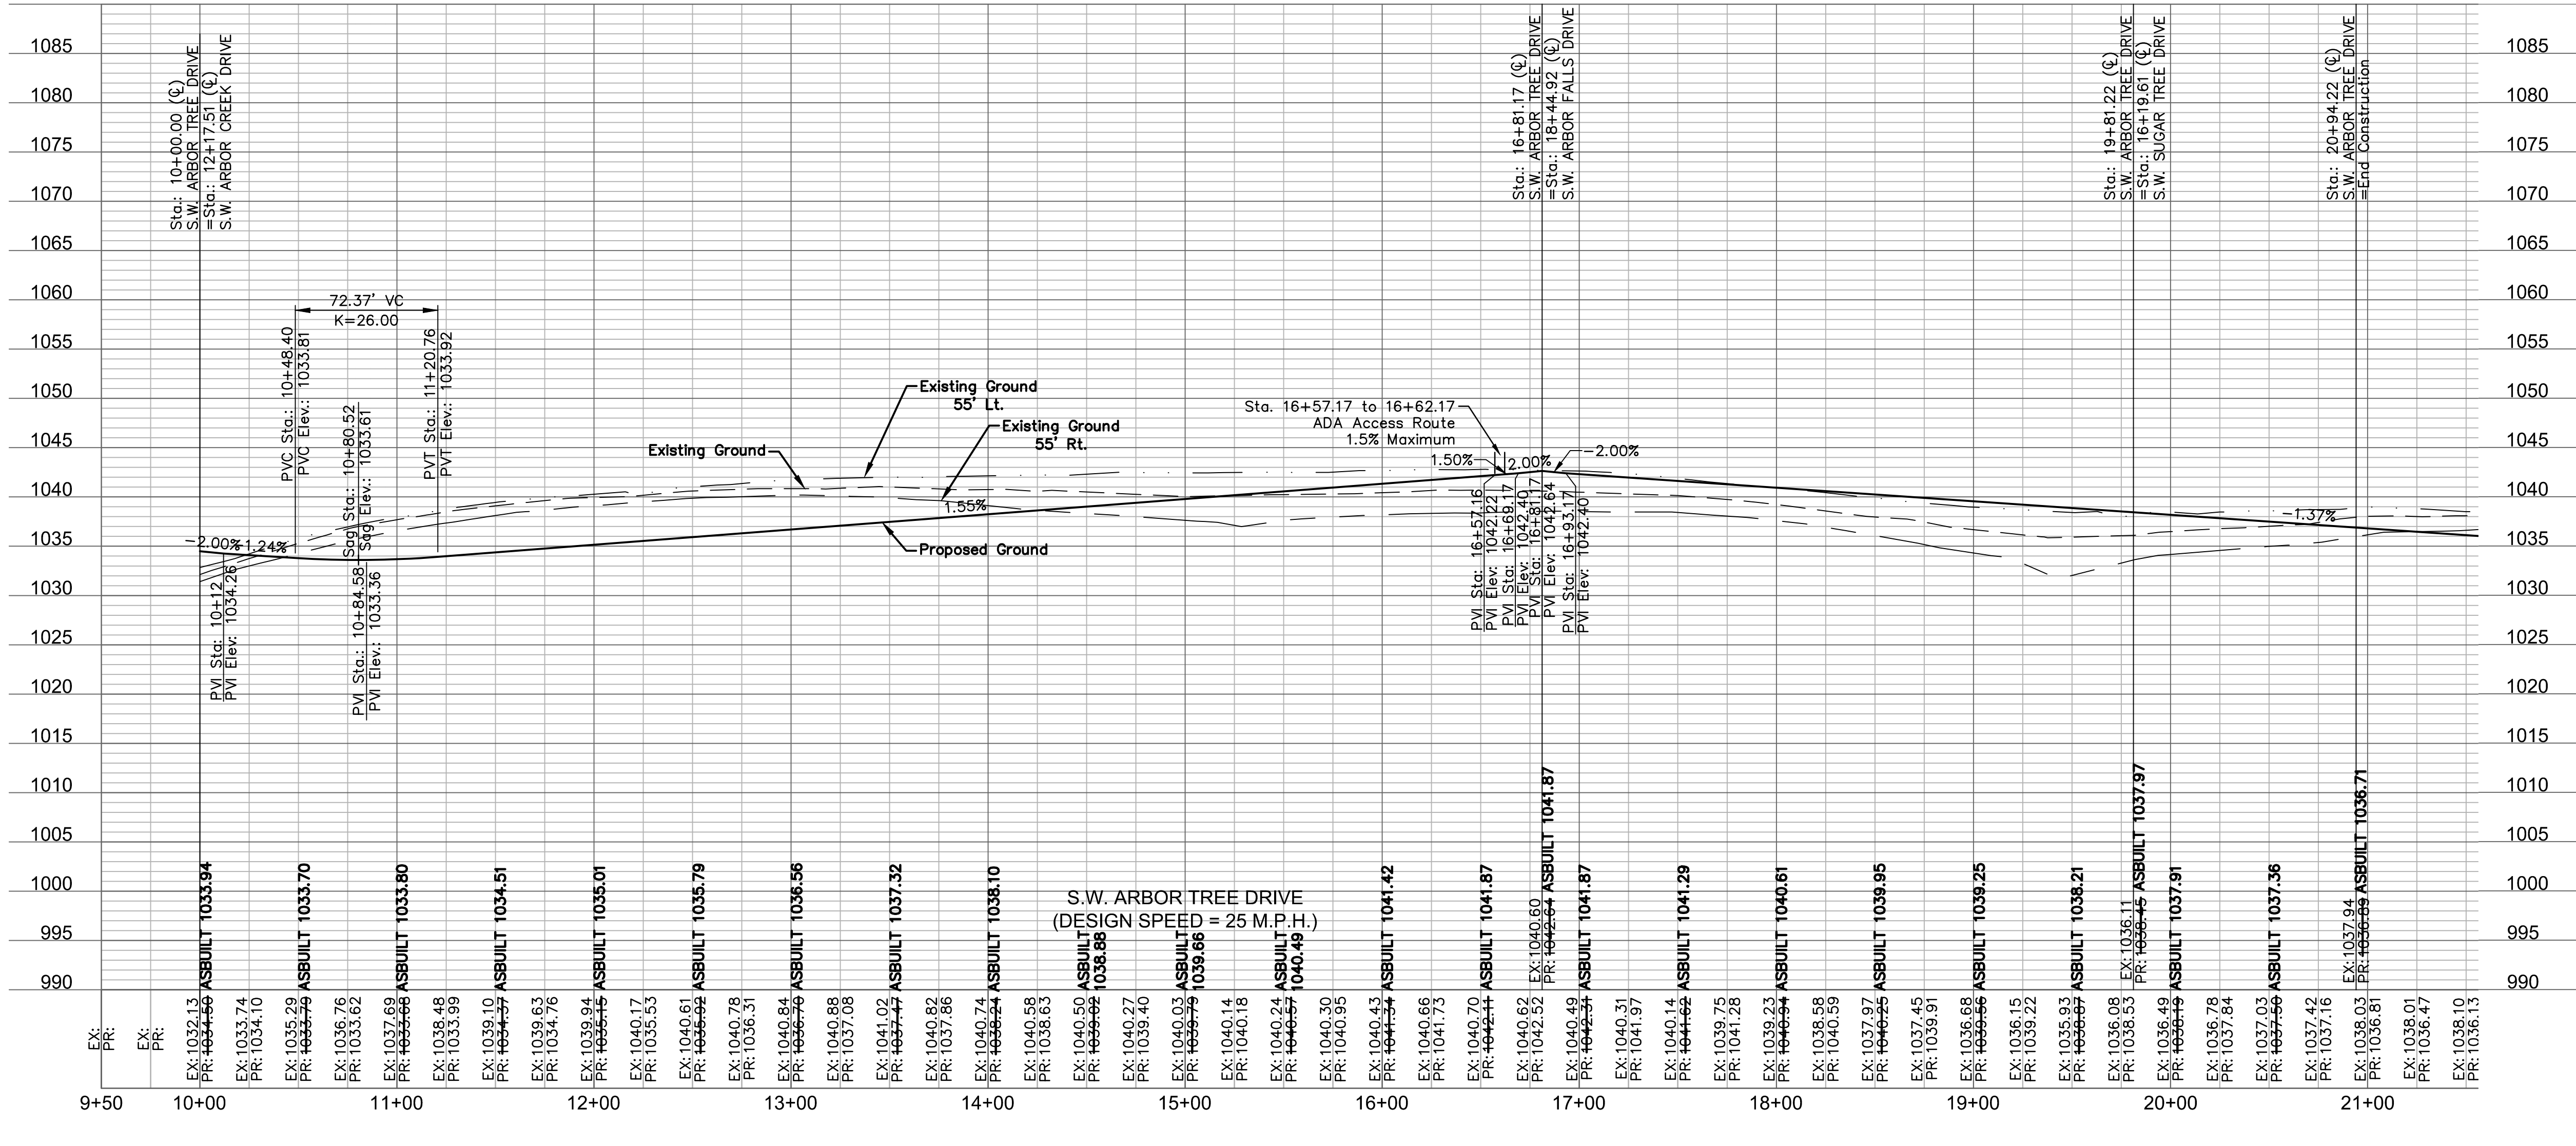

AS BUILT
DATE: 12/19/2018

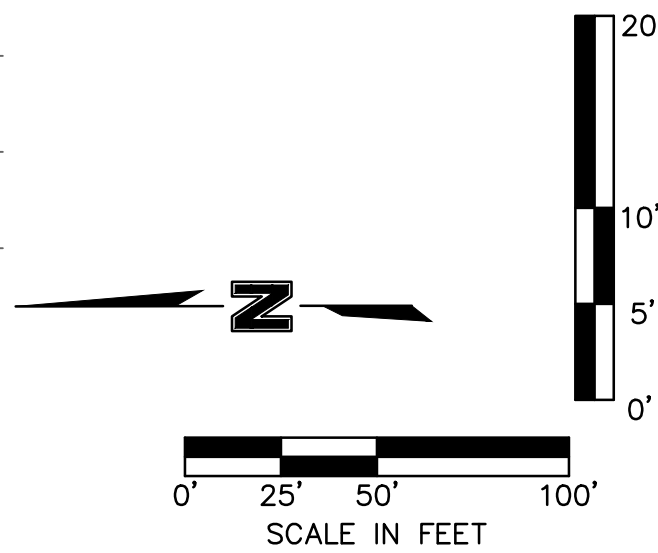

CURVE	RADIUS	LENGTH	TANGENT	DELTA	P.I. STA. (BK.)
A	200	152.21	80.01	43°36'22"	10+89.86

OLSSON ASSOCIATES

Olsson Associates - Civil Engineering
3400 S. Main Street, Suite 100
North Kansas City, MO 64116
TEL 816.897.4320
FAX 816.897.1393
www.olssonassociates.com

STATE OF MISSOURI
MELISSA G. DEGENIA
Professional Engineer
NUMBER
FE-2011000892
03/04/2019

BY: MGD

REVISIONS DESCRIPTION

NO. REV. DATE

1 02.12.2018 Revised ADA access routes

REVISIONS

2018

ROADWAY PLAN & PROFILE



HAWTHORN RIDGE
1ST PLAT

LEE'S SUMMIT, MO

drawn by: D.A.H.D.
checked by: M.G.P.
designed by: P.M.B.
QA/QC by: K.S.P.
project no.: 017-0188
date: 03.03.2017

SHEET
C111


- CONCRETE SIDEWALK
- ADA ACCESS ROUTE
- ASPHALT PAVEMENT
- CG-2 CURB & GUTTER
(See Detail Sheet)
- CG-1 CURB & GUTTER
(See Detail Sheet)

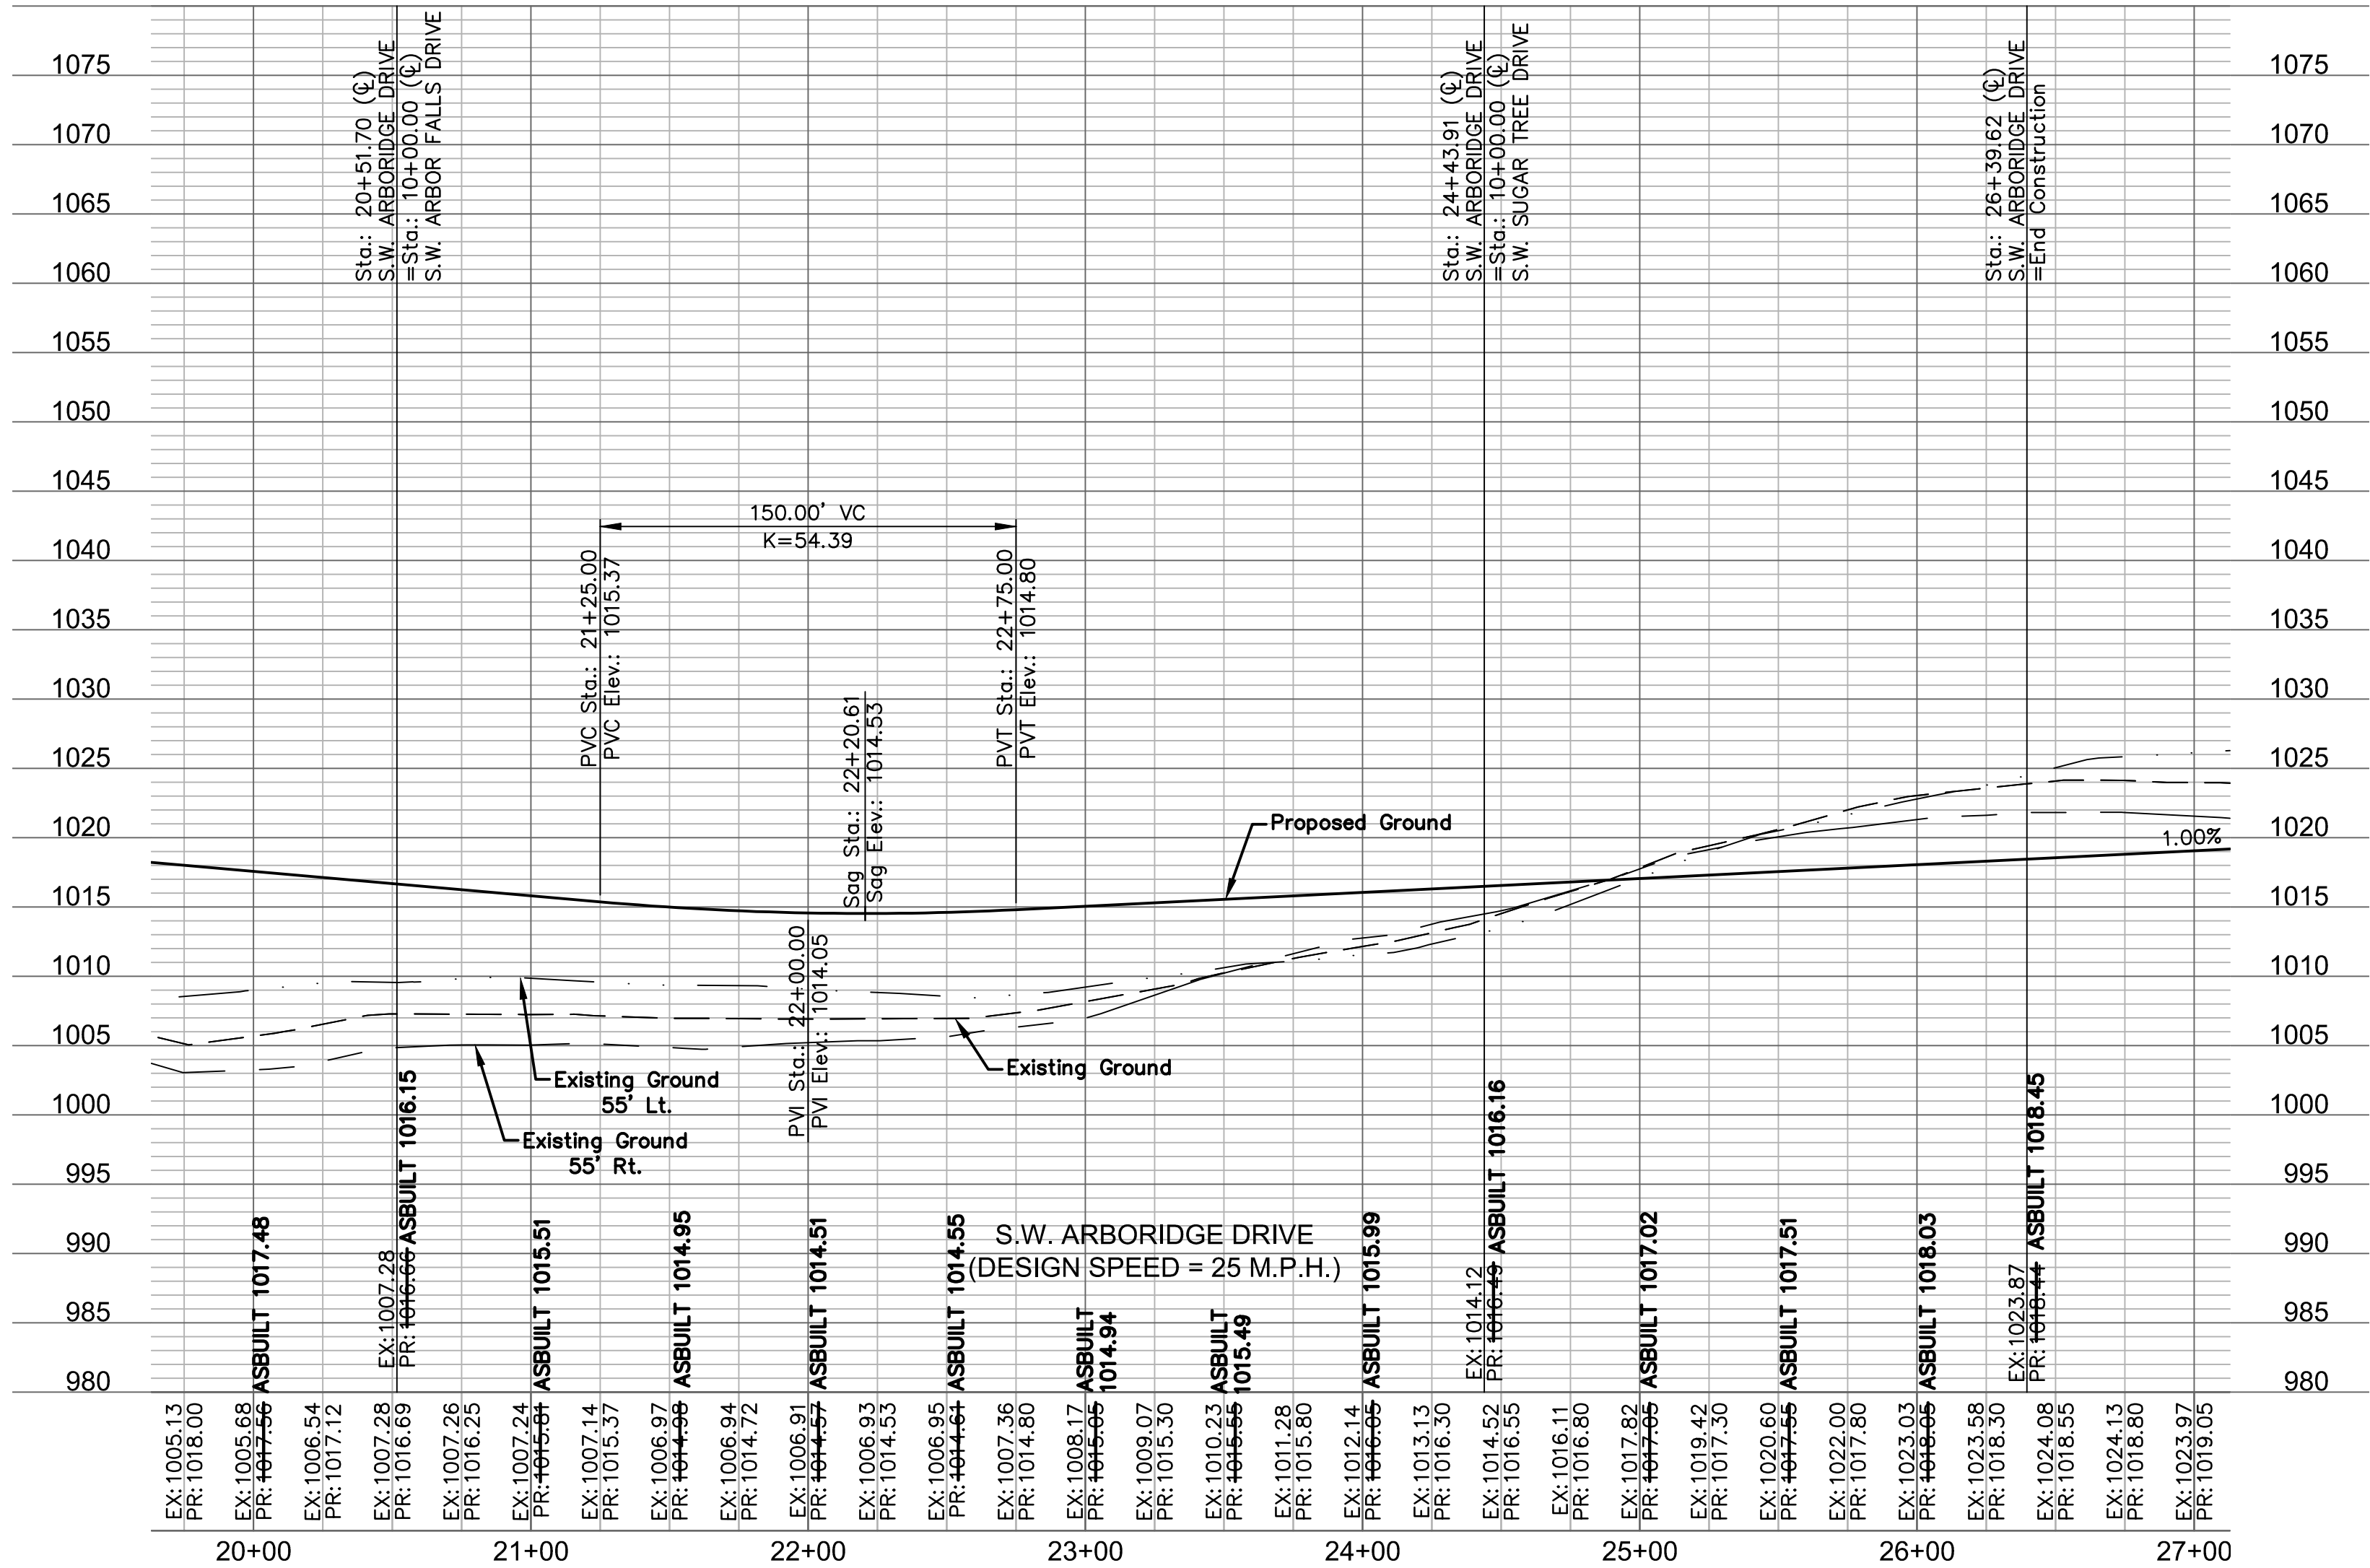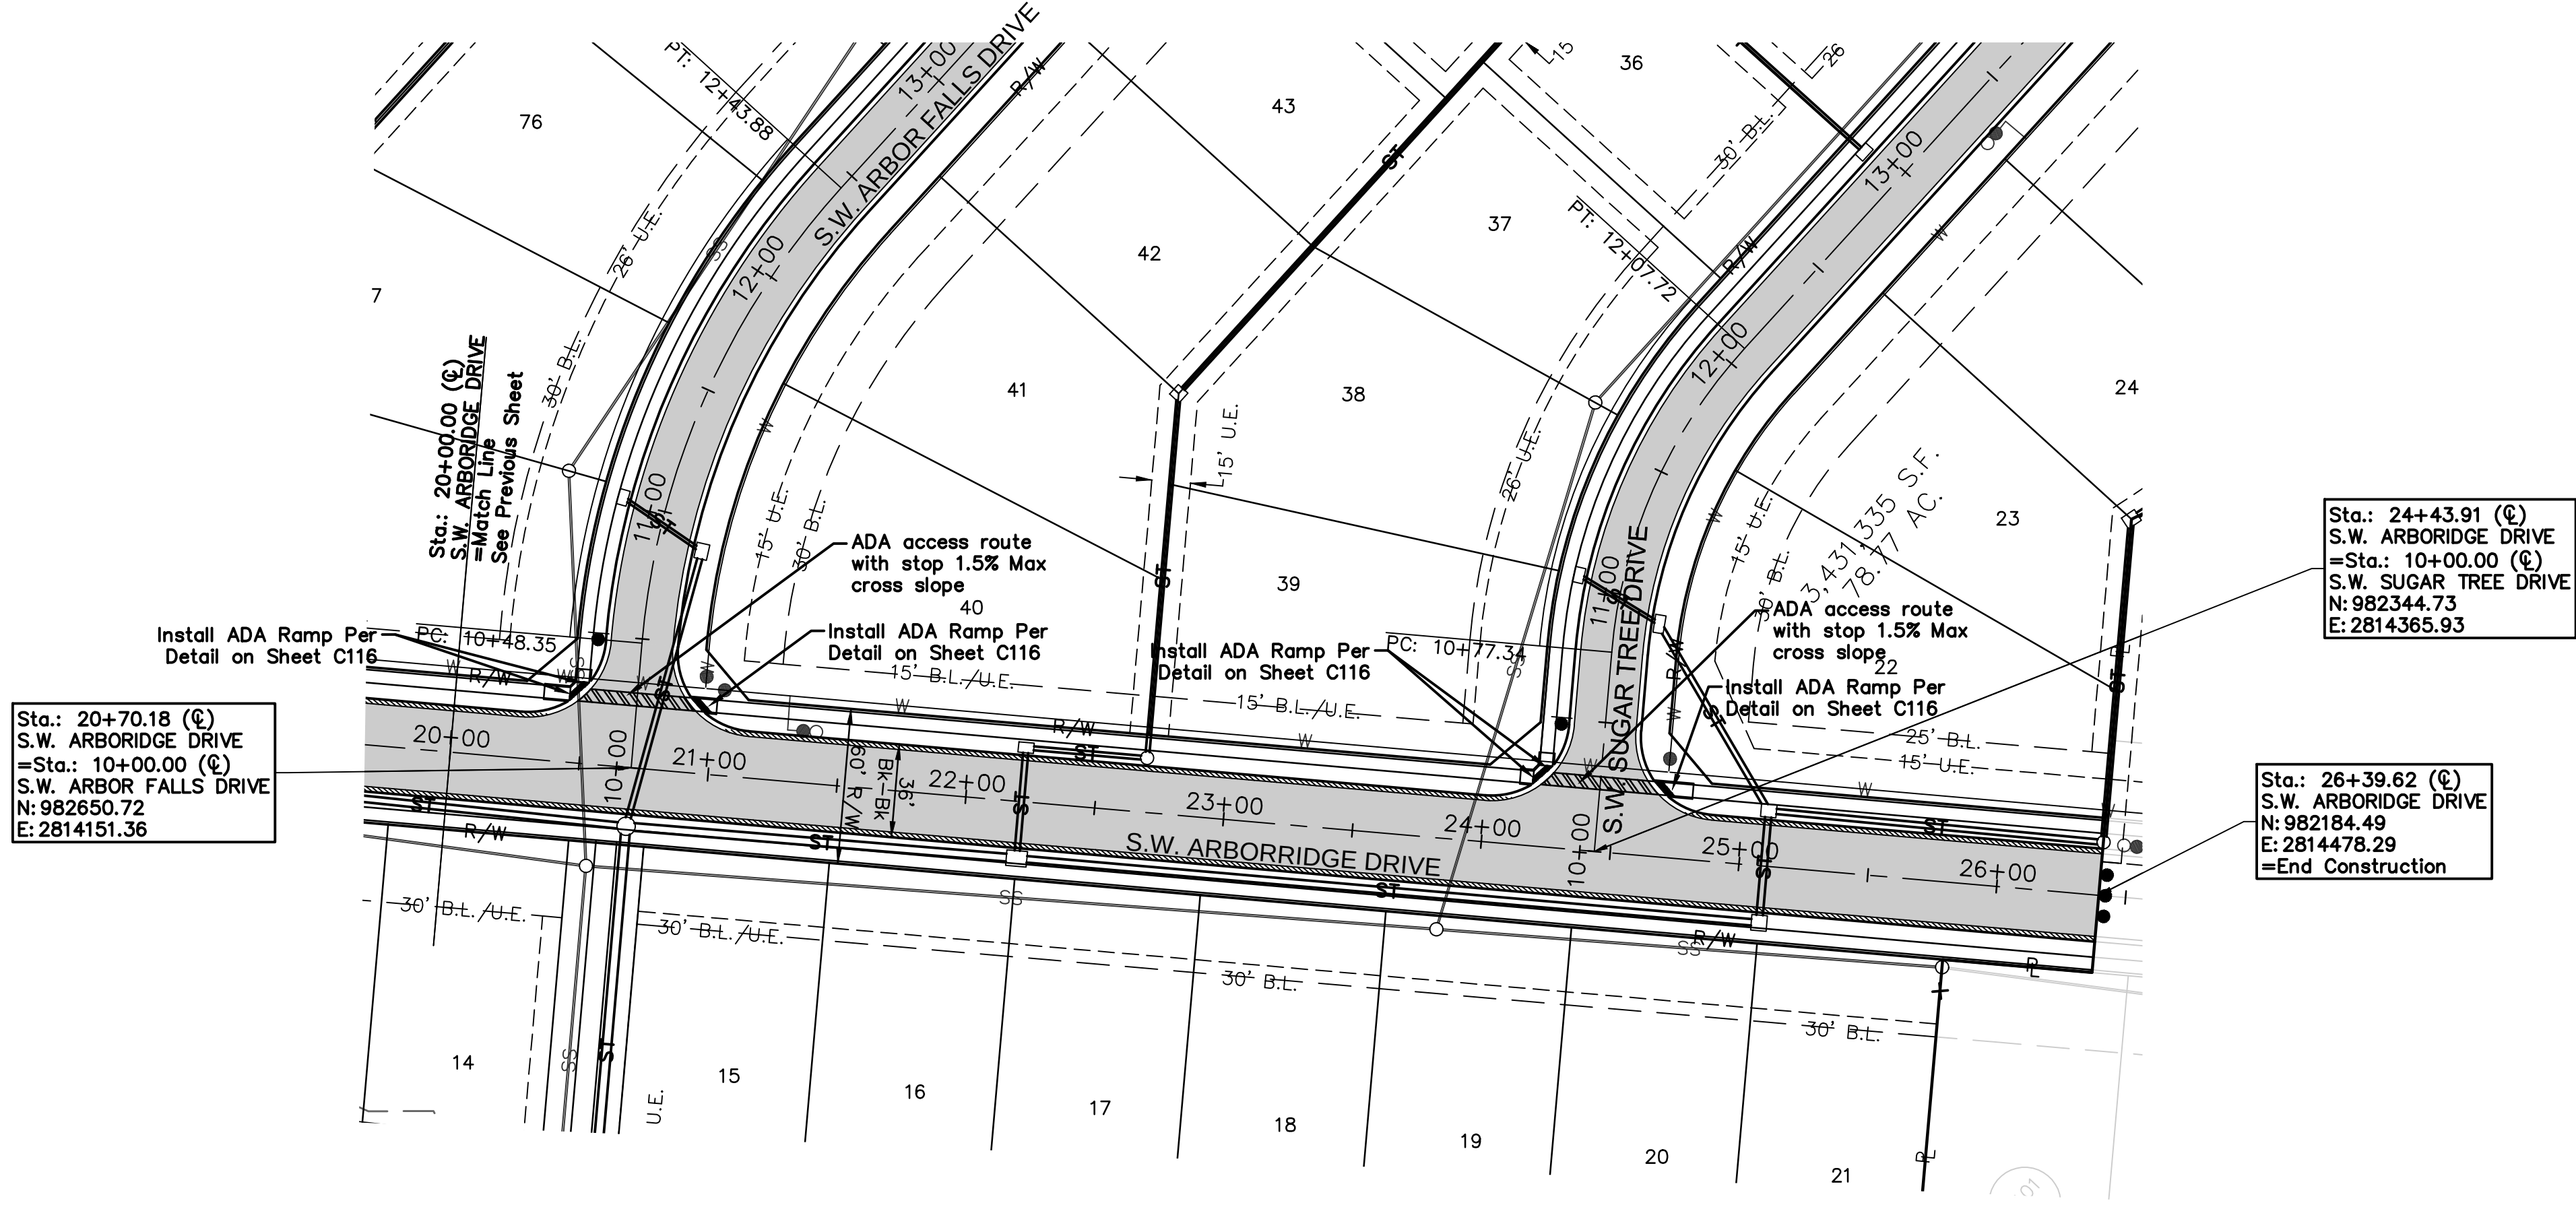

AS BUILT

DATE: 12/19/2018

Record Drawing

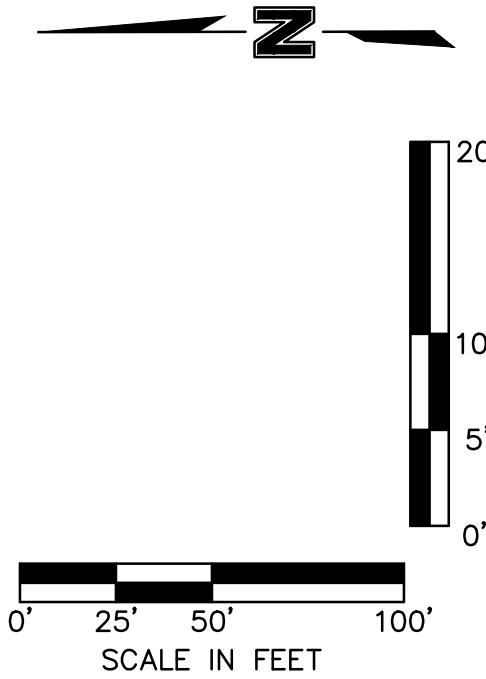







ROADWAY PLAN & PROFILE		2018	
HAWTHORN RIDGE 1ST PLAT		LEE'S SUMMIT, MO	
SHEET C113		REVISIONS	
NO.	REV.	DATE	DESCRIPTION
2		02.23.2017	Revised notes
4		01.08.2018	Removed Hook Road Improvements
5		02.14.2018	Revised ADA access notes

drawn by: DAH.O
checked by: M.G.D.
designed by: P.M.L.B.
QA/QC by: K.S.J.
project no.: 017-0188
date: 03.03.2017



OLSSON ASSOCIATES
Olsson Associates - Civil Engineering
1800 S. Main Street, Suite 100
North Kansas City, MO 64116
TEL 816.897.4320
FAX 816.897.1393
www.olssonassociates.com

DWG: F:\2017\0001-0500\017-0188\40-Design\AutoCAD\Final Plans\ASBUILT\GIS\CONV\01_Street & Storm_36x24\C_SPT02_017-0188.dwg
DATE: Feb 19, 2019 6:03pm
USER: dhernandez

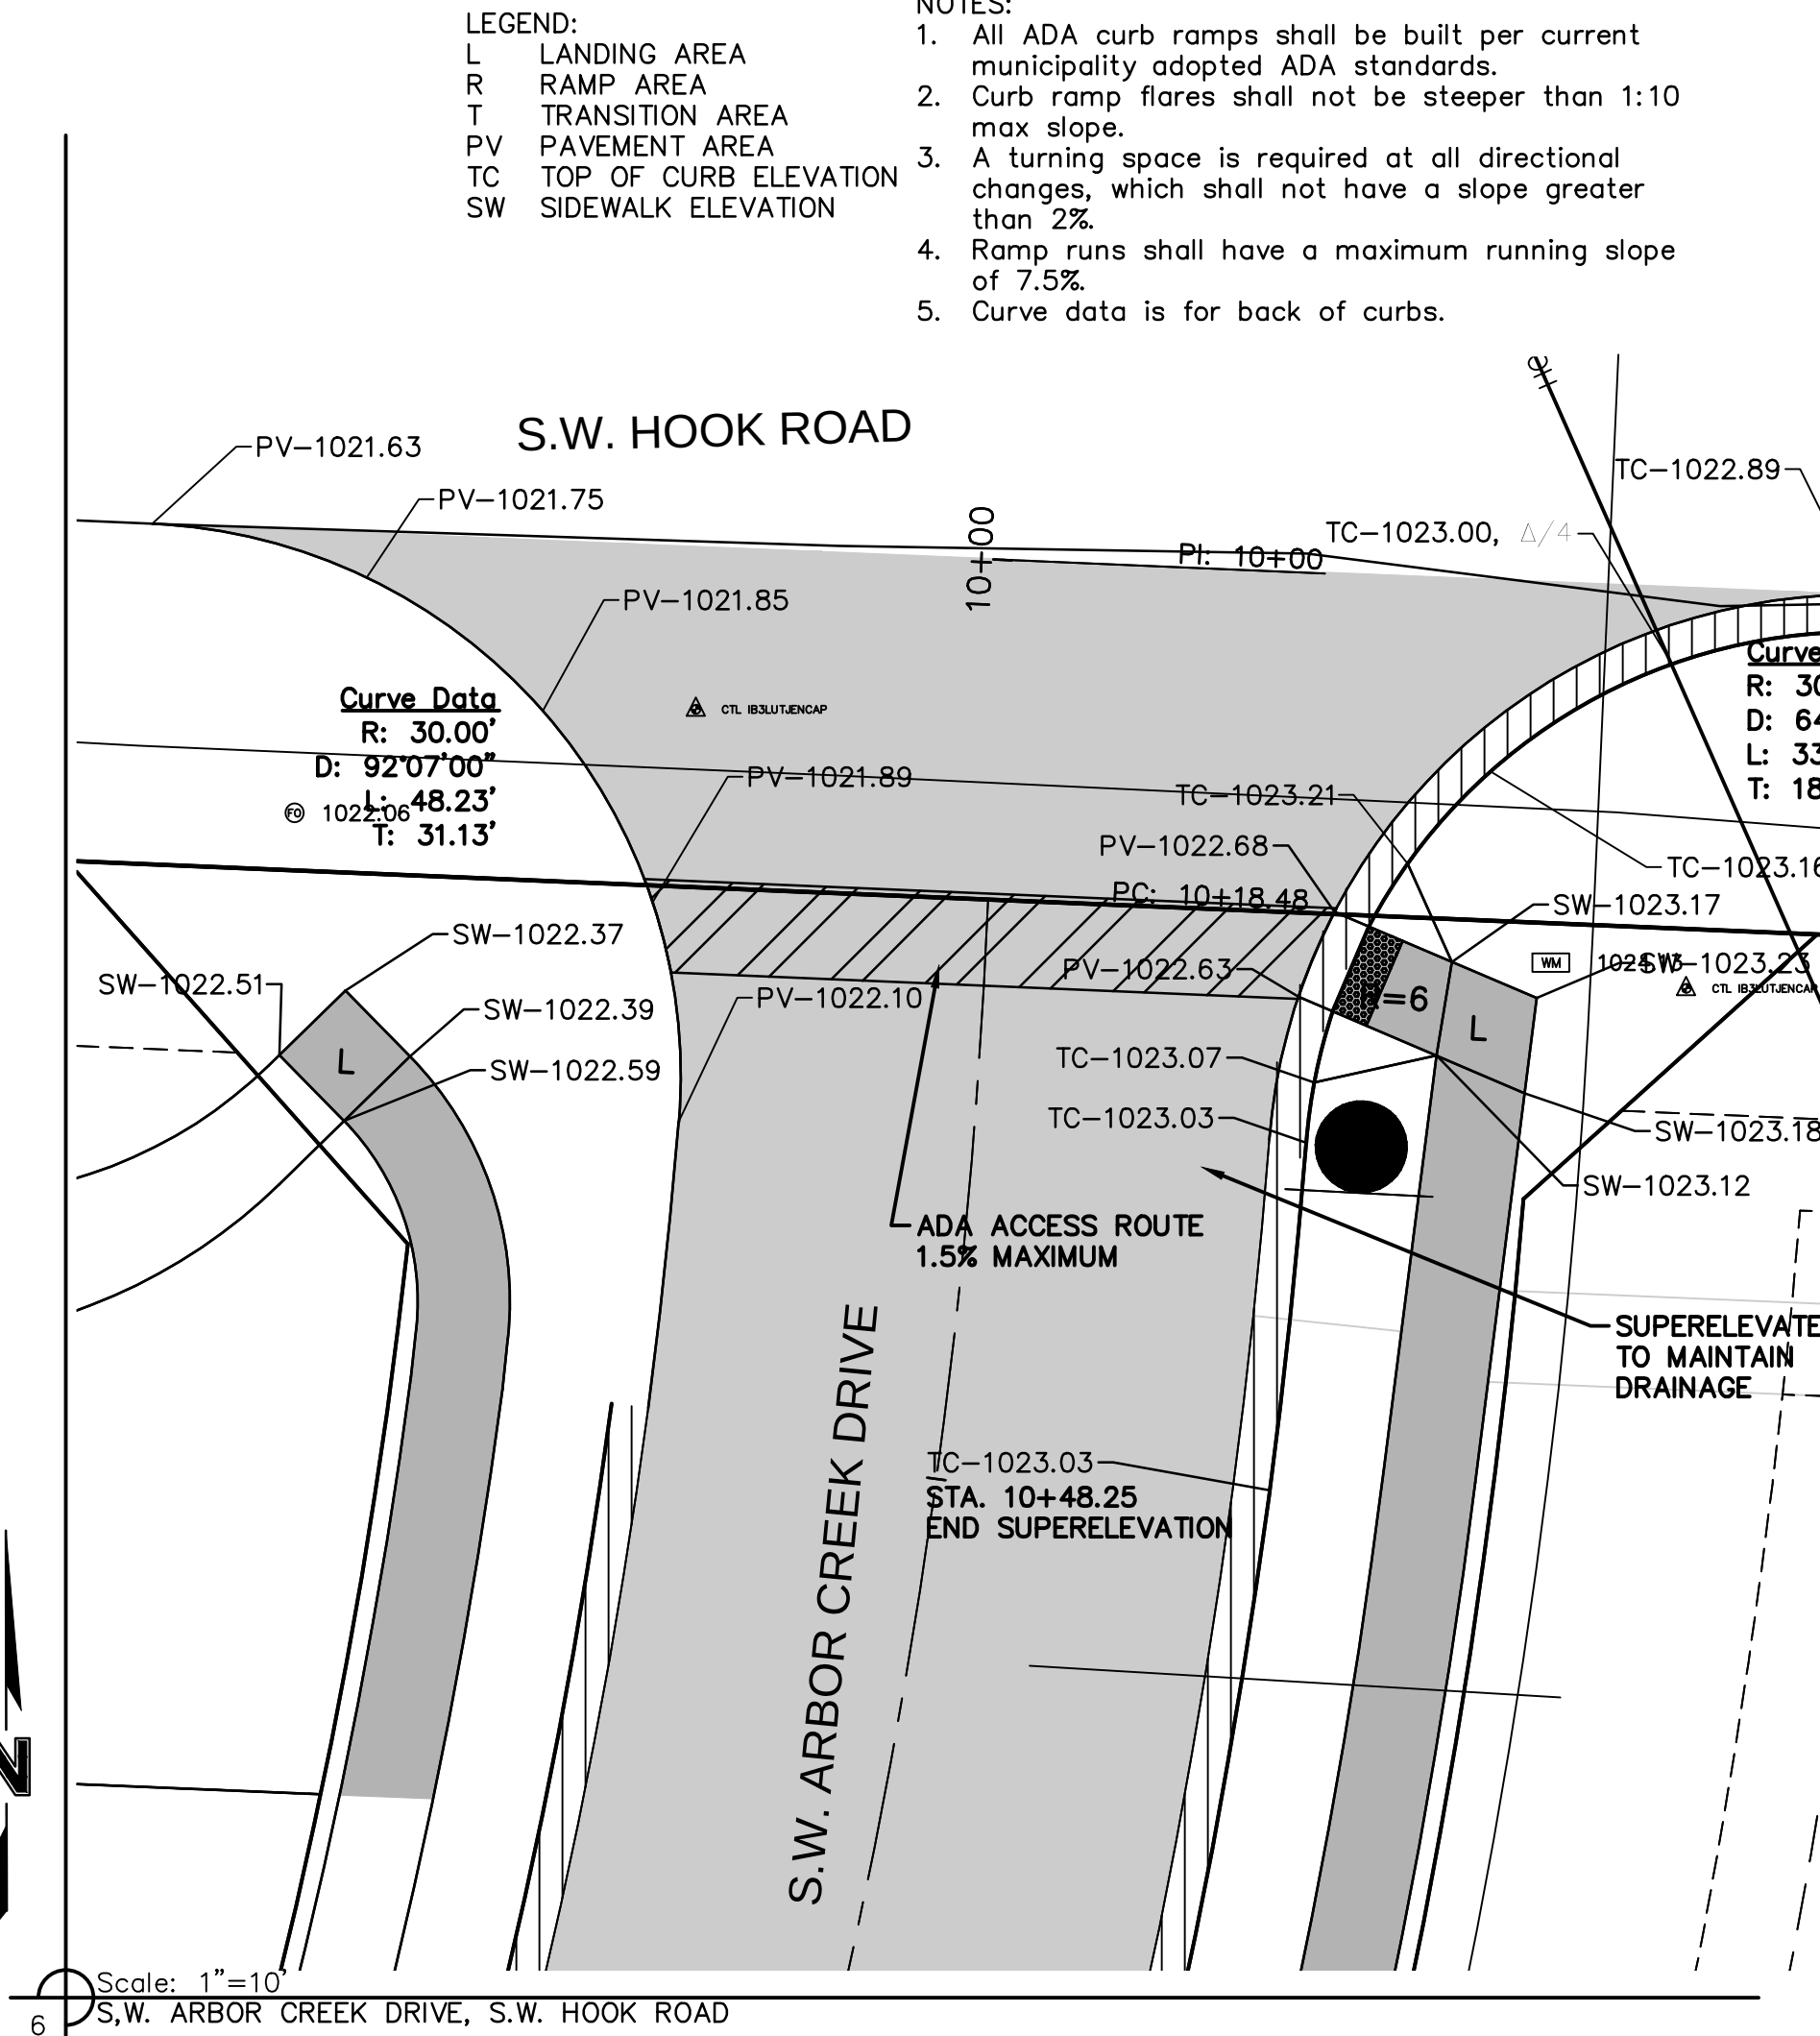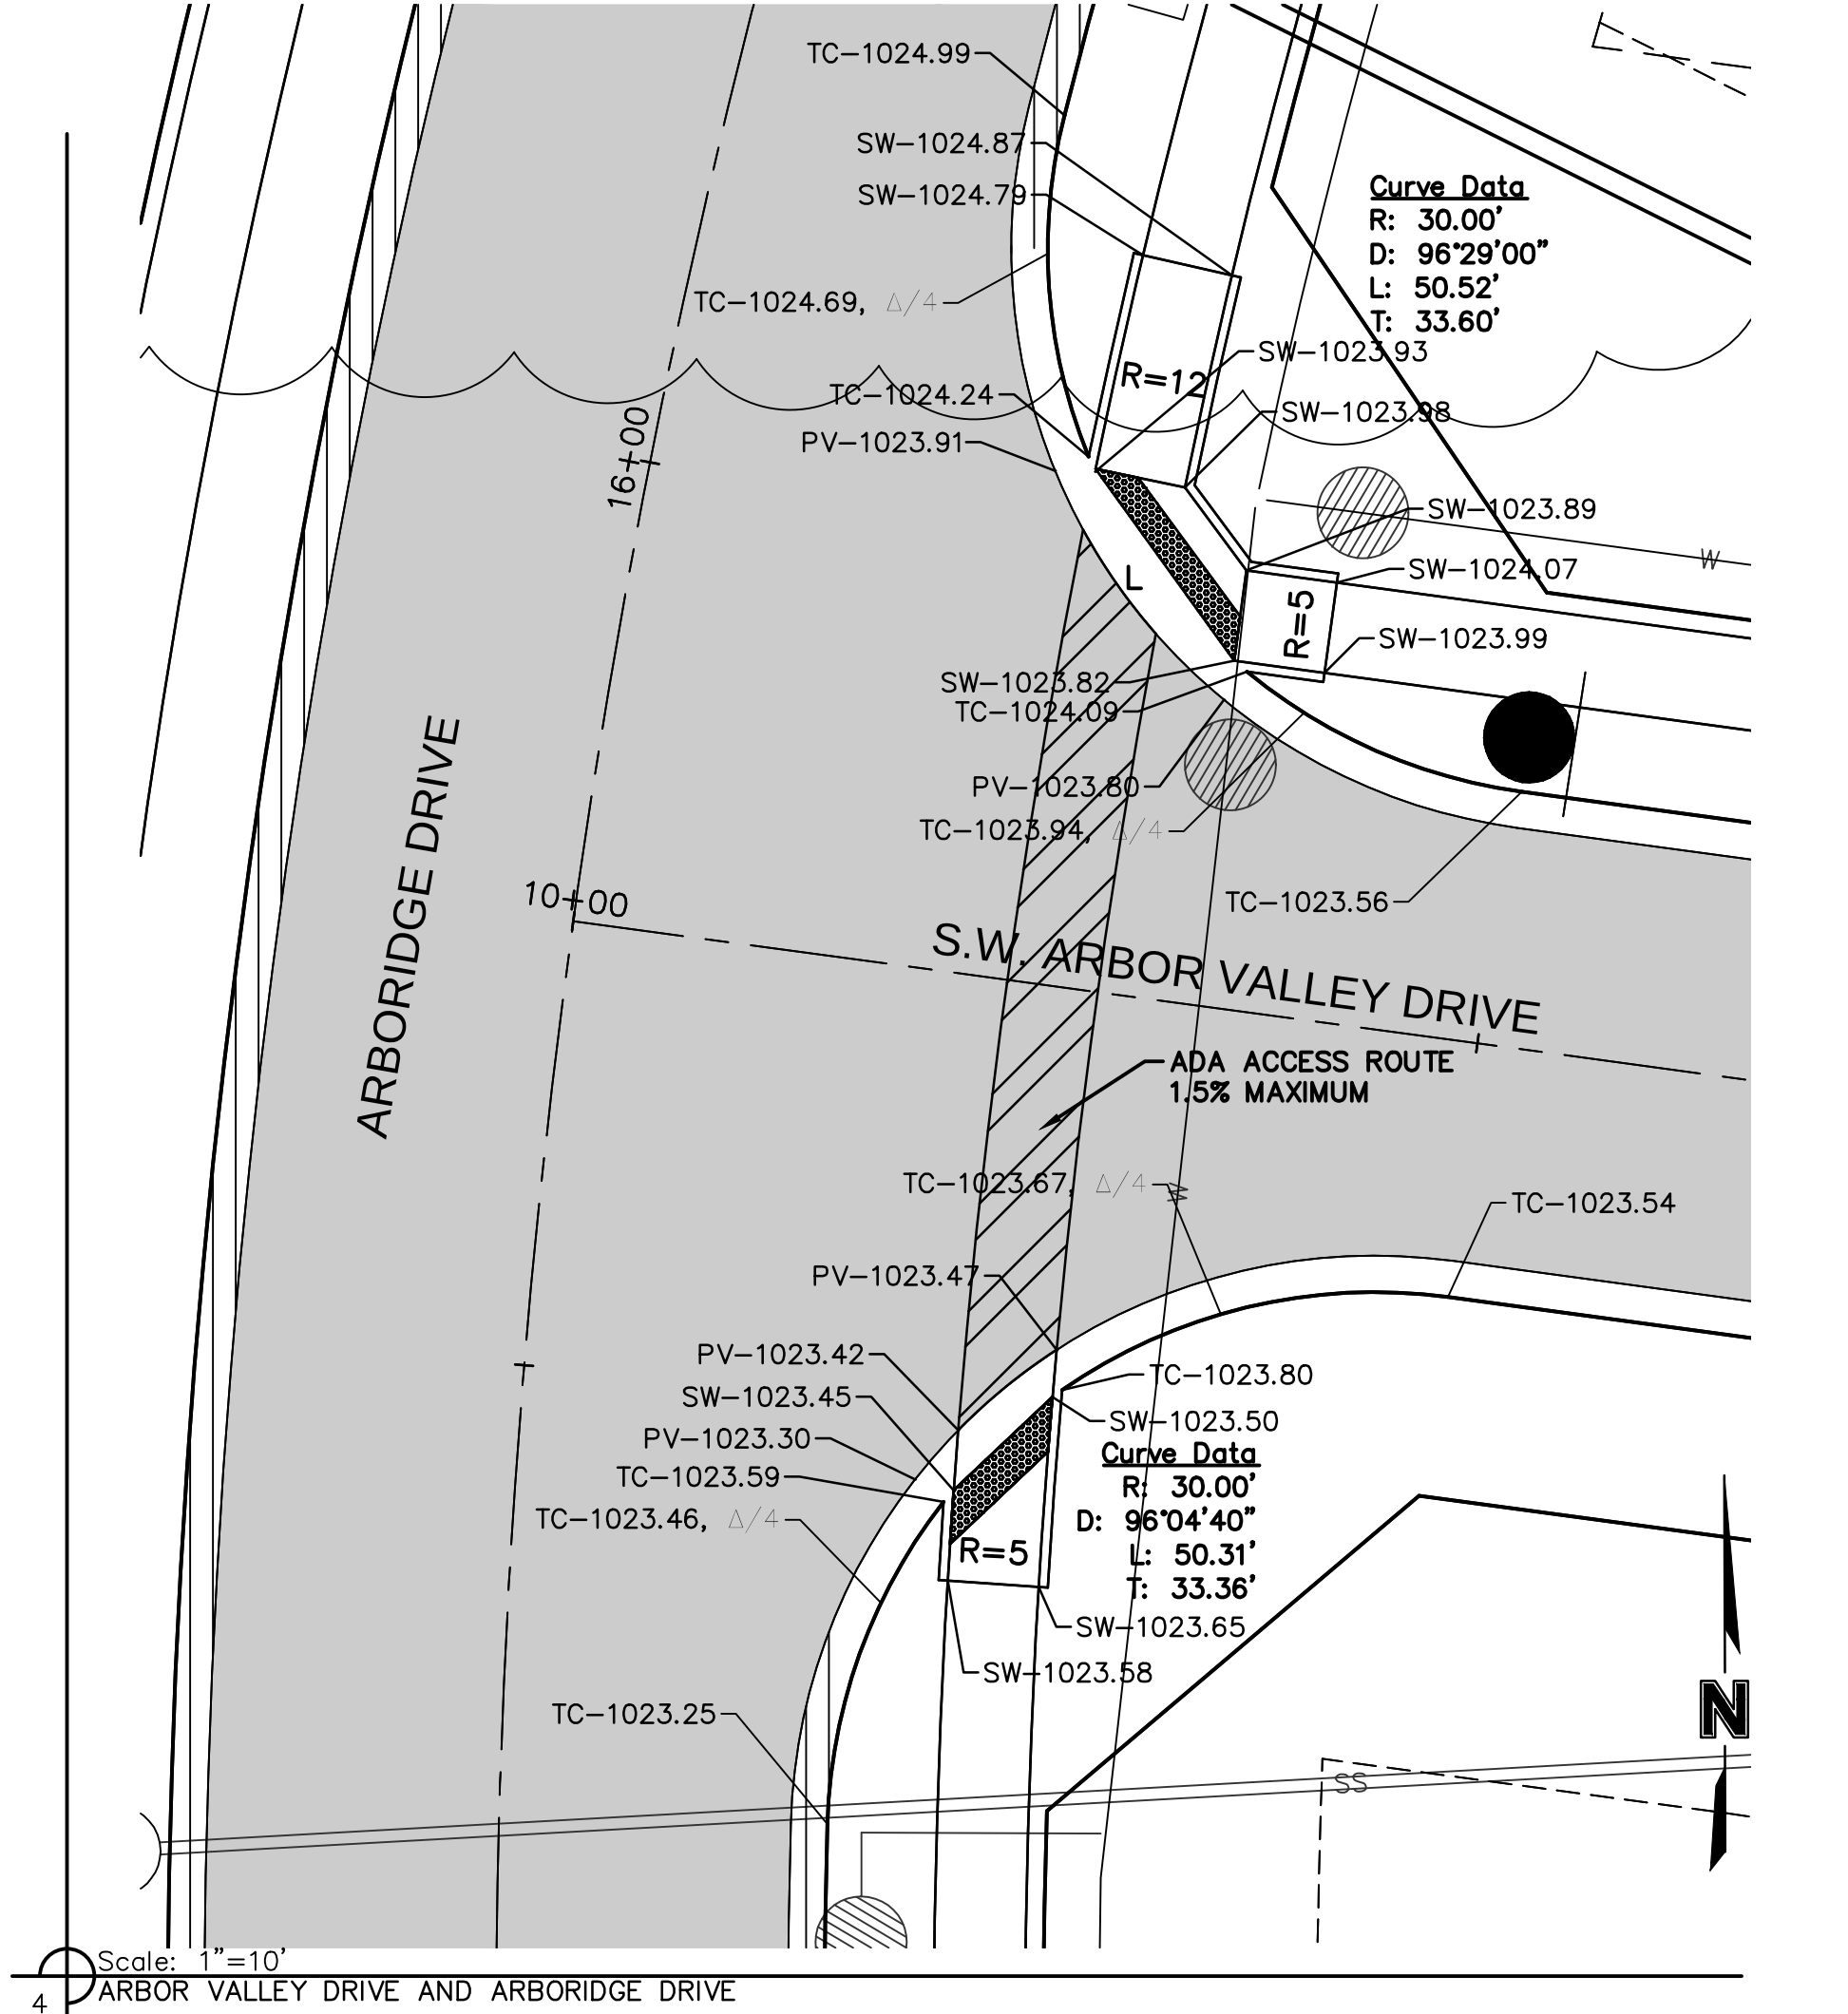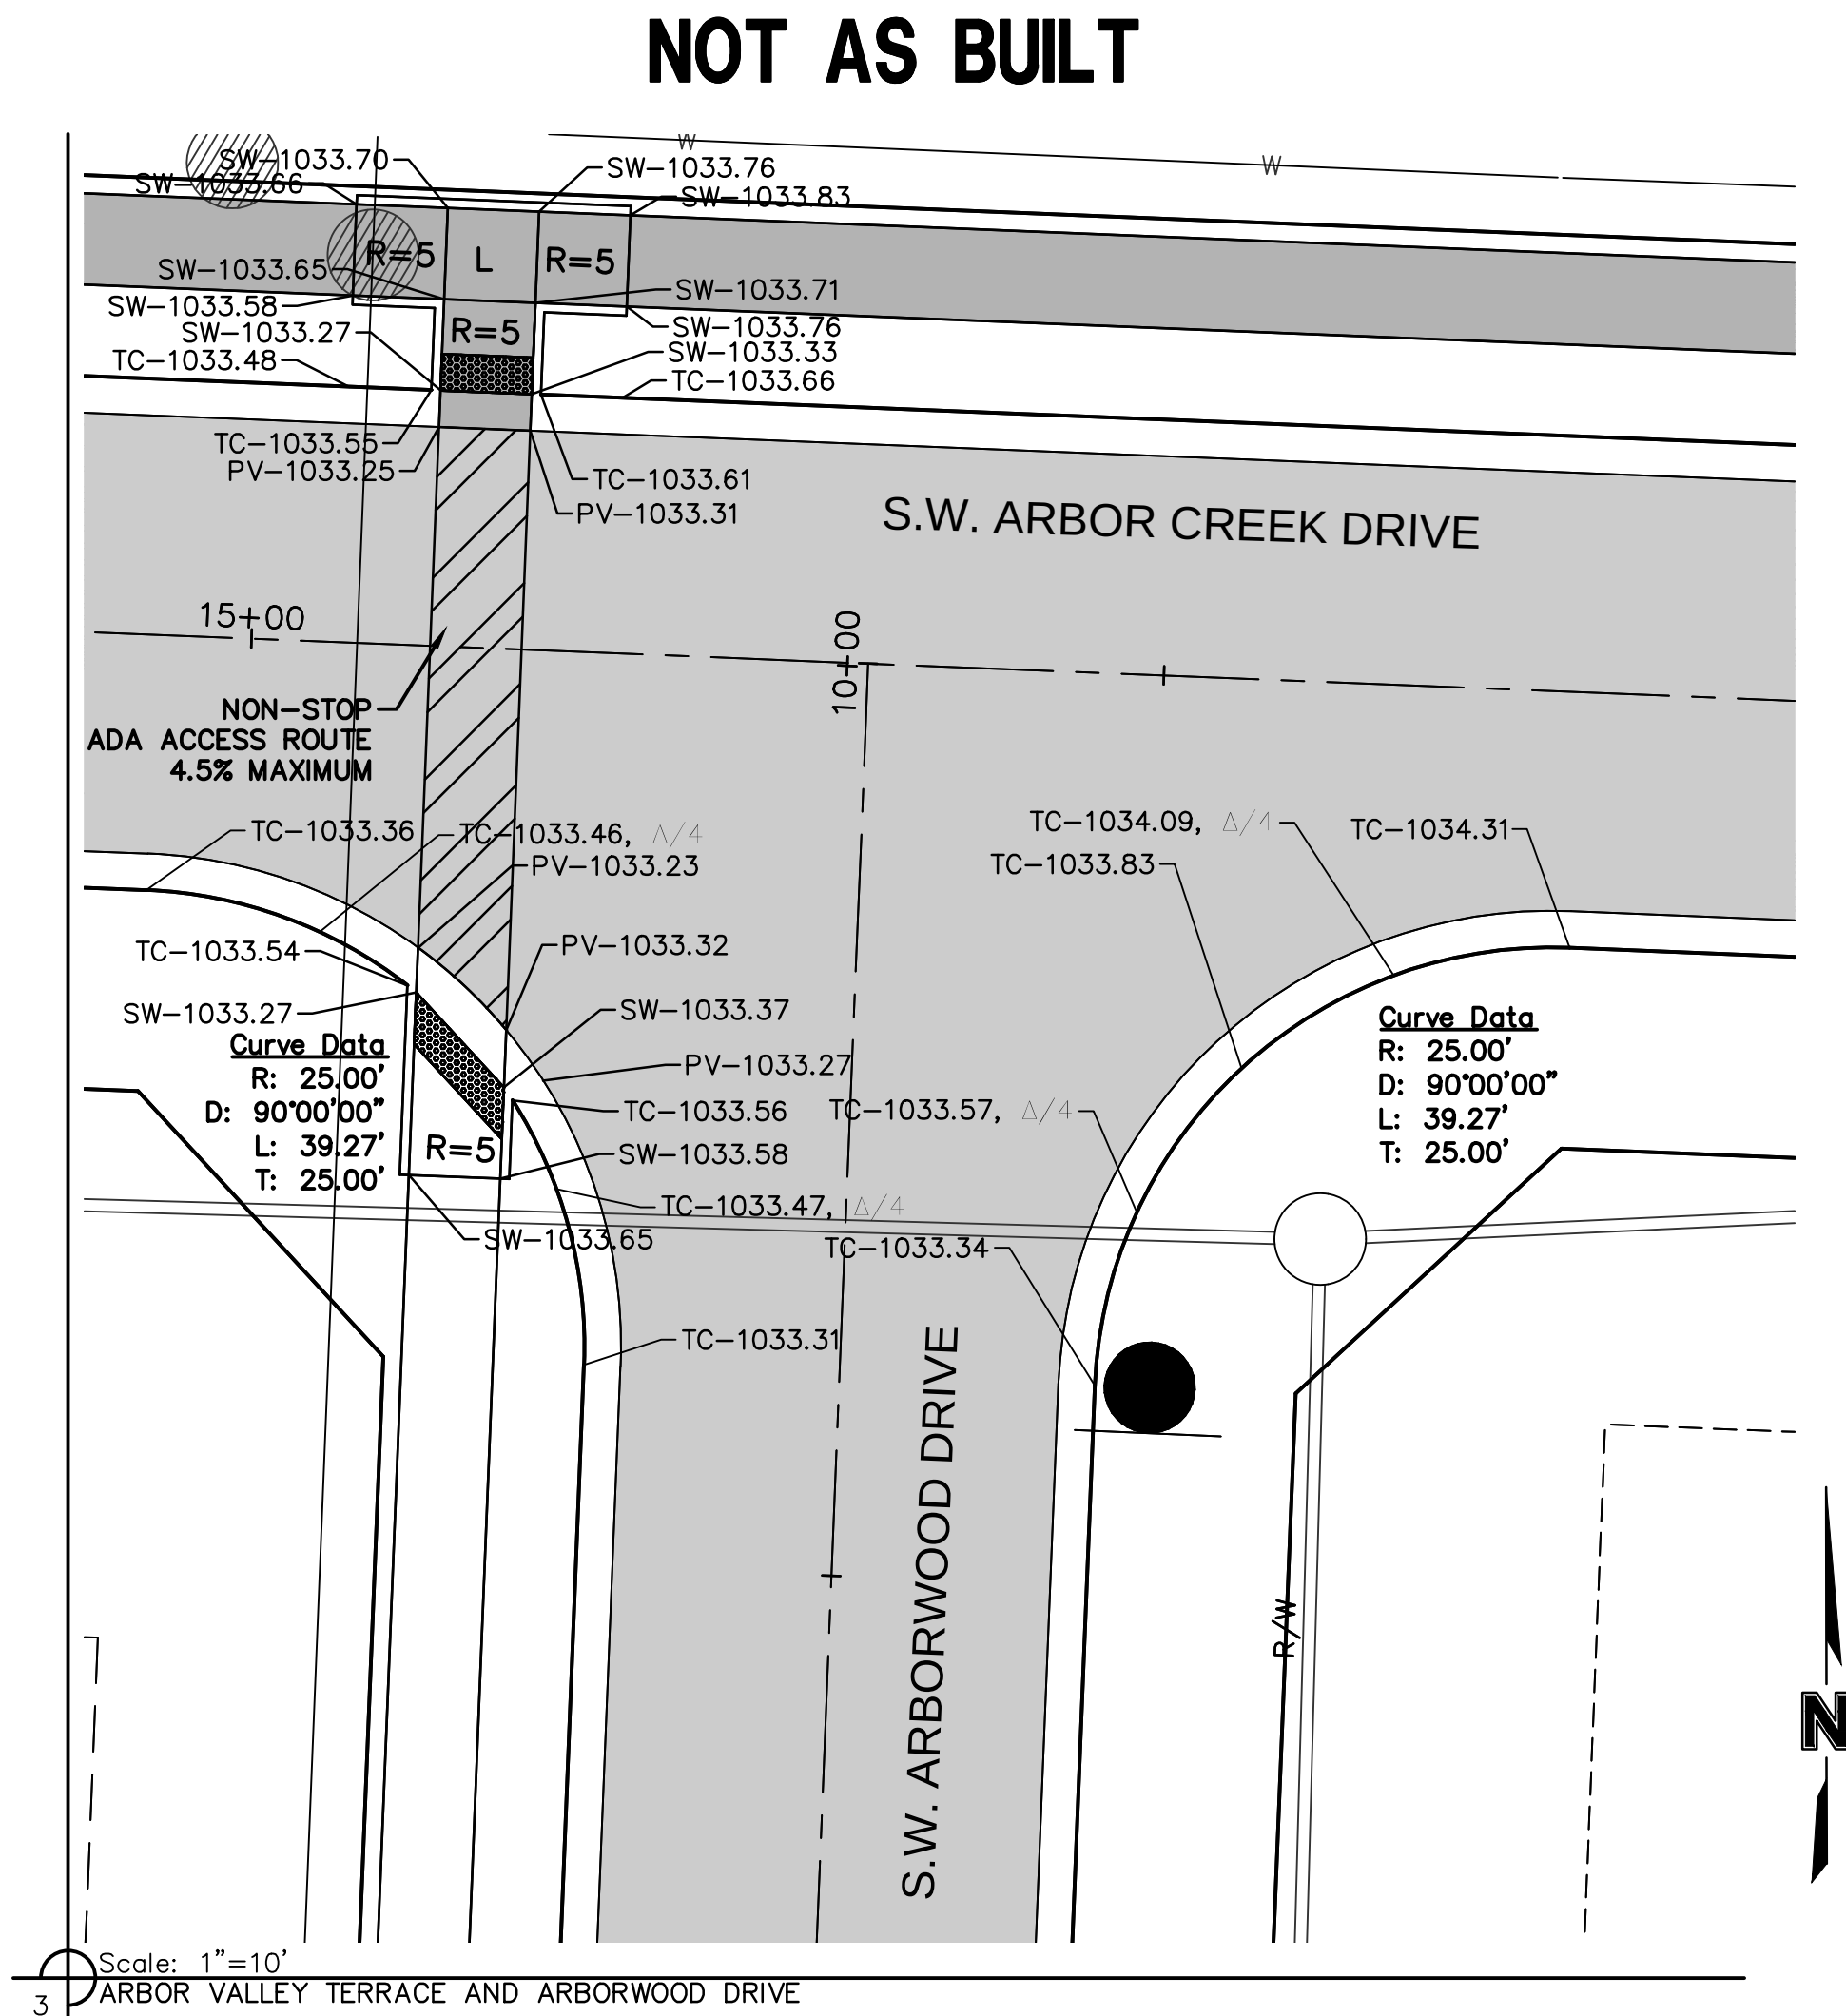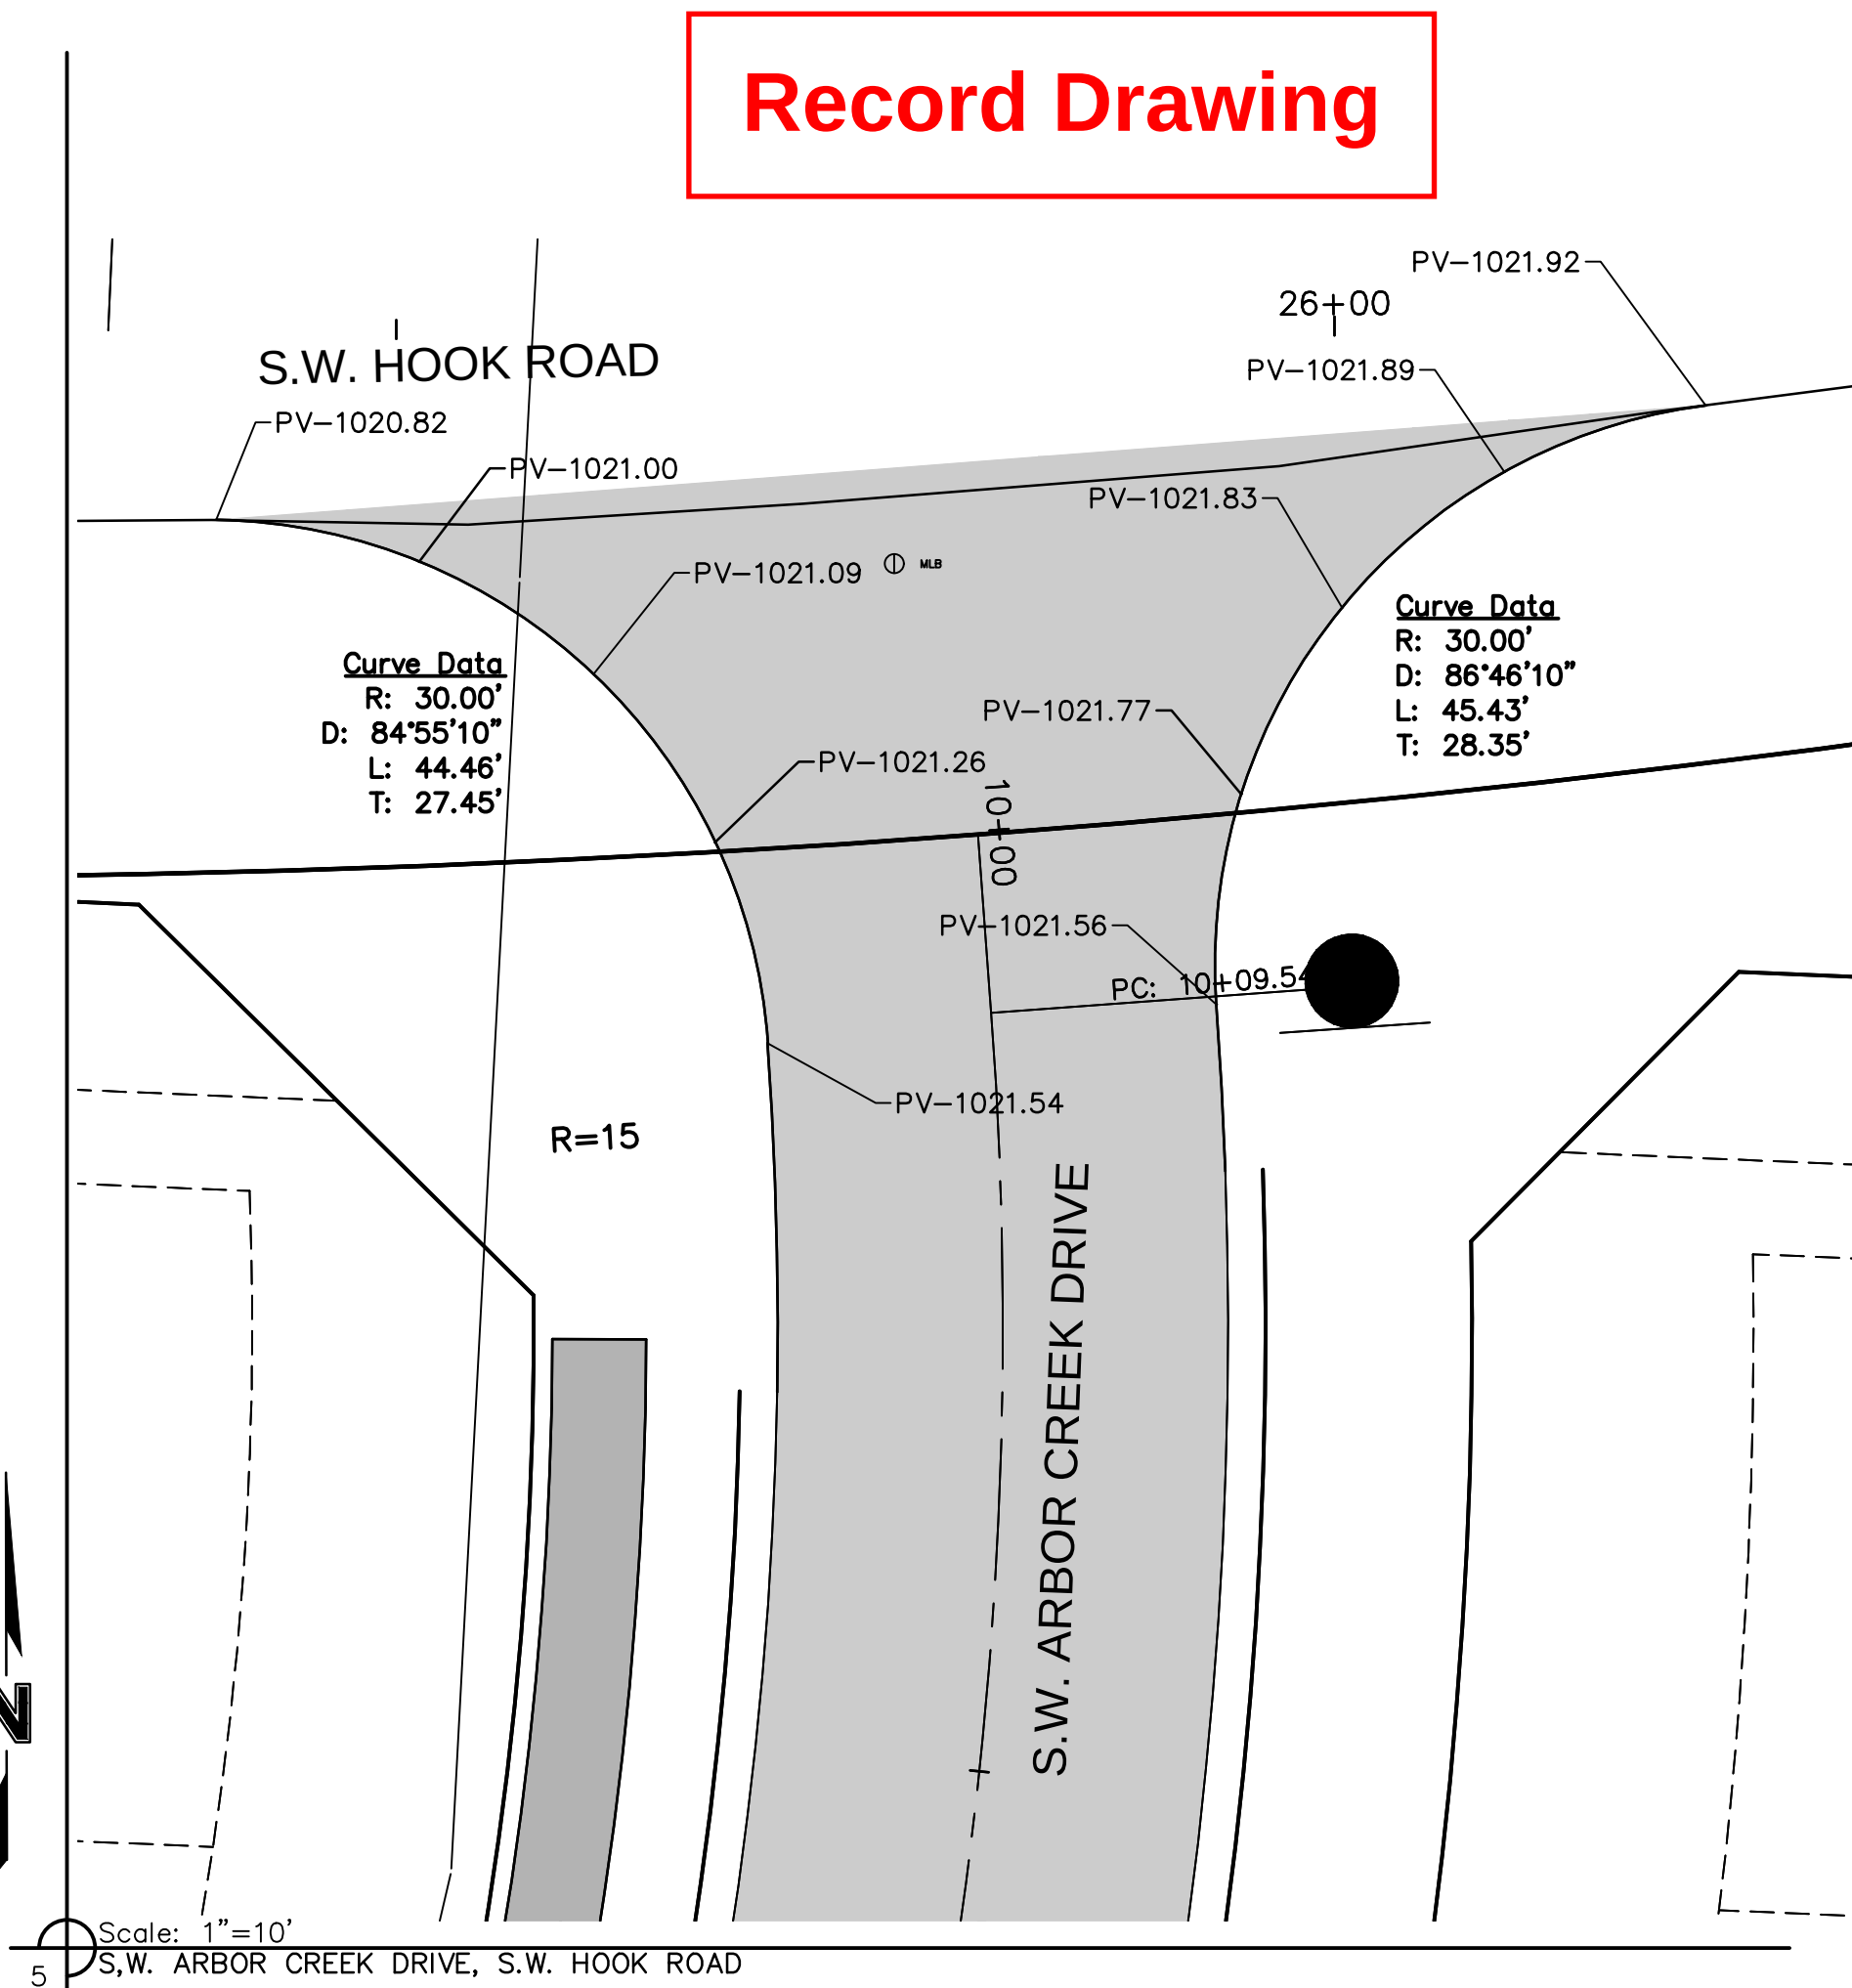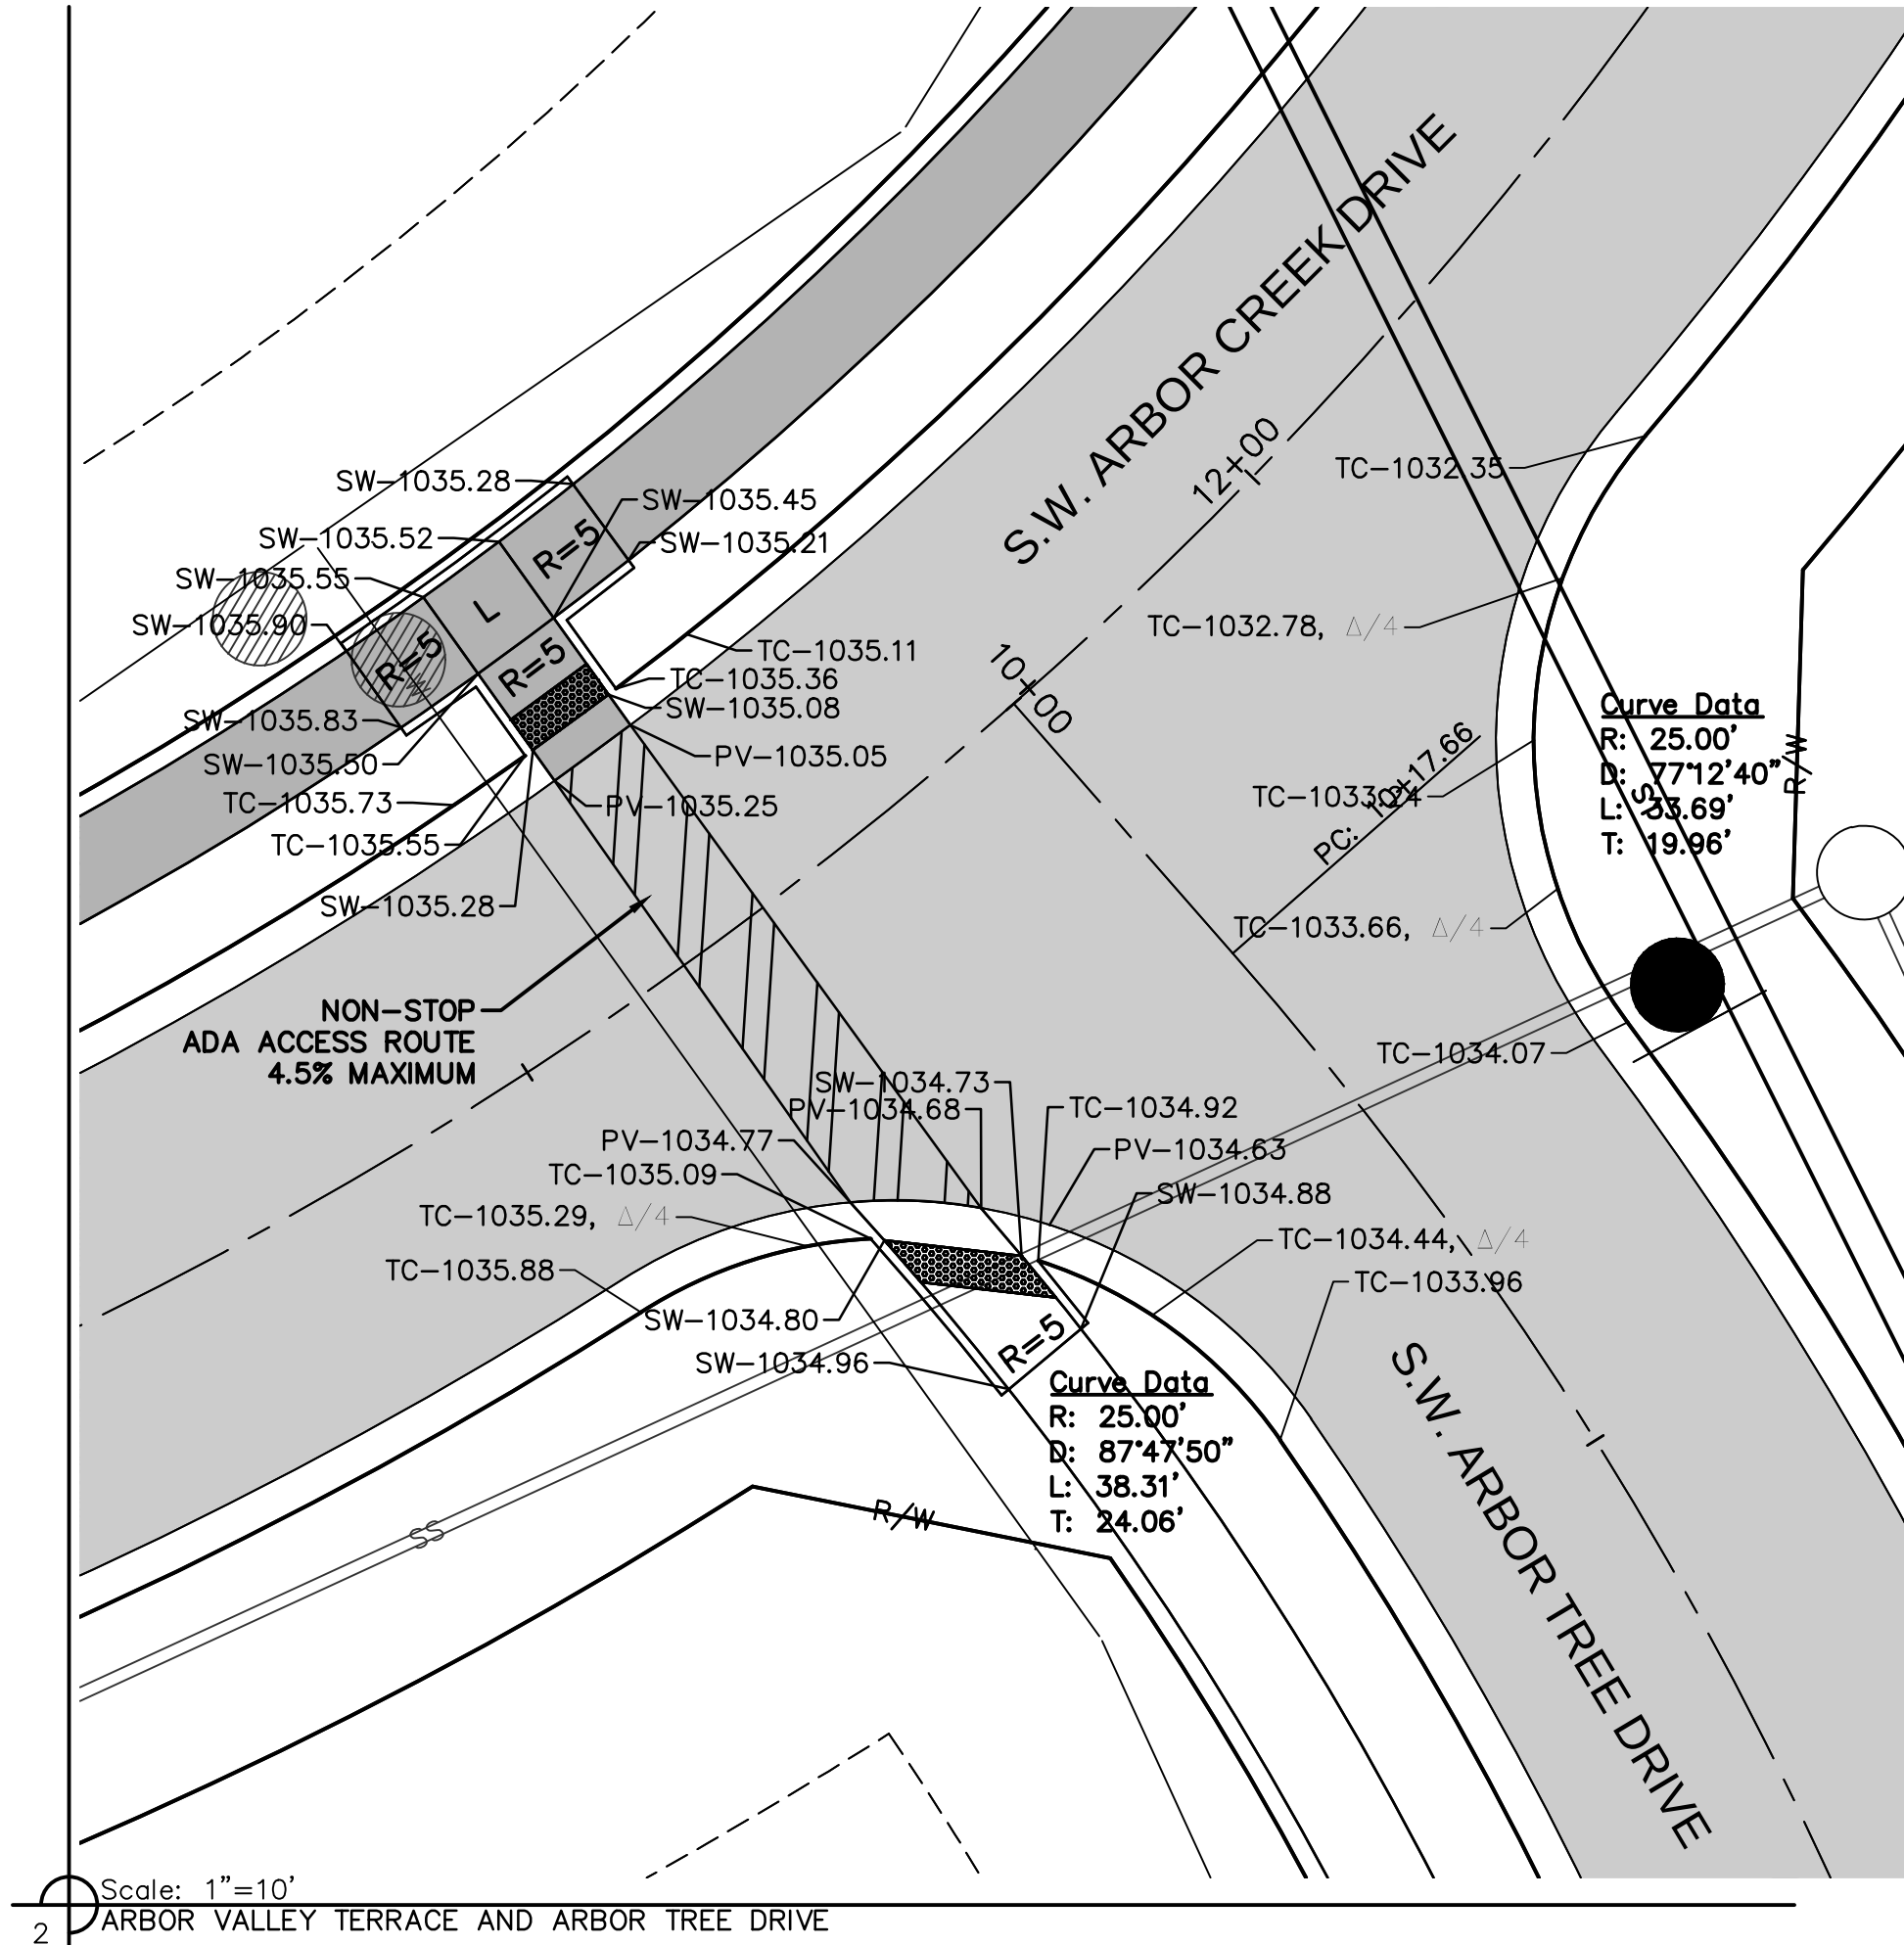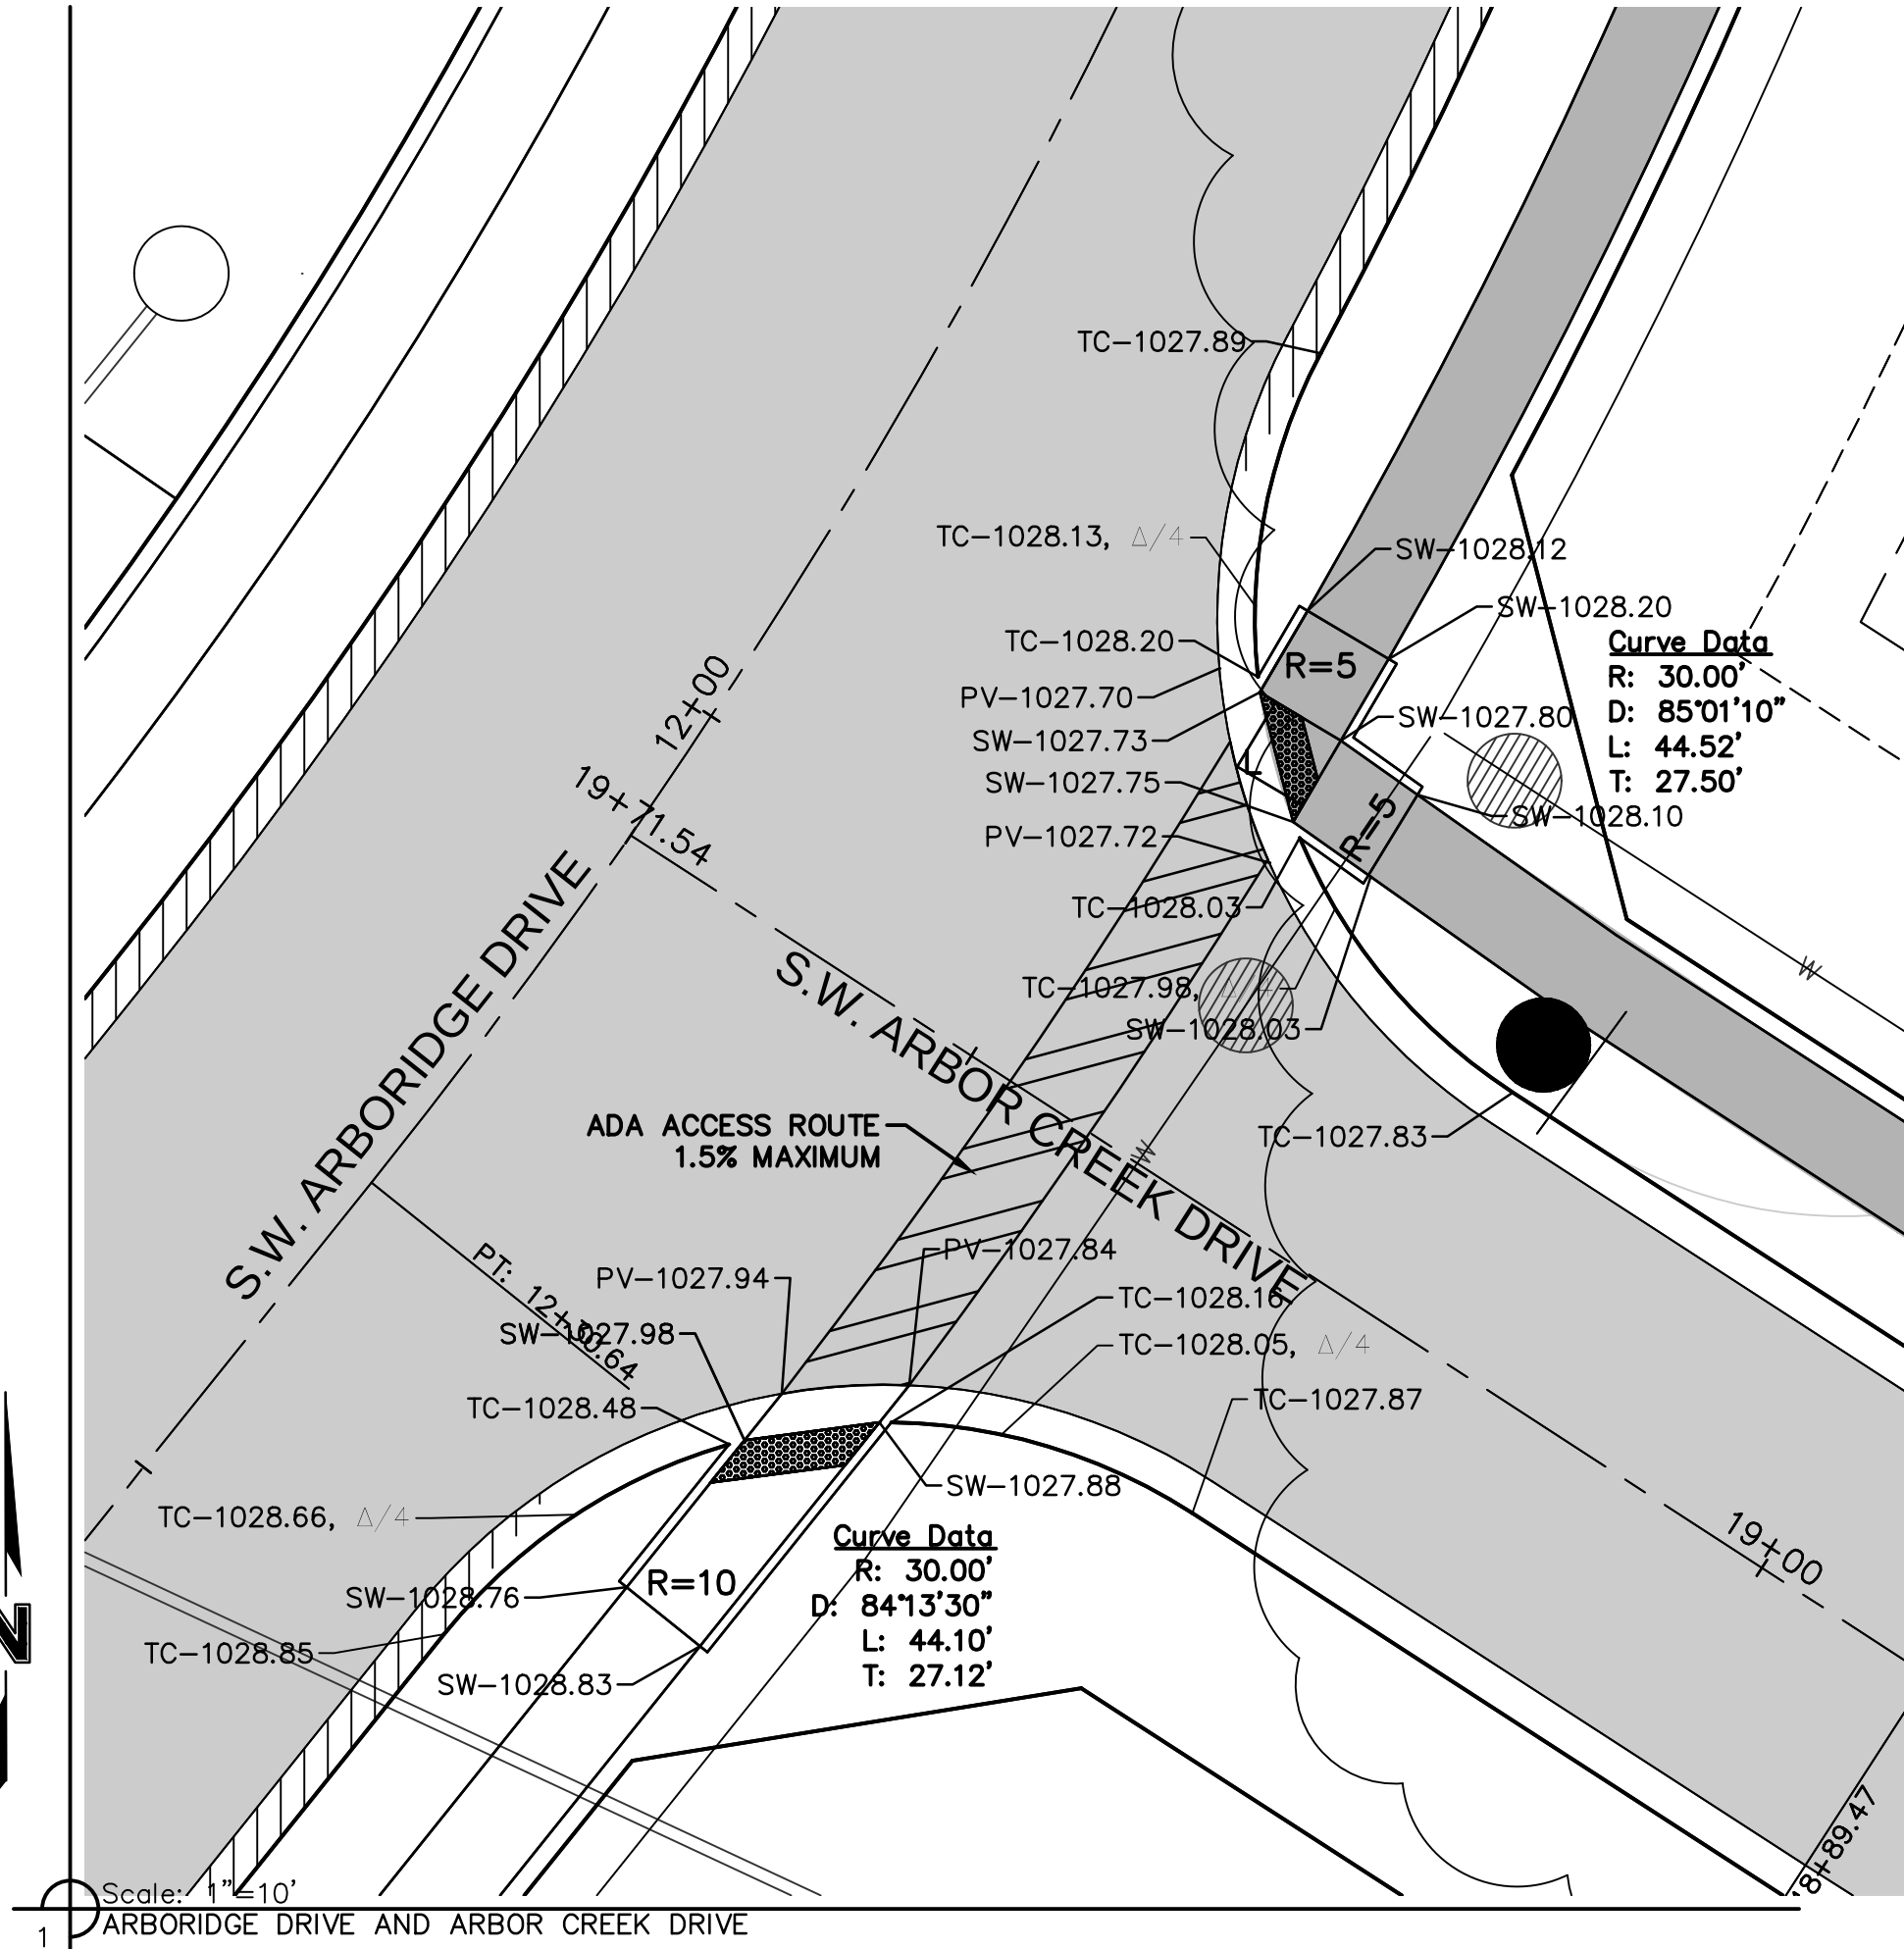

Record Drawing

OLSSON ASSOCIATES




STATE OF MISSOURI
MELISSA G. DEGENIA
Professional Engineer
No. 001000892
Exp. 04/2019

NO.	REV.	DATE	DESCRIPTION	BY
1		06/23/2017	Revised ramp elevations	MGD
2		01/08/2018	Revised Hook Road Improvements	MGD
3		02/14/2018	Revised ADA access notes	MGD
4		04/23/2018	Revised spot elevations	MGD




HAWTHORN RIDGE
1ST PLAT
LEE'S SUMMIT, MO
2018
SHEET C115

USER: dhernandez

DWG: F:\2017\0001-0500\017-0188\40-Design\AutoCAD\Final Plans\ASBUILTS\CONV\01_Street & Storm_36x24\C_SPT03_017-0188.dwg
DATE: Feb 19, 2019 6:05pm

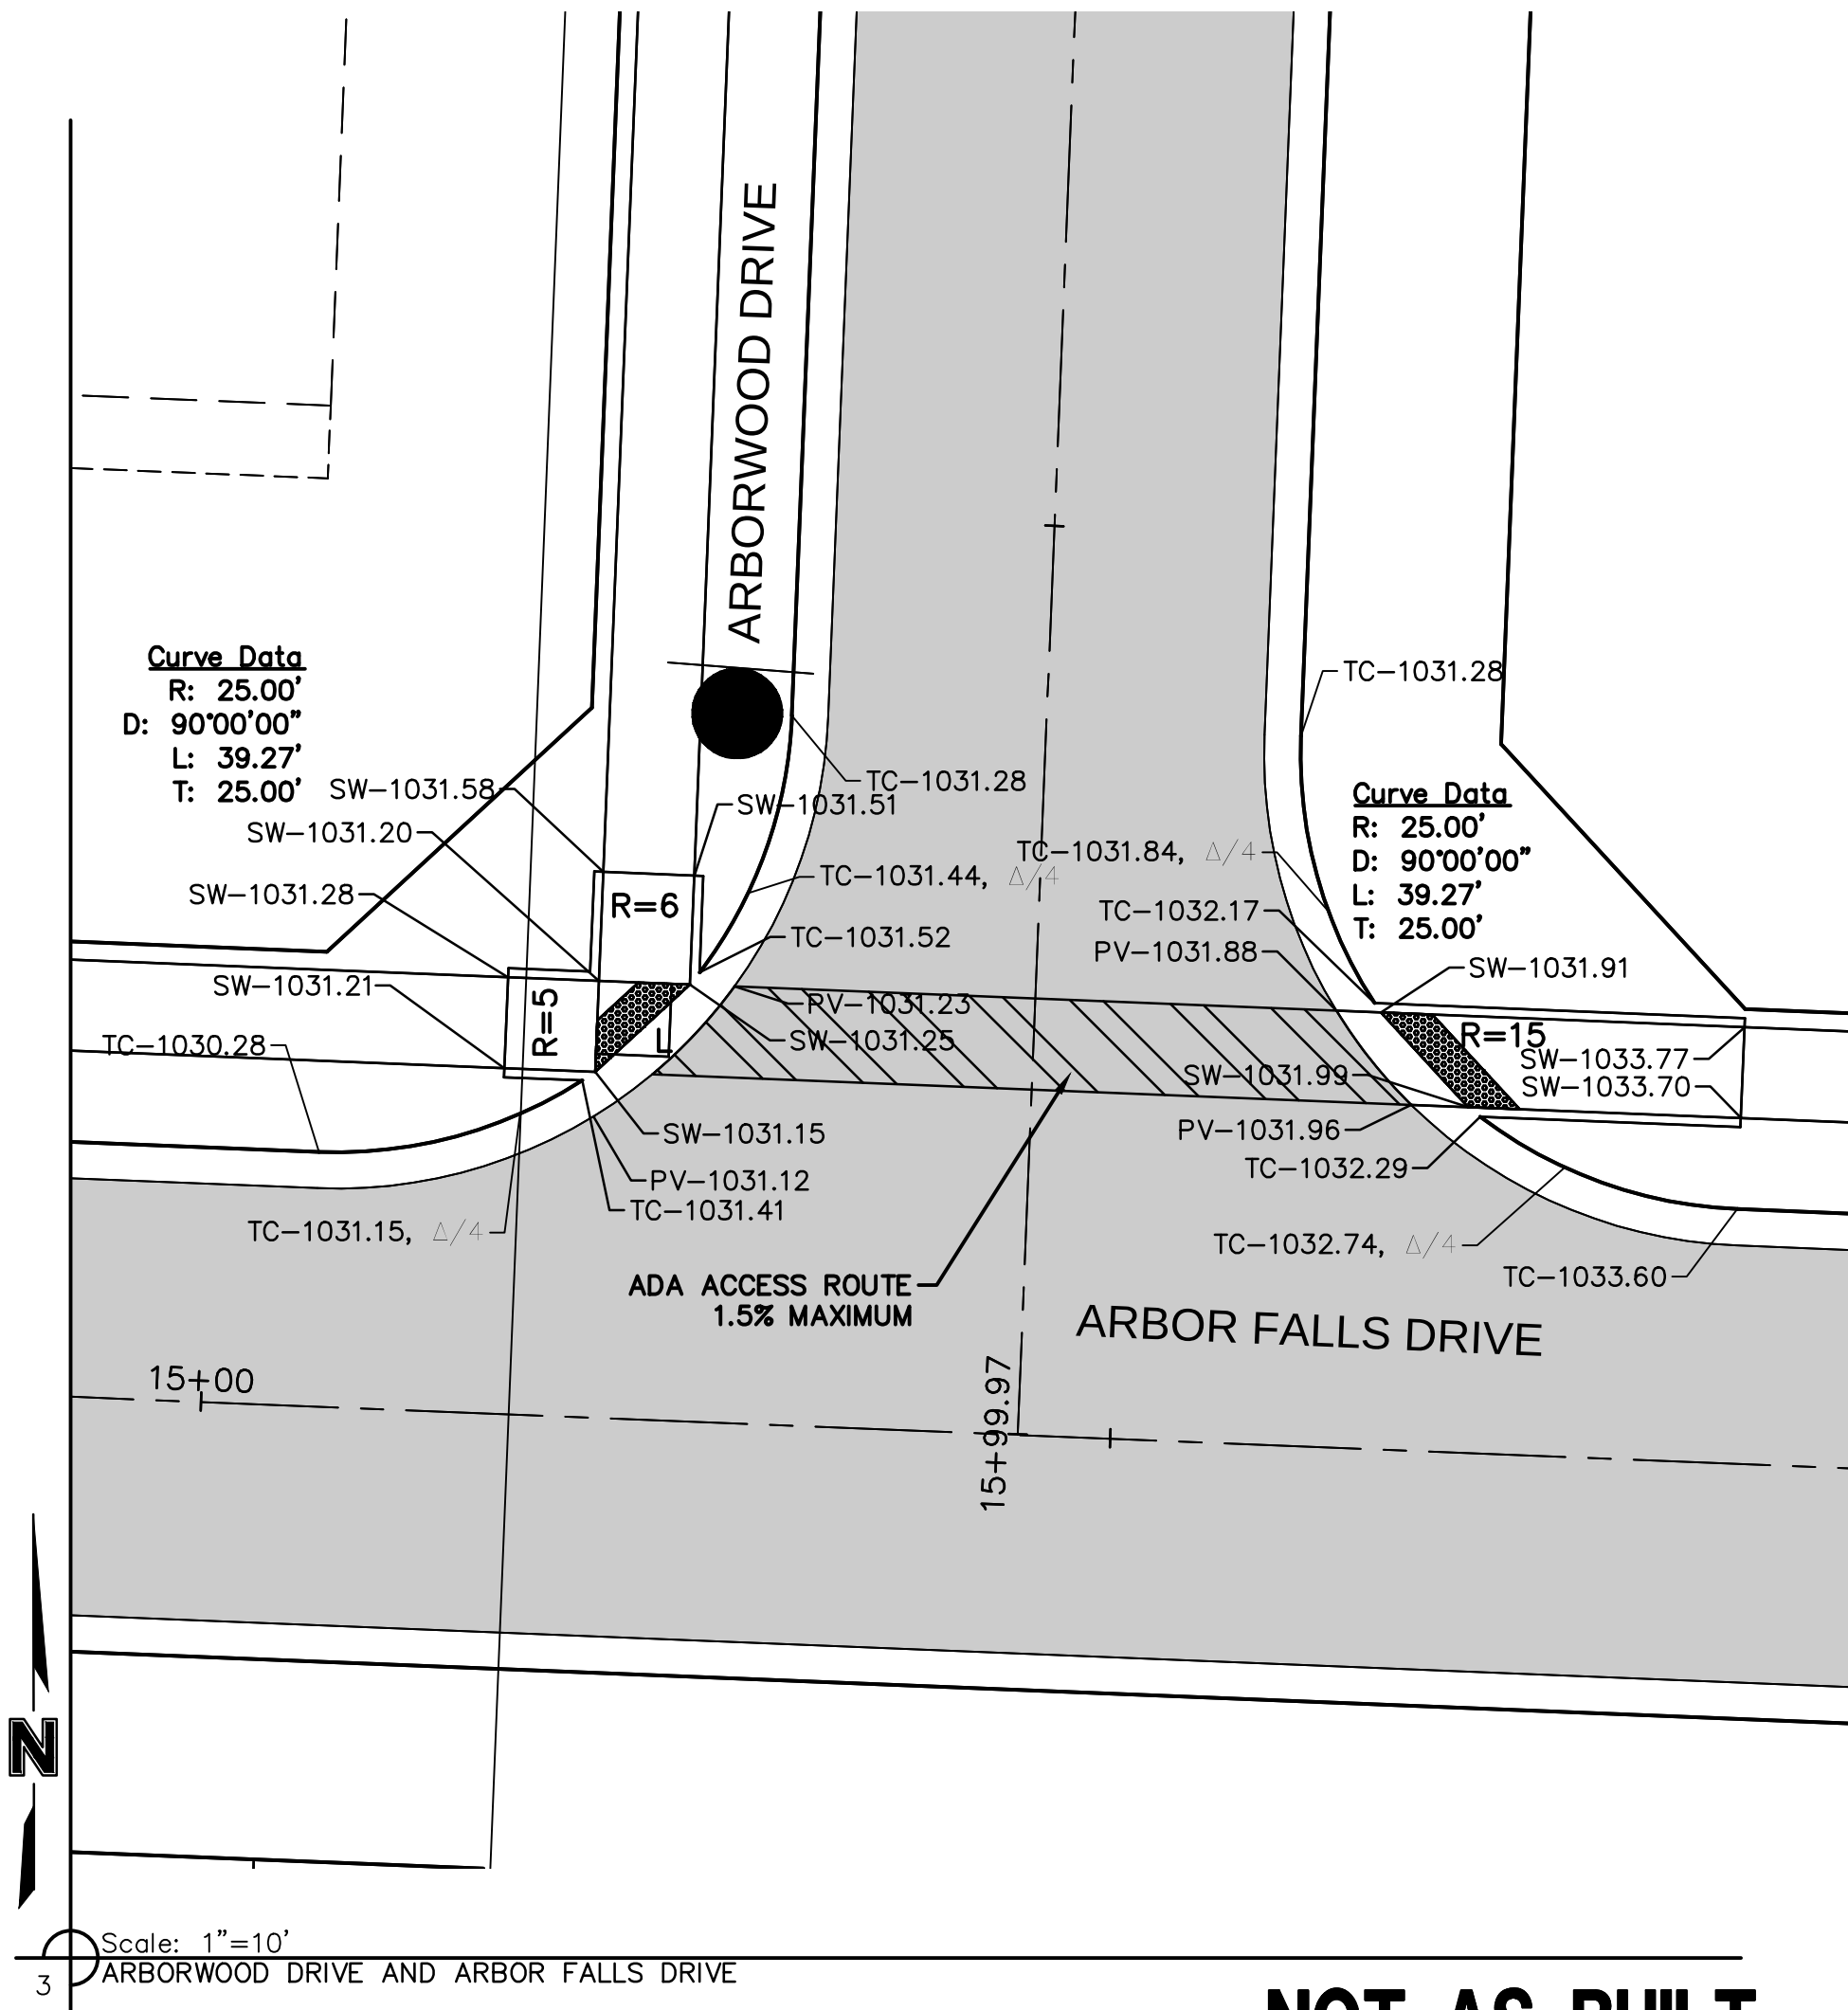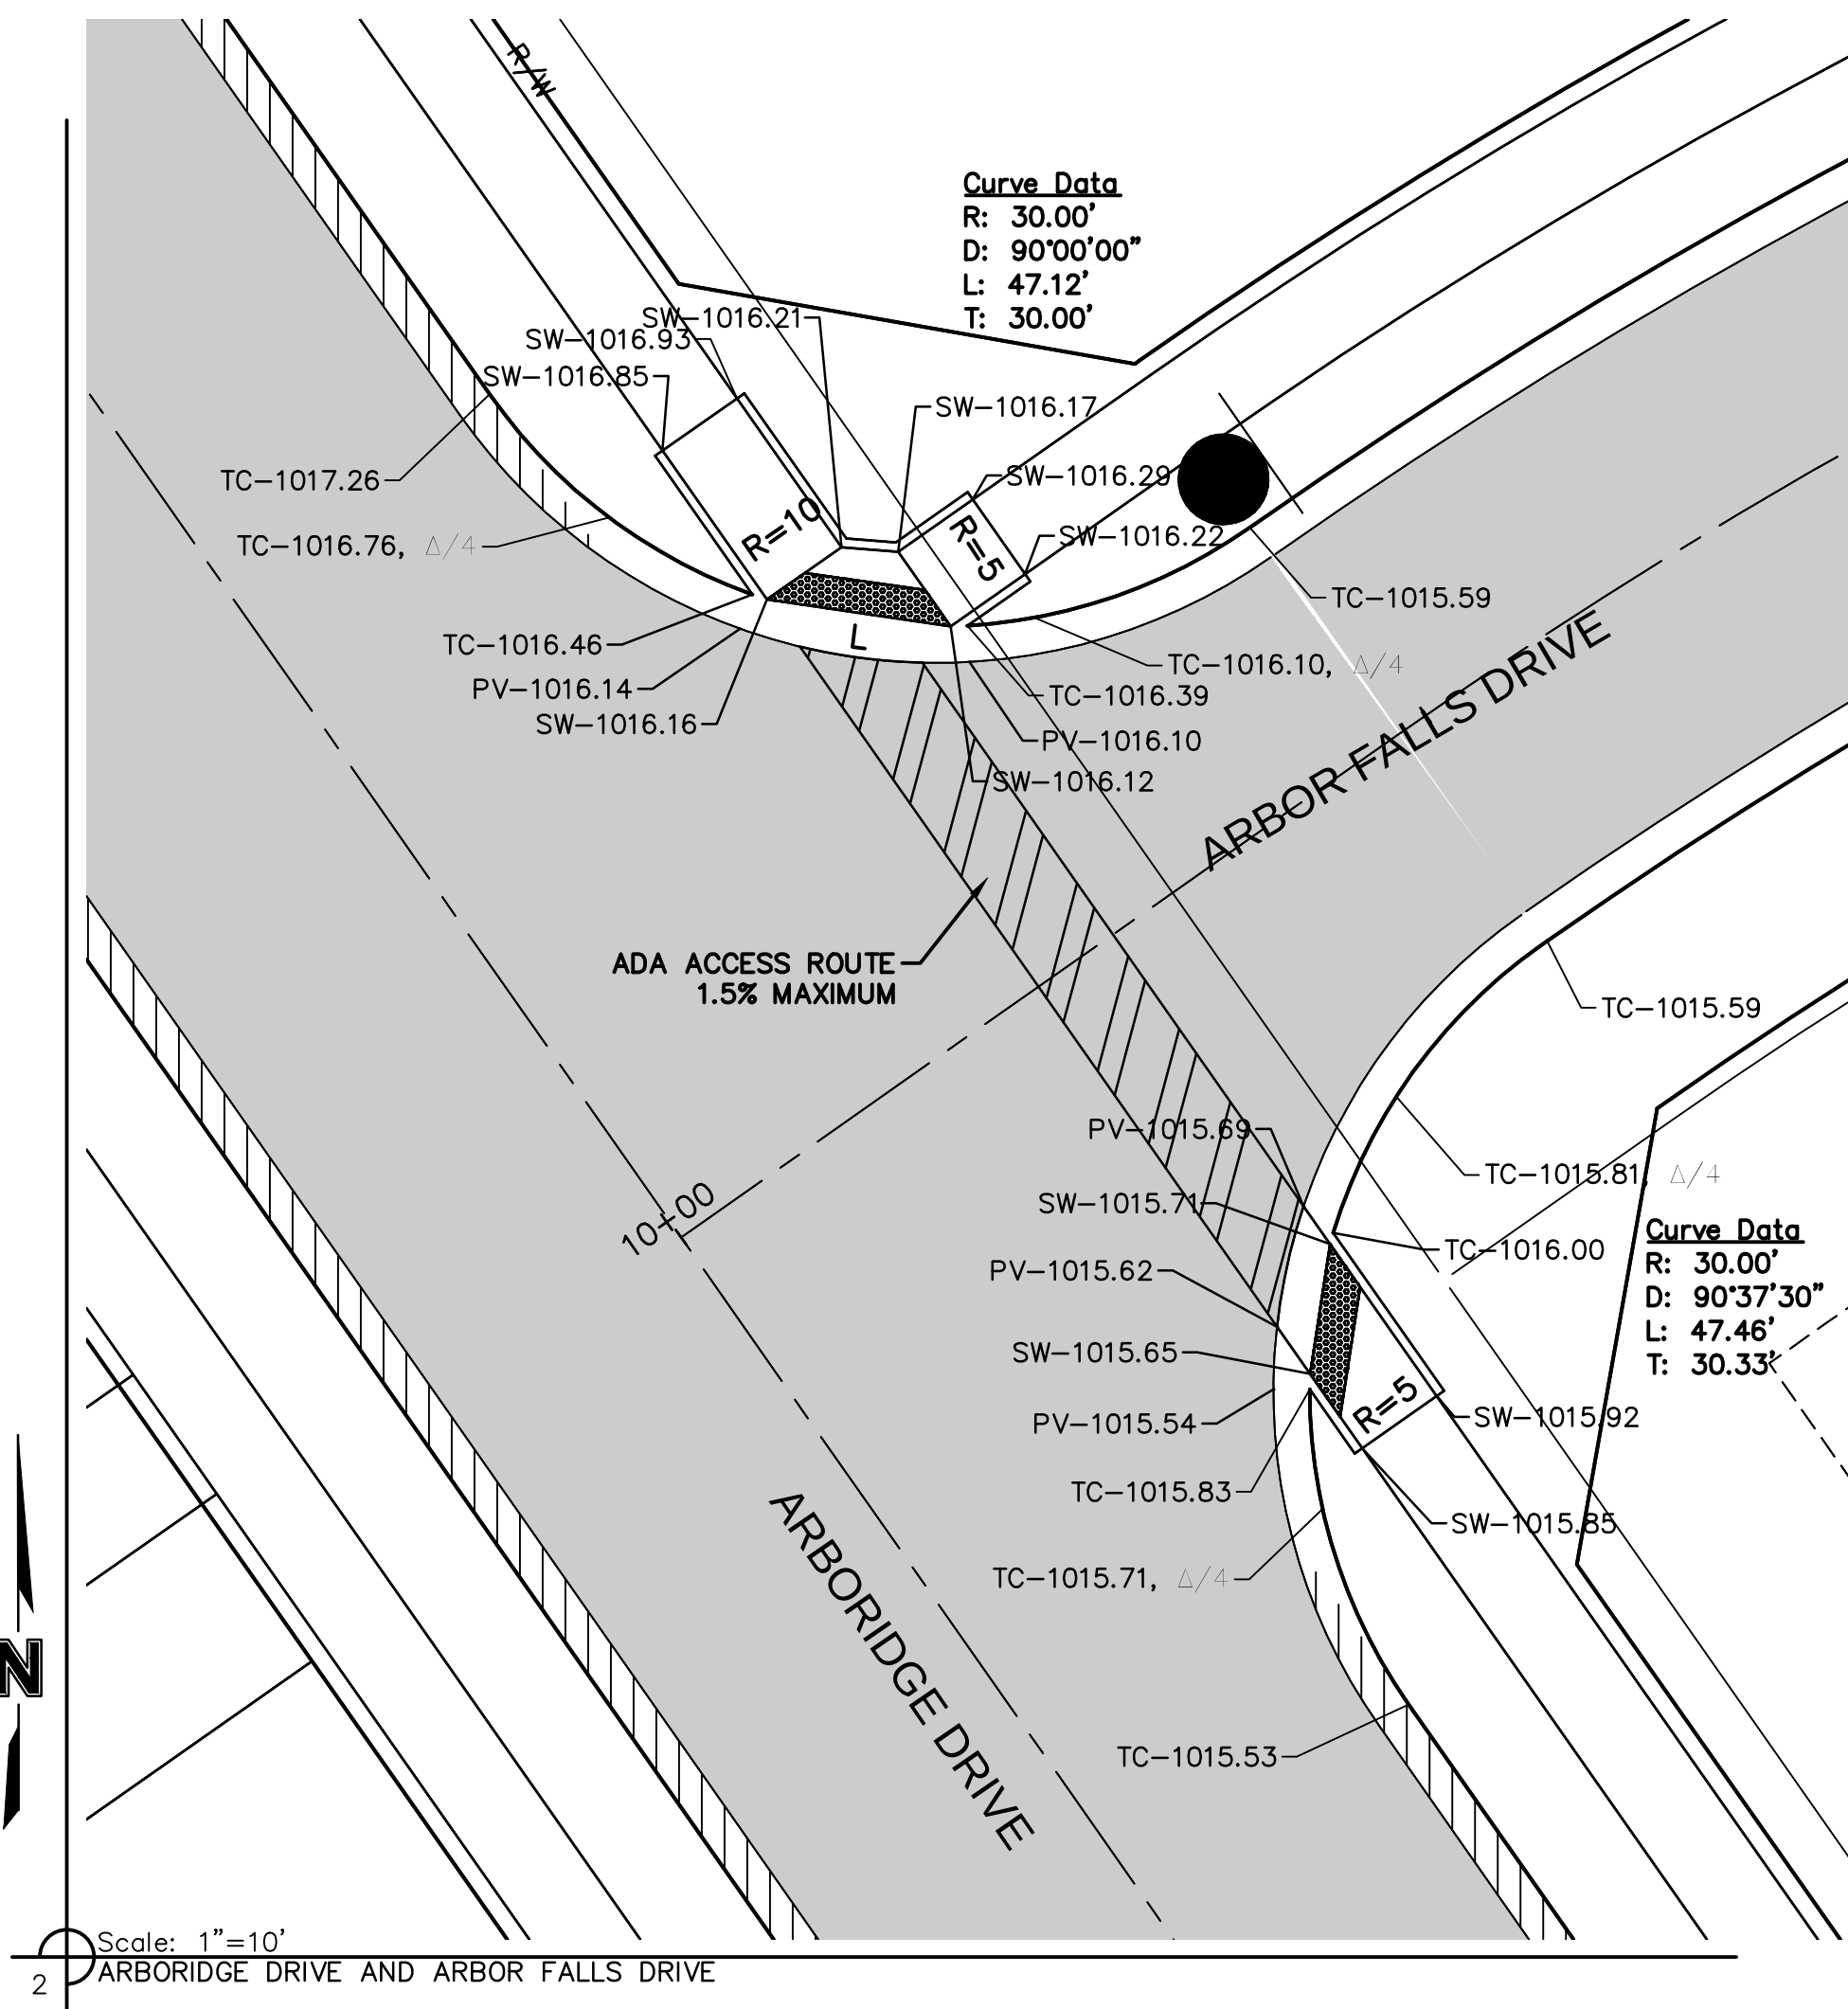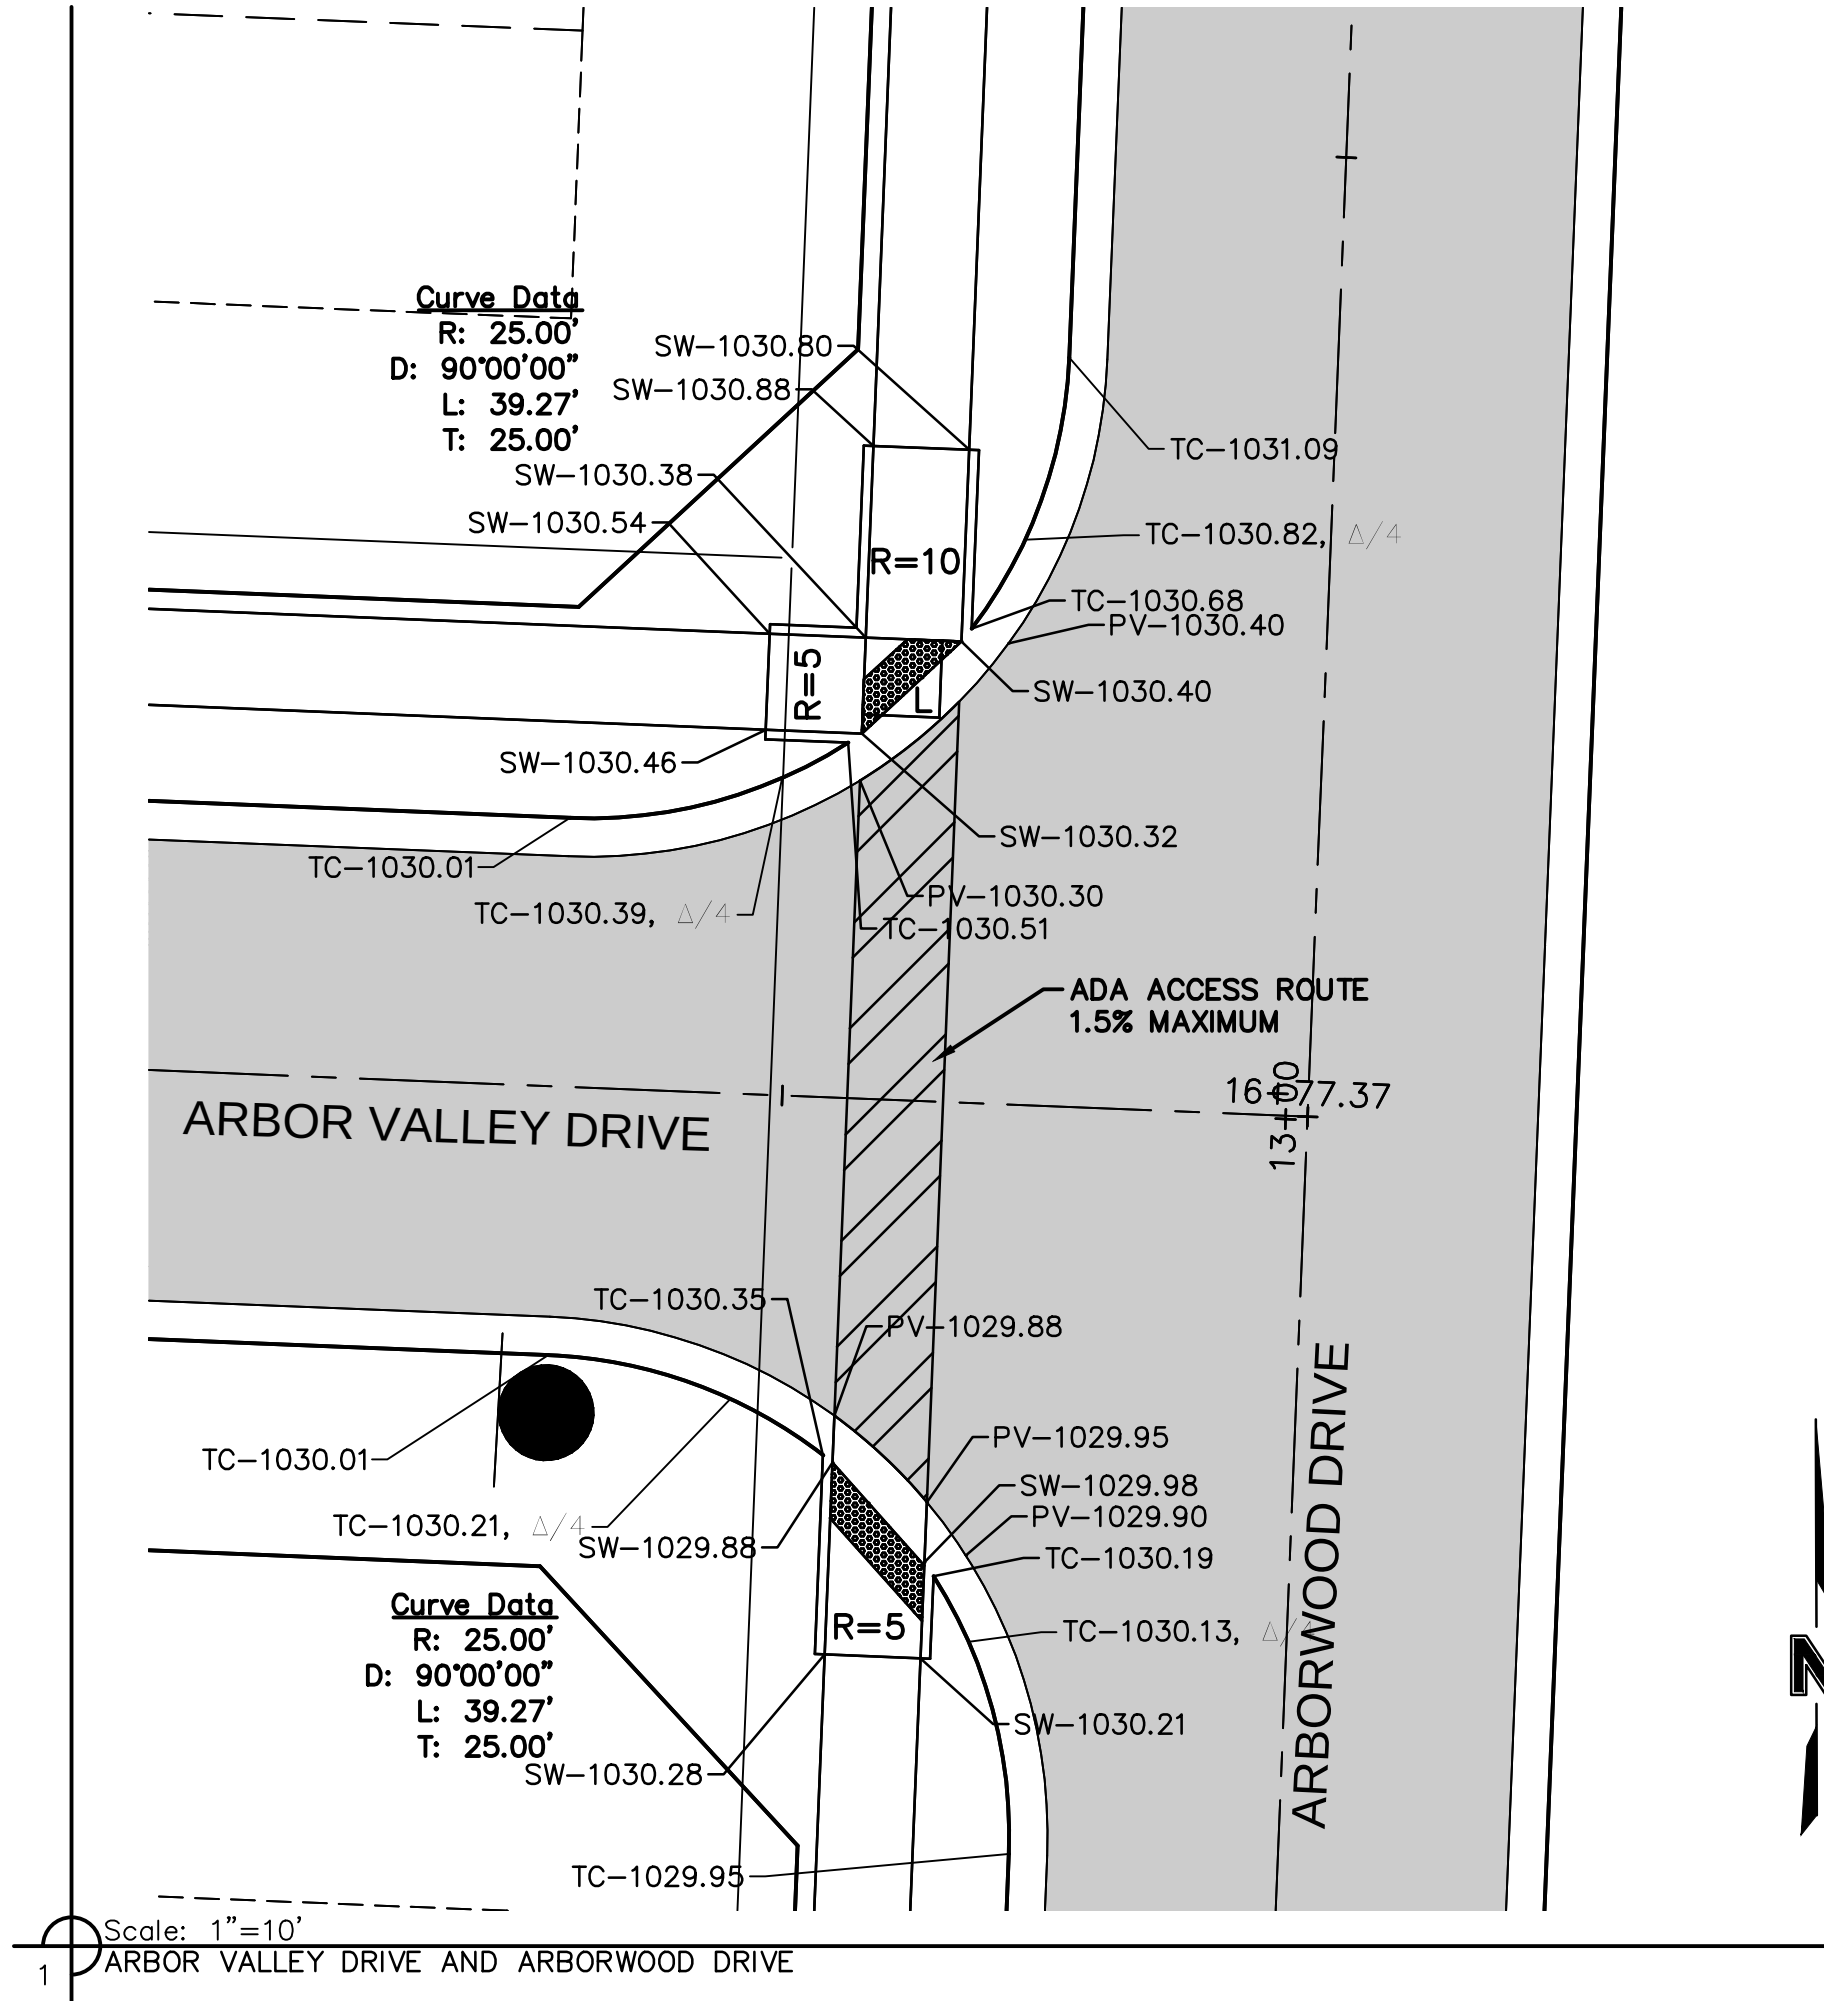

NOT AS BUILT

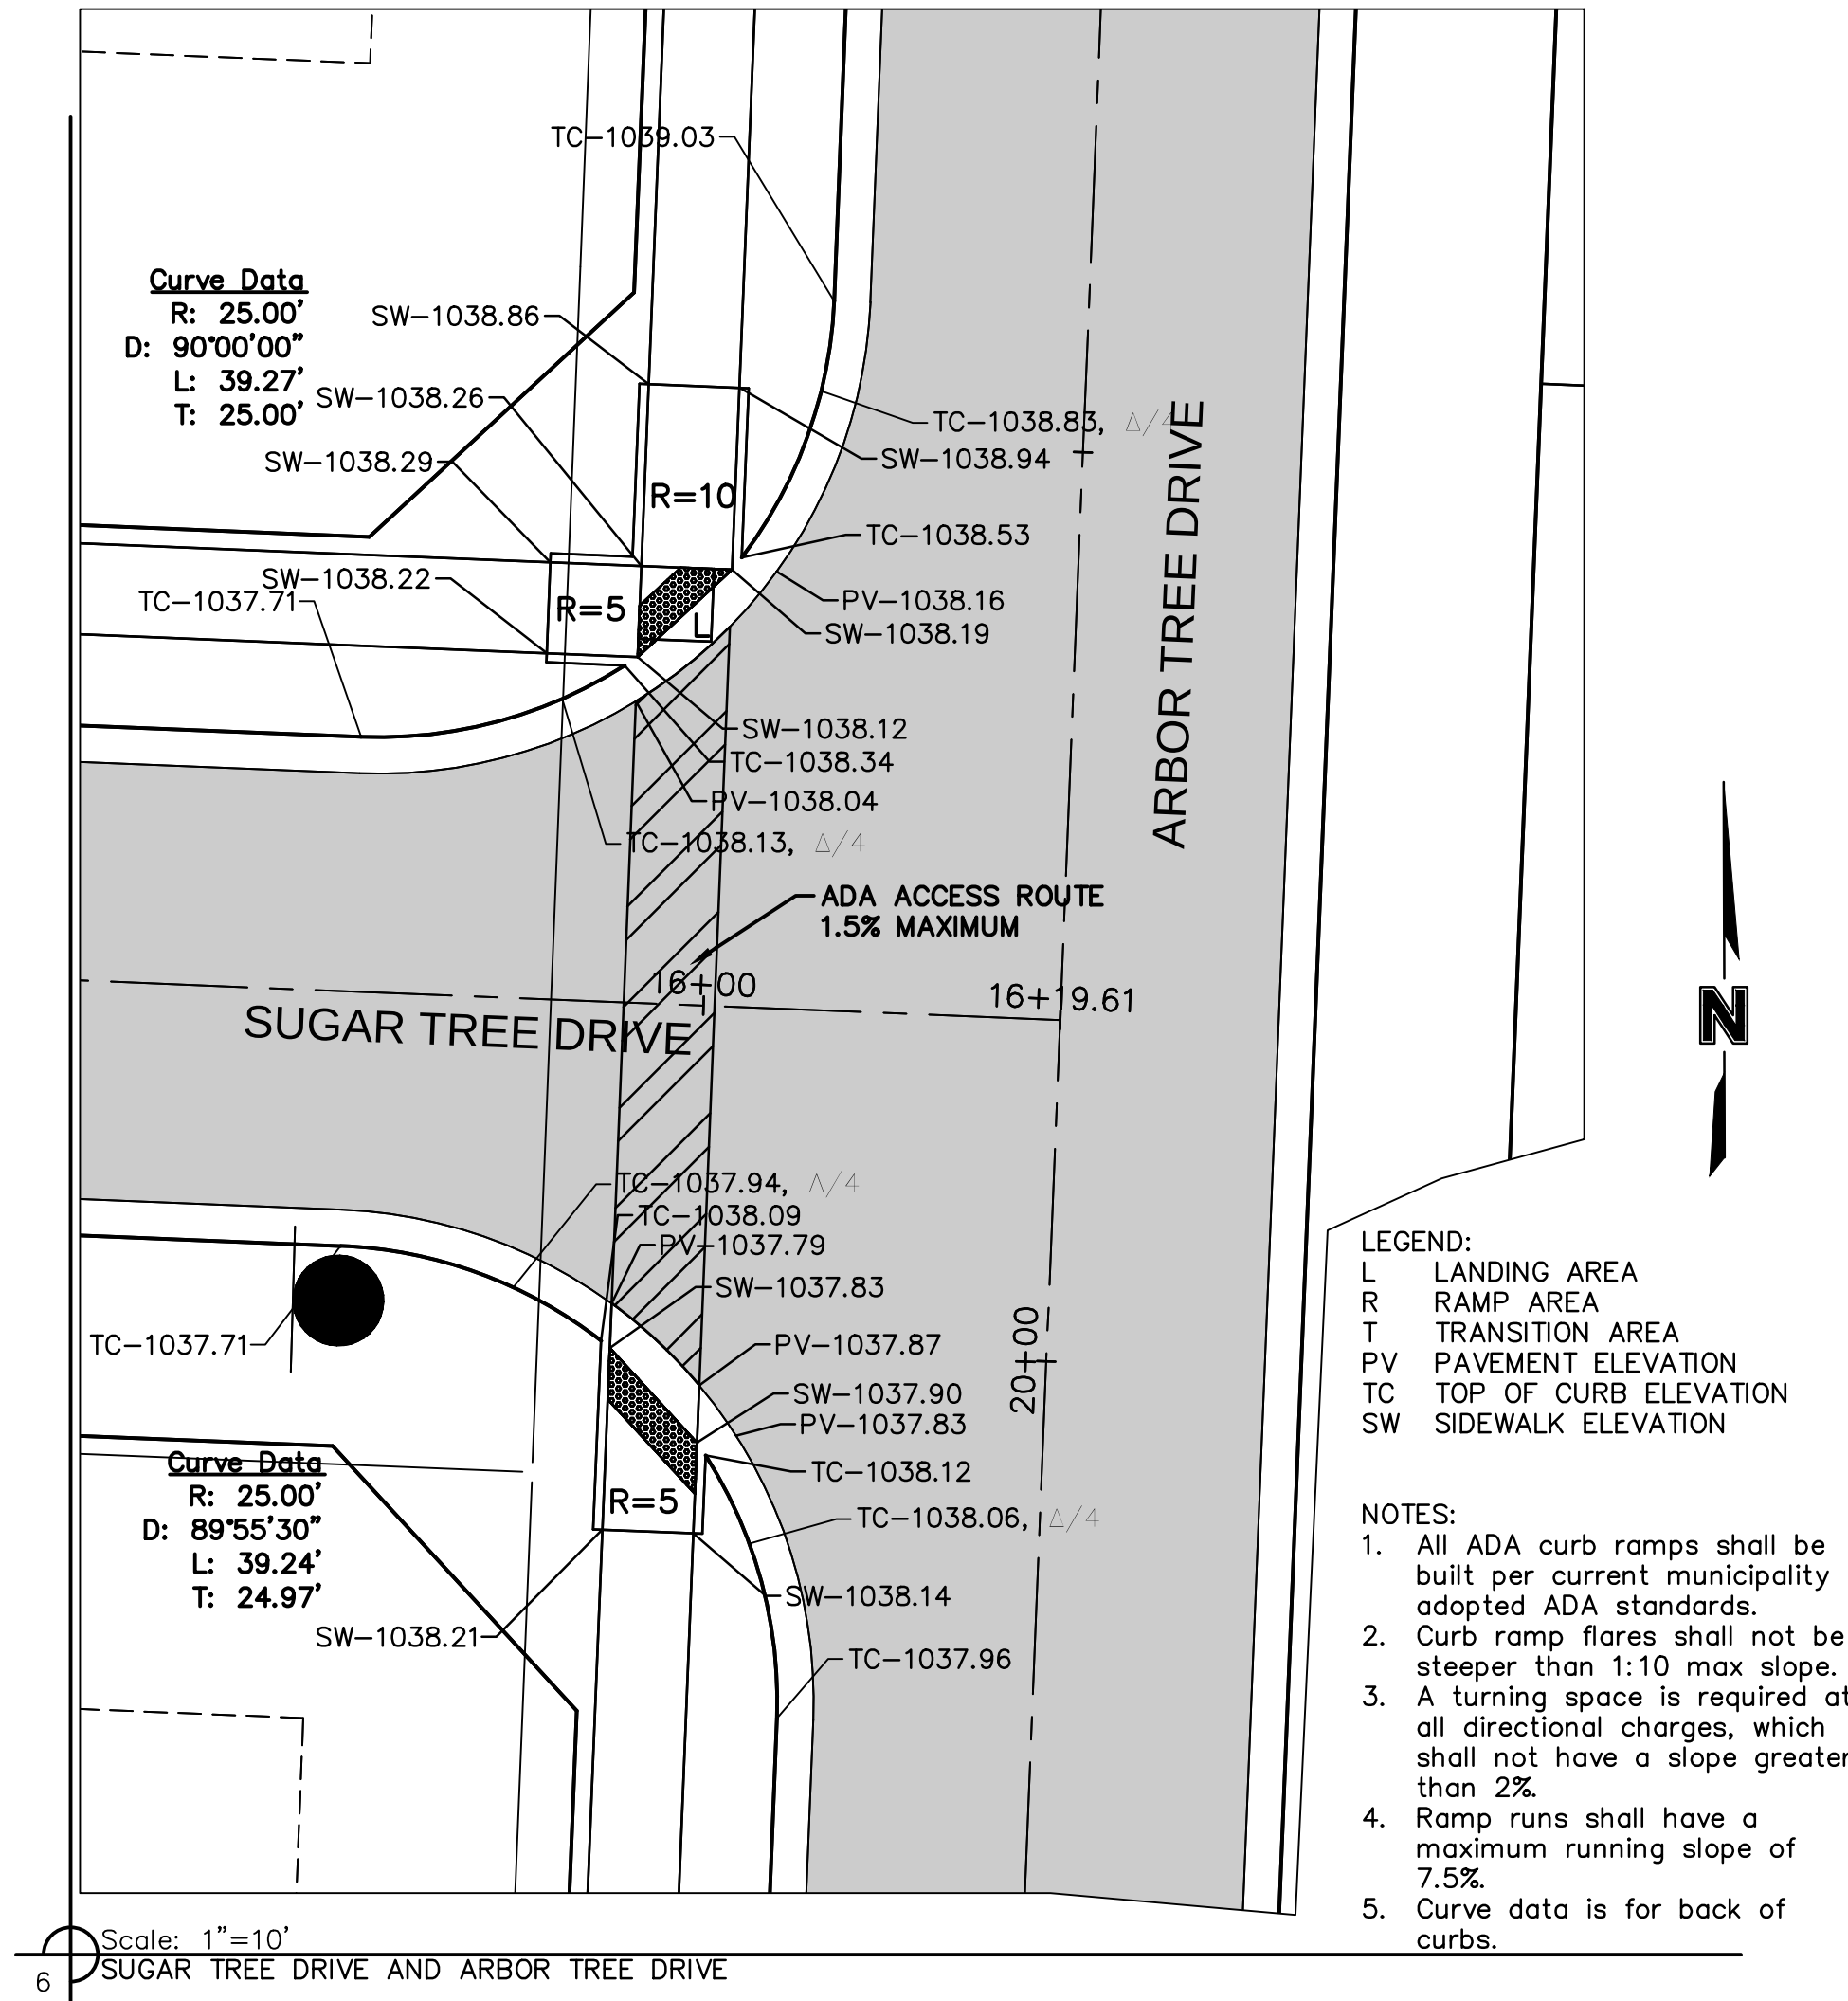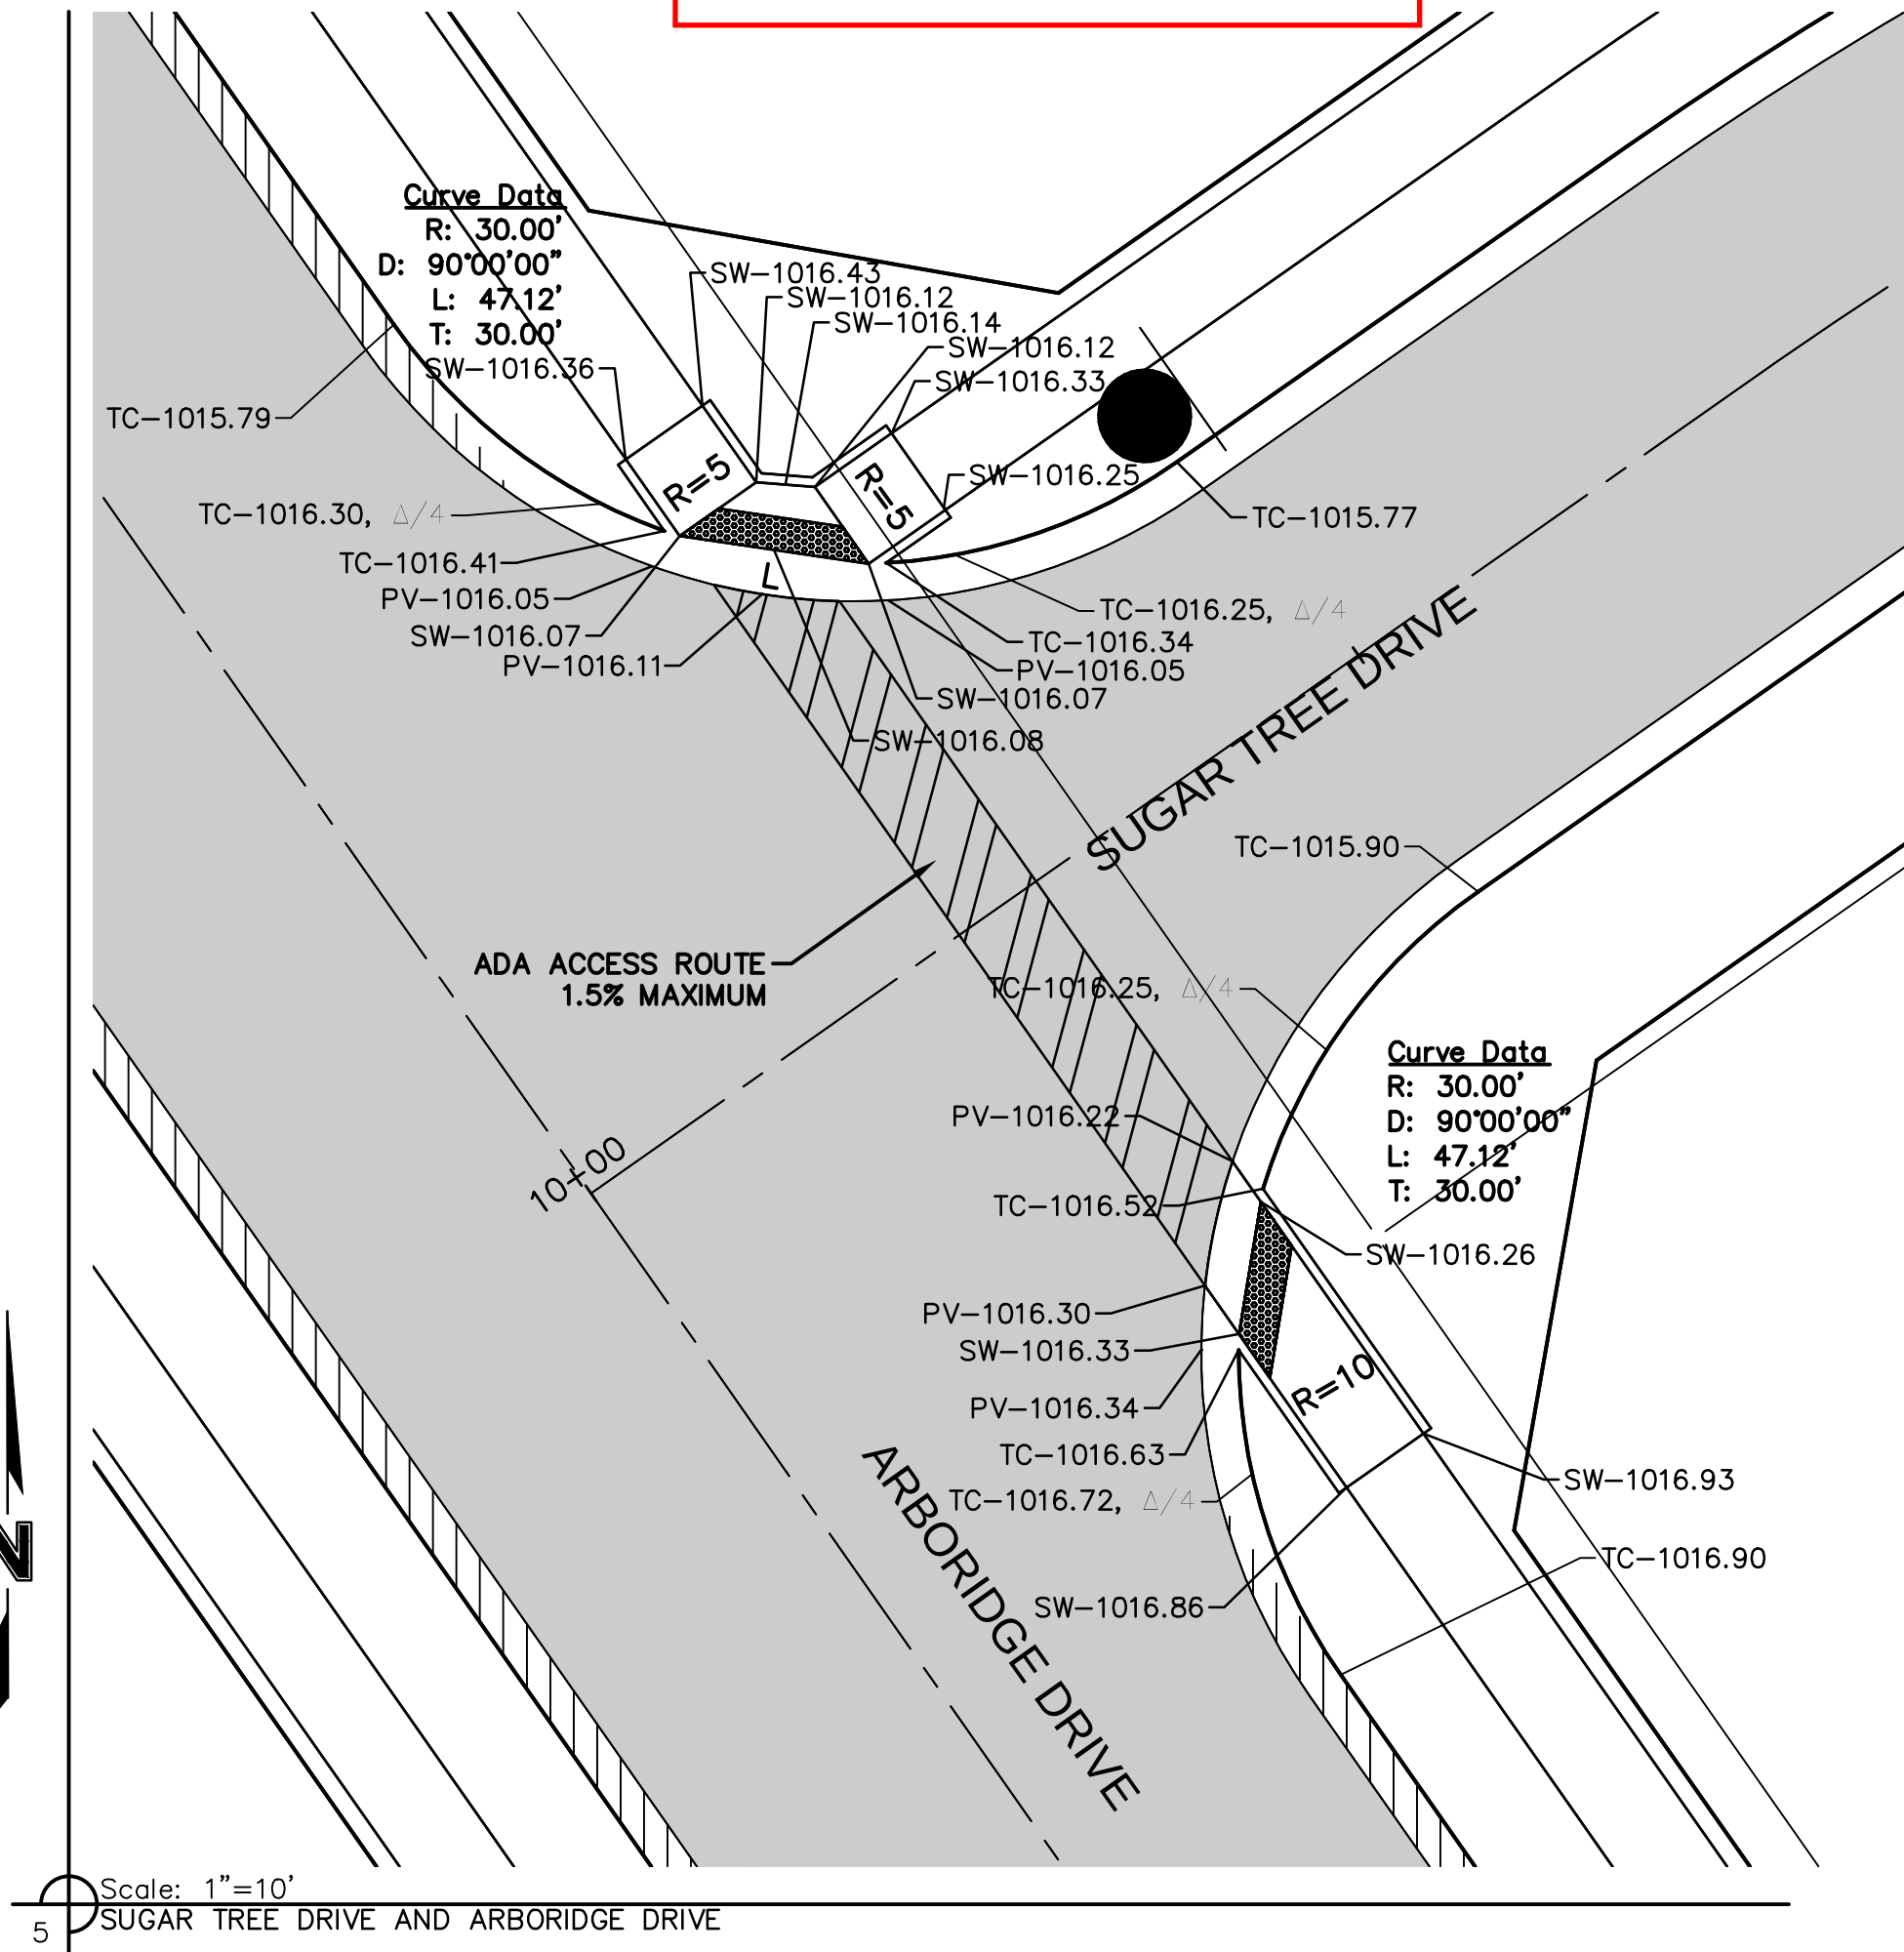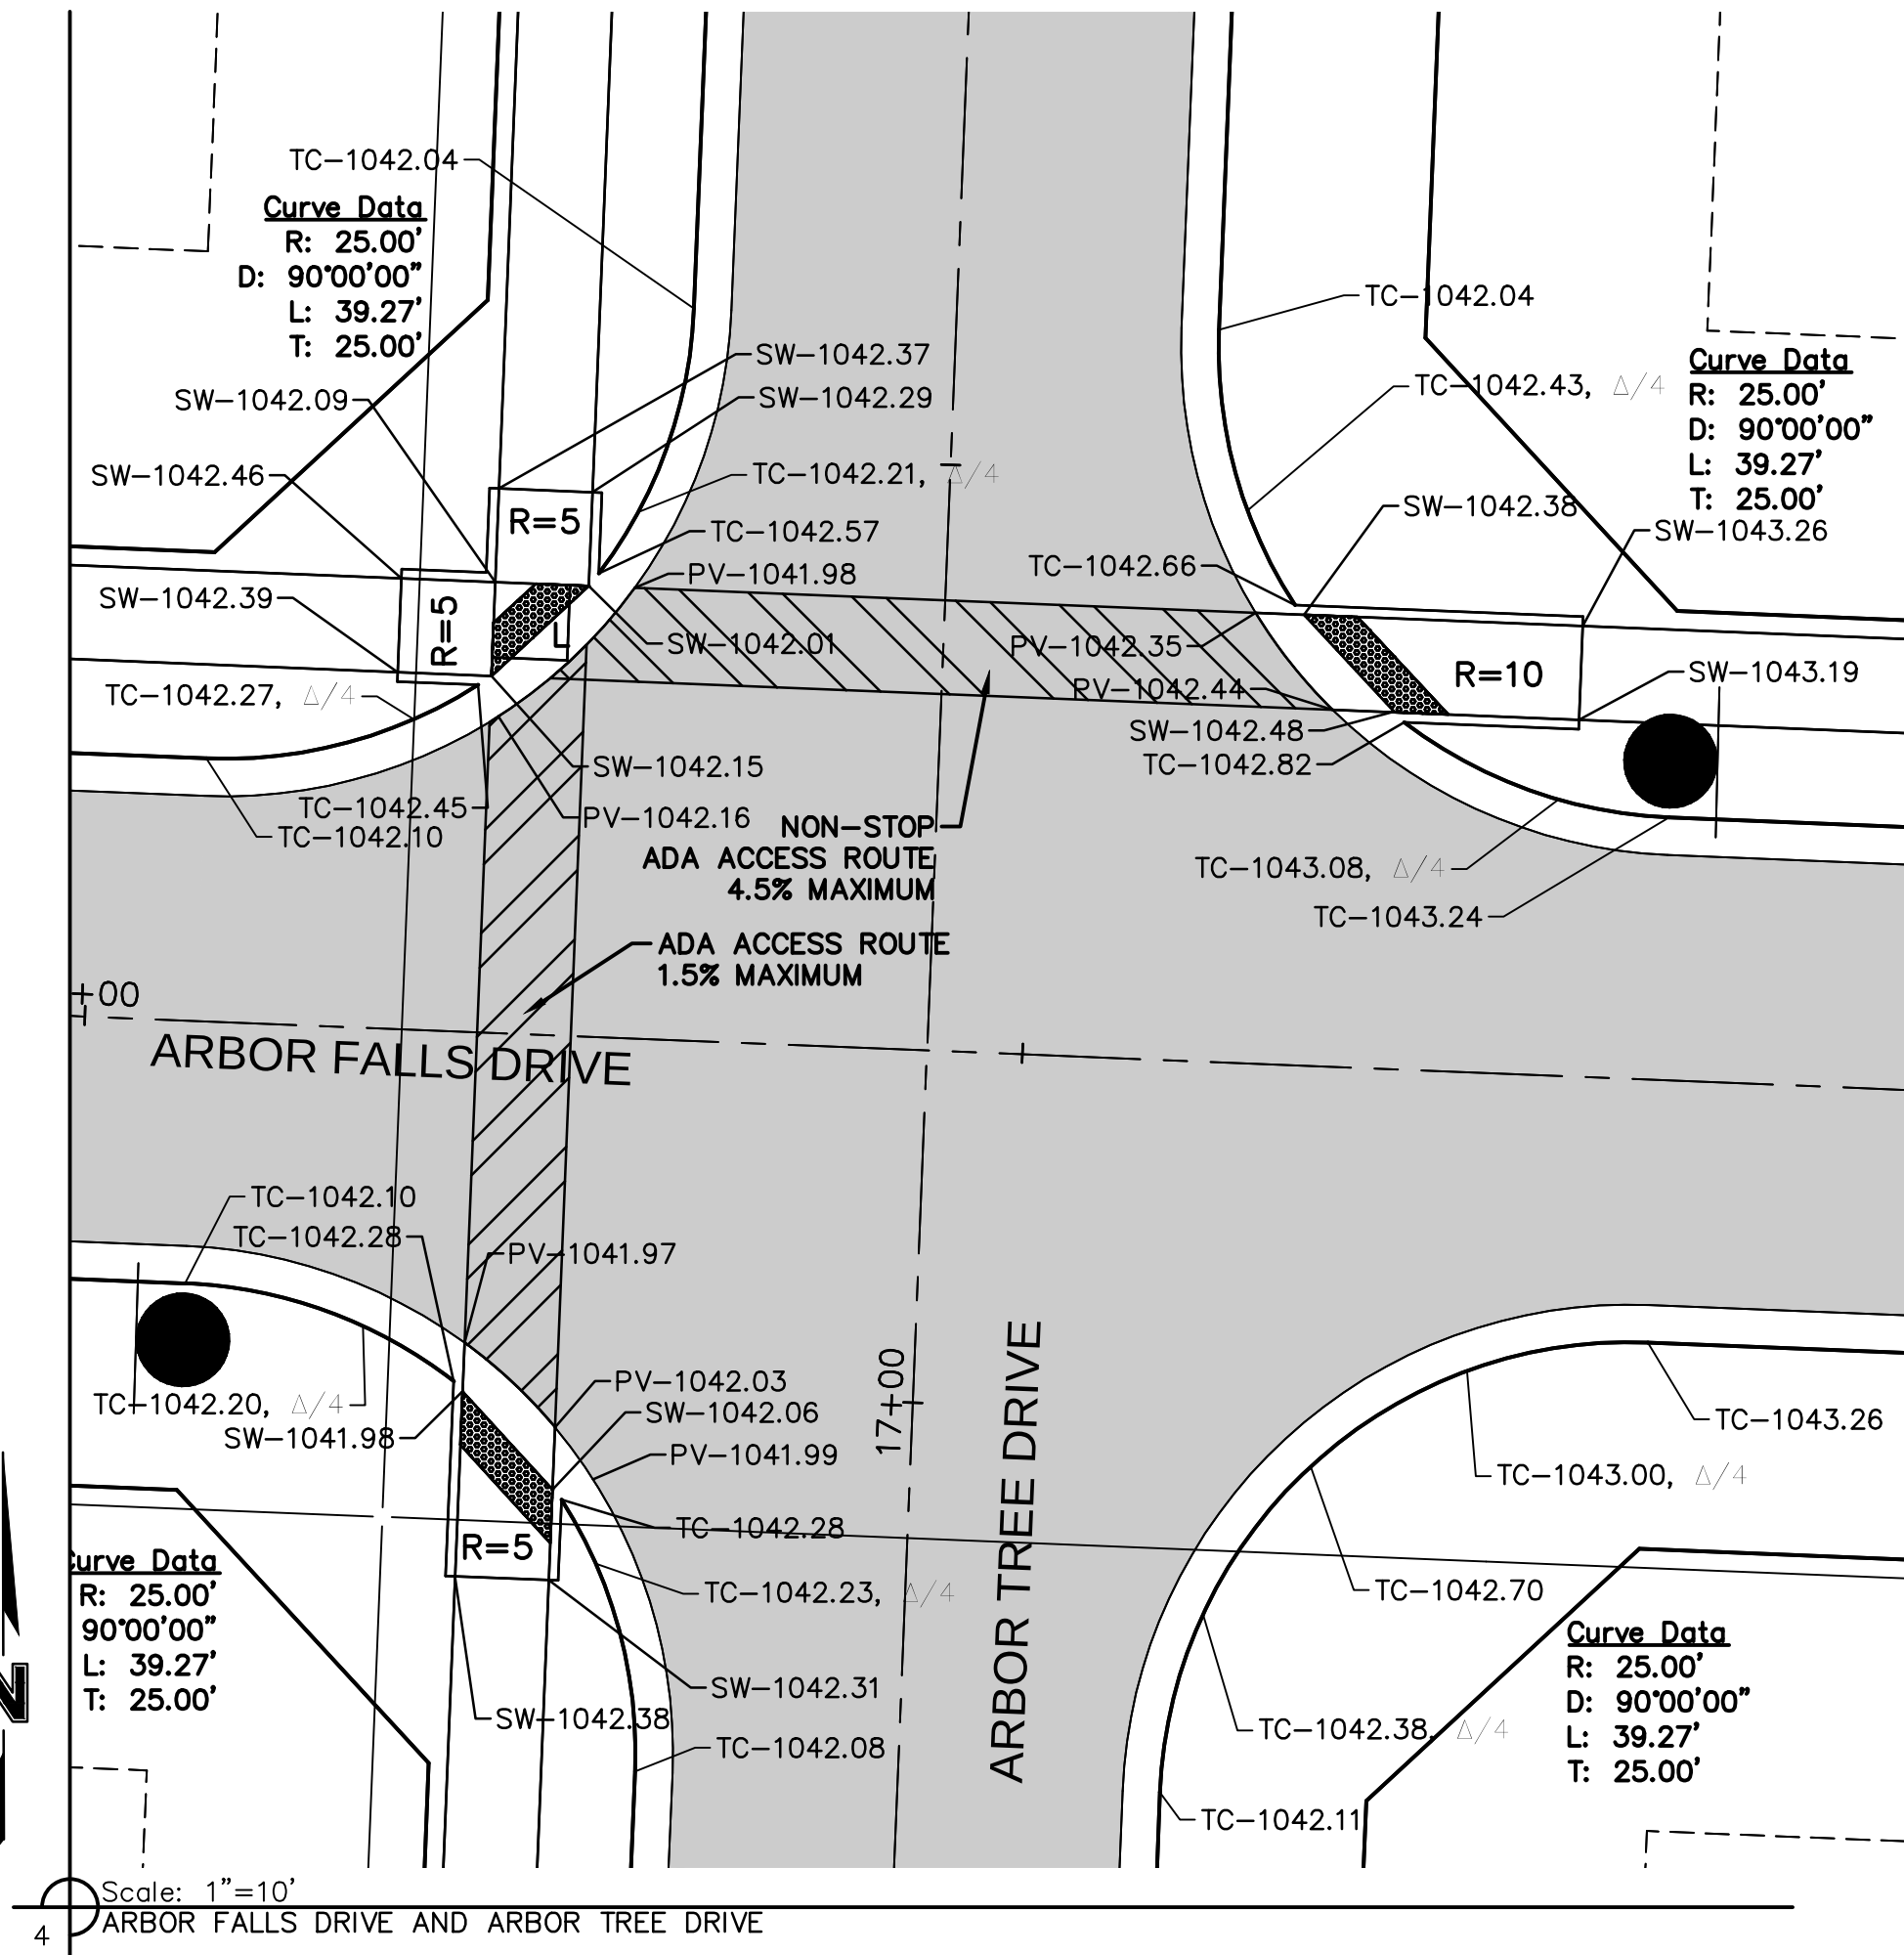

LEGEND:
L LANDING AREA
R RAMP AREA
T TRANSITION AREA
PV PAVEMENT ELEVATION
TC TOP OF CURB ELEVATION
SW SIDEWALK ELEVATION


NOTES:
1. All ADA curb ramps shall be built per current municipality adopted ADA standards.
2. Curb ramp flares shall not be steeper than 1:10 max slope.
3. A turning space is required at all directional changes, which shall not have a slope greater than 2%.
4. Ramp runs shall have a maximum running slope of 7.5%.
5. Curve data is for back of curbs.

OLSSON ASSOCIATES

MELISSA G. DEGENIA
Professional Engineer
No. 001000892
Exp. 04/2019





NO.	REV.	DATE	DESCRIPTION	BY	MGD	MGD
2		06.23.2017	Revised utility elevations			
5		02.14.2018	Revised ADA access notes			

HAWTHORN RIDGE 1ST PLAT			2018
LEE'S SUMMIT, MO			
SHEET C116			

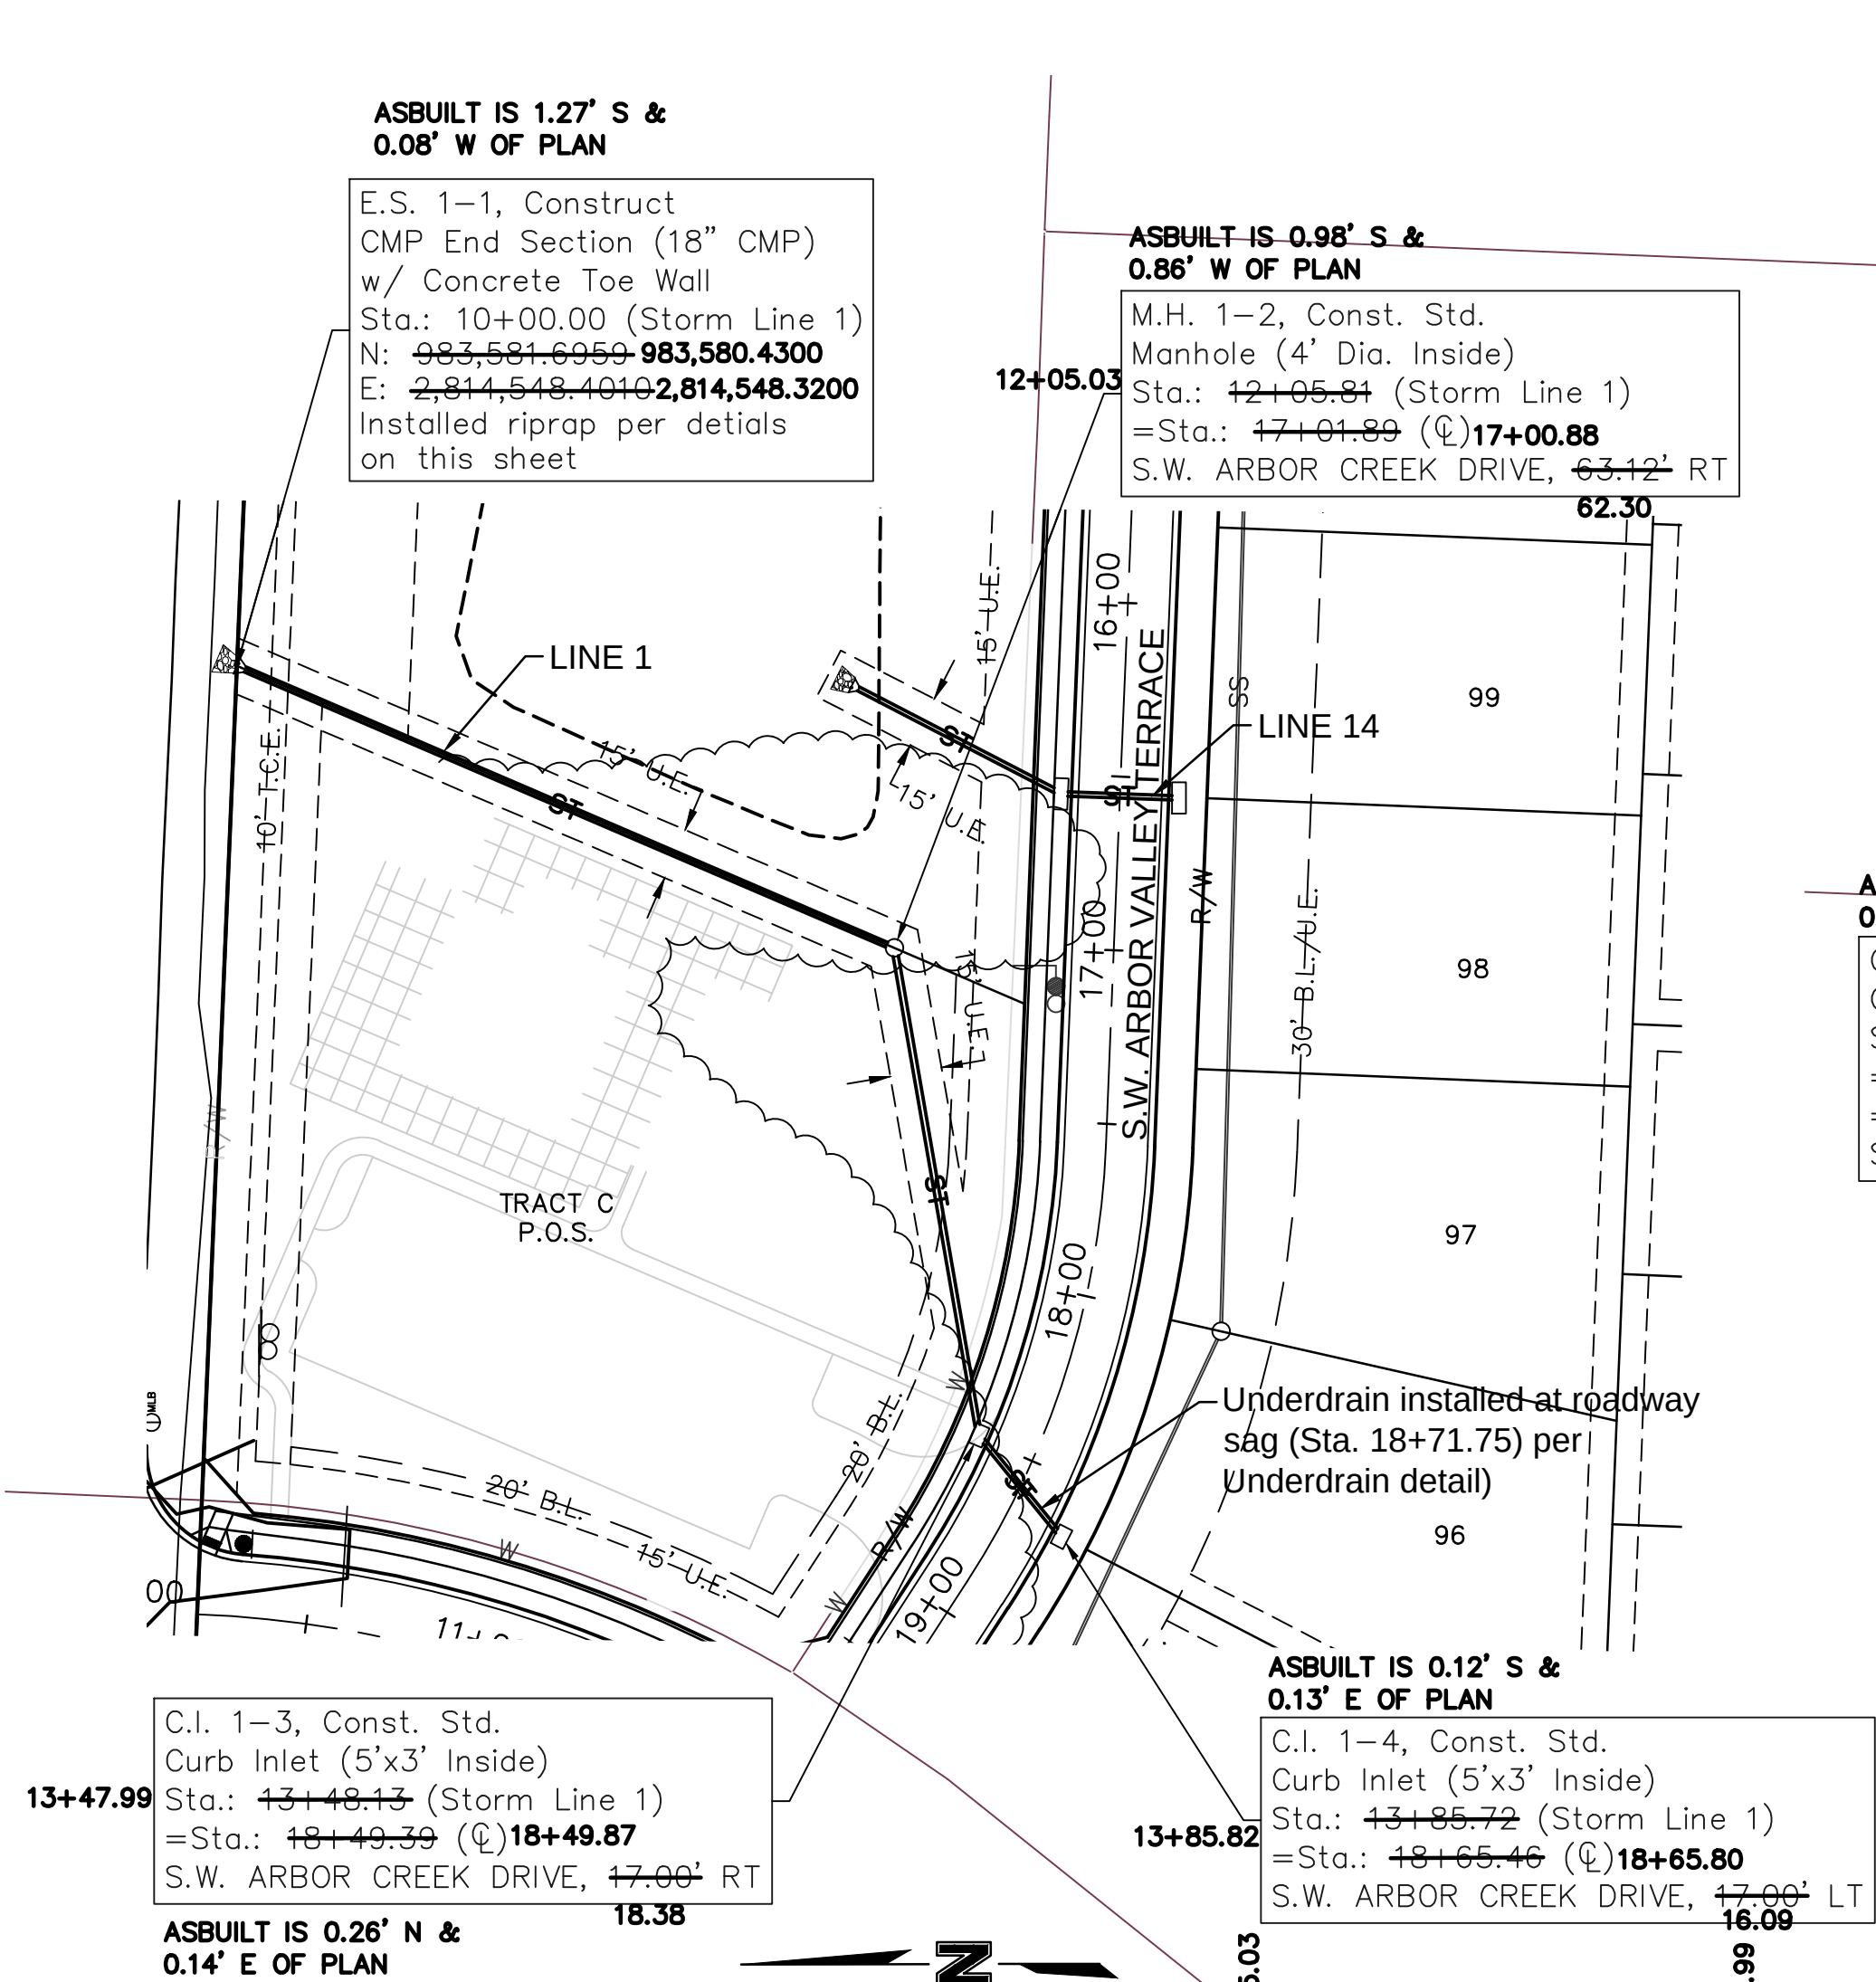

Riprap Calculations								
Structure	Discharge Flow (cfs)	Pipe Diameter (ft)	Class*	D50* (in)	Apron Length (ft)	Apron Depth (ft)	Apron Width (ft)	Area (SY)
E.S. 1-1	7.63	1.5	1.00	5.00	6	1.46	8.50	4.32

*Per Table 10.1 HEC 14-FHWA-Energy Dissipators Pg. 10-18

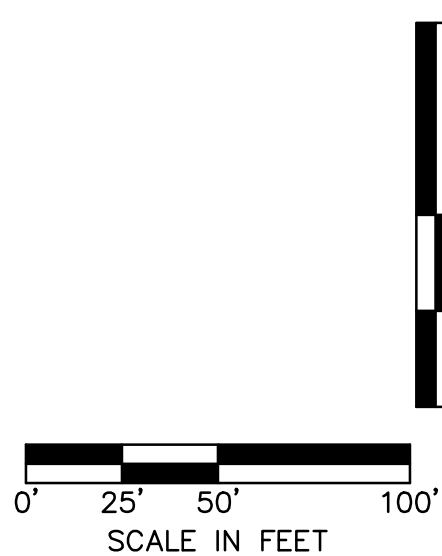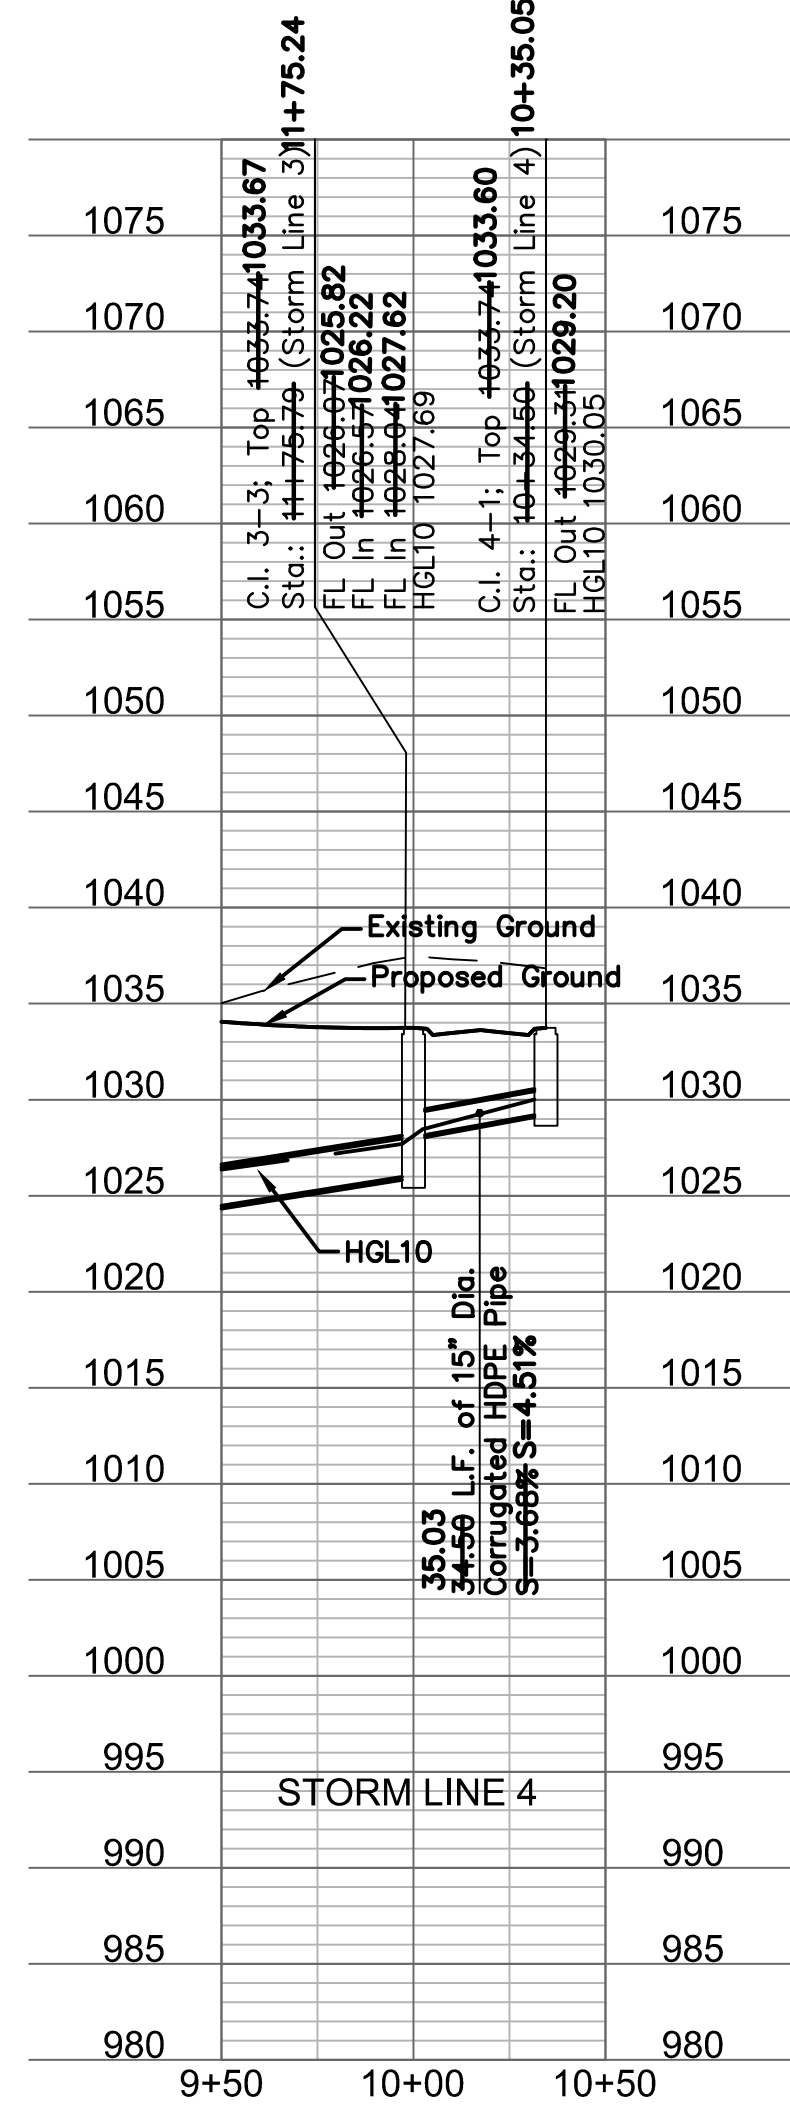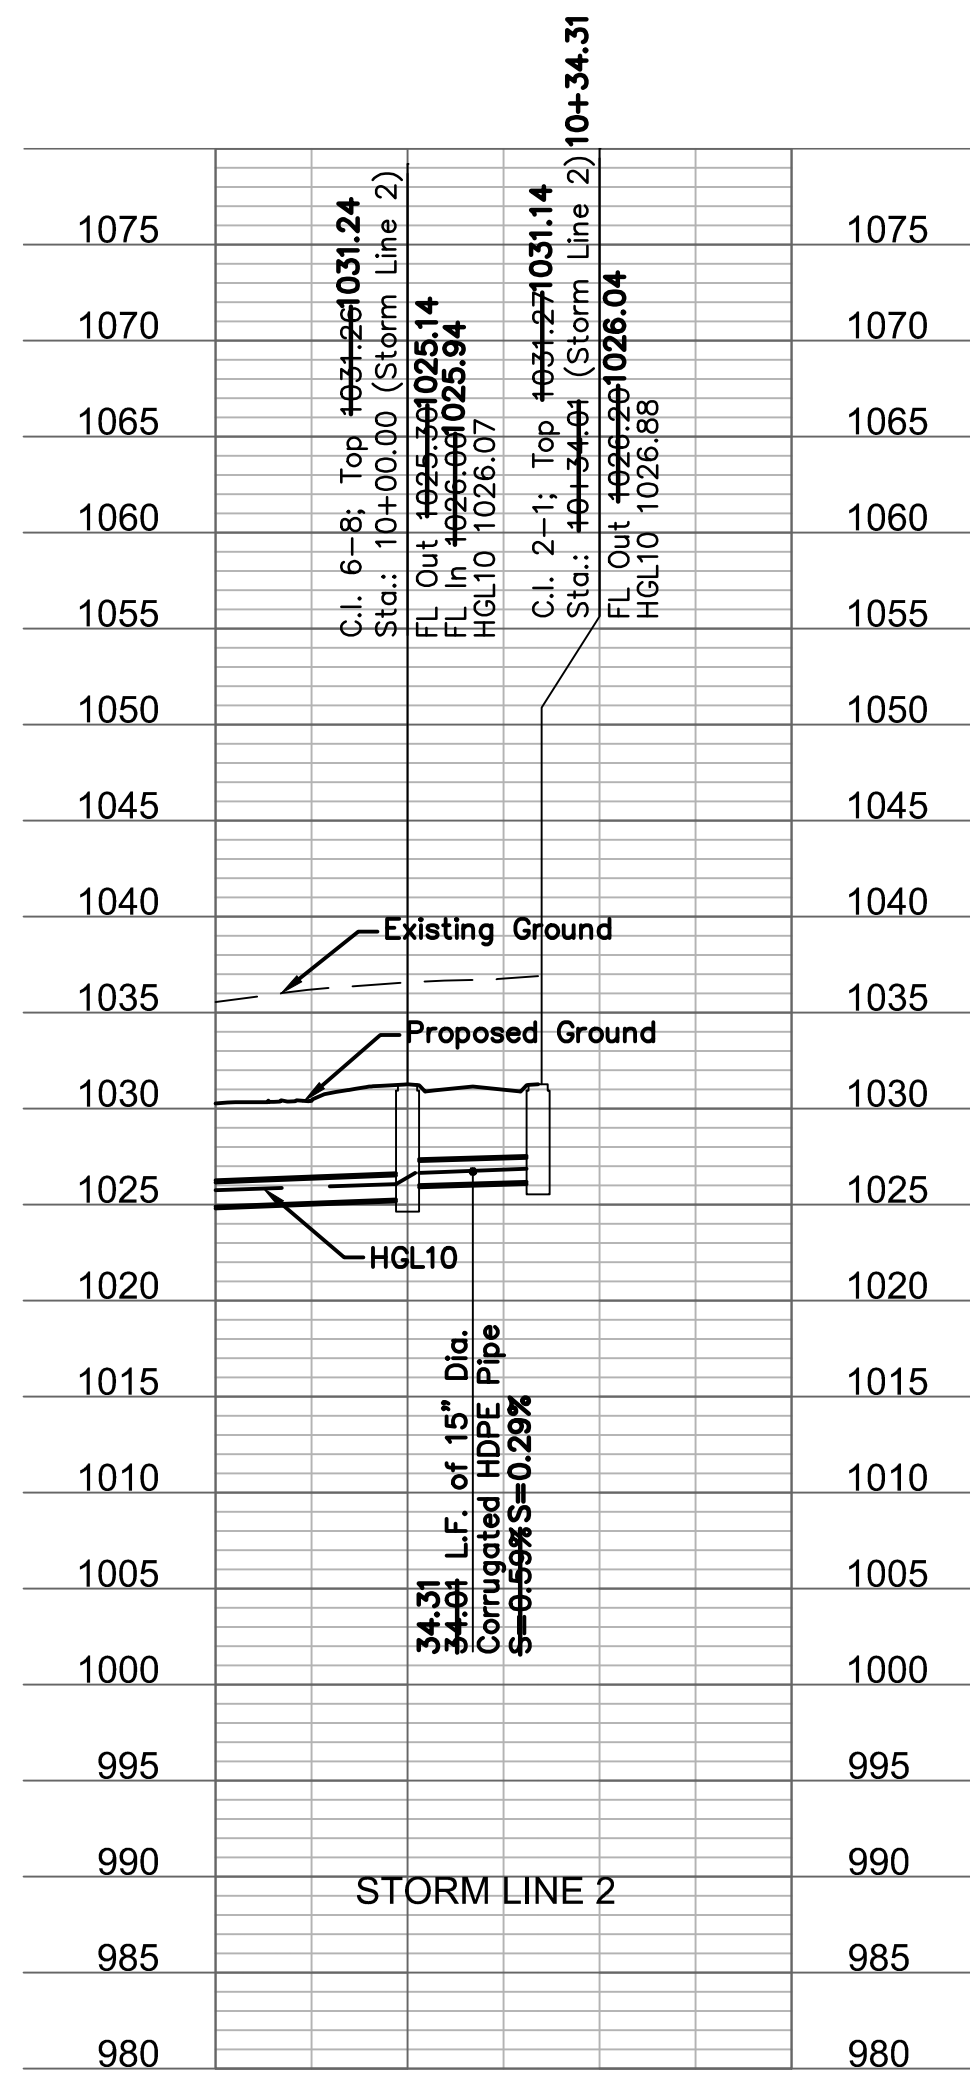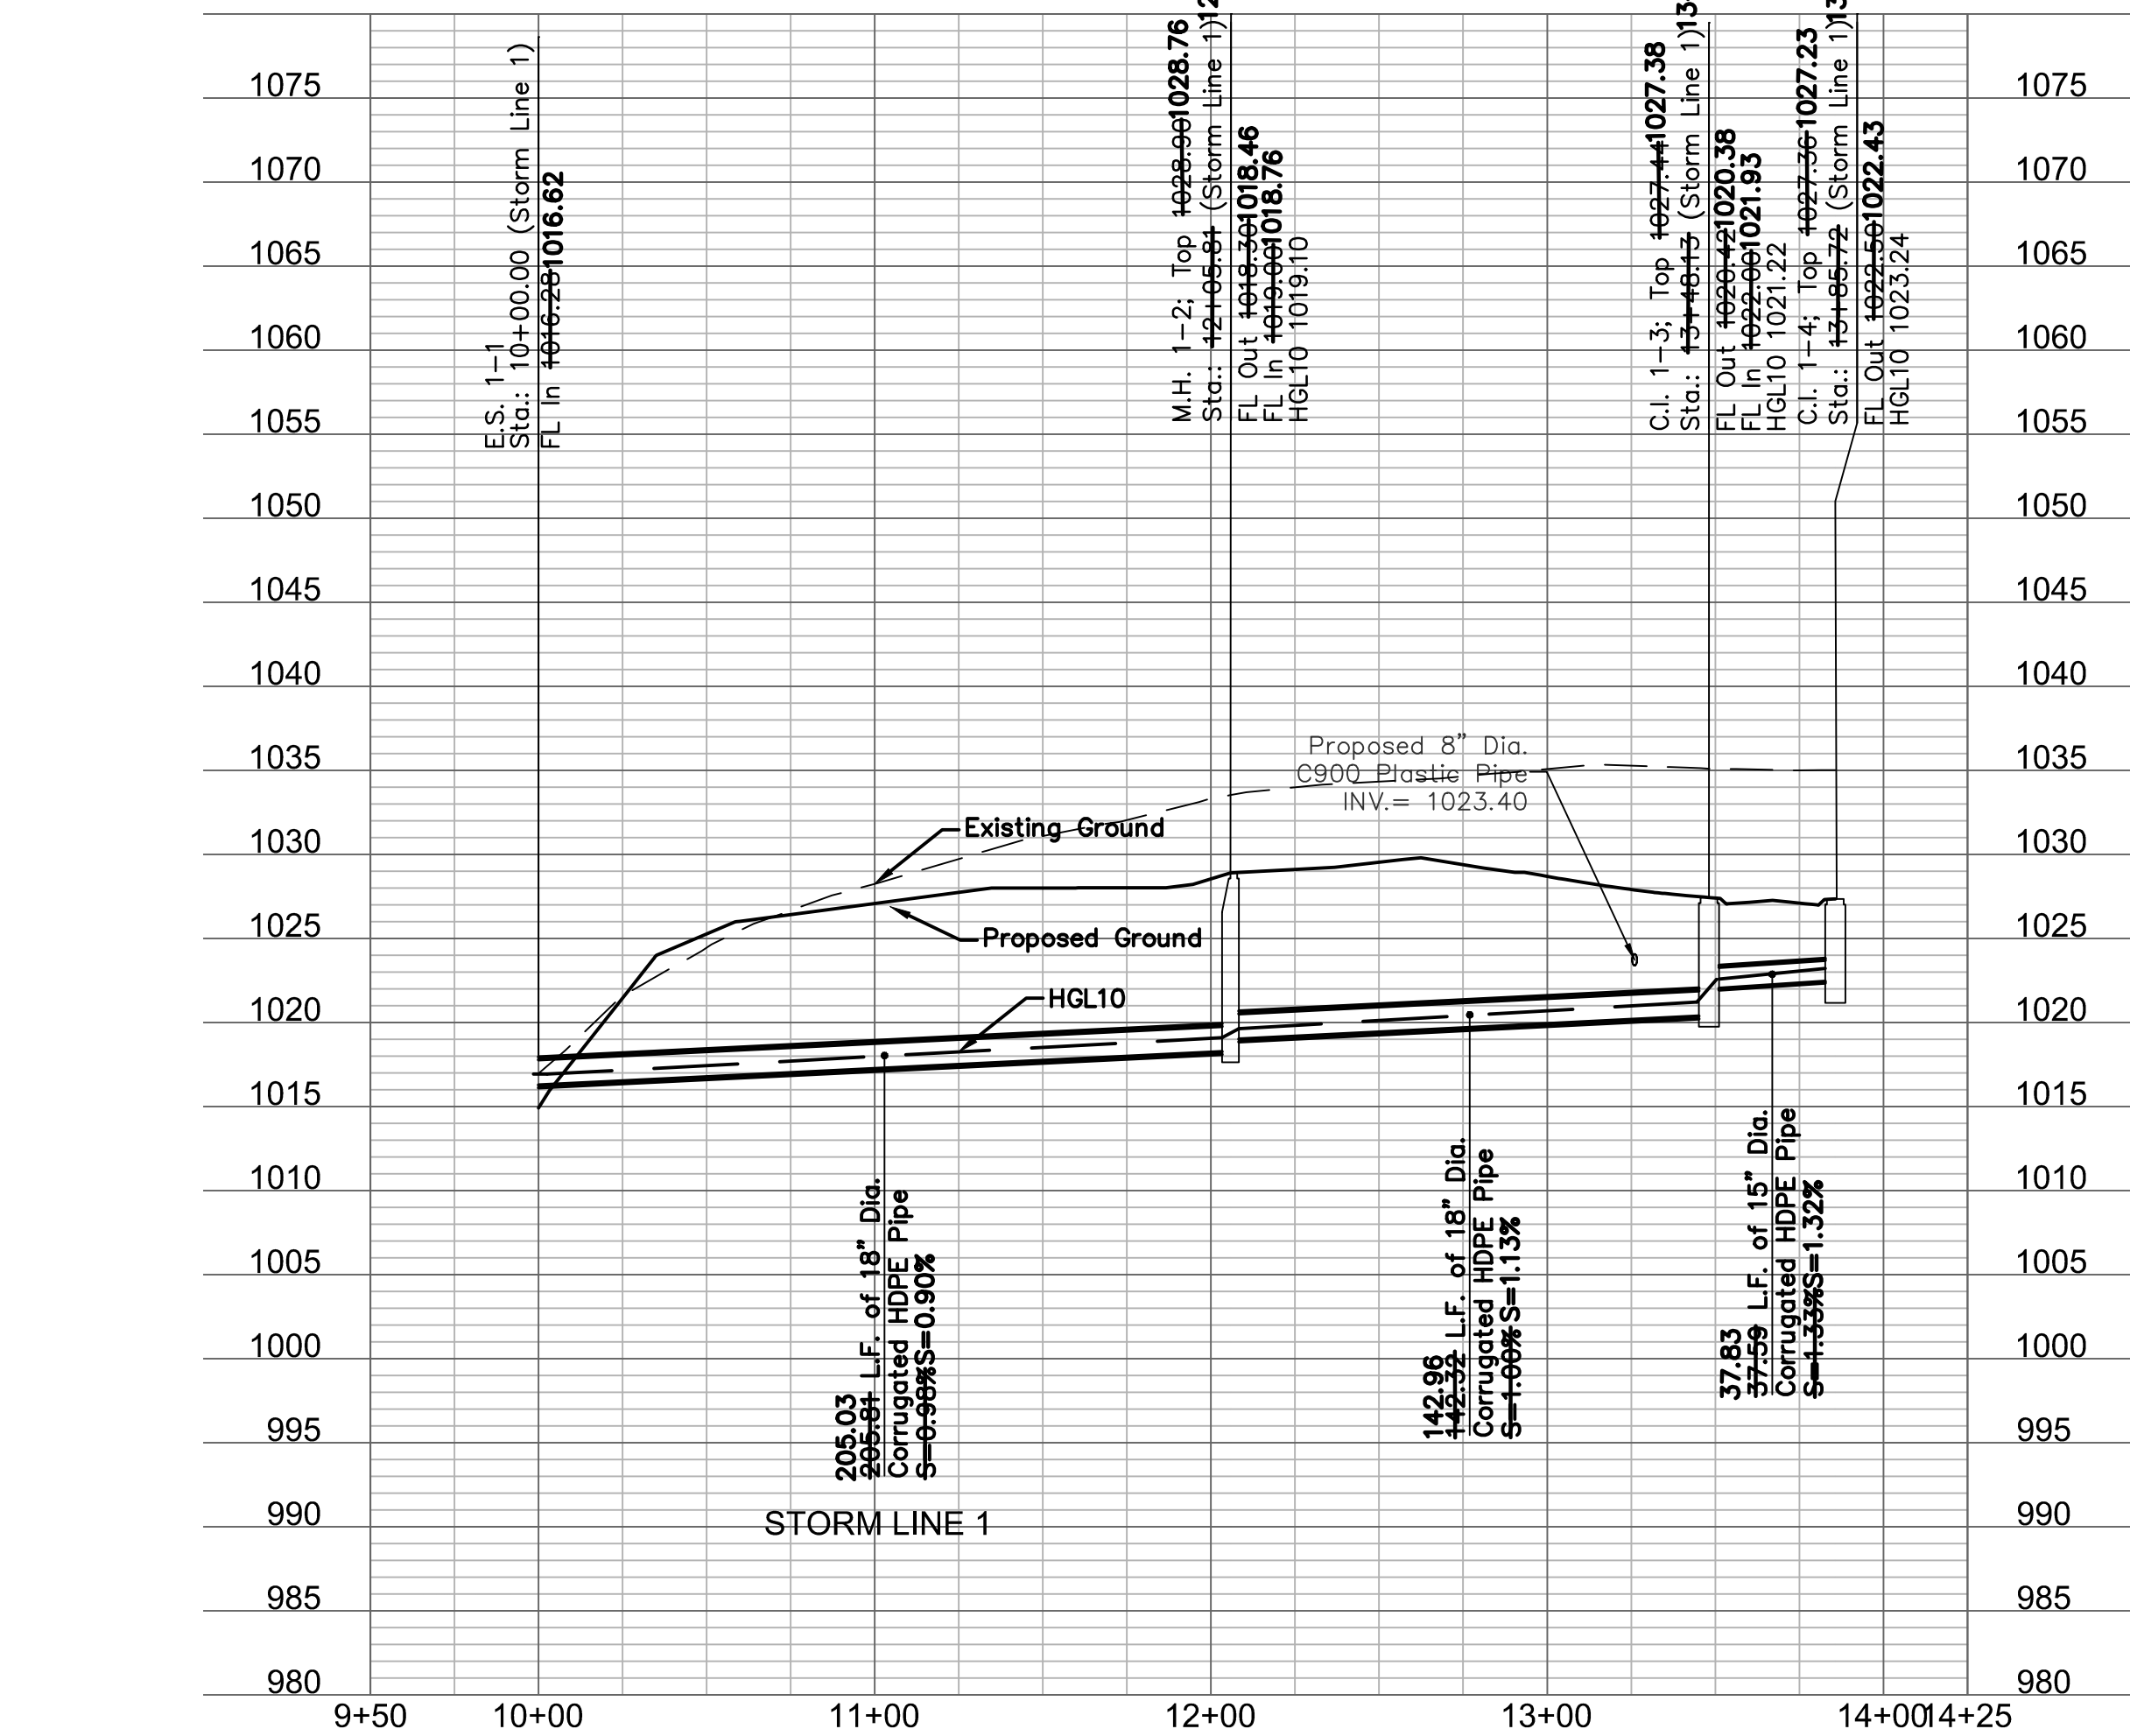

OLSSON ASSOCIATES

Olsson Associates - Civil Engineering
Professional Engineer
Certificate of Authority #01592
North Kansas City, MO 64116
TEL 816.597.4320
FAX 816.597.1393
www.olssonassociates.com

STATE OF MISSOURI

MELISSA G. DEGENIA
Professional Engineer
NUMBER
FE-2011000892
03/04/2019

REVISIONS

NO.	REV.	DATE	DESCRIPTION
1	04.19.2017	Added notes	
4	01.08.2018	Revised structures	

2018



LEE'S SUMMIT, MO

#####


HAWTHORN RIDGE
1ST PLAT

SHEET
C117

drawn by: D.A.H.Q.
checked by: M.G.D.
designed by: P.M.D.
QA/QC by: K.S.J.
project no.: 017-0188
date: 03.03.2017









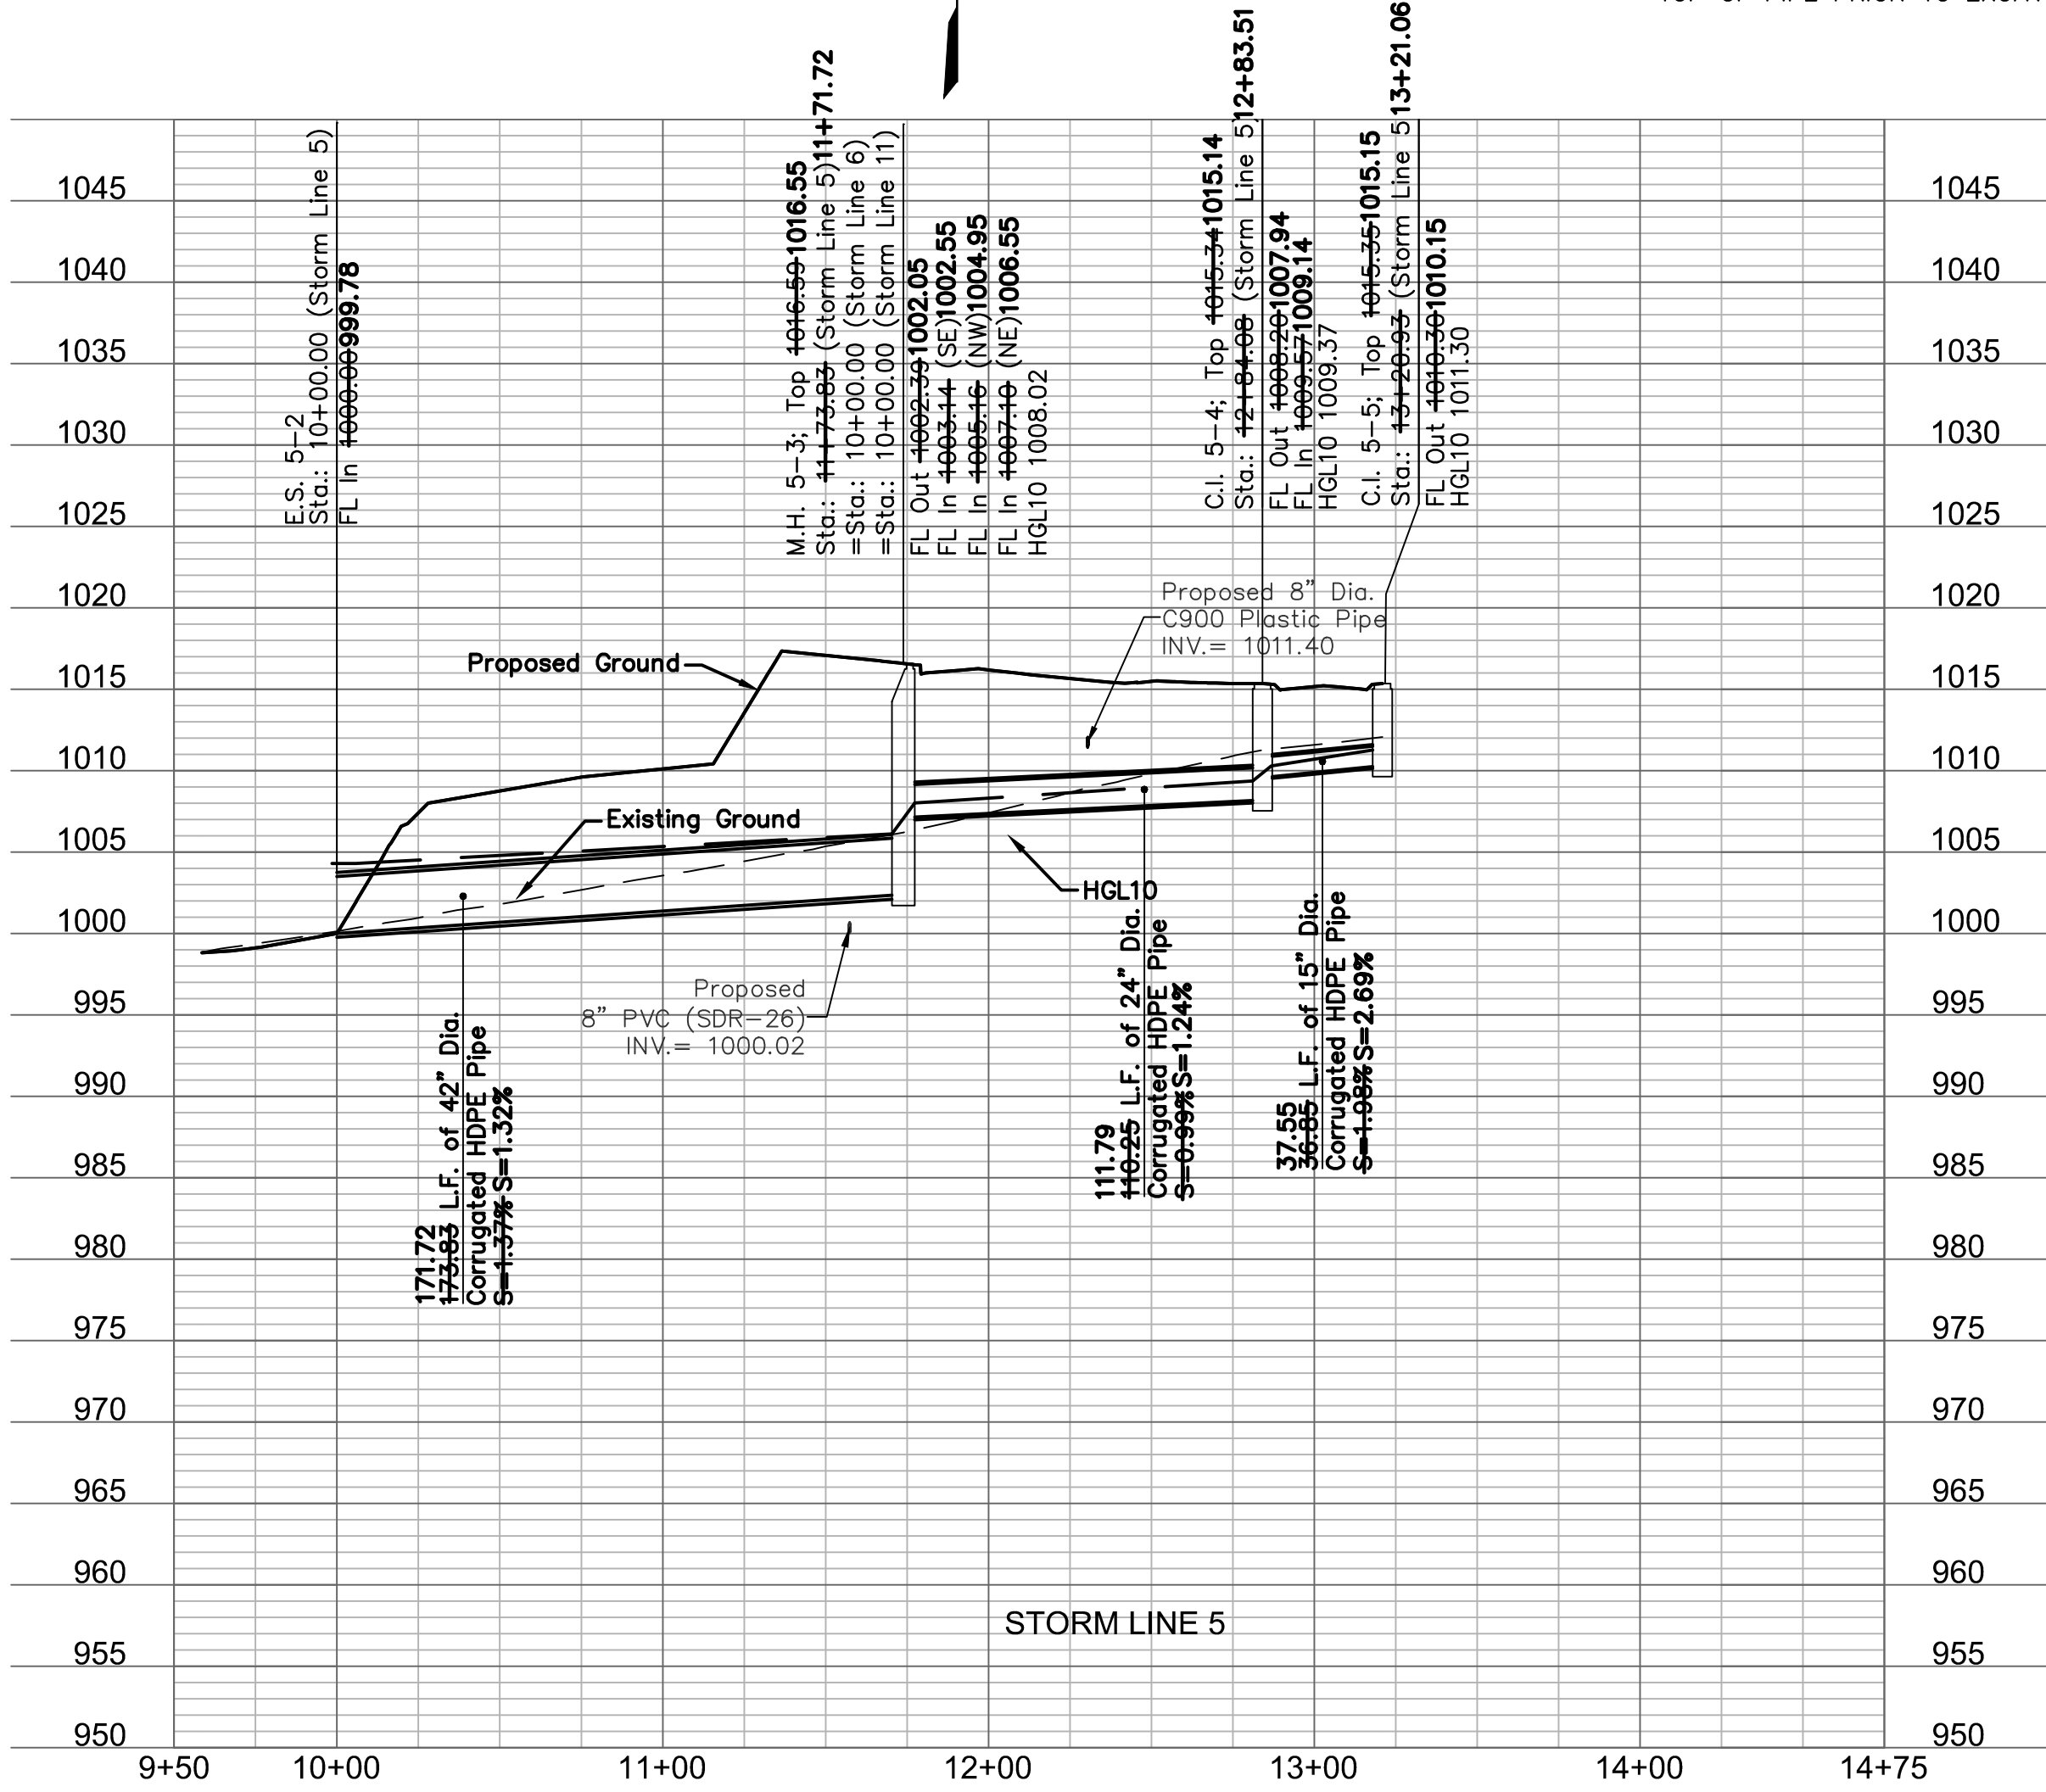
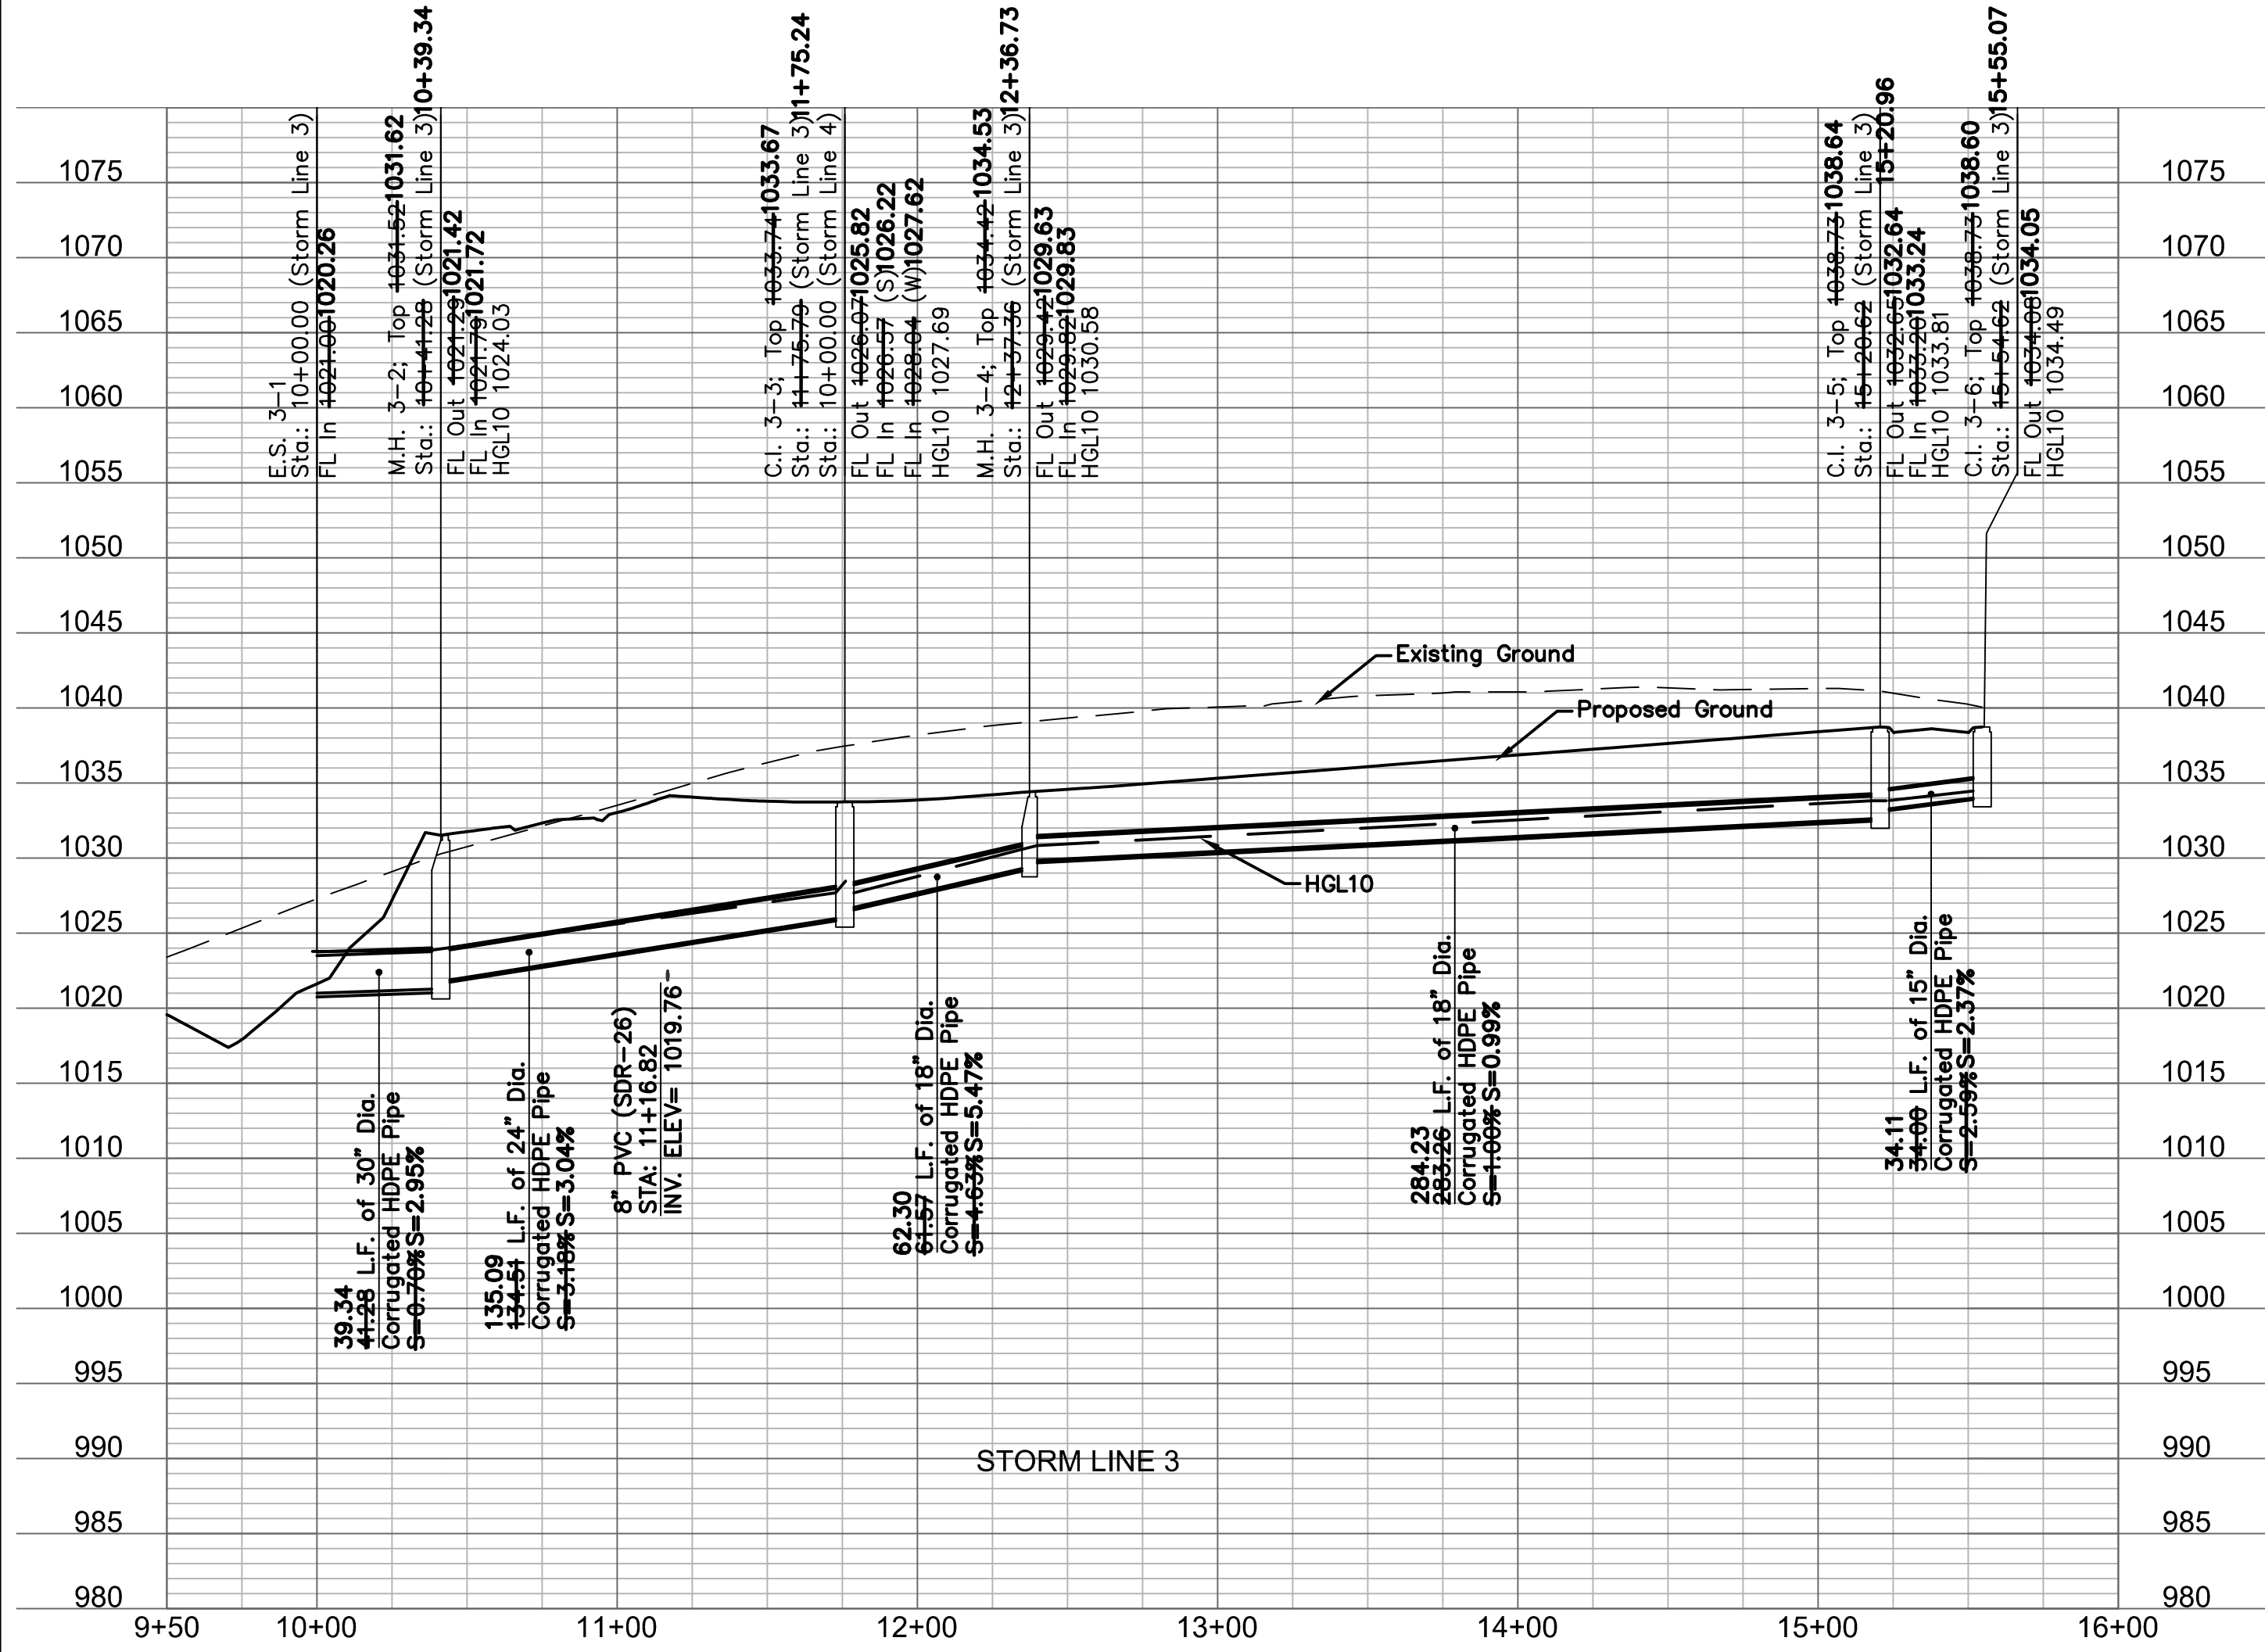


AS BUILT
DATE: 12/19/2018

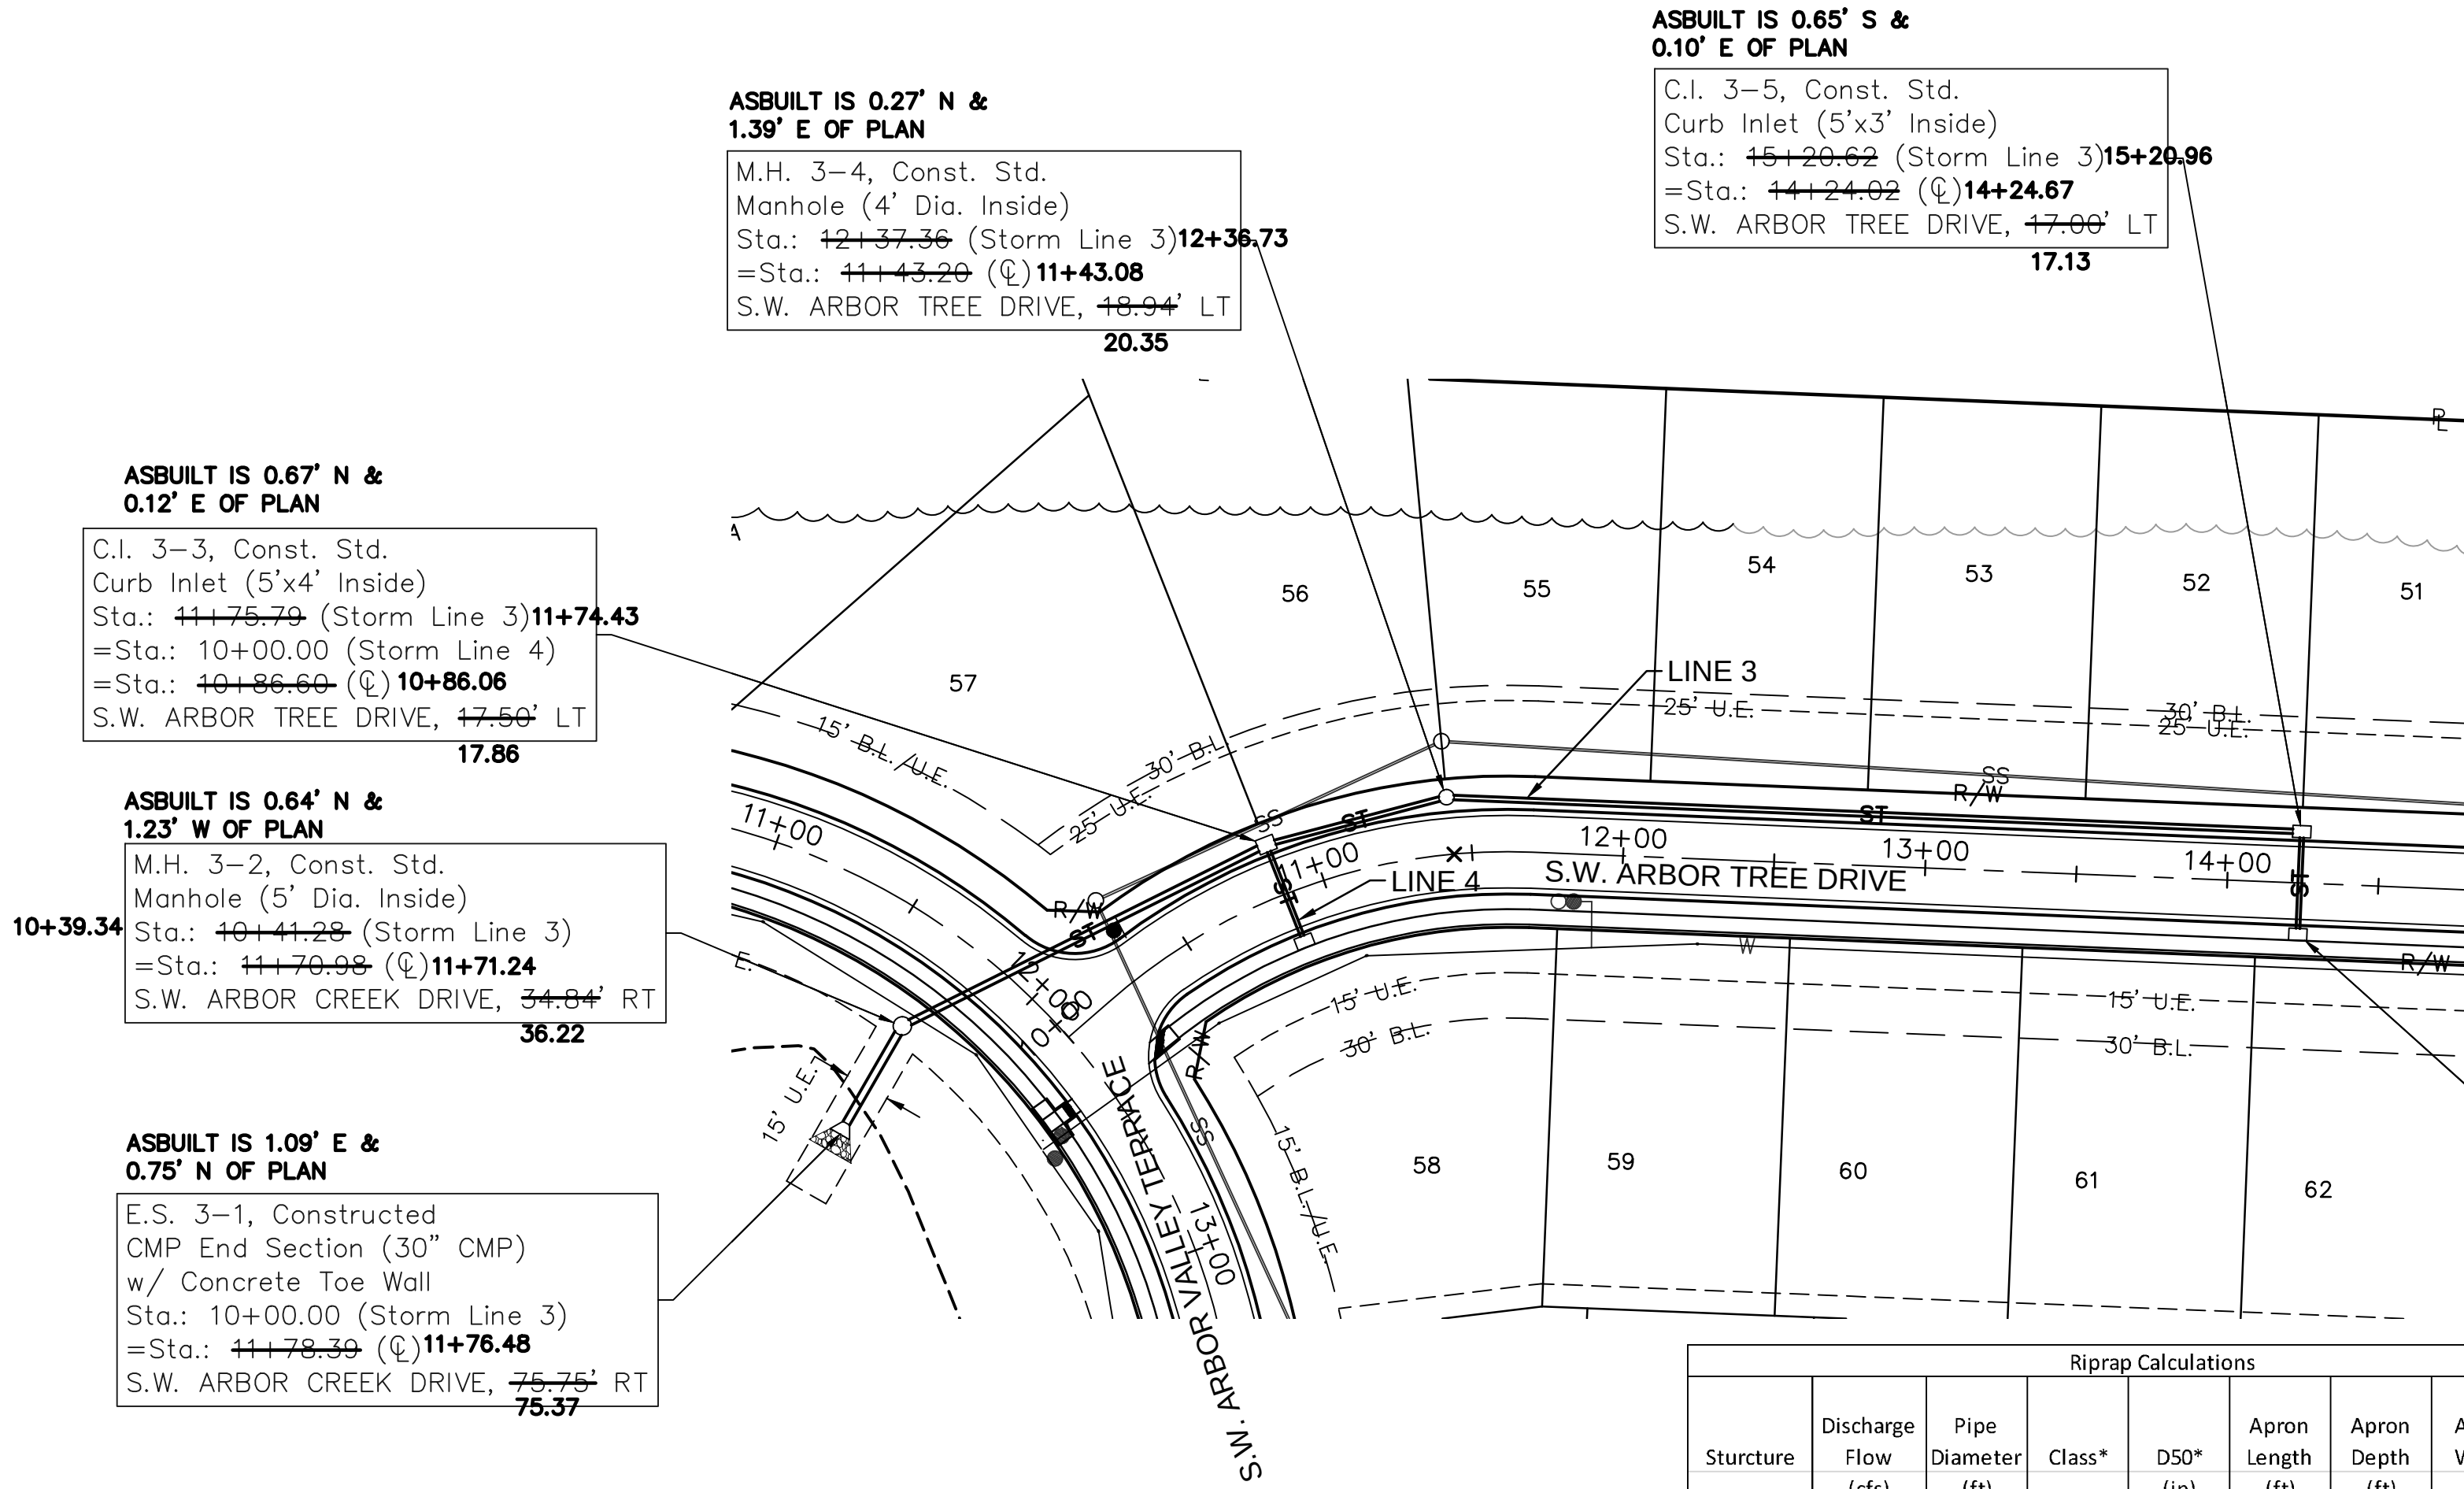

Riprap Calculations								
Structure	Discharge Flow (cfs)	Pipe Diameter (ft)	Class*	D50* (in)	Apron Length (ft)	Apron Depth (ft)	Apron Width (ft)	Area (SY)
E.S. 3-1	29.82	2.5	3.00	10.00	12.5	2.00	15.83	0.40
E.S. 5-2	143.51	3.5	6.00	24.00	31.5	4.00	31.50	73.56

*Per Table 10.1 HEC 14-FHWA-Energy Dissipators Pg. 10-18

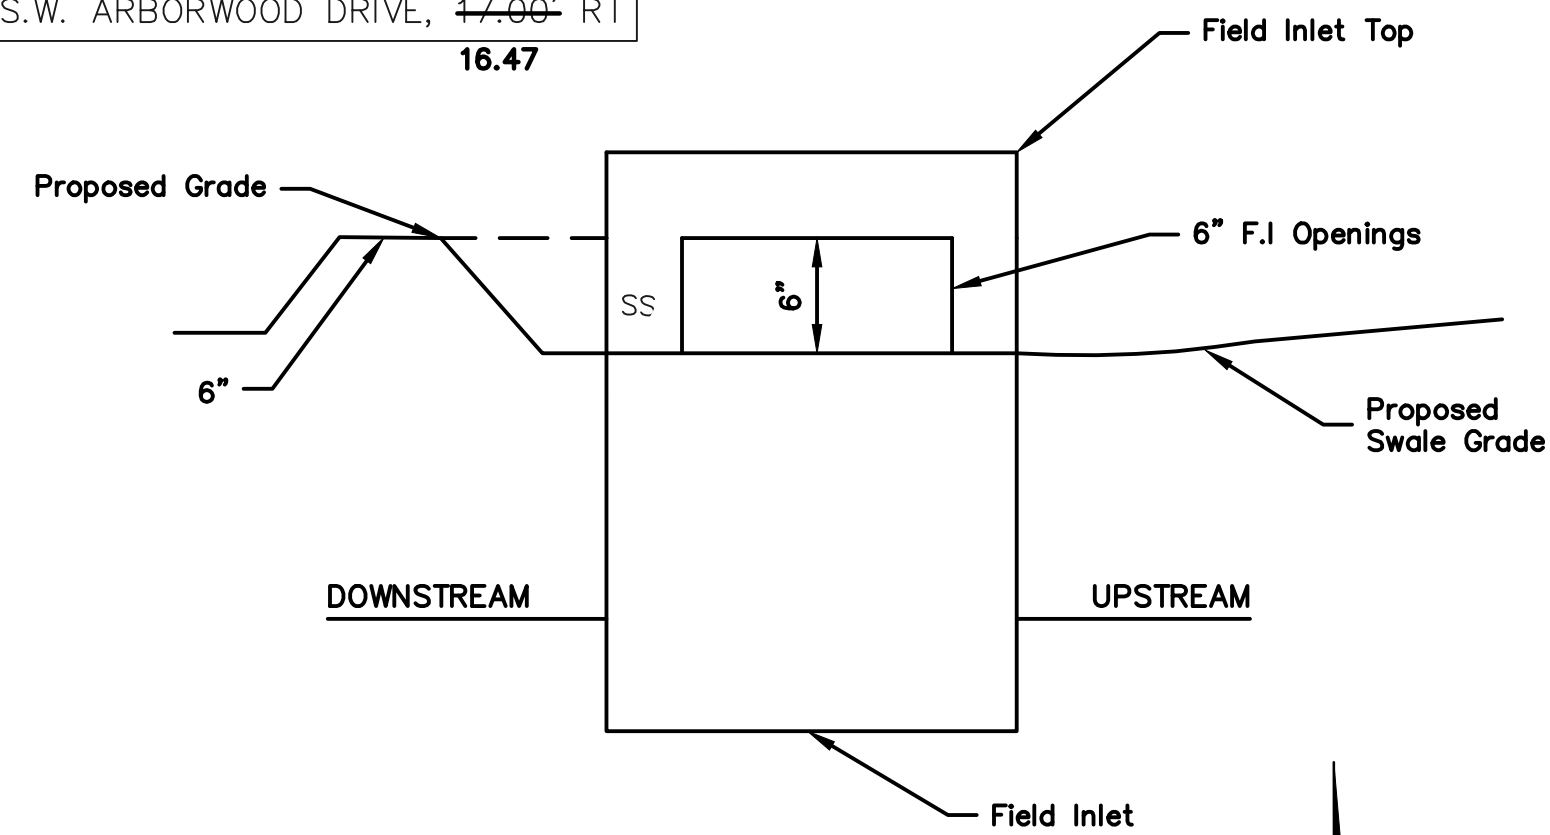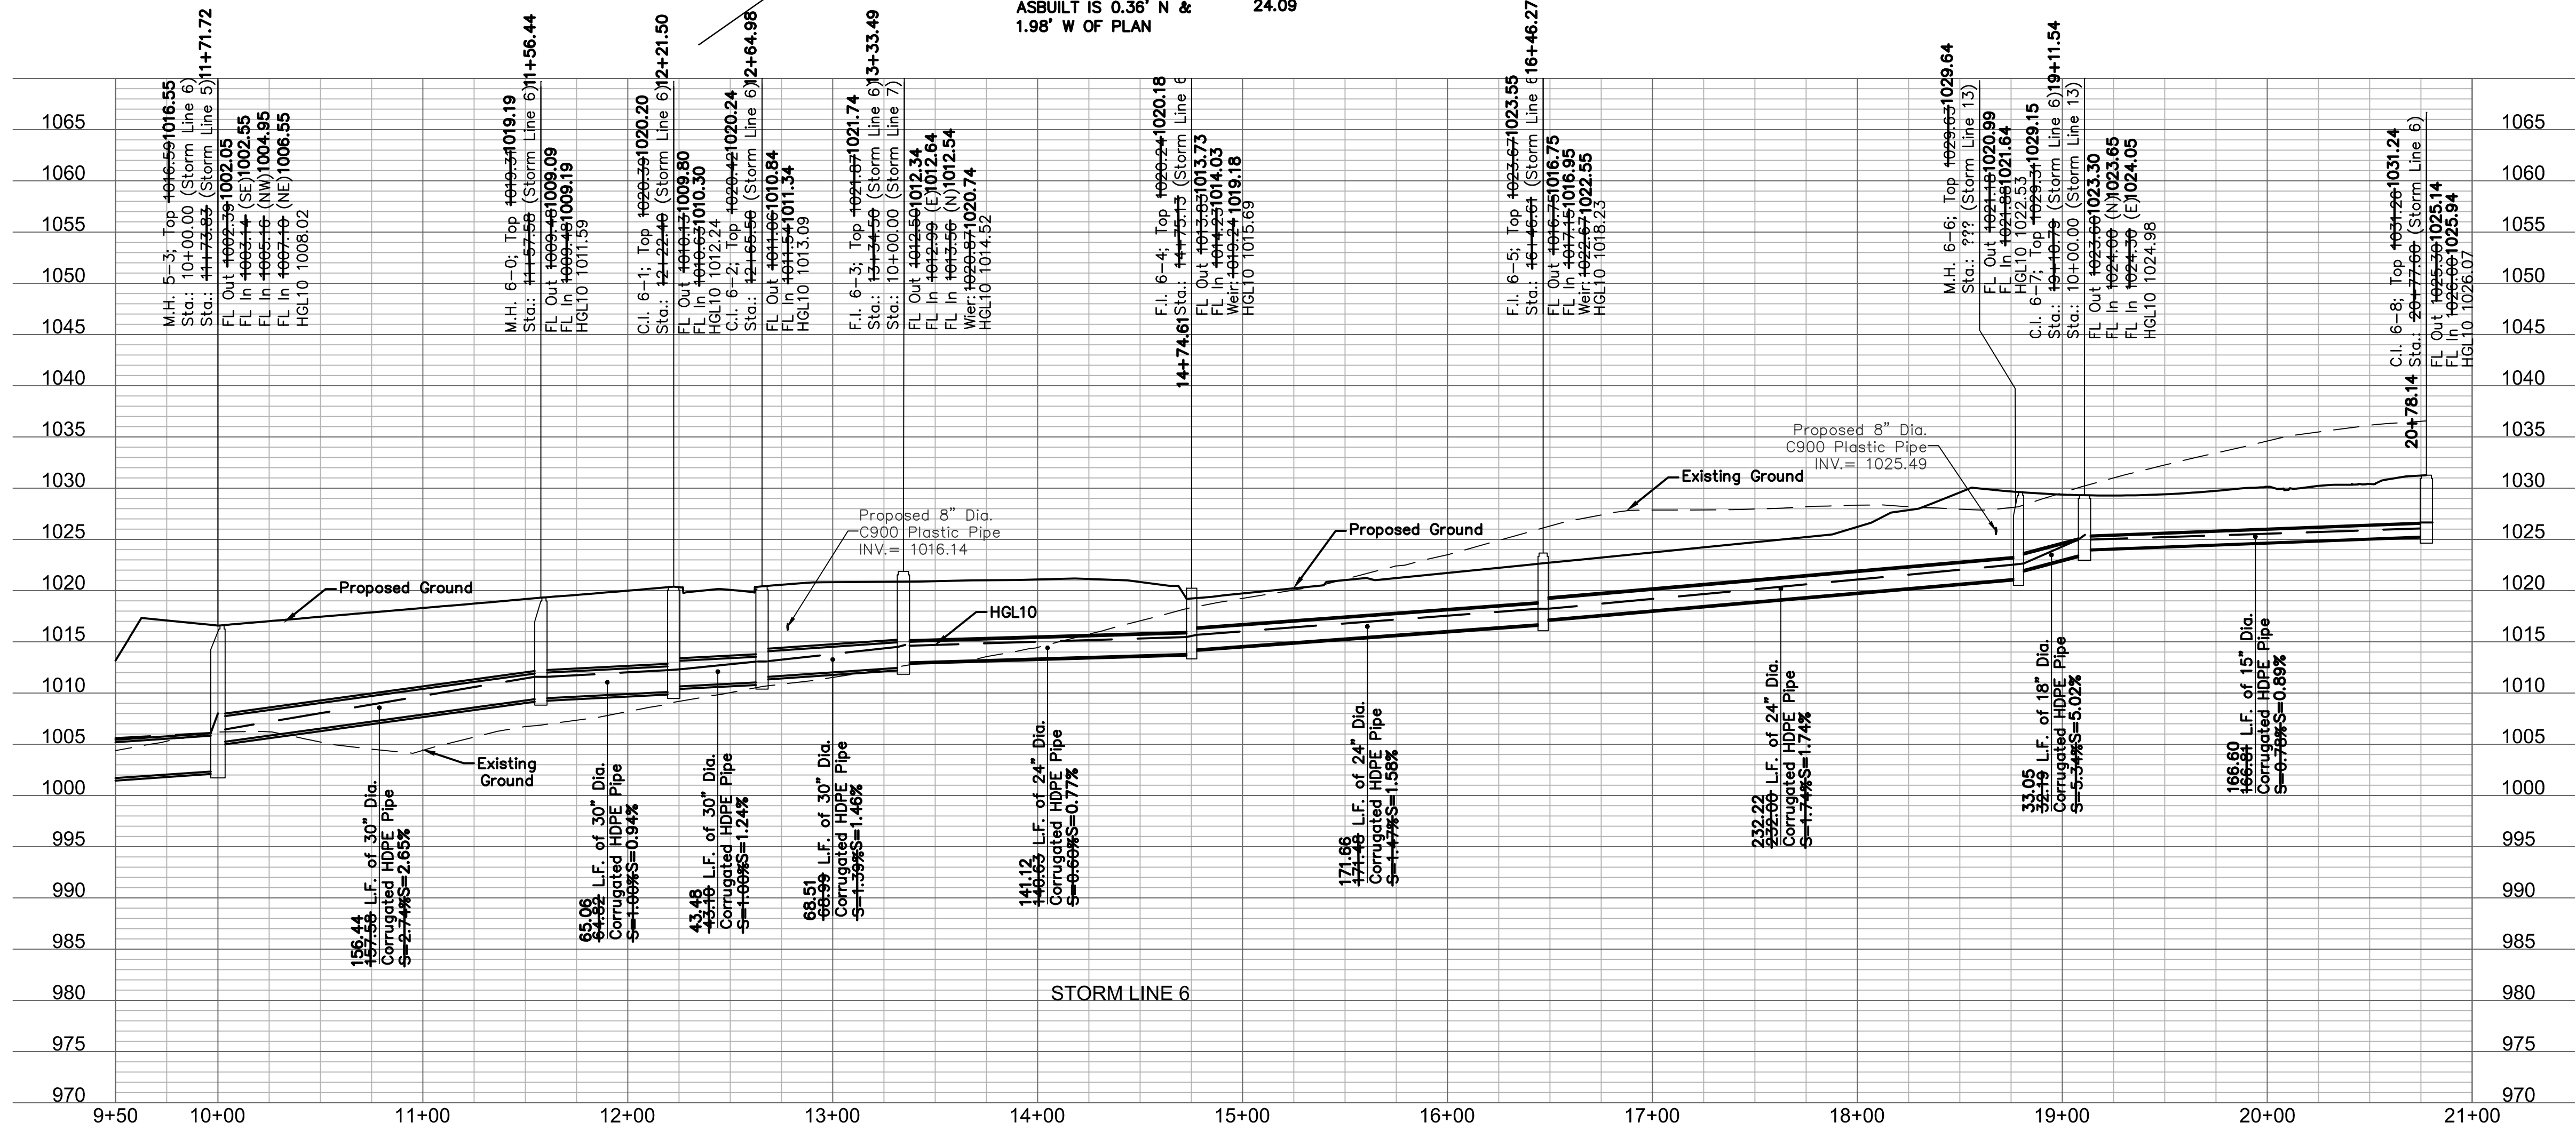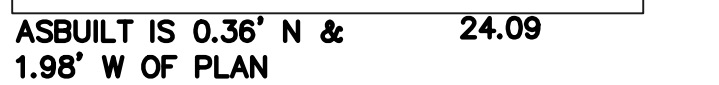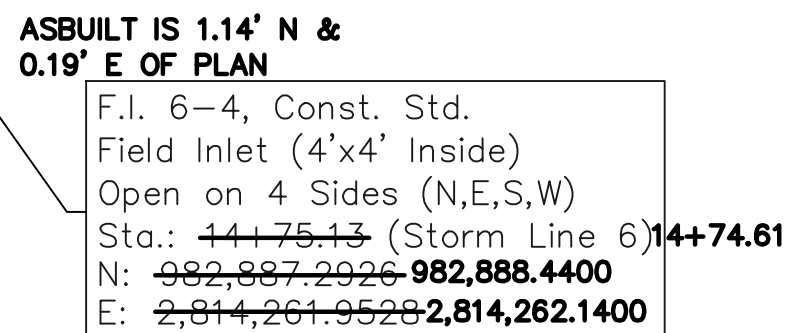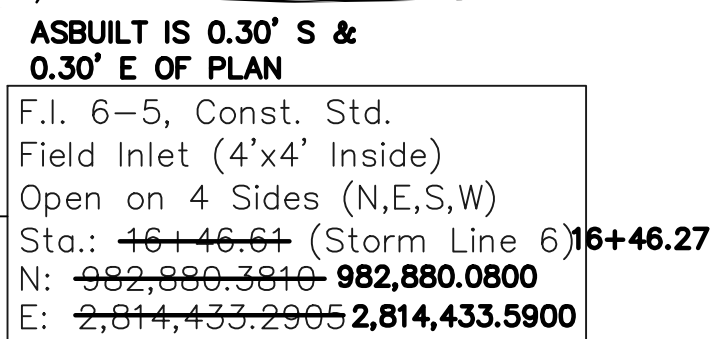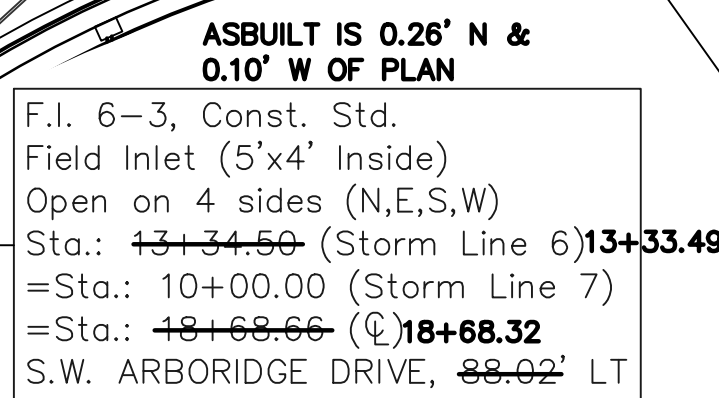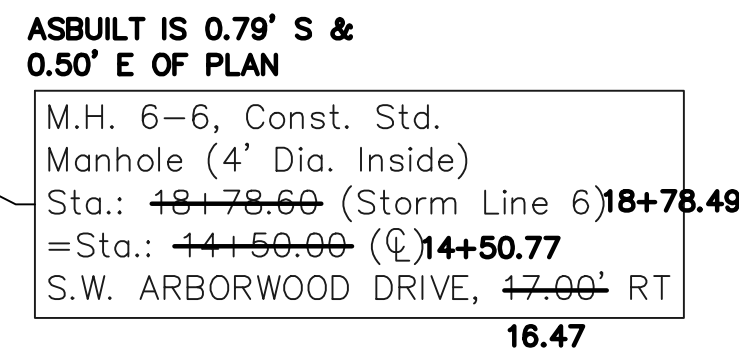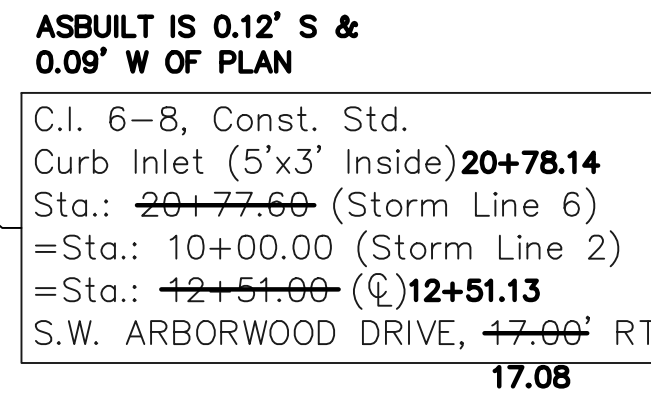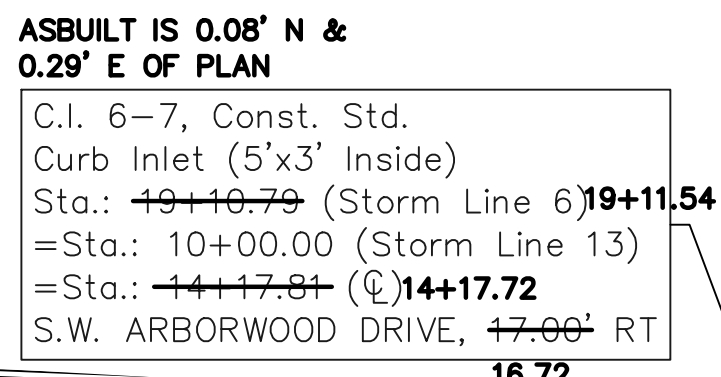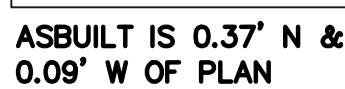



F.I SUMP DETAIL
NOT TO SCALE

NOTE: INCLUDE SUMP PER ABOVE DETAIL WHERE
FIELD INLETS ARE LOCATED WITHIN SWALES.


NOTE: CONTRACTOR FILLED AND COMPACTED TO 95%
STANDARD DENSITY TO A POINT 18" MINIMUM ABOVE
TOP OF PIPE PRIOR TO EXCAVATION FOR THE PIPE.

DATE: 12/19/2018

Record Drawing

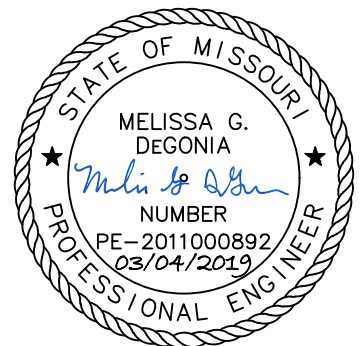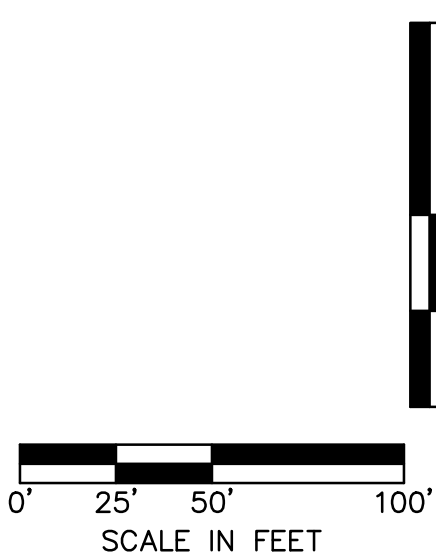


ASBUILT IS 0.26' N &
0.10' W OF PLAN
F.I. 6-3, Const. Std.
Field Inlet (5'x4' Inside)
Open on 4 sides (N,E,S,W)
Sta.: 13+34.50 (Storm Line 6)13+33.49
=Sta.: 10+00.00 (Storm Line 7)
=Sta.: 18+68.66 (E)18+68.32
S.W. ARBORIDGE DRIVE, 88.02' LT
88.03


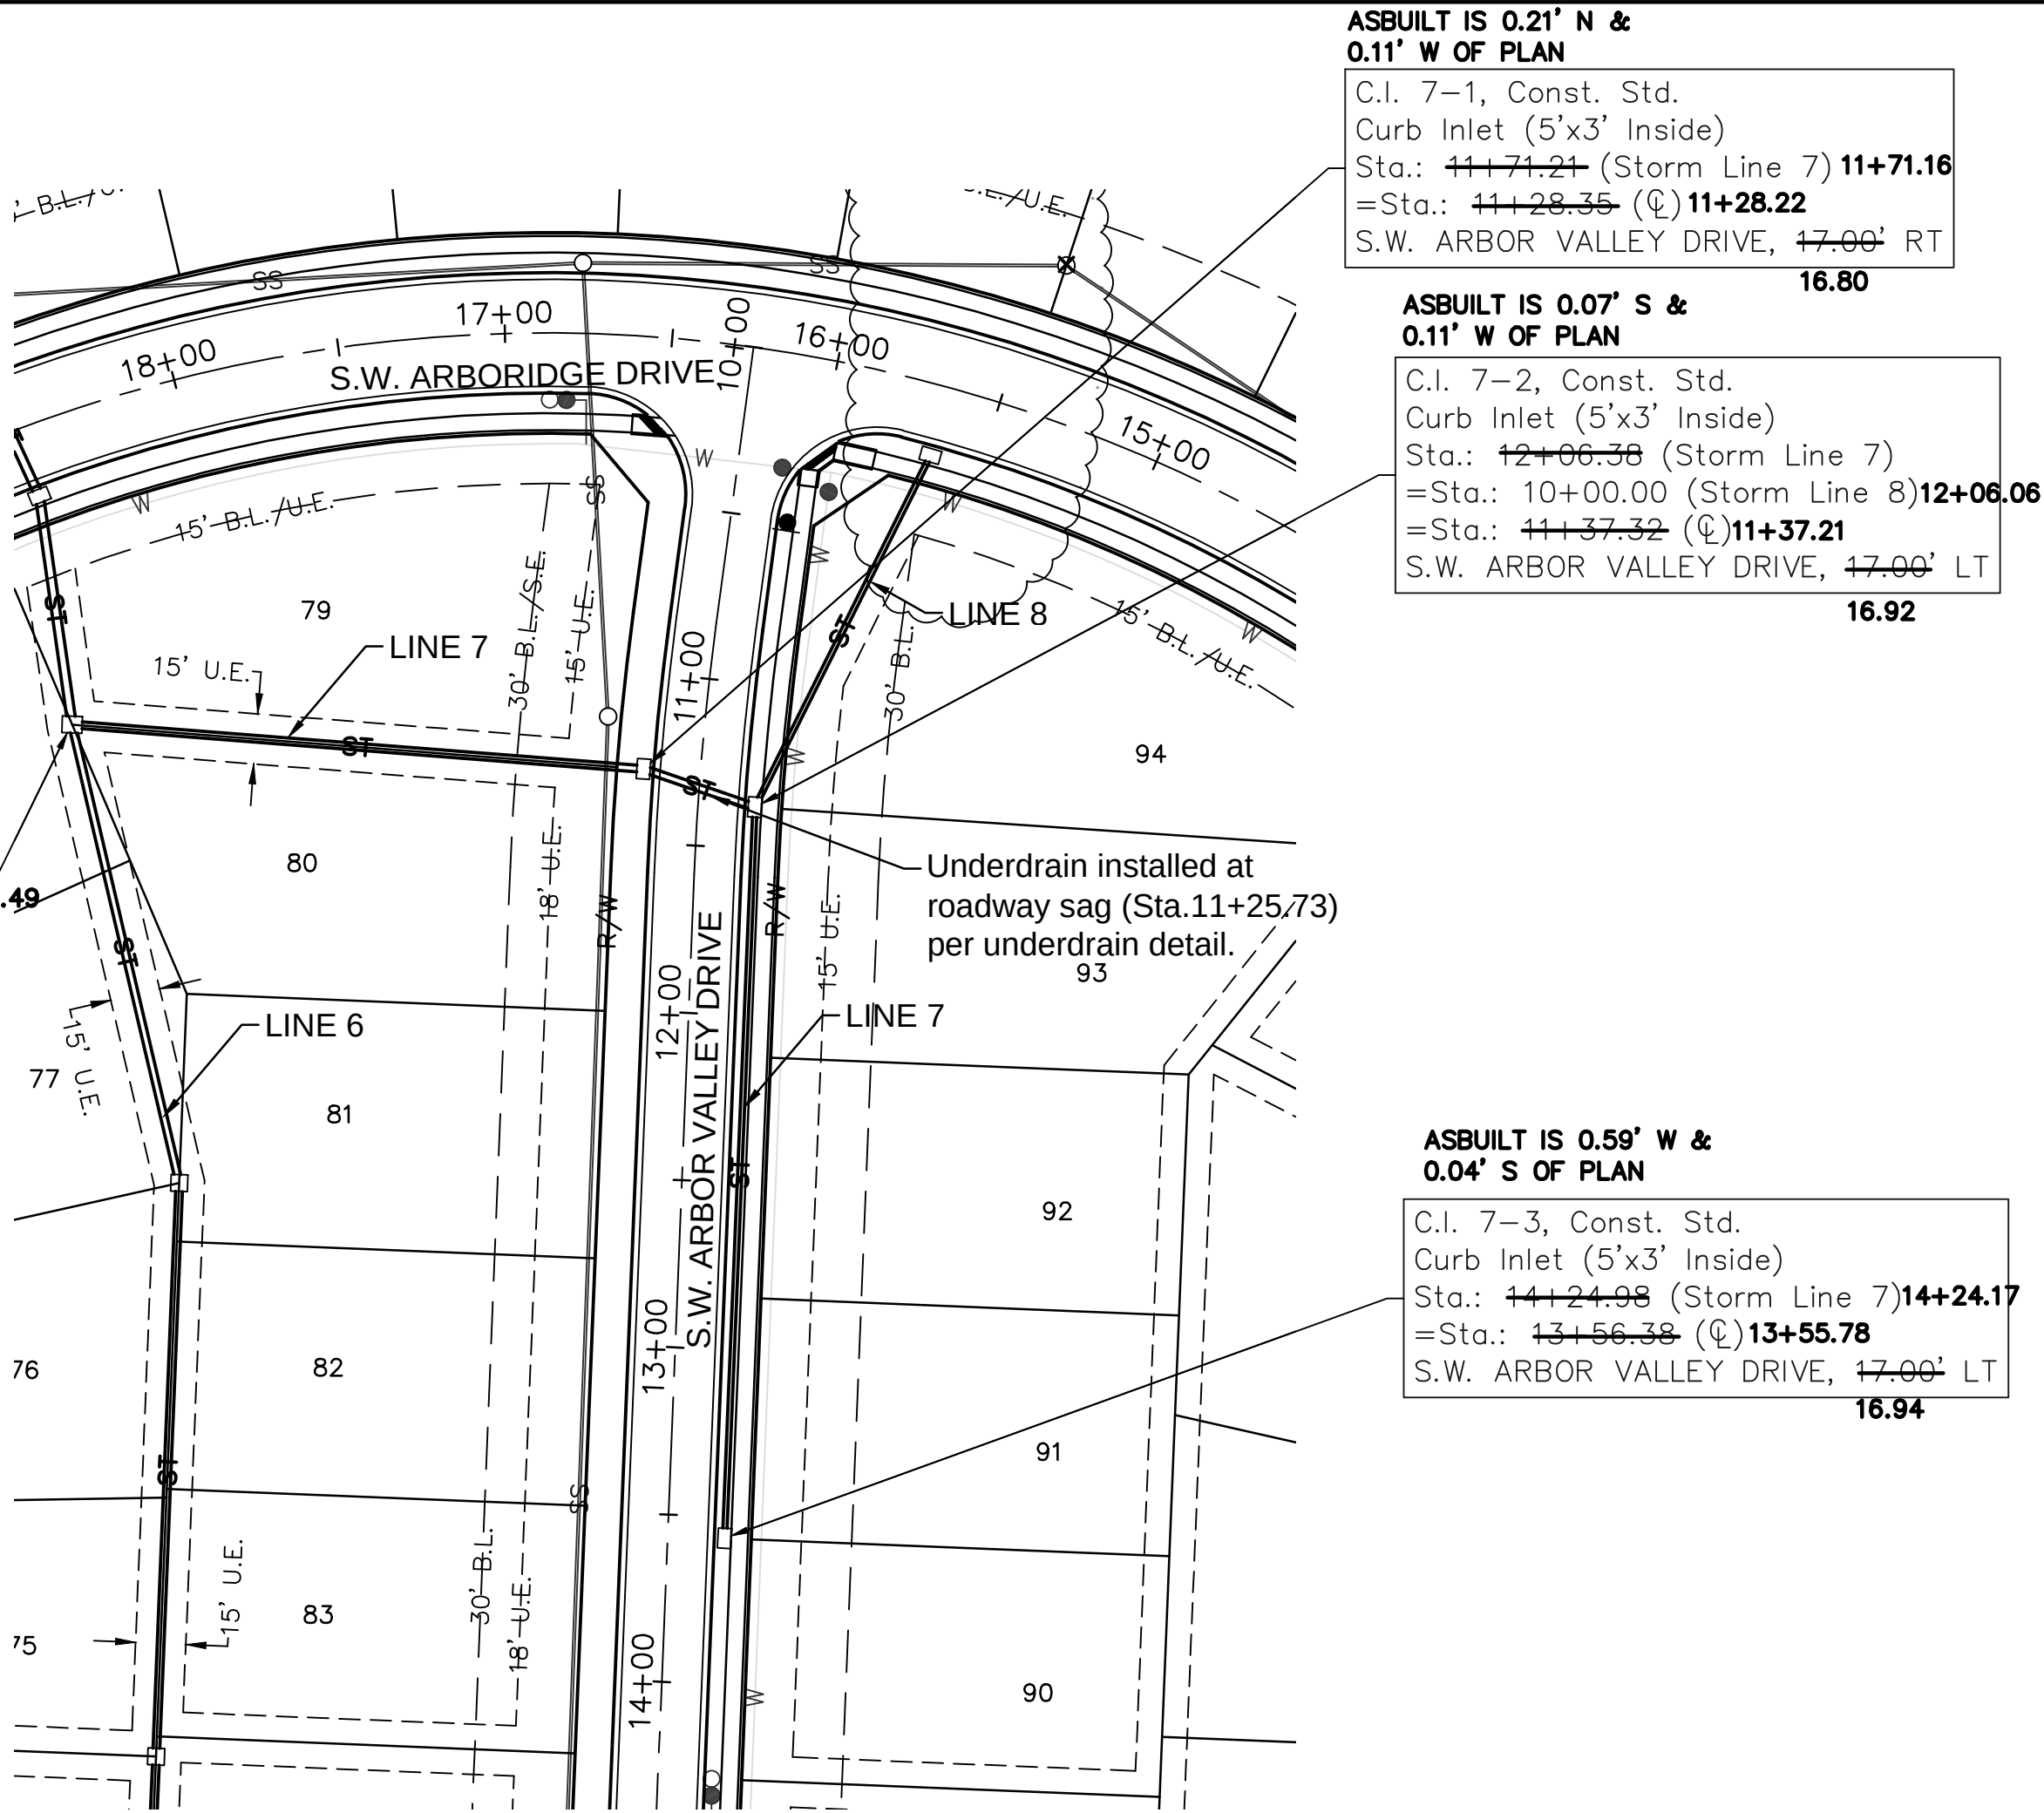


ASBUILT IS 0.07' S &
0.11' W OF PLAN
C.I. 7-2, Connect to Existing
Curb Inlet (5'x3' Inside)
Sta.: 12+06.38 (Storm Line 7)12+06.06
=Sta.: 10+00.00 (Storm Line 8)
=Sta.: 11+37.32 (E)11+37.21
S.W. ARBOR VALLEY DRIVE, 17.00' LT
16.92

C.I. 8-1, Const. Std.
Curb Inlet (5'x3' Inside)
Sta.: 11+17.47 (Storm Line 8)11+17.02
=Sta.: 15+65.79 (E)15+65.87
S.W. ARBORIDGE DRIVE, 21.00' LT
21.38
ASBUILT IS 0.18' S &
0.34' E OF PLAN

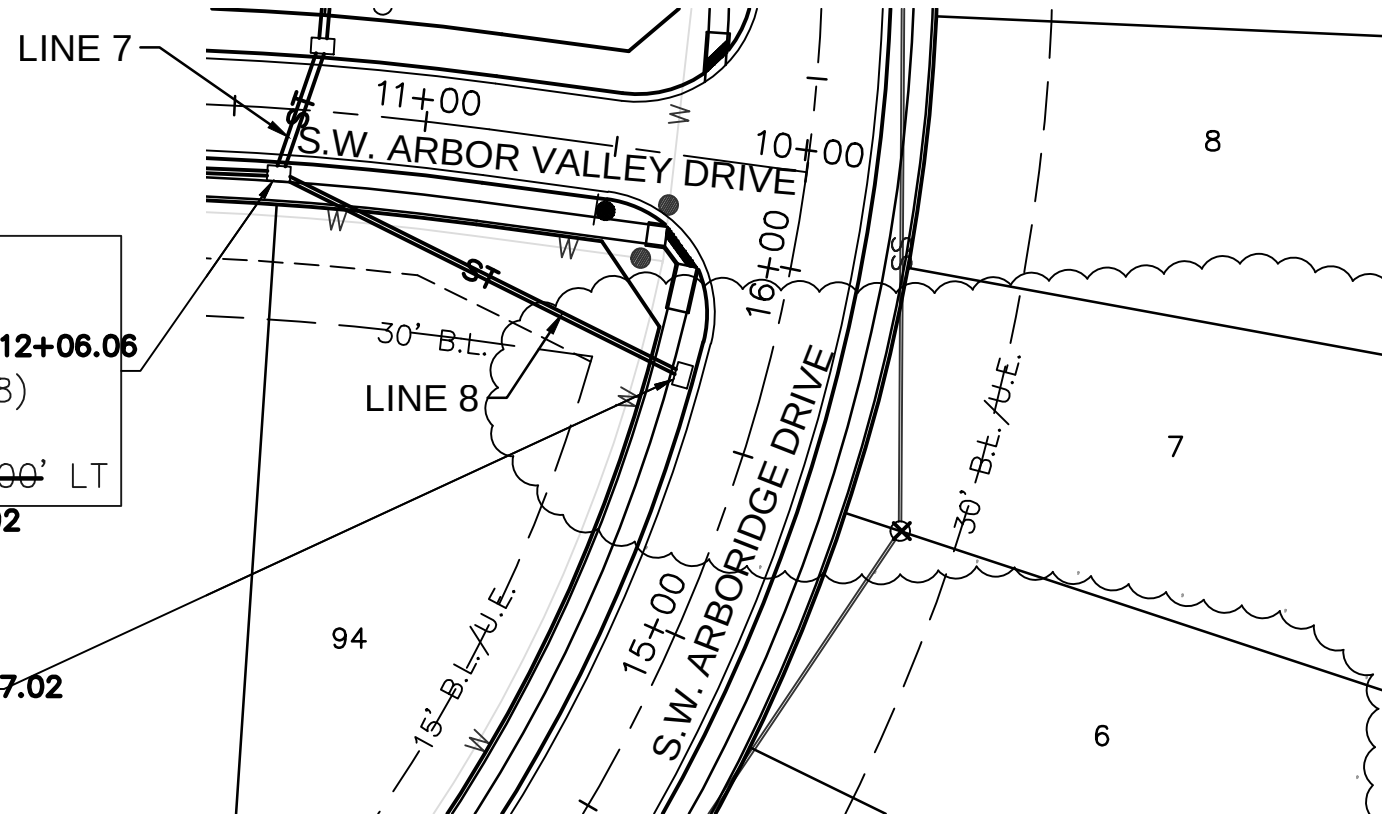





NOTE: CONTRACTOR FILLED AND COMPACTED TO 95%
STANDARD DENSITY TO A POINT 18" MINIMUM ABOVE
TOP OF PIPE PRIOR TO EXCAVATION FOR THE PIPE.

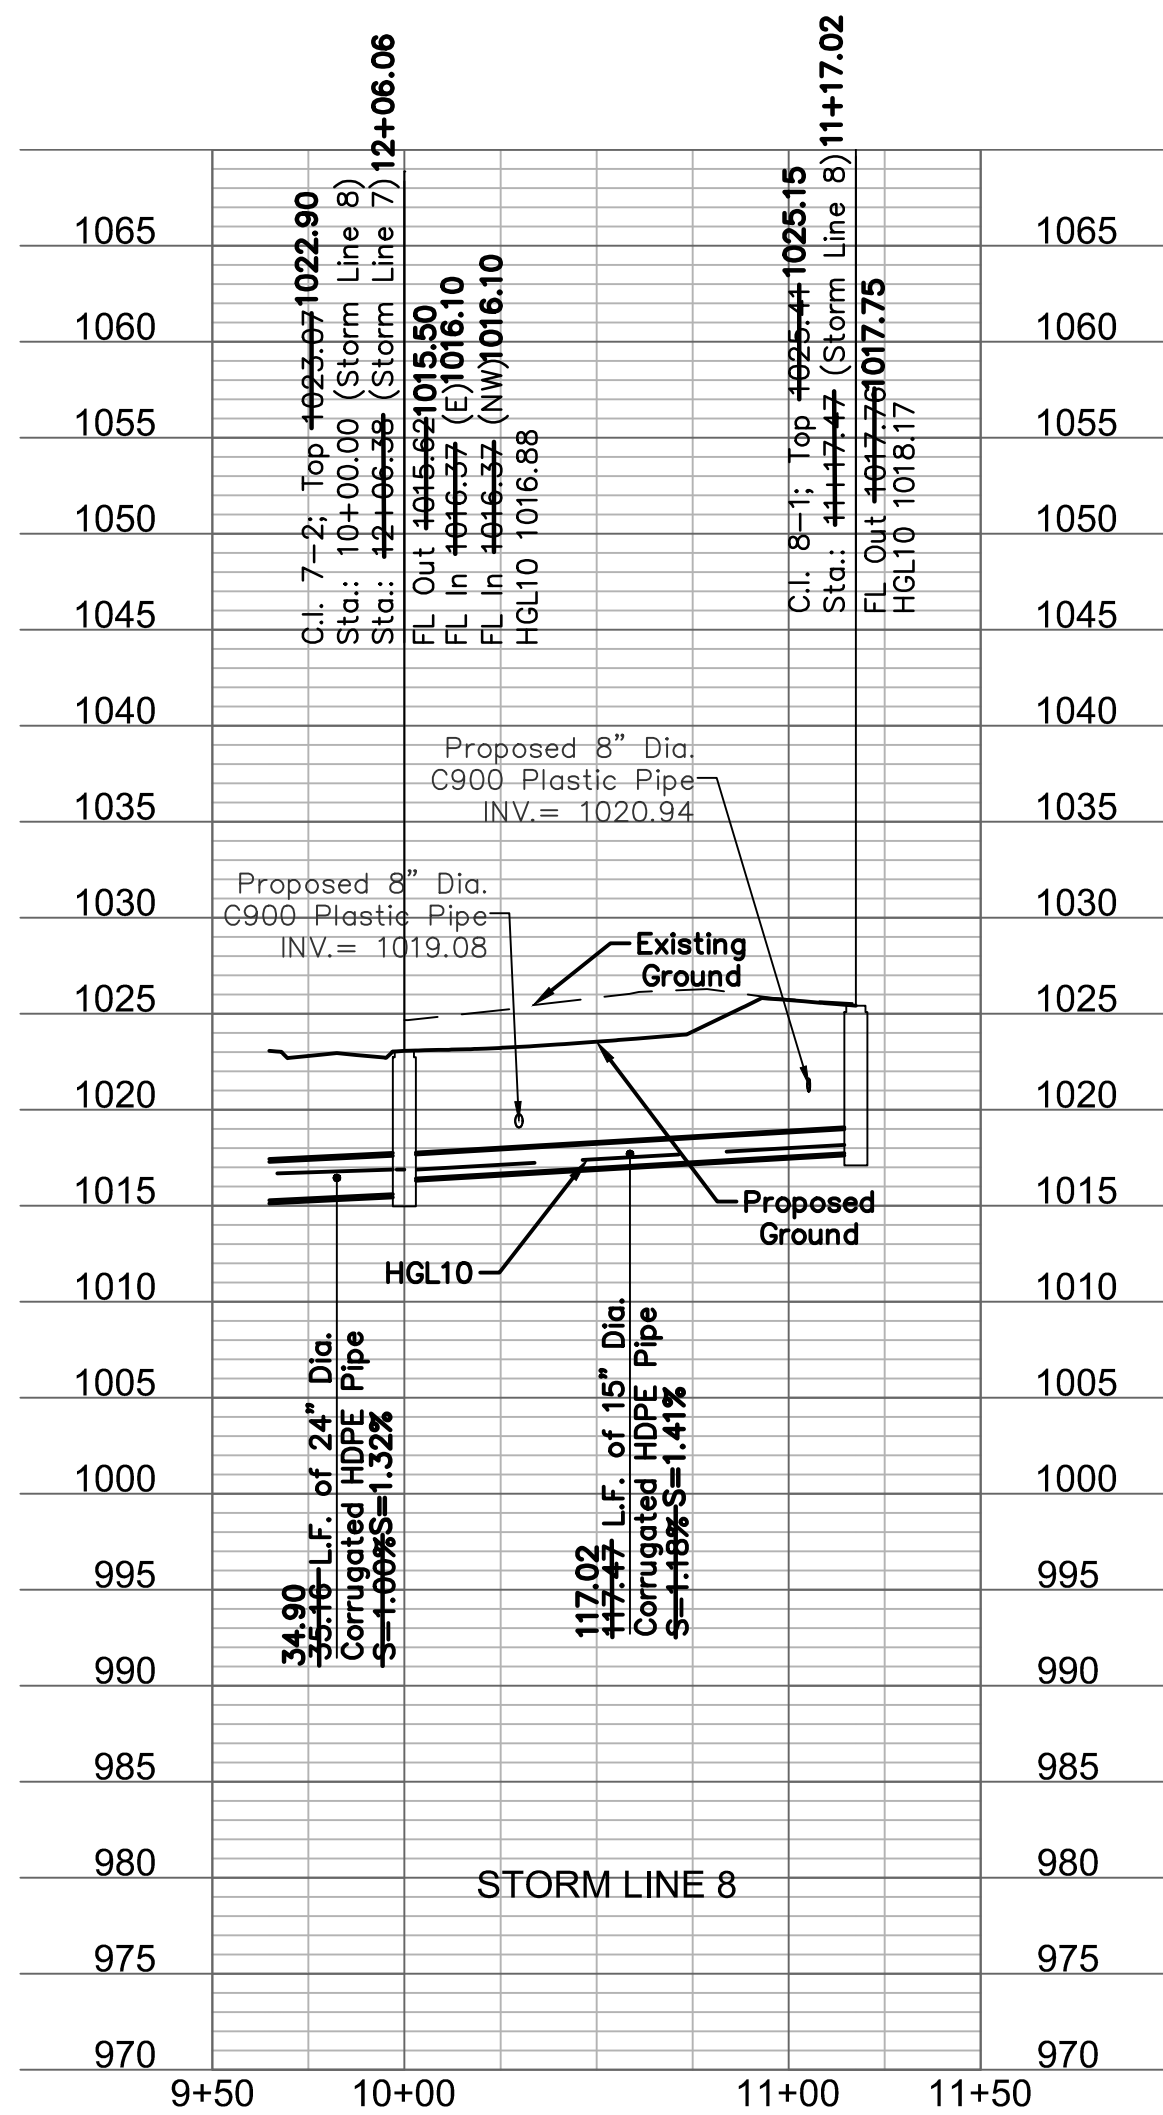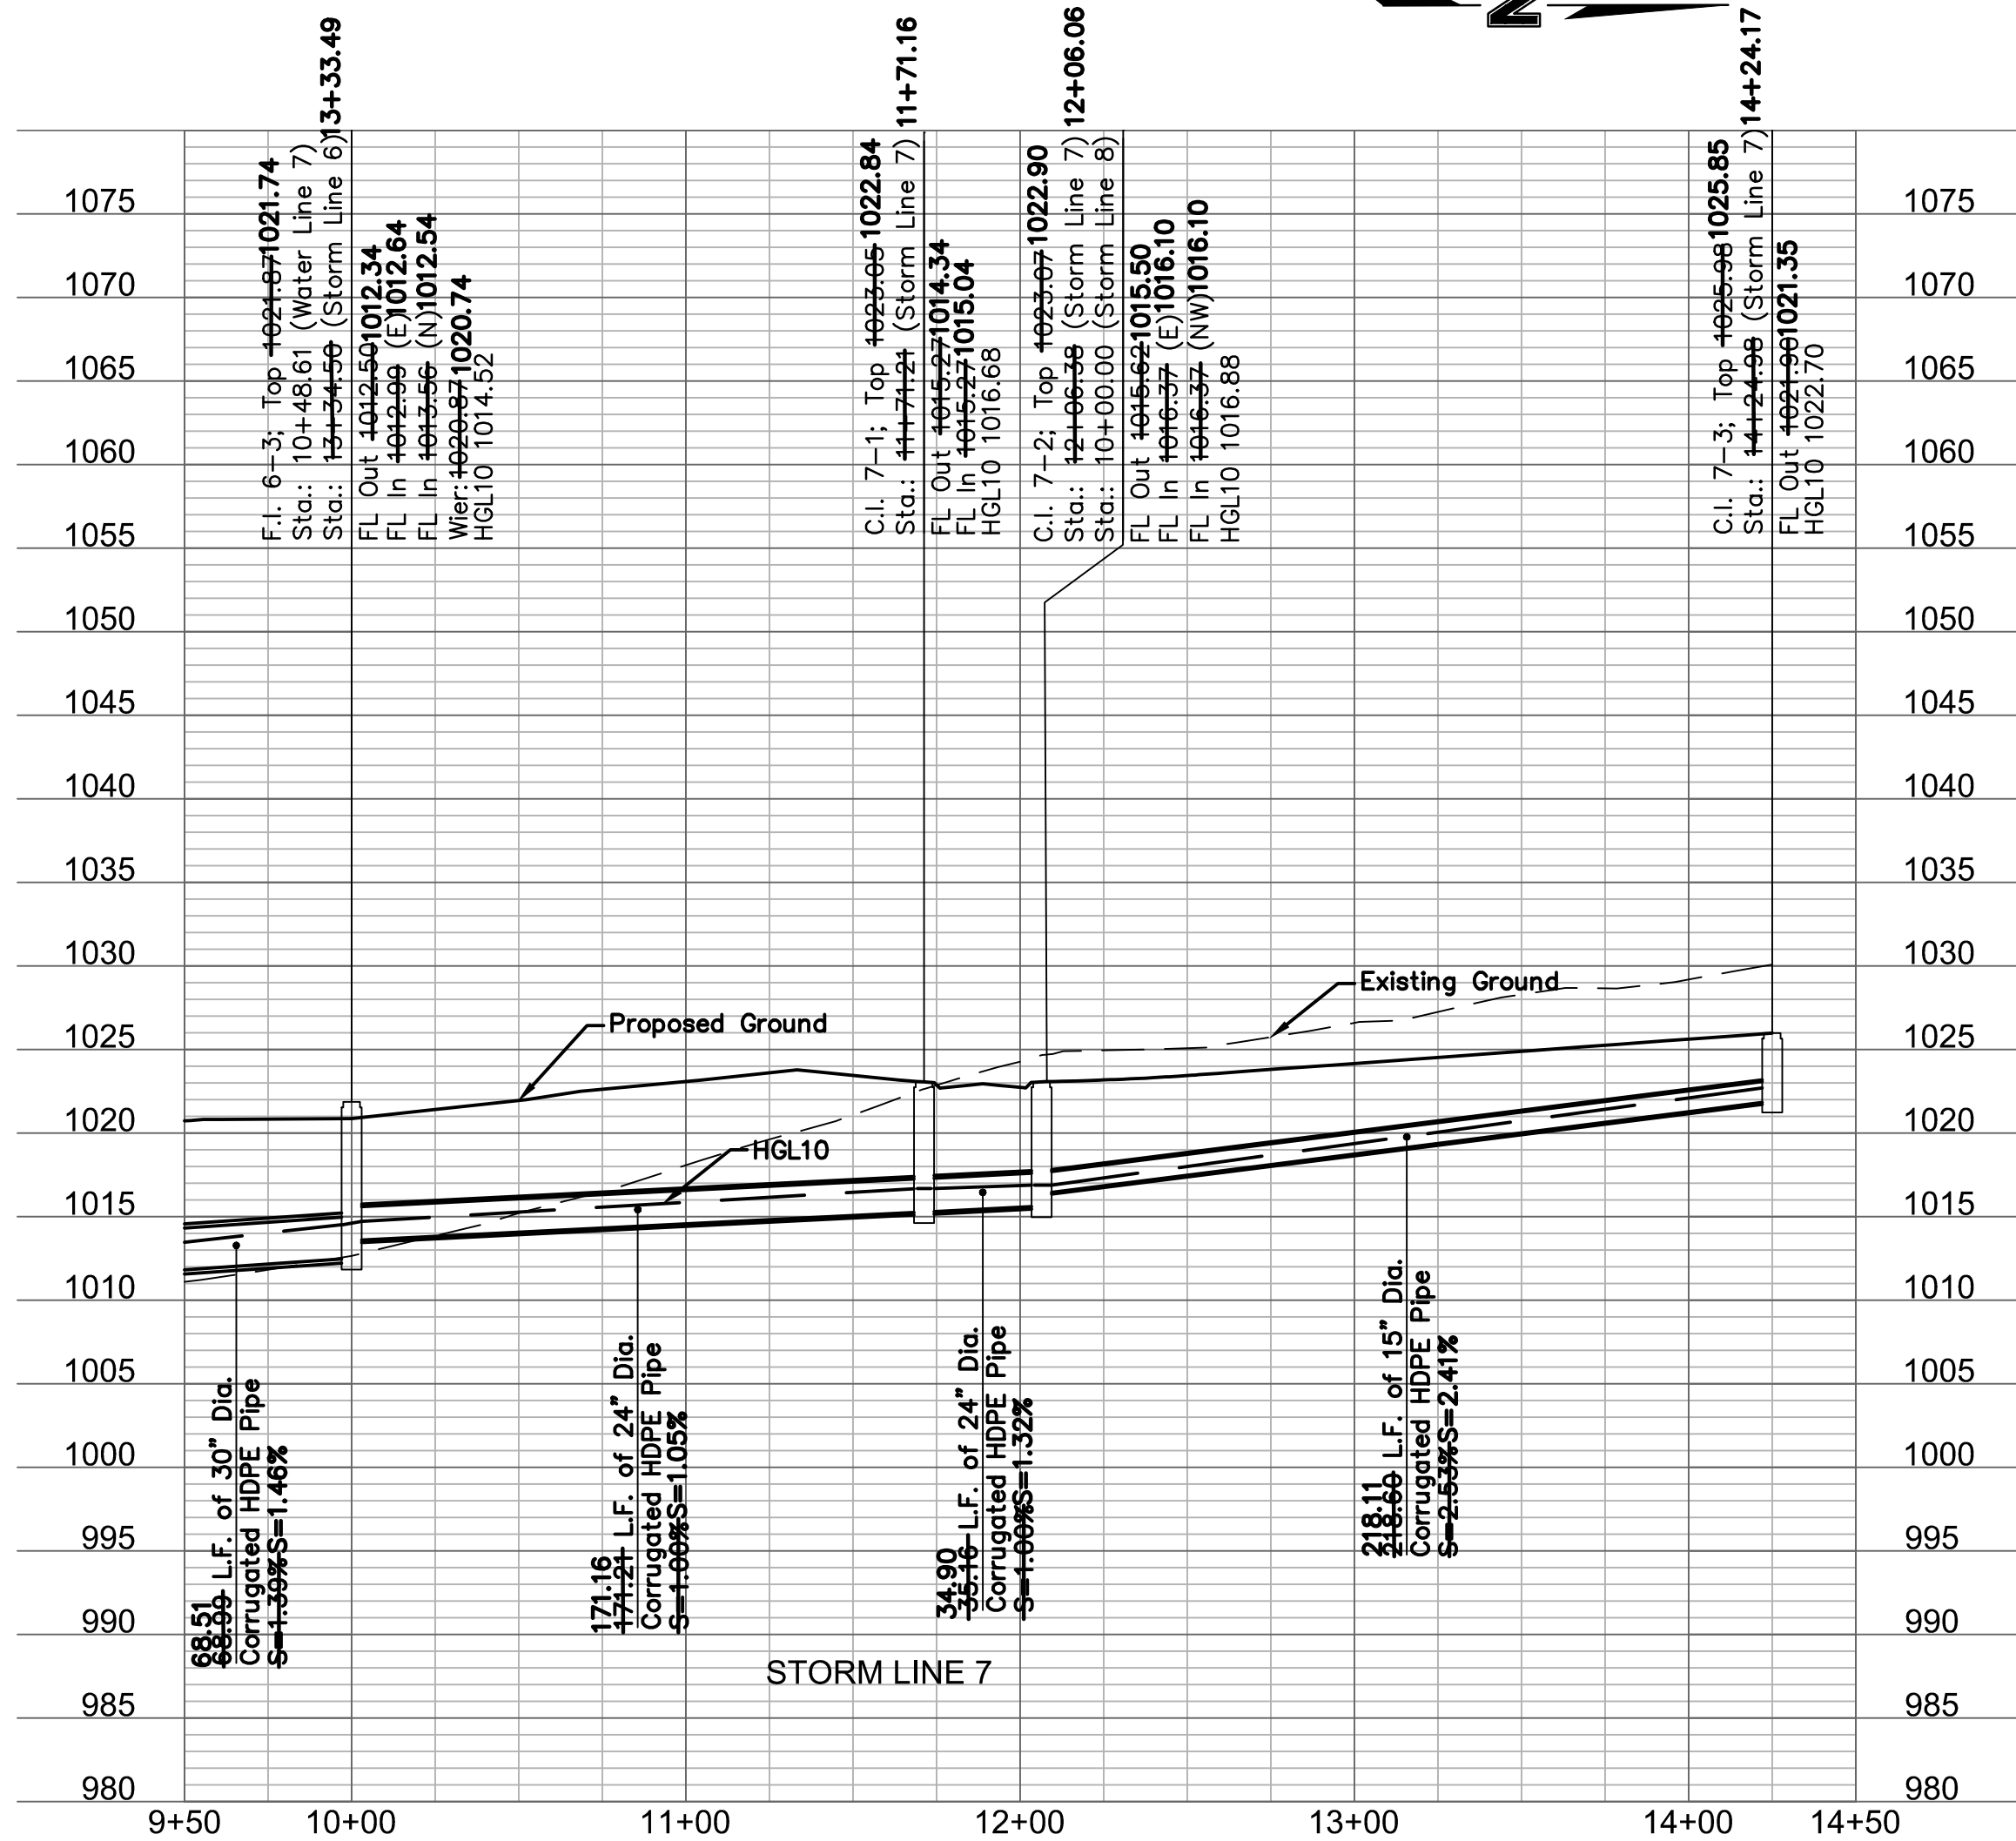


AS BUILT
DATE: 12/19/2018

 Record Drawing



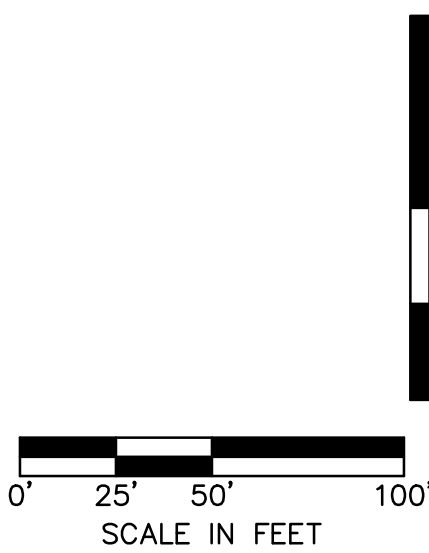


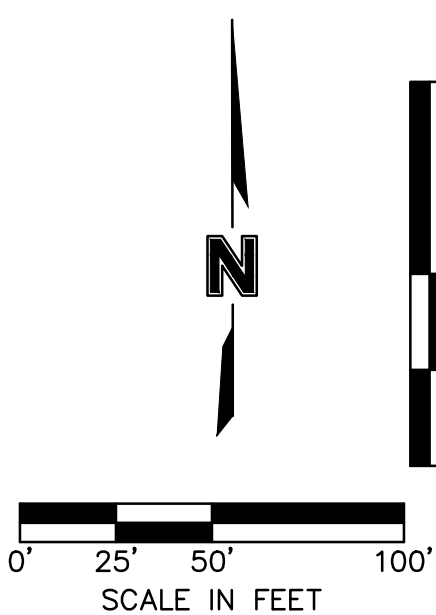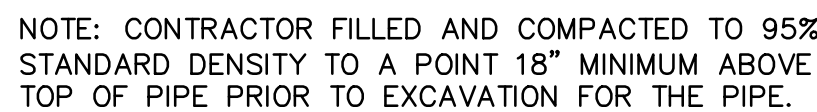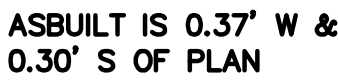

Revised structures

drawn by: D.A.H.Q
checked by: M.G.D.
designed by: P.M.D
QA/QC by: K.S.J
project no.: 017-0188
date: 03.03.2017



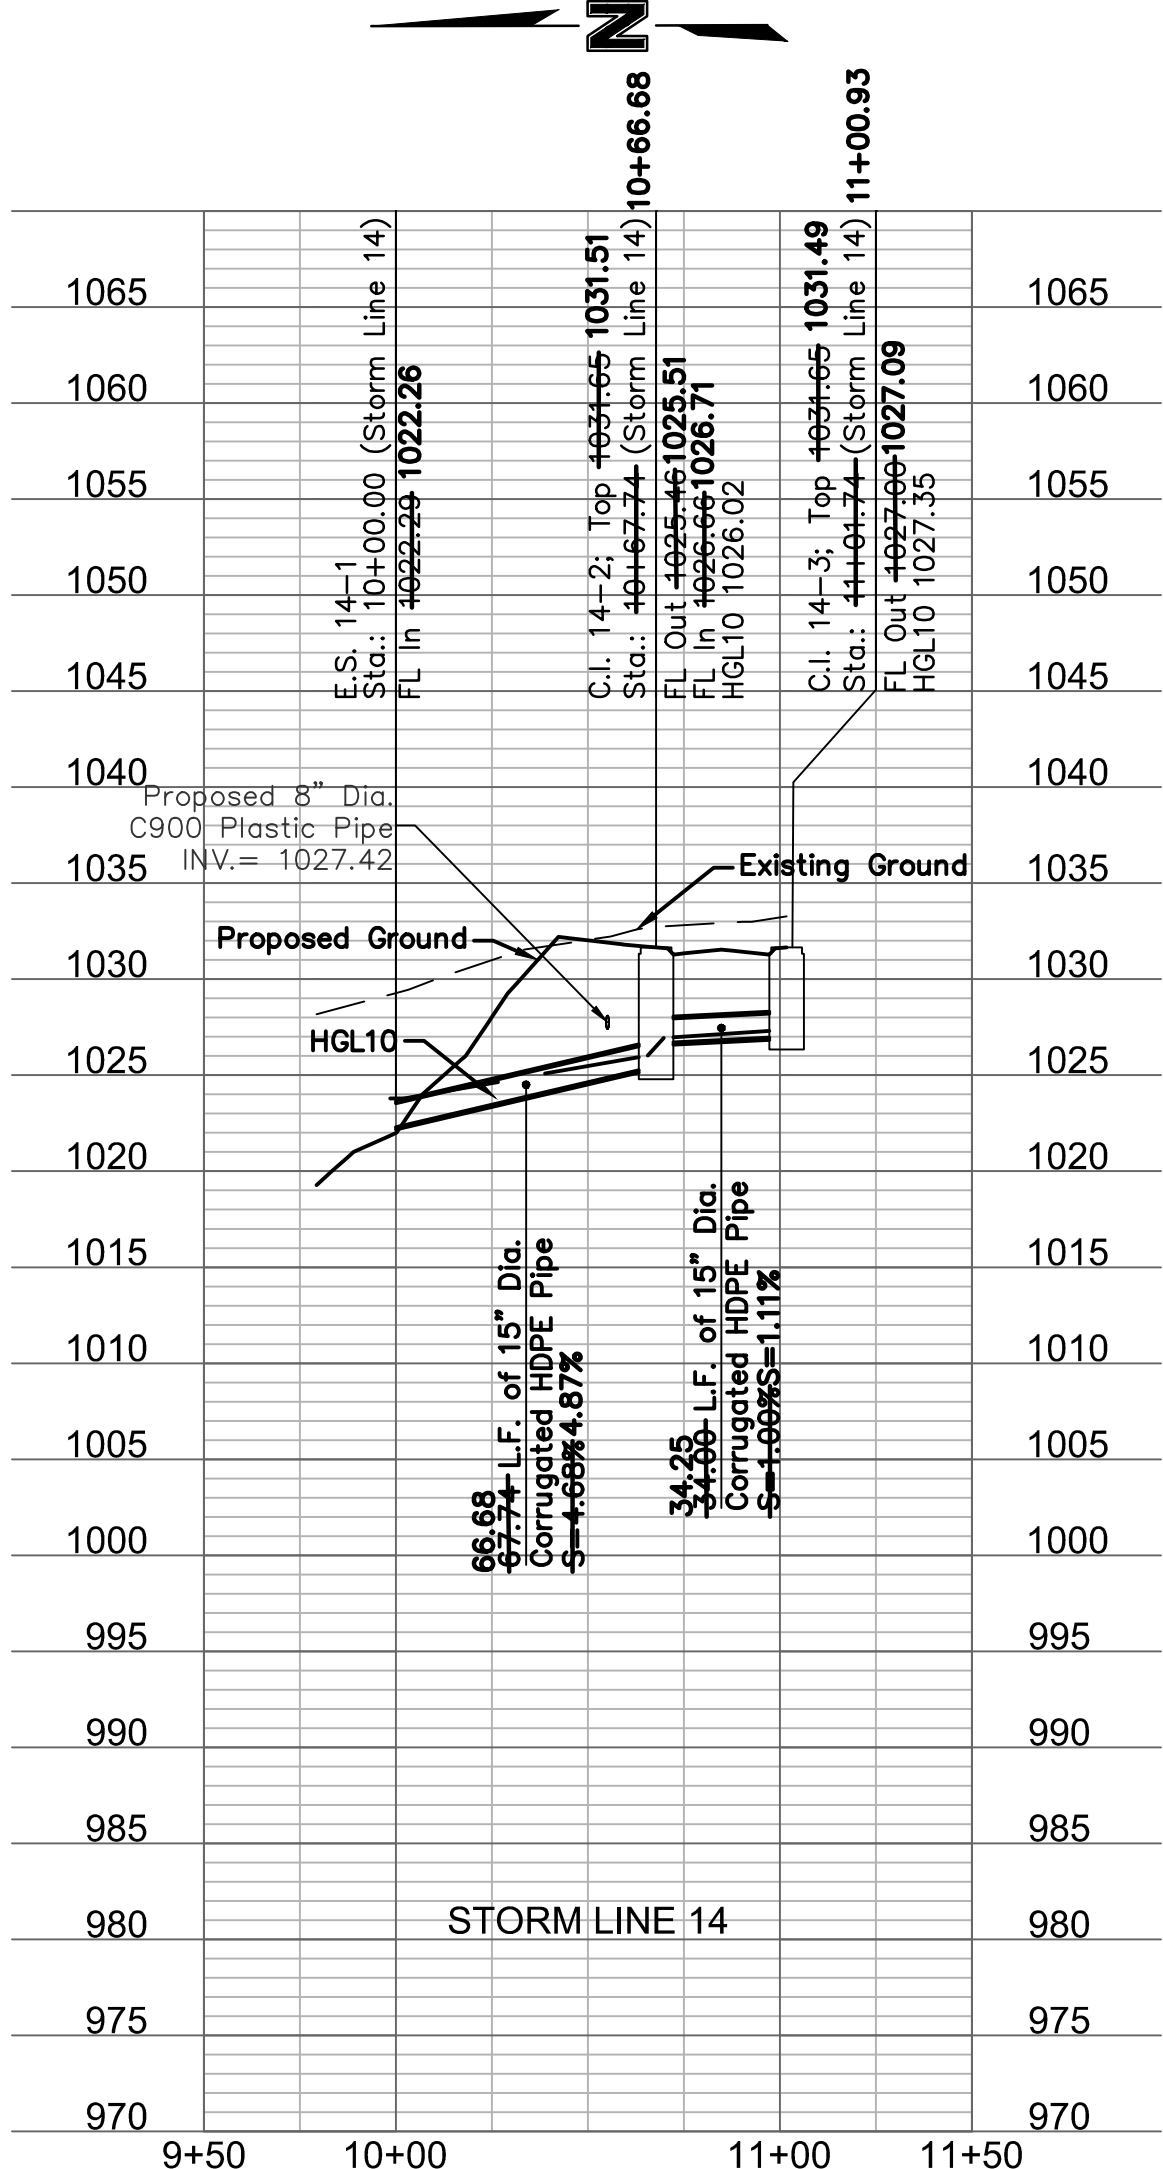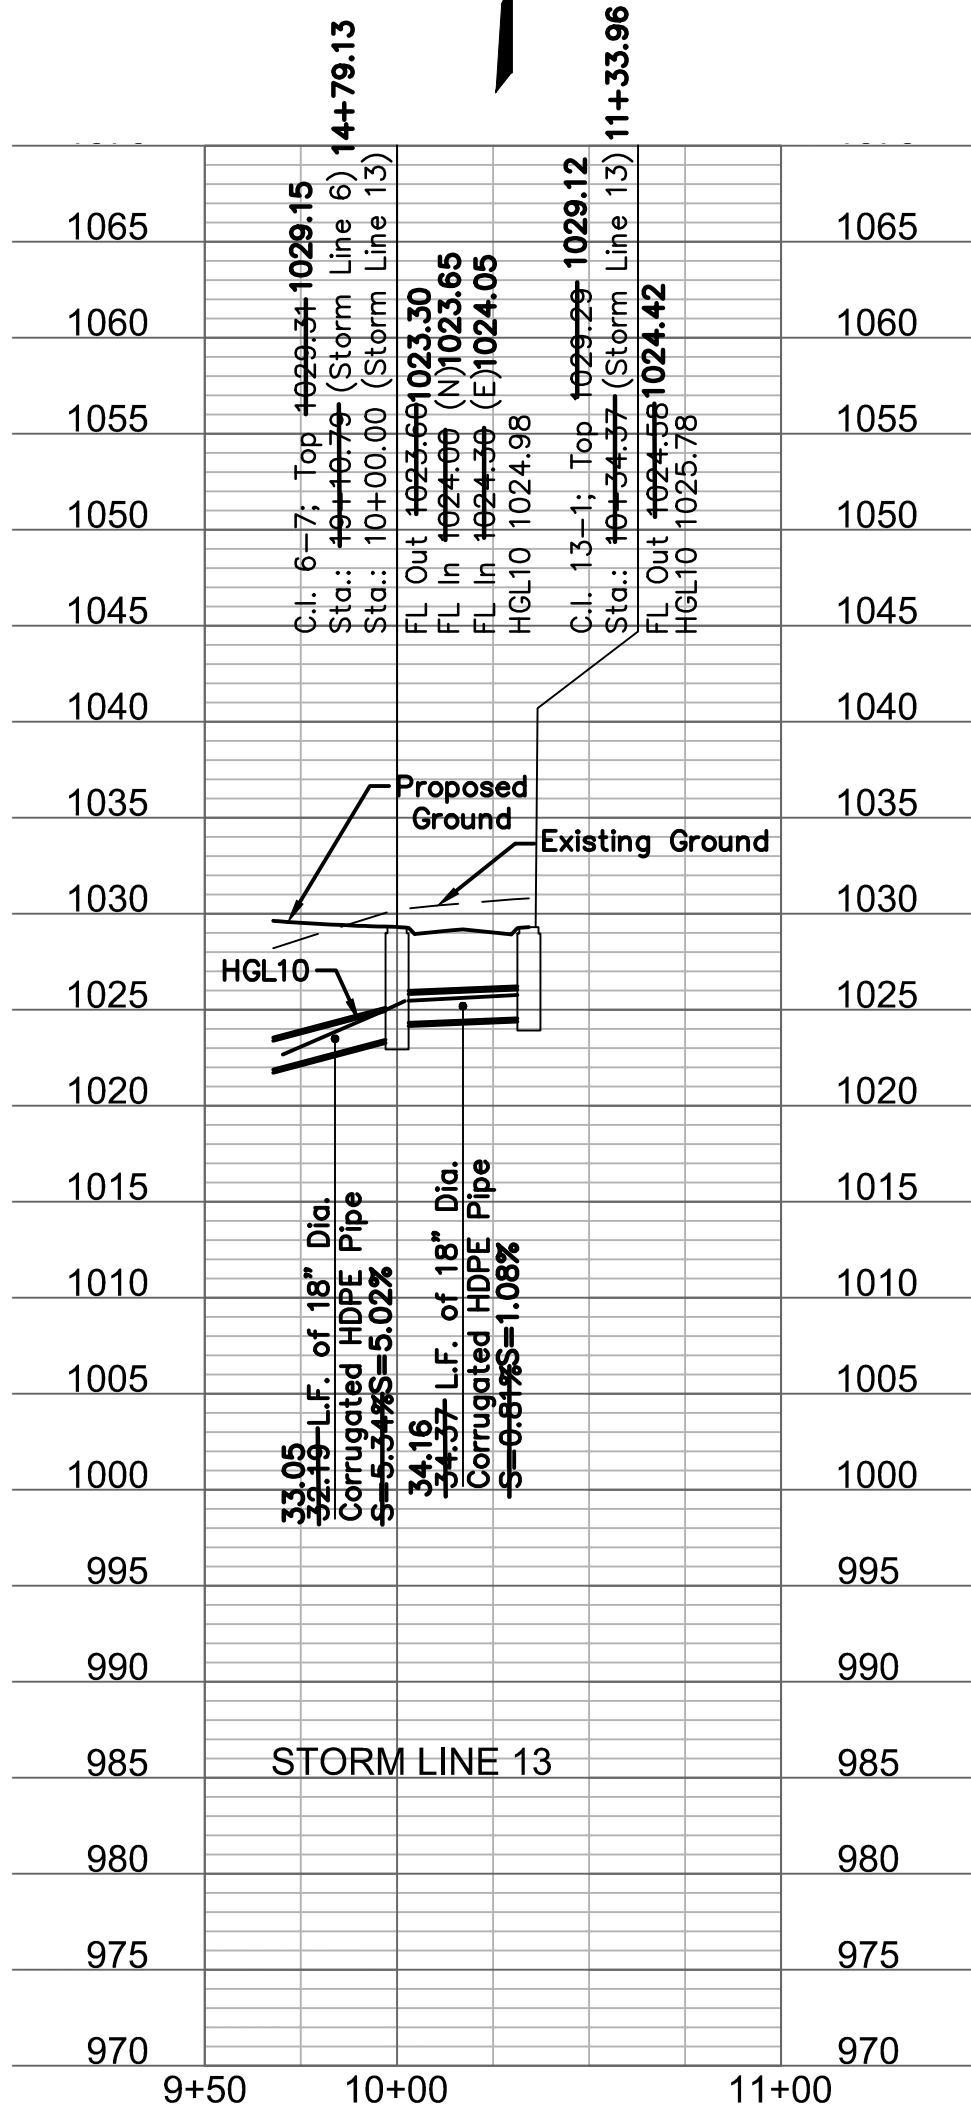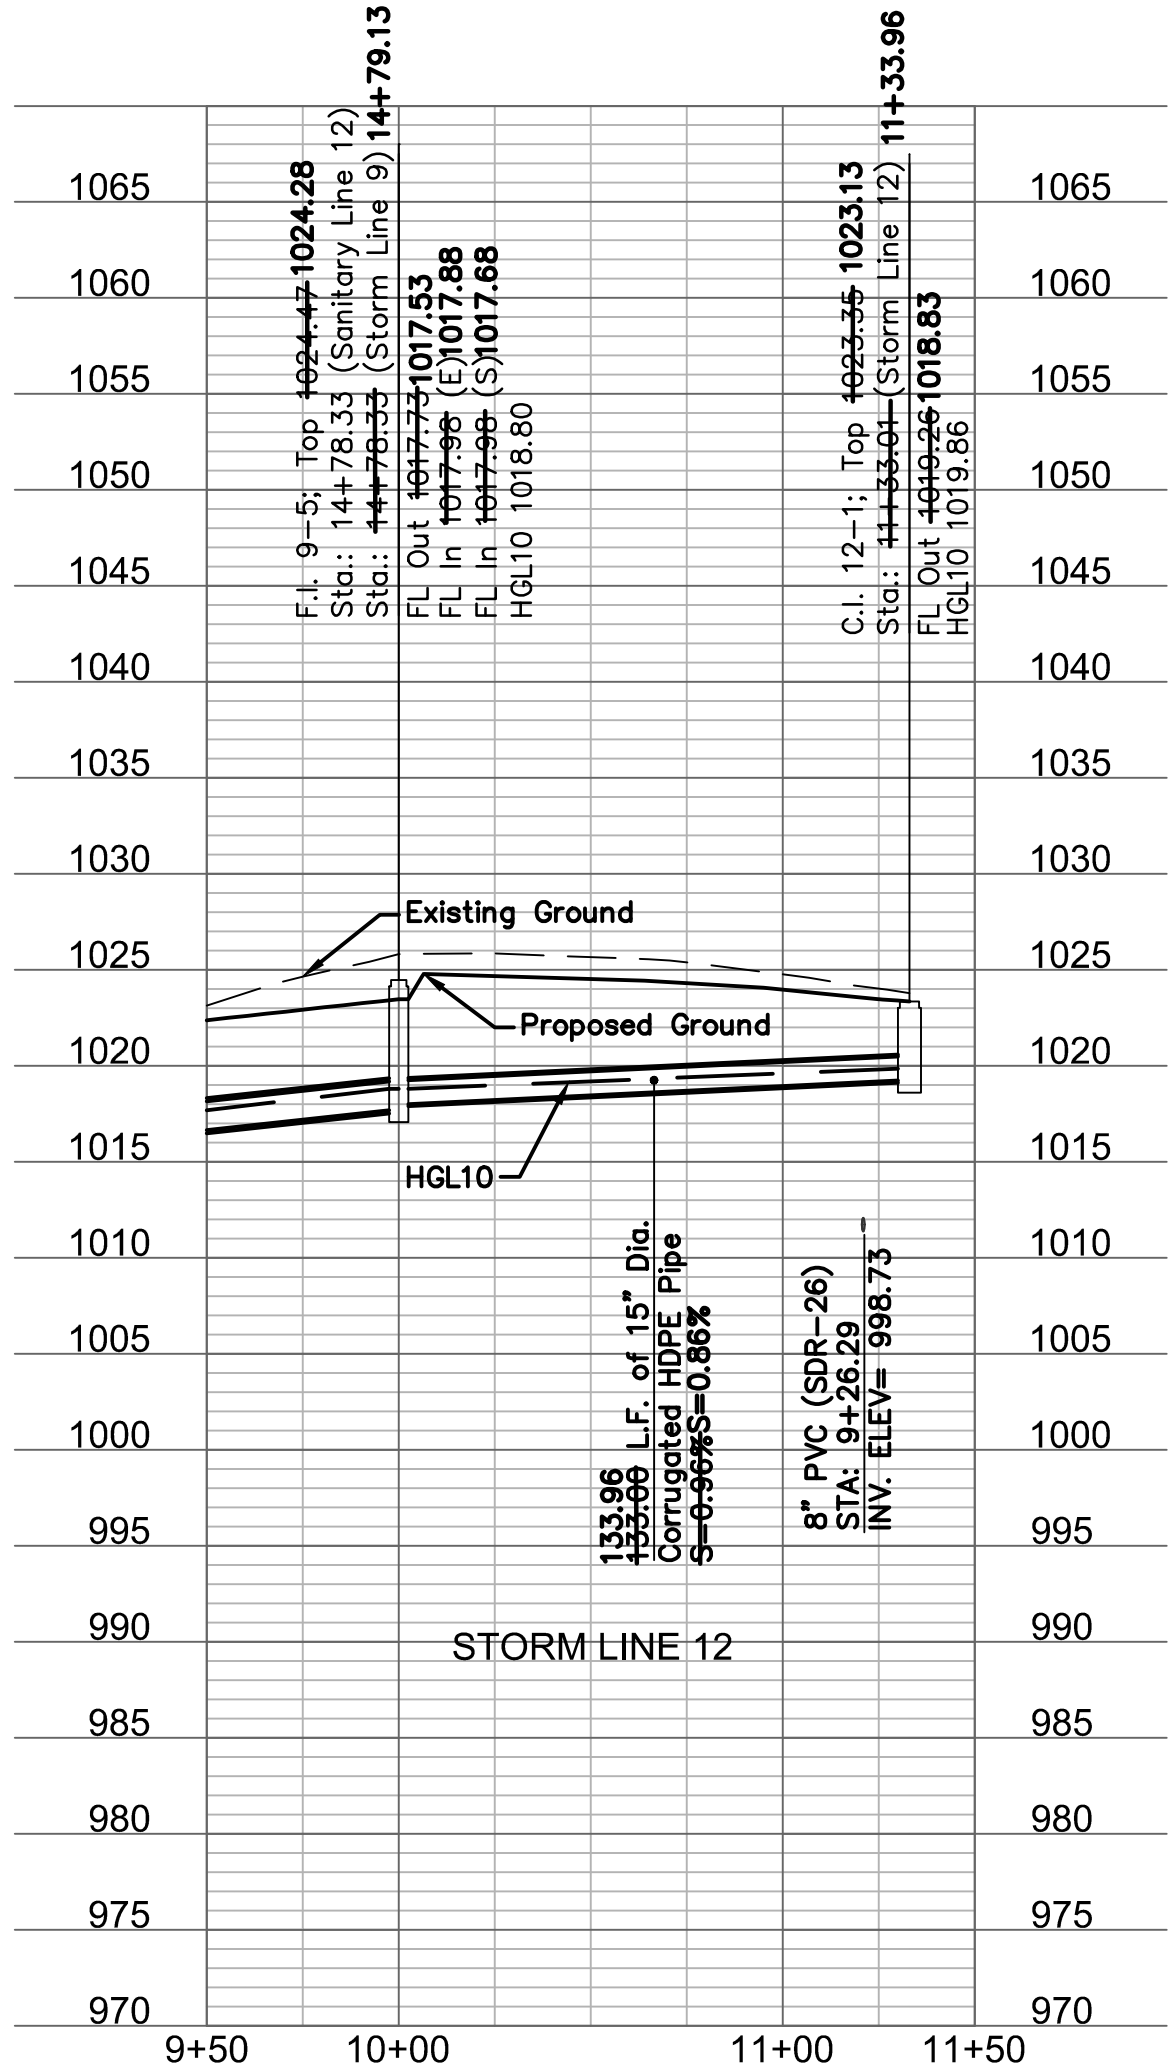

AS BUILT
DATE: 12/19/2018




Record Drawing

Riprap Calculations								
Sturcture	Discharge Flow (cfs)	Pipe Diameter (ft)	Class*	D50* (in)	Apron Length (ft)	Apron Depth (ft)	Apron Width (ft)	Area (SY)
E.S. 14-1	3.49	1.25	1.00	5.00	5	1.46	7.08	3.42
								2.89 S.Y.

*Per Table 10.1 HEC 14-FHWA-Energy Dissipators Pg. 10-18

NOTE: CONTRACTOR FILLED AND COMPACTED TO 95% STANDARD DENSITY TO A POINT 18" MINIMUM ABOVE TOP OF PIPE PRIOR TO EXCAVATION FOR THE PIPE.

ASBUILT IS 0.08' N & 0.33' W OF PLAN
C.I. 12-1, Const. Std. Curb Inlet (5'x3' Inside)
Sta.: 11+33.96 (Storm Line 12)
=Sta.: 12+94.73 (E) 12+94.73
S.W. SUGAR TREE DRIVE, 17.07' LT

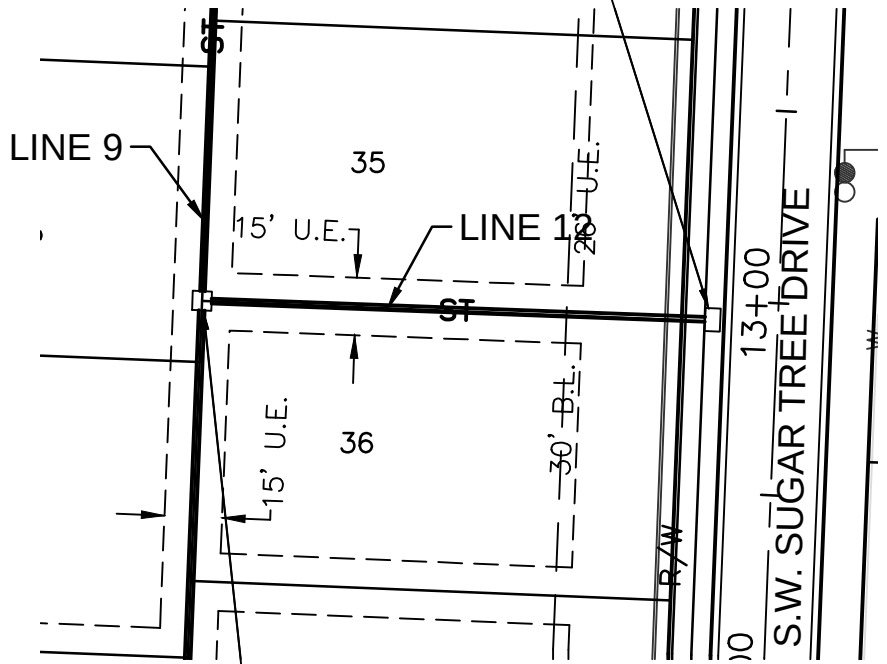


F.I. 9-5, Const. Std. Field Inlet (4'x4' Inside) Open on 4 sides (N,E,S,W)
Sta.: 14+79.13 (Storm Line 9)
=Sta.: 10+00.00 (Storm Line 12)
=Sta.: 12+94.73 (E) 12+94.73
S.W. SUGAR TREE DRIVE, 150.97' LT

ASBUILT IS 1.02' N & 0.19' E OF PLAN

C.I. 6-7, Const. Std. Curb Inlet (5'x3' Inside)
Sta.: 19+10.87 (Storm Line 6)
=Sta.: 10+00.00 (Storm Line 13)
=Sta.: 14+17.81 (E) 14+17.81
S.W. ARBORWOOD DRIVE, 17.06' LT

ASBUILT IS 0.08' N & 0.29' E OF PLAN

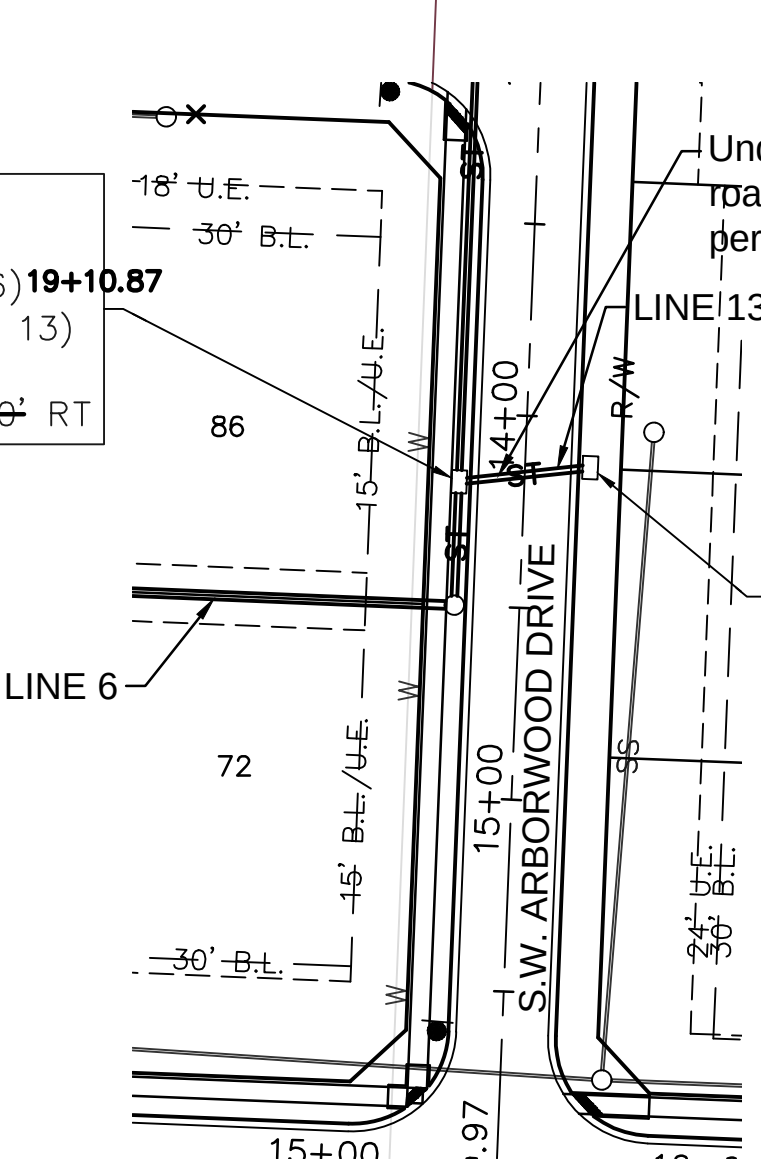

Underdrain installed at roadway sag (Sta. 14+05.34) per underdrain detail.


ASBUILT IS 0.07' E & 0.15' N OF PLAN
C.I. 13-1, Const. Std. Curb Inlet (5'x3' Inside)
Sta.: 10+34.16 (Storm Line 13)
=Sta.: 14+12.64 (E) 14+12.64
S.W. ARBORWOOD DRIVE, 17.06' LT

C.I. 14-2, Const. Std. Curb Inlet (8'x3' Inside)
Sta.: 10+67.74 (Storm Line 14)
=Sta.: 16+55.65 (E) 16+55.65
S.W. ARBOR CREEK DRIVE, 17.06' RT


ASBUILT IS 0.48' W & 0.19' N OF PLAN

ASBUILT IS 1.06' S & 0.37' W OF PLAN

E.S. 14-1, Construct 15 inch CMP End Section (15" CMP) w/ Concrete Toe Wall
Sta.: 10+00.00 (Storm Line 14)
=Sta.: 16+26.94 (E) 16+26.94
S.W. ARBOR CREEK DRIVE, 77.28' RT

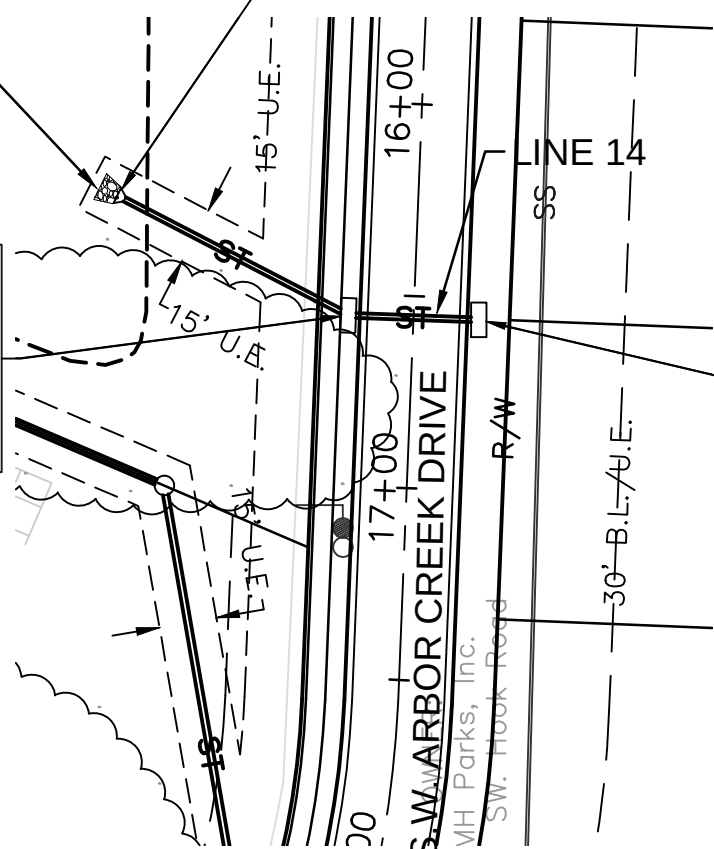

ASBUILT IS 0.14' E & 0.08' S OF PLAN
C.I. 14-3, Const. Std. Curb Inlet (8'x3' Inside)
Sta.: 11+04.74 (Storm Line 14)
=Sta.: 16+55.49 (E) 16+55.49
S.W. ARBOR CREEK DRIVE, 17.07' LT

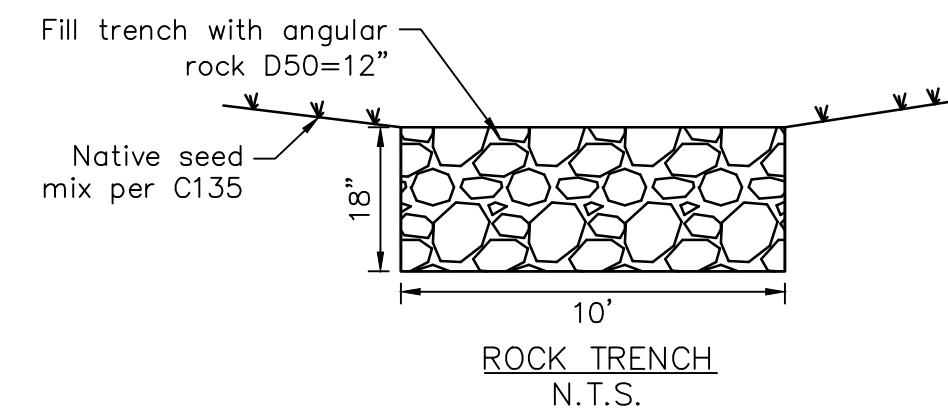


D.B. 15-3, Const. Detention
Structure (4'x4' Inside)
per detail on this sheet
Sta.: ~~41+23.86~~ (Storm Line 15)
N: ~~982,291.9857~~ **982,293.8140**
E: ~~2,813,906.9874~~ **2,813,905.6660**


SHEET
C124

DWG: F:\2017\0001-0500\017-0188\40-Design\AutoCAD\Final Plans\ASBUILTS\GNCV\01_Street & Storm_36x24\C_DBP02_017-0188.dwg

DATE: 12/19/2018

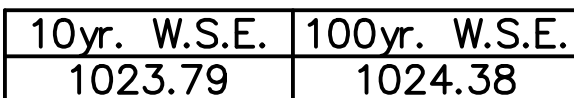

DETENTION BASIN PLAN	HAWTHORN RIDGE 1ST PLAT	LEE'S SUMMIT, MO	2018
drawn by: _____ D.A.H.Q. checked by: _____ M.G.D. designed by: _____ F.M.D. QA/QC by: _____ K.S.J. project no.: 017-0188 date: 03.03.2017			
SHEET C125			

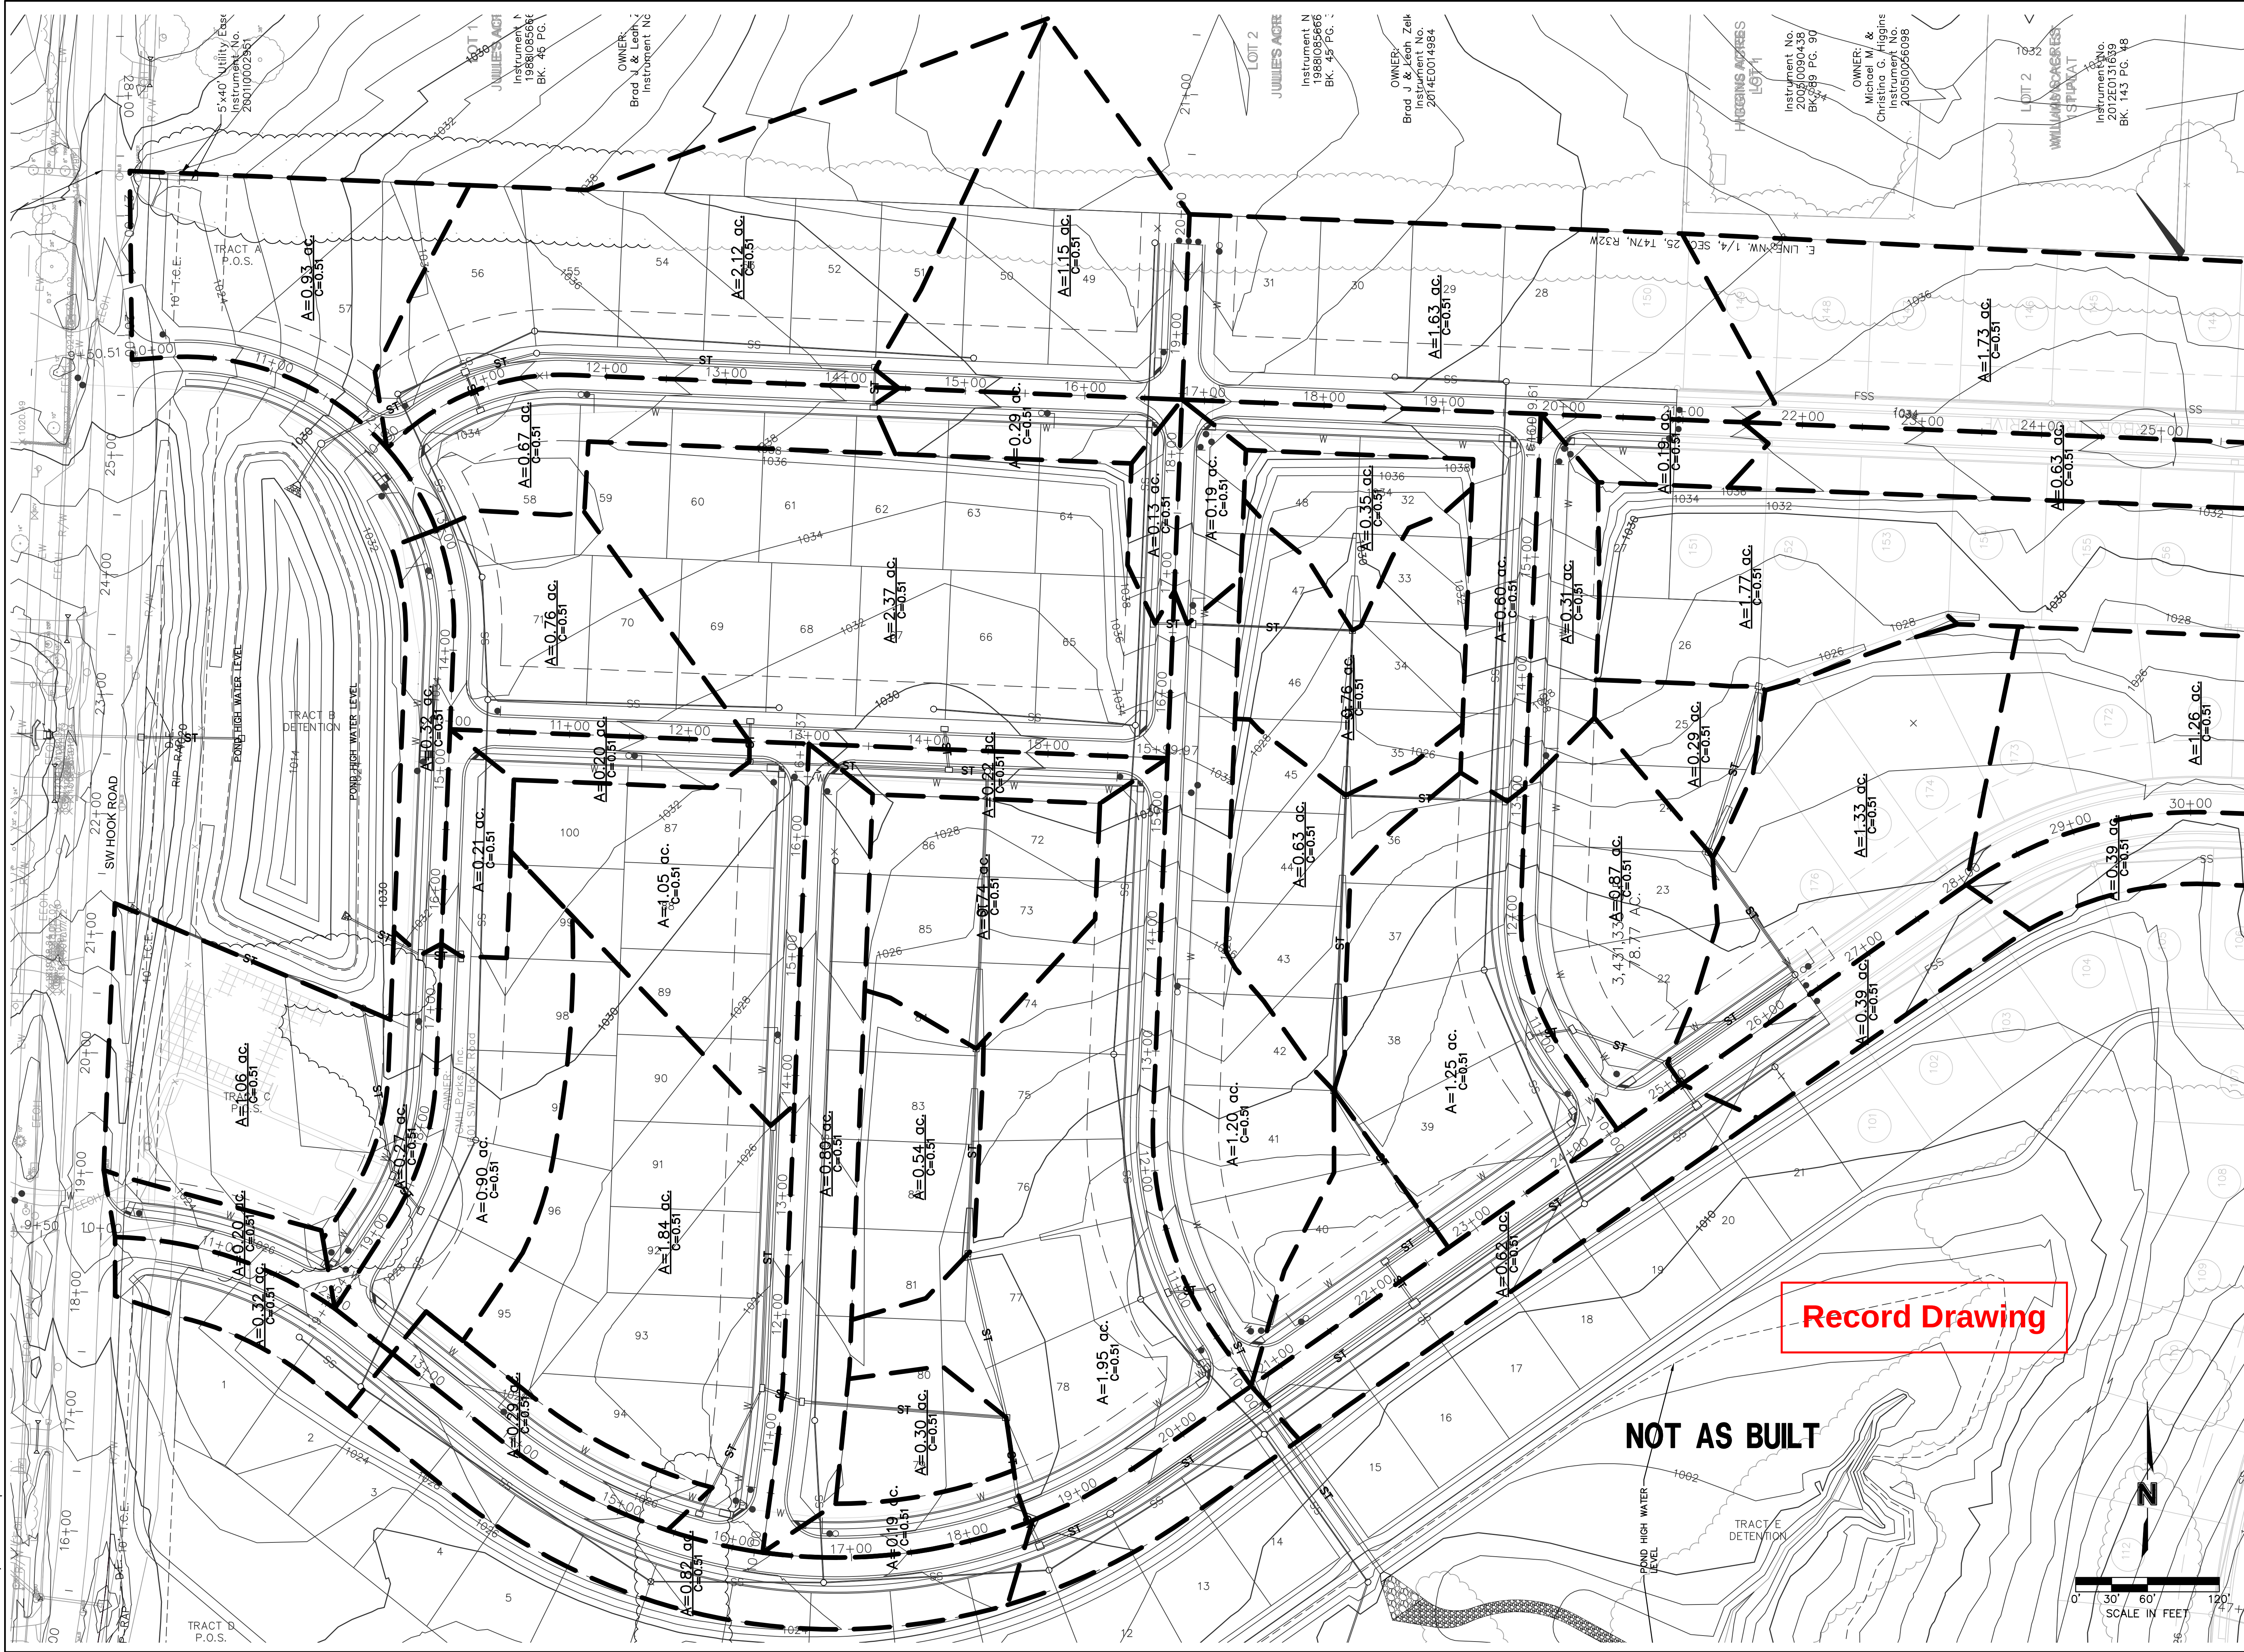

DRAINAGE PLAN		BY	
HAWTHORN RIDGE 1ST PLAT		REVISIONS DESCRIPTION	
LEE'S SUMMIT, MO		REVISIONS	
drawn by:	DA.H.Q.	NO.	DATE
checked by:	M.G.D.	REV.	
designed by:	P.M.L.		
QA/QC by:	K.S.P.		
project no.:	017-0188		
date:	03.03.2017		
SHEET C126		2018	

OLSSON ASSOCIATES

Olsson Associates - Civil Engineering
1800 S. Main Street, Suite 100
North Kansas City, MO 64116
TEL 816.897.4320
FAX 816.897.1393
www.olssonassociates.com

STATE OF MISSOURI
MELISSA G. DEGENIA
NUMBER
PE-2011000892
03/04/2019
PROFESSIONAL ENGINEER

Drainage Area Design Table (10-year Return Frequency)						
Inlet ID	Drainage Area	C	Tc	i	K	Peak Flow
	(ac)		(min)	(in/hr)		(cfs)
C.I. 1-3(L)	0.04	0.51	5.00	7.35	1.00	0.15
C.I. 1-3(R)	0.13	0.51	5.00	7.35	1.00	0.49
C.I. 1-3(B)	0.09	0.51	5.00	7.35	1.00	0.34
C.I. 1-3	0.26	0.51	5.00	7.35	1.00	0.98
C.I. 1-4(L)	0.07	0.51	5.00	7.35	1.00	0.26
C.I. 1-4(R)	0.52	0.51	5.00	7.35	1.00	1.95
C.I. 1-4(B)	0.31	0.51	5.00	7.35	1.00	1.16
C.I. 1-4	0.90	0.51	5.00	7.35	1.00	3.38
C.I. 1-2-1	0.76	0.51	5.00	7.35	1.00	2.85
C.I. 3-3(L)	0.00	0.51	5.00	7.35	1.00	0.00
C.I. 3-3(R)	0.39	0.51	5.00	7.35	1.00	1.46
C.I. 3-3(B)	1.73	0.51	5.00	7.35	1.00	6.49
C.I. 3-3	2.12	0.51	5.00	7.35	1.00	7.95
C.I. 3-5	1.15	0.51	5.00	7.35	1.00	4.31
C.I. 3-6	0.29	0.51	5.00	7.35	1.00	1.09
C.I. 4-1(L)	0.07	0.51	5.00	7.35	1.00	0.26
C.I. 4-1(R)	0.35	0.51	5.00	7.35	1.00	1.31
C.I. 4-1(B)	0.49	0.51	5.00	7.35	1.00	1.84
C.I. 4-1	0.91	0.51	5.00	7.35	1.00	3.41
C.I. 5-4(L)	0.00	0.51	5.00	7.35	1.00	0.00
C.I. 5-4(R)	0.66	0.51	5.00	7.35	1.00	2.48
C.I. 5-4(B)	0.55	0.51	5.00	7.35	1.00	2.06
C.I. 5-4	1.21	0.51	5.00	7.35	1.00	4.54
C.I. 5-5(L)	0.49	0.51	5.00	7.35	1.00	1.84
C.I. 5-5(R)	0.07	0.51	5.00	7.35	1.00	0.26
C.I. 5-5(B)	1.06	0.51	5.00	7.35	1.00	3.98
C.I. 5-5	1.62	0.51	5.00	7.35	1.00	6.08
C.I. 6-1	0.82	0.51	5.00	7.35	1.00	3.08
C.I. 6-2	0.19	0.51	5.00	7.35	1.00	0.71
F.I. 6-3	0.30	0.51	5.00	7.35	1.00	1.13
F.I. 6-4	0.54	0.51	5.00	7.35	1.00	2.03
F.I. 6-5	0.74	0.51	5.00	7.35	1.00	2.78
C.I. 6-7(L)	0.06	0.51	5.00	7.35	1.00	0.23
C.I. 6-7(R)	0.07	0.51	5.00	7.35	1.00	0.26
C.I. 6-7(B)	0.09	0.51	5.00	7.35	1.00	0.34
C.I. 6-7	0.22	0.51	5.00	7.35	1.00	0.83
C.I. 6-8	0.20	0.51	5.00	7.35	1.00	0.75
C.I. 7-1(L)	0.61	0.51	5.00	7.35	1.00	2.29
C.I. 7-1(R)	0.07	0.51	5.00	7.35	1.00	0.26
C.I. 7-1(B)	0.12	0.51	5.00	7.35	1.00	0.45
C.I. 7-1	0.80	0.51	5.00	7.35	1.00	3.00
C.I. 7-2(L)	0.09	0.51	5.00	7.35	1.00	0.34
C.I. 7-2(R)	0.11	0.51	5.00	7.35	1.00	0.41
C.I. 7-2(B)	1.73	0.51	5.00	7.35	1.00	6.49
C.I. 7-2	1.93	0.51	5.00	7.35	1.00	7.24
C.I. 7-3	1.05	0.51	5.00	7.35	1.00	3.94
C.I. 8-1	0.29	0.51	5.00	7.35	1.00	1.09
C.I. 9-2(L)	0.19	0.51	5.00	7.35	1.00	0.71
C.I. 9-2(R)	0.09	0.51	5.00	7.35	1.00	0.34
C.I. -9-2(B)	0.25	0.51	5.00	7.35	1.00	0.94
C.I. 9-2	0.53	0.51	5.00	7.35	1.00	1.99
F.I. 9-4	0.63	0.51	5.00	7.35	1.00	2.36
F.I. 9-5	0.76	0.51	5.00	7.35	1.00	2.85
F.I. 9-6	0.35	0.51	5.00	7.35	1.00	1.31
C.I. 9-7	0.19	0.51	5.00	7.35	1.00	0.71
C.I. 9-8	0.13	0.51	5.00	7.35	1.00	0.49
F.I. 10-2	0.29	0.51	5.00	7.35	1.00	1.09
F.I. 10-3	1.02	0.51	5.00	7.35	1.00	3.83
C.I. 11-1(L)	0.35	0.51	5.00	7.35	1.00	1.31
C.I. 11-1(R)	0.14	0.51	5.00	7.35	1.00	0.53
C.I. 11-1(B)	0.14	0.51	5.00	7.35	1.00	0.53
C.I. 11-1	0.63	0.51	5.00	7.35	1.00	2.36
C.I. 11-2	0.39	0.51	5.00	7.35	1.00	1.46
C.I.11-3	1.33	0.51	5.00	7.35	1.00	4.99
C.I. 11-4(L)	0.23	0.51	5.00	7.35	1.00	0.86
C.I. 11-4(R)	0.05	0.51	5.00	7.35	1.00	0.19
C.I. 11-4(B)	0.59	0.51	5.00	7.35	1.00	2.21
C.I. 11-4	0.87	0.51	5.00	7.35	1.00	3.26
C.I. 11-5(L)	0.21	0.51	5.00	7.35	1.00	0.79
C.I. 11-5(R)	0.19	0.51	5.00	7.35	1.00	0.71
C.I. 11-5(B)	0.85	0.51	5.00	7.35	1.00	3.19
C.I. 11-5	1.25	0.51	5.00	7.35	1.00	4.69
C.I. 12-1	0.60	0.51	5.00	7.35	1.00	2.25
C.I. 13-1(L)	0.21	0.51	5.00	7.35	1.00	0.79
C.I. 13-1(R)	0.20	0.51	5.00	7.35	1.00	0.75
C.I. 13-1(B)	2.16	0.51	5.00	7.35	1.00	8.10
C.I. 13-1	2.57	0.51	5.00	7.35	1.00	9.64
C.I. 14-2	0.32	0.51	5.00	7.35	1.00	1.20
C.I. 14-3	0.21	0.51	5.00	7.35	1.00	0.79

Inlet Design Table (10-year Return Frequency)													
Inlet ID	Inlet Location	Peak Flow	Upstream Bypass	Total Flow	Clogging Factor	Inlet Capacity	Sag Inlet Capacity (Note 1)	Captured Flow	Bypass Flow	Inlet Efficiency (Note 2)	Gutter Depth	Gutter Spread	Ponding Depth
		(cfs)	(cfs)	(cfs)		(cfs)	(cfs)	(cfs)	(cfs)	(%)	(ft)	(ft)	(ft)
C.I. 1-3(L)	SAG	0.15	...	...	...	...	...	...	...	...	0.06	2.85	...
C.I. 1-3(R)	SAG	0.49	...	...	...	...	...	...	...	...	0.09	4.51	...
C.I. 1-3	SAG	0.98	0.00	0.98	0.80	19.40	15.52	0.98	0.00	100.00%	...	...	...
C.I. 1-4(L)	SAG	0.26	...	...	...	...	...	...	...	...	0.07	3.52	...
C.I. 1-4(R)	SAG	1.95	...	...	...	...	...	...	...	...	0.15	7.60	...
C.I. 1-4	SAG	3.38	0.00	3.38	0.80	19.40	15.52	3.38	0.00	100.00%	...	...	...
C.I. 2-1	GRADE	2.85	0.00	2.85	1.00	2.40	2.40	2.40	0.45	84.10%	0.20	9.87	...
C.I. 3-3(L)	SAG	0.00	...	...	...	...	...	...	...	...	0.00	0.00	...
C.I. 3-3(R)	SAG	1.46	...	...	...	...	...	...	...	...	0.18	8.86	...
C.I. 3-3	SAG	7.95	0.00	7.95	0.80	19.40	15.52	7.95	0.00	100.00%	...	...	...
C.I. 3-5	GRADE	4.31	0.00	4.31	1.00	2.90	2.90	2.90	1.41	67.22%	0.21	10.31	...
C.I. 3-6	GRADE	1.09	0.00	1.09	1.00	0.99	0.99	0.99	0.10	90.79%	0.12	6.15	...
C.I. 4-1(L)	SAG	0.26	...	...	...	...	...	...	...	...	0.07	3.58	...
C.I. 4-1(R)	SAG	1.31	...	...	...	...	...	...	...	...	0.14	6.78	...
C.I. 4-1	SAG	3.41	0.00	3.41	0.80	19.40	15.52	3.41	0.00	100.00%	...	...	...
C.I. 5-4(L)	SAG	0.00	...	...	...	...	...	...	...	...	0.04	2.23	...
C.I. 5-4(R)	SAG	2.48	...	...	...	...	...	...	...	...	0.16	7.99	...
C.I. 5-4	SAG	4.54	0.00	4.54	0.80	19.40	15.52	4.54	0.00	100.00%	...	...	...
C.I. 5-5(L)	SAG	1.84	...	...	...	...	...	...	...	...	0.15	7.30	...
C.I. 5-5(R)	SAG	0.26	...	...	...	...	...	...	...	...	0.07	3.44	...
C.I. 5-5	SAG	6.08	0.00	6.08	0.80	19.40	15.52	6.08	0.00	100.00%	...	...	...
C.I. 6-1	GRADE	3.08	0.00	3.08	1.00	2.78	2.78	2.78	0.29	90.55%	0.19	8.79	...
C.I. 6-2	GRADE	0.71	0.00	0.71	1.00	0.71	0.71	0.71	0.00	99.97%	0.11	5.08	...
F.I. 6-3	SAG	1.13	...	...	...	...	...	...	...	...	...	...	0.09
F.I. 6-4	SAG	2.03	...	...	...	...	...	...	...	...	...	...	0.14
F.I. 6-5	SAG	2.78	...	...	...	...	...	...	...	...	...	...	0.17
C.I. 6-7(L)	SAG	0.23	...	...	...	...	...	...	...	...	0.07	3.37	...
C.I. 6-7(R)	SAG	0.26	...	...	...	...	...	...	...	...	0.08	4.02	...
C.I. 6-7	SAG	0.83	0.00	0.83	0.80	19.40	15.52	0.83	0.00	100.00%	...	...	...
C.I. 6-8	GRADE	0.75	0.00	0.75	1.00	0.72	0.72	0.72	0.03	96.30%	0.12	5.99	...
C.I. 7-1(L)	SAG	2.29	...	...	...	...	...	...	...	...	0.17	8.45	...
C.I. 7-1(R)	SAG	0.26	...	...	...	...	...	...	...	...	0.07	3.44	...
C.I. 7-1	SAG	3.00	0.00	3.00	0.80	19.40	15.52	3.00	0.00	100.00%	...	...	...
C.I. 7-2(L)	SAG	0.34	...	...	...	...	...	...	...	...	0.14	7.01	...
C.I. 7-2(R)	SAG	0.41	...	...	...	...	...	...	...	...	0.08	4.10	...
C.I. 7-2	SAG	7.24	0.00	7.24	0.80	19.40	15.52	7.24	0.00	100.00%	...	...	...
C.I. 7-3	GRADE	3.94	0.00	3.94	1.00	2.88	2.88	2.88	1.06	73.20%	0.21	10.40	...
C.I. 8-1	GRADE	1.09	0.00	1.09	1.00	1.08	1.08	1.08	0.01	99.47%	0.13	5.95	...
C.I. 9-2(L)	SAG	0.71	...	...	...	...	...	...	...	...	0.12	5.72	...
C.I. 9-2(R)	SAG	0.34	...	...	...	...	...	...	...	...	0.09	4.32	...
C.I. 9-2	SAG	1.99	0.00	1.99	0.80	19.40	15.52	1.99	0.00	100.00%	...	...	...
F.I. 9-4	SAG	2.36	...	...	...	...	...	...	...	...	...	...	0.15
F.I. 9-5	SAG	2.85	...	...	...	...	...	...	...	...	...	...	0.17
F.I. 9-6	SAG	1.31	...	...	...	...	...	...	...	...	...	...	0.10
C.I. 9-7	GRADE	0.71	0.00	0.71	1.00	0.63	0.63	0.63	0.08	88.55%	...	...	...
C.I. 9-8	GRADE	0.49	0.00	0.49	1.00	0.45	0.45	0.45	0.04	92.32%	...	...	...
F.I. 10-2	SAG	1.09	...	...	...	...	...	...	...	...	...	...	0.09
F.I. 10-3	SAG	3.83	...	...	...	...	...	...	...	...	...	...	0.21
C.I. 11-1(L)	SAG	1.31	...	...	...	...	...	...	...	...	0.17	7.83	...
C.I. 11-1(R)	SAG	0.53	...	...	...	...	...	...	...	...	0.13	6.02	...
C.I. 11-1	SAG	2.36	0.00	2.36	0.80	19.40	15.52	2.36	0.00	100.00%	...	...	...
C.I. 11-2	GRADE	1.46	0.00	1.46	1.00	1.13	1.13	1.13	0.33	77.37%	...	...	...
C.I. 11-3	GRADE	4.99	0.00	4.99	1.00	4.33	4.33	4.33	0.66	86.79%	...	...	...
C.I. 11-4(L)	SAG	0.86	...	...	...	...	...	...	...	...	0.11	5.59	...
C.I. 11-4(R)	SAG	0.19	...	...	...	...	...	...	...	...	0.06	3.15	...
C.I. 11-4	SAG	3.26	0.00	3.26	0.80	19.40	15.52	3.26	0.00	100.00%	...	...	...
C.I. 11-5(L)	SAG	0.79	...	...	...	...	...	...	...	...	0.14	7.07	...
C.I. 11-5(R)	SAG	0.71	...	...	...	...	...	...	...	...	0.10	5.20	...
C.I. 11-5	SAG	4.69	0.00	4.69	0.80	19.40	15.52	4.69	0.00	100.00%	...	...	...
C.I. 12-1	GRADE	2.25	0.00	2.25	1.00	1.42	1.42	1.42	0.83	63.32%	0.13	6.52	...
C.I. 13-1(L)	SAG	0.79	...	...	...	...	...	...	...	...	0.11	5.49	...
C.I. 13-1(R)	SAG	0.75	...	...	...	...	...	...	...	...	0.14	6.85	...
C.I. 13-1	SAG	9.64	0.00	9.64	0.80	19.40	15.52	9.64	0.00	100.00%	...	...	...
C.I. 14-2	GRADE	1.20	0.00	1.20	1.00	1.16	1.16	1.16	0.04	96.61%	0.14	6.92	...
C.I. 14-3	GRADE	0.79	0.00	0.79	1.00	0.78	0.78	0.78	0.01	98.63%	0.12	5.91	...
Notes:													
1. Inlet capacity at sag location has been reduced by a clogging factor of 0.80, reducing theoretical capacity to 80% capacity, as required per APWA Section 5600.													
Both theoretical capacity and reduced capacity are shown.													
2. Inlet efficiency shown in the tables is Captured Flow/Total Flow, denoting the actual percentage of flow captured after the capacity has been reduced to 80% of theoretical capacity.													

Drainage Area Design Table (100-year Return Frequency)						
Inlet ID	Drainage Area	C	Tc	i	K	Peak Flow
	(ac)		(min)	(in/hr)		(cfs)
C.I. 1-3(L)	0.04	0.51	5.00	10.32	1.25	0.26
C.I. 1-3(R)	0.13	0.51	5.00	10.32	1.25	0.86
C.I. 1-3(B)	0.09	0.51	5.00	10.32	1.25	0.59
C.I. 1-3	0.26	0.51	5.00	10.32	1.25	1.71
C.I. 1-4(L)	0.07	0.51	5.00	10.32	1.25	0.46
C.I. 1-4(R)	0.52	0.51	5.00	10.32	1.25	3.42
C.I. 1-4(B)	0.31	0.51	5.00	10.32	1.25	2.04
C.I. 1-4	0.90	0.51	5.00	10.32	1.25	5.92
C.I. 2-1	0.76	0.51	5.00	10.32	1.25	5.00
C.I. 3-3(L)	0.00	0.51	5.00	10.32	1.25	0.00
C.I. 3-3(R)	0.39	0.51	5.00	10.32	1.25	2.57
C.I. 3-3(B)	1.73	0.51	5.00	10.32	1.25	11.38
C.I. 3-3	2.12	0.51	5.00	10.32	1.25	13.95
C.I. 3-5	1.15	0.51	5.00	10.32	1.25	7.57
C.I. 3-6	0.29	0.51	5.00	10.32	1.25	1.91
C.I. 4-1(L)	0.07	0.51	5.00	10.32	1.25	0.46
C.I. 4-1(R)	0.35	0.51	5.00	10.32	1.25	2.30
C.I. 4-1(B)	0.49	0.51	5.00	10.32	1.25	3.22
C.I. 4-1	0.91	0.51	5.00	10.32	1.25	5.99
C.I. 5-4(L)	0.00	0.51	5.00	10.32	1.25	0.00
C.I. 5-4(R)	0.66	0.51	5.00	10.32	1.25	4.34
C.I. 5-4(B)	0.55	0.51	5.00	10.32	1.25	3.62
C.I. 5-4	1.21	0.51	5.00	10.32	1.25	7.96
C.I. 5-5(L)	0.49	0.51	5.00	10.32	1.25	3.22
C.I. 5-5(R)	0.07	0.51	5.00	10.32	1.25	0.46
C.I. 5-5(B)	1.06	0.51	5.00	10.32	1.25	6.98
C.I. 5-5	1.62	0.51	5.00	10.32	1.25	10.66
C.I. 6-1	0.82	0.51	5.00	10.32	1.25	5.40
C.I. 6-2	0.19	0.51	5.00	10.32	1.25	1.25
F.I. 6-3	0.30	0.51	5.00	10.32	1.25	1.97
F.I. 6-4	0.54	0.51	5.00	10.32	1.25	3.55
F.I. 6-5	0.74	0.51	5.00	10.32	1.25	4.87
C.I. 6-7(L)	0.06	0.51	5.00	10.32	1.25	0.39
C.I. 6-7(R)	0.07	0.51	5.00	10.32	1.25	0.46
C.I. 6-7(B)	0.09	0.51	5.00	10.32	1.25	0.59
C.I. 6-7	0.22	0.51	5.00	10.32	1.25	1.45
C.I. 6-8	0.20	0.51	5.00	10.32	1.25	1.32
C.I. 7-1(L)	0.61	0.51	5.00	10.32	1.25	4.01
C.I. 7-1(R)	0.07	0.51	5.00	10.32	1.25	0.46
C.I. 7-1(B)	0.12	0.51	5.00	10.32	1.25	0.79
C.I. 7-1	0.80	0.51	5.00	10.32	1.25	5.26
C.I. 7-2(L)	0.09	0.51	5.00	10.32	1.25	0.59
C.I. 7-2(R)	0.11	0.51	5.00	10.32	1.25	0.72
C.I. 7-2(B)	1.73	0.51	5.00	10.32	1.25	11.38
C.I. 7-2	1.93	0.51	5.00	10.32	1.25	12.70
C.I. 7-3	1.05	0.51	5.00	10.32	1.25	6.91
C.I. 8-1	0.29	0.51	5.00	10.32	1.25	1.91
C.I. 9-2(L)	0.19	0.51	5.00	10.32	1.25	1.25
C.I. 9-2(R)	0.09	0.51	5.00	10.32	1.25	0.59
C.I. 9-2(B)	0.25	0.51	5.00	10.32	1.25	1.65
C.I. 9-2	0.53	0.51	5.00	10.32	1.25	3.49
F.I. 9-4	0.63	0.51	5.00	10.32	1.25	4.15
F.I. 9-5	0.76	0.51	5.00	10.32	1.25	5.00
F.I. 9-6	0.35	0.51	5.00	10.32	1.25	2.30
C.I. 9-7	0.19	0.51	5.00	10.32	1.25	1.25
C.I. 9-8	0.13	0.51	5.00	10.32	1.25	0.86
F.I. 10-2	0.29	0.51	5.00	10.32	1.25	1.91
F.I. 10-3	1.02	0.51	5.00	10.32	1.25	6.71
C.I. 11-1(L)	0.35	0.51	5.00	10.32	1.25	2.30
C.I. 11-1(R)	0.14	0.51	5.00	10.32	1.25	0.92
C.I. 11-1(B)	0.14	0.51	5.00	10.32	1.25	0.92
C.I. 11-1	0.63	0.51	5.00	10.32	1.25	4.15
C.I. 11-2	0.39	0.51	5.00	10.32	1.25	2.57
C.I. 11-3	1.33	0.51	5.00	10.32	1.25	8.75
C.I. 11-4(L)	0.23	0.51	5.00	10.32	1.25	1.51
C.I. 11-4(R)	0.05	0.51	5.00	10.32	1.25	0.33
C.I. 11-4(B)	0.59	0.51	5.00	10.32	1.25	3.88
C.I. 11-4	0.87	0.51	5.00	10.32	1.25	5.73
C.I. 11-5(L)	0.21	0.51	5.00	10.32	1.25	1.38
C.I. 11-5(R)	0.19	0.51	5.00	10.32	1.25	1.25
C.I. 11-5(B)	0.85	0.51	5.00	10.32	1.25	5.59
C.I. 11-5	1.25	0.51	5.00	10.32	1.25	8.23
C.I. 12-1	0.60	0.51	5.00	10.32	1.25	3.95
C.I. 13-1(L)	0.21	0.51	5.00	10.32	1.25	1.38
C.I. 13-1(R)	0.20	0.51	5.00	10.32	1.25	1.32
C.I. 13-1(B)	2.16	0.51	5.00	10.32	1.25	14.21
C.I. 13-1	2.57	0.51	5.00	10.32	1.25	16.91
C.I. 14-2	0.32	0.51	5.00	10.32	1.25	2.11
C.I. 14-3	0.21	0.51	5.00	10.32	1.25	1.38

Inlet Design Table (100-year Return Frequency)													
Inlet ID	Inlet Location	Peak Flow	Upstream Bypass	Total Flow	Clogging Factor	Inlet Capacity	Sag Inlet Capacity (Note 1)	Captured Flow	Bypass Flow	Inlet Efficiency (Note 2)	Gutter Depth	Gutter Spread	Ponding Depth
		(cfs)	(cfs)	(cfs)		(cfs)	(cfs)	(cfs)	(cfs)	(%)	(ft)	(ft)	(ft)
C.I. 1-3(L)	SAG	0.26	...	...	...	...	...	...	...	...	0.07	3.52	...
C.I. 1-3(R)	SAG	0.86	...	...	...	...	...	...	...	...	0.11	5.57	...
C.I. 1-3	SAG	1.71	0.00	1.71	0.80	19.40	15.52	1.71	0.00	100.00%	...	...	...
C.I. 1-4(L)	SAG	0.46	...	...	...	...	...	...	...	...	0.09	4.35	...
C.I. 1-4(R)	SAG	3.42	...	...	...	...	...	...	...	...	0.19	9.43	...
C.I. 1-4	SAG	5.92	0.00	5.92	0.80	19.40	15.52	5.92	0.00	100.00%	...	...	...
C.I. 2-1	GRADE	5.00	0.00	5.00	1.00	3.68	3.68	3.68	1.32	73.67%	0.24	12.19	...
C.I. 3-3(L)	SAG	0.00	...	...	...	...	...	...	...	...	0.00	0.00	...
C.I. 3-3(R)	SAG	2.57	...	...	...	...	...	...	...	...	0.24	11.84	...
C.I. 3-3	SAG	13.95	0.00	13.95	0.80	19.40	15.52	13.95	0.00	100.00%	...	...	...
C.I. 3-5	GRADE	7.57	0.00	7.57	1.00	3.89	3.89	3.89	3.68	51.41%	0.25	12.73	...
C.I. 3-6	GRADE	1.91	0.00	1.91	1.00	1.60	1.60	1.60	0.31	83.82%	0.15	7.59	...
C.I. 4-1(L)	SAG	0.46	...	...	...	...	...	...	...	...	0.09	4.42	...
C.I. 4-1(R)	SAG	2.30	...	...	...	...	...	...	...	...	0.17	8.54	...
C.I. 4-1	SAG	5.99	0.00	5.99	0.80	19.40	15.52	5.99	0.00	100.00%	...	...	...
C.I. 5-4(L)	SAG	0.00	...	...	...	...	...	...	...	...	0.07	3.38	...
C.I. 5-4(R)	SAG	4.34	...	...	...	...	...	...	...	...	0.20	9.86	...
C.I. 5-4	SAG	7.96	0.00	7.96	0.80	19.40	15.52	7.96	0.00	100.00%	...	...	...
C.I. 5-5(L)	SAG	3.22	...	...	...	...	...	...	...	...	0.18	9.12	...
C.I. 5-5(R)	SAG	0.46	...	...	...	...	...	...	...	...	0.09	4.30	...
C.I. 5-5	SAG	10.66	0.00	10.66	0.80	19.40	15.52	10.66	0.00	100.00%	...	...	...
C.I. 6-1	GRADE	5.40	0.00	5.40	1.00	4.32	4.32	4.32	1.08	80.05%	0.24	10.85	...
C.I. 6-2	GRADE	1.25	0.00	1.25	1.00	1.24	1.24	1.24	0.01	98.94%	0.14	6.27	...
F.I. 6-3	SAG	1.97	...	...	...	...	...	...	...	...	...	...	0.14
F.I. 6-4	SAG	3.55	...	...	...	...	...	...	...	...	...	...	0.20
F.I. 6-5	SAG	4.87	...	...	...	...	...	...	...	...	...	...	0.25
C.I. 6-7(L)	SAG	0.39	...	...	...	...	...	...	...	...	0.08	4.16	...
C.I. 6-7(R)	SAG	0.46	...	...	...	...	...	...	...	...	0.10	5.13	...
C.I. 6-7	SAG	1.45	0.00	1.45	0.80	19.40	15.52	1.45	0.00	100.00%	...	...	...
C.I. 6-8	GRADE	1.32	0.00	1.32	1.00	1.22	1.22	1.22	0.09	92.81%	0.15	7.39	...
C.I. 7-1(L)	SAG	4.01	...	...	...	...	...	...	...	...	0.21	10.43	...
C.I. 7-1(R)	SAG	0.46	...	...	...	...	...	...	...	...	0.09	4.25	...
C.I. 7-1	SAG	5.26	0.00	5.26	0.80	19.40	15.52	5.26	0.00	100.00%	...	...	...
C.I. 7-2(L)	SAG	0.59	...	...	...	...	...	...	...	...	0.20	9.85	...
C.I. 7-2(R)	SAG	0.72	...	...	...	...	...	...	...	...	0.10	5.22	...
C.I. 7-2	SAG	12.70	0.00	12.70	0.80	19.40	15.52	12.70	0.00	100.00%	...	...	...
C.I. 7-3	GRADE	6.91	0.00	6.91	1.00	4.06	4.06	4.06	2.85	58.76%	0.26	12.84	...
C.I. 8-1	GRADE	1.91	0.00	1.91	1.00	1.83	1.83	1.83	0.07	96.13%	0.16	7.35	...
C.I. 9-2(L)	SAG	1.25	...	...	...	...	...	...	...	...	0.15	7.06	...
C.I. 9-2(R)	SAG	0.59	...	...	...	...	...	...	...	...	0.12	5.34	...
C.I. 9-2	SAG	3.49	0.00	3.49	0.80	19.40	15.52	3.49	0.00	100.00%	...	...	...
F.I. 9-4	SAG	4.15	...	...	...	...	...	...	...	...	...	...	0.22
F.I. 9-5	SAG	5.00	...	...	...	...	...	...	...	...	...	...	0.25
F.I. 9-6	SAG	2.30	...	...	...	...	...	...	...	...	...	...	0.15
C.I. 9-7	GRADE	1.25	0.00	1.25	1.00	1.00	1.00	1.00	0.25	80.33%	...	...	...
C.I. 9-8	GRADE	0.86	0.00	0.86	1.00	0.74	0.74	0.74	0.12	86.25%	...	...	...
F.I. 10-2	SAG	1.91	...	...	...	...	...	...	...	...	...	...	0.13
F.I. 10-3	SAG	6.71	...	...	...	...	...	...	...	...	...	...	0.31
C.I. 11-1(L)	SAG	2.30	...	...	...	...	...	...	...	...	0.22	10.07	...
C.I. 11-1(R)	SAG	0.92	...	...	...	...	...	...	...	...	0.18	8.42	...
C.I. 11-1	SAG	4.15	0.00	4.15	0.80	19.40	15.52	4.15	0.00	100.00%	...	...	...
C.I. 11-2	GRADE	2.57	0.00	2.57	1.00	1.65	1.65	1.65	0.92	64.23%	...	...	...
C.I.11-3	GRADE	8.75	0.00	8.75	1.00	6.52	6.52	6.52	2.24	74.44%	...	...	...
C.I. 11-4(L)	SAG	1.51	...	...	...	...	...	...	...	...	0.14	6.90	...
C.I. 11-4(R)	SAG	0.33	...	...	...	...	...	...	...	...	0.08	3.89	...
C.I. 11-4	SAG	5.73	0.00	5.73	0.80	19.40	15.52	5.73	0.00	100.00%	...	...	...
C.I. 11-5(L)	SAG	1.38	...	...	...	...	...	...	...	...	0.19	9.43	...
C.I. 11-5(R)	SAG	1.25	...	...	...	...	...	...	...	...	0.13	6.42	...
C.I. 11-5	SAG	8.23	0.00	8.23	0.80	19.40	15.52	8.23	0.00	100.00%	...	...	...
C.I. 12-1	GRADE	3.95	0.00	3.95	1.00	1.85	1.85	1.85	2.10	46.93%	0.16	8.05	...
C.I. 13-1(L)	SAG	1.38	...	...	...	...	...	...	...	...	0.14	6.87	...
C.I. 13-1(R)	SAG	1.32	...	...	...	...	...	...	...	...	0.18	9.19	...
C.I. 13-1	SAG	16.91	0.00	16.91	0.80	19.40	15.52	15.52	1.39	91.78%	...	...	...
C.I. 14-2	GRADE	2.11	0.00	2.11	1.00	1.94	1.94	1.94	0.17	91.97%	0.17	8.55	...
C.I. 14-3	GRADE	1.38	0.00	1.38	1.00	1.32	1.32	1.32	0.06	95.68%	0.15	7.30	...
Notes:													
1. Inlet capacity at sag location has been reduced by a clogging factor of 0.80, reducing theoretical capacity to 80% capacity, as required per APWA Section 5600.													
Both theoretical capacity and reduced capacity are shown.													
2. Inlet efficiency shown in the tables is Captured Flow/Total Flow, denoting the actual Percentage of flow captured after the capacity has been reduced to 80% of theoretical capacity.													

Storm Sewer Design Calculation Table (100-year Return Frequency)													
Upstream Structure	Downstream Structure	Length (ft)	Upstream Invert (ft)	Downstream Invert (ft)	Slope (%)	Diameter (in)	Manning's n	Total Flow (cfs)	Velocity (ft/s)	Capacity (cfs)	Flow Depth (ft)	Upstream Struct. HGL (ft)	Upstream Top Elev. (ft)
M.H. 1-2	E.S. 1-1	205.81	1018.30	1016.28	0.98	18	0.012	7.63	6.80	11.27	1.07	1019.37	1028.90
C.I. 1-3	M.H. 1-2	142.32	1020.42	1019.00	1.00	18	0.012	7.63	6.89	11.36	1.07	1021.49	1027.43
C.I. 1-4	C.I. 1-3	37.59	1022.50	1022.00	1.33	15	0.012	5.92	7.18	8.07	0.98	1023.48	1027.34
C.I. 2-1	C.I. 6-8	34.01	1026.20	1026.00	0.59	15	0.012	5.00	4.08	5.36	1.25	1047.50	1031.27
M.H. 3-2	E.S. 3-1	41.28	1021.29	1021.00	0.79	30	0.012	29.82	6.08	39.38	2.50	1024.55	1031.53
C.I. 3-3	M.H. 3-2	134.46	1026.07	1021.79	3.18	24	0.012	29.82	9.49	43.72	1.86	1027.93	1033.74
M.H. 3-4	C.I. 3-3	61.52	1029.42	1026.57	4.63	18	0.012	9.88	5.87	24.49	1.21	1030.63	1034.42
C.I. 3-5	M.H. 3-4	283.26	1032.65	1029.82	1.00	18	0.012	9.88	7.25	11.37	1.21	1033.86	1038.73
C.I. 3-6	C.I. 3-5	34.00	1034.08	1033.20	2.59	15	0.012	1.91	2.90	11.25	0.55	1034.63	1038.73
C.I. 4-1	C.I. 3-3	34.00	1029.31	1028.04	3.74	15	0.012	5.99	10.68	13.52	0.99	1030.30	1033.74
M.H. 5-3	E.S. 5-2	169.45	1002.66	999.29	1.73	42	0.012	167.19	17.38	143.51	3.50	1007.37	1016.36
C.I. 5-4	M.H. 5-3	109.56	1008.20	1004.16	3.69	24	0.012	18.62	5.93	47.37	2.00	1012.69	1015.33
C.I. 5-5	C.I. 5-4	36.39	1010.30	1009.57	2.01	15	0.012	10.66	8.69	9.91	1.25	1014.31	1015.35
M.H. 6-0	M.H. 5-5	157.56	1009.48	1005.16	2.74	30	0.012	68.50	13.96	73.57	2.50	1015.81	1019.31
C.I. 6-1	M.H. 6-0	64.77	1010.13	1009.48	1.00	30	0.012	68.50	13.96	44.51	2.50	1018.05	1020.37
C.I. 6-2	C.I. 6-1	42.10	1011.06	1010.63	1.02	30	0.012	63.10	12.86	44.90	2.50	1023.44	1020.42
F.I. 6-3	C.I. 6-2	68.99	1012.50	1011.54	1.39	30	0.012	61.85	12.60	52.41	2.50	1026.09	1021.87
F.I. 6-4	F.I. 6-3	140.64	1013.83	1012.99	0.60	24	0.012	33.10	10.54	18.94	2.00	1032.28	1020.24
F.I. 6-5	F.I. 6-4	171.48	1016.75	1014.23	1.47	24	0.012	29.55	9.41	29.29	2.00	1035.31	1023.67
M.H. 6-6	F.I. 6-5	232.00	1021.18	1017.15	1.74	24	0.012	24.68	7.86	32.70	2.00	1038.36	1029.63
C.I. 6-7	M.H. 6-6	32.19	1023.60	1021.88	5.34	18	0.012	24.68	13.97	26.30	1.50	1040.83	1029.31
C.I. 6-8	C.I. 6-7	166.81	1025.30	1024.00	0.78	15	0.012	6.32	5.15	6.18	1.25	1046.71	1031.26
C.I. 7-1	F.I. 6-3	171.21	1015.27	1013.56	1.00	24	0.012	26.78	8.53	24.49	2.00	1031.76	1023.06
C.I. 7-2	C.I. 7-1	35.16	1015.62	1015.27	1.00	24	0.012	21.52	6.85	24.45	2.00	1032.60	1023.07
C.I. 7-3	C.I. 7-2	218.61	1021.90	1016.37	2.53	15	0.012	6.91	5.63	11.13	1.25	1035.82	1025.98
C.I. 8-1	C.I. 7-2	117.47	1017.76	1016.37	1.18	15	0.012	1.91	1.56	7.61	1.25	1033.77	1025.23
C.I. 9-2	C.I. 11-1	43.01	1005.53	1005.13	0.93	24	0.012	21.00	6.69	23.63	2.00	1017.23	1014.75
M.H. 9-3	C.I. 9-2	46.93	1007.00	1006.53	1.00	18	0.012	17.51	9.91	11.38	1.50	1019.39	1014.97
F.I. 9-4	M.H. 9-3	141.40	1009.57	1007.50	1.46	18	0.012	17.51	9.91	13.76	1.50	1024.26	1018.04
F.I. 9-5	F.I. 9-4	247.00	1017.73	1012.41	2.15	18	0.012	13.36	7.56	16.70	1.50	1029.18	1024.47
F.I. 9-6	F.I. 9-5	138.00	1022.56	1017.98	3.32	15	0.012	4.41	3.59	12.74	1.25	1031.07	1026.50
C.I. 9-7	F.I. 9-6	133.00	1029.11	1023.01	4.59	15	0.012	2.11	1.72	14.98	1.25	1031.49	1036.81
C.I. 9-8	C.I. 9-7	34.02	1030.50	1030.16	1.00	15	0.012	0.86	0.70	6.99	1.01	1031.51	1036.77
M.H. 10-1	C.I. 11-3	129.94	1010.73	1008.49	1.72	24	0.012	26.19	8.34	32.17	2.00	1029.66	1018.66
F.I. 10-2	M.H. 10-1	125.40	1012.41	1010.73	1.34	24	0.012	26.19	8.34	28.36	2.00	1032.17	1022.17
F.I. 10-3	F.I. 10-2	144.55	1016.61	1013.01	2.49	24	0.012	24.28	7.73	38.67	2.00	1024.92	1025.11
C.I. 11-1	M.H. 5-5	151.51	1004.13	1003.16	0.64	36	0.012	80.07	11.33	57.81	3.00	1013.92	1014.77
C.I. 11-2	C.I. 11-1	288.06	1006.66	1004.63	0.70	30	0.012	54.92	11.19	43.25	2.50	1021.32	1017.23
C.I. 11-3	C.I. 11-2	43.00	1007.49	1007.16	0.77	30	0.012	49.79	10.15	38.92	2.50	1024.78	1017.25
C.I. 11-4	C.I. 11-3	84.02	1008.83	1007.99	1.00	24	0.012	13.96	4.44	24.50	2.00	1028.44	1015.86
C.I. 11-5	C.I. 11-4	36.35	1010.75	1010.28	1.29	15	0.012	8.23	6.71	7.95	1.25	1029.19	1015.95
C.I. 12-1	F.I. 9-5	133.00	1019.26	1017.98	0.96	15	0.012	3.95	3.22	6.86	1.25	1030.94	1023.39
C.I. 13-1	C.I. 6-7	34.37	1024.58	1024.30	0.81	18	0.012	16.91	9.57	10.27	1.50	1046.11	1029.29
C.I. 14-2	E.S. 14-1	67.74	1025.46	1022.29	4.68	15	0.012	3.49	2.84	15.13	0.75	1026.21	1031.65
C.I. 14-3	E.S. 14-2	34.00	1027.00	1026.66	1.00	15	0.012	1.38	4.43	7.00	0.46	1027.46	1031.65

NOT AS BUILT

Record Drawing

NOTES:
RMBOE - REAR MINIMUM BUILDING OPENING ELEVATION
FMBOE - FRONT MINIMUM BUILDING OPENING ELEVATION

NOTES:
1. Individual lot owners shall not change or obstruct the drainage flow lines or paths on the lots, as shown on the Master Drainage Plan, unless specific application is made and approved by the City Engineer.
2. Plot is location in Zone X, "areas outside the 1-percent annual chance floodplains, areas of 1-percent annual chance sheet flow flooding where the average depths are less than 1 foot, areas of 1-percent annual chance stream flooding where the contributing drainage area is less than 1 square mile, or areas protected from the 1-percent annual chance flood by levees. No base flood elevations or depths are shown within this zone."
3. Plot is located outside of any required buffer zones for natural streams.
4. MBOE elevations have been provided per lot lines. Interpolation will be allowed between the right and left side MBOEs shown on the Master Drainage Plan, depending on the location of the lowest opening on the proposed structure.

NOTE: No building permits will be issued until an as-graded Master Drainage Plan has been submitted to the city and approved by the city.


* Swales to be constructed between each of the lots 87 through 94 to drain to the south.

BASEMENT TYPES

- (D) DAYLIGHT
(W) WALKOUT
(S) STANDARD

AS BUILT
DATE: 12/19/2018

Record Drawing

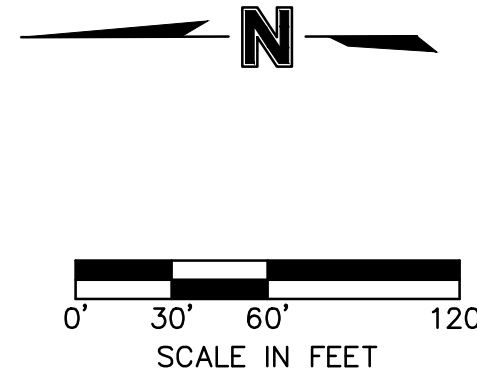


100 YEAR WSE: 1024.38




SEDIMENT BASIN DESIGN DATA SUMMARY				
Design Item:	Basin #1	Basin #2	Units	Notes:
Site Data:				
Tributary Drainage Area to Pond:	31.34	8.09	Acres	
50% (2 yr) Design Flow:	83.92	21.67	cfs	
4% (25 yr) Design Flow:	149.09	38.50	cfs	
Pond Data:				
Minimum Sediment Storage Volume:	4200	1085	cu. yd.	134 cy/acre minimum
Provided Sediment Storage Volume:	4200	1085	cu. yd.	134 cy/acre minimum
Bottom Elevation:	998.00	1014.00	Ft	
Sediment Cleanout Elevation:	1001.60	1016.41	Ft	Elevation Equal to 50% of Original Design Volume.
Top of Riser Elevation:	1002.98	1017.12	Ft	Top of Dry Storage Volume
Emergency Spillway Elevation:	1006.00	1024.90	Ft	at or Above Q-2 elev. 1.0 ft min above principal spillway
Q-25 year Elevation:	1006.82	1025.14	Ft	
Top of Dam Elevation:	1008.00	1026.10	Ft	1.0 ft min above Q-25 elev.
Basin Shape Data:				
A= Area at Normal Pool	36337.18	9000.36	SF	
L= Length of Flow Path	128.00	160.00	Ft	
We = Effective Width = A/L	283.88	56.25	Ft	
Length to Width Ratio = L/We	0.45	2.84		If Length to Width Ratio is less than 2, baffles are required
Principal Spillway Data:				
Riser Pipe Diameter:	48	18	in	15-inch min. Size for 2 year flow minimum
Barrell Pipe Diameter:	36	15	in	15-inch min. Size for 2 year flow minimum
Riser Pipe Base Size:	1.93	0.23	cu. yd.	Size to Prevent Flotation. 1.25 safety factor required.
Emergency Spillway Data:				
Elevation of Spillway:	1006.00	1024.90		
Design Width of Spillway:	75.00	125.00	Ft	
Design Depth in Spillway:	0.82	0.24	Ft	Use $Q_{25yr}=C_b b H^{3/2}$ where $C_b=2.63$, b is the Width of Spillway
Design Velocity in Spillway:	2.44	1.31	Ft/sec	

TEMPORARY SEDIMENT TRAP		1
POND AND PRINCIPAL SPILLWAY DATA:		
DAM TOP ELEVATION		1020.00
EMERGENCY SPILLWAY ELEVATION		1018.71
WET STORAGE VOLUME ELEVATION		1017.65
CLEANOUT ELEVATION		1017.65
DRY BOTTOM ELEVATION		1016.00
VOL. REQ'D @ 134CY/ACRE		732
VOL. PROVIDED BELOW OUTLET CREST (CY)		732
STONE OUTLET DATA:		
LENGTH (L) FT.		32.94
WIDTH (W) FT.		10.00
DRAINAGE AREA (AC)		5.49
UPSTREAM D50 (MEDIAN STONE SIZE, IN)		2.00
DOWNSTREAM D50 (MEDIAN STONE SIZE, IN)		10.00

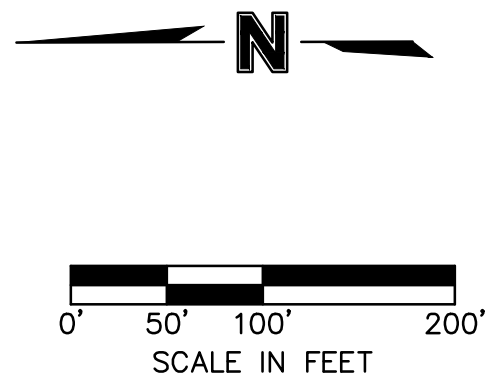

LEGEND:

PHASE 1 DEVICES

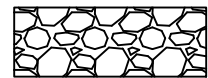

TEMPORARY STONE CONSTRUCTION ENTRANCE

SF SILT FENCE

STORM DRAIN INLET PROTECTION

TEMPORARY DIVERSION BERM

NOTE:
THE SITE DISTURBANCE PLANS INDICATES THE FINAL PLACEMENT OF EROSION CONTROL DEVICES. THE CONTRACTOR(S) MAY PROCEED WITH THE CONSTRUCTION PRIOR TO THE FINAL PLACEMENT OF THESE DEVICES BY PROVIDING ADDITIONAL DEVICES TO CONTROL EROSION ON THEIR ITEMS OF WORK. THESE DEVICES SHALL BE MAINTAINED UNTIL THE FINAL DEVICES ARE IN PLACE.

Record Drawing

NOT AS BUILT

Approximate location of vehicle tracking control. Location may be varied to accommodate construction.

Prior to any clearing or other construction activities contractor shall install inlet protection device per APWA detail ESC-19. Inlet protection to remain in place until seeding and mulching operations are completed (Typ.).

Prior to any clearing or other construction activities contractor shall install temporary sediment trap #1 with rock outlet per table on this sheet and details on sheet C137.

Prior to any clearing or other construction activities contractor shall install sediment basin #2 with riser and skimmer outlet per table on this sheet and details on sheet C137.

Prior to any clearing or other construction activities contractor shall install temporary sediment basin #1 with riser and skimmer outlet per table on this sheet and details on sheet C137.

Prior to any clearing or other construction activities contractor shall install silt fencing to control erosion and silt. Fencing to be installed per APWA detail. (Typ.)



OLSSON[®]

ASSOCIATES

Olsson Associates - Civil Engineering

1400 S. Centerville Rd., Suite 100

North Kansas City, MO 64116

TEL 816.897.4320

FAX 816.897.1393

www.olssonassociates.com

STATE OF MISSOURI

MELISSA G. DEGENIA

NUMBER

FE-2011000892

08/04/2019

PROFESSIONAL ENGINEER

BY

JES

REVISIONS DESCRIPTION

NO. REV.

DATE

6

03.03.2018

Sediment Basins revised

2018

REVISIONS

SITE DISTURBANCE PLAN - PHASE 1

HAWTHORN RIDGE

1ST PLAT

LEE'S SUMMIT, MO

drawn by: DAH.D

checked by: M.G.D.

designed by: P.M.L.

QA/QC by: K.S.L.


project no.: 017-0188

date: 03.03.2017

SHEET

C130

DWG: F:\2017\0001-0500\017-0188\40-Design\AutoCAD\Final Plans\ASBUILTS\GNV\01_Street & Storm_36x24\C_ERC02_017-0188.dwg
DATE: Feb 19, 2019 6:20pm
USER: dhernandez



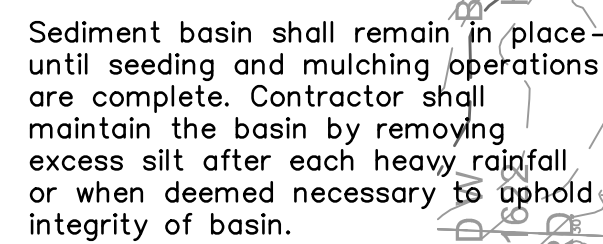


Sediment Trap shall remain in place—until seeding and mulching operations are complete. Contractor shall maintain the trap by removing excess silt after each heavy rainfall or when deemed necessary to uphold integrity of trap.

Sediment basin shall remain in place until seeding and mulching operations are complete. Contractor shall maintain the basin by removing excess silt after each heavy rainfall or when deemed necessary to uphold integrity of basin.

~~Install Rock Check Dams as swale is constructed per APWA detail (Typ.).~~

Record Drawing

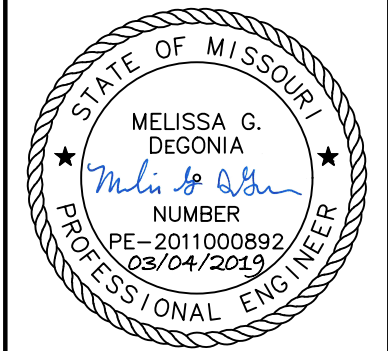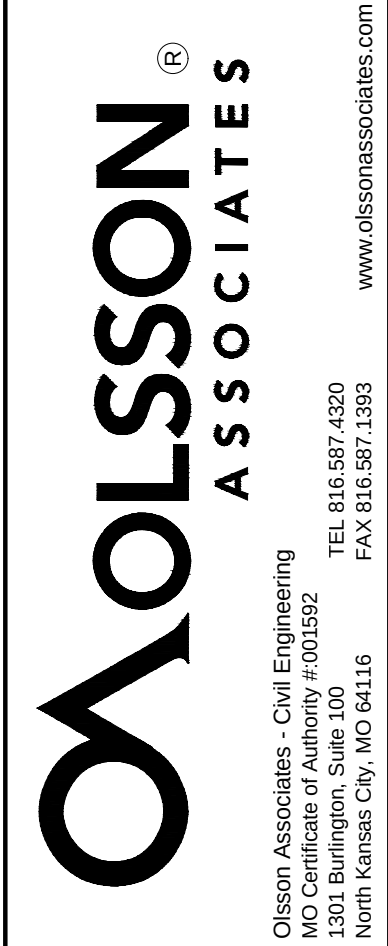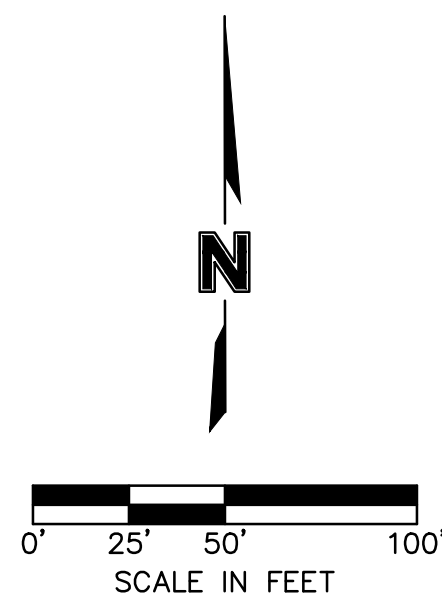[illegible]

SITE DISTURBANCE PLAN - PHASE 2

HAWTHORN RIDGE
1ST PLAT

LEE'S SUMMIT, MO

drawn by: D.A.H.O
checked by: M.G.D.
designed by: P.M.D
QA/QC by: K.S.J
project no.: 017-0188
date: 03.03.2017

SHEET
C131

GENERAL NOTES:

SEED & MULCH NOTES:
SEEDING SHALL BE DONE BEFORE THE PROPOSED SEEDBED BECOMES ERODED, CRUSTED OVER, OR DRIED OUT AND SHALL NOT BE DONE WHEN THE GROUND IS FROZEN, OR COVERED WITH SNOW. THE SEED SHALL COMPLY WITH THE REQUIREMENTS OF THE MISSOURI SEED LAW AND THE FEDERAL SEED ACT. ALSO, IT SHALL CONTAIN NO SEED OF ANY PLANT ON THE FEDERAL NOXIOUS WEED LIST. OTHER WEED SEED SHALL NOT EXCEED ONE PERCENT BY WEIGHT OF MIX.

SEED & FERTILIZER RATE:
MIX I - RYE GRASS / BLUE GRASS -----100 LBS. PER ACRE
MIX II - TALL FESCUE / BLUE GRASS -----195 LBS. PER ACRE
LIME -----2000 LBS. PER ACRE
(50 LBS. PER 1000 SQ. FT.)
FERTILIZER -----800 TO 1200 LBS. PER ACRE (25 LBS. PER 1000 SQ. FT.)

DURING THE DATES DECEMBER 15TH THROUGH MAY 31 ALL LIME, FERTILIZER, SEED, AND MULCH SHALL BE APPLIED TO FINISHED SLOPES OF DISTURBED AREAS. DURING THE MONTHS OF JUNE, JULY, OCTOBER, AND NOVEMBER 1ST THROUGH DECEMBER 15TH, LIME, FERTILIZER, SEED, AND MULCH SHALL BE APPLIED AT THE FOLLOWING RATES:

LIME - 100 % OF SPECIFIED QUANTITY
FERTILIZER - 75 % OF THE SPECIFIED QUANTITY
SEED - 50 % OF THE SPECIFIED QUANTITY
MULCH - 100 % OF THE SPECIFIED QUANTITY
MULCH SHALL BE VEGETATIVE TYPE, CEREAL STRAW FROM STALKS OF OATS, RYE, OR BARLEY, OR APPROVED EQUAL. THE STRAW SHALL BE FREE OF PROHIBITED WEED SEED AND RELATIVELY FREE OF ALL OTHER NOXIOUS AND UNDESIRABLE SEED. MULCH SHALL BE APPLIED AT THE RATE OF 2 TONS PER ACRE, (70 TO 90 LBS. PER 1000 SQ. FT.). MULCH SHALL BE EMBEDDED BY A MULCH ANCHORING TOOL OR DISK TYPE ROLLER HAVING FLAT SERRATED DISKS SPACED NOT MORE THAN 10 INCHES APART AND CLEANING SCRAPERS SHALL BE PROVIDED.

THE SITE DISTURBANCE PLANS INDICATES THE FINAL PLACEMENT OF EROSION CONTROL DEVICES. THE CONTRACTOR(S) MAY PROCEED WITH THE CONSTRUCTION PRIOR TO THE FINAL PLACEMENT OF THESE DEVICES BY PROVIDING ADDITIONAL DEVICES TO CONTROL EROSION ON THEIR ITEMS OF WORK. THESE DEVICES SHALL BE MAINTAINED UNTIL THE FINAL DEVICES ARE IN PLACE.

NATIVE SEED MIX
NORTHERN SHORT GRASS MEADOW MIX (6LB PER ACRE)
SUPPLIER:
CRITSITE PRODUCTS, PRAIRIE AND WETLAND CENTER
16245 SOUTH HIGHWAY 71
BELTON, MO 64012
816-331-9736

Sediment trap and diversion berm to be removed and final grading completed once grading has been stabilized. Area disturbed by removal grading to be seeded and mulched immediately upon completion of grading activities.

Area to be planted with native seed mix and mulched.

Sediment basin and diversion berm to be removed and final grading completed once grading has been stabilized. Area disturbed by removal grading to be seeded and mulched immediately upon completion of grading activities.

Area to be planted with native seed mix and mulched. Install 10' wide x 1.5' deep rock trench for trickle flow.

Contractor shall remove temporary basin and grade permanent detention basin after tributary area has been stabilized.

Install Inlet control devices as storm sewer is constructed per APWA detail ESC-26 (Typ.).

Install Inlet control devices as storm sewer is constructed per APWA detail ESC-21 (Typ.).

Rock check dams to remain until graded areas are stabilized.

LEGEND:


PHASE 1 DEVICES



PHASE 2 DEVICES



PHASE 3 DEVICES

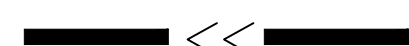

TEMPORARY STONE CONSTRUCTION ENTRANCE

SILT FENCE


STORM DRAIN INLET PROTECTION

TEMPORARY DIVERSION BERM

NATIVE SEED MIX

NOT AS BUILT

Record Drawing

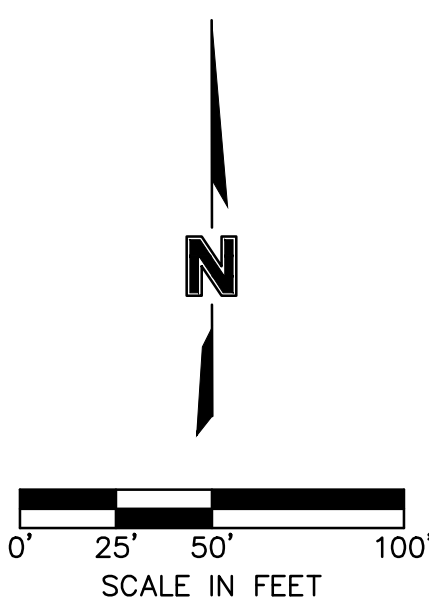

NO.	REV.	DATE	REVISIONS DESCRIPTION	BY
5		02.14.2018	Added rock check dams	
6		02.14.2018	Added native vegetation and rock trench	

SITE DISTURBANCE PLAN - PHASE 3		2018
HAWTHORN RIDGE 1ST PLAT		
LEE'S SUMMIT, MO		

drawn by: D.A.H.O.
checked by: M.G.D.
designed by: P.M.D.
QA/QC by: K.S.J.
project no.: 017-0188
date: 03.03.2017

DWG: F:\2017\0001-0500\017-0188\40-Design\AutoCAD\Final Plans\ASBUILTS\GNCV\01_Street & Storm_36x24\C_XSC01_017-0188.dwg
DATE: Feb 19, 2019 6:21pm
USER: dhernandez

- Gradation - riprap materials shall be graded within the following limits

Not more than 5% shall pass through the 2 inch sieve.

Thickness 20–60 mills

Grab strength 90–120 lbs.

Conform ASTM D-1682 or ASTM D-177

2' Min.

Compacted Soil

12' Min.

Flow

6' Typical

TEMPORARY DIVERSION DIKE DETAIL



The diagram illustrates a cross-section of a road shoulder or embankment. On the left, a sloped area is labeled "ORIGINAL GROUND ELEVATION" and "67 CU. YD./ ACRE". Below this, a horizontal line is labeled "67 CU. YD./ ACRE" and "EXCAVATED". A vertical dimension of "4' MAX." is shown for the excavation depth. The right side of the diagram shows a cross-section of the shoulder. The top layer is labeled "1' VARIABLE *". Below this is a layer of "d₅₀ 2" COARSE AGGREGATE" and "d₅₀ 10" RIPRAP". A vertical dimension of "1' VARIABLE *" is shown for the aggregate layer. A horizontal line labeled "ORIGINAL GROUND ELEVATION" is shown at the base of the shoulder. A vertical dimension of "1' VARIABLE *" is shown for the riprap layer. A horizontal line labeled "GEOTEXTILE" is shown at the base of the shoulder. A vertical dimension of "1' VARIABLE *" is shown for the geotextile layer. A horizontal line labeled "ORIGINAL GROUND ELEVATION" is shown at the base of the shoulder. A vertical dimension of "1' VARIABLE *" is shown for the geotextile layer. A horizontal line labeled "ORIGINAL GROUND ELEVATION" is shown at the base of the shoulder. A vertical dimension of "1' VARIABLE *" is shown for the geotextile layer.

NOTE:
* SEE MINIMUM TOP WIDTH BELOW.

The drawing consists of two parts: a perspective view on the left and a cross-section view on the right.

Perspective View (Left):

- Shows a rectangular area of **d₅₀ 10" RIPRAP** on a slope.
- The **LENGTH IN FEET = 6 X DRAINAGE AREA IN AC.**
- A **DIVERSION DIKE** is shown adjacent to the riprap area.
- Below the riprap is a layer of **d₅₀ 2" COARSE AGGREGATE**.
- An **EXCAVATED AREA** is indicated by a dashed line.
- A **GEOTEXTILE** layer is shown at the base of the excavation.

Cross-Section View (Right):

- Shows a trapezoidal cross-section of the riprap area with a **2:1** slope.
- The top width is labeled **W**.
- The height is labeled **H₀**.
- The **EXCAVATED AREA** is shown with a **MAX. DEPTH = 4'**.
- The **ORIGINAL GROUND ELEV.** is indicated by a dashed line.


Labels and Notes:

- OUTLET (PERSPECTIVE VIEW)**
- MINIMUM TOP WIDTH**
- NOT TO SCALE**

Record Drawing



1. LIMIT PONDING HEIGHT TO 24"
2. ATTACH FABRIC TO UPSTREAM SIDE OF POST.
3. DRIVE OVER EACH SIDE OF SEDIMENT FENCE 2 TO 4 TIMES WITH DEVICE EXERTING 60 PSI OR GREATER AFTER MATERIAL IS SLICED INTO THE GROUND.
4. SPACE POSTS A MAX OF
7' ON OPEN RUNS AND
4' ON POOLING AREAS.
5. SINK POSTS AS FAR BELOW GROUND AS FABRIC ABOVE GROUND.

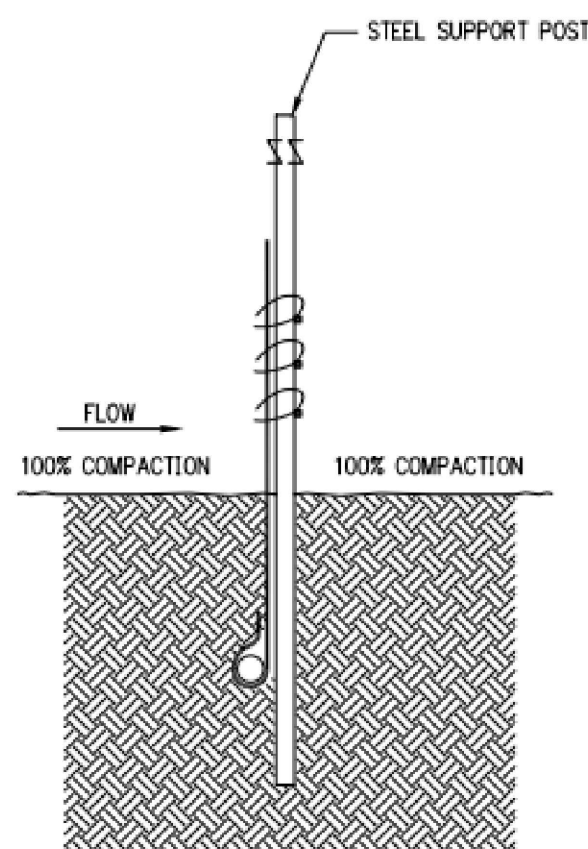

1

NOT TO SCALE

HAWTHORN RIDGE
1ST PLAT


LEE'S SUMMIT, MO

drawn by: D.A.H.O
checked by: M.G.D.
designed by: P.M.D
QA/QC by: K.S.J
project no.: 017-0188
date: 03.03.2017

SHEET
C133


[illegible]

2018

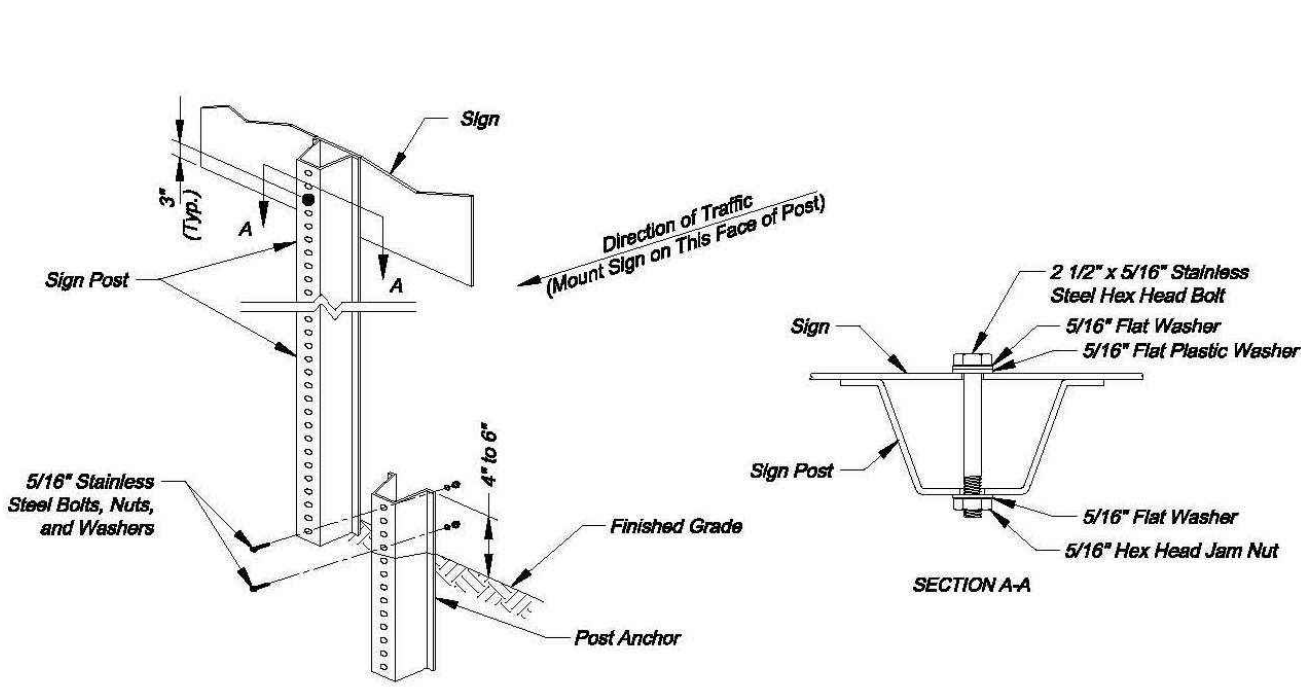

U-STEEL POST DETAILS

- U-STEEL POST NOTES:**
1. Splice shall be positioned entirely between finished grade line and 18" above finished grade line. Only one splice will be allowed per post.
 2. U-Steel post shall be 3 to 4 ft. galvanized according to ASTM A123.
 3. U-Steel post can be used for installation of signs with an area of less than 2.5 square feet.
 4. All posts shall be embedded a minimum of 3 feet.

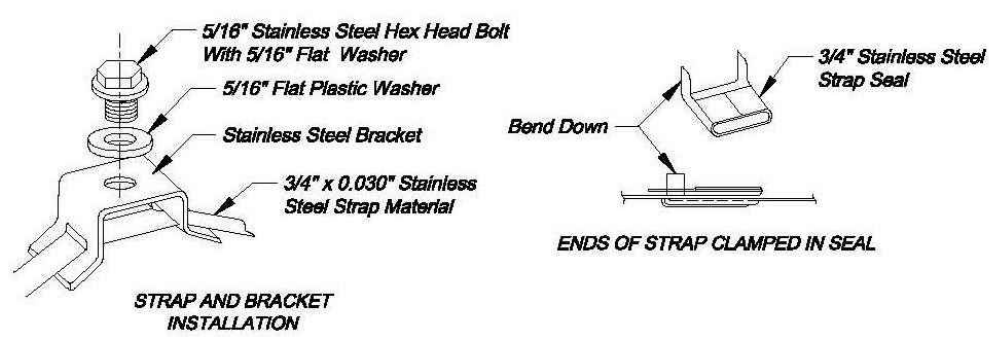


STRAP TYPE SIGN SUPPORT DETAILS

- METAL POLE SIGN MOUNTING NOTES:**
1. Signs on metal poles shall be attached with two brackets and stainless steel bands.
 2. Holes in sign for attachment to the mounting brackets shall be offset a minimum of 2 inches from the edge of the sign.
 3. Holes in sign shall be located such that the sign is level.
 4. All strap, bracket, and seal materials should be Type 201 stainless steel.

- PERMANENT SIGNING GENERAL NOTES:**
1. All signing shall be in accordance with the latest edition of the Manual on Uniform Traffic Control Devices (MUTCD).
 2. The Contractor is responsible for avoiding any and all utilities when installing sign posts, whether the utility is indicated on the plans or not.
 3. All workmanship and materials shall be subject to the inspection and approval of the Public Works Department of the City of Lee's Summit.
 4. The Contractor shall stake the location of all sign posts to be installed. The City Inspector shall inspect the staking prior to installation.
 5. Signs shown to be installed on the side of metal poles shall be mounted with stainless steel straps or wing brackets as detailed. No signs are to be installed on wood poles. See Traffic Signal Standard Drawings for the installation of signs or mast arms.
 6. All post mounted signs shall be installed with breakaway anchors according to the Standard Drawings.
 7. All existing signs will be used in place during construction and protected from damage unless otherwise indicated in the plans. If the Contractor damages any existing sign or posts during construction, the Contractor will be required to replace the damaged materials with new signs or posts of the same type and size at the Contractor's expense. The Contractor shall be responsible for removing and storing any signs that are to be reinstalled on the project. All equipment shall be maintained in good condition.
 8. Existing permanent signs and posts removed by the Contractor for construction purposes which are not to be reinstalled shall be delivered to the City's Public Works Maintenance Facility (1671 SE Hamblen Road). The Contractor shall be responsible for removing and storing equipment in good condition and is fully responsible for the equipment until it is delivered.
 9. All Stop, Yield, or street name signs shall be maintained in a conspicuous location for the driving public. All Stop and Yield signs removed for construction purposes can be temporarily erected in reflectorized drums (no less than 7 feet above the pavement surface) until they can be reinstalled. Any temporary Stop or Yield sign installation to be left in place overnight will require prior approval from the City Inspector.

- SQUARE STEEL POST INSTALLATION SEQUENCE:**
1. Sign post anchor driven partially into the ground using a drive cap with a sledge and power equipment.
 2. Anchor sleeve slipped over anchor and drive into the ground together with the sign post anchor.
 3. Insert sign post into the post anchor and bolt in place.

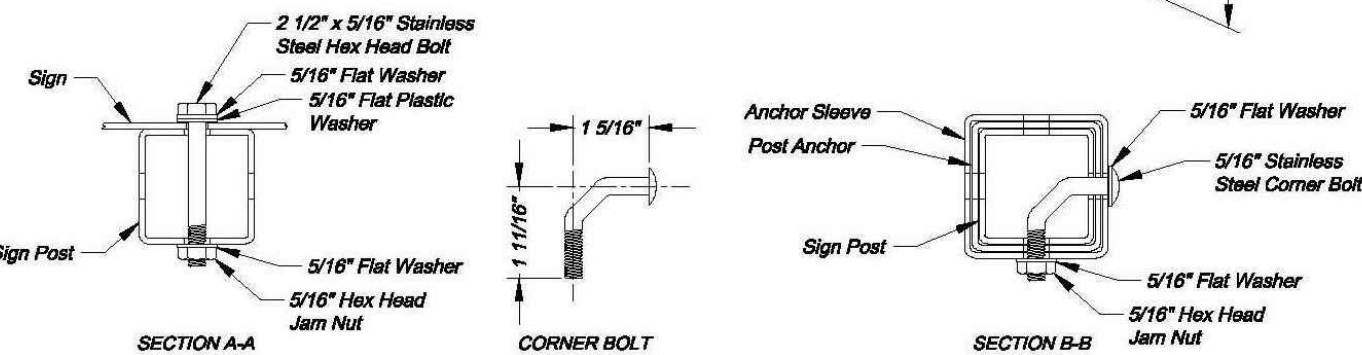


SQUARE STEEL POST DETAILS

- SQUARE STEEL POST NOTES:**
1. Square steel sign posts and break-away anchor shall consist of the following materials:
Sign Post - 14 Ga. 2" x 2" Square Steel Post
Post Anchor - 12 Ga. 2 1/4" x 2 1/4" x 36" Square Steel Post
Anchor Sleeve - 12 Ga. 2 1/4" x 2 1/4" x 18" Square Steel Post
 2. 14 Gauge posts must meet a certified minimum yield strength of 60,000 psi.
 3. In all installations the first hole above the finished grade line on the sign post, anchor, and anchor sleeve must be in line for the insertion of the corner bolt.
 4. The maximum area for one sign post is 9.0 square feet. A sign or combination of signs with an area greater than 9.0 square feet will require two posts. Also, signs with a width greater than 36" (not including 36" x 36" diamond shaped signs) will require two posts.


STANDARD ABBREVIATION LISTS

Named Streets	Numbered Streets
Avenue AVE	First ST
Boulevard BLVD	Second ND
Circle CIR	Third RD
Creek CR	Fourth to Tenth TW
Court CT	
Crossing XING	
Drive DR	
Highway HWY	
Lane LN	
Parkway PKWY	
Place PL	
Road RD	
Street ST	
Terrace TER	
Trail TRL	
Way WAY	

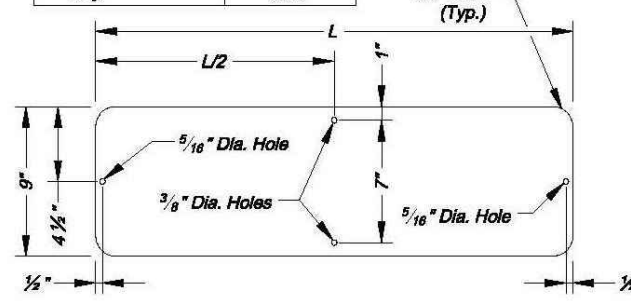

STREET NAME SIGN BLANK DETAILS


For Mounting on Square Steel Posts

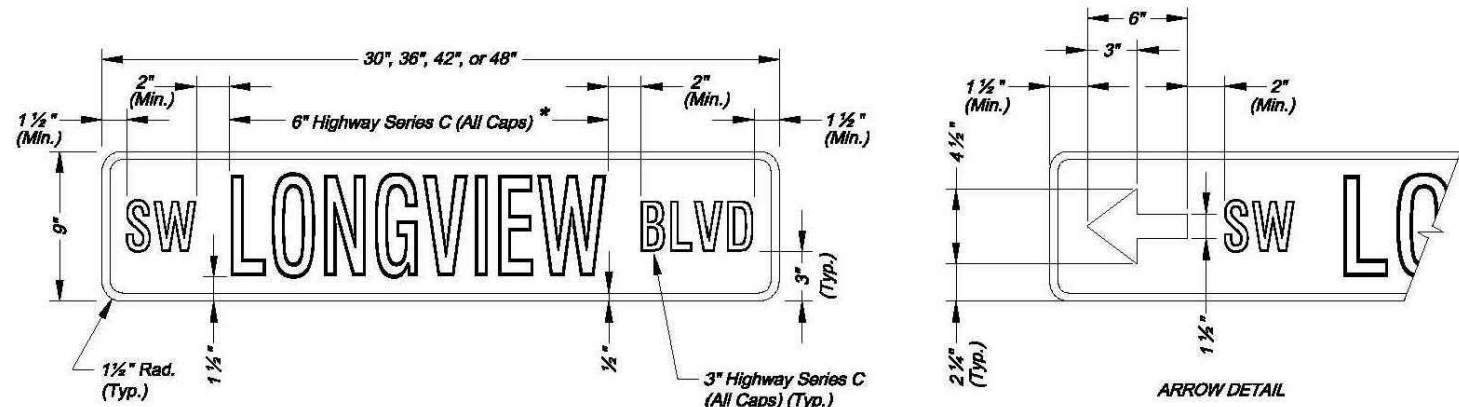


PROJECT SIGN DETAILS

NAMED STREET NAME SIGN DETAIL

* Use Highway Series B (All Caps) in lieu of series C if necessary to fit text on a 36" sign blank.

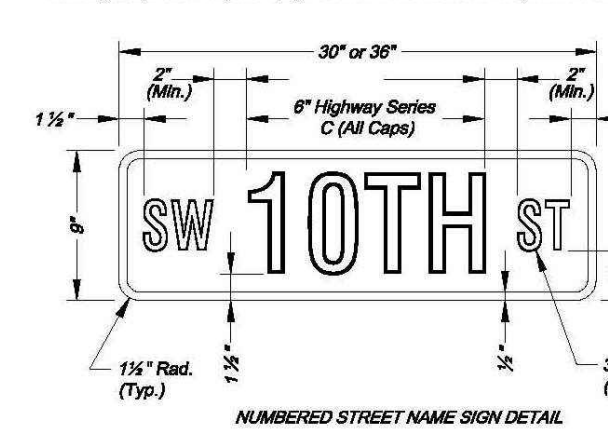


NUMBERED STREET NAME SIGN DETAIL

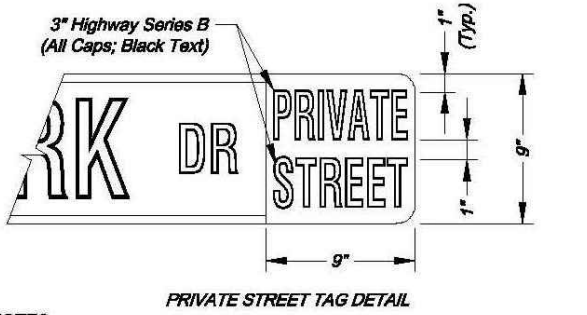


PRIVATE STREET TAG DETAIL

- NOTES:**
1. For all street name signs, the legend shall be white and the background shall be green.
 2. Arrows shall be added to street name signs where the name of a street changes at an intersection. Street name signs with arrows are to be installed on each side of the intersection to indicate the change in names. Arrows shall be white.
 3. The "PRIVATE STREET" tag should be added to the end of street name signs to indicate where a street that is outside the right-of-way intersects a public street. The background for the "PRIVATE STREET" tag shall be yellow.


STREET NAME SIGN FACE DETAILS

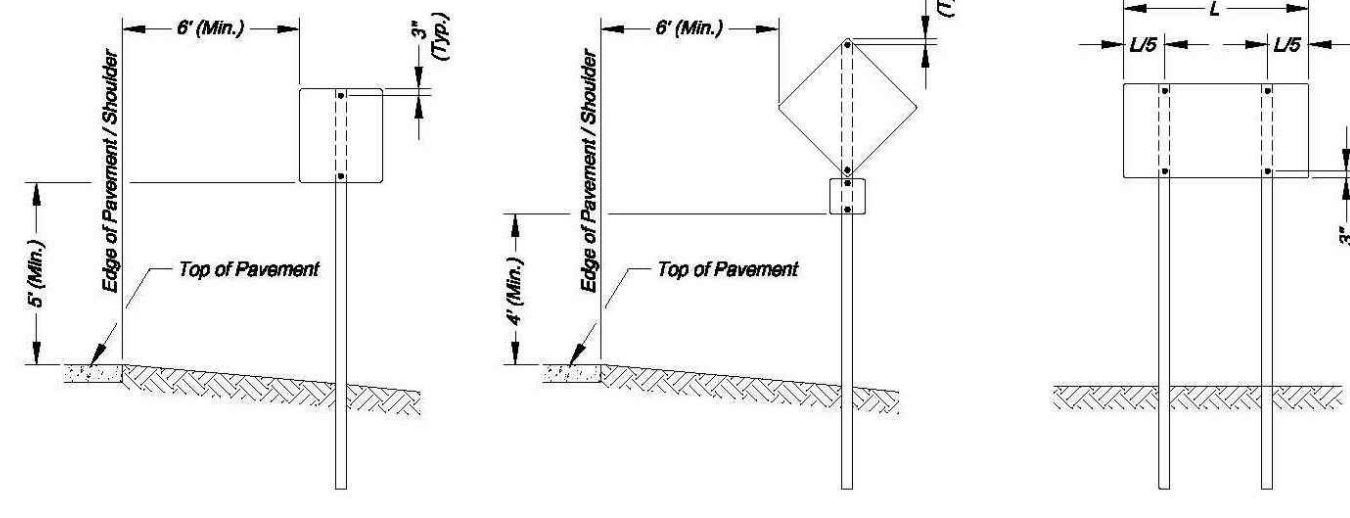

SIGN INSTALLATION FOR NON-CURBED STREET

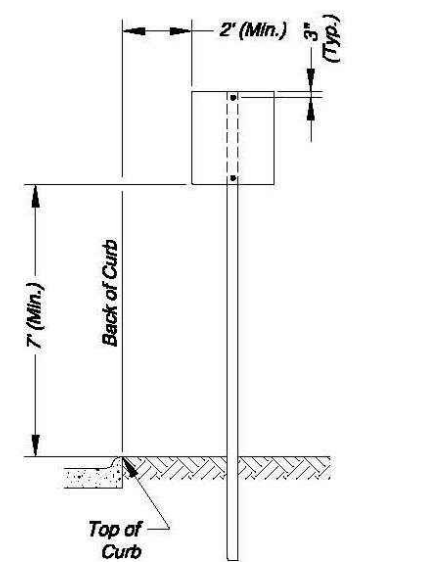


SIGN INSTALLATION FOR CURBED STREET

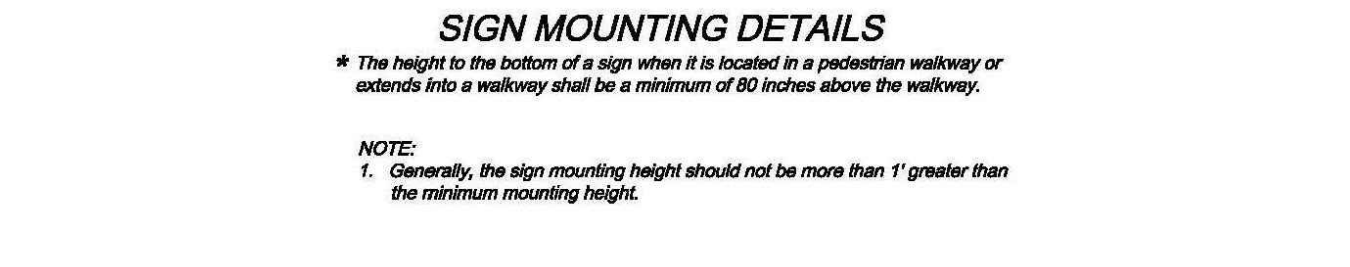


SIGN MOUNTING DETAILS

- * The height to the bottom of a sign when it is located in a pedestrian walkway or extends into a walkway shall be a minimum of 80 inches above the walkway.

- NOTE:**
1. Generally, the sign mounting height should not be more than 1' greater than the minimum mounting height.

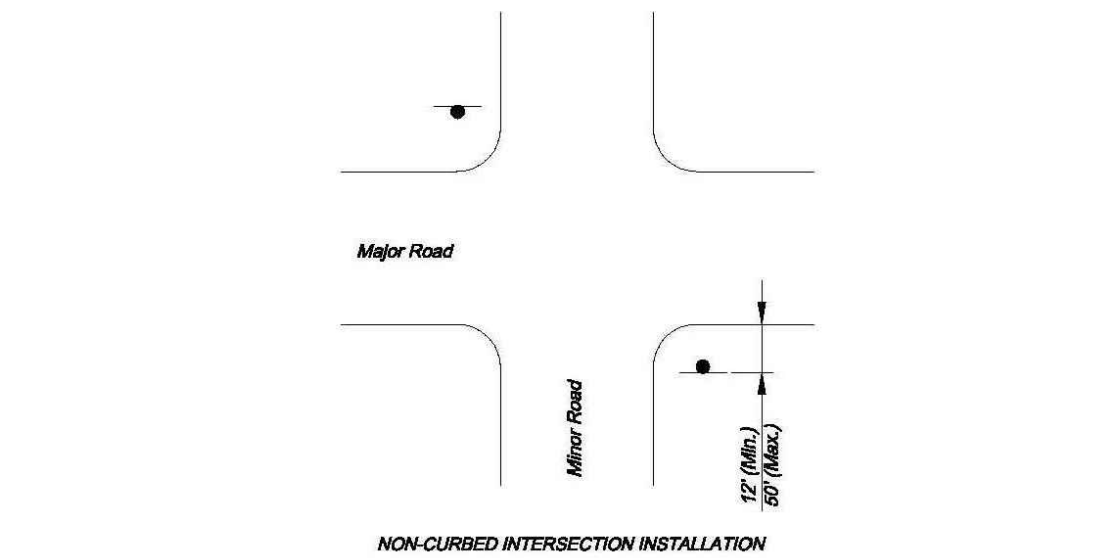

CONTROL SIGN LOCATION

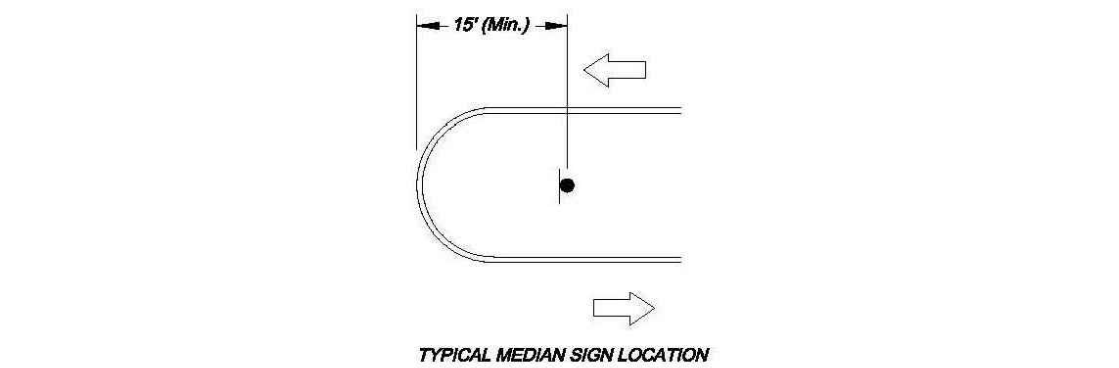

MEDIAN SIGN LOCATION

- NOTES:**
1. A 4" P.V.C. sleeve shall be installed in new concrete medians at each location where a sign is to be installed.
 2. For existing concrete medians, a 4" hole shall be bored into the concrete.

NOT AS BUILT

Record Drawing



1. BACKFILL SHALL BE JOB EXCAVATED MATERIAL FREE FROM DEBRIS AND STONES COMPACTED TO 90% OF MAXIMUM DENSITY AT OPTIMUM MOISTURE CONTENT AS DETERMINED BY ASTM D698. BACKFILL UNDER PAVEMENT (EXISTING OR PROPOSED), SHALL BE FLOWABLE FILL.
2. TRENCH BANKS MAY BE CUT BACK ON SLOPES IN ACCORDANCE WITH CURRENT OSHA REGULATIONS, BUT ONLY IN AREAS WHERE THE INCREASED TRENCH WIDTH WILL NOT INTERFERE WITH SURFACE FEATURES. SLOPES MUST NOT EXTEND BELOW TOP OF BEDDING.
3. MINIMUM AND MAXIMUM WIDTHS SHALL BE IN ACCORDANCE WITH PIPE MANUFACTURER'S RECOMMENDATION AS APPROVED ON ENGINEERING PLANS.



1. Locate ring and cover over outlet.
2. All work and materials shall conform to APWA Sect. 2600.
3. Use 20 chamfer strip on all exposed concrete corners.
4. Steps required at 400 O.C. when depth from top of casing to invert exceeds 1200.
5. Boxcuts will not be allowed to project through the corners of the structure.
6. The minimum reinforcing shall be 1 H-bar over a cast-in place pipe and 2 H-bars over a precast boxcut.
7. Limit opening height to 150 with 15M galvanized bars extending to corner rebars.
8. Show field inlet orientation on plans plus number and size of openings.
9. O.R. = outside pipe radius
10. Ring & Cover to be Neenah R-1537, Clay & Bailey #200, Deeter #2016, or approved equal.
(Casting may vary by municipality, refer to plans & contract documents.)
11. 100 # field tie or precast hole shall be located at entering pipe and in the front face sump points. These ties or openings shall be capped with 6 galvanized wire mesh on the outside of the inlet and clear the invert and base concrete.

[illegible]

FIELD INLET DETAIL
N.T.S.





1. Where Pipe Underdrains are used, all Underdrain Outlet Pipes shall be solid wall with watertight joints. All Outlets Pipes shall be tied into the nearest storm sewer inlets at roadway sag locations as indicated in the street profile.
2. All Underdrain Pipes shall be installed at a minimum slope of 1%.
3. Underdrain Pipe shall be installed with the perforations placed down.
4. Blanket Underdrain Aggregate, Pipe Underdrain Aggregate, Pipe Underdrain, Edge Underdrain and Outlet Pipe shall conform to City of Lee's Summit Specifications.
5. Overlap geotextile at top of trench a minimum of 12".

BARS	BAR SIZE	SPACING (mm)
H	10M	300
V	10M	300
L	15M	150
W	15M	150

NOTE: All dimensions in mm.

Record Drawing

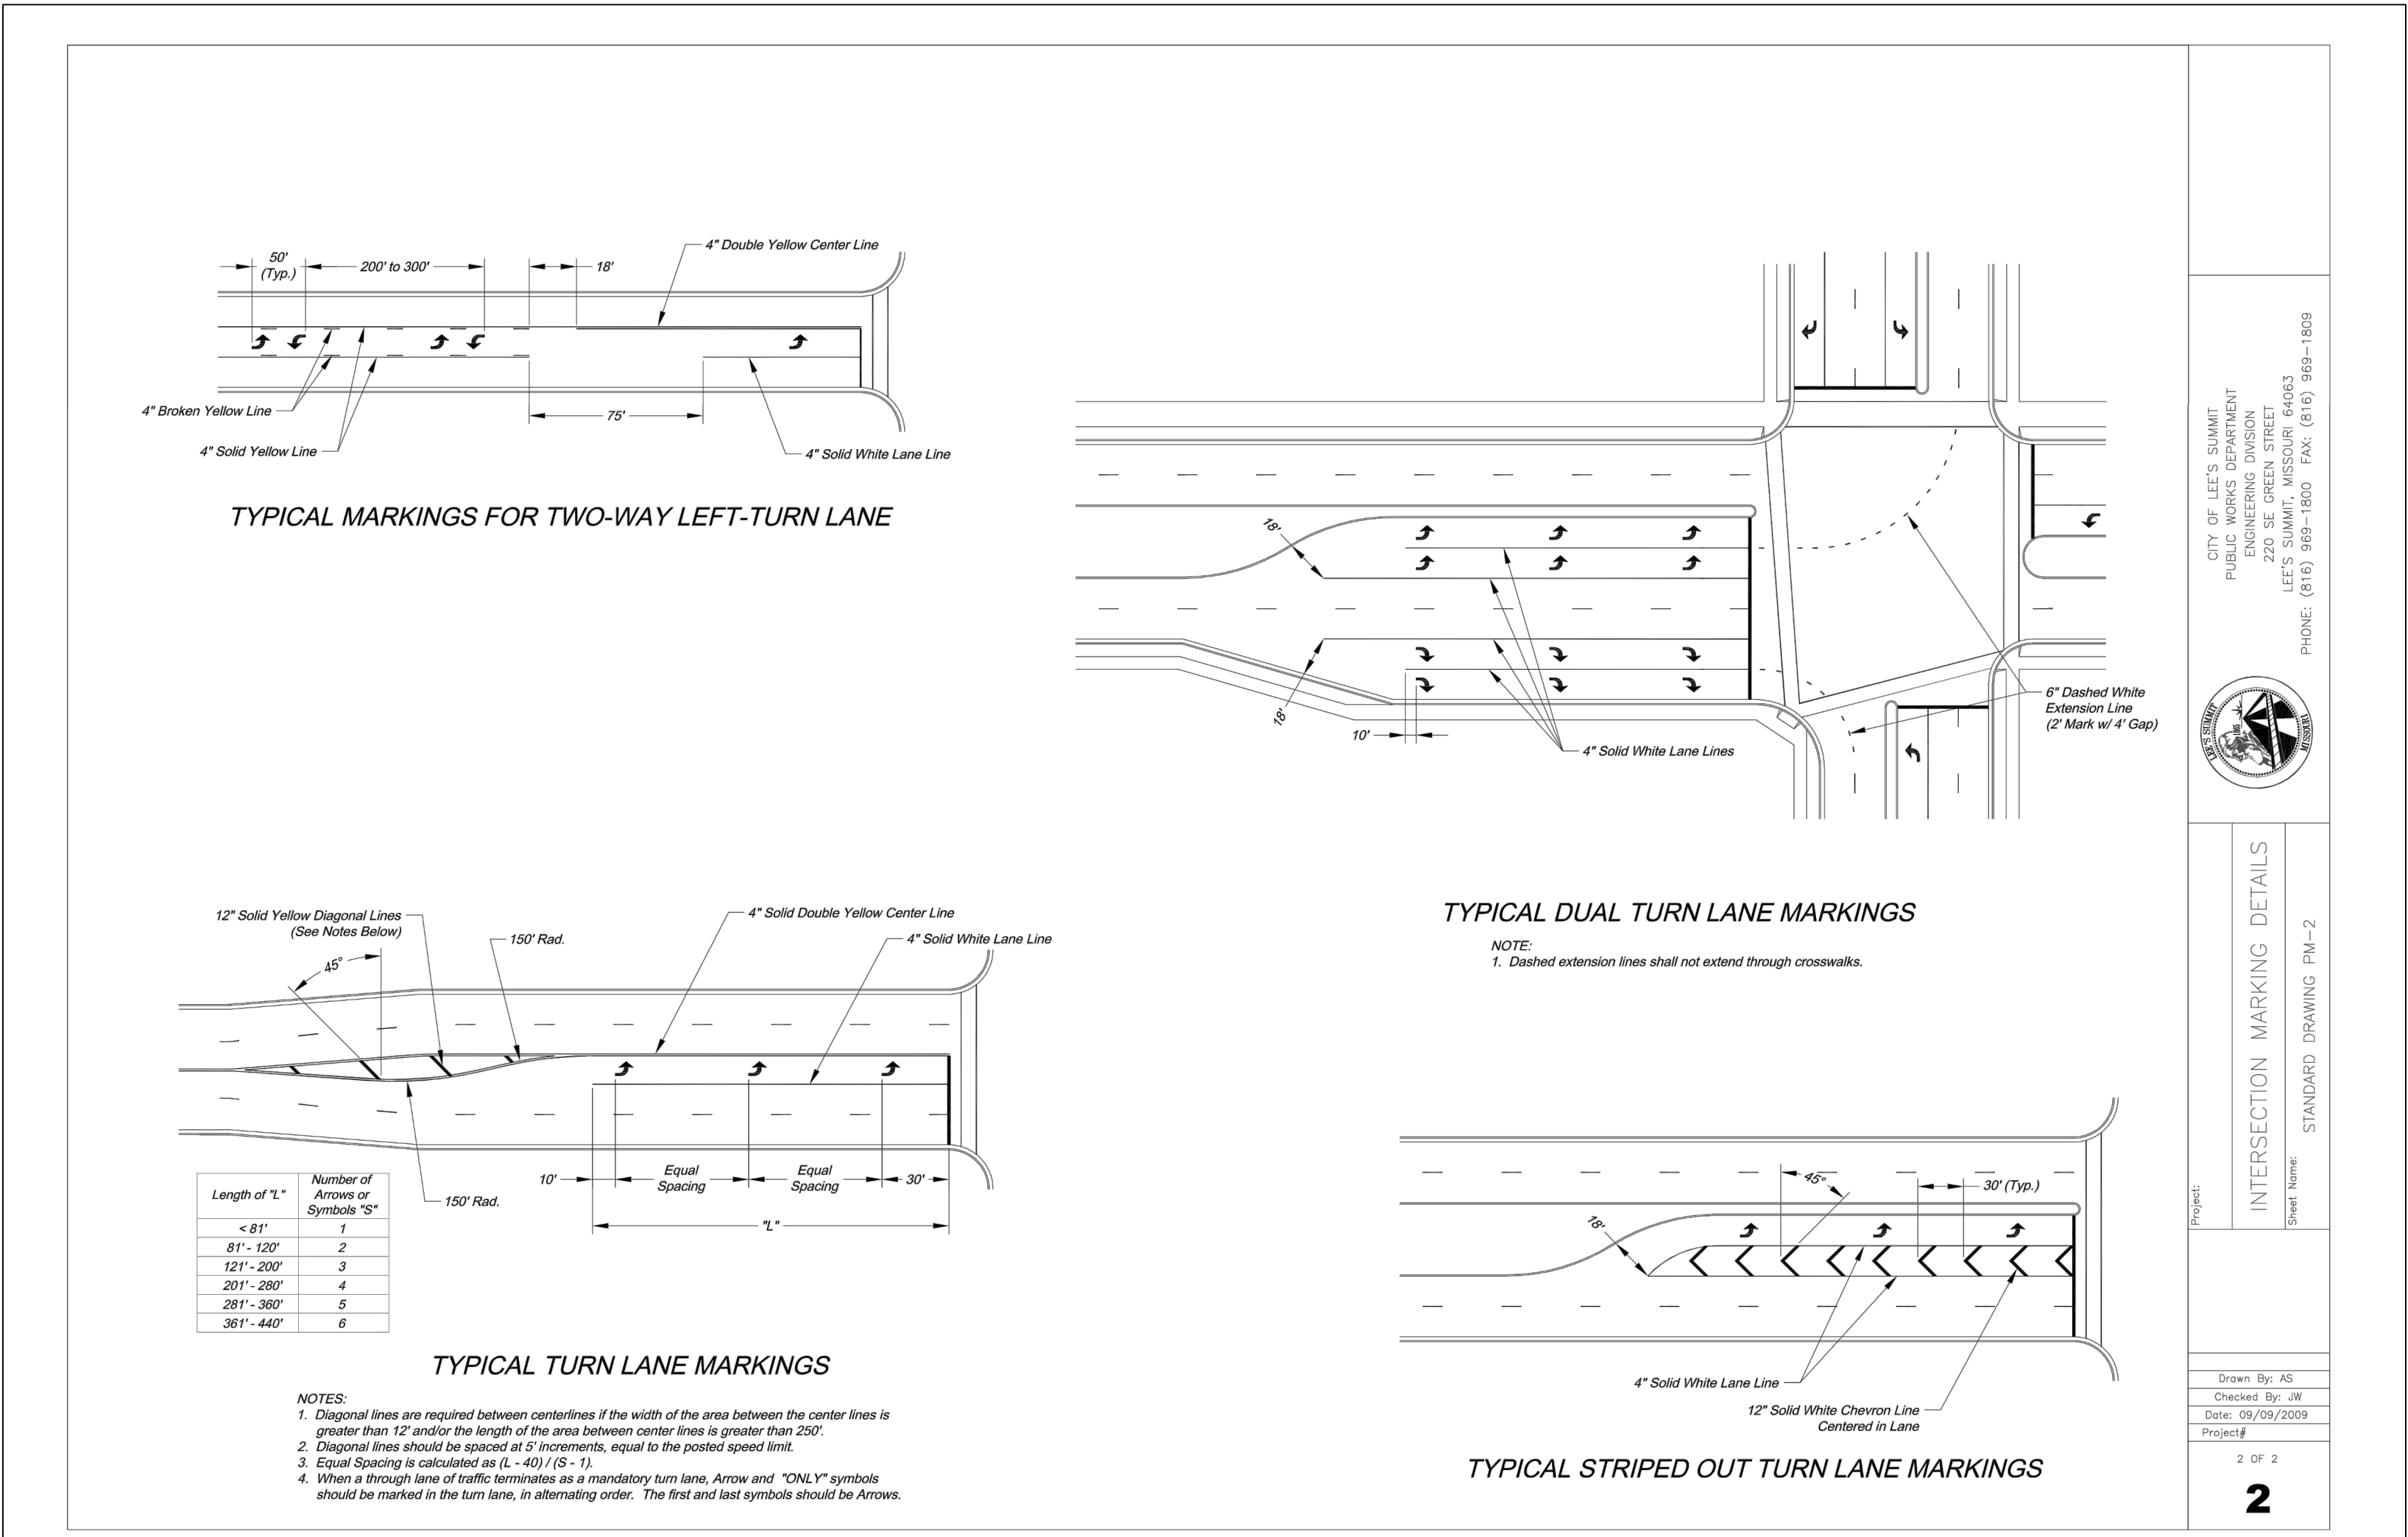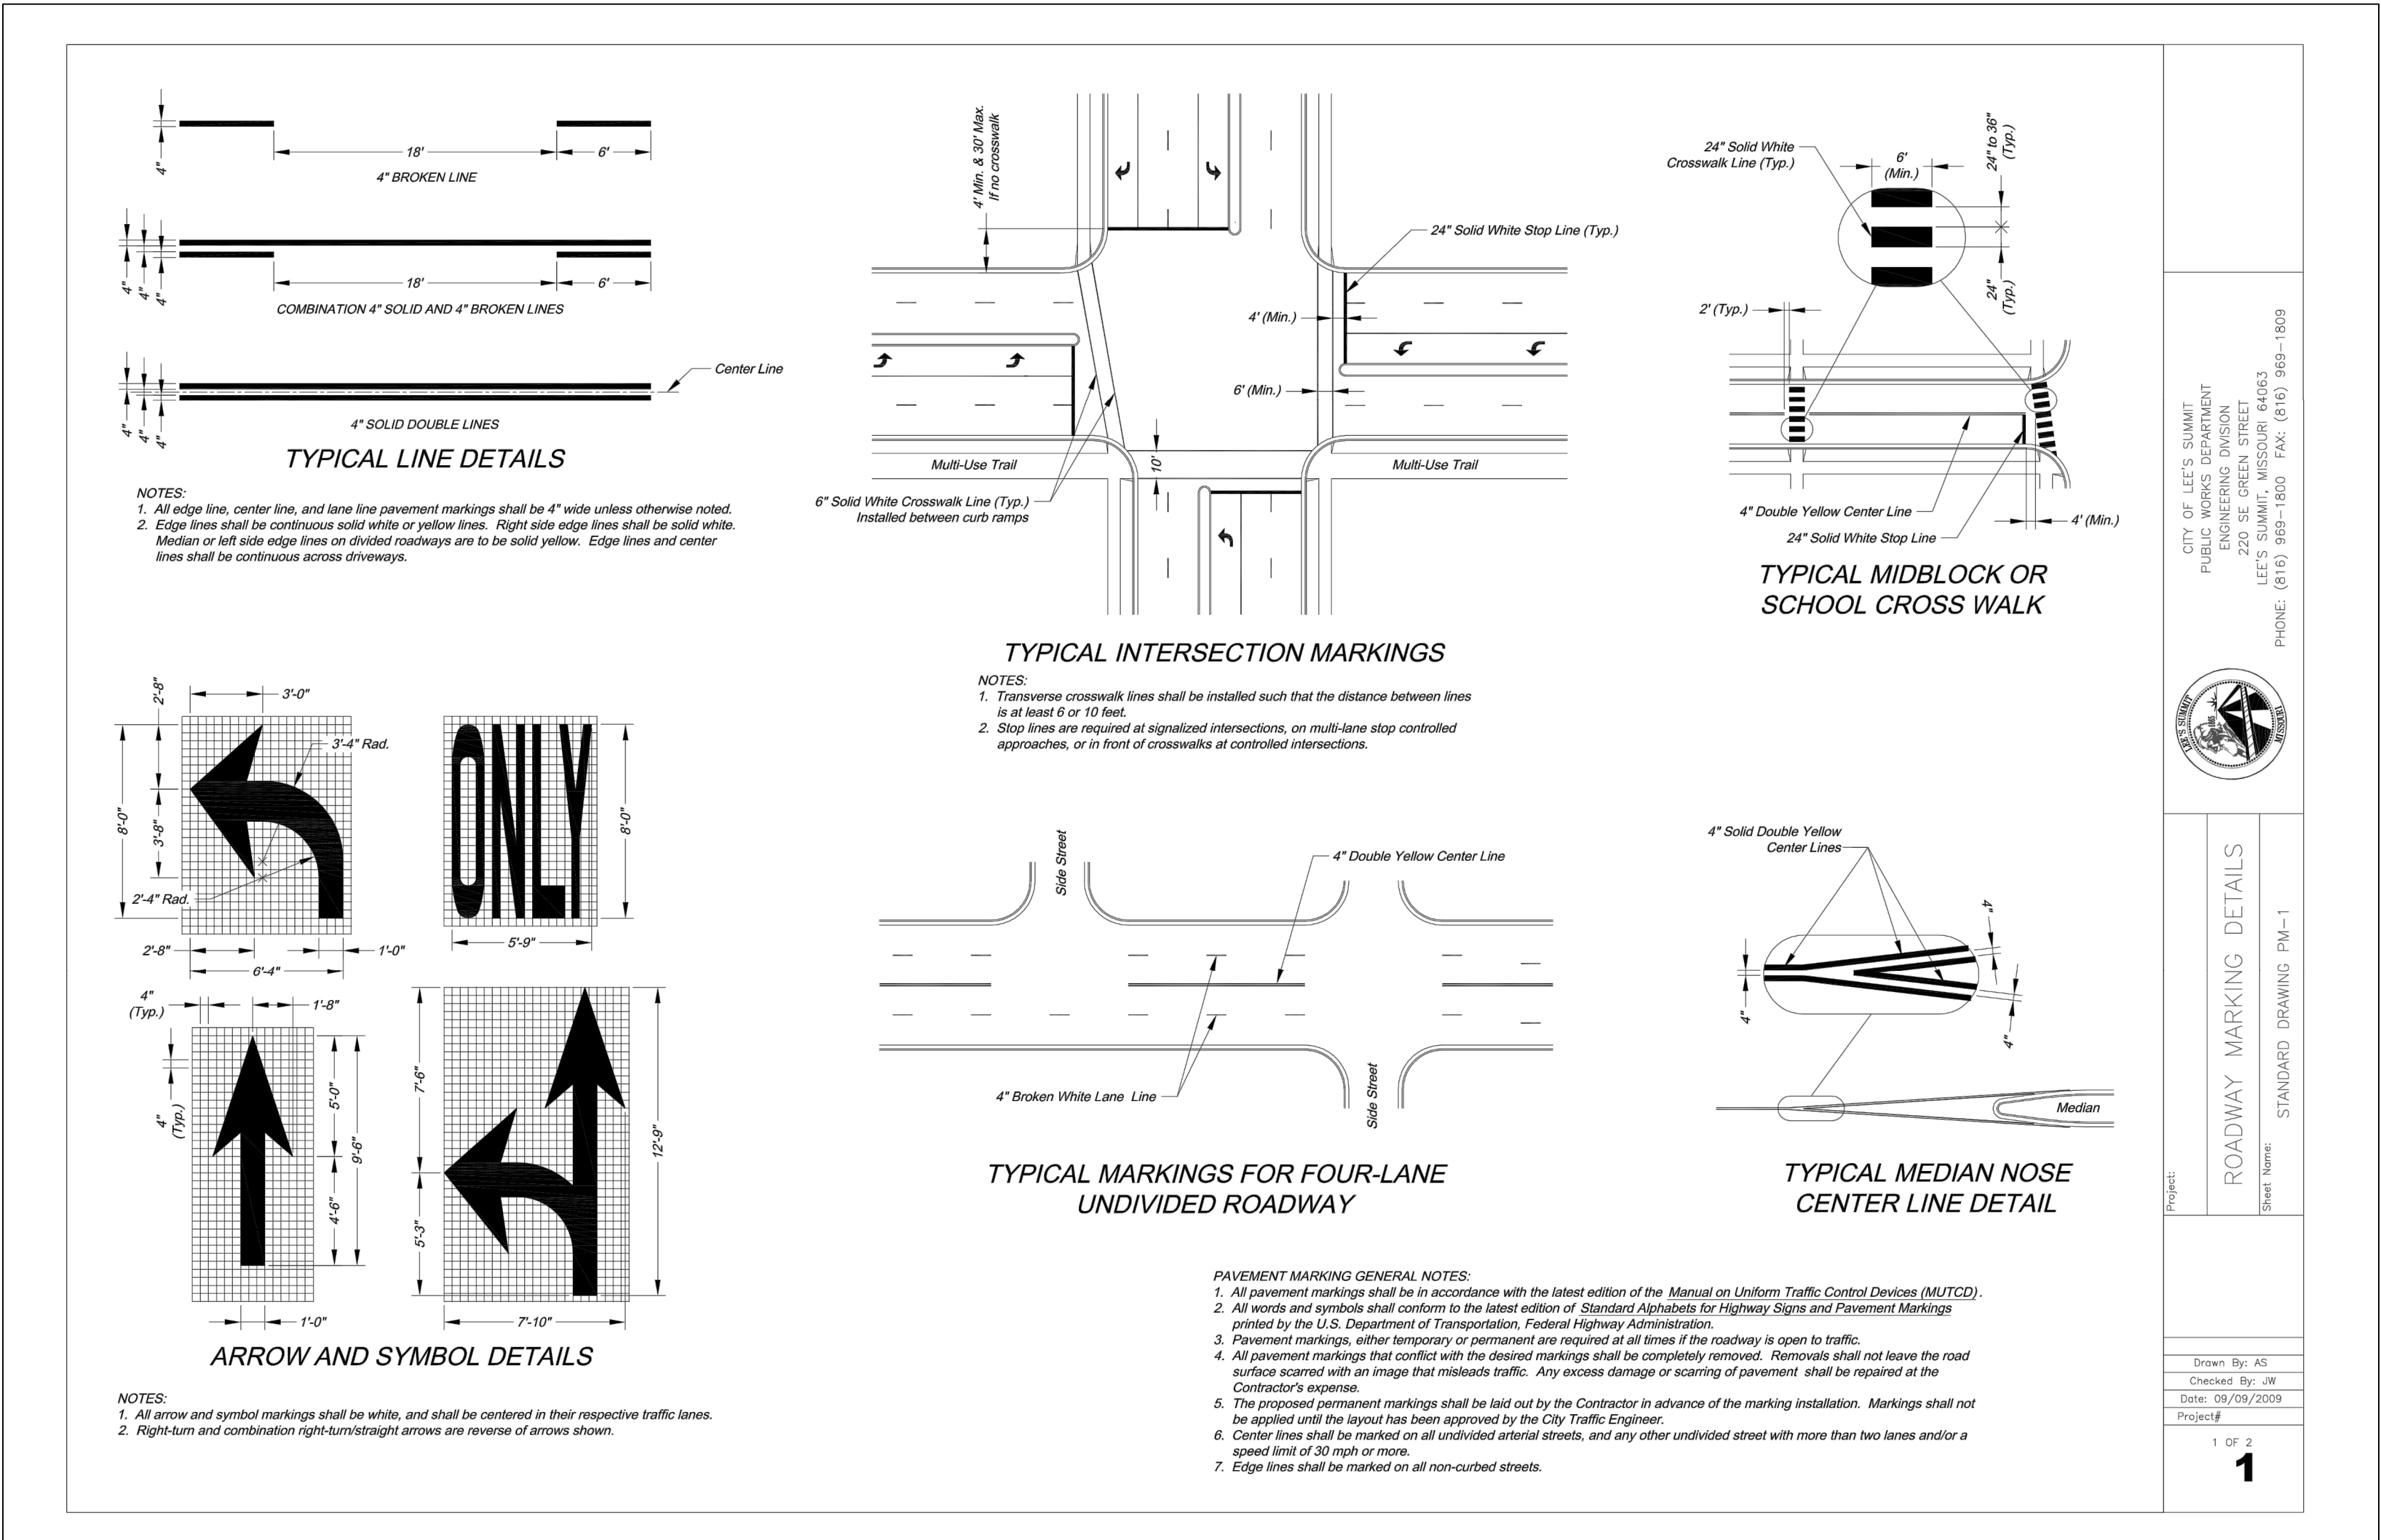

NOT AS BUILT

Record Drawing