


CONSTRUCTION PLANS
FOR
WHISPERING WOODS AMENITY AREA
CITY OF LEE'S SUMMIT
JACKSON COUNTY, MISSOURI

DESCRIPTION

PROPERTY DESCRIPTION
CONTAINING 105,623 SQUARE FEET OR 2.42 ACRES

TRACT C OF WHISPERING WOODS, 1ST PLAT, LOTS 1-33

PROJECT LOCATION

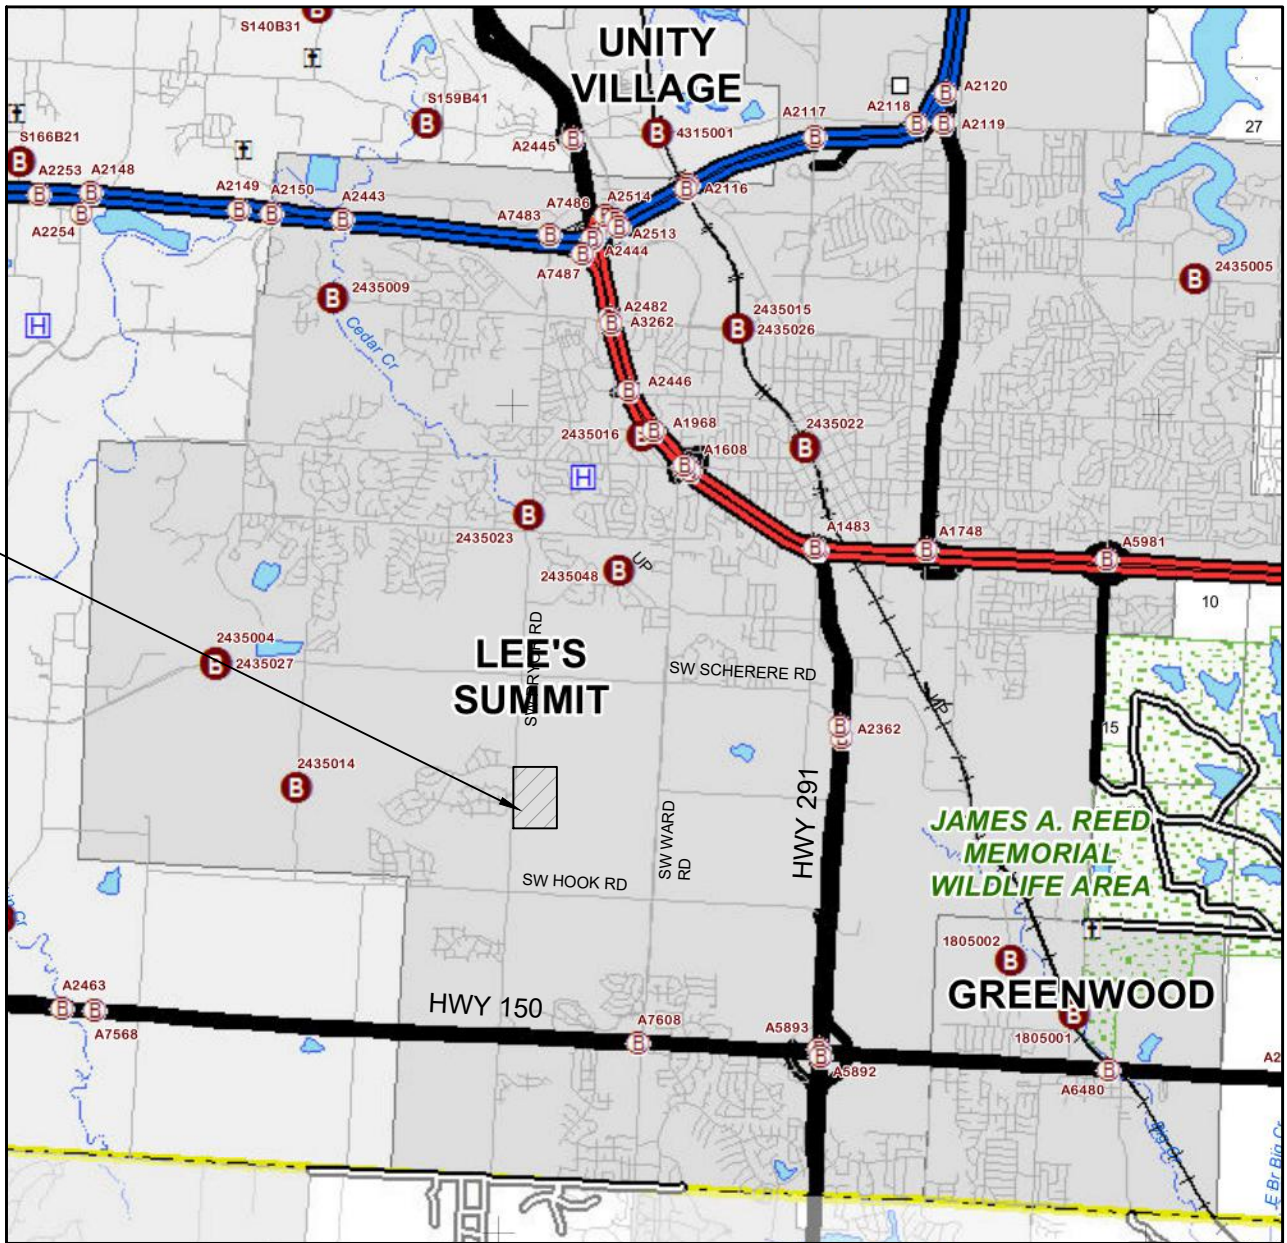

LOCATION MAP
N.T.S.

Sheet List Table


Sheet Number	Sheet Title
C1.0	TITLE SHEET
C1.1	GENERAL NOTES
C2.0	OVERALL SITE PLAN
C2.1	SITE PLAN
C3.0	GRADING PLAN
C3.1	SPOT ELEVATION PLAN
C3.2	SIDEWALK RAMP PLAN
C3.3	EROSION CONTROL PLAN
C3.4	UTILITY PLAN
C4.0	DETAILS
C4.1	DETAILS
C5.0	LIGHTING PLAN
C6.0	POOL PLUMBING PLAN
C6.1	POOL ELECTRICAL PLAN
C6.2	POOL PROFILE
L1.0	LANDSCAPE PLAN

APPROVED:


City Engineer

Date

UTILITY SERVICE NUMBERS	
SPECTRUM	886-874-2389
EVERGY	816-220-5213
SPIRE GAS	816-399-9633
LEE'S SUMMIT PUBLIC WORKS	816-969-1800
CITY PLANNING & DEVELOPMENT	816-969-1600
FIRE DEPARTMENT	816-969-1300

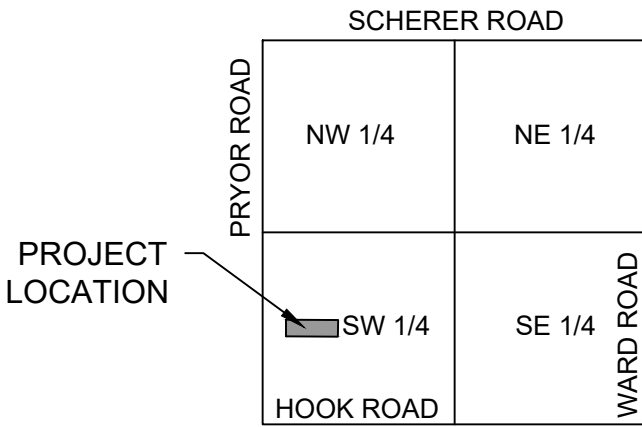

VICINITY MAP
N.T.S.

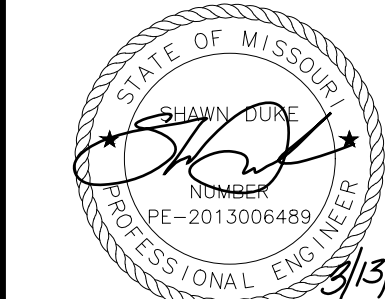

SHAWN DUKE - ENGINEER
MO PE#2013006489

WHISPERING WOODS AMENITY AREA

LEE'S SUMMIT, MO

TITLE SHEET

SNYDER & ASSOCIATES
ENGINEERS & PLANNERS, INC.



Project No: 120.0484.11

Sheet C1.0

Sheet C1.0

- CONTRACTOR SHALL REFER TO THE CURRENT VERSION OF THE CITY OF LEE'S SUMMIT DESIGN AND CONSTRUCTION (D&C) MANUAL.
2. ALL WORKMANSHIP AND MATERIALS SHALL BE SUBJECT TO THE INSPECTION AND APPROVAL OF THE ENGINEERING DEPARTMENT OF LEE'S SUMMIT, MISSOURI.
3. LINEAL FOOT MEASUREMENTS SHOWN ON THESE PLANS ARE HORIZONTAL MEASUREMENTS, NOT SLOPE MEASUREMENTS. ALL PAYMENTS SHALL BE MADE ON HORIZONTAL MEASUREMENTS.
4. NO GEOLOGICAL INVESTIGATION WAS PERFORMED ON THIS PROJECT.
5. THE UTILITY LOCATIONS SHOWN ON THESE PLANS ARE TAKEN FROM UTILITY COMPANY RECORDS AND ARE APPROXIMATE ONLY. THEY DO NOT CONSTITUTE ACTUAL FIELD LOCATIONS. THE CONTRACTOR SHALL VERIFY THE LOCATION AND DEPTH OF ALL UTILITIES PRIOR TO CONSTRUCTION.
6. CLEARING AND GRUBBING OPERATIONS AND DISPOSAL OF ALL DEBRIS THEREFROM SHALL BE PERFORMED BY THE CONTRACTOR IN STRICT ACCORDANCE WITH ALL STATE AND LOCAL CODES AND ORDINANCES.
7. ALL WASTE MATERIAL SHALL BE DISPOSED OF AT A LOCATION TO BE SELECTED BY THE OWNER OR HIS AUTHORIZED REPRESENTATIVE, SUCH LOCATION TO BE ON THE SITE.
8. THE CONTRACTOR SHALL CONTROL THE EROSION AND SILTATION DURING ALL PHASES OF CONSTRUCTION. HE SHALL KEEP THE STREETS CLEAN OF MUD AND DEBRIS AND FOLLOW THE EROSION CONTROL PLAN PREPARED BY THE DESIGN ENGINEER.
9. ALL MANHOLES, CATCH BASINS, UTILITY VALVES AND METER PITS TO BE ADJUSTED OR REBUILT TO GRADE AS REQUIRED.
10. SUBGRADE SOIL FOR ALL CONCRETE STRUCTURES, REGARDLESS OF THE TYPE OR LOCATION, SHALL BE FIRM, DENSE AND THOROUGHLY COMPACTED AND CONSOLIDATED; SHALL BE FREE FROM MUCK AND MUD; AND SHALL BE SUFFICIENTLY STABLE TO REMAIN FIRM AND INTACT UNDER THE FEET OF THE WORKMAN OR MACHINERY ENGAGED IN SUBGRADE, LAYING REINFORCING STEEL, AND DEPOSITING CONCRETE THEREON. IN ALL CASES WHERE SUBSOIL IS MUCKY OR WORKS INTO MUD OR MUCK DURING SUCH OPERATION, A SEAL COURSE OF EITHER CONCRETE OR ROCK SHALL BE PLACED BELOW SUBGRADE TO PROVIDE A FIRM BASE FOR WORKING AND FOR PLACING THE FLOOR SLAB.
11. A MINIMUM HORIZONTAL DISTANCE OF TEN FEET (10') SHALL BE MAINTAINED BETWEEN PARALLEL WATER AND SANITARY SEWER LINES. AT ANY POINT WHERE SANITARY SEWER LINES CROSS WATER MAIN, THE SANITARY SEWER SHALL BE CONSTRUCTED OF CAST IRON PIPE OR PIPE ENCASED IN CONCRETE FOR A DISTANCE OF TEN FEET (10') IN EACH DIRECTION FROM THE CROSSING UNLESS THE WATER IS A MINIMUM OF EIGHTEEN INCHES (18") ABOVE THE TOP OF THE SANITARY SEWER LINE.
12. CONTRACTOR SHALL PROVIDE TESTING AND INSPECTION PER SECTION 3500 - SANITARY SEWERS CITY OF LEE'S SUMMIT, MISSOURI STANDARD SPECIFICATIONS.
13. DEVELOPMENT PLANS ARE APPROVED INITIALLY FOR ONE (1) YEAR, AFTER WHICH THEY AUTOMATICALLY BECOME VOID AND MUST BE UPDATED AND APPROVED BY THE CITY ENGINEER BEFORE ANY CONSTRUCTION WILL BE PERMITTED.
14. ALL SANITARY SEWER STUBS SHALL BE SURVEYED AND STAKED ON SITE BEFORE THE CONSTRUCTION OF SANITARY SERVICE STUBS.
15. THE CITY OF LEE'S SUMMIT PLAN REVIEW IS ONLY FOR GENERAL CONFORMANCE WITH THE CITY OF LEE'S SUMMIT DESIGN CRITERIA AND THE CITY CODE. THE CITY IS NOT RESPONSIBLE FOR THE ACCURACY AND ADEQUACY OF THE DESIGN, OR DIMENSIONS AND ELEVATIONS WHICH SHALL BE CONFIRMED AND CORRELATED AT THE JOB SITE. THE CITY OF LEE'S SUMMIT THROUGH APPROVAL OF THIS DOCUMENT ASSUMES NO RESPONSIBILITY OTHER THAN AS STATED ABOVE FOR THE COMPLETENESS AND/OR ACCURACY OF THIS DOCUMENT.
16. THE CONTRACTOR SHALL HAVE ONE (1) SIGNED COPY OF THE PLANS (APPROVED BY THE CITY OF LEE'S SUMMIT) AND ONE (1) COPY OF THE APPROPRIATE CONSTRUCTION STANDARDS AND SPECIFICATIONS AT THE JOB SITE AT ALL TIMES.
17. CONSTRUCTION OF THE IMPROVEMENTS SHOWN OR IMPLIED BY THIS SET OF DRAWINGS SHALL NOT BE INITIATED OR ANY PART THEREOF UNDERTAKEN UNTIL THE CITY ENGINEER IS NOTIFIED OF SUCH INTENT AND ALL REQUIRED AND PROPERLY EXECUTED BONDS AND PERMIT FEES ARE RECEIVED AND APPROVED BY THE CITY ENGINEER.
18. ALL STUB LINES SHALL BE LAID ON 2.00% MINIMUM GRADE UNLESS APPROVED OTHERWISE.
19. CONTRACTOR SHALL NOT BE ALLOWED TO WORK ON SATURDAYS, SUNDAYS, OR HOLIDAYS WITHOUT PRIOR APPROVAL OF THE CITY ENGINEER.
20. RELOCATION OF ANY WATER LINE, SEWER LINE OR SERVICE LINE THEREOF REQUIRED FOR THE CONSTRUCTION OF THIS PROJECT SHALL BE THE RESPONSIBILITY OF THE CONTRACTOR AND SHALL BE AT HIS EXPENSE.
21. THE CONTRACTOR SHALL INSTALL AND PROPERLY MAINTAIN A MECHANICAL PLUG AT ALL CONNECTION POINTS WITH EXISTING LINES UNTIL SUCH TIME THAT THE NEW LINE IS TESTED AND APPROVED.
22. THE CONTRACTOR SHALL CONSTRUCT MANHOLES PLACING ECCENTRIC CONE SECTION IN SUCH A MANNER THAT MANHOLE COVERS ARE ADJACENT TO THE PROPOSED SIDEWALKS. IN LOCATIONS WHERE MANHOLES ARE NOT NEAR PROPOSED SIDEWALKS THE MANHOLE COVERS SHALL GENERALLY BE PLACED ON THE UPSTREAM SIDE OF THE MANHOLES WHENEVER POSSIBLE.
23. STUB LINES, LOCATIONS, AND MINIMUM BASEMENT FLOOR ELEVATIONS ARE LOCATED IN THE TABLE LABELED "TABLE OF SERVICE LOCATIONS."
24. CONSTRUCTION PERMITS WILL NOT BE ISSUED UNTIL THE CITY OF LEE'S SUMMIT RECEIVES A SEWER EXTENSION PERMIT FROM MDNR.

- PROJECT NOTES:

9. NO OIL/GAS WELLS ARE PRESENT ON PROPERTY, PER MoDNR.

TOTAL LOT AREA = 2.43 AC


➤ TOTAL DISTURBED AREA = 0.47 AC

➤ TOTAL BUILDING AREA = 0.016 AC

REQUIRED PARKING SPACES = 9

PROPOSED PARKING SPACES = 11

IMPERVIOUS COVERAGE = .293 AC = 12.06% OF TOTAL AREA

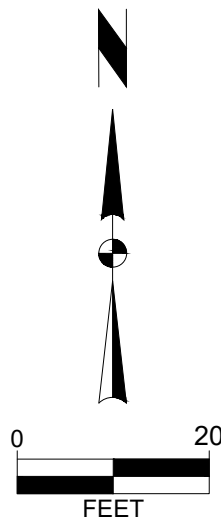[illegible]

SHAWN DUKE - ENGINEER
MO PE#2013006489

WHISPERING WOODS AMENITY AREA

LEE'S SUMMIT, MO

GENERAL NOTES


SNYDER & ASSOCIATES
ENGINEERS & PLANNERS, INC.



Project No: 120.0484.11

Sheet C1.1

V:\Projects\2020\120.0484_120.0484_Plan\120.0484_Plan.dwg P:\AN\VIEWEY SITE PLAN 2020\313_4_10PM.ANS FULL BLEED 0 (34.00 X 22.00 INCHES)

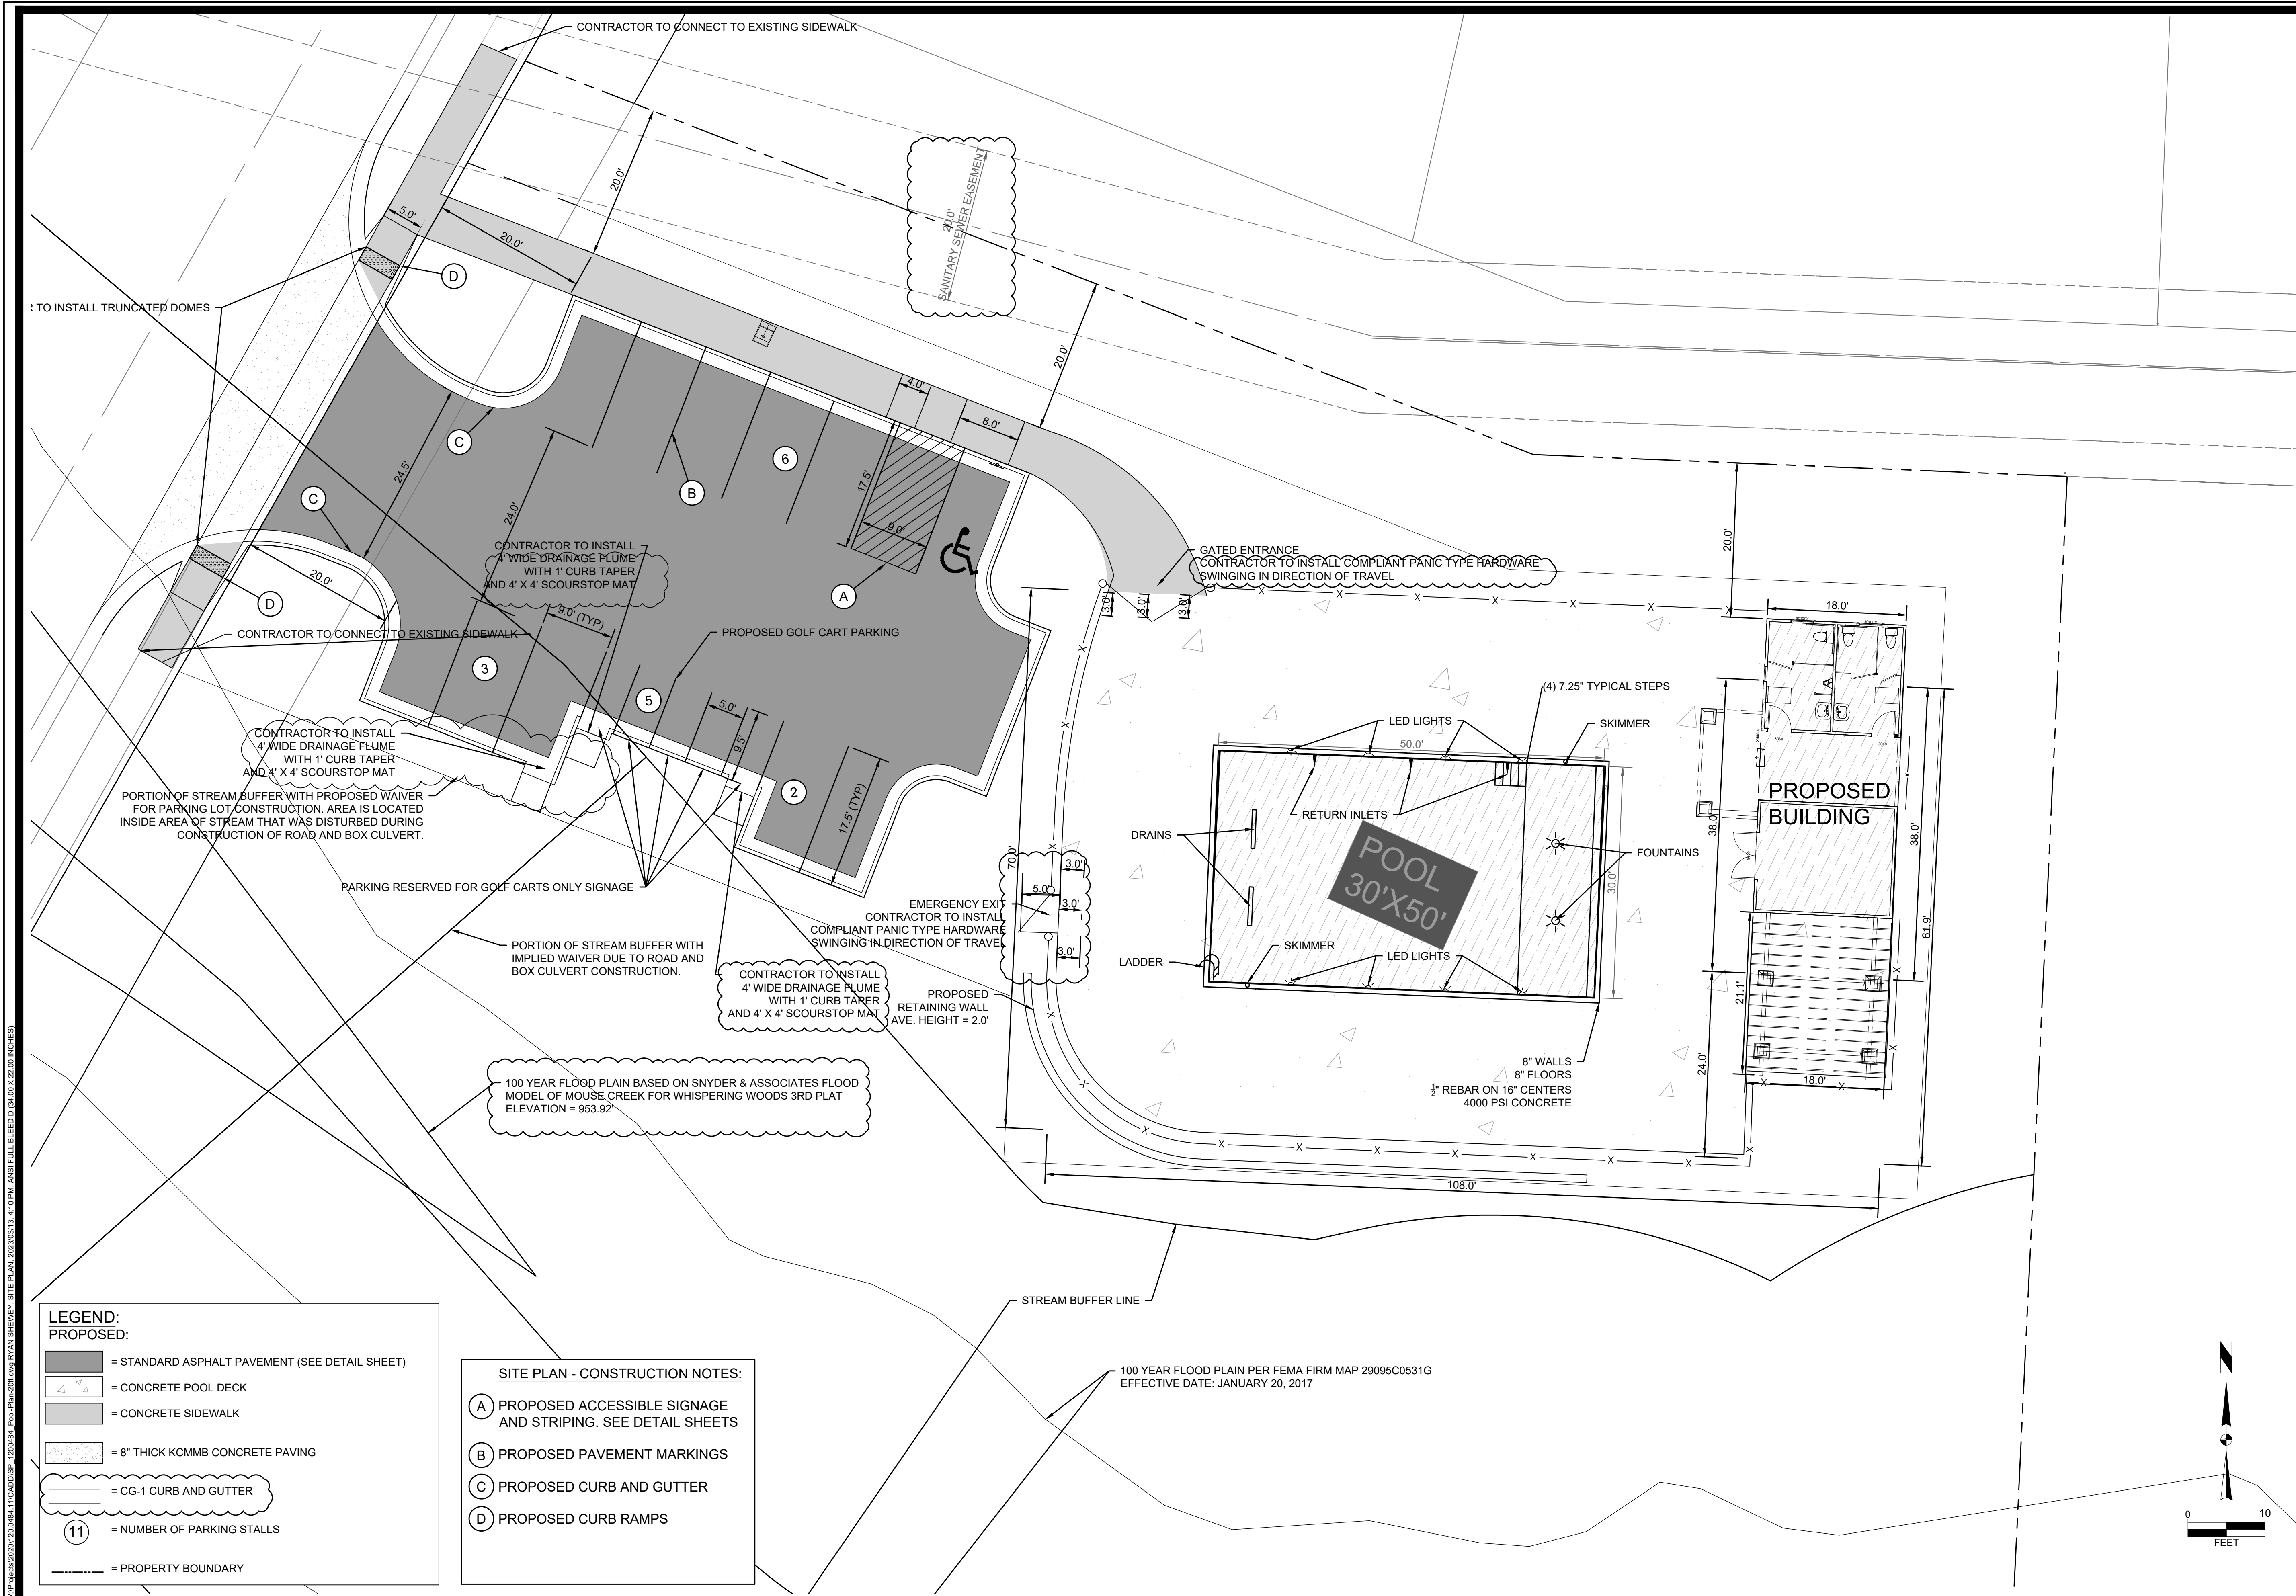

MARK	REVISION	DATE	BY
Engineer: SD	Checked By: SD	Scale: 1" = 10'	
Technician: JS	Date: 04-26-2022	T-R-S: 47N-32W-24	

Snyder & Associates Engineers & Planners, Inc.
Missouri State Certificate of Authority #200606544

SHAWN DUKE - ENGINEER
MO PE#2013006489

WHISPERING WOODS AMENITY AREA

SITE PLAN

LEE'S SUMMIT, MO

SNYDER & ASSOCIATES
ENGINEERS & PLANNERS, INC.

802 FRANCIS STREET
ST. JOSEPH, MISSOURI 64501
816-364-5222 | www.snyder-associates.com

SNYDER & ASSOCIATES

Project No: 120.0484.11

Sheet C2.1

\\proj04\proj\2020\120.0484.1\CD\DISP-1200484_Pool_Plan-20.dwg P:\M\VIEWEY SPOT ELEVATION PLAN 20200313 4.10 PM ANSI FULL BLEED D (34.00 X 22.00 INCHES)

LEGEND:

- 870- = EXISTING INDEX CONTOUR
- 870- = NEW INDEX CONTOUR



WHISPERING WOODS AMENITY AREA

SPOT ELEVATION PLAN

LEE'S SUMMIT, MO

SNYDER & ASSOCIATES
ENGINEERS & PLANNERS, INC.



Project No: 120.0484.11

Sheet C3.1



SHAWN DUKE - ENGINEER
MO PE#2013006489

802 FRANCIS STREET
ST. JOSEPH, MISSOURI 64501
816-364-5222 | www.snyder-associates.com


MARK	REVISION	DATE	BY
Engineer: SD	Checked By: SD	Scale: 1" = 10'	
Technician: JS	Date: 04-26-2022	T-R-S: 47N-32W-24	

Snyder & Associates Engineers & Planners, Inc.
Missouri State Certificate of Authority #2006008544

Sheet C3.1


Sheet C3.2

802 FRANCIS STREET
ST. JOSEPH, MISSOURI 64501
816-364-5222 | www.snyder-associates.com

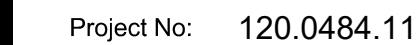

Sheet C3.2

V:\Projects\2020\120.0484_11\CAD\DWG_1200484_PoolUtility.dwg RYAN SHEVEY, UTILITY PLAN, 2023/03/13, 4:10 PM, ANSI FULL BLEED, 0.34, 0.0 X 22.00 INCHES

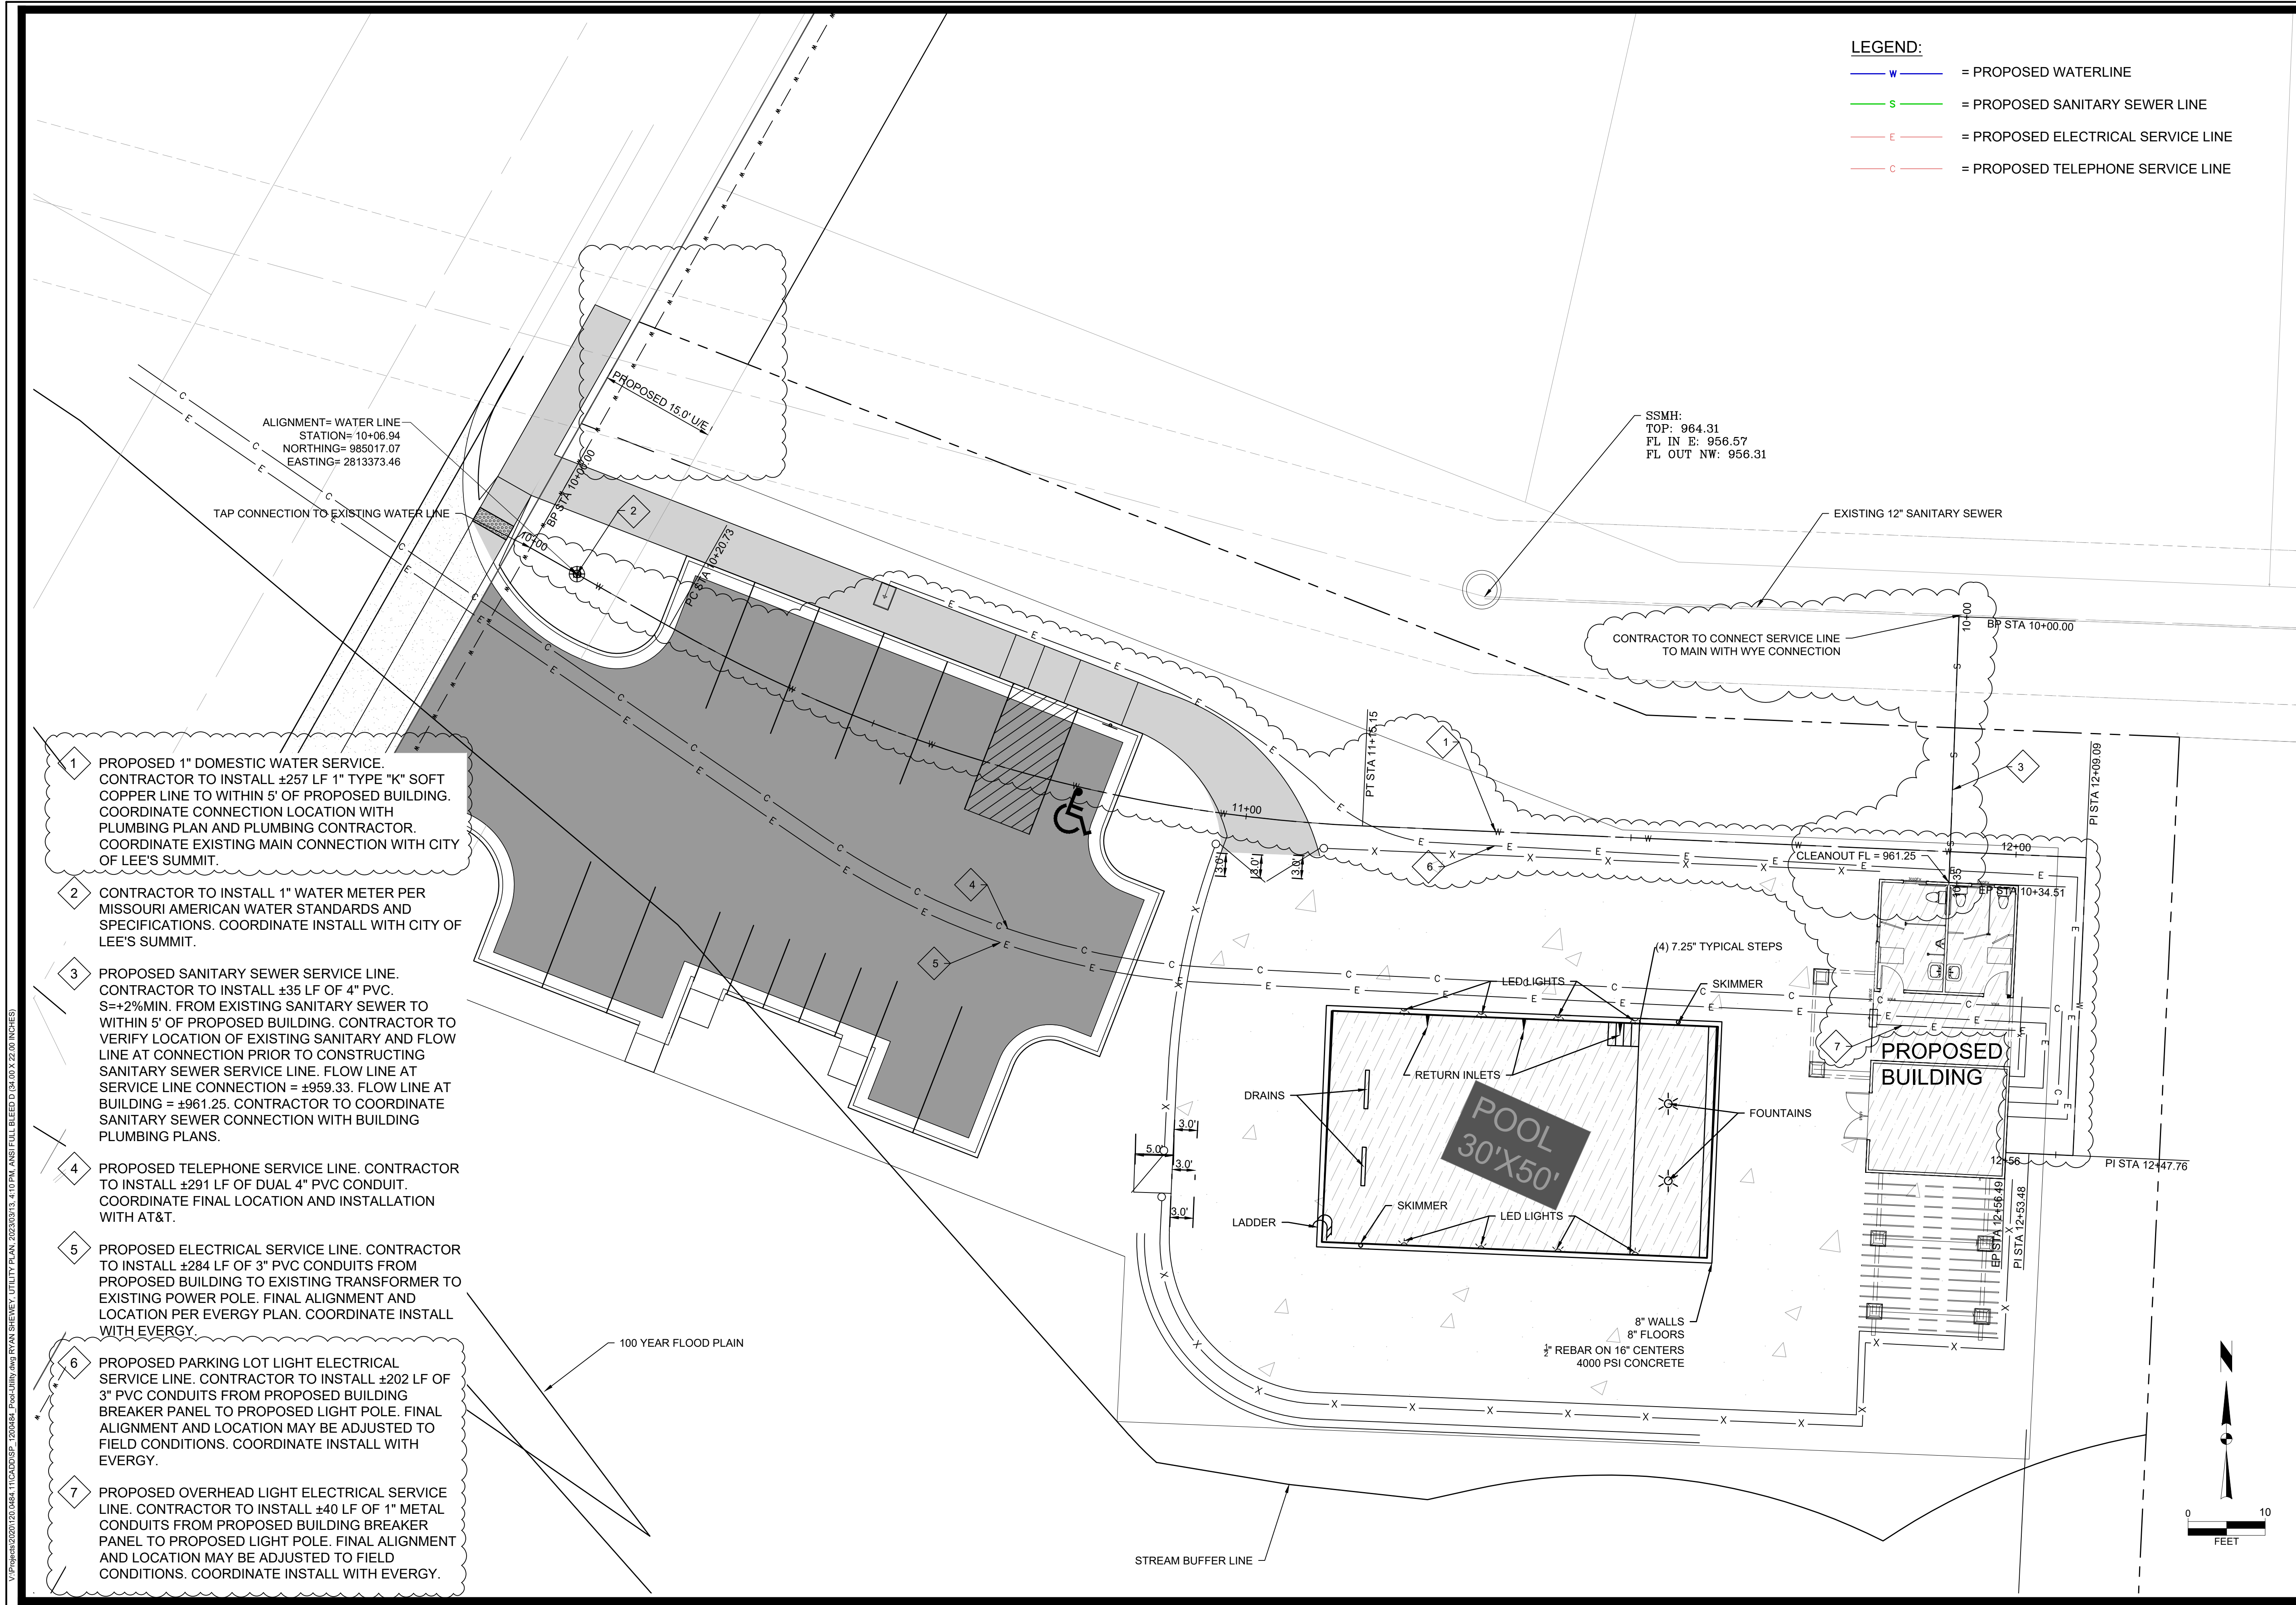

SHAWN DUKE - ENGINEER
MO PE#2013006489

WHISPERING WOODS AMENITY AREA

UTILITY PLAN

LEE'S SUMMIT, MO

SNYDER & ASSOCIATES
ENGINEERS & PLANNERS, INC.

802 FRANCIS STREET
ST. JOSEPH, MISSOURI 64501
816-364-5222 | www.snyder-associates.com





Project No: 120.0484.11


Sheet C3.4

Sheet C3.4




Revisions:
BY DATE
SD 1" = 10'
JS 04-26-2022
T-R-S 47N-32W-24

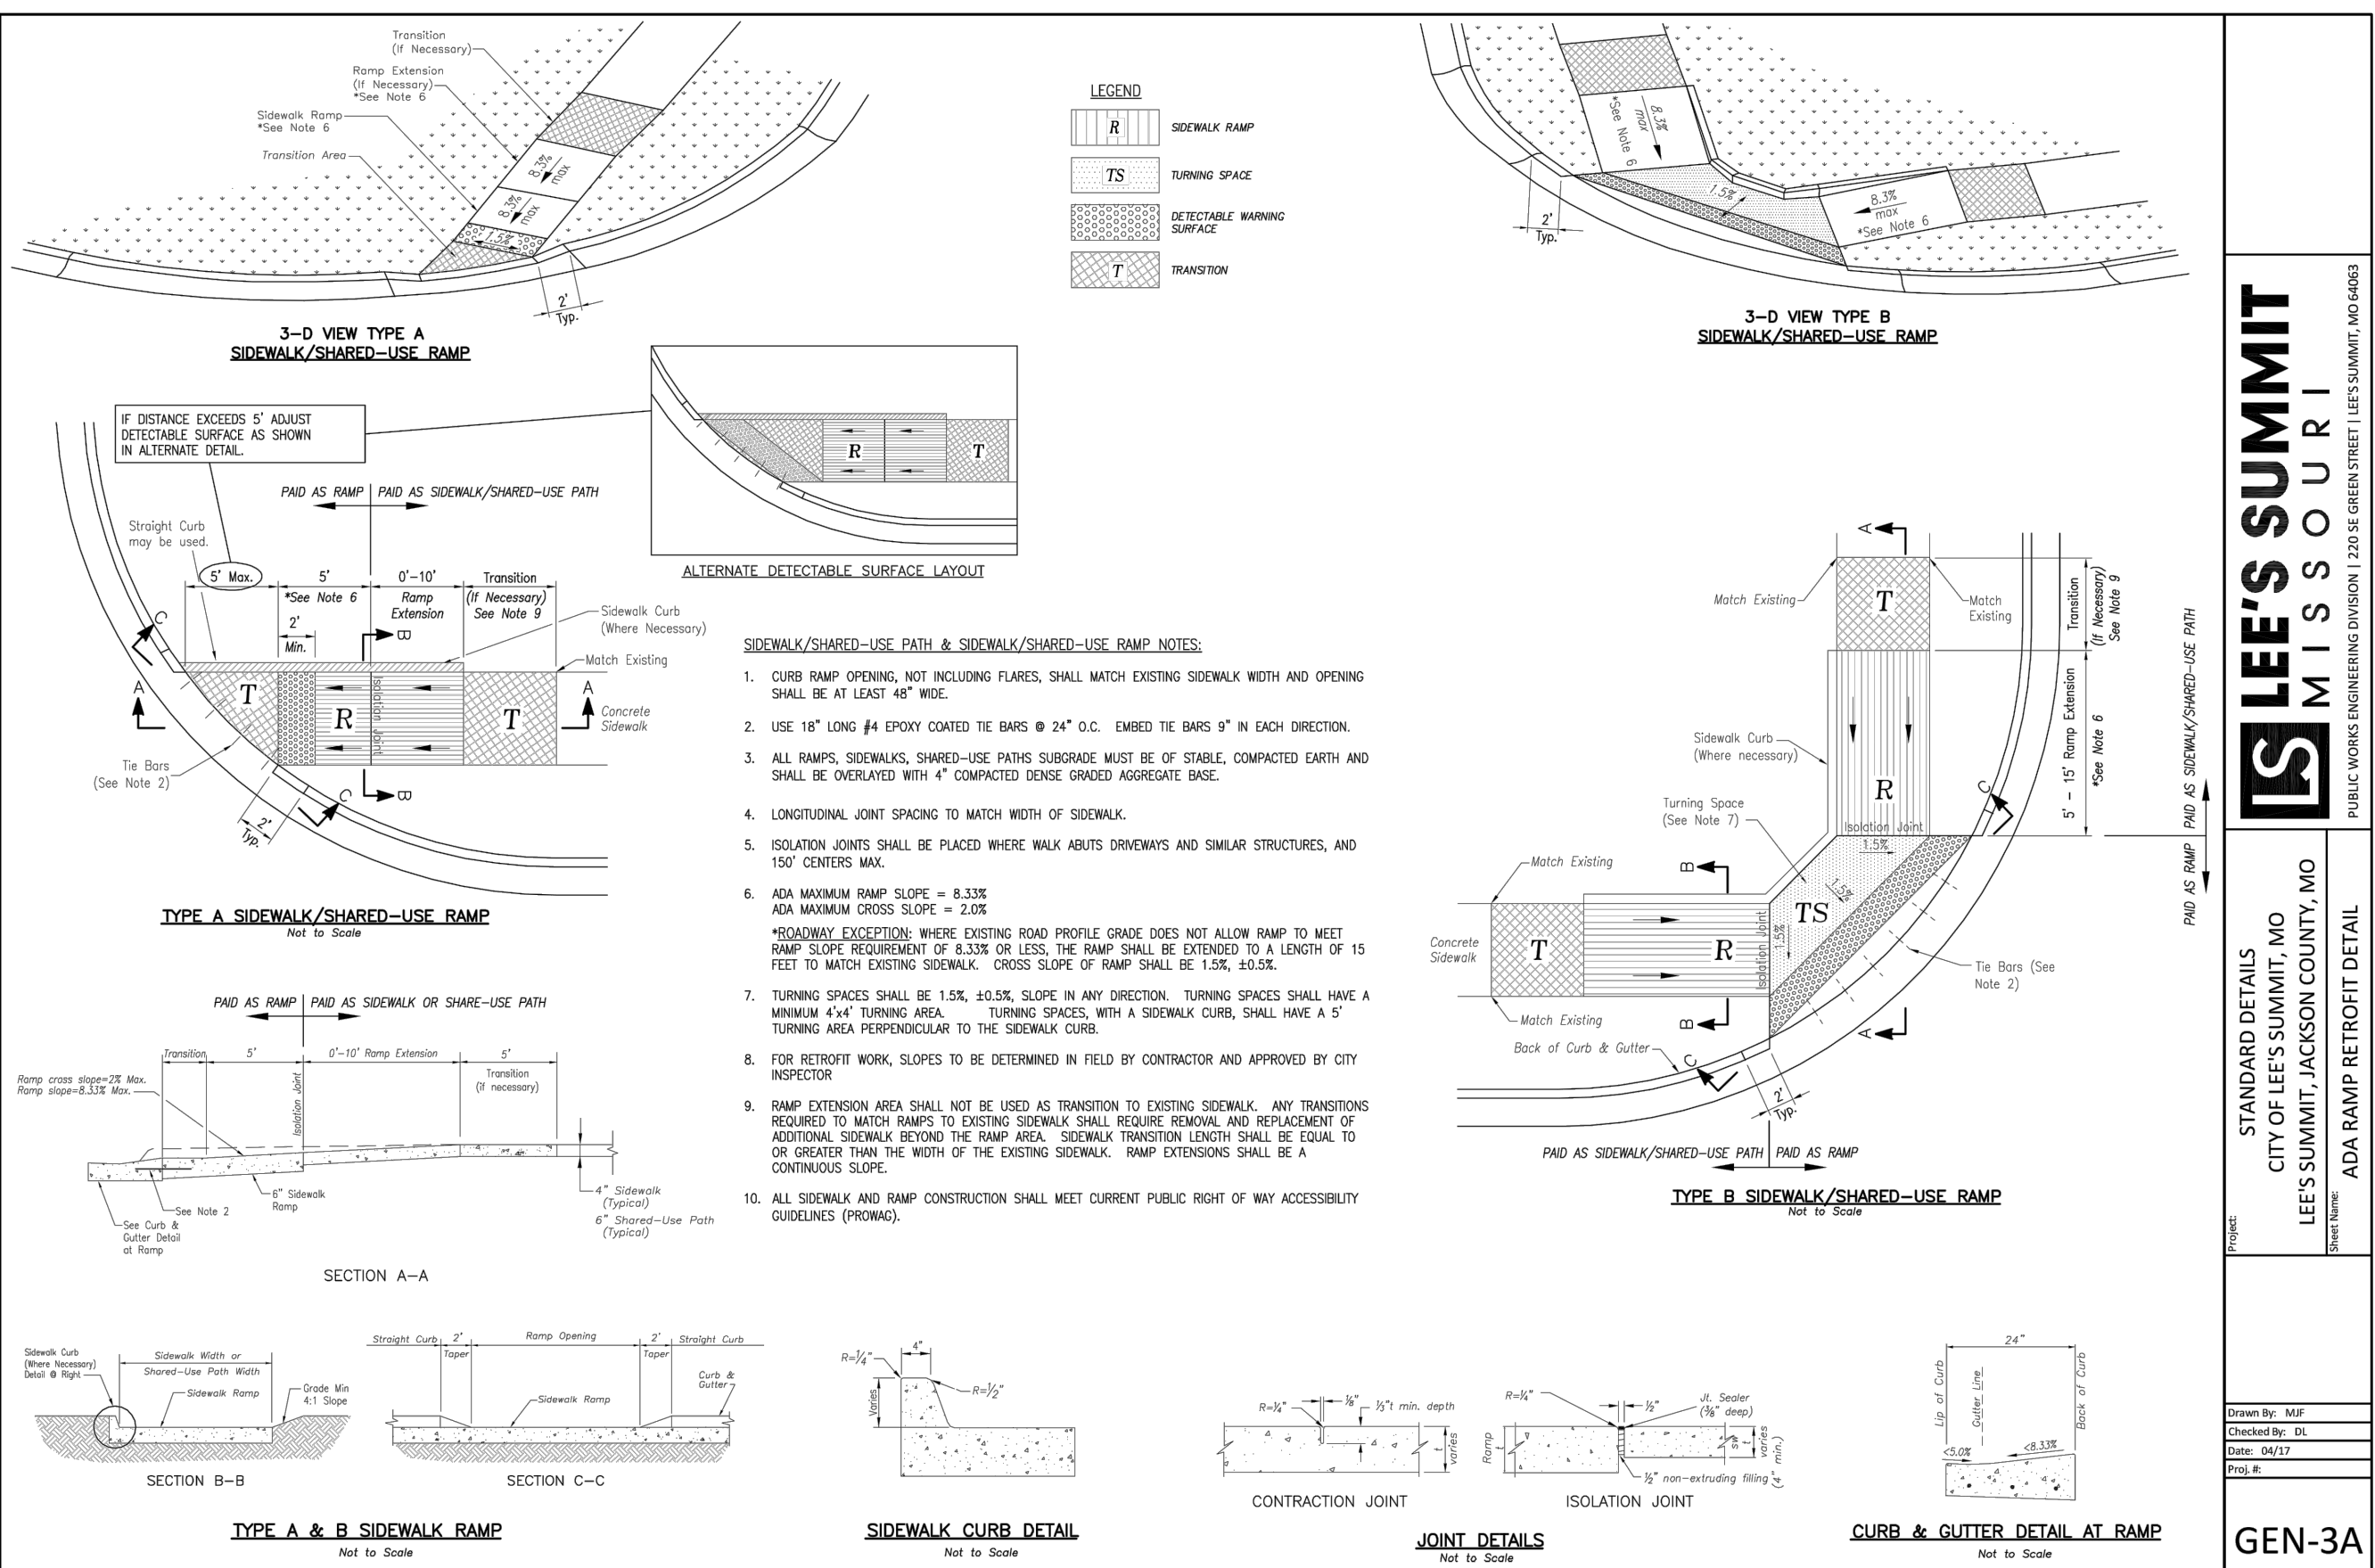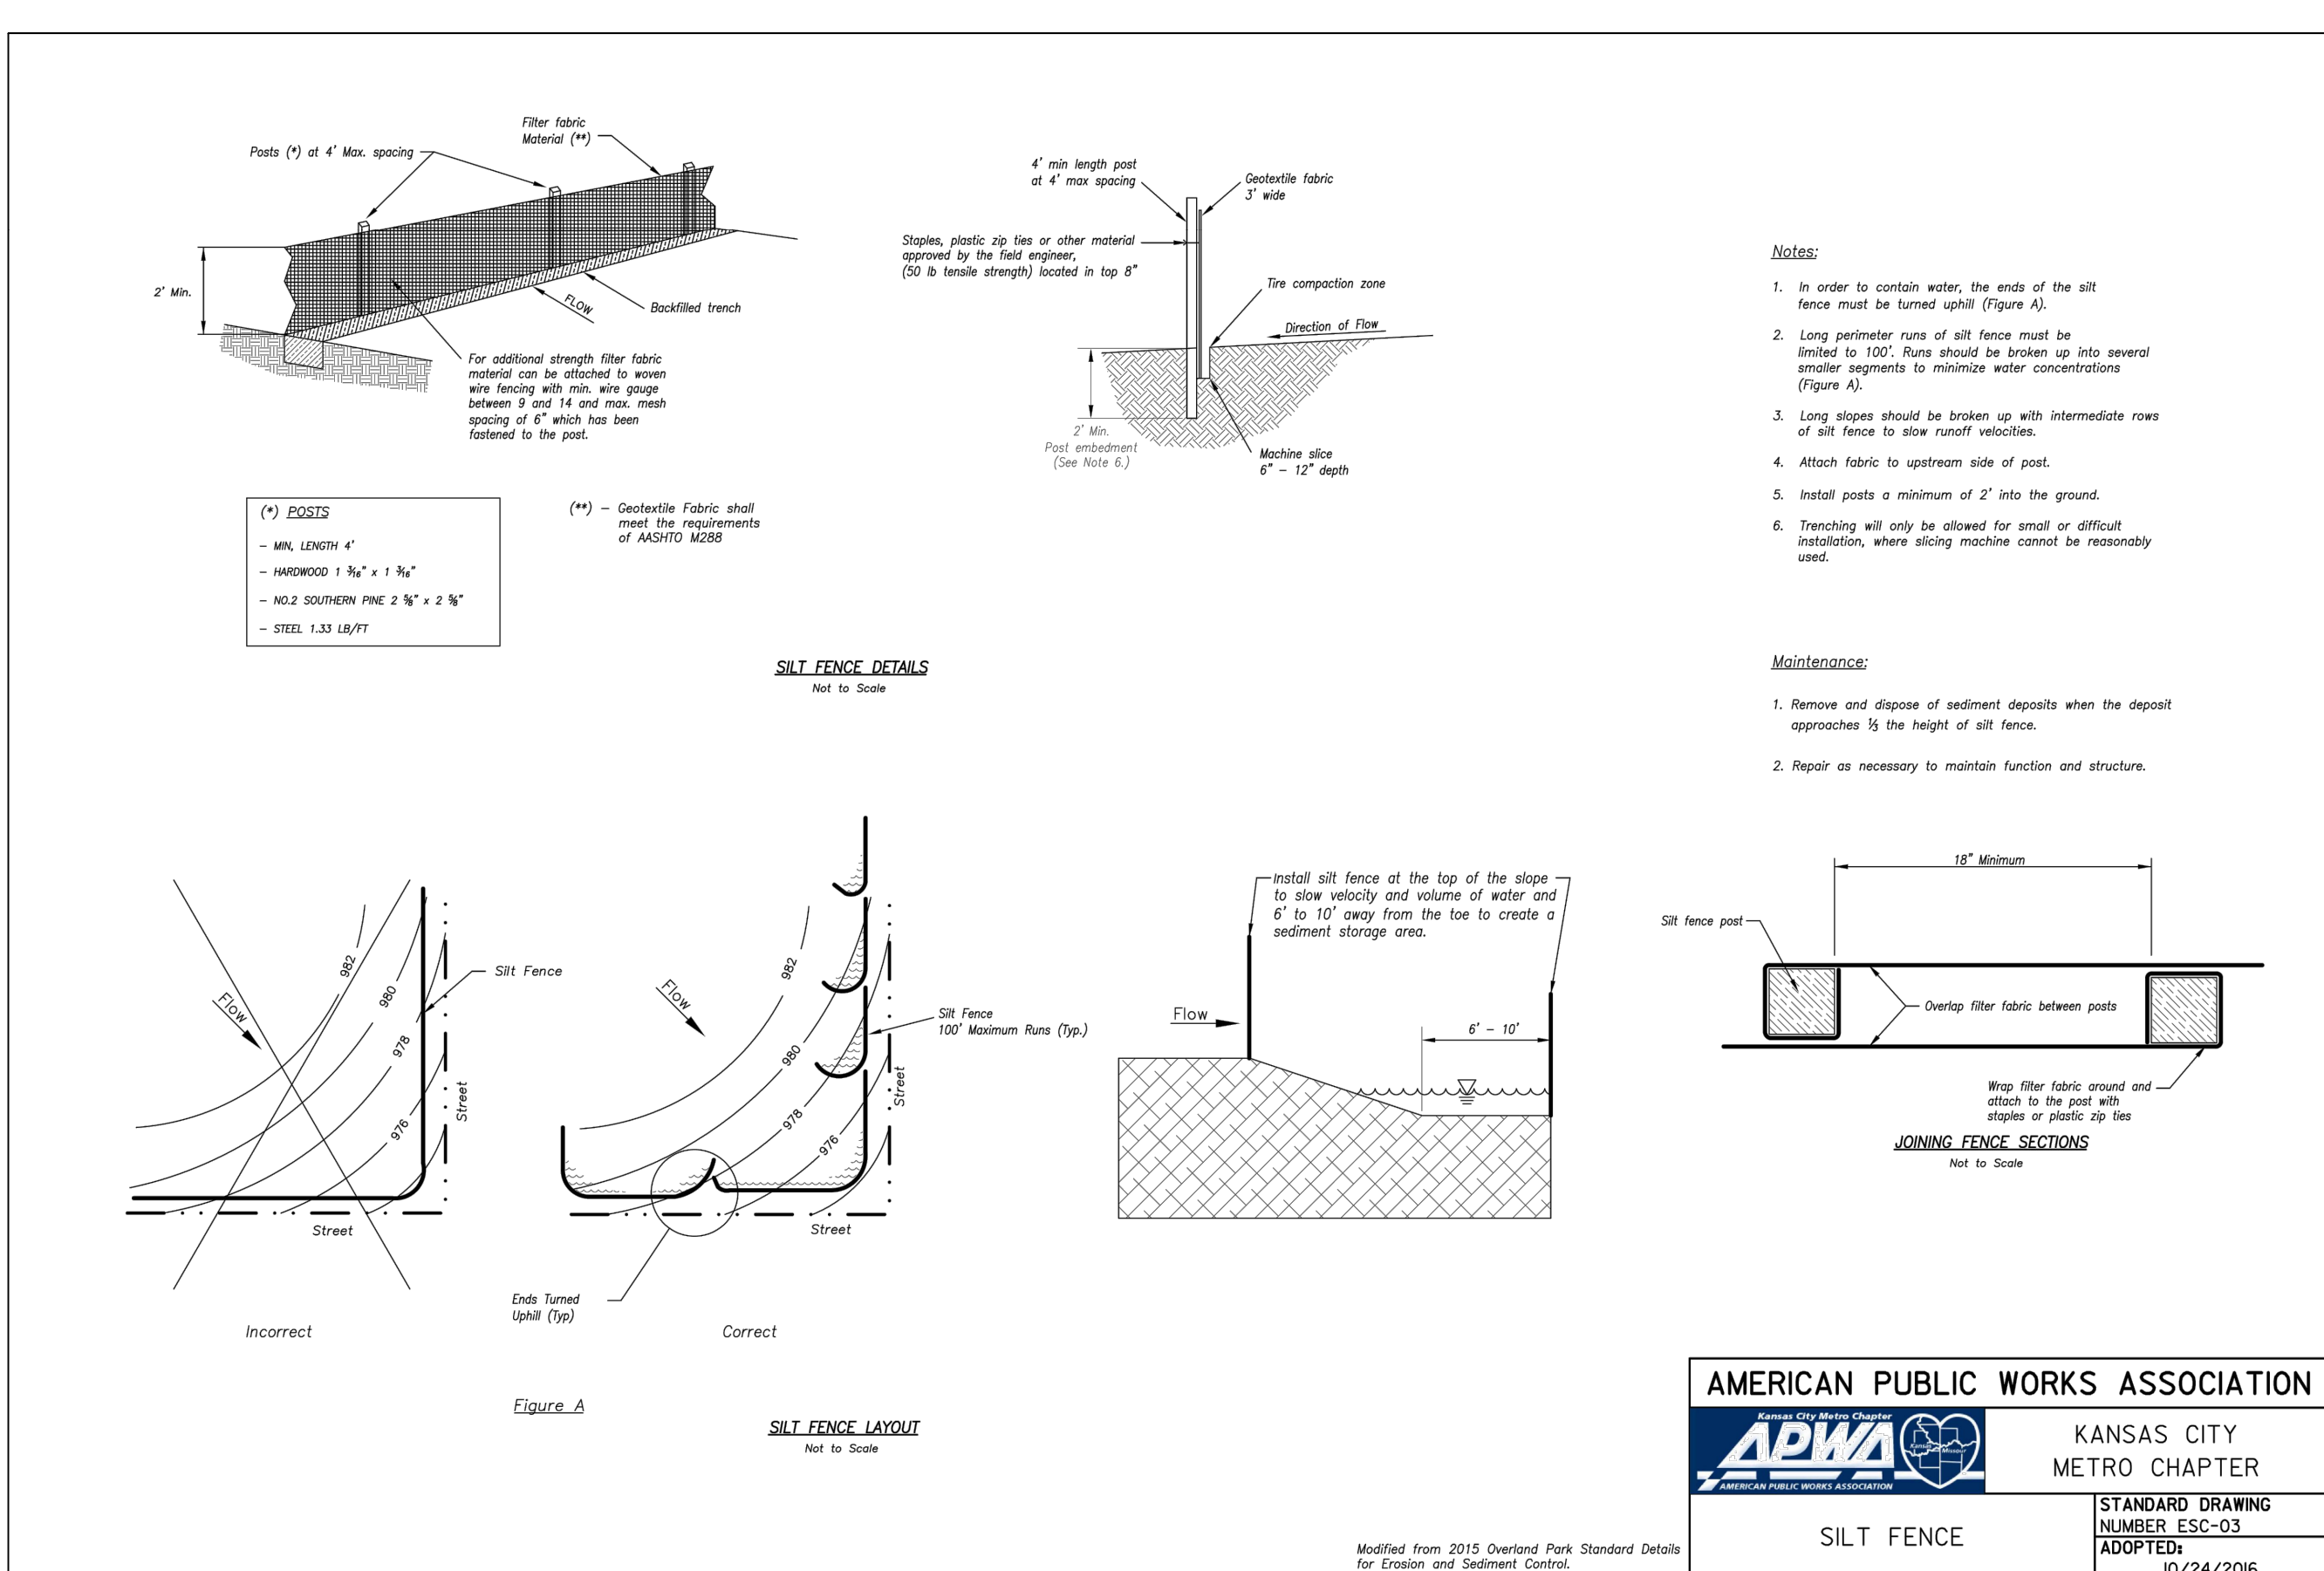


\\p01pc01\2021\120.0484.1\CD\DDSP - 120484 - Road Plan-2021.dwg PVAL SHEETVIEW DETAILS: 2023/03/13 1:11 PM ANSI FULL BLEED D 34.00 X 22.00 INCHES

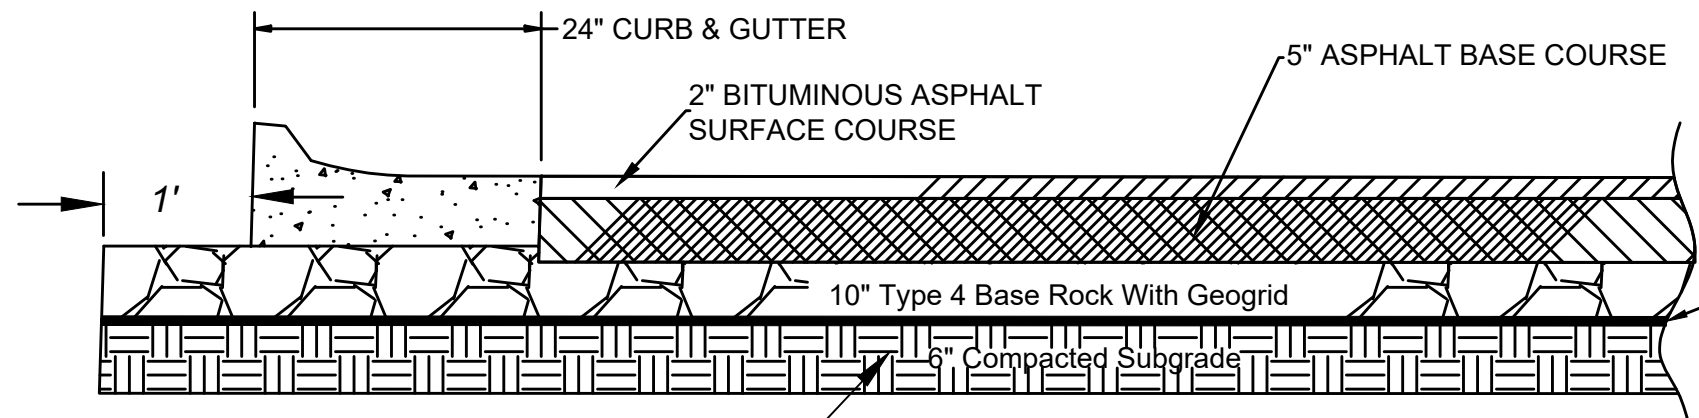


ASPHALT SECTION
NO SCALE

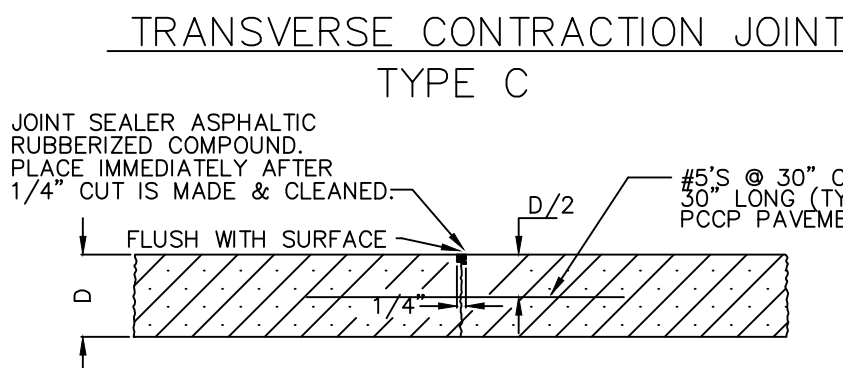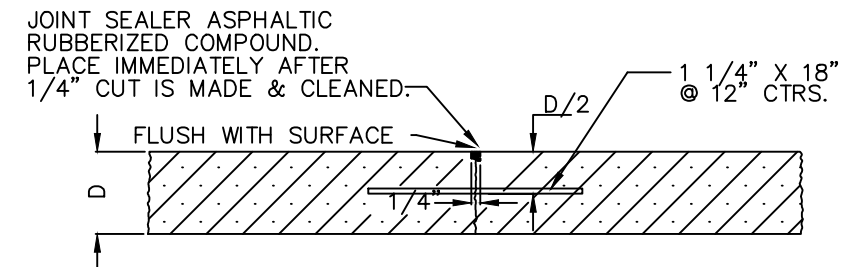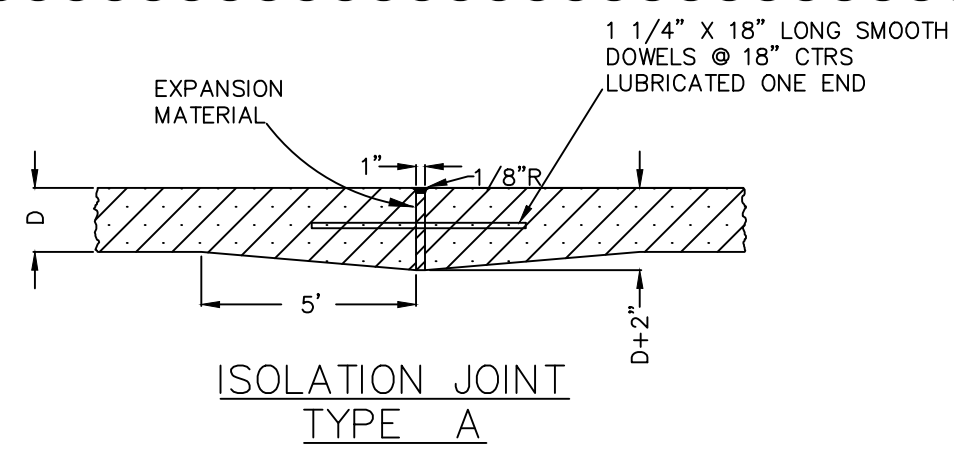



JOINT PAVING DETAILS
NOT TO SCALE

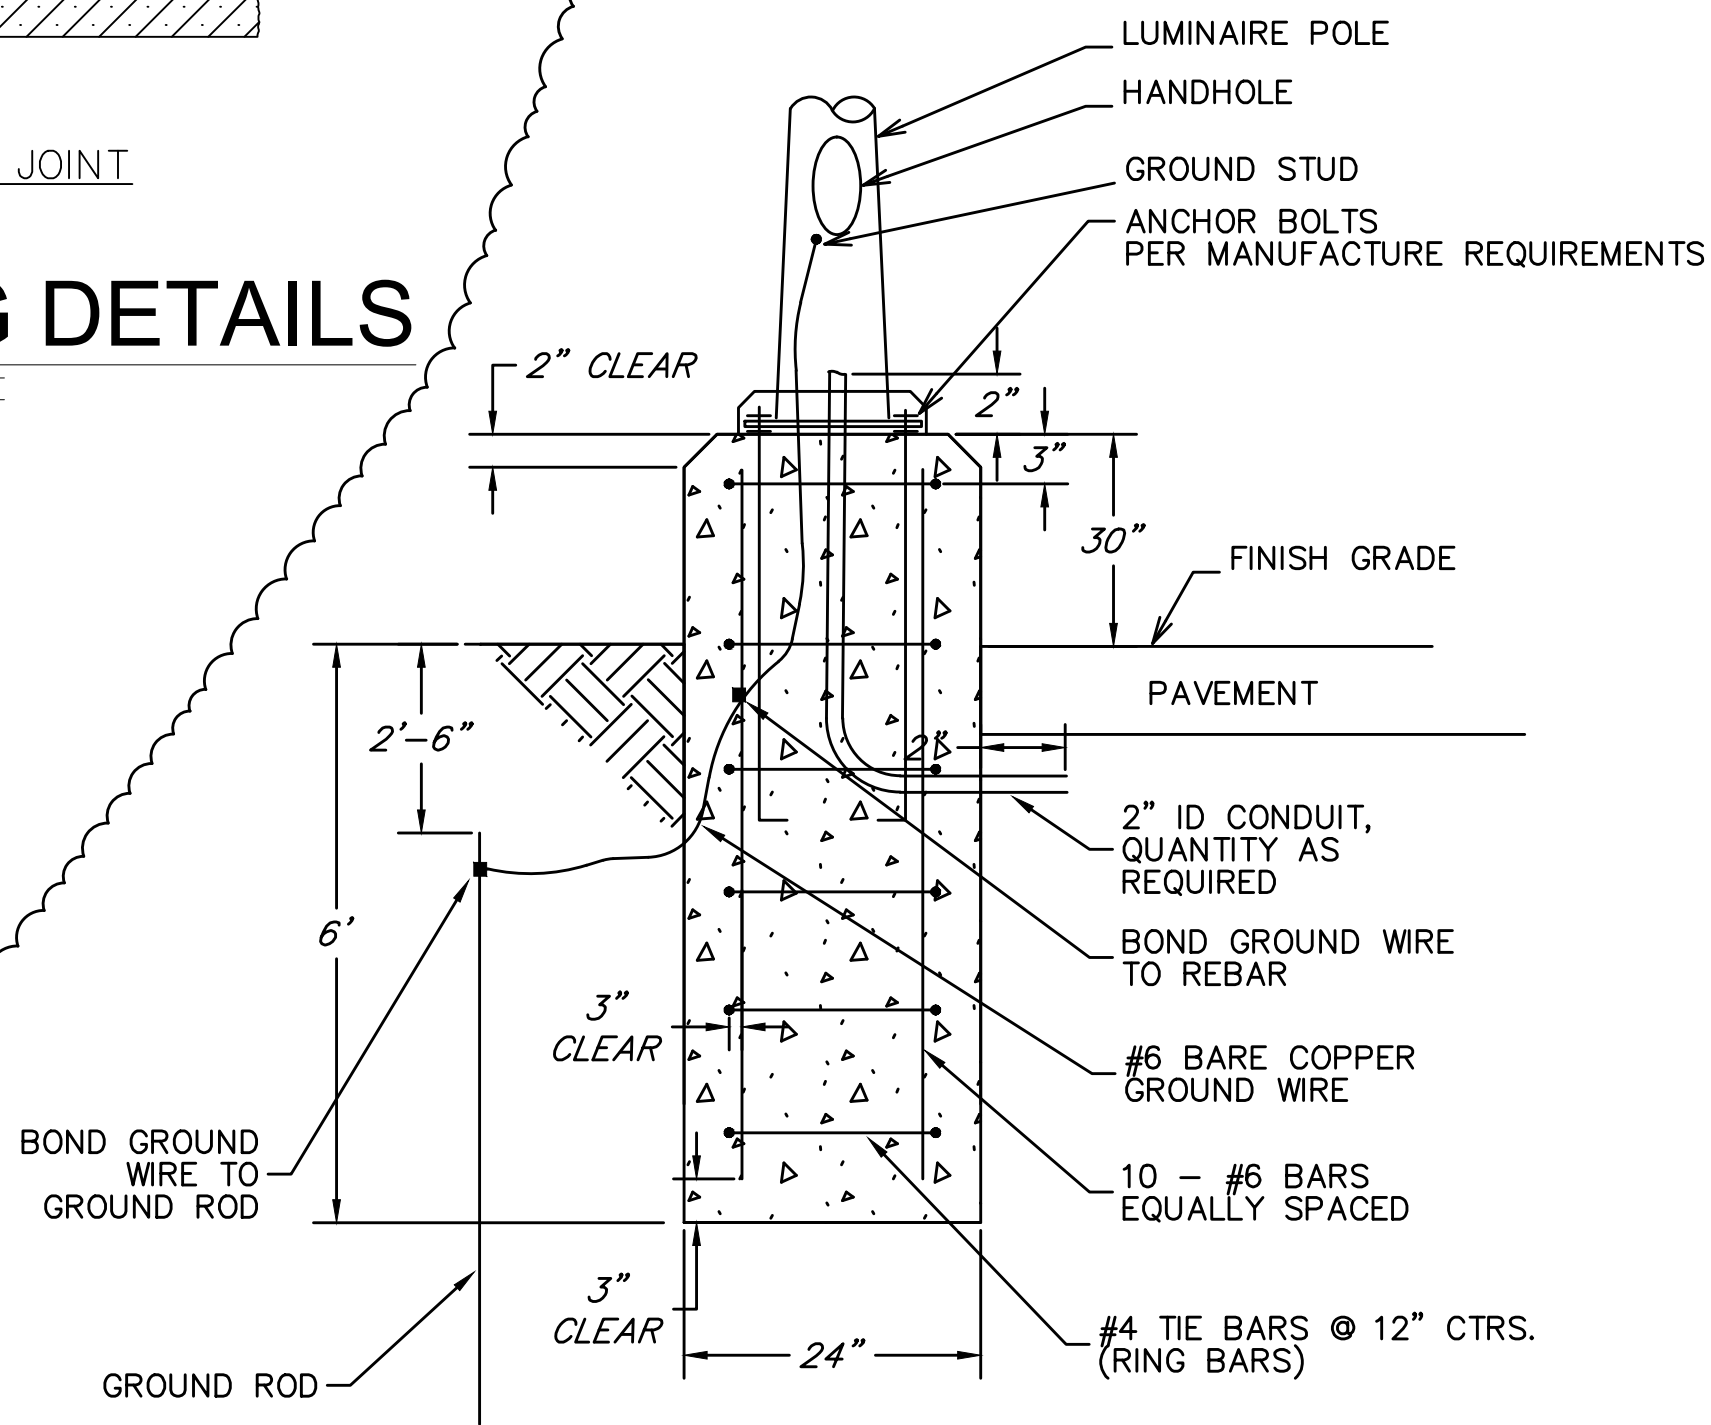

LIGHT POLE BASES

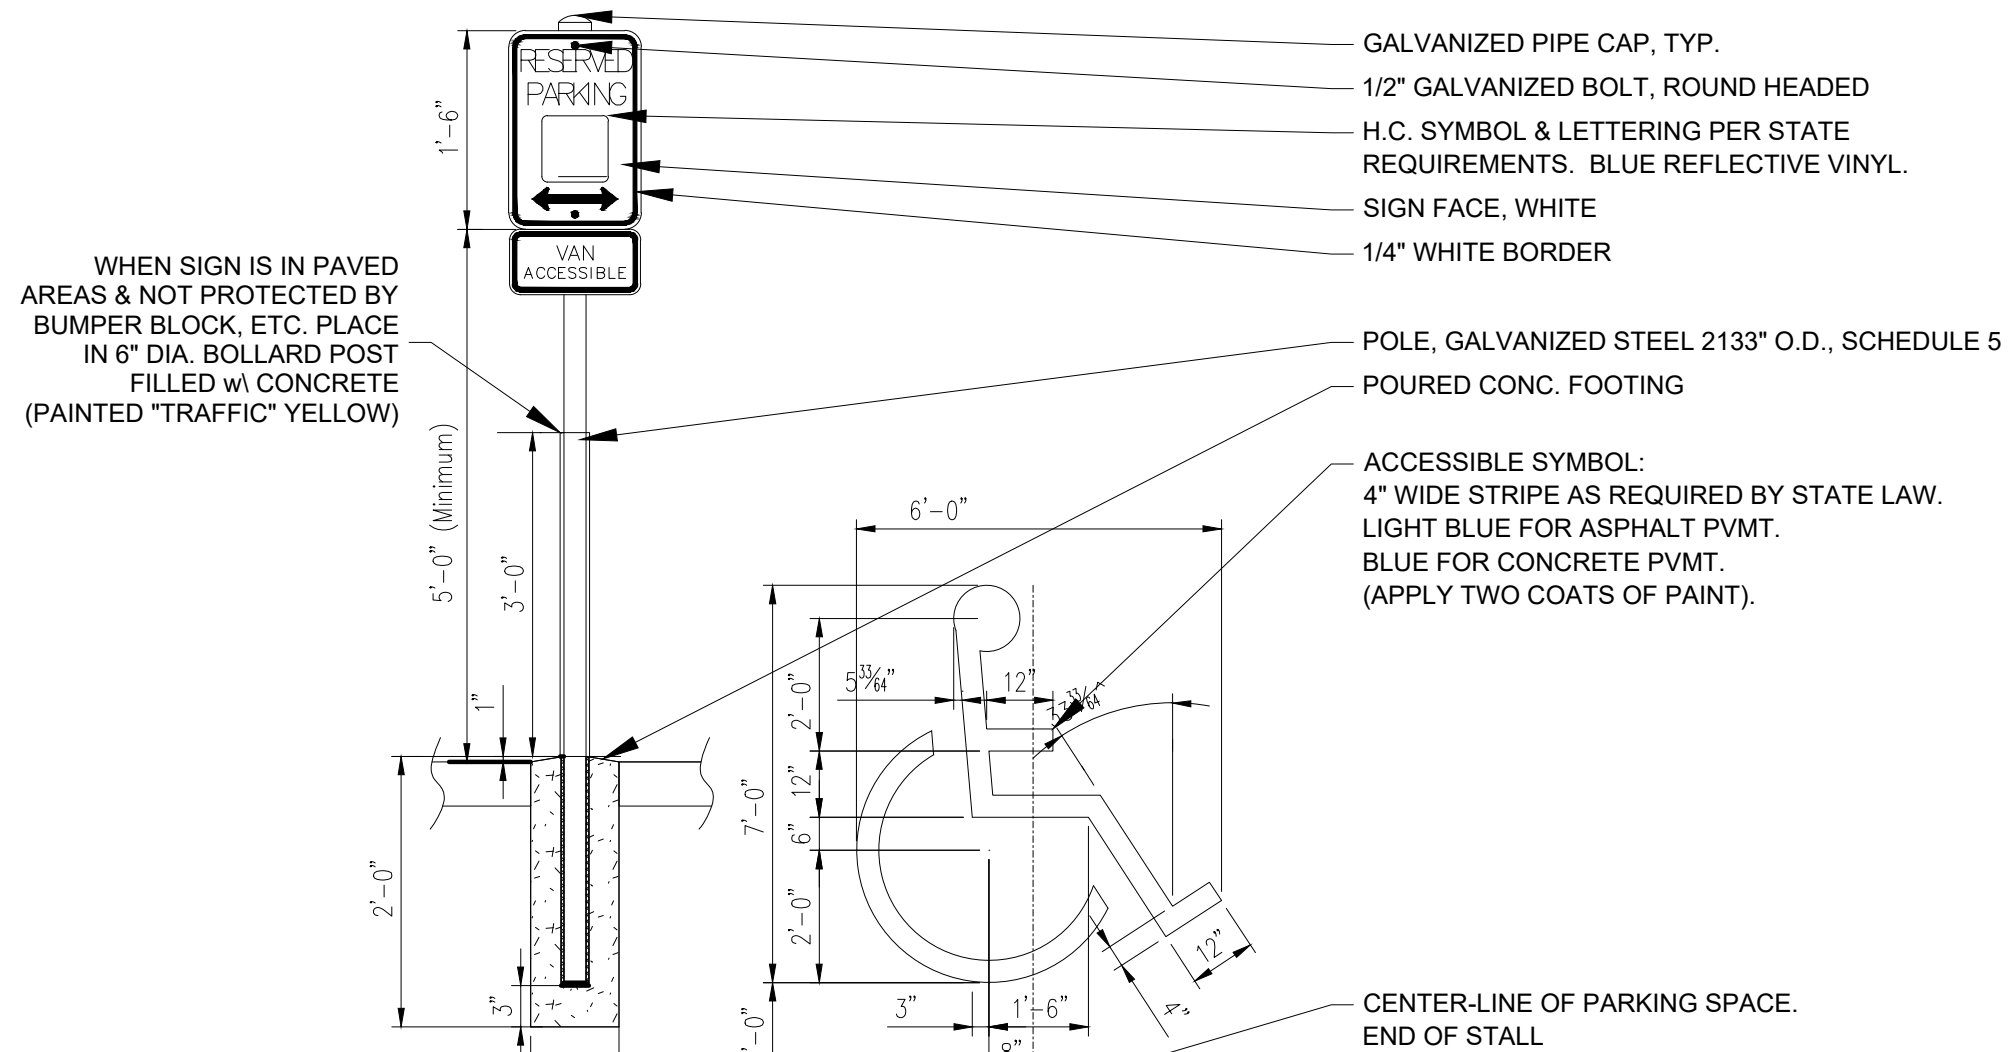

ACCESSIBLE SIGN & SYMBOL DETAILS
NO SCALE

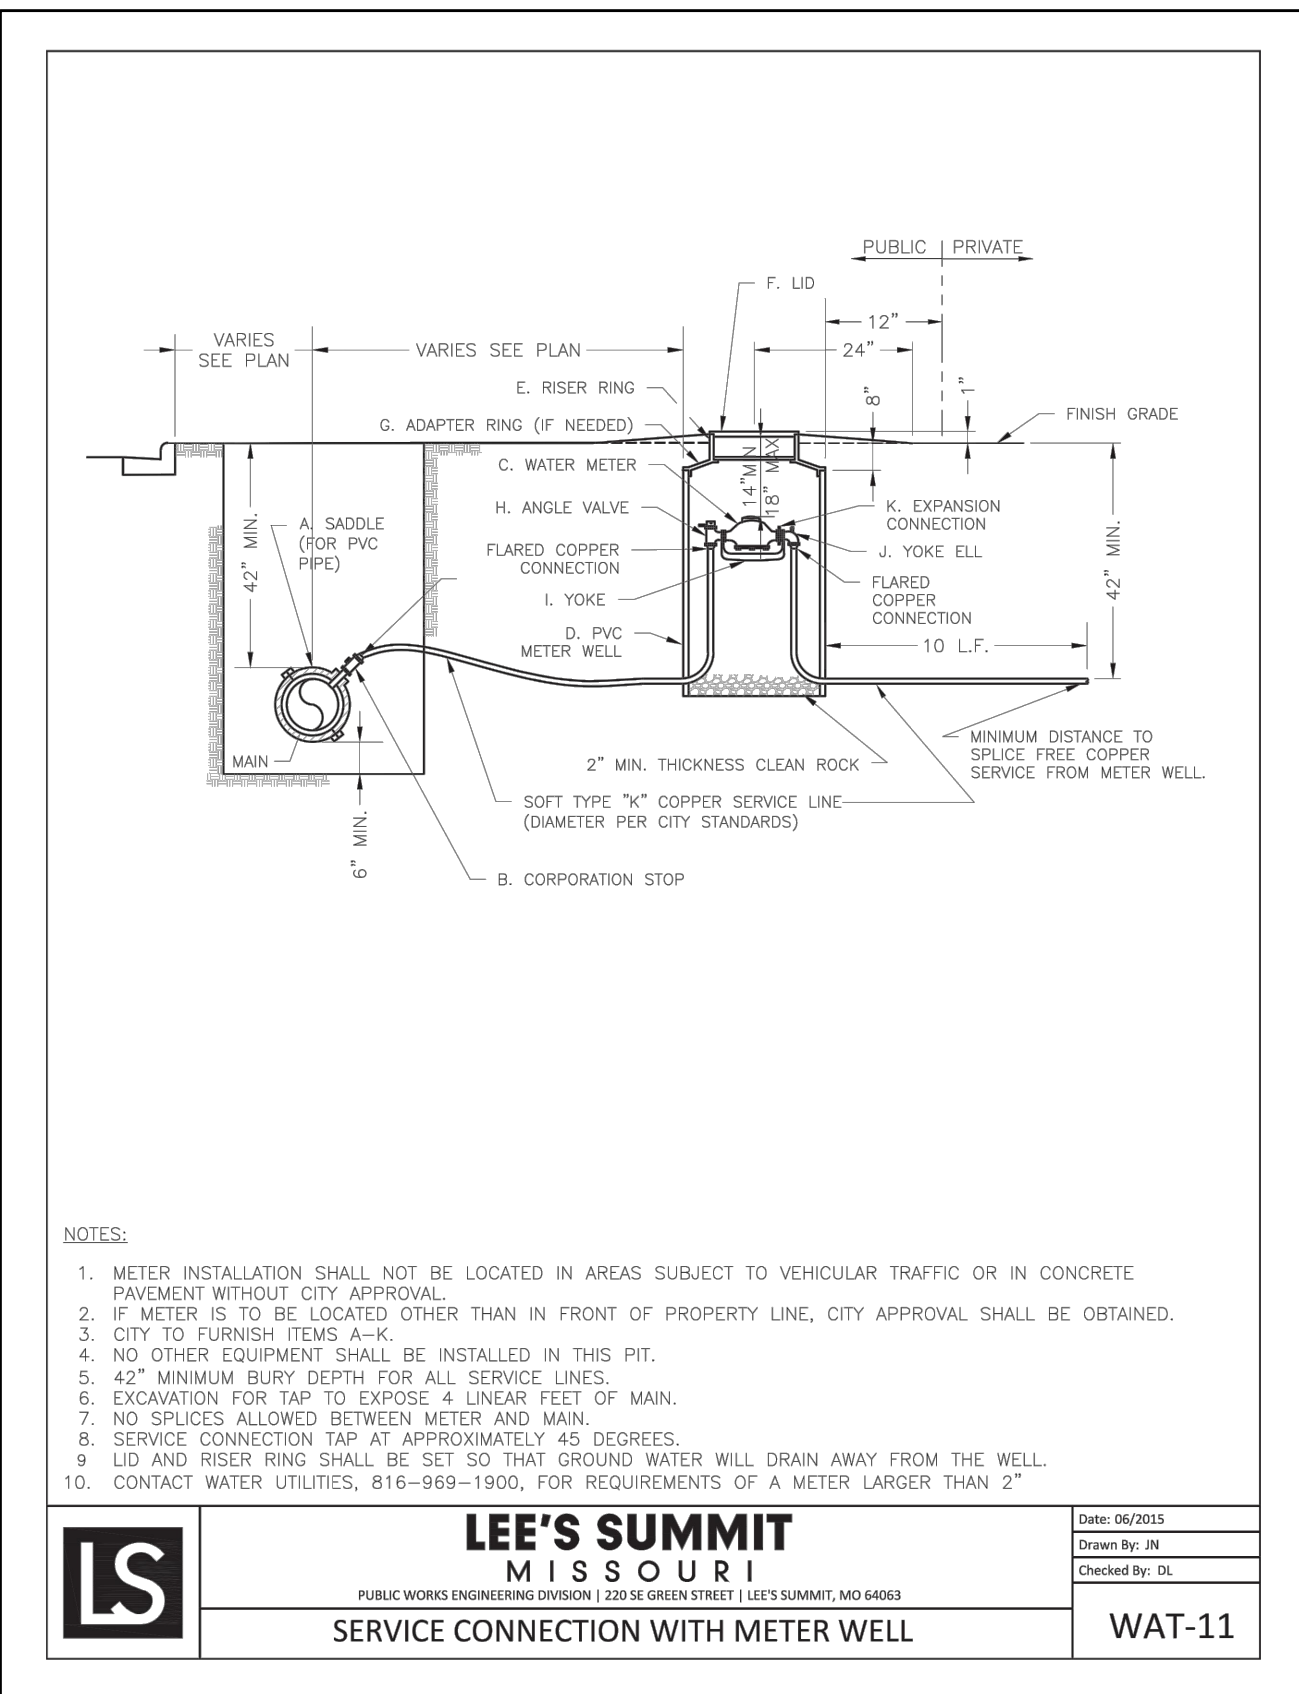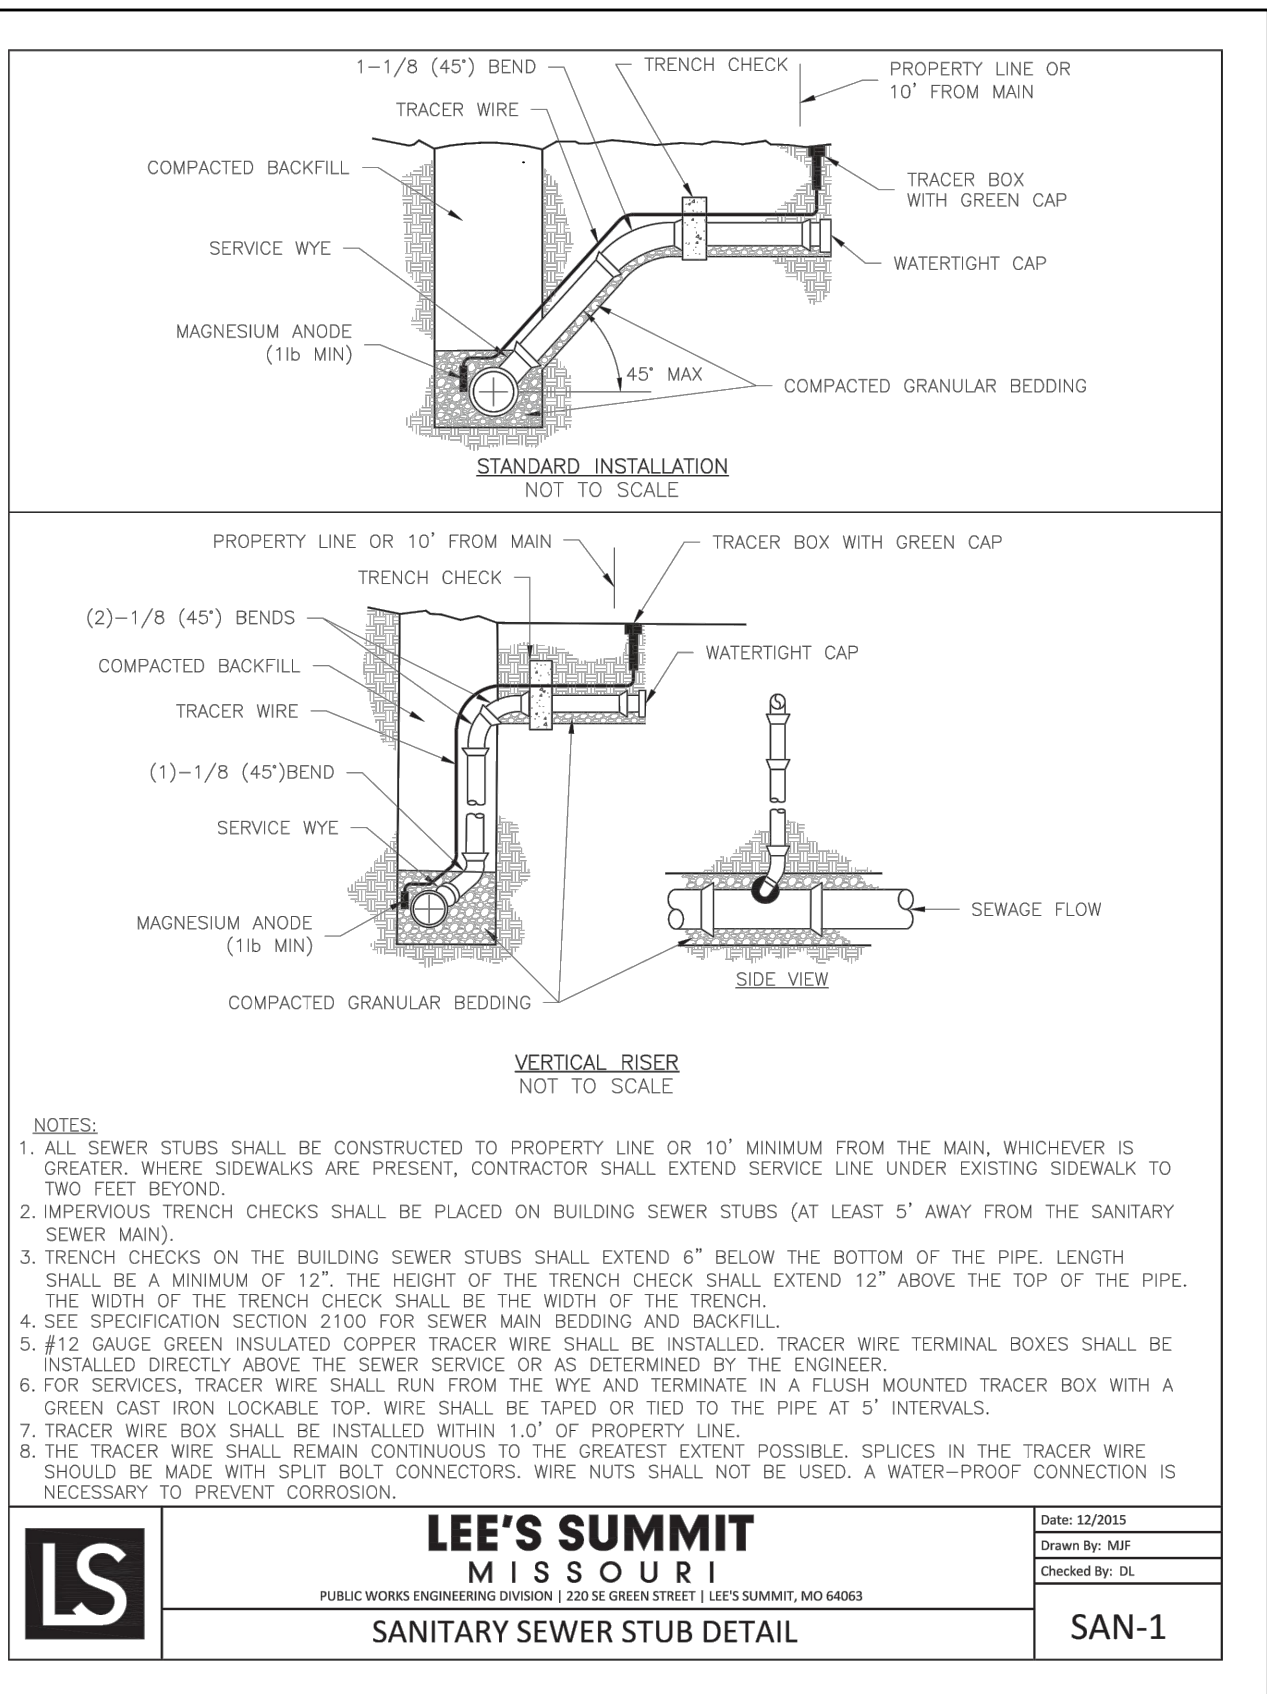

MARK	REVISION	DATE	BY
Engineer: SD	Checked By: SD	Scale: 1" = 20'	
Technician: JS	Date: 04-26-2022	T-R-S: 47N-32W-24	

Sheet C4.1

Snyder & Associates Engineers & Planners, Inc.
Missouri State Certificate of Authority #200608544



SHAWN DUKE - ENGINEER
MO PE#2013006489

LEE'S SUMMIT, MO
802 FRANCIS STREET
ST. JOSEPH, MISSOURI 64501
816-364-5222 | www.snyder-associates.com

WHISPERING WOODS AMENITY AREA

DETAILS


SNYDER & ASSOCIATES
ENGINEERS & PLANNERS, INC.



Project No: 120.0484.11

Sheet C4.1

\\p00004\2020\120.0484_120.0484_Plan_Plot-2020.dwg P:\A\SHREVEY LANDSCAPE PLAN 2020\0313_411 PM_ANSI FULL BLEED 0.00 X 22.00 INCHES

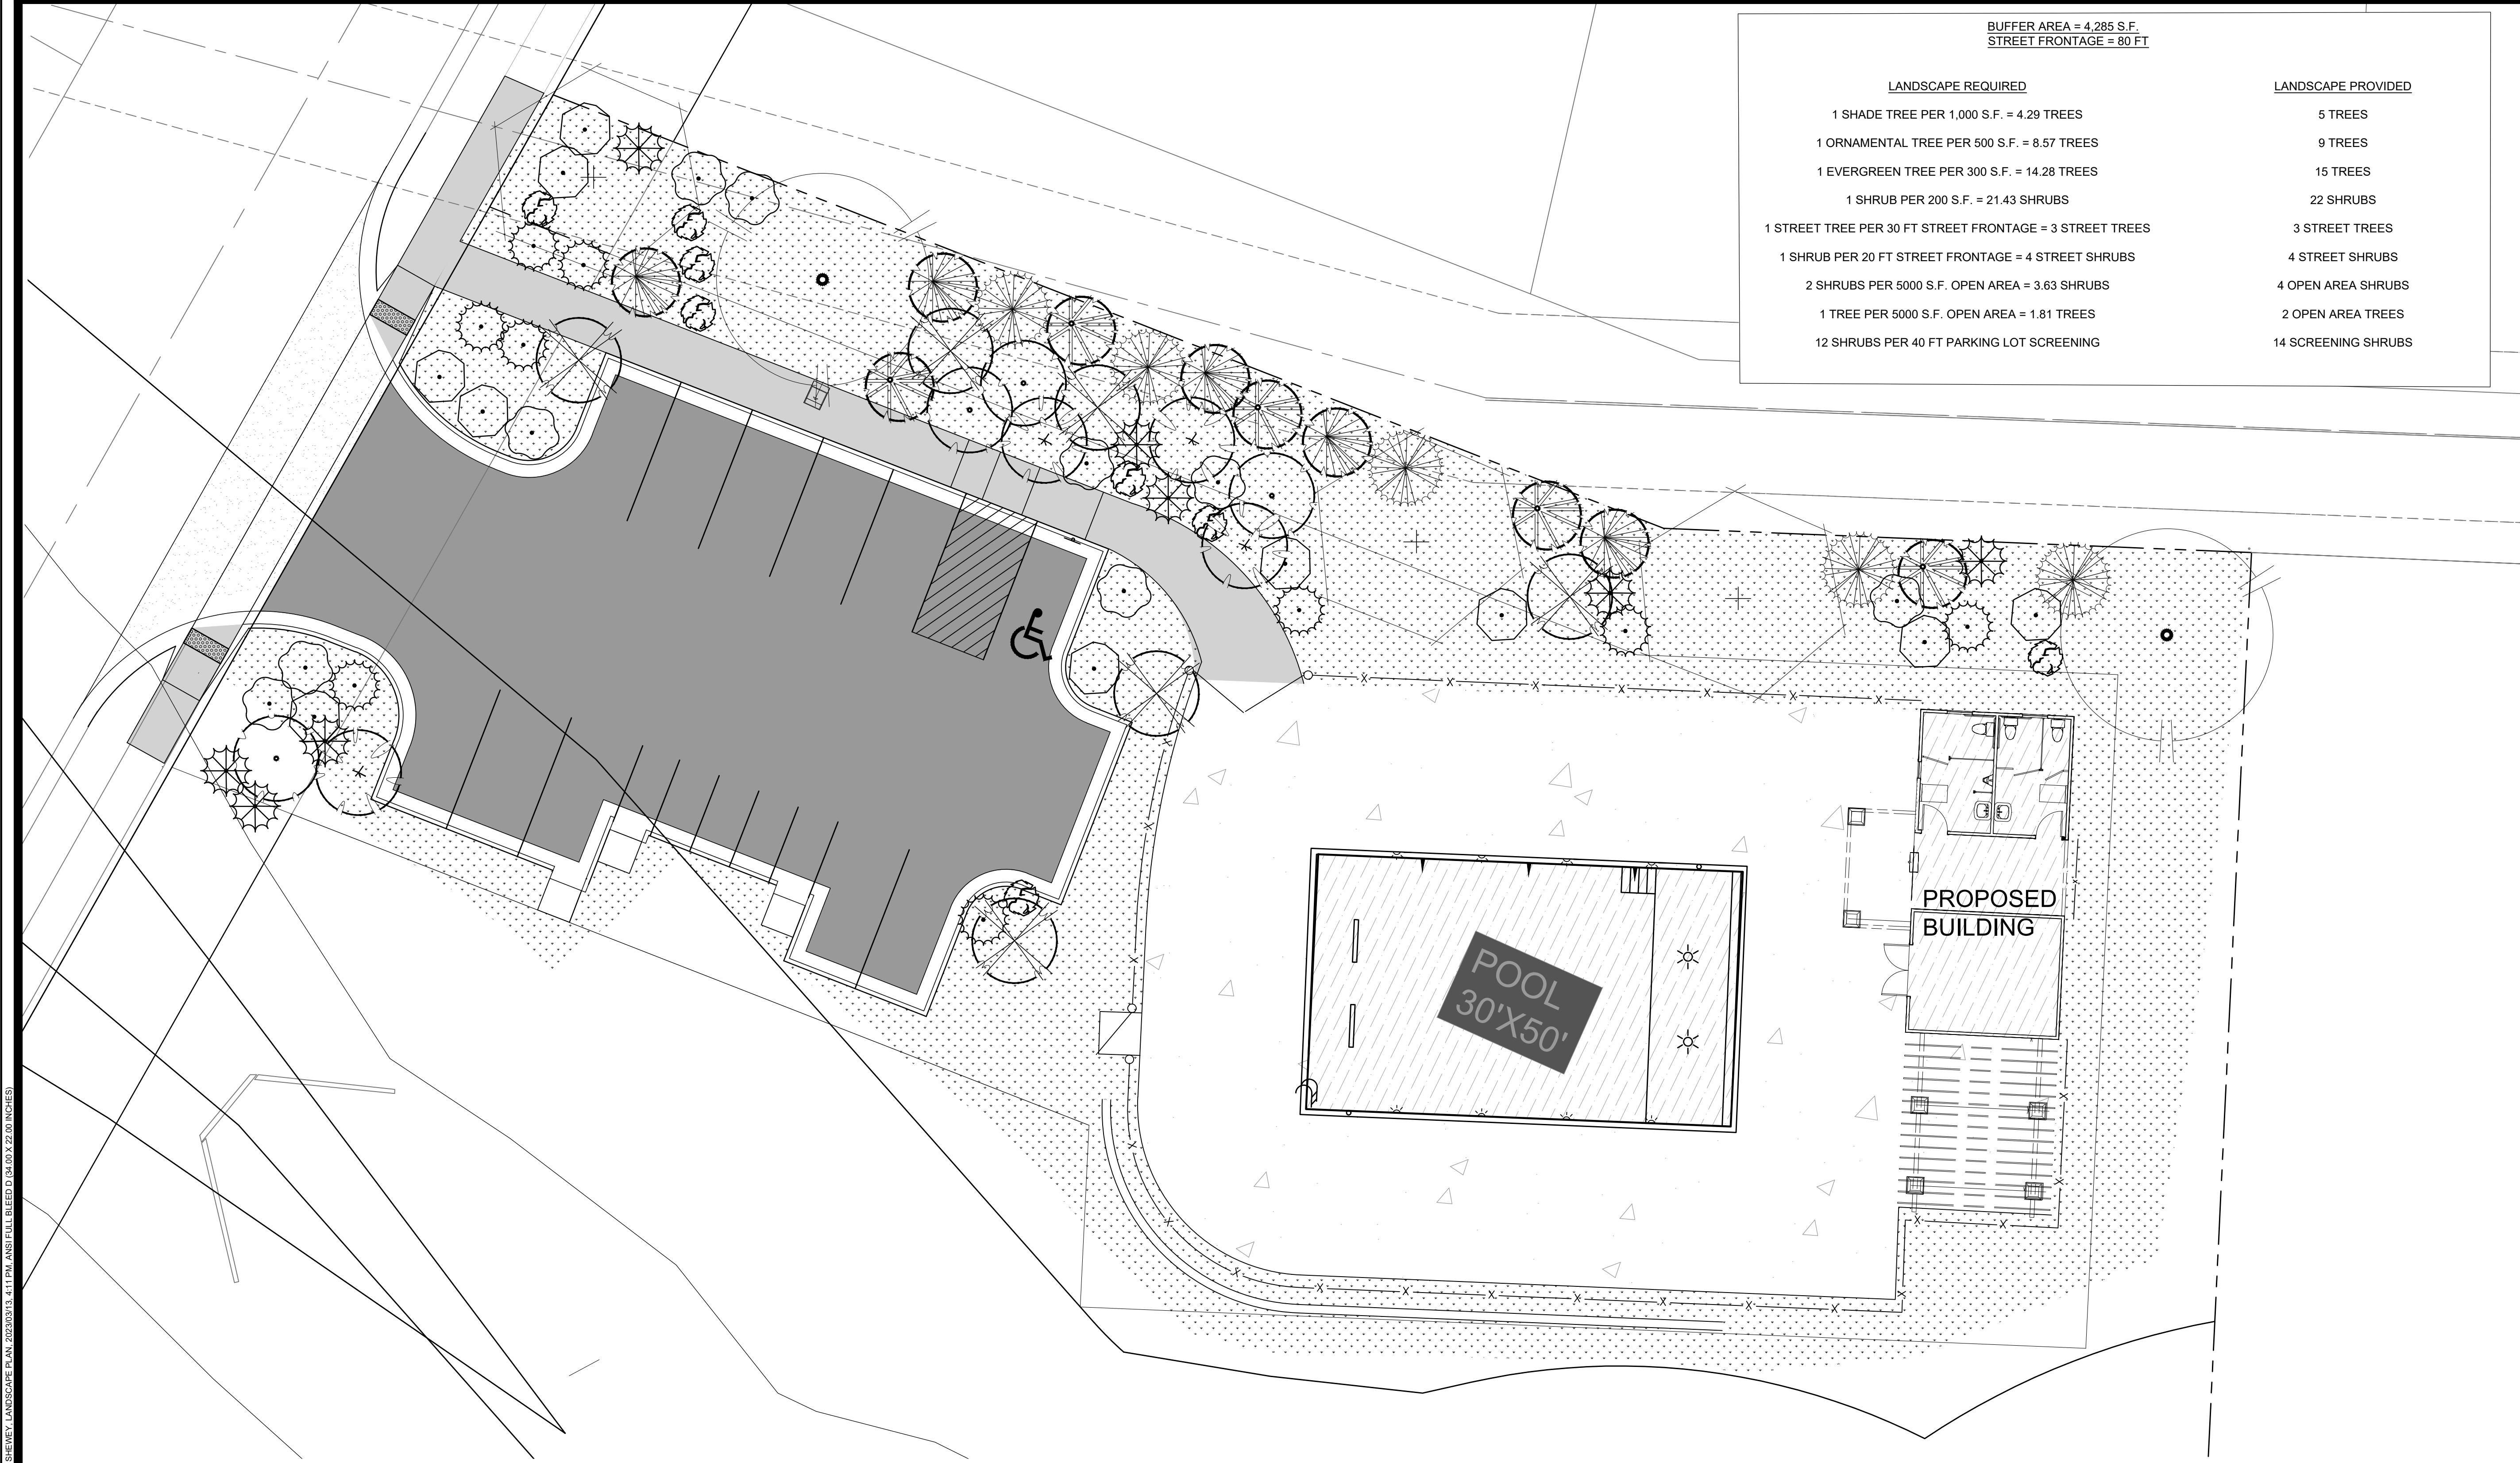

BUFFER AREA = 4,285 S.F.
STREET FRONTAGE = 80 FT

LANDSCAPE REQUIRED

- 1 SHADE TREE PER 1,000 S.F. = 4.29 TREES
- 1 ORNAMENTAL TREE PER 500 S.F. = 8.57 TREES
- 1 EVERGREEN TREE PER 300 S.F. = 14.28 TREES
- 1 SHRUB PER 200 S.F. = 21.43 SHRUBS
- 1 STREET TREE PER 30 FT STREET FRONTAGE = 3 STREET TREES
- 1 SHRUB PER 20 FT STREET FRONTAGE = 4 STREET SHRUBS
- 2 SHRUBS PER 5000 S.F. OPEN AREA = 3.63 SHRUBS
- 1 TREE PER 5000 S.F. OPEN AREA = 1.81 TREES
- 12 SHRUBS PER 40 FT PARKING LOT SCREENING

LANDSCAPE PROVIDED

- 5 TREES
- 9 TREES
- 15 TREES
- 22 SHRUBS
- 3 STREET TREES
- 4 STREET SHRUBS
- 4 OPEN AREA SHRUBS
- 2 OPEN AREA TREES
- 14 SCREENING SHRUBS

SHADE TREES			ORNAMENTAL TREES			EVERGREEN TREES			SHRUBS		
QUANTITY	SIZE		QUANTITY	SIZE		QUANTITY	HEIGHT		QUANTITY	SIZE	
3	3" CAL.	COMMON HACKBERRY	4	3" CAL.	FLOWERING DOGWOOD	5	8 FT	BALD CYPRUS	10	24" B&B	AMERICAN HAZELNUT
2	3" CAL.	SKYLINE HONEY LOCUST	4	3" CAL.	SERVICEBERRY	5	8 FT	EASTERN RED CEDAR	8	24" B&B	ARROWWOOD VIBURNUM
			6	3" CAL.	CRAB APPLE				9	24" B&B	FRAGRANT SUMAC
						5	8 FT	EASTERN WHITE PINE	9	24" B&B	MEADOW WILLOW
									8	24" B&B	NINEBARK

= AREA TO BE SODDED

0 10
FEET

Sheet L1.0

Shnyder & Associates Engineers & Planners, Inc.
Missouri State Certificate of Authority #2006008544

MARK: SD
Engineer: SD
Technician: JS

REVISION: SD
Checked By: SD
Date: 04-26-2022

DATE: 1" = 10'
T-R-S: 47N-32W-24

STATE OF MISSOURI
SHAWN DUKE
LICENSED PROFESSIONAL ENGINEER
MO #2013006489
3/13/23

SHAWN DUKE - ENGINEER
MO PE#2013006489

WHISPERING WOODS AMENITY AREA

LANDSCAPE PLAN

LEE'S SUMMIT, MO

SNYDER & ASSOCIATES
ENGINEERS & PLANNERS, INC.

Project No: 120.0484.11

Sheet L1.0

802 FRANCIS STREET
ST. JOSEPH, MISSOURI 64501
816-364-5222 | www.snyder-associates.com

STONE AND MASONRY VENEER SHALL BE INSTALLED IN ACCORDANCE WITH R103.7, TABLE R103.4 AND FIGURE R103.7. THESE VENEERS INSTALLED OVER A BACKING OF WOOD SHALL BE LIMITED TO THE FIRST STORY ABOVE-GRADE AND SHALL NOT EXCEED 5 INCHES IN THICKNESS. COMPLY WITH SECTION R602.12 FOR WALL BRACING REQUIREMENTS FOR MASONRY VENEER FOR WOOD FRAMED CONSTRUCTION.

R103.6.2 SIDING TO BE PORTLAND CEMENT PLASTER APPLIED TO METAL LATH, THREE COATS - 7/8 INCH THICKNESS ON A VAPOR-PERMEABLE, WATER-RESISTANT BUILDING PAPER OVER SHEATHING AND FRAMING.

INSTALLATION OF EXTERIOR PLASTER SHALL BE IN COMPLIANCE WITH ASTM C 926 AND ASTM C 1063 AND THE PROVISIONS OF R103.6.

R103.6.1 LATH. ALL LATH AND LATH ATTACHMENTS SHALL BE OF CORROSION-RESISTANT MATERIALS. EXPANDED METAL OR WOVEN WIRE LATH SHALL BE ATTACHED WITH 7/8" 16 GA. STAPLES SPACED 6" APART.

R103.2 WEATHER-RESISTANT SHEATHING PAPER. ASPHALT SATURATED FELT FREE FROM HOLES AND BREAKS, HEIGHING NOT LESS THAN 14 POUNDS PER 100 SQUARE FEET AND COMPLYING WITH ASTM D 226 OR OTHER APPROVED WEATHER-RESISTANT MATERIAL SHALL BE APPLIED OVER STUDS OR SHEATHING OF ALL EXTERIOR WALLS AS REQUIRED BY TABLE R103.4. SUCH FELT OR MATERIAL SHALL BE APPLIED HORIZONTALLY, WITH THE UPPER LAYER LAPPED OVER THE LOWER LAYER NOT LESS THAN 2 INCHES. WHERE JOINTS OCCUR, FELT SHALL BE LAPPED NOT LESS THAN 6 INCHES.

R103.3.1 WOOD SIDING. JOINTS IN WOOD, WOOD STRUCTURAL PANEL SIDING SHALL BE MADE AS FOLLOWS UNLESS OTHERWISE APPROVED. VERTICAL JOINTS IN PANEL SIDING SHALL OCCUR OVER FRAMING MEMBERS, UNLESS WOOD OR WOOD STRUCTURAL PANEL SHEATHING IS USED, AND SHALL BE SHIPLAPPED OR COVERED WITH A BATTEN. HORIZONTAL JOINTS IN PANEL SIDING SHALL BE LAPPED A MINIMUM OF 1 INCH OR SHALL BE SHIPLAPPED OR SHALL BE FLASHED WITH Z-FLASHING AND OCCUR OVER SOLID BLOCKING, WOOD OR WOOD STRUCTURAL PANEL SHEATHING.

FIBER-CEMENT PANELS SHALL COMPLY WITH THE REQUIREMENTS OF ASTM C1106, TYPE A, MINIMUM GRADE II. PANELS SHALL BE INSTALLED WITH THE LONG DIMENSION EITHER PARALLEL OR PERPENDICULAR TO FRAMING. VERTICAL AND HORIZONTAL JOINTS SHALL OCCUR OVER FRAMING MEMBERS AND SHALL BE SEALED WITH CAULKING, COVERED WITH BATTENS OR SHALL BE DESIGNED TO COMPLY WITH SECTION R103.1. PANEL SIDING SHALL BE INSTALLED WITH FASTENERS ACCORDING TO TABLE R103.4 OR APPROVED MANUFACTURER'S INSTALLATION INSTRUCTIONS.

SIDING, STUCCO AND STONE ON ALL SIDES TO BE EARTHTONES COLORS.

LAMINATED COMPOSITION ROOF (SEE ELEVATIONS) (INSTALL PER MANUF.'S SPECIFICATION)

RAFTER BEARING PLATE (SEE ELEVATIONS)

2X6 SUB-FASCIA

1X8 FASCIA

AL. GUTTER 4 DN. SPOUT

PLY-BEAD BD. SMARTSIDE PANEL OR FIBER-CEMENT SOFFIT

PROVIDE 5/4 FRIEZE BD. UNDER SOFFIT

SOFFITS SHALL COMPLY W/ SECTION R103.3.1 OR MANUFACTURER'S INSTALLATION INSTRUCTIONS

EAVE SECTION 8:12 PITCH SCALE: 3/4" = 1'-0"

(15PSC) TABLE 608.1 OCCUPANT LOAD				
ROOM	NET AREA	AREA/OCCUPANT	OCCUPANCY	
POOL - WADING AREA	300 SQ. FT.	8 SQ. FT. / PERSON	37	
POOL - DEEP AREA	1,200 SQ. FT.	10 SQ. FT. / PERSON	120	
DECK AREA	4,645 SQ. FT.	15 SQ. FT. / PERSON	313	
TOTAL OCCUPANCY			470	
MALE			235	
FEMALE			235	
609.2 NUMBER OF FIXTURES (609.2.1 WATER AREA LESS THAN 7,500 SQ. FT.)				
OCCUPANT	FIXTURES	SECTION 609.2.1	REQUIRED	PROVIDED
MALE	URINAL	1	1 - REQUIRED	1
MALE	WATER CLOSETS	1	1 - REQUIRED	1
FEMALE	WATER CLOSETS	2	2 - REQUIRED	2
MALE	LAVATORIES	1	1 - REQUIRED	1
FEMALE	LAVATORIES	1	1 - REQUIRED	1
MALE	DECK SHOWER	1	1 - REQUIRED	1
FEMALE	DECK SHOWER	1	1 - REQUIRED	1
(IPC) TABLE 403.1 MINIMUM NUMBER OF REQUIRED PLUMBING FIXTURES				
DRINKING FOUNTAIN		1 PER 1,000	1 - REQUIRED	1
SERVICE SINK			1 - REQUIRED	1

REFERENCE:
(IPC) TABLE 403.1 MINIMUM NUMBER OF REQUIRED PLUMBING FIXTURES
(15PSC) TABLE 608.1 OCCUPANT LOAD
(15PSC) SECTION 609.2.1

WHISPERING WOODS POOL
1901 SW RIVER RUN DR, LEES SUMMIT, MO 64082

LEGAL DESCRIPTION:
TRACT C OF WHISPERING WOODS, 1ST PLAT

CODE REFERENCE:
2018 INTERNATIONAL BUILDING CODES
2018 INTERNATIONAL FIRE CODE
2018 INTERNATIONAL PLUMBING CODE
2018 INTERNATIONAL ENERGY CONSERVATION CODE
2018 INTERNATIONAL MECHANICAL CODE
2018 INTERNATIONAL FUEL GAS CODE
2017 NATIONAL ELECTRIC CODE NFPA 70
2018 INTERNATIONAL SWIMMING POOL AND SPA CODE
2004 ACCESSIBLE AND USABLE BUILDINGS AND FACILITIES ICC/ANSI A117.1

CONSTRUCTION TYPE:
V-B
NON-SPRINKLERED BUILDING


OCCUPANCY TYPE: ASSEMBLY A-5; PARTICIPATION IN OUTDOOR ACTIVITIES

OCCUPANCY LOAD: (15PSC) TABLE 608.1 OCCUPANT LOAD
TOTAL: 470 USERS
POOL DECK - (313 USERS) 4,645 SQ. FT. / 15 S.F. PER USER
POOL WADING AREA - (57 USERS) 300 SQ. FT. / 8 S.F. PER USER
POOL DEEP AREA - (120 USERS) 1,200 SQ. FT. / 10 S.F. PER USER

ZONING:
R-1 SINGLE FAMILY RESIDENTIAL


PARKING SPACES:
TABLE 8-1 (UNIFIED DEVELOPMENT ORDINANCE OF THE CITY OF LEE'S SUMMIT, MISSOURI)
1 FOR EVERY 16 LOTS IN SUBDIVISION OR MINIMUM OF 6 PARKINGS
TOTAL PROVIDED: 11 PARKINGS
10 - STANDARD PARKING PROVIDED
1 - VAN ACCESSIBLE PARKING PROVIDED
5 - DESIGNATED GOLF CART PARKING

ROOF SNOW LOAD: 20 POUNDS PER SQUARE FOOT
WIND SPEED: 115 MILES PER HOUR
TOPOGRAPHIC EFFECTS: NO
SEISMIC DESIGN CATEGORY: A
WEATHERING: SEVERE
FROST LINE DEPTH: 36 INCHES
TERMITE: MODERATE TO HEAVY
DECAY: SLIGHT TO MODERATE
WINTER DESIGN TEMPERATURE: SIX DEGREES FAHRENHEIT
ICE BARRIER UNDERLAYMENT REQUIRED: YES
FLOOD HAZARDS: LATEST ADOPTED FIRM AND FBFM DOCUMENTS.
AIR FREEZING INDEX: 1,000
MEAN ANNUAL TEMPERATURE: 54.7 DEGREES FAHRENHEIT

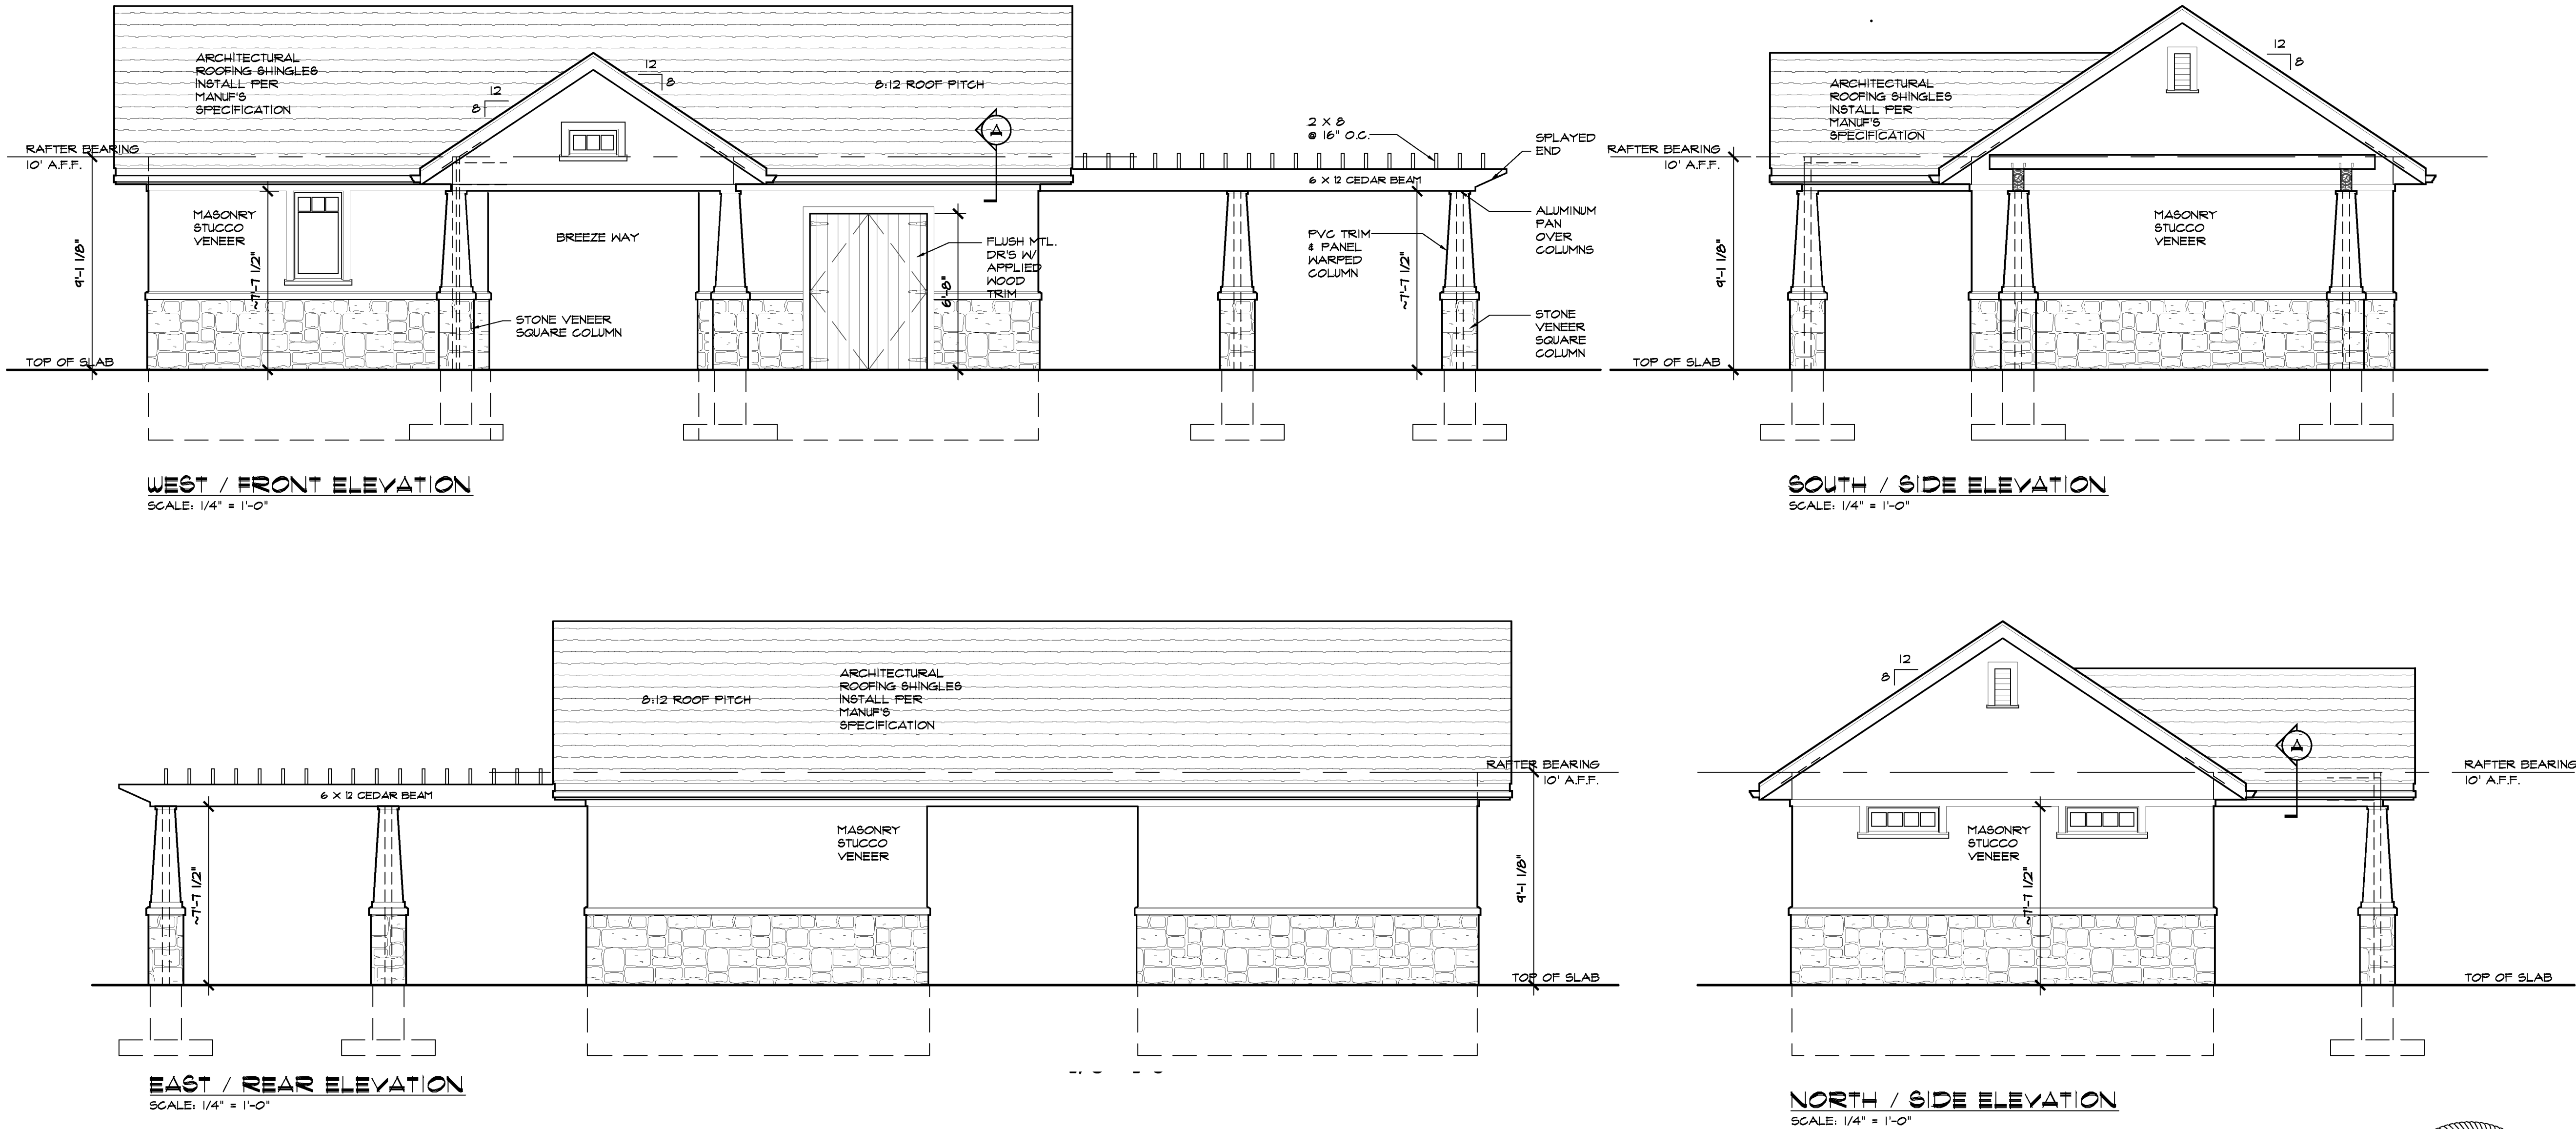

Review and Approval
Structural Only

David Mezger Engineering LLC
212 NE Circle Dr.
Kansas City, MO 64116

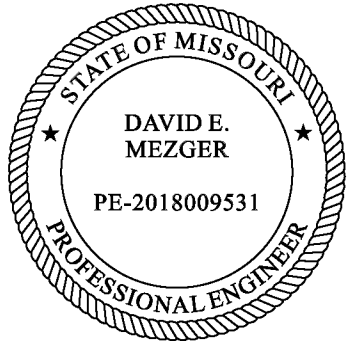

Digitally signed by David Eugene Mezger
DN: cn=US, E=dmezger@gmail.com,
O=David Mezger Engineering LLC,
cn=David Eugene Mezger
Date: 2022.05.28
13:07:00-05'00

BUILD IN ACCORDANCE WITH
2018 INTERNATIONAL
BUILDING CODE AND LOCAL
CODES.

POOL HOUSE
1901 SW RIVER RUN DR
LEE SUMMIT MO

SCALE
1/4" = 1'-0"


DATE
5-27-22

PLAN NO.

3781


SHEET NO.

1 OF 5

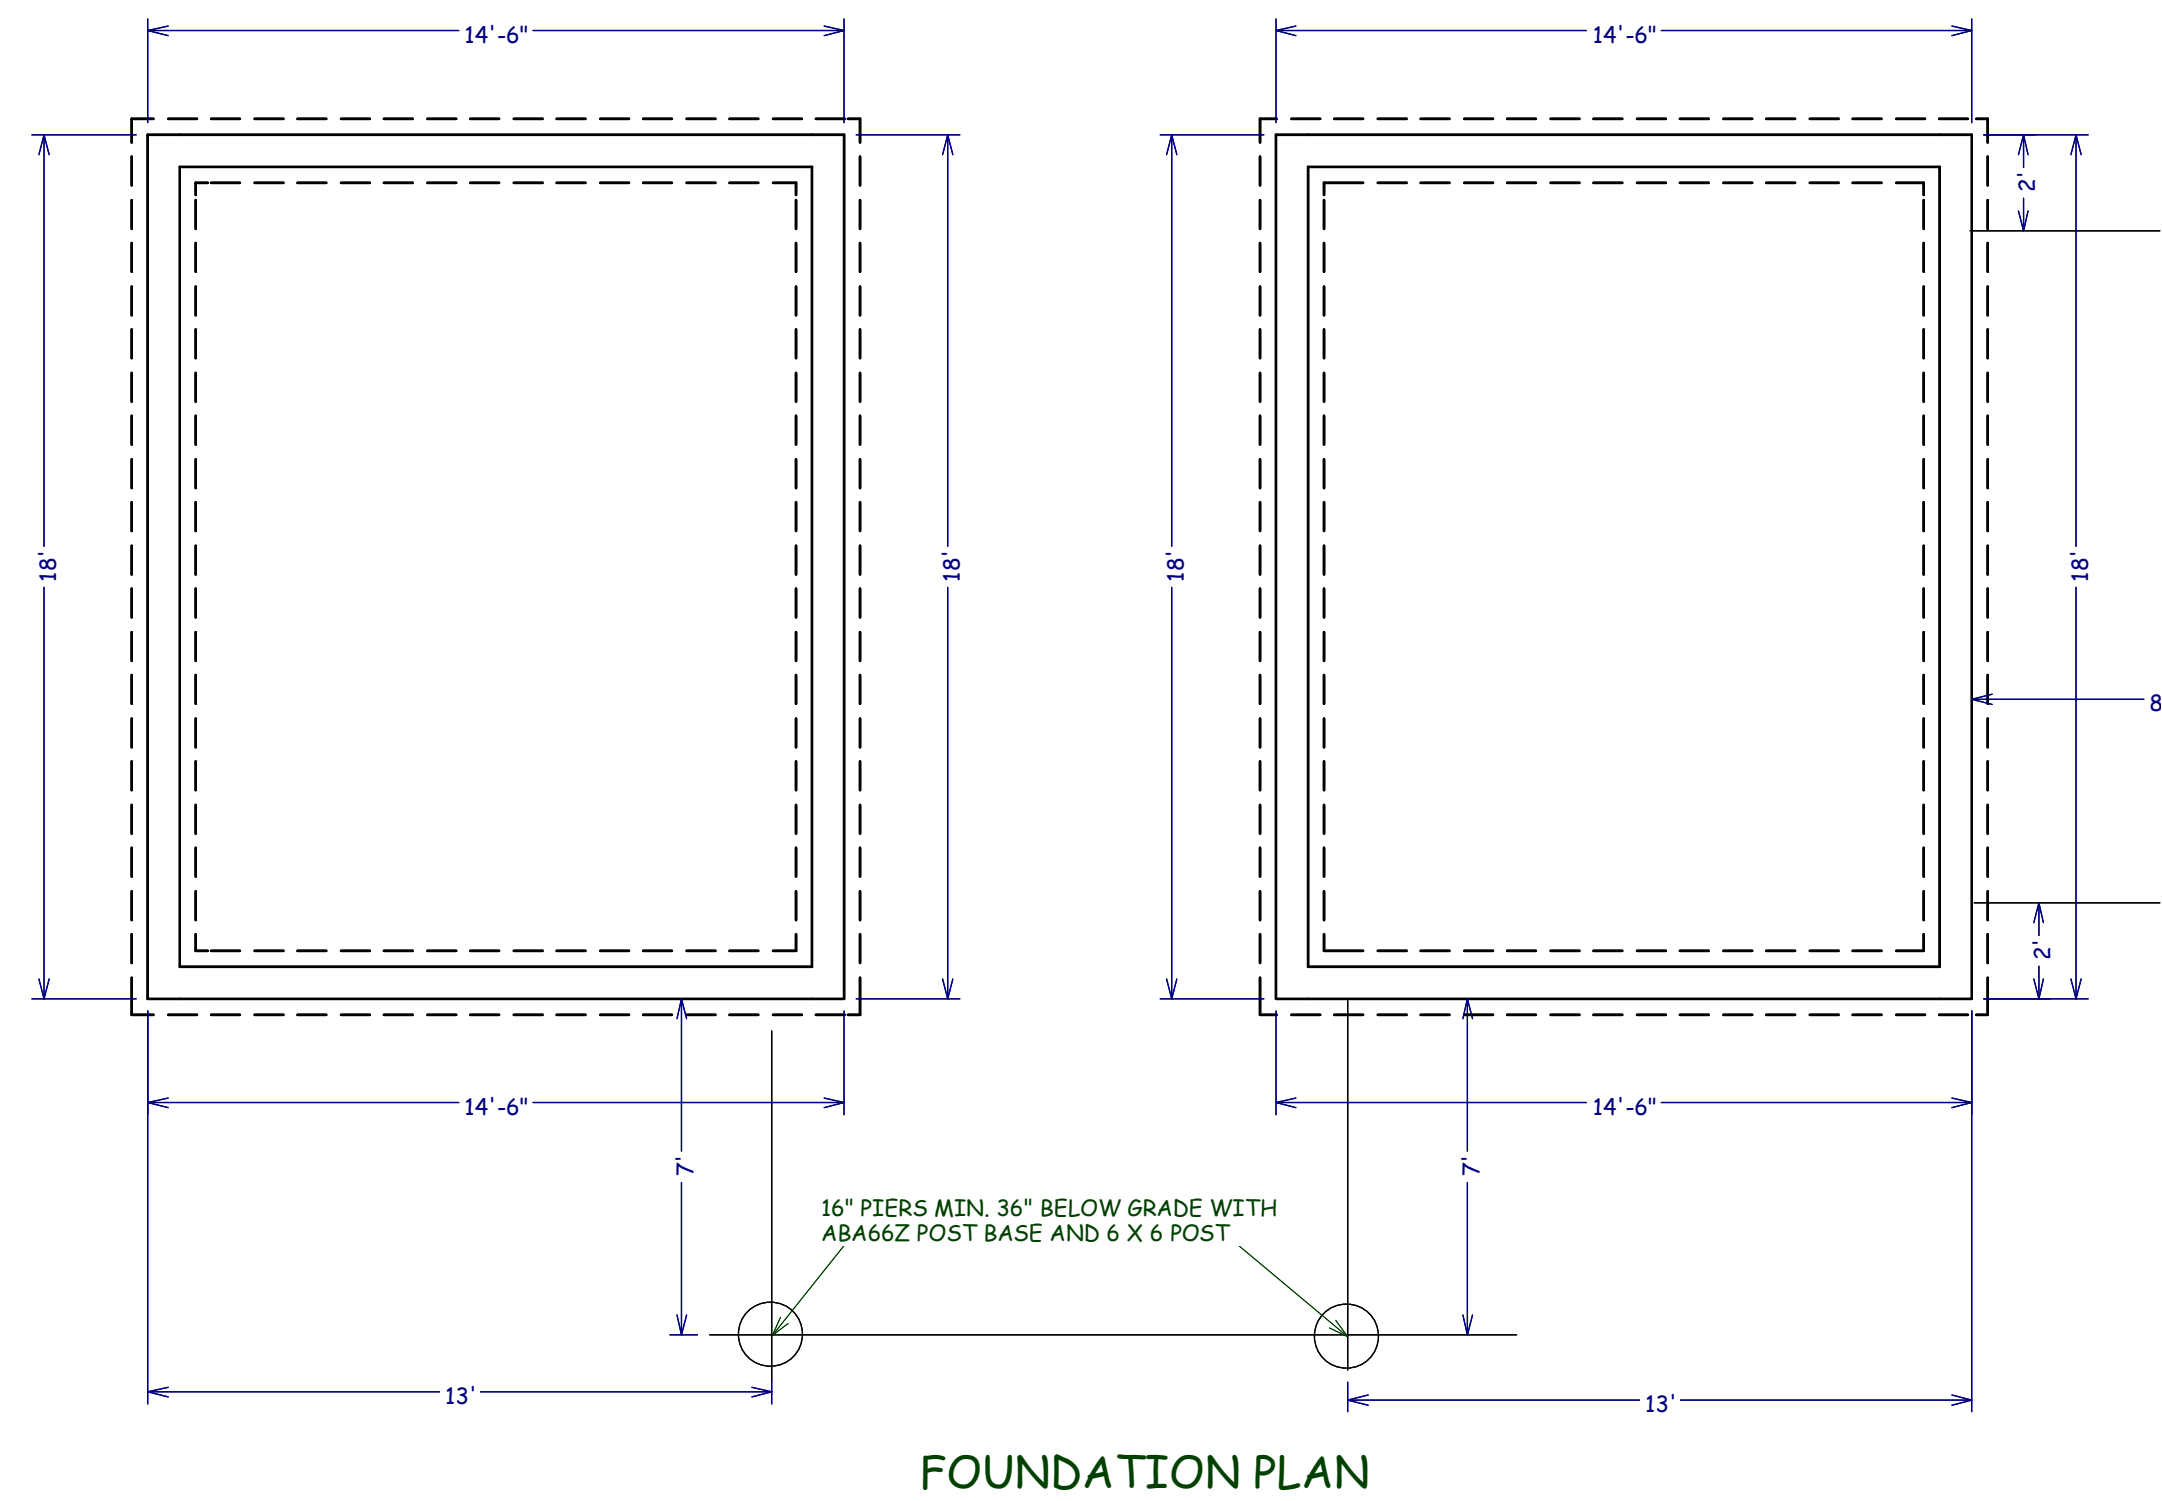

Review and Approval
Structural Only

David Mezger Engineering LLC
212 NE Circle Dr.
Kansas City, MO 64116

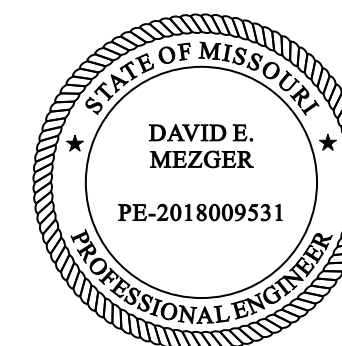

**BUILD IN ACCORDANCE WITH
2018 INTERNATIONAL
BUILDING CODE AND LOCAL
CODES.**

POOL HOUSE
1901 SW RIVER RUN DR
LEE SUMMIT MO

SCALE
1/4" = 1'-0"


DATE
5-27-22

PLAN NO.


3781

SHEET NO.


2 OF 5

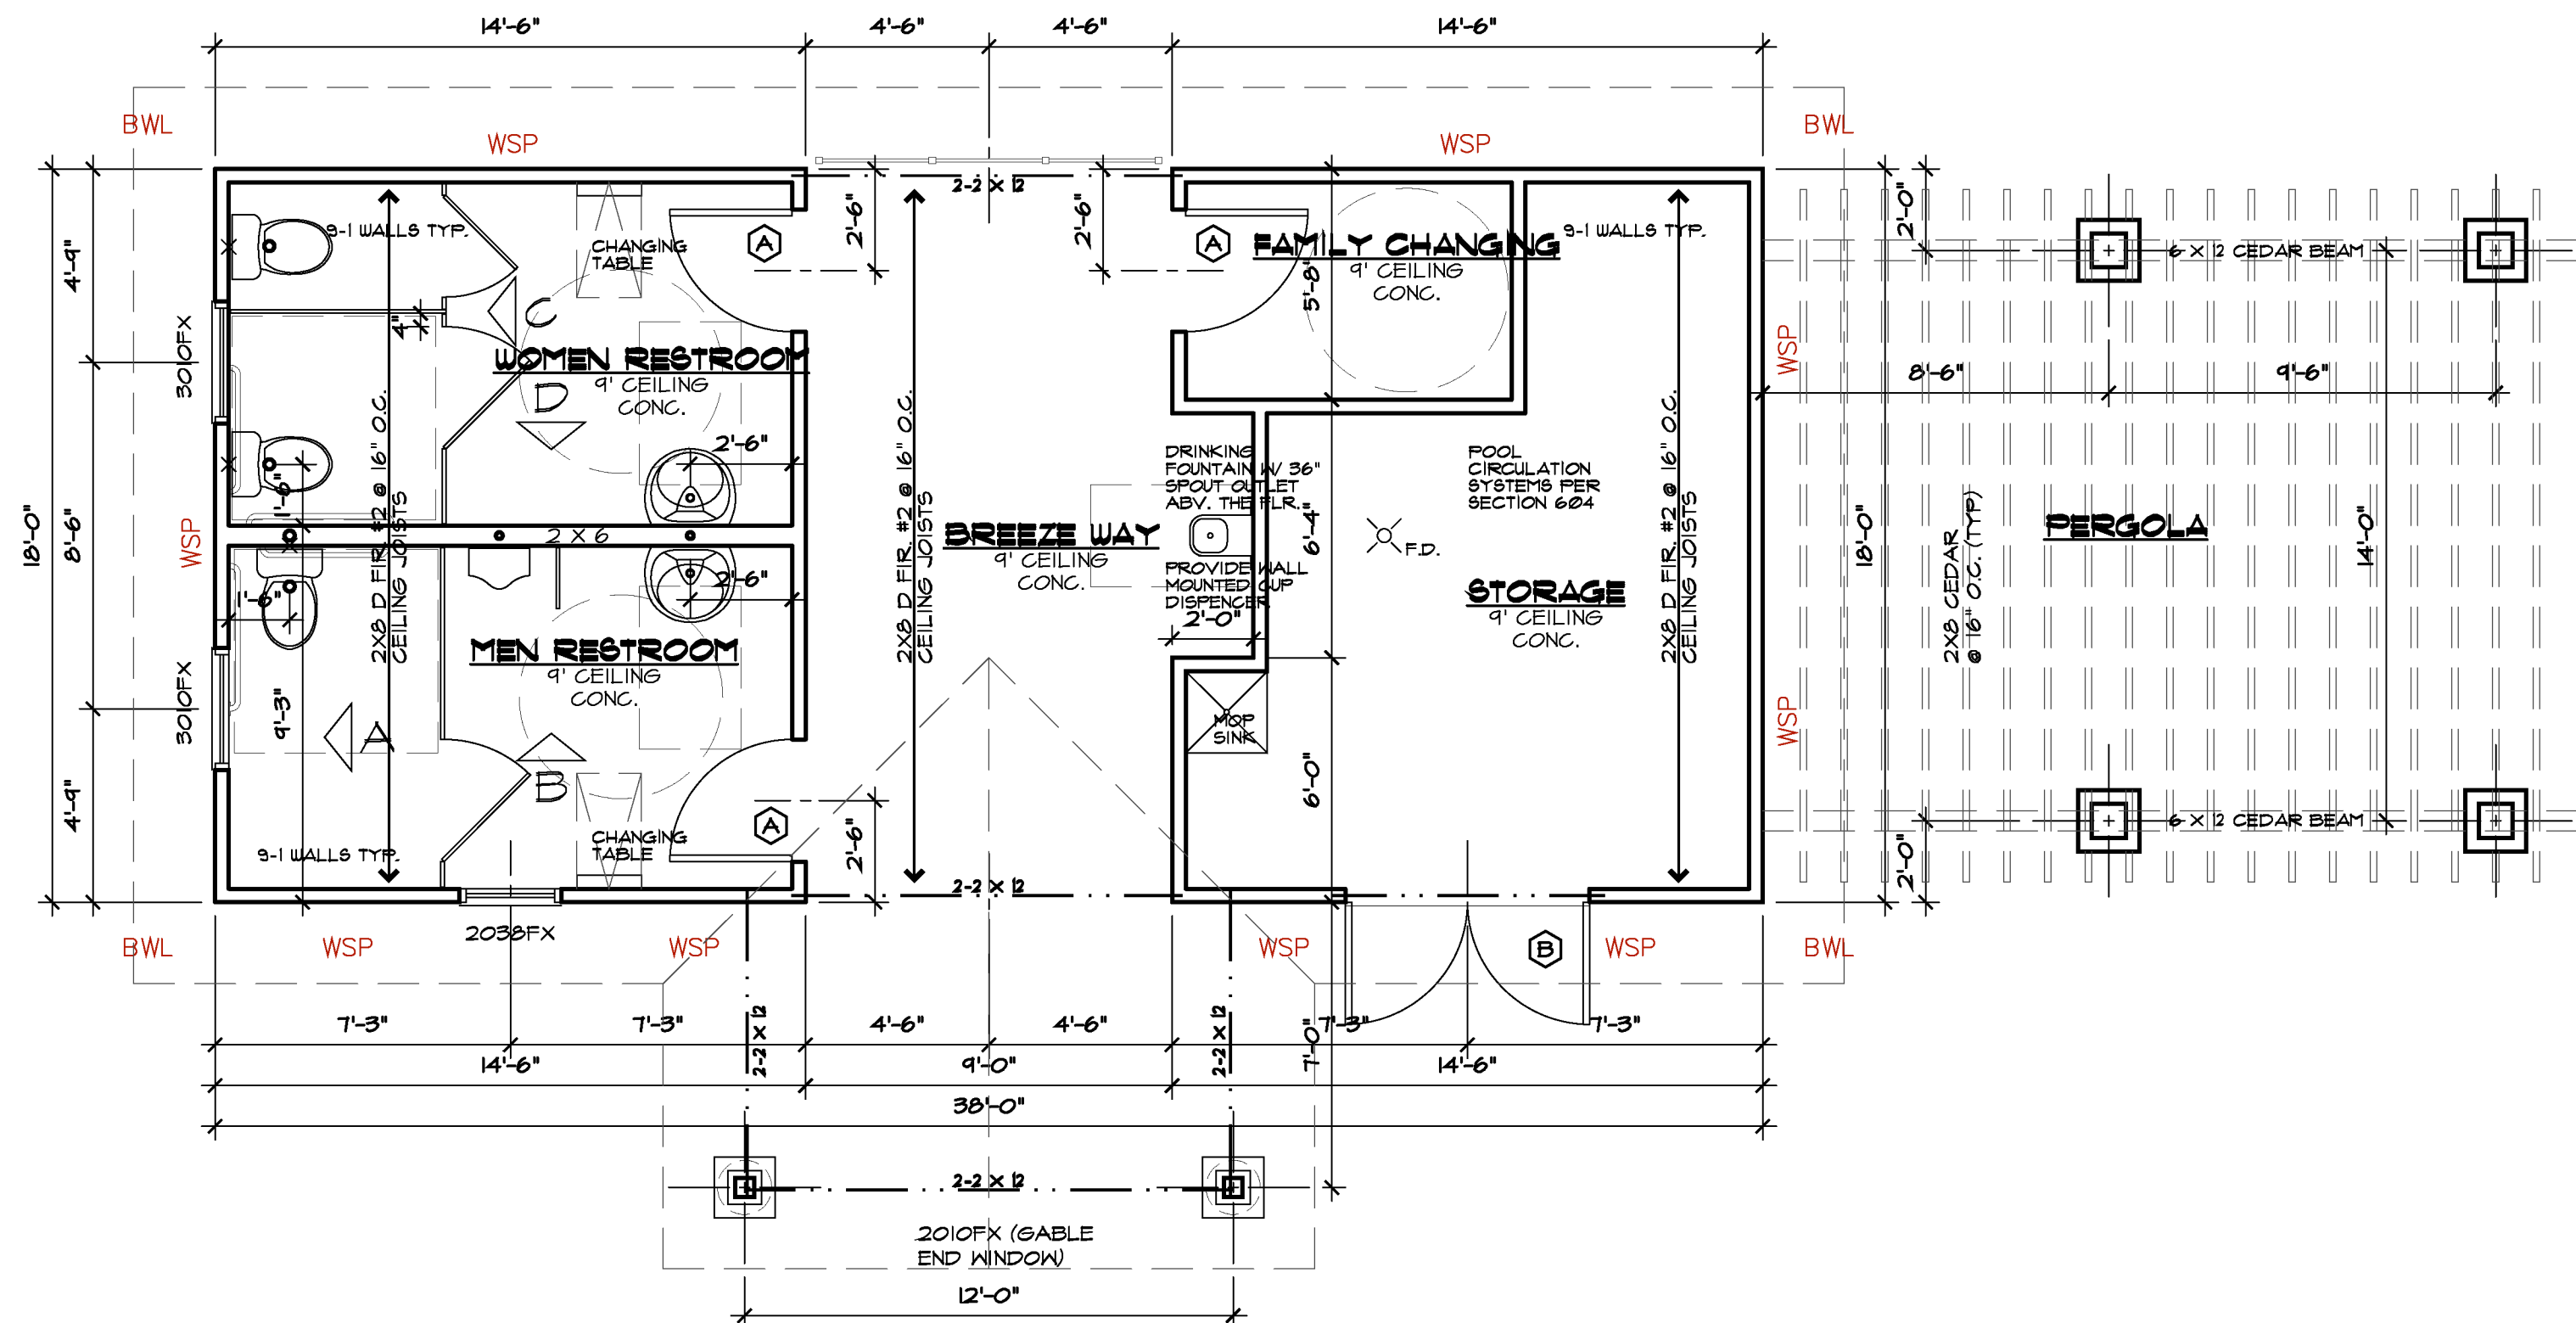


POOL HOUSE FLOOR PLAN
SCALE: 1/4" = 1'-0"

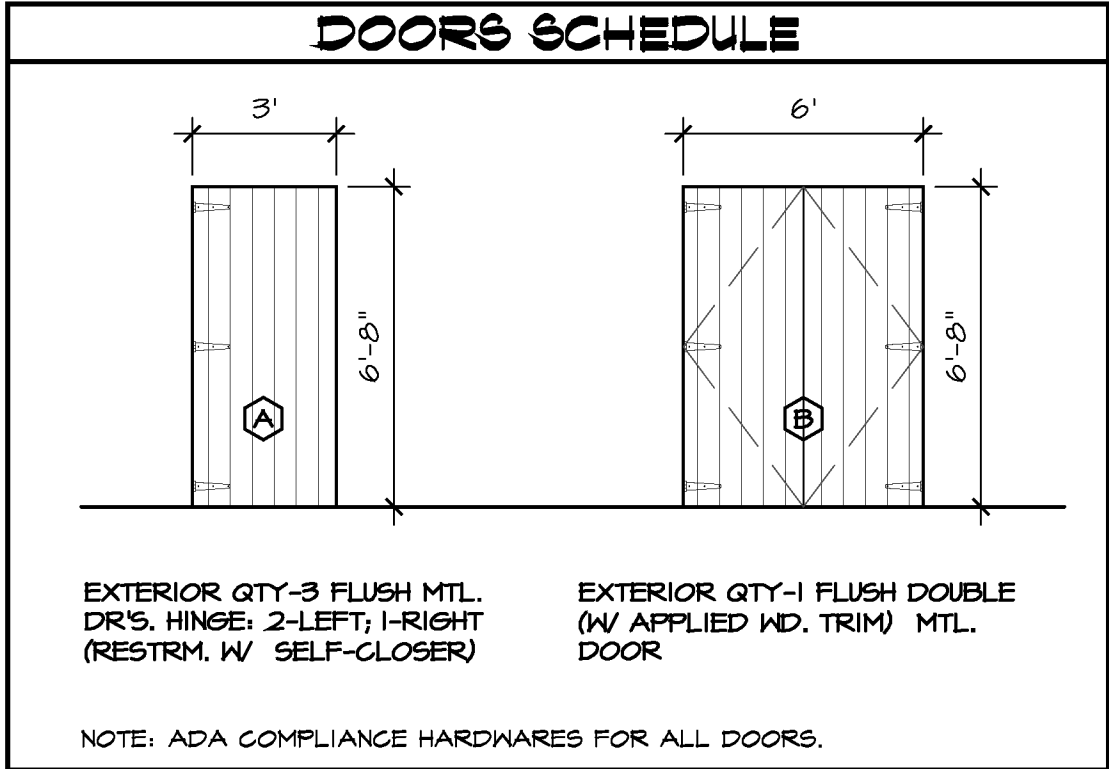

- RESTROOM FIXTURE LEGEND**
- ① WALL MOUNTED LAVATORY W/ INSULATED PIPING BELOW
 - ② MIRROR
 - ③ DUAL ROLL TOILET PAPER DISPENSER
 - ④ STAINLESS STEEL GRAB BAR per ANSI SPEC'S.
 - ⑤ FLOOR MOUNTED ACCESSIBLE WATER CLOSET
 - ⑥ EPOXY PAINT AS REQ.
 - ⑦ WALL MOUNTED URINAL
- TOILET (ADA COMPLIANCE UNIT)
WALL MOUNTED LAVATORY (ADA COMPLIANCE UNIT)
WALL MOUNTED URINAL (ADA COMPLIANCE UNIT)

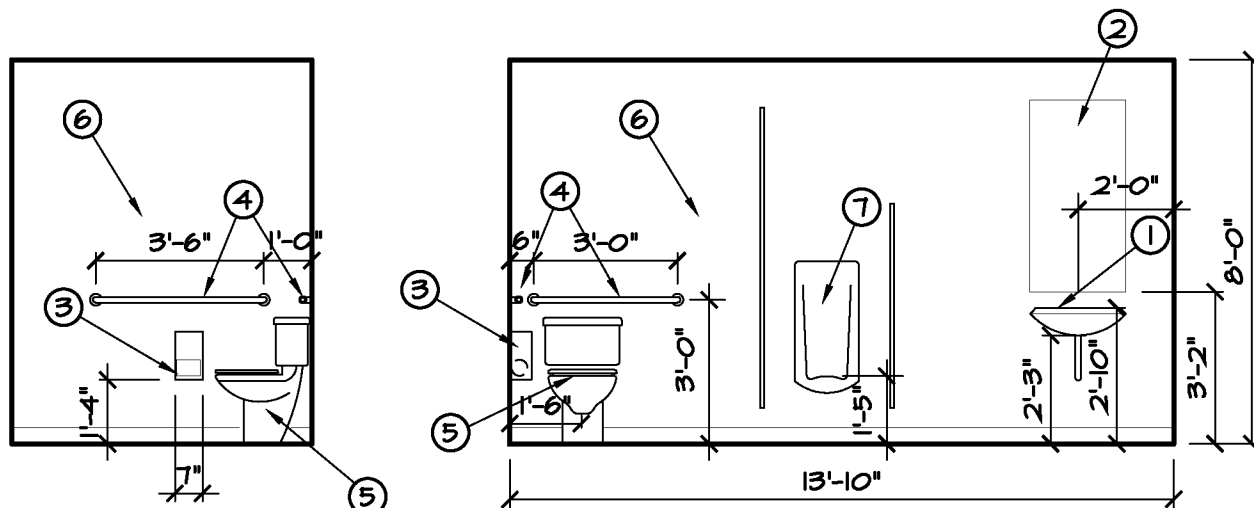

ELEVATION A
ELEVATION B
MEN RESTROOM ELEVATIONS
SCALE: 1/4" = 1'-0"

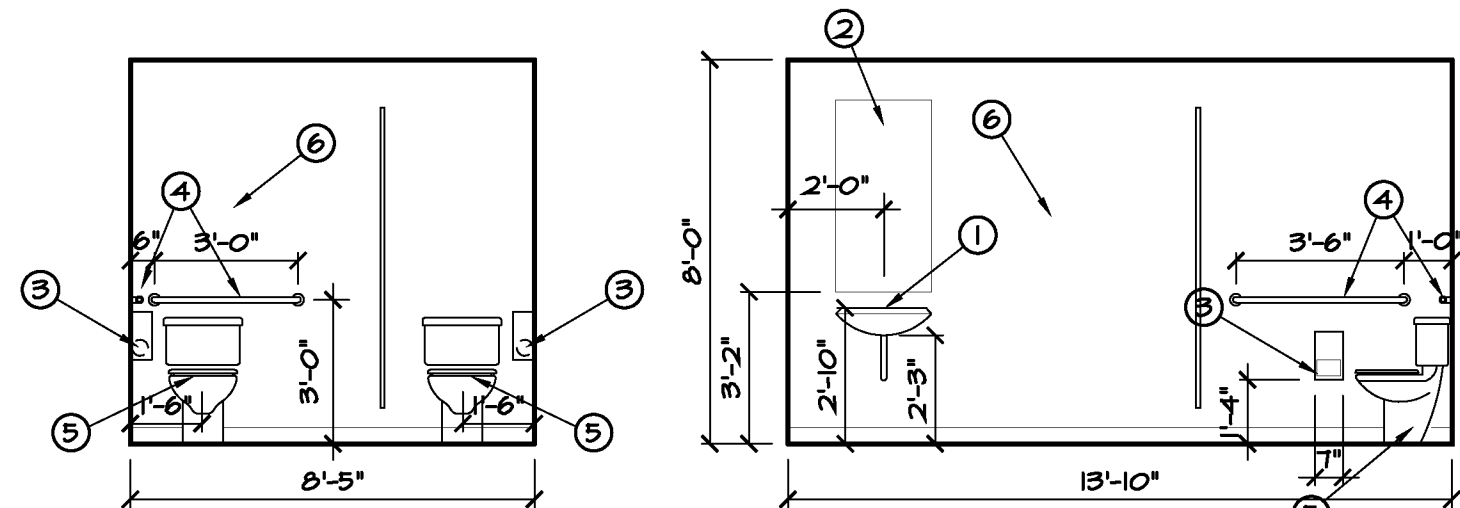

ELEVATION C
ELEVATION D
WOMEN RESTROOM ELEVATIONS
SCALE: 1/4" = 1'-0"

MAIN FLOOR
POOL HOUSE
522 SF FINISHED

Review and Approval
Structural Only

David Mezger Engineering LLC
212 NE Circle Dr.
Kansas City, MO 64116



Digitally signed by David
Eugene Mezger
DN: C=US,
E=dmezger@gmail.com,
O=David Mezger
Engineering LLC,
CN=David Eugene Mezger
Date: 2022.05.28
13:07:36-0500

BUILD IN ACCORDANCE WITH
2018 INTERNATIONAL
BUILDING CODE AND LOCAL
CODES.

POOL HOUSE
1901 SW RIVER RUN DR
LEE SUMMIT MO

SCALE
1/4" = 1'-0

DATE
5-27-22

PLAN NO.
3781

SHEET NO.
3 OF 5

ENERGY CONSERVATION CODE
THE FOLLOWING VALUES ARE NEEDED.

R-15 IN WALLS

R-49 IN ATTICS

R-38 IN VAULTS
R-30 REDUCTION FOR VAULTS IS ONLY FOR 500 SF
PF AREA

R-19 IN FLOORS OVER UNCONDITIONED SPACES



R-10 IN CRAWL SPACE WALLS

BASEMENT WALLS R-13 CAVITY OR R-10 CONTINUOUS

SLABS SHALL BE R-10 FOR A DEPTH OF 2 FOOT

A WINDOW U FACTOR OF .35 OR BETTER

DUCTWORK NEEDS TO HAVE AN R-8 VALUE

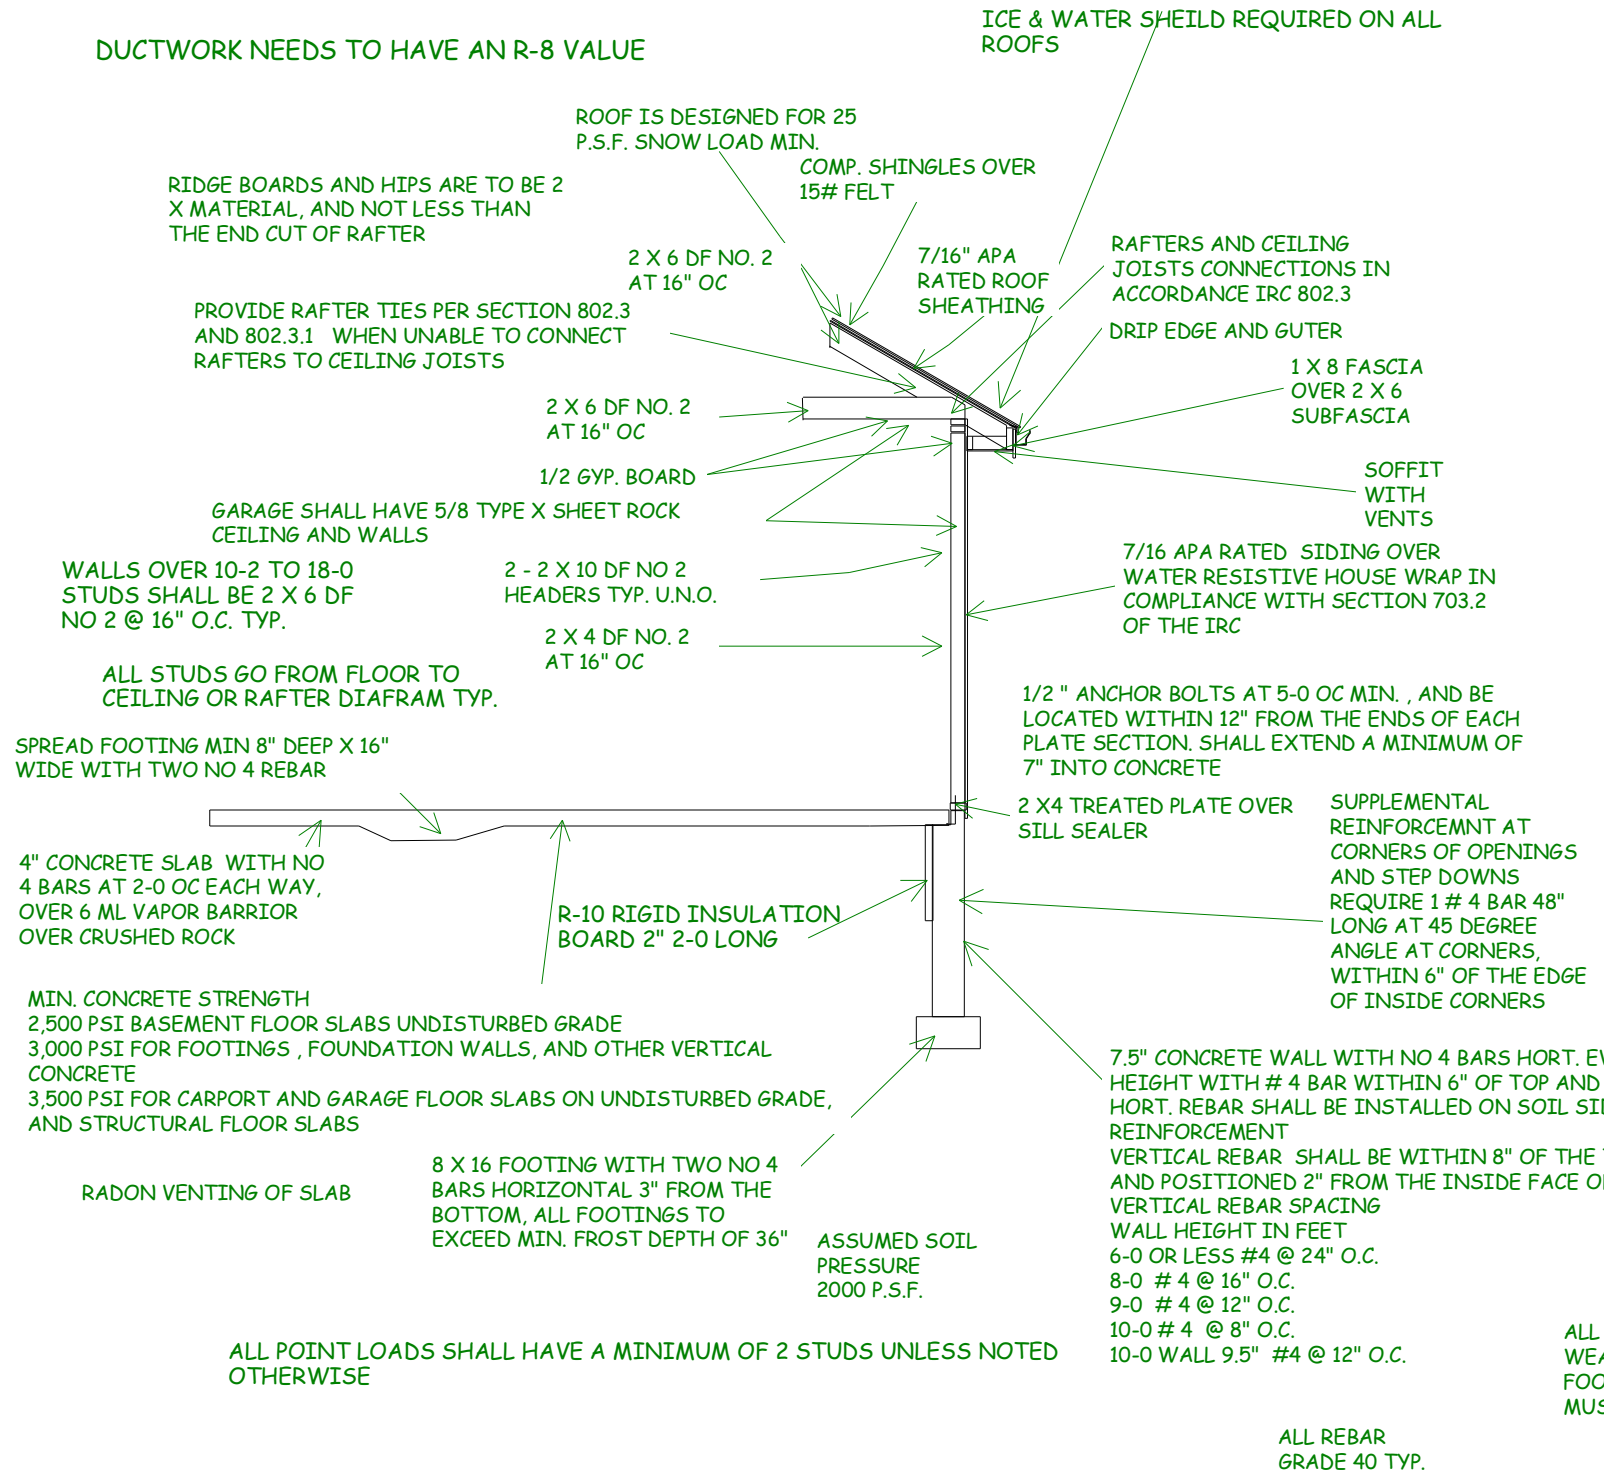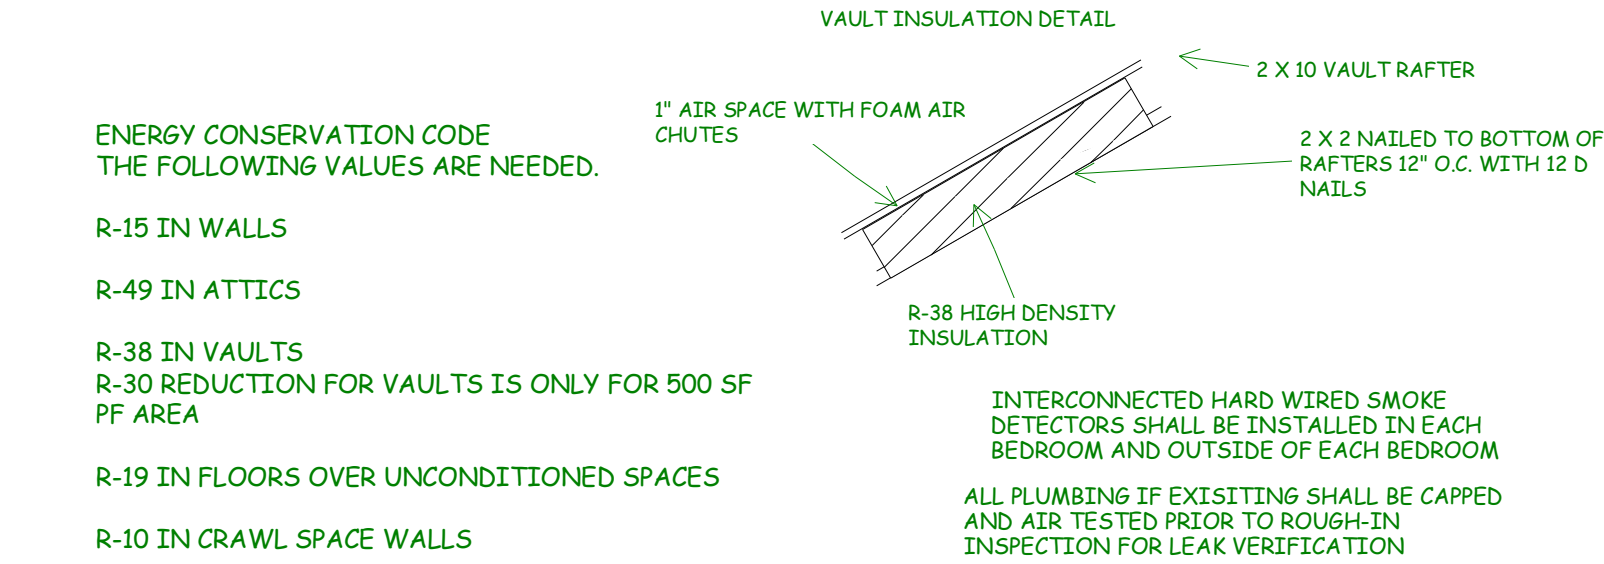

TYPICAL WALL SECTION

WINDOW EGRESS REQUIREMENTS

WINDOW SAFETY GLAZING PER 308

SAFETY GLAZING REQUIRED ALONG WALKING SURFACES AND STAIRS LOCATED WITHIN 36 INCHES HORIZONTALLY OF THE STEPS. SAFETY GLAZING REQUIRED IF EXPOSED SINGLE PANEL IS IN EXCESS OF 9 SQUARE FEET OR THE BOTTOM EDGE OF THE GLAZING IS LESS THAN 18 INCHES ABOVE THE FINISHED FLOOR.


SAFETY GLAZING REQUIRD WHERE THE NEAREST EXPOSED EDGE OF THE GLAZING IS WITHIN 24 INCHES OF EITHER VERTICAL EDGE OF THE DOOR IN A CLOSED POSITION AND WHERE THE BOTTOM EXPOSED EDGE OF THE GLAZING IS LESS THAN 60 INCHES ABOVE A WALKING SURFACE, SAFETY OR TEMPERED GLAZING IS REQUIRED.

WINDOWS ARE TO HAVE FALL PROTECTION PER IRC 312.2

BEDROOM WINDOW EGRESS MINIMUM FOR A DOUBLE HUNG WINDOW IS 34 INCH CLEAR WIDTH MIN. AND 24 INCH CLEAR HEIGHT MIN. WITH A CLEAR OPENABLE AREA OF 5.7 SQUARE FEET MIN. A CASEMENT OR SLIDER WINDOW MINIMUMS ARE 20 INCH CLEAR WIDTH MINIMUM AND 41 INCH CLEAR HEIGHT MINIMUM. WITH A MINIMUM 5.7 SQUARE FOOT OF OPENABLE AREA. OPENING OF EGRESS WINDOW NOT MORE THAN 42" FROM THE FLOOR


PIER PADS

TYP. U.N.O. 3-0 X 3-0 X 12" PEIR PADS MIN. WITH # 4 REBAR, 6 EACH WAY

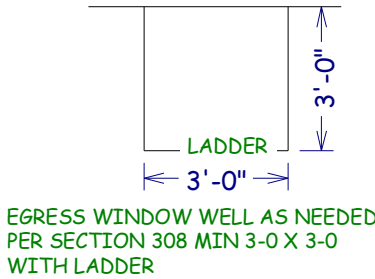


OVERHEAD GARAGE DOORS MUST MEET DASMA 115 MPH OR IRC 2018 REQUIREMENTS

ALL CONCRETE EXPOSED TO WEATHER GARAGE SLABS FOOTINGS WALLS AND FLATWORK MUST HAVE 6% AIR ENTRAINMENT

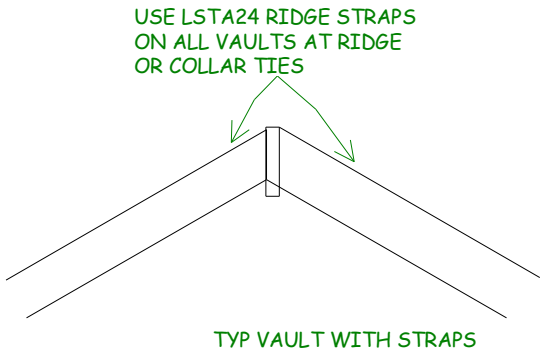

TYP VAULT WITH STRAPS

1. DWELLING / GARAGE OPENINGS BETWEEN GARAGE AND SLEEPING PURPOSES SHALL NOT BE PERMITTED. OTHER OPENINGS SHALL BE EQUIPPED WITH SOLID WOOD OR STEEL DOORS NOT LESS THAN 1-3/8" THICK OR 20 MINUTE RATED DOORS, WITH SELF CLOSING DEVICES REQUIRED FOR GARAGE / DWELLING SEPERATION DOORS R302.5.1
2. WHOLE HOUSE MECHANICAL VENTILATION SYSTEM IS REQUIRED FOR ANY DWELLING IN COMPLIANCE WITH IRC M 1505
3. CARBON MONOXIDE DETECTORS REQUIRED IRC R 315
4. STEEL COLUMNS SHALL BE MINIMUM SCHEDULE 40 R407.3
5. DECK SHALL BE BUILT PER TABLES 507.2 , 507.2.1, 507.3, 507.6, 507.5.1(1)&(2), 507.5, AND 507.6
6. STUDS SHALL BE CONTINUOUS BETWEEN FLOOR, CEILING AND OR ROOF DIAPHRAGMS R602.3
7. ADDED REQUIREMENTS FOR WINDOW FALL PROTECTION R312.2
8. NEW PROVISIONS FOR ATTACHMENT OF RAFTERS, TRUSSES AND ROOF BEAMS R802.3.1 R802.11
9. INSULATION REQUIRED FOR ALL BASEMENT WALLS (INCLUDING UNFINISHED BASEMENTS) N1102.1
10. EXTERIOR WINDOWS/DOORS SHALL HAVE U-FACTOR 0.35 AND GLAZING SHALL HAVE SOLAR HEIGHT GAIN FACTOR OF 0.40 N1102.1
11. HOUSE LEAKAGE AND DUCT LEAKAGE PERFORMANCE STANDARDS EFFECTIVE JANUARY 1, 2014. A SAMPLE TESTING PROGRAM WILL BE IMPLEMENTED OCTOBER 1, 2012 KCBRC N1102.4.1.2 N1103.2.2
12. LIGHTING FIXTURES PENETRATING THE THERMAL ENVELOPE (E.G. CAN LIGHTS IN ATTIC) SHALL BE IC- RATED, LEAKAGE- RATED AND SEALED TO THE GYPSUM WALLBOARD N1102.4.4
- 13.PROGRAMMABLE THERMOSTAT REQUIRED N1103.1.1
14. AIR HANDLERS SHALL BE RATED FOR MAXIMUM 2 % AIR LEAKAGE RATE N1103.2.2.1
15. BUILDING CAVITIES USED AS RETURN AIR PLENUMS SHALL BE SEALED TO PREVENT LEAKAGE ACROSS THE THERMAL ENVELOPE KCBRC N1103.2.2
16. CERTAIN HOT WATER PIPES SHALL BE INSULATED N1103.4
17. ALL EXHAUST FANS SHALL TERMINATE TO THE BUILDING EXTERIOR M1507.2
18. MAKEUP AIR SYSTEM REQUIRED FOR KITHCHEN EXHAUST HOODS THAT EXCEED 400 CFM M1503.4
19. BUILDING CAVITIES IN A THERMAL ENVELOPE WALL (INCLUDING THE WALL BETWEEN THE HOUSE AND GARAGE) SHALL NOT BE USED AS RETURN AIR PLENUMS
20. AN AIR HANDLING SYSTEM SHALL NOT SERVE BOTH THE LIVING SPACE AND THE GARAGE M1601.6
21. A CONCRETE- ENCASED GROUNDING ELECTRODE ('UFER' GROUND) CONNECTION SHALL BE PROVIDED TO THE ELECTRICAL SERVICE E3608.1
22. COMPLIANCE WITH THE REQUIRMENT AND SHOW CONNECTION AS NEEDED FOR ROOF BEAM, TRUS, RAFTER, AND GIRDER CONNECTION FOR UPLIFT PER IRC 802.11. ALL RAFTERS BE IN COMPLIANCE WITH IRC 502.11 AMENDED RAYMORE CODE

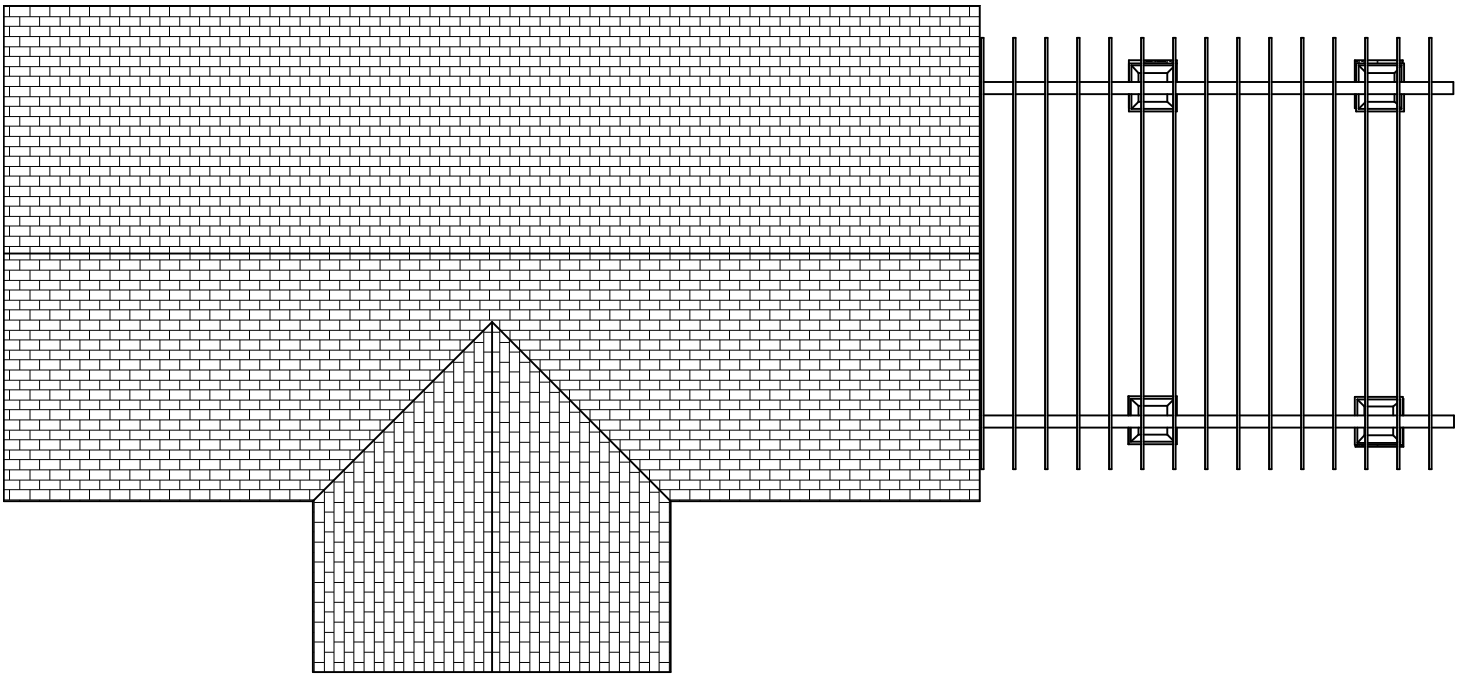

ROOF PLAN
1/8 = 1-0
ROOF PITCHES 8/12
16" SOFFITS TYP.
RAFTERS 2 X 6 DF NO 2 @ 16" O.C.
HIPS AND RIDGES 2 X 8 DF NO 2

BUILD IN ACCORDANCE WITH
2018 INTERNATIONAL
BUILDING CODE AND LOCAL
CODES.

POOL HOUSE
1901 SW RIVER RUN DR
LEE SUMMIT MO

SCALE
1/4" = 1-0

DATE
5-27-22

PLAN NO.
3781

SHEET NO.
4 OF 5

Review and Approval
Structural Only

David Mezger Engineering LLC
212 NE Circle Dr.
Kansas City, MO 64116



EXPOSURE CATEGORY B • 36-FOOT MEAN ROOF HEIGHT • 10-FOOT WALL HEIGHT • 2 BRACED WALL LINES		MINIMUM TOTAL LENGTH (FEET) OF BRACED WALL PANELS REQUIRED ALONG EACH BRACED WALL LINE ^a				
Ultimate Design Wind Speed (mph)	Story Location	Braced Wall Line Spacing ^b (feet)	Method LIB ^c	Method GB	Methods DWB, WSP, SFB, PBS, FCP, HPS, BV-WSP, ABW, PFH, PCP, CS-SFB	Methods CS-WSP, CS-G, CS-PF
≤ 115		10	3.5	3.5	2.0	2.0
		20	6.5	6.5	3.5	3.5
		30	9.5	9.5	5.5	4.5
		40	12.5	12.5	7.0	6.0
		50	15.0	15.0	9.0	7.5
		60	18.0	18.0	10.5	9.0
		10	7.0	7.0	4.0	3.5
		20	12.5	12.5	7.5	6.5
		30	18.0	18.0	10.5	9.0
		40	23.5	23.5	13.5	11.5
		50	29.0	29.0	16.5	14.0
		60	34.5	34.5	20.0	17.0
		10	NP	10.0	6.0	5.0
		20	NP	18.5	11.0	9.0
		30	NP	27.0	15.5	13.0
		40	NP	35.0	20.0	17.0
		50	NP	43.0	24.5	21.0
		60	NP	51.0	29.0	25.0

METHODS, MATERIAL	MINIMUM THICKNESS	FIGURE	CONNECTION CRITERIA ^a	
			Fasteners	Spacing
Intermittent Bracing Methods	LIB Let-in-bracing		Wood: 2-8d common nails or 3-8d (2 1/2" long x 0.113" dia.) nails Metal strap: per manufacturer	Wood: per stud and top and bottom plates Metal: per manufacturer
	DWB Diagonal wood boards		2-8d (2 1/2" long x 0.113" dia.) nails or 2 - 1 1/4" long staples	Per stud
	WSP Wood structural panel (See Section R604)		Exterior sheathing per Table R602.3(3) Interior sheathing per Table R602.3(1) or R602.3(2)	6" edges 12" field Varies by fastener
	BV-WSP ^b Wood structural panels with stone or masonry veneer (See Section R602.10.6.5)		8d common (2 1/2" x 0.131") nails	4" at panel edges 12" at intermediate supports 4" at braced wall panel end posts
	SFB Structural fiberboard sheathing		1 1/2" long x 0.12" dia. (for 1/2" thick sheathing) 1 1/2" long x 0.12" dia. (for 3/4" thick sheathing) galvanized roofing nails	3" edges 6" field
	GB Gypsum board		Nails or screws per Table R602.3(1) for exterior locations Nails or screws per Table R702.3.5 for interior locations	For all braced wall panel locations: 7" edges (including top and bottom plates) 7" field
	PBS Particleboard sheathing (See Section R605)		For 3/4" 6d common (2" long x 0.113" dia.) nails For 1/2" 8d common (2 1/2" long x 0.131" dia.) nails	3" edges 6" field
	PCP Portland cement plaster		1 1/2" long, 11 gage, 7/16" dia. head nails or 1/2" long, 16 gage staples	6" o.c. on all framing members
	HPS Hardboard panel siding		0.092" dia., 0.225" dia. head nails with length to accommodate 1 1/2" penetration into studs	4" edges 8" field
	ABW Alternate braced wall		See Section R602.10.6.1	See Section R602.10.6.1

METHODS, MATERIAL	MINIMUM THICKNESS	FIGURE	CONNECTION CRITERIA ^a	
			Fasteners	Spacing
Intermittent Bracing Methods	PFH Portal frame with hold-downs		See Section R602.10.6.2	See Section R602.10.6.2
	PFG Portal frame at garage		See Section R602.10.6.3	See Section R602.10.6.3
	CS-WSP Continuously sheathed wood structural panel		Exterior sheathing per Table R602.3(3) Interior sheathing per Table R602.3(1) or R602.3(2)	6" edges 12" field Varies by fastener
Continuous Sheathing Methods	CS-G ^a Continuously sheathed wood structural panel adjacent to garage openings		See Method CS-WSP	See Method CS-WSP
	CS-PF Continuously sheathed portal frame		See Section R602.10.6.4	See Section R602.10.6.4
	CS-SFB ^b Continuously sheathed structural fiberboard		1 1/2" long x 0.12" dia. (for 1/2" thick sheathing) 1 1/2" long x 0.12" dia. (for 3/4" thick sheathing) galvanized roofing nails	3" edges 6" field

For SI: 1 inch = 25.4 mm, 1 foot = 304.8 mm, 1 degree = 0.0175 rad, 1 pound per square foot = 47.8 N/m², 1 mile per hour = 0.447 m/s.
a. Adhesive attachment of wall sheathing, including Method GB, shall not be permitted in Seismic Design Categories C, D_s, D₁, and D₂.
b. Applies to panels next to garage door opening where supporting gable end wall or roof load only. Shall only be used on one wall of the garage. In Seismic Design Categories D_s, D₁, and D₂, roof covering dead load shall not exceed 3 psf.
c. Garage openings adjacent to a Method CS-G panel shall be provided with a header in accordance with Table R602.7(1). A full-height clear opening shall not be permitted adjacent to a Method CS-G panel.
d. Method CS-SFB does not apply in Seismic Design Categories D_s, D₁, and D₂.
e. Method applies to detached one- and two-family dwellings in Seismic Design Categories D_s through D₂ only.

METHOD (See Table R602.10.4)	MINIMUM LENGTH ^a (inches)					CONTRIBUTING LENGTH (inches)
	8 feet	9 feet	10 feet	11 feet	12 feet	
DWB, WSP, SFB, PBS, FCP, HPS, BV-WSP	48	48	48	53	58	Actual ^b
GB	48	48	48	53	58	Double sided = Actual Single sided = 0.5 x Actual
LIB	55	62	69	NP	NP	Actual ^b
ABW	SDC A, B and C, ultimate wind speed < 140 mph	28	32	34	38	42
	SDC D _s , D ₁ and D ₂ , ultimate wind speed < 140 mph	32	32	34	NP	NP
CS-G	Adjacent clear opening height (inches)	24	27	30	33	36
CS-WSP, CS-SFB	≤ 64	24	27	30	33	36
	68	26	27	30	33	36
	72	27	27	30	33	36
	76	30	29	30	33	36
	80	32	30	30	33	36
	84	35	32	32	33	36
	88	38	35	33	33	36
	92	43	37	35	35	36
	96	48	41	38	36	36
	100	—	44	40	38	38
	104	—	49	43	40	39
	108	—	54	46	43	41
	112	—	—	50	45	43
	116	—	—	55	48	45
	120	—	—	60	52	48
	124	—	—	—	56	51
	128	—	—	—	61	54
	132	—	—	—	66	58
	136	—	—	—	—	62
	140	—	—	—	—	66
	144	—	—	—	—	72
METHOD (See Table R602.10.4)	Portal header height	8 feet	9 feet	10 feet	11 feet	12 feet
	Supporting roof only	16	16	16	Note c	Note c
PFH	Supporting one story and roof	24	24	24	Note c	Note c
PFG		24	27	30	Note d	Note d
CS-PF	SDC A, B and C	16	18	20	Note e	Note e
	SDC D _s , D ₁ and D ₂	16	18	20	Note e	Note e

For SI: 1 inch = 25.4 mm, 1 foot = 304.8 mm, 1 mile per hour = 0.447 m/s.
NP = Not Permitted.
a. Linear interpolation shall be permitted.
b. Use the actual length where it is greater than or equal to the minimum length.
c. Maximum header height for PFH is 10 feet in accordance with Figure R602.10.6.2, but wall height shall be permitted to be increased to 12 feet with pony wall.
d. Maximum header height for PFG is 10 feet in accordance with Figure R602.10.6.3, but wall height shall be permitted to be increased to 12 feet with pony wall.
e. Maximum header height for CS-PF is 10 feet in accordance with Figure R602.10.6.4, but wall height shall be permitted to be increased to 12 feet with pony wall.

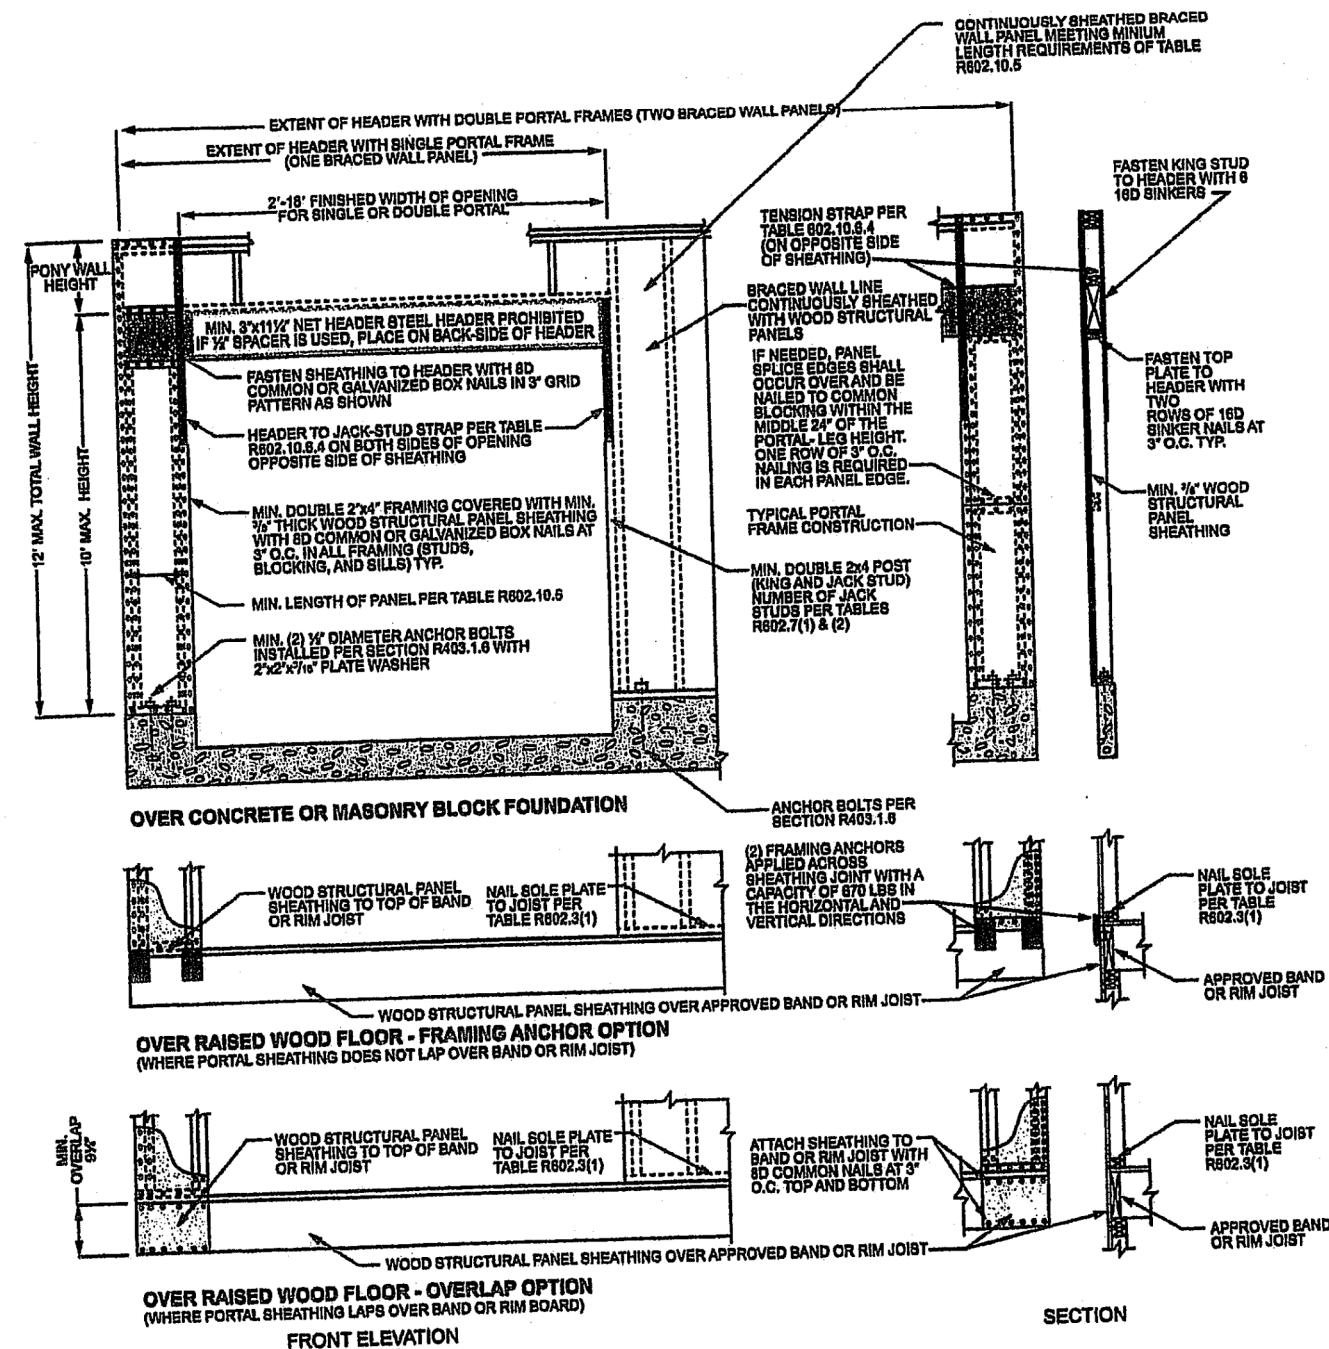


FIGURE R602.10.6.4
METHOD CS-PF—CONTINUOUSLY SHEATHED PORTAL FRAME PANEL CONSTRUCTION


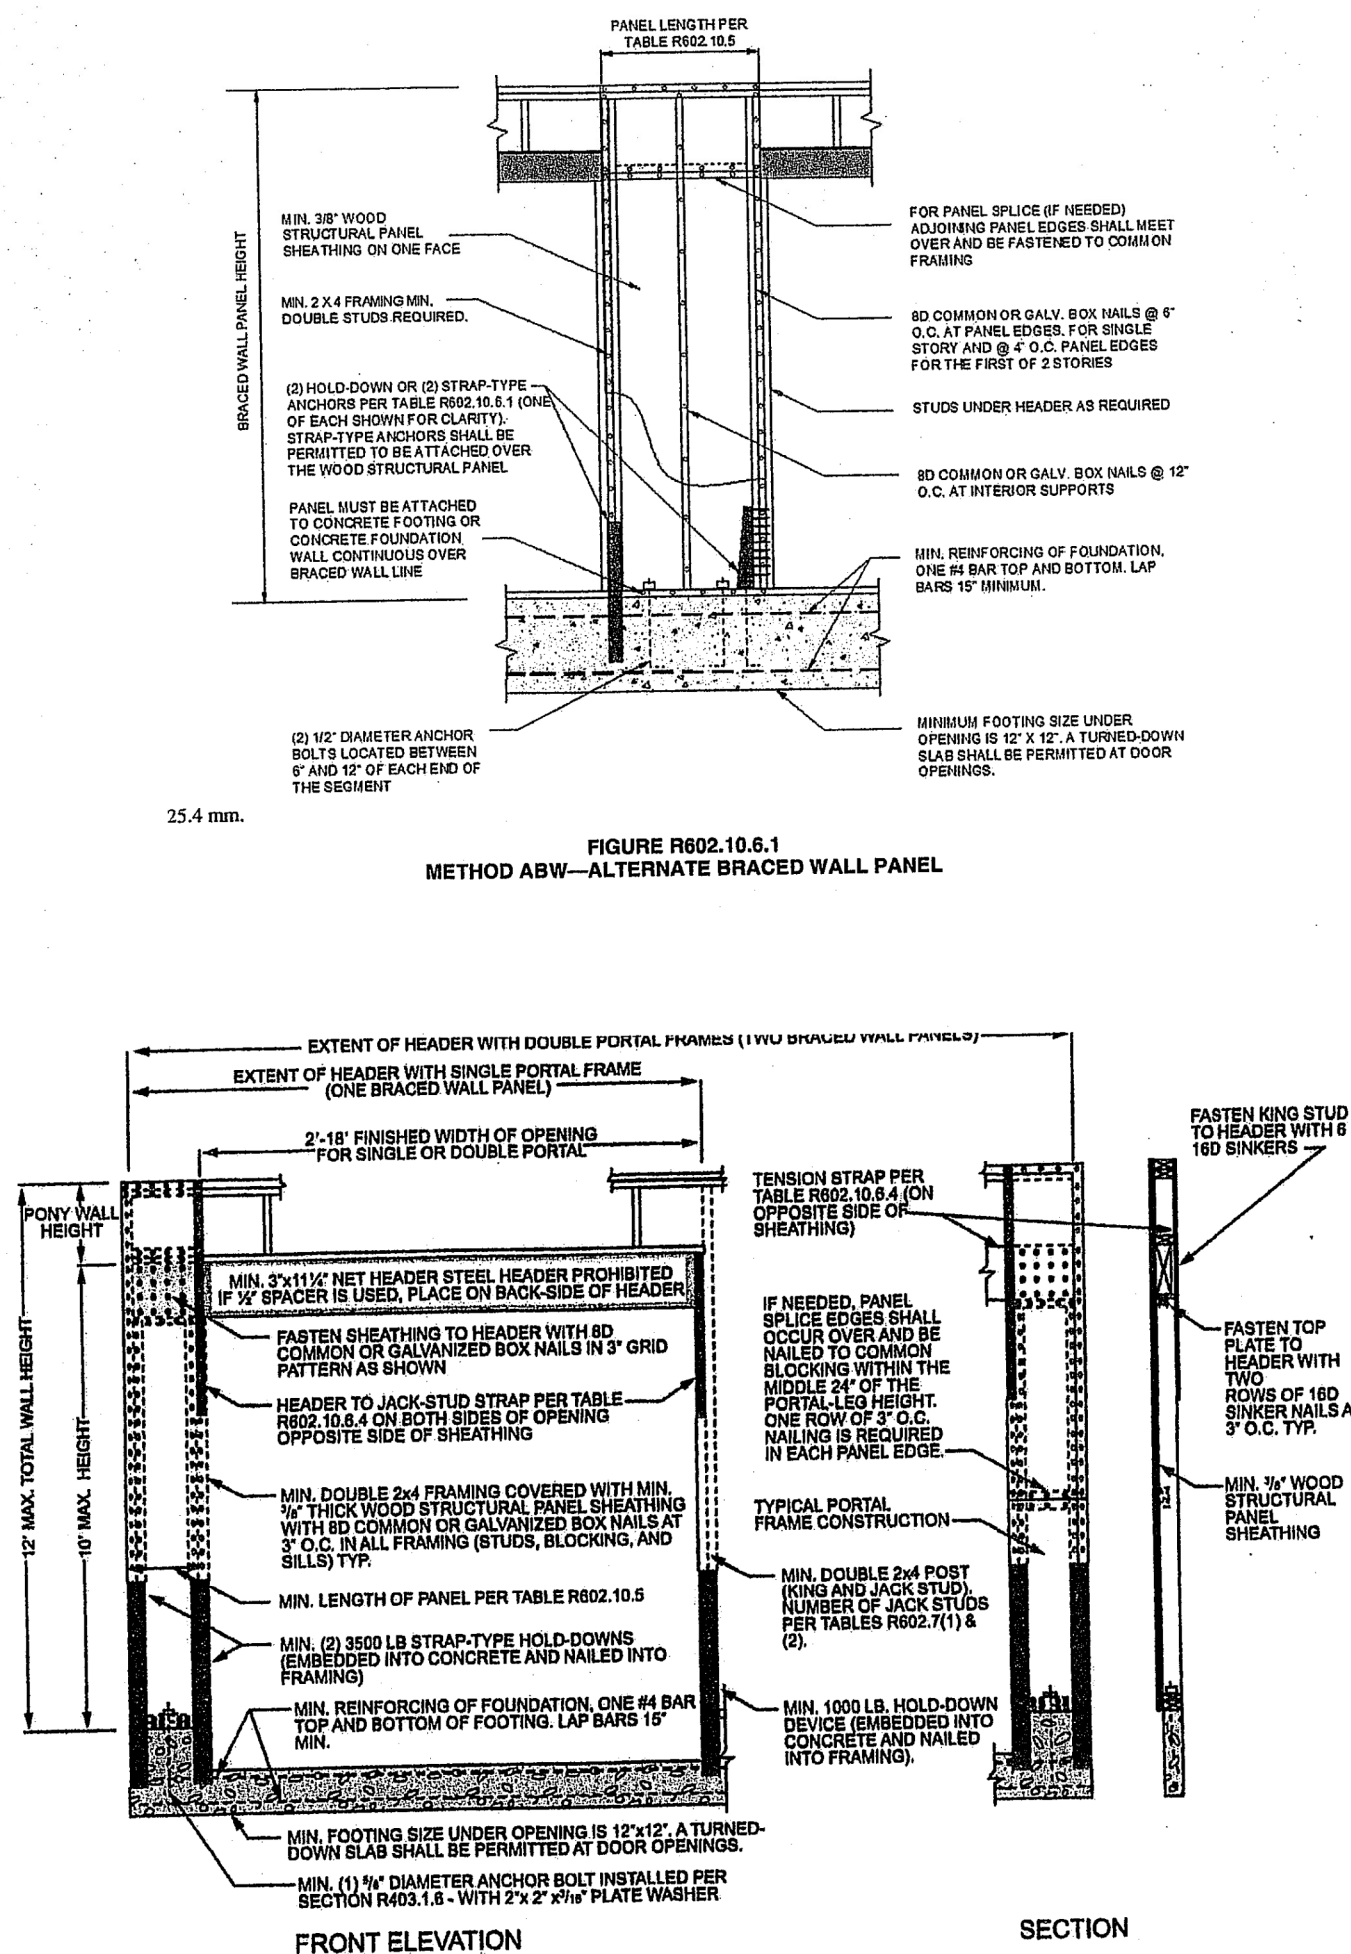


FIGURE R602.10.6.2
METHOD PFH—PORTAL FRAME WITH HOLD-DOWNS

BRACE WALL DETAILS
WIND SPEED 115 MPH
WIND EXPOSURE A
SEISMIC DESIGN CATEGORY A

Review and Approval
Structural Only

David Mezger Engineering LLC
212 NE Circle Dr.
Kansas City, MO 64116

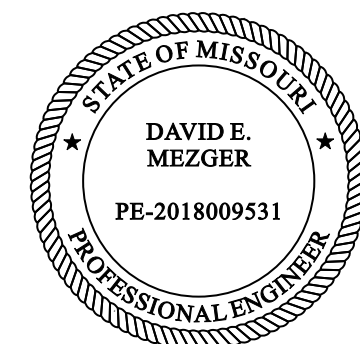

BUILD IN ACCORDANCE WITH
2018 INTERNATIONAL
BUILDING CODE AND LOCAL
CODES.

POOL HOUSE
1901 SW RIVER RUN DR
LEE SUMMIT MO

SCALE
1/4" = 1-0

DATE
5-27-22

PLAN NO.

3781

SHEET NO.

5 OF 5

7

6

5

4

3

2

1

EXHAUST FAN SCHEDULE												
MARK	AREA SERVED	MANUFACTURER	MODEL	TYPE	CFM	ESP (IN)	DRIVE	POWER	OPERATION	ELECTRICAL		WEIGHT
										VOLTS	PHASE	
EF-1	MEN R.R.	PANASONIC	FV-08-11VFL5	CEILING	110	0.25	DIRECT	26.5w	LIGHT SWITCH	120	1	12
EF-2	WOMEN R.R.	PANASONIC	FV-08-11VFL5	CEILING	110	0.25	DIRECT	26.5w	LIGHT SWITCH	120	1	12
EF-3	EQUIPMENT ROOM	FANTECH	FR-160	IN-LINE	225	0.5	DIRECT	125w	BREAKER	120	1	8

MECHANICAL & PLUMBING SPECIFICATIONS


1. GENERAL PROVISIONS:
- PROVIDE ALL LABOR, MATERIALS, AND EQUIPMENT NECESSARY FOR THE COMPLETE INSTALLATION OF THE PLUMBING SYSTEMS OUTLINED.
 - OBTAIN ALL PERMITS, FEES, LICENSES, INSPECTIONS, AND CERTIFICATIONS OF COMPLIANCE OR APPROVAL AS REQUIRED BY AUTHORITIES.
 - ALL WORK SHALL BE PERFORMED IN ACCORDANCE WITH ALL APPLICABLE LAWS, CODES AND REGULATIONS OF THE GOVERNMENTAL BODIES HAVING JURISDICTION OVER THE SITE.
 - PROVIDE ALL NECESSARY CUTTING AND PATCHING OF WALLS, FLOORS, CEILINGS, AND ROOFS AS NECESSARY. PATCH AROUND ALL OPENINGS SHALL MATCH ADJACENT AREA. COORDINATE ALL ROOFING WORK WITH OWNER OR RESPONSIBLE PARTY, SO THAT THE EXISTING ROOFING WARRANTY WILL BE MAINTAINED.
 - CONTRACTOR SHALL GUARANTEE ALL WORK AND MATERIALS AGAINST DEFECT FOR A PERIOD OF ONE YEAR FROM FINAL ACCEPTANCE.
 - INSPECTION OF THE SITE: THIS CONTRACTOR SHALL THOROUGHLY ACQUAINT HIMSELF WITH THE MEP DRAWINGS, SPECIFICATIONS, DETAIL, AND THE SITE. THIS CONTRACTOR SHALL NOTIFY THE ARCHITECT OF ANY SPECIAL OR UNUSUAL PROBLEMS, CONFLICTS, OR OBSTRUCTIONS THAT AFFECT HIS BID.
 - FOR THE PURPOSE OF CLEARNESS AND LEGIBILITY, THE DRAWINGS ARE ESSENTIALLY DIAGRAMMATIC AND DO NOT SHOW ALL OFFSETS AND FITTINGS REQUIRED FOR INSTALLATION. DO NOT SCALE DRAWINGS. THE SIZE AND LOCATION OF EQUIPMENT IS SHOWN TO SCALE WHEREVER POSSIBLE. THE CONTRACTOR SHALL VERIFY ALL CONDITIONS AND DATA AS INDICATED ON THE DRAWINGS AND IN THE SPECIFICATION SECTIONS WHERE MECHANICAL WORK INTERFACES WITH OTHER TRADES.
 - INCLUDE ALL BASIC MATERIALS AND CONSTRUCTION METHODS INCLUDING PIPES, PIPE FITTINGS, AND SPECIALTIES AND SUPPORTING DEVICES, VALVES, PIPE AND VALVE IDENTIFICATION, PUMPS, VIBRATION ISOLATION, ETC.
2. PLUMBING
- PROVIDE AND APPROVED WATER HAMMER ARRESTOR FOR EACH PLUMBING FIXTURE SUPPLY AS REQUIRED BY FIXTURE MANUFACTURER.
 - ALL EXPOSED PIPE SHALL BE CHROME PLATED BRASS PIPE, NO FERROUS PIPE.
 - PROVIDE CLEANOUTS AT EACH CHANGE IN DIRECTION AND AT 100 FOOT INTERVALS IN STRAIGHT RUNS.
 - PROVIDE ACCESS PANELS FOR ALL CONCEALED VALVES AND TRAPS.
 - CLEANOUTS:
 - UNFINISHED FLOOR (FCO):JR SMITH #4020, OR EQUAL.
 - WALL (WCO):JR SMITH #4472, OR EQUAL, 24" ABOVE THE FLOOR.
 - GRADE (GCO):JR SMITH #4256, OR EQUAL, WITH HEAVY DUTY CAST IRON BODY AND COVER.
 - PROVIDE DIELECTRIC UNIONS WITH APPROPRIATE END CONNECTION TO MATCH THE PIPE SYSTEM IN WHICH INSTALLED (SCREWED, SOLDERED, OR FLANGED). PROVIDE DIELECTRIC UNIONS ON ALL PIPING CONNECTIONS TO HOT WATER HEATERS AND EXPANSION JOINTS.
 - ALL SEWER PIPING LOCATED INSIDE THE BUILDING SHALL BE INSTALLED WITH THE FOLLOWING SLOPES.
 - INSTALL 2-1/2" AND SMALLER PIPE AT 1/4" PER FOOT FALL.
 - INSTALL 3" AND LARGER PIPE AT 1/8" PER FOOT FALL.
 - ALL SEWER PIPING LOCATED EXTERIOR TO THE BUILDING SHALL BE INSTALLED WITH THE FOLLOWING SLOPES.
 - INSTALL 4" AND SMALLER PIPE AT A MINIMUM OF 2% SLOPE.
 - INSTALL 6" AND LARGER PIPE AT A MINIMUM OF 1% SLOPE.
3. PIPING
- DOMESTIC COLD, AND HOT.
 - TYPE L HARD DRAWN COPPER TUBING, ASTM B-88 WITH WROUGHT BRONZE SOLDERED FITTINGS.
 - BALL VALVE: CRANE #932 OR EQUAL.
 - SANITARY SEWER AND VENTS.
 - SCHEDULE 40 PVC SOLID PLASTIC PIPE WITH DWV FITTINGS.
4. INSULATION:
- ALL INSULATIONS AND ACCESSORIES SHALL HAVE A FIRE HAZARD CLASSIFICATION WITH A FLAME SPREAD RATING OF NOT OVER 25, A FUEL CONTRIBUTION RATING OF NOT OVER 50, AND A SMOKE DEVELOPMENT RATING OF NOT OVER 50, IN ACCORDANCE WITH NFPA.
 - PIPE INSULATION (ABOVE GRADE):
 - THE PIPE INSULATION USED SHALL HAVE A THERMAL CONDUCTIVITY OF 0.27 BTU PER IN./HR*SQ-FT*F OR LESS.
 - FLEXIBLE CLOSED CELL ELASTOMERIC THERMAL INSULATION, UNSUT OR PRESUT WITH PRESSURE SENSITIVE ADHESIVE SYSTEM FOR CLOSURE AND VAPOR SEALING, EQUAL TO ARMSTRONG AP ARMAFLEX OR ARMAFLEX 2000.
 - INSULATION SCHEDULE:
 - DOMESTIC HOT WATER: 1"
5. TESTING, BALANCING AND CLEANING:
- ALL PIPING SHALL BE TESTED FOR LEAKS BEFORE BEING CONCEALED IN WALL CONSTRUCTION OR COVERED WITH INSULATION.
 - SEWER AND VENT PIPING SHALL BE HYDROSTATICALLY TESTED WITH NO LESS THAN 10 FEET OF HEAD FOR A PERIOD OF NOT LESS THAN 15 MINUTES, PER THE LOCAL PLUMBING CODE, WITH NO LEAKS.
 - DOMESTIC WATER PIPING SHALL BE HYDROSTATICALLY TESTED AT A PRESSURE OF NOT LESS THAN 1-1/2 TIMES THE OPERATING PRESSURE, BUT NOT LESS THAN 60 PSI, FOR A PERIOD OF NOT LESS THAN 2 HOURS, WITH NO LEAKS.

GENERAL NOTES

- DRAWINGS ARE DIAGRAMMATIC ONLY AND REPRESENT THE GENERAL SCOPE OF WORK. REVIEW THE GENERAL NOTES, SPECIFICATIONS AND PLANS FOR ADDITIONAL REQUIREMENTS THAT MAY NOT BE SPECIFICALLY CALLED OUT IN THIS PORTION OF THE CONSTRUCTION DOCUMENTS. NOTIFY ARCHITECT, ENGINEER AND/OR OWNER OF CONFLICTS OR DISCREPANCIES PRIOR TO SUBMISSION OF BID.
- COORDINATE INSTALLATION OF MECHANICAL SYSTEM WITH OTHER TRADES TO ENSURE A NEAT AND ORDERLY INSTALLATION AND AVOID CONFLICTS. INSTALL DUCTWORK AND PIPING AS TIGHT TO STRUCTURE AS POSSIBLE. COORDINATE INSTALLATION OF DUCTWORK AND PIPING TO AVOID CONFLICTS WITH ELECTRICAL PANELS, LIGHTING FIXTURES, ETC. VERIFY DUCT SPACE AVAILABLE ABOVE ALL CEILINGS PRIOR TO ANY FABRICATION OF INSTALLATION.
- ALL ROOF AND WALL PENETRATIONS SHALL BE COORDINATED WITH THE GENERAL CONTRACTOR. PROVIDE ALL REQUIRED SLEEVES, FLASHINGS, CURBS, REINFORCED ANGLES, SUPPORTING FRAMES, ETC. UNLESS THEY ARE SPECIFICALLY CALLED OUT TO BE FURNISHED BY OTHERS.
- THE ELECTRICAL SYSTEM DESIGN IS BASED IN PART ON THE SPECIFIED HVAC EQUIPMENT. IT IS THE RESPONSIBILITY OF THE CONTRACTOR TO COORDINATE THE ELECTRICAL REQUIREMENTS OF THE HVAC EQUIPMENT BEING FURNISHED. ANY CHANGES TO THE ELECTRICAL SYSTEM DUE TO HVAC EQUIPMENT OTHER THAN THE SPECIFIED EQUIPMENT BEING FURNISHED SHALL BE PROVIDED AT NO ADDITIONAL COST TO THE OWNER.

KEYED PLAN NOTES


- CEILING MOUNT EXHAUST FAN WITH 4"Ø DUCT UP THROUGH ROOF. DUCT SHALL TERMINATE 16" ABOVE ROOF WITH WEATHERPROOF RAIN CAP. SEAL ROOF PENETRATION WEATHER TIGHT.
- 6"Ø PVC EXHAUST DUCT UP THROUGH ROOF. DUCT SHALL TERMINATE 16" ABOVE ROOF WITH PVC WEATHER CAP.
- 6"Ø PVC EXHAUST DUCT DOWN. TERMINATE EXHAUST DUCT 12" A.F.F. COVER OPENING WITH 1/4"x1/4" WIRE MESH SCREEN. COORDINATE LOCATION WITH POOL CONSULTANT.
- LOUVERED DOOR BY GENERAL CONTRACTOR.

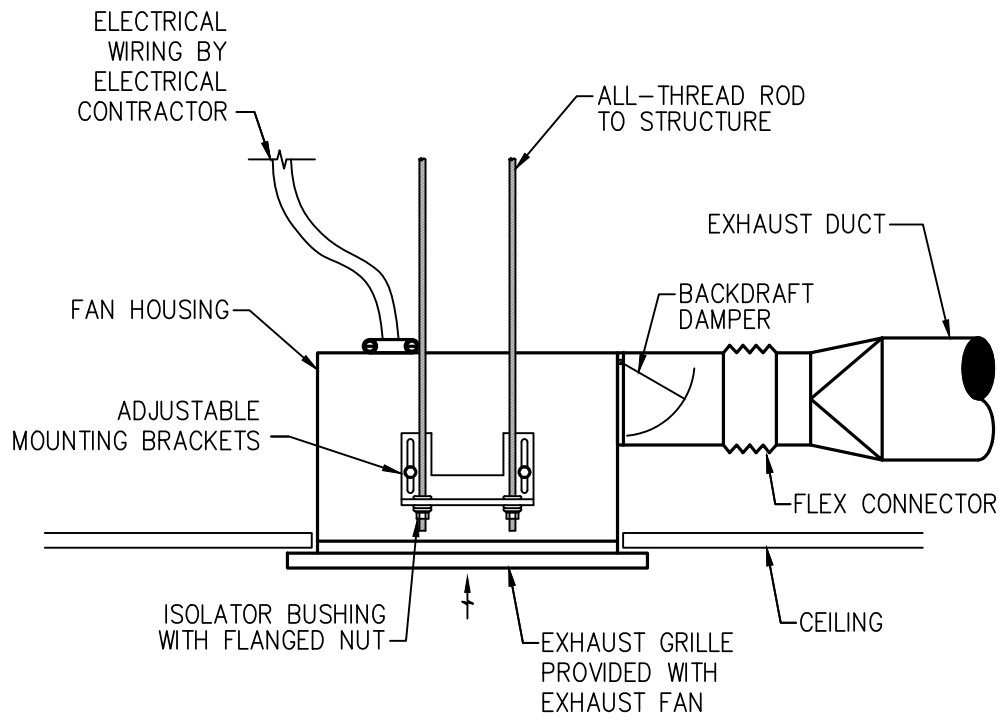

CEILING MOUNTED EXHAUST FAN

SCALE : NO SCALE


3

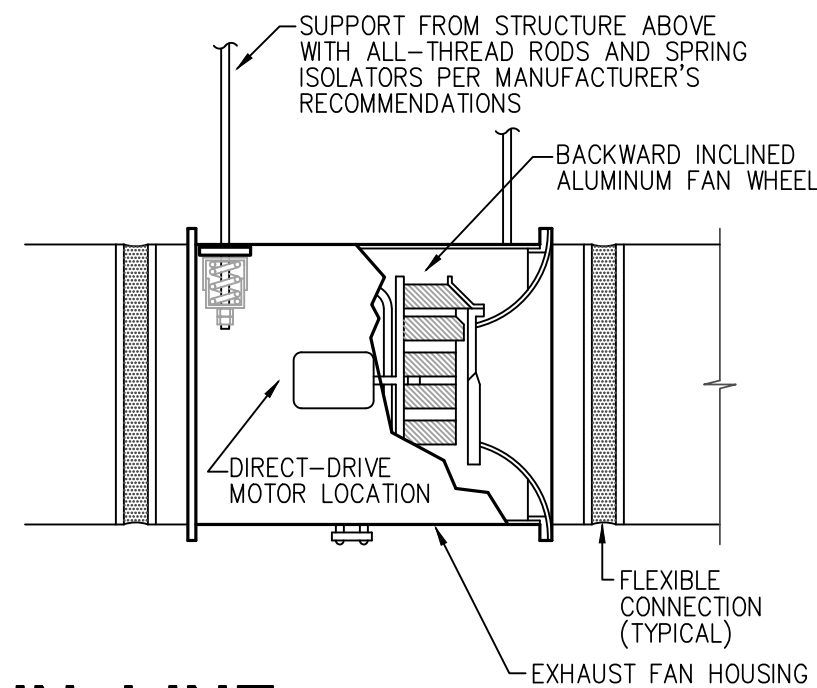

IN-LINE EXHAUST FAN

SCALE : NO SCALE


2

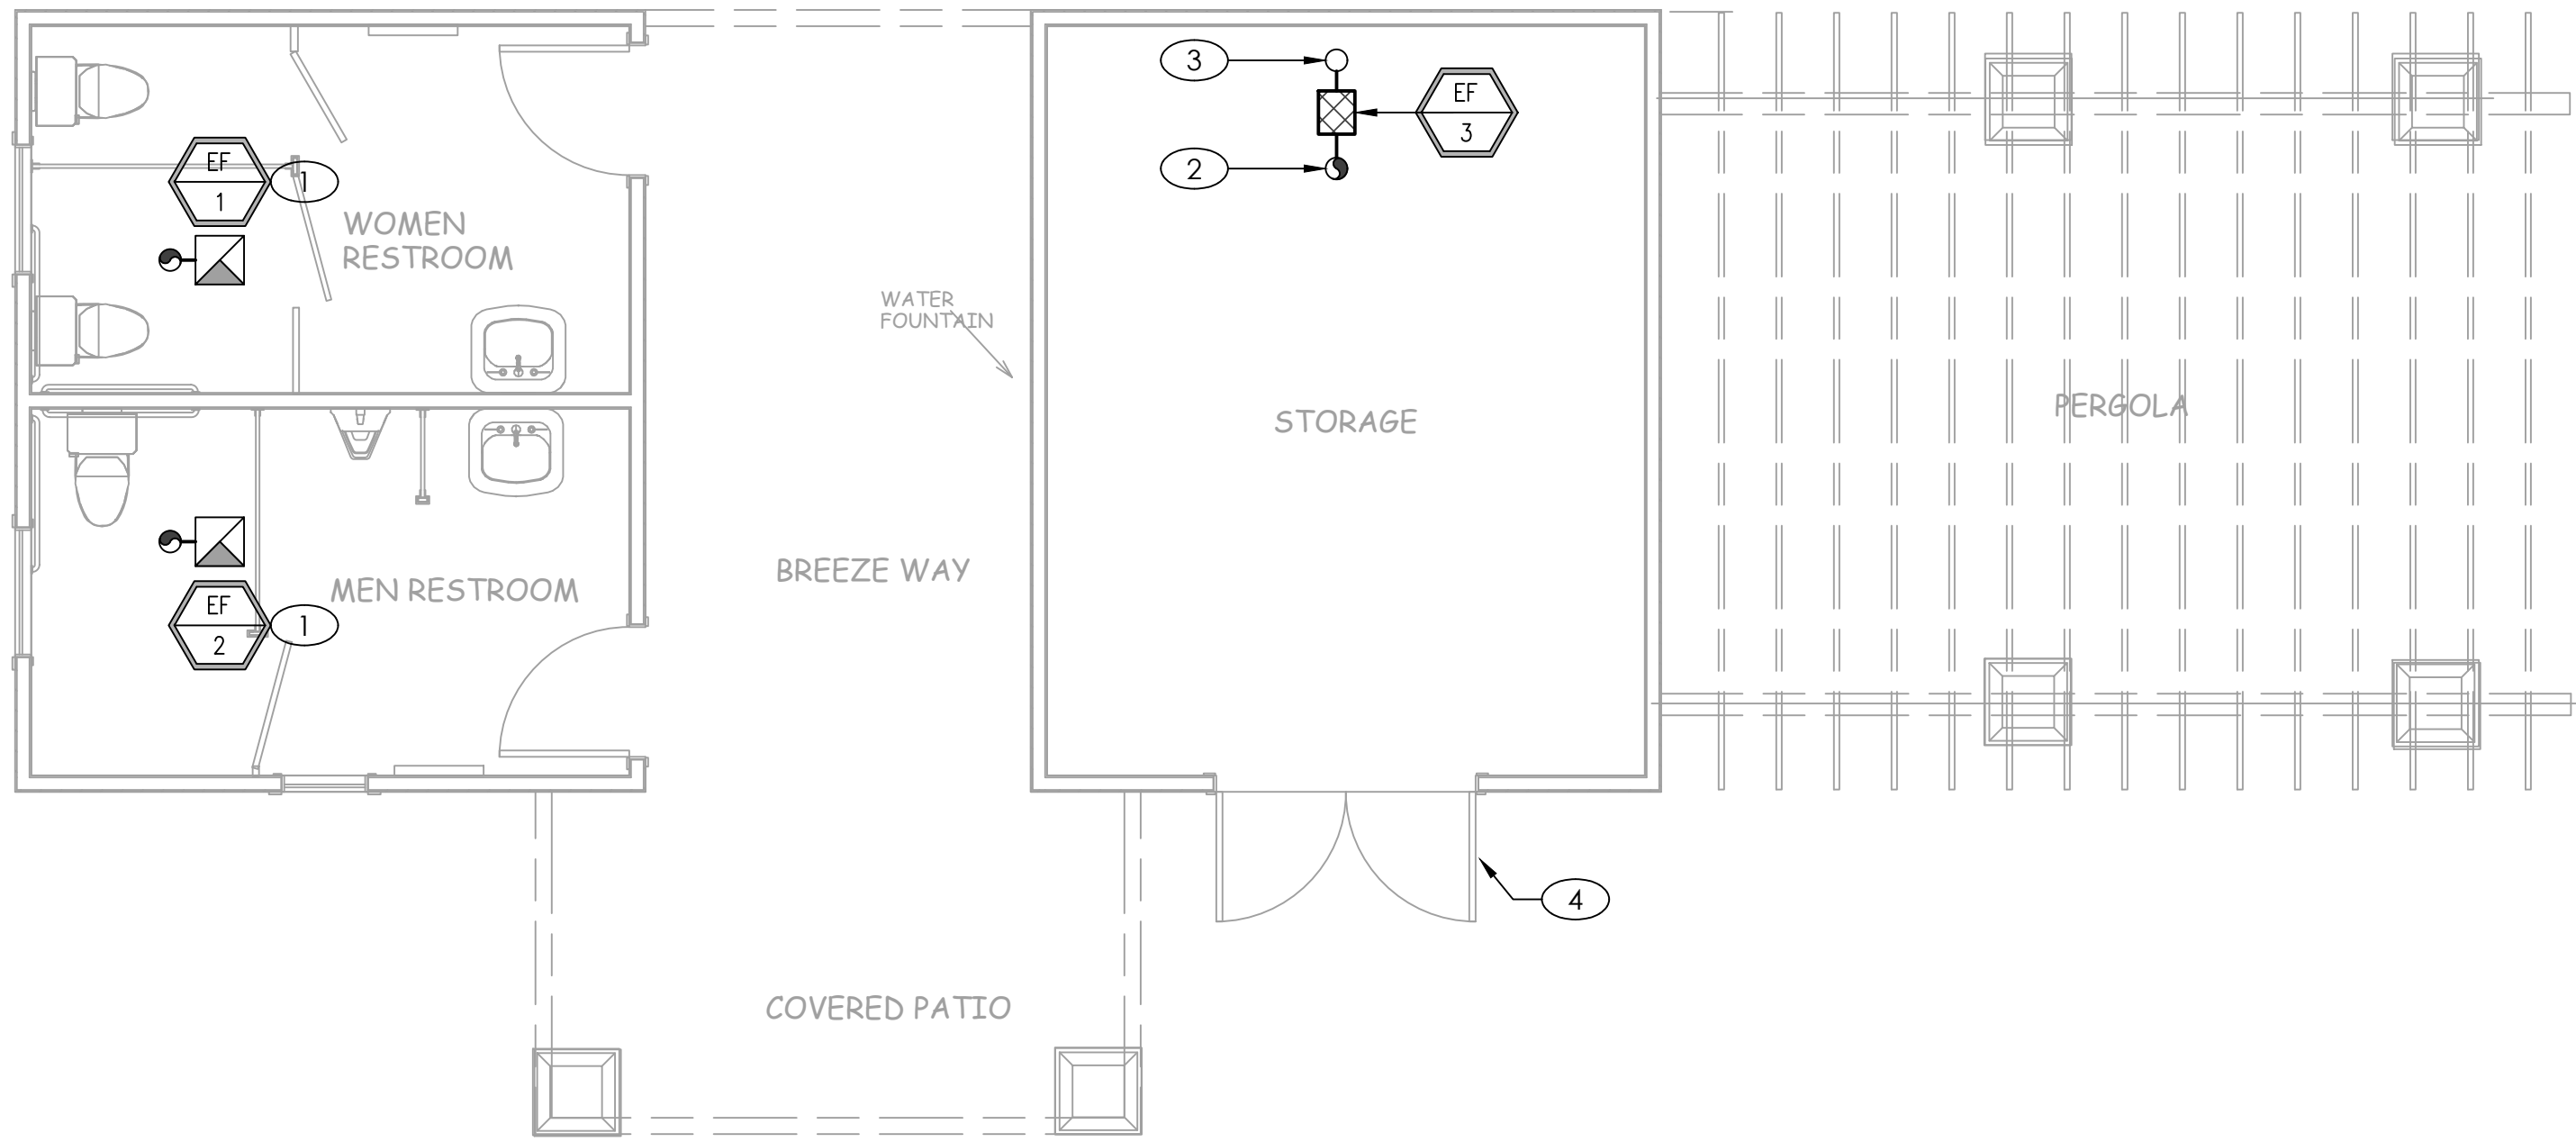

MECHANICAL PLAN

SCALE: 1/4" = 1'-0"

1

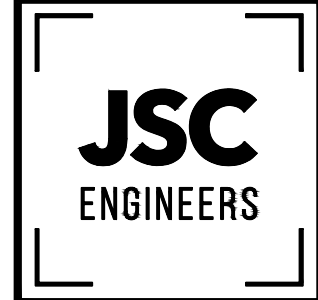

MO CDA NO. 2010000786 / KS CDA NO. E-2818
1926 CENTRAL ST. SUITE #201
KANSAS CITY, MO 64108
phone: (816) 272-8289
email: jsmothers@jscengineers.com



PROJECT
POOL HOUSE STRUCTURE
LEE'S SUMMIT, MO

REVISIONS:	DATE	DESCRIPTION
1		
2		
3		
4		
5		

Copyright 2021
JSC Engineers

ISSUED:

PERMIT

SHEET TITLE:

**MECHANICAL PLAN
AND
SPECIFICATIONS**

DATE: 05.20.2022

JOB NO.: 22-133

SHEET:

MP1.1

7

6

5

4

3

2

1

E


D

C

B

A


PLUMBING FIXTURE SCHEDULE	
LAV	HANDICAP ACCESSIBLE WALL MOUNT LAVATORY WITH CARRIER, PROFLO MODEL PF5411WH, VITREOUS CHINA, WHITE, SELF-RIMMING COUNTER TOP, PROFLOW PFWS3006 ADA COMPLIANT FAUCET, SS FLEX SUPPLY RISERS WITH CHROME PLATED STOP VALVES, P-TRAP WITH CLEANOUT AND ESCUTCHEONS. INSULATE WITH "HANDI-LAV-GUARD" MODEL 102, OR EQUAL.
WC	FLOOR-MOUNTED ADA WATER CLOSET: PROFLO MODEL PF1503WH, HANDICAP ACCESSIBLE, VIREOUS CHINA, 1.28 GPF, ELONGATED BOWL, FLOOR MOUNTED, WHITE, VITREOUS CHINA TANK AND COVER CONTAINING FLUSHOMETER/TANK WITH BUILT-IN PRESSURE REGULATOR AND BACKFLOW PREVENTER, WHITE OPEN FRONT SEAT, CHROME STOPS, C.P. FLEXIBLE RISER TUBE, BOLT CAPS, AND ESCUTCHEON
FD	FLOOR DRAIN: SOUX CHIEF 842-3PNR, FLOOR DRAIN, PVC BODY AND CLAMPING COLLAR, ADJUSTABLE 5-1/2" ROUND NICKEL BRONZE STRAINER. PROVIDE WITH PROSET SYSTEMS "TRAP GUARD" INSERT FOR ACTUAL FLOOR DRAIN MODEL AND SIZE PROVIDED.
FS	FLOOR SINK, JOSAM 49420-LF-NB SERIES SQUARE CAST IRON 12-1/4" DEEP SUPER FLO-SEPTOR® FLOOR SINK WITH ACID-RESISTING INTERIOR, BOTTOM OUTLET, ALUMINUM INTERNAL DOME STRAINER, NIKALOY SANITARY SLOPED RIM AND NIKALOY, LIGHT-DUTY, ANTI-TILTING, SUPER-FLO® GRATE. 16x16 SQUARE TOP, 4" OUTLET.
DF	DRINKING FOUNTAIN. ELKAY EZH2O. ELECTRIC WATER COOLER WITH BOTTLE FILLING STATION. ADA COMPLIANT. COLOR BY OWNER/ARCHITECT. MOUNT AT HEIGHT DETERMINED BY ARCHITECT. 115V/1PH, 4.2 FLA, 370 WATTS, 71 LBS.
RPZ1	REDUCED PRESSURE ZONE BACKFLOW PREVENTER: 1", WATTS # LF009QT, MEETING ASSE 1013, LEAD FREE CAST BRONZE BODY, QUARTER TURN TESTING COCKS, QUARTER TURN BALL VALVES, AND # 909AG AIR GAP FITTING.
RPZ2	REDUCED PRESSURE ZONE BACKFLOW PREVENTER: 3/4", WATTS # LF009QT, MEETING ASSE 1013, LEAD FREE CAST BRONZE BODY, QUARTER TURN TESTING COCKS, QUARTER TURN BALL VALVES, AND # 909AG AIR GAP FITTING.
FPWH	FREEZE-PROOF WALL HYDRANT: PRIER PRODUCTS #C-6341, 3/4" FPT INET, 3/4" THREADED HOSE CONNECTION, LOOSE KEY HANDLE HYDRANT LENGTH AS REQUIRED FOR INSTALLED WALL THICKNESS, ADJUSTABLE WALL CLAMP, BRASS BOX WITH SATIN NICKEL PLATED FINISH AND INTEGRAL ASSE 1052 DOUBLE CHECK VACUUM BREAKER.
UR1	URINAL: SLOAN WEUS1000.1001, WHITE, VITREOUS CHINA, WASHOUT WALL URINAL, 0.1 GALLONS PER FLUSH, 27"H X 17"W, FURNISH WITH FLUSHOMETER, VANDAL RESISTANT CHROME PLATED HOUSING, ADJUSTABLE TAILPIECE AND VANDAL RESISTANT OUTLET STRAINER. MOUNT NON-ADA AT 24" FROM FINISHED FLOOR, MOUNT ADA URINAL 17" FROM FINISHED FLOOR. TRIM: SUITABLE CARRIER WITH STANCHIONS TO FLOOR.
EW1	ELECTRIC WATER HEATER, EEMAX, MODEL SP2412, 2.4KW, 20 AMP, 110 VOLT, POINT OF USE WATER HEATER. SET HW SUPPLY TEMP SET TO 110F.
EW2	ELECTRIC WATER HEATER, EEMAX, MODEL SP2412, 2.4KW, 20 AMP, 110 VOLT, POINT OF USE WATER HEATER. SET HW SUPPLY TEMP SET TO 110F.

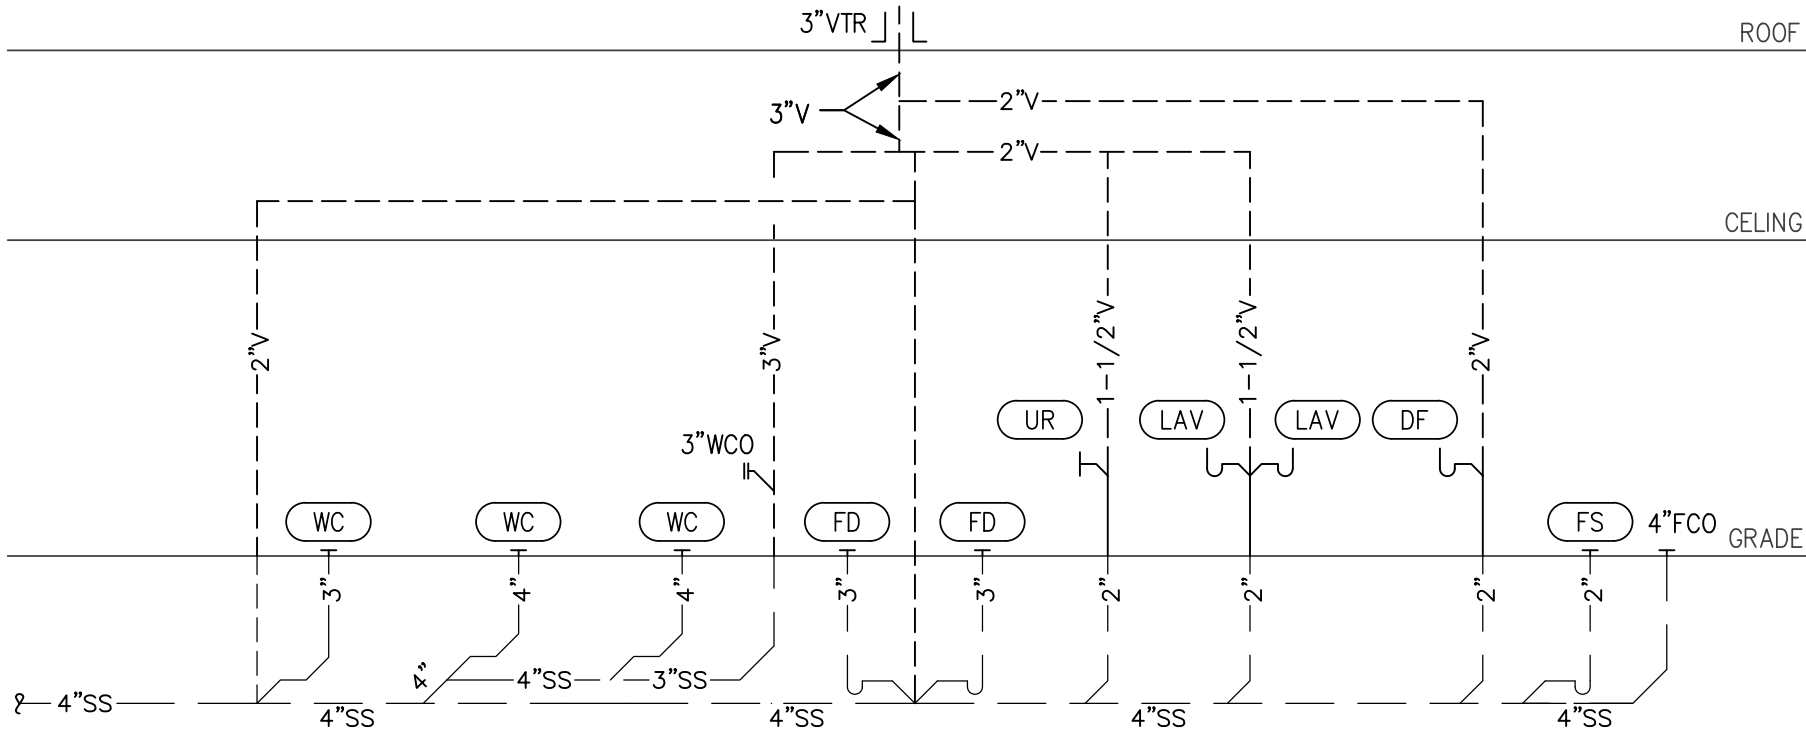

PLUMBING RISER DIAGRAM

SCALE : NO SCALE


3

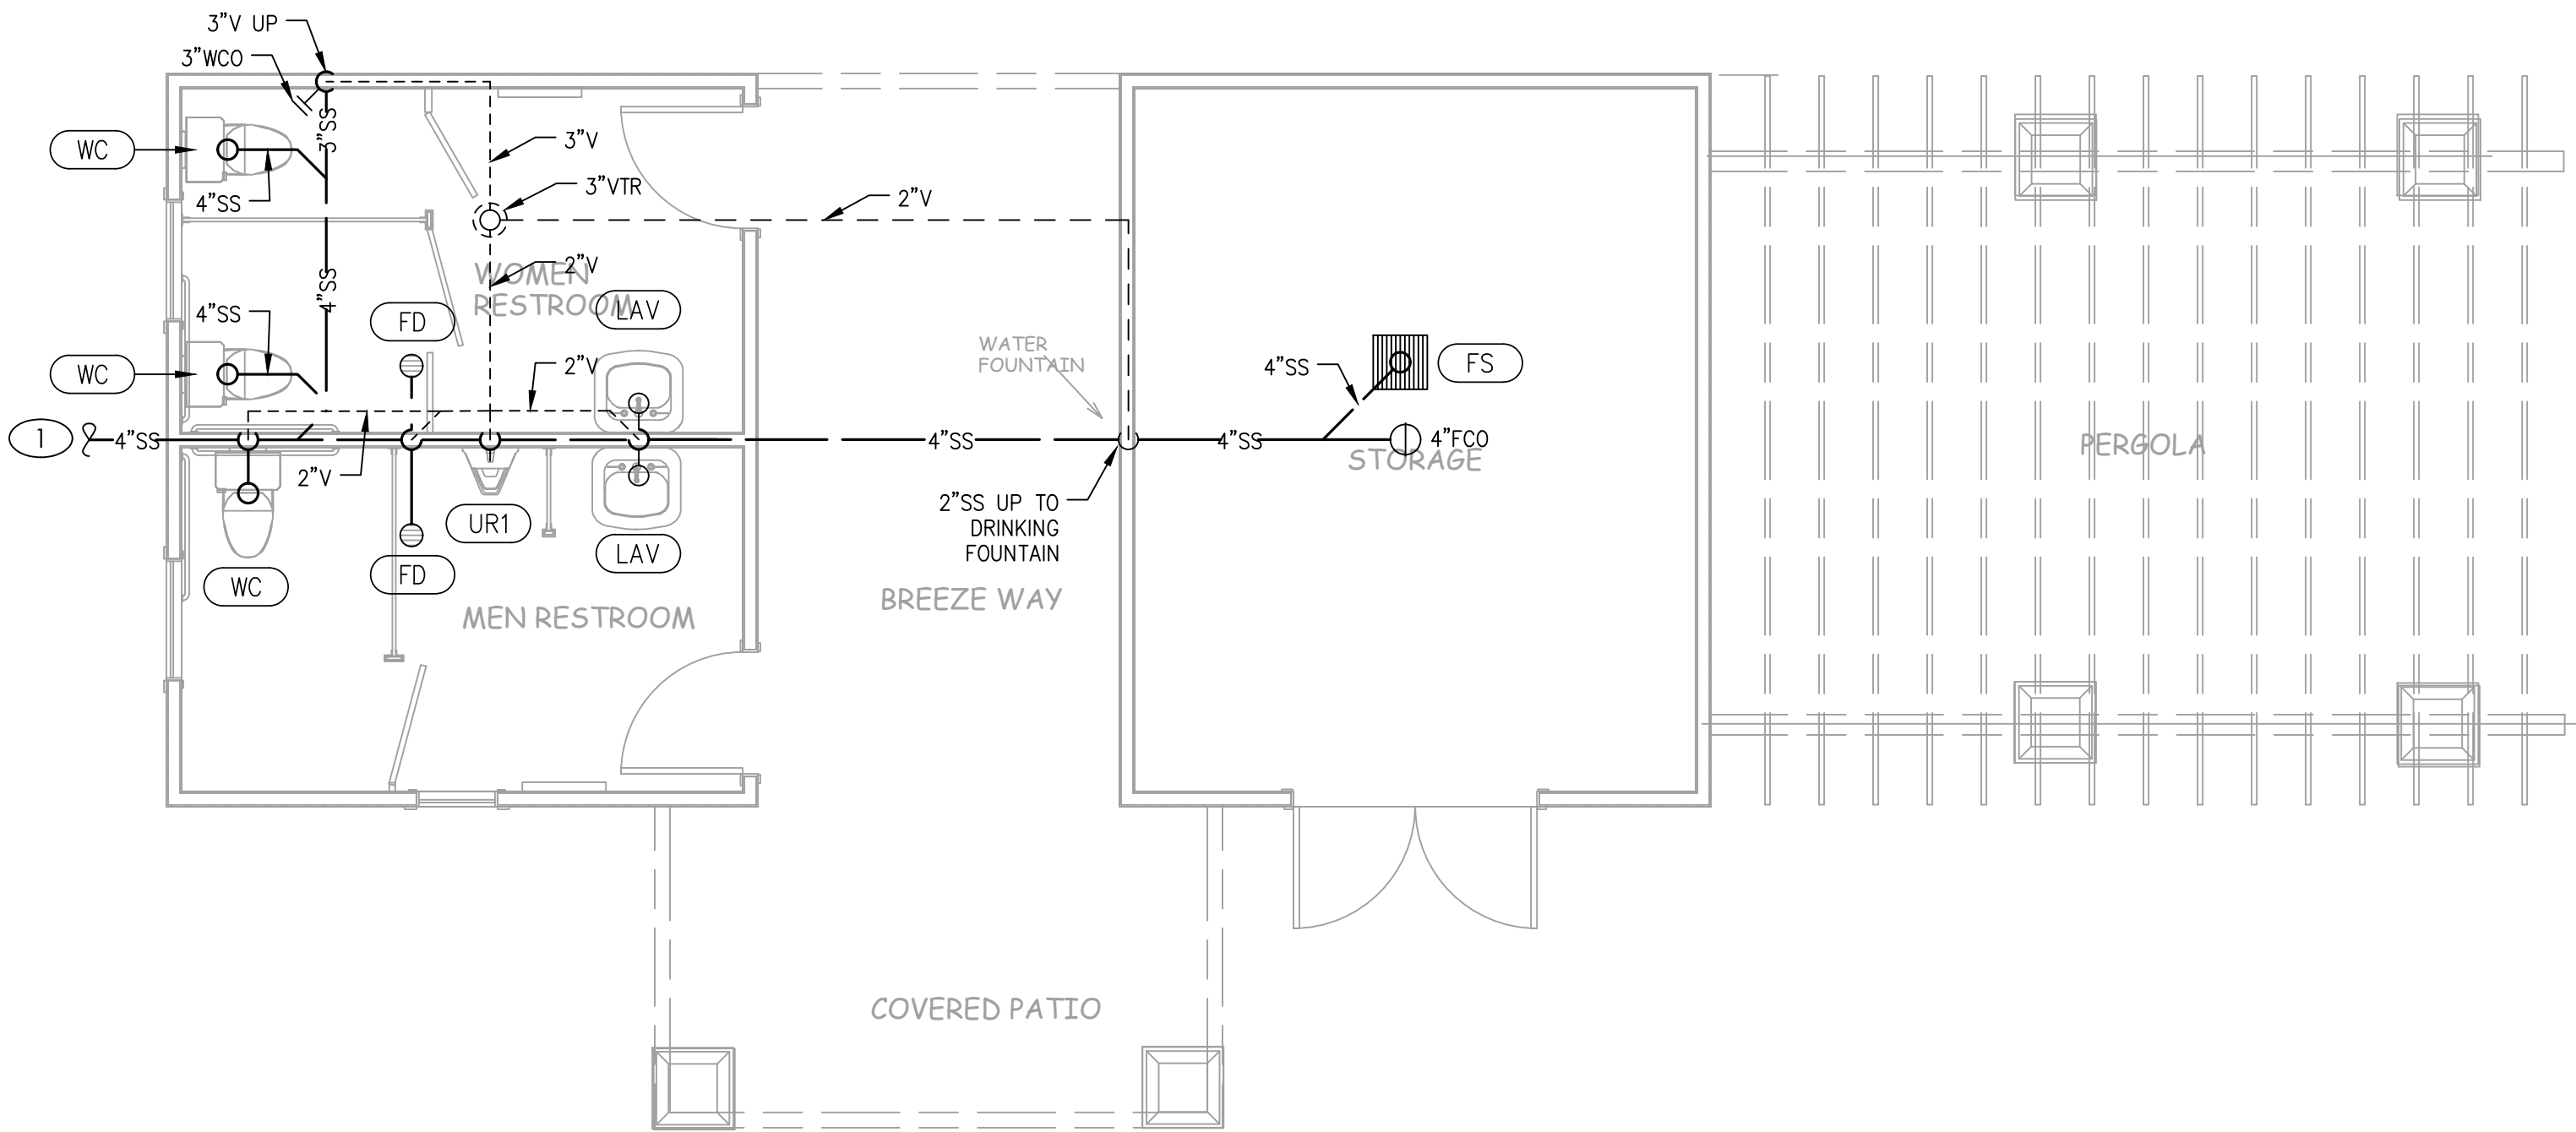

WASTE & VENT PLAN

SCALE: 1/4" = 1'-0"


2

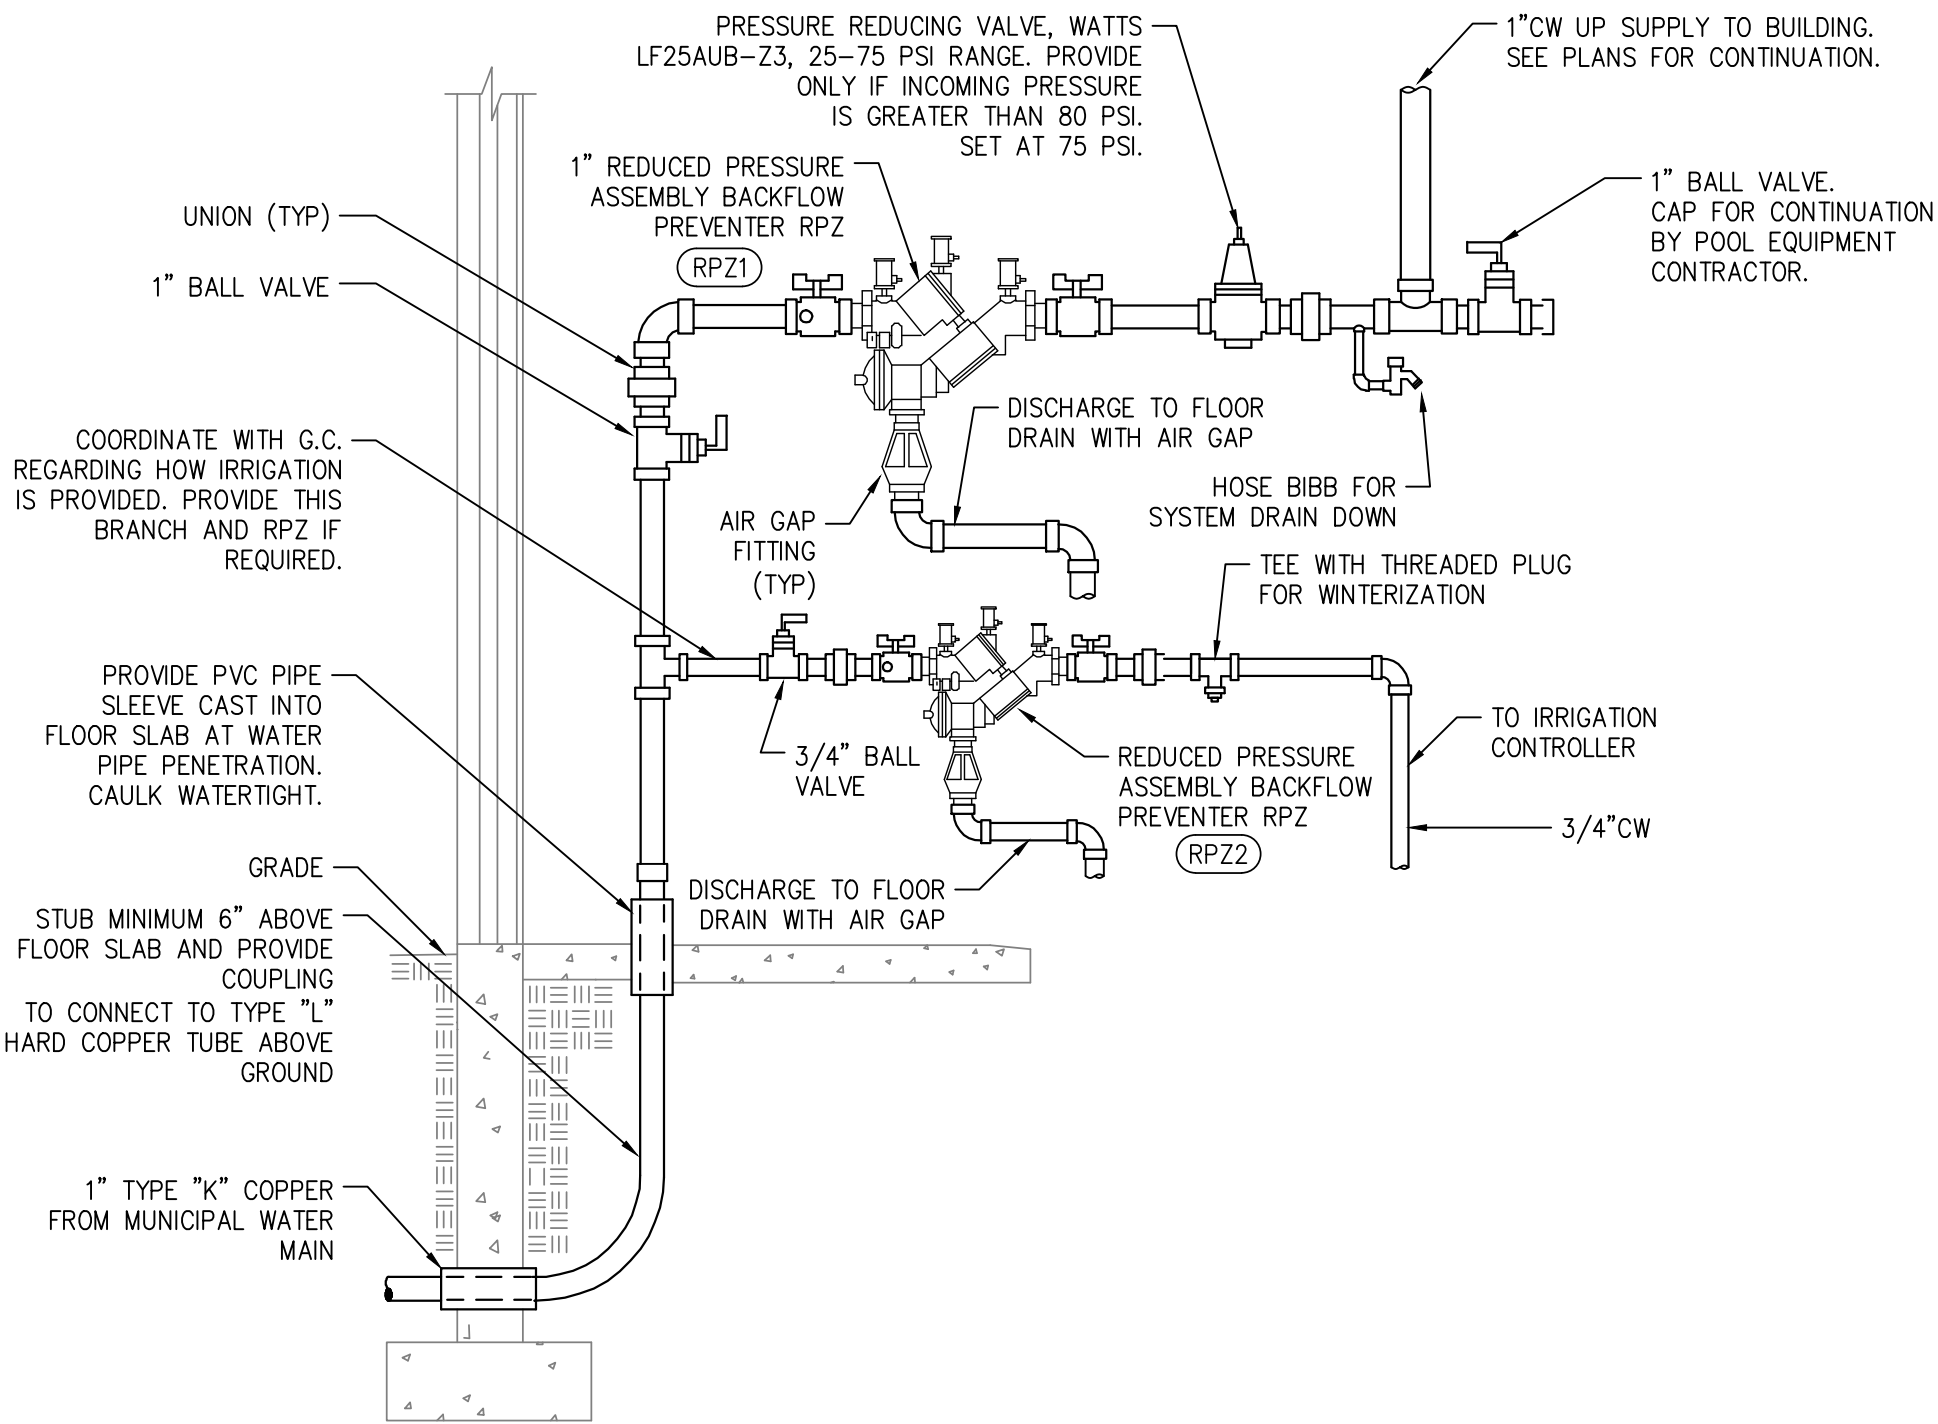

DOMESTIC WATER ENTRY

SCALE : NONE

4

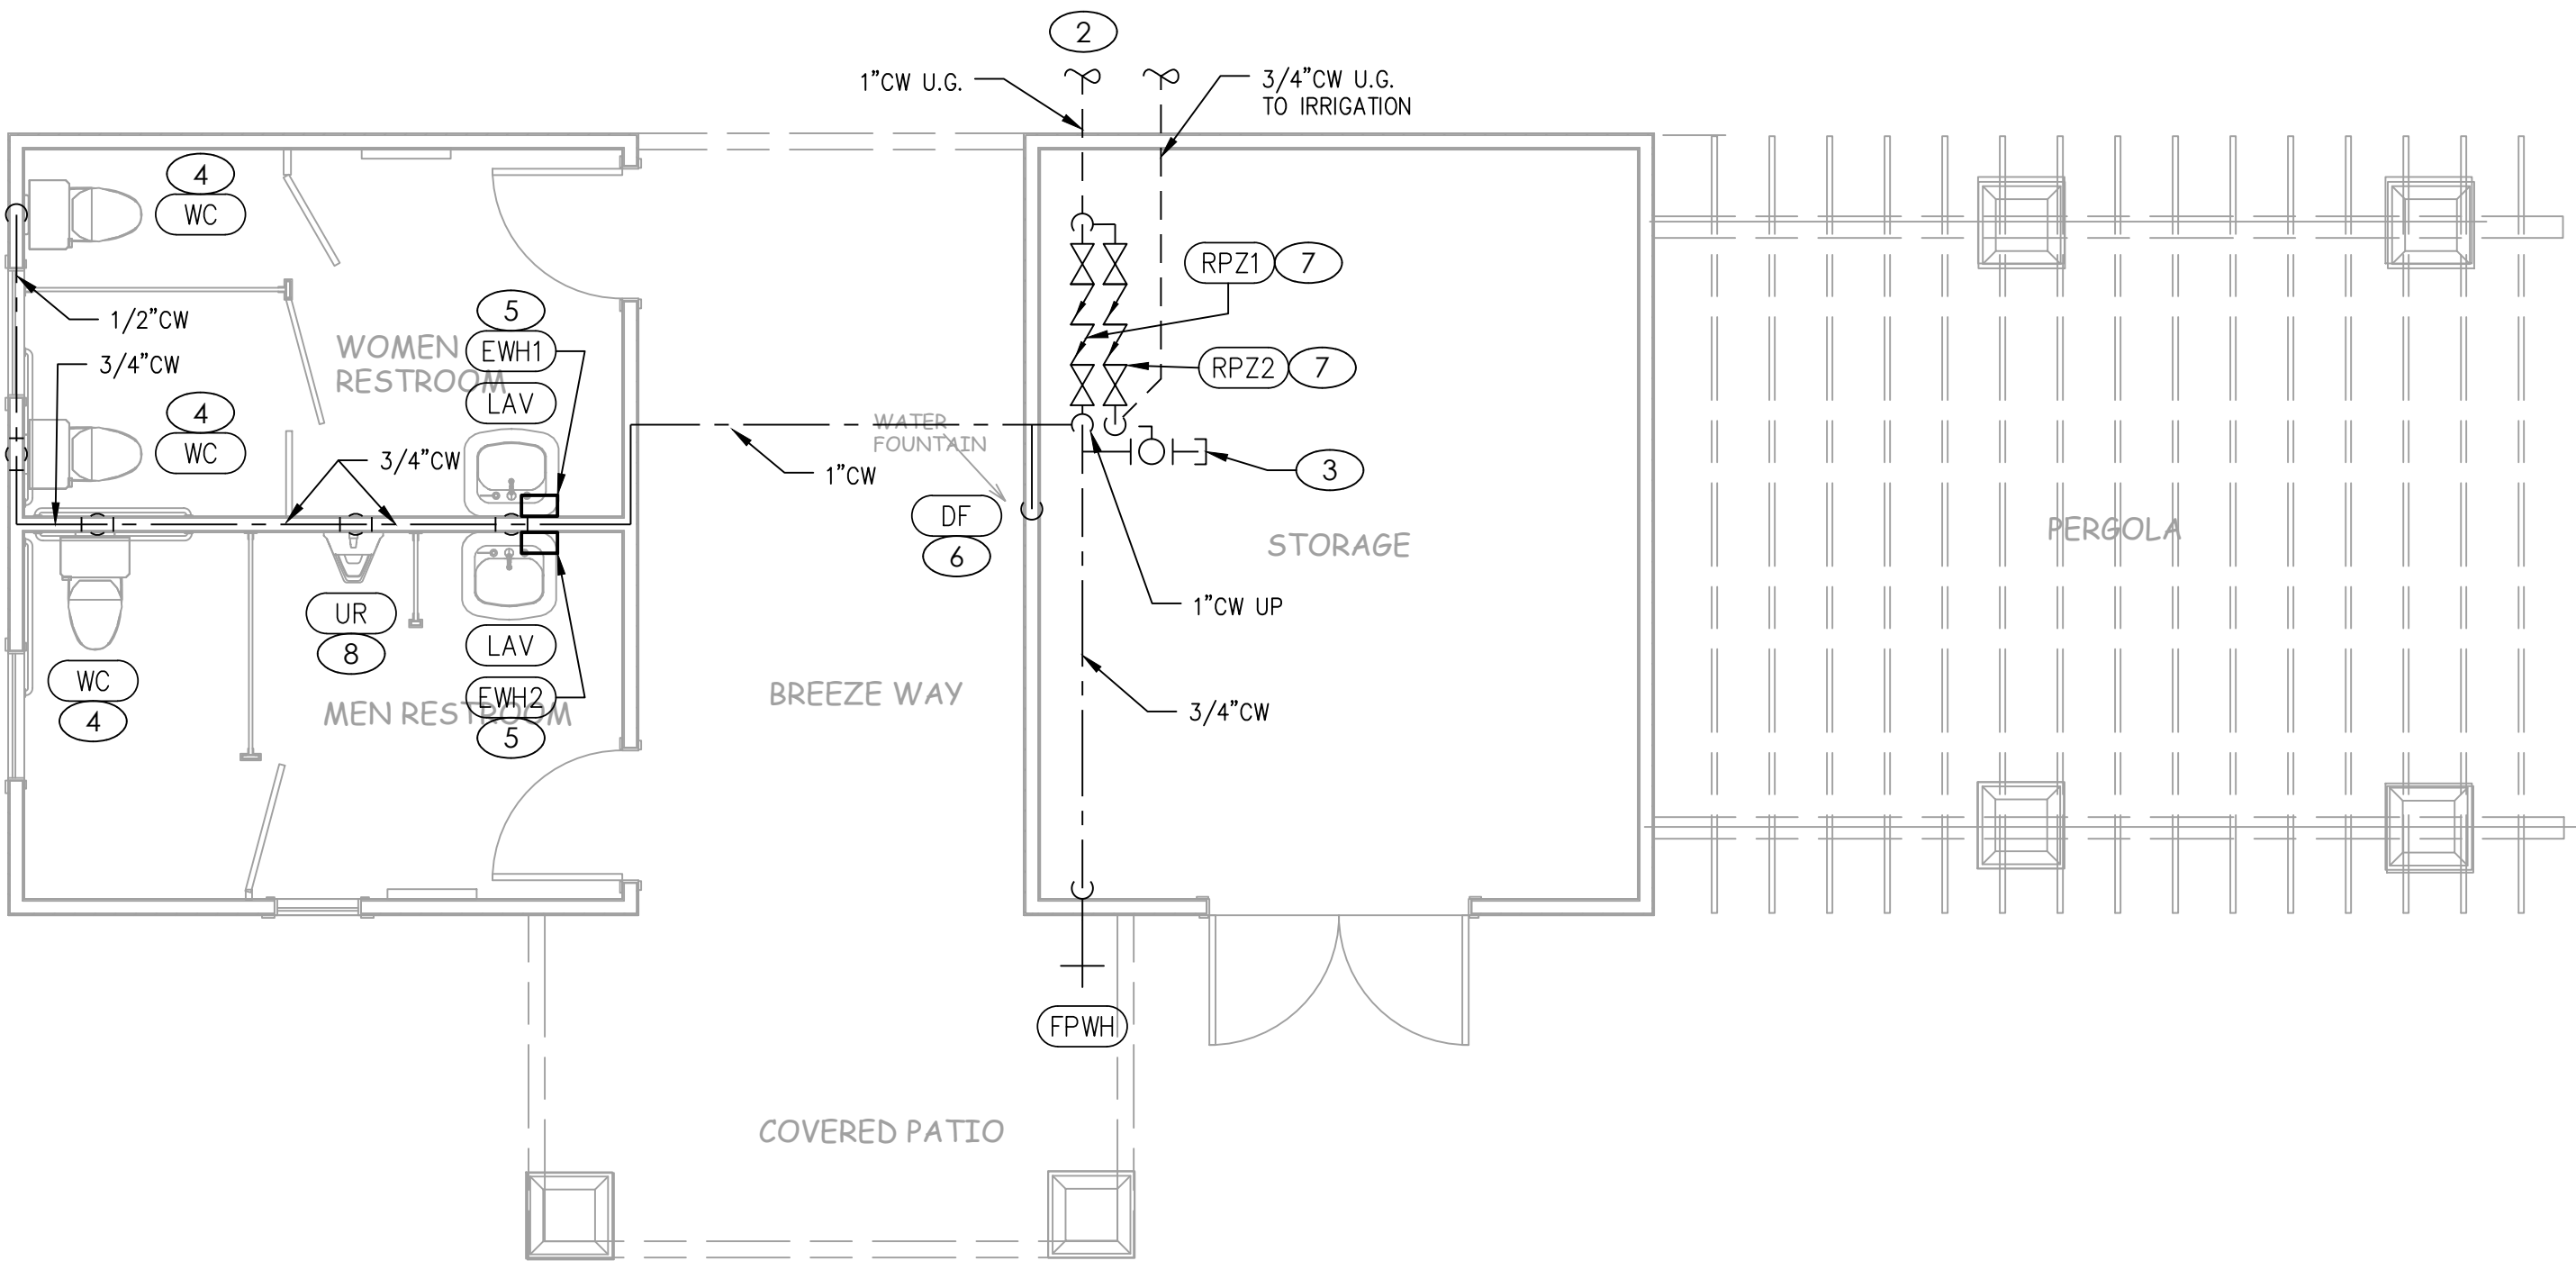

WATER PLAN


SCALE: 1/4" = 1'-0"

1




KEYED PLAN NOTES

- 4" SANITARY TO UTILITY SERVICE. CONTRACTOR SHALL WORK WITH LOCAL WASTE WATER AUTHORITY FOR INSTALLATION OF A NEW SEWER LINE CONNECTING INTO THE SEWER MAIN FOR A COMPLETE INSTALLATION. REFER TO CIVIL PLANS FOR CONTINUATION. COORDINATE INVERT ELEVATION WITH SITE CIVIL CONTRACTOR PRIOR TO START OF WORK.
- 1" DOMESTIC COLD WATER TO UTILITY SERVICE. CONTRACTOR SHALL WORK WITH THE WATER COMPANY FOR THE INSTALLATION OF A NEW WATER MAIN ENTRANCE, INCLUDING TAP, METER, METER PIT, PIPING, ETC. FOR A COMPLETE INSTALLATION. REFER TO CIVIL PLANS FOR CONTINUATION.
- 1" CW VALVED AND CAPPED FOR FUTURE USE BY POOL EQUIPMENT.
- 1/2" CW TO WATER CLOSET.
- 1/2" CW DOWN IN WALL. PROVIDE 1/2" CW TO LAV AND 1/2" CW TO INSTANTANEOUS WATER HEATER UNDER SINK. CONTINUE WITH 1/2" HW TO LAV. SET HW SUPPLY TEMPERATURE TO 110F.
- 1/2" CW TO DRINKING FOUNTAIN.
- COORDINATE PLACEMENT OF RPZ WITH POOL CONSULTANT PRIOR TO INSTALLATION. ALSO COORDINATE WITH ELECTRICAL CONTRACTOR. DO NOT ROUTE PIPING ABOVE OR WITHIN WORKING SPACE OF ELECTRICAL PANEL.
- 3/4" CW DOWN TO URINAL.

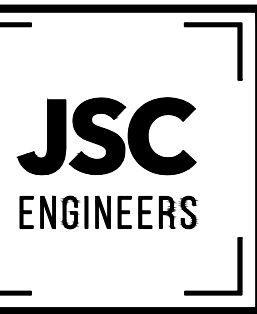

MO COA NO. 2012000786 / KS COA NO. E-2818
1925 CENTRAL ST. SUITE #201
KANSAS CITY, MO 64108
phone: (816) 272-8289
email: jsmothers@jscengineers.com

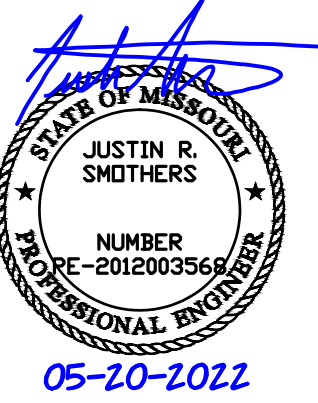

POOL HOUSE STRUCTURE
LEE'S SUMMIT, MO

PROJECT:

REVISIONS:	DATE	DESCRIPTION
1		
2		
3		
4		
5		

Copyright 2021
JSC Engineers

ISSUED:

PERMIT

SHEET TITLE:

PLUMBING PLANS

DATE: 05.20.2022

JOB NO.: 22-133

SHEET:

MP1.2

ELECTRICAL SPECIFICATIONS

PART I – GENERAL

A. CONDITIONS

- FURNISH AND INSTALL A COMPLETELY WIRED AND OPERATIONAL ELECTRICAL SYSTEM AS SHOWN ON THE DRAWINGS AND SPECIFIED HEREIN, INCLUDING BUT NOT LIMITED TO, THESE MAJOR ITEMS.
A. LIGHTING FIXTURES AS INDICATED AND SPECIFIED ON THE PLANS.
B. ELECTRICAL PANELS, SERVICE, CONDUIT, WIRING, ETC., FOR ALL OUTLETS AND EQUIPMENT.
C. TELEPHONE, TELEVISION, AND FIRE ALARM. OUTLETS AND CONDUIT AS INDICATED.
- OBTAIN AND REVIEW ALL OTHER DRAWINGS INCLUDING REFLECTED CEILING PLAN, INTERIOR AND EXTERIOR ELEVATIONS, FURNITURE PLANS AND ALL MILL WORK DRAWINGS. COORDINATE INSTALLATION OF ALL ELECTRICAL DEVICES AND EQUIPMENT PRIOR TO ROUGH-IN.
- OBTAIN SUBMITTAL AND SHOP DRAWINGS FROM OTHER TRADES AND EQUIPMENT TO COORDINATE INSTALLATION ACCORDINGLY.
- INSTALLATION SHALL COMPLY WITH ALL CURRENT APPLICABLE CODES AND GOVERNING AGENCIES HAVING JURISDICTION.
- FIRE ALARM SYSTEM, IF REQUIRED PER IBC, SHALL BE DESIGN-BUILD BY OWNER'S/OC'S FIRE ALARM CONTRACTOR. DESIGN SHALL BE IN ACCORDANCE WITH NFPA 72. FIRE ALARM CONTRACTOR SHALL SUBMIT STAMPED DRAWINGS TO AHJ FOR REVIEW AND APPROVAL. FIRE ALARM CONTRACTOR IS RESPONSIBLE FOR TESTING AND VERIFYING THAT THE AUDIBILITY OF THE FIRE ALARM SYSTEM MEETS A MINIMUM OF 15 DBA ABOVE AMBIENT NOISE LEVELS. ADD HORNS WHERE REQUIRED TO MAINTAIN MINIMUM LEVELS.
- PROVIDE FIRE STOP ON ALL PIPING THAT PENETRATES RATED WALLS. METHOD OF FIRE STOP SHALL MEET WALL RATING. REFER TO ARCHITECTURAL DRAWINGS FOR LOCATION OF FIRE RATED WALLS. THIS CONTRACTOR SHALL PROVIDE FIRE RATED ENCLOSURES AROUND ALL ROUGH-IN BOXES, PANELS, ETC. THAT ARE LOCATED IN FIRE RATED WALLS AND SHALL FIRE CAULK ALL OPENINGS IN RATED ASSEMBLIES.

B. RELATED WORK BY OTHERS

- THE ELECTRICAL CONTRACTOR SHALL PROVIDE CONDUIT, TRENCH, AND BACKFILL FOR ELECTRICAL SERVICE ENTRANCE FROM THE MAIN SERVICE TO UTILITY POINT OF ELECTRICAL SERVICE. ELECTRICAL CONTRACTOR SHALL COORDINATE THE INSTALLATION OF THE ELECTRICAL SERVICE ENTRANCE WITH SERVING UTILITY COMPANY.
- THE ELECTRICAL CONTRACTOR SHALL PROVIDE CONDUIT, TRENCH, AND BACKFILL FOR PRIMARY PHONE AND CATV SERVICE FROM THE TELEPHONE TERMINAL BOARD OR CABINET TO THE PHONE COMPANY AND CATV COMPANY POINT OF SERVICE COORDINATE WITH LOCAL UTILITY COMPANIES.

C. CODES, REGULATIONS, AND STANDARDS

- THE INSTALLATION SHALL COMPLY WITH APPLICABLE LOCAL AND STATE CODES AND ORDINANCES, WITH THE REGULATIONS OF THE LATEST EDITION OF THE NATIONAL ELECTRIC CODE AND WITH THE REQUIREMENTS OF THE POWER, TELEPHONE, AND CATV COMPANIES FURNISHING SERVICES TO THIS INSTALLATION.
- THE LATEST EDITIONS OF THE FOLLOWING INDUSTRY STANDARDS, SPECIFICATIONS, AND CODES ARE MINIMUM REQUIREMENTS:
A. THE NATIONAL ELECTRICAL MANUFACTURER'S ASSOCIATION STANDARDS.
B. THE NATIONAL ELECTRICAL CODE, INCLUDING LOCAL AMENDMENTS.
C. UNDERWRITER LABORATORIES INCORPORATED STANDARDS.
D. AMERICAN NATIONAL STANDARDS INSTITUTE.
E. INTERNATIONAL BUILDING CODE.

D. INSPECTION OF SITE

- PRIOR TO SUBMITTING A BID FOR ELECTRICAL WORK, THE CONTRACTOR SHALL VISIT THE SITE OF THE PROPOSED CONSTRUCTION AND SHALL THOROUGHLY ACQUAINT HIMSELF WITH EXISTING UTILITIES, AND WORKING CONDITIONS TO BE ENCOUNTERED, ETC. ALLOWANCE WILL NOT BE MADE FOR NONCOMPLIANCE WITH THIS CONDITION AFTER BIDDING.
- ELECTRICAL INSTALLATION SHALL MEET THE EXISTING CONDITIONS.

E. STORAGE AND HANDLING OF MATERIAL

- DELIVER MATERIALS AND EQUIPMENT TO THE PROJECT IN THE MANUFACTURER'S ORIGINAL, UNOPENED, LABELED CONTAINERS. PROTECT AGAINST MOISTURE, TAMPERING, OR DAMAGE FROM IMPROPER HANDLING OR STORAGE. CONTRACTOR SHALL PROTECT AND BE RESPONSIBLE FOR ANY DAMAGE TO WORK OR MATERIALS UNTIL FINAL ACCEPTANCE BY THE OWNER, AND SHALL MAKE GOOD WITHOUT COST TO THE OWNER, ANY DAMAGE OR LOSS THAT MAY OCCUR DURING THIS PERIOD.
- ARRANGE FOR TIMELY DELIVERY OF MATERIALS AND EQUIPMENT TO THE JOB SITE IN ORDER TO MINIMIZE THE LENGTH OF TIME BETWEEN DELIVERY AND INSTALLATION.
- COVER AND PROTECT ANY MATERIAL WHICH MAY BE AFFECTED BY THE WEATHER WHILE IN TRANSIT OR STORED AT THE PROJECT SITE. ANY MATERIAL FOUND DEFECTIVE OR NOT INSTALLED IN ACCORDANCE WITH THE CONTRACT DOCUMENTS MAY BE REJECTED BY THE ENGINEER.

F. CLEANUP

- KEEP THE PREMISES FREE FROM ACCUMULATION OF WASTE MATERIALS, OR RUBBISH CAUSED BY EMPLOYEES OR WORK UNDER THIS DIVISION OF THE SPECIFICATIONS. AT THE COMPLETION OF THE WORK REMOVE ALL SURPLUS MATERIALS, TOOLS, ETC., AND LEAVE THE PREMISES BROOM-CLEAN.

G. EXCAVATION, CUTTING, AND FITTING

- PERFORM ALL EXCAVATION AND BACK FILLING REQUIRED FOR WORK PERFORMED UNDER THIS DIVISION OF THE SPECIFICATIONS. USE EXCAVATED MATERIALS FOR BACKFILL UNLESS OFF SITE MATERIALS ARE DEEMED NECESSARY.
- PERFORM THE EXCAVATION, CUTTING, FITTING, REPAIRING, AND FINISHING OF THE WORK NECESSARY FOR THE INSTALLATION OF THE EQUIPMENT OF THIS SECTION. HOWEVER, NO CUTTING OF THE WORK OF OTHER TRADES OR OF ANY STRUCTURAL MEMBERS SHALL BE DONE WITHOUT THE CONSENT OF THE ARCHITECT.

H. DRAWINGS

- THE DRAWINGS INDICATE THE GENERAL ARRANGEMENT AND LOCATIONS OF THE ELECTRICAL WORK DATA PRESENTED ON THESE DRAWINGS ARE AS ACCURATE AS PLANNING CAN DETERMINE, BUT FIELD VERIFICATION OF ALL DIMENSIONS, LOCATIONS, LEVELS, ETC., TO SUIT FIELD CONDITIONS IS REQUIRED. REVIEW ALL ARCHITECTURAL, STRUCTURAL, AND MECHANICAL DRAWINGS AND ADJUST ALL WORK TO MEET THE REQUIREMENTS OF CONDITIONS SHOWN. THE ARCHITECTURAL DRAWINGS SHALL TAKE PRECEDENCE OVER ALL OTHER DRAWINGS. DISCREPANCIES BETWEEN DIFFERENT PLANS, OR BETWEEN DRAWINGS AND SPECIFICATIONS, OR REGULATIONS AND CODES GOVERNING THE INSTALLATION SHALL BE BROUGHT TO THE ATTENTION OF THE ENGINEER IN WRITING BEFORE THE DATE OF BID OPENING. IF DISCREPANCIES ARE NOT REPORTED, THE CONTRACTOR SHALL BID THE GREATER QUANTITY OR BETTER QUALITY, AND APPROPRIATE ADJUSTMENTS WILL BE MADE AFTER CONTRACT AWARD. CONTRACTOR SHALL BE RESPONSIBLE TO FIELD MEASURE AND CONFIRM MOUNTING HEIGHTS AND LOCATION OF ELECTRICAL EQUIPMENT WITH RESPECT TO COUNTERS, RADIATION, ETC. DO NOT SCALE DISTANCES OFF THE ELECTRICAL DRAWINGS, USE ACTUAL BUILDING DIMENSIONS.

I. COOPERATION WITH OTHER CONTRACTORS

- COOPERATE WITH THE OTHER TRADES SO THAT THE INSTALLATION OF THE ELECTRICAL OUTLETS AND EQUIPMENT WILL BE PROPERLY COORDINATED. CONDUIT, LIGHTING FIXTURES, AND OTHER EQUIPMENT LOCATIONS SHALL BE VERIFIED WITH OTHER TRADES TO AVOID CONFLICT WITH THE PIPING, DUCTWORK, STEEL, BEAMS, OR OTHER OBSTRUCTIONS.
- CAREFULLY VERIFY THE LOCATIONS OF THE OUTLET BOXES AND DETERMINE THAT THEY HAVE NOT BEEN DISTURBED DURING THE INSTALLATION OF MATERIALS OF OTHER TRADES.
- COORDINATE THE LOCATION OF THE TRENCHES AND CONDUITS FOR ELECTRICAL AND TELEPHONE UTILITY SERVICES WITH THE GENERAL CONTRACTOR.
- COORDINATE HVAC AND PLUMBING EQUIPMENT CONNECTION REQUIREMENTS WITH HVAC AND PLUMBING CONTRACTORS.

J. RECORD DRAWINGS

- THE ELECTRICAL CONTRACTOR SHALL MAINTAIN A SET OF DRAWINGS AT THE JOB SITE FOR THE EXCLUSIVE PURPOSE OF MAINTAINING A RECORD OF ALL WORK INSTALLED AND TO SHOW ANY DEVIATIONS FROM THE WORK INDICATED ON THE DRAWINGS.
- AT THE COMPLETION OF THE PROJECT, ONE SET OF REPRODUCIBLE DRAWINGS, SHOWING ALL RECORD CONDITIONS, SHALL BE DELIVERED TO THE OWNER FOR ACCEPTANCE PRIOR TO FINAL PAYMENT.

PART II – PRODUCTS AND EXECUTION

A. MATERIALS

- ALL MATERIALS SHALL BE NEW AND OF QUALITY AS SPECIFIED ON THE PLANS OR SPECIFICATIONS AND MUST CARRY THE UNDERWRITER'S LABORATORIES APPROVAL COVERING THE PURPOSE FOR WHICH THEY ARE USED, IN ADDITION TO MEETING ALL REQUIREMENTS OF THE CURRENT APPLICABLE CODES AND REGULATIONS.

B. SHOP DRAWINGS AND APPROVALS

- THE ITEMS SPECIFIED HEREIN AND ON DRAWINGS ARE USED AS A STANDARD OF QUALITY. ANY MATERIALS OF EQUAL QUALITY AND AESTHETIC VALUE WILL BE GIVEN CONSIDERATION AS A SUBSTITUTE FOR THE MATERIALS SPECIFIED. NO APPROVAL WILL BE GIVEN TO A SPECIFIC CATALOG NUMBER, MODEL, OR TYPE OF EQUIPMENT, PRIOR TO BIDDING. AFTER BIDDING, THE DECISION OF THE ARCHITECT AND/OR ENGINEER DETERMINING EQUAL MATERIALS WILL BE FINAL.
- THE CONTRACTOR SHALL SUBMIT SEVEN (7) IDENTICAL BOUND SETS OF SHOP DRAWINGS ON THE FOLLOWING ITEMS:
A. LIGHTING FIXTURE CUTS AND PERFORMANCE DATA.
B. OUTLINE DRAWINGS AND DATA SHEETS OF EACH PANELBOARD, LOAD CENTERS, AND DISTRIBUTION PANELS.
C. OUTLINE DRAWINGS OF ALL SWITCH GEAR COMPONENTS.
D. WIRING DEVICES AND COVERPLATES.
E. ALL CIRCUIT BREAKERS INSTALLED IN PANELBOARDS, LOAD CENTERS, AND DISTRIBUTION PANELS. SUBMIT ITEMS AT ONE TIME IN A NEAT AND ORDERLY MANNER WITHIN 15 DAYS OF AWARD OF CONTRACT. PARTIAL SUBMITTALS WILL NOT BE ACCEPTABLE.

C. SYSTEM GROUNDING

- GROUNDING SHALL COMPLY WITH REQUIREMENTS OF ARTICLE 250. ALL EXPOSED NONCURRENT CARRYING METALLIC PARTS OF ELECTRICAL EQUIPMENT, METALLIC RACEWAY SYSTEMS, METALLIC CABLE ARMOR, GROUNDING CONDUCTOR OF NONMETALLIC SHEATHED CABLES, GROUNDING CONDUCTOR IN NONMETALLIC RACEWAYS, AND GROUNDED CONDUCTORS OF THE WIRING SYSTEM SHALL BE GROUNDED.
- GROUNDING CONDUCTOR (NEUTRAL) OF THE WIRING SYSTEM SHALL BE CONNECTED TO THE SYSTEM GROUNDING CONDUCTOR AT A SINGLE PLACE IN EACH SYSTEM BY REMOVABLE BONDING JUMPERS, SIZED ACCORDING TO THE APPLICABLE PROVISIONS OF THE NATIONAL ELECTRICAL CODE. THE GROUNDED CONDUCTOR (NEUTRAL) TO THE GROUNDING CONDUCTOR CONNECTION SHALL BE LOCATED IN THE ENCLOSURE FOR THE SYSTEM'S OVERCURRENT PROTECTION OR WHERE OTHERWISE INDICATED ON THE PLANS OR SPECIFICATION.
- A GROUND BUS SEPARATE FROM THE NEUTRAL BUS SHALL BE PROVIDED IN ALL DISTRIBUTION PANELS AND PANELBOARDS. PROPER TORQUE ON GROUND BUS SHALL BE VERIFIED, PER MANUFACTURER'S RECOMMENDATIONS, PRIOR TO ENERGIZING EQUIPMENT.
- GROUND BUSES AND NEUTRAL BUSES IN ALL DISTRIBUTION PANELS, LOAD CENTERS, PANELBOARDS, AND THOSE PROVIDED IN ANY EQUIPMENT SHALL BE ISOLATED EXCEPT WHERE REQUIRED TO BE CONNECTED AS SPECIFIED ABOVE FOR THE SERVICE ENTRANCE.
- WHEN INDICATED ON THE DRAWINGS, EQUIPMENT GROUNDING CONDUCTORS SHALL BE EXTENDED FROM THE GROUND BUS IN THE DISTRIBUTION EQUIPMENT TO THE RECEPTACLE, FIXTURE OR DEVICE LUGS WHERE THEY ARE PROVIDED. WHERE LUGS ARE NOT PROVIDED, EQUIPMENT GROUNDING CONDUCTORS SHALL BE CONNECTED TO EQUIPMENT ENCLOSURES. THE CONNECTIONS SHALL BE ARRANGED SUCH THAT REMOVAL OF THE RECEPTACLE, EQUIPMENT GROUND CONDUCTORS, OR GROUND JUMPERS FROM GROUND BUSING SHALL NOT AFFECT THE GROUND SYSTEM.
- CONDUITS SHALL NOT BE USED AS A GROUNDING CONDUCTOR FOR POWER AND LIGHTING CIRCUITS. ALL CONDUIT SHALL HAVE SEPARATE CODE SIZED GREEN GROUND WIRE INSTALLED IN THE CONDUIT TO INSURE A CONTINUOUS GROUNDING PATH.
- IN INACCESSIBLE LOCATIONS, MAKE CONNECTIONS BY EXOTHERMIC WELD PROCESS.
- IN ACCESSIBLE LOCATIONS, CONNECTIONS SHALL BE MADE WITH BOLTED THROUGH, APPROVED SOLDERLESS BRONZE GROUNDING DEVICES.

D. WIRE

- CONDUCTOR SIZES SHOWN ON THE DRAWINGS ARE BASED ON COPPER WIRE. UNLESS OTHERWISE SPECIFIED, ALL WIRE SHALL BE TYPE XHHW OR SE FOR FEEDERS OR BRANCH CIRCUITS LARGER THAN 4 AWG, TYPE THHN/THWN INSULATION FOR FEEDERS AND BRANCH CIRCUITS 4 AWG AND SMALLER. ALL BRANCH CIRCUIT WIRING SHALL BE COPPER.
- ALUMINUM CONDUCTORS MAY BE UTILIZED FOR SERVICE ENTRANCE AND PANEL FEEDERS. CONDUCTORS SHALL BE ALUMINUM ALLOW AA-8000 SERIES.
- THE WIRES SHALL BE MARKED WITH COLOR TO SIMPLIFY CIRCUIT IDENTIFICATION. UNLESS OTHERWISE REQUIRED BY LOCAL ORDINANCES GROUND WIRES SHALL BE GREEN, NEUTRAL WIRES SHALL BE 120V-WHITE, AND LIVE WIRES 208Y/120V AND 120/240V SHALL BE BLACK (PHASE A), RED (PHASE B), AND BLUE (PHASE C). CIRCUIT SHALL BE LABELED IN EACH J-BOX.
- ALL CONDUCTORS SHALL BE RATED 600 VOLT.
- SPLICERS IN EXTERIOR PULL BOXES AND MANHOLES SHALL BE WEATHERPROOF USING "SCOTCHCAST" SPLICER KIT OR APPROVED EQUAL. SEAL ENDS OF CONDUITS AND DUCTS WITH "DUCTSEAL" OR APPROVED EQUAL.
- PROVIDE SOLID CONDUCTOR FOR 12 AWG AND SMALLER.
- ALL WIRING WITHIN RESIDENTIAL UNITS ONLY MAY BE TYPE NM CABLE.
- NO WIRE SHALL BE INSTALLED IN THE CONDUIT SYSTEM UNTIL THE CONDUIT SYSTEM IS COMPLETE. USE MINERALAC NO. 100 OR EQUIVALENT AS A LUBRICANT TO FACILITATE THE INSTALLATION OF THE CONDUCTORS IN THE CONDUIT SYSTEM.
- MC CABLE WITH COPPER CONDUCTORS AND GROUND WIRE MAY BE USED WHERE PERMITTED.

E. CONDUIT

- ALL WIRING SHALL BE INSTALLED IN LISTED METALLIC CONDUIT EXCEPT AS PERMITTED IN OTHER SECTIONS. RGS, WITH A 20 MIL PVC COATING WILL BE USED WHEN IN CONTACT WITH EARTH. IMC MAY BE USED IN INDOOR LOCATIONS NOT IN CONTACT WITH THE EARTH. EMT MAY BE USED IN INDOOR LOCATIONS NOT IN CONTACT WITH EARTH, NOT IN CONCRETE SLABS OR WALLS AND NOT SUBJECT TO DAMAGE. PVC MAY BE USED IN OR BELOW CONCRETE AND DIRECT BURIED IN EARTH. FLEXIBLE STEEL CONDUIT SHALL BE USED FOR INDOOR FINAL CONNECTIONS TO EQUIPMENT IN LENGTHS NOT TO EXCEED 72". LIQUID-TIGHT FLEXIBLE STEEL CONDUIT SHALL BE FOR OUTDOOR FINAL CONNECTIONS TO EQUIPMENT NOT TO EXCEED 48".
- WHERE CONDUIT ENTERS OUTLET BOXES, FIXTURES OR CABINETS, FIRMLY FASTEN WITH STEEL SET SCREW, COMPRESSION CONNECTORS, OR DOUBLE LOCKNUTS FOR GRC. ALL CONNECTIONS SHALL HAVE BUSHINGS OR INSULATED THROAT CONNECTORS. FIRMLY FASTEN CONDUIT TO THE BUILDING CONSTRUCTION. RUN EXPOSED CONDUIT PARALLEL TO THE BUILDING LINES, SUPPORTED BY APPROPRIATE HANGERS (UNISTRUT, T & B OR APPLETON, OR EQUAL).
- COVER METALLIC CONDUIT IN CONTACT WITH EARTH WITH POLYETHYLENE TAPED SPIRAL WRAPPED, 1/2 LAPPED TO PROVIDE 20 MIL THICKNESS. TAPE SHALL BE SCOTCH NO. 50 TAPE. CONDUIT AND DUCTS NOT UNDER BUILDINGS AND FEEDER DUCTS SHALL BE INSTALLED PER N.E.C. 300-5. MAKE JOINTS WITH COMPOUND TO BE WATERTIGHT.
- SCHEDULE 40 PVC CONDUIT SHALL BE PERMITTED UNDERGROUND WITH PROPER FITTINGS, ALL UL APPROVED AND CEMENTED JOINTS. PENETRATIONS THROUGH FLOOR SLABS AND BENDS GREATER THAN 22" SHALL BE WRAPPED RIGID GALVANIZED STEEL ELBOWS.
- FITTINGS AND CONDUIT BODIES SHALL BE STEEL. DIECAST FITTINGS ARE NOT ACCEPTABLE. CONDUIT SIZES SHALL BE AS REQUIRED BY CODE AND AS INDICATED OR SPECIFIED.
- ALL EMPTY CONDUIT SYSTEMS SHALL HAVE A 200 LB. TEST NYLON PULL STRING TO FACILITATE INSTALLATION OF FUTURE WIRE.
- WIRING, CONDUITS, AND OUTLETS SHALL BE CONCEALED WITH THE BUILDING STRUCTURE, EXCEPT THAT CERTAIN MOTOR AND LIGHTING FEEDER CONDUITS MAY BE RUN EXPOSED IN CERTAIN AREAS AS INDICATED ON THE DRAWINGS.
- CONDUIT PENETRATION THROUGH ROOF SHALL HAVE ROOF FLASHING WITH CAULK TYPE COUNTER FLASHING SLEEVE. INSTALLATION SHALL BE WATERTIGHT.
- CONDUITS SHALL BE ROUTED PARALLEL AND PERPENDICULAR TO THE STRUCTURE.

F. OUTLET, PULL, AND JUNCTION BOXES

- EACH SWITCH, LIGHT, RECEPTACLE OR OTHER OUTLET, INSTALLED IN RESIDENTIAL UNITS, SHALL BE PROVIDED WITH A CODE SIZED, PLASTIC OUTLET BOX. JUNCTION AND PULL BOXES SHALL BE CODE SIZED, PLASTIC OR METAL OUTLET BOX. ALL OTHER OUTLET BOXES SHALL BE STEEL.
- BOXES INSTALLED IN POURED CEMENT FLOORS SHALL BE FLUSH TYPE CAST IRON OR STEEL WITH WATERTIGHT GASKETED COVERS. WHERE BOXES ARE INSTALLED IN FLOORS WITH TILE OR CARPET FLOOR COVERING, COVERS SHALL BE OF THE RECESSED TYPE TO ACCOMMODATE THE FLOOR COVERING. BOXES INSTALLED FOR THE ALARM, COMPUTER, AND SECURITY SYSTEM SHALL BE PROVIDED WITH APPROPRIATE COVER PLATES.
- BOXES FOR TELEPHONE, COMPUTER, T.V., FIRE ALARM, SECURITY, AND SIMILAR SYSTEMS SHALL BE MINIMUM 2-1/8" DEEP.

G. WIRING DEVICES

- WALL SWITCHES SHALL BE SPECIFICATION GRADE AC SILENT TYPE SWITCHES, 20A 120/277 VOLT. RECEPTACLES SHALL BE SPECIFICATION GRADE, DUPLEX TYPE. NEMAS-20R, 20 AMPERE, 120VOLT GROUNDED TYPE. SPECIAL APPLICATION RECEPTACLES SHALL BE INDICATED ON PLANS. MOUNT WITH THE GROUND DOWN.
- DEVICE PLATES SHALL BE EQUAL TO SIERRA SMOOTH-LINE PLASTIC WALL PLATES. COLOR SHALL BE WHITE, UNLESS OTHERWISE NOTED.
- RECEPTACLES IN OUTDOOR AND WET LOCATIONS SHALL BE INSTALLED WITH A HINGED OUTLET COVER/ENCLOSURE CLEARLY MARKED AND U.L. LISTED SUITABLE FOR WET LOCATIONS WHILE IN USE, EQUAL TO TAYMAC SPECIFICATION GRADE.

H. SERVICE ENTRANCE SECTION

- THE SERVICE ENTRANCE EQUIPMENT SHALL BE AS INDICATED ON THE DRAWINGS. EQUIPMENT SHALL CARRY THE U.L. LABEL AND SHALL CONFORM TO THE POWER COMPANY REGULATIONS.
- SERVICE ENTRANCE EQUIPMENT SHALL BE PROVIDED WITH A FULLY RATED COPPER OR ALUMINUM BUS. HORIZONTALLY TAPERED BUSSING SHALL NOT BE ALLOWED.

I. DISTRIBUTION PANELS

- DISTRIBUTION PANELS SHALL BE PROVIDED WITH FULLY RATED COPPER OR ALUMINUM BUS. HORIZONTAL TAPERED BUSSING SHALL NOT BE ALLOWED.
- ACCEPTABLE MANUFACTURERS – CUTLER HAMMER, SIEMENS, SQUARE D OR GENERAL ELECTRIC FACTORY ASSEMBLED DEAD FRONT, METAL ENCLOSED, AND SELF-SUPPORTING SWITCH BOARD ASSEMBLY CONFORMING T NEMA PB 2 AND UL 891, AND COMPLETE FROM INCOMING LINE TERMINALS TO LOAD SIDE TERMINATIONS.
- LINE AND LOAD TERMINATIONS: ACCESSIBLE FROM FRONT ONLY OF THE SWITCH BOARD. SUITABLE FOR CONDUCTOR MATERIALS AND NUMBER OF CONDUCTORS USED.
- BUS CONNECTIONS: BOLTED, ACCESSIBLE FROM FRONT FOR MAINTENANCE. PROVIDE BELLEVILLE WASHERS FOR PROPERLY TORQUE ALL CONNECTIONS
- PROVIDE FULLY-RATED NEUTRAL BUS AND FULLY RATED GROUND BUS MATCHING MATERIAL USED FOR MAIN BUS.
- FUTURE PROVISIONS: FULLY EQUIP SPACES FOR FUTURE DEVICES WITH BUSSING AND BUS CONNECTIONS SUITABLY INSULATED AND BRACED FOR SHORT CIRCUIT CURRENTS. CONTINUOUS CURRENT RATING AS INDICATED ON DRAWINGS.
- ALL CIRCUIT BREAKERS SHALL BE BOLT-ON TYPE.

J. PANEL BOARDS

- CIRCUIT BREAKER TYPE AS INDICATED ON DRAWINGS, UNLESS INDICATED OTHERWISE, ALL PANELS SHALL HAVE PANEL HAVE PANEL BOARD TYPE CONSTRUCTION WITH BOLT-ON CIRCUIT BREAKERS FOR 3ø PANELS
- MANUFACTURERS SHALL BE GENERAL ELECTRIC, SQUARE D, SIEMENS, CUTLER-HAMMER WITH VOLTAGE, SIZES, AND RATINGS AS INDICATED ON DRAWINGS.
- THE CIRCUIT BREAKERS SHALL BE OPERABLE IN ANY POSITION AND BE REMOVABLE FROM THE FRONT OF THE PANEL BOARD WITHOUT DISTURBING THE ADJACENT UNITS. BRANCH BREAKERS SHALL BE OF SUCH DESIGN THAT COMBINATION OF SINGLE-POLE, DOUBLE-POLE, AND THREE-POLE BREAKERS CAN BE ASSEMBLED ON THE SAME PANEL. EACH BRANCH CIRCUIT SHALL BE CLEARLY NUMBERED. BRANCH AND MAIN TERMINALS SHALL BE SOLDERLESS TYPE. HANDLE TIES TO FORM MULTI-POLE BREAKERS NOT ACCEPTABLE.

K. LOAD CENTER

- CIRCUIT BREAKER TYPE AS INDICATED ON DRAWINGS. MANUFACTURERS SHALL BE GENERAL ELECTRIC, SQUARE D, SIEMENS, CUTLER-HAMMER/EATON WITH VOLTAGE, SIZES, AND RATINGS AS INDICATED ON DRAWINGS.
- THE CIRCUIT BREAKERS SHALL BE OPERABLE IN ANY POSITION AND BE REMOVABLE FROM THE FRONT OF THE PANEL BOARD WITHOUT DISTURBING THE ADJACENT UNITS. BRANCH BREAKERS SHALL BE OF SUCH DESIGN THAT COMBINATION OF SINGLE-POLE AND DOUBLE-POLE BREAKERS CAN BE ASSEMBLED ON THE SAME PANEL. EACH BRANCH CIRCUIT SHALL BE CLEARLY NUMBERED. BRANCH AND MAIN TERMINALS SHALL BE OF THE SOLDERLESS TYPE. HANDLE TIES TO FORM MULTI-POLE BREAKERS NOT ACCEPTABLE. A. CIRCUIT BREAKERS SHALL BE PLUG-IN TYPE
- WIRE TERMINATION FOR PANEL BOARDS AND CIRCUIT BREAKERS SHALL BE LISTED AS SUITABLE FOR 75 DEGREES C.
- PROVIDE A TYPEWRITTEN CIRCUIT INDEX BEHIND CLEAR PLASTIC COVER ON INSIDE OF DOOR. INFORMATION SHALL INCLUDE ROOM AND TYPE LOAD SERVED. ALL CIRCUIT BREAKERS SHALL BE IDENTIFIED, INCLUDING SPARES. INDEX CARD FRAME SHALL BE METAL, SECURED TO DOOR.
- PANEL BOARDS/LOAD CENTERS TO BE PROVIDED WITH COPPER BUSSING ONLY.

L. LIGHTING FIXTURES

- PROVIDE ALL LIGHTING FIXTURES, WIRED AND CONNECTED. THE DRAWINGS INDICATE THE FIXTURES FOR EACH LOCATION. PROVIDE LAMPS FOR ALL FIXTURES. THE LAMPS SHALL BE BY THE SAME MANUFACTURER. VERIFY CEILING CONSTRUCTION BEFORE ORDERING RECESSED UNITS. PROVIDE PLASTER FRAMES AND HANGERS AS REQUIRED. CEILING CONSTRUCTION, ARCHITECTURAL ACCESSORIES, VOLTAGE, AND BALLASTS TO MEET THE EXISTING CEILING CONDITION.

M. LIGHTING CONTROL

- FURNISH AND INSTALL TIME SWITCHES, PHOTOCELLS, CONTRACTORS AND FULL LIGHTING CONTROL SYSTEMS AS REQUIRED FOR LIGHTING CONTROLS INDICATED ON THE DRAWINGS.
- TIME SWITCHES SHALL BE EQUAL TO PARAGON, GENERAL ELECTRIC, TORK, OR INTERMATIC AND SHALL HAVE SIZE AND NUMBER OF POLES AS REQUIRED.
- PHOTOCELLS SHALL BE EQUAL TO TORK OR INTERMATIC WITH VOLTAGE AS INDICATED.

N. TELEPHONE AND CABLE TELEVISION SYSTEMS

- TELEPHONE WALL OUTLETS SHALL CONSIST OF STANDARD BOXES MOUNTED 18" ABOVE THE FLOOR UNLESS OTHERWISE INDICATED. PROVIDE A TERMINAL MOUNTING BOARD FOR THE INCOMING SERVICE CABLE.
- CABLE TELEVISION OUTLETS SHALL CONSIST OF STANDARD BOXES MOUNTED 18" ABOVE THE FLOOR UNLESS OTHERWISE INDICATED. PROVIDE A TERMINAL MOUNTING BOARD FOR THE INCOMING SERVICE CABLE.

O. GUARANTEE

- GUARANTEE ALL MATERIAL FURNISHED AND ALL WORKMANSHIP PERFORMED FOR A PERIOD OF ONE YEAR FROM DATE OF FINAL ACCEPTANCE OF WORK. ANY DEFECTS DEVELOPING WITHIN THIS PERIOD, TRACEABLE TO MATERIAL FURNISHED AS A PART OF THIS SECTION OR WORKMANSHIP PERFORMED HEREUNDER, SHALL BE MADE GOOD AT NO EXPENSE TO THE OWNER.

SYMBOLS LEGEND

NOTE: THIS IS A MASTER LEGEND AND NOT ALL SYMBOLS, ETC, ARE NECESSARILY USED ON THE DRAWINGS.

LIGHTING FIXTURES – SYMBOL/LETTER INDICATES LIGHT FIXTURE AS INDICATED ON FIXTURE SCHEDULE

- LED FIXTURE (SEE LIGHTING FIXTURE SCHEDULE)
- FIXTURE WITH EMERGENCY BATTERY DRIVER UNIT TRACK LIGHT
- DOWNLIGHT FIXTURE WITH EMERGENCY BATTERY DRIVER UNIT
- WALL MOUNTED FIXTURE WITH EMERGENCY BATTERY DRIVER UNIT
- PENDANT MOUNTED FIXTURE WITH EMERGENCY BATTERY DRIVER UNIT
- DOWNLIGHT FIXTURE
- WALL MOUNTED FIXTURE
- PENDANT MOUNTED FIXTURE
- WALL WASHER
- SINGLE FACE EXIT SIGN – UNIVERSAL MOUNTED
- SINGLE FACE EXIT SIGN W/ DIRECTIONAL ARROWS – UNIVERSAL MTD
- DOUBLE FACE EXIT SIGN W/ DIRECTIONAL ARROWS – UNIVERSAL MTD
- DUAL HEADED EMERGENCY UNIT
- COMBO DUAL HEADED EMERGENCY AND EXIT SIGN UNIT

LIGHTING CONTROLS

- S SINGLE POLE SWITCH @ +48" UNLESS NOTED
- Sabc SWITCH BANK @ +48" UNLESS NOTED. LOWER CASE LETTER INDICATES FIXTURE CONTROLLED.
- S3 3-WAY SWITCH @ +48" UNLESS NOTED
- S4 4-WAY SWITCH @ +48" UNLESS NOTED
- SD DIMMER SWITCH – SIZE AS REQUIRED @ +48" UNLESS NOTED
- Sm MANUAL MOTOR STARTER
- Sos WALL SWITCH WITH OCCUPANCY SENSOR. DIGITAL LOW VOLTAGE WALL SWITCH. SWITCH @ +48" UNLESS NOTED.
- SLV TWO BUTTON DIGITAL LOW VOLTAGE WALL SWITCH. PROVIDES ON/OFF/0-10V DIMMING. SWITCH @ +48" UNLESS NOTED. PROVIDE EXTRA CONTROL CABLES NEEDED TO FIXTURE CONTROLLED.
- CS LIGHTING CONTROLS CEILING MOUNT OCCUPANCY SENSOR
- PC LIGHTING CONTROLS POWER PACK
- PH PHOTOCELL
- TC TIMECLOCK

POWER DISTRIBUTION

- SWITCHBOARD, MOTOR CONTROL CENTER OR DISTRIBUTION BOARD
- 277/480V, 3 PHASE, 4 WIRE PANELBOARD, UNO
- 120/208V, 3 PHASE, 4 WIRE PANELBOARD, UNO
- 120/240V, 1 PHASE, 3 WIRE PANELBOARD, UNO
- TRANSFORMER

POWER DEVICES


- SPECIAL HEAVY DUTY RECEPTACLE – SIZE AS NOTED. @ +18" UNLESS NOTED
- 1/2 SWITCHED RECEPTACLE @ +18" UNLESS NOTED
- FIRE RATED POKE THRU WITH TYPE INDICATED
- FLUSH FLOOR BOX WITH TYPE INDICATED
- SINGLE RECEPTACLE @ +18" UNLESS NOTED
- DUPLEX RECEPTACLE @ +18" UNLESS NOTED
- DOUBLE DUPLEX RECEPTACLE @ +18" UNLESS NOTED
- DUPLEX RECEPTACLE INSTALLED ABOVE COUNTERTOP
- GFCI-RATED DUPLEX RECEPTACLE
- ARC FAULT RATED DUPLEX RECEPTACLE
- TAMPER RESISTANT RATED DUPLEX RECEPTACLE
- DUPLEX RECEPTACLE WITH WEATHERPROOF COVERPLATE @ 18" UNLESS NOTED
- JUNCTION BOX
- DISCONNECT SWITCH – SIZE AND TYPE NOTED
- COMBINATION FUSED STARTER DISCONNECT SWITCH FUSE SIZE AS INDICATED, STARTER SIZE '1'

AUXILIARY SYSTEMS

- MECHANICAL EQUIP. CONNECTION, SEE SCHED. ON MECH. PLAN
- TELEPHONE OUTLET @ +18" UNLESS NOTED
- DATA OUTLET @ +18" UNLESS NOTED
- COMBINATION TELEPHONE/DATA OUTLET @ +18" UNLESS NOTED
- TELEVISION OUTLET @ +60" UNLESS NOTED
- SMOKE DETECTOR
- HEAT DETECTOR
- DUCT SMOKE DETECTOR
- REMOTE TEST STATION WITH INDICATING LIGHT. MOUNT AT 48" AFF UNO.
- AUXILIARY SYSTEM TERMINAL CABINET

GENERAL

- CONDUIT RUN CONCEALED IN WALL OR ABOVE CEILING
- CONDUIT RUN BELOW FLOOR OR GRADE
- P1-3,5,7 HOMERUN TO PANELBOARD, INFORMATION AT ARROWS ARE CIRCUIT NUMBERS AND PANELBOARD FOR TERMINATION. REFER TO ASSOCIATED NOTE FOR BRANCH CIRCUIT CONDUCTOR SIZES.
- INDICATES 1/2" CONDUIT CONCEALED IN CEILING OR WALL WITH (3) CONDUCTORS. (1) PHASE, (1) NEUTRAL AND (1) GROUND WIRE. ALL ARE #12 AWG UNLESS NOTED OTHERWISE.
- (E) OR ETR: DENOTES EXISTING ITEM/EQUIPMENT TO REMAIN

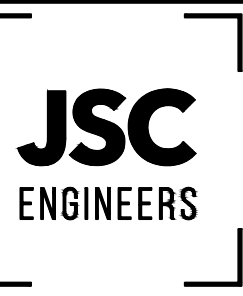

MO COA NO. 20160007861 / KS COA NO. E-2818
1925 CENTRAL ST. SUITE #201
KANSAS CITY, MO 64108
phone: (816) 272-8289
email: jsc@jscengineers.com



POOL HOUSE STRUCTURE
LEE'S SUMMIT, MO

REVISIONS:	DATE	DESCRIPTION
1		
2		
3		
4		
5		

Copyright 2021
JSC Engineers

ISSUED:

PERMIT

SHEET TITLE:

ELECTRICAL
SPECIFICATIONS


DATE: 05.20.2022

JOB NO.: 22-133

SHEET:


E0.1

ELECTRICAL LIGHTING SCHEDULE							
FIXTURE TYPE	MANUFACTURER		VOLT AMPS	MOUNTING	LAMP TYPE	REMARKS	VOLT
	NAME	CATALOG NUMBER					
A	LITHONIA	VAP-600LM-FST-MD-MVOLT-40K-80CRI-VAP5MB-WLF-DL-STSL-MS102L3VWL	50	SURFACE CEILING	INCLUDED LED 4000K	VANDAL RESISTANT LED 4' DAMP LOCATION STRIP LUMINAIRE	120
B	LITHONIA	LDN6-30/15-L06-LSS-MVOLT-30K	17.5	RECESSED CEILING	INCLUDED LED 3000K	6' LED RECESSED DOWNLIGHT - WET LOCATION LISTED	120
W	EXTERIOR SCONCE	OWNER SELECTED	60	WALL SURFACE	INCLUDED LED 3000K	WET LOCATION RATED SCONCE - MAX 60W/FIXTURE	120
	LITHONIA	WLTU LED	5	SURFACE CEILING	INCLUDED	LED COMBO EXIT SIGN EMERGENCY LUMINAIRE WITH 90 MIN BATT. PACK WET LOCATION	120
	LITHONIA	ELA LED TWP M12	3	WALL	INCLUDED	OUTDOOR DOUBLE REMOTE HEAD EMERGENCY EGRESS LUMINAIRE	120

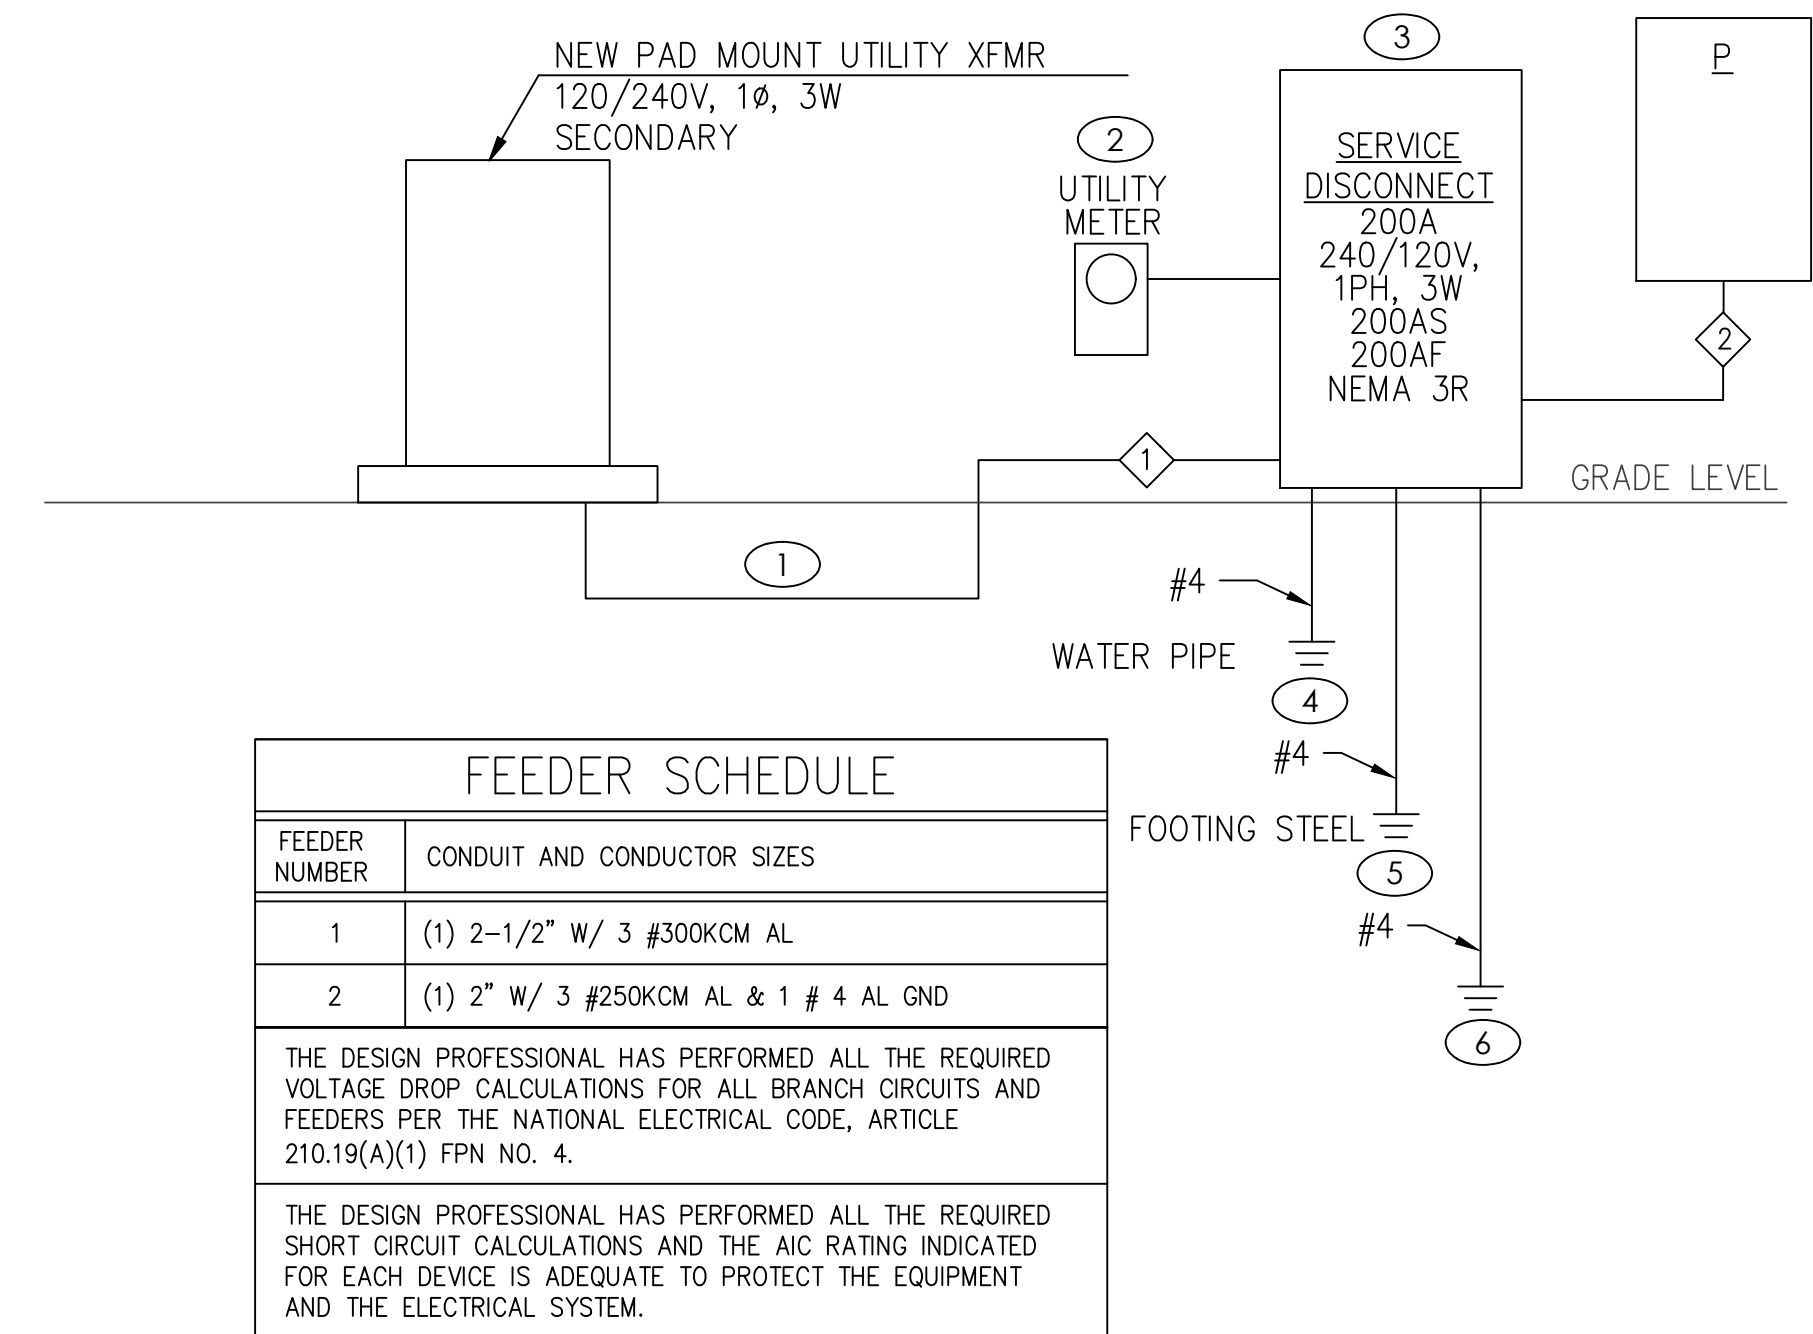

SINGLE LINE DIAGRAM

SCALE: NO SCALE

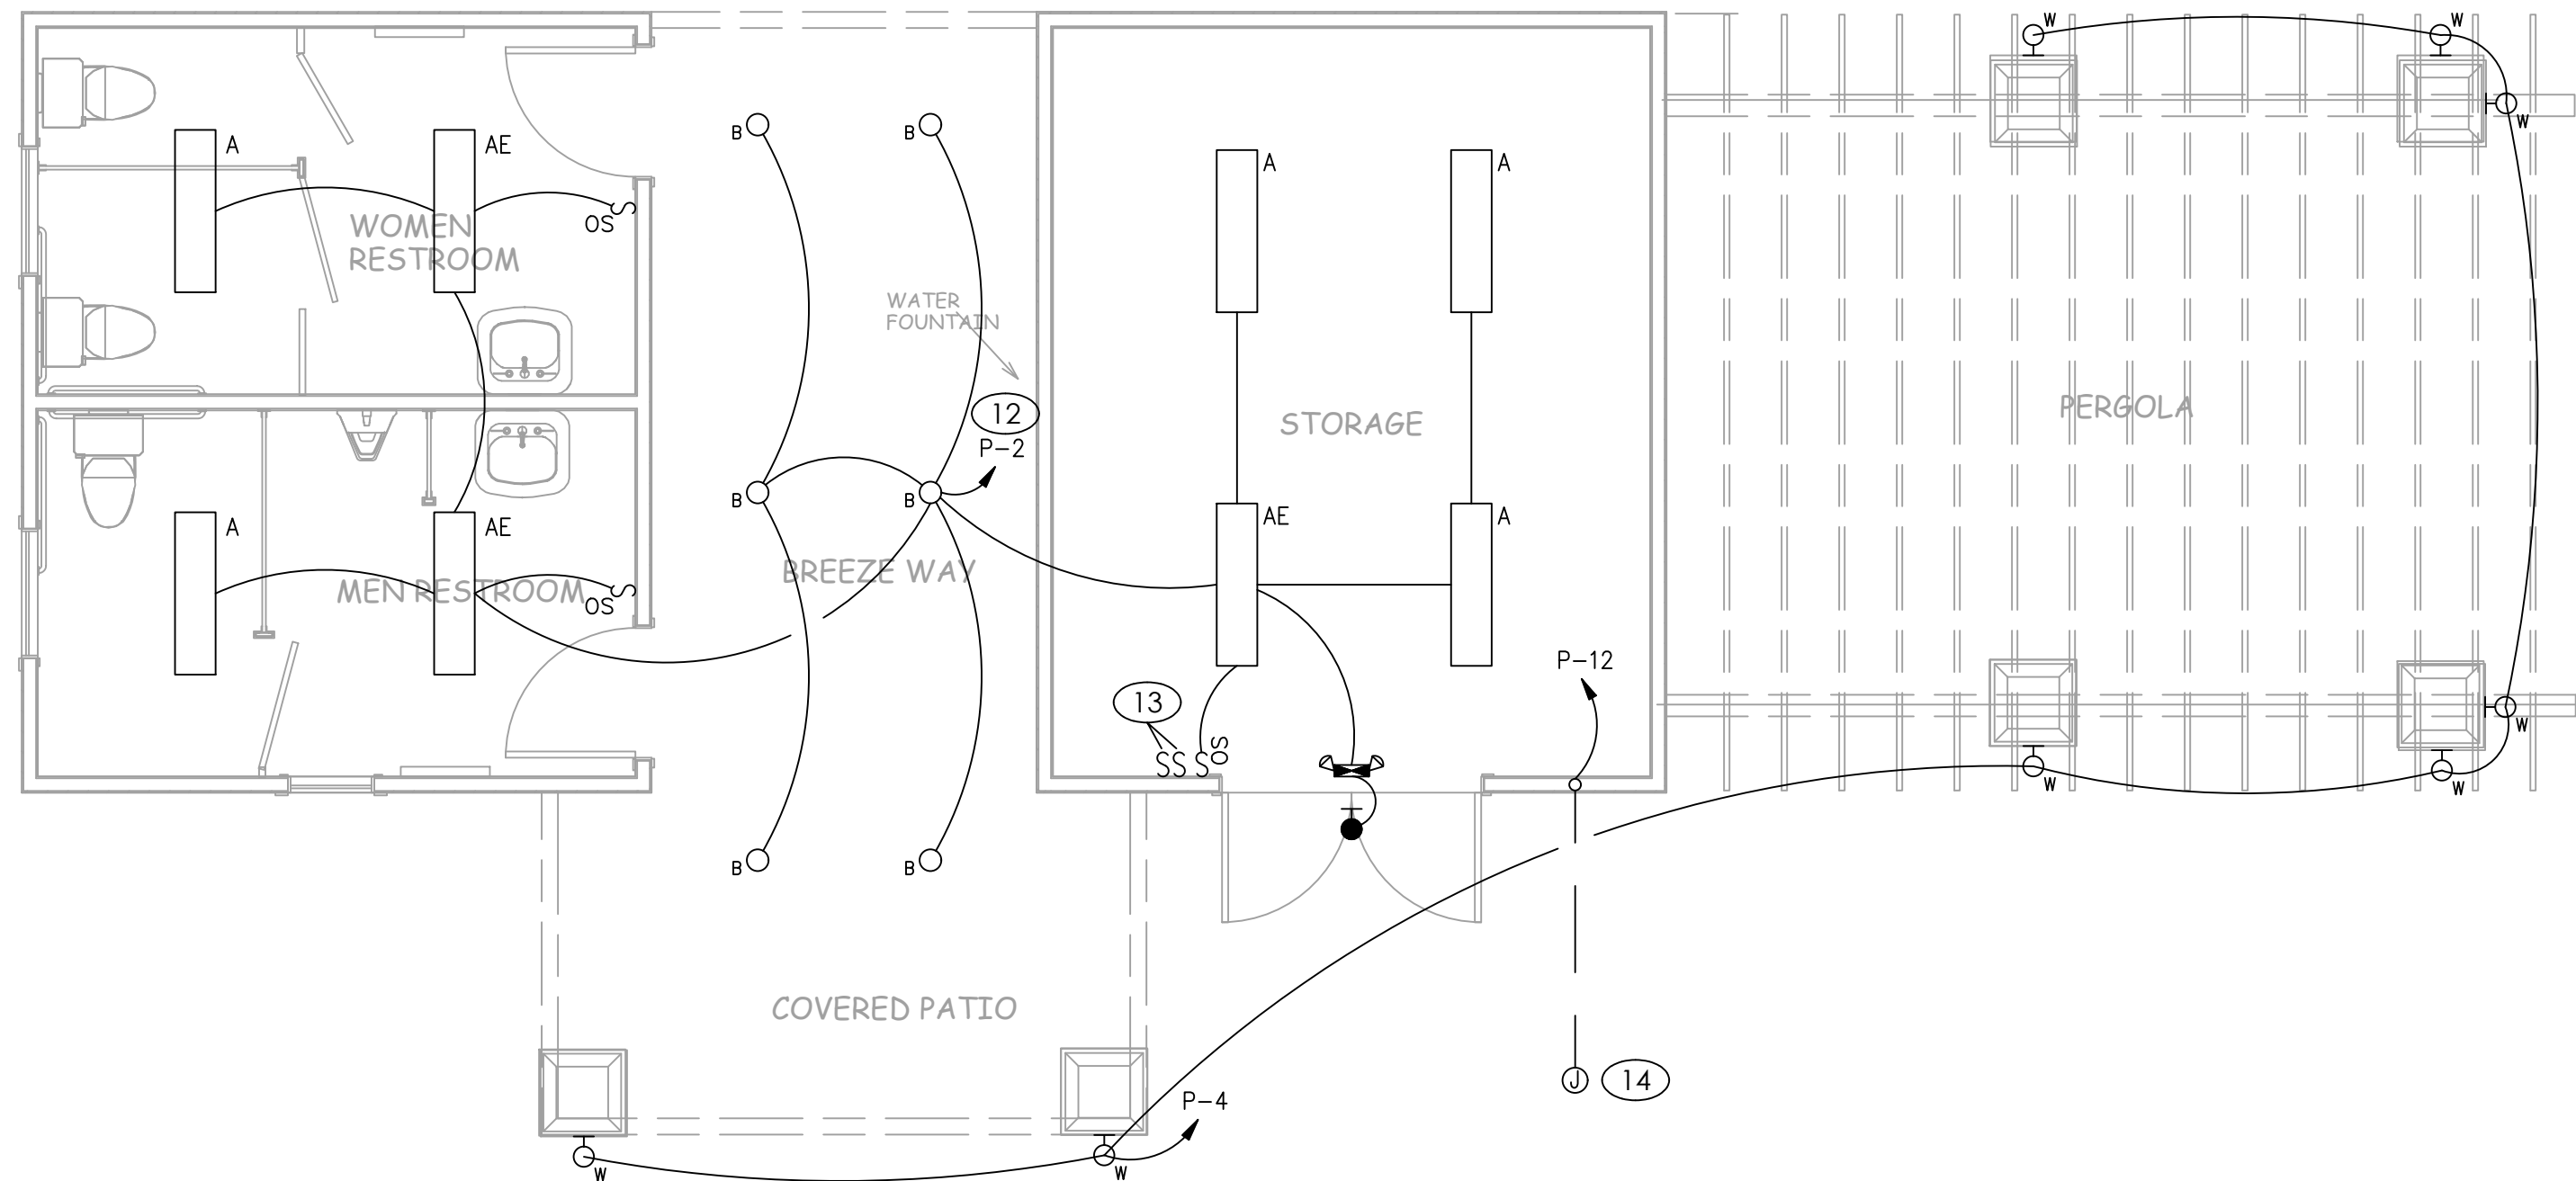


ELECTRICAL LIGHTING PLAN

SCALE: 1/4" = 1'-0"

PANEL: P									
LOCATION: EQUIPMENT ROOM		VOLTAGE: 240/120V		1PH, 3W		CIRCUIT CODES: 1=(CONTINUOUS LOAD)			
SHEET/1 LINE: E1.1		BUS: 200 AMPS		MAIN: M.L.O		2=(NON-CONTINUOUS LOAD)			
AIC RATING: 42,000		MOUNTING: SURFACE				3=(RECEPTACLES)			
CKT	CB	LOAD DESIGNATION		LOAD	PHASES	LOAD	LOAD DESIGNATION		CB
NO.	TRIP	ROLE	DESCRIPTION	MISC.	REC	LITE	VA	A	B
1	2	30	1 EWH-1	X			2400	2914	//////
2	2	30	1 EWH-2	X			2400	//////	2800
3	2	30	1 RESTROOM/BREEZWAY OUTLETS	X			360	730	//////
7	1	15	1 EF-3	X			72	//////	612
9			SPACE					500	//////
11			SPACE					500	//////
13			SPACE					500	X
15			SPACE					//////	0
17			SPACE					0	//////
19			SPACE					0	//////
TOTAL							4144	3912	
NOTES:							CONNECTED KVA		
"GF" = GFCI TYPE BREAKER							CONN.KVA (CODE 1)		
							CONN.KVA (CODE 2)		
							CONN.KVA (CODE 3)		
							CONN.KVA (CODE 4)		
JOB NAME: LSMO POOLHOUSE							FEEDER DEMAND KVA		
ISSUE DATE: 05.18.22							FEEDER DEMAND AMPS		

PANELBOARD SCHEDULES

SCALE: NO SCALE

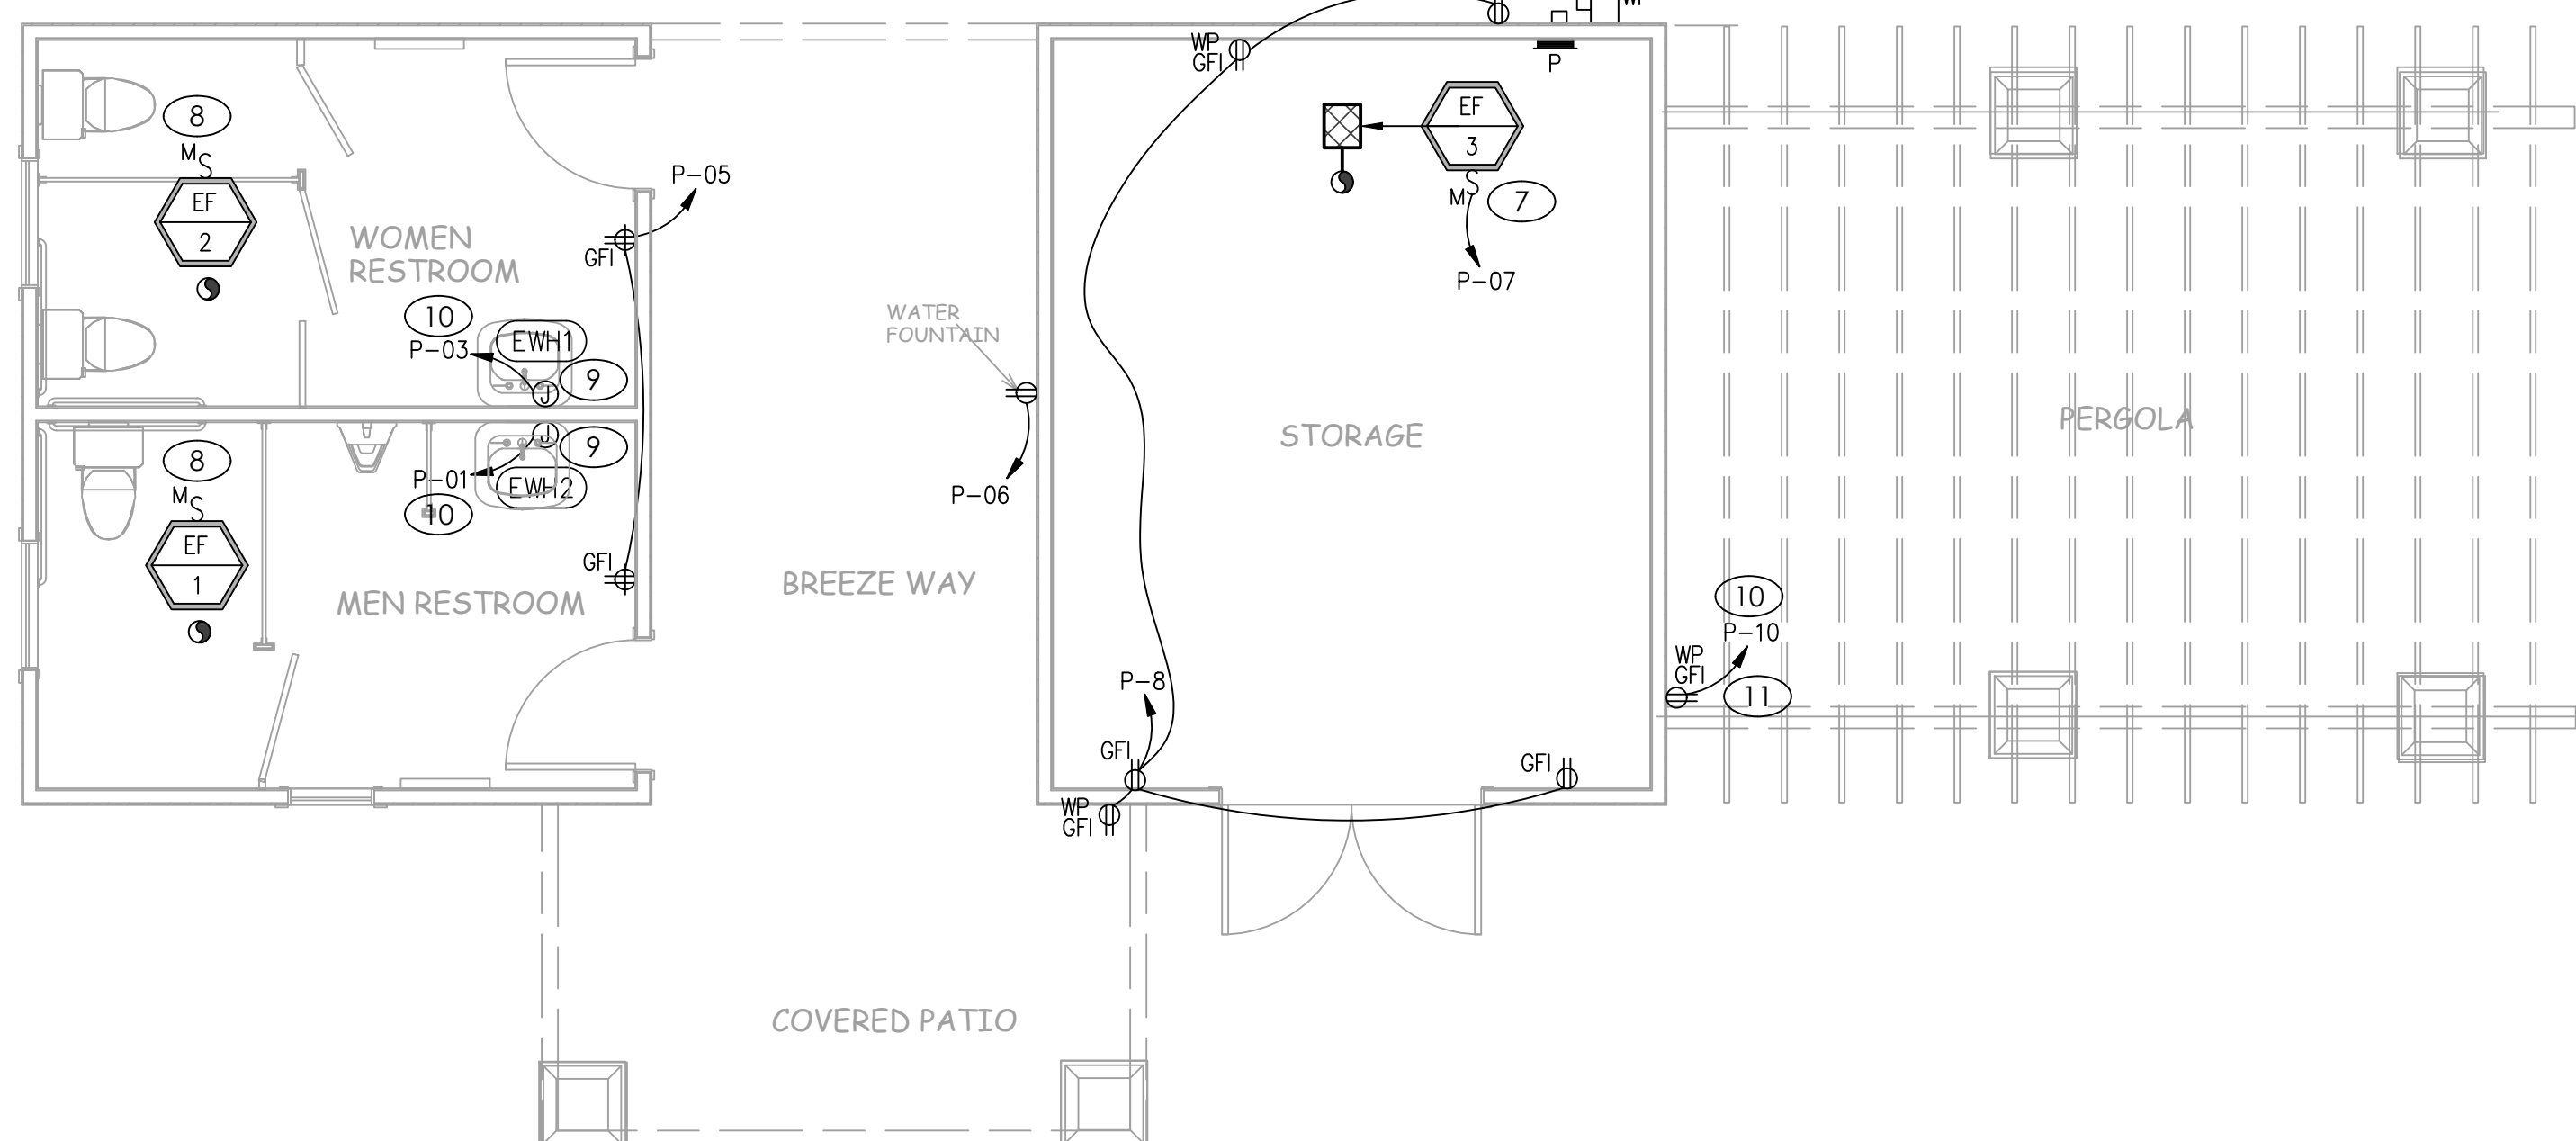

WHISPERING WOODS POOL

1901 SW. RIVER RUN DR.

PROJECT INFORMATION

STATE: MISSOURI
COUNTY: JACKSON
CITY: LEE'S SUMMIT
TYPE: INGROUND POOL
CONSTRUCTION METHOD: CAST-IN-PLACE
SANITATION: CHLORINE
HEATED: NO

GENERAL NOTES

- * ANY CHANGES IN CONSTRUCTION PLANS OR EQUIPMENT MUST BE APPROVED BY THE GOVERNING HEALTH DEPARTMENT. CHANGES MAY REQUIRE ADDITIONAL PLAN CHECK FEES AND RE-SUBMITTAL.
- * POOL PLAN APPROVAL DOES NOT AUTHORIZE THE VIOLATION OF ANY LAW, ORDINANCE, OR REGULATION AND FINAL APPROVAL IS SUBJECT TO FIELD INSPECTION.
- * ALL EQUIPMENT SHALL BE INSTALLED PER MANUFACTURER'S INSTRUCTIONS.
- * ALL EQUIPMENT AND MATERIALS NOT SHOWN OR SPECIFIED ON THESE PLANS, BUT REQUIRED TO COMPLETE THIS PROJECT, SHALL BE SUPPLIED BY THE POOL CONTRACTOR AS PART OF THIS CONTRACT WORK.
- * REINFORCING STILL OF ALL AQUATIC FEATURES SHALL BE BONDED WITH #3 COPPER WIRE. TIED BOND TO EACH MECHANICAL SYSTEM AND ALL RAIL ANCHORS AND METAL WITHIN 5 FT OF POOL EDGE
- * CRUSHED ROCK BELOW POOL FLOOR TO BE 1/2" CLEAN MINIMUM OF 4" DEPTH
- * ALL STEEL TO BE GRADE 40, #4 BAR AND A MINIMUM OF 12" ON CENTER EACH WALL HORIZONTAL AND VERTICAL. BELOW 6" WATER DEPTH REBAR SHALL BE 6" EACH WALL IN THE WALL
- * REINFORCING STEEL TO BE PLACED A MINIMUM OF 2" BELOW EXPOSED FACE OF CONCRETE

LOCATION MAP



PROJECT LOCATION

POOL DATA

PERIMETER: 160'-0"
SURFACE AREA: 1500-SQFT
APPROXIMATE VOLUME: 42,200 GALLONS
MINIMUM TURN OVER: 6-HOURS
MINIMUM FLOW RATE: 116-GPM
MAXIMUM FLOW RATE: 60-GPM
MINIMUM DEPTH OF POOL: 12"
MAXIMUM DEPTH OF POOL: 5'-0"

SHEET INDEX

P0.0 COVER SHEET
P1.0 POOL PLAN
P2.0 EQUIPMENT SCHEDULE
P2.1 FLOW CALCULATIONS
P3.0 POOL PLUMBING LAYOUT
P3.1 EQUIPMENT ROOM LAYOUT
P4.0 DETAILS
P4.1 DETAILS
P4.2 DETAILS
P4.3 DETAILS
P5.0 SAFETY PLAN
P5.1 SIGN DETAILS

CODE COMPLIANCE

- * ANSI POOL AND SPA STANDARD TO PREVENT SUCTION ENTRAPMENT
- * VIRGINIA GRAEME BAKER SAFETY ACT
- * LEE'S SUMMIT BUILDING CODE
- * BONDING SHALL BE PERFORMED IN ACCORDANCE WITH NEC




DATE: 3/10/2023
BY: MEJ
JOB:
SHEET NO. P0.0

VAN DEURZEN & ASSOCIATES, P.A.
11011 KING STREET, SUITE 130
OVERLAND PARK, KS 66210
(913) 451-6305 FAX (913) 451-1021
WEB PAGE WWW.VANDEURZENASSOC.COM
E-MAIL VDA@VANDEURZENASSOC.COM
Van Deurzen and Associates, P.A. © 2023

SWIMMING POOL FOR:

WHISPERING WOODS

1901 SW. RIVER RUN DR.
LEE'S SUMMIT, MISSOURI

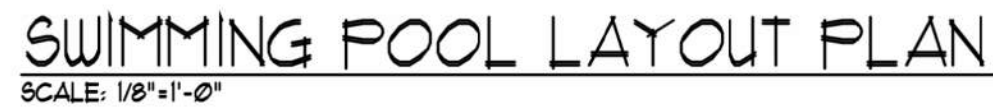

SITE PLAN FOR:

WHISPERING WOODS

1901 SW. RIVER RUN DR.
LEE'S SUMMIT, MISSOURI



VAN DEURZEN & ASSOCIATES, P.A.
11011 KING STREET SUITE 130
OVERLAND PARK, KS 66210
(913) 451-6305 FAX (913) 451-1021
WEB PAGE WWW.VANDEURZENASSOC.COM
E-MAIL VD.A@VANDEURZENASSOC.COM

Van Deurzen and Associates, P.A. © 2023

DATE: 11/23/2022

BY: MEJ

JOB:

SHEET NO.

 $\frac{Q}{L}$

EQUIPMENT						
EQUIPMENT NAME	MANUFACTURER PART #	WAREHOUSE PART #	QTY.	POWER REQUIREMENTS	HOOP UP RESPONSIBILITY	NOTES
BADU PRO UVS 4 HP PUMP	015583		1	110/230 V	POOL CONTRACTOR-PLUMBING ELECTRICIAN-HIGH VOLTAGE	
TRITON II SAND FILTER	TR 60 CP		1	NA	POOL CONTRACTOR	
FLOVIS FLOW GAUGE	FV-C		1	NA	POOL CONTRACTOR	
SKIMMER	SP1082		3	NA	POOL CONTRACTOR	
PENTAIR MICROBRITE LED WHITE LIGHT			8	15W 12V	POOL CONTRACTOR	
300W TRANSFORMER	PX300		1	300W	POOL CONTRACTOR	
MAIN DRAIN SUCTION FITTING VGB APPROVED	25506-320		1	NA	POOL CONTRACTOR	
STAINLESS STEEL ENTRY LADDER	SR SMITH PLF-245-4C-MG		1	NA	POOL CONTRACTOR	
HANDRAIL	SR SMITH 316 STAINLESS CUSTOM RAILING		2	NA	POOL CONTRACTOR	



EQUIPMENT SCHEDULE FOR:
WHISPERING WOODS
1901 SW. RIVER RUN DR.
LEE'S SUMMIT, MISSOURI

VD VAN DEURZEN & ASSOCIATES, P.A.
11011 KING STREET, SUITE 130
OVERLAND PARK, KS 66210
(913) 451-6305 FAX (913) 451-1021
WEB PAGE WWW.VANDEURZENASSOC.COM
E-MAIL VDA@VANDEURZENASSOC.COM
Van Deurzen and Associates, P.A. © 2023

DATE: 3/10/2023
BY: MEJ
JOB:
SHEET NO. **P2.0**


FLOW CALCULATIONS		
PUMP (S)	1	PENTAIR INTELLIFLOW
POOL CAPACITY GALLONS	42,200	
REQUIRED TURN OVER (6 HOURS OR 4 TIMES PER DAY)	4	
REQUIRED GALLONS PER 24 HOURS	168,800	
REQUIRED GALLONS PER HOUR	7030	
REQUIRED GALLONS PER MINUTE	117	
REQUIRED PER PUMP	60	
FILTER (S)	2	
FILTER SQ. FT. (EACH)	520	
FILTER RATE PER GALLON	13	
FILTER RATE AT MAX. PUMP (SQ. FT. PER GALLON)	8.66	
MAX. PUMP FLOW GPM	120	FROM PUMP CHART
MAX. PUMP VELOCITY SUCTION ALLOWED	6 FPS	
MAX. VELOCITY AT MAX. PUMP FLOW FEET PER SECOND (SUCTION)	5.74	
MAX. VELOCITY RETURN REQUIRED	8 FPS	
MAX. VELOCITY AT MAX. (RETURN)	5.74	
MINIMUM PIPE SIZE SUCTION	3"	
MINIMUM PIPE SIZE RETURN	2.5"	
MINIMUM PIPE SIZE SUCTION (AFTER FIRST TEE ON SUCTION)	2"	
MINIMUM PIPE SIZE RETURN (AFTER FIRST TEE ON RETURN)	2"	
MAX. FLOW REQUIREMENTS FOR MAIN DRAIN SPECIFIED	60	
FLOOR GALLONS PER MINUTE	309	
WALL GALLONS PER MINUTE	212	



FLOW CALCULATIONS FOR:
WHISPERING WOODS
1901 SW. RIVER RUN DR.
LEE'S SUMMIT, MISSOURI

VD VAN DEURZEN & ASSOCIATES, P.A.
11011 KING STREET, SUITE 130
OVERLAND PARK, KS 66210
(913) 451-6305 FAX (913) 451-1021
WEB PAGE WWW.VANDEURZENASSOC.COM
E-MAIL VDA@VANDEURZENASSOC.COM
Van Deurzen and Associates, P.A. © 2023

DATE: 3/10/2023
BY: MEJ
JOB:
SHEET NO. **P2.1**

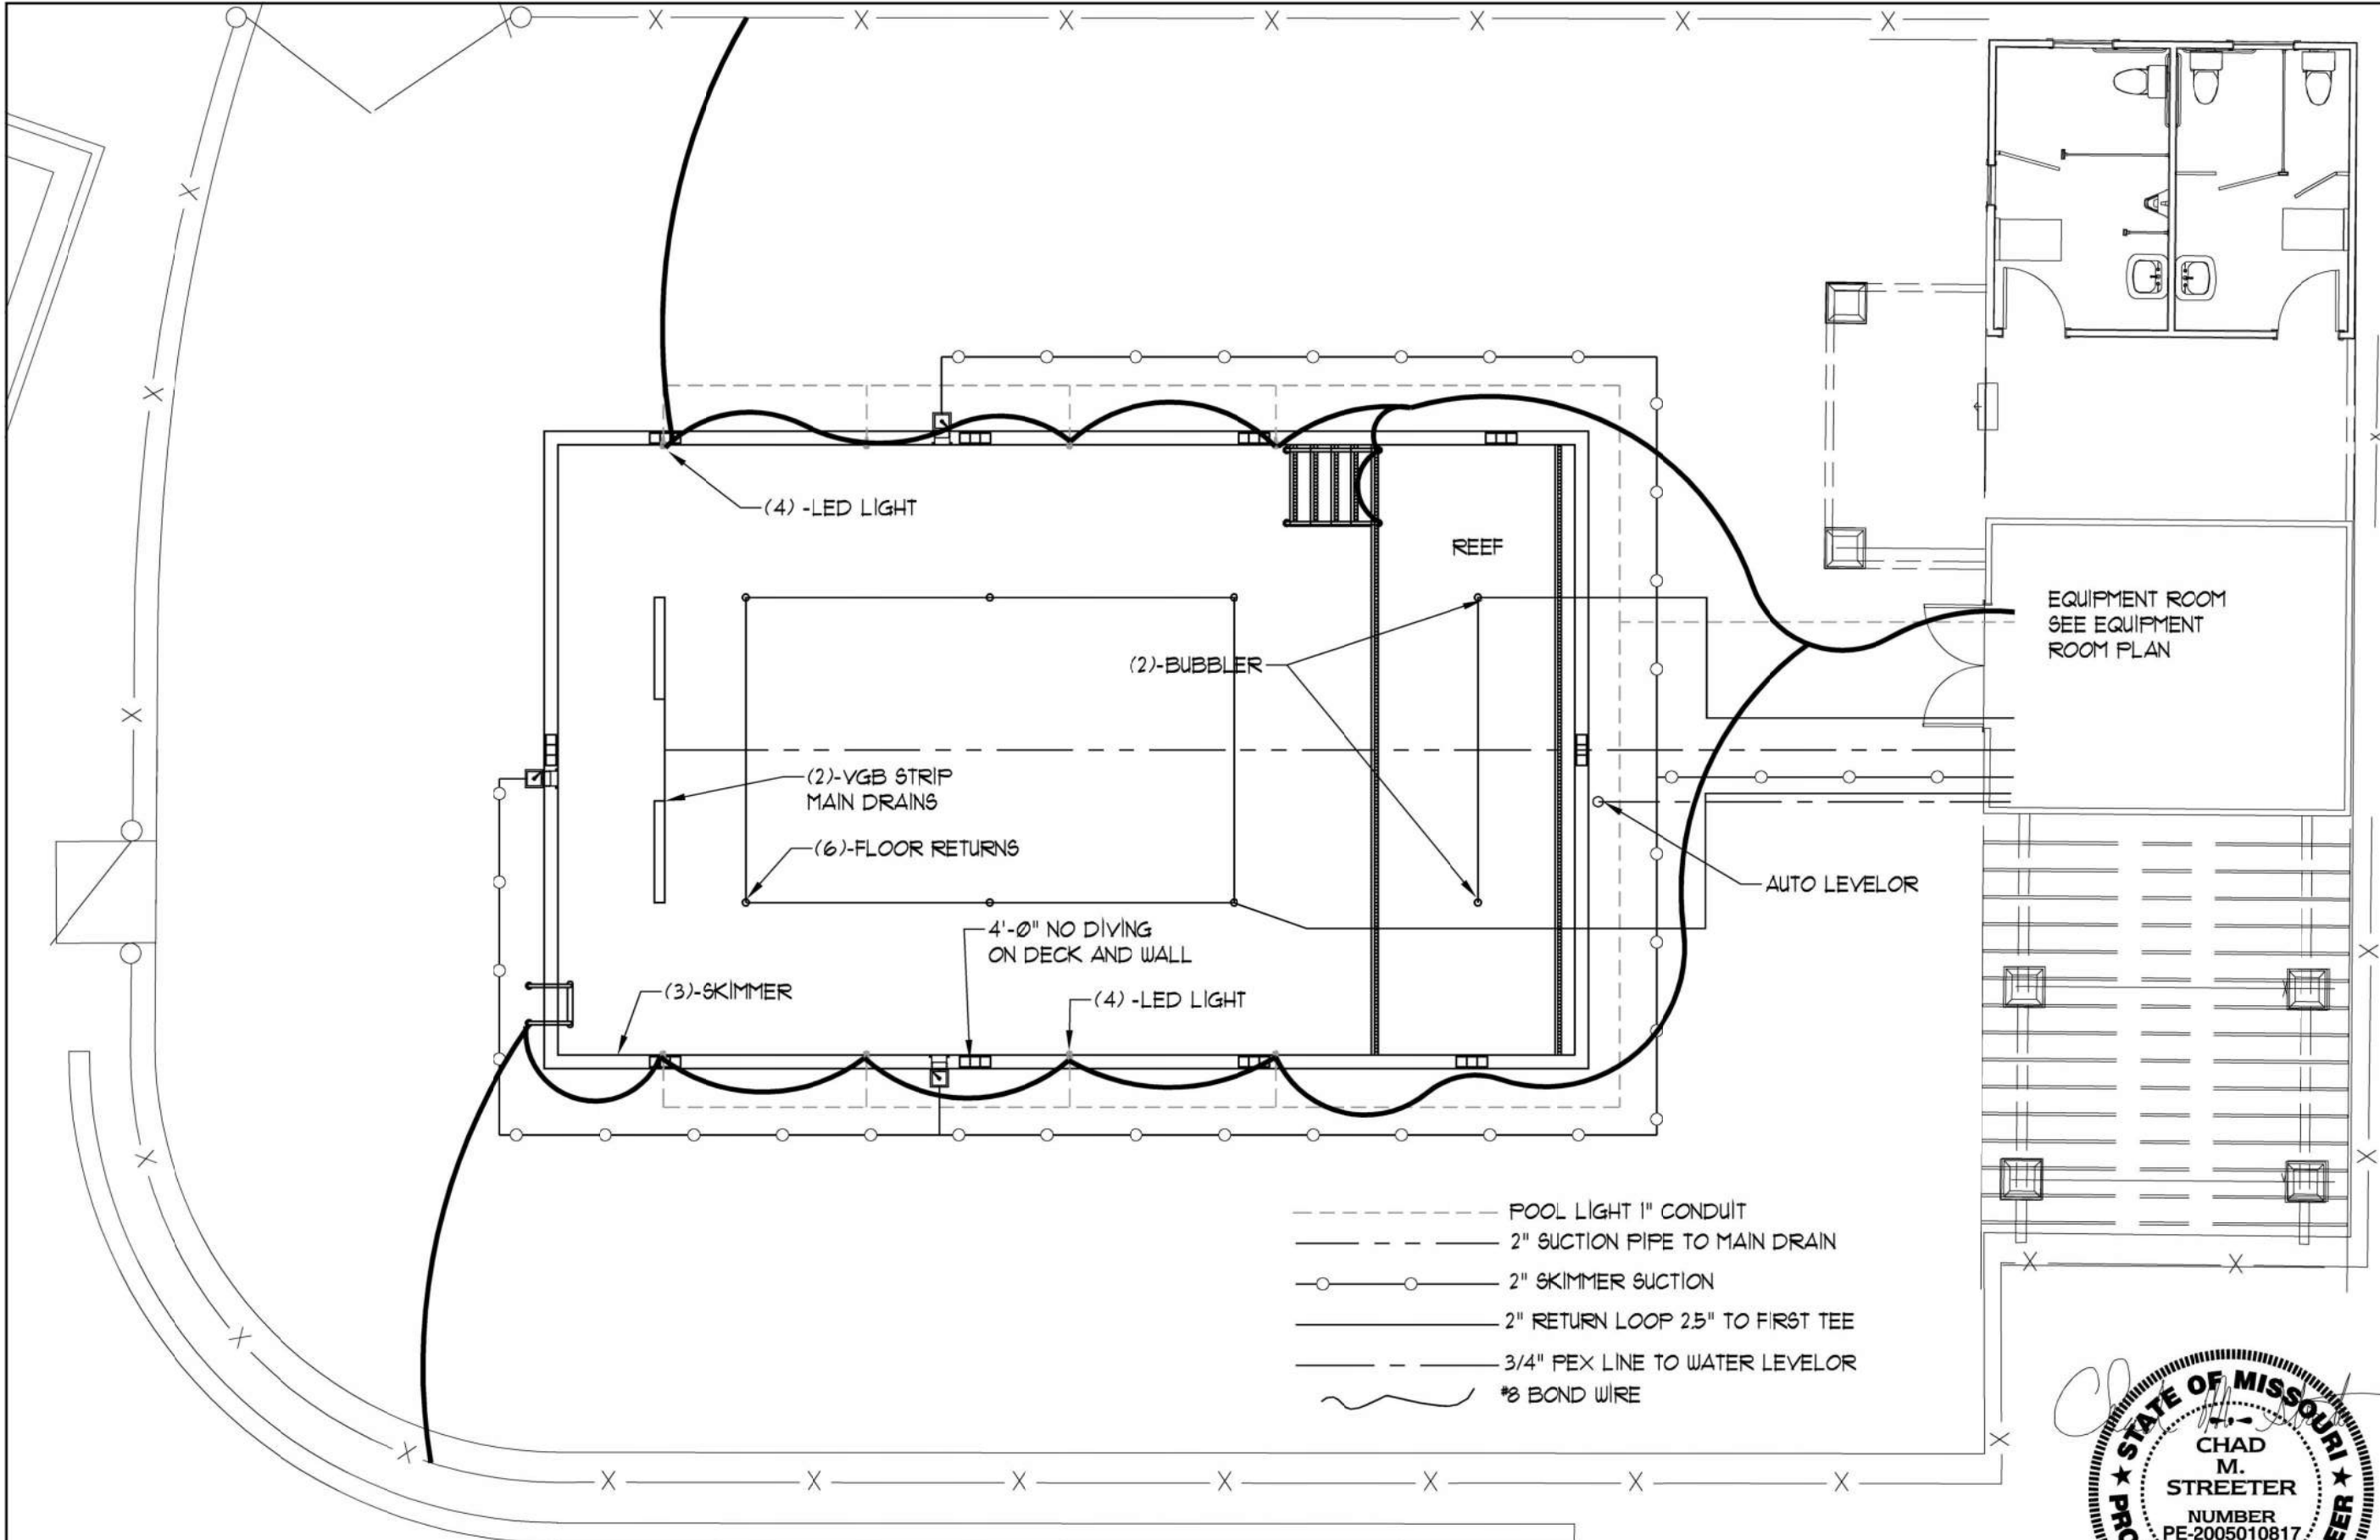

SWIMMING POOL PLUMBING PLAN SCALE: 1/8"=1'-0"



POOL PLUMBING PLAN FOR:

WHISPERING WOODS


1901 SW. RIVER RUN DR.
LEE'S SUMMIT, MISSOURI



VAN DEURZEN & ASSOCIATES, P.A.
11011 KING STREET, SUITE 130
OVERLAND PARK, KS 66210
(913) 451-6305 FAX (913) 451-1021
WEB PAGE WWW.VANDEURZENASSOC.COM
E-MAIL VDA@VANDEURZENASSOC.COM

DATE: 3/10/2023
BY: MEJ
JOB:
SHEET NO. **P3.0**

Van Deurzen and Associates, P.A. © 2023

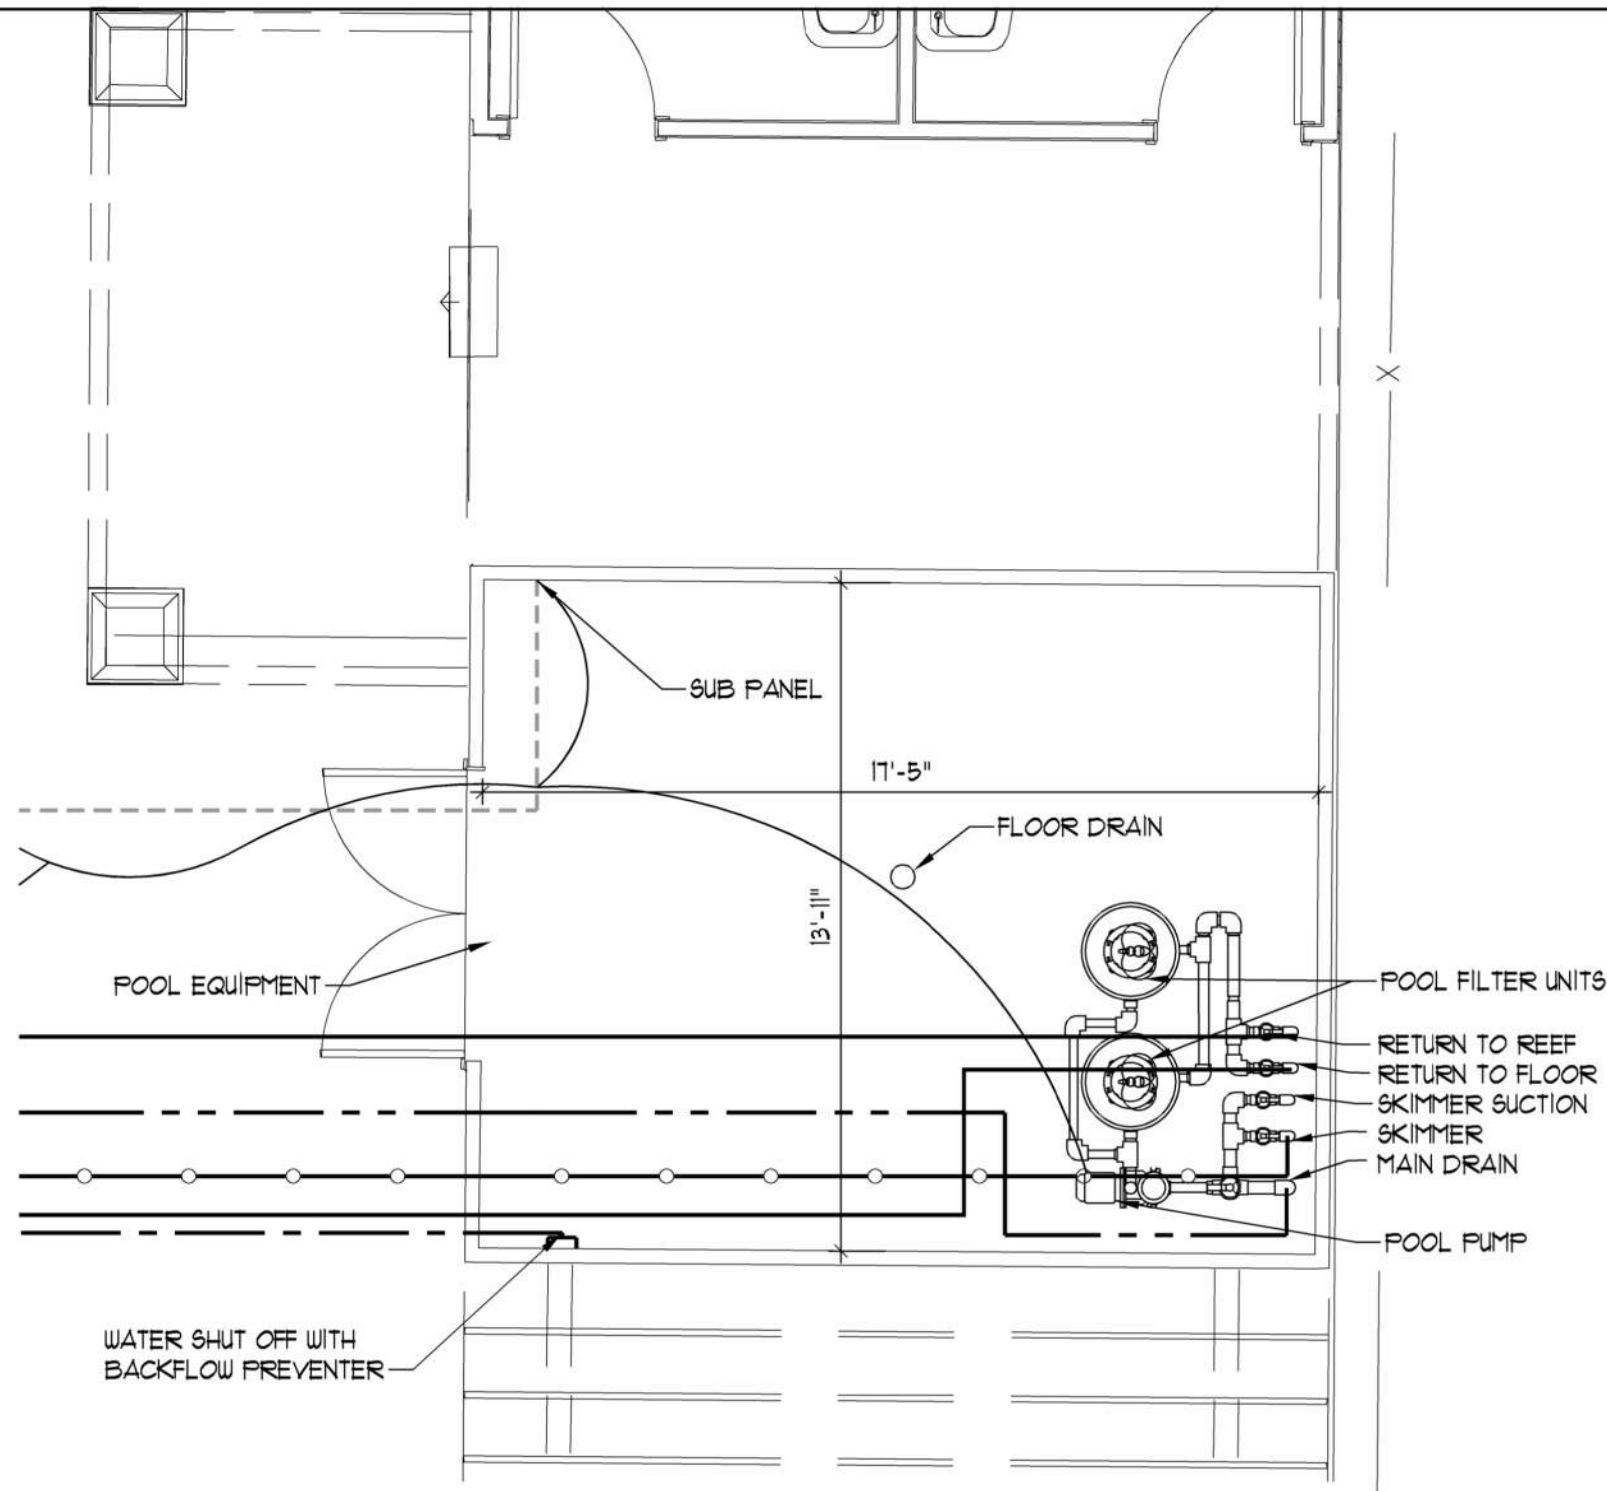

- — — — — 3/4" PEX LINE TO WATER LEVELOR
- - - - - POOL LIGHT 1" CONDUIT
- - - - - 2" SUCTION PIPE TO MAIN DRAIN
- - - - - 2" SKIMMER SUCTION
- - - - - 2" RETURN LOOP 2.5" TO FIRST TEE
- ~~~~~ #8 BOND WIRE

SWIMMING POOL EQUIPMENT LAYOUT PLAN

SCALE: 1/4"=1'-0"



EQUIPMENT ROOM LAYOUT FOR:

WHISPERING WOODS

1901 SW. RIVER RUN DR.
LEE'S SUMMIT, MISSOURI

VDA VAN DEURZEN & ASSOCIATES, P.A.
11011 KING STREET, SUITE 130
OVERLAND PARK, KS 66210
(913) 451-6305 FAX (913) 451-1021
WEB PAGE WWW.VANDEURZENASSOC.COM
E-MAIL VDA@VANDEURZENASSOC.COM

Van Deurzen and Associates, P.A. © 2023



DATE: 3/10/2023

BY: MEJ

JOB:


SHEET NO.

P3.1

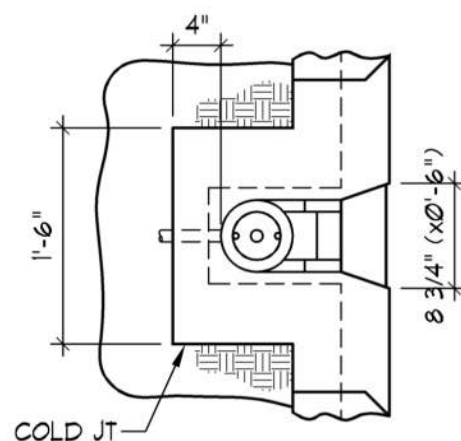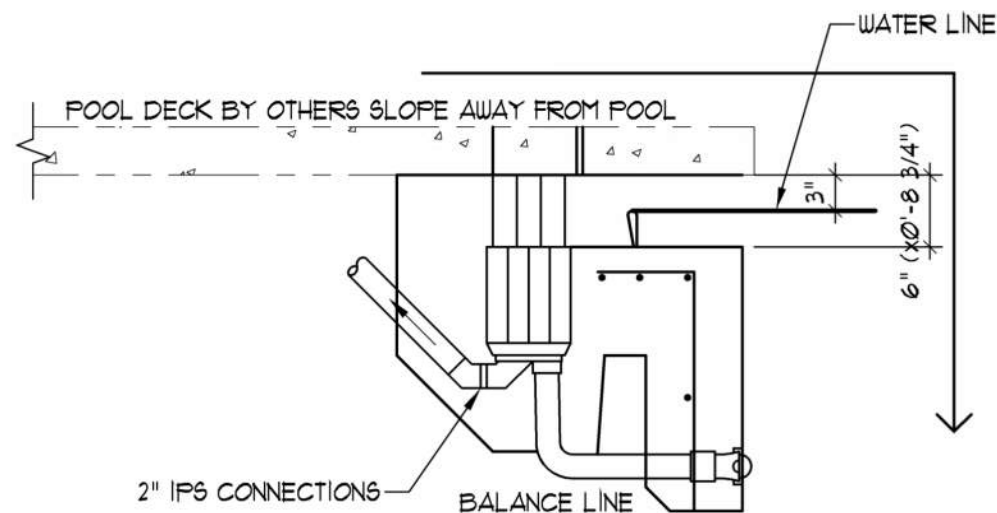


POOL TYPICAL SKIMMER SECTION

SCALE: 3/4"=1'-0"

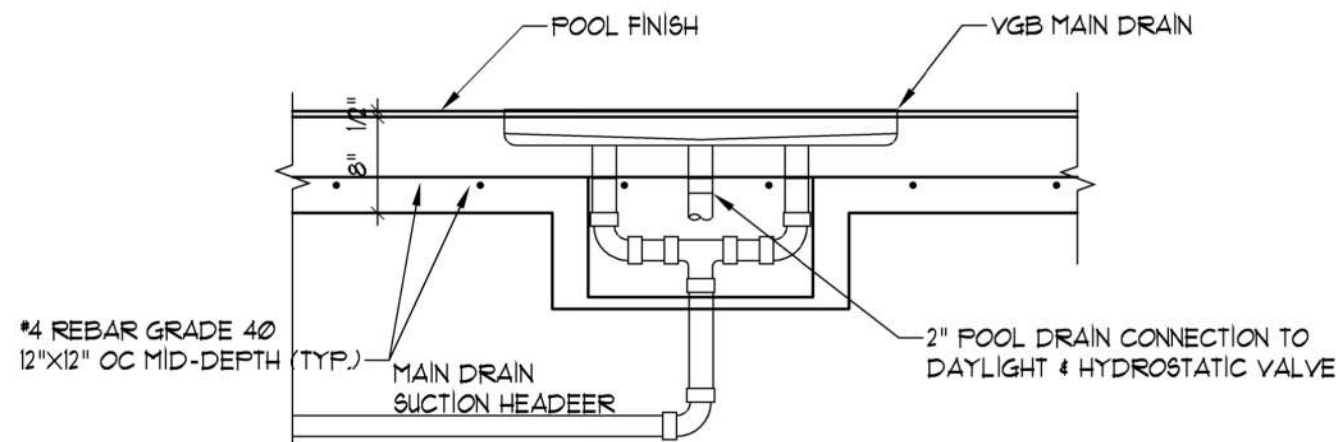


POOL MAIN DRAIN SECTION

SCALE: 3/4"=1'-0"

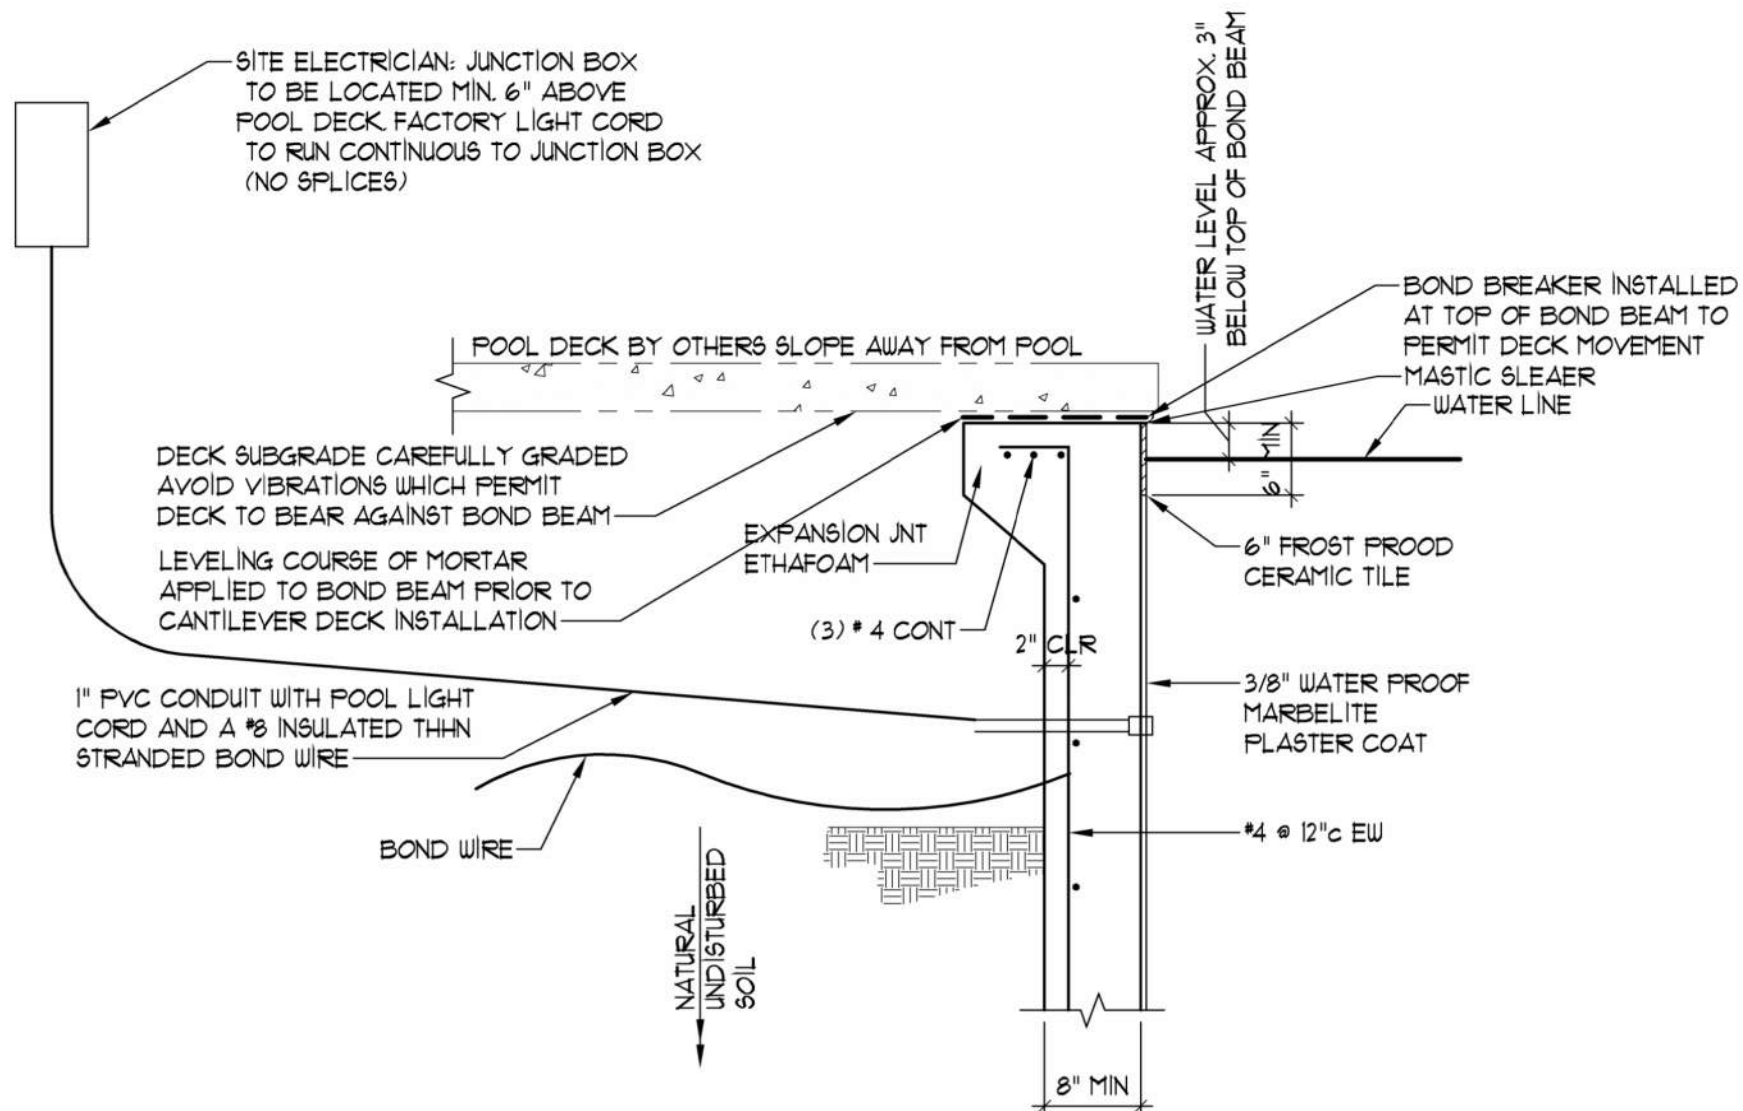

POOL TYPICAL WALL SECTION

SCALE: 3/4"=1'-0"

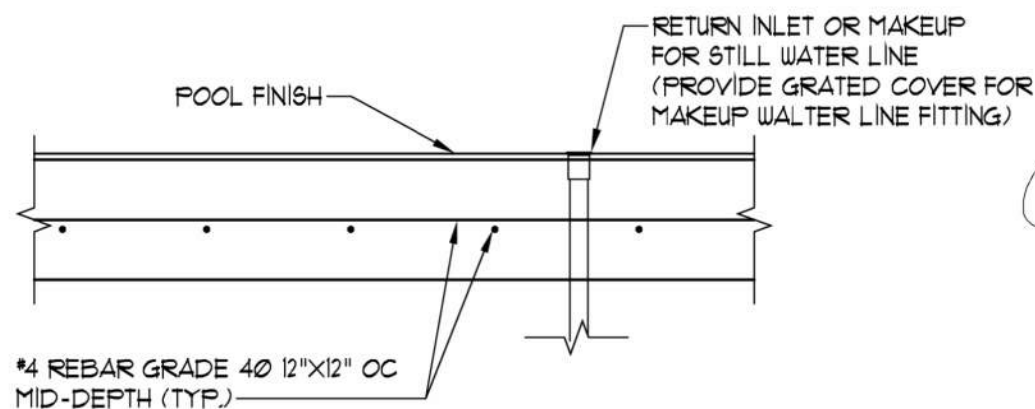

POOL FLOOR RETURN INLET SECTION

SCALE: 3/4"=1'-0"



DETAILS FOR:

WHISPERING WOODS

1901 SW. RIVER RUN DR.
LEE'S SUMMIT, MISSOURI

VAN DEURZEN & ASSOCIATES, P.A.

11011 KING STREET, SUITE 130

OVERLAND PARK, KS 66210

(913) 451-6305 FAX (913) 451-1021

WEB PAGE WWW.VANDEURZENASSOC.COM

E-MAIL VDA@VANDEURZENASSOC.COM

Van Deurzen and Associates, P.A. © 2023


DATE: 3/10/2023

BY: MEJ

JOB:

SHEET NO.

P4.0

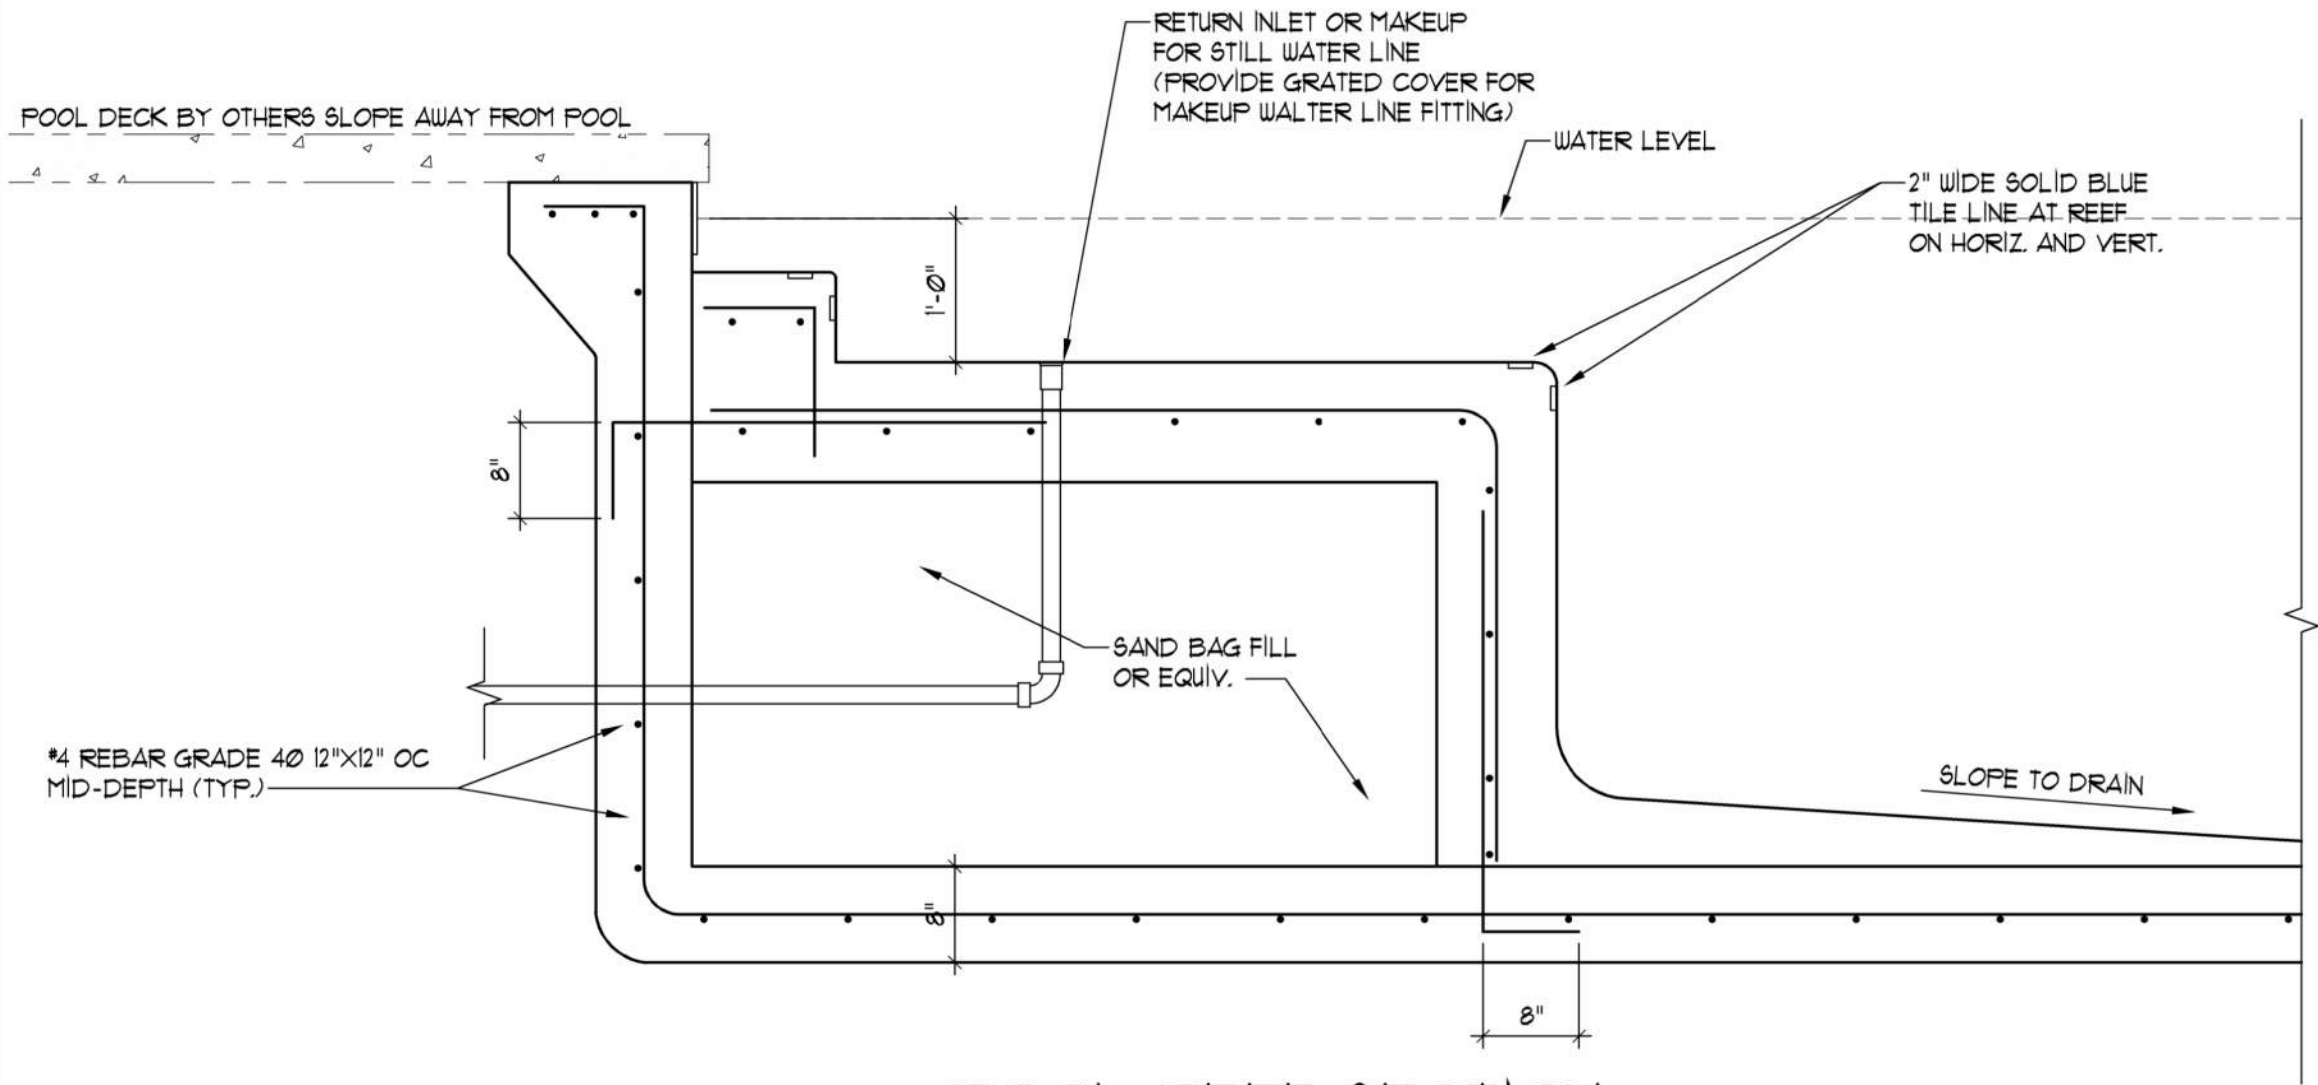

POOL REEF SECTION

SCALE: 3/4" = 1'-0"



DETAILS FOR:

WHISPERING WOODS

1901 SW. RIVER RUN DR.
LEE'S SUMMIT, MISSOURI

VAN DEURZEN & ASSOCIATES, P.A.

11011 KING STREET, SUITE 130

OVERLAND PARK, KS 66210

(913) 451-6305 FAX (913) 451-1021

WEB PAGE WWW.VANDEURZENASSOC.COM

E-MAIL VDA@VANDEURZENASSOC.COM

Van Deurzen and Associates, P.A. © 2022


DATE: 3/10/2023

BY: MEJ

JOB:

SHEET NO.

P4.1

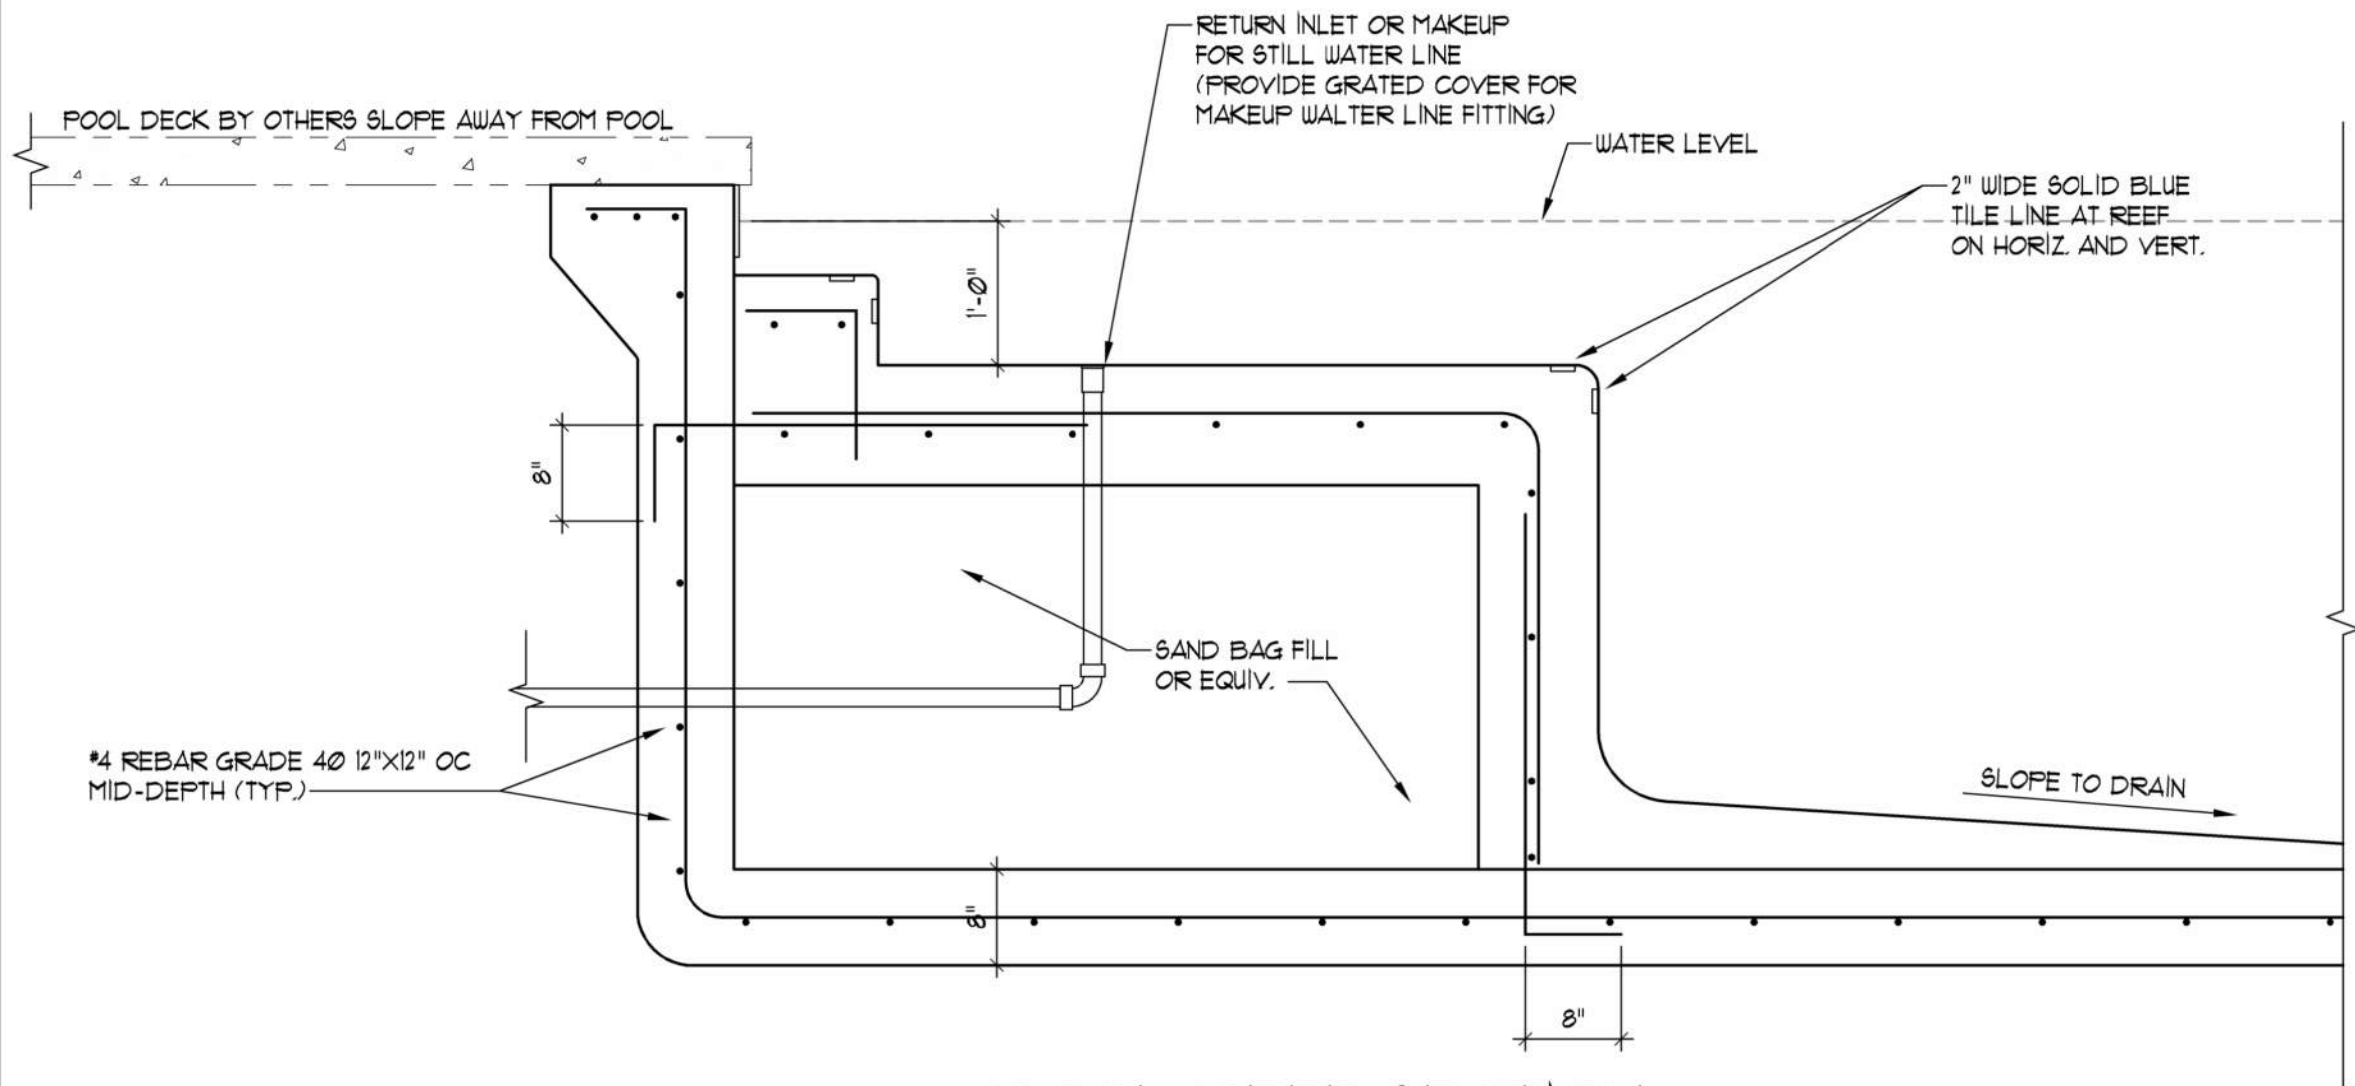

POOL REEF SECTION

SCALE: 3/4"=1'-0"



DETAILS FOR:

ARCHER VILLAS

275 S. PARKER
OLATHE, KANSAS

VD VAN DEURZEN & ASSOCIATES, P.A.
11011 KING STREET, SUITE 130
OVERLAND PARK, KS 66210
(913) 451-6305 FAX (913) 451-1021
WEB PAGE WWW.VANDEURZENASSOC.COM
E-MAIL VDA@VANDEURZENASSOC.COM

Van Deurzen and Associates, P.A. © 2023


DATE: 3/10/2023

BY: C115

JOB:

SHEET NO.

P42

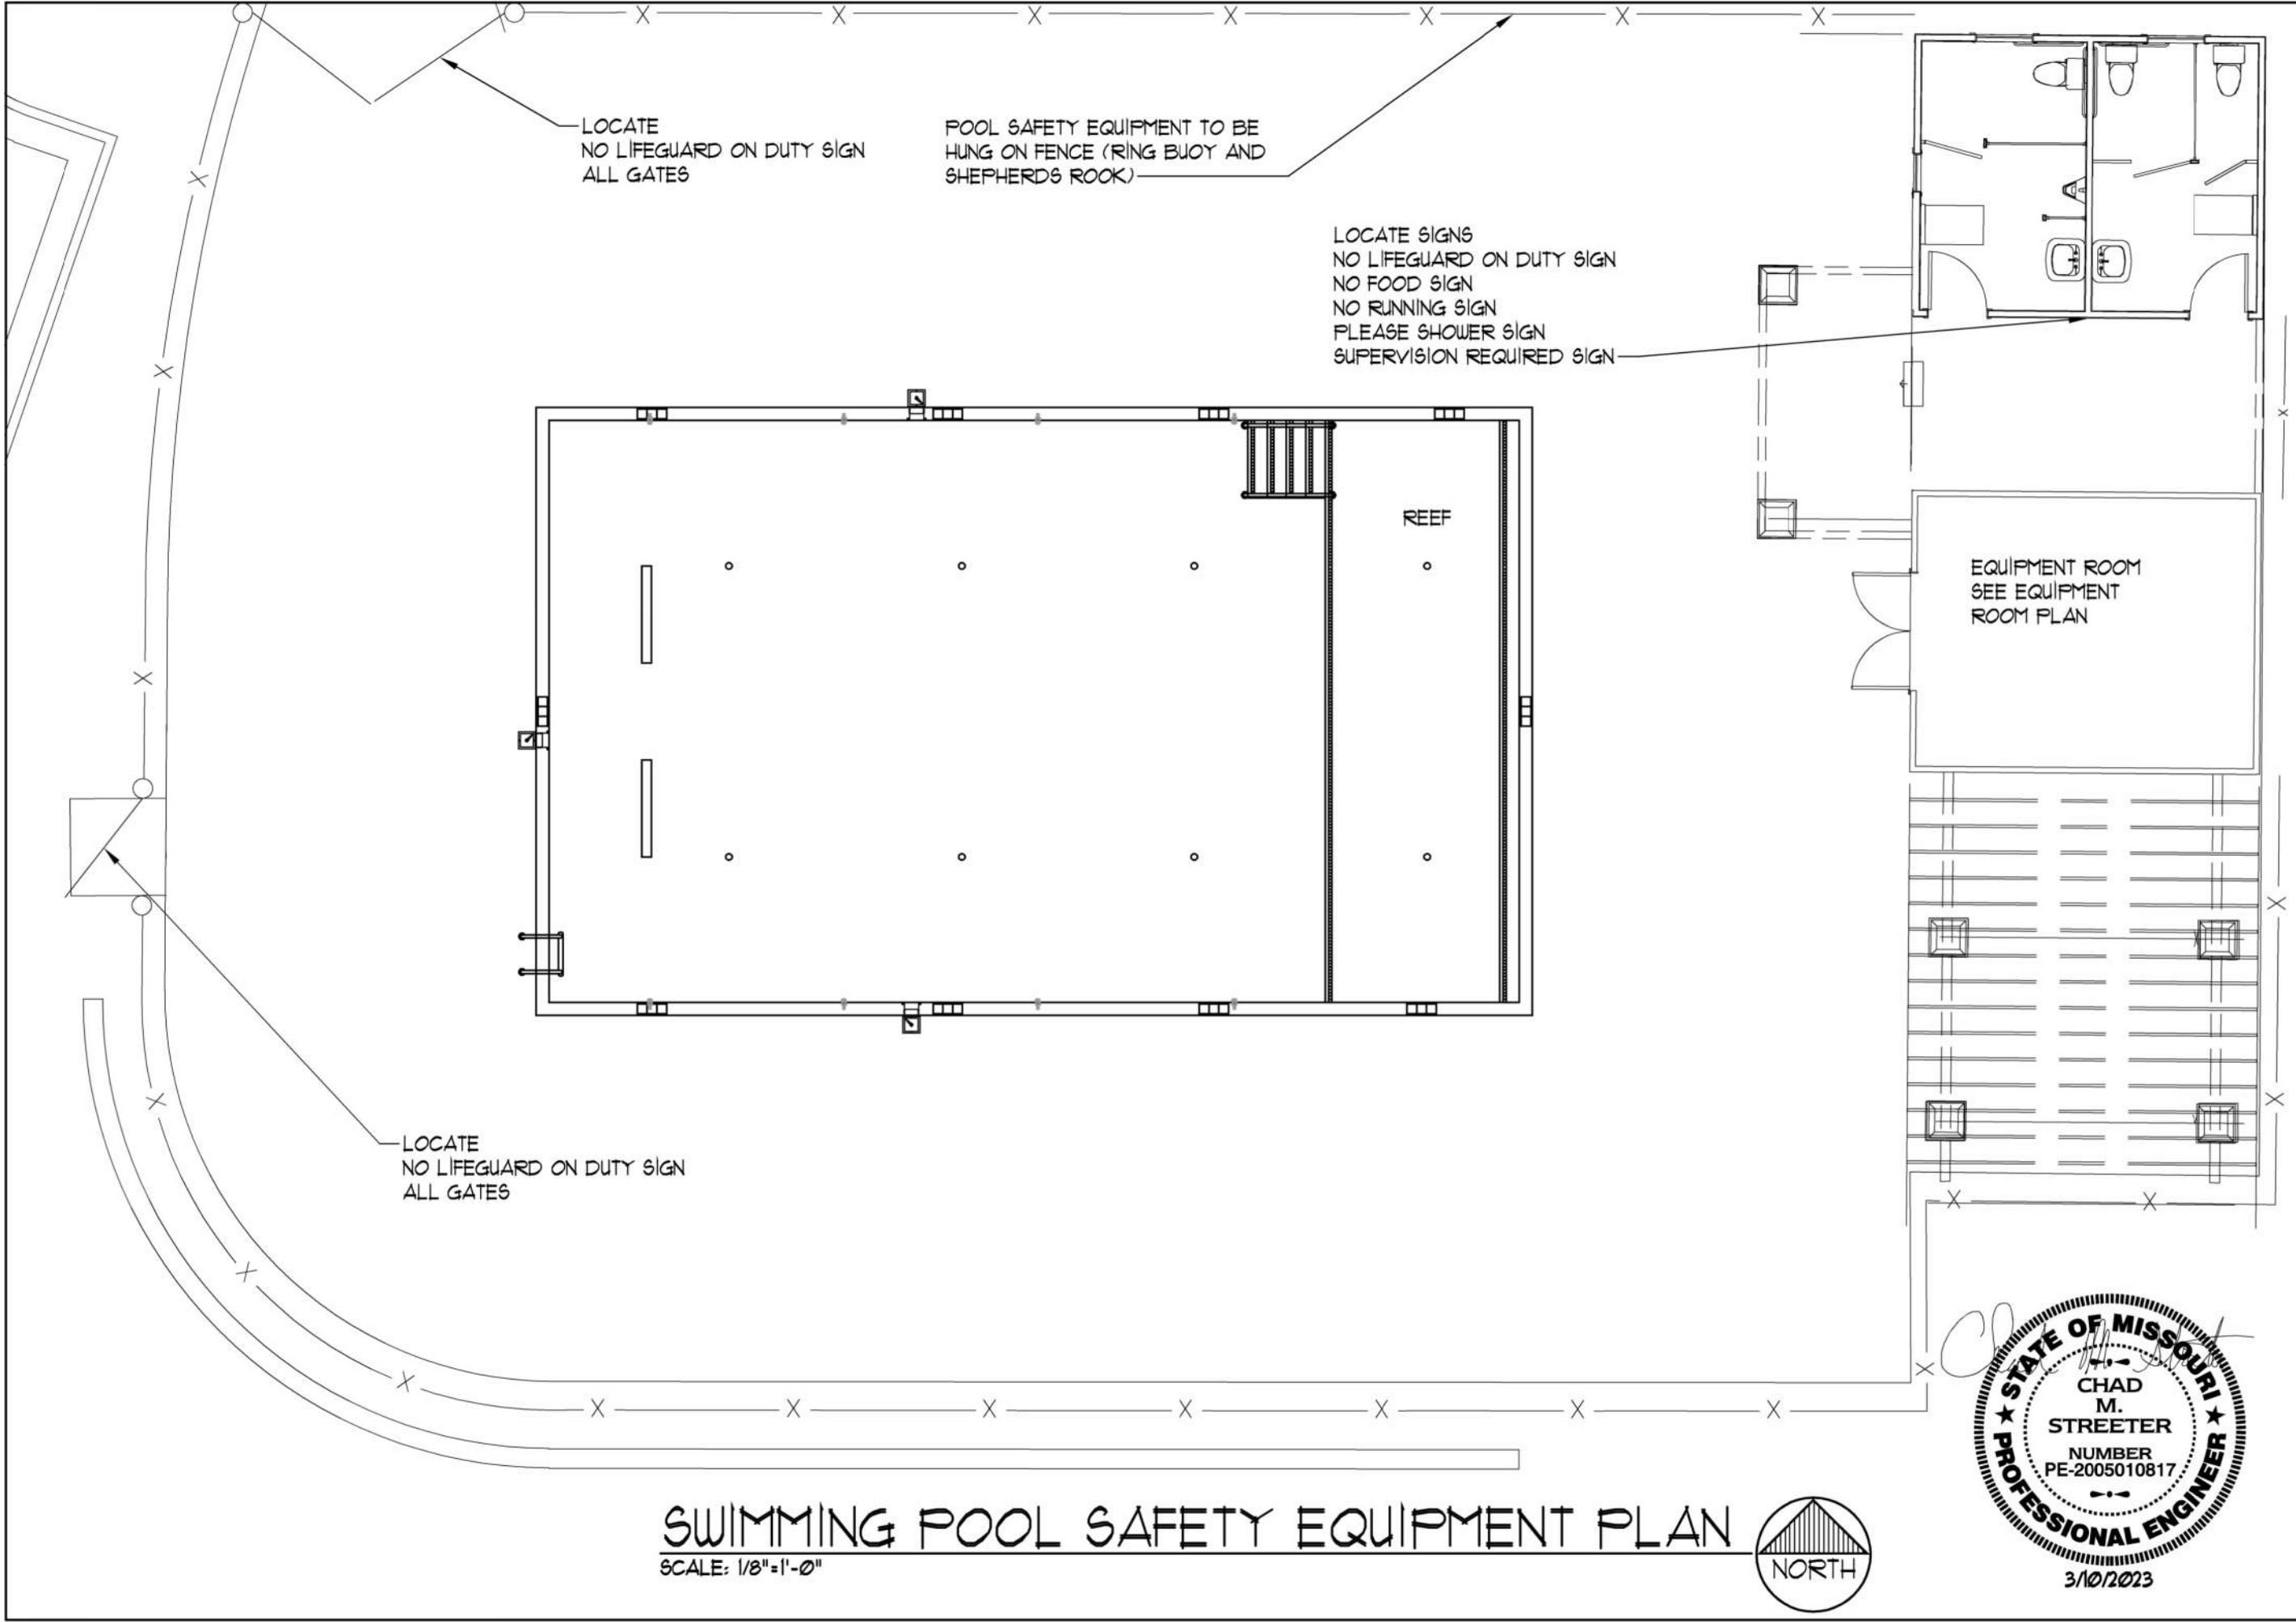

SWIMMING POOL SAFETY EQUIPMENT PLAN
SCALE: 1/8" = 1'-0"



SAFETY PLAN FOR:
WHISPERING WOODS
1901 SW. RIVER RUN DR.
LEE'S SUMMIT, MISSOURI

VAN DEURZEN & ASSOCIATES, P.A.
11011 KING STREET, SUITE 130
OVERLAND PARK, KS 66210
(913) 451-6305 FAX (913) 451-1021
WEB PAGE WWW.VANDEURZENASSOC.COM
E-MAIL VDA@VANDEURZENASSOC.COM

Van Deurzen and Associates, P.A. © 2023

DATE: 3/10/2023
BY: MEJ
JOB:
SHEET NO. **P5.0**



SIGN A



SIGN B



SIGN C



SIGN D



SIGN E



DATE: 3/10/2023

BY: MEJ


JOB:

SHEET NO.

SAFETY PLAN FOR:

WHISPERING WOODS

1901 SW. RIVER RUN DR.
LEE'S SUMMIT, MISSOURI



VAN DEURZEN & ASSOCIATES, P.A.
11011 KING STREET, SUITE 130
OVERLAND PARK, KS 66210
(913) 451-6305 FAX (913) 451-1021
WEB PAGE WWW.VANDEURZENASSOC.COM
E-MAIL YD@VANDEURZENASSOC.COM

Van Deurzen and Associates, P.A. © 2023

P5.1